

**BENCH MARKS:**

HO. CO. # 2142001 CL = 294.90  
 HO. CO. # 2042007 CL = 210.68

**GENERAL NOTES:**

**SHEET INDEX**

1. Cover Sheet
2. Plan View
3. Plan View
4. Profiles: Water & Sewer

# WINTERBROOK

**PART I**

1. Approximate location of existing mains are shown. The contractor shall take all necessary precautions to protect existing mains and services and maintain uninterrupted supply. Any damage incurred shall be repaired immediately to the satisfaction of the Engineer at the Contractor's expense.
2. All horizontal controls are based on Maryland State Coordinates.
3. All vertical controls are based on U.S.G.S. data.
4. All pipe elevations shown are invert elevations.
5. Clear all utilities by a minimum of 6". Clear all poles by 2' - 0" minimum or tunnel as required. The owner has contacted the utility companies and has made arrangements for bracing of poles as shown on the drawings. In the event the contractor's work requires the bracing of additional poles, any cost incurred by the owner for bracing of additional poles or damages shall be deducted from money owed the contractor. The contractor shall coordinate with the utility companies to schedule the bracing of the poles.
6. For details not shown on the drawings, and for materials and construction methods use Howard County Design Manual, Volume IV, Standard Specifications and Detail for Construction (Latest Edition). The contractor shall have a copy of Volume IV on the job.
7. Where test pits have been made on existing utilities they are noted by the symbol (E) at the location of the test pit. A note or notes containing the results of the test pit or pits is included on the drawings. Existing utilities in the vicinity of the proposed work for which test pits have not been dug shall be located by the contractor two weeks in advance of construction operations at his own expense.
8. Contractor shall notify the following utility companies or agencies at least five working days before starting work shown on these plans:
 

State Highway Administration	531-5533
EG&E Co. Contractor Services	850-4620
BC&E Co. Under Ground Damage Control	781-9060
Miss Utility	1-800-257-7777
Howard County Department of Public Works Bureau of Utilities	313-4900
9. Trees and shrubs are to be protected from damage to maximum extent. Trees and shrubs located within the construction strip are not to be removed or damaged by the contractor.
10. Contractor shall remove trees, stumps and roots along line of excavation. Payment for such removal shall be included in the unit price bid for construction of the main.

**PART II - WATER**


1. All water mains to be D.I.P. Class 52 unless otherwise noted.
2. Tops of all water mains to have a minimum of 3'-1/2' cover unless otherwise noted.
3. Valves adjacent to tees shall be strapped to tees.
4. All fittings shall be buttressed or anchored with concrete in accordance with the Standard Details unless otherwise provided for on the drawings.
5. Fire hydrants shall be set to the bury line elevations shown on the drawings. All fire hydrants shall be strapped and buttressed with concrete in accordance with Standard Details. Soil around the fire hydrant shall be compacted in accordance with Section 1000 and 1005 of the Standard Specifications.
6. The contractor shall not operate any water main valves on the existing water system.
7. All water house connections shall be for inside meter setting unless otherwise noted on plans or in specifications.

**PART III - SEWER**

1. All sewer mains shall be DIP, RCP, VCPX, CSPX, RCCP and P.V.C. unless otherwise noted.
2. All manholes shall be 4' - 0" inside diameter unless otherwise noted.
3. Force mains shall be D.I.P. only.
4. Manholes shown with 12" and 16" walls are for brick manholes only.
5. Manholes designated W.T. in plan and profile shall have watertight frame and covers, Standard Detail 65.52. Where watertight manhole frame and cover is used, set top of frame 1" - 6" above finished grade unless otherwise noted on the drawings.
6. House(s) with the symbol "C.N.S." indicates that cellar cannot be served.

WATER AND SEWER CODE  
 COUNTY USE  
 Water Code CC1  
 Water Test Gradient 550  
 Sewer Code 4250000

Type of Building	SFD
Number of Lots/Parcels:	36 (34 buildable)
Number of W.H.C.'s	34
Number of S.H.C.'s	34
Drainage Area:	Little Patuxent
Treatment Plant	Little Patuxent WWTP

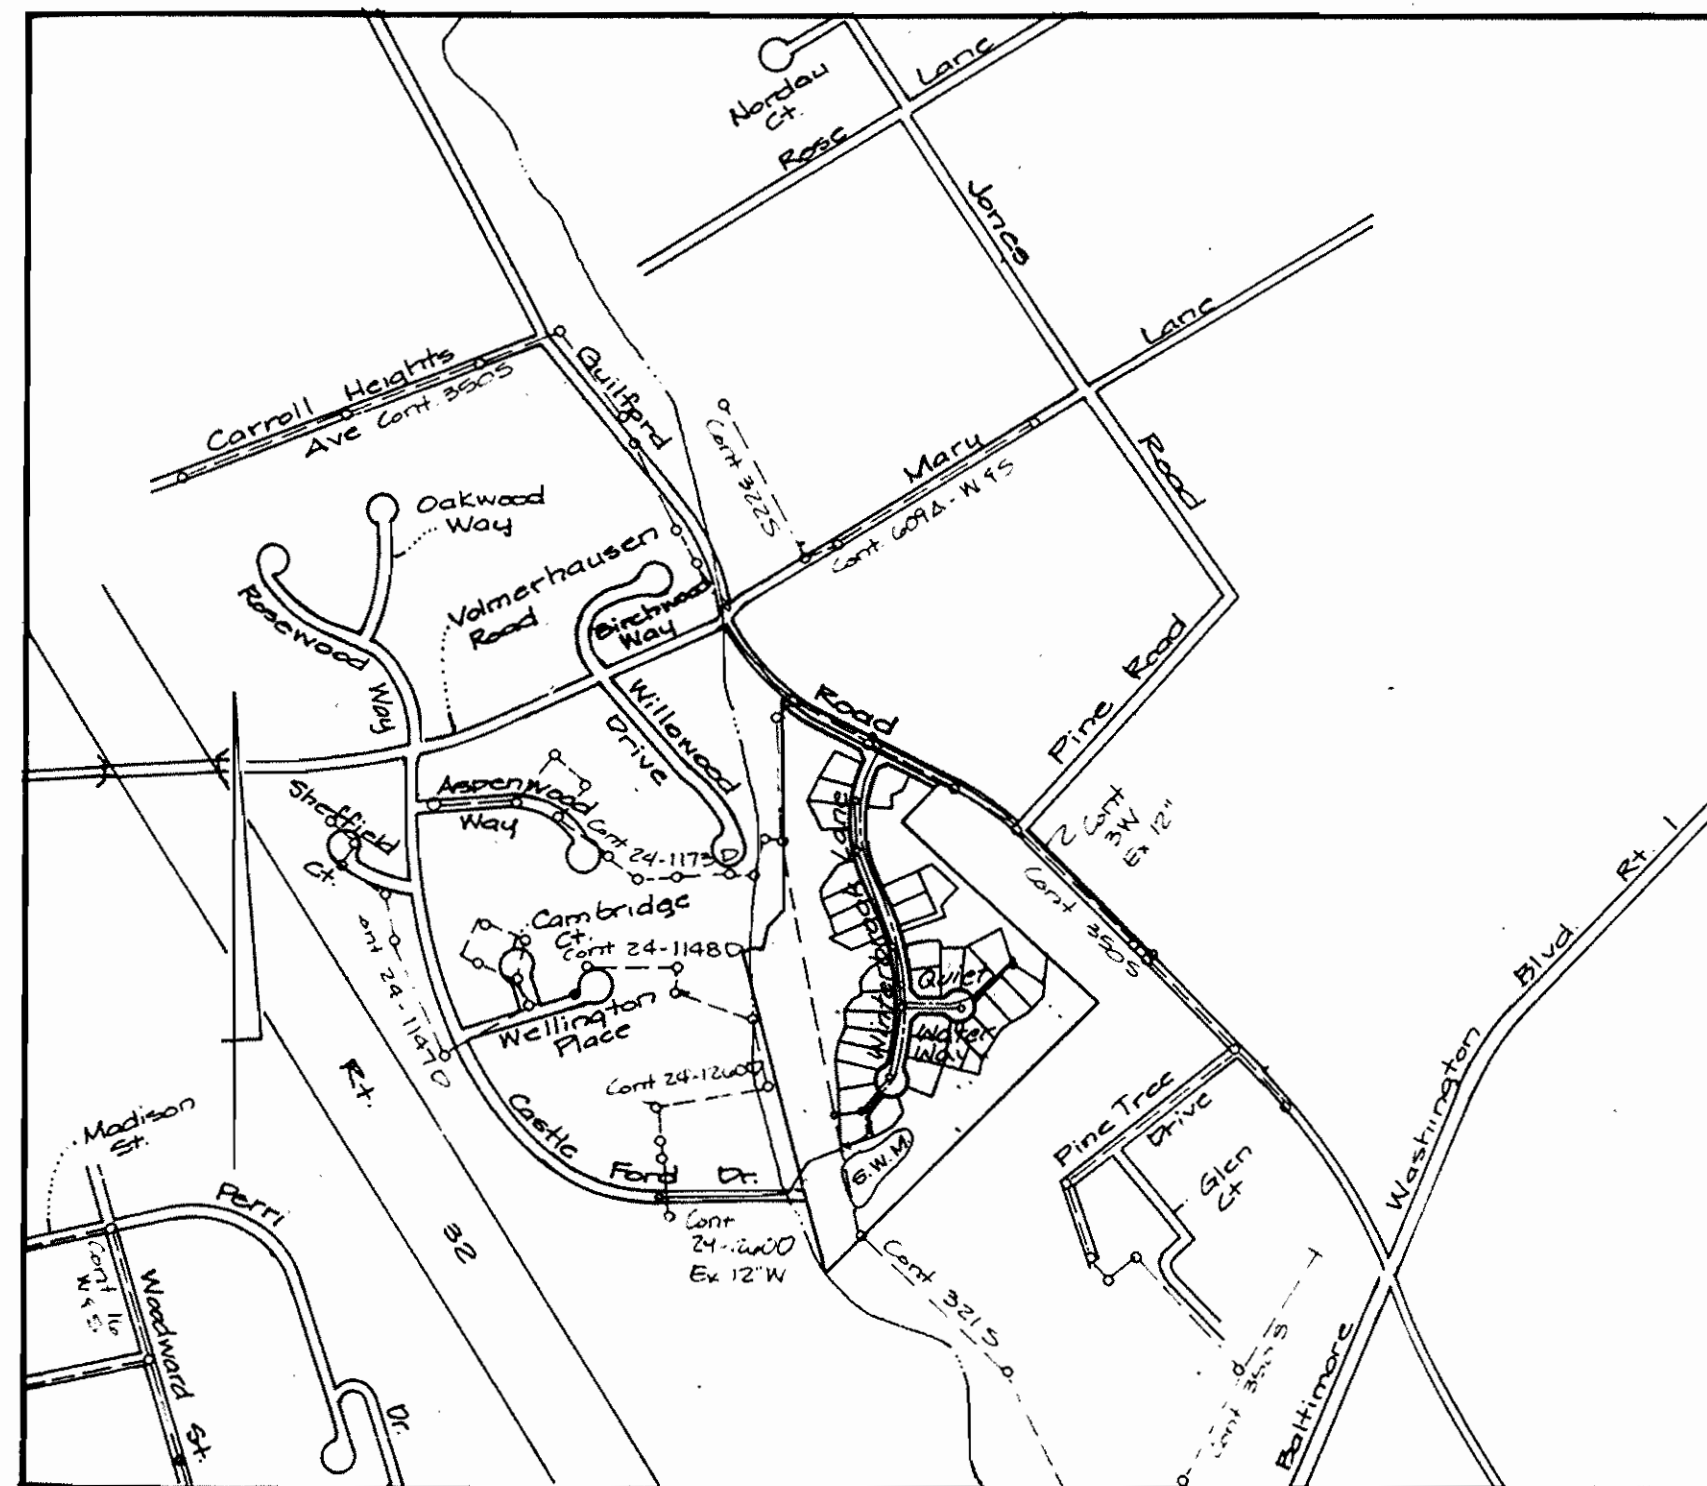

LOCATION MAP  
 SCALE: 1" = 600'

Item	Qty Est	Qty	Type	Manufacturer/Supplier
4" Water D.I.P.	170	LE 172	DIP	GRIFFIN PIPE CO.
6" Water D.I.P.	230	LE 242	DIP	GRIFFIN PIPE CO.
8" Water D.I.P.	1407	LE 1415	DIP	"
4" x 8" V.C.	1	CA 1	DIP	"
6" x 8" V.C.	2	CA 2	DIP	"
8" Valve	2	CA 2	CAST IRON	MUELLER CO.
6" Valve	3	CA 3	"	"
12" x 8"	1	CA 1	DIP T & S	U.S. FOUNDRY
(Wrapping Sleeve & Valve)	CA 1	GATE VALVE	"	MUELLER CO.
8" Cap & Buttress	1	CA 1	DIP	GRIFFIN PIPE CO.
3/4" W.H.C.	278	LE 280	K COPPER	HOWELL METALS
1" W.H.C.	850	LE 850	P.V.C.	M-MANUFACTURING
1 1/2" Blowoff	2	CA 2	K COPPER	HOWELL METALS
F.H.	2	CA 2	CAST IRON	MUELLER CO.
8" Sewer	1520	LE 1520	P.V.C.	J.M. MANUFACTURING
6" Dia. V.H.	2	CA 2	CAST IRON	U.S. FOUNDRY
18" Bore 8"	2	CA 2	D.I.P.	U.S. FOUNDRY
18" Bore 8"	2	CA 2	D.I.P.	U.S. FOUNDRY

Utility Contractor: CONSOLIDATED CONSTRUCTION SERVICES  
 Check Box:  
 Survey and Drafting Div.   
 As Built Date

SEWER HOUSE CONNECTIONS		
LOT	INV. @ PROPERTY LINE	M.C.E.
1	200.05 ✓	203.5
2	199.70 ✓	203.0
3	193.58 ✓	196.5
4	190.37 ✓	193.5
5	189.39 ✓	192.5
6	188.48 ✓	191.5
7	187.67 ✓	191.0
8	184.83 ✓	188.0
9	183.85 ✓	187.0
10	182.60 ✓	185.5
11	181.66 ✓	185.0
12	180.97 ✓	184.0
13	180.28 ✓	183.5
14	179.02 ✓	182.0
15	177.26 ✓	180.5
16	179.36 ✓	182.5
17	181.19 ✓	184.5
18	182.05 ✓	185.0
19	184.56 ✓	187.5
20	184.41 ✓	190.5
21	191.58 ✓	194.5
22	192.36 ✓	195.5
23	195.91 ✓	199.0
24	199.61 ✓	203.0
25	201.22 ✓	204.5
26	199.56 ✓	203.0
27	194.91 ✓	198.0
28	188.82 ✓	192.0
29	184.93 ✓	188.0
30	186.01 ✓	189.0
31	187.37 ✓	194.0
32	188.04 ✓	191.0
33	188.94 ✓	192.0
34	199.70 ✓	203.0

\* INV. AT EDGE OF EASEMENT

# WATER & SEWER CONTRACT DRAWINGS

6th ELECTION DISTRICT HOWARD COUNTY, MARYLAND

CONTRACT No 24-1951-D


Reviewed for Howard Soil Conservation District and meets Technical Requirements.  
*Patricia Engle* 3/9/95  
 U. S. Soil Conservation Service

This Development Plan is Approved for Soil Erosion and Sediment Control by the Howard County Soil Conservation District.  
*John R. Roberts* 3/9/95  
 Howard County Soil Conservation District

Sediment Control Measures for this Contract will be implemented in accordance with Section 219 of the Standard Specification and Final Road Construction Plans: F-25-15

Department of Public Works  
 Howard County, MD.  
*James G. Shaw* 3/10/95  
 Director of Public Works  
*Robert H. Bannister* 3-5-95  
 Chief - Bureau of Utilities

LAND DESIGN ENGINEERING, INC.  
 2035 Columbia 100 Pkwy. Unit N  
 Columbia, Maryland 21045  
 Phone: (410) 715-1070 (301) 996-3424

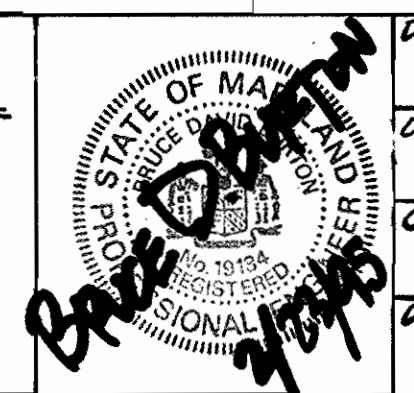

Designed: MJE			
Drawn: BEI			
Checked: MJE/BOB			
Date: JULY 1994			
BY No.		REVISION	DATE

COVER SHEET  
 WATER AND SEWER MAINS  
 600 SCALE MAP No. 47 BLOCK No. 6

WATER & SEWER AS-BUILTS  
 WINTERBROOK AS-BUILT  
 LOTS 1 THRU 36  
 6th ELECTION DISTRICT HOWARD COUNTY, MARYLAND  
 CONTRACT NO. 24-1951-D

SCALE AS SHOWN  
 SHEET 1 OF 4









