


Street	Address Chart
Lot/Parcel No.	Street Address
Lot 2	9100 WHITEHALL ROAD

SITE DEVELOPMENT PLAN HONRAO'S PROPERTY


LOT 2


TAX MAP No. 24 GRID No. 23 PARCEL NO. 270 SECOND ELECTION DISTRICT HOWARD COUNTY, MARYLAND

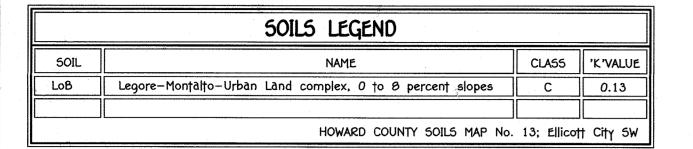

STORMWATER MANAGEMENT SUMMARY								
area id.	E5Dv REQUIRED CU.FT.	ESDV PROVIDED CU.FT.	REMARKS					
SITE	602	848	MICRO BIO RETENTION (M-6)					
TOTAL.	602	949		╢				


MICRO BIO CHART							
DRYWELL NO.	AREA OF ROOF	VOLUME REQUIRED	VOLUME PROVIDED	AREA OF TREATMENT	L	W	D
	3031 5Q. FT.	602 C.F.	848 C.F.	100%*			
	MODIFIED STORAGE	EL TO CAP	TURE 100	YR STORM	40' x	23'	x 5.3'

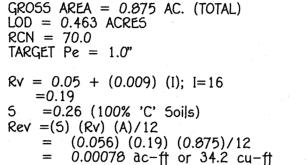

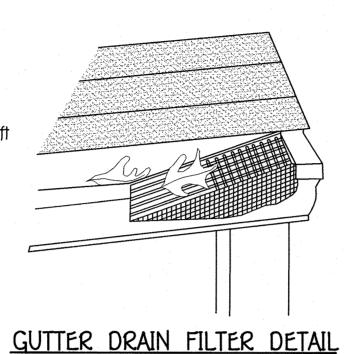



- BIO-RETENTION AREAS (M-6) ANNUAL MAINTENANCE OF PLANT MATERIAL, MULCH LAYER AND SOIL LAYER IS REQUIRED. MAINTENANCE OF OF MULCH AND SOIL IS LIMITED TO CORRECTING AREAS OF EROSION OR WASH OUT. ANY MULCH REPLACEMENT SHALL BE DONE IN THE SPRING. PLANT MATERIAL SHALL BE CHECKED FOR DISEASE AND INSECT INFESTATION AND MAINTENANCE WILL ADDRESS DEAD MATERIAL AND PRUNING.
- SCHEDULE OF PLANT INSPECTION WILL BE TWICE A YEAR IN SPRING AND FALL THIS INSPECTION WILL INCLUDE REMOVAL OF DEAD AND DISEASED VEGETATION CONSIDER BEYOND TREATMENT. TREATMENT OF ALL DISEASED TREES AND SHRUBS AND REPLACEMENT OF ALL DEFICIENT STAKES AND WIRES. MULCH SHALL BE INSPECTED EACH SPRING. REMOVE PREVIOUS MULCH LAYER BEFORE
- APPLYING NEW LAYER ONCE EVERY 2 TO 3 YEARS. D. SOIL EROSION TO BE ADDRESSED ON AN AS NEEDED BASIS. WITH A MINIMUM OF ONCE PER MONTH AND AFTER HEAVY STORM EVENTS.

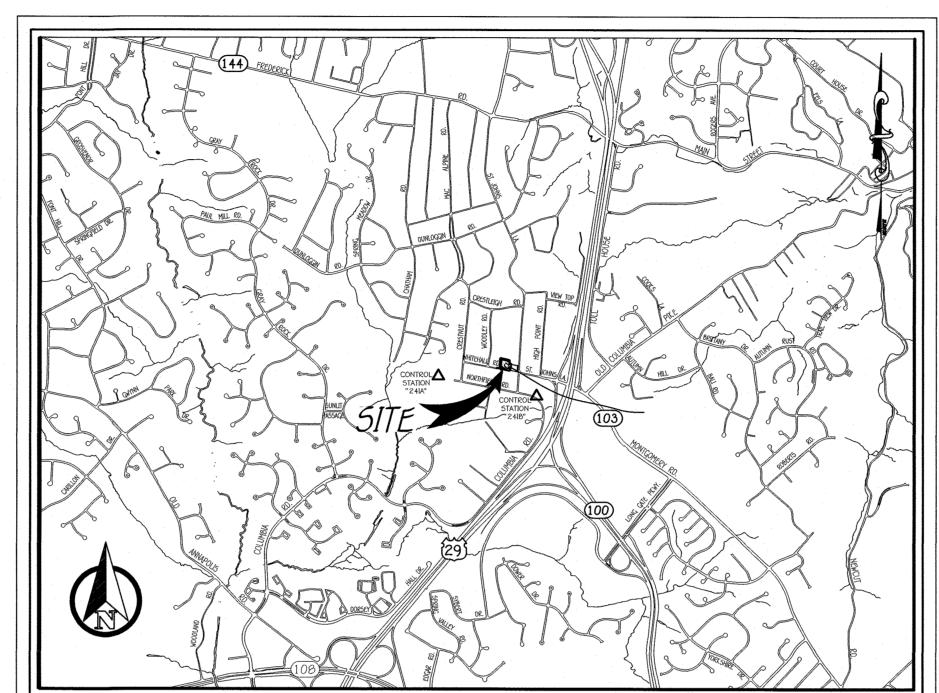

4" PERFORATED PIPE/GRAVEL NO GEOTEXTILE—NO G NOTE: 6" FB FOR QIOU TO ENTER STAND PIPES FACILITY NO. | A | B F-6 (1) | 393.00 | 391.30 NO SCALE * Consult pipe manufacturar for number and size of perforations per L.f. of pipe

GROSS AREA = 0.875 ACRES


EL = 394.7 = TOP OF EMB.


LOD = 0.463 ACRES

TARGET Pe = 1.0°

RCN = 78.0

Material	Specification	Size	Notes
Plantings	see Appendix A; Table A.4	n/a	plantings are site-specific
Planting soil [2' to 4' deep]	loamy sand 60-65% compost 35-40% or sandy loam 30%		USDA soil types loamy sand or sandy loam; clay content <5%
	coarse sand 30% compost 40%		
Organic Content	Min. 10% by dry weight (ASTM D 2974)		
Mulch	shredded hardwood		aged 6 months, minimum
Pea gravel diaphragm	ped gravel: ASTM-D-440	No. 0 or No. 9 (1/8" to 3/8")	
Curtain drain	ornamental stone: washed cobbles	stone: 2" to 5"	
Geotextile		n/a	PE Type 1 nonwoven
Grāvel (underdrāins ānd infiltrātion berms)	AASHTO M-43	No. 57 or No. 7 Aggregāțe (3/8" †o 3/4")	
Underdrain piping	F 750, Type P5 20 or AA5HTO M-270	4" to 6" rigid schedule 40 PVC or 5DR35	Slotted or perforated pipe; 3/8" pert. © 6" on center. 4 holes per row; minimum of 3" of gravel over pipes; not necessary underneath pipes. Perforated pipe shall be wrapped with 1/4 inch galvanized hardware cloth
Poured in place concrete (if required)	MSHA Mix No. 3; f = 3500 psi at 20 days, normal weight, air-entrained; reinforcing to meet ASTM-615-60	n.ā	on-site testing of poured-in-place concrete required: 20 day strength and slump test; all concrete design (cast-in-place or pre-cast) not using previously approved 5tate or local standards requires design drawings sealed and approved by a professional structural engineer licensed in the 5tate of Maryland — design to include meeting ACI Code 350.R/99; vertical loading [H-10 or H-201; allowable horizontal loading (based on soil pressures); and analysis of potential cracking
5and	AASHTO-M-6 or ASTM-C-33	0.02" to 0.04"	Sand substitutions such as Diabase and Graystone (AASHTO) #10 are not acceptable. No calcium carbonated or dolomitic sand substitutions are acceptable. No "rock dust" can be used for sand.

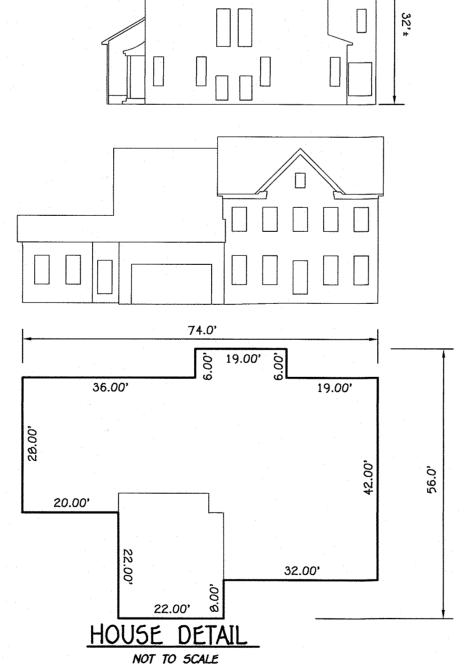

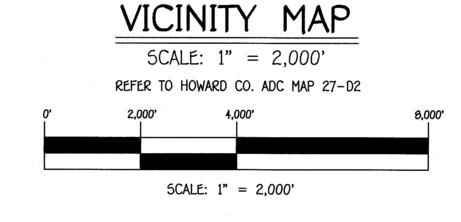

SITE ANALYSIS DATA CHART

TOTAL IMPERVIOUS AREA = 0.14 AC±

TOTAL PARKING REQUIRED: 2 SPACES

TOTAL PARKING PROVIDED: 4 SPACES

TOTAL AREA OF ERODIBLE SOILS = 0.88 AC. ±

TOTAL AREA OF ROAD DEDICATION = 0.00 AC. ±

TOTAL AREA OF THIS SUBMISSION = 0.875 AC.± (LOT 2)

LIMIT OF DISTURBED AREA = 20,163.5 SQ.FT. OR 0.463 Ac. ± PRESENT ZONING DESIGNATION = R-20(PER 10/06/2013 COMPREHENSIVE ZONING PLAN) PROPOSED USE: RESIDENTIAL (ONE SINGLE FAMILY DETACHED DWELLING PREVIOUS HOWARD COUNTY FILES: ECP-16-057, F-17-021, WP-17-057 TOTAL AREA OF FLOODPLAIN LOCATED ON-SITE = 0.00 AC± TOTAL AREA OF MODERATE STEEP SLOPES: 15%-24.9% = 0.00 AC± TOTAL AREA OF STEEP SLOPES: 25% OR GREATER = 0.00 AC± TOTAL AREA OF WETLANDS (INCLUDING BUFFER) = 0.00 AC. ± TOTAL AREA OF STREAM (INCLUDING BUFFER) = 0.00 AC. ± TOTAL AREA OF EXISTING FOREST = 0.00 AC± TOTAL AREA OF FOREST TO BE RETAINED = 0.00 AC± TOTAL AREA OF LOTS / BUILDABLE PARCELS = 0.794 AC± TOTAL GREEN OPEN AREA = 0.65 AC±

14. PROVISIONS SHALL BE MADE TO MINIMIZE 1/2" PREFORMED EXPANSION JOINT IF EXISTING CURB IS TO BE REMOVED (TYPICAL) COMPACTED SUB-BASE -MODIFIED COMBINATION CURB AND GUTTER 7" COMBINATION CURB AND GUTTER RESIDENTIAL DRIVEWAY ENTRANCE Department of Public Works Closed Section Roadway Approved: Oromas E. Butle
Chief, Bureau of Engineering without Sidewalk BUILDER OWNER TIMBERLAKE HOMES, INC. HONRAO ABHIJIT 304 HARRY 5. TRUMAN PARKWAY 4060 ST. JOHN'S LANE

ANNAPOLIS, MD 21401

(443-618-2643)

CONCRETE FOOT PLATE DRY WELL DETAIL NOT TO SCALE

SUBJECT PROPERTY ZONED R-20 PER 10/06/13 COMPREHENSIVE ZONING PLAN.

A). WIDTH - 12 FEET (16 FEET SERVING MORE THAN ONE RESIDENCE);

G). MAINTENANCE - SUFFICIENT TO ENSURE ALL WEATHER USE.

Sta. 241B N 578,753.501 E 1,362,302,987

F). STRUCTURE CLEARANCE - MINIMUM 12 FEET;

10. NO DWELLINGS OR HISTORIC STRUCTURES EXIST ON LOT 2.

16.1202(B)(1)(VII) OF THE SUBDIVISION REGULATIONS.

19. A SPEED STUDY WAS NOT REQUIRED FOR THIS SITE.

MSHA STANDARDS AND SPECIFICATIONS IF APPLICABLE.

HOWARD COUNTY, DEPT. OF PUBLIC WORKS, BUREAU OF UTILITIES

COMMENTS FOR PROCESSING OF FINAL PLAN, F-17-021

CONTRACT NO. 10-W and 129-5).

PLACEMENT OF ANY ASPHALT.

STATE HIGHWAY ADMINISTRATION

BGE(CONTRACTOR SERVICES)

COLONIAL PIPELINE COMPANY

BGE(UNDERGROUND DAMAGE CONTROL)

HOWARD COUNTY HEALTH DEPARTMENT

R-6.05

ELLICOTT CITY, MD 21042

12. SITE IS NOT ADJACENT TO A SCENIC ROAD.

TATIONS NO. 24IA AND NO. 24IB.

5ta. 24IA N 579,167.044

4. B.R.L. DENOTES BUILDING RESTRICTION LINE

ALL AREAS ARE MORE OR LESS (\pm) .

COORDINATES BASED ON NAD '83, MARYLAND COORDINATE SYSTEM AS PROJECTED BY HOWARD COUNTY GEODETIC CONTROL

DRIVEWAYS SHALL BE PROVIDED PRIOR TO ISSUANCE OF A USE AND OCCUPANCY PERMIT FOR ANY NEW DWELLINGS TO ENSURE

3. THIS PLAN IS BASED ON FIELD RUN MONUMENTED BOUNDARY SURVEY PERFORMED ON OR ABOUT MARCH, 2016 BY NJR &

DISTANCES SHOWN ARE BASED ON SURFACE MEASUREMENT AND NOT REDUCED TO NAD '83 GRID MEASUREMENT.

B). SURFACE - SIX (6") INCHES OF COMPACTED CRUSHER RUN BASE WITH TAR AND CHIP COATING.

C). GEOMETRY - MAXIMUM 15% GRADE, MAXIMUM 10% GRADE CHANGE AND 45-FOOT TURNING RADIUS; D). STRUCTURES (CULVERTS/BRIDGES) - CAPABLE OF SUPPORTING 25 GROSS TONS (H25-LOADING);

E). DRAINAGE ELEMENTS - CAPABLE OF SAFELY PASSING 100 YEAR FLOOD WITH NO MORE THAN 1 FOOT

PROPERTY SUBJECT TO PRIOR DEPARTMENT OF PLANNING AND ZONING FILE NO'S: PLAT BOOK 7, PAGE 4, ECP-16-057,

9. NO CEMETERIES EXIST ON THE SUBJECT PROPERTY BASED ON VISUAL OBSERVATION OR LISTED IN AVAILABLE HOWARD COUNTY

14. WATER AND SEWER SERVICE TO THESE LOTS WILL BE GRANTED UNDER THE PROVISIONS OF SECTION 10.1228 OF THE HOWAR

15. PUBLIC WATER AND SEWER ALLOCATION WILL BE GRANTED AT THE TIME OF ISSUANCE OF THE BUILDING PERMIT IF CAPACITY

16. STORMWATER MANAGEMENT IS IN ACCORDANCE WITH THE M.D.E. STORM WATER DESIGN MANUAL. VOLUMES I & IL REVISED 2009

17. THIS PLAN IS IN COMPLIANCE WITH THE AMENDED FIFTH EDITION OF THE SUBDIVISION AND LAND DEVELOPMENT REGULATIONS PER COUNCIL BILL 45-2003 AND THE 10/06/13 COMPREHENSIVE ZONING PLAN. DEVELOPMENT OR CONSTRUCTION ON THESE LOTS MUST COMPLY WITH SETBACK AND BUFFER REGULATIONS IN EFFECT AT THE TIME OF SUBMISSION OF THE SITE

18. LANDSCAPING IS PROVIDED IN ACCORDANCE WITH SECTION 16.124 OF THE HOWARD COUNTY CODE AND THE LANDSCAPE

20. THIS PROPERTY IS LOCATED WITHIN THE METROPOLITAN DISTRICT AND WILL BE SERVED BY PUBLIC WATER AND SEWER (SEE

21. ALL CONSTRUCTION SHALL BE IN ACCORDANCE WITH THE LATEST STANDARDS AND SPECIFICATIONS OF HOWARD COUNTY PLUS

22. THE CONTRACTOR SHALL NOTIFY THE DEPARTMENT OF PUBLIC WORKS/BUREAU OF ENGINEERING/CONSTRUCTION INSPECTION

23. THE CONTRACTOR SHALL NOTIFY "MISS UTILITY" AT 1-000-257-7777 AT LEAST 40 HOURS PRIOR TO ANY EXCAVATION WORK 24. TRAFFIC CONTROL DEVICES, MARKINGS AND SIGNING SHALL BE IN ACCORDANCE WITH THE LATEST EDITION OF THE MANUAL OF UNIFORM TRAFFIC CONTROL DEVICES (MUTCD). ALL STREET AND REGULATORY SIGNS SHALL BE IN PLACE PRIOR TO THE

25. DRIVEWAY SHALL BE PROVIDED IN ACCORDANCE WITH HOWARD COUNTY STANDARD DETAIL R-6.06 IN THE VOL. IV DESIGN

29. ANY DAMAGE TO PUBLIC RIGHT-OF WAYS, PAVING OR EXISTING UTILITIES WILL BE CORRECTED AT THE CONTRACTOR'S EXPENSE.

2016 AND SUPPLEMENTED WITH HOWARD COUNTY GIS TOPOGRAPHY AT 2' CONTOUR INTERVAL

32. SEWER HOUSE CONNECTION (SHC) ELEVATIONS ARE LOCATED AT THE PROPERTY LINE.

27. IN ACCORDANCE WITH SECTION 128 (0)(A)(1)(E)OF THE HOWARD COUNTY ZONING REGULATIONS, BAY WINDOWS, CHIMNEYS OR EXTERIOR STAIRWAYS NOT MORE THAN 16 FEET IN WIDTH MAY PROJECT NOT MORE THAN 4 FEET INTO ANY SETBACKS,

PORCHES OR DECKS, OPEN OR ENCLOSED MAY PROJECT NOT MORE THAN 10 FEET INTO THE FRONT OR REAR YARD SETBACK. 26. THE CONTRACTOR SHALL NOTIFY THE FOLLOWING UTILITY COMPANIES OR AGENCIES AT LEAST FIVE (5) WORKING DAYS BEFORE STARTING WORK

THE EXISTING TOPOGRAPHY SHOWN HEREON IS BASED ON A TOPOGRAPHIC SURVEY PERFORMED BY NJR ASSOCIATES IN MAY,

33. MAINTAIN 10 FEET OF SEPARATION BETWEEN THE WATER HOUSE CONNECTION (WHC) AND THE SEWER HOUSE CONNECTION (SHC)

31. EXISTING UTILIZES ARE BASED ON FIELD LOCATION OF VISIBLE STRUCTURES AND SUPPLEMENTED WITH HOWARD COUNTY GIS

34. THE PLANNING DIRECTOR ON JANUARY 28, 2017 APPROVED THE REQUEST FOR AN ALTERNATIVE COMPLIANCE OF SECTION

16.127(c)(4)(i), WHICH REQUIRES A LIMIT ON ADJOINING DRIVEWAYS, SUBJECT TO COMPLIANCE WITH THE SRC AGENCY

410.850.4620

410,787,9068

410.795.1390

410.313.2640 1.800.252.1133

1.800.743.0033/410.224.9210

ESD PRACTICES IN ACCORDANCE WITH CHAPTER 5 AND AND QUANTITY MANAGEMENT PRACTICES IN ACCORDANCE WITH CHAPTER

FACILITY. THIS CHAMBER RETAINS THE 100-YEAR STORM MANAGEMENT VOLUME FOR THE SITE AND STORES THE 500-YEAR VOLUME (0.51

MANUAL. A LANDSCAPE SURETY IN THE AMOUNT OF \$2,700.00 BASED ON (4) SHADE TREES @ \$300/SHADE TREE AND (10) EVERGREEN TREES @ \$150/EVERGREEN TREE WILL BE BONDED WITH THE BUILDING/GRADING PERMIT.

3 ARE BEING UTILIZED. QUANTITY MANAGEMENT IS ACHIEVED BY USE OF A STONE RESERVOIR CHAMBER BELOW THE MICRO-BIORETENTION

11. THERE ARE NO FOREST STANDS, WETLANDS, WETLAND BUFFER, STREAM, STREAM BUFFER, STEEP SLOPES AND FLOODPLAIN

13. THIS PROJECT IS EXEMPT FROM THE REQUIREMENTS OF THE FOREST CONSERVATION ACT IN ACCORDANCE WITH SECTION

INCHES) OVER NEW IMPERVIOUS AREAS.". THIS SITE IS LOCATED WITHIN THE PLUMTREE WATERSHED.

DIVISION AT (410) 313-1860 AT LEAST FIVE (5) WORKING DAYS PRIOR TO THE START OF WORK.

DEVELOPMENT PLAN, WAIVER PETITION APPLICATION, OR BUILDING/GRADING PERMIT.

26. SOILS INFORMATION BASED ON NRCS WEB SOIL SURVEY FOR HOWARD COUNTY, MARYLAND.

SAFE ACCESS FOR FIRE AND EMERGENCY VEHICLES PER THE FOLLOWING (MINIMUM) REQUIREMENTS:

Elev.= 390.560

(2 GARAGES SPACES + 2 DRIVEWAY SPACES) APPROVED: DEPARTMENT OF PLANNING AND ZONING

FISHER, COLLINS & CARTER, INC. CIVIL ENGINEERING CONSULTANTS & LAND SURVEYOR

DATE

PROFESSIONAL CERTIFICATION HEREBY CERTIFY THAT THESE DOCUMENTS WERE PREPARED OR APPROVED BY ME AND THAT I AM A DULY LICENSED PROFESSIONAL LAND SURVEYOR UNDER THE LAWS OF THE

STATE OF MARYLAND, LICENSE NO. 21476, EXPIRATION DATE: 07/14/2023

BUILDER'S CERTIFICATE "I/WE CERTIFY THAT ALL DEVELOPMENT AND CONSTRUCTION WILL BE DONE ACCORDING TO THIS PLAN, FOR SEDIMENT AND EROSION CONTROL DEPARTMENT OF THE ENVIRONMENT APPROVED TRAINING PROGRAM FOR THE CONTROL OF SEDIMENT AND EROSION BEFORE BEGINNING THE

25791

Chief, Division of Land Development Director - Department of Planning and Zoning 9-14-21 PARCEL NO. HONRAO'S PROPERTY, LOT 2 270 CENSUS TR. ZONE TAX MAP # ELEC. DIST. 23 SECOND

TITLE SHEET


PLAT#: F-17-021 / DEED# 16606/164

HONRAO'S PROPERTY,

LOT 2, 9100 WHITEHALL ROAD

ZONED R-20 TAX MAP No. 24 GRID No. 23 PARCEL No. 270 SECOND ELECTION DISTRICT HOWARD COUNTY, MARYLAND SCALE: AS SHOWN DATE: MAY, 2021

> SHEET 1 OF 3 5DP-20-064

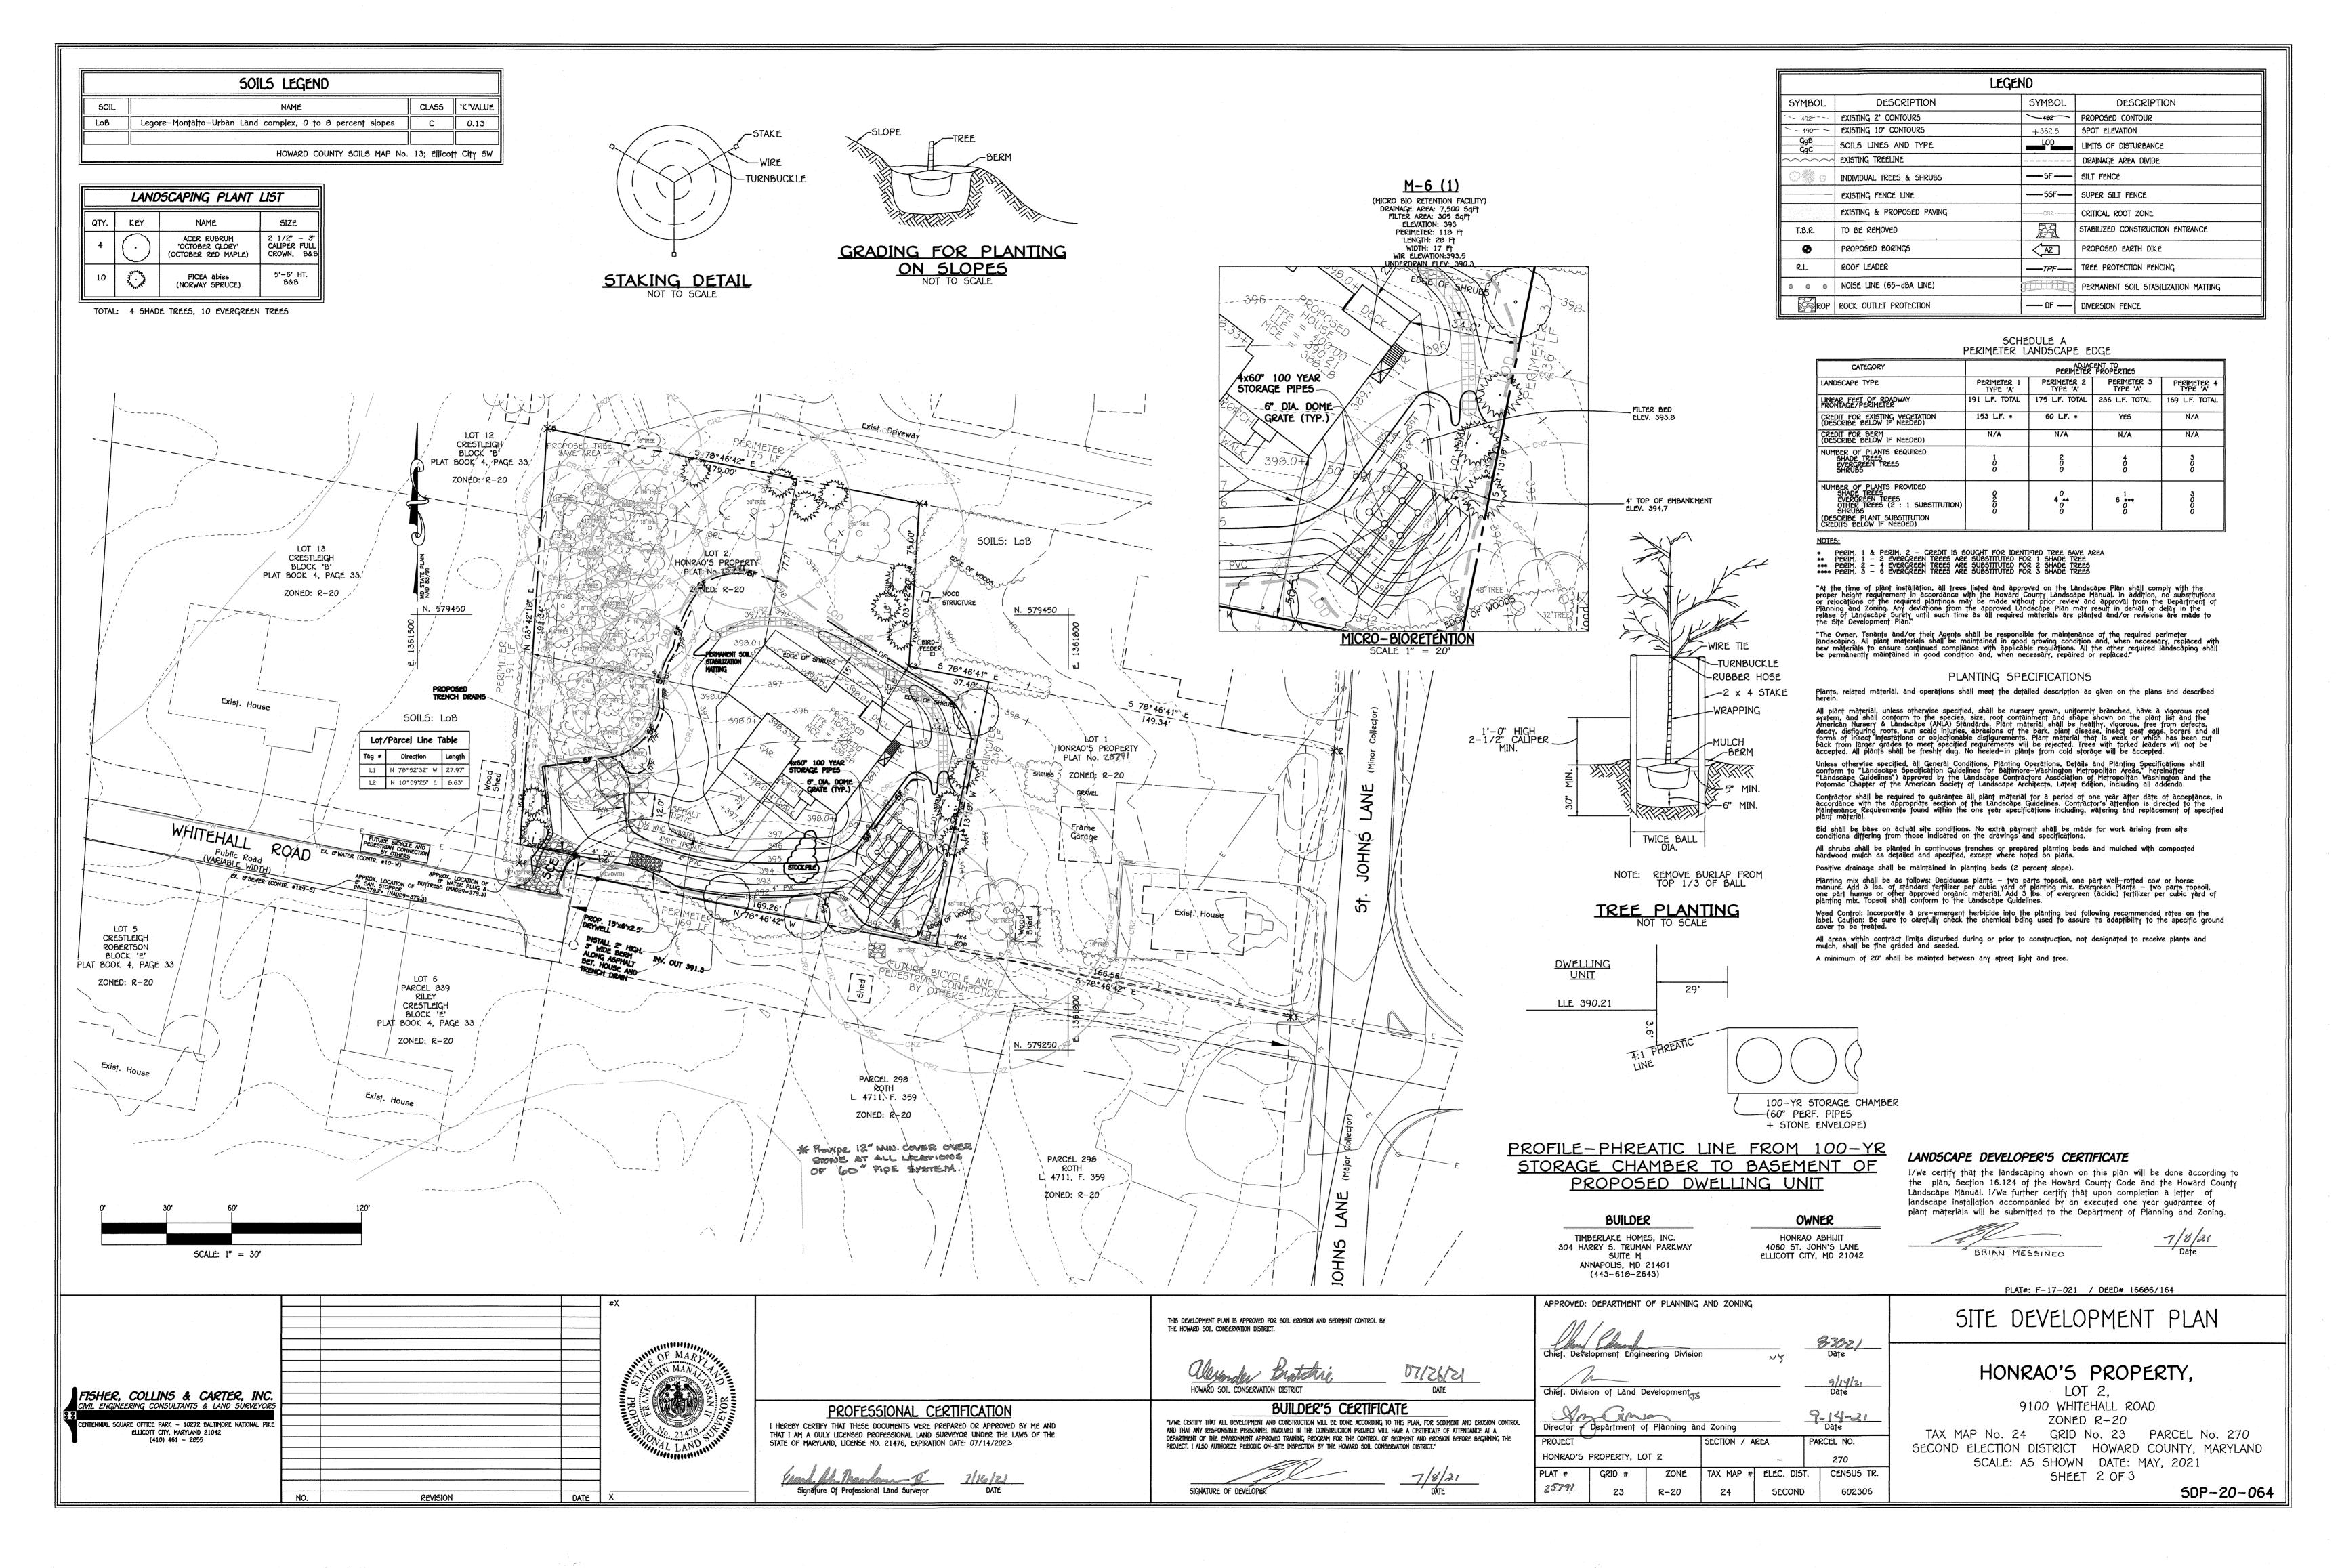

SOIL PREPARATION, TOPSOILING AND SOIL AMENDMENTS (B-4-2)

A. Soil Preparation

1. Temporary Stabilizatio

a. Seedbed preparation consists of loosening soil to a depth of 3 to 5 inches by means of suitable agricultural or construction equipment, such as disc harrows or chisel plows or rippers mounted on construction equipment. After the soil is loosened, it must not be rolled or dragged smooth but left in the roughened condition. Slopes 3:1 or latter are to be tracked with ridges running parallel to the contour of the slope. b. Apply fertilizer and lime as prescribed on the plans.

c. Incorporate lime and fertilizer into the top 3 to 5 inches of soil by disking or other suitable means.

2. Permanent Stabilization a. A soil test is required for any earth disturbance of 5 acres or more. The minimum soil conditions required for permanent vegetative establishment are:

Soil of between 6.0 and 7.0. . Soluble salts less than 500 parts per million (ppm).

scarified or otherwise loosened to a depth of 3 to 5 inches.

iii. Soil contains less than 40 percent clay but enough fine grained material (greater than 30 percent silt plus clay) to provide the capacity to hold a moderate amount of moisture. An exception: if lovegrass will be planted, then a sandy soil (less than 30 percent silt plus clay) would be acceptable.

iv. Soil contains 1.5 percent minimum organic matter by weight. v. Soil contains sufficient pore space to permit adequate root penetration

b. Application of amendments or topsoil is required if on-site soils do not meet the above conditions. c. Graded areas must be maintained in a true and even grade as specified on the approved plan, then

d. Apply soil amendments as specified on the approved plan or as indicated by the results of a soil test. e. Mix soil amendments into the top 3 to 5 inches of soil by disking or other suitable means. Rake lawn area to smooth the surface, remove large objects like stones and branches, and ready the area for seed application. Loosen surface soil by dragging with a heavy chain or other equipment to roughen the surface where site conditions will not permit normal seedbed preparation. Track slopes 3:1 or flatter with tracked equipment leaving the soil in an irregular condition with ridges running parallel to the contour of the slope. Leave the top 1 to 3 inches of soil loose and friable. Seedbed loosening may be unnecessary on newly disturbed areas.

B. Topsoiling

1. Topsoil is placed over prepared subsoil prior to establishment of permanent vegetation. The purpose is to provide a suitable soil medium for vegetative growth. Soils of concern have low moisture content, low nutrient levels, low pH,

2. Topsoil salvaged from an existing site may be used provided it meets the standards as set forth in these specifications. Typically, the depth of topsoil to be salvaged for a given soil type can be found in the representative soil profile section in the Soil Survey published by USDA-NRCS.

3. Topsoiling is limited to areas having 2:1 or flatter slopes where:

a. The texture of the exposed subsoil/parent material is not adequate to produce vegetative growth.

b. The soil material is so shallow that the rooting zone is not deep enough to support plants or furnish continuing

c. The original soil to be vegetated contains material toxic to plant growth.

d. The soil is so acidic that treatment with limestone is not feasible.

4. Areas having slopes steeper than 2:1 require special consideration and design.

5. Topsoil Specifications: Soil to be used as topsoil must meet the following criteria:

a. Topsoil must be a loam, sandy loam, clay loam, silt loam, sandy clay loam, or loamy sand. Other soils may be used if recommended by an agronomist or soil scientist and approved by the appropriate approval authority. Topsoil must not be a mixture of contrasting textured subsoils and must contain less than 5 percent by volume of cinders. stones, slag, coarse fragments, gravel, sticks, roots, trash, or other materials larger than 1 1/2 inches in diameter b. Topsoil must be free of noxious plants or plant parts such as Bermuda grass, quack grass, Johnson grass, nut sedge, poison ivy, thistle, or others as specifie

c. Topsoil substitutes or amendments, as recommended by a qualified agronomist or soil scientist and approved by the appropriate approval authority, may be used in lieu of natural topsoil

6. Topsoil Application

a. Erosion and sediment control practices must be maintained when applying topsoil.

Uniformly distribute topsoil in a 5 to 8 inch layer and lightly compact to a minimum thickness of 4 inches. Spreading is to be performed in such a manner that sodding or seeding can proceed with a minimum of additional soil preparation and tillage. Any irregularities in the surface resulting from topsoiling or other operations must be corrected in order to prevent the formation of depressions or water pockets

c. Topsoil must not be placed if the topsoil or subsoil is in a frozen or muddy condition, when the subsoil is excessively wet or in a condition that may otherwise be detrimental to proper grading and seedbed preparation.

C. Soil Amendments (Fertilizer and Lime Specifications)

1. Soil tests must be performed to determine the exact ratios and application rates for both lime and fertilizer on sites having disturbed areas of 5 acres or more. Soil analysis may be performed by a recognized private or commercial laboratory. Soil samples taken for engineering purposes may also be used for chemical analyses 2. Fertilizers must be uniform in composition, free flowing and suitable for accurate application by

approval authority. Fertilizers must all be delivered to the site fully labeled according to the applicable 3. Lime materials must be ground limestone (hydrated or burnt lime may be substituted except when hydroseeding which contains at least 50 percent total oxides (calcium oxide plus magnesium oxide). Limestone must be ground to

appropriate equipment. Manure may be substituted for fertilizer with prior approval from the appropriate

such fineness that at least 50 percent will pass through a #100 mesh sieve and 90 to 100 percent will pass

through a #20 mesh sieve. 4. Lime and fertilizer are to be evenly distributed and incorporated into the top 3 to 5 inches of soil by disking or

5. Where the subsoil is either highly acidic or composed of heavy clays, spread ground limestone at the rate of 4 to 8 tons/acre (200-400 pounds per 1,000 square feet) prior to the placement of topsoil.

B-4-3 STANDARDS AND SPECIFICATIONS FOR SEEDING AND MULCHING

The application of seed and mulch to establish vegetative cover.

To protect disturbed soils from erosion during and at the end of construction

Conditions Where Practice Applies To the surface of all perimeter controls, slopes, and any disturbed area not under active grading

A. Seeding 1. Specifications

a. All seed must meet the requirement of the Maryland State Seed Law. All seed must be subject to re-testing by a recognized seed laboratory. All seed used must have been tested within the 6 months immediately preceding the date of sowing such material on any project. Refer to Table B.4 regarding the quality of seed. Seed tags must be available upon request to the inspector to verify type of

b. Mulch alone may be applied between the fall and spring seeding dates only if the ground is frozen. The appropriate seeding mixture c. Inoculants: The inoculant for treating legume seed in the seed mixtures must be a pure culture of nitrogen fixing bacteria prepared specifically for the species. Inoculants must not be used later than the date indicated on the container. Add fresh inoculants as

directed on the package. Use four times the recommended rate when hydroseeding. Note: It is very important to keep inoculant as cook as possible until used. Temperatures above 75 to 80 degrees Fahrenheit can weaken bacteria and make the inoculant less d. Sod or seed must not be placed on soil which has been treated with soil sterilants or chemicals used for weed control until sufficient

time has elapsed (14 days min.) to permit dissipation of phyto-toxic materials. 2. Application

a. Dry Seeding: This includes use of conventional drop or broadcast spreaders. Incorporate seed into the subsoil at the rates prescribed on Temporary Seeding Table B.1, Permanent Seeding Table B.3, or

site—specific seeding summaries. ii. Apply seed in two directions, perpendicular to each other. Apply half the seeding rate in each direction. Roll the seeded area with

weighted roller to provide good seed to soil contact.

b. Drill or Cultipacker Seeding: Mechanized seeders that apply and cover seed with soil. Cultipacking seeders are required to bury the seed in such a fashion as to provide at least 1/4 inch of soil covering. Seedbed must

Apply seed in two directions, perpendicular to each other. Apply half the seeding rate in each direction. c. Hydroseeding: Apply seed uniformly with hydroseeder (slurry includes seed and fertilizer).

If fertilizer is being applied at the time of seeding, the application rates should not exceed the following: nitrogen, 100 pounds per acre total of soluble nitrogen; P 0 (phosphorus), 200 pounds per acre; K 0 (potassium), 200 pounds per acre. ii. Lime: Use only ground agricultural limestone (up to 3 tons per acre may be applied by hydroseeding). Normally, not more than 2 tons

are applied by hydroseeding at any one time. Do not use burnt or hydrated lime when hydroseeding iii. Mix seed and fertilizer on site and seed immediately and without interruption.

iv. When hydroseeding do not incorporate seed into the soil. . Mulch Materials (in order of preference)

a. Straw consisting of thoroughly threshed wheat, rye, oat, or barley and reasonably bright in color. Straw is to be free of noxious weed seeds as specified in the Maryland Seed Law and not musty, moldy, caked, decayed, or excessively dusty. Note: Use only sterile straw mulch in areas where one species of grass is desired. b. Wood Cellulose Fiber Mulch (WCFM) consisting of specially prepared wood cellulose processed into uniform fibrous physical state. i. WCFM is to be dyed green or contain a green dye in the package that will provide an appropriate color to facilitate visual inspection

ii. WCFM, including dye, must contain no germination or growth inhibiting factors. iii. WCFM materials are to be manufactured and processed in such a manner that the wood cellulose fiber mulch will remain in uniform suspension in water under agitation and will blend with seed, fertilizer and other additives to form a homogeneous slurry. The mulch material must form a blotter—like ground cover, on application, having moisture absorption and percolation properties and must cover

and hold grass seed in contact with the soil without inhibiting the growth of the grass seedlings. iv. WCFM material must not contain elements or compounds at concentration levels that will by phyto-toxic v. WCFM must conform to the following physical requirements: fiber length of approximately 10 millimeters, diameter approximately millimeter, pH range of 4.0 to 8.5, ash content of 1.6 percent maximum and water holding capacity of 90 percent minimum.

a. Apply mulch to all seeded areas immediately after seeding.
b. When straw mulch is used, spread it over all seeded areas at the rate of 2 tons per acre to a uniform loose depth of 1 to 2 inches. Apply mulch to achieve a uniform distribution and depth so that the soil surface is not exposed. When using a mulch

anchoring tool, increase the application rate to 2.5 tons per acre. c. Wood cellulose fiber used as mulch must be applied to a net dry weight of 1500 pounds per acre. Mix the wood cellulose fiber with water to attain a mixture with a maximum of 50 pounds of wood cellulose fiber per 100 gallons of water.

a. Perform mulch anchoring immediately following application of mulch to minimize loss by wind or water. This may be done by one of the following methods (listed by preference), depending upon the size of the area and erosion hazard:

i. A mulch anchoring tool is a tractor drawn implement designed to punch and anchor mulch into the soil surface a minimum of 2 inches. This practice is most effective on large areas, but is limited to flatter slopes where equipment can operate safely. If used on sloping land, this practice should follow the contour. ii. Wood cellulose fiber may be used for anchoring straw. Apply the fiber binder at a net dry weight of 750 pounds per acre. Mix the

wood cellulose fiber with water at a maximum of 50 pounds of wood cellulose fiber per 100 gallons of water. iii. Synthetic binders such as Acrylic DLR (Agro-Tack). DCA-70. Petroset, Terra Tax II. Terra Tack AR or other approved equal may be used. Follow application rates as specified by the manufacturer. Application of liquid binders needs to be heavier at the edges where wind catches mulch, such as in valleys and on crests of banks. Use of asphalt binders is strictly prohibited.

v. Lightweight plastic netting may be stapled over the mulch according to manufacturer recommendations. Netting is usually available in rolls 4—15 feet wide and 300 to 3,000 feet long.

TEMPORARY SEEDING NOTES (B-4-4)

Definition

To stabilize disturbed soils with vegetation for up to 6 months.

To use fast growing vegetation that provides cover on disturbed soils.

Conditions Where Practice Applies

Exposed soils where ground cover is needed for a period of 6 months or less. For longer duration of time, permanent stabilization practices are required.

1. Select one or more of the species or seed mixtures listed in Table 8.1 for the appropriate Plant Hardiness Zone (from Figure B.3), and enter them in the Temporary Seeding Summary below along with application rates, seeding dates and seeding depths. If this Summary is not put on the plan and completed, then Table 8.1 plus fertilizer and lime rates must be put on the plan

2. For sites having soil tests performed, use and show the recommended rates by the testing agency. Soil tests are not required for Temporary Seeding.

3. When stabilization is required outside of a seeding season, apply seed and mulch or straw mulch alone as prescribed in Section B-4-3.A.1.b and maintain until the next seeding season.

		Temporary Seeding	g Summary		
Hardiness Zon Seed Mixture	e (from Figure B. (from Table B.1):		Fertilizer Rate (10-20-20)	Lime Rațe	
Species	Application Rate (lb/ac)	Seeding Dates	Seeding Depths		
BARLEY	96	3/1 - 5/15,	1"	436 lb/ac	2 tons/ac
OAT5	72	8/15 - 10/15	1"	(10 lb/ 1000 sf)	(90 lb/ 1000 sf)
RYE	112		1"		

PERMANENT SEEDING NOTES (B-4-5) A. Seed Mixtures

1. General Use

Figure 8.3) and based on the site condition or purpose found on Table 8.2. Enter selected mixture(s), application rates, and seeding dates in the Permanent Seeding Summary. The Summary is to be placed on the plan. b. Additional planting specifications for exceptional sites such as shorelines, stream banks, or dunes or for special purposes such as wildlife or aesthetic treatment may be found in USDA-NRCS Technical Field Office Guide, Section 342 - Critical Area Planting.

c. For sites having disturbed area over 5 acres, use and show the rates recommended by the soil testing agency. d. For areas receiving low maintenance, apply urea form fertilizer (46-0-0) at 3 1/2 pounds per 1000 square feet (150 pounds per acre) at the time of seeding in addition to the soil amendments shown in the Permanent Seeding Summary

a. Areas where turfgrass may be desired include lawns, parks, playgrounds, and commercial sites which will receive a medium to high level of maintenance.

b. Select one or more of the species or mixtures listed below based on the site conditions or purpose. Enter selected mixture(s), application rates, and seeding dates in the Permanent Seeding Summary. The summary is to be placed on the plan.

i. Kentucky Bluegrass: Full Sun Mixture: For use in areas that receive intensive management. Irrigation required in the areas of central Maryland and Eastern Shore. Recommended Certified Kentucky Bluegrass Cultivars Seeding Rate: 1.5 to 2.0 pounds per 1000 square feet. Choose a minimum of three Kentucky bluegrass cultivars with each ranging from 10 to 35 percent of the total mixture by weight.

ii. Kentucky Bluegrass/Perennial Rye: Full Sun Mixture: For use in full sun areas where rapid establishment is necessary and when turf will receive medium to intensive management. Certified Perennial Ryegrass Cultivars/Certified Kentucky Bluegrass Seeding Rate: 2 pounds mixture per 1000 square feet. Choose a minimum of three Kentucky bluegrass cultivars with each ranging from 10 to 35 percent of the total mixture by weight

iii. Tall Fescue/Kentucky Bluegrass: Full Sun Mixture: For use in drought prone areas and/or for areas receiving low to medium management in full sun to medium shade. Recommended mixture includes; Certified Tall Fescue Cultivars 95 to 100 percent, Certified Kentucky Bluegrass Cultivars 0 to 5 percent. Seeding Rate: 5 to 8 pounds per 1000 square feet. One or more cultivars may be blended

iv. Kentucky Bluegrass/Fine Fescue: Shade Mixture: For use in areas with shade in Bluegrass lawns. For establishment in high quality, intensively managed turf area. Mixture includes: Certified Kentucky Bluegrass Cultivars 30 to 40 percent and Certified Fine Fescue and 60 to 70 percent. Seeding Rate: 1 1/2 to 3 pounds per 1000 square feet.

Select turfarass varieties from those listed in the most current University of Maryland Publication, Agronomy Memo #77, "Turfgrass Cultivar Recommendations for Maryland"

Choose certified material. Certified material is the best guarantee of cultivar purity. The certification program of the Maryland Department of Agriculture, Turf and Seed Section, provides a reliable means of consumer protection and assures a pure genetic line c. Ideal Times of Seeding for Turf Grass Mixtures Western MD: March 15 to June 1, August 1 to October 1 (Hardiness Zones: 5b, 6a) Central MD: March 1 to May 15, August 15 to October 15 (Hardiness Zone: 6b) Southern MD, Eastern Shore: March 1 to May 15, August 15 to October 15

d. Till areas to receive seed by disking or other approved methods to a depth of 2 to 4 inches, level and rake the areas to prepare a proper seedbed. Remove stones and debris over 1 1/2 inches in diameter The resulting seedbed must be in such condition that future moving of grasses will pose no difficulty. e. If soil moisture is deficient, supply new seedings with adequate water for plant growth (1/2 to 1 inch every 3 to 4 days depending on soil texture) until they are firmly established. This is especially true when seedings are made late in the planting season, in abnormally dry or hot seasons, or on adverse sites.

Permanent Seeding Summary

		e (from Figure B. (from Table B.3):		Fertilizer Rate (10-20-20)			Lime Rate	
о.	Species	Application Rate (lb/ac)	Seeding Dates	Seeding Depths	N	P ₂ O ₅	K ₂ 0	
В	TALL FESCUE	100	Mar. 1-May 15 Aug. 15-Oct. 15	1/4-1/2 in.	per acre	90 b/ac (2 b/	(2 lb/	2 tons/ac (90 lb/
					(1.0 lb/ 1000 sf)	1000 sf)	1000 sf)	1000 sf)

B. Sod: To provide quick cover on disturbed areas (2:1 grade or flatter).

a. Class of turfgrass sod must be Maryland State Certified. Sod labels must be made available to the job foreman and

b. Sod must be machine cut at a uniform soil thickness to 34 inch, plus or minus 14 inch, at the time of cutting. Measurement for thickness must exclude top growth and thatch. Broken pads and torn or uneven ends will not be

c. Standard size sections of sod must be strong enough to support their own weight and retain their size and shape when suspended vertically with a firm grasp on the upper 10 percent of the section. . Sod must not be harvested or transplanted when moisture content (excessively dry of wet) may adversely affect its survival. e. Sod must be harvested, delivered, and installed within a period of 36 hours. Sod not transplanted within this period must be approved by an agronomist or soil scientist prior to its installation.

5od Installation a. During periods of excessively high temperature or in areas having dry subsoil, lightly irrigate the subsoil immediately prior to

b. Lay the first row of sod in a straight line with subsequent rows placed parallel to it and tightly wedged against each other. Stagger lateral joints to promote more uniform growth and strength. Ensure that sod is not stretched or overlapped and that all joints are butted tight in order to prevent voids which would cause air drying of the roots. c. Wherever possible, lay sod with the long edges parallel to the contour and with staggering joints. Roll and tamp, peg or

otherwise secure the sod to prevent slippage on slopes. Ensure solid contact exists between sod roots and the underlying d. Water the sod immediately following rolling and tamping until the underside of the new sod pad and soil surface below the sod are thoroughly wet. Complete the operations of laying, tamping, and irrigating for any piece of sod within eight hours.

a. In the absence of adequate rainfall, water daily during the first week or as often and sufficiently as necessary to maintain moist soil to a depth of 4 inches. Water sod during the heat of the day to prevent wilting.

b. After the first week, sod watering is required as necessary to maintain adequate moisture conten c. Do not mow until the sod is firmly rooted. No more than 1/3 of the grass leaf must be removed by the initial cutting or

subsequent cuttings. Maintain a grass height of at least 3 inches unless otherwise specified. B-4-8 STANDARDS AND SPECIFICATIONS FOR STOCKPILE AREAS

A mound or pile of soil protected by appropriately designed erosion and sediment control measures

To provide a designated location for the temporary storage of soil that controls the potential for erosion, sedimentation, and changes to drainage patterns.

1. The stockpile location and all related sediment control practices must be clearly indicated on the erosion and sediment control plan. 2. The footprint of the stockpile must be sized to accommodate the anticipated volume of material and based on a side slope ratio no steeper than 2:1. Benching must be provided in accordance with Section B-3 Land Grading. 3. Runoff from the stockpile area must drain to a suitable sediment control practice 4. Access the stockpile area from the upgrade side.

5. Clear water runoff into the stockpile area must be minimized by use of a diversion device such as an earth dike, temporary swale or diversion fence. Provisions must be made for discharging concentrated flow in a non-erosive manner. 6. Where runoff concentrates along the toe of the stockpile fill, an appropriate erosion/sediment control practice must be used to 7. Stockpiles must be stabilized in accordance with the 3/7 day stabilization requirement as well as Standard B-4-1 Incremental Stabilization and Standard B-4-4 Temporary Stabilization. 8. If the stockpile is located on an impervious surface, a liner should be provided below the stockpile to facilitate cleanup. Stockpiles containing contaminated material must be covered with impermeable sheeting. Maintenance

The stockpile area must continuously meet the requirements for Adequate Vegetative Establishment in accordance with Section B-4 Vegetative Stabilization. Side slopes must be maintained at no steeper than a 2:1 ratio. The stockpile area must be kept free of erosion. If the vertical height of a stockpile exceeds 20 feet for 2:1 slopes, 30 feet for 3:1 slopes, or 40 feet for 4:1 slopes, benching must be provided in accordance with Section B-3 Land Grading

HOWARD SOIL CONSERVATION DISTRICT STANDARD SEDIMENT CONTROL NOTES

1. A pre-construction meeting must occur with the Howard County Department of Public Works, Construction Inspection Division (CID), 410-313-1855 after the future LOD and protected areas are marked clearly in the field. A minimum of 40 hour notice to CID must be given at the following stages:

a. Prior to the start of earth disturbance. b. Upon completion of the installation of perimeter erosion and sediment controls, but before

proceeding with any other earth disturbance or grading, Prior to the start of another phase of construction or opening of another grading unit,

d. Prior to the removal or modification of sediment control practices. Other building or grading inspection approvals may not be authorized until this initial approval by the inspection agency is made. Other related state and federal permits shall be referenced, to ensure coordination and to avoid conflicts with this plan.

2. All vegetative and structural practices are to be installed according to the provisions of this plan and are to be in conformance with the 2011 MARYLAND STANDARDS AND SPECIFICATIONS FOR SOIL EROSION AND SEDIMENT CONTROL. and revisions thereto.

3. Following initial soil disturbance or re-disturbance, permanent or temporary stabilization is required within three (3) calendar days as to the surface of all perimeter controls, dikes, swales, ditches, perimeter slopes, and all slopes steeper than 3 horizontal to 1 vertical (3:1); and seven (7) calendar days as to all other disturbed areas on the project site except for those areas under active grading.

4. All disturbed areas must be stabilized within the time period specified above in accordance with the 2011 MARYLAND STANDARDS AND SPECIFICATIONS FOR SOIL EROSION AND SEDIMENT CONTROL for topsoil (Sec. B-4-2), permanent seeding (Sec. B-4-5), temporary seeding (Sec. B-4-4) and mulching (Sec. B-4-3). Temporary stabilization with mulch alone can only be applied between the fall and spring seeding dates if the ground is frozen. Incremental stabilization (Sec. B-4-1) specifications shall be enforced in areas with >15 of cut and/or fill. Stockpiles (Sec. B-4-0) in excess

areas shall receive soil stabilization matting (Sec. B-4-6). . All sediment control structures are to remain in place, and are to be maintained in operative condition until permission for their removal has been obtained from the CID.

of 20 ft. must be benched with stable outlet. All concentrated flow, steep slope, and highly erodible

Site Analysis: Total Area of Site: 0.875 Acres Area Disturbed: 0.463 Acres Area to be roofed or paved: 0.14 Acres Area to be vegetatively stabilized: 0.53 Acres

Total Cut: 350 Cu. Yds Total Fill: 700 Cu. Yds

7. Offsite waste/borrow area location: N/A 8. Any sediment control practice which is disturbed by grading activity for placement of utilities must be repaired on the same day of disturbance.

controls shall be inspected by the contractor weekly; and the next day after each rain event. A written report by the contractor, made available upon request, is part of every inspection and should include: Inspection date Inspection type (routine, pre-storm event, during rain event) Name and title of inspector Weather information (current conditions as well as time and amount of last recorded

9. Additional sediment control must be provided, if deemed necessary by the CID. The site and all

Brief description of project's status (e.g., percent complete) and/or current activities Evidence of sediment discharges Identification of plan deficiencies Identification of sediment controls that require maintenance

Identification of missing or improperly installed sediment controls Compliance status regarding the sequence of construction and stabilization requirements Photographs

Monitoring/sampling Maintenance and/or corrective action performed Other inspection items as required by the General Permit for Stormwater Associated with Construction Activities (NPDES, MDE)

back-filled and stabilized by the end of each workday, whichever is shorter. 11. Any major changes or revisions to the plan or sequence of construction must be reviewed and approved by the HSCD prior to proceeding with construction. Minor revisions may allowed by the CID per the list of HSCD-approved field changes.

12. Disturbance shall not occur outside the L.O.D. A project is to be sequenced so that grading activities

10. Trenches for the construction of utilities is limited to three pipe lengths or that which can and shall be

begin on one grading unit (maximum acreage of 20 ac. per grading unit) at a time. Work may proceed to a subsequent grading unit when at least 50 percent of the disturbed area in the preceding grading unit has been stabilized and approved by the CID. Unless otherwise specified and approved by the HSCD. no more than 30 acres cumulatively may be disturbed at a given time. 13. Wash water from any equipment, vehicles, wheels, pavement, and other sources must be treated in a


sediment basin or other approved washout structure. 14. Topsoil shall be stockpiled and preserved on-site for redistribution onto final grade. 15. All Silt Fence and Super Silt Fence shall be placed on-the-contour, and be imbricated at 25 minimum

intervals, with lower ends curled uphill by 2' in elevation. 16. Stream channels must not be disturbed during the following restricted time periods (inclusive): Use I and IP March 1 - June 15 Use III and IIIP October 1 - April 30

Use IV March 1 - May 31 17. A copy of this plan, the 2011 MARYLAND STANDARDS AND SPECIFICATIONS FOR SOIL EROSION AND SEDIMENT CONTROL, and associated permits shall be on-site and available when the site is active.

THIS DEVELOPMENT PLAN IS APPROVED FOR SOIL EROSION AND SEDIMENT CONTROL BY

THE HOWARD SOIL CONSERVATION DISTRICT

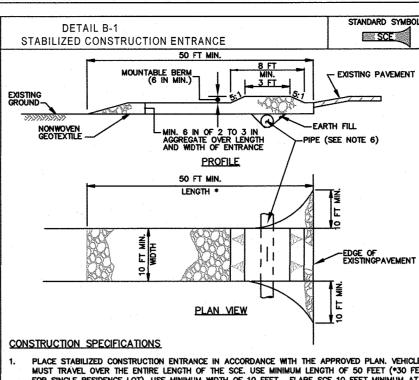


PLACE STABILIZED CONSTRUCTION ENTRANCE IN ACCORDANCE WITH THE APPROVED PLAN. VEHICLES MUST TRAVEL OVER THE ENTIRE LENGTH OF THE SCE. USE MINIMUM LENGTH OF 50 FEET (*30 FEET FOR SINGLE RESIDENCE LOT). USE MINIMUM WIDTH OF 10 FEET. FLARE SCE 10 FEET MINIMUM AT THE EXISTING ROAD TO PROVIDE A TURNING RADIUS.

PIPE ALL SURFACE WATER FLOWING TO OR DIVERTED TOWARD THE SCE UNDER THE ENTRANCE, MAINTAINING POSITIVE DRAINAGE, PROTECT PIPE INSTALLED THROUGH THE SCE WITH A MOUNTABLE BERM WITH 5:1 SLOPES AND A MINIMUM OF 12 INCHES OF STONE OVER THE PIPE, PROVIDE PIPE AS SPECIFIED ON APPROVED PLAN. WHEN THE SCE IS LOCATED AT A HIGH SPOT AND HAS NO DRAINAGE TO CONVEY, A PIPE IS NOT NECESSARY. A MOUNTABLE BERM IS REQUIRED WHEN SCE IS NOT LOCATED AT A HIGH SPOT.

PREPARE SUBGRADE AND PLACE NONWOVEN GEOTEXTILE, AS SPECIFIED IN SECTION H-1 MATERIALS PLACE CRUSHED AGGREGATE (2 TO 3 INCHES IN SIZE) OR EQUIVALENT RECYCLED CONCRETE (WITHOUT REBAR) AT LEAST 6 INCHES DEEP OVER THE LENGTH AND WIDTH OF THE SCE.

MAINTAIN ENTRANCE IN A CONDITION THAT MINIMIZES TRACKING OF SEDIMENT. ADD STONE OR MAKE OTHER REPAIRS AS CONDITIONS DEMAND TO MAINTAIN CLEAN SURFACE, MOUNTABLE BERM, AND SPECIFIED DIMENSIONS. IMMEDIATELY REMOVE STONE AND/OR SEDIMENT SPILLED, DROPPED, OR TRACKED ONTO ADJACENT ROADWAY BY VACUUMING, SCRAPING, AND/OR SWEEPING. WASHING ROADWAY TO REMOVE MUD TRACKED ONTO PAVEMENT IS NOT ACCEPTABLE UNLESS WASH WATER IS DIRECTED TO AN APPROVED SEDIMENT CONTROL PRACTICE.

MARYLAND STANDARDS AND SPECIFICATIONS FOR SOIL EROSION AND SEDIMENT CONTROL

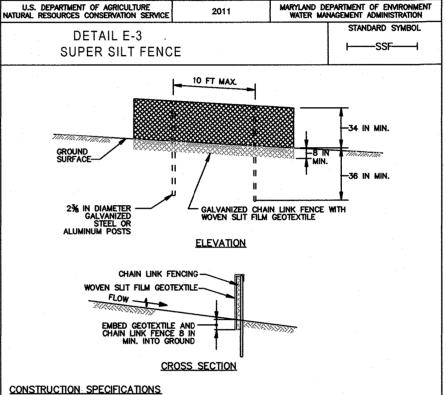

. FASTEN WOVEN SLIT FILM GEOTEXTILE AS SPECIFIED IN SECTION H-1 MATERIALS, SECURELY TO THE UPSLOPE SIDE OF CHAIN LINK FENCE WITH TIES SPACED EVERY 24 INCHES AT THE TOP AND MID SECTION. EMBED GEOTEXTILE AND CHAIN LINK FENCE A MINIMUM OF 8 INCHES INTO THE GROUND.

EXTEND BOTH ENDS OF THE SUPER SILT FENCE A MINIMUM OF FIVE HORIZONTAL FEET UPSLOPE AT 45 DEGREES TO THE MAIN FENCE ALIGNMENT TO PREVENT RUNOFF FROM GOING AROUND THE ENDS OF THE SUPER SILT FENCE.

PROVIDE MANUFACTURER CERTIFICATION TO THE INSPECTION/ENFORCEMENT AUTHORITY SHOWING THAT GEOTEXTILE USED MEETS THE REQUIREMENTS IN SECTION H-1 MATERIALS.

MARYLAND STANDARDS AND SPECIFICATIONS FOR SOIL EROSION AND SEDIMENT CONTROL U.S. DEPARTMENT OF AGRICULTURE 2011

DETAIL E-1 SILT FENCE ----SF-------ELEVATION V EMBED GEOTEXTILE
MIN. OF 8 IN VERTICALLY
INTO THE GROUND. BACKFILL CROSS SECTION STAPLE-TWIST POSTS TOGETHER STAPLE---STAPLE -----STAPLE FINAL CONFIGURATION W

STANDARD SYMBOL

CONSTRUCTION SPECIFICATIONS

USE 36 INCH MINIMUM POSTS DRIVEN 16 INCH MINIMUM INTO GROUND NO MORE THAN 6 FEET APAR USE WOVEN SLIT FILM GEOTEXTILE AS SPECIFIED IN SECTION H-1 MATERIALS AND FASTEN GEOTEXTILE SECURELY TO UPSLOPE SIDE OF FENCE POSTS WITH WIRE TIES OR STAPLES AT TOP AND MID-SECTION

JOINING TWO ADJACENT SILT FENCE SECTIONS (TOP VIEW)

PROVIDE MANUFACTURER CERTIFICATION TO THE AUTHORIZED REPRESENTATIVE OF THE INSPECTION/ENFORCEMENT AUTHORITY SHOWING THAT THE GEOTEXTILE USED MEETS THE REQUIREMENTS IN SECTION H-1 MATERIALS. EMBED GEOTEXTILE A MINIMUM OF 8 INCHES VERTICALLY INTO THE GROUND. BACKFILL AND COMPACT THE SOIL ON BOTH SIDES OF FABRIC.

WHERE TWO SECTIONS OF GEOTEXTILE ADJOIN: OVERLAP, TWIST, AND STAPLE TO POST IN ACCORDANCE WITH THIS DETAIL.

MARYLAND STANDARDS AND SPECIFICATIONS FOR SOIL EROSION AND SEDIMENT CONTROL

EXTEND BOTH ENDS OF THE SILT FENCE A MINIMUM OF FIVE HORIZONTAL FEET UPSLOPE AT 45 DEGREES TO THE MAIN FENCE ALIGNMENT TO PREVENT RUNOFF FROM GOING AROUND THE ENDS OF THE SILT FENCE. REMOVE ACCUMULATED SEDIMENT AND DEBRIS WHEN BULGES DEVELOP IN SILT FENCE OR WHEN SEDIMENT REACHES 25% OF FENCE HEIGHT. REPLACE GEOTEXTILE IF TORN. IF UNDERMINING OCCURS, REINSTALL FENCE.

U.S. DEPARTMENT OF AGRICULTURE URAL RESOURCES CONSERVATION SERVICE MARYLAND DEPARTMENT OF ENVIRONMEN
WATER MANAGEMENT ADMINISTRATION 2011 STANDARD SYMBOL DETAIL B-4-6-C PERMANENT SOIL STABILIZATION MATTING PSSMC - * Ib/1
(* INCLUDE SHEAR STRESS) CHANNEL APPLICATION

1. USE MATTING THAT HAS A DESIGN VALUE FOR SHEAR STRESS EQUAL TO OR HIGHER THAN THE SHEAR STRESS 2. USE PERMANENT SOIL STABILIZATION MATTING MADE OF OPEN WEAVE SYNTHETIC, NON-DEGRADABLE FIBERS OR ELEMENTS OF UNIFORM THICKNESS AND DISTRIBUTION THROUGHOUT. CHEMICALS USED IN THE MAT MUST BE NON-LEACHING AND NON-TOXIC TO VEGETATION AND SEED GERMINATION AND NON-INJURIOUS TO THE SKIN. IF PROMETRY, NETTING MUST BE EXTRUDED PLASTIC WITH A MAXIMUM MESH OPENING OF 2x2 INCHES AND SUFFICIENTLY BONDED OR SEWN ON 2 INCH CENTERS ALONG LONGITUDINAL AXIS OF THE MATERIAL TO PREVENT SEPARATION OF THE NET FROM THE PARENT MATERIAL.

ISOMETRIC VIEW

5. SECURE MATTING USING STEEL STAPLES OR WOOD STAKES. STAPLES MUST BE "U" OR "T" SHAPED STEEL WIRE HAVING A MINIMUM GAUGE OF NO. 11 AND NO. 8 RESPECTIVELY. "U" SHAPED STAPLES MUST AVERAGE 1 TO 1 ½ INCHES WIDE AND BE A MINIMUM OF 6 INCHES LONG. "T" SHAPED STAPLES MUST HAVE A MINIMUM 8 INCH MAIN LEG, A MINIMUM 1 INCH SECONDARY LEG, AND MINIMUM 4 HAD WOOD STAKES MUST BE ROUGH-SAWN HARDWOOD, 12 TO 24 INCHES IN LENGTH, 1x3 INCH IN CROSS SECTION, AND WEDGE SHAPE AT PERFORM FINAL GRADING, TOPSOIL APPLICATION, SEEDBED PREPARATION, AND PERMANENT SEEDING IN ACCORDANCE WITH SPECIFICATIONS. PLACE MATTING WITHIN 48 HOURS OF COMPLETING SEEDING OPERATIONS, UNLESS END OF WORKDAY STABILIZATION IS SPECIFIED ON THE APPROVED EROSION AND SEDIMENT CONTROL PLAN

UNROLL MATTING IN DIRECTION OF WATER FLOW, CENTERING THE FIRST ROLL ON THE CHANNEL CENTER LINE. WORK FROM CENTER OF CHANNEL OUTWARD WHEN PLACING ROLLS. LAY MATTING SMOOTHLY AND FIRMLY UPON THE SEEDED SURFACE, AVOID STRETCHING THE MATTING. . OVERLAP OR ABUT EDGES OF MATTING ROLLS PER MANUFACTURER RECOMMENDATIONS. OVERLAP ROLL ENDS BY 6 INCHES (MINIMUM). WITH THE UPSTREAM MAT OVERLAPPING ON TOP OF THE NEXT DOWNSTREAM MAT.

KEY IN THE TOP OF SLOPE END OF MAT 6 INCHES (MINIMUM) BY DIGGING A TRENCH, PLACING THE MATTING ROLL END IN THE TRENCH, STAPLING THE MAT IN PLACE, REPLACING THE EXCAVATED MATERIAL, AND TAMPINI TO SECURE THE MAT END IN THE KEY. 8. STAPLE/STAKE MAT IN A STAGGERED PATTERN ON 4 FOOT (MAXIMUM) CENTERS THROUGHOUT AND 2 FOOT (MAXIMUM) CENTERS ALONG SEAMS, JOINTS, AND ROLL ENDS. 9. IF SPECIFIED BY THE DESIGNER OR MANUFACTURER AND DEPENDING ON THE TYPE OF MAT BEING INSTALLED, ONCE THE MATTING IS KEYED AND STAPLED IN PLACE, FILL THE MAT VOIDS WITH TOP SOIL OR GRANULAR MATERIAL AND LIGHTLY COMPACT OR ROLL TO MAXIMIZE SOIL/MAT CONTACT WITHOUT CRUSHING MAT.

10. ESTABLISH AND MAINTAIN VEGETATION SO THAT REQUIREMENTS FOR ADEQUATE VEGETATIVE ESTABLISHMENT ARE CONTINUOUSLY MET IN ACCORDANCE WITH SECTION 8-4 VEGETATIVE STABILIZATION. MARYLAND STANDARDS AND SPECIFICATIONS FOR SOIL EROSION AND SEDIMENT CONTROL U.S. DEPARTMENT OF AGRICULTURE

NATIONAL PESCHIRCES CONSERVATION SERVICE

2011

WARYLAND DEPARTMENT OF ENVIRONMENT
WATER MANAGEMENT ADMINISTRATION

SHEAR STRESS FOR PSSMC = y(weight density) * R(water depth) * Sw(slope) = shear stress SHEAR STRESS FOR PSSMC (LOT 5, North) = 62.4 LB5/FT3 x 0.153 FT x 0.020 = 0.19 LB5/FT2 SHEAR STRESS FOR PSSMC (LOT 5, South) = $62.4 \text{ LBS/FT}^3 \times 0.146 \text{ FT} \times 0.025 = 0.23 \text{ LBS/FT}^2$

SEQUENCE OF CONSTRUCTION

OBTAIN A GRADING PERMIT AND HOLD PRE-CONSTRUCTION MEETING WITH COUNTY INSPECTOR. (2 WEEKS)
NOTIFY "MISS UTILITY" AT LEAST 49 HOURS BEFORE BEGINNING ANY WORK AT 1-900-257-7777. NOTIFY THE HOWARD COUNTY OFFICE OF CONSTRUCTION/ INSPECTION AT 410-313-1330 AT LEAST 24 HOURS BEFORE STARTING WORK. INSTALL STABILIZED CONSTRUCTION ENTRANCE, SILT FENCE, SUPER SILT FENCE, AND TREE PROTECTIVE FENCING, I REMOVE NECESSARY TREES AND ROUGH GRADE LOT. (2 DAYS)

INSTALL TEMPORARY SEEDING. (1 DAY)

CONSTRUCT HOUSE AND DRIVEWAY. INSTALL SEWER AND WATER HOUSE CONNECTIONS. (4 MONTHS)

INSTALL ROOF LEADERS, DRYWELLS AND MICRO-BIORETENTION. UPON CONSTRUCTION OF HOUSE, FINE GRADE. INSTALL PERMANENT SOIL STABILIZATION MATTING IN SWALES AS SHOWN. (3 DAYS) INSTALL PERMANENT SEEDING WITH CONSTRUCTION. (1 DAY)
ALL FINAL GRADES AND STABILIZATION SHOULD BE COMPLETED BEFORE ANY REMOVAL OF CONTROLS. WHEN ALL

PLAT#: F-17-021 / DEED# 16686/164

CONTRIBUTING AREAS TO THE SEDIMENT CONTROL DEVICES HAVE BEEN STABILIZED AND WITH THE PERMISSION OF THE SEDIMENT CONTROL INSPECTOR, THE SEDIMENT CONTROL DEVICES MAY BE REMOVED. (3 DAYS) NOTE: THE CONTRACTOR SHALL INSPECT AND PROVIDE NECESSARY MAINTENANCE EACH RAINFALL AND ON A DAILY BASIS.

APPROVED: DEPARTMENT OF PLANNING AND ZONING WY 9/14/21

OWNER

HONRAO ABHIJIT

4060 ST. JOHN'S LANE

ELLICOTT CITY, MD 21042

HONRAO'S PROPERTY,

LOT 2, 9100 WHITEHALL ROAD ZONED R-20

TAX MAP No. 24 GRID No. 23 PARCEL No. 270 SECOND ELECTION DISTRICT HOWARD COUNTY, MARYLAND SCALE: AS SHOWN DATE: MAY, 2021

THAT I AM A DULY LICENSED PROFESSIONAL LAND SURVEYOR UNDER THE LAWS OF THE STATE OF MARYLAND, LICENSE NO. 21476, EXPIRATION DATE: 07/14/2023

1/WE CERTIFY THAT ALL DEVELOPMENT AND CONSTRUCTION WILL BE DONE ACCORDING TO THIS PLAN. FOR SEDIMENT AND EROSION CONTROL AND THAT ANY RESPONSIBLE PRESONNEL INVOLVED IN THE CONSTRUCTION PROJECT WILL HAVE A CERTIFICATE OF ATTENDANCE AT A DEPARTMENT OF THE ENVIRONMENT APPROVED TRAINING PROGRAM FOR THE CONTROL OF SEDIMENT AND EROSION BEFORE BEGINNING THE PPOLIFOT I ALSO ALITHOPIZE PEPINDIC ON-SITE INSPECTION BY THE HOWARD SOIL CONSERVATION DISTORT

HOWARD SOIL CONSERVATION DISTRICT

7/8/21

BUILDER'S CERTIFICATE

Chief. Development Engineering Division Chief, Division of Land Development 9-14-21 Director Department of Planning and Zoning SECTION / AREA PARCEL NO. HONRAO'S PROPERTY, LOT 2 270 TAX MAP # ELEC. DIST. CENSUS TR. GRID #

VIL ENGINEERING CONSULTANTS & LAND SURVEYOR FLLICOTT CITY, MARYLAND 21042 (410) 461 - 2055 DATE REVISION



PROFESSIONAL CERTIFICATION HEREBY CERTIFY THAT THESE DOCUMENTS WERE PREPARED OR APPROVED BY ME AND

Grand State Banker I Signature Of Professional Land Surveyor

07/26/2

PROJECT PLAT # 2579

23 24

BUILDER

TIMBERLAKE HOMES, INC.

304 HARRY 5. TRUMAN PARKWAY

ANNAPOLIS, MD 21401

(443-618-2643)

SECOND

602306

REQUIRED (1 DAY)

SHEET 3 OF 3

5DP-20-064

FISHER, COLLINS & CARTER, INC.

SIGNATURE OF DEVELOPER