
## BENCH MARKS

- 1. B.W. \*HO, CO, 2745010-R ELEV. 482.20 34" REBAR O.4' BELOW SURFACE 34.7' SOUTH OF CURB ON WO. ROUTE 108 175' EAST OF
- 2 B.W. # HO. CO. 2743000 ELEY 530.07 CONCRETE MONUMENT AT BURFACE 40'± EAST OF NORTHWEST DRIVE OF HOWARD HIGH SCHOOL ON NORTH SIDE OF WO

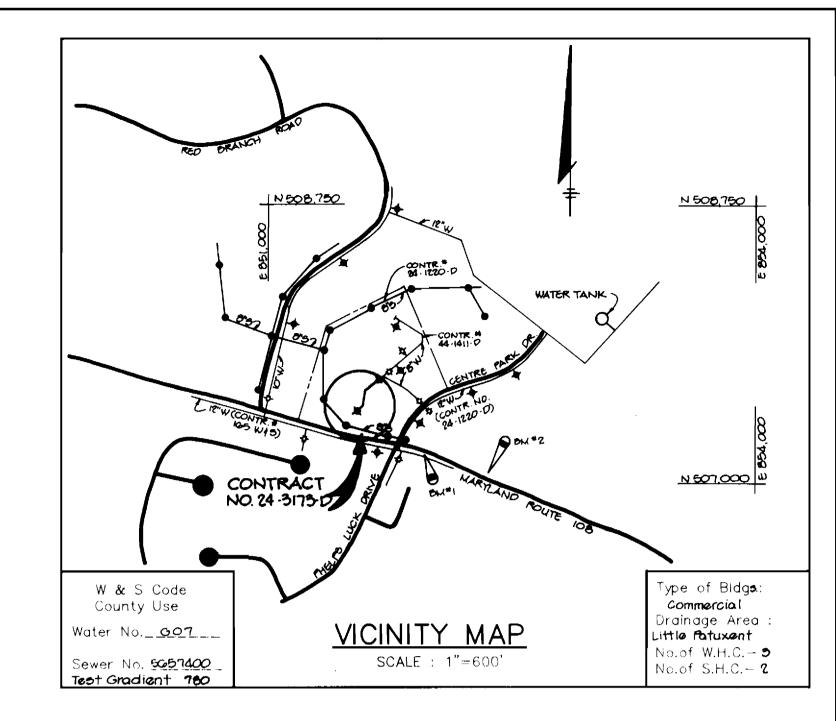


## GENERAL NOTES

- 1. Approximate location of existing mains are shown. The contractor shall take all necessary precautions to protect existing mains and services and maintain uninterrupted supply. Any damage incurred shall be repaired immediately to the satisfaction of the Engineer at the Contractor's
- 2. All horizontal controls are based on Maryland State Coordinates.
- 3. All vertical controls are based on U.S.G.S. data.
- 4. All pipe elevations shown ( ) are invert elevations.
- 5. Clear all utilities by a minimum of 6". Clear all poles by 2'-0" minimum or tunnel as required. The owner has contacted the utility companies and has made arrangements for bracing of poles as shown on the drawings. In the event the contractor's work requires the bracing of additional poles, any cost incurred by the owner for bracing of additional poles or damages shall be deducted from money owed the contractor. The contractor shall coordinate with the utility companies to schedule the bracing of the poles.
- 6. For details not shown on the drawings, and for materials and construction methods use Howard County Design Manual, Volume IV, Standard Specifications and Details for Construction. (Latest Edition). The contractor shall have a copy of Volume IV on the job.
- 7. Where test pits have been made on existing utilities, they are noted by the symbol 🖥 at the location of the test pit. A note or notes containing the results of the test pit or pits is included on the drawings. Existing utilities in the vicinity of the proposed work for which test pits have not been dug shall be located by the contractor two weeks in advance of construction operations at his own expense.
- 8. Contractor shall notify the following utility companies or agencies at least five working days before starting work shown on these plans:

State Highway Administration 531-5533 Baltimore Gas & Electric Co. Contractor Services 850-4620 Baltimore Gas & Electric Co. Underground Damage Control 787-9068 1-800-257-7777 Colonial Pipeline Co. 795-1390 Bureau of Utilities, Howard County Department of Public Works 313-4900

- 9. Trees and shrubs are to be protected from damage to maximum extent. Trees and shrubs located within the construction strip are not to be removed or damaged by the contractor.
- 10. Contractor shall remove trees, stumps and roots along line of excavation. Payment for such removal shall be included in the unit price bid for construction of the main.
- 11. All water mains to be D.I.P. Class 52 unless otherwise noted.
- 12. Tops of all water mains to have a minimum of 3-1/2' cover unless otherwise
- 13. Valves adjacent to tees shall be strapped to tees.
- 14. All fittings shall be buttressed or anchored with concrete in accordance with the Standard Details unless otherwise provided for on the drawings.
- 15. Fire hydrants shall be set to the bury line elevations shown on the drawings. All fire hydrants shall be restrained and buttressed with concrete in accordance with Standard Details. Soil around the fire hydrant shall be compacted in accordance with Section 1000 and 1005 of the Standard
- 16. The contractor shall not operate any water main valves on the existing
- 17. All water house connections shall be for inside meter setting unless otherwise noted on plans or in specifications.
- 18. All sewer mains shall be DIP, RCP, VCPX, CSPX, RCCP and P.V.C. unless otherwise noted.
- 19. The contractor shall provide a joint in all sewer mains within 2'-0" of exterior manhole wall.
- 20. All manholes shall be 4'-0" inside diameter unless otherwise noted.
- 21. Force mains shall be D.I.P. only.
- 22. Manholes shown with 12" and 16" walls are for brick manholes only.
- 23. Manholes designated W.T. in plan and profile shall have watertight frame and covers, Standard Detail G5.52. Where watertight manhole frame and cover is used, set top of frame 1"-6" above finished grade unless otherwise noted on the drawings.
- 24. House(s) with the symbol "C.N.S." indicates that cellar cannot be served.

WATER AS-BUILT

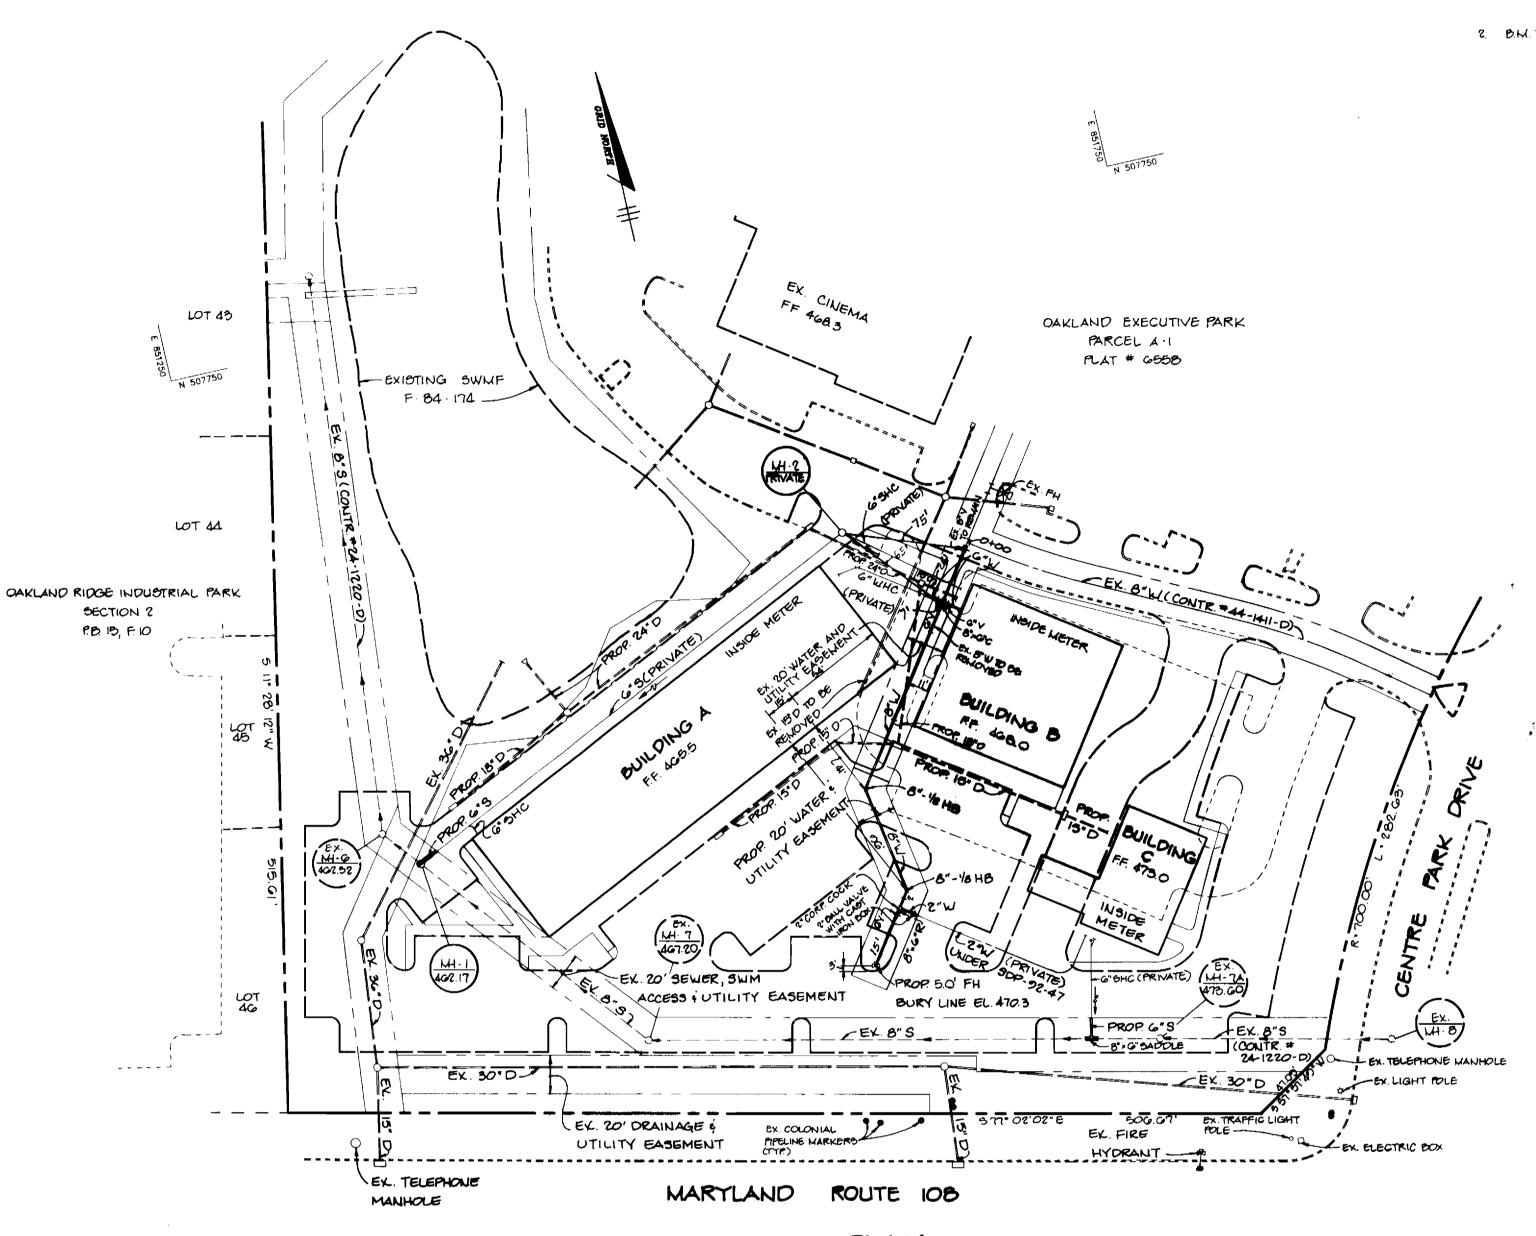

QUANTITIES AS- BUILT QUANTITIES ITEMS ESTIMATED MANUFACTURER QUANTITES SUPPLIER G" WATER 53 LF SI LF. ATLANTIC B" WATER 200 LF ATLANTIS 225 L.F. 2" WATER 10 LF 10 L.F. CAMBRIDGE-LE G" HYDRANT I EA. MUELLER I EA. 2" CORPORATION COCK & VALVE I EA. I EA. MUELLER G" VALVE 3 EA. MUELLER 3 EA. 8" x 6" CROSS I EA. 1 53.10 MUELLER 8" × C' REDUCER IEA. MUELLER I EA. 20 L.F. J.M. MANUFAL 6" SEWER 20 L.F. ATLANTIC

NAME OF UTILITY CONTRACTOR CHECKDOX AS-BUILT DATE SURVEY AND DRAFTING DIVISION

## plan is approved for soil erosion and ediment control by the Howard Soil Conservation

Sediment control measures for this contract

HOWARD SOIL CONSERVATION DISTRICT

will be implemented in accordance with Section


DEPARTMENT OF PUBLIC WORKS HOWARD COUNTY, MARYLAND

press 3 mary CHIEF, BUREAU OF ENGINEERING

4' DIA. MANHOLE

RIEMER MUEGGE & ASSOCIATES, INC. A Land Planning, Engineering and Consulting Firm 8818 Centre Park Drive Suite 200 Columbia, Md. 21045 301-227-8200 FAX: 301-227-2282

II V.E

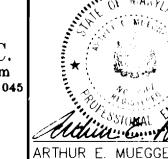

OF MAINTENANCE	DES: CJR				
*	DRN: MAD				
ACCOUNT TO THE PARTY OF THE PAR	CHK: JOP				
E. MUEGGE #8707	DATE: 10-31-01	BY	NO.	REVISION	DATE
, , , , , , , , , , , , , , , , , , , ,					•

PLAN SHEET 600' SCALE MAP NO. \_\_\_**30**\_\_\_\_ BLOCK NO. <u>18</u>

SEQUENCE OF WORK FOR REMOVAL OF 8" WATER LINE

1. TURN OFF EXISTING LINE AT EXISTING 8" VALVE STATION 0+05. 2. REMOVE EXISTING LINE FROM STATION 0+15 TO STATION 1+31.

3. INSTALL VERTICAL BEND AT STATION OHIS AND PROCEED WITH

4. UPON ACCEPTANCE OF LINE BY HOWARD COUNTY BUREAU

BUREAU OF UTILITIES, TURN EXISTING 8" VALVE ON .

OF CONSTRUCTION AND INSPECTION AND HOWARD COUNTY


LINE AS SHOWN ON THESE PLANS

5. SEE SHEET 2 FOR PROFILE OF WATER MAIN.


COLUMBIA PALACE OFFICE CENTER 2nd ELECTION DISTRICT HOWARD COUNTY, MARYLAND CONTRACT NO. 24-3173-D

**SCALE** AS SHOWN SHEET

<u>1</u> OF <u>2</u>

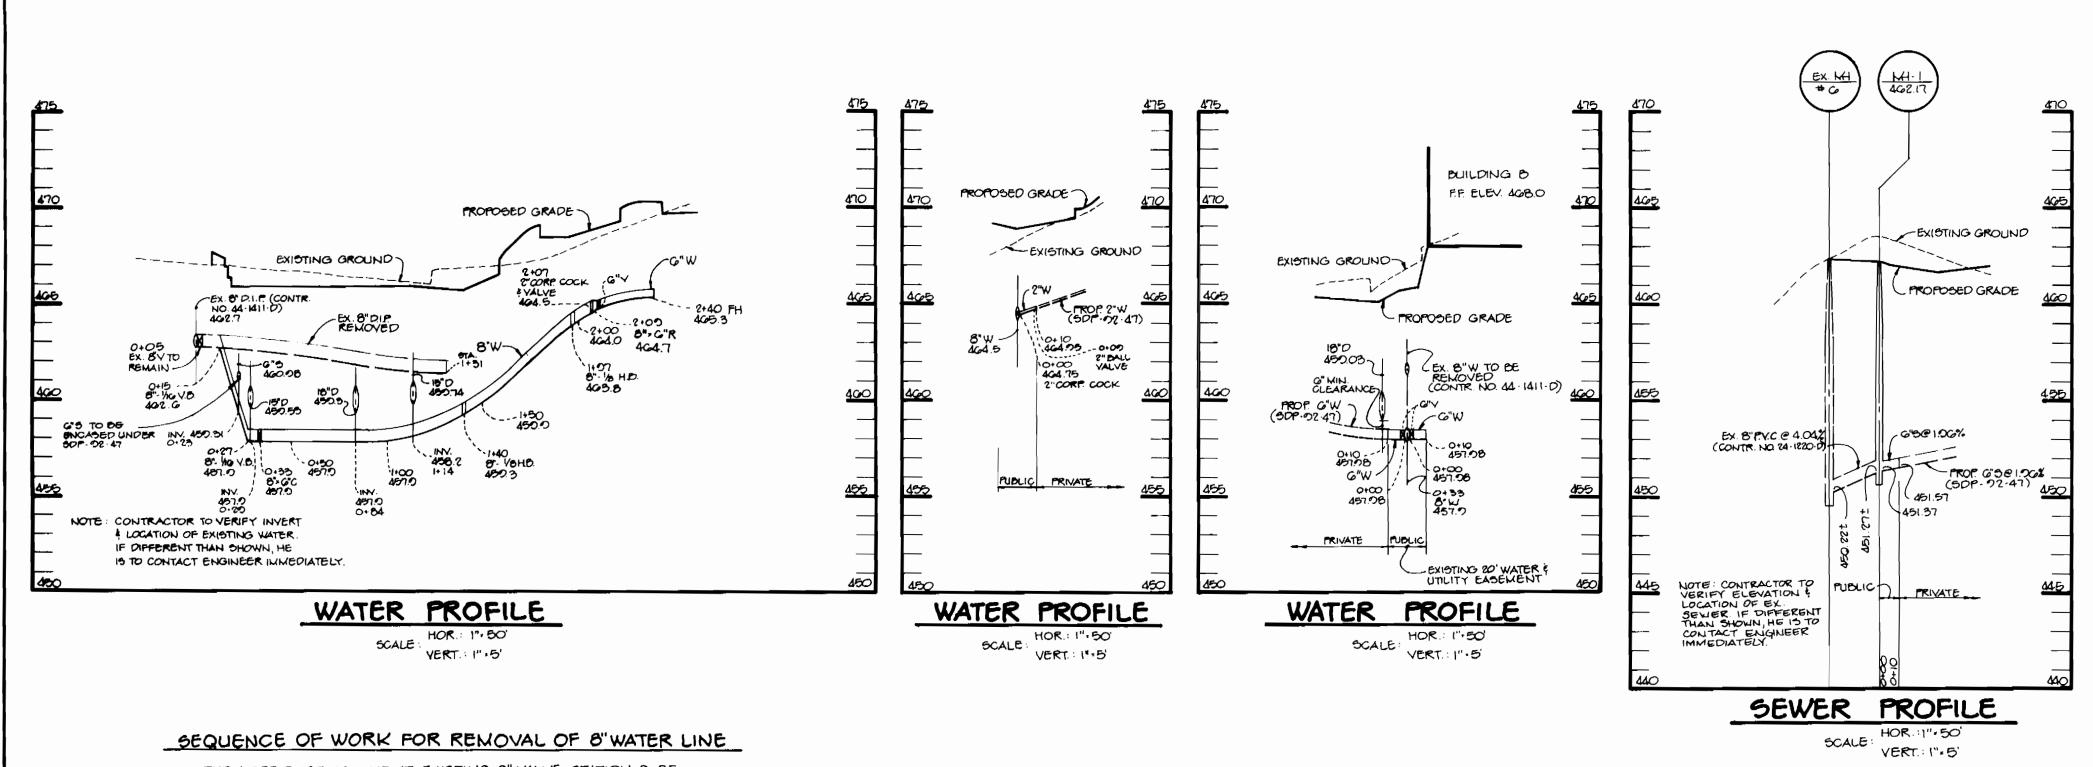

- I TURN OFF EXISTING LINE AT EXISTING 8" VALVE STATION 0+05.
- 2. REMOVE EXISTING LINE FROM STATION 0+15 TO STATION 1+31.
  3. INSTALL VERTICAL BEND AT STATION 0+15 AND PROCEED WITH
- LINE AS SHOWN ON THESE PLANS.
- 4. UPON ACCEPTANCE OF LINE BY HOWARD COUNTY BUREAU OF CONSTRUCTION AND INSPECTION AND HOWARD COUNTY BUREAU OF UTILITIES TURN EXISTING 8" VALVE ON.

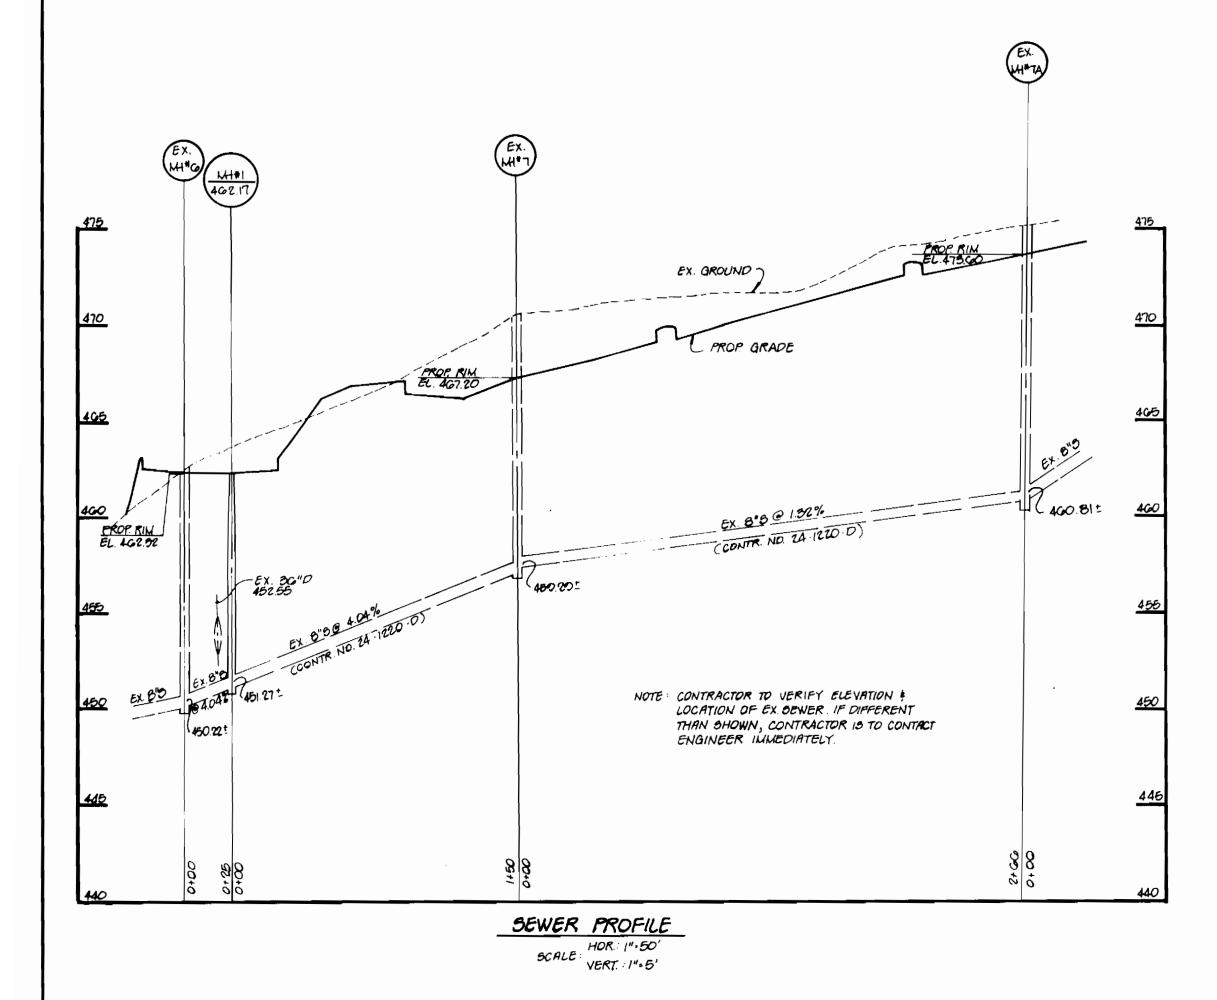

DEPARTMENT OF PUBLIC WORKS

HOWARD COUNTY, MARYLAND

JOHN STORM ST

RIEMER MUEGGE & ASSOCIATES, INC.

A Land Planning, Engineering and Consulting Firm

8818 Centre Park Drive Suite 200 Columbia, Md. 21045

501-997-8900 Fax.: 501-997-9282

	DES: C.J.R.		 	
	DRN: M.A.D.			
1. Solomon Miller	CHK: J.O.P.			
THUR E. MUEGGE #8707	DATE: 10-31-01	BY	NO.	REVISION

PROFILE SHEET

COLUMBIA PALACE OFFICE CENTER

2nd ELECTION DISTRICT

HOWARD COUNTY, MARYLAND

CONTRACT NO. 24-3173-D

SCALE AS SHOWN

SHEET \_2\_OF \_2