


AS-BUILT 10/30/96

WS/2 Elk Hill


3281

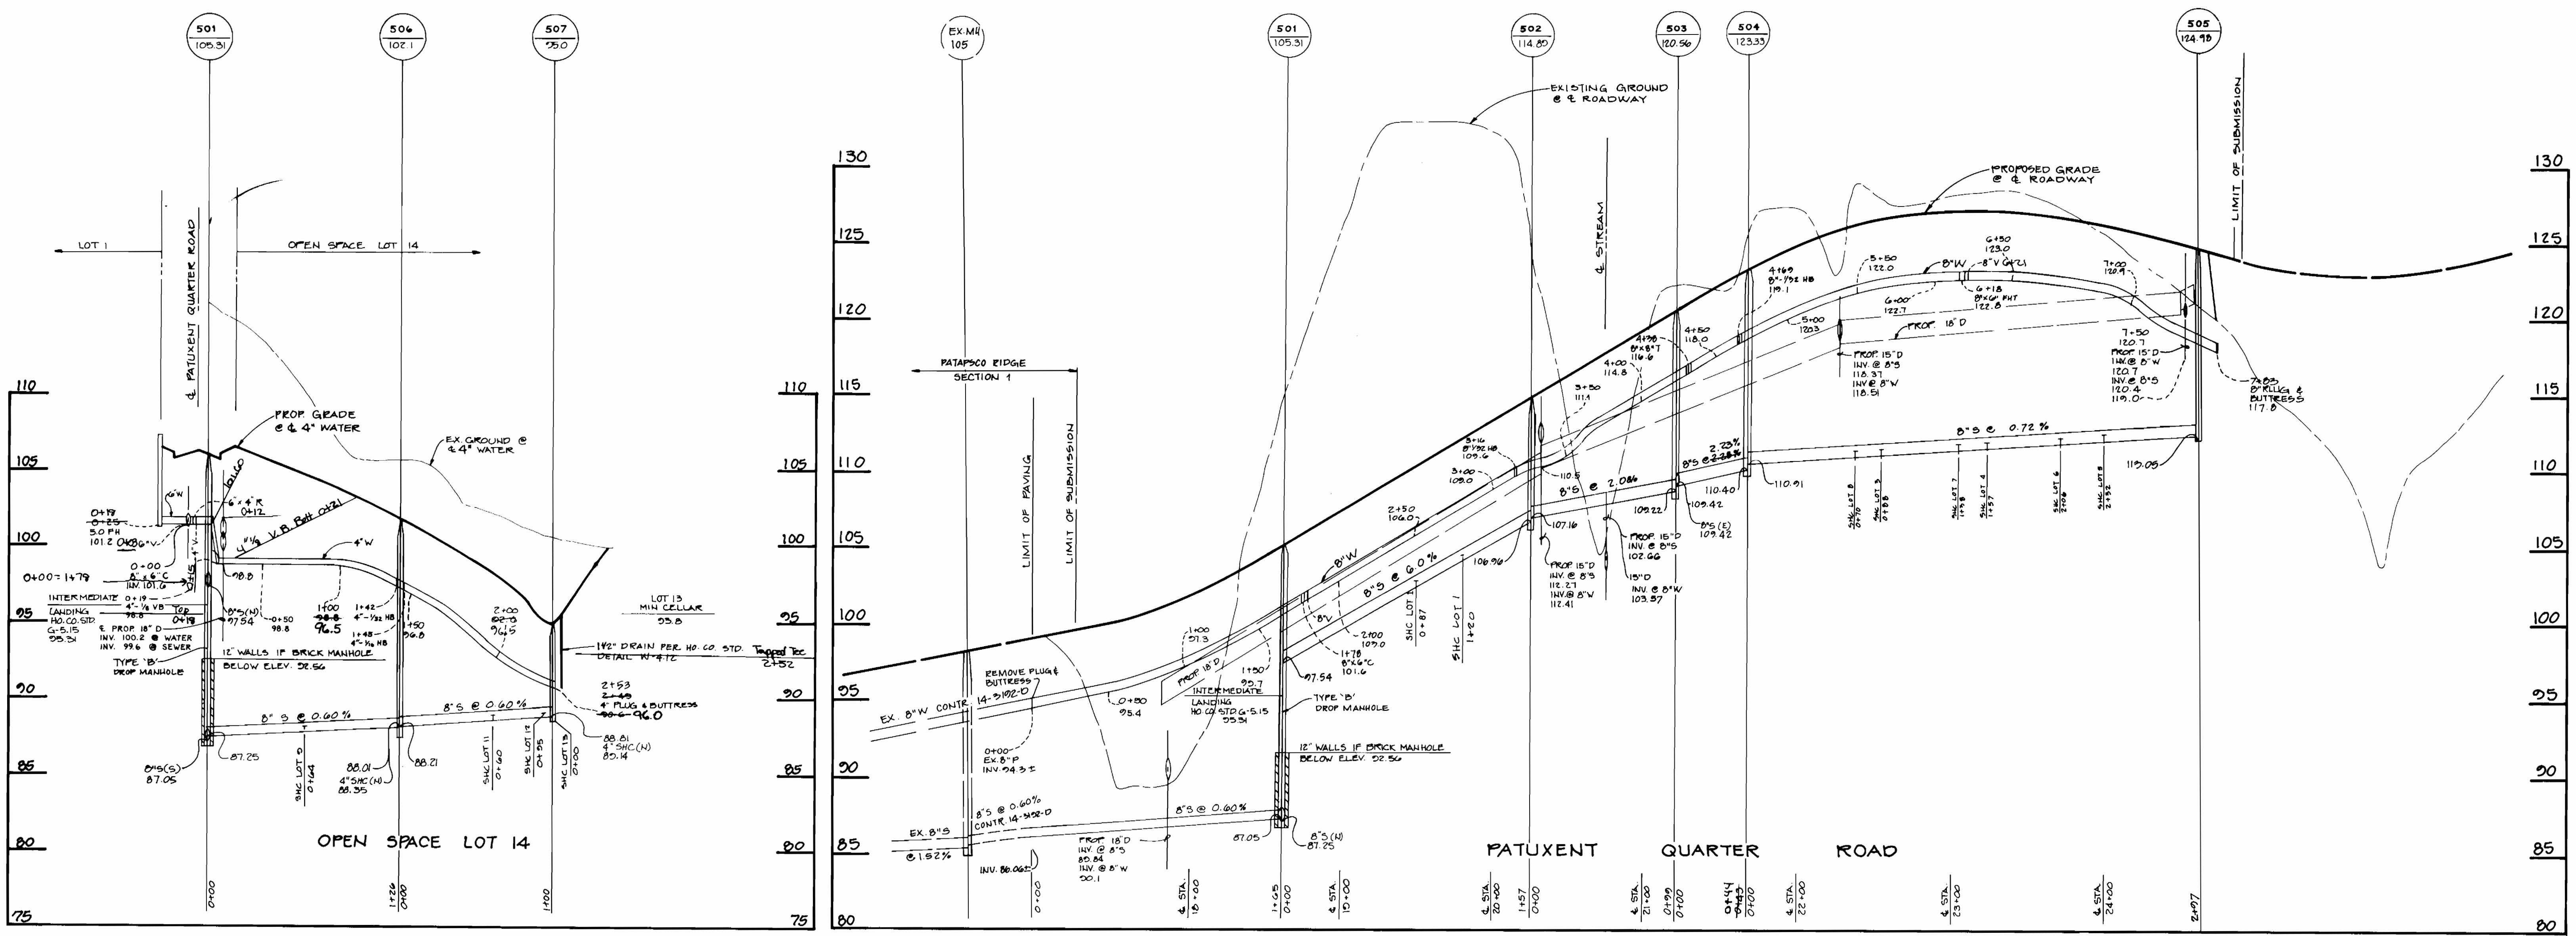

ELK HILL SEC. I WATER AS-BUILT			
WATER VALVES	FROM	TO	DISTANCE
8" valve Sta. 1491 Patuxent Quarter Rd.	MH-501	8" valve	20'
8" valve Sta. 0407 Patuxent Quarter Rd.	MH-503	" "	31'
8" valve Sta. G+21 Patuxent Quarter Rd.	MH-504	" "	45'
8" valve Sta. G+21 Patuxent Quarter Rd.	MH-505	" "	152'
6" FH Valve Sta. G+18 Patuxent Quarter Rd.	8" valve Sta. G+21	6" valve	4'
6" FH Valve Sta. 1478 Patuxent Quarter Rd.	FH-1	" "	15'
4" valve 15' RT. Sta. 1479 Patuxent Quarter Rd.	MH-501	4" valve	33'
	MH-501	" "	10'

ELK HILL SEC. I WATER AS-BUILT			
LOT	FROM	TO	DISTANCE
1	MH-502	curb stop	39'
	FH-1	" "	122'
	MH-503	" "	82'
	MH-504	" "	43'
	FH-2	" "	43'
	8" valve Sta. G+21	" "	52'
	8" valve Sta. G+21	" "	53'
	FH-2	" "	58'
	8" valve Sta. G+21	" "	57'
	FH-2	" "	64'
	8" valve Sta. G+21	" "	47'
	FH-2	" "	59'
	8" valve Sta. G+21	" "	42'
	MH-504	" "	86'
	FH-2	" "	78'
	MH-506	" "	29'
	4" valve Sta. 0415	" "	107'
	MH-506	" "	25'
	4" valve Sta. 0415	" "	112'
	MH-507	" "	30'
	MH-506	" "	80'
	MH-506	" "	25'
	MH-506	" "	86'
	MH-507	" "	20'
	MH-506	" "	112'

ELK HILL SEC. I-SAN AS-BUILT			
LOT	FROM	TO	DISTANCE
1	MH-502	SAN. BOARD	48'
	FH-1	" "	112'
2	MH-503	" "	68'
	MH-504	" "	33'
3	MH-504	" "	97'
	FH-2	" "	43'
4	8" valve Sta. G+21	" "	22'
	FH-2	" "	17'
5	MH-505	" "	72'
	FH-2	" "	89'
6	MH-505	" "	97'
	FH-2	" "	76'
7	8" valve Sta. G+21	" "	34'
	FH-2	" "	51'
8	MH-504	" "	77'
	FH-2	" "	88'
9	MH-501	" "	70'
	MH-506	" "	64'
10	MH-506	" "	22'
	507	" "	98'
11	MH-506	" "	71'
	MH-507	" "	45'
12	MH-506	" "	98'
	MH-507	" "	20'
13	MH-506	" "	106'
	MH-507	" "	20'
	MH-503	8" PLUG	35'
	MH-504	" "	55'

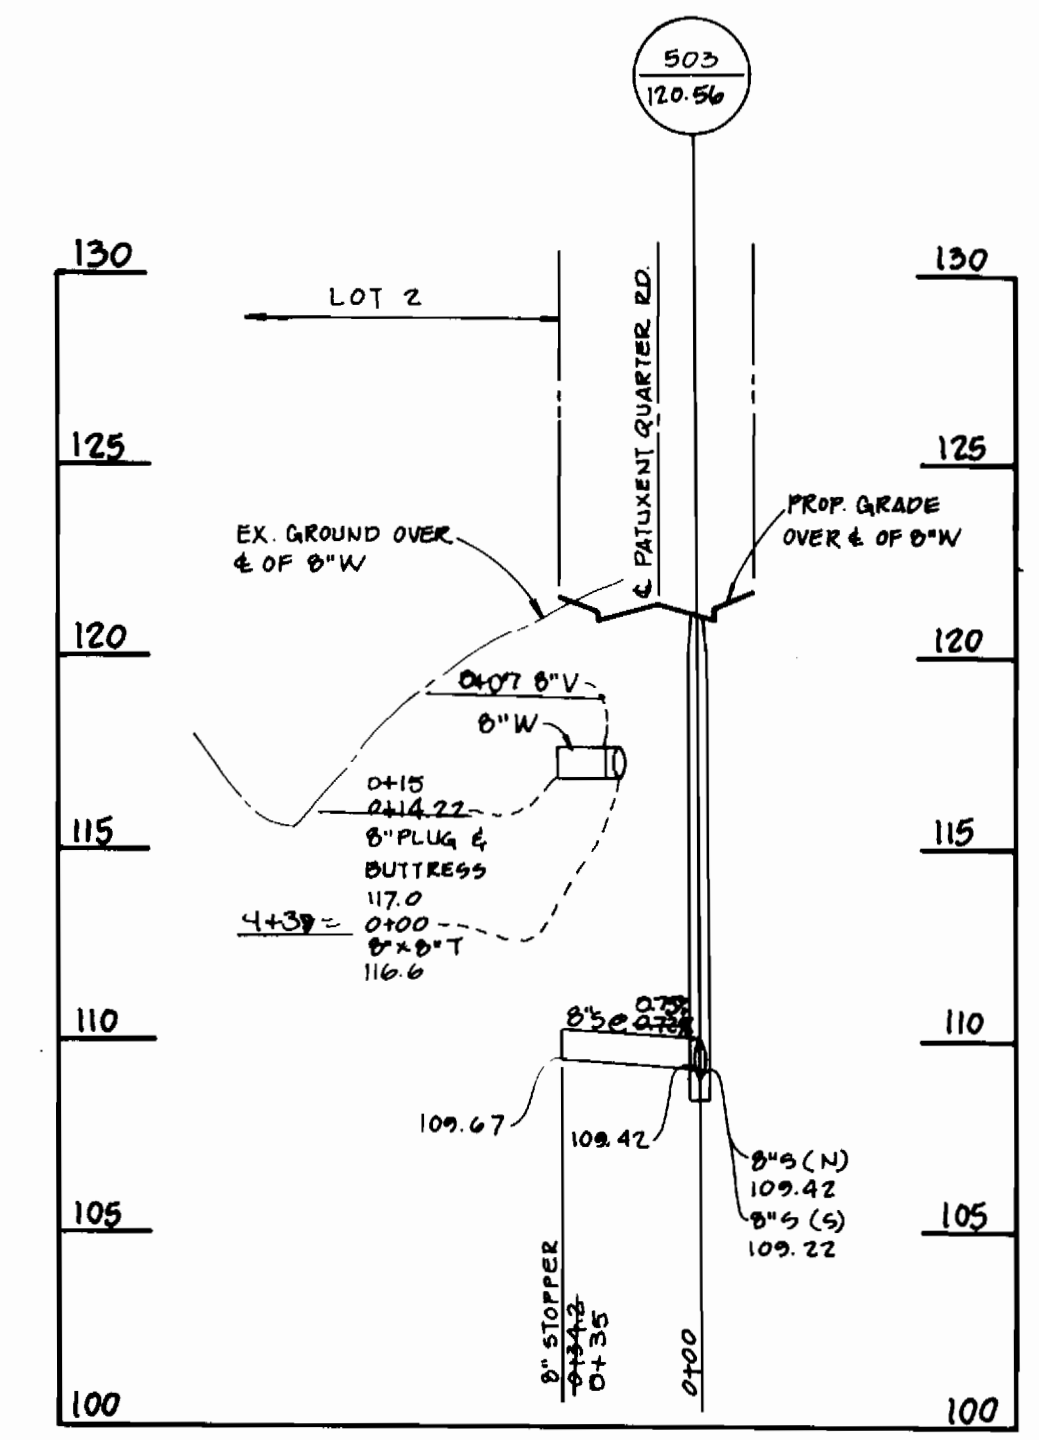

DEPARTMENT OF PUBLIC WORKS
HOWARD COUNTY, MARYLAND

Samuel Chen 1/28/94
DIRECTOR OF PUBLIC WORKS DATE

Paul D. Brown 1/27/94
CHIEF, BUREAU OF ENGINEERING DATE

Robert Brown 1-18-94
CHIEF, BUREAU OF UTILITIES DATE

John D. ...
CHIEF, LAND DEVELOPMENT DIVISION DATE

T.S.A. GROUP INC.
planning • engineering • surveying
8480 Baltimore National Pike • Suite 418
Ellicott City, Maryland 21043

John D. ...

DES: JH
DRN: JWG
CHK: DAM
DATE: 3-23-93 4-19-94 1-12-94 BY NO.

REVISIONS: REVISOR DATE

REVISOR: REVISED 8" SLOPE FROM STUBS TO 501 AND 501-507
DATE: 600 SCALE MAP NO. 37 BLOCK NO. 16

PROFILES OF
WATER & SEWER MAINS

ELK HILL
SECTION 1
LOTS 1 THRU 18

ELECTION DISTRICT NO. 1
CONTRACT NO. 14-3281-D

SCALE:
HORIZ. 1" = 50'
VERT. 1" = 5'

SHEET
2 OF 2

AS-BUILT 10/30/96