


3422 ws/2 VLR 4/2

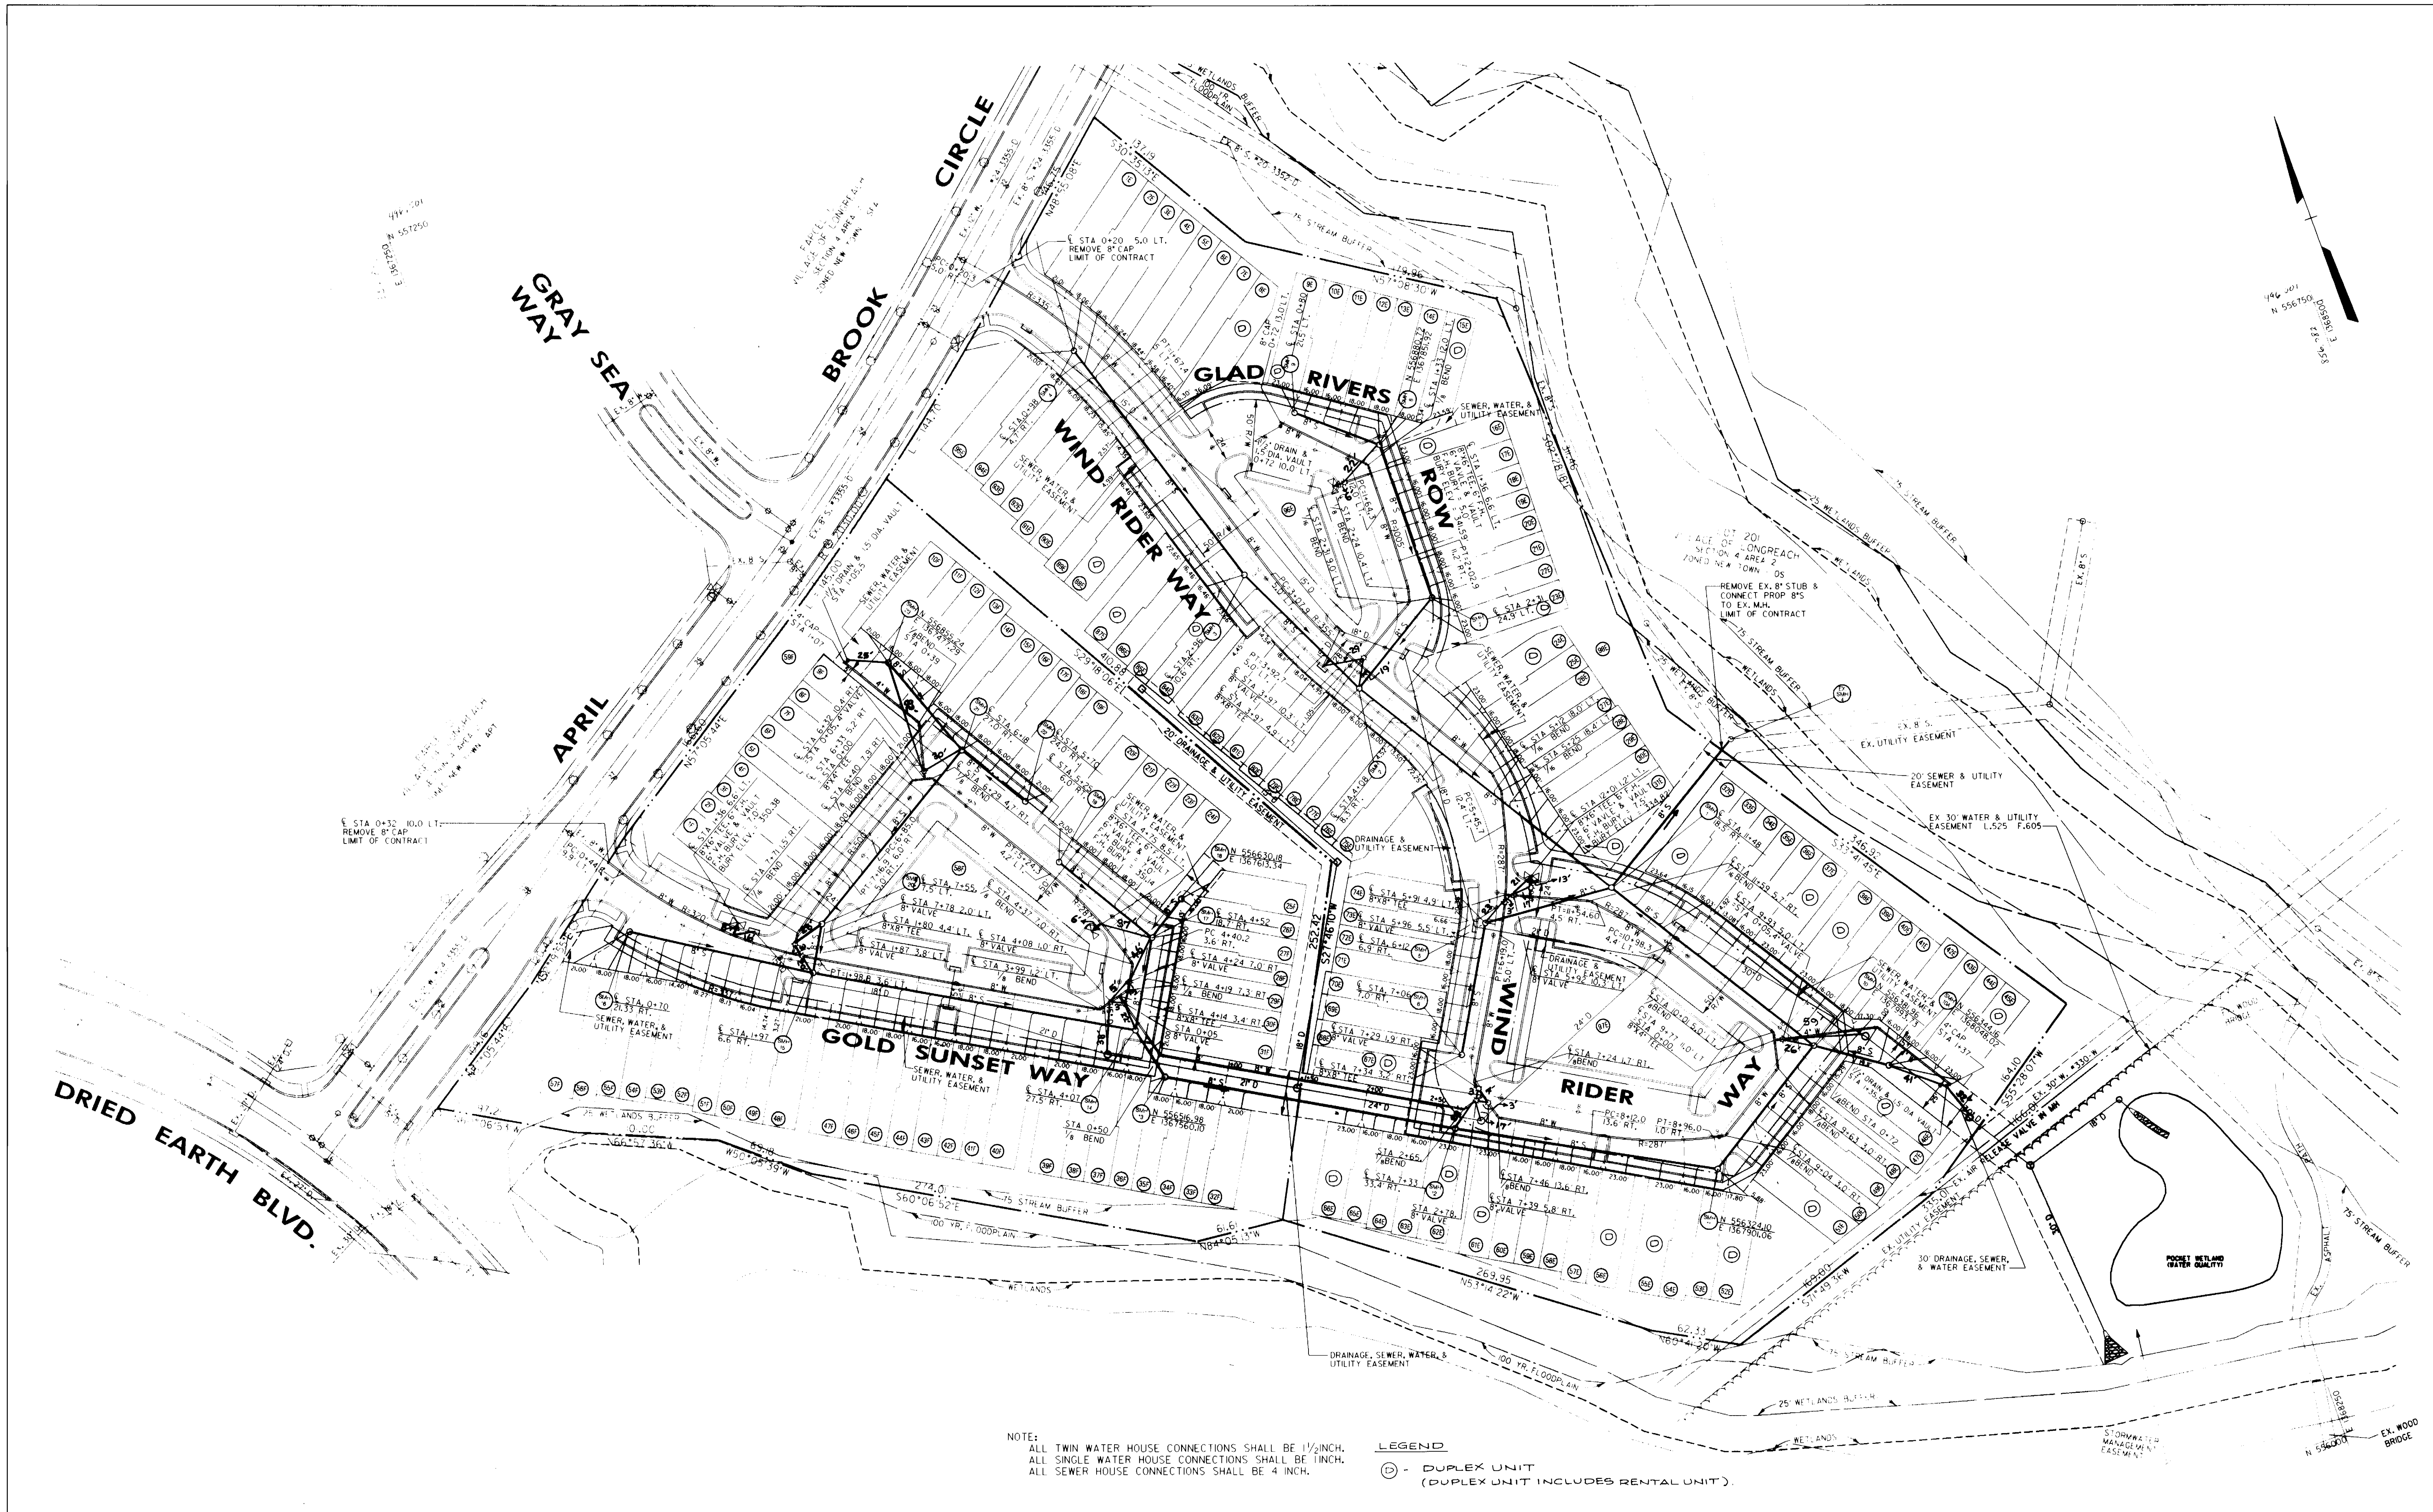

NOTE: ALL TWIN WATER HOUSE CONNECTIONS SHALL BE 1 1/2 INCH.
 ALL SINGLE WATER HOUSE CONNECTIONS SHALL BE 1 INCH.
 ALL SEWER HOUSE CONNECTIONS SHALL BE 4 INCH.

LEGEND
 (D) - DUPLEX UNIT
 (DU) - DUPLEX UNIT INCLUDES RENTAL UNIT


DEPARTMENT OF PUBLIC WORKS
 HOWARD COUNTY, MARYLAND

[Signature]
 CHIEF - BUREAU OF UTILITIES - DATE

DEPARTMENT OF PLANNING & ZONING
 HOWARD COUNTY, MARYLAND

[Signature] 7/12/95
 CHIEF, DEVELOPMENT ENGINEERING DIVISION DATE

DMW
 Dan McCune-Walker, Inc.
 200 East Pennsylvania Avenue A Team of Land Planners,
 Townson, Maryland 21286
 (410) 296-3333
 Fax 296-4705
 Landscape Architects,
 Engineers, Surveyors &
 Environmental Professionals

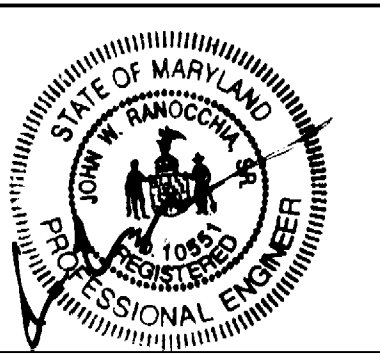

DESIGN BY:	CEV		
DRAWN BY:	CEV		
CHECKED BY:	JWR		
DATE:	JUNE 95		
BY NO.	LTM 1	PER OPZ DEV ENG DIV COMMENTS	8/16/95
REVISION	02	8/27/95	

WATER & SEWER PLAN


600 SCALE MAP NO. 37 BLOCK NO. 13

VILLAGE OF LONGREACH
 SECTION 4 AREA 2
 LOTS E1-E95 & F1-F57
 6th ELECTION DISTRICT

CONTRACT NO. 24-3422-D


SCALE
 1" = 50'
 SHEET
 2 OF 45

3422 ws/3 VLR 4/2

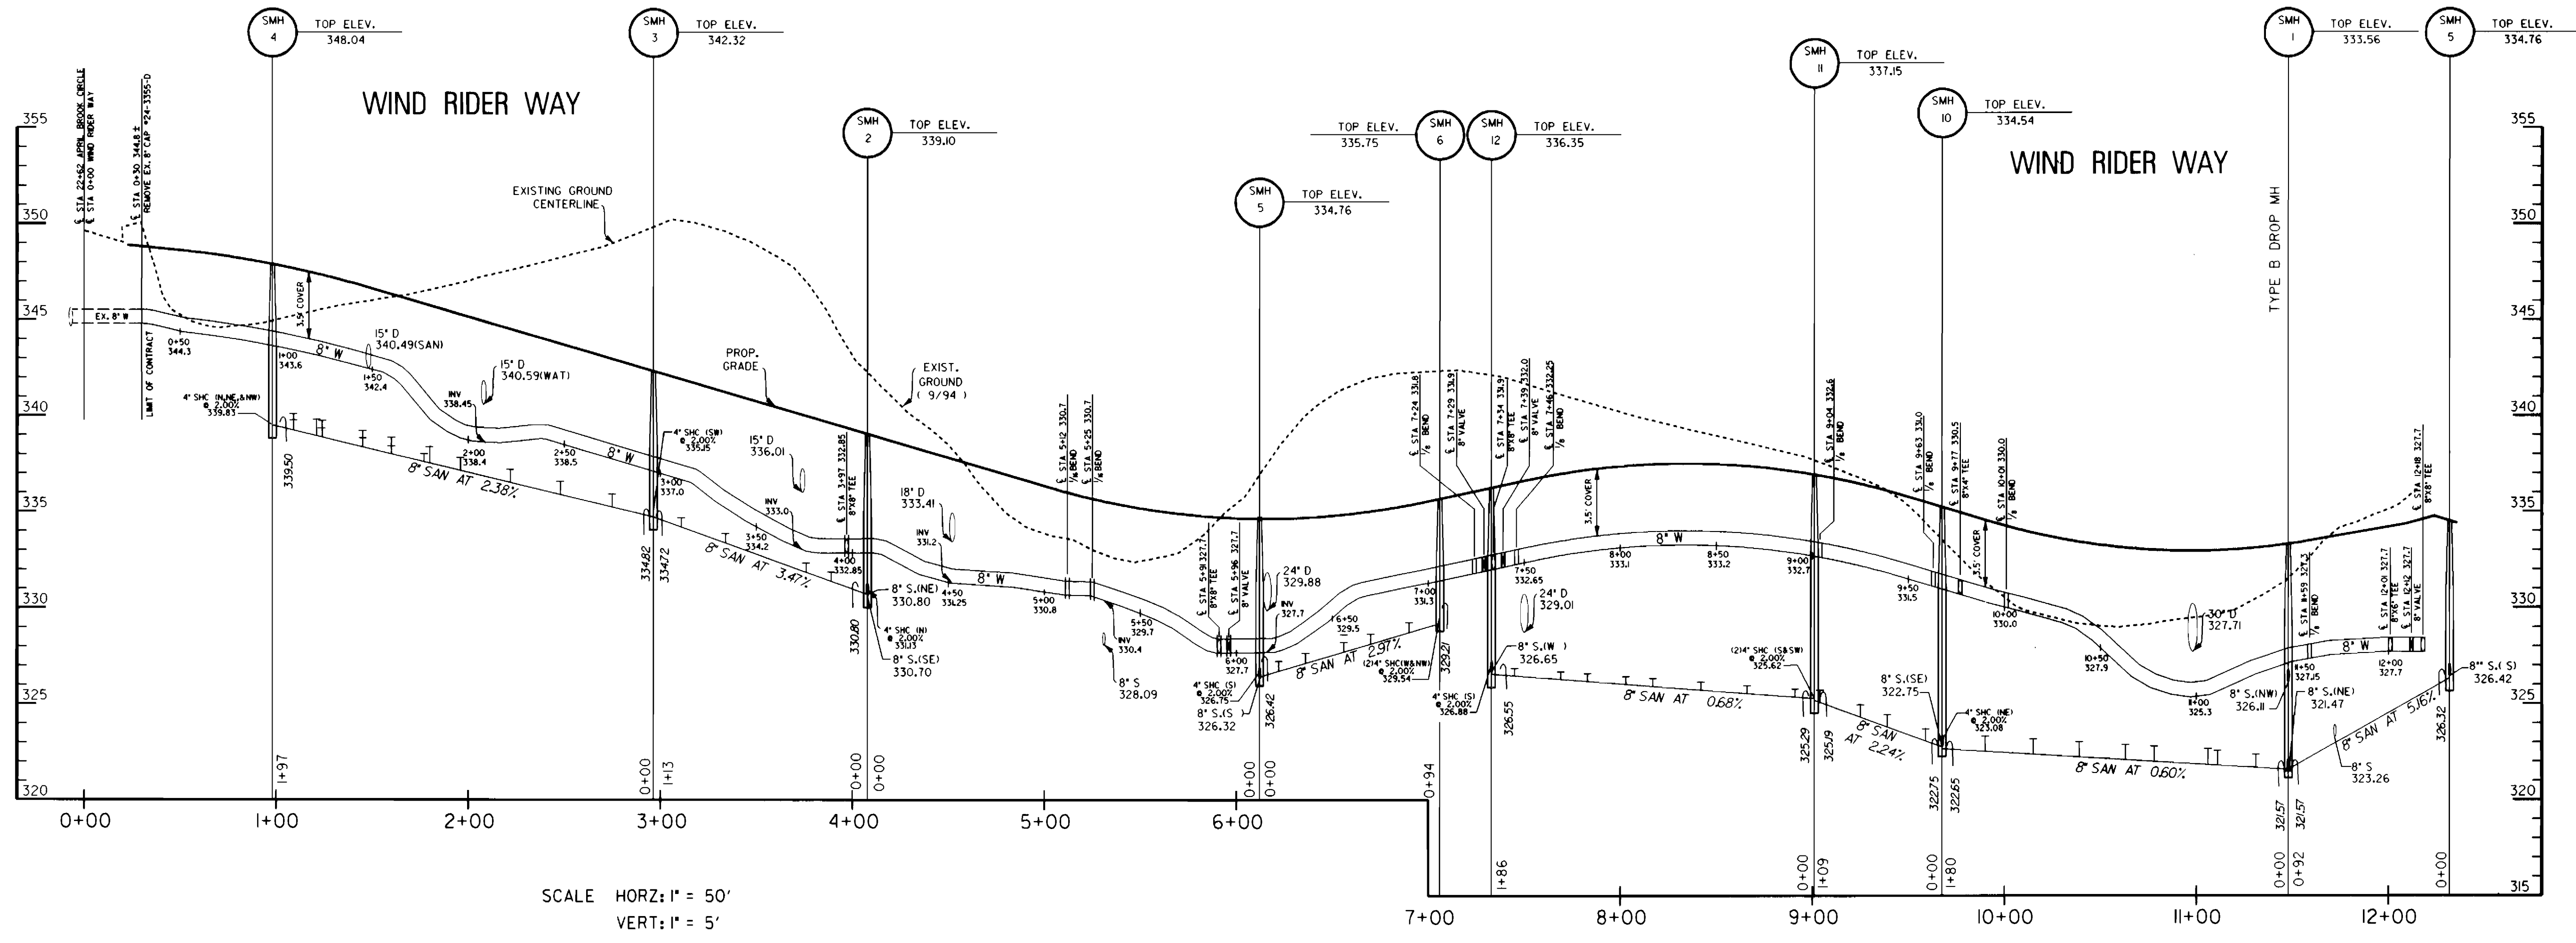


SCALE HORZ: 1" = 50'
VERT: 1" = 5'

SCALE HORZ: 1" = 50'
VERT: 1" = 5'

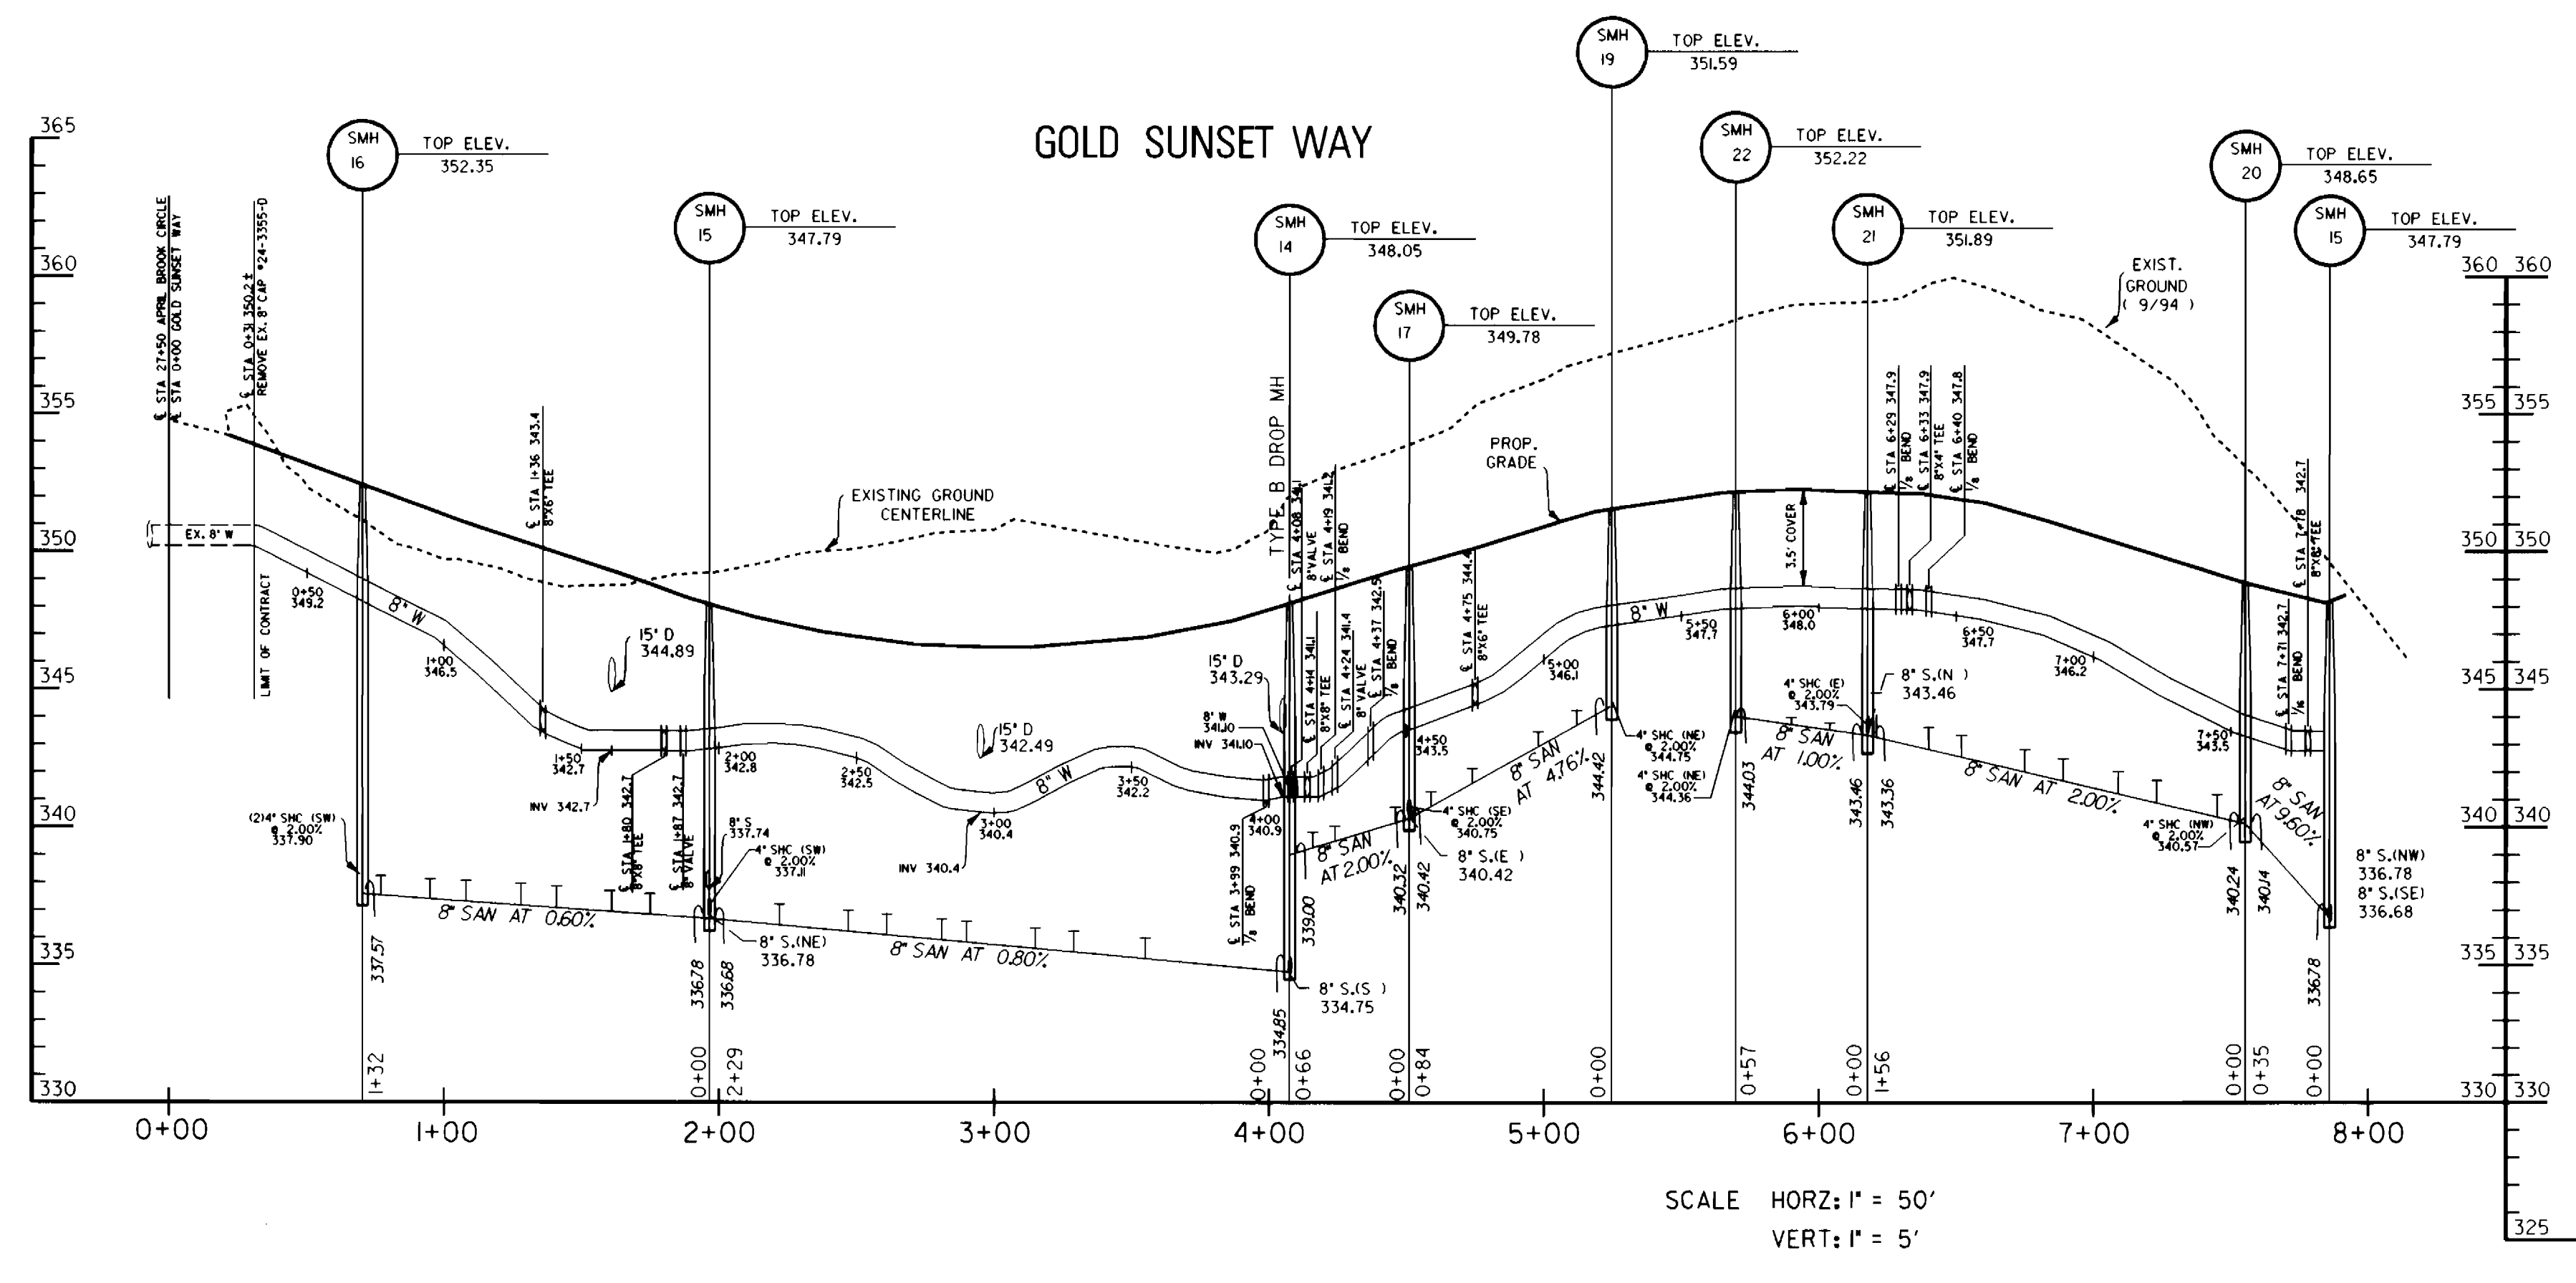

SCALE HORZ: 1" = 50'
VERT: 1" = 5'

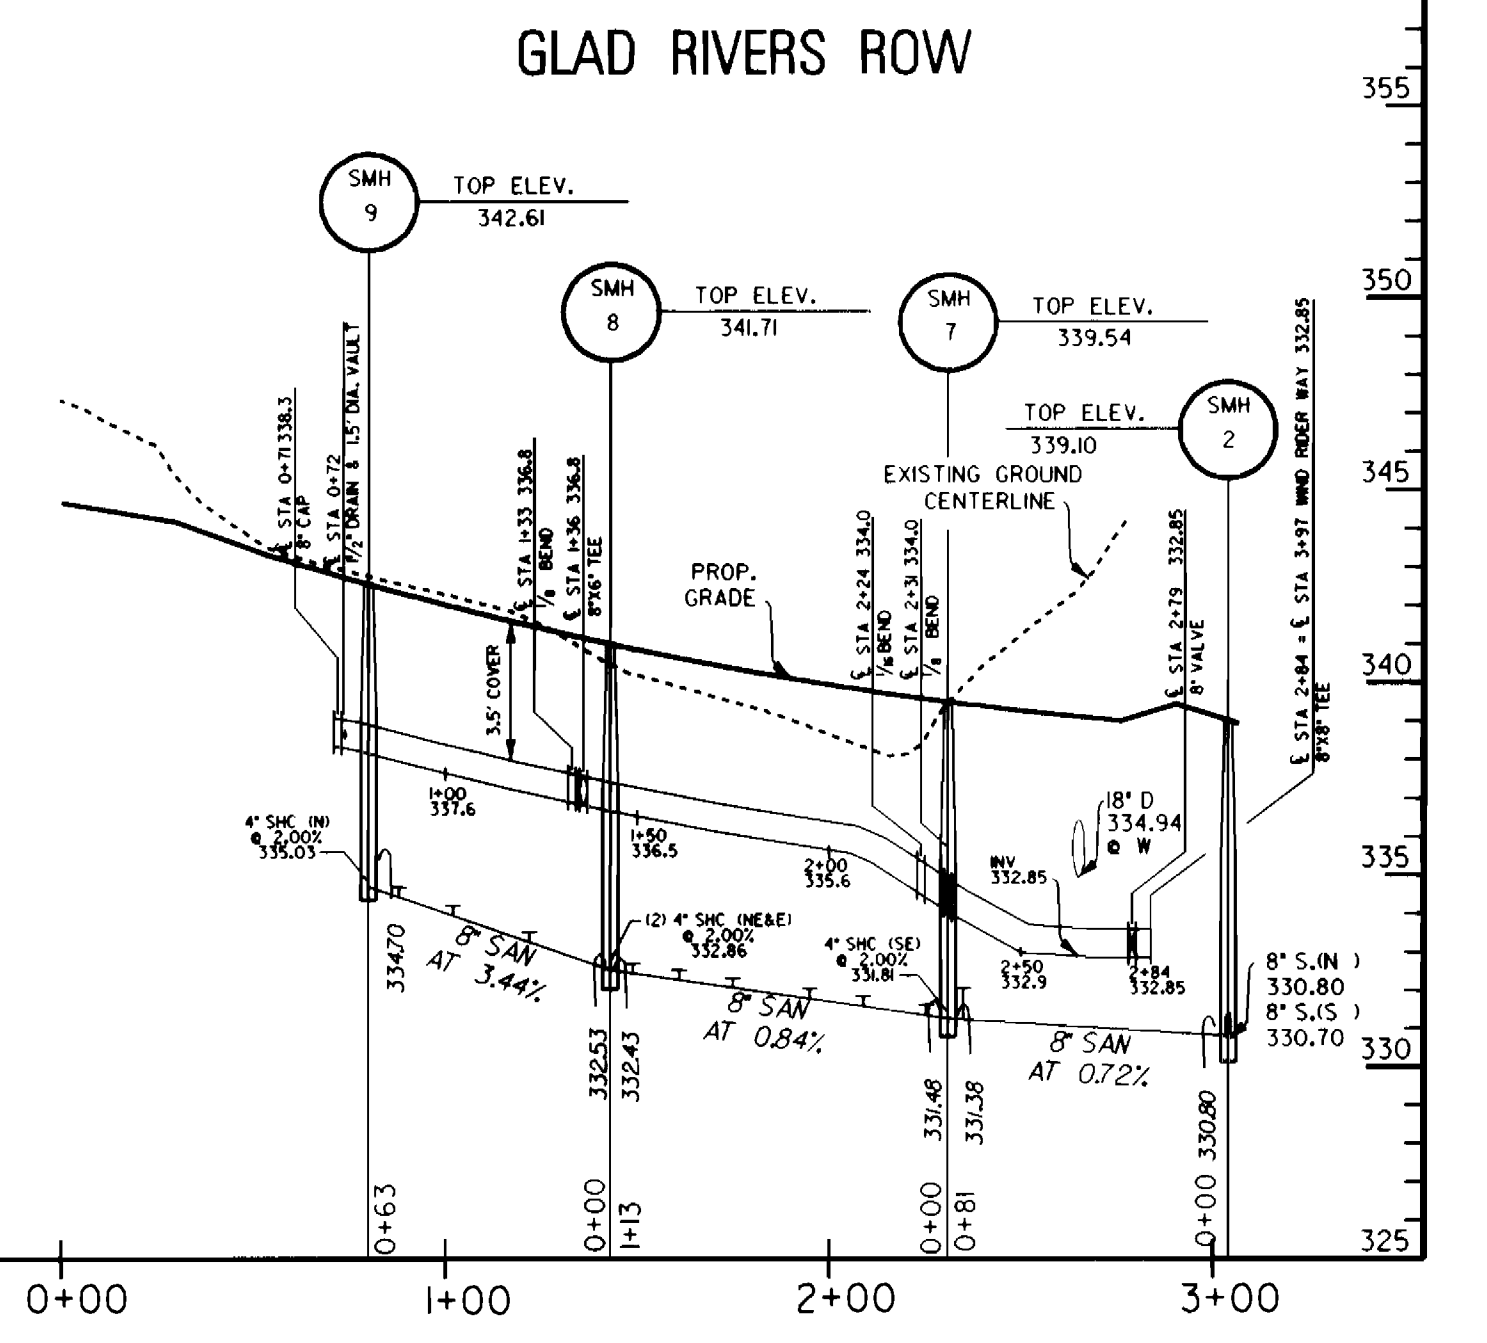


DEPARTMENT OF PUBLIC WORKS HOWARD COUNTY, MARYLAND	DEPARTMENT OF PLANNING & ZONING HOWARD COUNTY, MARYLAND	DMW <small>Daft McCune-Walker, Inc.</small> 200 East Pennsylvania Avenue A Team of Land Planners, Towson, Maryland 21286 (410) 286-3333 Fax 296-4706		DESIGN BY: _____ DRAWN BY: _____ CHECKED BY: _____ DATE: _____	WATER & SEWER PROFILES	VILLAGE OF LONGREACH SECTION 4 AREA 2 LOTS E1-E95 & F1-F57 6th ELECTION DISTRICT CONTRACT NO. 24-3422-D	SCALE 1" = 50' HOR. 1" = 5' VERT. SHEET 3 OF 4 S
CHIEF - BUREAU OF UTILITIES - DATE _____		CM/EF, DEVELOPMENT ENGINEERING DIVISION DATE _____		JUNE 95 BY NO. _____ REVISION _____ DATE _____	600 SCALE MAP NO. 37 BLOCK NO. 13	CONTRACT NO. 24-3422-D	


Tue Jun 20 15:39:28 1995 d:\94020\94020.dwg

3422 ws/4 VLR 4/2


ALONG SEWER & UTILITY EASEMENT

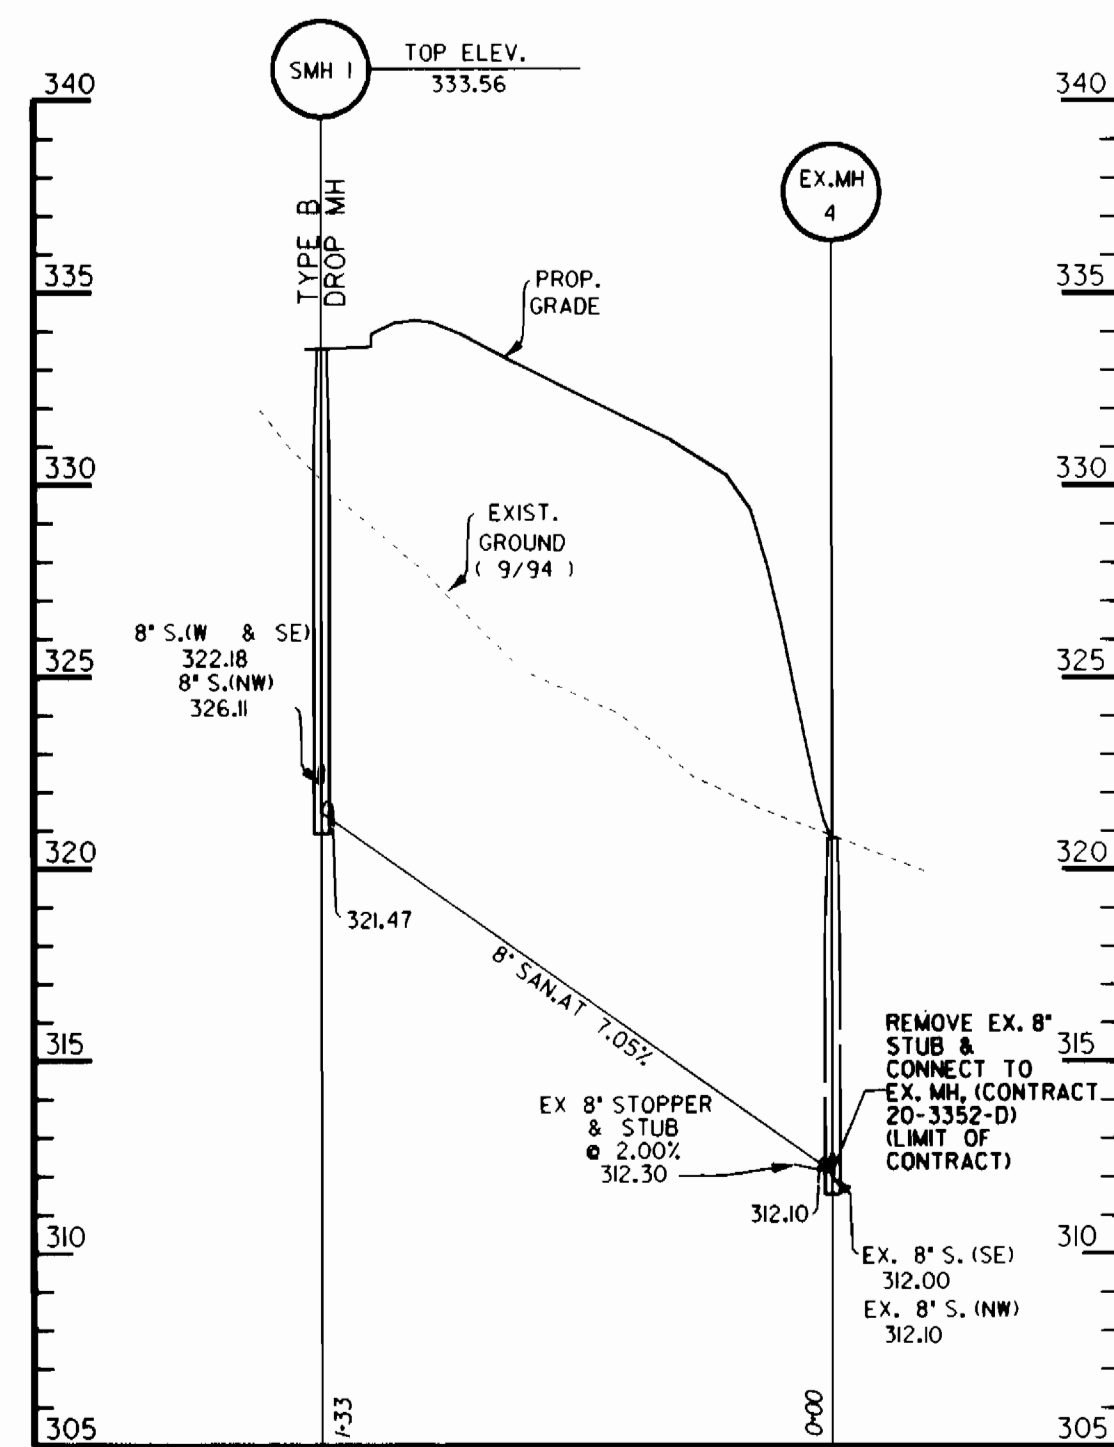


ALONG SEWER, WATER & UTILITY EASEMENT

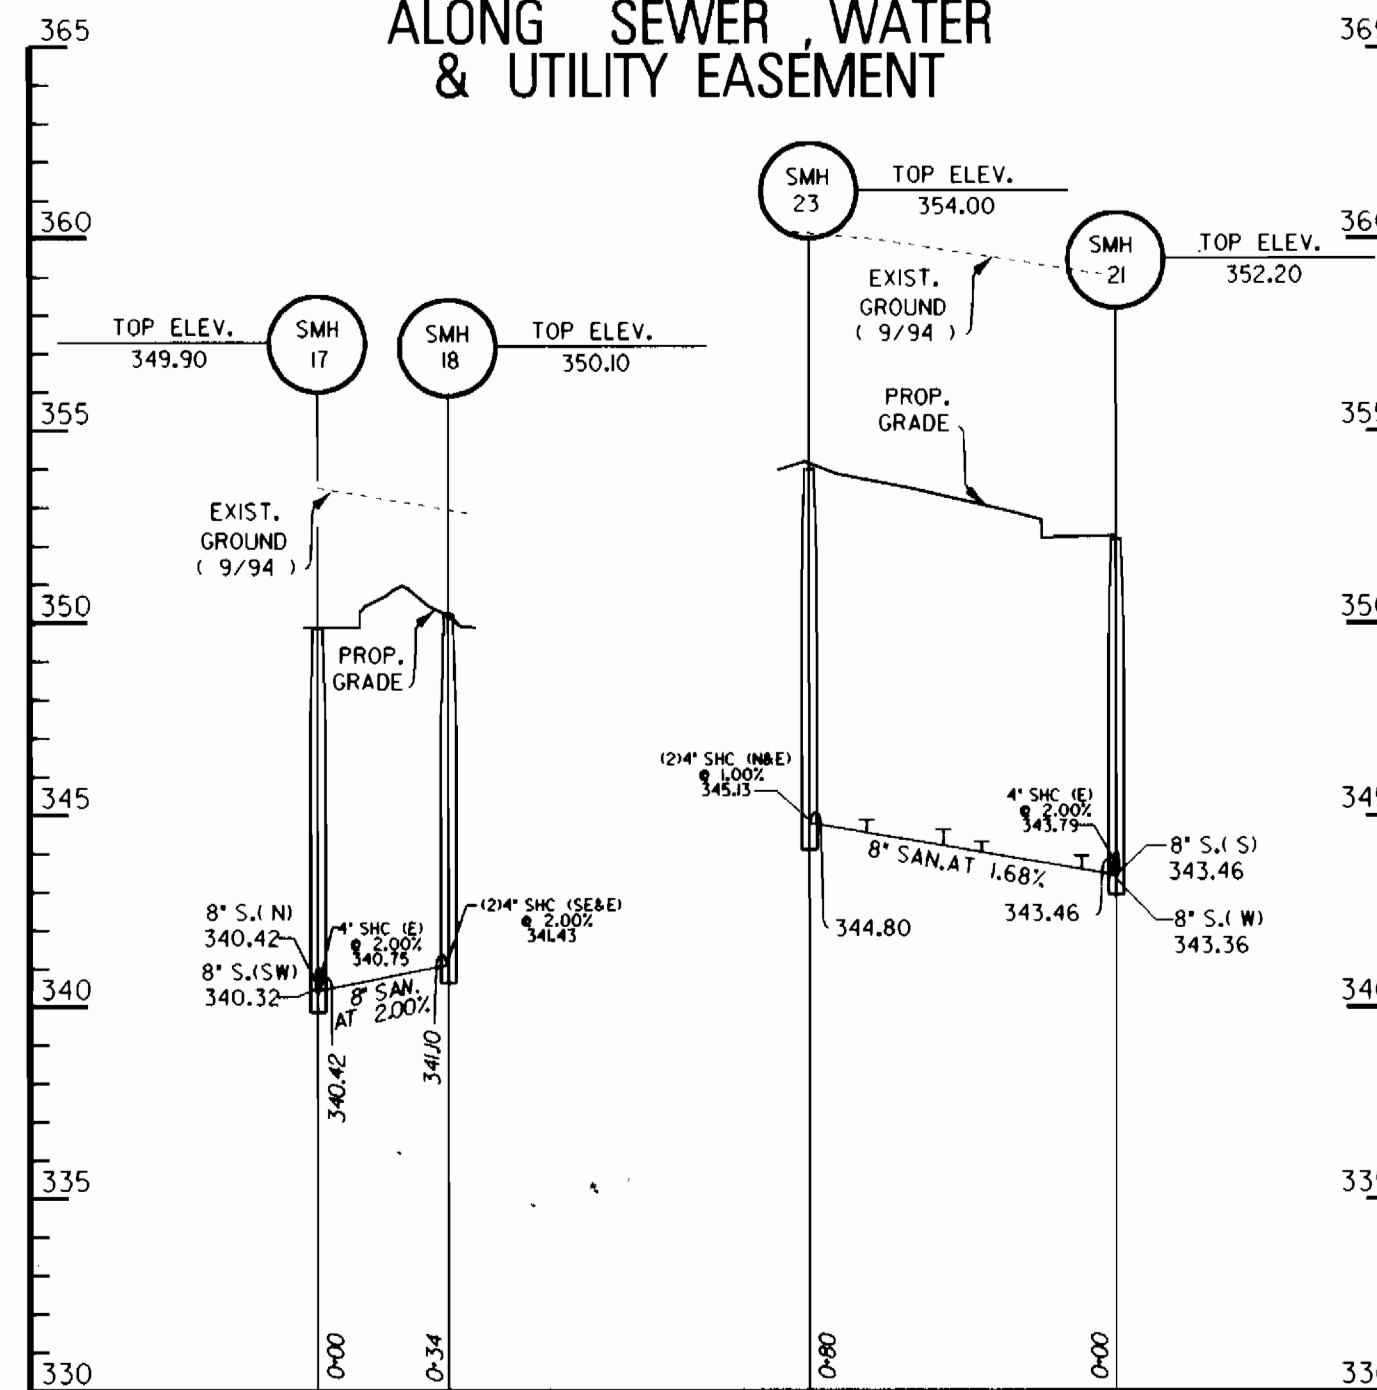


ALONG DRAINAGE, SEWER & UTILITY EASEMENT

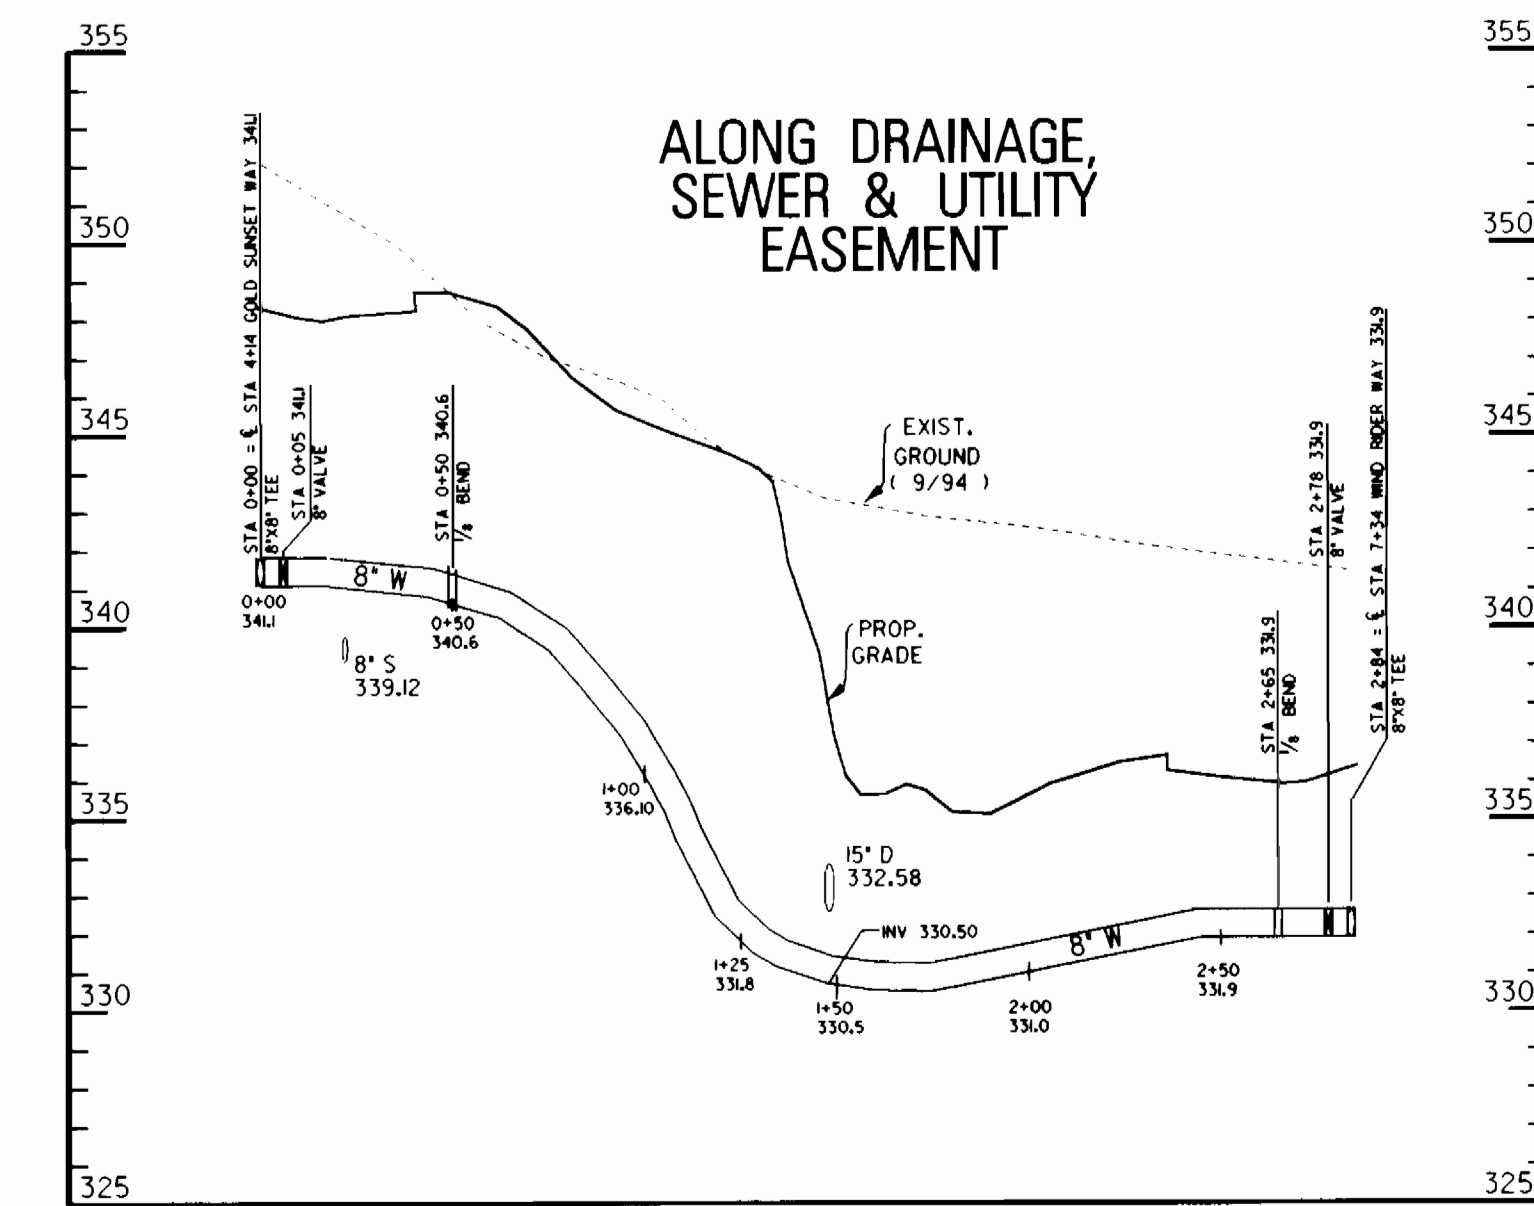


ALONG DRAINAGE, SEWER & UTILITY EASEMENT

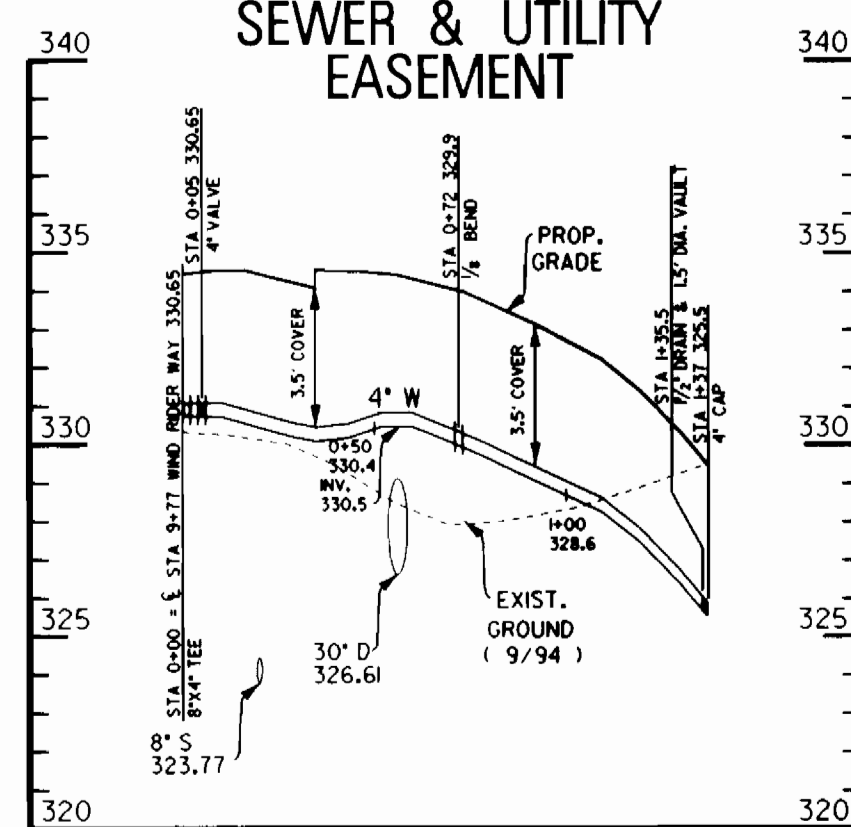


ALONG SEWER & UTILITY EASEMENT

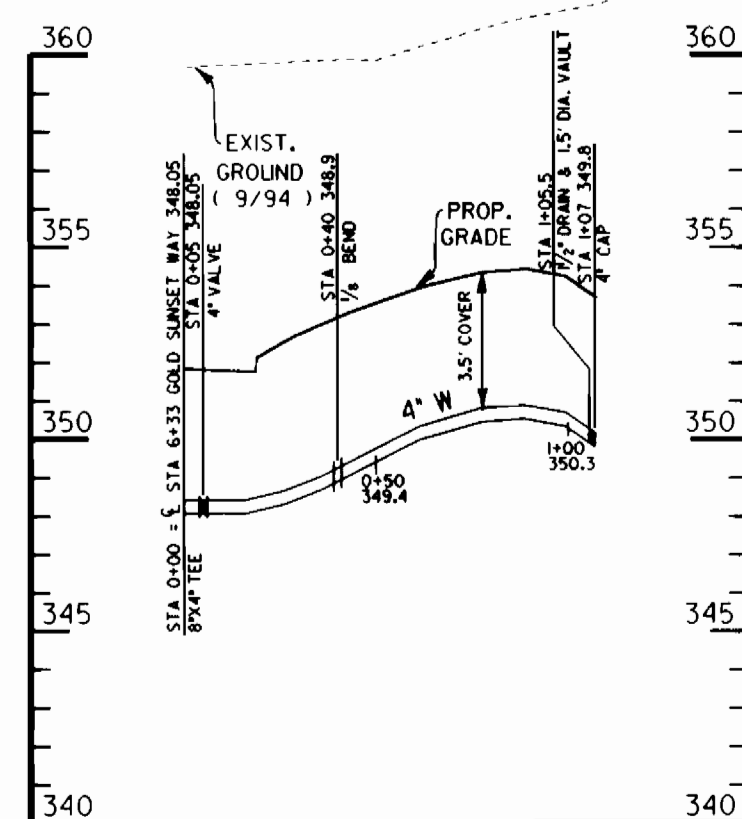


ALONG DRAINAGE, SEWER & UTILITY EASEMENT

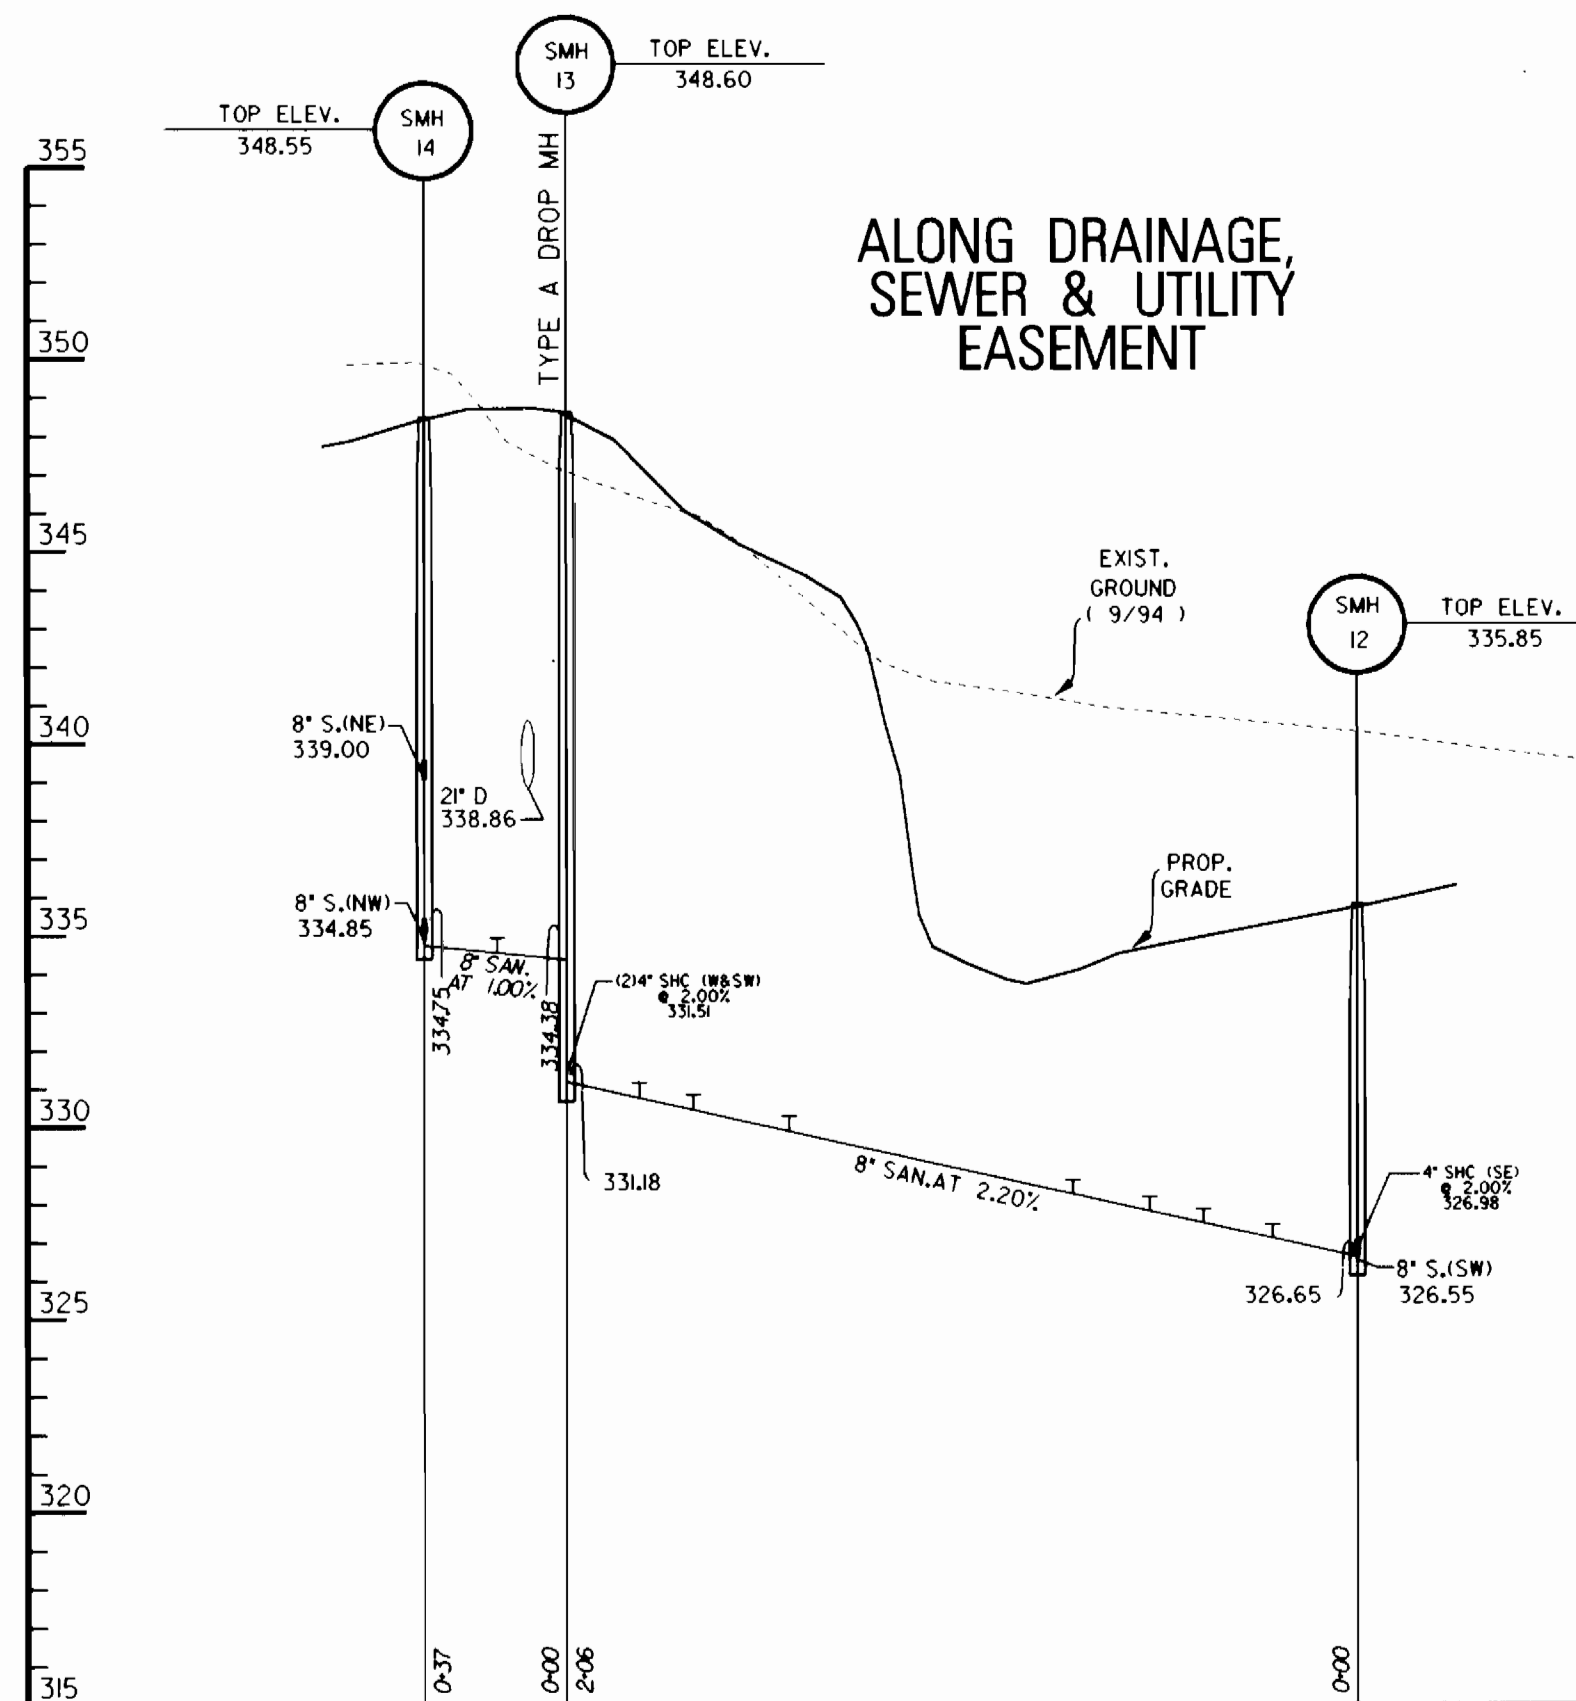

ALONG DRAINAGE, SEWER & UTILITY EASEMENT

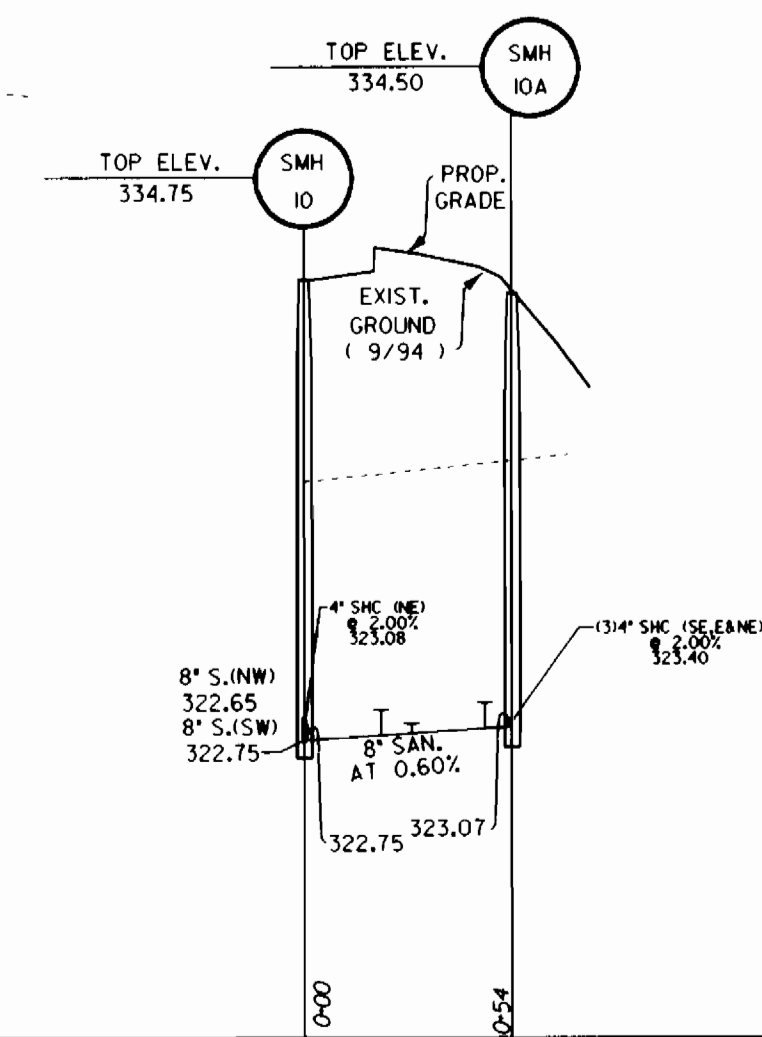

WIND RIDER WAY

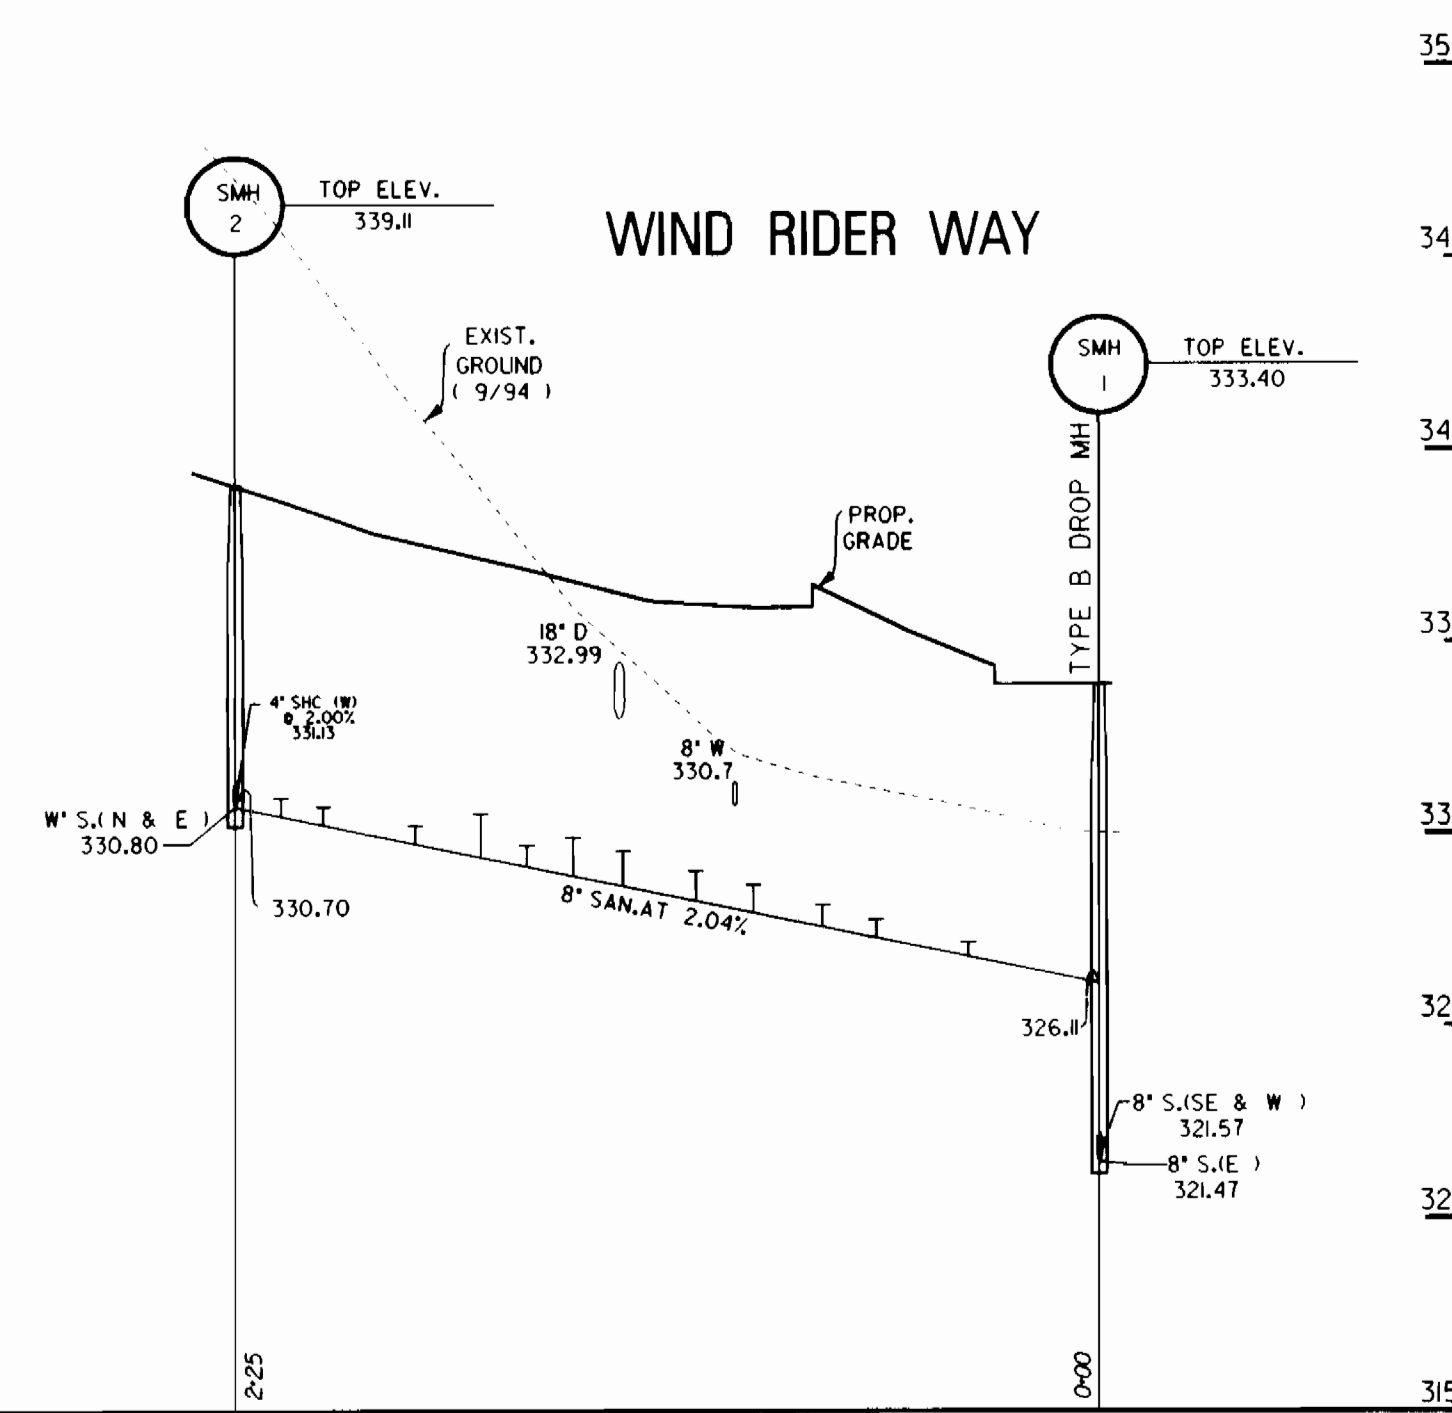


SCALE HORZ: 1" = 50'
VERT: 1" = 5'

DEPARTMENT OF PUBLIC WORKS
HOWARD COUNTY, MARYLAND

DEPARTMENT OF PLANNING & ZONING
HOWARD COUNTY, MARYLAND

DMW
Duff McCune-Walker, Inc.
200 East Pennsylvania Avenue A Team of Land Planners,
Towson, Maryland 21286
(410) 296-3333
Engineers, Surveyors &
Environmental Professionals

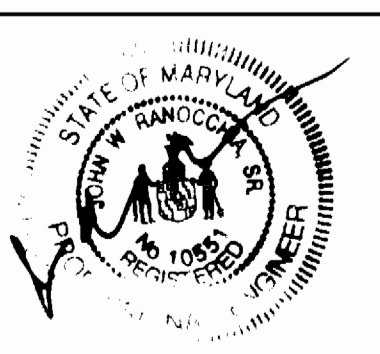

DESIGN BY:	CEV			
DRAWN BY:	CEV			
CHECKED BY:	JWR			
DATE:	JUNE 95	BY	NO.	REVISION

WATER & SEWER PROFILES

800 SCALE MAP NO. 37 BLOCK NO. 13

VILLAGE OF LONGREACH
SECTION 4 AREA 2
LOTS E1-E95 & F1-F57
6th ELECTION DISTRICT
CONTRACT NO. 24-3422-D

SCALE
1" = 50' HOR.
1" = 5' VERT.

SHEET
4 OF 5

3422 AS-BLT INFO.

SEWER AS-BUILTS

WATER AS-BUILTS

Table with columns for Lot #, Sewer AS-Builts, and Water AS-Builts. Each lot entry includes specific dimensions and lot numbers for sewer and water connections.

DEPARTMENT OF PUBLIC WORKS HOWARD COUNTY, MARYLAND

DIRECTOR OF PUBLIC WORKS DATE CHIEF, BUREAU OF ENGINEERING DATE

Table with columns for DES, DRN, CHK, DATE, BY, NO., REVISION, DATE.

SEWER & WATER AS-BUILTS

VILLAGE OF LONGREACH SECTION 4 AREA 2 LOTS E1-E9S & F1-F57

SCALE AS SHOWN SHEET 5 OF 5

JAY WHITE MARSH, MD.