


sect. 23, Ph. 1
lots 9-26

WS/1 MT. HEBRON

3513

QUANTITIES				
ITEM	ESTIMATED	QUANTITIES	AS-BUILT	SUPPLIER
8" SEWER	1,742 L.F.	1,573 L.F.	SDR 35	E.T.I.
8" SEWER (D.I.P.)	632 L.F.	848 L.F.	CL-52	Griffin
4" SEWER	399 L.F.	446 L.F.	SDR 35	E.T.I.
SEWER MANHOLES	12 EACH	12 EA.	Precast	Atlantic C.P.
8" WATER	1,432 L.F.	1,382	CL-52	Griffin C.P.
6" WATER	70 L.F.	83 L.F.	CL-52	Griffin C.P.
1" WHC	26 L.F.	70 L.F.	K Type Copper	Cambridge
3/4" WHC	494 L.F.	421 L.F.	K Type Copper	Lee
FIRE HYDRANTS	3 EACH	3 EA.		Kennedy
AIR RELEASE MH	1 EACH	1 EA.	Precast	Atlantic C.P.
8" x 8" TEE	1 EACH	1 EA.	CL-350 DIP	Mueller
8" x 6" TEE	3 EACH	3 EA.	CL-350 DIP	Mueller
8" VALVE	4 EACH	4 EA.	Gate Valve	Kennedy
6" VALVE	3 EACH	3 EA.	Gate Valve	Kennedy
8" - 1/2" HD	2 EACH	3 EA.	CL-350 DIP	Mueller
8" - 1/2" HD	1 EACH	1 EA.	CL-350 DIP	Mueller
8" PLUG & OUTLETS	1 EACH	1 EA.	CL-350 DIP	Mueller

NAME OF UTILITY CONTRACTOR: C.C.S. Inc.
SURVEY & DRAFTING DIVISION AS-BUILT DATE:

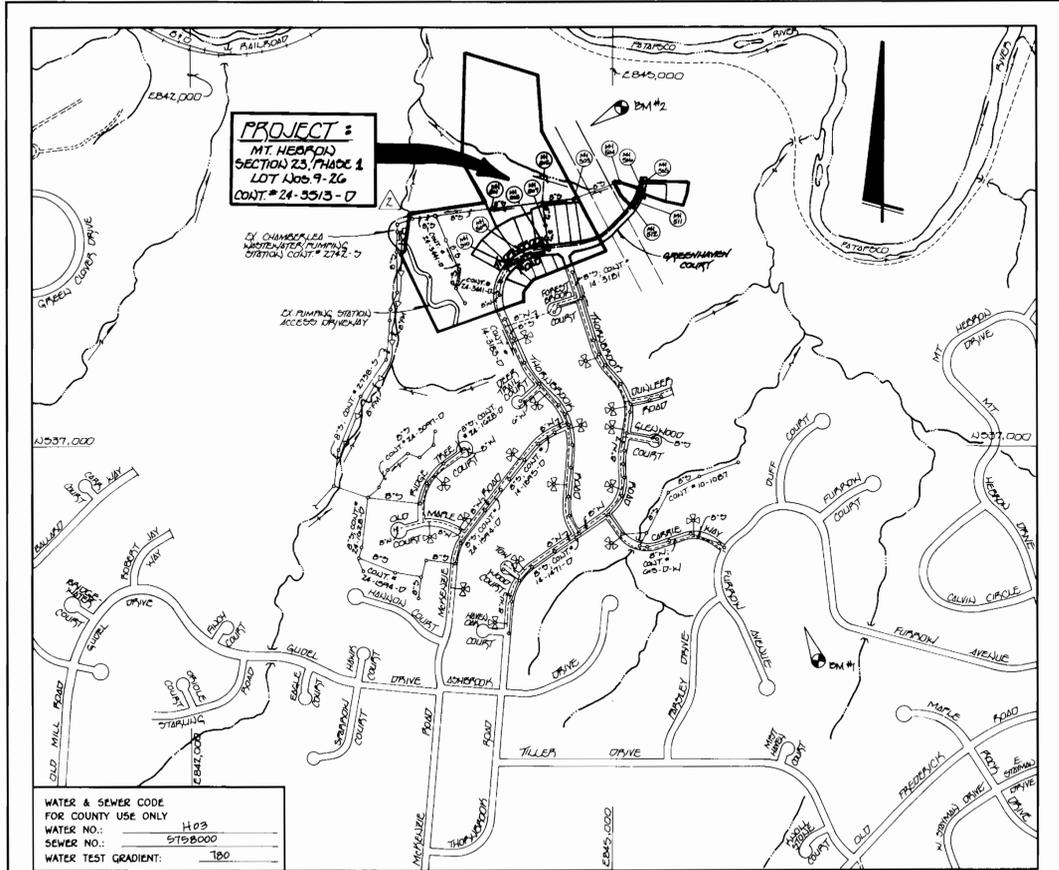

WATER & SEWER CODE FOR COUNTY USE ONLY	WATER NO.:	H03
	SEWER NO.:	510B000
	WATER TEST GRADIENT:	180

TYPE OF BUILDING:	RESIDENTIAL; SINGLE FAMILY DETACHED
NUMBER OF LOTS:	18 (17 BULLDOZED)
NO. OF WATER HOUSE CONNECTIONS:	17
NO. OF SEWER HOUSE CONNECTIONS:	17
DRAINAGE AREA:	PATAWCO
TREATMENT PLANT:	PATAWCO WASTEWATER TREATMENT PLANT VIA THE CHAMBERLAIN PUMPING STATION
NO. OF WHC'S FOR FUTURE LOTS:	2
NO. OF SHC'S FOR FUTURE LOTS:	2

VICINITY MAP

SCALE: 1"=600'

PLAN REFERENCE NUMBERS:	P-96-12
	F-96-193

GENERAL NOTES

- APPROXIMATE LOCATION OF EXISTING MAINS ARE SHOWN. THE CONTRACTOR SHALL TAKE ALL NECESSARY PRECAUTIONS TO PROTECT EXISTING MAINS AND SERVICES AND MAINTAIN UNINTERRUPTED SUPPLY. ANY DAMAGE INCURRED SHALL BE REPAIRED IMMEDIATELY TO THE SATISFACTION OF THE ENGINEER AT THE CONTRACTOR'S EXPENSE.
- ALL HORIZONTAL CONTROLS ARE BASED ON MARYLAND STATE COORDINATES.
- ALL VERTICAL CONTROLS ARE BASED ON U.S.G.S. DATUM.
- ALL PIPE ELEVATIONS ARE INVERT ELEVATIONS.
- CLEAR ALL UTILITIES BY A MINIMUM OF 6". CLEAR ALL POLES BY 2'-0" MINIMUM.
- FOR DETAILS NOT SHOWN ON THE DRAWINGS, AND FOR MATERIALS AND CONSTRUCTION METHODS, USE HOWARD COUNTY DESIGN MANUAL VOLUME IV, STANDARD SPECIFICATIONS AND DETAILS FOR CONSTRUCTION (1991 AMENDMENTS) THE CONTRACTOR SHALL HAVE A COPY OF VOLUME IV ON THE JOB SITE.
- WHERE TEST PITS HAVE BEEN MADE ON EXISTING UTILITIES, THEY ARE NOTED BY THE SYMBOL AT THE LOCATION OF THE TEST PIT. A NOTE OR NOTES CONTAINING THE RESULTS OF THE TEST PIT OR PITS IS INCLUDED ON THE DRAWINGS. EXISTING UTILITIES IN THE VICINITY OF THE PROPOSED WORK FOR WHICH TEST PITS HAVE NOT BEEN DUG SHALL BE VERIFIED BY THE CONTRACTOR TO HIS OWN SATISFACTION. ANY DAMAGE TO EXISTING FACILITIES DUE TO THE CONTRACTOR'S NEGLIGENCE SHALL BE REPAIRED AT THE CONTRACTOR'S EXPENSE.
- CONTRACTOR SHALL NOTIFY THE FOLLOWING UTILITIES OR AGENCIES AT LEAST FIVE WORKING DAYS BEFORE STARTING WORK SHOWN ON THESE PLANS:
 - STATE HIGHWAY ADMINISTRATION - 531-5533
 - BALTIMORE GAS & ELECTRIC CO. - CONTRACTOR SERVICES - 850-4620
 - BALTIMORE GAS & ELECTRIC CO. - UNDER GROUND DAMAGE CONTROL - 787-9068
 - MISS UTILITY - 1-800-257-7777
 - COLONIAL PIPELINE CO. - 795-1390
 - BUREAU OF UTILITIES, HOWARD COUNTY DEPARTMENT OF PUBLIC WORKS - 313-4900
- TREES AND SHRUBS ARE TO BE PROTECTED FROM DAMAGE TO MAXIMUM EXTENT. TREES AND SHRUBS LOCATED WITHIN THE CONSTRUCTION STRIP ARE NOT TO BE REMOVED OR DAMAGED BY THE CONTRACTOR.
- CONTRACTOR SHALL REMOVE TREES, STUMPS AND ROOTS ALONG THE LINE OF EXCAVATION. PAYMENT FOR SUCH REMOVAL SHALL BE INCLUDED IN THE UNIT PRICE BID FOR CONSTRUCTION OF THE MAIN.
- ALL SEWER MAINS SHALL BE D.I.P. OR P.V.C. UNLESS OTHERWISE NOTED.
- ALL MANHOLES SHALL BE 4'-0" INSIDE DIAMETER UNLESS OTHERWISE NOTED.
- T.B. DENOTES TEST BORING.
- MANHOLES SHOWN WITH 12" AND 18" WALLS ARE FOR BRICK MANHOLES ONLY.
- MANHOLES DESIGNATED W.T. IN PLAN AND PROFILE SHALL HAVE WATERTIGHT FRAME AND COVERS, STANDARD DETAIL G 5.52.
- WHERE WATERTIGHT MANHOLE FRAME AND COVER IS USED, SET TOP OF FRAME 1'-6" ABOVE FINISHED GRADE UNLESS OTHERWISE NOTED ON THE PLANS OR IN THE SPECIFICATIONS.
- HOUSE(S) WITH THE SYMBOL "C.N.S." INDICATES THAT THE CELLAR CANNOT BE SERVED.
- ALL WATER HOUSE CONNECTIONS SHALL BE FOR INSIDE METER SETTING, UNLESS OTHERWISE NOTED ON THE PLANS OR IN THE SPECIFICATIONS.
- MANHOLES LOCATED WITHIN THE PROPOSED ROADWAY SHALL HAVE STANDARD HEAVY TRAFFIC MANHOLE FRAMES AND COVERS, STANDARD DETAIL G5.51.
- WATER MAINS AND WATER HOUSE CONNECTION LINES MUST BE PLACED AS TO HAVE ONE (1) FOOT SEPARATION FROM THE SEWER MAIN OR SEWER HOUSE CONNECTION AS THEY PASS ABOUT IT.
- ALL WATER MAINS SHALL BE D.I.P., CLASS 52 UNLESS OTHERWISE NOTED.
- TOPS OF ALL WATER MAINS TO HAVE A MINIMUM OF 3'-1/2" COVER UNLESS OTHERWISE NOTED.
- VALVES ADJACENT TO TREES SHALL BE STRAPPED TO TREES.
- ALL FITTINGS SHALL BE BUTTRESSED OR ANCHORED WITH CONCRETE IN ACCORDANCE WITH THE STANDARD DETAILS UNLESS OTHERWISE PROVIDED FOR ON THE DRAWINGS.
- FIRE HYDRANTS SHALL BE SET TO THE BURY LINE ELEVATION SHOWN ON THE DRAWINGS. ALL FIRE HYDRANTS SHALL BE RESTRAINED AND BUTTRESSED WITH CONCRETE IN ACCORDANCE WITH THE STANDARD DETAILS (W1.11 AND W2.13). SOIL AROUND THE FIRE HYDRANT SHALL BE COMPACTED IN ACCORDANCE WITH SECTION 1000 AND 1005 OF THE STANDARD SPECIFICATIONS.
- THE CONTRACTOR SHALL NOT OPERATE ANY WATER MAIN VALVES ON THE EXISTING WATER SYSTEM.
- ALL D.I.P. FITTINGS SHALL BE IN ACCORDANCE WITH AWWA SPECIFICATIONS C-153; DUCTILE IRON COMPACT FITTINGS, 3-INCH THROUGH 12-INCH FOR WATER AND OTHER LIQUIDS.
- THE CONTRACTOR SHALL NOTIFY THE BUREAU OF HIGHWAYS, HOWARD COUNTY, @ (410) 313-2450 AT LEAST FIVE WORKING DAYS BEFORE ANY OPEN CUT OF ANY COUNTY ROAD OR BORING/JACKING OPERATION IN COUNTY ROADS FOR LAYING WATER/SEWER MAINS OR HOUSE CONNECTIONS. THE APPROVAL OF THESE DRAWINGS WILL CONSTITUTE COMPLIANCE WITH DW REQUIREMENTS PER SECTION 18.114(f) OF THE HOWARD COUNTY CODE.

ENGINEER'S CERTIFICATE

I HEREBY CERTIFY THAT THIS PLAN FOR EROSION AND SEDIMENT CONTROL REPRESENTS A PRACTICAL AND WORKABLE PLAN BASED ON MY PERSONAL KNOWLEDGE OF THE SITE CONDITIONS AND THAT IT WAS PREPARED IN ACCORDANCE WITH THE REQUIREMENTS OF THE HOWARD SOIL CONSERVATION DISTRICT.

Paul W. Koebel
SIGNATURE OF ENGINEER

06/18/96
DATE

DEVELOPER'S CERTIFICATE

I HEREBY CERTIFY THAT ALL DEVELOPMENT AND CONSTRUCTION WILL BE DONE ACCORDING TO THIS PLAN OF DEVELOPMENT AND PLAN FOR EROSION AND SEDIMENT CONTROL AND THAT ALL RESPONSIBLE PERSONNEL INVOLVED IN THE CONSTRUCTION PROJECT WILL HAVE A CERTIFICATE OF ATTENDANCE AT A DEPARTMENT OF THE ENVIRONMENT APPROVED TRAINING PROGRAM FOR THE CONTROL OF SEDIMENT AND EROSION BEFORE BEGINNING THE PROJECT. I ALSO AUTHORIZE PERIODIC ON-SITE INSPECTION BY THE HOWARD SOIL CONSERVATION DISTRICT OF THEIR AUTHORITY AGENTS AS ARE DEEMED NECESSARY.

Michael J. McCann for H.J. Bruce
SIGNATURE OF DEVELOPER

01/18/96
DATE

CONTRACT No. 24-3513-D
MT. HEBRON

SECTION 23 - PHASE 1
LOT NOS. 9-26

WATER AND SEWER MAIN EXTENSIONS
HOWARD COUNTY, MARYLAND

REVIEWED FOR HOWARD COUNTY SOIL CONSERVATION DISTRICT AND MEETS TECHNICAL REQUIREMENTS.

J. H. Warkel 7/30/95
U.S.D.A. NATURAL RESOURCES CONSERVATION SERVICE DATE

THIS DEVELOPMENT IS APPROVED FOR EROSION AND SEDIMENT CONTROL BY HOWARD SOIL CONSERVATION DISTRICT.

APPROVED: *Michael J. McCann for H.J. Bruce* 7/30/95
HOWARD SOIL CONSERVATION DISTRICT DATE

SEDIMENT CONTROL MEASURES FOR THIS CONTRACT WILL BE IMPLEMENTED IN ACCORDANCE WITH SECTION 219 OF THE HOWARD COUNTY DESIGN MANUAL & STANDARDS AND SPECIFICATIONS FOR SOIL EROSION AND SEDIMENT CONTROL IN DEVELOPING AREAS AS SHOWN ON THESE PLANS AND UNDER F-96-153.

Michael J. McCann for H.J. Bruce 6/18/96
SIGNATURE OF DEVELOPER DATE

BENCHMARKS

BM #1	N 535 573 189	ELEV. +466.8
	E 846 324 490	
	HOWARD COUNTY MONUMENT # 3442011; 3/4"	
	REINFORCING ROD	
BM #2	N 539 292 989	ELEV. +426.8
	E 844 846 447	
	HOWARD COUNTY MONUMENT # 3541004; 3/4"	
	REINFORCING ROD	


Water & Sewer As-Builts

CONTRACT NO. 24-3513-D
MT. HEBRON
SECTION 23 - PHASE 1
LOT NOS. 9-26
WATER AND SEWER MAIN EXTENSIONS
HOWARD COUNTY, MARYLAND

DEPARTMENT OF PUBLIC WORKS HOWARD COUNTY, MARYLAND	DEPARTMENT OF PLANNING AND ZONING HOWARD COUNTY, MARYLAND	Fisher, Collins & Carter, Inc. CIVIL ENGINEERING CONSULTANTS & LAND SURVEYORS CENTENNIAL SQUARE OFFICE PARK 10272 Baltimore National Pike Ellicott City, Maryland 21042 (410) 481-2855	#9757 TERRELL A. FISHER	DES: M.J.M. DRWN: J.M.M. CHK: P.W.K. DATE:	F.C.C. <input checked="" type="checkbox"/> REVISE VICINITY MAP (SEWER MAINS LOCATIONS) AUG. 96 F.C.C. <input checked="" type="checkbox"/> REVISE QUANTITIES FOR 8" D.I.P. MAINS & B'S AUG. 96 BY: J.D. REVISION DATE:	TITLE SHEET	MT. HEBRON SECTION 23 - PHASE 1 LOT NOS. 9-26 CONTRACT NO. 24-3513-D SECOND ELECTION DISTRICT HOWARD COUNTY, MARYLAND	SCALE AS SHOWN SHEET 1 OF 5
---	--	---	----------------------------	---	---	-------------	--	--------------------------------

NOTE: THE EXISTING STORM DRAIN SYSTEM IN THORNBROOK ROAD, THE EXISTING S.W.M. FACILITY, EXISTING CHANNELS & THE EXISTING ACCESS DRIVEWAY TO THE S.W.M. FACILITY WAS CONSTRUCTED UNDER F-95-107

NOTE: AFTER THE COMPLETION OF THE SEWER MAIN CONSTRUCTION BETWEEN MH 502 & MH 503, ANY DISTURBANCE TO THE EXISTING KIRKPATRICK CHANNEL SHALL BE RECONSTRUCTED TO THE ORIGINAL DESIGN.

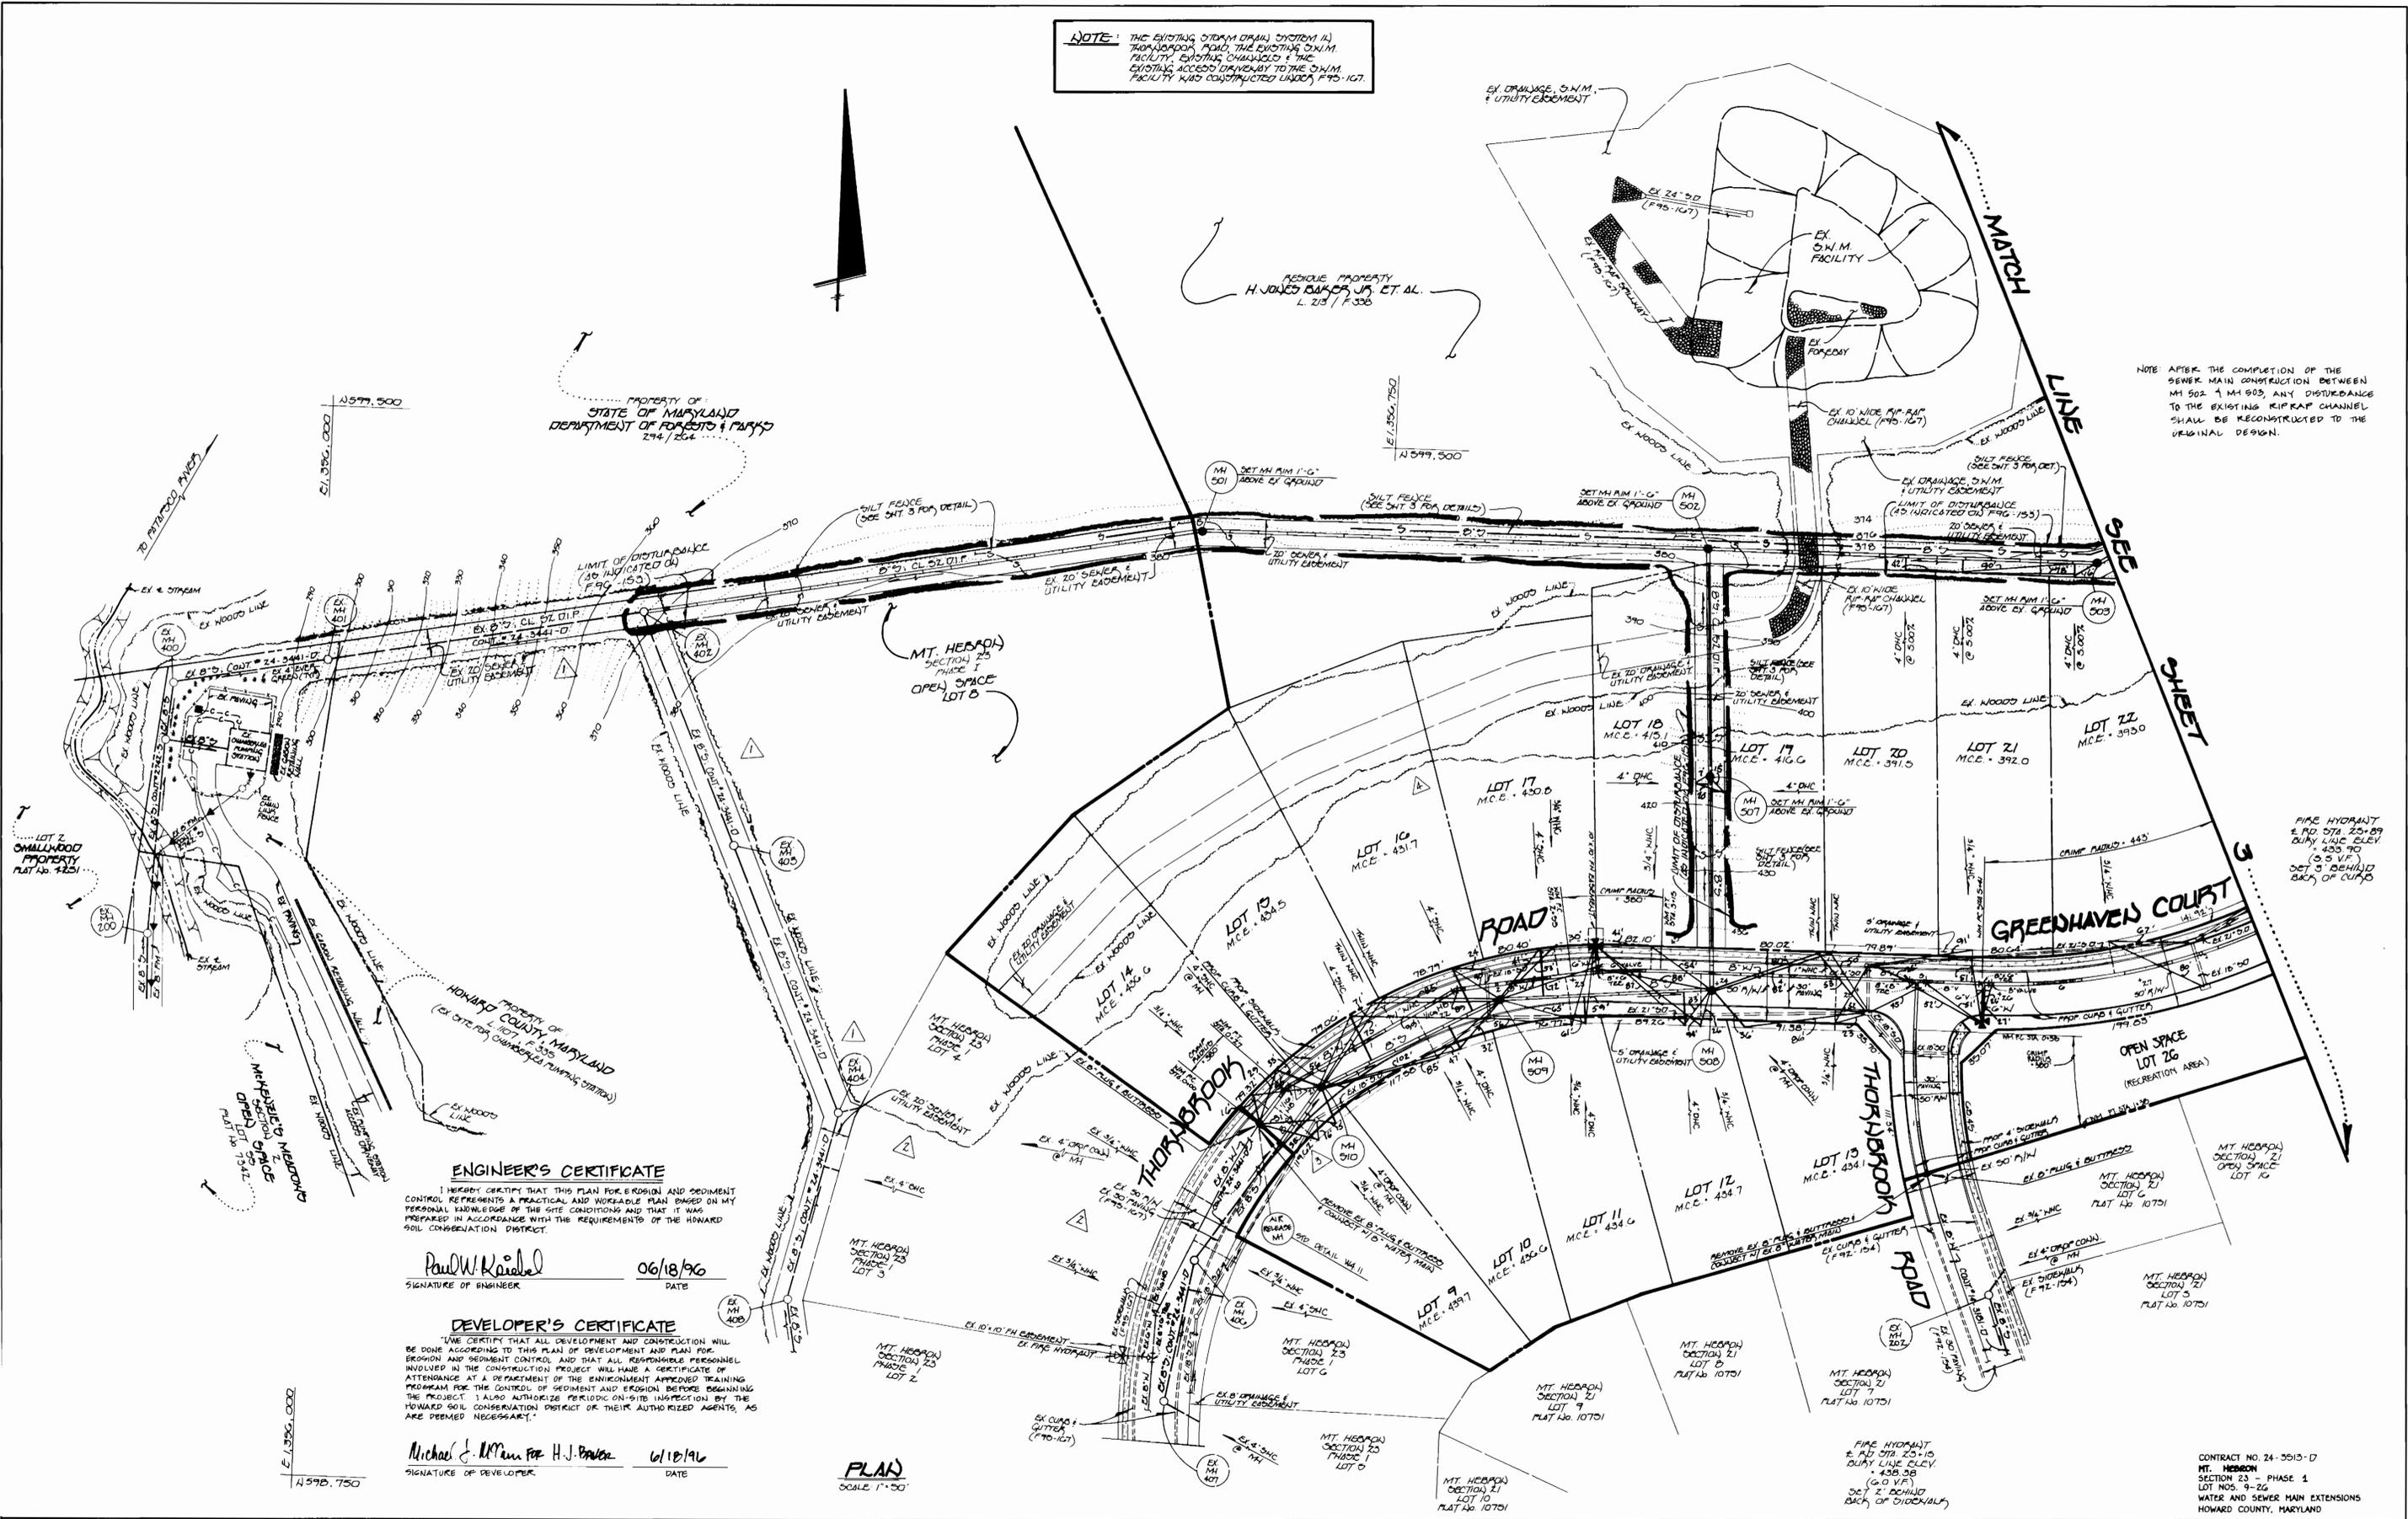

ENGINEER'S CERTIFICATE
 I HEREBY CERTIFY THAT THIS PLAN FOR EROSION AND SEDIMENT CONTROL REPRESENTS A PRACTICAL AND WORKABLE PLAN BASED ON MY PERSONAL KNOWLEDGE OF THE SITE CONDITIONS AND THAT IT WAS PREPARED IN ACCORDANCE WITH THE REQUIREMENTS OF THE HOWARD SOIL CONSERVATION DISTRICT.

Paul W. Kriebel 06/18/96
 SIGNATURE OF ENGINEER DATE

DEVELOPER'S CERTIFICATE
 I HEREBY CERTIFY THAT ALL DEVELOPMENT AND CONSTRUCTION WILL BE DONE ACCORDING TO THIS PLAN OF DEVELOPMENT AND PLAN FOR EROSION AND SEDIMENT CONTROL AND THAT ALL RESPONSIBLE PERSONNEL INVOLVED IN THE CONSTRUCTION PROJECT WILL HAVE A CERTIFICATE OF ATTENDANCE AT A COURSE OF THE ENVIRONMENT APPROVED TRAINING PROGRAM FOR THE CONTROL OF SEDIMENT AND EROSION BEFORE BEGINNING THE PROJECT. I ALSO AUTHORIZE PERIODIC ON-SITE INSPECTION BY THE HOWARD SOIL CONSERVATION DISTRICT OR THEIR AUTHORIZED AGENTS, AS ARE DEEMED NECESSARY.

Michael J. McMan for H.J. Bowen 6/18/96
 SIGNATURE OF DEVELOPER DATE

PLAN
 SCALE 1"=50'

DEPARTMENT OF PUBLIC WORKS
 HOWARD COUNTY, MARYLAND
 Michael A. Rinaldi for RRS 7/26/96
 CHIEF, BUREAU OF UTILITIES DATE

DEPARTMENT OF PLANNING AND ZONING
 HOWARD COUNTY, MARYLAND
 H. J. Bowen 7/26/96
 CHIEF, DEVELOPMENT ENGINEERING DIVISION DATE

Fisher, Collins & Carter, Inc.
 CIVIL ENGINEERING CONSULTANTS & LAND SURVEYORS
 CENTENNIAL SQUARE OFFICE PARK
 10272 Baltimore National Pike
 Elliott City, Maryland 21042
 (410) 461-2855
 Terrell A. Fisher

DES.	M.J.M.	DATE	REVISION
DRWN.	J.M.M.	6/18/96	REVISE M.C.E.'S FOR LOTS 14 - 17
CHK.	P.W.R.	6/18/96	ADD EX. 1' PROP. SEWER MAIN IN THORNBROOK ROAD
DATE:		6/18/96	DELETE EX. SEWER MAIN FROM EX. MH 404 TO EX. MH 400;
BY:		6/18/96	REVISE EX. SEWER MAIN ALIGNMENT IN EX. O.S. LOT B

PLAN VIEW
 WATER AND SEWER MAINS
 600' SCALE MAP NO. 17 BLOCK NO. 3 & 4

MT. HEBRON
 SECTION 23 - PHASE 1
 LOT NOS. 9-26
 CONTRACT NO. 24-3513-17
 SECOND ELECTION DISTRICT
 HOWARD COUNTY, MARYLAND
 SCALE AS SHOWN
 SHEET 2 OF 5

SEDIMENT CONTROL NOTES


- A minimum of 48 hours notice must be given to the HOWARD COUNTY DEPARTMENT OF INSPECTIONS, LICENSING AND PERMITS, SEDIMENT CONTROL DIVISION PRIOR TO THE START OF ANY CONSTRUCTION (303-855).
- ALL VEGETATION AND STRUCTURAL PRACTICES ARE TO BE INSTALLED ACCORDING TO THE PROVISIONS OF THIS PLAN AND ARE TO BE IN CONFORMANCE WITH THE MOST CURRENT MARYLAND STANDARDS AND SPECIFICATIONS FOR SOIL EROSION AND SEDIMENT CONTROL, AND REVISIONS THEREOF.
- FOLLOWING INITIAL SOIL DISTURBANCE OR RE-DISTURBANCE, PERMANENT OR TEMPORARY STABILIZATION SHALL BE COMPLETED WITHIN 317 CALENDAR DAYS FOR ALL PERIMETER SEDIMENT CONTROL STRUCTURES. AS TO ALL OTHER DISTURBED OR UNDISTURBED AREAS ON THE PROJECT SITE, ALL SOILS TRACKING SHALL BE FENCED AND MARKED WITH SIGNS AND CHARTERED BY THE HOWARD COUNTY DESIGN MANUAL, STORM DRAINAGE.
- ALL DISTURBED AREAS MUST BE STABILIZED WITHIN THE TIME PERIOD SPECIFIED ABOVE IN ACCORDANCE WITH THE 1998 MARYLAND STANDARDS AND SPECIFICATIONS FOR SOIL EROSION AND SEDIMENT CONTROL, FOR PERMANENT SEEDING (SEC. 20, 500 SEC. 5A), TEMPORARY SEEDING (SEC. 20 AND FILLING (SEC. 20). TEMPORARY STABILIZATION WITH MULCH ALONE CAN ONLY BE DONE WHEN RECEPTIVE SEEDING DOES NOT ALLOW FOR PROPER GERMINATION AND ESTABLISHMENT OF GRASSES.
- ALL SEDIMENT CONTROL STRUCTURES ARE TO REMAIN IN PLACE AND ARE TO BE MAINTAINED IN OPERABLE CONDITION UNTIL PERMISSION FOR THEIR REMOVAL HAS BEEN OBTAINED FROM THE HOWARD COUNTY SEDIMENT CONTROL INSPECTOR.
- NOTE: SEE SHEET 5 FOR SECTION 20.0 STANDARDS & SPECIFICATIONS FOR VEGETATIVE STABILIZATION, AND SECTION 21.0 STANDARDS & SPECIFICATIONS FOR TOPSOIL.

SEQUENCE OF CONSTRUCTION

- OBTAIN THE REQUIRED GRADING PERMIT (7 DAYS)
- NOTIFY MISS UTILITY 48 HOURS BEFORE BEGINNING ANY WORK (1-800-257-7777). NOTIFY HOWARD COUNTY CONSTRUCTION/INSPECTION DIVISION 24 HOURS BEFORE STARTING ANY WORK (410)333-1870. (1 DAY)
- INSTALL THE REQUIRED SEDIMENT AND EROSION CONTROL DEVICES AS INDICATED ON THE PLAN SHEETS. (3 DAYS)
- THE CONTRACTOR SHALL INSPECT AND PROVIDE NECESSARY MAINTENANCE ON ALL SEDIMENT AND EROSION CONTROL DEVICES AFTER EACH RAINFALL AND ON A DAILY BASIS. (AS REQUIRED)
- CLEAR AND GRUB AS NECESSARY, ONLY AS REQUIRED FOR EXCAVATION AND INSTALLATION OF THE WATER AND SEWER MAIN AND ONLY WITHIN THE DESIGNATED EASEMENTS. (7 DAYS)
- INSTALL WATER MAINS, SEWER MAINS AND APPURTENANCES. (40 DAYS)
- THE LENGTH OF OPEN WATER AND SEWER MAIN TRENCH SHALL BE LIMITED TO THREE (3) PIPE LENGTHS OR THAT WHICH CAN BE BACKFILLED AND STABILIZED IN ONE (1) WORKING DAY, WHICHEVER IS SHORTER.
- STABILIZE SEED AND MULCH ALL DISTURBED AREAS IN ACCORDANCE WITH THE PERMANENT SEEDING NOTES SHOWN ON THESE PLANS. (3 DAYS)
- FOLLOWING SUCCESSFUL STABILIZATION OF ALL DISTURBED AREAS, AND AFTER PERMISSION HAS BEEN OBTAINED FROM THE HOWARD COUNTY SEDIMENT CONTROL INSPECTOR, REMOVE ALL EROSION AND SEDIMENT CONTROL DEVICES. (1 DAY)

SHC INVERTS @ PROPERTY LINE CHART



STATION	LOT	ELEVATION
1+40 PT	MH 502 TO MH 503	374.00
1+80 PT	20 (DHC @ 5%)	374.50
2+60 PT	22 (DHC @ 5%)	375.50
0+80 PT	MH 504 TO MH 505	384.20
0+15 PT	MH 505 TO MH 506	374.54
0+45 PT	24 (DHC @ 1.00%)	387.32
0+05 PT	15 (DHC)	408.70
0+10 LT	19 (DHC)	410.20
@ MH 508 LT	13 (DHC @ 1.00%)	425.20
0+20 LT	MH 508 TO MH 509	429.50
0+45 LT	12 (DHC)	429.40
1+20 PT	17	425.22
0+20 PT	10	426.14
0+40 LT	10 (DHC)	431.40
1+00 PT	15	426.99
@ MH 510 LT	9 (DHC @ 1.00%)	434.56
@ MH 510 PT	14 (DHC @ 1.00%)	431.03
0+40 LT	FUTURE LOT 2	387.54
@ MH 512 LT	FUTURE LOT 1	388.04

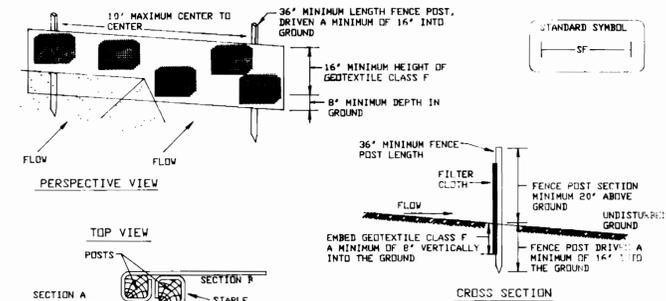

- Construction Specifications**
- Fence posts shall be a minimum of 36" long driven 16" minimum into the ground. Wood posts shall be 1 1/2" x 1 1/2" square (minimum) cut, or 1 1/2" diameter (minimum) round and shall be of sound quality hardwood. Steel posts will be standard T or U section weighting not less than 1.00 pound per linear foot.
 - Geotextile shall be fastened securely to each fence post with wire ties or staples at top and mid-section and shall meet the following requirements for Geotextile Class F:

Tensile Strength	50 lbs/in (min.)	Test: NHT 509
Tensile Modulus	20 lbs/in (min.)	Test: NHT 509
Flow Rate	0.2 gal per minute (max.)	Test: NHT 382
Filtering Efficiency	75% (min.)	Test: NHT 382
 - Where ends of geotextile fabric come together, they shall be overlapped, folded and stapled to prevent sediment bypass.
 - Silt Fence shall be inspected after each rainfall event and maintained when bulges occur or when sediment accumulation reached 50% of the fabric height.

SILT FENCE
NOT TO SCALE

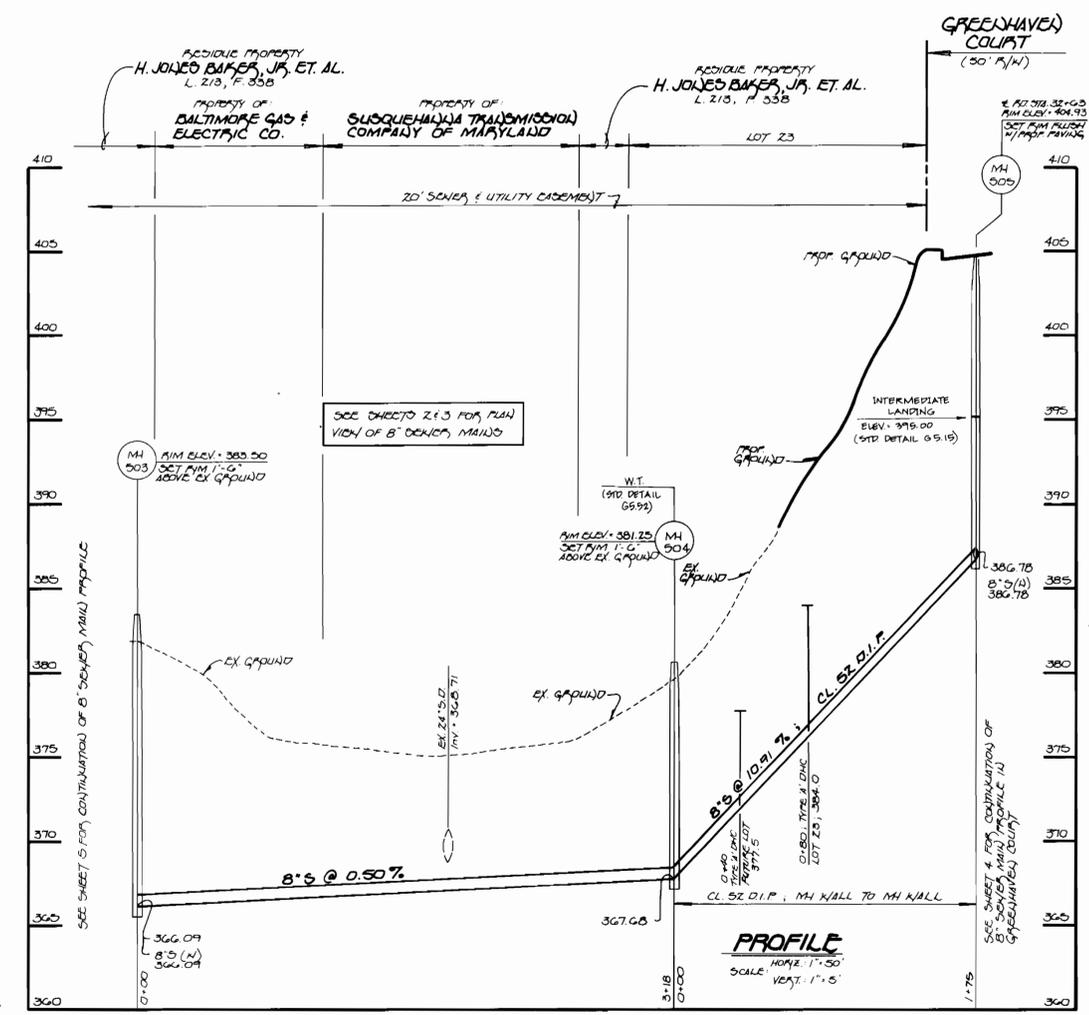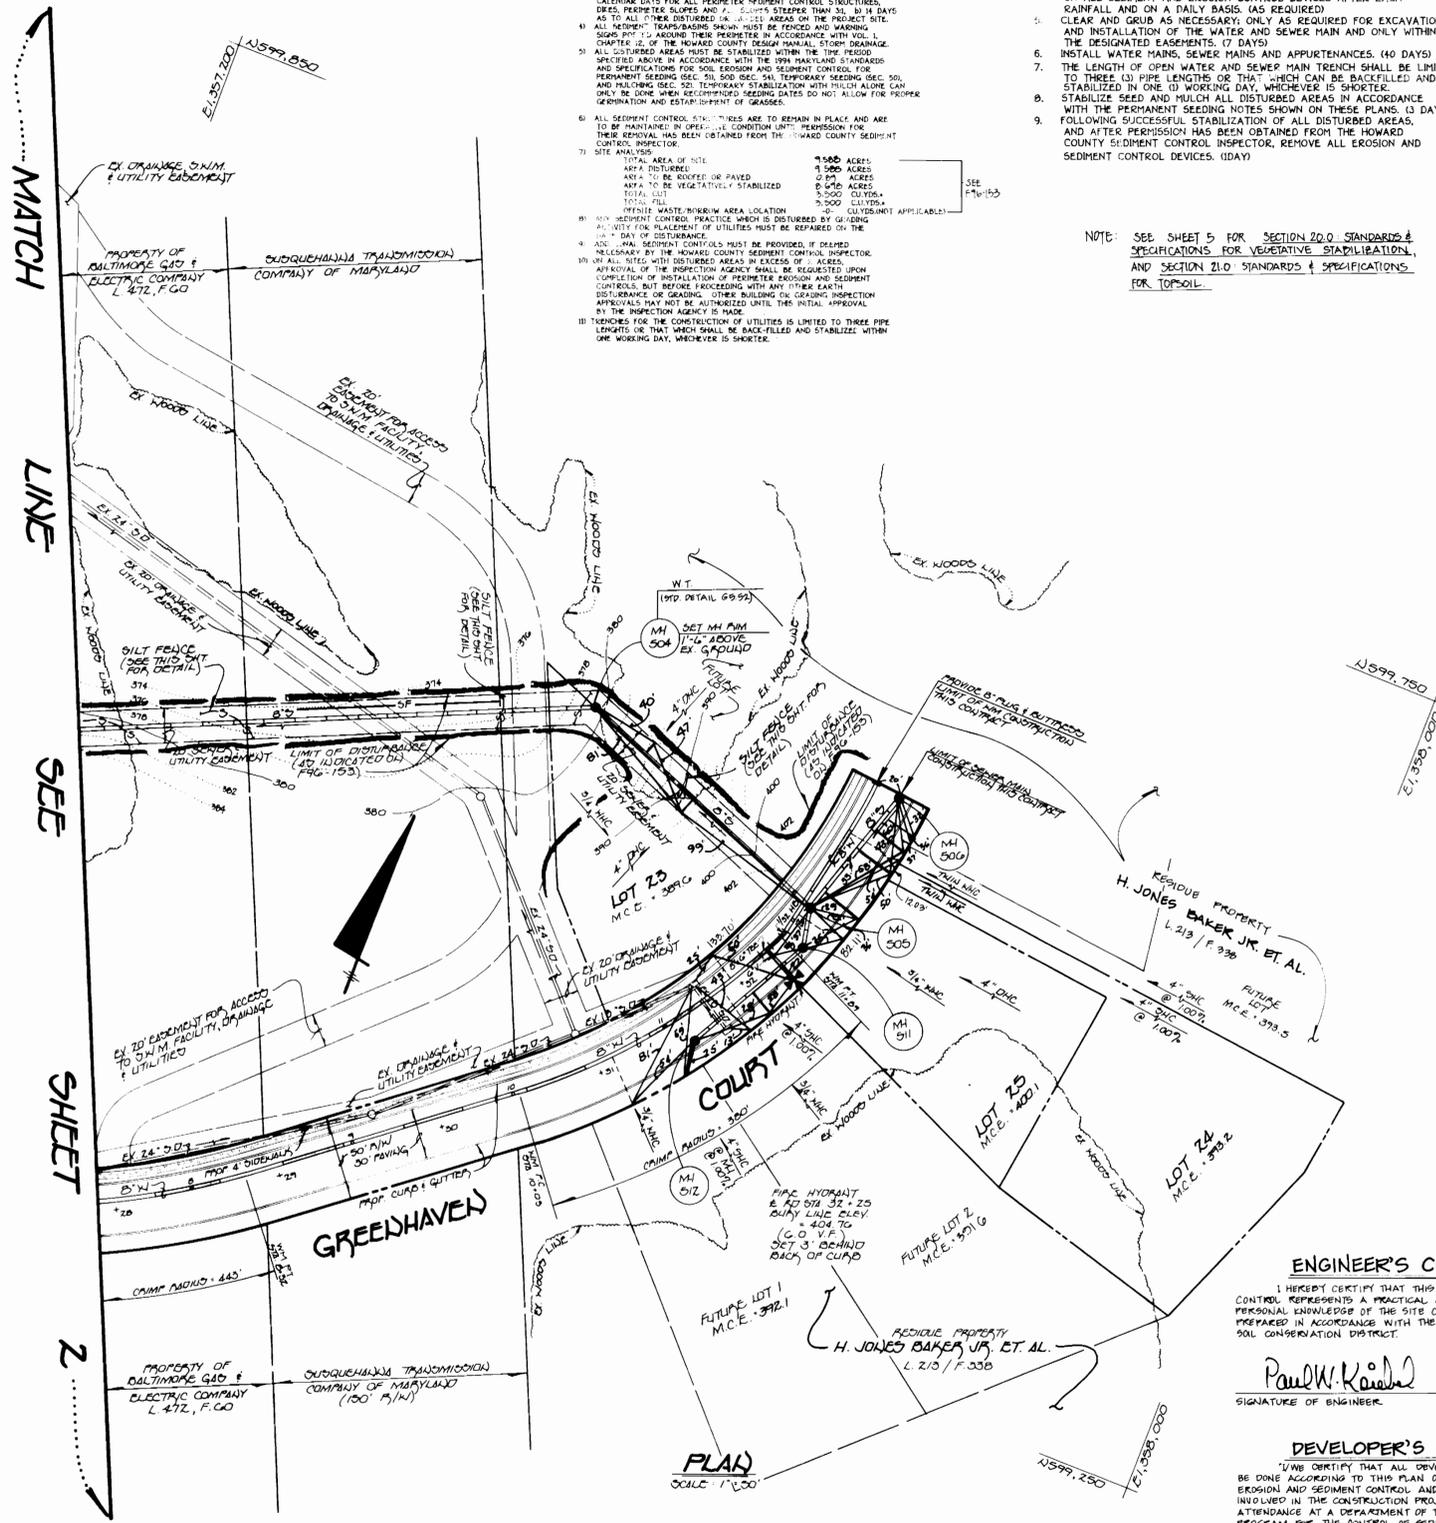

ENGINEER'S CERTIFICATE
I HEREBY CERTIFY THAT THIS PLAN FOR EROSION AND SEDIMENT CONTROL REPRESENTS A PRACTICAL AND WORKABLE PLAN BASED ON MY PERSONAL KNOWLEDGE OF THE SITE CONDITIONS AND THAT IT WAS PREPARED IN ACCORDANCE WITH THE REQUIREMENTS OF THE HOWARD SOIL CONSERVATION DISTRICT.



Paul W. Keadel
SIGNATURE OF ENGINEER

06/18/96
DATE

DEVELOPER'S CERTIFICATE
I HEREBY CERTIFY THAT ALL DEVELOPMENT AND CONSTRUCTION WILL BE DONE ACCORDING TO THIS PLAN OF DEVELOPMENT AND PLAN FOR EROSION AND SEDIMENT CONTROL AND THAT ALL RESPONSIBLE PERSONNEL INVOLVED IN THE CONSTRUCTION PROJECT WILL HAVE A CERTIFICATE OF ATTENDANCE AT A DEPARTMENT OF THE ENVIRONMENT APPROVED TRAINING PROGRAM FOR THE CONTROL OF SEDIMENT AND EROSION BEFORE BEGINNING THE PROJECT. I ALSO AUTHORIZE PERIODIC ON-SITE INSPECTION BY THE HOWARD SOIL CONSERVATION DISTRICT OR THEIR AUTHORIZED AGENTS, AS ARE DEEMED NECESSARY.

Michael J. McCann for H. J. Baker
SIGNATURE OF DEVELOPER

6/18/96
DATE

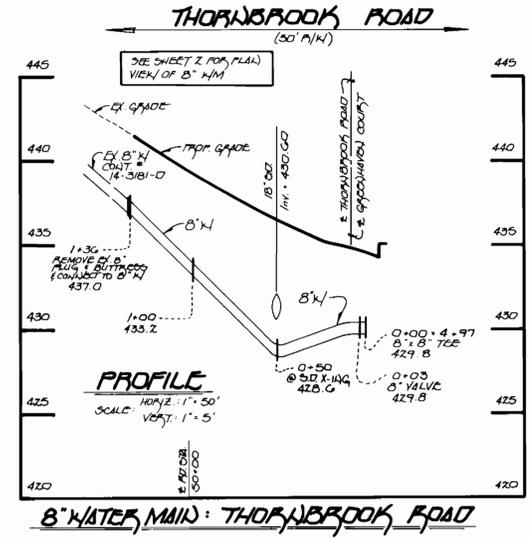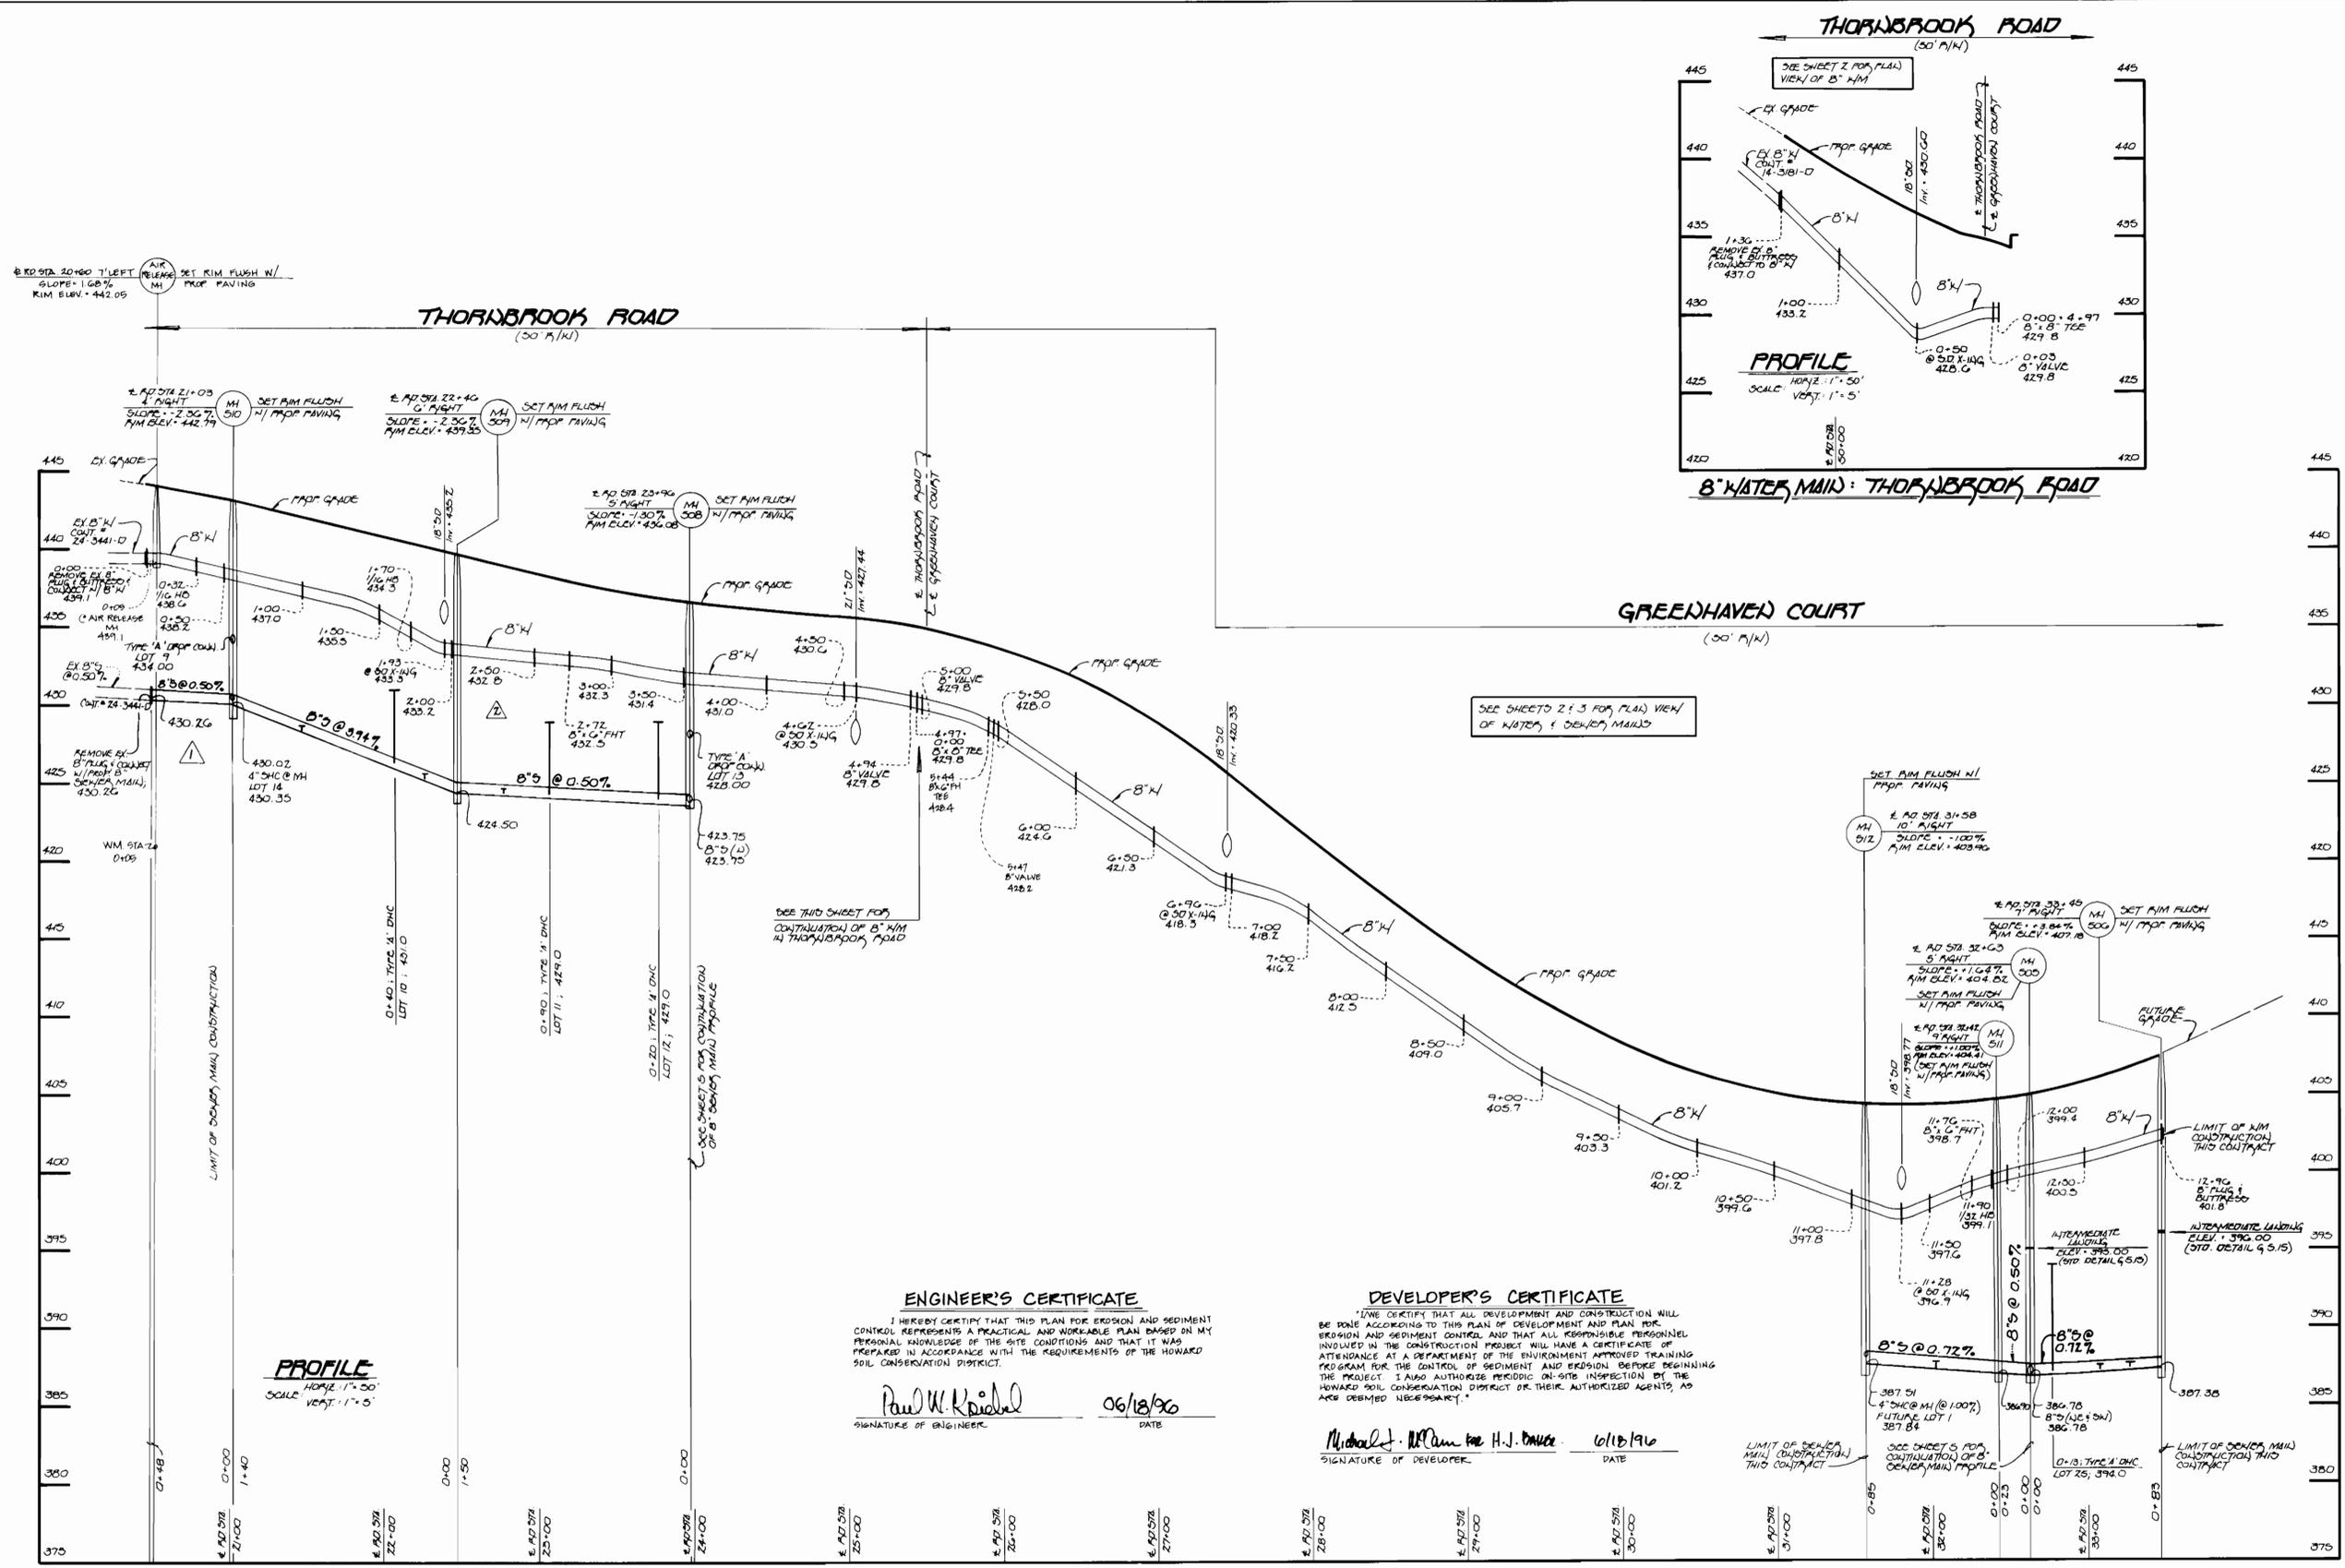

PROFILE
 HORIZ. 1" = 50'
 VERT. 1" = 5'

ENGINEER'S CERTIFICATE

I HEREBY CERTIFY THAT THIS PLAN FOR EROSION AND SEDIMENT CONTROL REPRESENTS A PRACTICAL AND WORKABLE PLAN BASED ON MY PERSONAL KNOWLEDGE OF THE SITE CONDITIONS AND THAT IT WAS PREPARED IN ACCORDANCE WITH THE REQUIREMENTS OF THE HOWARD SOIL CONSERVATION DISTRICT.

Paul W. Kiehl
 SIGNATURE OF ENGINEER
 06/18/96
 DATE

DEVELOPER'S CERTIFICATE


I HAVE CERTIFIED THAT ALL DEVELOPMENT AND CONSTRUCTION WILL BE DONE ACCORDING TO THIS PLAN OF DEVELOPMENT AND PLAN FOR EROSION AND SEDIMENT CONTROL AND THAT ALL RESPONSIBLE PERSONNEL INVOLVED IN THE CONSTRUCTION PROJECT WILL HAVE A CERTIFICATE OF ATTENDANCE AT A DEPARTMENT OF THE ENVIRONMENT APPROVED TRAINING PROGRAM FOR THE CONTROL OF SEDIMENT AND EROSION BEFORE BEGINNING THE PROJECT. I ALSO AUTHORIZE PERIODIC ON-SITE INSPECTION BY THE HOWARD SOIL CONSERVATION DISTRICT OR THEIR AUTHORIZED AGENTS, AS ARE DEEMED NECESSARY.

Michael J. McNamee H.J. Davis
 SIGNATURE OF DEVELOPER
 06/18/96
 DATE

8" WATER & 8" SEWER MAINS: THORNBROOK ROAD & GREENHAVEN COURT

CONTRACT NO. 24-3513-D
 MT. HEBRON
 SECTION 23 - PHASE 1
 LOT NOS. 9-2G
 WATER AND SEWER MAIN EXTENSIONS
 HOWARD COUNTY, MARYLAND

DEPARTMENT OF PUBLIC WORKS HOWARD COUNTY, MARYLAND <i>Michael A. Mainelli</i> 7/26/96 CHIEF, BUREAU OF UTILITIES DATE	DEPARTMENT OF PLANNING AND ZONING HOWARD COUNTY, MARYLAND <i>John J. ...</i> 1/31/96 CHIEF, DEVELOPMENT ENGINEERING DIVISION DATE	Fisher, Collins & Carter, Inc. CIVIL ENGINEERING CONSULTANTS & LAND SURVEYORS CENTENNIAL SQUARE OFFICE PARK 10272 Baltimore National Pike Ellicott City, Maryland 21042 (410) 481-2855	DES: M.J.M. DRWN: J.M.M. CHK: P.W.K. DATE:	F.C.C. 17 F.C.C. 17 BY NO. 17 REVISION 17 DATE:	RAISE SEWER MAIN FROM MH 500 - 510 PER 200' (DISEMPOWER) ELD. JUNE 97 100' 8" SEWER MAIN FROM MH 510 TO COLLECT TO EX. 8" SEWER. MAY 96	600' SCALE MAP NO. 17 BLOCK NO. 3 & 4	MT. HEBRON SECTION 23 - PHASE 1 LOT NOS. 9-2G CONTRACT NO. 24-3513-D SECOND ELECTION DISTRICT HOWARD COUNTY, MARYLAND	SCALE AS SHOWN SHEET 4 OF 5
--	--	---	---	---	--	--	---	--------------------------------

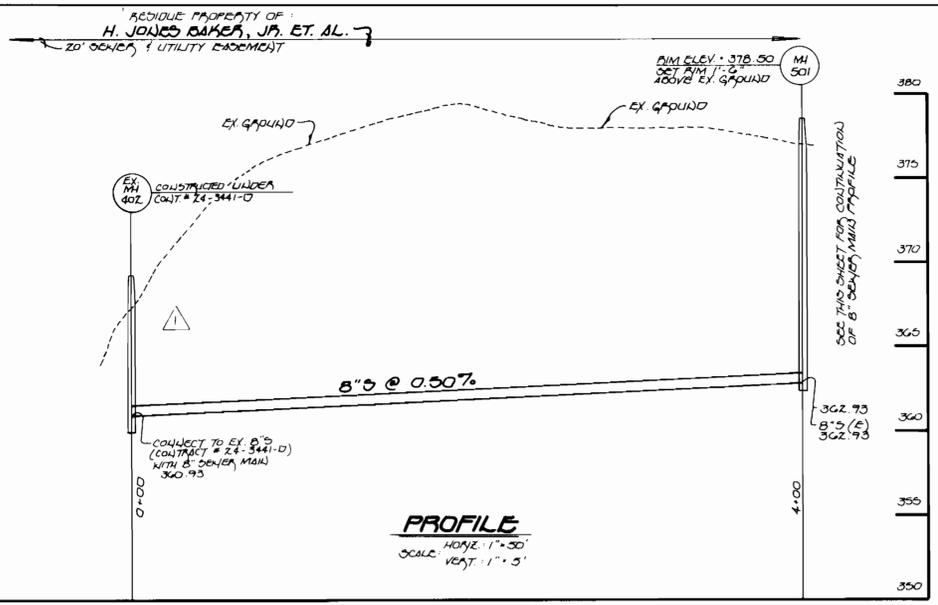

200: STANDARDS AND SPECIFICATIONS FOR VEGETATIVE STABILIZATION


DEFINITION: Using vegetation as cover for barren soil to protect it from forces that cause erosion. Vegetative stabilization specifications are used to promote the establishment of vegetation on exposed soil. When soil is stabilized with vegetation, the soil is less likely to erode and more likely to absorb infiltration of rainwater, thereby reducing sediment loads and runoff to downstream areas, and improving wildlife habitat and visual resources.

CONDITIONS WHERE PRACTICE APPLIES: This practice shall be used on denuded areas as specified on the plans and may be used on highly erodible or critically eroding areas. This specification is divided into Temporary Seeding, to quickly establish vegetative cover for short duration (up to one year), and Permanent Seeding for long term vegetative cover. Examples of applicable areas for Temporary Seeding are temporary soil stockpiles, cleared areas lying left on between construction phases, earth fills, etc. and for Permanent Seeding are ditches, bank cut and fill slopes and other areas at final grade, former erodible and sloping areas, etc.

EFFECTS ON WATER QUALITY AND QUANTITY: Planting vegetation in disturbed areas will have an effect on the water budget, especially on volume and rates of runoff, infiltration, absorption, transpiration, percolation and groundwater recharge. Vegetation over time, will increase organic matter content and improve the water holding capacity of the soil and subsequent plant growth. Vegetation will help reduce the movement of sediment, nutrients, and other chemicals carried by runoff to receiving waters. Plants will also help protect groundwater supplies by assimilating these substances present within the root zone. Sediment control devices must remain in place during seeding, seedbed preparation, mulching and vegetative establishment to prevent large quantities of sediment and associated chemicals and nutrients from washing into surface waters.

SECTION 1 - VEGETATIVE STABILIZATION METHODS AND MATERIALS

- Site Preparation:**
 - Install erosion and sediment control structures (either temporary or permanent) such as diversion, grade stabilization structures, berms, waterways, or sediment control basins.
 - Perform all grading operations at right angles to the slope. Final grading and shaping is not usually necessary for temporary seeding.
 - Schedule required soil tests to determine soil amendment composition and application rates for sites having disturbed areas over 5 acres.
- Soil Amendments (Fertilizer and Lime Specifications):**
 - Soil tests must be performed to determine the exact location and application rates for both lime and fertilizer on sites having disturbed areas over 5 acres. Soil analysis may be performed by the University of Maryland or a recognized commercial laboratory. Soil samples taken for engineering purposes may also be used for chemical analysis.
 - Fertilizer shall be uniform in composition, free flowing and suitable for accurate application by approved equipment. Fertilizer may be substituted for fertilizer with prior approval from the appropriate approval authority. Fertilizers shall be delivered to the site fully blended according to the applicable state fertilizer laws and shall bear the name, trade name or trademark and warranty of the producer.
 - Lime materials shall be ground limestone hydrated or burnt lime may be substituted which contain at least 50% total oxide (calcium oxide plus magnesium oxide). Limestone shall be ground to such fineness that at least 50% will pass through a #100 mesh sieve and 90-100% will pass through a #20 mesh sieve.
 - Incorporate lime and fertilizer into the top 3-5" of soil by disking or other suitable means.

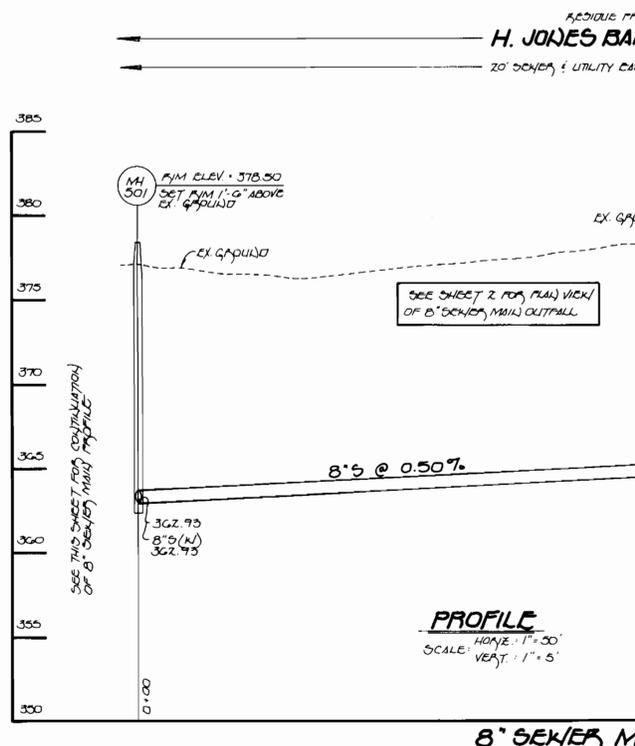

8" SEWER MAIN OUTFALL

Methods of Seeding:

- Hydroseeding:** Apply seed uniformly with hydroseeder (seeder includes seed and fertilizer) broadcast or drop seeded, or a backpack seeder.
- Drop Seeding:** If fertilizer is being applied at the time of seeding, the application rates amounts will not exceed the following nitrogen maximum of 100 lbs. per acre total of soluble nitrogen.
 - Line - use only ground agricultural limestone, 40 to 50 lbs. per acre may be applied by hydroseeding. Normally, not more than 2 tons are applied by hydroseeding at any one time. Do not use burnt or hydrated lime when hydroseeding.
 - Seed and fertilizer shall be mixed on site and seeding shall be done immediately and without interruption.
- Drill Seeding:** This includes use of conventional drop or broadcast spreaders.
 - Seed spreader shall be incorporated into the seedbed at the rates prescribed on the Temporary or Permanent Seeding Summary or Tables 205 or 26. The seeded area shall then be raked with a weighted roller to provide good seed to soil contact.
 - Where fertilizers shall be applied, in two directions perpendicular to each other. Apply half the seeding rate in each direction.
 - Drill or backpack seeding - mechanized seeders that apply and cover seed with soil.
 - Backpacking seeders are required to bury the seed in such a fashion as to provide at least 1/4 inch of soil covering. Seedbed must be firm after planting.
 - Where fertilizers shall be applied in two directions perpendicular to each other. Apply half the seeding rate in each direction.
- Mulch Specifications (in order of preference):**
 - Straw shall consist of thoroughly threshed wheat, rye or oat straw, reasonable bright in color, and shall not be musty, moldy, raked, decayed or excessively dusty and shall be free of noxious weed seeds as specified in the attached flow chart.
 - Wood mulch shall consist of specially prepared wood cellulose processed into a uniform fibrous product.
 - WMF shall be dried green or contain a green dye in the package that will provide an appropriate color to facilitate no germination or growth inhibiting factors.
 - WMF shall be made of natural wood fiber processed in such a manner that the wood cellulose fiber mulch will remain in uniform suspension in water under agitation and will bond with seed fertilizer and other additives to form a homogeneous slurry. The mulch material shall form a barrier size ground cover, on application, having moisture absorption and retention properties and shall cover and hold grass seed in contact with the soil without inhibiting the growth of the grass seedlings.
 - WMF shall contain no elements or compounds at concentrations levels that will be phytotoxic.
 - WMF shall conform to the following physical requirements (other than weight):
 - Approximately 10 mm. diameter approximately 2 mm. particle size of 4.0 to 8.5, ash content of 10%.

Note: Type 'A' straw mulch should be used in areas where fine species of grass is desired.

Mulching Seeding: Mulch shall be applied to all seeded areas immediately after seeding. If grading is completed outside of the seeding season, mulch shall be applied as prescribed in the following table to the contour of the slope.

- When straw mulch is applied over all seeded areas at the rate of 2 tons/acre, mulch shall be applied to a uniform loose depth of between 1" and 2". Mulch applied shall achieve a uniform distribution and depth so that the soil surface is not exposed. If a mulching tool is to be used, the rate should be increased to 2.5 tons/acre.
- Wood cellulose fiber used as a mulch shall be applied at a net dry weight of 1500 lbs. per acre. The wood cellulose fiber shall be mixed with water, and the mixture shall contain a maximum of 50 lbs. of wood cellulose fiber per 100 gallons of water.

Securing Straw Mulch (Anchoring): Mulch anchoring shall be performed immediately following mulch application to minimize loss by wind or water. This may be done by one of the following methods (in preference, depending upon size of area and erosion hazard):

- A mulch anchoring line is a tractor draw implement designed to punch and anchor mulch into the soil surface a minimum of two (2) inches. This practice is most effective on large applications. Synthetic binders such as Acryl, Acryl-Tack, Acryl-Tack-A-70 (Petro-Tack) Terra-Tax Terra-Tax AC or other approved equal may be used at rates recommended by the manufacturer. To anchor mulch, the mulch shall be applied at a net dry weight of 750 pounds/acre. The wood cellulose fiber shall be mixed with water and the mixture shall contain a maximum of 50 pounds of wood cellulose fiber per 100 gallons.
- Application of liquid binders should be heavier at the edges where wind catches mulch, such as in valleys and crest of banks. The remainder of area should be applied uniformly after proper application. Synthetic binders such as Acryl, Acryl-Tack, Acryl-Tack-A-70 (Petro-Tack) Terra-Tax Terra-Tax AC or other approved equal may be used at rates recommended by the manufacturer. To anchor mulch, the mulch shall be applied according to manufacturer's recommendations. Netting is usually available in 6 to 15 feet wide and 300 to 1000 feet long.

210: STANDARDS AND SPECIFICATIONS FOR TOPSOIL


DEFINITION: PLACEMENT OF TOPSOIL OVER A PREPARED SUBSOIL PRIOR TO ESTABLISHMENT OF PERMANENT VEGETATION.

PURPOSE: TO PROVIDE A SUITABLE SOIL MEDIUM FOR VEGETATIVE GROWTH.

SPECIFICATIONS:

- TOPSOIL SHALL BE A Mixture of contrasting texture subsoils.
- TOPSOIL SHALL CONTAIN LESS THAN 2% BY VOLUME OF CINDELS, GRAVEL, STONES, BRICKS OR OTHER MATERIALS LARGER THAN 1/2" DIAMETER.
- TOPSOIL SHALL BE UNIFORMLY DISTRIBUTED IN A 4" TO 8" LAYER AND LIGHTLY COMPACTED TO A MINIMUM THICKNESS OF 4" HOURS SUBSEQUENT TO APPLICATION.
- PLACE TOPSOIL AND APPLY SOIL AMENDMENTS AS SPECIFIED IN 200 VEGETATIVE STABILIZATION.

TOPSOIL SHALL NOT BE PLACED DURING FROZEN, MUDDY, OR EXCESSIVELY WET PERIODS.

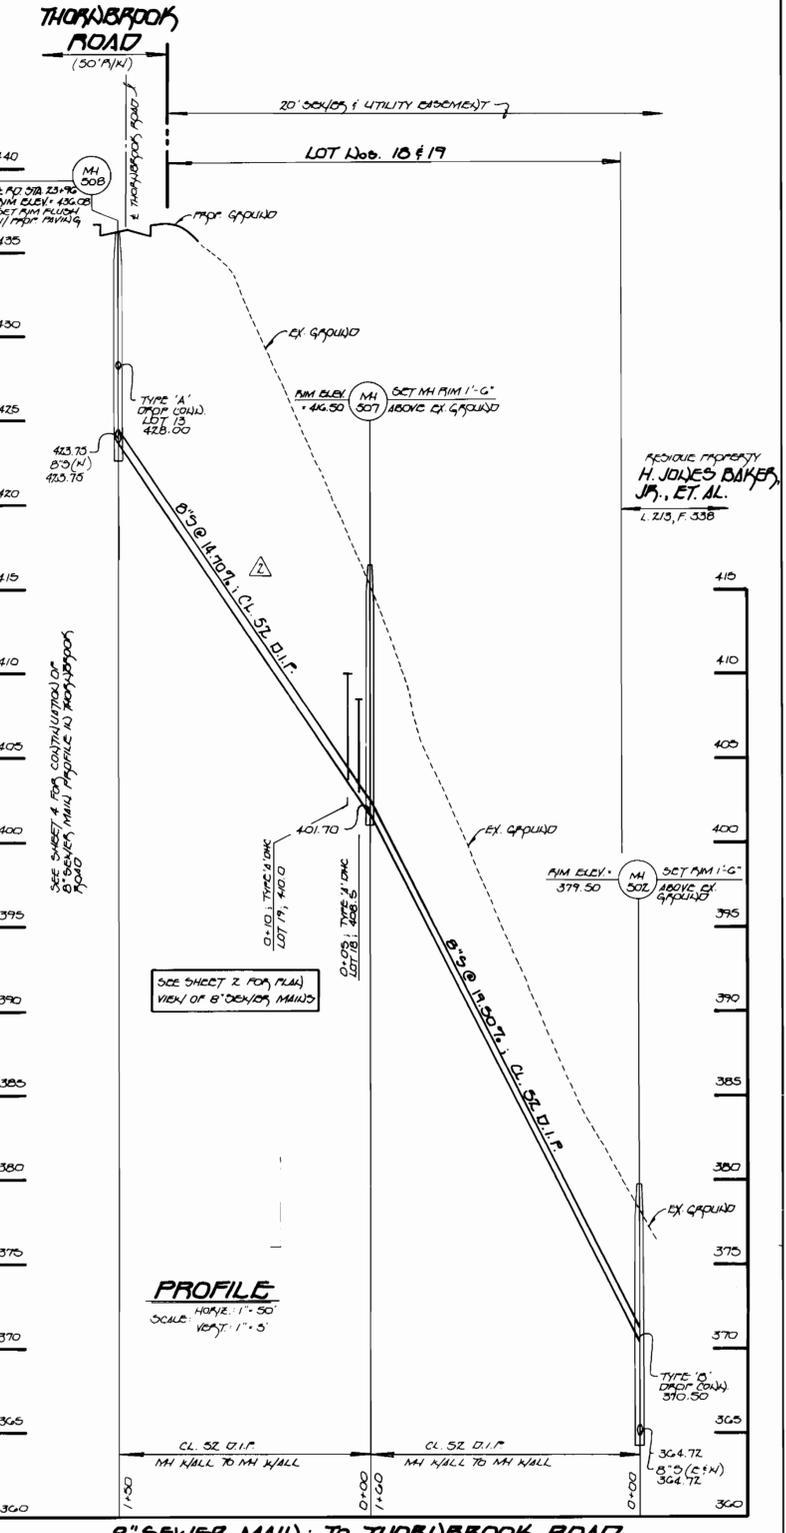

8" SEWER MAIN TO THORNBROOK ROAD

DEVELOPER'S CERTIFICATE

I HEREBY CERTIFY THAT ALL DEVELOPMENT AND CONSTRUCTION WILL BE DONE ACCORDING TO THIS PLAN OF DEVELOPMENT AND PLAN FOR EROSION AND SEDIMENT CONTROL, AND THAT ALL RESPONSIBLE PERSONNEL INVOLVED IN THE CONSTRUCTION PROJECT WILL HAVE A CERTIFICATE OF ATTENDANCE AT A DEPARTMENT OF THE ENVIRONMENT APPROVED TRAINING PROGRAM FOR THE CONTROL OF SEDIMENT AND EROSION BEFORE BEGINNING THE PROJECT. I ALSO AUTHORIZE PERIODIC ON-SITE INSPECTION BY THE HOWARD SOIL CONSERVATION DISTRICT OR THEIR AUTHORIZED AGENTS AS ARE DEEMED NECESSARY.

Michael J. ... for H.J. Baker
DATE: 6/18/96

ENGINEER'S CERTIFICATE

I HEREBY CERTIFY THAT THIS PLAN FOR EROSION AND SEDIMENT CONTROL REPRESENTS A PRACTICAL AND WORKABLE PLAN BASED ON MY PERSONAL KNOWLEDGE OF THE SITE CONDITIONS AND THAT IT WAS PREPARED IN ACCORDANCE WITH THE REQUIREMENTS OF THE HOWARD SOIL CONSERVATION DISTRICT.

Paul W. ...
DATE: 06/18/96

DEPARTMENT OF PUBLIC WORKS
HOWARD COUNTY, MARYLAND

Michael A. ...
CHIEF, BUREAU OF UTILITIES

DEPARTMENT OF PLANNING AND ZONING
HOWARD COUNTY, MARYLAND

...
CHIEF, DEVELOPMENT ENGINEERING DIVISION

Fisher, Collins & Carter, Inc.
#9757
CIVIL ENGINEERING CONSULTANTS & LAND SURVEYORS
CENTENNIAL SQUARE OFFICE PARK
10272 Baltimore National Pike
Bilcoott City, Maryland 21042
(410) 481-2855

TERRILL A. FISHER

DES:	M.J.M.
DRWN:	J.M.M.
CHK:	P.W.K.
DATE:	JULIE 97
BY:	NO.
NO.	REVISION

DES:	M.J.M.
DRWN:	J.M.M.
CHK:	P.W.K.
DATE:	JULIE 97
BY:	NO.
NO.	REVISION

60' SCALE MAP NO. 17 BLOCK NO. 3 & 4

PROFILES WATER AND SEWER MAINS

MT. HEBRON
SECTION 23 - PHASE 1
LOT NOS. 9-26
CONTRACT NO. 24-3513-D
SECOND ELECTION DISTRICT
HOWARD COUNTY, MARYLAND

SCALE AS SHOWN
SHEET 5 OF 5