

Note: Plastic Grade Rings Used @ Manholes 45 To 54

NOTE: THIS PLAN SUPERCEDES SHEET No. 2 of 6 CONTRACT No. 34-362-D APPROVED ON 5-14-10 BY CHIEF, DEVELOPMENT ENGINEERING DIVISION CHUCK DAMMERS. (F-39-17)

NOTE: This new plan sheet 2 of 6 is as per final Plat F-99-17, to eliminate Lots 92-97. The Bank Open Space lots recorded under F-98-52. The new lots are shown on this plan.

75' STREAM BUFFER

100 YEAR FLOODPLAIN DRAINAGE AND UTILITY CASEMENT

Field Lock

8" Water in Slope To Site From Jack & Bore

Caseing

OPEN SPACE LOT 83

MEGA LOGS ON GROUND

OPEN SPACE LOT 85

OPEN SPACE LOT 87

DEPARTMENT OF PUBLIC WORKS
HOWARD COUNTY, MARYLAND

DEPARTMENT OF PLANNING AND ZONING
HOWARD COUNTY, MARYLAND

TSA GROUP, INC.
planning • engineering • surveying
8480 Baltimore National Pike Suite 418
Ellicott City, Maryland 21043

Professional Engineer Seal

DES: MLV
DRN: DBT
CHK: DAM
DATE: 11/97
BY: NO.

DESIGN REVISIONS

DATE: 11/97

DATE: 4/98

DATE: 11-29-99

DATE: 11-29-99

600 SCALE MAP NO. 41

BLOCK 4 AND 5

VILLAGE OF CEDAR RIDGE

PHASE 2 (F-99-17)

ELECTION DISTRICT NO. 5

CONTRACT NO. 34-362-D

PLAN OF WATER AND SEWER MAINS

AS-BUILTS

SCALE: 1" = 50'

SHEET NO. 2 OF 6

DATE: 11/97

DATE: 4/98

DATE: 11-29-99

DATE: 11-29-99

DATE: 11-29-99

600 SCALE MAP NO. 41

BLOCK 4 AND 5



VILLAGE OF CEDAR RIDGE

PHASE 2 (F-99-17)

ELECTION DISTRICT NO. 5

CONTRACT NO. 34-362-D

PLAN OF WATER AND SEWER MAINS

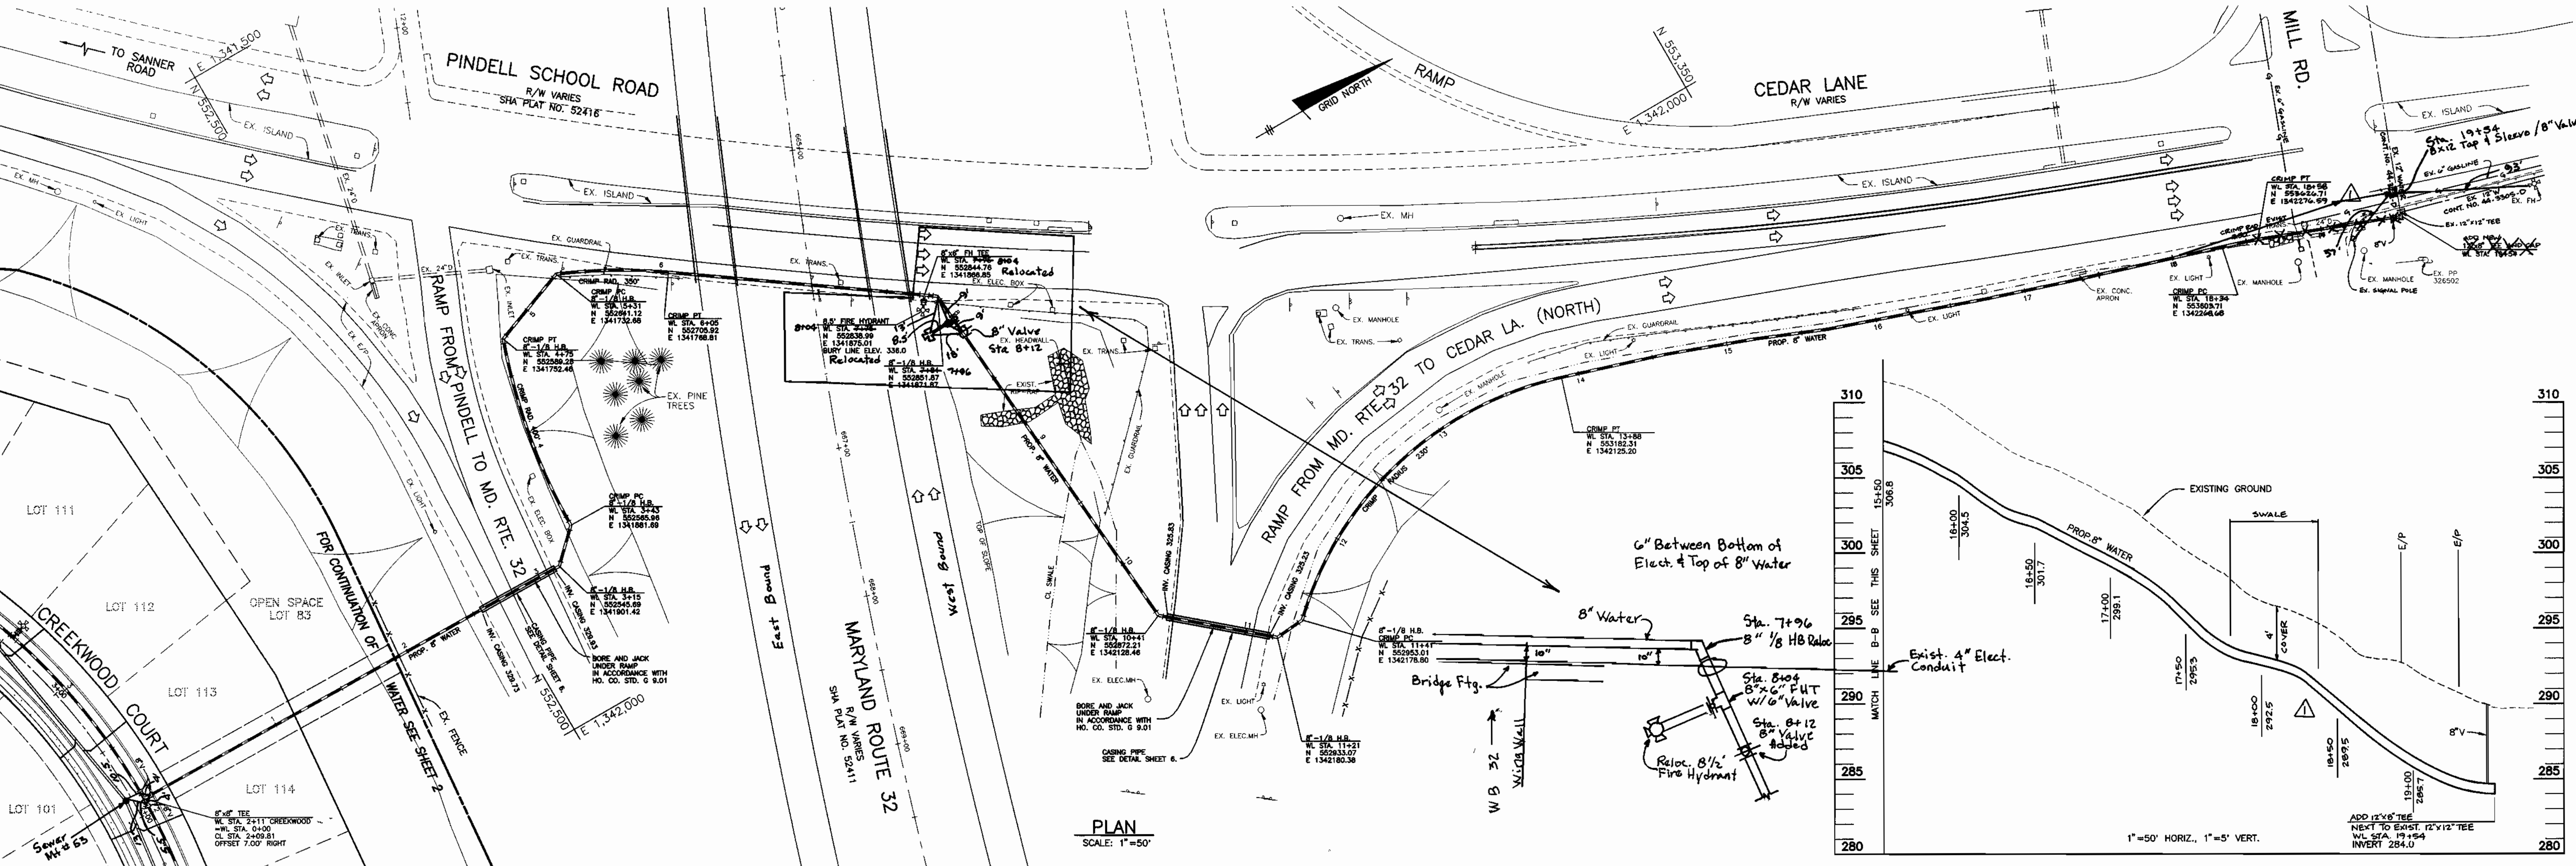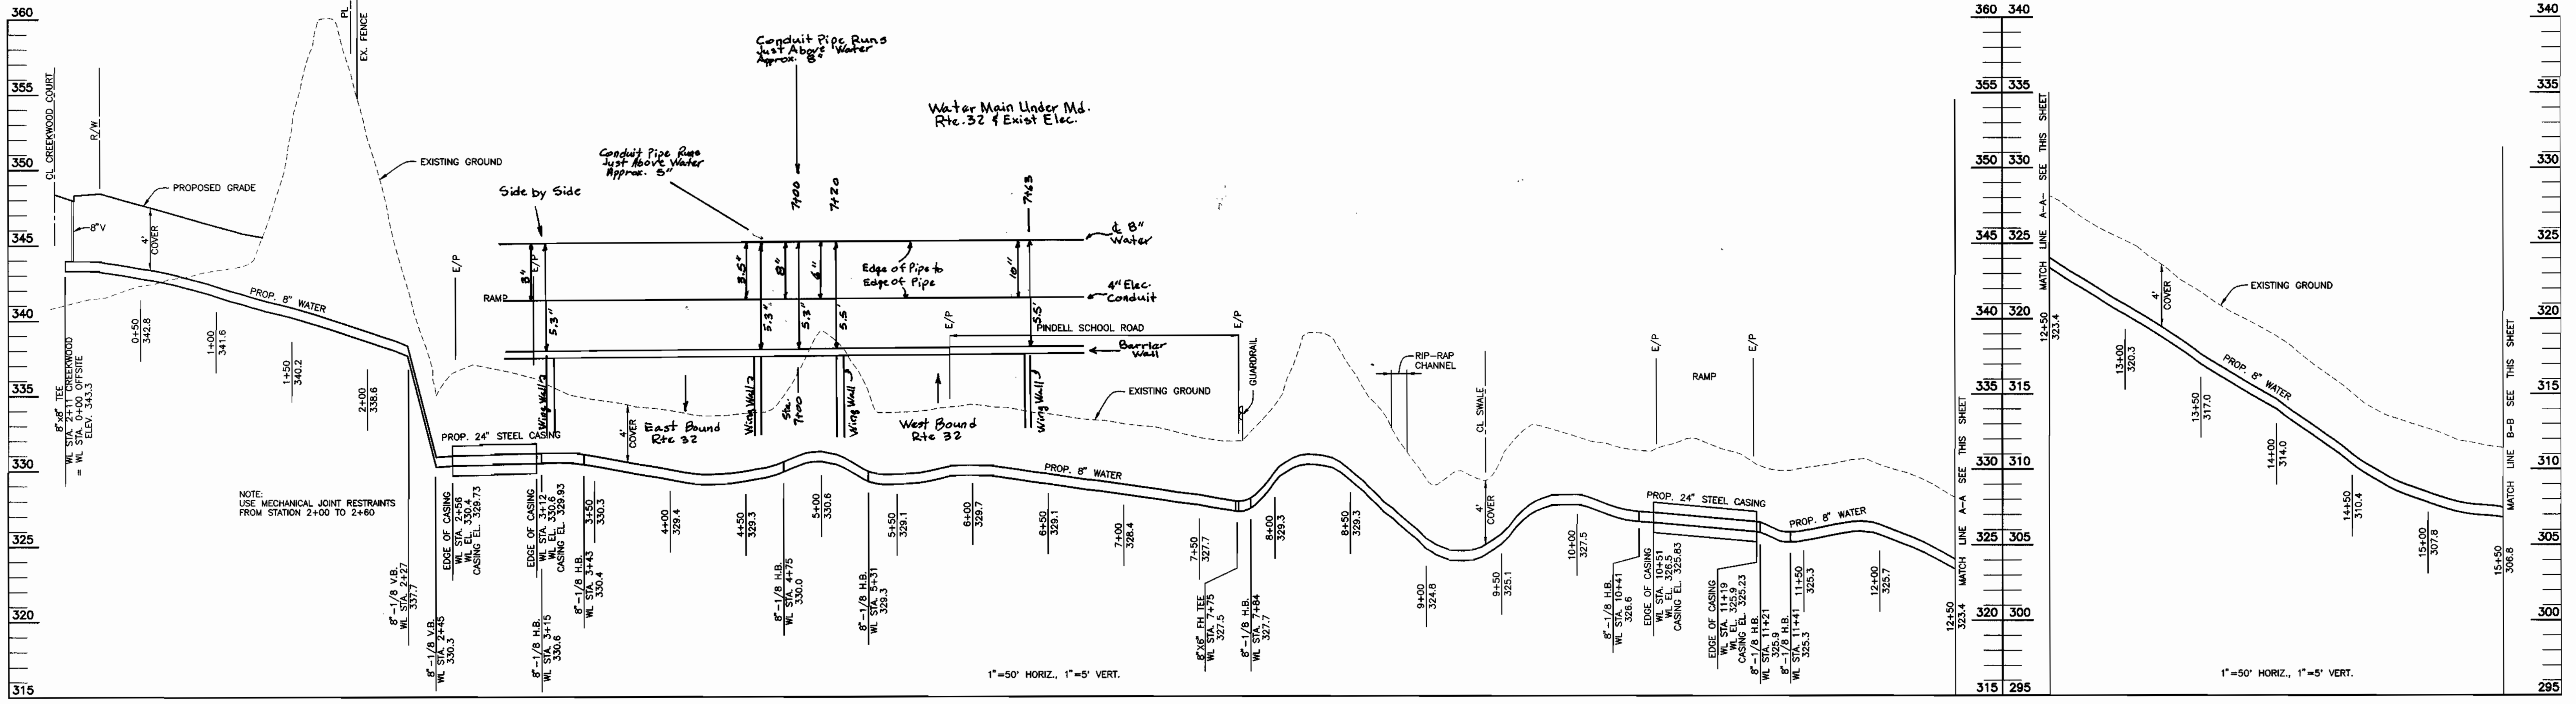


Plotted: April 6, 1998
 Acad. Dwg. # 6002503

DEPARTMENT OF PUBLIC WORKS
 HOWARD COUNTY, MARYLAND
 Robert B. Buijn 5-5-98
 CHIEF, BUREAU OF UTILITIES DATE

DEPARTMENT OF PLANNING AND ZONING
 HOWARD COUNTY, MARYLAND
 John D. ... sl/bo
 CHIEF, DEVELOPMENT ENGINEERING DIVISION DATE

TSA GROUP, INC.
 planning • engineering • surveying
 8480 Baltimore National Pike Suite 418
 Ellicott City, Maryland 21043

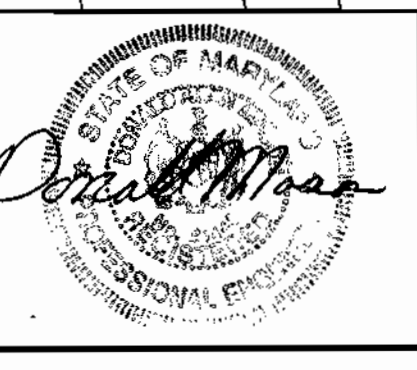


DES:	MLV				
DRN:	DBT				
CHK:	DAM				
DATE:	11/97	DBT	REVISIONS	11-29-97	
	4/98	BY	NO.		




PLAN AND PROFILE
 OF OFFSITE WATER EXTENSION
 AS-BUILTS
 600 SCALE MAP NO. 41
 BLOCK 4 AND 5

VILLAGE OF CEDAR RIDGE
 PHASE 2
 ELECTION DISTRICT NO. 5
 CONTRACT NO. 34-3662-D

SCALE:
 AS SHOWN
 SHEET NO.
 3 OF 6


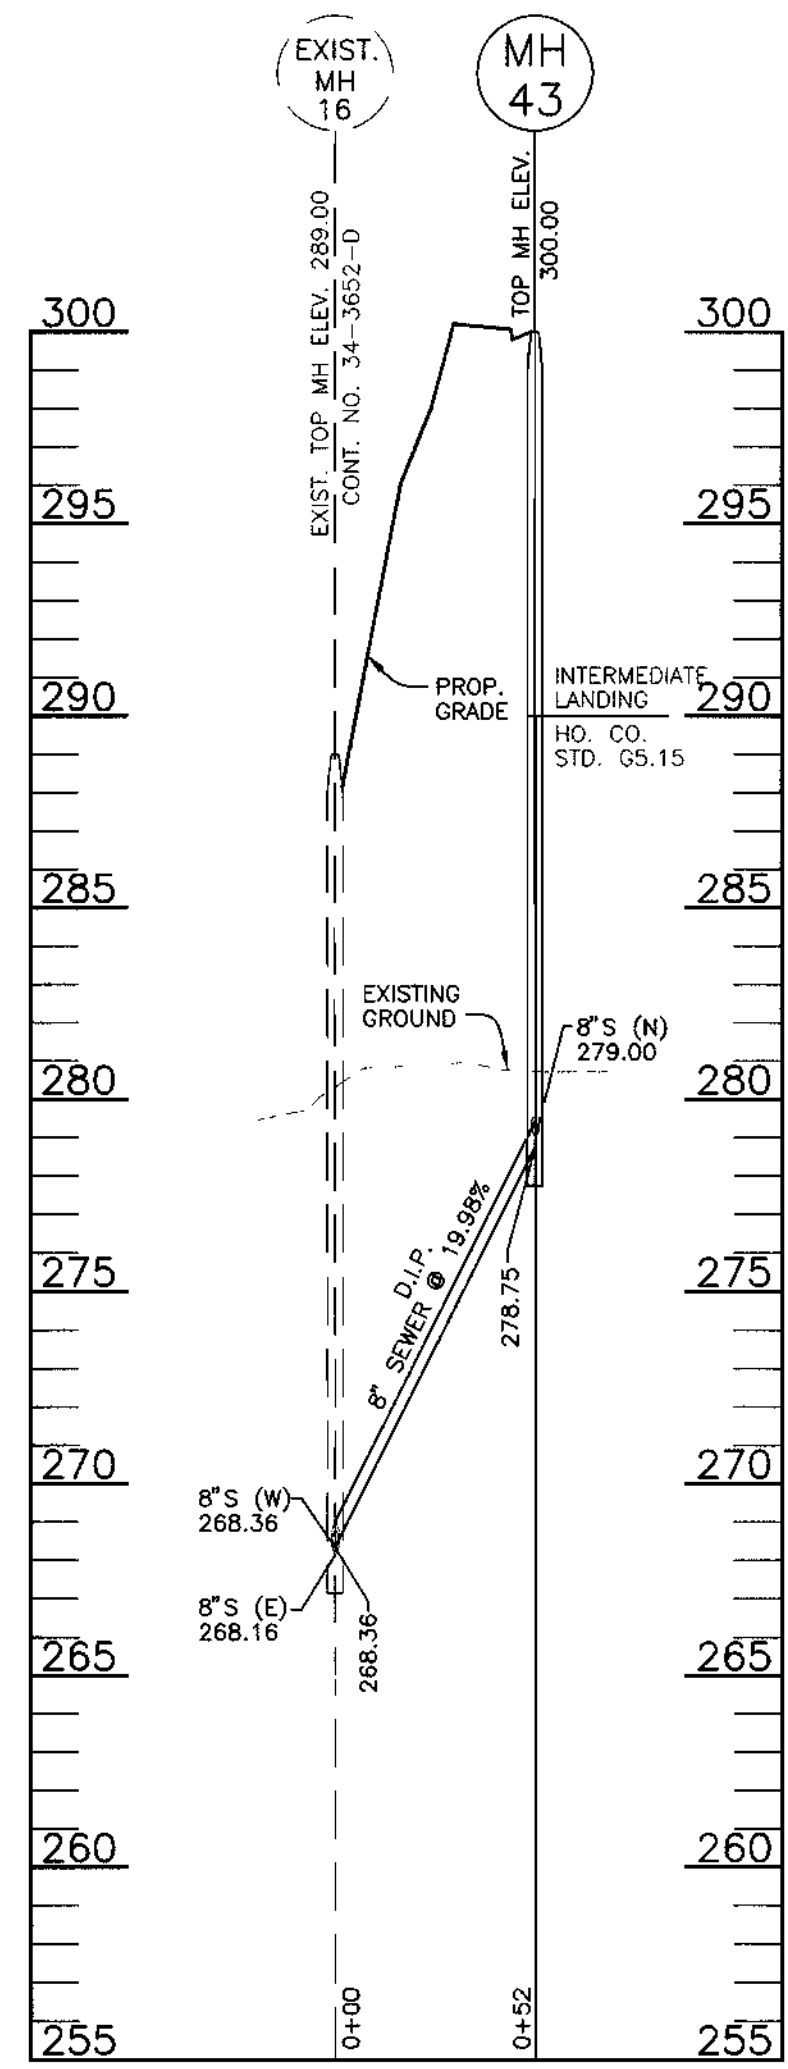


NOTE: ALL SEWER MANHOLES SHALL BE PRECAST FOR THIS CONTRACT.

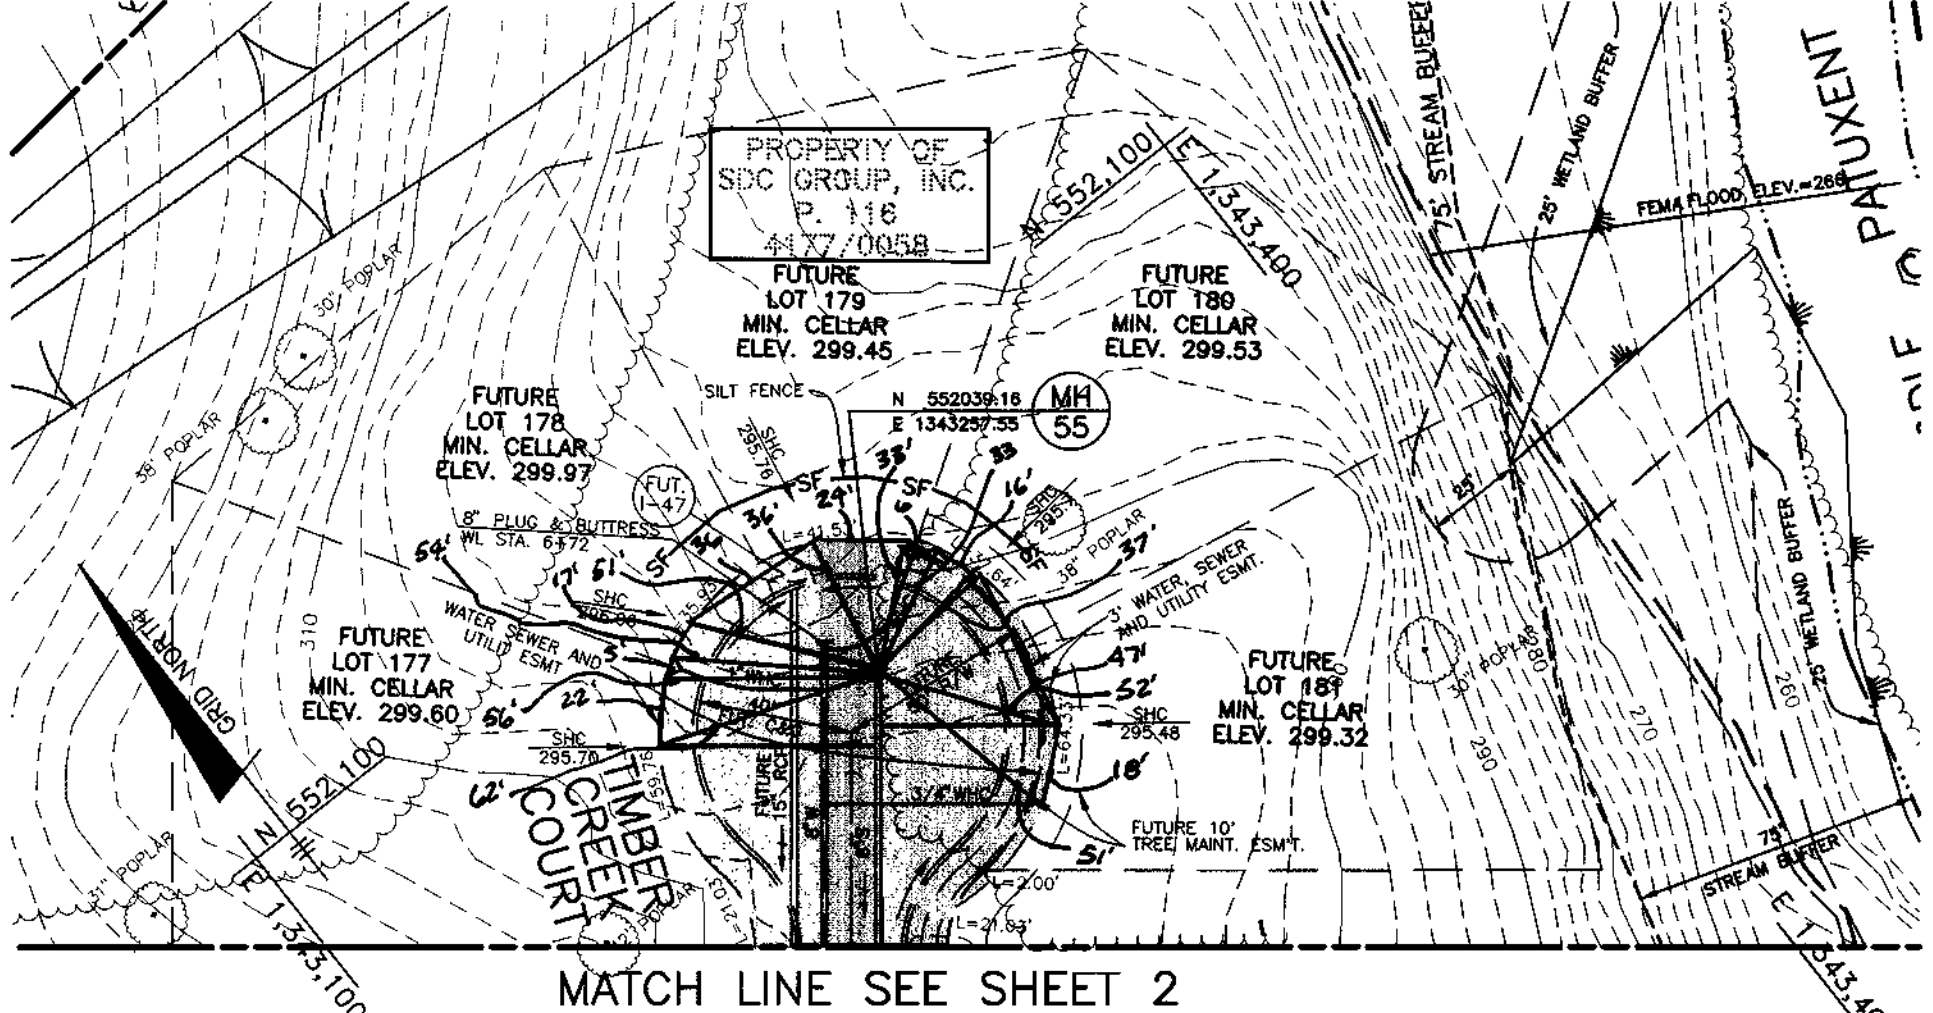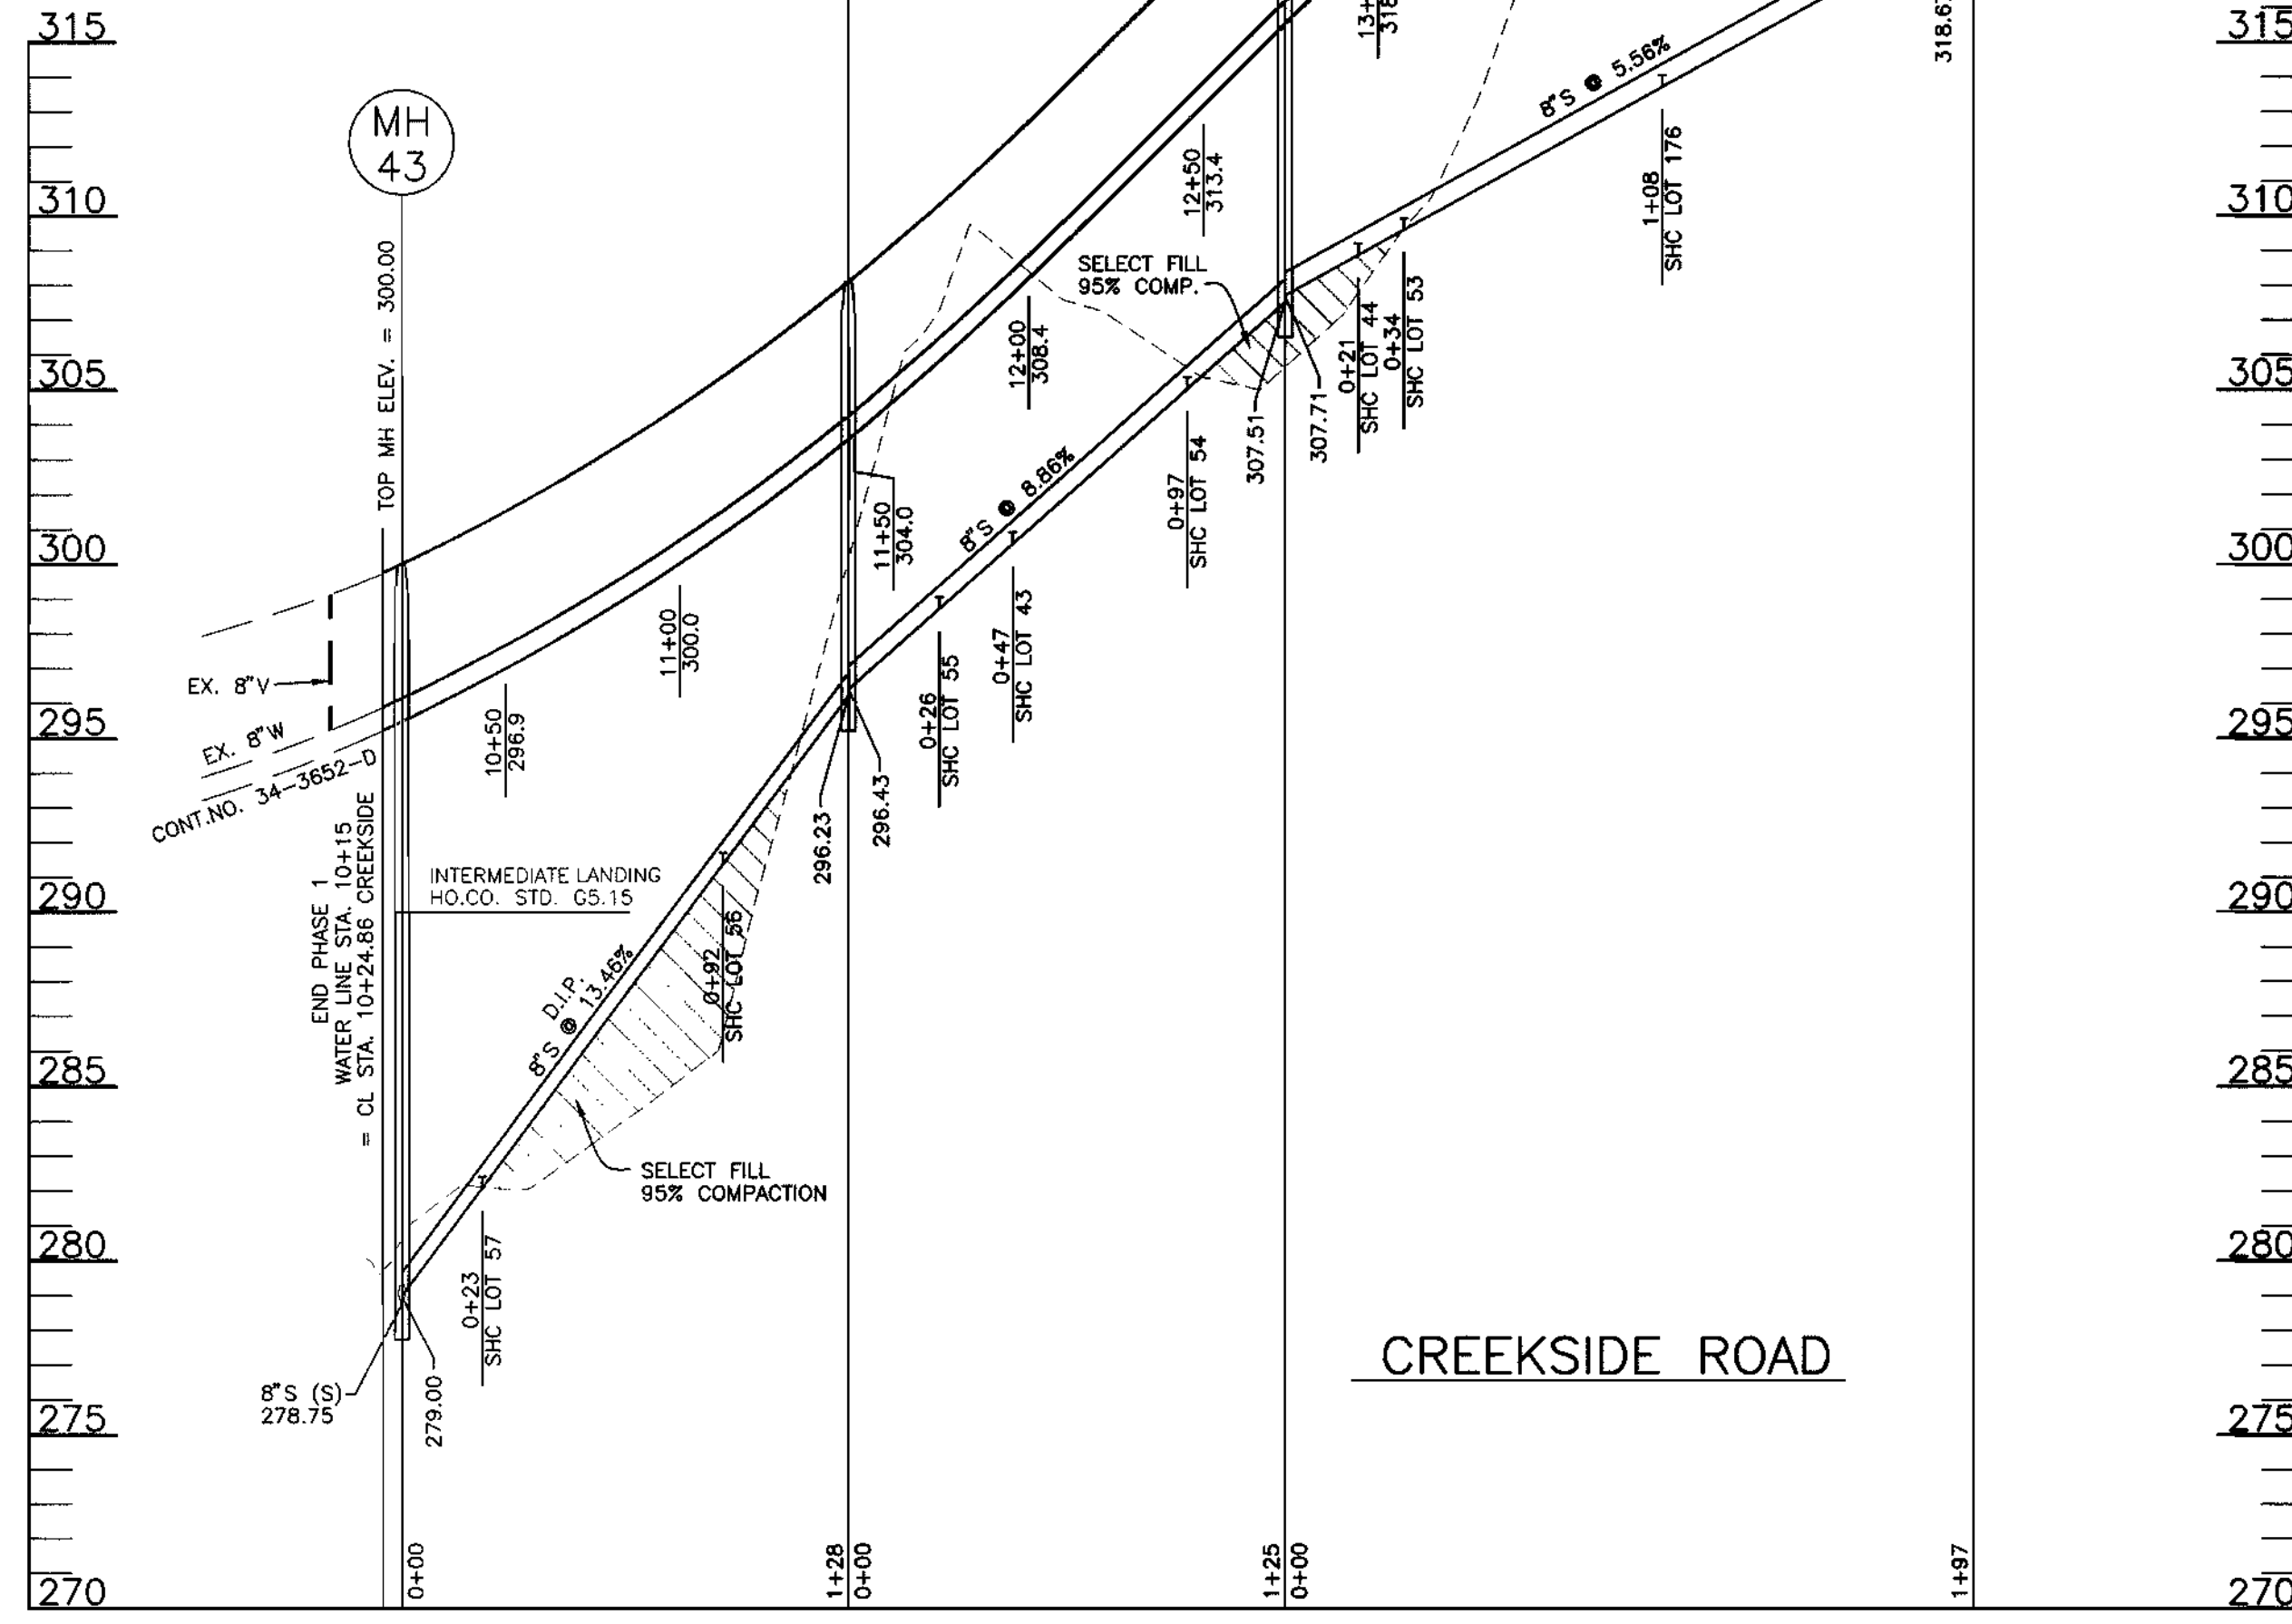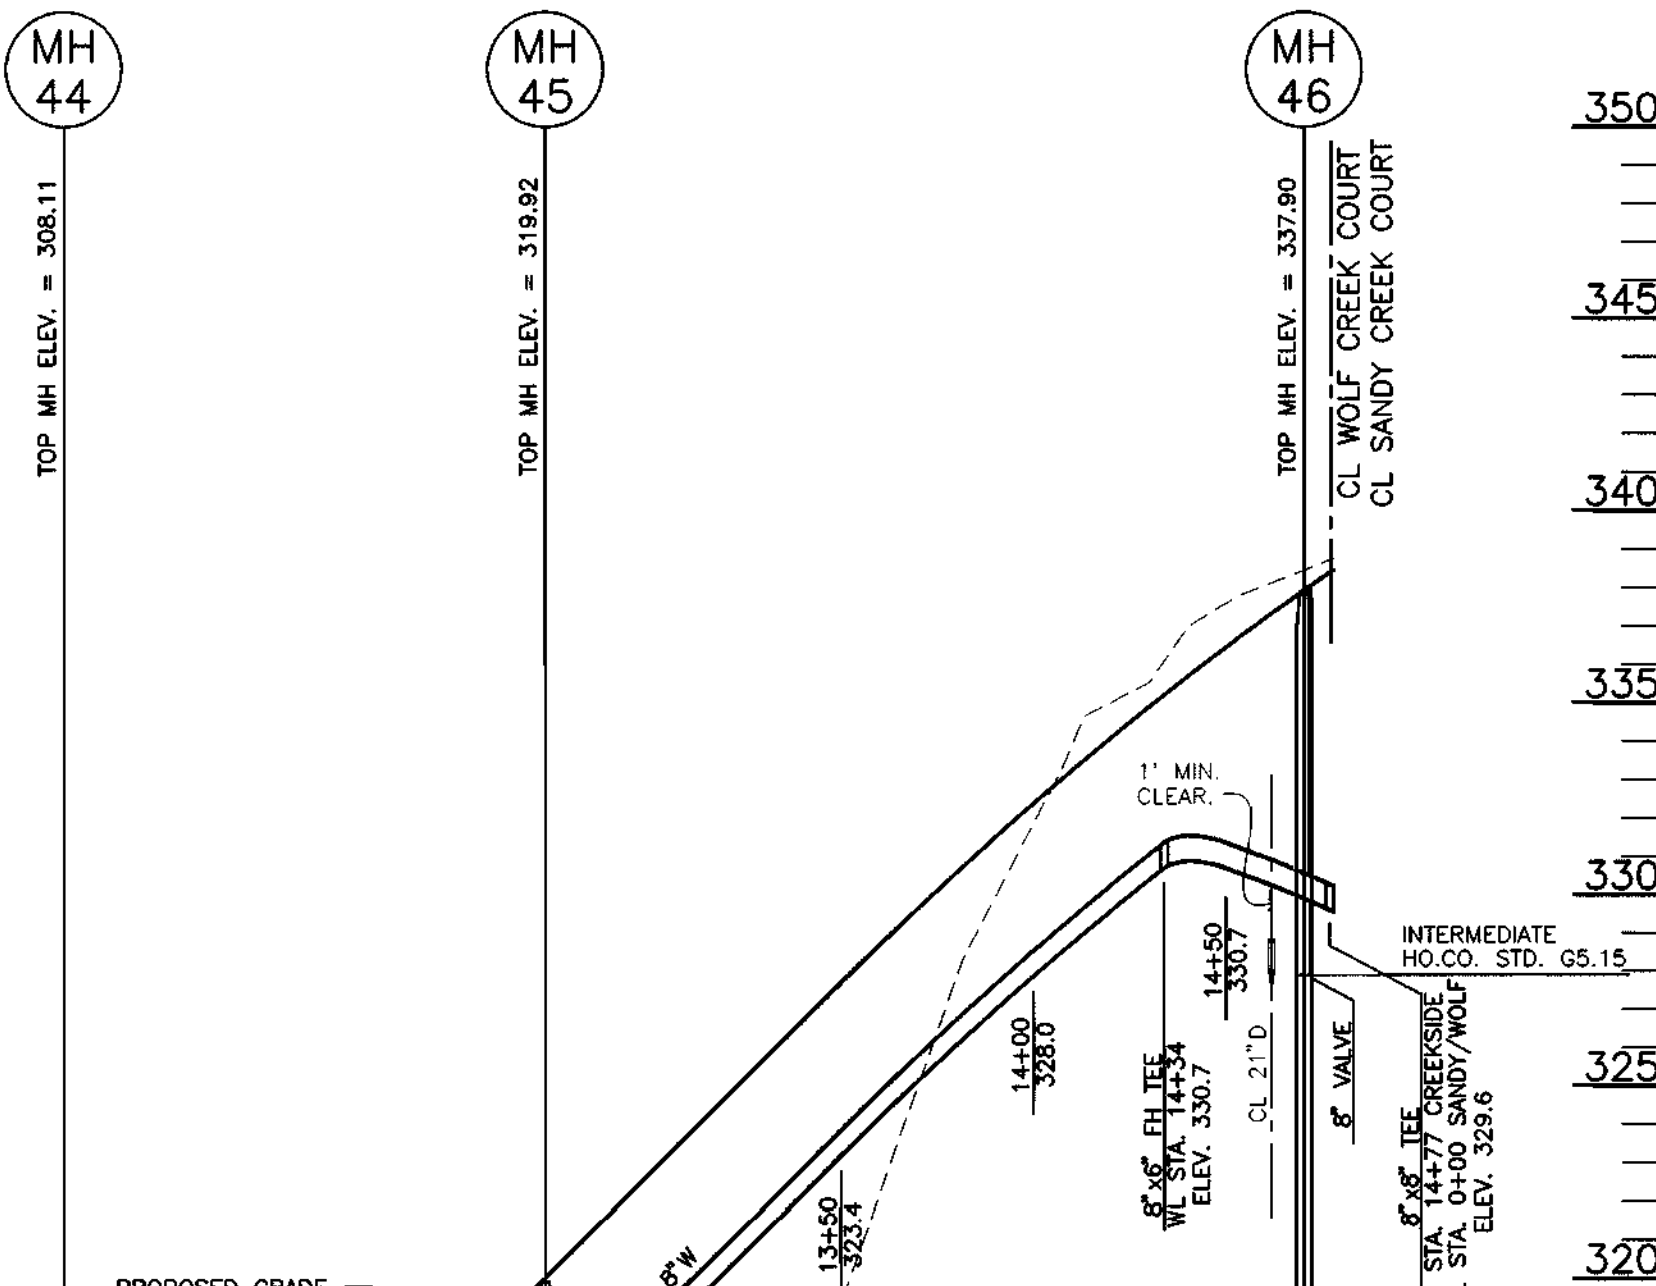

MATCH LINE SEE SHEET 2

PLAN VIEW
SCALE: 1" = 50'

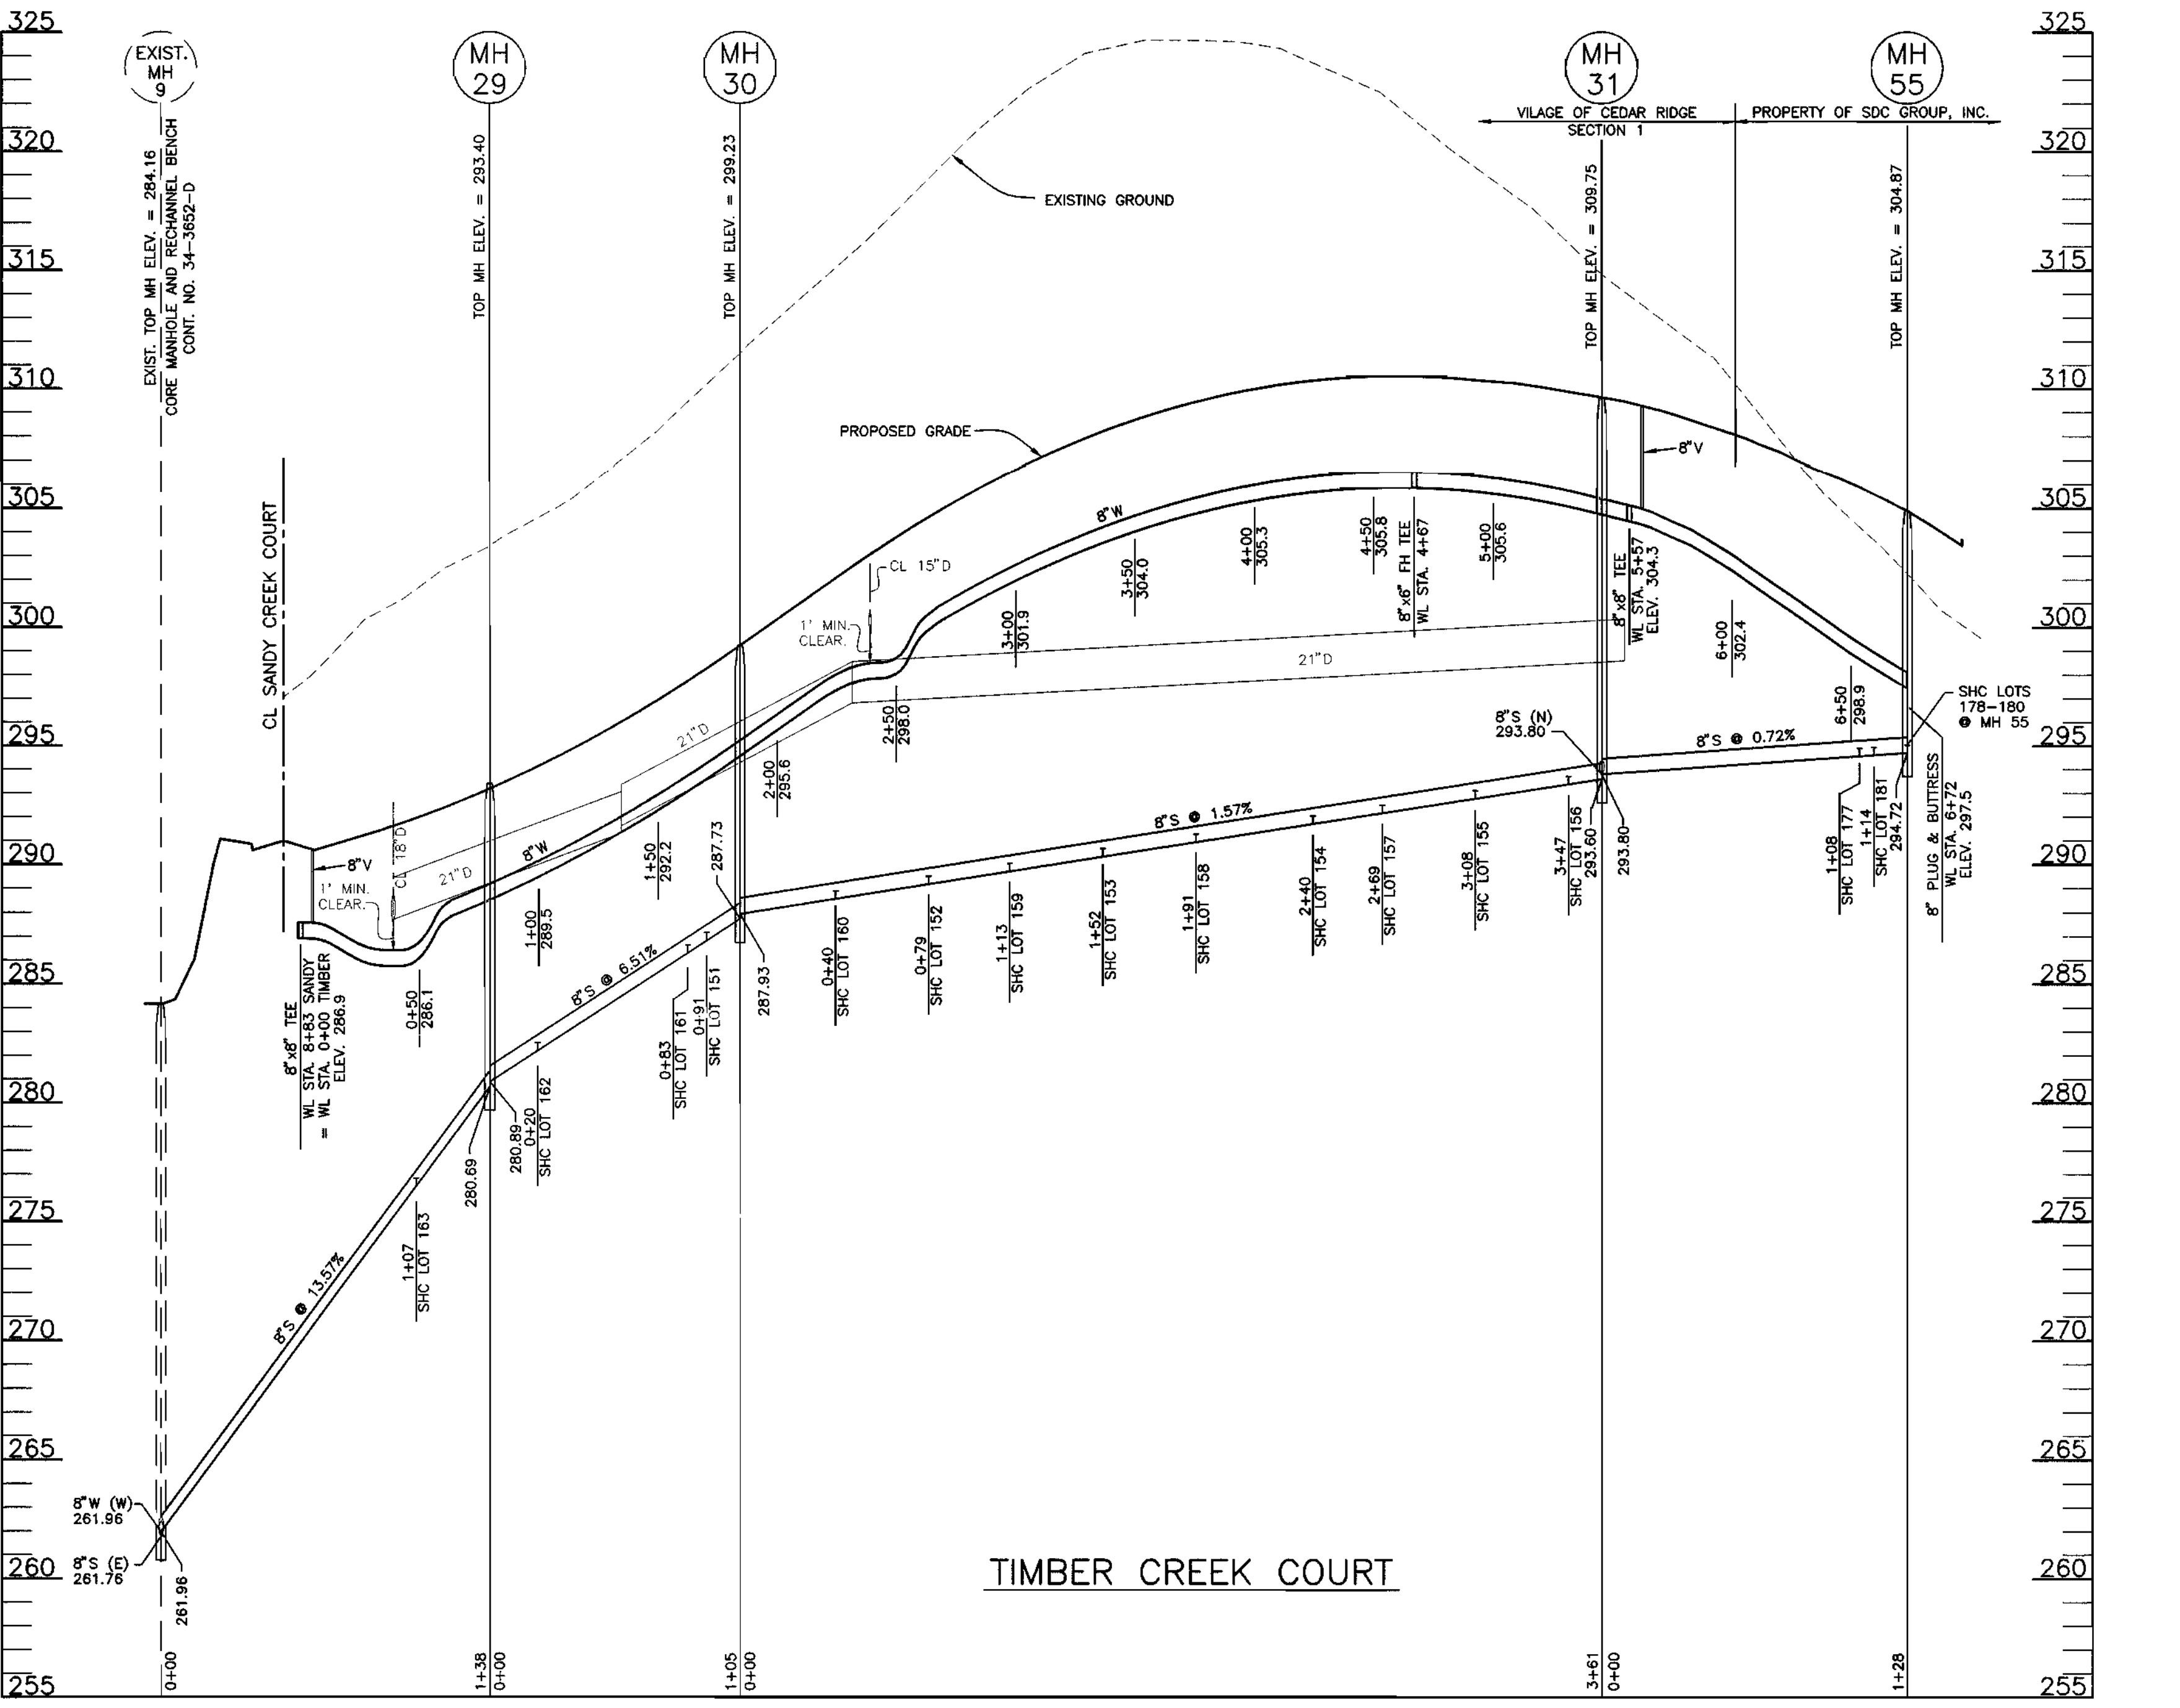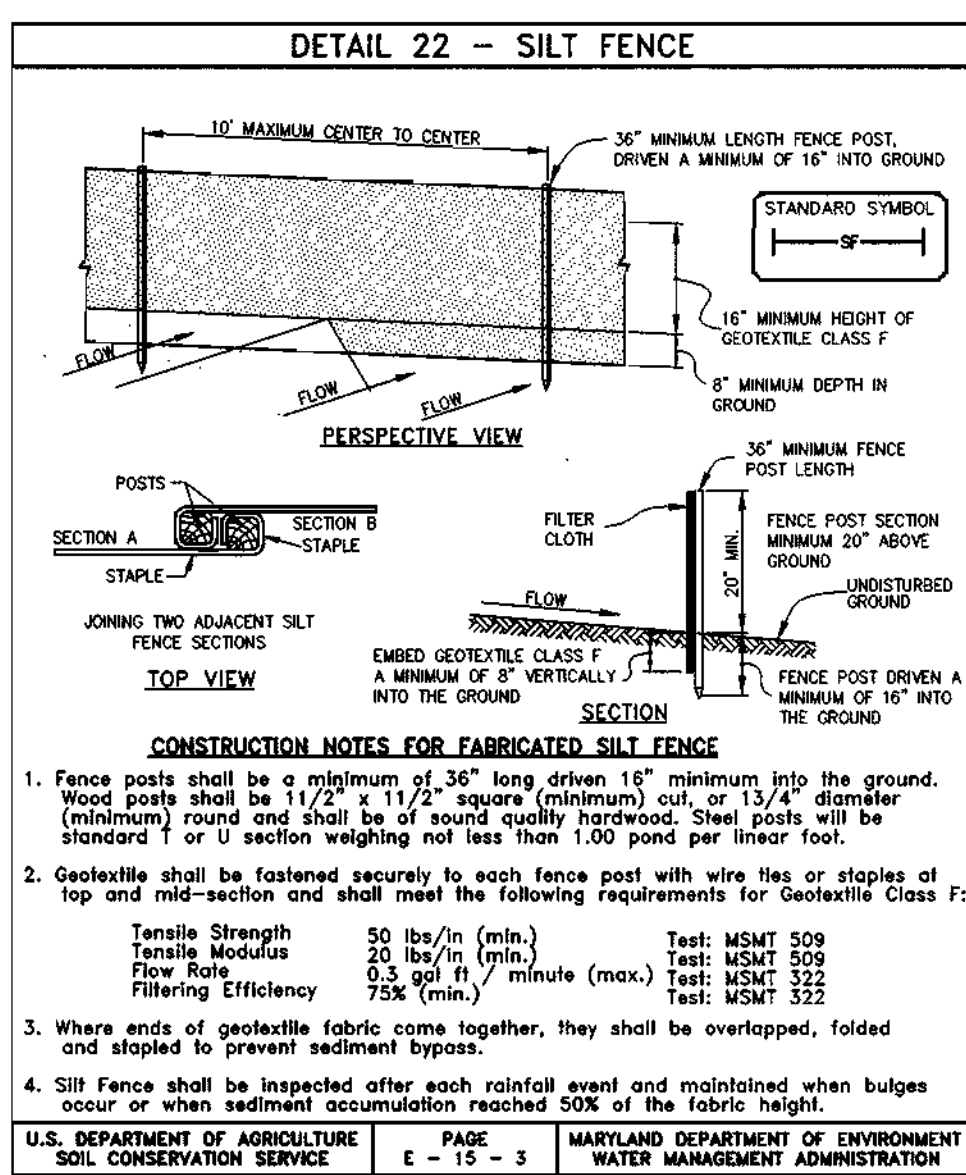

SCALE: 1"=50'HORIZ., 1"=5'VERT.

Printed: April 27, 1998

Acad Dwg: 6002504

DEPARTMENT OF PUBLIC WORKS
HOWARD COUNTY, MARYLAND

DEPARTMENT OF PLANNING AND ZONING
HOWARD COUNTY, MARYLAND

TSA GROUP, INC.
planning • engineering • surveying
8480 Baltimore National Pike Suite 418
Ellicott City, Maryland 21043

Donald Mason

DES:	MLV				
DRN:	DBT				
CHK:	DAM				
DATE:	11/97	BY:	NO.	REVISIONS	DATE
	4/98				

PROFILES OF
WATER AND SEWER MAINS

600 SCALE MAP NO. 41 BLOCK 4 AND 5





VILLAGE OF CEDAR RIDGE
PHASE 2
ELECTION DISTRICT NO. 5

CONTRACT NO. 34-3662-D

SCALE:
AS SHOWN
SHEET NO.
4 OF 6

R. J. ...
CHIEF, BUREAU OF UTILITIES
5-5-98

M. ...
CHIEF, DEVELOPMENT ENGINEERING DIVISION
5/1/98

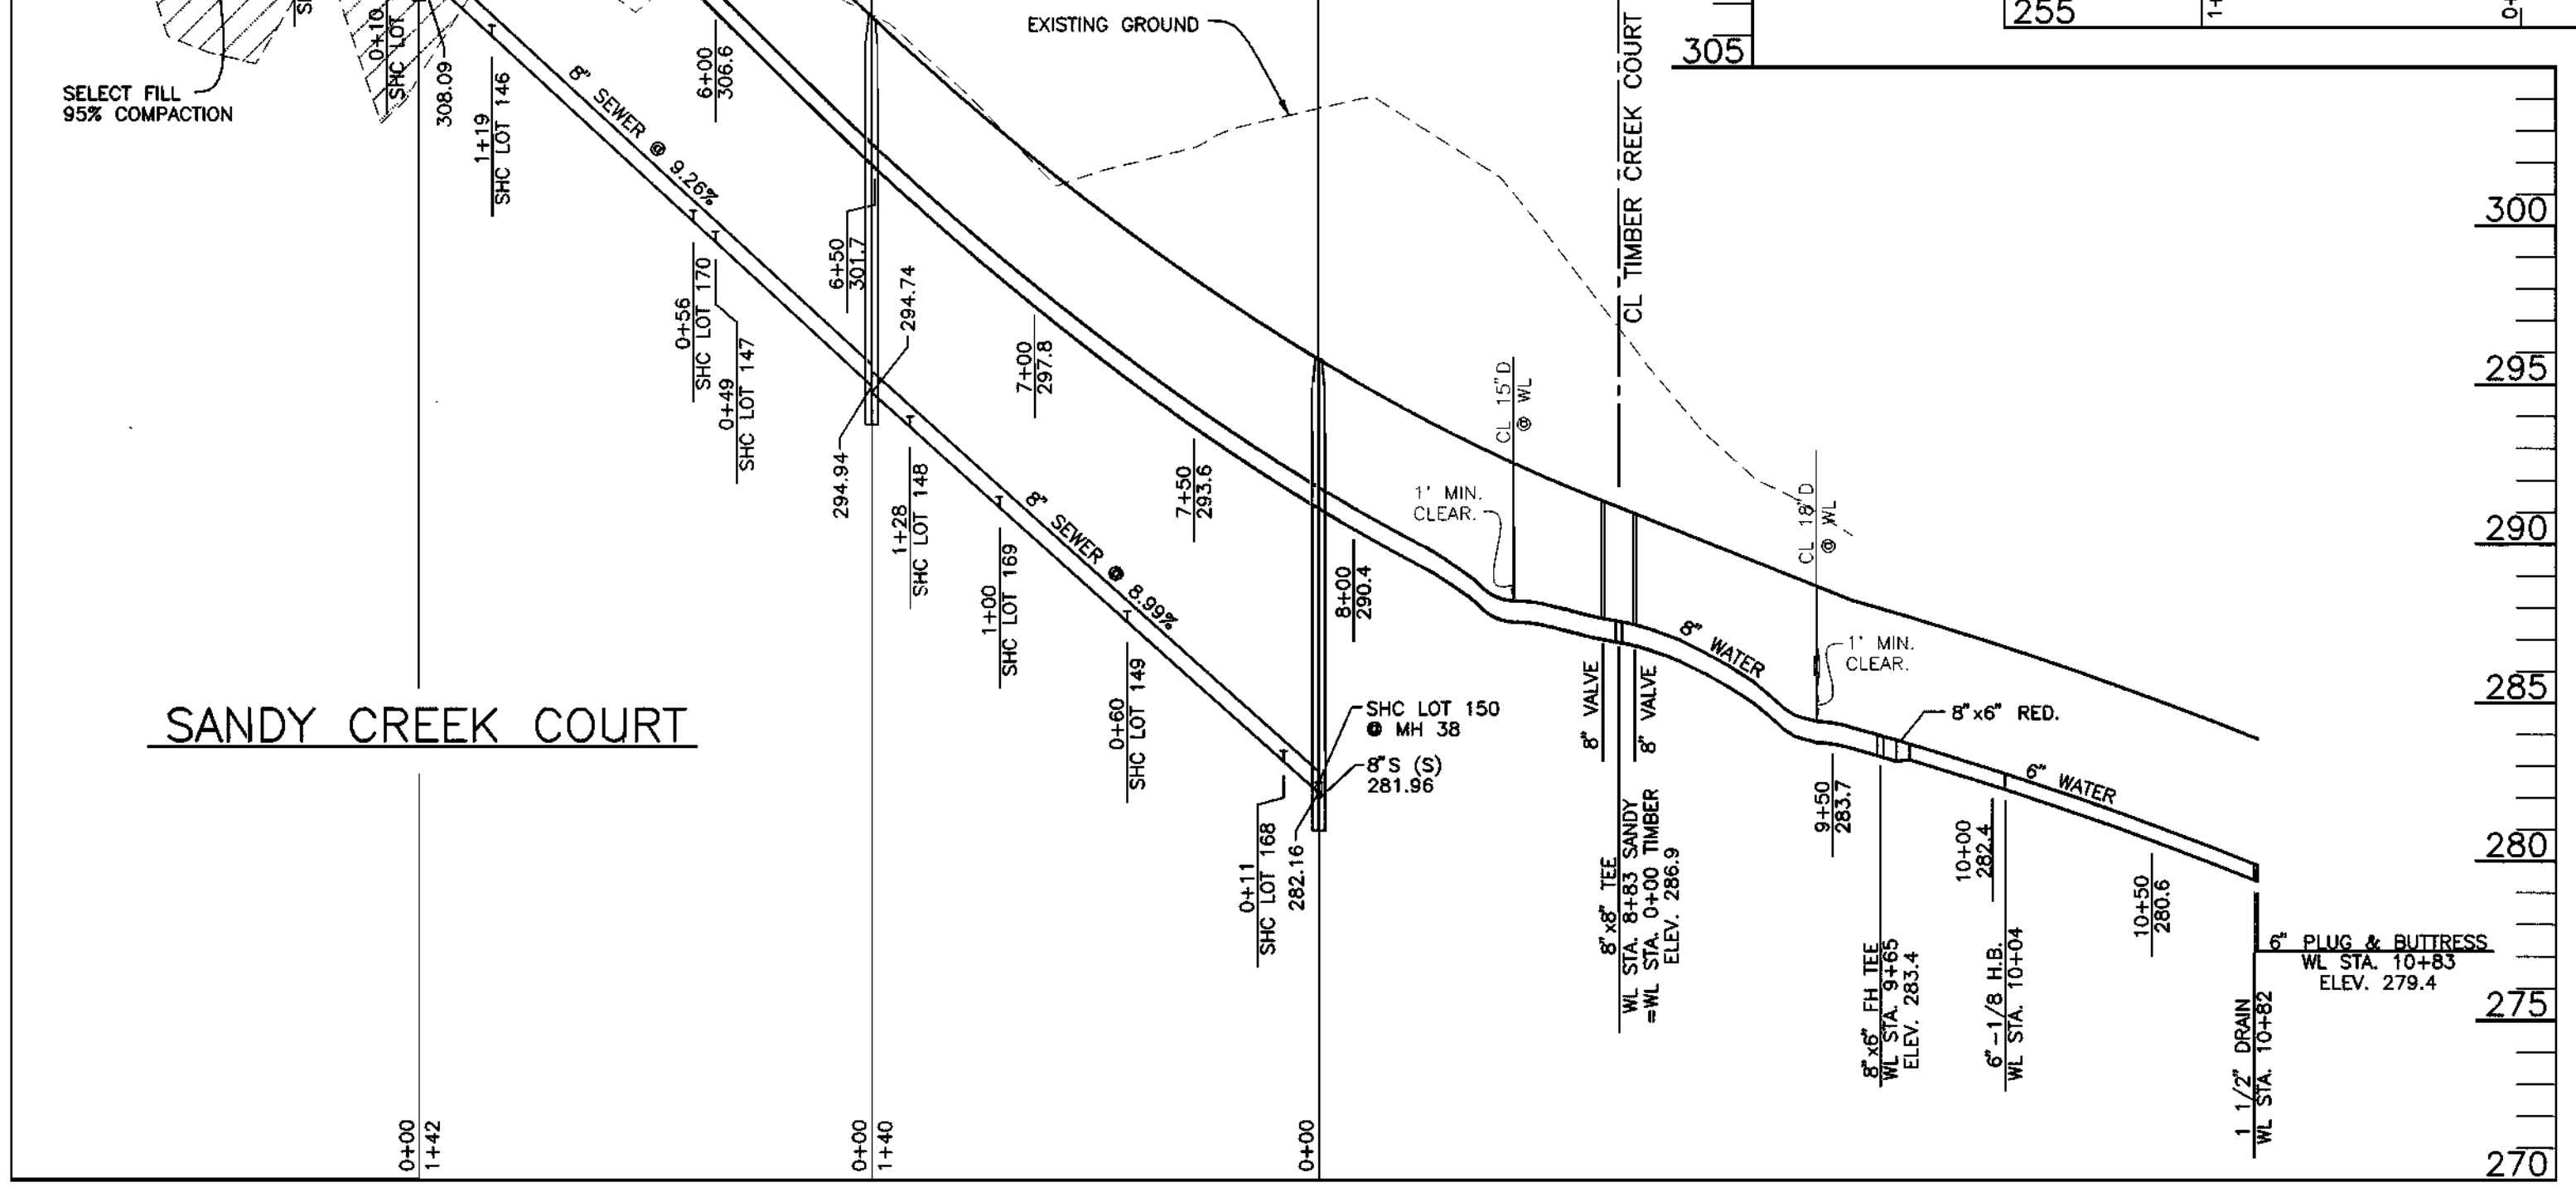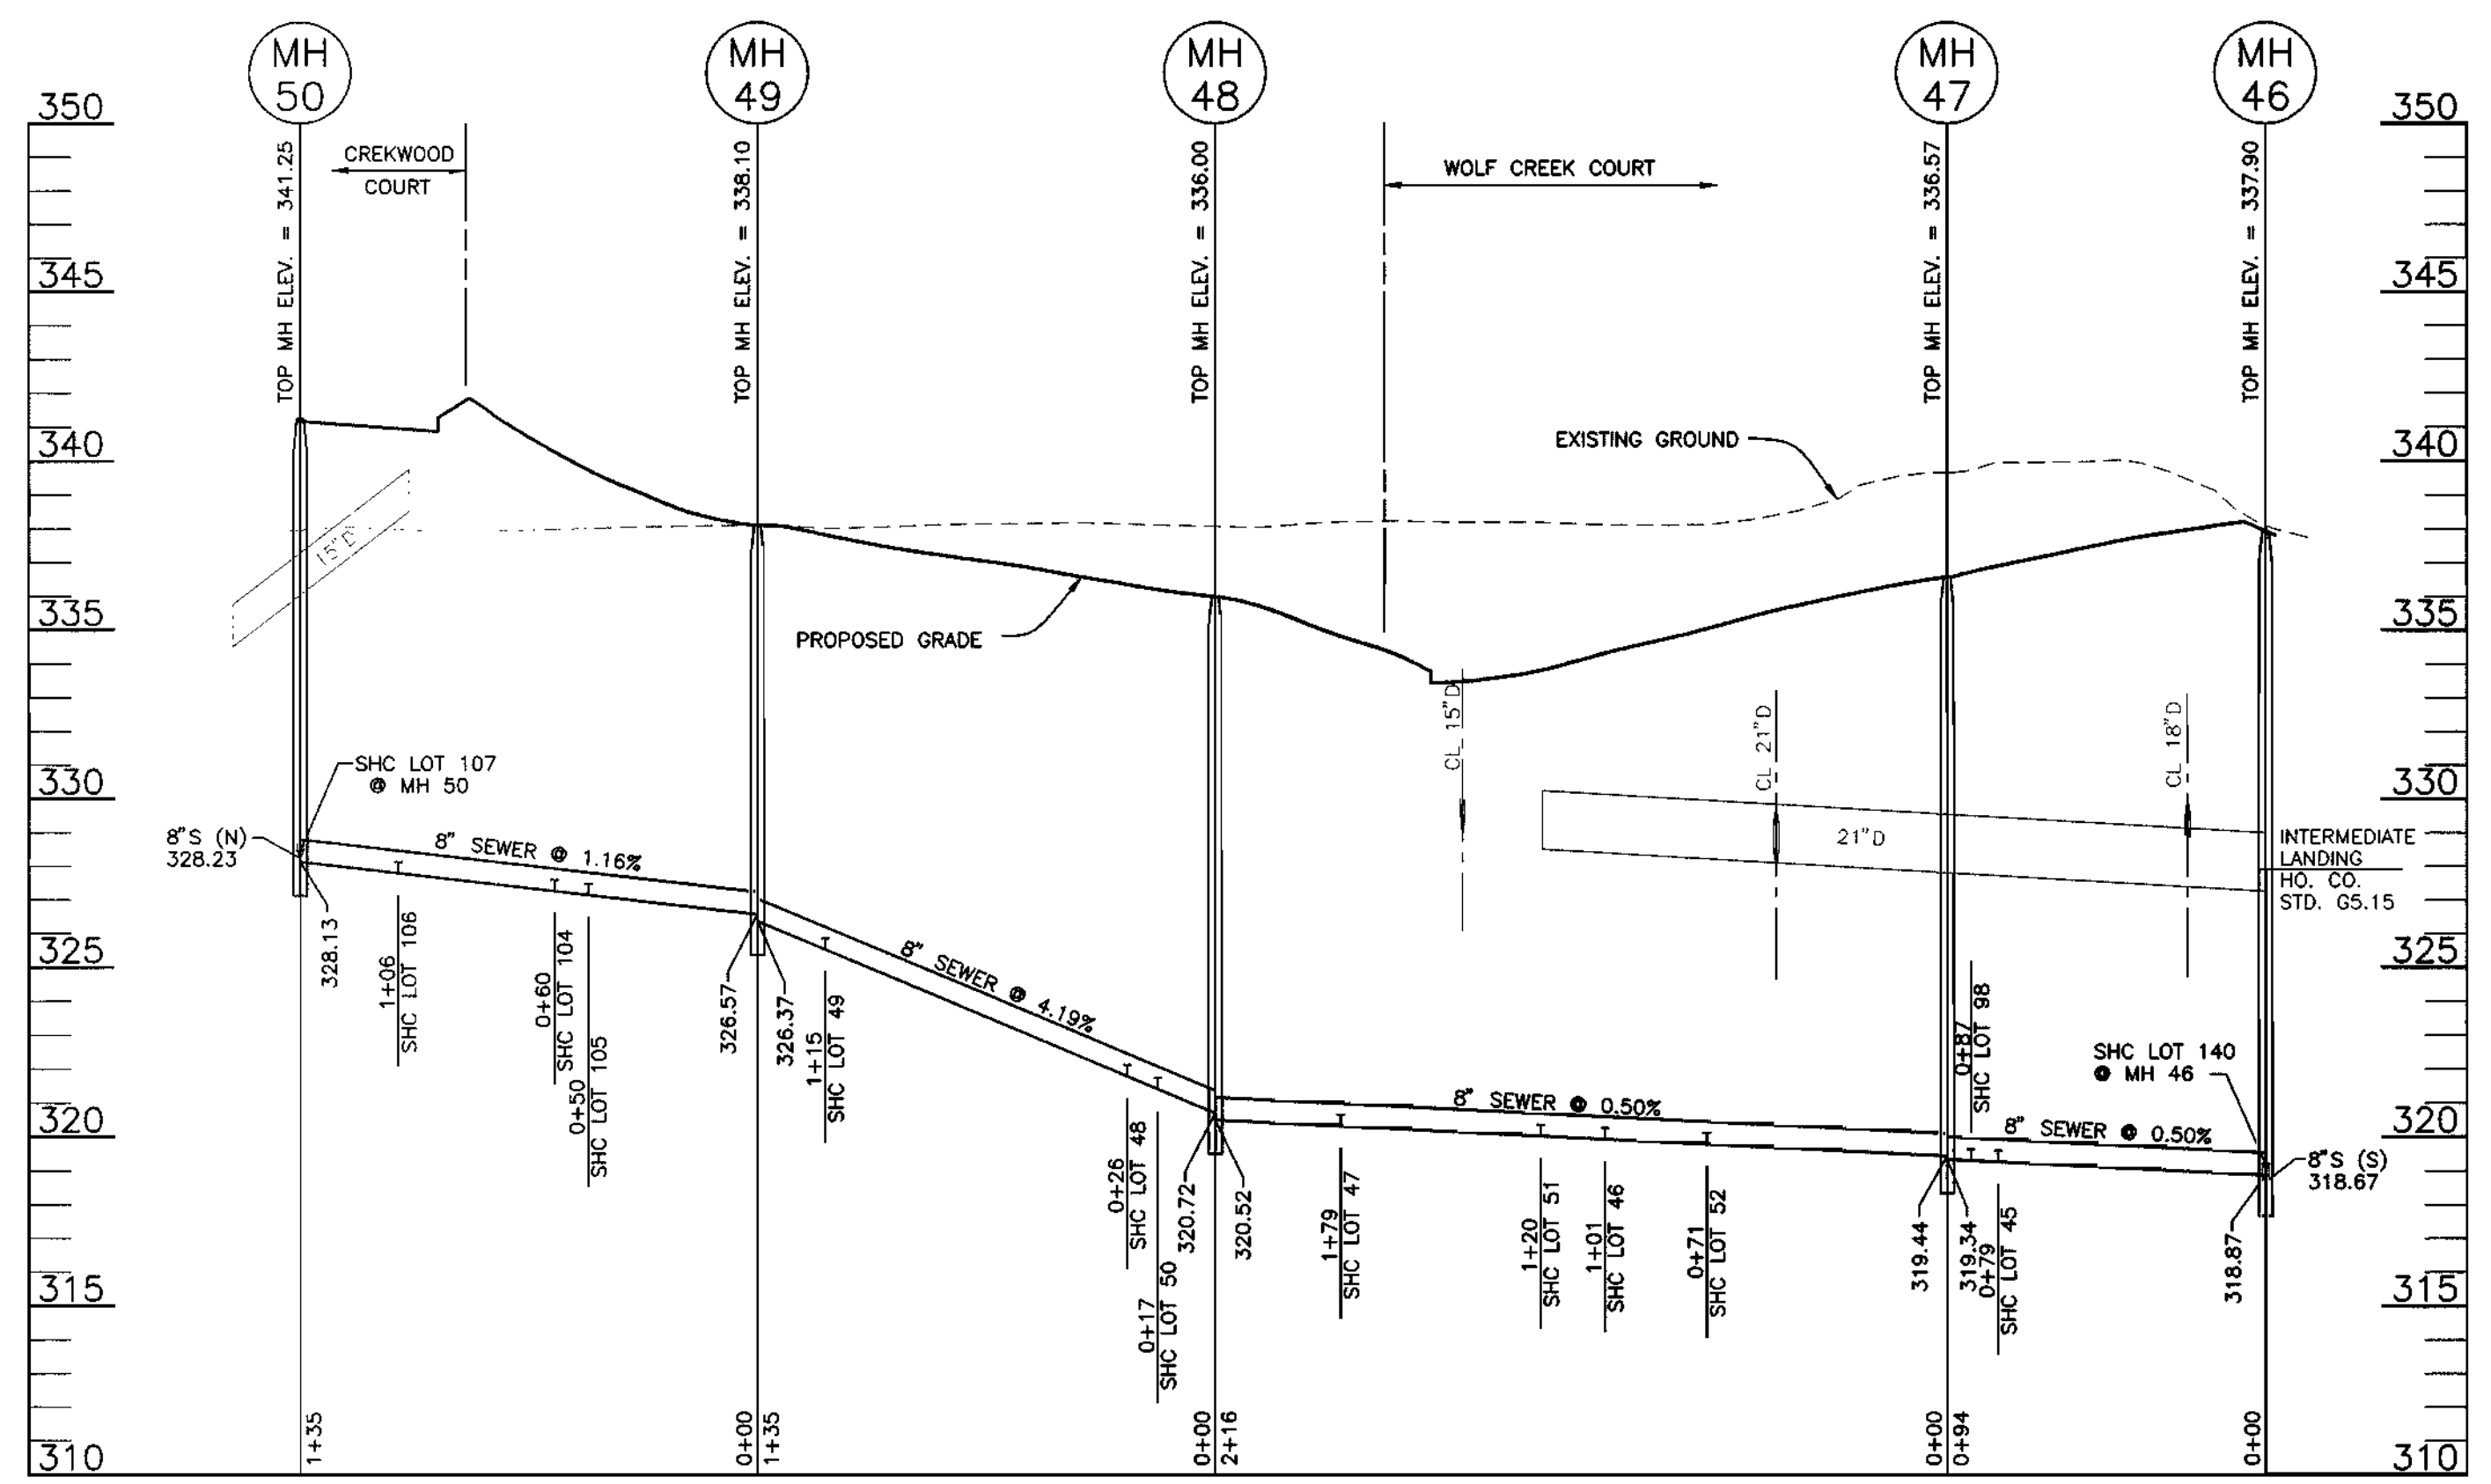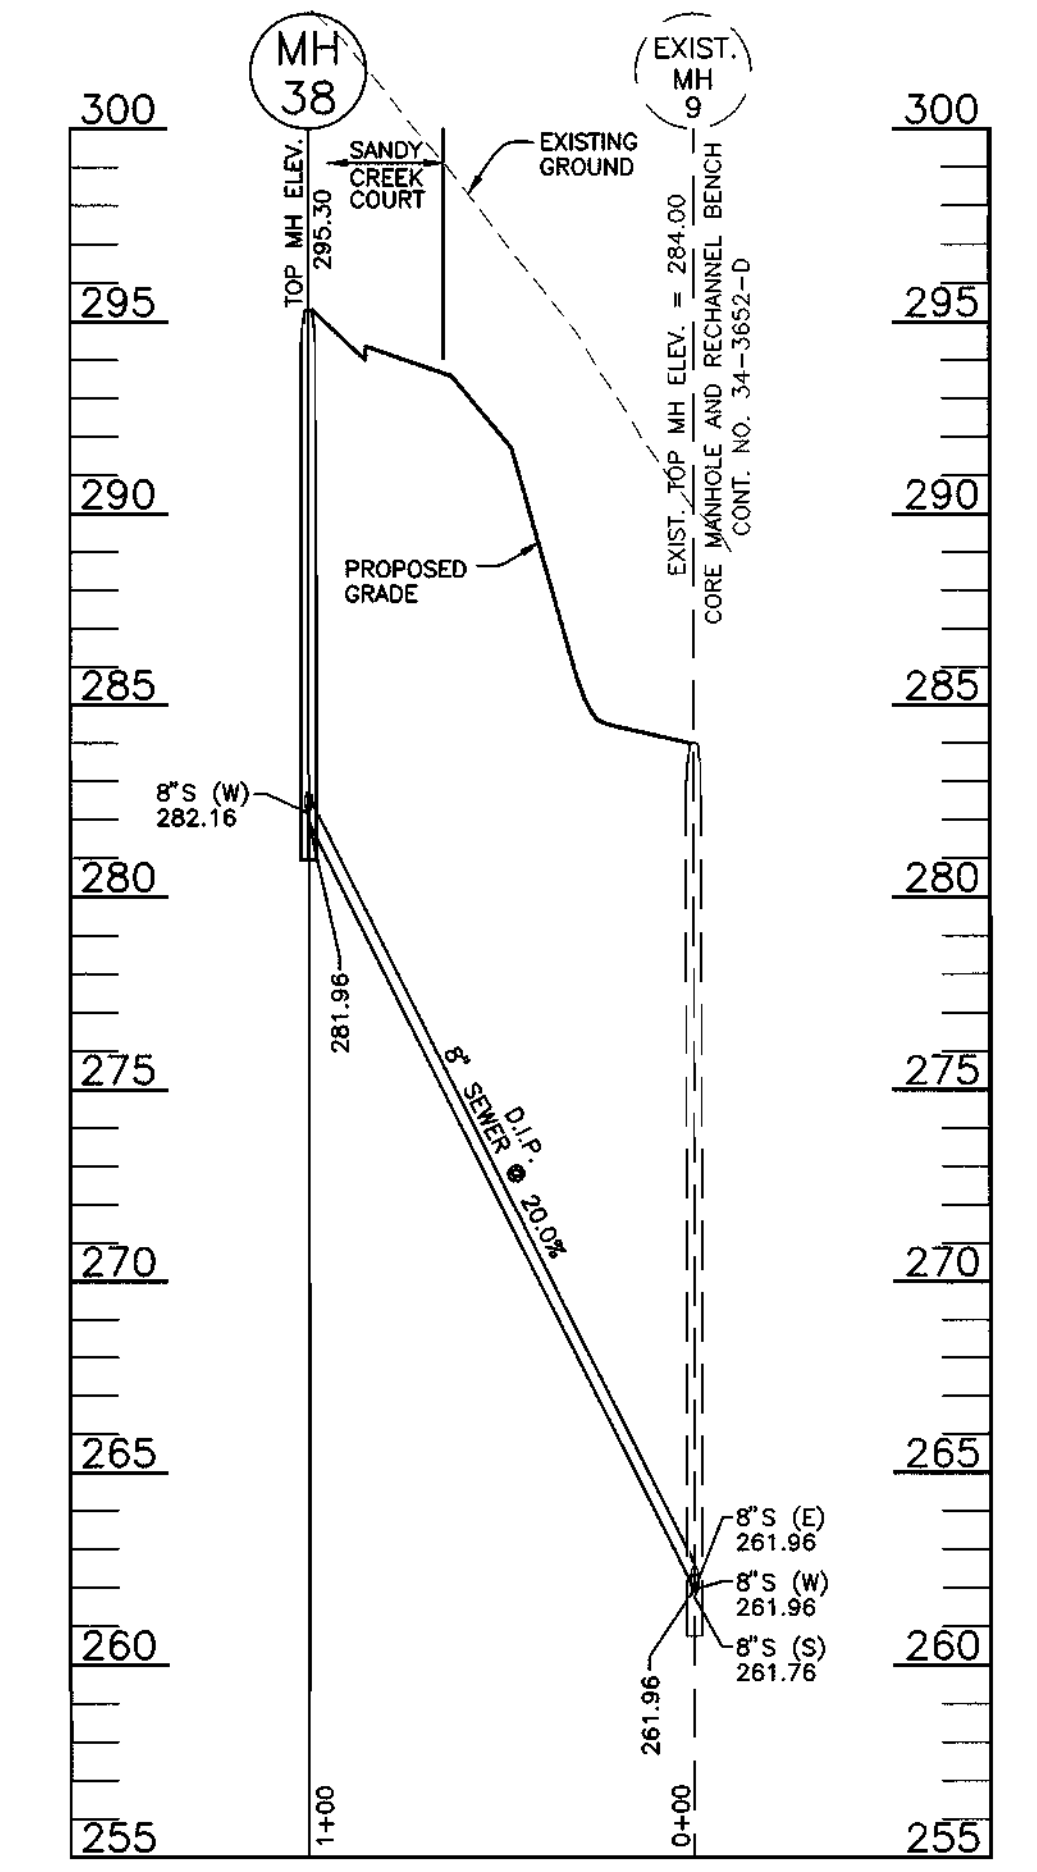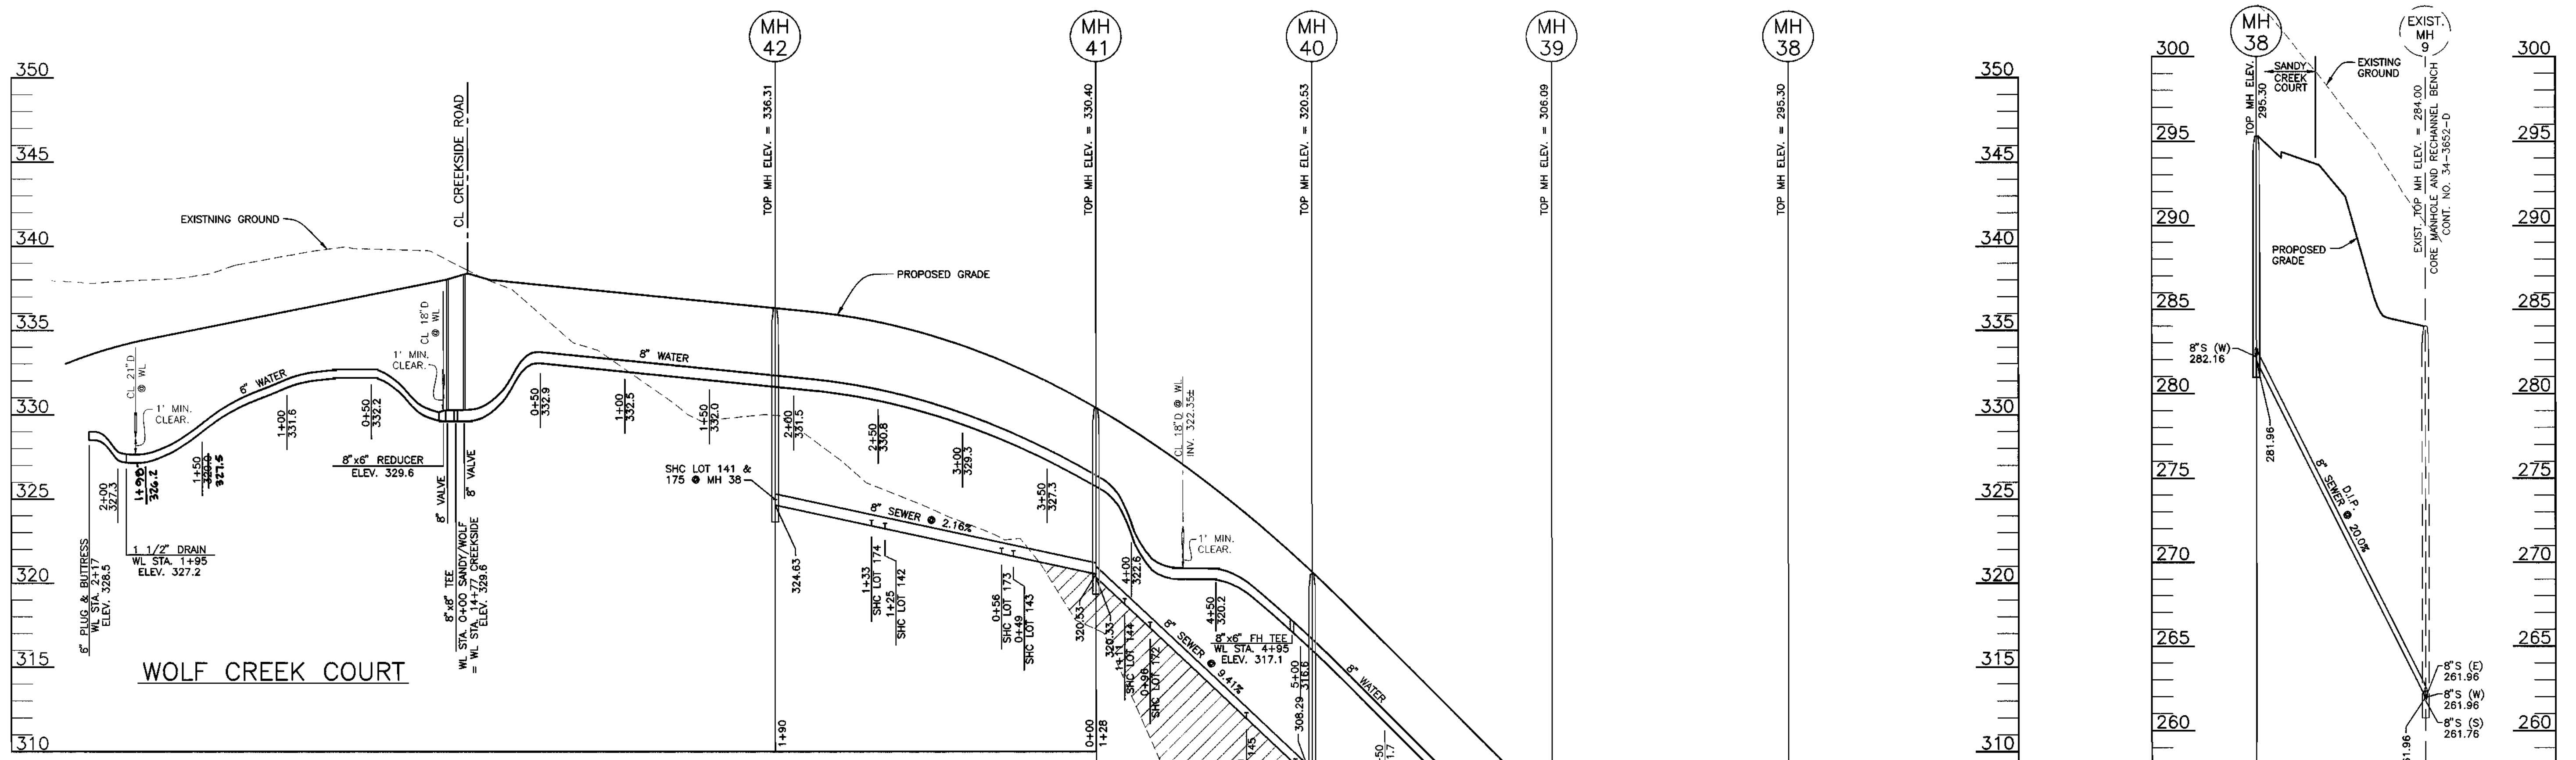

NOTE: ALL SEWER MANHOLES SHALL BE PRECAST FOR THIS CONTRACT.

Acad Dwg: 6002505
Plotted: April 3, 1998

DEPARTMENT OF PUBLIC WORKS
HOWARD COUNTY, MARYLAND

DEPARTMENT OF PLANNING AND ZONING
HOWARD COUNTY, MARYLAND

TSA GROUP, INC.
planning • engineering • surveying
8480 Baltimore National Pike Suite 418
Ellicott City, Maryland 21043



DES:	MLV				
DRN:	DBT				
CHK:	DAM				
DATE:	11/97	BY:	NO.	REVISIONS	DATE
	4/98				

PROFILES OF
WATER AND SEWER MAINS





600 SCALE MAP NO. 41
BLOCK 4 AND 5

VILLAGE OF CEDAR RIDGE
PHASE 2
ELECTION DISTRICT NO. 5
CONTRACT NO. 34-3662-D

SCALE:
1"=50' HORIZ.
1"=5' VERT.
SHEET NO.
5 OF 6

Robert J. Reinger
CHIEF, BUREAU OF UTILITIES
5-5-98

David M. Mason
CHIEF, DEVELOPMENT ENGINEERING DIVISION
5/14/98

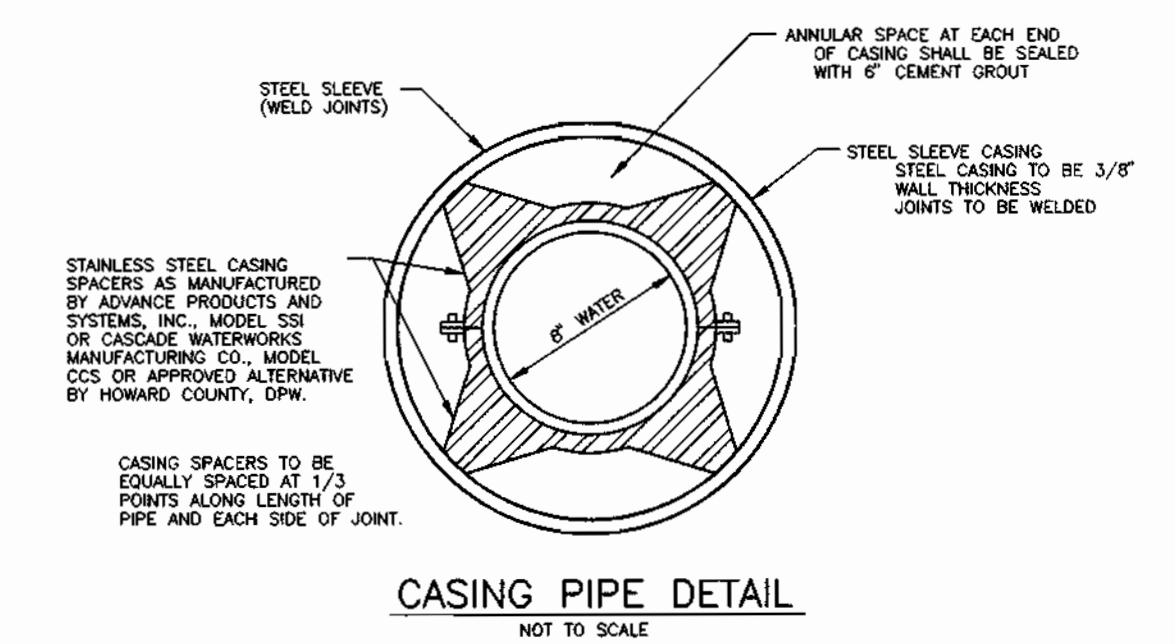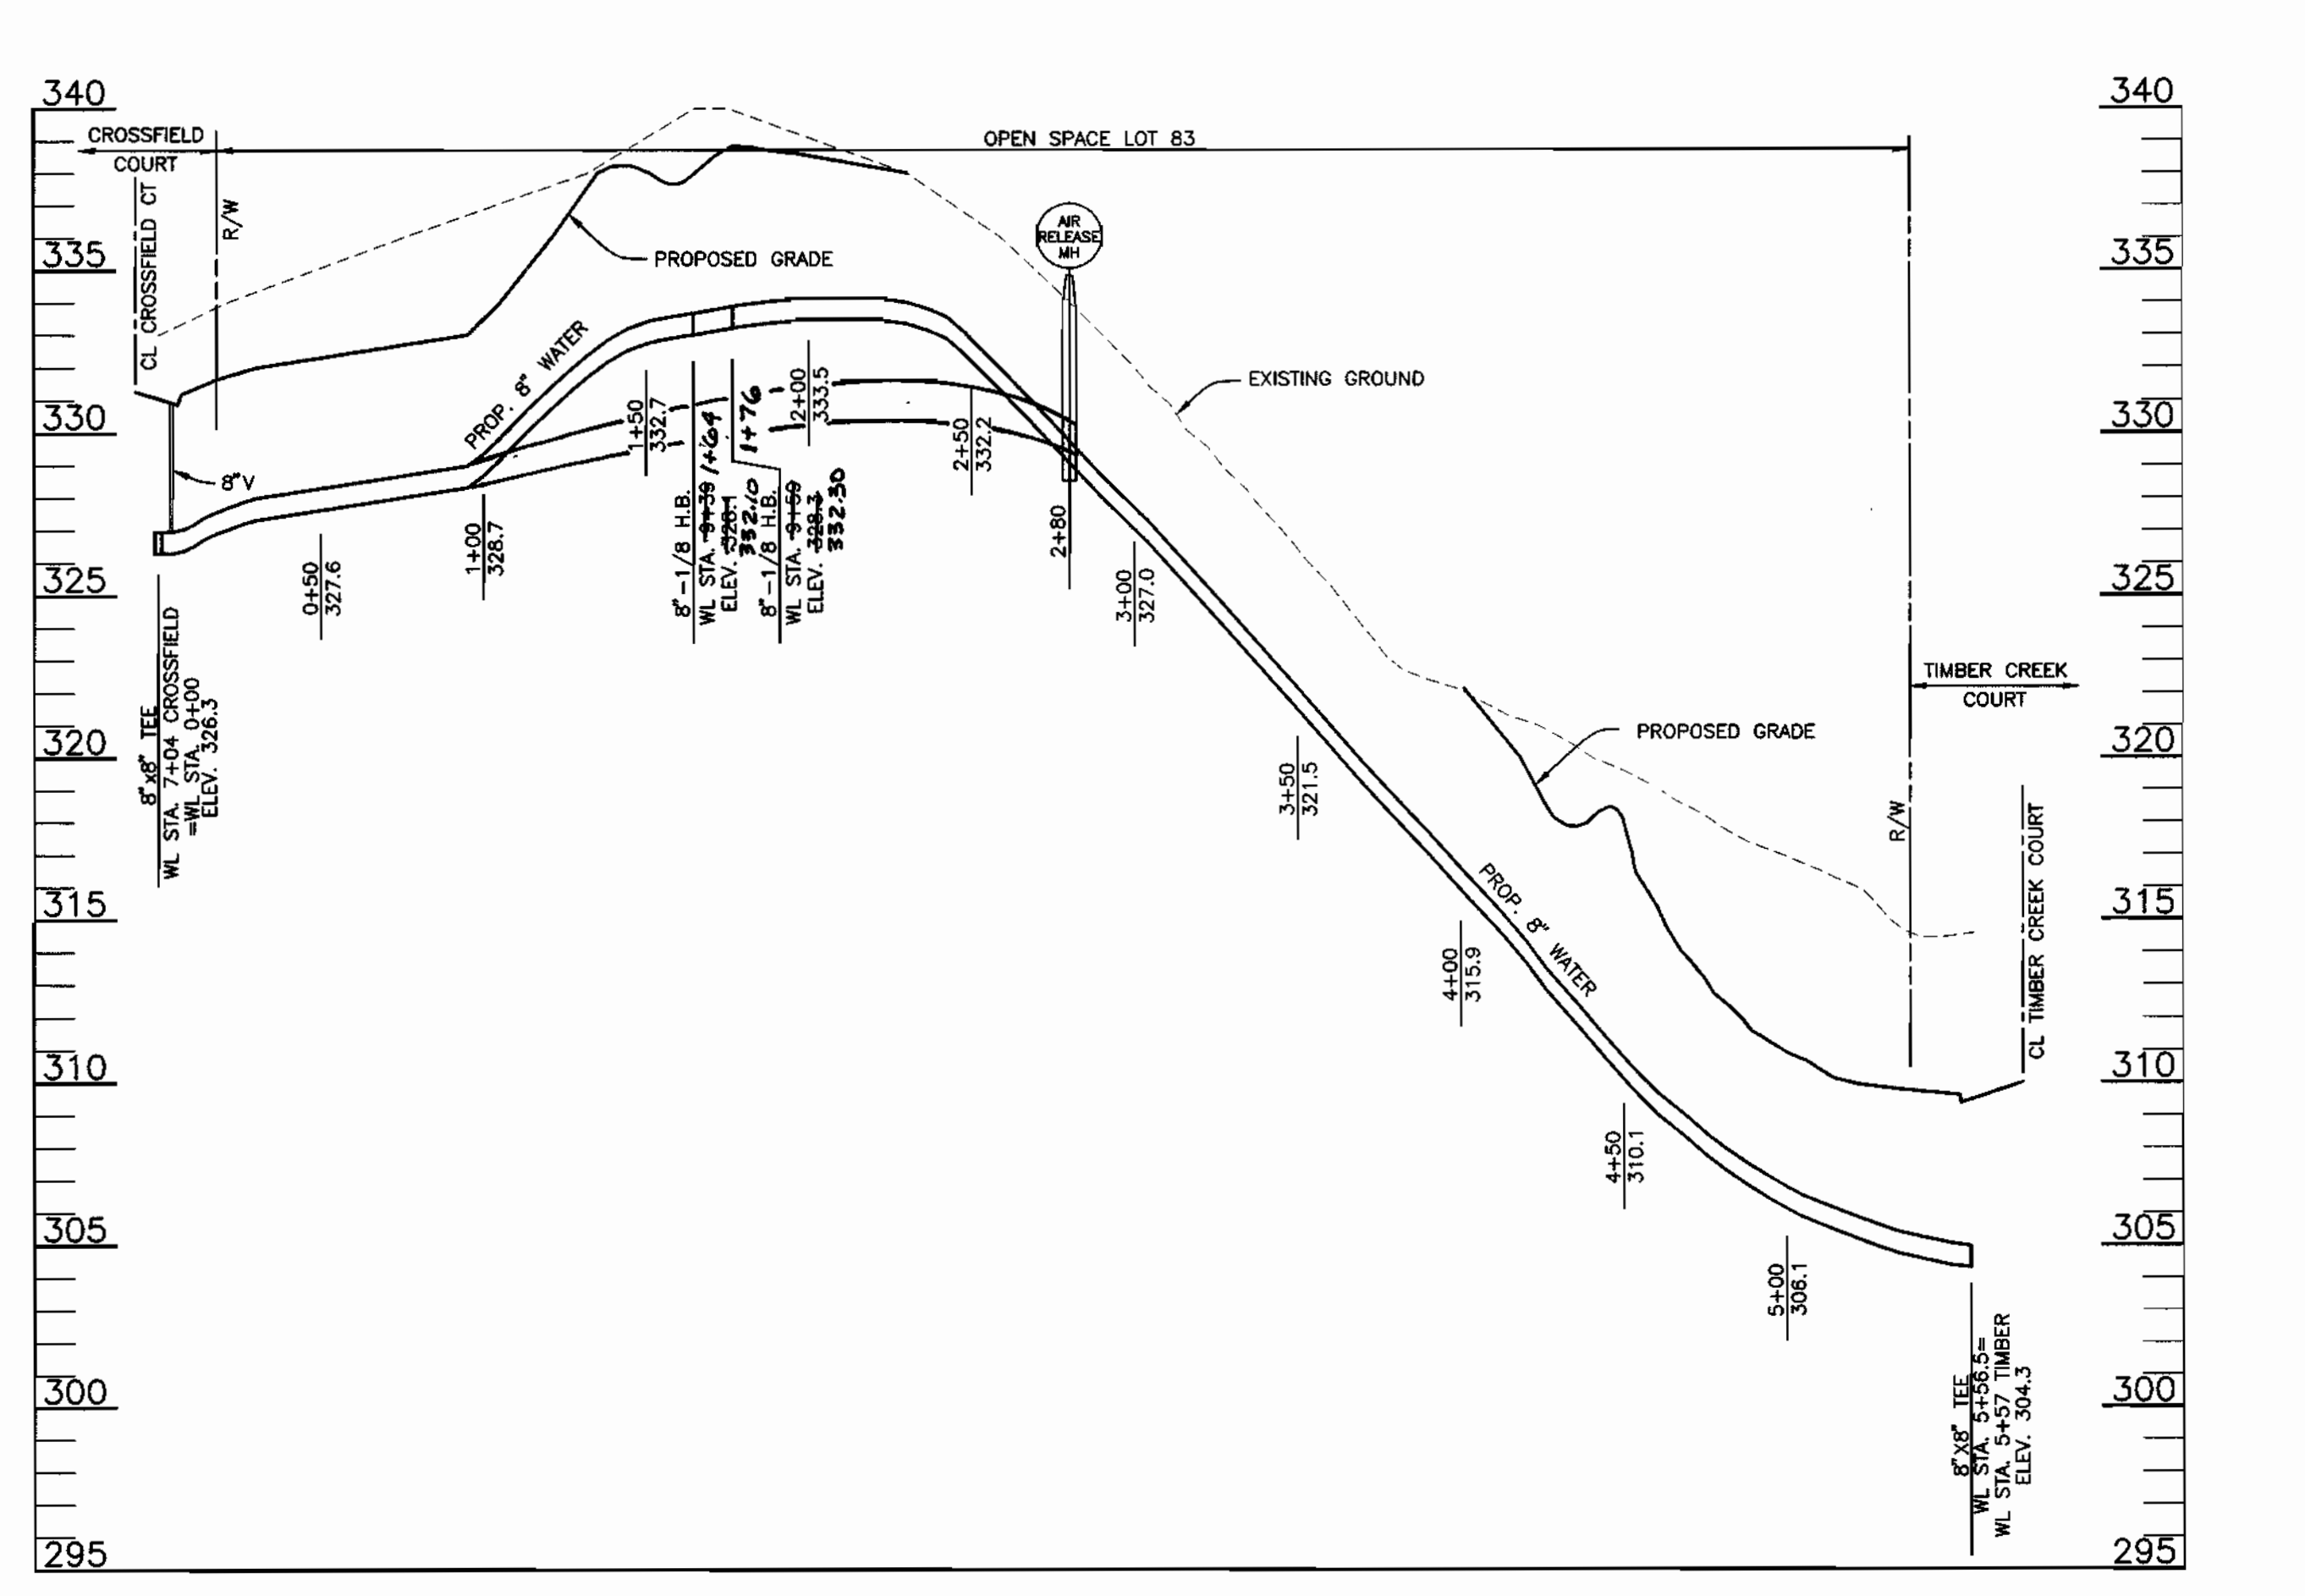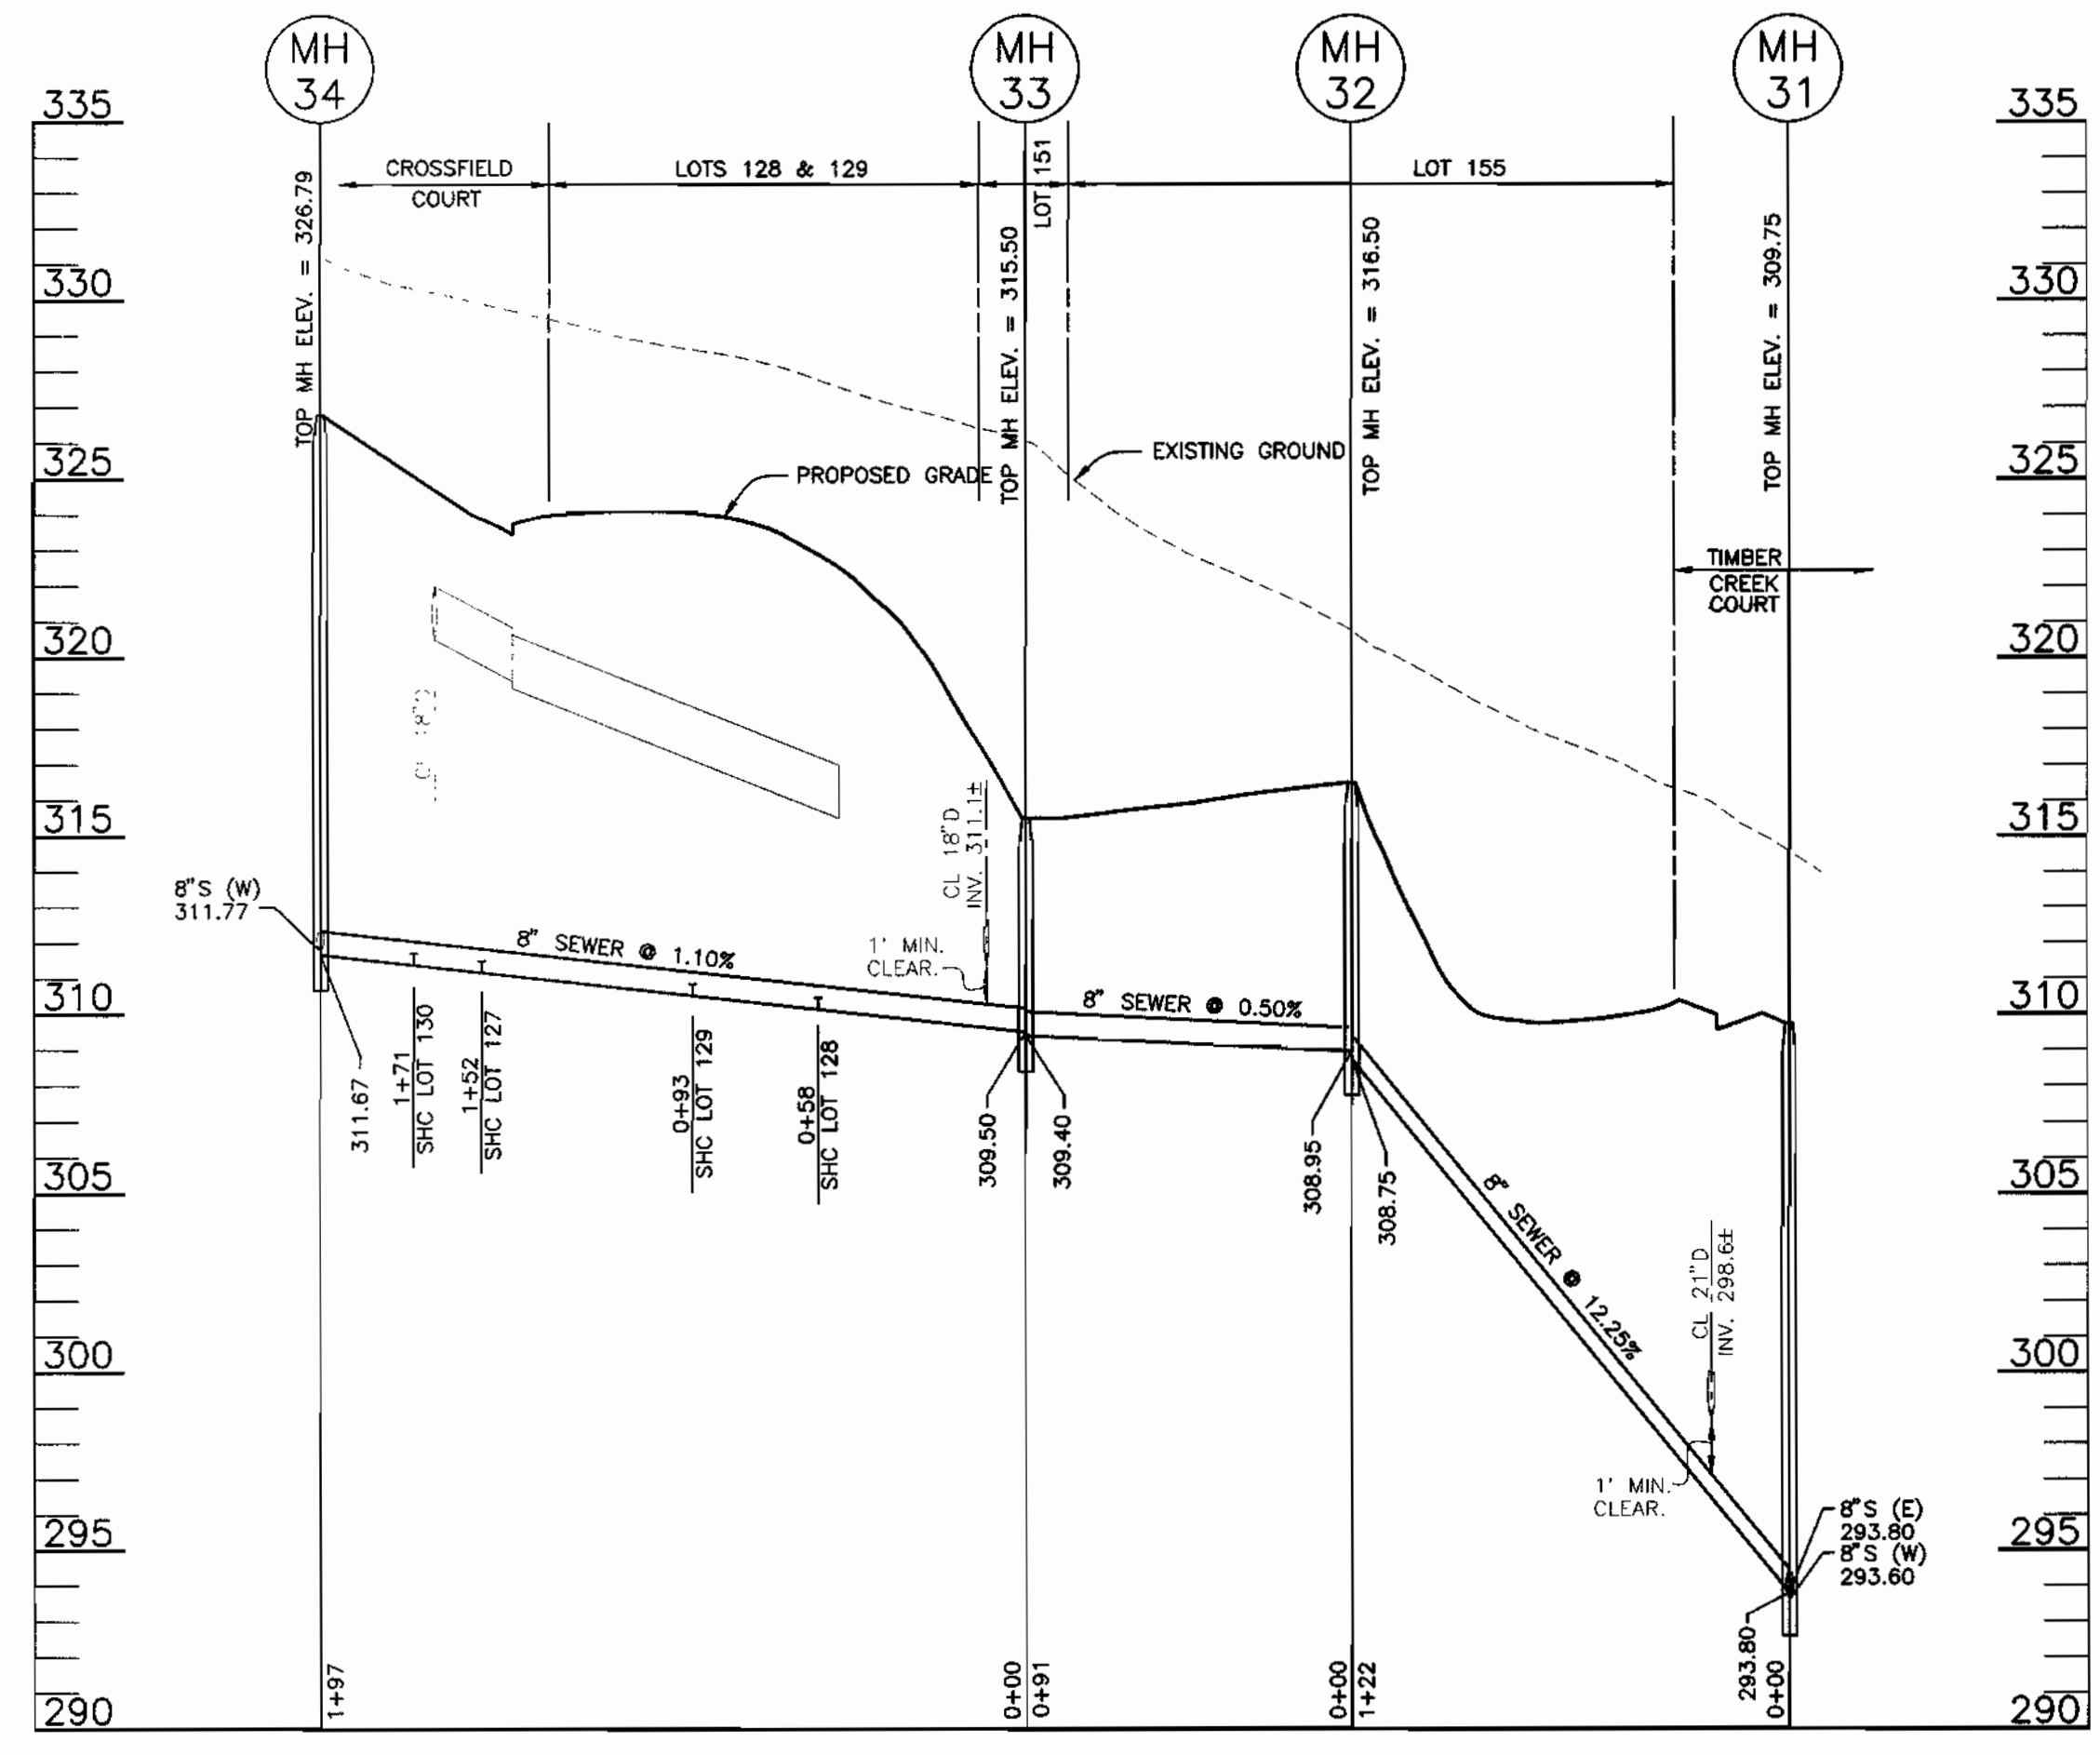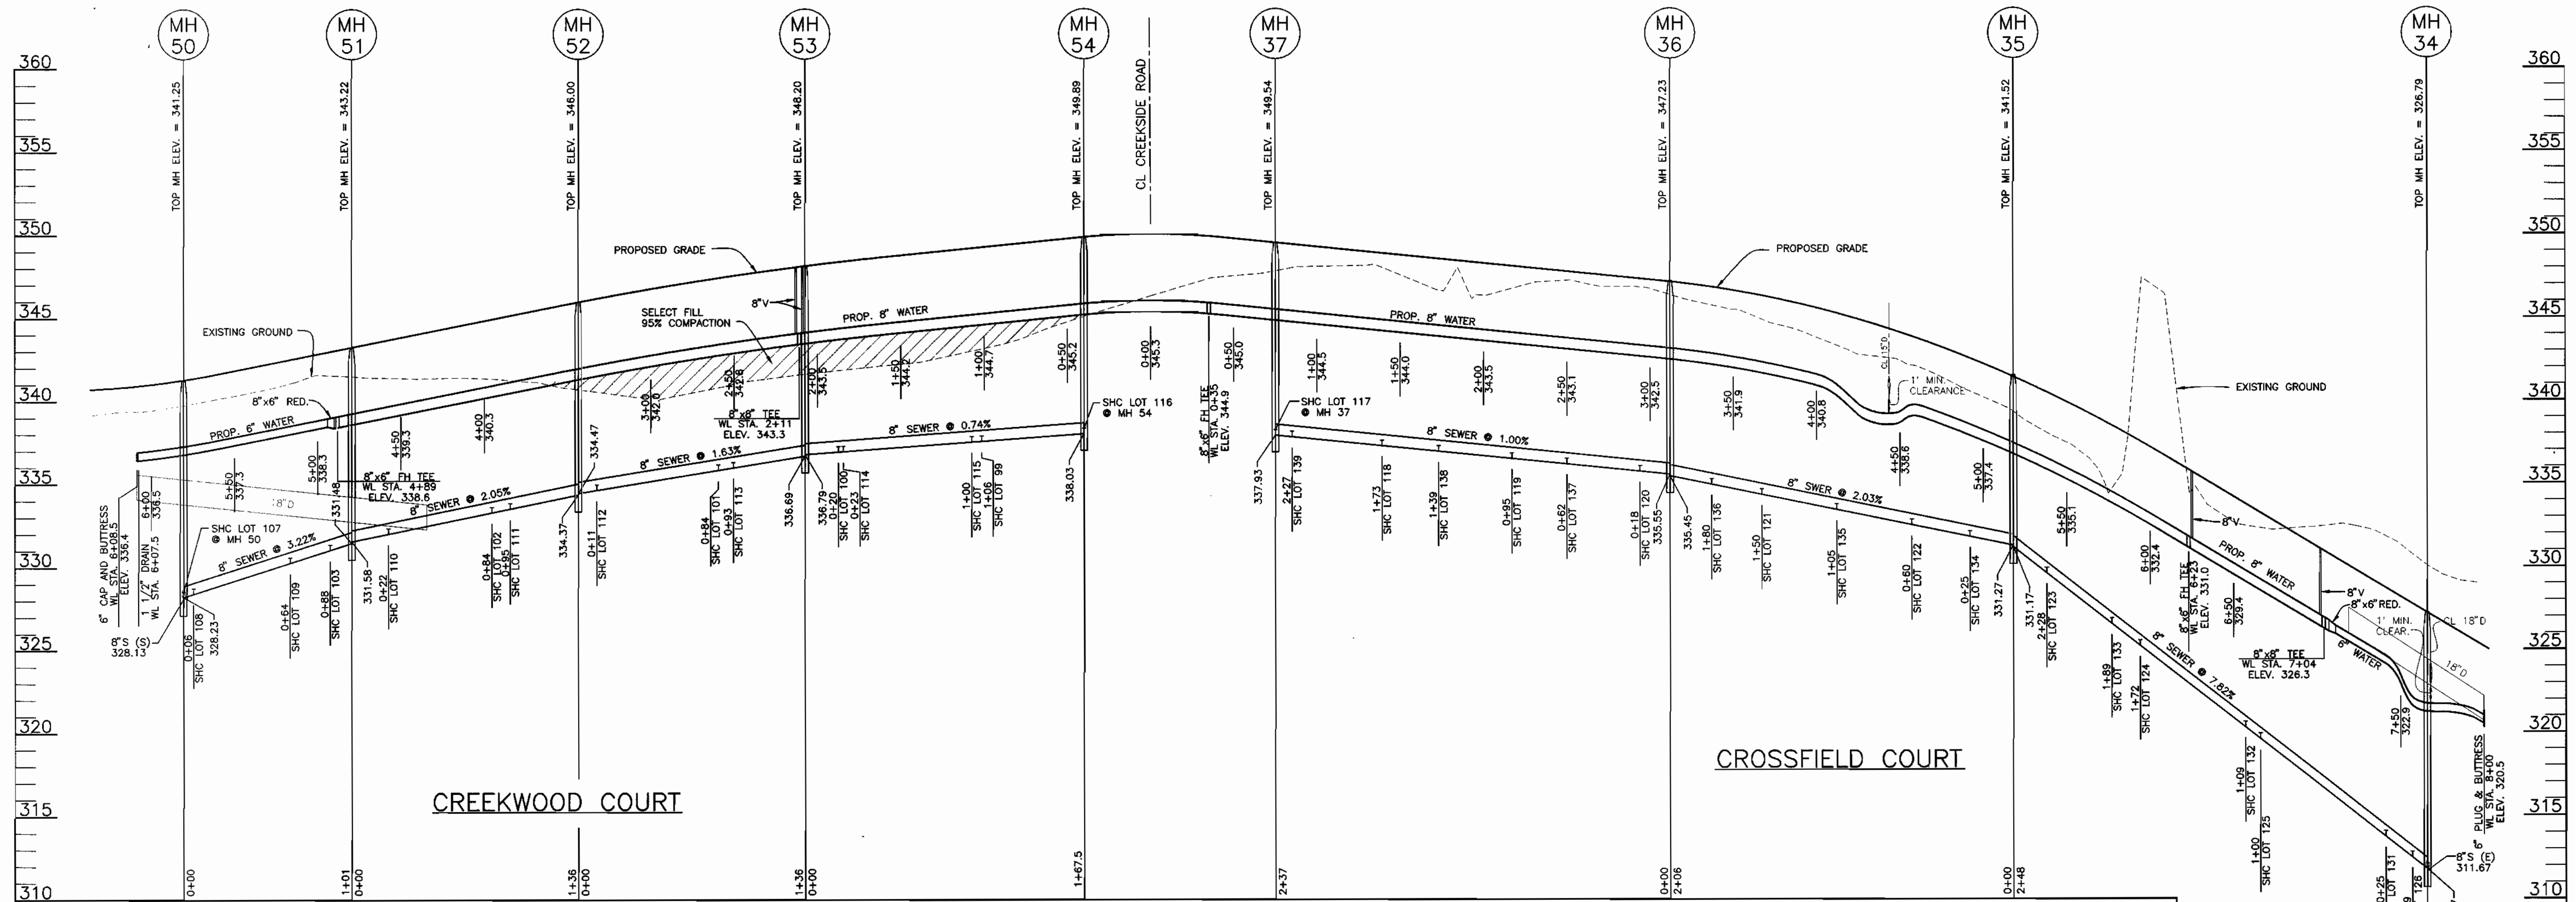

NOTE: ALL SEWER MANHOLES SHALL BE PRECAST FOR THIS CONTRACT.

Plotted: April 6, 1998

DEPARTMENT OF PUBLIC WORKS
HOWARD COUNTY, MARYLAND
Robert Reinger
CHIEF, BUREAU OF UTILITIES

DEPARTMENT OF PLANNING AND ZONING
HOWARD COUNTY, MARYLAND
Michael D. ...
CHIEF, DEVELOPMENT ENGINEERING DIVISION

TSA GROUP, INC.
planning • engineering • surveying
8480 Baltimore National Pike Suite 418
Ellicott City, Maryland 21043



DES:	MLV				
DRN:	DBT				
CHK:	DAM				
DATE:	11/97				
	4/98	BY	NO.	REVISIONS	DATE

PROFILES OF
WATER AND SEWER MAINS
600 SCALE MAP NO. 41
BLOCK 4 AND 5

VILLAGE OF CEDAR RIDGE
PHASE 2
ELECTION DISTRICT NO. 5
CONTRACT NO. 34-3662-D
SCALE:
1"=50' HORIZ.
1"=5' VERT.
SHEET NO.
6 OF 6