QUANTITIES								
		AS-BUILT						
ITEMS	QUANTITIES ESTIMATED	QUANTITIES	TYPE	MANUFACTURER /SUPPLIER				
8" PVC S.	1352 LF							
8" DIP S.	190 LF							
TYPE "B" DROP MH OR MH WITH INTERMEDIATE LANDINGS	2 EA.							
STD MANHOLES	6 EA.							
MANHOLES	108 VF.							
TYPE "A" DROP MH	2 EA.							

SHEET INDEX					
SHEET No. DESCRIPTION					
1	COVER SHEET				
2	SEWER, EROSION AND SEDIMENT CONTROL PLAN				
3	SEWER PROFILES AND DETAILS				
4	EROSION AND SEDIMENT CONTROL DETAILS				


Montpelier

Research Park Parcels E-2 thru E-3, Johns Hopkins Road

SEWER CONSTRUCTION

CONTRACT NO. 30–3789–D

Howard County, Maryland Department of Public Works

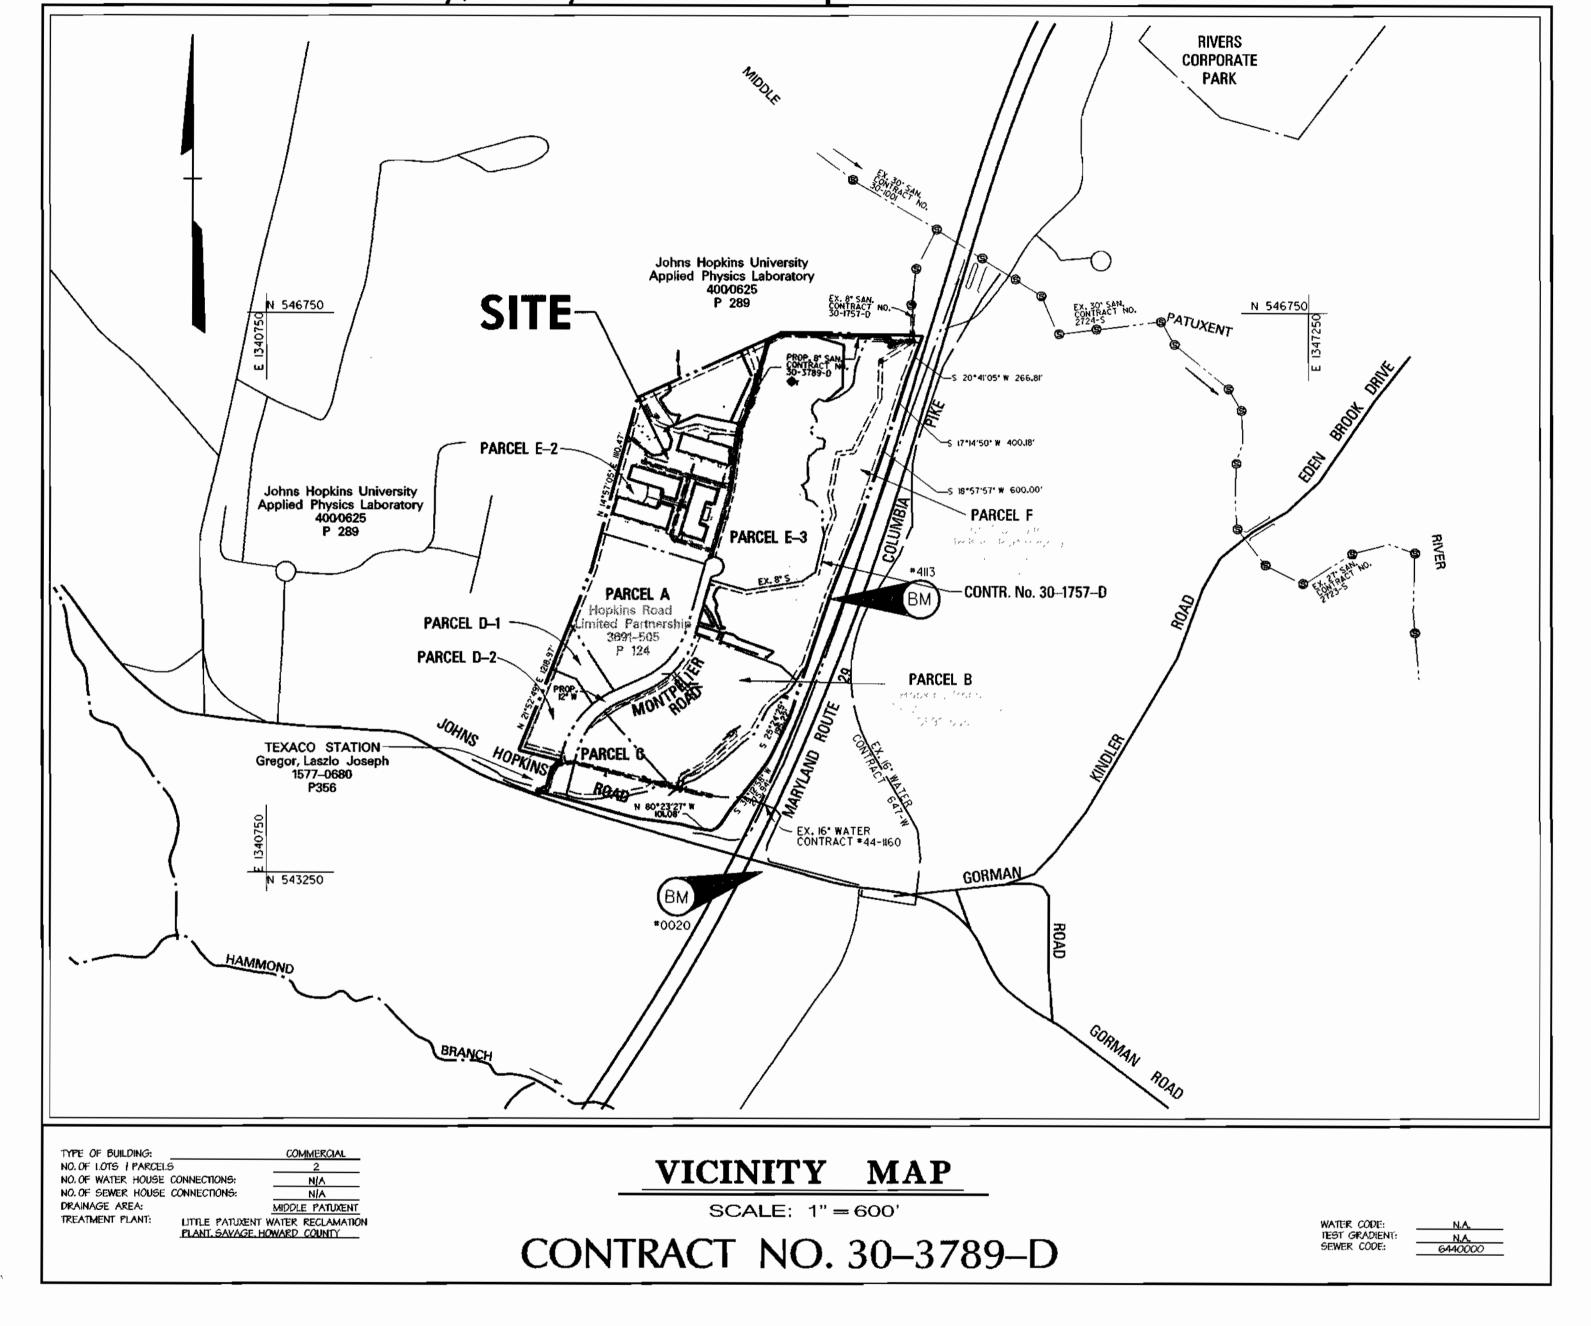

GENERAL NOTES

- 1. APPROXIMATE LOCATION OF EXISTING MAINS ARE SHOWN. THE CONTRACTOR SHALL TAKE ALL NECESSARY PRECAUTIONS TO PROTECT EXISTING MAINS AND SERVICES AND MAINTAIN UNINTERRUPTED SUPPLY, ANY DAMAGE INCURRED SHALL BE REPAIRED IMMEDIATELY TO THE SATISFACTION OF THE ENGINEER AT THE CONTRACTOR'S EXPENSE.
- 2. ALL HORIZONTAL CONTROLS ARE BASED ON MARYLAND STATE COORDINATES. 3. ALL VERTICAL CONTROLS ARE BASED ON U.S.G.S. DATA.
- 4. ALL PIPE ELEVATIONS SHOWN ARE INVERT ELEVATIONS, UNLESS OTHERWISE NOTED.
- 5. CLEAR ALL UTILITIES BY A MINIMUM OF 12". CLEAR ALL POLES BY 2'-0" MINIMUM OR TUNNEL AS REQUIRED. THE OWNER HAS CONTACTED THE UTILITY COMPANIES AND HAS MADE ARRANGEMENTS FOR BRACING OF POLES AS SHOWN ON THE DRAWINGS. IN THE EVENT THE CONTRACTOR'S WORK REQUIRES THE BRACING OF ADDITIONAL POLES, ANY COST INCURRED BY THE OWNER FOR BRACING OF ADDITIONAL POLES OR DAMAGES SHALL BE DEDUCTED FROM MONEY OWED THE CONTRACTOR, THE CONTRACTOR SHALL COORDINATE
- MITH THE UTILITY COMPANIES TO SCHEDULE THE BRACING OF THE POLES. 6. FOR DETAILS NOT SHOWN ON THE DRAWINGS AND FOR MATERIALS AND CONSTRUCTION METHODS USE HOWARD COUNTY DESIGN MANUAL, VOLUME IV, STANDARD SPECIFICATIONS AND DETAIL FOR CONSTRUCTION (LATEST EDITION). THE CONTRACTOR SHALL HAVE A
- COPY OF VOLUME IV ON THE JOB. 7. WHERE TEST PITS HAVE BEEN MADE ON EXISTING UTILITIES, THEY ARE NOTED BY THE SYMBOL AT THE LOCATION OF THE TEST PIT. A NOTE OR NOTES CONTAINING THE RESULTS OF THE TEST PIT OR PITS IS INCLUDED ON THE DRAWINGS, EXISTING UTILITIES IN THE VICINITY OF THE PROPOSED WORK FOR WHICH TEST PITS HAVE NOT BEEN DUG SHALL BE LOCATED BY THE CONTRACTOR TWO WEEKS IN ADVANCE OF CONSTRUCTION OPERATIONS AT HIS OWN EXPENSE.
- 8. CONTRACTOR SHALL NOTIFY THE FOLLOWING UTILITY COMPANIES OR AGENCIES AT LEAST FIVE WORKING DAYS BEFORE STARTING WORK SHOWN ON THESE PLANS:

STATE HIGHWAY ADMINISTRATION BG&E CO. CONTRACTOR SERVICES BG&E CO. UNDER GROUND DAMAGE CONTROL COLONIAL PIPELINE CO. HOWARD COUNTY DEPARTMENT OF PUBLIC WORKS BUREAU OF UTILITIES

410-531-5533 410-850-4620 410-787-9068 1-800-257-7777 410-795-1390

410-313-4900 1-800-446-5266 BELL ATLANTIC

- 9. TREES AND SHRUBS ARE TO BE PROTECTED FROM DAMAGE TO MAXIMUM EXTENT. TREES AND SHRUBS LOCATED WITHIN THE CONSTRUCTION STRIP ARE NOT TO BE REMOVED OR DAMAGED BY THE
- 10. CONTRACTOR SHALL REMOVE TREES, STUMPS, AND ROOTS ALONG LINE OF EXCAVATION, PAYMENT FOR SUCH REMOVAL SHALL BE INCLUDED IN THE UNIT PRICE BID FOR CONSTRUCTION OF THE MAIN.
- 11. THE CONTRACTOR SHALL NOTIFY THE BUREAU OF HIGHWAYS, HOWARD COUNTY, AT (410) 313-2450 AT LEAST FIVE WORKING DAYS BEFORE ANY OPEN OUT OF ANY COUNTY ROAD OR BORING/JACKING OPERATION IN COUNTY ROADS FOR LAYING WATER/SEWER MAINS OR HOUSE CONNECTIONS, THE APPROVAL OF THESE DRAWINGS WILL CONSTITUTE COMPLIANCE WITH DPW REQUIREMENTS PER SECTION 18.114(A) OF THE HOWARD COUNTY CODE.

PART II - SEWER

- ALL SEWER MAINS SHALL BE P.V.C. OR D.I.P. CLASS 52 UNLESS OTHERWISE NOTED. THE CONTRACTOR SHALL PROVIDE A JOINT IN ALL SEWER MAINS WITHIN 2'-0' OF
- EXTERIOR MANHOLE WALL.
 ALL MANHOLES SHALL BE 4'-0" INSIDE DIAMETER UNLESS OTHERWISE NOTED
- ALL MANHOLES SHALL BE 4"-0" INSIDE DIAMETER UNLESS OTHERWISE NOTED,
 FORCE MAINS SHALL BE D.I.P. ONLY.
 MANHOLES SHOWN WITH 12" AND 16" WALLS ARE FOR BRICK MANHOLES ONLY.
 MANHOLES DESIGNATED W.T. IN PLAN AND PROFILE SHALL HAVE WATERTIGHT FRAME AND
 COVERS, STANDARD DETAIL 65.52. WHERE WATERTIGHT MANHOLE FRAME AND COVER IS
 USED, SET TOP OF FRAME 1"-6" ABOVE FINISHED GRADE UNLESS OTHERWISE NOTED ON
- 7. HOUSE(S) WITH THE SYMBOL "C.N.S." INDICATES THAT CELLAR CANNOT BE SERVED

BENCHMARK


DESCRIPTION

N 544492.88 E 1344177.82 ELEVATION = 391.65

CONCRETE MONUMENT 4'± WEST OF TOP OF BANK OFF SOUTH BOUND LANE OF MARYLAND ROUTE 29 AT SURFACE.

N 543170.96 E 1343822.16 ELEVATION = 403.62

STANDARD MBCS SURVEY DISC SET ON CONCRETE MONUMENT, FLUSH WITH THE GROUND.

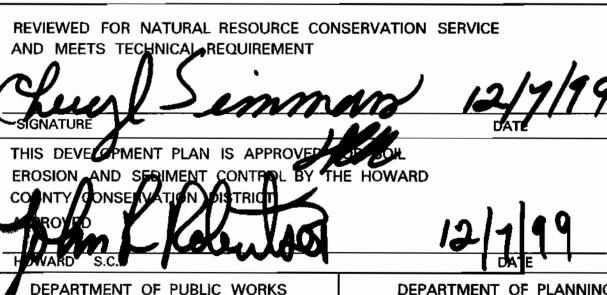

SEDIMENT CONTROL MEASURES WILL BE IMPLEMENTED IN ACCORDANCE WITH SECTION 219 OF THE SPECIFICATIONS AND SITE DEVELOPMENT PLAN F-00-49

HOWARD COUNTY, MARYLAND

DEPARTMENT OF PLANNING & ZONING HOWARD COUNTY, MARYLAND

Daft·McCune·Walker, Inc. A Team of Land Planners. 200 East Pennsylvania Avenue Towson, Maryland 21286 410 296 3333 Landscape Architects. Engineers, Surveyors & Environmental Professionals Fax 296 4705



DESIGN BY:			
BIS			
DRAWN BY:			_
ADL			
CHECKED BY:			
DATE:			
10-20-99	BY	NO.	REVISION

COVER SHEET _BLOCK NO. <u>17</u>

Research Park HOWARD COUNTY MARYLAND OWNER: HOPKINS ROAD LIMITED PARTNERSHIP 9030 RED BRANCH ROAD, SUITE 200 COLUMBIA, MD 210 DEVELOPER: TRAMMELL CROW COMPANY


6701 DEMOCRACY BLVD. SUITE 410, BETHESDA, MD 20813


CONTRACT NO. 30-3789-D


SHOWN

SHEET

1 OF 4

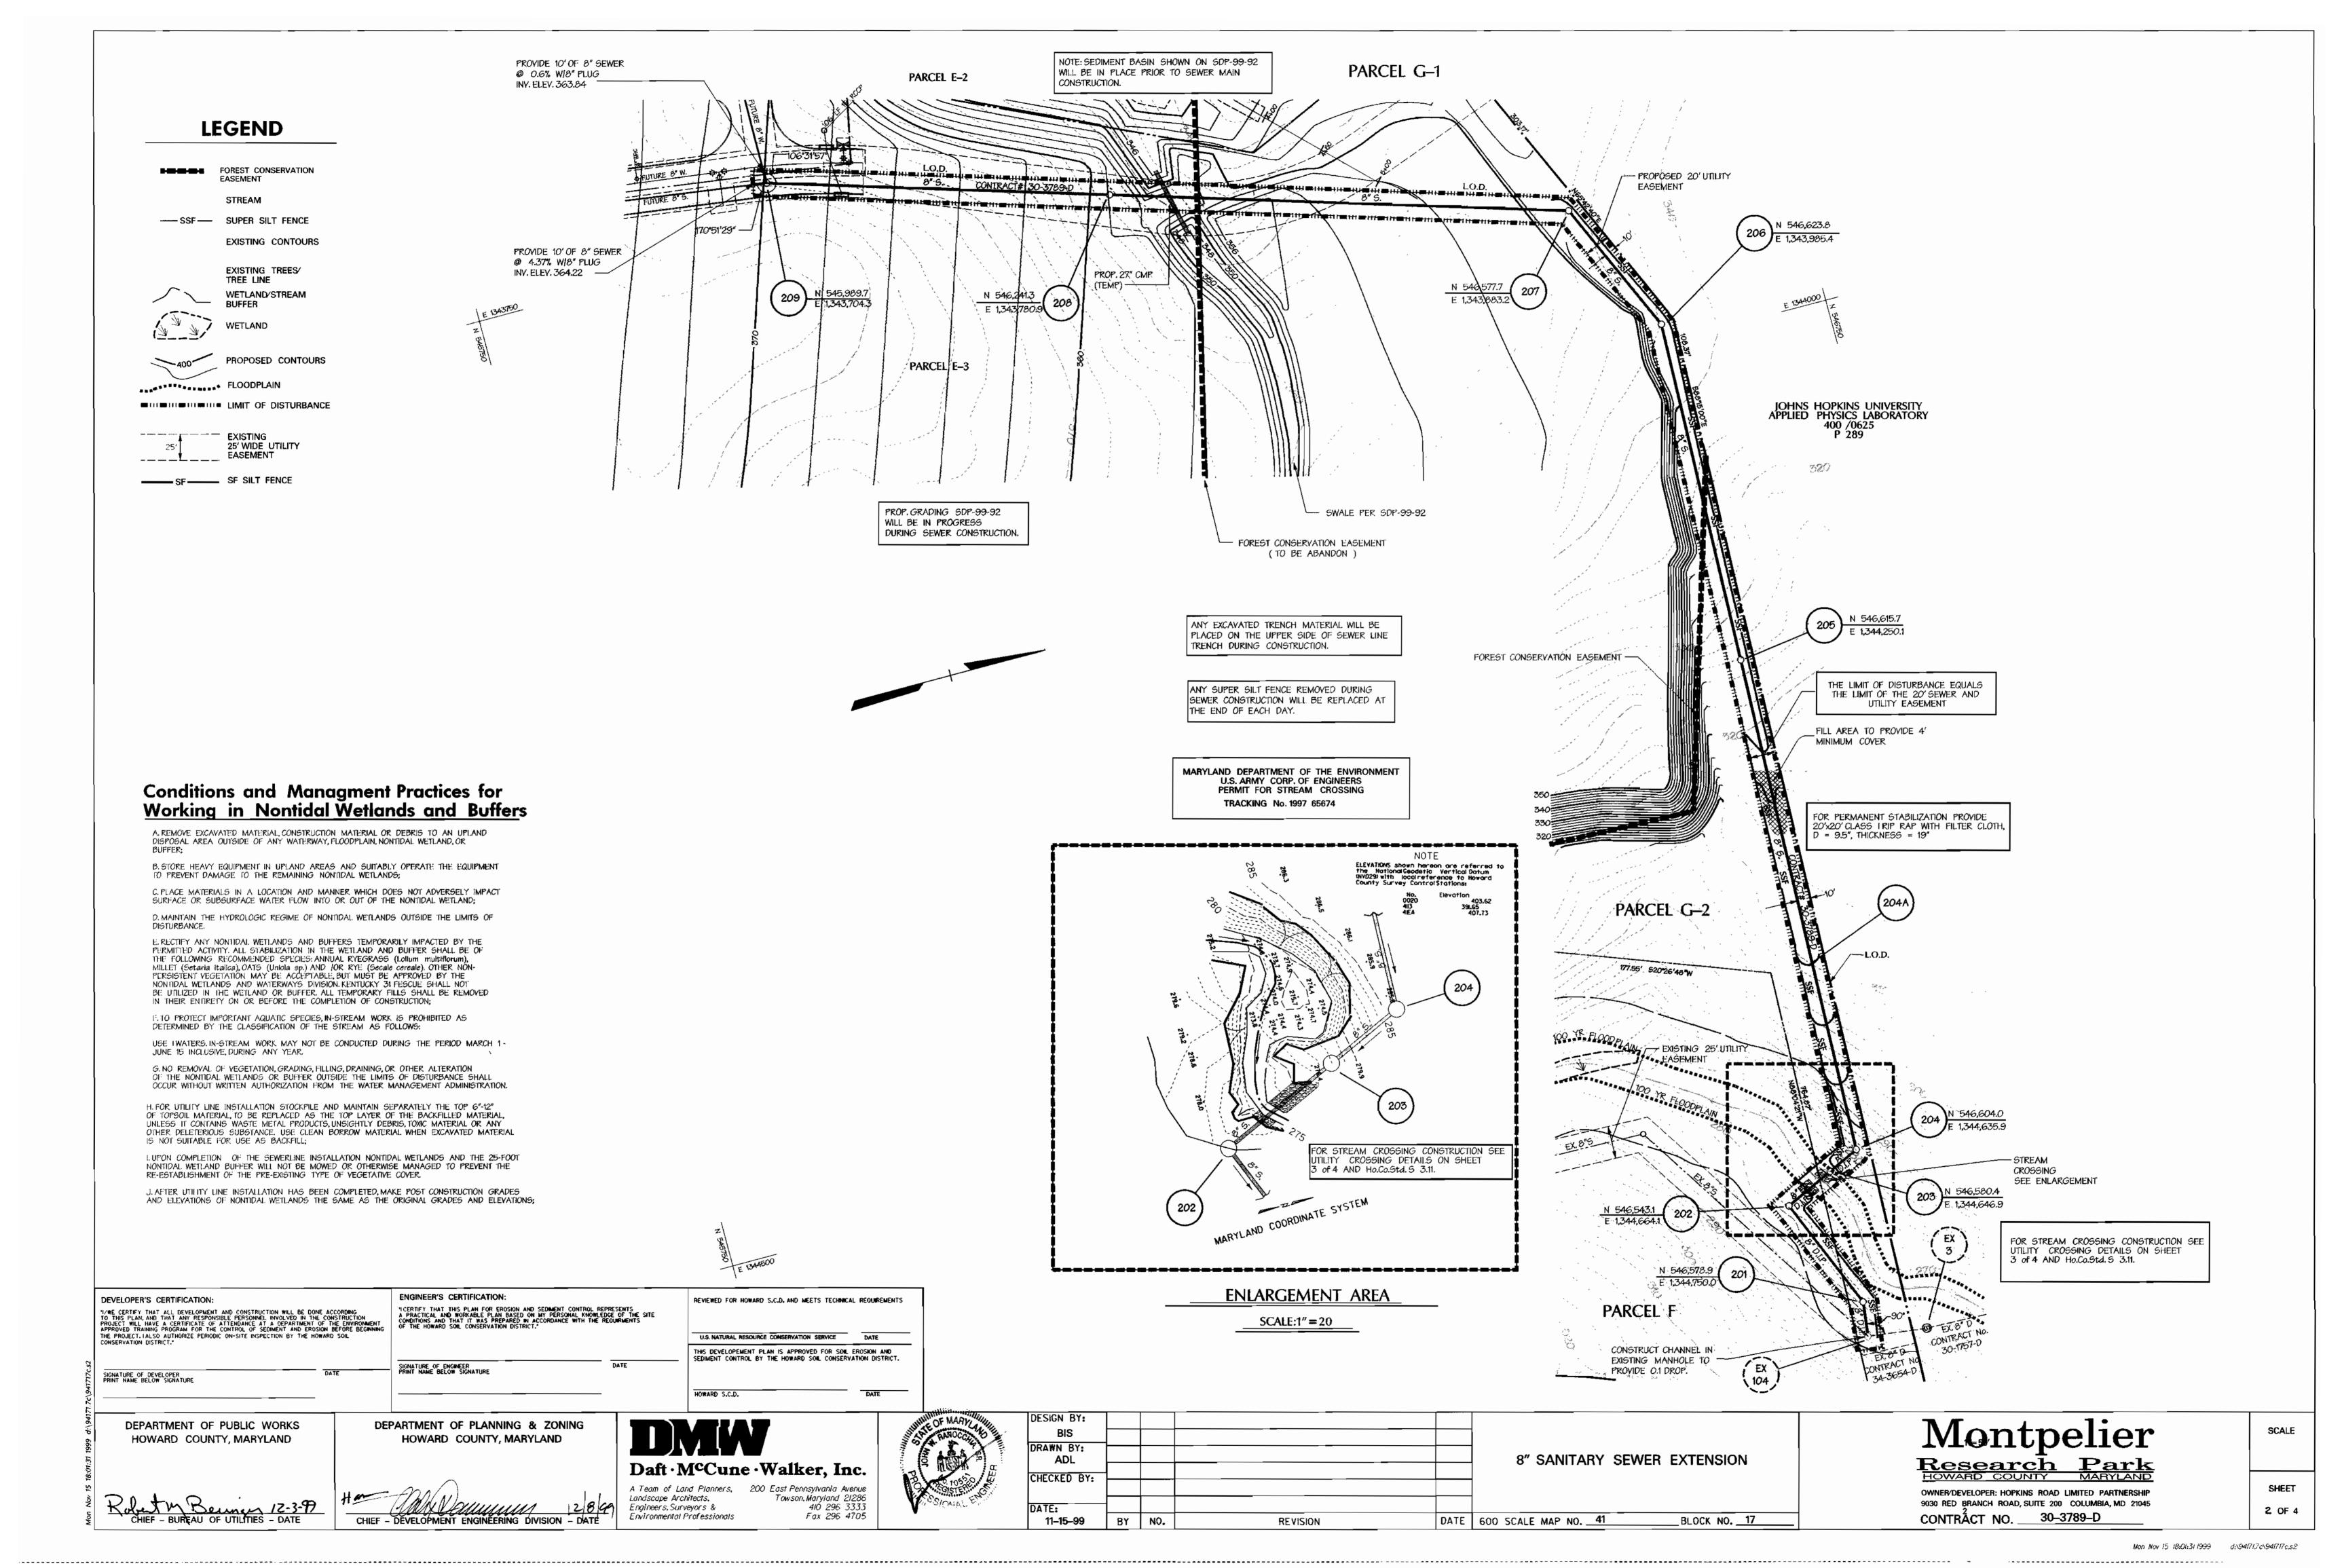

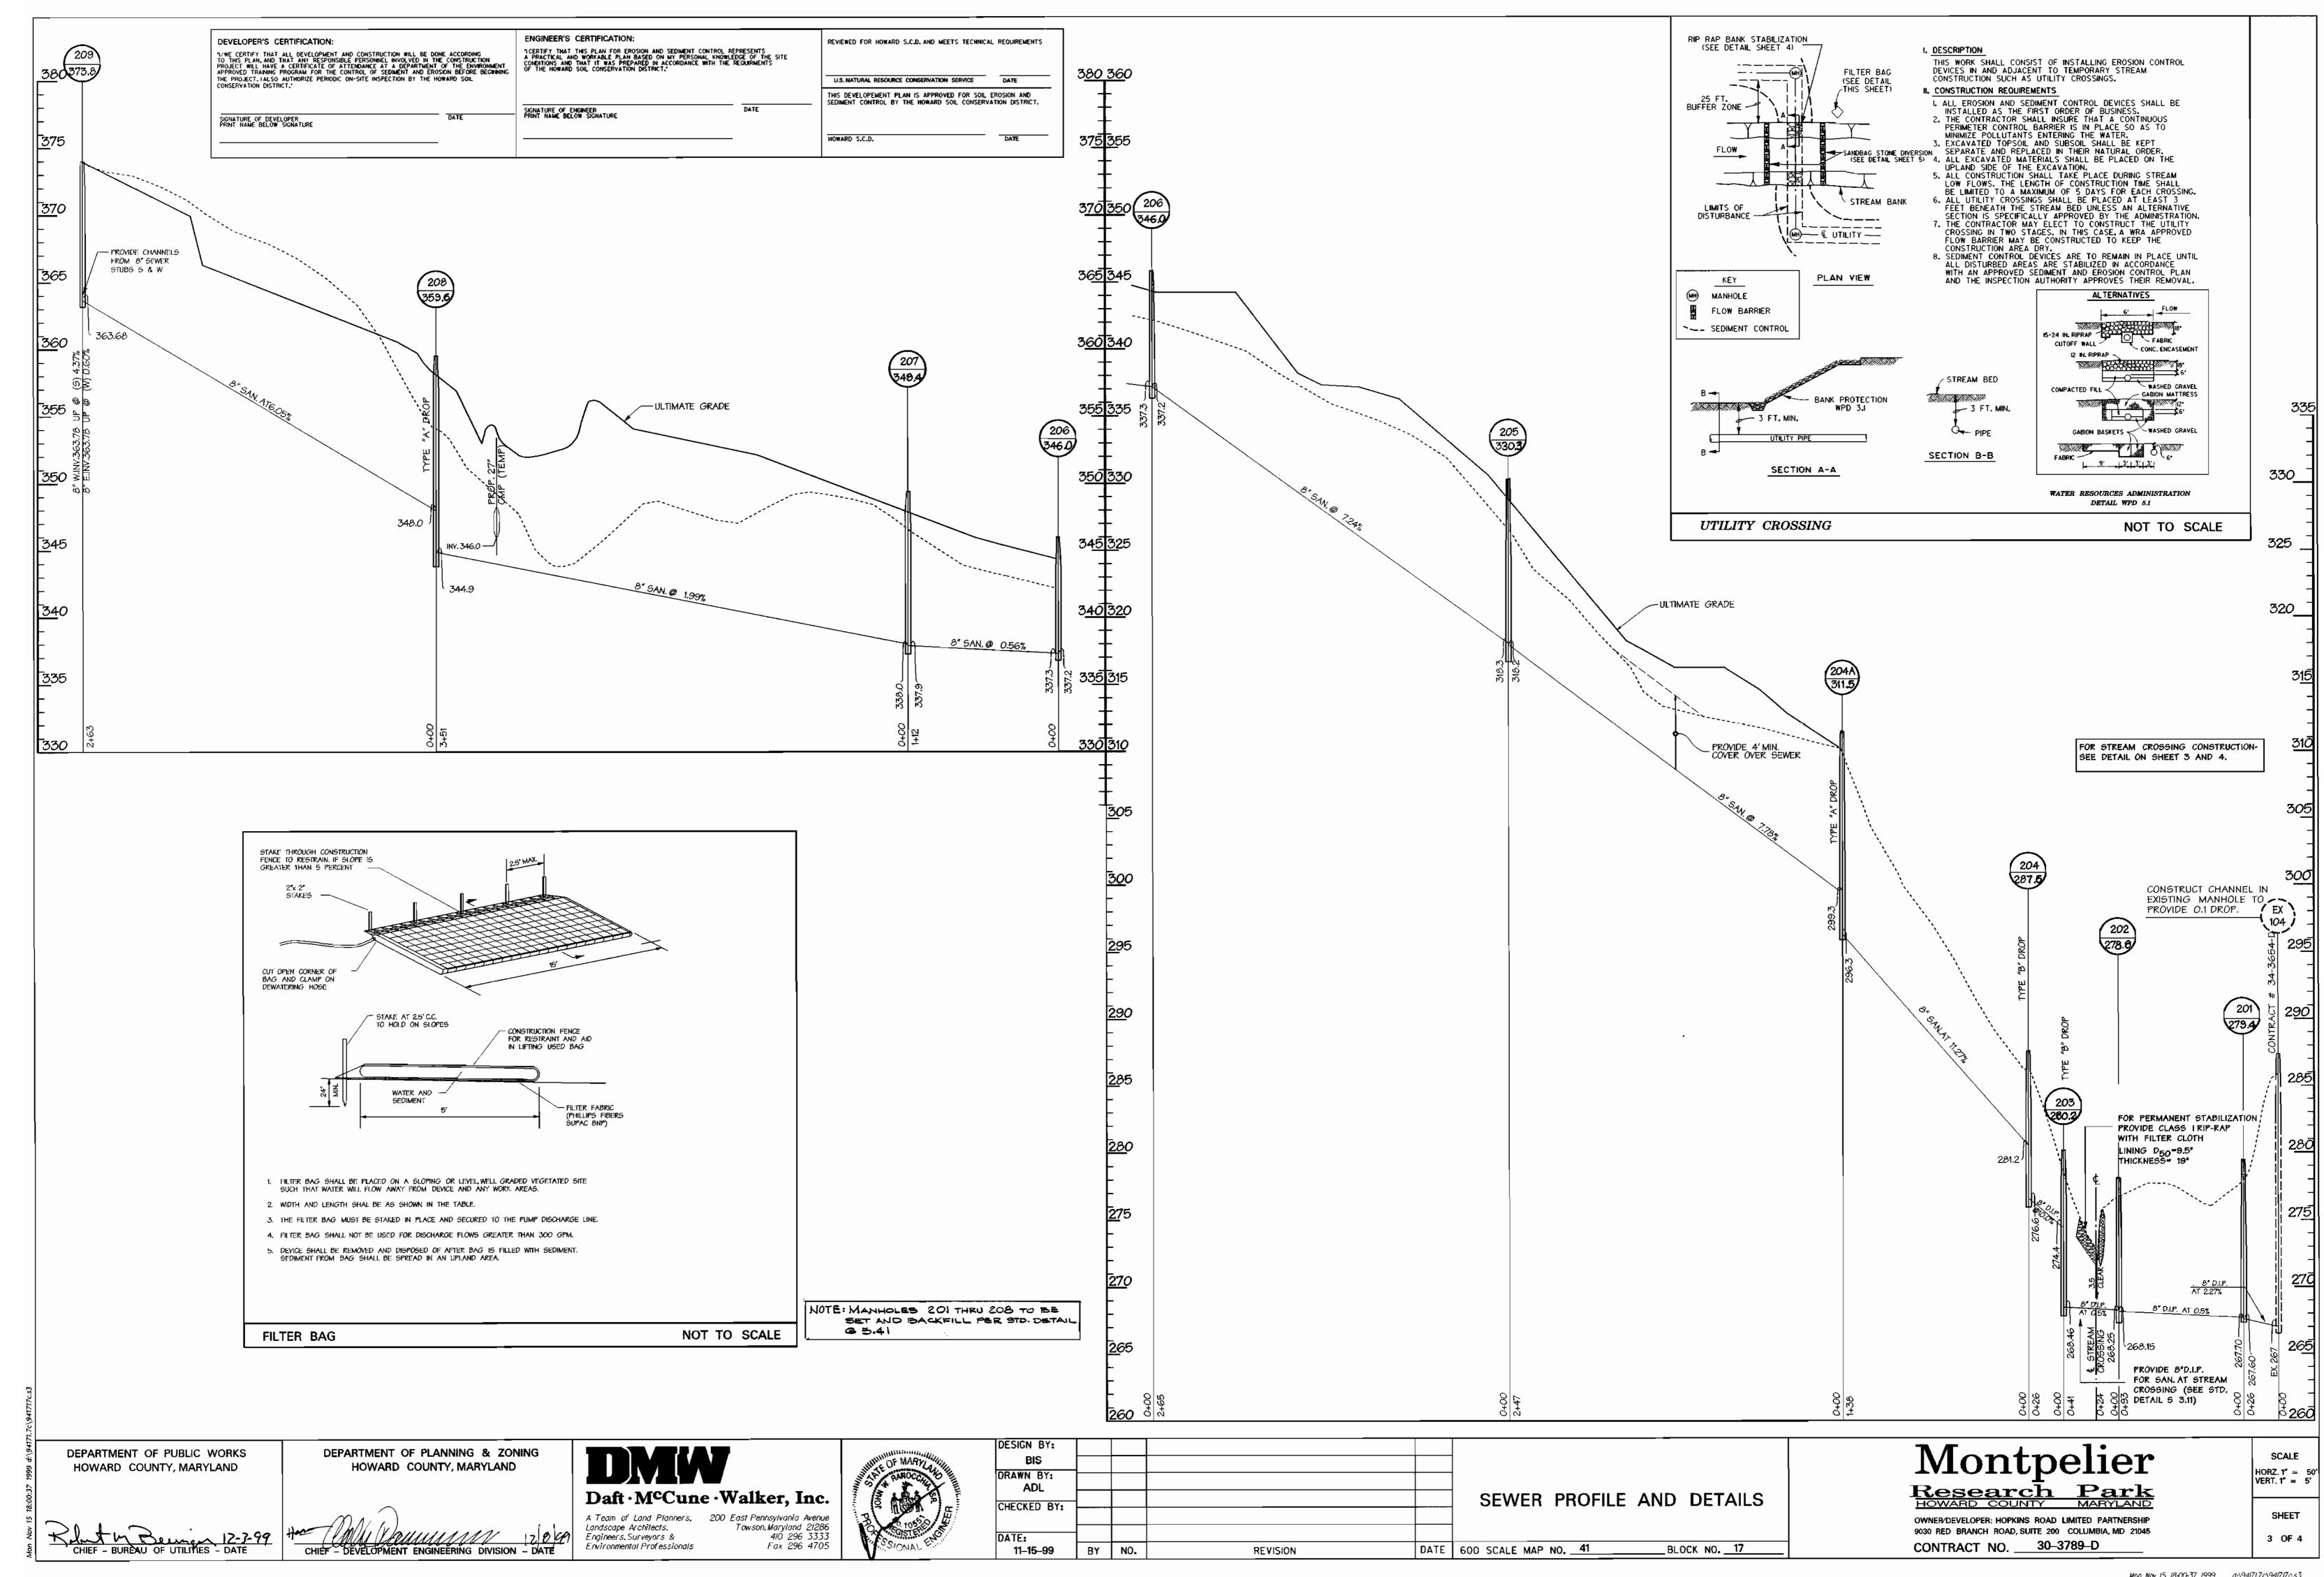

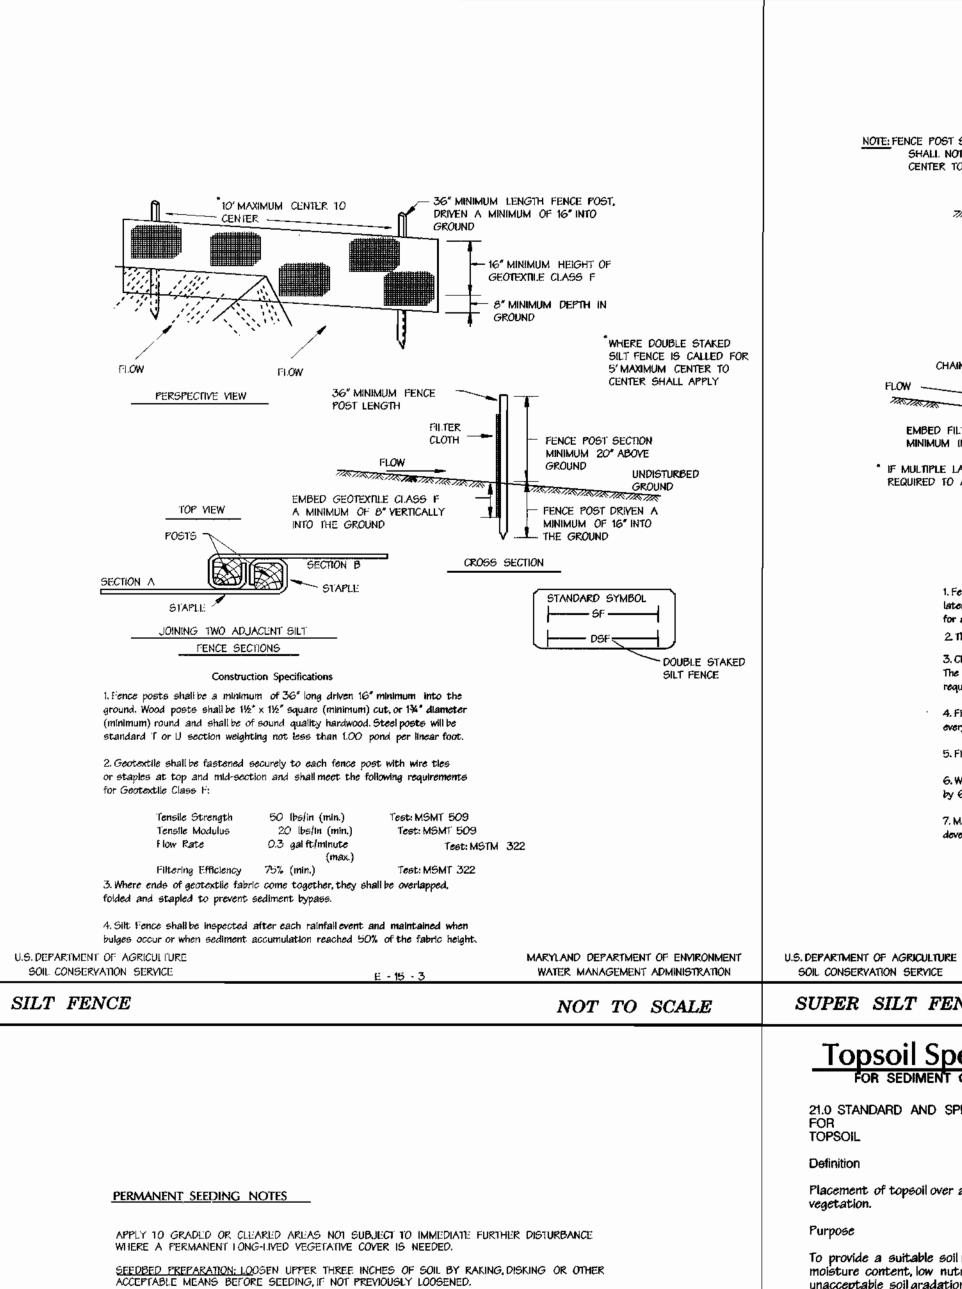

<u>SOIL AMENDMENTS: IN LIEU OF SOIL TEST RECOMMENDATIONS, USE ONE OF THE FOLLOWING SCHEDULES:</u>

DISK INTO UPPER THREE INCHES OF SOIL AT TIME OF SEEDING, APPLY 400 LBS. PER ACRE

30-0-0 UREAFORM FERTILIZER (9 LBS./1000 SQ.FT.)

PER ACRE (8 GAL/1000 SQ.FT.) FOR ANCHORING.

TEMPORARY SEEDING NOTES

(8 GAL/1000 SQ.FT.) FOR ANCHORING.

YEGETATIVE COVER IS NEEDED.

DISK INTO UPPER THREE INCHES OF SOIL.

ANCHORED STRAW.

1. <u>Freyerred</u> - Apply 2 tons per acres dolomitic limestone (92 lbs/1000 sq.ft.) and 1000 lbs. per acre 10-10-10 fertilizer (14 lbs./1000 sq.ft.) before seeding. Harrow or

2. ACCEPTABLE - APPLY 2 TOMS PER ACRES DOLOMITIC LIMESTONE (92 LBS/1000 SQ.FT.) AND 1000 LBS. PER ACRE 10-10-10 FERTILIZER (23 LBS./1000 SQ.FT.) BEFORE SEEDING. HARROW OR

SEEDING FOR THE PERIODS MARCH 1 THRU APRIL 30, AND AUGUST 1 THRU OCTOBER 15, SEED WITH 60 LBS, PER ACRE (1.4 LBS/1000 SQ.FT.) OF KENTUCKY 31 TALL FESCUE. FOR THE PERIOD

MAY 1 THRU JULY 31 SEED WITH GO LIBS KENTUCKY 31 TALL FESCUE PER ACRE AND 2 LIBS PER

MULCH AND SEED AS SOON AS POSSIBLE IN THE SPRING, OPTION (2) - USE SOD, OPTION (3) -

FEBRUARY 28, PROTECT SITE BY: OPTION (1) - 2 TONS PER ACRE OF WELL ANCHORED STRAW

SEED WITH GO LBS/ACRE KENTUCKY 31 TALL FESCUE AND MULCH WITH 2 TONS/ACRE WELL.

MULCHING - APPLY 1-1/2 TO 2 TONS PER ACRE (70 TO 90 LBS/1000 SQ.FT.) OF UNROTTED SMALL GRAIN STRAW IMMEDIATELY AFTER SEEDING. ANCHOR MULCH IMMEDIATELY AFTER

MAINTENANCE - INSPECT ALL SEEDING AREAS AND MAKE NEEDED REPAIRS, REPLACEMENTS AND RESEEDING.

APPLY TO GRADED OR CLEARED AREAS LIKELY TO BE REDISTURBED WHERE A SHORT-TERM

SOIL AMENDMENTS - APPLY 600 LBS. PER ACRE 10-10-10 FERTILIZER (14 LBS/1000 SQ.FT.)

2-1/2 BUSHEL PER ACRE OF ANNUAL RYE (3.2 LBS/1000 SQ.FT.). FOR THE PERIOD MAY 1 THRU

PERIOD NOVEMBER 16 THRU FEBRUARY 28 PROTECT SITE BY APPLYING 2 10NS PER ACRE OF

ACCEPTABLE MEANS BEFORE SEEDING, IF NOT PREVIOUSLY LOOSENED.

SEDIMENT CONTROL FOR ADDITIONAL RATES AND METHODS NOT COVERED.

SEEDBED PREPARATION - LOOSEN UPPER THREE INCHES OF SOIL BE RAKING, DISKING OR OTHER

5 - FOR THE PERIODS MARCH 1 THRU APRIL 30, AND AUGUST 15 OCTOBER 15, SEED WITH

AUGUST 14, SEED WITH 3 LIBS PER ACRE OF WEEPING LOVEGRASS (.07 LIBS/1000 SQ.FT.). FOR THE

WELL ANCHORED STRAW MULCII AND SEED AS SOON AS POSSIBLE IN THE SPRING, OR USE SOO.

MULCHING - APPLY 1-1/2 TO 2 TONS PER ACRE (70 TO 90 LBS/1000 SQ.FT.) OF UNROTTED WEED FREE SMALL GRAIN STRAW IMMEDIATELY AFTER SEEDING, ANCHOR MULCH IMMEDIATELY AFTER

APPLICATION USING MULCH ANCHORING TOOL OR 218 GAL PER ACRE (5 GAL/1000 SQ.FT.) OF


EMULSHIED ASPHLAT ON FLAT AREAS. ON SLOPES & FT. OR HIGHER, USE 348 GAL PER ACRE

REFER 10 THE 1994 MARYLAND STANDARDS AND SPECIFICATIONS FOR SOIL EROSION AND

APPLICATIONS USING MULCH ANCHORING TOOL OR 218 GALLONS PER ACRE (5 GALMOOD SQ.FT.)

OF EMULSIFIED ASPHALT ON FLAT AREAS, ON SLOPES 8 FEET OR HIGHER, USE 346 GALLONS

ACRE (.05 LBS/1000 SQ.FT.) OF WEEPING LOYEGRASS, DURING THE PERIOD OF OCTOBER 16 THRU

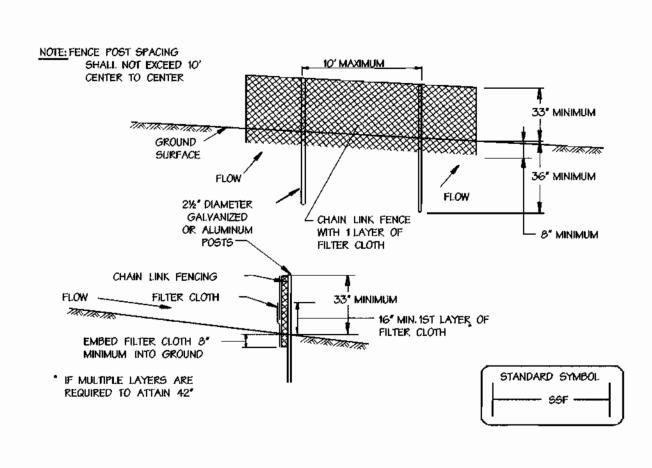

1. Fencing shall be 42 Inches in height and constructed in accordance with the latest Maryland State Highway (SHA) Details for Chain Link Fencing. The specification for a 6' fence shall be used, substituting 42" fabric and 6' length posts. 2. The posts do not need to be set in concrete.

3. Chain link fence shall be fastened securely to the fence posts with wire ties or staples. The lower tension wire, brace and truss rods, drive anchors and post caps are not required except on the ends of the fence. The chain link fencing shall be six (6) guage or heavier.

4. Filter cloth shall be fastened securely to the chain link fence with ties spaced every 24" at the top and mid section.

5. Filter cloth shall be embedded a minimum of 8" into the ground.

6. When two sections of filter cloth adjoin each other, they shall be overlapped by 6" and folded.

7. Maintenance shall be performed as needed and silt buildups removed when "builges" develop in the silt fence, or when silt reaches 50% of fence height

H - 26 - 3

MARYLAND DEPARTMENT OF ENVIRONMENT WATER MANAGEMENT ADMINISTRATION

NOT TO SCALE

1. A MINIMUM OF 48 HOURS NOTICE MUST BE GIVEN TO THE HOWARD COUNTY DEPARTMENT OF INSPECTIONS, LICENSES AND PERMITS, SEDIMENT CONTROL DIVISION PRIOR TO THE START OF ANY CONSTRUCTION (313-1855).

2. ALL VEGETATIVE AND STRUCTURAL PRACTICES ARE 10 BE INSTALLED ACCORDING TO THE PROVISIONS OF THIS PLAN AND ARE TO BE IN CONFORMANCE WITH THE "1994 MARYLAND STANDARDS AND SPECIFICATIONS FOR SOIL EROSION AND SEDIMENT CONTROL." AND REVISIONS

3. FOLLOWING INITIAL SOIL DISTURBANCE OR RE-DISTURBANCE, PERMANENT OR TEMPORARY STABILIZATION SHALL BE COMPLETED WITHIN:

A SEVEN CALENDAR DAYS FOR ALL PERIMETER SEDIMENT CONTROL STRUCTURES, DIKES, PERIMETER SLOPES AND ALL SLOPES STEEPER THAN 3:1. B. FOURTEEN DAYS AS TO ALL OTHER DISTURBED OF GRADED AREAS ON THE PROJECT SITE. 4. ALL SEDIMENT TRAPS/BASING SHOWN MUST BE FENCED AND WARNING SIGNS POSTED AROUND THEIR PERIMETER IN ACCORDANCE WITH VOL.1, CHAPTER 12, OF THE "HOWARD COUNTY DESIGN

MANUAL". STORM DRAINAGE. 5. ALL DISTURBED AREAS MUST BE STABILIZED WITHIN THE TIME PERIOD SPECIFIED ABOVE IN ACCORDANCE WITH THE "1994 MARYLAND STANDARDS AND SPECIFICATIONS FOR SOIL EROSION AND SEDIMENT CONTROL" FOR PERMANENT SEEDINGS, SODS, TEMPORARY SEEDING AND MULCHING (SECTION G). TEMPORARY STABILIZATION WITH MULCH ALONE CAN ONLY

ESTABLISHMENT OF GRASSES 6. ALL SEDIMENT CONTROL STRUCTURES ARE TO REMAIN IN PLACE AND ARE TO BE MAINTAINED IN OPERATIVE CONDITION UNTIL PERMISSION FOR THEIR REMOVAL HAS BEEN OBTAINED FROM

BE DONE WHEN RECOMMENDED SEEDING DATES DO NOT ALLOW FOR PROPER GERMINATION AND

THE HOWARD COUNTY SEDIMENT CONTROL INSPECTOR. 7. SITE ANALYSIS: TOTAL AREA OR SITE 104 ACRES 0.72 ACRES AREA DISTURBED


AREA TO BE ROOFED OR PAYED O.O ACRES AREA TO BE VEGETATIVELY STABILIZED 0.72 ACRES TOTAL CUT O CUBIC YARDS TOTAL FILL O CUBIC YARDS

SEDIMENT CONTROL GENERAL NOTES


OFF-SITE WASTE/BORROW AREA LOCATION WASTE = 8. ANY SEDIMENT CONTROL PRACTICE WHICH IS DISTURBED BY GRADING ACTIVITY FOR PLACEMENT OF UTILITIES MUST BE REPAIRED ON THE SAME DAY OF DISTURBANCE. 9. ADDITIONAL SEDIMENT CONTROLS MUST BE PROVIDED, IF DEEMED NECESSARY BY THE

HOWARD COUNTY SEDIMENT CONTROL INSPECTOR. 10. ON ALL SITES WITH DISTURBED AREAS IN EXCESS OF 2 ACRES, APPROVAL OF THE INSPECTION AGENCY SHALL BE REQUESTED UPON COMPLETION OF INSTALLATION OF PERIMETER EROSION AND SEDIMENT CONTROLS, BUT BEFORE PROCEEDING WITH ANY OTHER EARTH DISTURBANCE OR GRADING, OTHER BUILDING OR GRADING INSPECTION APPROVALS MAY NOT BE AUTHORIZED UNTIL THIS INITIAL APPROVAL BY THE INSPECTION AGENCY IS MADE.

11. TRENCHES FOR THE CONSTRUCTION OF UTILITIES IS LIMITED TO THREE PIPE LENGTHS OR THAT WHICH SHALL BE BACK-FILLED AND STABILIZED WITHIN ONE WORKING DAY, WHICHEVER IS SHORTER.

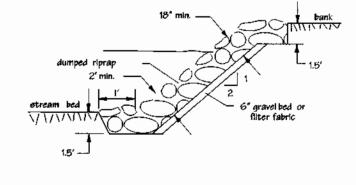

CROSS SECTION

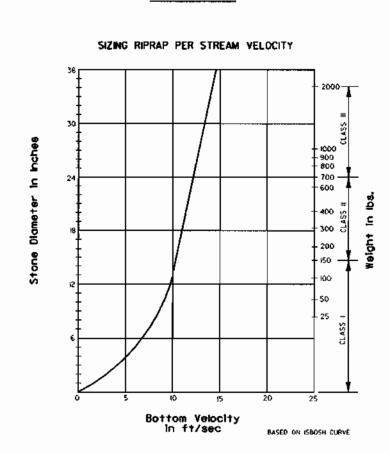

RIPRAP GRADATION

	SIZE	PERCENT OF TOTAL WEIGHT SMALLER THAN THE GIVEN SIZE
CLASS I	150 LB (70 KG) 2 LB (1 KG)	100 10 MAX
CLASS II	700 LB (320 KG) 20 LB (10 KG)	100 10 MAX
CLASS II)	2000 LB (910 KG) 20 LB (20KG)	100 10 MAX

This work shall consist of protedting slopes and channels from erosion with coverings of stone in accordance with the plans and specifications shown on this drawing.

l. Description

II. Material Specifications Bedding:
 A. Bank run gravel shall meet the following

requirements % less than selve size 21/2 in

B. Geotextile filter fabric meet the following requirements. Tensile Strength Burst Strength Puncture Strengt Permeability
Elongation at failure .02 cm/sec

The maximum weight of stone shall be based upon the chart. The gradation of the sotne shall be as

III. Construction Requirements

The constructor shall install all sediment and crosion control devices as a first order of busines: 2. Provisions must be made to anchor the Hprap at the stream bed so as to provide protection agains undermining. If this cannot be accomplished b extending the toe trench as Indicated in Crosss

3. Excavation for riprap shall be made in reasonable close conformity with the existing stream slope and

received prior written approval of the Admini-

A. A filter bedding is required under all riprap. Bedding material shall consist of either a bank run gravel or a geotextile filter fabric meeting the specifications of II. 1,15 above.

The placement of riprap shall begin with the too. The larger stones shall be placed in teh toe and along the outside edges of teh limits of the slope and chann protection. The riprap shall be placed with sultable equipment in such a manner as to produce a reason ably graded mass of stones with zero drop height. he placing of stones that cause extensive segri

6. Any excavation voids existing along the edges of the

. All disturbed areas shall be permanently stabilized in accordance with an approved sediment and erosion

> WATER RESOURCES ADMINISTRATION DETAIL WPD 3,1

> > NOT TO SCALE

Topsoil Specifications

FOR SEDIMENT CONTROL /STABILIZATION PURPOSES

21.0 STANDARD AND SPECIFICATIONS

TOPSOIL

SUPER SILT FENCE

Placement of topsoil over a prepared subsoil prior to establishment of permanent

To provide a suitable soil medium for vegetative growth. Soils of concern have low moisture content, low nutrient levels, low pH, materials toxic to plants, and/or unacceptable soil gradation.

Conditions Where Practice Applies

I. This practice is limited to areas having 2:1 or flatter slopes where:

a. The texture of the exposed subsoil/parent material is not adequate to produce

b. The soil material is so shallow that the rooting zone is not deep enough to support plants or furnish continuing supplies of moisture and plant nutrients.

c. The original soil to be vegetated contains material toxic to plant growth.

d. The soil is so acidic that treatment with limestone is not feasible.

II. For the purpose of these Standards and Specifications, areas having slopes steeper than 2:1 require special consideration and design for adequate stabilization. Areas having slopes steeper than 2:1 shall have the appropriate stabilization shown

Construction and Material Specifications

I. Topsoil salvaged from the existing site may be used provided that it meets the standards as set forth in these specifications. Typically, the depth of topsoil to be salvaged for a given soil type can be found in the representative soil profile section in the Soil Survey published by USDA-SCS in cooperation with Maryland Agricultural Experimental Station.

II. Topsoil Specifications - Soil to be used as topsoil must meet the following:

i. Topsoil shall be a loam, sandy loam, clay loam, silt loam, sandy clay loam, loamy sand. Other soils may be used if recommended by an agronomist or soil scientist and approved by the appropriate approval authority. Regardless, topsoil shall not be mixture of contrasting textured subsoils and shall contain less than 5% by volume of cinders, stones, slags, coarse fragments, gravel sticks, roots, trash, and other materials larger 11/2 inch in diameter.

ii. Topsoil must be free of plants or plant parts such as Bermuda grass, quackgrass, Johnsongrass, nutsedge, poison ivy, thistle, or others as specified.

lii. Where the subsoil is either highly acidic or composed of heavy clays, ground limestone shall be spread at the rate of 4-8 tons/acre (200-400 pounds per 1.000 square feet) prior to the placement of topsoil. Lime shall be distributed uniformly over designated areas and worked into the soil in conjunction with tillage operations as described in the following procedures.

II. For sites having disturbed areas under 5 acres:

i. Place topsoil (if required) and apply soil amendments as specified in 20.0 Vegetative Stabilization - Section 1 - Vegetative Stabilization Methods and

III. For sites having disturbed areas over 5 acres:

I. On soil meeting Topsoil specifications, obtain test results dictating fertilizer and lime amendments required to bring the soil into compliance with the following:

a. pH for topsoil shall be between 6.0 and 7.5. If the tested soil demonstrates a pH

of less than 6.0, sufficient lime shall be prescribed to raise the pH to 6.5 or higher.

b. Organic contents of topsoil shall be not less than 1.5 percent by weight.

c. Topsoil having soluble salt content greater than 500 parts per million shall not be

d. No sod or seed shall be placed on soil which has been treated with soil sterilants or chemicals used for weed control until sufficient time has elapsed (14 days min.) to permit dissipation of phyto-toxic materials.

Note: Topsoil substitutes or amendments, as recommended by a qualified agronomist or soil scientist and approved by the appropriate approval authority, may be used in lieu of natural topsoil.

ii. Place topsoil (if required) and apply soil amendments as specified in 20.0 Vegetative Stabilization-Section I-Vegetative Stabilization Methods and


V. Topsoil Application

i. When topsoiling, maintain needed erosion and sediment control practices such as diversions, Grade Stabilization Structures, Earth Dikes, Slop Silt Fence and Sediment Traps and Basins.

ii. Grades on the areas to be topsoiled, which have been previously established, shall be maintained, albeit 41/32 - 81/32 higher in elevation.

iii. Topsoil shall be uniformly distributed in a 4952 - 8952 layer and lightly compacted to a minimum thickness of 49%. Spreading shall be performed in such a manner that sodding or seeding can proceed with a minimum of additional soil preparation and tillage. Any irregularities in the surface resulting from topsoiling or other operations shall be corrected in order to prevent the formation of depressions or water pockets.

iv. Topsoil shall not be placed while the topsoil or subsoil is in a frozen or muddy condition, when the subsoil is excessively wet or in a condition that may otherwise be detrimental to proper grading and seedbed preparation.

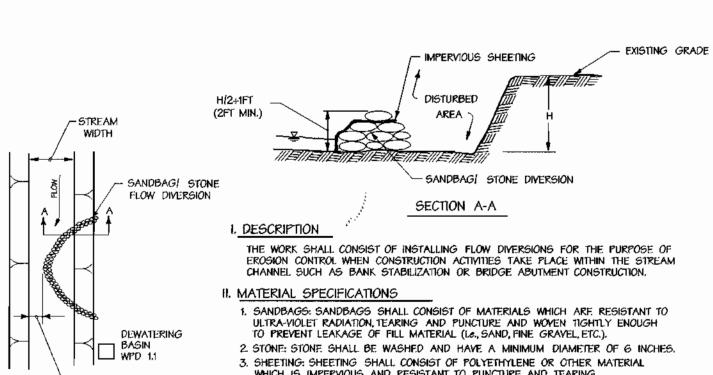

NOT TO SCALE

THE WORK SHALL CONSIST OF INSTALLING FLOW DIVERSIONS FOR THE PURPOSE OF EROSION CONTROL WHEN CONSTRUCTION ACTIVITIES TAKE PLACE WITHIN THE STREAM CHANNEL SUCH AS BANK STABILIZATION OR BRIDGE ABUTMENT CONSTRUCTION.

RIP-RAP BANK STABILIZATION

ULTRA-VIOLET RADIATION, TEARING AND PUNCTURE AND WOVEN TIGHTLY ENOUGH TO PREVENT LEAKAGE OF FILL MATERIAL (I.E., SAND, FINE GRAVEL, ETC.). 2. STONE: STONE SHALL BE WASHED AND HAVE A MINIMUM DIAMETER OF 6 INCHES. 3. SHEETING: SHEETING SHALL CONSIST OF POLYETHYLENE OR OTHER MATERIAL WHICH IS IMPERVIOUS AND RESISTANT TO PUNCTURE AND TEARING.

I. CONSTRUCTION REQUIREMENTS 1. ALL EROSION AND SEDIMENT CONTROL DEVICES SHALL BE INSTALLED AS THE

MIN. WIDTH 16 25%

OF STREAM WIDTH

SANDBAG / STONE DIVERSION

PLAN VIEW

FIRST ORDER OF WORK. 2 THE DIVERSION STRUCTURE SHALL BE INSTALLED FROM UPSTREAM TO

3. THE HEIGHT OF THE DIVERSION STRUCTURE SHALL BE ONE HALF THE DISTANCE FROM THE STREAM BED TO THE STREAM BANK PLUS ONE FOOT, AS INDICATED

4. ALL EXCAVATED MATERIALS SHALL BE DISPOSED OF IN A SCD APPROVED DISPOSAL AREA OUTSIDE THE 100-YEAR FLOODPLAIN UNLESS OTHERWISE APPROVED ON THE PLANS BY THE WRA. 5. ALL DEWATERING OF THE CONSTRUCTION AREA SHALL BE PUMPED TO A

DEWATERING BASIN PRIOR TO RE-ENTERING THE STREAM. 6. SHEETING SHALL BE OVERLAPPED SUCH THAT THE UPSTREAM PORTION COVERS THE DOWNSTREAM PORTION WITH AT LEAST AN 18 INCH OVERLAP. 7. SEDIMENT CONTROL DEVICES ARE TO REMAIN IN PLACE UNTIL ALL DISTURBED

AREAS ARE STABILIZED IN ACCORDANCE WITH AN APPROVED SEDIMENT AND EROSION CONTROL PLAN AND THE INSPECTING AUTHORITY APPROVES THEIR REMOVAL. WATER RESOURCES ADMINISTRATION

DETAIL WPD 22

Sequence of Construction

1. OBTAIN A GRADING AND WETLAND PERMIT.

2. INSTALL EROSION AND SEDIMENT CONTROL MEASURES AND STABILIZE. 4

3. WHILE CONSTRUCTING UTILITIES THE LIMIT-OF -DISTURBANCE SHALL INCLUDE ONLY THREE (3) PIPE LENGTHS OR THAT WHICH WILL BE BACKFILLED AND STABILIZED IN ONE WORK DAY. -4. STABILIZE ALL AREAS IN ACCORDANCE WITH STANDARDS

5. UPON APPRROVAL OF THE EROSION AND SEDIMENT CONTROL INSPECTOR, REMOVE ALL EROSION AND SEDIMENT CONTROL MEASURES AND STABILIZE

AND SPECIFICATIONS.

DEVELOPER'S CERTIFICATION: 7/WE CERTIFY THAT ALL DEVELOPMENT AND CONSTRUCTION WILL BE DONE ACCORDING TO THIS PLAN, AND THAT ANY RESPONSIBLE PERSONNEL INVOLVED IN THE CONSTRUCTION PROJECT WILL HAVE A CERTIFICATE OF ATTENDANCE AT A DEPARTMENT OF THE ENVIRONMENT APPROVED TRAINING PROGRAM FOR THE CONTROL OF SEDIMENT AND EROSION BEFORE BEGINNING THE PROJECT, IALSO AUTHORIZE PERIODIC ON-SITE INSPECTION BY THE HOWARD SOIL CONSERVATION DISTRICT.

ENGINEER'S CERTIFICATION:

CERTIFY THAT THIS PLAN FOR EROSION AND SEDIMENT CONTROL REPRESENTS OF PRACTICAL AND WORKABLE PLAN BASED ON MY PERSONAL KNOWLEDGE OF THE SITE CONDITIONS AND THAT IT WAS PREPARED IN ACCORDANCE WITH THE REQUIRMENTS OF THE HOWARD SOIL CONSERVATION DISTRICT."

SIGNATURE OF ENGINEER PRINT NAME BELOW SIGNATURE

REVIEWED FOR HOWARD S.C.D. AND MEETS TECHNICAL REQUIREMENTS


U.S. NATURAL RESOURCE CONSERVATION SERVICE THIS DEVELOPEMENT PLAN IS APPROVED FOR SOIL EROSION AND SEDIMENT CONTROL BY THE HOWARD SOIL CONSERVATION DISTRICT.

TEMPORARY AND PERMANENT SEEDING NOTES

DEPARTMENT OF PUBLIC WORKS HOWARD COUNTY, MARYLAND

Robert M. Berry 12-3-99

DEPARTMENT OF PLANNING & ZONING HOWARD COUNTY, MARYLAND

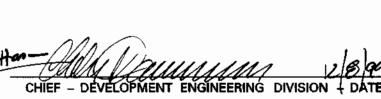

Daft · McCune · Walker, Inc. A Team of Land Planners. 200 East Pennsylvania Avenue

Landscape Architects.

Engineers. Surveyors &

Environmental Professionals



TY CANCEL FULL WALLES	֖֝֞֜֜֜֝֞֜֜֜֜֜֜֜֜֜֜֜֜֜֜֜֜֜֜֜֜֜֜֜֜֜֜֜֜֜֜֜
Harrier Harris	C
AL EMMINITED	C

T	DESIGN BY:			•		
	BIS					
ſ	DRAWN BY:					
ŀ	CHECKED BY:					EROSION AND SEDIMENT CONTROL DETAILS
ľ	SHEGHED DI					
ŀ	DATE:					
	10–20–99	BY	NO.	REVISION	DATE	600 SCALE MAP NO. 41 BLOCK NO. 17

Montpelier Research Park HOWARD COUNTY MARYLAND

NOT TO SCALE

OWNER/DEVELOPER: HOPKINS ROAD LIMITED PARTNERSHIP 9030 RED BRANCH ROAD, SUITE 200 COLUMBIA, MD 21045 CONTRACT NO. ____30-3789-D

SHEET 4 OF 4

SCALE

AS SHOWN

Wed Oct 20 15:22:11 1999 n:\941717c\941717c\s4

QUANTITIES							
		AS-BUILT					
ITEMS	QUANTITIES ESTIMATED	QUANTITIES	TYPE	MANUFACTURER /SUPPLIER			
8" PVC S.	1352 LF	1380 LF	PVC SDR 25	JM Hanufacturer / Municipal & Contractor Sales			
8" DIP S.	190 LF	163 LF	CL 52	Griffin/Municipal & Contractors Salas			
Type "B" drop mre or mit with intermediate landings	2 EA.	2 EA	Precast	Fredrick Precast Inc / Fredrick Procast			
STD MANHOLES	6 EA.	4EA	Precast	Fredrick PrecastInc. / Fredrick Precast			
MANHOLES	100 VF.						
TYPE "A" DROP MH	2 EA.	2.EA	Precast	Fradrick Precast Inc. / Fradrick Pracast			
	······································						
NAME OF UTILITY	NAME OF UTILITY CONTRACTOR: Utilities Unlimited						
SURVEY AND DRAFTING DIVISION AS-BUILT DATE:							


SHEET INDEX					
SHEET No.	DESCRIPTION				
1	COVER SHEET				
2	SEWER, EROSION AND SEDIMENT CONTROL PLAN				
3	SEWER PROFILES AND DETAILS				
4	EROSION AND SEDIMENT CONTROL DETAILS				

Montpelier

Research Park Parcels E-2 thru E-3, Johns Hopkins Road

SEWER CONSTRUCTION

CONTRACT NO. 30–3789–D
Howard County, Maryland Department of Public Works

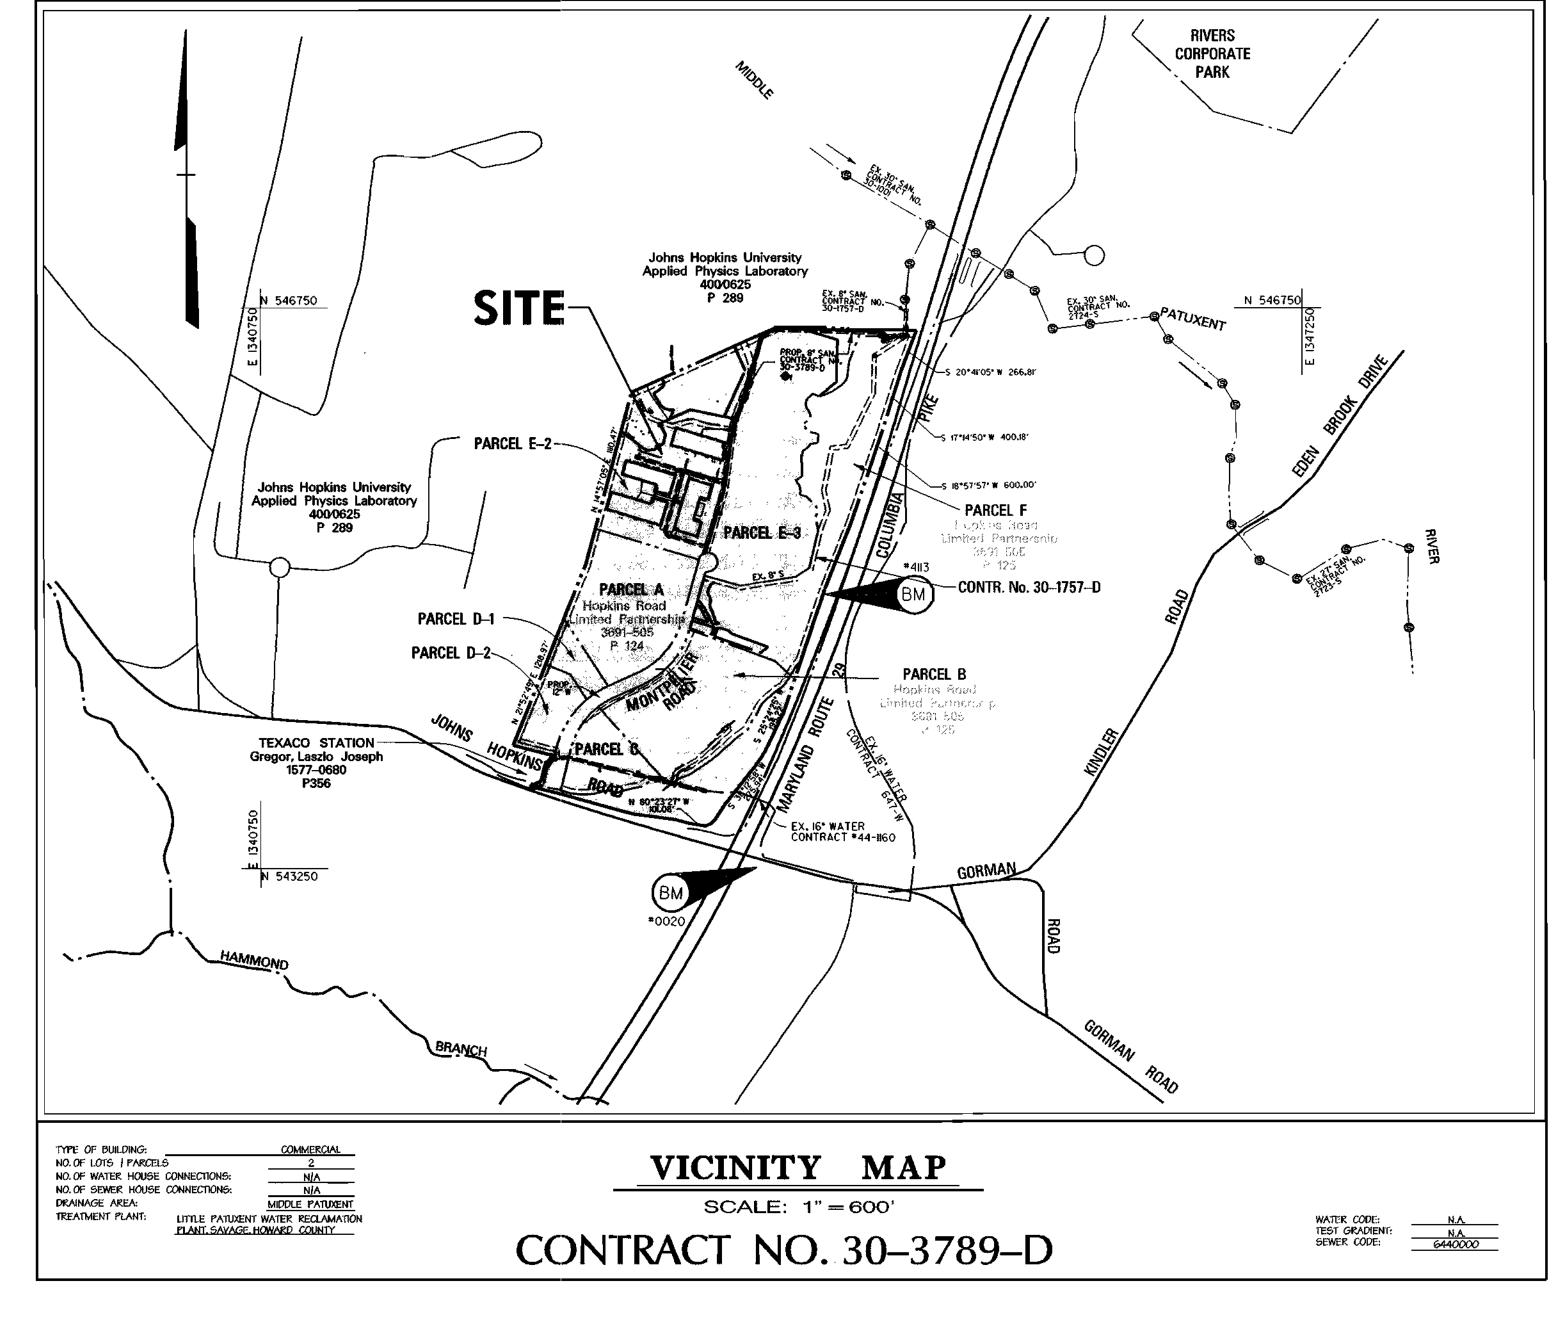

AS-BUILTS

OWED THE CONTRACTOR, THE CONTRACTOR SHALL COORDINATE WITH THE UTILITY COMPANIES TO SCHEDULE THE BRACING OF THE POLES. 6. FOR DETAILS NOT SHOWN ON THE DRAWINGS AND FOR MATERIALS AND CONSTRUCTION METHODS USE HOWARD COUNTY DESIGN MANUAL, VOLUME IV, STANDARD SPECIFICATIONS AND DETAIL FOR CONSTRUCTION (LATEST EDITION). THE CONTRACTOR SHALL HAVE A

GENERAL NOTES

REPAIRED IMMEDIATELY TO THE SATISFACTION OF THE ENGINEER AT

2. ALL HORIZONTAL CONTROLS ARE BASED ON MARYLAND STATE COORDINATES

5. CLEAR ALL UTILITIES BY A MINIMUM OF 12". CLEAR ALL POLES BY 2'-0"

ADDITIONAL POLES OR DAMAGES SHALL BE DEDUCTED FROM MONEY

MINIMUM OR TUNNEL AS REQUIRED. THE OWNER HAS CONTACTED THE UTILITY COMPANIES AND HAS MADE ARRANGEMENTS FOR BRACING OF POLES AS SHOWN ON THE DRAWINGS. IN THE EVENT THE

CONTRACTOR'S WORK REQUIRES THE BRACING OF ADDITIONAL POLES, ANY COST INCURRED BY THE OWNER FOR BRACING OF

4. ALL PIPE ELEVATIONS SHOWN ARE INVERT ELEVATIONS, UNLESS OTHERWISE NOTED.

1. APPROXIMATE LOCATION OF EXISTING MAINS ARE SHOWN. THE CONTRACTOR SHALL TAKE ALL NECESSARY PRECAUTIONS TO PROTECT EXISTING MAINS AND SERVICES AND MAINTAIN UNINTERRUPTED SUPPLY. ANY DAMAGE INCURRED SHALL BE

3. ALL VERTICAL CONTROLS ARE BASED ON U.S.G.S. DATA.

THE CONTRACTOR'S EXPENSE.

COPY OF VOLUME IV ON THE JOB. 7. WHERE TEST PITS HAVE BEEN MADE ON EXISTING UTILITIES, THEY ARE NOTED BY THE SYMBOL AT THE LOCATION OF THE TEST PIT. A NOTE OR NOTES CONTAINING THE RESULTS OF THE TEST PIT OR PITS IS INCLUDED ON THE DRAWINGS. EXISTING UTILITIES IN THE VICINITY OF THE PROPOSED WORK FOR WHICH TEST PITS HAVE NOT BEEN DUG SHALL BE LOCATED BY THE CONTRACTOR TWO WEEKS IN ADVANCE OF CONSTRUCTION OPERATIONS AT HIS OWN EXPENSE.

8. CONTRACTOR SHALL NOTIFY THE FOLLOWING UTILITY COMPANIES OR AGENCIES AT LEAST FIVE WORKING DAYS BEFORE STARTING WORK SHOWN ON THESE PLANS:

> STATE HIGHWAY ADMINISTRATION BG&E CO. CONTRACTOR SERVICES BG&E CO. UNDER GROUND DAMAGE CONTROL COLONIAL PIPELINE CO. HOWARD COUNTY DEPARTMENT OF PUBLIC WORKS

410-531-5533 410-850-4620 410-787-9068 1-*800-257-777*7 410-795-1390 410-313-4900

BUREAU OF UTILITIES 1-800-446-5266 BELL ATLANTIC

- 9. TREES AND SHRUBS ARE TO BE PROTECTED FROM DAMAGE TO MAXIMUM EXTENT, TREES AND SHRUBS LOCATED WITHIN THE CONSTRUCTION STRIP ARE NOT TO BE REMOVED OR DAMAGED BY THE
- 10. CONTRACTOR SHALL REMOVE TREES, STUMPS, AND ROOTS ALONG LINE OF EXCAVATION. PAYMENT FOR SUCH REMOVAL SHALL BE INCLUDED IN THE UNIT PRICE BID FOR CONSTRUCTION OF THE MAIN. 11. THE CONTRACTOR SHALL NOTIFY THE BUREAU OF HIGHWAYS,
- HOWARD COUNTY, AT (410) 313-2450 AT LEAST FIVE WORKING DAYS BEFORE ANY OPEN OUT OF ANY COUNTY ROAD OR BORING/JACKING OPERATION IN COUNTY ROADS FOR LAYING WATER/SEWER MAINS OR HOUSE CONNECTIONS, THE APPROVAL OF THESE DRAWINGS WILL CONSTITUTE COMPLIANCE WITH DPW REQUIREMENTS PER SECTION 18.114(A) OF THE HOWARD COUNTY CODE.

PART II - SEWER

- ALL SEWER MAINS SHALL BE P.V.C. OR D.I.P. CLASS 52 UNLESS OTHERWISE NOTED. THE CONTRACTOR SHALL PROVIDE A JOINT IN ALL SEWER MAINS WITHIN 2'-0' OF

- EXTERIOR MANHOLE WALL.

 ALL MANHOLES SHALL BE 4'-0" INSIDE DIAMETER UNLESS OTHERWISE NOTED.

 FORCE MAINS SHALL BE D.I.P. ONLY.

 MANHOLES SHOWN WITH 12" AND 16" WALLS ARE FOR BRICK MANHOLES ONLY.

 MANHOLES DESIGNATED W.T. IN PLAN AND PROFILE SHALL HAVE WATERTIGHT FRAME AND COVERS, STANDARD DETAIL G5.52. WHERE WATERTIGHT MANHOLE FRAME AND COVER IS USED, SET TOP OF FRAME 1'-6" ABOVE FINISHED GRADE UNLESS OTHERWISE NOTED ON THE DRAWINGS.
- THE DRAWINGS.

 7. HOUSE(S) WITH THE SYMBOL "C.N.S." INDICATES THAT CELLAR CANNOT BE SERVED.

BENCHMARK

DESCRIPTION

*4113 N 544492.88 E 1344177.82 ELEVATION = 391.65

CONCRETE MONUMENT 4' # WEST OF TOP OF BANK OFF SOUTH BOUND LANE OF MARYLAND ROUTE 29 AT SURFACE.

*0020 N 543170.96 E 1343822.16 ELEVATION = 403.62

STANDARD MBCS SURVEY DISC SET ON CONCRETE MONUMENT, FLUSH WITH THE GROUND.

REVIEWED FOR NATURAL RESOURCE CONSERVATION SERVICE

DEPARTMENT OF PUBLIC WORKS

HOWARD COUNTY, MARYLAND

SEDIMENT CONTROL MEASURES WILL BE IMPLEMENTED IN ACCORDANCE WITH SECTION 219 OF THE SPECIFICATIONS AND SITE DEVELOPMENT PLAN F.00-49

DEPARTMENT OF PLANNING & ZONING

HOWARD COUNTY, MARYLAND Daft·McCune·Walker, Inc. A Team of Land Planners, 200 East Pennsylvania Avenue Landscape Architects. Towson. Maryland 21286 Engineers, Surveyors & 410 296 3333 Fax 296 4705 Environmental Professionals



DESIGN BI:					
BIS					
DRAWN BY:					
ADL					COVED CHEET
CHECKED BY:					COVER SHEET
DATE:					
10-20-99	BY	NO.	REVISION	DATE	600 SCALE MAP NO. <u>41</u> BLOCK NO. <u>17</u>

Research Park HOWARD COUNTY MARYLAND OWNER: HOPKINS ROAD LIMITED PARTNERSHIP 9030 RED BRANCH ROAD, SUITE 200 COLUMBIA, MD 21045 DEVELOPER: TRAMMELL CROW COMPANY


6701 DEMOCRACY BLVD. SUITE 410, BETHESDA, MD 20817


CONTRACT NO. 30–3789–D


SHOWN

1 OF 4

Won Nov 15 18:02:17 1999 d:\941717c\941717c\si

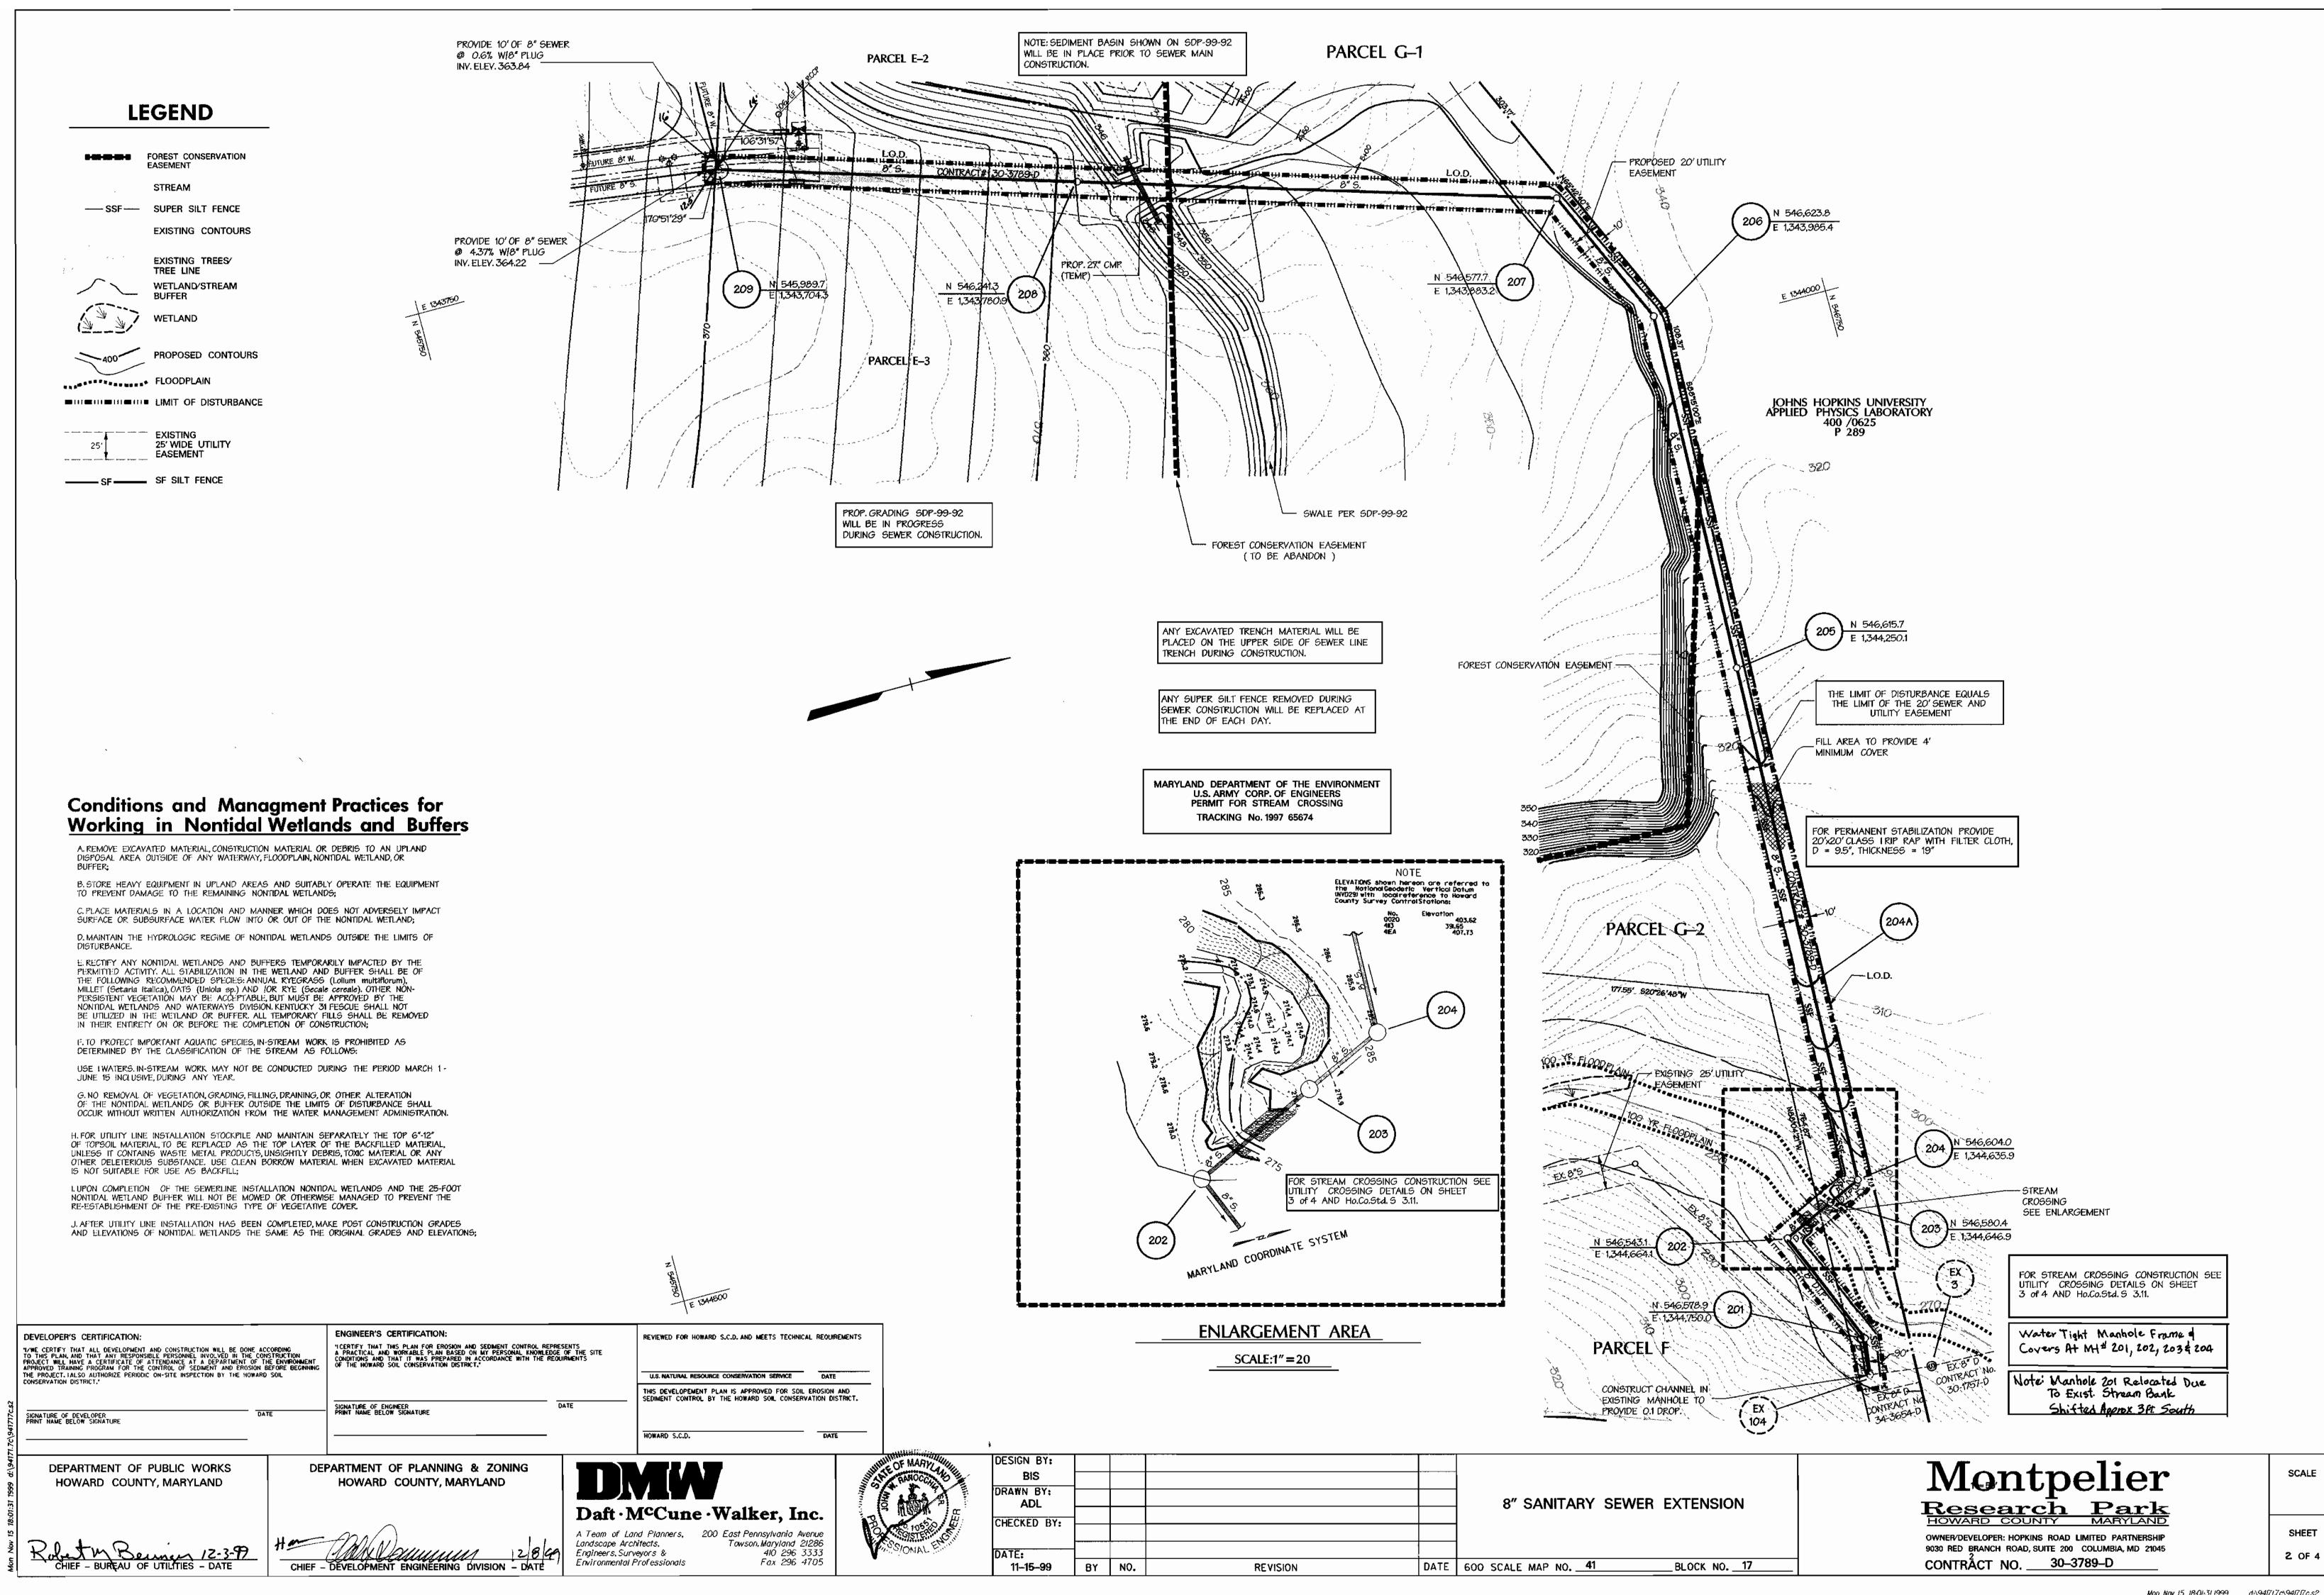

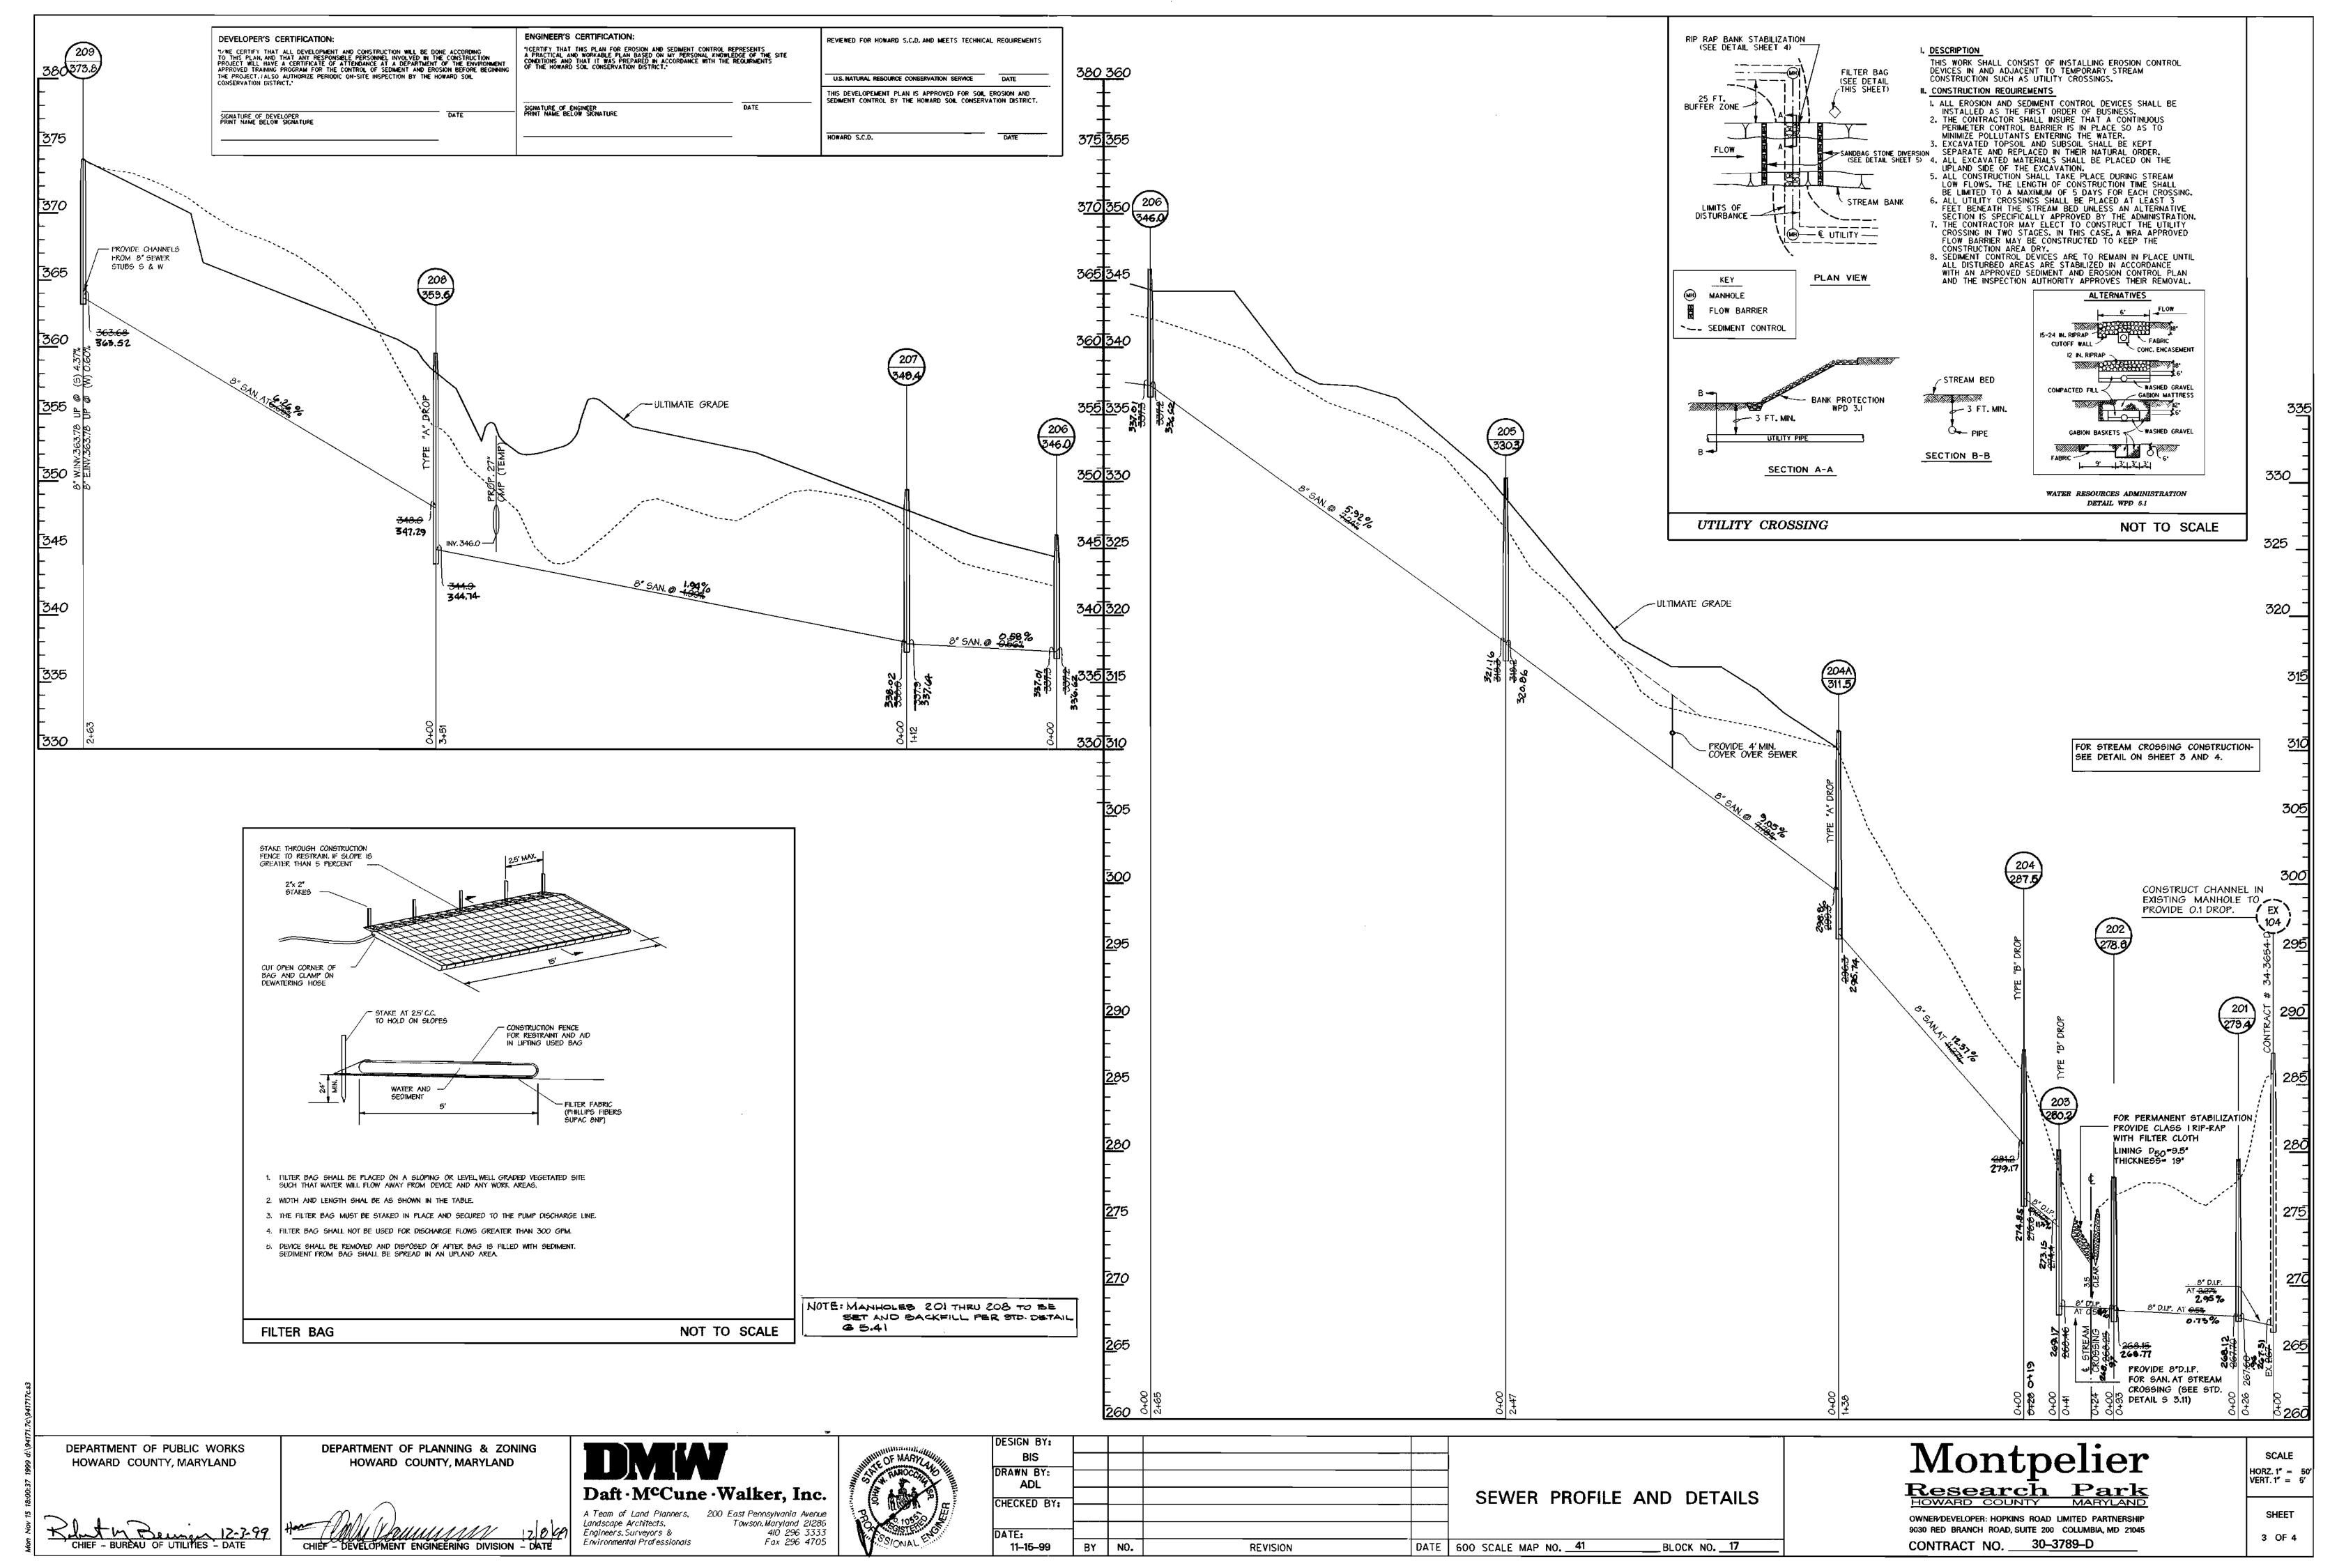

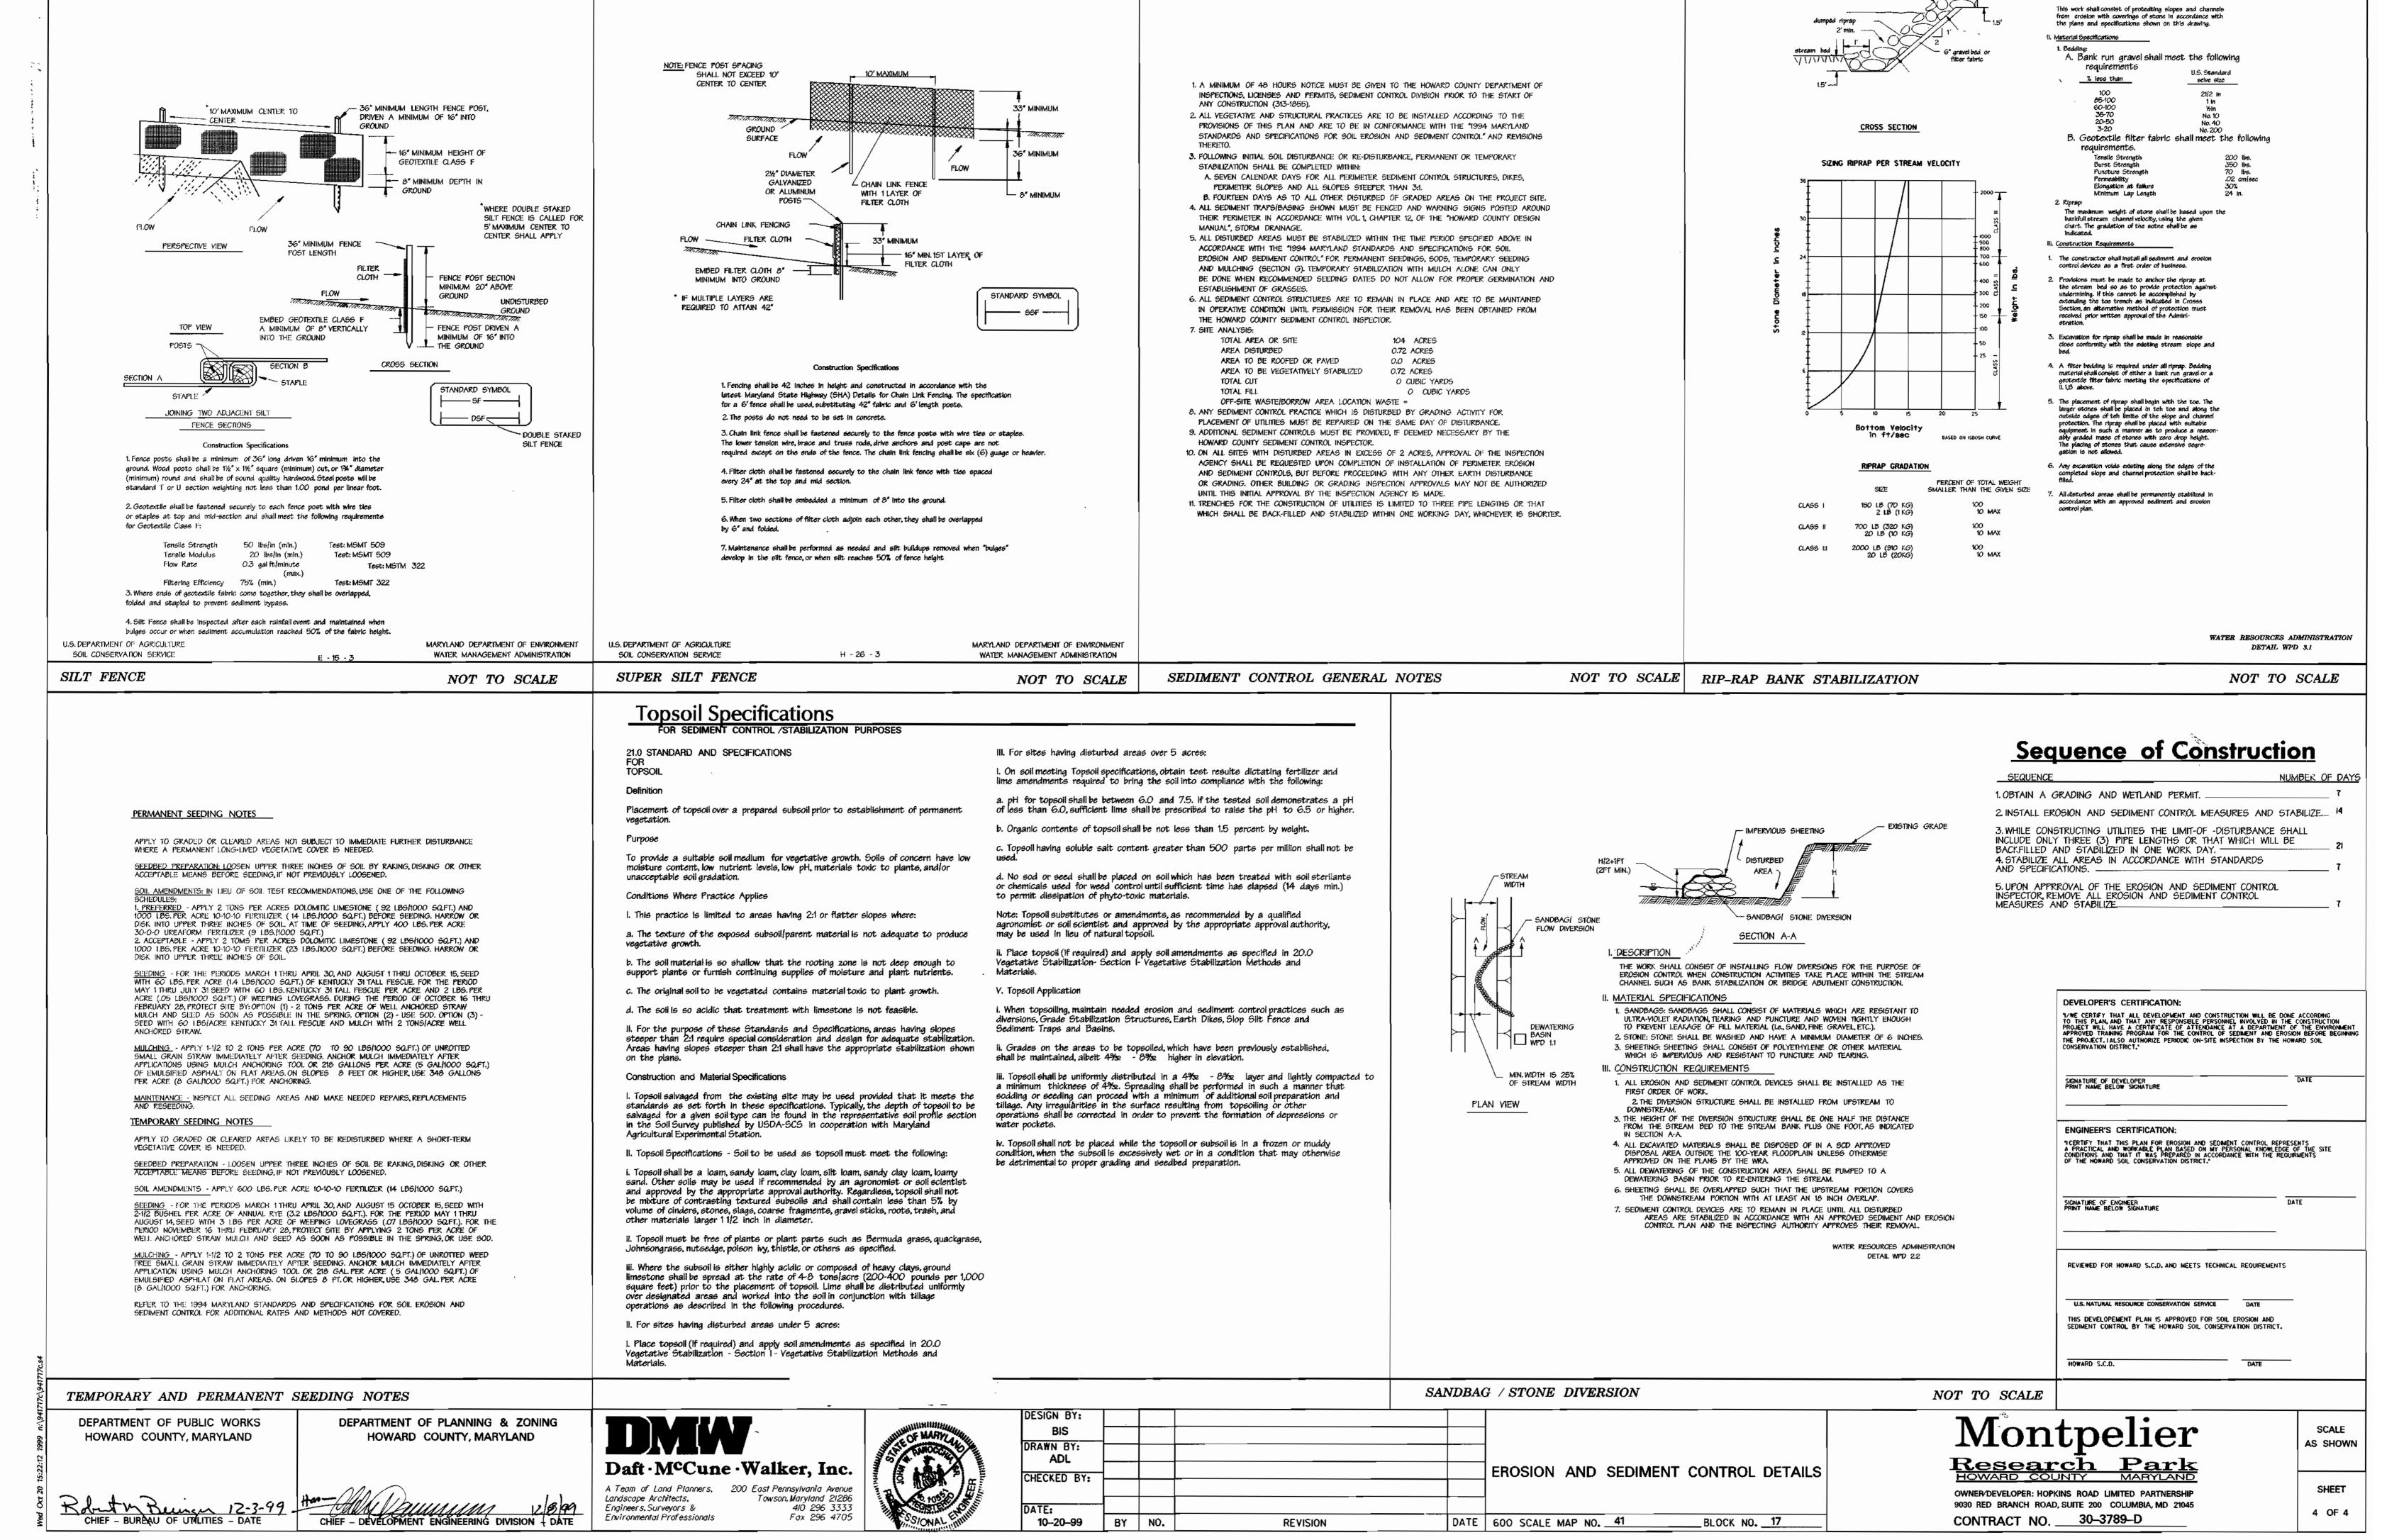

I. Description