

NOTE:
 THESE PLANS REPRESENT AS-BUILT CONDITIONS (5-2003) AS PREPARED BY KCI TECHNOLOGIES, INC. THIS PROJECT WAS A DETAIL-BUILD UNDER DIRECTION OF HOWARD COUNTY DEPARTMENT OF PUBLIC WORKS.


AS BUILT

HOWARD COUNTY DPW
 In-House PLANS

DEPARTMENT OF PUBLIC WORKS HOWARD COUNTY, MARYLAND Director of Public Works: <i>[Signature]</i> 7-23-03 Chief, Bureau of Engineering: <i>[Signature]</i> 7-22-03 Chief, Utility Design Division: <i>[Signature]</i> 7-22-03		HOWARD COUNTY DEPARTMENT OF ENGINEERING Thomas H. Priddy, P.E. 2200 North Washington Blvd., Suite 200 Annapolis, MD 21403		DES: [] DRN: [] CHK: [] DATE: 6/03		PLAN 12-INCH WATER MAIN SCALE: 1"=20' DATE: 6/03 BY: KCI NO. [] AS-BUILT REVISION []		MEKENIE COURT/ALPHA RIDGE LANDFILL WATER MAIN LOOPING CAPITAL PROJECT NO. W-8239 CONTRACT NO. 44-4021 ELECTION DISTRICT NO. 3 HOWARD COUNTY, MARYLAND		SCALE AS SHOWN SHEET 1 OF 2
---	--	--	--	--	--	---	--	--	--	--------------------------------------


PLOTTED: 10:23 AM on Wednesday, June 25, 2003
 B:\Chandler_Kate_Division_Environment\Engineering\PLANS\44-4021.dwg
 PLOT: m:\2003\06\25\3\4\4021.dwg

M:\2001-01\10105\5\DRAWINGS

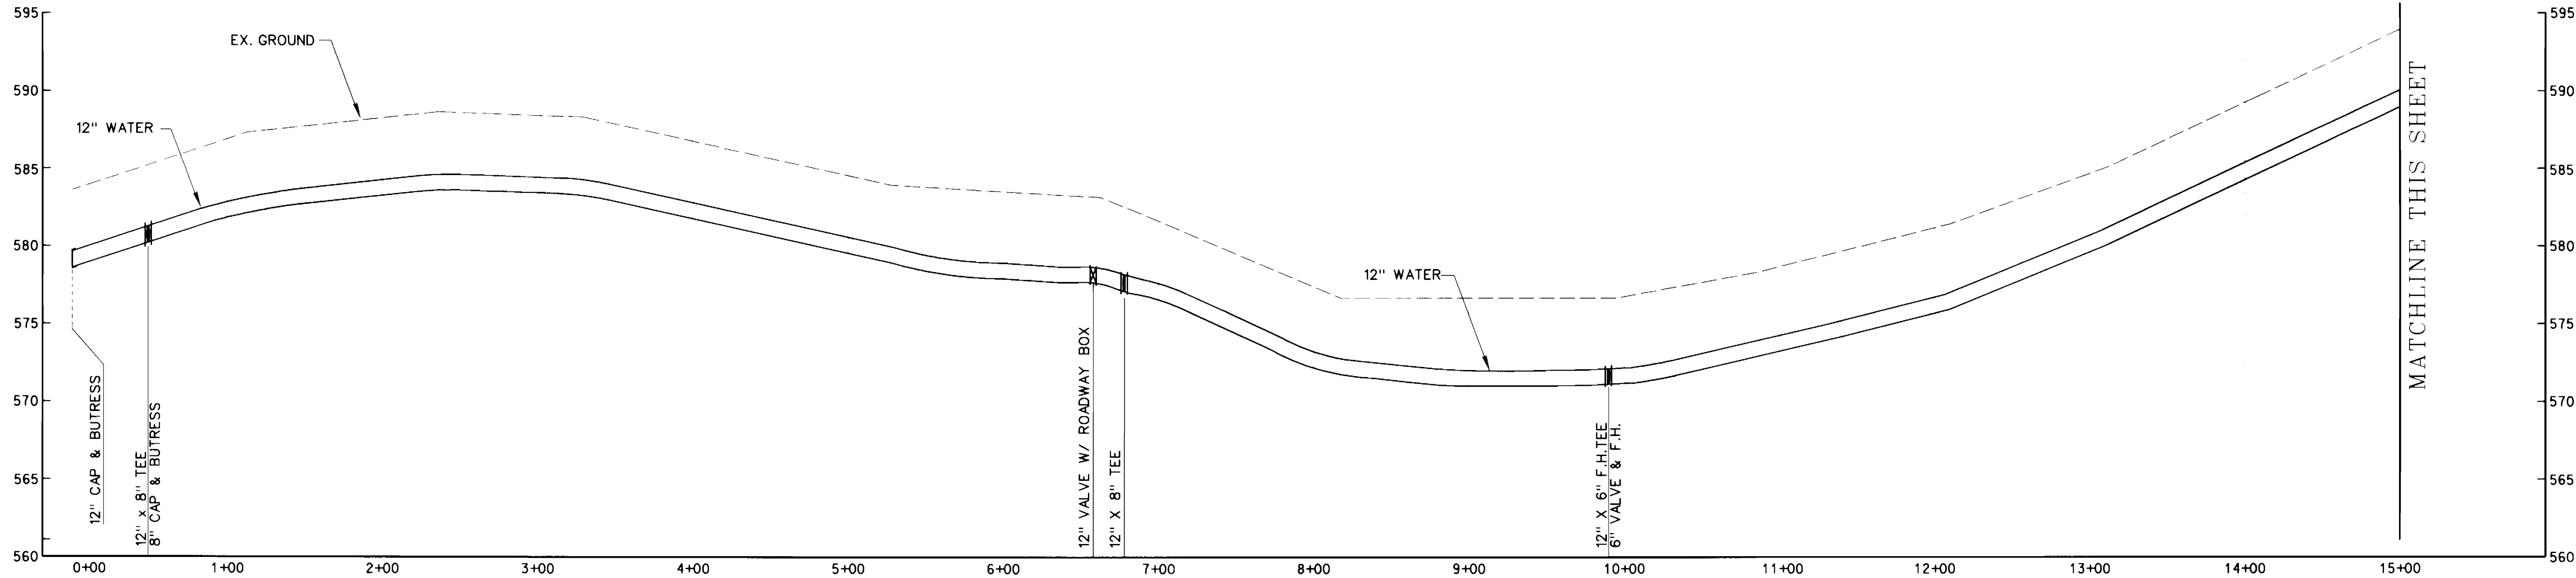


PROFILE

SCALE: HORIZONTAL 1" = 50'
VERTICAL 1" = 5'

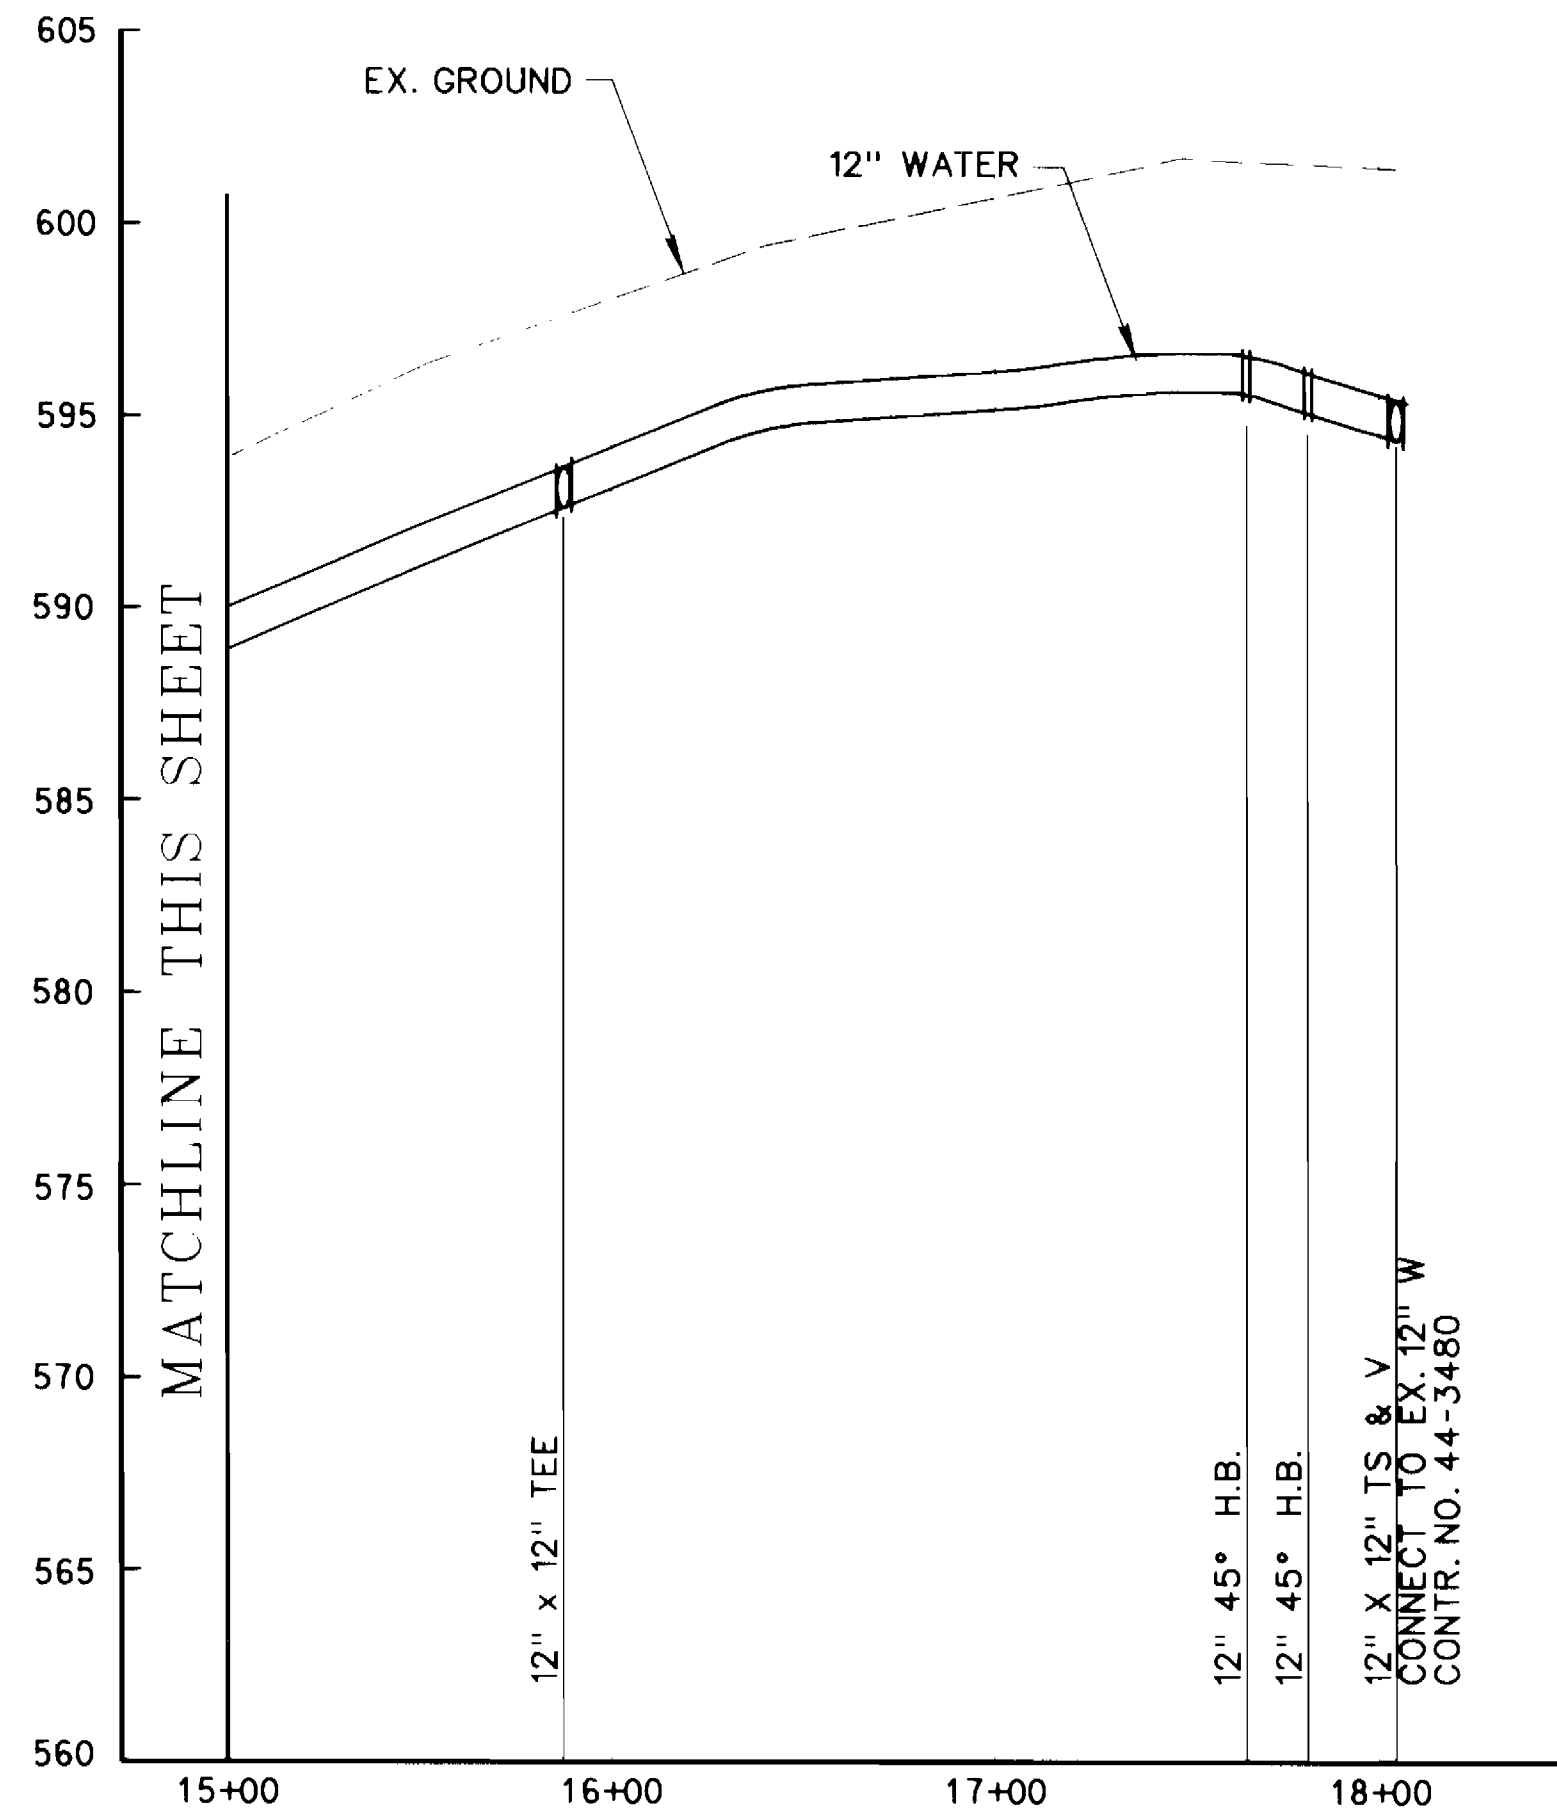

PROFILE

SCALE: HORIZONTAL 1" = 50'
VERTICAL 1" = 5'

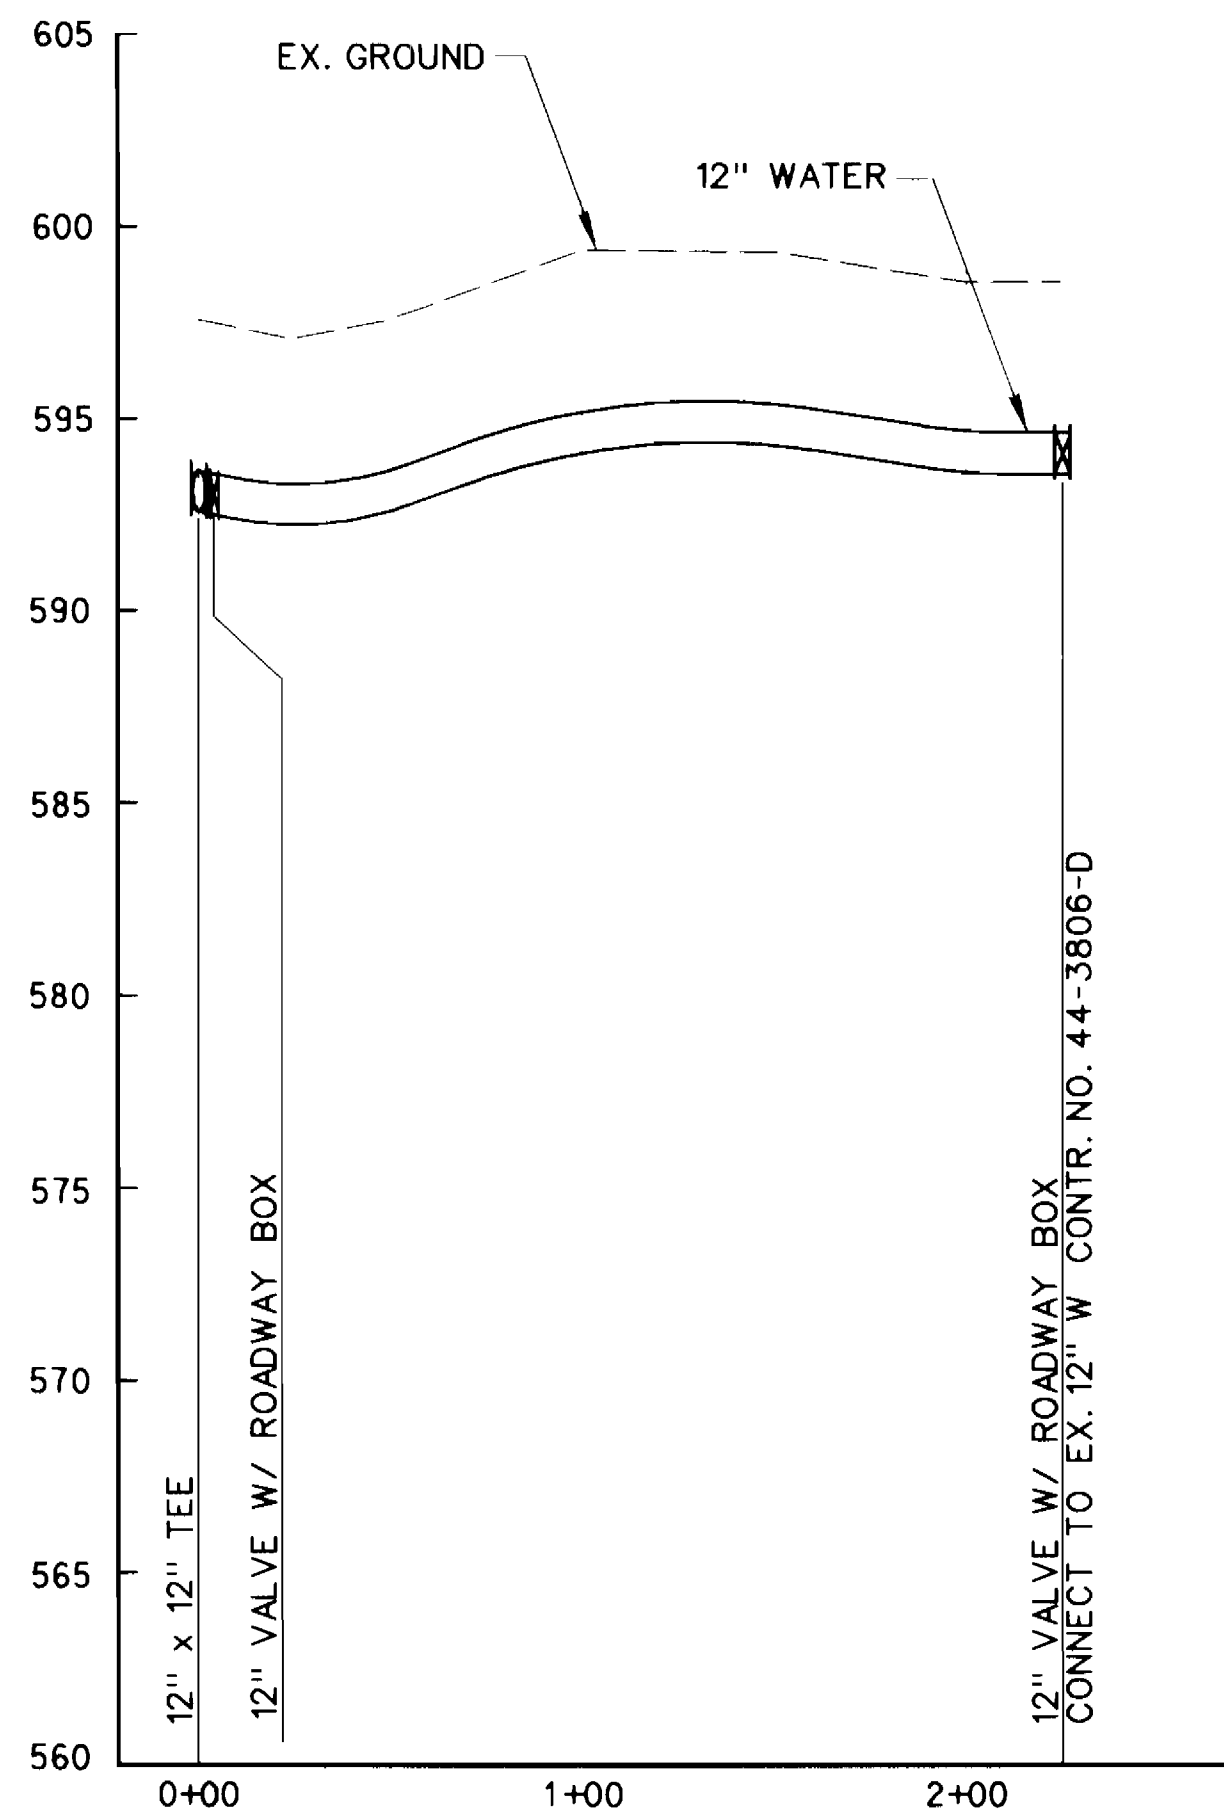

PROFILE 'B'


SCALE: HORIZONTAL 1" = 50'
VERTICAL 1" = 5'


AS BUILT

HOWARD COUNTY DPW
IN-HOUSE PLANS


PLOTTED: 10:24 AM on Wednesday, June 25, 2003
By: Chandler, A. Division: Environmental Engineering
C:\m\2001\010105\Drawings\AlphaRidge\ASBUILT.dwg

DEPARTMENT OF PUBLIC WORKS
HOWARD COUNTY, MARYLAND

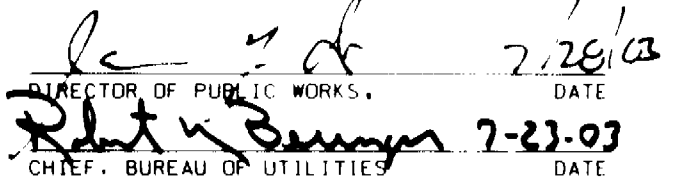 7/26/03
 DIRECTOR OF PUBLIC WORKS, DATE
 CHIEF - BUREAU OF UTILITIES

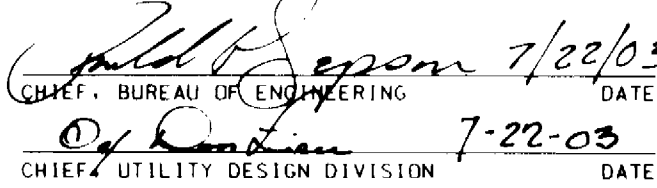 7/22/03
 CHIEF - BUREAU OF ENGINEERING, DATE
 CHIEF, UTILITY DESIGN DIVISION

HOWARD COUNTY BUREAU OF ENGINEERING
Thomas H. Deane III, Esq.
9220 Beltsville Road
Columbia, MD 21045

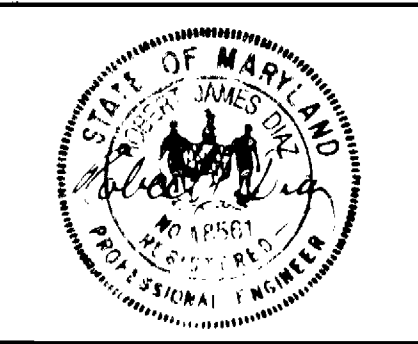

DES:					
DRN:					
CHK:					
DATE: 6/03	KCI	AS-BUILT		JUNE 2003	
BY:	NO.	REVISION			

PROFILE
12-INCH WATER MAIN

600' SCALE MAP NO. 16 BLOCK NO. 2

MEKENIE COURT/ALPHA RIDGE LANDFILL
WATER MAIN LOOPING
CAPITAL PROJECT NO. W-8239
CONTRACT NO. 44-4021
ELECTION DISTRICT NO. 3
HOWARD COUNTY, MARYLAND

SCALE AS SHOWN
SHEET 2 OF 2

M:\2001\010105\DRAWINGS\