



**8-IN SEWER PROFILE  
MH-1 TO MH-3**

SCALE: HOR: 1"=50'  
VER: 1"=5'

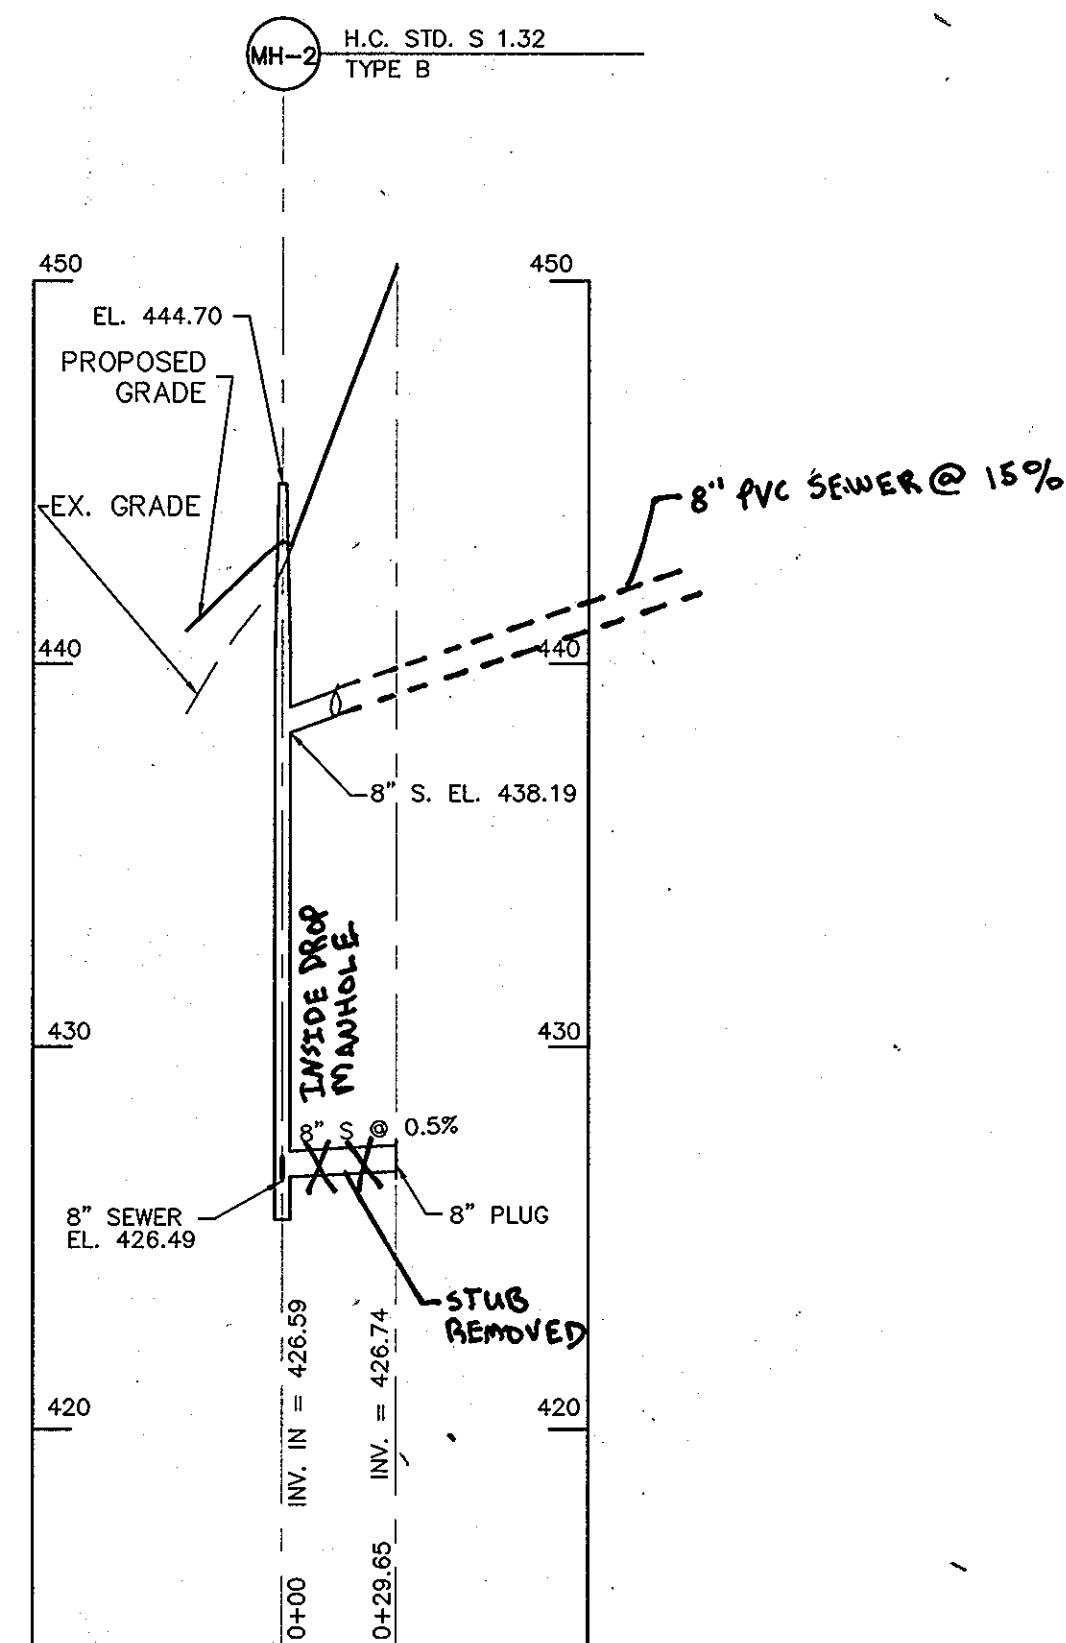

**8-IN SEWER PROFILE  
MH-2 TO PLUG**

SCALE: HOR: 1"=50'  
VER: 1"=5'

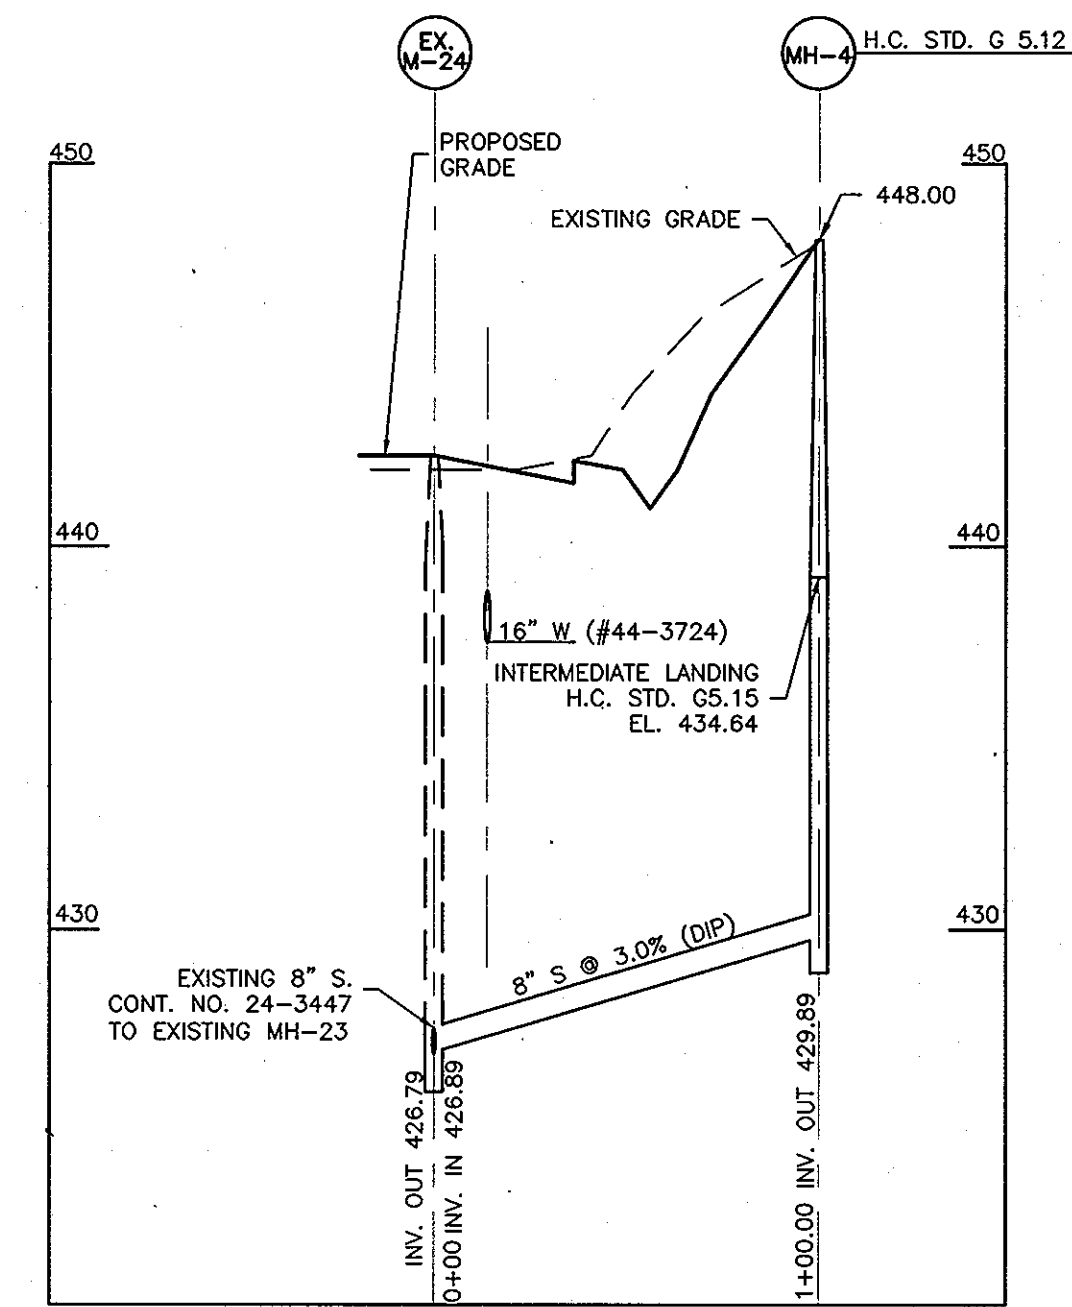

**8-IN SEWER PROFILE  
EX. MH-24 TO MH-4  
(FUTURE SERVICE TO POD I)**

SCALE: HOR: 1"=50'  
VER: 1"=5'

**OWNER**

MANGIONE ENTERPRISES OF TURF VALLEY, L.P.  
1205 YORK ROAD, PENTHOUSE  
LUTHERVILLE, MARYLAND 21093  
(410) 825-8400

DEPARTMENT OF PUBLIC WORKS  
HOWARD COUNTY, MARYLAND  
Ruth Dennis 5-9-06  
CHIEF, BUREAU OF UTILITIES DATE

DEPARTMENT OF PLANNING & ZONING  
HOWARD COUNTY, MARYLAND  
[Signature] 5/3/06  
CHIEF, DEVELOPMENT ENGINEERING DIVISION DATE

**MILDENBERG,  
BOENDER & ASSOC., INC.**  
Engineers Planners Surveyors  
5072 Dorsey Hall Drive, Suite 202, Ellicott City, Maryland 21024  
(410) 997-0296 Balt. (301) 621-5521 Wash. (410) 997-0298 Fax

[Handwritten signature and initials]

engineering	AMC				
illustration	AMC				
approval	JBM				
project	03029	KCI	2	AS BUILT REVISED	FILED
date	JULY 2004	KCI	1	AS BUILT DATA SHOWN	FILED
BY	NO.			REVISION	DATE

**SEWER PROFILES**  
DATE: 7/15/06  
SCALE: 1"=50' SCALE MAP NO. 16 BLOCK NO. 10 & 16

**TURF VALLEY  
PROFESSIONAL BUILDINGS**  
CONTRACT NO.: 20-4048-D  
THIRD ELECTION DISTRICT  
HOWARD COUNTY

scale  
AS SHOWN  
3 OF 3

H:\010521.dwg\_P8 F:\plans\New\Inad-sewer-profl1rev.dwg