

COORDINATE TABLE		
①	12"x 8" T.S. & V.	E 1352094
②	8" CAP	E 1352261

COORDINATE TABLE		
①	MH 200	E 1352094
②	MH 201	E 1352060
③	MH 202	E 1352260
④	MH 203	E 1352246
⑤	MH 204	E 1351720

**AS BUILT**  
DATE: MARCH 04, 2005

GLW FILE #48121  
v52.dwg

DEPARTMENT OF PUBLIC WORKS  
HOWARD COUNTY, MARYLAND  
BUREAU OF UTILITIES  
DATE: 10/21/04


DEPARTMENT OF PLANNING AND ZONING  
HOWARD COUNTY, MARYLAND  
CHIEF, DEVELOPMENT ENGINEERING DIVISION  
DATE: 4/1/04

**GLW GUTSCHICK LITTLE & WEBER, P.A.**  
CIVIL ENGINEERS, LAND SURVEYORS, LAND PLANNERS, LANDSCAPE ARCHITECTS  
3909 NATIONAL DRIVE - SUITE 250 - BURTONSVILLE OFFICE PARK  
BURTONSVILLE, MARYLAND 20866  
TEL: 301-421-4024 BAL: 410-860-1820 DC/VA: 301-989-2524 FAX: 301-421-4186



DES:	HWJ				
DRN:	HWJ				
CHK:	rot				
DATE:	OCT, 2003	BY:	NO	REVISION:	DATE:

WATER and SEWER EXTENSION PLAN  
600' SCALE MAP NO. 30 & 36 BLOCK NO. 14 & 1

**COLUMBIA TOWN CENTER**  
SECTION 2 AREA 1  
LOT 39  
CONTRACT No. 24-4135-D  
SHEET 2 OF 3

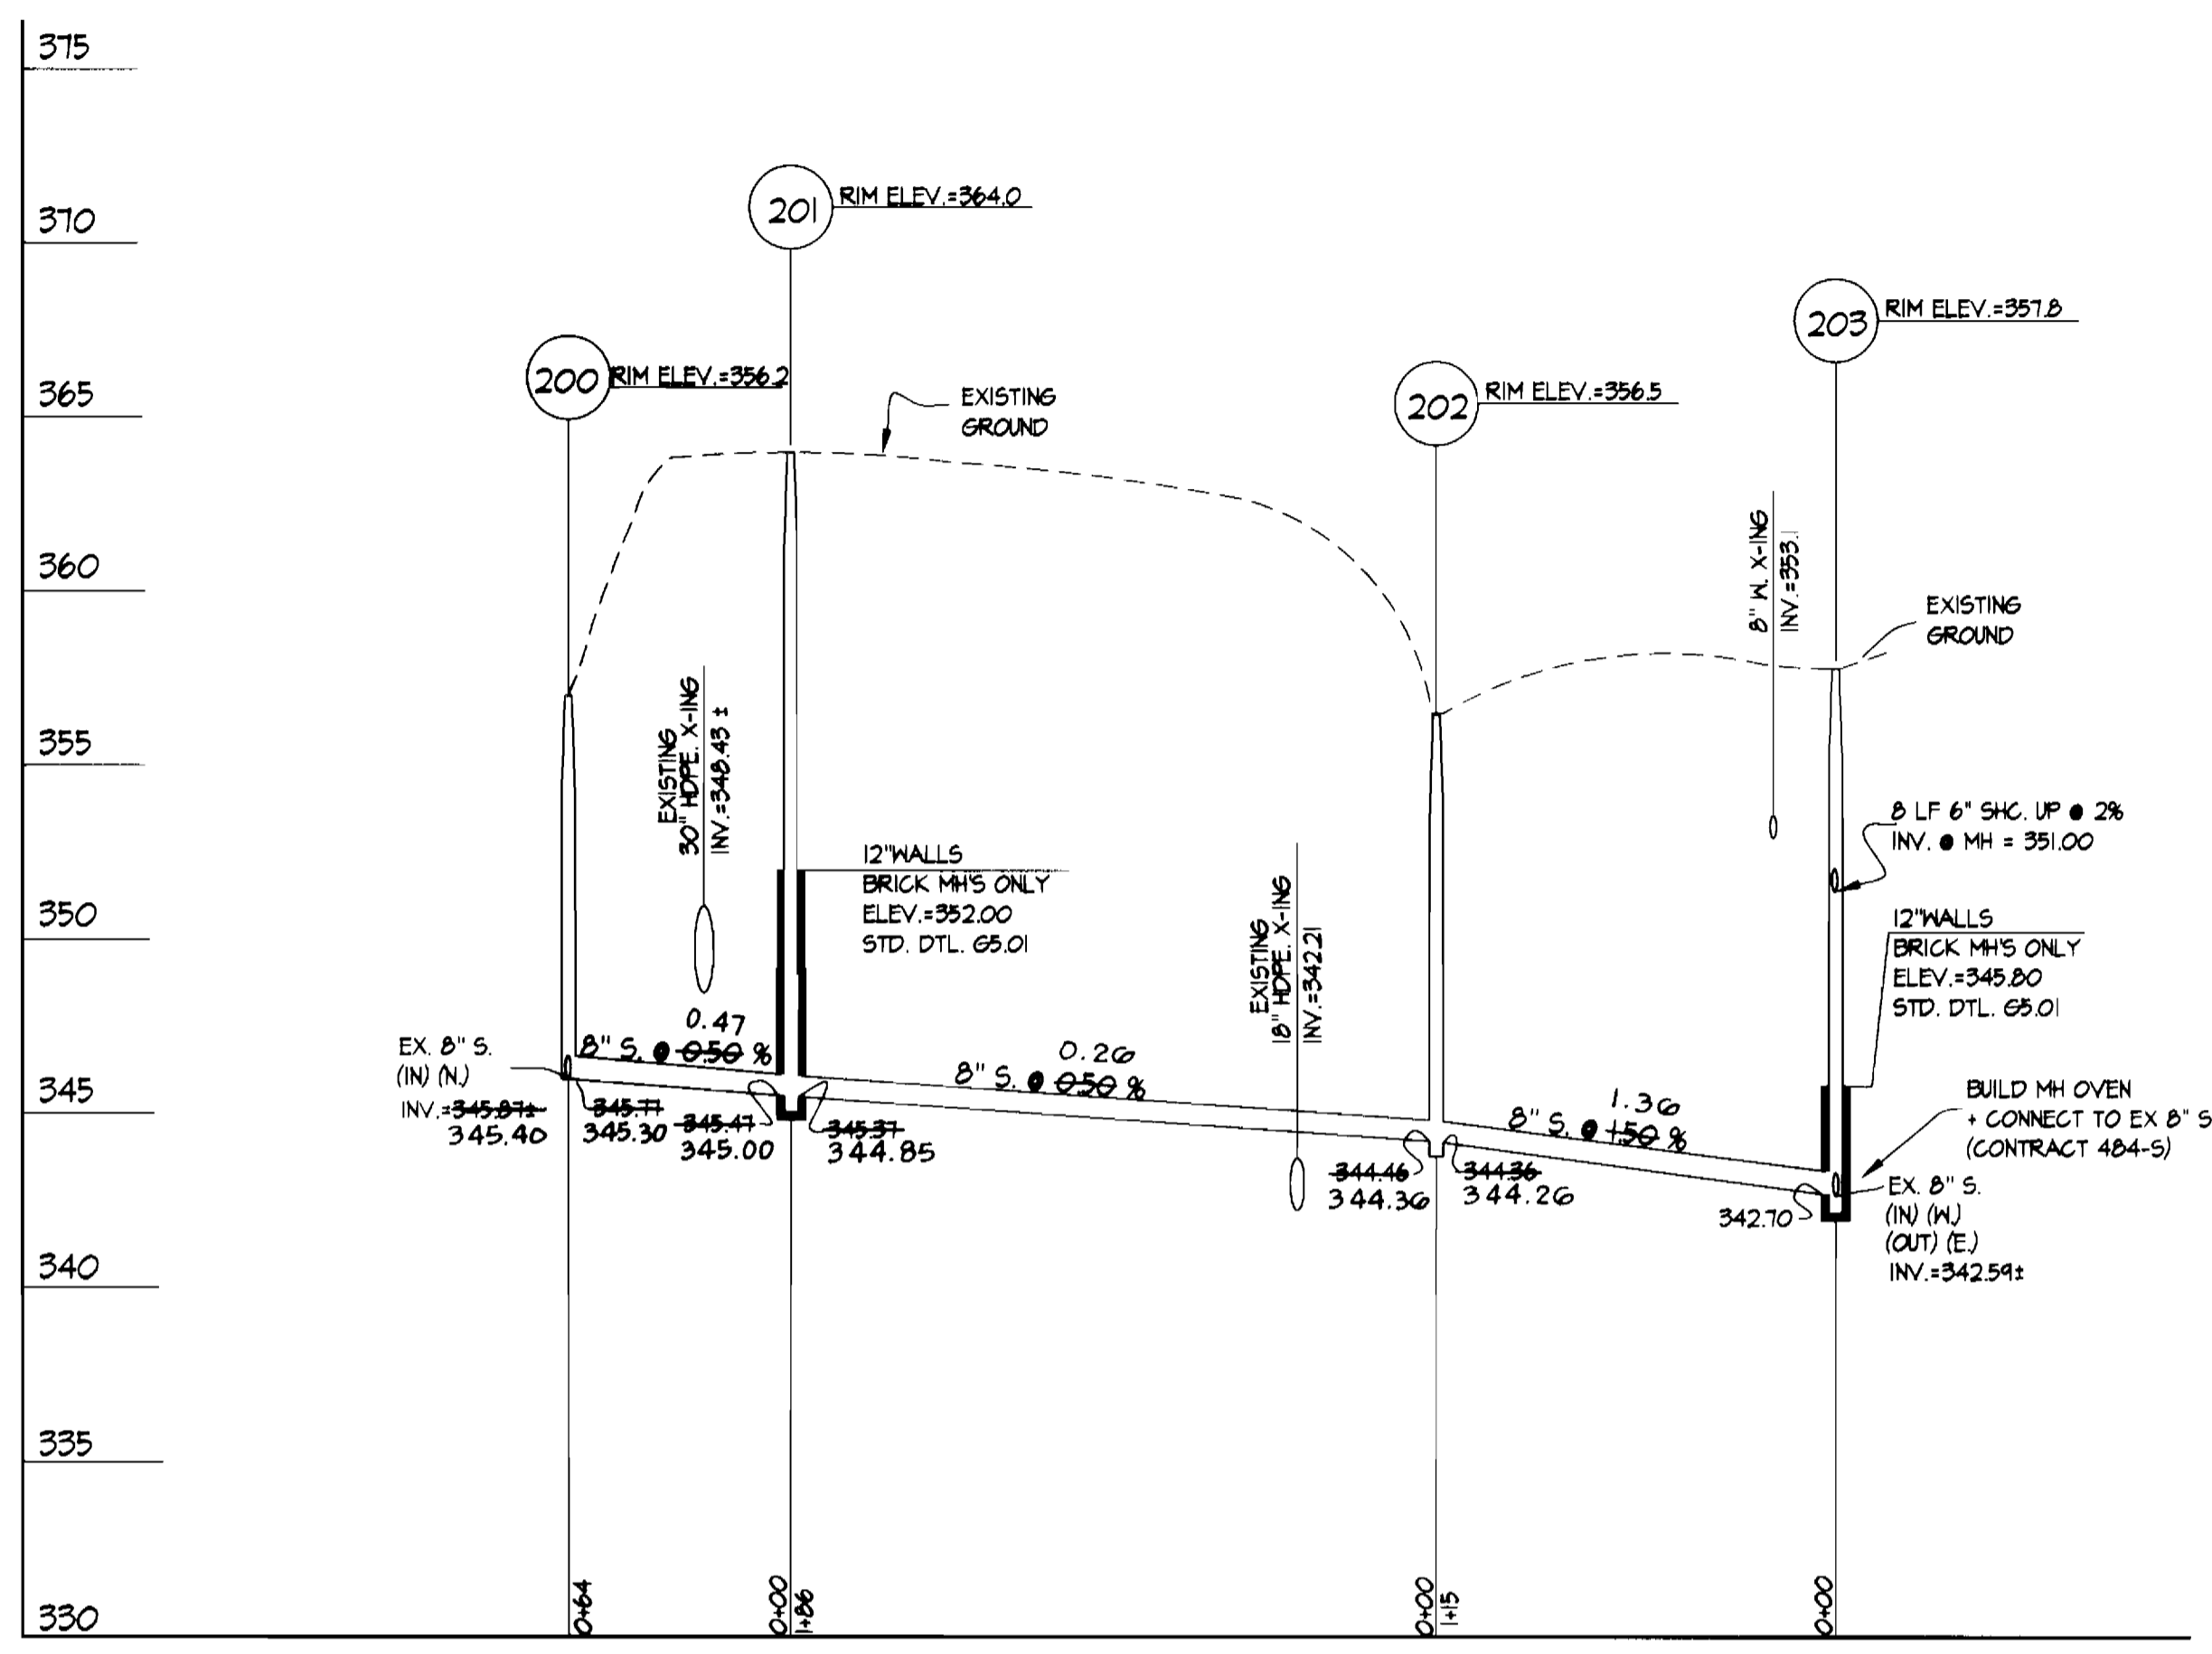

PROFILE SCALES:  
HORIZONTAL: 1" = 50'  
VERTICAL: 1" = 5'

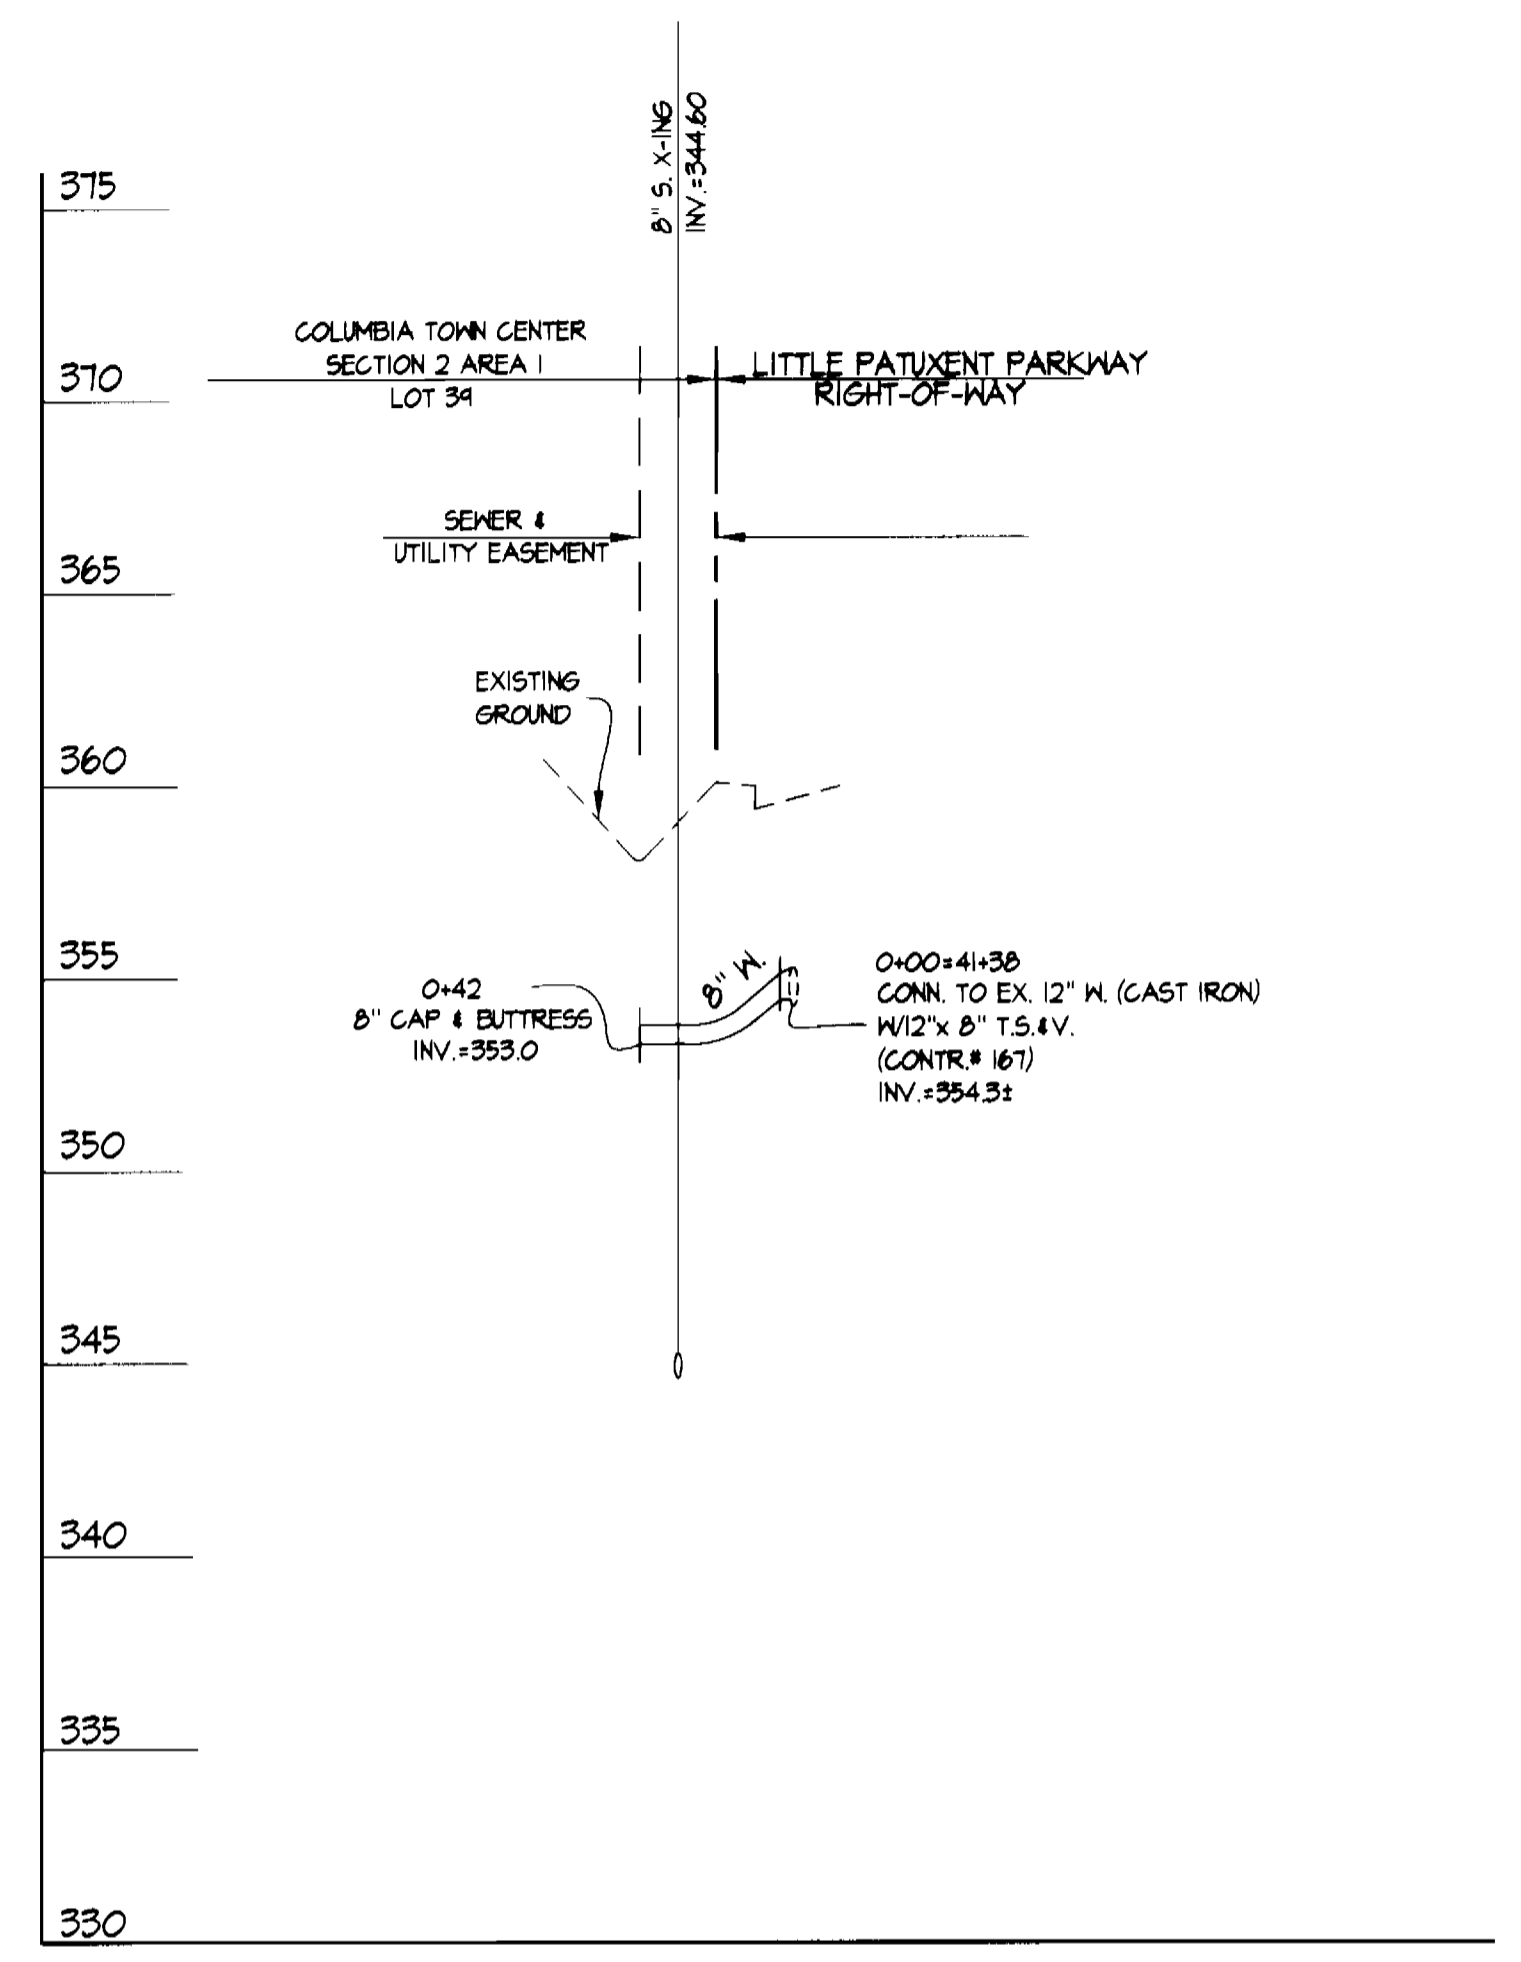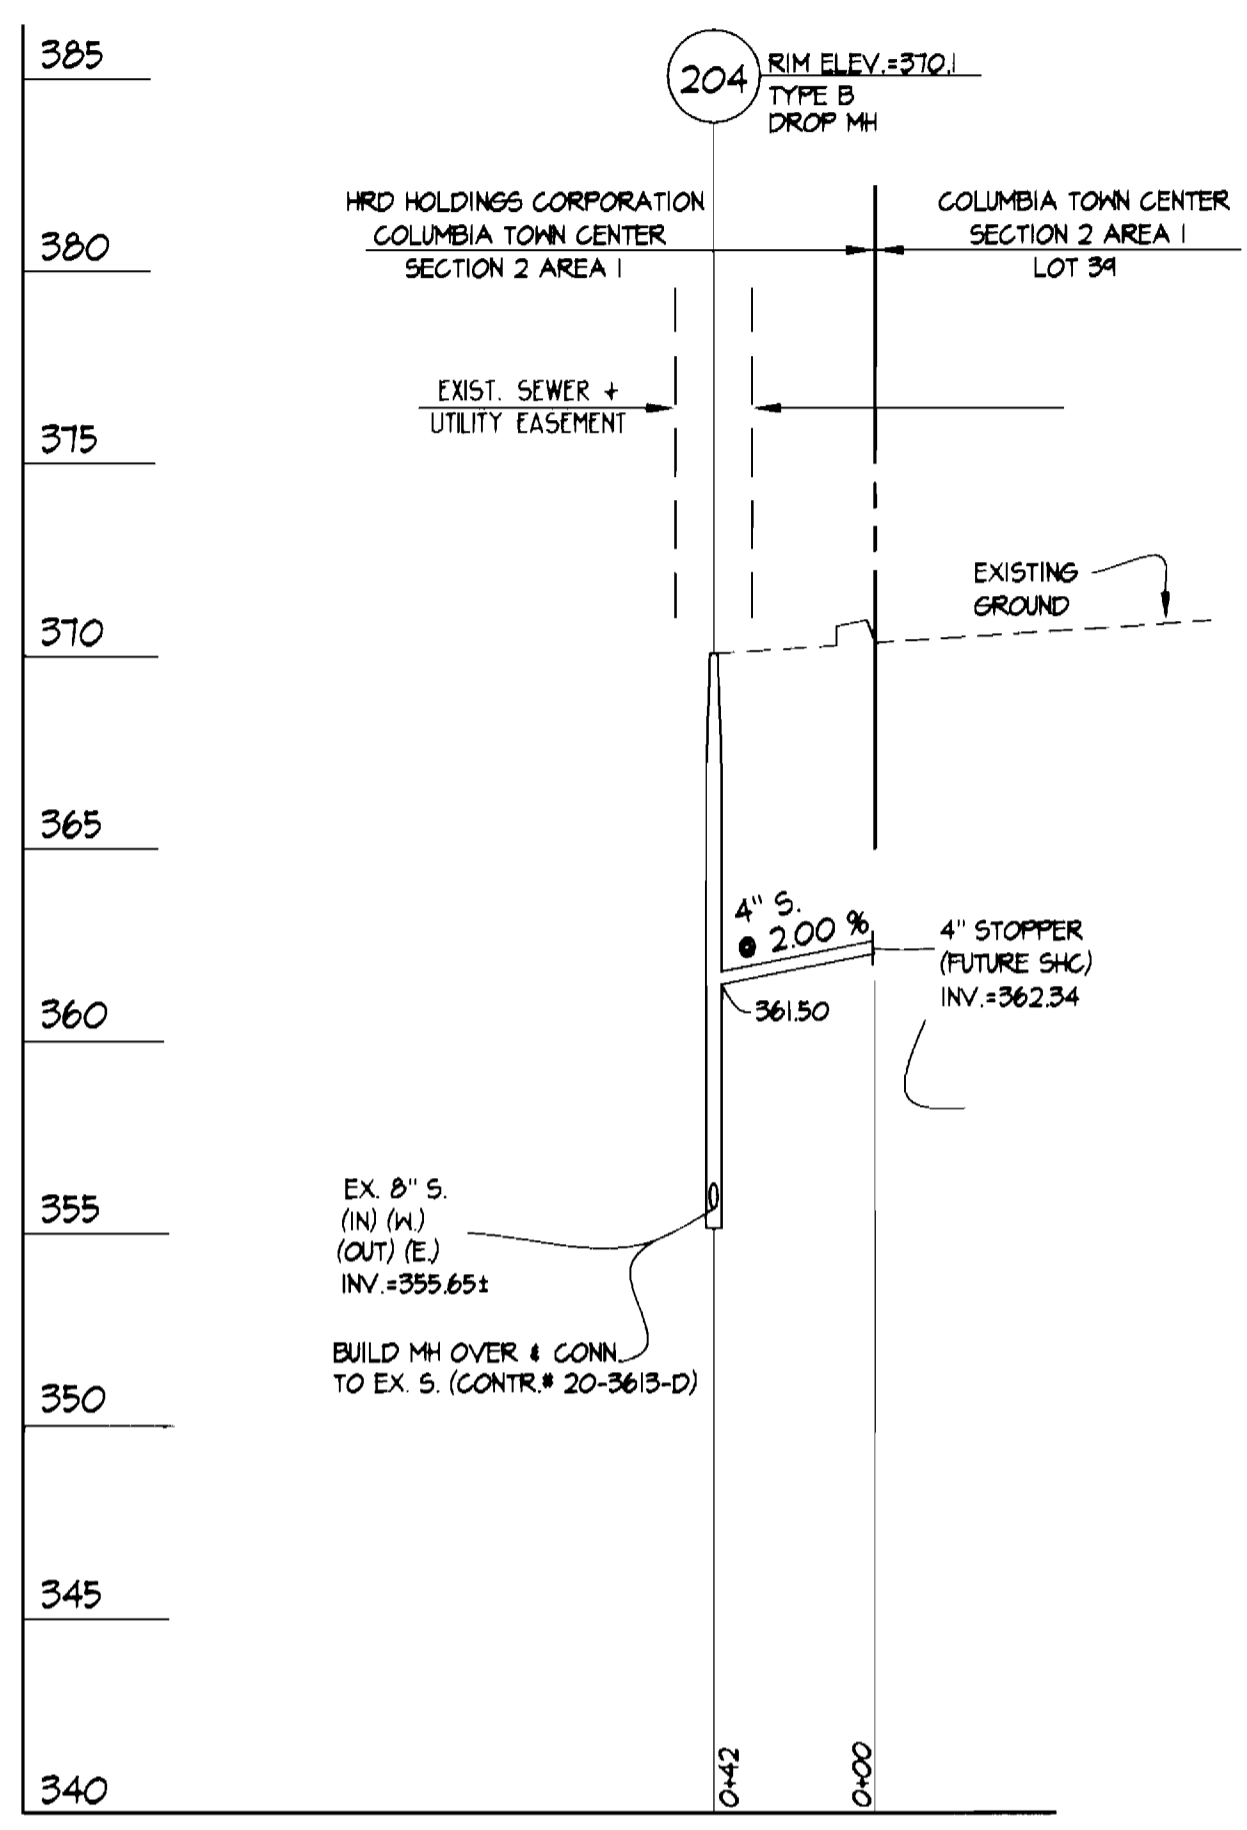

**AS BUILT**  
DATE MARCH 04, 2005

GLW FILE #98121  
w53.dwg

DEPARTMENT OF PUBLIC WORKS  
HOWARD COUNTY, MARYLAND  
*[Signature]*  
BUREAU OF UTILITIES DATE

DEPARTMENT OF PLANNING AND ZONING  
HOWARD COUNTY, MARYLAND  
*[Signature]* 11/1/04  
CHIEF, DEVELOPMENT ENGINEERING DIVISION DATE

**GLW GUTSCHICK LITTLE & WEBER, P.A.**  
CIVIL ENGINEERS, LAND SURVEYORS, LAND PLANNERS, LANDSCAPE ARCHITECTS  
3909 NATIONAL DRIVE - SUITE 250 - BURTONSVILLE OFFICE PARK  
BURTONSVILLE, MARYLAND 20866  
TEL: 301-421-4024 BAL: 410-880-1820 DC/VA: 301-989-2524 FAX: 301-421-4186

DES:	MSJ				
DRN:	MSJ				
CHK:	rgt.				
DATE:	OCT. 2003	BY:	NO	REVISION:	DATE:

WATER and SEWER EXTENSION  
PROFILES  
600' SCALE MAP NO. 30 & 36 BLOCK NO. 19 & 1

**COLUMBIA TOWN CENTER**  
SECTION 2 AREA I  
LOT 39  
CONTRACT No. 24-4135-D

SCALE AS SHOWN  
SHEET 3 OF 3