


PUBLIC SEWER PLANS


THE PADDOCKS EAST

HOWARD COUNTY, MARYLAND

CONTRACT NO. 50-4156-D

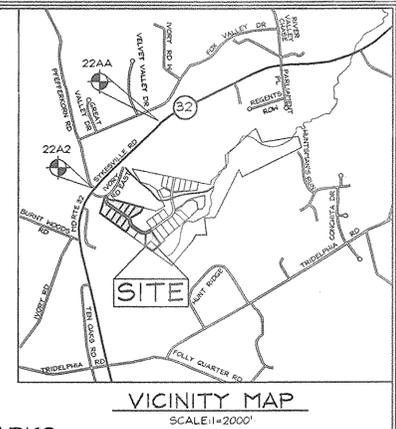

QUANTITIES				
NAME OF UTILITY CONTRACTOR :				
SURVEY AND DRAFTING DIVISION AS-BUILT DATE :				
ITEMS	QUANTITIES ESTIMATED	AS-BUILT		
		QUANTITIES	TYPE	MANUFACTURER/SUPPLIER
Transition Manhole	1	1	PRECAST	ATLANTIC
3,000 Gallon Septic Tank	1	1	"	MAYER BROTHERS
6,700 Gallon Septic Tank	1	1	"	"
NitriFast (®) 4.5 System	1	1	"	CAN NOT READ!
10'X18' Prefabricated Storage Shed	1	1	PREFAB	RIQGE CABUET
Split Rail Fence	717 LF			
Entrance Gate	1			
2018-129 Duplex Grinder Pump	4	4	ENVIRONMENTAL	
Union Ball Valve Assembly	5	5	BRASS	HAMMOND
Clean Outs (GP Location)	8	8	P.V.C.	CHARLOTTE
Distribution Lateral (Phase 1)	16	16	P.V.C.	"
10' Turf Box w/Lid	43	43		CARSON
Monitoring Well	3	3		? GEOMETRIX ENG ?
Distribution Boxes (Phase 1)	2	2	PRECAST	MAYER BROTHERS
4" Sewer Flugs (For Distribution Box 3)	20	20	PVC	CHARLOTTE
4" Sewer Valve	3	19	RSMJ	KENNEDY
Clean Outs (Distribution Box 1)	19	19	P.V.C.	CHARLOTTE
Elect. Conduit (Blower)	200 LF	200	"	ALLIEO
1 1/2" X 1/2" Reducer (GP Location)	4	4	"	CHARLOTTE
1 1/2" X 2" Split Wye Branches	4	4	"	"
2" X 4" Reducer (TPH Location)	1	1	"	"
Vert. 1 1/2" PS 45° Bends	8	8	"	"
Hor. 1 1/2" PS 45° Bends	4	4	P.V.C.	"
Hor. 2" PS 45° Bends	4	4	"	"
Hor. 4" PS 45° Bend	1	1	"	"
Vert. 2" PS 45° Bends	2	2	"	"
1 1/2" FS	120 LF	120	"	"
2" PS	1178 LF	1178	"	"
4" PS (TPH Location)	2 LF	2	"	"
4" SHC (GP Location)	32 LF	32	"	"
4" Sewer	129 LF	129	"	"
3" Air PVC (Blower)	72 LF			
PVC Laterals (Distribution Box 1)	755 LF	755	P.V.C.	CHARLOTTE
4" SDR-21 Septic Trench (Phase 1)	1650 LF	1,650	"	"

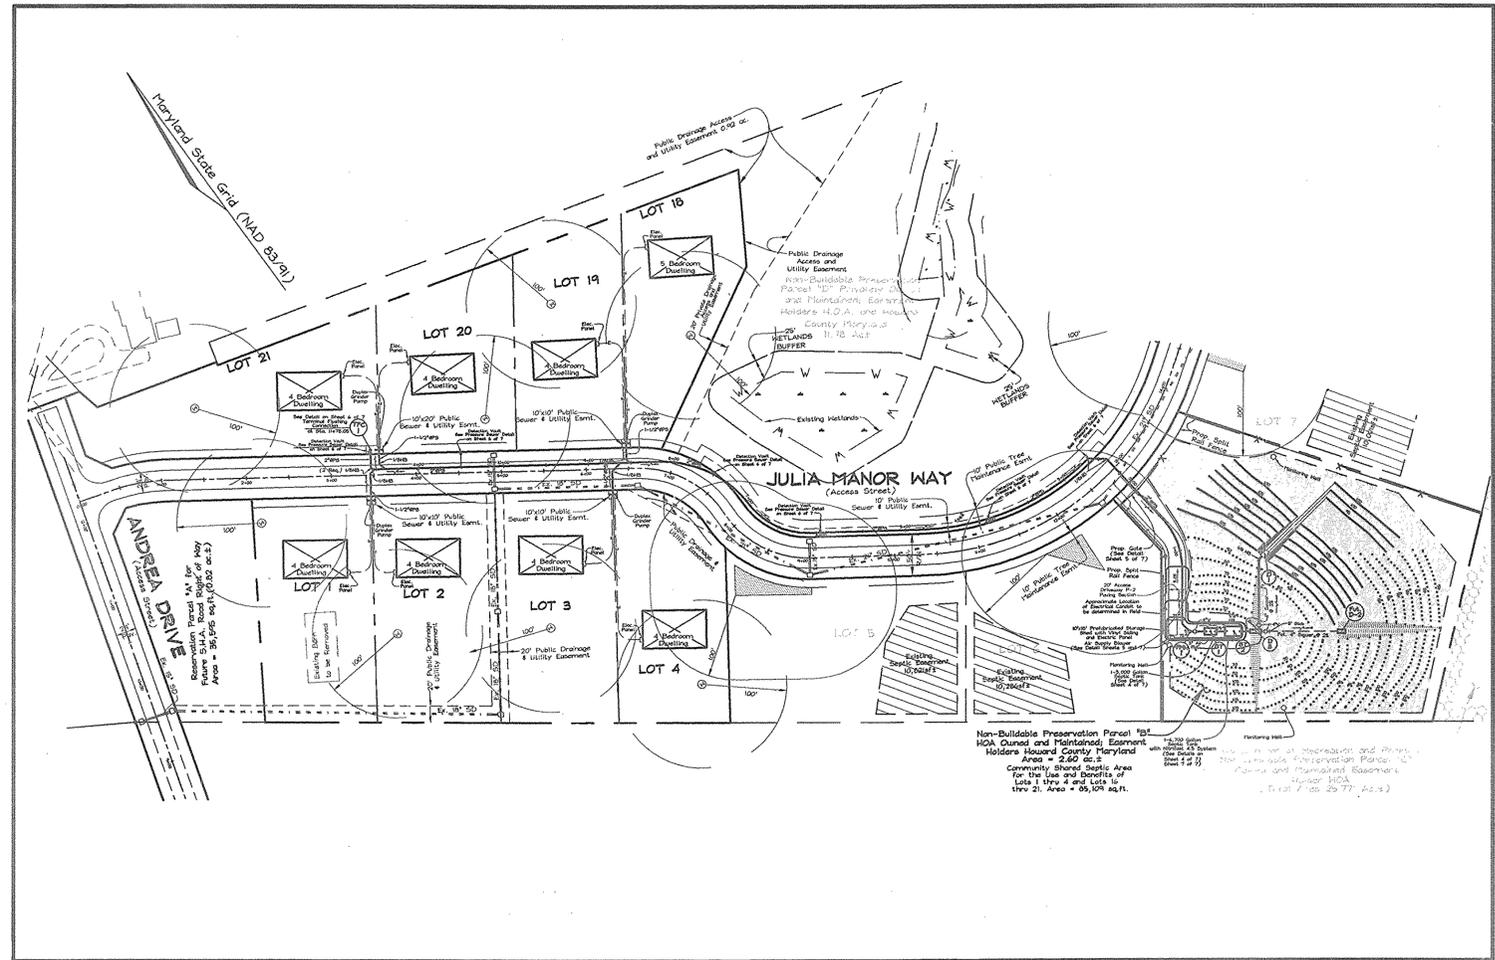

OWNER/DEVELOPER
 PULTE HOME CORPORATION
 1501 S. EDGEMOOR STREET
 SUITE K
 BALTIMORE, MARYLAND 21227

SEWAGE DESIGN FLOW CALCULATIONS	
CONSTRUCTION PHASE	MAX. SEWAGE FLOW
PHASE I	PHASE I
Minimum Flow per Bedroom = 150 GPD	
7 Dwellings with 4 Bedrooms = 4,200 GPD	
(Lots 1,2,3,4,19,20 and 21)	
1 Dwelling with 5 Bedrooms = 750 GPD	
(Lot 18)	
+	
4,950 GPD	5,000 GPD

SEPTIC TANK DESIGN CALCULATIONS	
SIZE OF REQUIRED TANKS	TANK SIZES
7 Dwellings x 1,250 Gallons = 8,750 Gallons	
1 Dwellings x 1,500 Gallons = 1,500 Gallons	
+	
10,250 Gallons	Provide one 3,000 Gallon Tank and one 6,700 Gallon Tank with NitriFast 4.5 System

TRENCH DESIGN CHART		
CONSTRUCTION PHASE	MAX. SEWAGE FLOW	MAX. TRENCH LENGTH
PHASE I	4950 GPD	1650 LF
PHASE 2	4750 GPD	1650 LF
PHASE 3	4950 GPD	1650 LF

Note: Distribution Boxes D-1 and D-3 shall be built first (at Phase I). D-2 shall be built in the future.

- * 10'X18' Vinyl Sided Storage Building. High wall barn style with 6 foot side walls and no windows. One double door on one end of the building. Specifications to include:
- 4"X4" pressure treated skid.
 - 2"X4" floor joists 16" on center.
 - 2"X4" studs 16" on center.
 - All walls shall be plated at the bottom and double plated at the top.
 - 3/8" roof sheathing.
 - 240 pound asphalt, 20 year shingle.
 - doors are to be reinforced with "X" pattern.
 - Door hinges must be "T" type or strap type. Three hinges per door side.
 - Vinyl siding color = Almond

SEDIMENT CONTROL MEASURES WILL BE IMPLEMENTED IN ACCORDANCE WITH SECTION 219 OF THE STANDARD SPECIFICATIONS AND WITH ROAD CONSTRUCTION PLANS F-03-112

THIS DEVELOPMENT IS APPROVED FOR SOIL EROSION AND SEDIMENT CONTROL BY THE HOWARD COUNTY SOIL CONSERVATION DISTRICT.

REVIEWED FOR HOWARD COUNTY SOIL CONSERVATION DISTRICT AND MEETS TECHNICAL REQUIREMENTS.

[Signature] 1/22/09 DATE

[Signature] 1/22/09 DATE

DEPARTMENT OF PUBLIC WORKS
HOWARD COUNTY, MARYLAND

[Signature] 1-6-09
CHIEF, BUREAU OF UTILITIES

DEPARTMENT OF PLANNING & ZONING
HOWARD COUNTY, MARYLAND

[Signature] 2/17/09
CHIEF, DEVELOPMENT ENGINEERING DIVISION

FSH Associates
 Engineers Planners Surveyors
 8318 Forrest Street, Ellicott City, MD 21043
 Tel: 410-750-2251 Fax: 410-750-7330
 E-mail: FSHAssociates@cs.com

DESIGN BY: Mike Mitchell
 DRAWN BY: Mike Mitchell
 CHECKED BY: ZYF
 DATE: Dec. 12, 2003

TYPE OF BUILDING:	Single Family Dwelling
NO. OF LOTS/PARCELS:	8
NO. OF WATER HOUSE CONNECTIONS:	NA
NO. OF SEWER HOUSE CONNECTIONS:	8
DRAINAGE AREA:	Middle Patuxent
TREATMENT PLANT:	The Paddocks East Shared Septic System
WATER & SEWER COUNTY CODE	
WATER CODE:	N/A
SEWER CODE:	N/A
TEST GRADIENT:	N/A




SEWER PLAN

600' SCALE MAP NO. 22 BLOCK NO.: 8

THE PADDOCKS EAST
 LOTS 1-4, 18-21, AND
 NON-BUILDABLE PRESERVATION PARCEL '5'
 CONTRACT NO. 50-4156-D
 TAX MAP #22 GRID 8 PARCEL 7
 3RD ELECTION DISTRICT HOWARD COUNTY, MARYLAND

SCALE AS SHOWN

SHEET NO. 1 OF 7

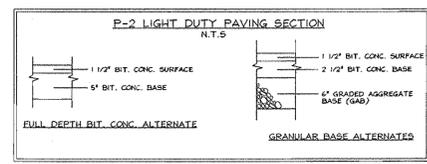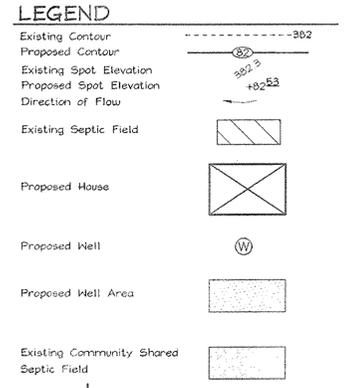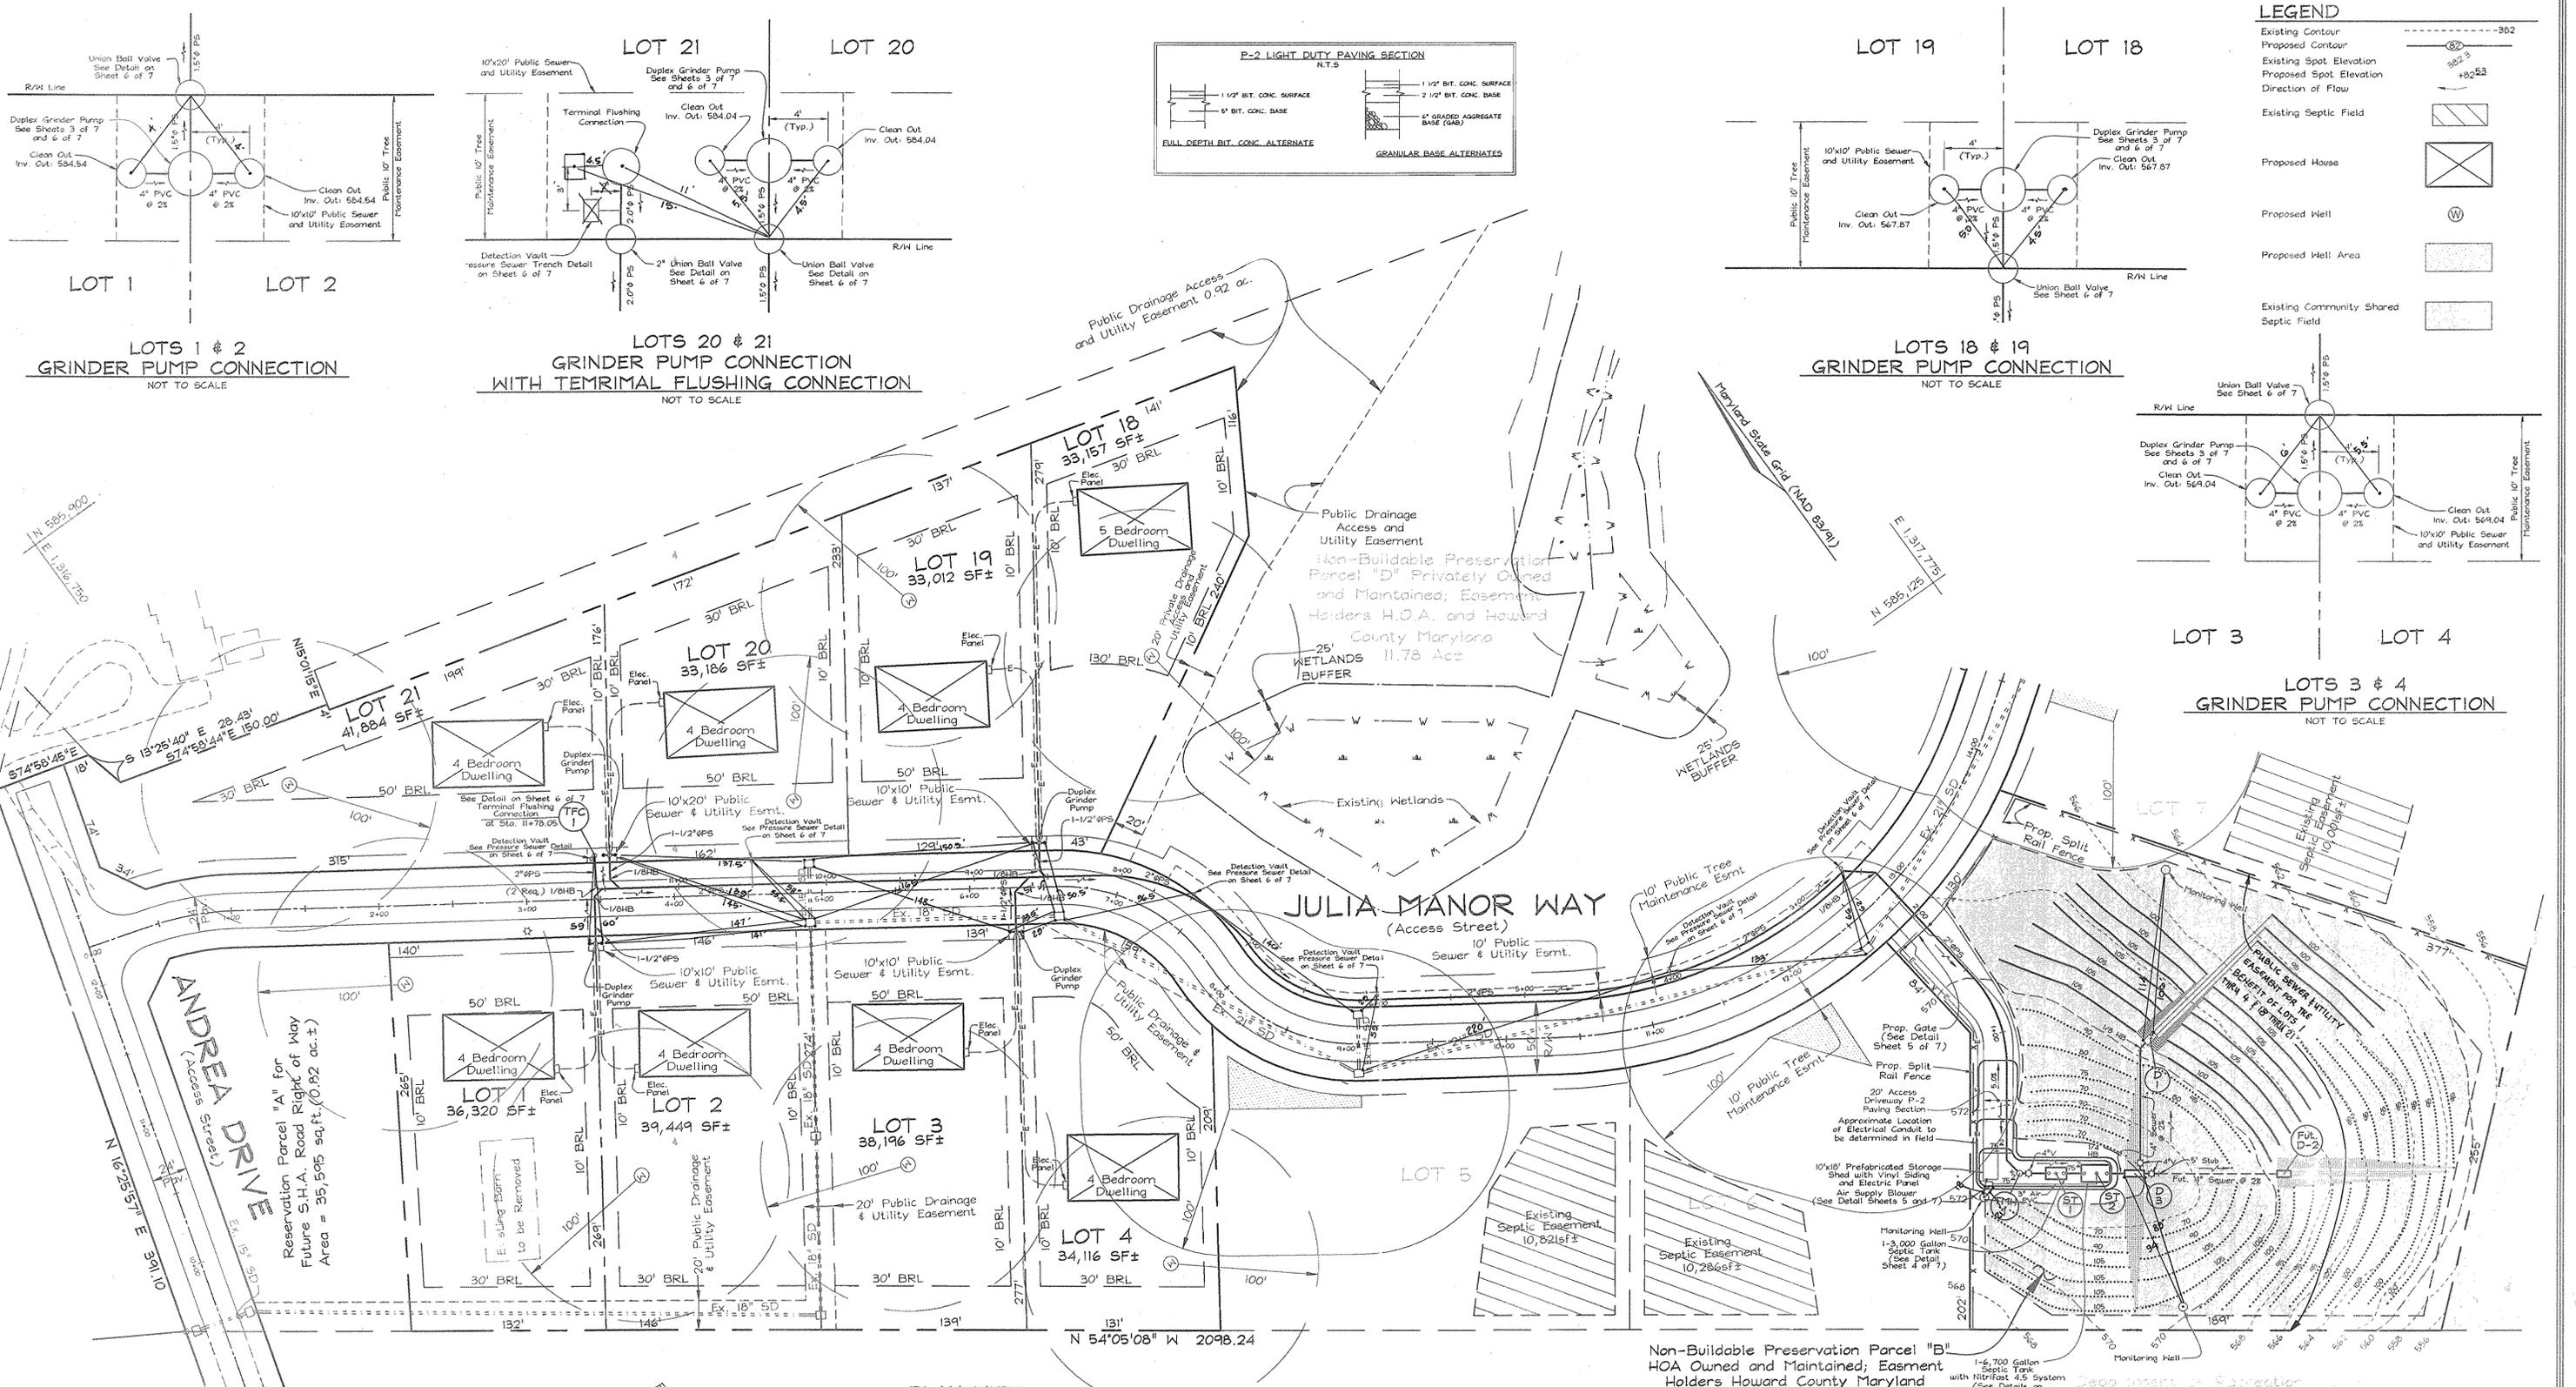

LOTS 1 & 2
GRINDER PUMP CONNECTION
NOT TO SCALE

LOTS 20 & 21
GRINDER PUMP CONNECTION
WITH TERMINAL FLUSHING CONNECTION
NOT TO SCALE

LOTS 18 & 19
GRINDER PUMP CONNECTION
NOT TO SCALE

LOTS 3 & 4
GRINDER PUMP CONNECTION
NOT TO SCALE

PLAN VIEW
SCALE: 1"=50'

OWNER/DEVELOPER
PULTE HOME CORPORATION
1501 S. EDGEWOOD STREET
SUITE K
BALTIMORE, MARYLAND 21227

Non-Buildable Preservation Parcel "B"
HOA Owned and Maintained; Easement
Holders Howard County Maryland
Area = 2.60 ac.±
Community Shared Septic Area
for the Use and Benefits of
Lots 1 thru 4 and Lots 18
thru 21. Area = 85,109 sq.ft.

1-6,700 Gallon
Septic Tank
with
Nitrofast 4.5 System
(See Details on
Sheet 4 of 7)
Sheet 7 of 7)

APPROVED FOR PRIVATE WATER AND PUBLIC SEWERAGE SYSTEMS
HOWARD COUNTY HEALTH DEPARTMENT
Paula Beatty, M.P.S.E.
COUNTY HEALTH OFFICER
3-12-07
DATE

DEPARTMENT OF PUBLIC WORKS
HOWARD COUNTY, MARYLAND
Ralph Berman
CHIEF, BUREAU OF UTILITIES
1-6-04
DATE

DEPARTMENT OF PLANNING & ZONING
HOWARD COUNTY, MARYLAND
William Dammann
CHIEF, DEVELOPMENT ENGINEERING DIVISION
2/17/04
DATE

FSH Associates
Engineers Planners Surveyors
8318 Forrest Street, Elkridge, MD 21043
Tel: 410-750-2251 Fax: 410-750-7355
E-mail: FSHAssociates@cs.com



DESIGN BY: Mike Mitchell
DRAWN BY: Mike Mitchell
CHECKED BY: ZYF
DATE: Dec. 11, 2003



NO.	REVISION	DATE
K01	1	ADDUCT DATA
BY NO.		

DATE: 10/10/06


SEWER PLAN
600' SCALE MAP NO.: 22 BLOCK NO.: 8

THE PADDOCKS EAST
LOTS 1-4, 18-21, AND
NON-BUILDABLE PRESERVATION PARCEL "B"
CONTRACT NO. 50-4156-D
TAX MAP #22 GRID 8
3RD ELECTION DISTRICT
PARCEL 7
HOWARD COUNTY, MARYLAND

SCALE AS SHOWN
SHEET NO. 2 OF 7

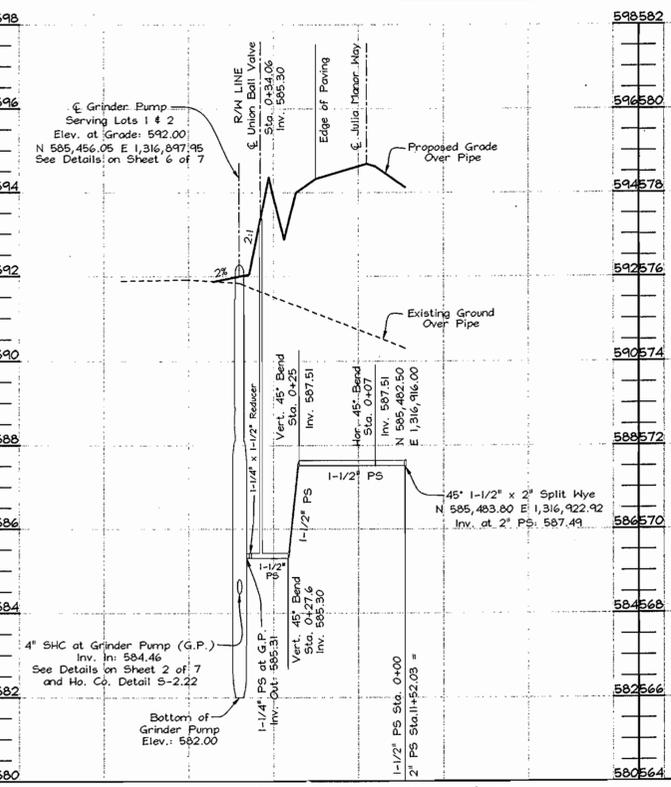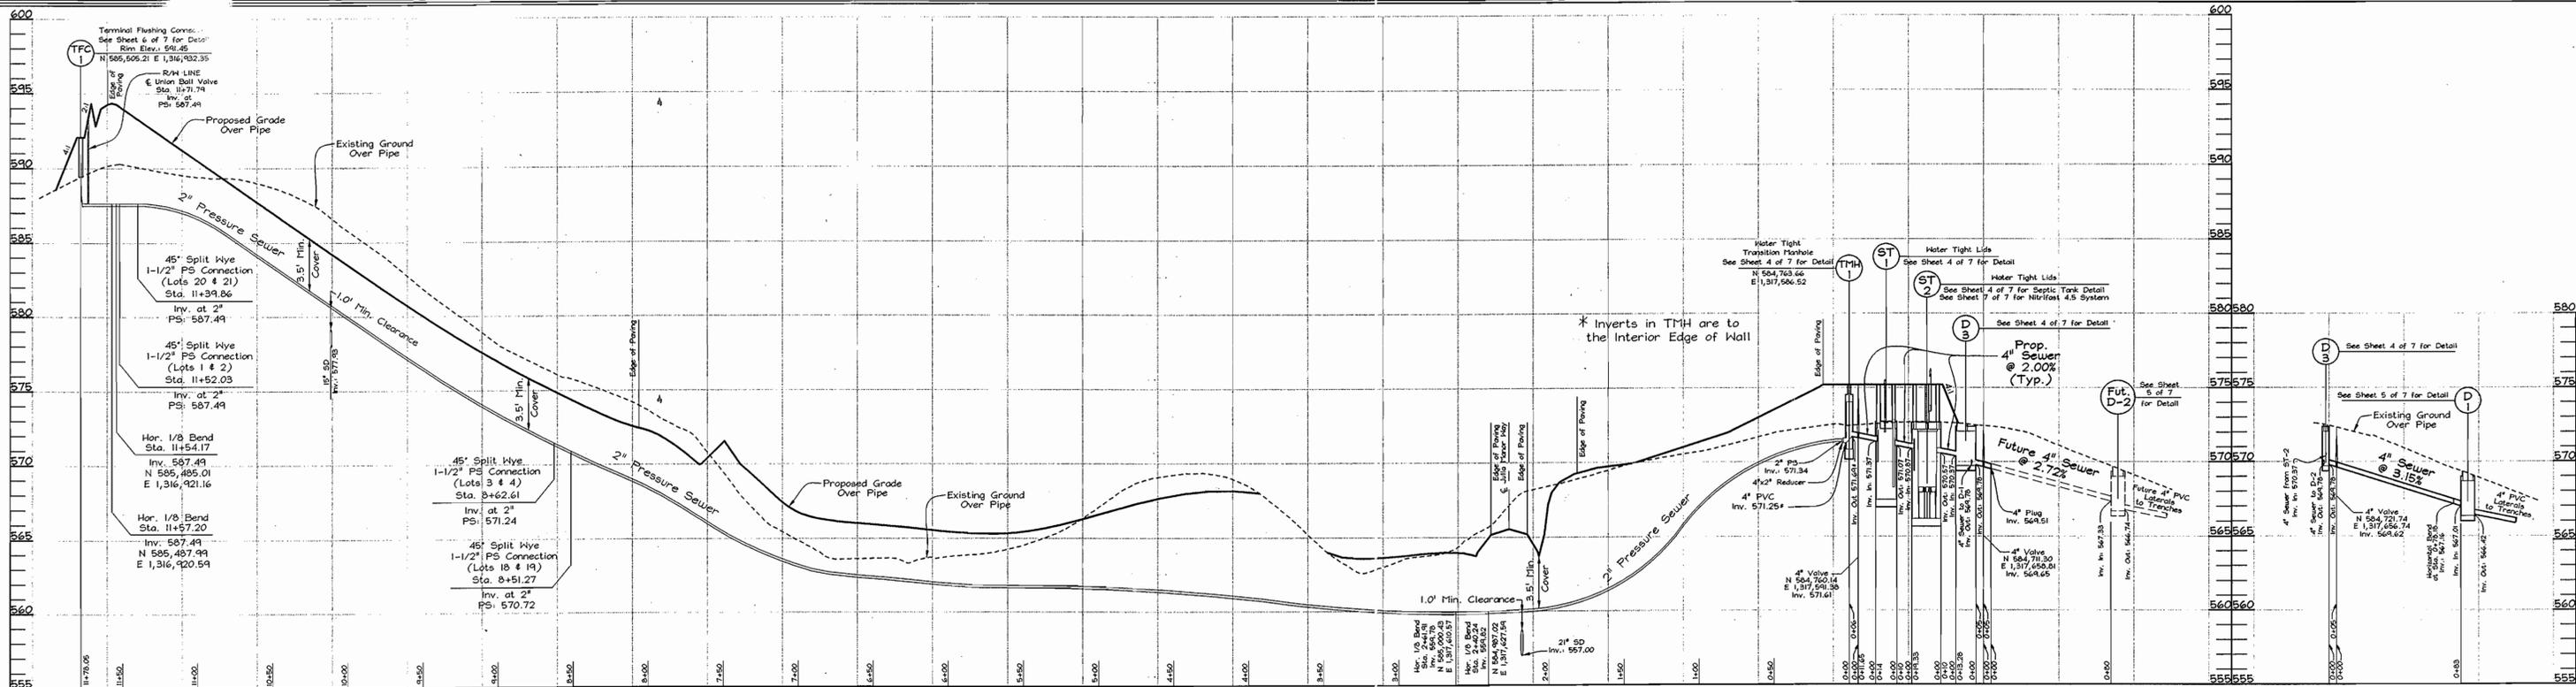


CONNECTION DETAIL LOTS 1 & 2
SCALE: 1" = 20' HORIZ.
1" = 2' VERT.

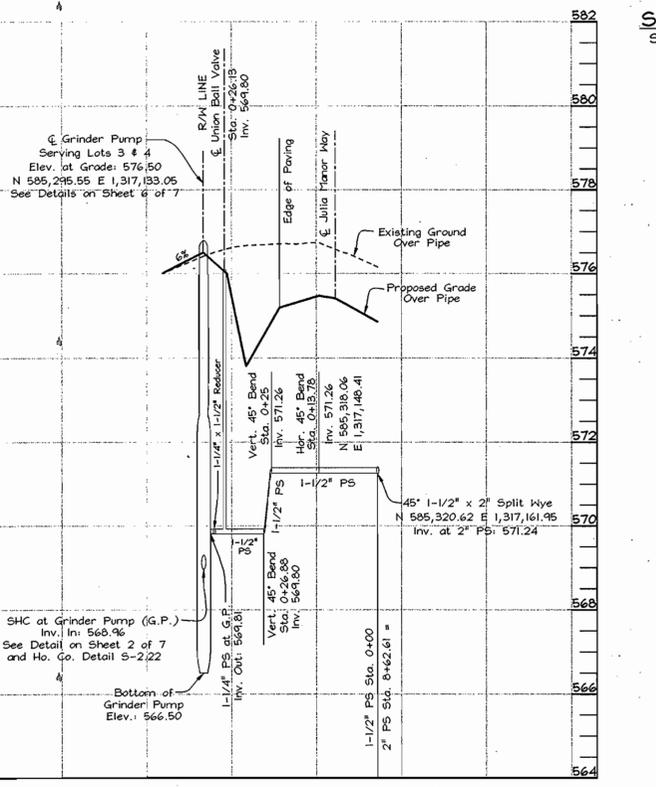

CONNECTION DETAIL LOTS 3 & 4
SCALE: 1" = 20' HORIZ.
1" = 2' VERT.

SEWER PROFILE
SCALE: 1" = 50' HORIZ.
1" = 5' VERT.

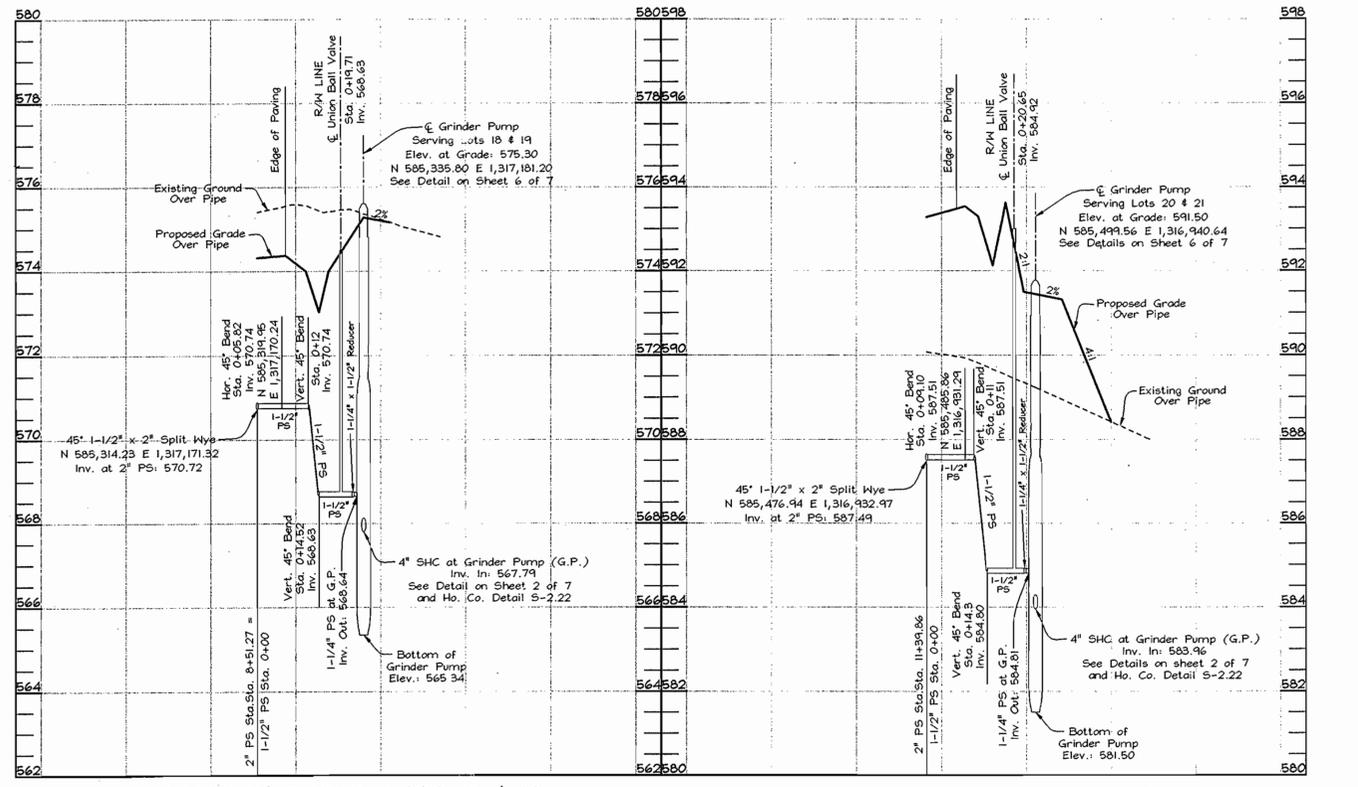

CONNECTION DETAIL LOTS 18 & 19
SCALE: 1" = 20' HORIZ.
1" = 2' VERT.


CONNECTION DETAIL LOTS 20 & 21
SCALE: 1" = 20' HORIZ.
1" = 2' VERT.

APPROVED FOR PRIVATE WATER AND PUBLIC SEWERAGE SYSTEMS
HOWARD COUNTY HEALTH DEPARTMENT
Diana B. ...
COUNTY HEALTH OFFICER
DATE: 2-12-04

DEPARTMENT OF PUBLIC WORKS
HOWARD COUNTY, MARYLAND
Robert ...
CHIEF, BUREAU OF UTILITIES
DATE: 1-6-04

DEPARTMENT OF PLANNING & ZONING
HOWARD COUNTY, MARYLAND
...
CHIEF, DEVELOPMENT ENGINEERING DIVISION
DATE: 2/17/04

FSH Associates
Engineers Planners Surveyors
8318 Forrest Street, Ellicott City, MD 21043
Tel: 410-750-2251 Fax: 410-750-7350
E-mail: FSHAssociates@cs.com

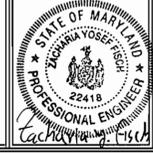

DESIGN BY: Mike Mitchell
DRAWN BY: Mike Mitchell
CHECKED BY: ZYF
DATE: Dec. 11, 2003



BY	NO.	REVISION	DATE

SEWER PROFILE AND DETAILS
600' SCALE MAP NO.: 22 BLOCK NO.: 8

THE PADDOCKS EAST
LOTS 1-4, 18-21, AND
NON-BUILDABLE PRESERVATION PARCEL 'B'
CONTRACT NO. 50-4156-D
TAX MAP 422 GRID 8 PARCEL 7
3RD ELECTION DISTRICT HOWARD COUNTY, MARYLAND

SCALE AS SHOWN
SHEET NO. 3 OF 7

OWNER/DEVELOPER
PULTE HOME CORPORATION
1501 S. EDGEMOOD STREET
SUITE K
BALTIMORE, MARYLAND 21227



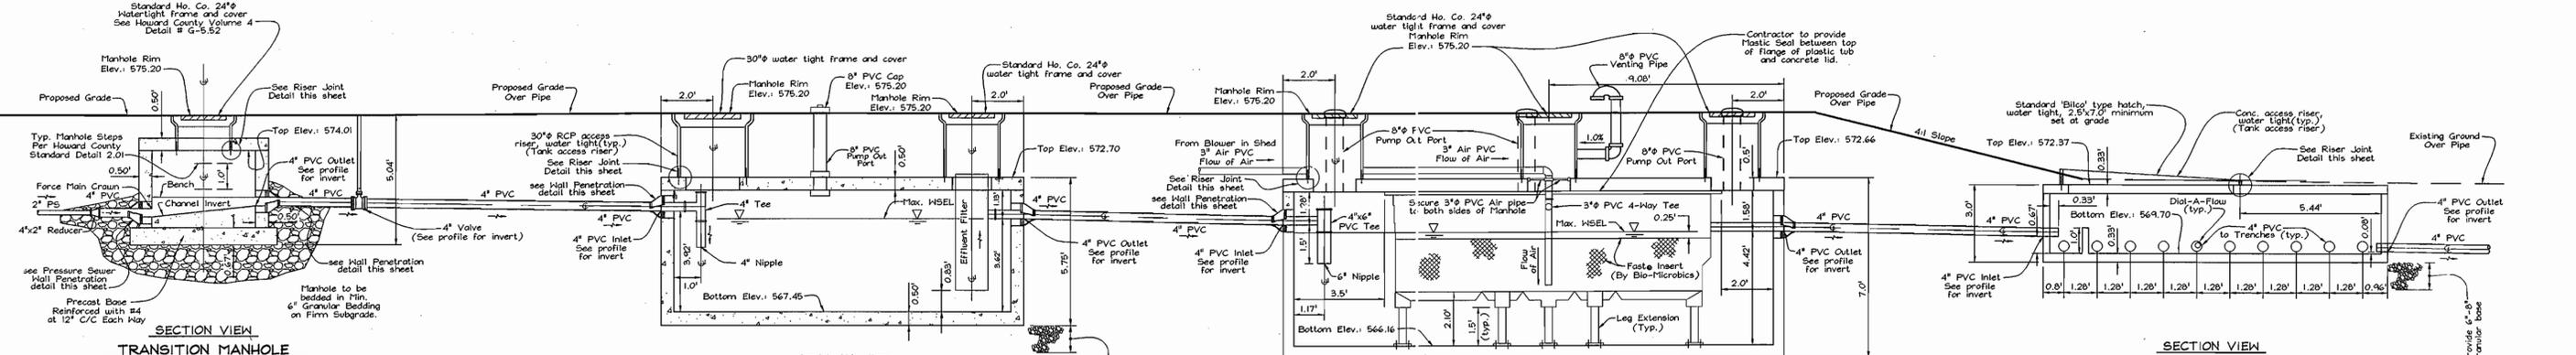
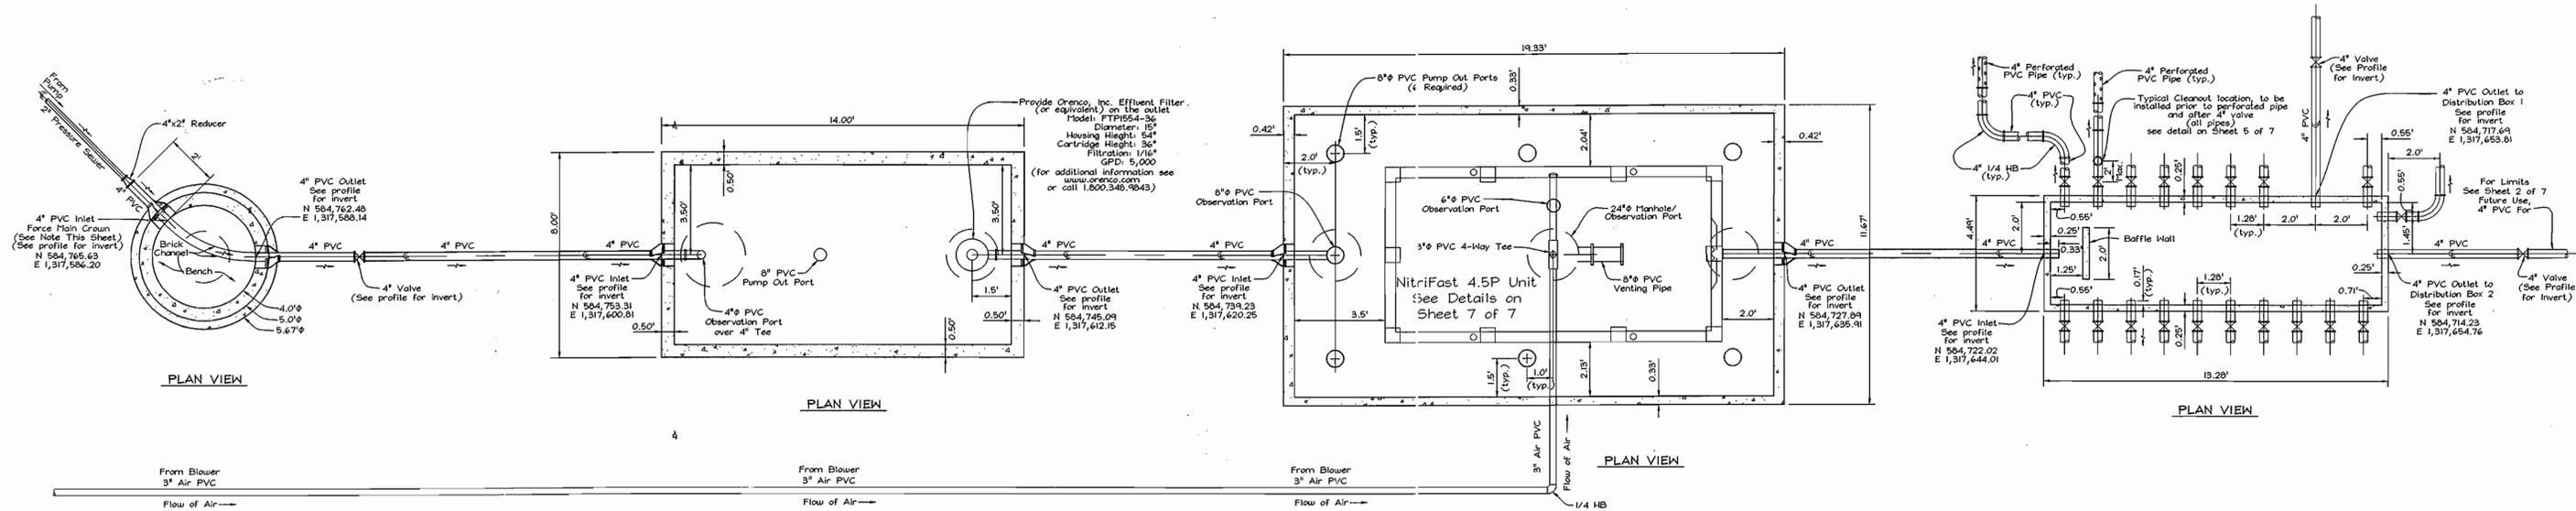


NOTES:

- Elevation of gravity sewer invert shall be a minimum of 0.1' above elevation of force main crown.
- Provide smooth upward sloping channel from force main to gravity sewer.

NOTE: To insure equal distribution to each manifold, provide "Dial-a-Flow" levelers from American Manufacturing Company, Inc. (or equivalent).

Part #	Size	Color
170-0038	4" Nominal - 4" ID 4' above	Green
170-0039	4" Nominal - Under 4" ID	Grey

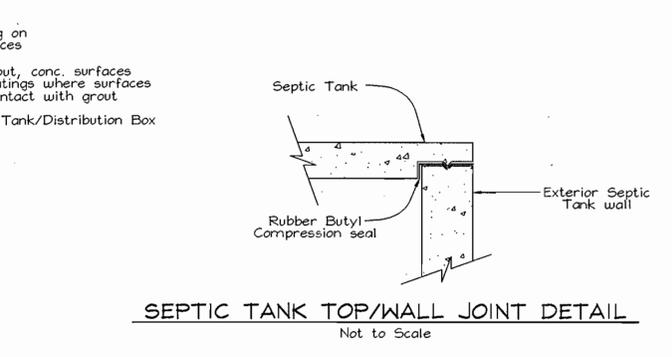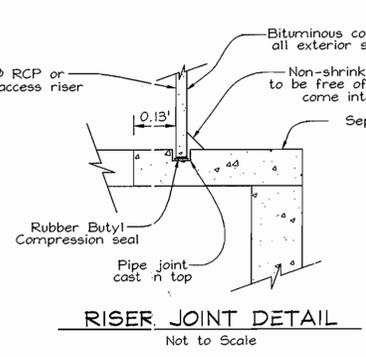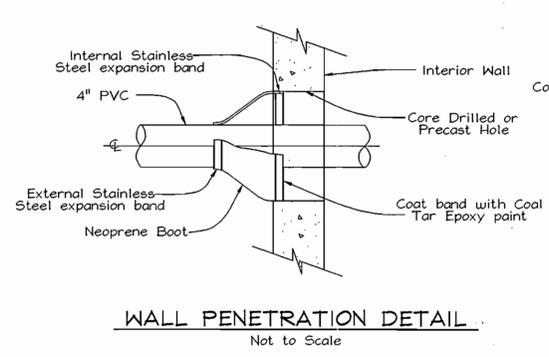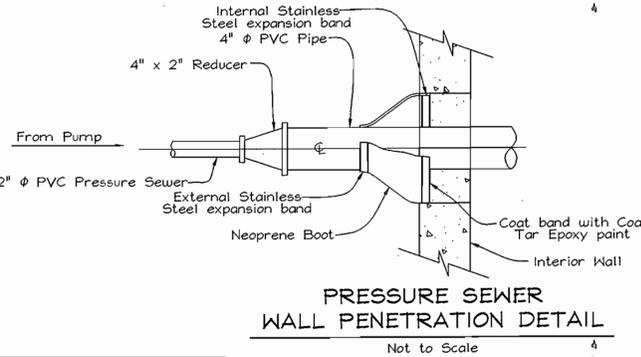

APPROVED FOR PRIVATE WATER AND PUBLIC SEWERAGE SYSTEMS
 HOWARD COUNTY HEALTH DEPARTMENT

[Signature] 2-12-2004
 COUNTY HEALTH OFFICER DATE

OWNER/DEVELOPER

PULTE HOME CORPORATION
 1501 S. EDGEMOOD STREET
 SUITE K
 BALTIMORE, MARYLAND 21227

DEPARTMENT OF PUBLIC WORKS
 HOWARD COUNTY, MARYLAND

[Signature] 1-6-04
 CHIEF, BUREAU OF UTILITIES DATE

DEPARTMENT OF PLANNING & ZONING
 HOWARD COUNTY, MARYLAND

[Signature] 2/12/04
 CHIEF, DEVELOPMENT ENGINEERING DIVISION DATE

FSH Associates
 Engineers Planners Surveyors
 8318 Forrest Street, Ellicott City, MD 21043
 Tel: 410-750-2251 Fax: 410-750-7350
 E-mail: FSHassociates@cs.com



DESIGN BY: Mike Mitchen
 DRAWN BY: Mike Mitchen
 CHECKED BY: JTF
 DATE: Dec. 11, 2003

BY	NO.	REVISION	DATE

SEWER DETAILS


600' SCALE MAP NO.: 22 BLOCK NO.: 8

TH PADDOCKS EAST
 LOTS 1-4, 18-21, AND
 NON-BUILDABLE PRESERVATION PARCEL 'B'
 CONTRACT NO. 50-4156-D
 TAX MAP #22 GRID 8
 3RD ELECTION DISTRICT

PARCEL 7
 HOWARD COUNTY, MARYLAND

SCALE AS SHOWN

SHEET NO. 4 OF 7

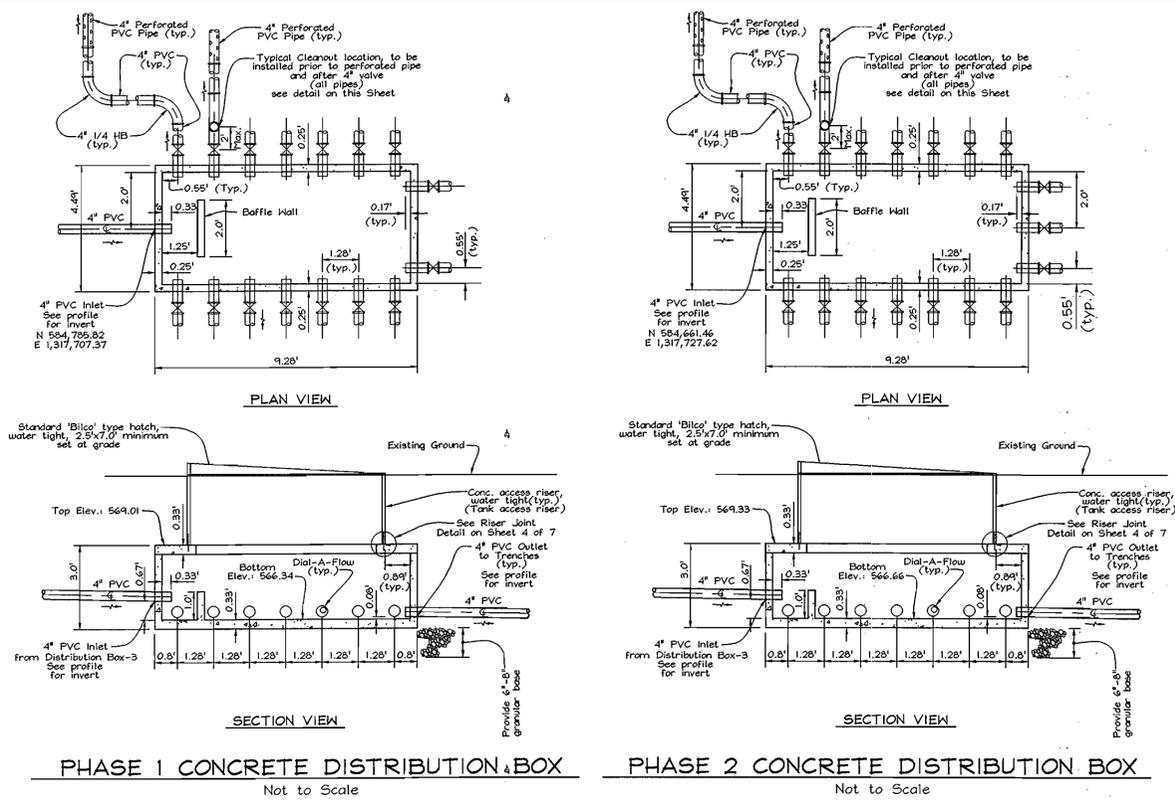


PHASE 1 CONCRETE DISTRIBUTION BOX
Not to Scale

PHASE 2 CONCRETE DISTRIBUTION BOX
Not to Scale

NOTE: To insure equal distribution to each manifold, provide "Dial-a-Flow" levers from American Manufacturing Company, Inc. (or equivalent).


Size	Color
Part # 170-0036 4" Nominal - 4" ID # above	Green
170-0094 4" Nominal - Under 4" ID	Grey

(for additional information see www.americanmfg.com or call 1.800.345.3152)

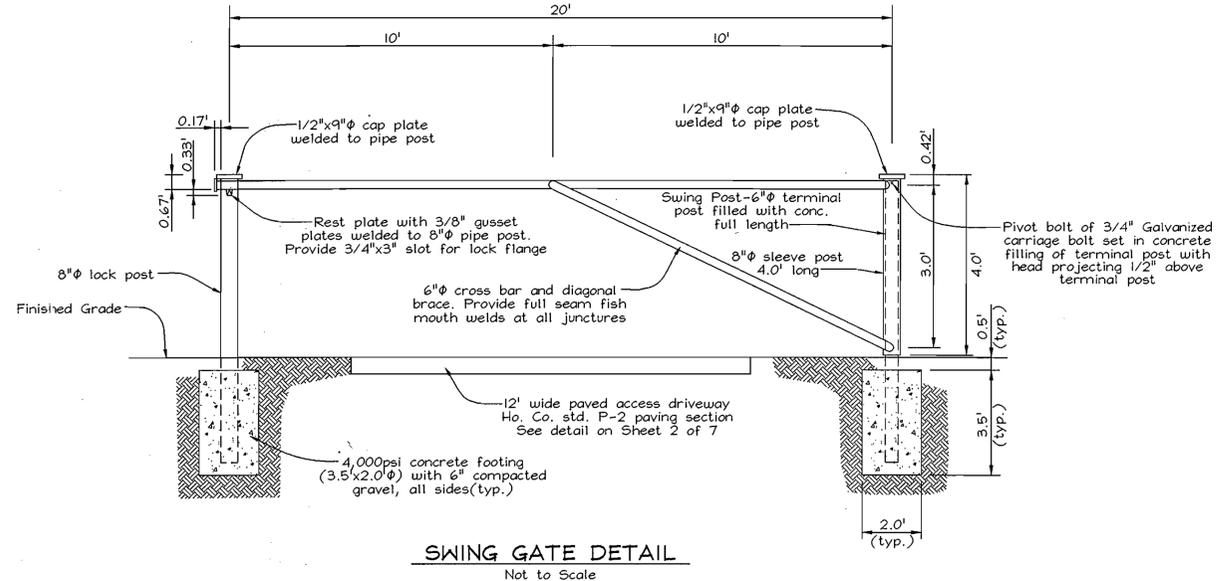


SWING GATE DETAIL
Not to Scale


- NOTES:
- All steel members to be hot dipped galvanized.
 - Provide reflective tapes on center of posts and crossbars.
 - Padlock to be keyed to Howard County DPH master key system.

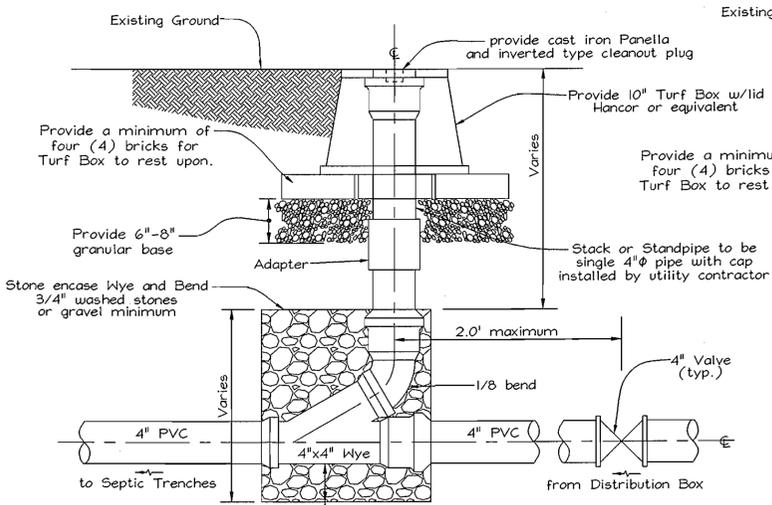


SEWER CLEANOUT @ DISTRIBUTION BOX
Modified Ho. Co. Std. Detail S-2.22
Not to Scale

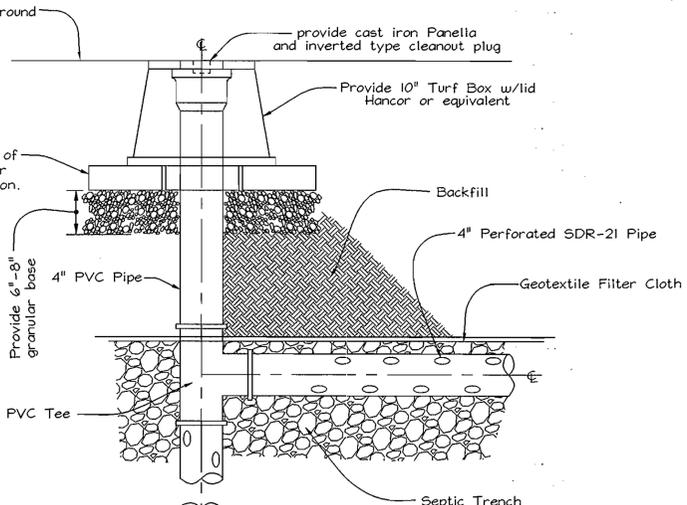


DISTRIBUTION LATERAL TERMINATION DETAIL
Not to Scale

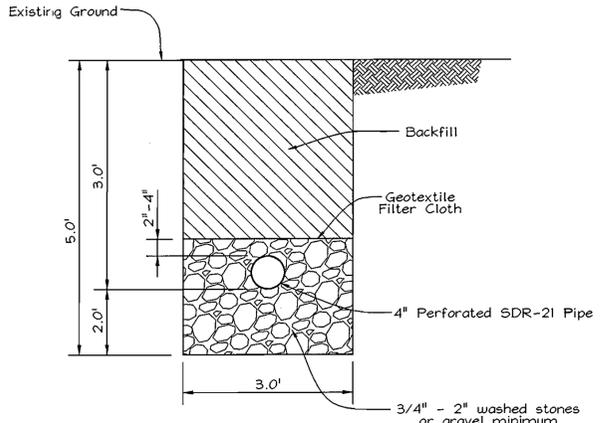

SEPTIC TRENCH DETAIL
Not to Scale

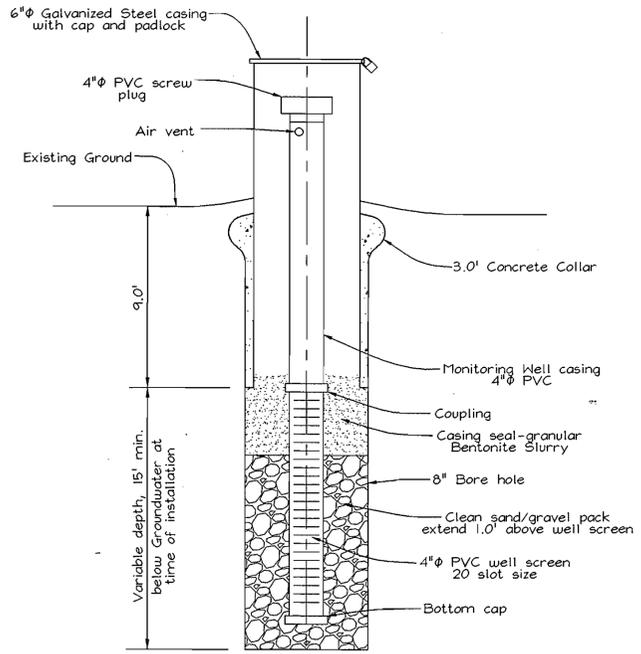

MONITORING WELL DETAIL
Not to Scale

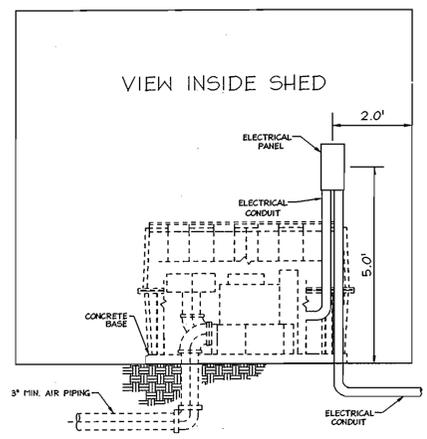

ELECTRIC PANEL MOUNTING DETAIL
Not to Scale

APPROVED FOR PRIVATE WATER AND PUBLIC SEWERAGE SYSTEMS
HOWARD COUNTY HEALTH DEPARTMENT
Dennis Banta 2-22-04
COUNTY HEALTH OFFICER DATE

DEPARTMENT OF PUBLIC WORKS
HOWARD COUNTY, MARYLAND
Robert Benjamin 1-6-04
CHIEF, BUREAU OF UTILITIES DATE

DEPARTMENT OF PLANNING & ZONING
HOWARD COUNTY, MARYLAND
Robert Benjamin 2/12/04
CHIEF, DEVELOPMENT ENGINEERING DIVISION DATE

FSH Associates
Engineers Planners Surveyors
8318 Forest Street Ellicott City, MD 21043
Tel: 410-750-2251 Fax: 410-750-7350
E-mail: FSHAssociates@cs.com




DESIGN BY: Mike Mischen
DRAWN BY: Mike Mischen
CHECKED BY: ZYF
DATE: Dec. 11, 2003

BY	NO.	REVISION	DATE

SEWER DETAILS
600' SCALE MAP NO.: 22 BLOCK NO.: 8


THE PADDOCKS EAST
LOTS 1-4, 18-21, AND
NON-BUILDABLE PRESERVATION PARCEL 'B'
CONTRACT NO. 50-4156-D
TAX MAP #22 GRID 8 PARCEL 7
3RD ELECT'N DISTRICT HOWARD COUNTY, MARYLAND

OWNER/DEVELOPER
PULTE HOME CORPORATION
1501 S. EDGEWOOD STREET
SUITE K
BALTIMORE, MARYLAND 21227
SCALE AS SHOWN
SHEET NO. 5 OF 7

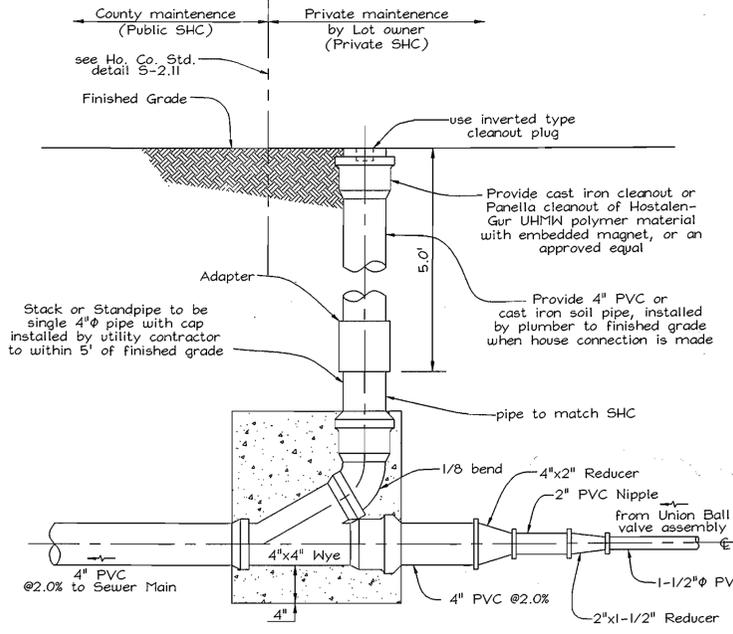

TYPICAL FORCE MAIN HOUSE CONNECTION
Modified Ho. Co. Std. Detail 5-2.22
Not to Scale


NOTE: Connection may also be made on Standpipe with a minimum of 3.5' cover

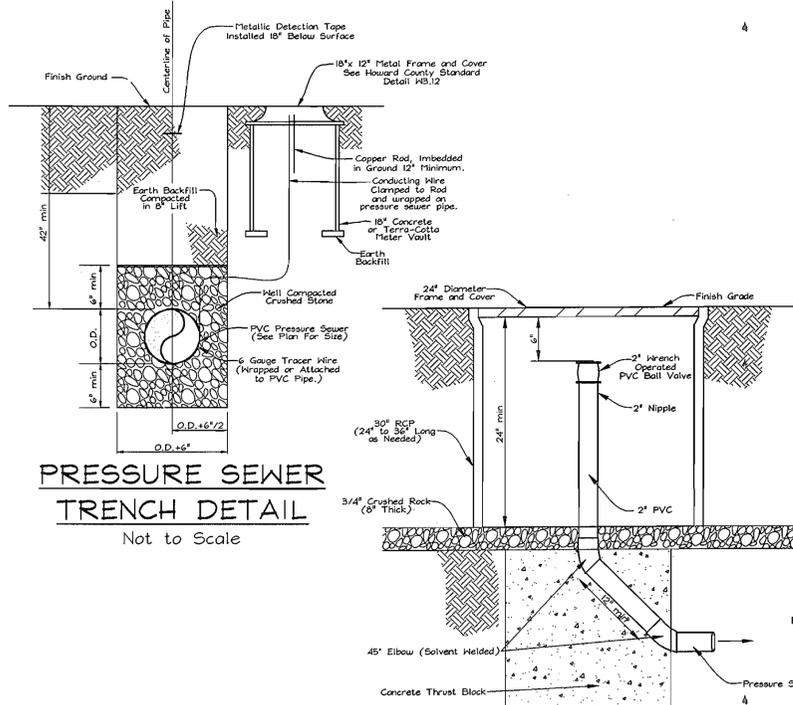


PRESSURE SEWER TRENCH DETAIL
Not to Scale

TERMINAL FLUSHING CONNECTION
Not to Scale


BUTRESS DIMENSIONS						
PIPE SIZE	B	C	D	E	F	G
1 1/2"	4 1/2"	4 1/2"	5"	9"	4 1/2"	4"
2"	5"	5"	7"	7"	5"	5"

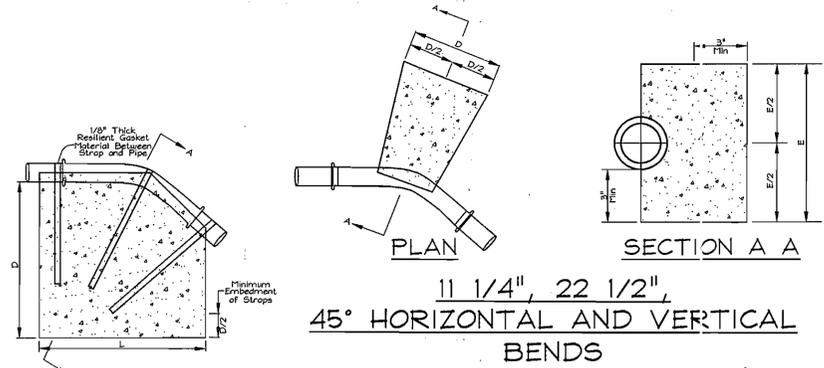


SECTION A A ANCHORING PRESSURE SEWERS
(Upper Vertical Bends)
Not to Scale

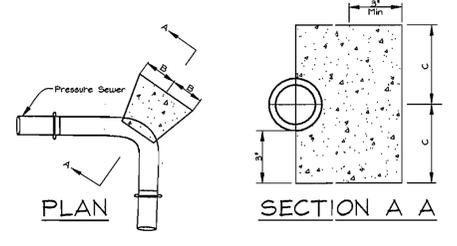

90 degree HORIZONTAL BENDS

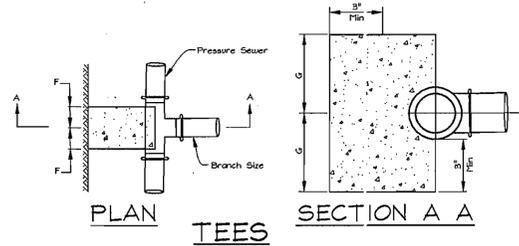


PRESSURE SEWER BLOCKING DETAILS
Not to Scale

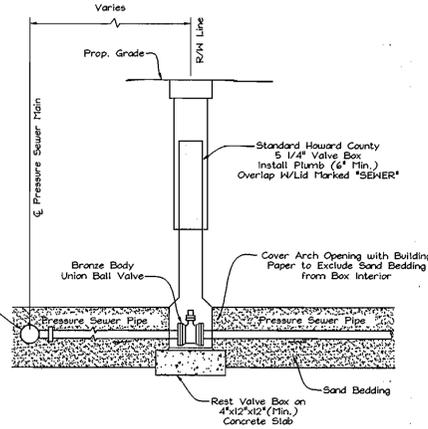


NOTES:
1. Maintain 3.5' Minimum Cover over Pressure Sewer.
2. Contractor to Construct Concrete Slab on Undisturbed Earth or Firm Subgrade.

PRESSURE SEWER UNION BALL VALVE ASSEMBLY
Not to Scale

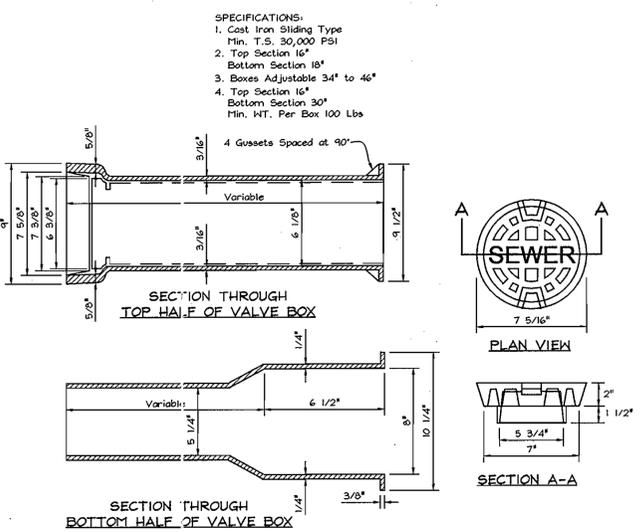


ADJUSTABLE VALVE BOX ROUND HEAD SLIDING TYPE
Not to Scale

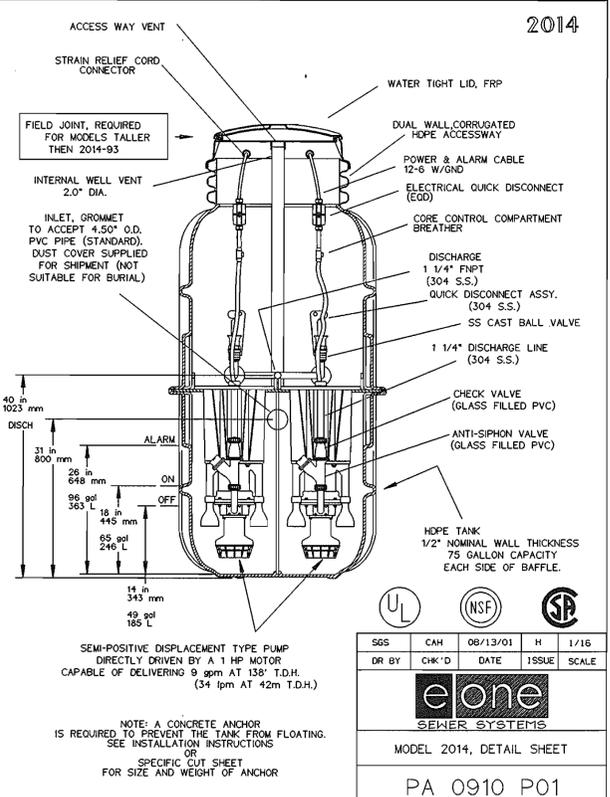

SGS	CAH	08/13/01	H	1/16
DR BY	CHK'D	DATE	ISSUE	SCALE

eone
SEWER SYSTEMS
MODEL 2014, DETAIL SHEET
PA 0910 P01

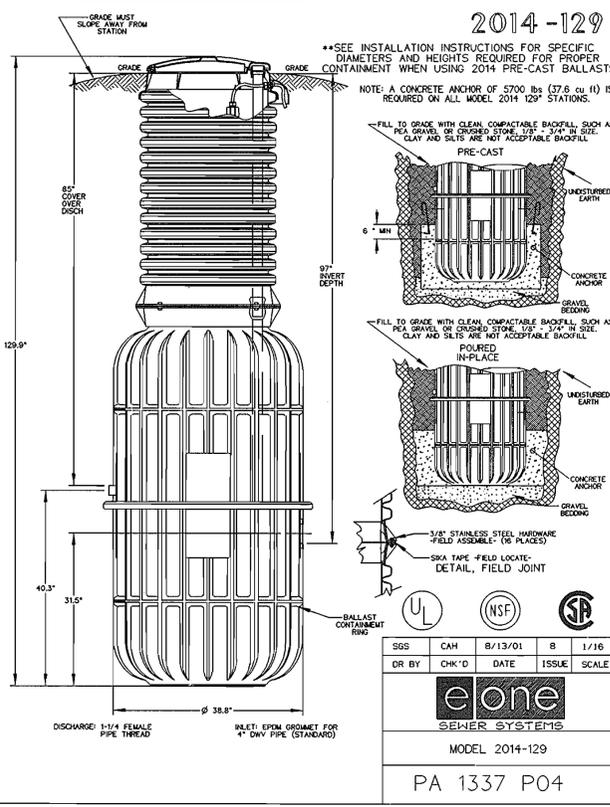

SGS	CAH	8/13/01	B	1/16
DR BY	CHK'D	DATE	ISSUE	SCALE

eone
SEWER SYSTEMS
MODEL 2014-129
PA 1337 P04


OWNER/DEVELOPER
PULTE HOME CORPORATION
1501 S EDGEMOOD STREET
SUITE K
BALTIMORE, MARYLAND 21227

APPROVED FOR PRIVATE WATER AND PUBLIC SEWERAGE SYSTEMS
HOWARD COUNTY HEALTH DEPARTMENT
Demetrius M. Williams
COUNTY HEALTH OFFICER
2-12-04
DATE

DEPARTMENT OF PUBLIC WORKS
HOWARD COUNTY, MARYLAND
John J. ...
CHIEF, BUREAU OF UTILITIES
1-6-04
DATE

DEPARTMENT OF PLANNING & ZONING
HOWARD COUNTY, MARYLAND
...
CHIEF, DEVELOPMENT ENGINEERING DIVISION
2/17/04
DATE

FSH Associates
Engineers Planners Surveyors
8318 Forrest Street, Elliott City, MD 21043
Tel: 410-750-2251 Fax: 410-750-7350
E-mail: FSHAssociates@cs.com

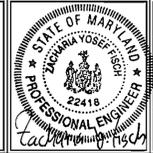


DESIGN BY: Mike Mischler
DRAWN BY: Mike Mischler
CHECKED BY: JZF
DATE: Dec. 11, 2003

BY	NO.	REVISION	DATE

SEWER DETAILS
600' SCALE MAP NO. 22 BLOCK NO. 8

THE PADDOCKS EAST
LOTS 1-4, 18-21, AND
NON-BUILDABLE PRESERVATION PARCEL 'B'
CONTRACT NO. 50-4156-D.
TAX MAP #22 GRID 8
3RD ELECTION DISTRICT
PARCEL 7
HOWARD COUNTY, MARYLAND


SCALE AS SHOWN
SHEET NO. 6 OF 7

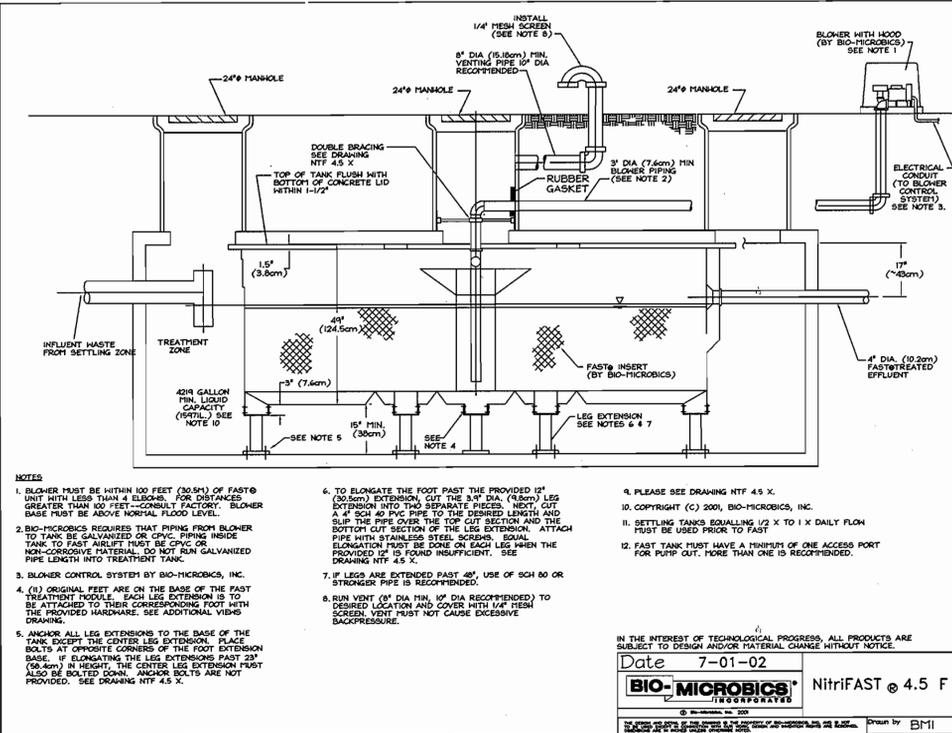

NOTES

1. BLOWER MUST BE WITHIN 100 FEET (30.5M) OF FASTO UNIT WITH LESS THAN 4 ELBOWS. FOR DISTANCES GREATER THAN 100 FEET—CONSULT FACTORY. BLOWER BASE MUST BE ABOVE NORMAL FLOOD LEVEL.
2. BIO-MICROBICS REQUIRES THAT PIPING FROM BLOWER TO TANK BE GALVANIZED OR CPVC. PIPING INSIDE TANK TO FAST ASSEMBLY MUST BE CPVC OR NON-CORROSIVE MATERIAL. DO NOT BURY GALVANIZED PIPE LENGTH INTO TREATMENT TANK.
3. BLOWER CONTROL SYSTEM BY BIO-MICROBICS, INC.
4. (E) ORIGINAL FEET ARE ON THE BASE OF THE FAST TREATMENT MODULE. EACH LEG EXTENSION IS TO BE ATTACHED TO THEIR CORRESPONDING FOOT WITH THE PROVIDED HARDWARE. SEE ADDITIONAL VIEWS DRAWING.
5. ANCHOR ALL LEG EXTENSIONS TO THE BASE OF THE TANK EXCEPT THE CENTER LEG EXTENSION. PLACE BOLTS AT OPPOSITE CORNERS OF THE FOOT EXTENSION BASE. IF ELONGATING THE LEG EXTENSIONS PAST 24\"/>


DATE 7-01-02
BIO-MICROBICS Nitrifast 4.5 F
 Drawn by BMI

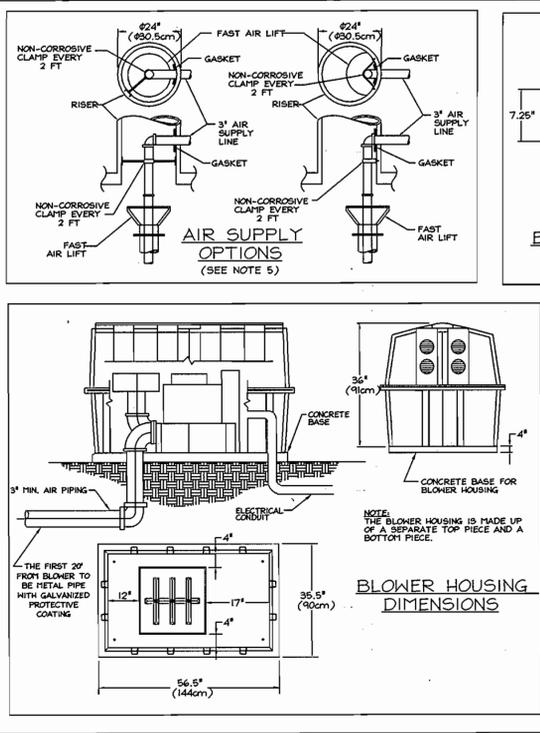

NOTES

1. PLEASE SEE DRAWING NTF 4.5 X.
2. COPYRIGHT (C) 2001, BIO-MICROBICS, INC.
3. SETTLING TANKS EQUALLING 1/2 X TO 1 X DAILY FLOW MUST BE USED PRIOR TO FAST.
4. FAST TANK MUST HAVE A MINIMUM OF ONE ACCESS PORT FOR PIPE OUT. MORE THAN ONE IS RECOMMENDED.


DATE 7-01-02
BIO-MICROBICS Nitrifast 4.5 X
 Drawn by BMI

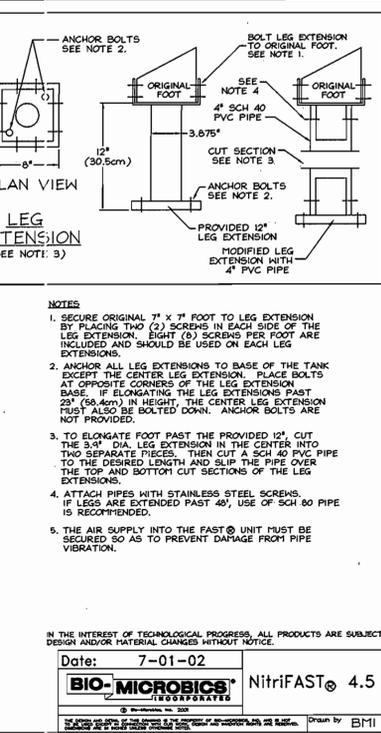


NOTES

1. SECURE ORIGINAL 7\"/>

DATE 7-01-02
BIO-MICROBICS Nitrifast 4.5 X
 Drawn by BMI

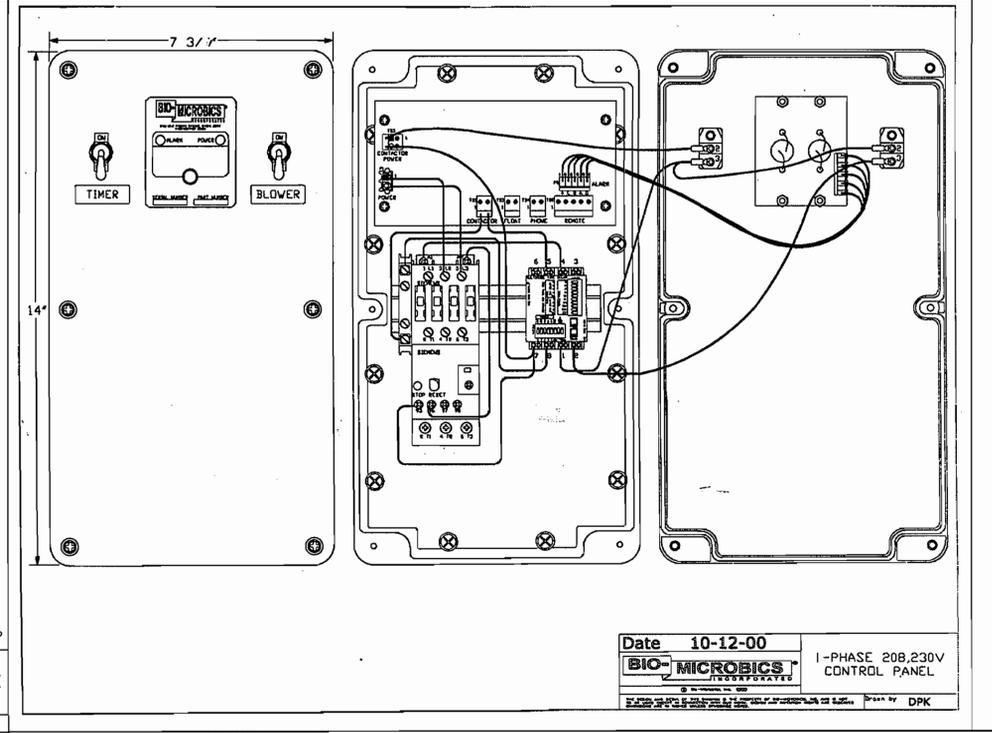

DATE 10-12-00
BIO-MICROBICS 1-PHASE 208/230V CONTROL PANEL
 Drawn by DPK

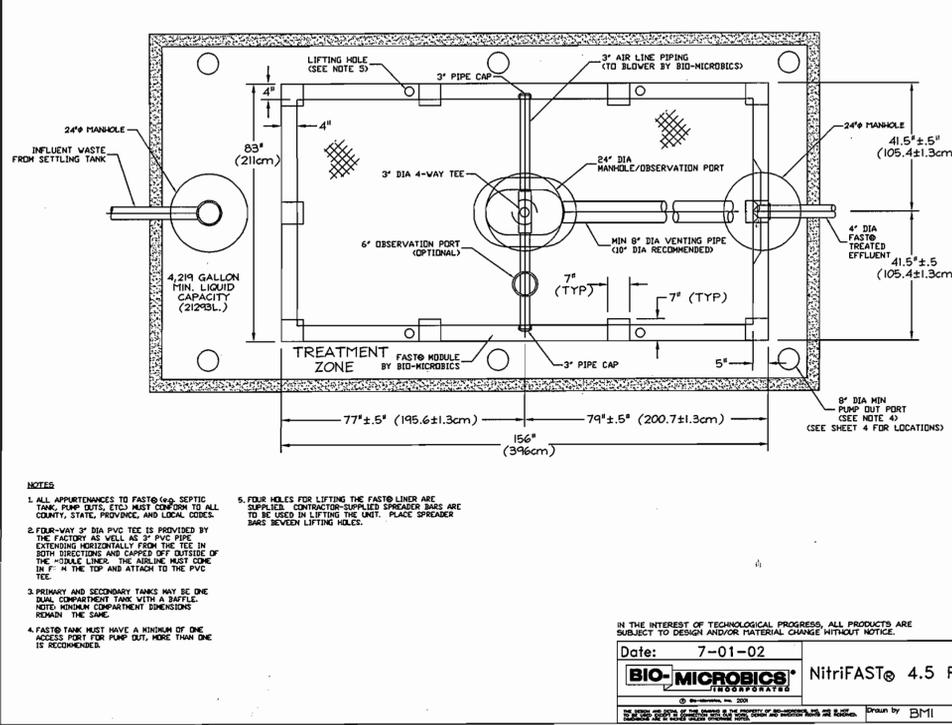

NOTES

1. ALL APPOINTMENTS TO FASTO (e.g. SEPTIC TANK, PUMP OUTS, ETC) MUST CONFORM TO ALL COUNTY, STATE, PROVINCIAL AND LOCAL CODES.
2. FIBER-WAY 3\"/>

DATE 7-01-02
BIO-MICROBICS Nitrifast 4.5 P
 Drawn by BMI

Specifications For Nitrifast 4.5 Wastewater Treatment System

1. GENERAL
 The contractor shall furnish and install (1) Nitrifast 4.5 treatment system as manufactured by Bio-Microbics, Inc. The treatment system shall be complete with all needed equipment as shown on the drawings and specified herein.

2. OPERATING CONDITIONS
 The Nitrifast 4.5 treatment system shall be capable of treating the wastewater produced by typical family activities (both laundry, kitchen, etc.) ranging from (18) eighteen to (63) sixty-three persons and not to exceed 4,500 US Gallons per day (17033 LPD).

3. MEDIA
 The FAST media shall be manufactured of rigid PVC or polyethylene and it shall be supported by a polyethylene insert. The media shall be fixed in position and contain no moving or wearing parts and shall not corrode. The media shall be designed and installed to ensure that sloughed solids immediately descend through the media to the bottom of the septic tank.

4. BLOWER
 The Nitrifast 4.5 unit shall come equipped with a regenerative type blower capable of delivering 90-135 CFM. The blower assembly shall include an inlet filter with metal filter element.

5. REMOTE MOUNTED BLOWER
 The blower shall be mounted remote, up to 100 feet (30.5 M) maximum, from the Nitrifast unit on a contractor supplied concrete base. The blower elevation must be higher than the normal flood level. A two-piece, rectangular housing shall be provided with tamper-proof screws. The discharge air line from the blower to the MicroFAST shall be provided and installed by the contractor.

6. ELECTRICAL
 The electrical source should be within 150 feet of the blower. Consult local codes for longer wiring distances. The input power required for the blower is 230 Volts, Single Phase, 60/50 Hertz, 11.5 Full Load Amps, minimum wire size is 12 A.W.G. (Locked Rotor Amps are 67). All conduit and wiring between the electrical control panel, the power supply, and the blower shall be furnished and installed by the contractor.

7. ALARMS
 The alarm system shall consist of a visual and audible alarm to indicate loss of power to the blower. A manual silence switch is included.

8. INSTALLATION AND OPERATING INSTRUCTIONS
 All work must be done in accordance with local codes and regulations. Installation of the Nitrifast 4.5 shall be done in accordance with the written instructions provided by the manufacturer. An operation and maintenance manual shall be furnished which will include a description of system installation, operation, and maintenance procedures.


9. FLOW & PIPE SIZING
 Each FAST module is provided with a standard (4) four inch effluent pipe hole and gasket. The maximum free or unrestricted flow with a four inch effluent pipe is 90 U.S. Gallons per minute (341 LPM), or 45 U.S. GPM (170 LPM) with a 2.0 design safety factor. An optional (6) six inch hole and gasket can be utilized on the same centerline dimension or up to 2 inches (5 cm) higher. Maximum free or unrestricted flow with a 6 inch effluent pipe is 260 GPM (984 LPM) or 130 GPM (492 LPM) with a 2.0 design safety factor.

10. WARRANTY
 The manufacturer of the Nitrifast 4.5 treatment system shall warrant for eighteen months from the date of shipment or one year from the date of start-up, whichever occurs first, that the equipment they provide will be free from defects in material and workmanship.

11. IN THE EVENT A MECHANICAL COMPONENT FAILS TO PERFORM AS SPECIFIED OR IS PROVEN DEFECTIVE IN SERVICE DURING THE WARRANTY PERIOD, THE MANUFACTURER SHALL REPAIR OR REPLACE SUCH DEFECTIVE PARTS. (Cost of labor on repair/replacement is not covered under this warranty.) The replacement or repair of those items normally consumed in service such as air filter, etc., shall be considered as part of routine maintenance and upkeep.

12. IT IS NOT INTENDED THAT THE CONTRACTOR ASSUME RESPONSIBILITY FOR CONTINGENT LIABILITIES OR CONSEQUENCES OF ANY NATURE RESULTING FROM DEFECTS IN DESIGN, MATERIAL OR WORKMANSHIP OR DELAYS IN DELIVERY, REPLACEMENT, OR OTHERWISE.

DATE 7-01-02
BIO-MICROBICS Nitrifast 4.5 S
 Drawn by BMI

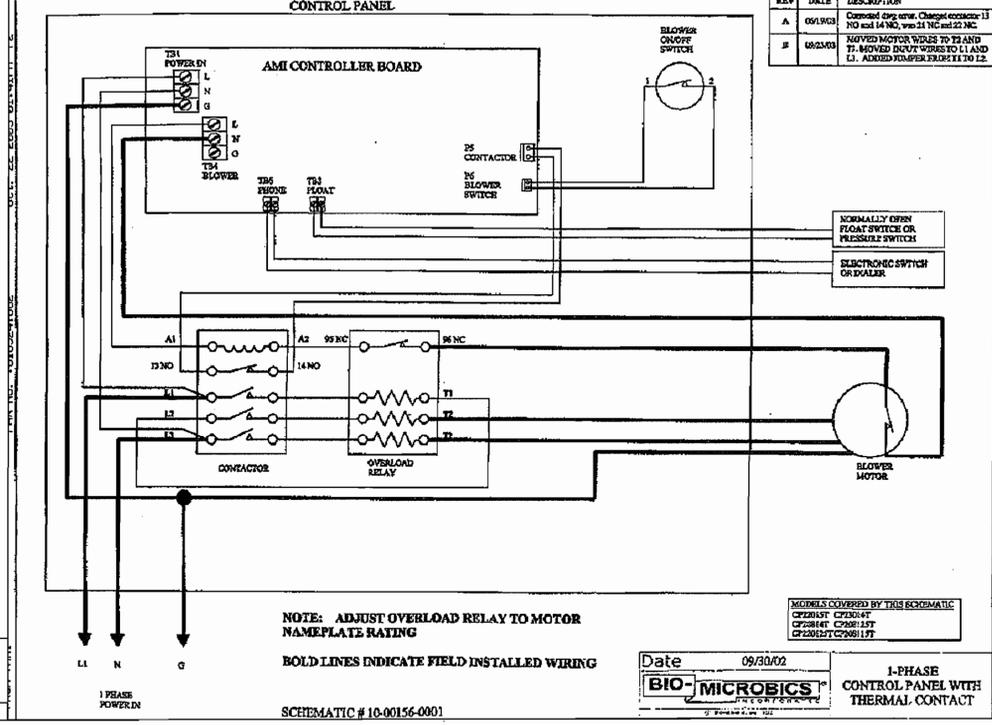

NOTE: ADJUST OVERLOAD RELAY TO MOTOR NAMEPLATE RATING

DATE 09/30/02
BIO-MICROBICS 1-PHASE CONTROL PANEL WITH THERMAL CONTACT
 SCHEMATIC # 10-00156-0001

NOTE: CONTROL PANEL DETAILS SHOWN ARE FOR ILLUSTRATIVE PURPOSES. CONTRACTOR TO UTILIZE BLOWER MANUALS FOR INSTALLATION OF ELECTRICAL CONTROL PANEL.

OWNER/DEVELOPER
 RULTE HOME CORPORATION
 1501 S. EDGEMOOD STREET
 SUITE K
 BALTIMORE, MARYLAND 21227

APPROVED: FOR PRIVATE WATER AND PUBLIC SEWERAGE SYSTEMS
 HOWARD COUNTY HEALTH DEPARTMENT
 County Health Officer
 2-12-04 DATE

DEPARTMENT OF PUBLIC WORKS
 HOWARD COUNTY, MARYLAND
 Chief, Bureau of Utilities
 1-6-04 DATE

DEPARTMENT OF PLANNING & ZONING
 HOWARD COUNTY, MARYLAND
 Chief, Development Engineering Division
 2/17/04 DATE

FSH Associates
 Engineers Planners Surveyors
 8318 Forrest Street Ellicott City, MD 21043
 Tel: 410-750-2251 Fax: 410-750-7350
 E-mail: FSHAssociates@cs.com

DESIGN BY: Mike Hilschen
 DRAWN BY: Mike Hilschen
 CHECKED BY: ZYF
 DATE: Dec. 11, 2003

BY NO. REVISION DATE

600' SCALE MAP NO.: 22 BLOCK NO.: 8

SEWER DETAILS

THE PADDOCKS EAST
 LOTS 1-4, 18-21, AND
 NON-BUILDABLE PRESERVATION PARCEL 'B'
 CONTRACT NO. 50-4156-D
 TAX MAP #22 GRID 8 PARCEL 7
 3RD ELECTION DISTRICT HOWARD COUNTY, MARYLAND

SCALE AS SHOWN
 SHEET NO. 7 OF 7