

U.S. 40 WATER SERVICE MAIN REPLACEMENT

CAPITAL PROJECT NO. W-8311 CONTRACT NO. 44-4731 HOWARD COUNTY, MARYLAND



GENERAL NOTES
PART I
1. Approximate locations of existing mains are shown. The contractor shall take all necessary precautions to protect existing mains and services and maintain uninterrupted service. Any damage incurred shall be repaired immediately to the satisfaction of the Engineer at the contractor's expense.

2. Topographic field surveys were performed on November 2011 by Harford Aerial and J.A. Rice Inc.
3. Horizontal and Vertical Survey Controls:
The coordinates shown on the drawings are based on Maryland State Reference System NAD '83/91 as projected by Howard County Geodetic Control Stations No. 24B5, No. 24BB and No. 24CA.

All vertical controls are based on NAVD '88. Vertical controls provided on the drawings are aluminum stamped discs.
4. All pipe elevations shown are invert elevations unless otherwise noted on the plans.
5. Clear all utilities by a minimum of 12 inches. Clear all poles by 5'-0" minimum or tunnel as required unless otherwise noted. The owner has contacted the utility companies and has made arrangements for bracing of poles as shown on the drawings. In the event the contractor's work requires the bracing of additional poles, any cost incurred by the owner for the bracing of additional poles or damages shall be deducted from monies owed the contractor. The contractor shall coordinate with the utility companies to schedule the bracing of the poles.

6. For details not shown on the drawing, and for materials and construction methods, use Howard County Design Manual, Volume IV, Standard Specifications and Details for Construction (Latest Edition). The contractor shall have a copy of Volume IV on the job.
7. Where test pits have been made on existing utilities, they are noted by the symbol [] at the locations of the test pits. A note or notes containing the results of the test pit or pits is included on the drawings. Existing utilities in the vicinity of the proposed work for which test pits have not been dug shall be located by the contractor two weeks in advance of construction operations at his own expense.

8. The contractor shall notify the following utility companies or agencies at least five working days before starting work shown on these plans:

AT & T	1-800-252-1133
BGE (Construction Services)	410-637-8713
BGE (Emergency)	410-685-0123
Bureau of Utilities	410-313-4900
Colonial Pipeline Company	410-795-1390
Miss Utility	1-800-257-7777
State Highway Administration (District 7 Office)	301-624-8100
State Highway Administration (Signal Shop)	410-787-7650
Verizon	1-800-743-0033

9. Trees and shrubs are to be protected from damage to the maximum extent. Trees and shrubs located within the construction strip are not to be removed or damaged by the contractor.
10. The contractor shall remove trees, stumps and roots along the line of excavation. Payment for such removal shall be included in the unit price bid for construction of the main.

11. The contractor shall notify the Bureau of Highways, Howard County, at (410)-313-7450 at least five working days before open cutting or boring/jacking of any County road for laying water/sewer mains or house connections. The approval of these drawings will constitute compliance with DPW requirements per Section 18.114(a) of the Howard County Code.

12. The contractor shall coordinate any disruption of traffic signals, sensors and wiring with Maryland State Highway Administration, Office of Traffic and Safety.
13. Working hours shall be limited to 9am - 3pm and 8pm - 5am. See specifications for acceptable working days. In the event of a double lane closure, the contractor shall be limited to working hours of 8pm-5am.

PART II - WATER

1. All water mains to be C-900 or Fusible C-905 unless otherwise noted. There shall be no deflection of PVC pipe joints or bending of AWWA C-900 pipe.
2. Tops of all water mains to have a minimum of 3'-6" of cover unless otherwise noted.

3. Valves adjacent to tees shall be strapped to tees.
4. All fittings shall be buttressed or anchored with concrete in accordance with the Standard Details unless otherwise provided for on the drawings.

5. Fire hydrants shall be set to the bury line elevations shown on the drawings. All fire hydrants shall be restrained and buttressed with concrete in accordance with the Standard Details. The soil around the fire hydrant shall be compacted in accordance with Section 1000 and 1005 of the Standard Specifications.
6. The contractor shall not operate any water main valves on the existing water system.

7. Tracer wires and continuity test stations shall be installed on all DIP and PVC water mains in accordance with the Howard County Design Manual.
8. For PVC water mains, all records for the Quality Control and Qualification Test Requirements noted in Section 5.1 of the AWWA Standard C900 for PVC pressure pipe shall be submitted with the pipe material certifications or shop drawings prior to approval of the material for use. The test records shall be for the pipe to be installed under this contract. All PVC pipe shall contain markings to allow cross referencing of the pipe supplied to the test records received.

9. Unless otherwise noted on the plans or in the specifications, seventeen (17) pound sacrificial anodes shall be installed on all valves and metallic fittings used with PVC water mains in accordance with Volume IV, Standard Specifications and Details for Construction. Magnesium anodes shall be installed on all valves and ductile iron fittings including restraints and harnesses. Zinc anodes shall be installed on all stainless steel fittings and saddles used with PVC mains. All "tees" used with PVC mains shall be ductile iron. See Corrosion Protection Details Sheets 12 & 13.
10. The contractor shall notify Howard County DPW as any unknown utility services are encountered. Contractor shall reconnect all active water services encountered.


11. The contractor shall verify that existing water lines and valves are restrained prior to removal of existing water line, at connection locations. Contractor shall provide thrust blocking and/or deadmen anchors on the existing water system where there is no existing thrust projection.
12. The contractor shall abandon existing waterline in place unless otherwise indicated on the plans. Contractor shall cap all cut or open ends, remove existing valve roadway boxes and abandon existing valves in place. The contractor shall be responsible for removal and disposal of existing waterline where indicated to be replaced in-kind.

13. The contractor shall mill and overlay asphalt for the full lane width for any lane encroached by the utility trench more than 1 linear foot, per SHA specifications. Prior to excavation, Contractor shall notify Howard County DPW if utility trench will encroach more than one lane. The contractor shall also mill and overlay 50 linear feet beyond the limits of the new 8-inch waterline and 50 linear feet into named street intersections. See limit of disturbance for detail.
14. For ada ramp improvements, contractor shall replace one additional sidewalk panel to transition from new ada ramp to existing sidewalks narrower than 5-feet.

NO.	INDEX OF SHEETS
1	TITLE SHEET
2	8" WATER LINE PLAN & PROFILE STATION 0+00 - 9+50
3	8" WATER LINE PLAN & PROFILE STATION 9+50 - 20+00
4	8" WATER LINE PLAN & PROFILE STATION 20+00 - 30+50
5	8" WATER LINE PLAN & PROFILE STATION 30+50 - 41+00
6	8" WATER LINE PLAN & PROFILE STATION 41+00 - 51+50
7	8" WATER LINE PLAN & PROFILE STATION 51+50 - 60+51
8	MISCELLANEOUS DETAILS AND SEQUENCE OF CONSTRUCTION
9	MISCELLANEOUS DETAILS
10	EROSION & SEDIMENT CONTROL DETAILS
11	TRAFFIC CONTROL DETAILS
12	CORROSION PROTECTION DETAILS
13	CORROSION PROTECTION DETAILS

LEGEND

[Symbol]	EXIST. WATER MAIN / VALVE VAULT
[Symbol]	PROP. WATER MAIN
[Symbol]	TEMP. WATER MAIN
[Symbol]	EXIST. WATER MAIN TO BE ABANDONED
[Symbol]	EXIST. SEWER MAIN / MANHOLE
[Symbol]	EXIST. STORM DRAIN
[Symbol]	EXIST. GAS
[Symbol]	EXIST. ELECTRIC (UNDERGROUND)
[Symbol]	EXIST. ELECTRIC (ABOVE GROUND)
[Symbol]	EXIST. CABLE TV
[Symbol]	EXIST. TELEPHONE (UNDERGROUND)
[Symbol]	EXIST. TELEPHONE (ABOVE GROUND)
[Symbol]	RIGHT OF WAY
[Symbol]	GUARDRAIL
[Symbol]	FENCE
[Symbol]	PROPERTY LINE
[Symbol]	SILT FENCE
[Symbol]	LIMITS OF DISTURBANCE
[Symbol]	ROAD CENTERLINE
[Symbol]	TRAVERSE
[Symbol]	STREAM / WATERWAY EDGE
[Symbol]	630 W
[Symbol]	550
[Symbol]	SHRUB
[Symbol]	VALVE
[Symbol]	FIRE HYDRANT
[Symbol]	BGE POLE
[Symbol]	STREET SIGN
[Symbol]	ROAD DELINEATOR
[Symbol]	BORING LOCATION
[Symbol]	CONTINUITY TEST STATION
[Symbol]	SAN. MANHOLE IDENTIFICATION
[Symbol]	TEST PIT LOCATION
[Symbol]	CIP

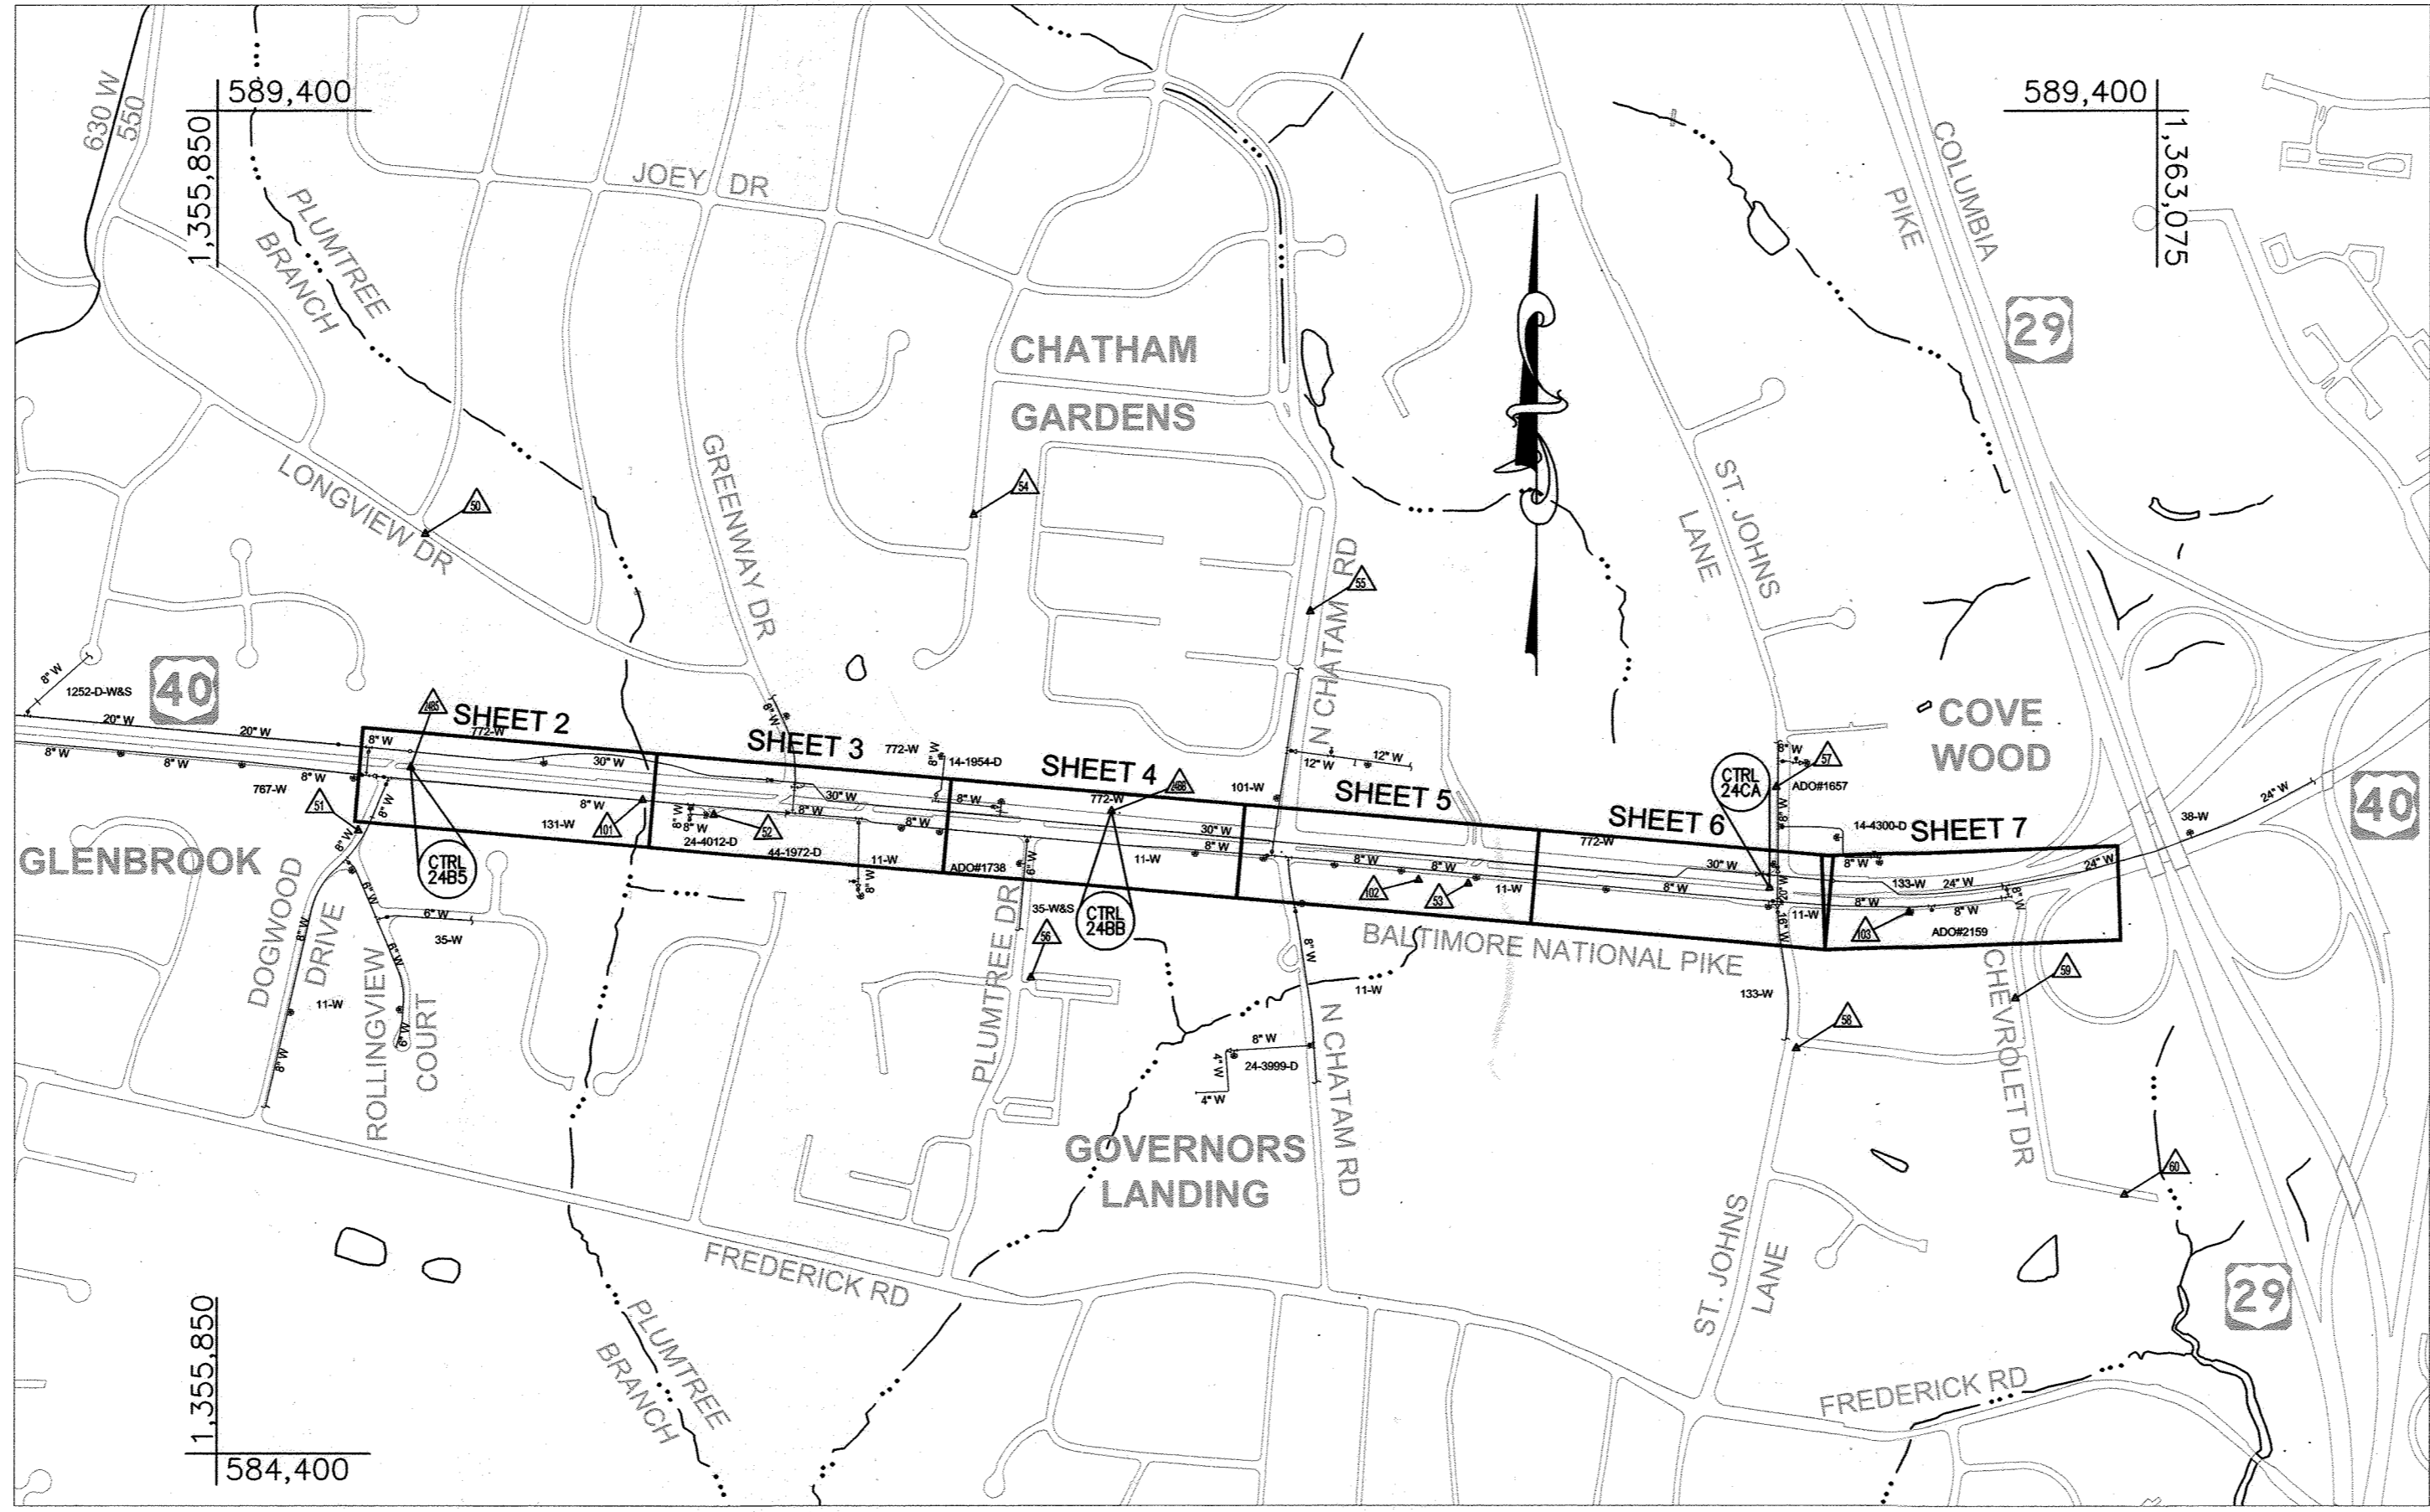

QUANTITIES

ITEMS	QUANTITIES ESTIMATED	QUANTITIES	TYPE	MANUFACTURER / SUPPLIER
WATER				
8" Water Pipe	6,067 L.F.	6,110.5	C900 DR-18	NATIONAL PIPE & PLASTICS
6" Water Pipe	296 L.F.	302.5	C900 DR-18	NATIONAL PIPE & PLASTICS
8" Valve and Roadway Box	12 EA.	14	GATE	MUELLER CO.
6" Valve and Roadway Box	24 EA.	23	GATE	MUELLER CO.
8" X 8" Tee	7 EA.	7	MECHANICAL JT.	TYLER UNION
8" X 6" Tee	20 EA.	22	MECHANICAL JT.	TYLER UNION
Test Station	20 EA.	20	VAULT	PRISM PRECAST PRODUCTS
Fire Hydrant	10 EA.	10	5'	MUELLER CO.

WATER ZONE PRESSURE: 550W # WHCS: #
TEST GRADIENT: #330 TYPE OF BUILDING: RESIDENTIAL/COMMERCIAL
DRAINAGE AREA: PATAPSCO

VICINITY MAP
SCALE: 1" = 600'

HORIZONTAL AND VERTICAL CONTROL BASED ON MARYLAND NAD83 (91) (HORIZONTAL) AND NAVD88 (VERTICAL) DATUM.
HOWARD COUNTY GEODETIC SURVEY CONTROL NUMBERS:
NO. 24B5 NO. 24BB NO. 24CA
N 586,956.27 N 586,791.24 N 586,506.22
E 1,356,570.78 E 1,359,181.16 E 1,361,634.27
ELEV. 390.17 ELEV. 386.13 ELEV. 398.25

Note: 6" water pipe and 6" valve & roadway box quantities include 6" services that are not shown on plans, but are represented on the Water Services Table on Sheet 8.

HOWARD SOIL CONSERVATION DISTRICT CERTIFICATION:
THIS DEVELOPMENT PLAN IS APPROVED FOR SOIL EROSION AND SEDIMENT CONTROL BY THE HOWARD SOIL CONSERVATION DISTRICT.
John Roberto 3/14/13
HOWARD SCD DATE

ENGINEER'S DESIGN CERTIFICATION:
"I CERTIFY THAT THIS PLAN FOR EROSION AND SEDIMENT CONTROL REPRESENTS A PRACTICAL AND WORKABLE PLAN BASED ON MY PERSONAL KNOWLEDGE OF THE SITE CONDITIONS AND THAT IT WAS PREPARED IN ACCORDANCE WITH THE REQUIREMENTS OF THE HOWARD SOIL CONSERVATION DISTRICT."
Nathan C. Atkinson 3/11/13
SIGNATURE OF ENGINEER DATE
NATHAN C. ATKINSON, P.E.

OWNER'S / DEVELOPER'S CERTIFICATION:
"I/WE CERTIFY THAT ALL DEVELOPMENT AND CONSTRUCTION WILL BE DONE ACCORDING TO THIS PLAN, AND THAT ANY RESPONSIBLE PERSONNEL INVOLVED IN THE CONSTRUCTION PROJECT WILL HAVE A CERTIFICATE OF ATTENDANCE AT A DEPARTMENT OF THE ENVIRONMENT APPROVED TRAINING PROGRAM FOR THE CONTROL OF SEDIMENT AND EROSION BEFORE BEGINNING THE PROJECT. I ALSO AUTHORIZE PERIODIC ON-SITE INSPECTION BY THE HOWARD SOIL CONSERVATION DISTRICT."
Nathan C. Atkinson 3/11/13
BUREAU OF ENGINEERING DATE
DEPARTMENT OF PUBLIC WORKS

DEPARTMENT OF PUBLIC WORKS
HOWARD COUNTY, MARYLAND
John Roberto 3/13/13
DIRECTOR OF PUBLIC WORKS DATE
Morgan S. Buttle 3/13/13
CHIEF, BUREAU OF ENGINEERING DATE
Steve C. Lane 3/12/13
CHIEF, BUREAU OF UTILITIES DATE
Clayton 3/12/13
CHIEF, UTILITY DESIGN DIVISION DATE

URS
MONTGOMERY PARK BUSINESS CENTER
1800 WASHINGTON BOULEVARD, SUITE 410
BALTIMORE, MARYLAND 21230
(410) 468-0875
Professional Certification
I hereby certify that these documents were prepared or approved by me, and that I am a duly licensed professional engineer under the laws of the State of Maryland, License No. 28817, Expiration Date: 08/01/13
Nathan C. Atkinson

DESIGN:	NO.	REVISION	DATE	BY
NCA	1	REMOVE TEMPORARY WATER SERVICE, REVISE ALIGNMENT	9/3/2013	URS
NCA	2	RELOCATE PROPOSED FIRE HYDRANT	10/4/2013	URS
NCA	3	ADD PROP. 6" AND 8" VALVES AND ROADWAY BOXES	1/15/2013	URS
NCA	4	REVISE 8" WATERLINE VERTICAL ALIGNMENT	11/22/2013	URS
NCA	5	ADD MODIFICATIONS TO EXISTING GUARDRAIL	2/3/2014	URS
EMT	6	REVISE PLAN TO ADD 4" WATER SERVICE & INDOOR WELP	1/23/2020	RK & K

DATE: 3/7/13 NO. REVISION DATE BY
AS-BUILT 7/15/2024 WRA



TITLE SHEET
U.S. 40 WATER SERVICE MAIN REPLACEMENT
CAPITAL PROJECT NO. W-8311
CONTRACT NO. 44-4731
6TH ELECTION DISTRICT
HOWARD COUNTY, MARYLAND
SCALE: AS SHOWN
SHEET 1 OF 13

AS-BUILT 1/2015



Manhole #	Invert	Rim Elevation
1498	354.16	370.51 +/-
1497	353.16	368.02 +/-

WATER MAIN STAKE-OUT SCHEDULE				
Station	Fitting	Northing	Easting	Invert
0+40.00	1.50" HD COUPLING (VERT.)	586,917.12	1,356,533.76	384.80
1+00.00	0.25" HD COUPLING (VERT.)	586,911.69	1,356,593.52	384.81
2+00.00	1.00" HD COUPLING (VERT.)	586,902.64	1,356,693.11	384.39
2+50.00	8"x6" TEE	586,898.12	1,356,742.90	383.31
2+50.00	6" VALVE & ROADWAY BOX	586,893.51	1,356,742.48	383.31
2+50.00	FIRE HYDRANT (4'-6" BURY)	586,888.64	1,356,742.04	383.31
2+56.00	TEST STATION	586,887.89	1,356,748.00	-
3+80.00	1.00" HD COUPLING (VERT.)	586,886.35	1,356,872.37	380.49
4+60.00	0.50" HD COUPLING (VERT.)	586,879.12	1,356,952.04	377.36
6+00.00	8"x6" TEE	586,866.45	1,357,091.47	373.11
6+00.00	6" VALVE & ROADWAY BOX	586,861.83	1,357,091.05	373.11
6+00.00	FIRE HYDRANT (4'-6" BURY)	586,857.91	1,357,090.69	373.11
6+06.00	TEST STATION	586,857.27	1,357,096.66	-
8+20.00	0.75" HD COUPLING (VERT.)	586,846.54	1,357,310.56	366.42
9+25.00	8"x6" TEE	586,837.04	1,357,415.13	364.82
9+25.00	6" VALVE & ROADWAY BOX	586,832.43	1,357,414.71	364.82
9+25.00	FIRE HYDRANT (4'-6" BURY)	586,828.50	1,357,414.36	364.82
9+31.00	TEST STATION	586,827.76	1,357,420.31	-

TEST PIT DATA		
TEST PIT NUMBER	TYPE OF UTILITY	TOP DEPTH
TH 1G	6" WRAPPED STEEL GAS PIPE	3.76

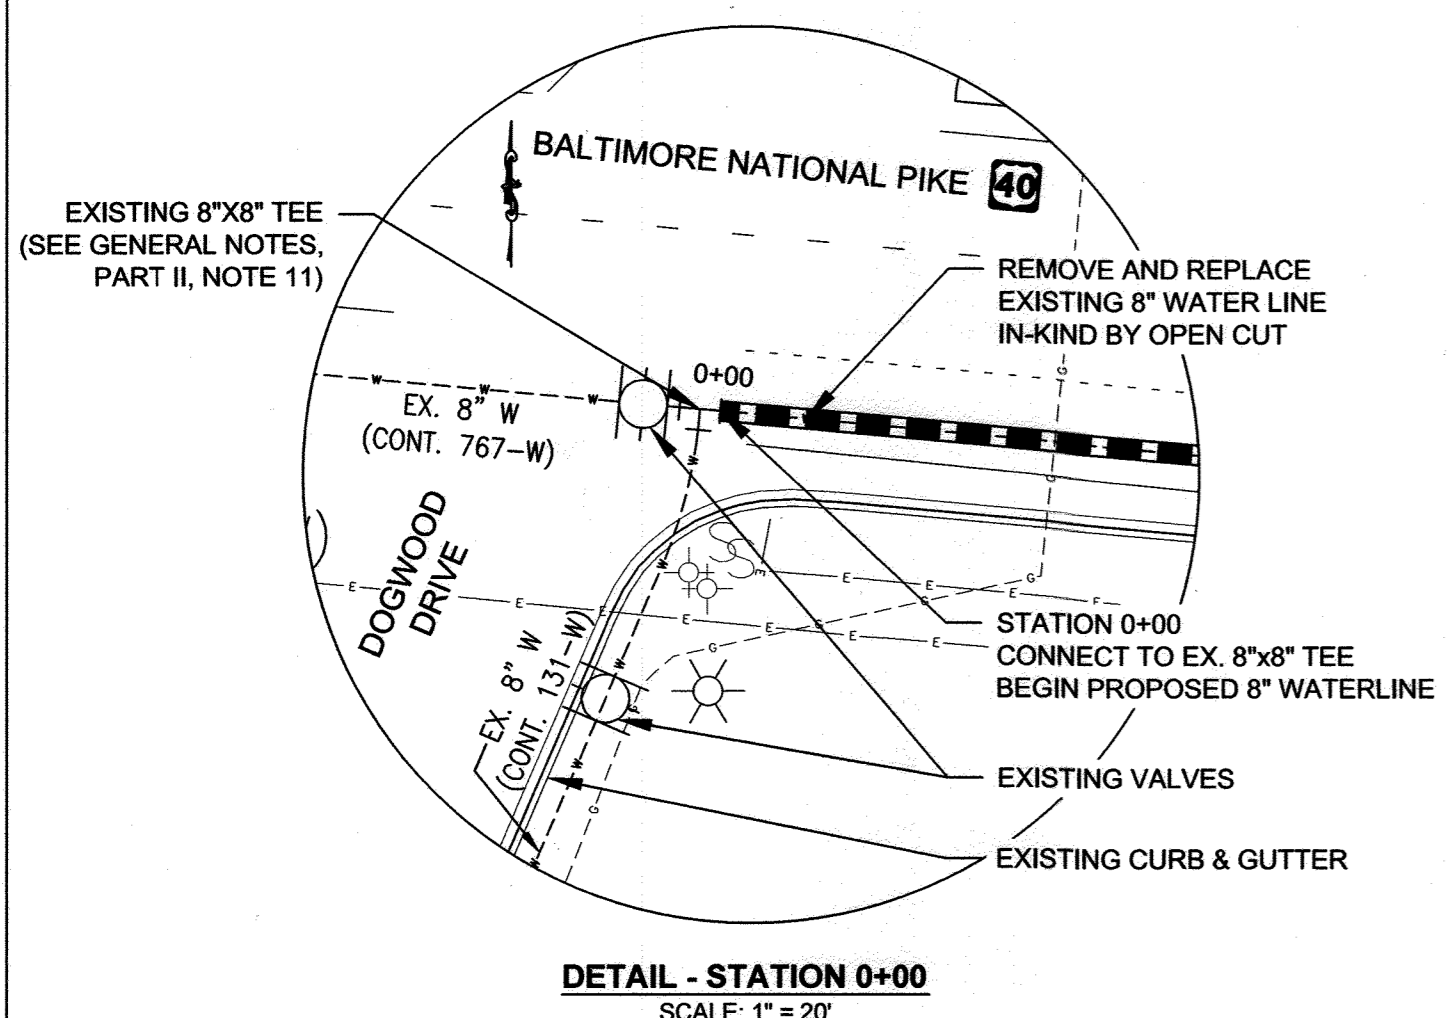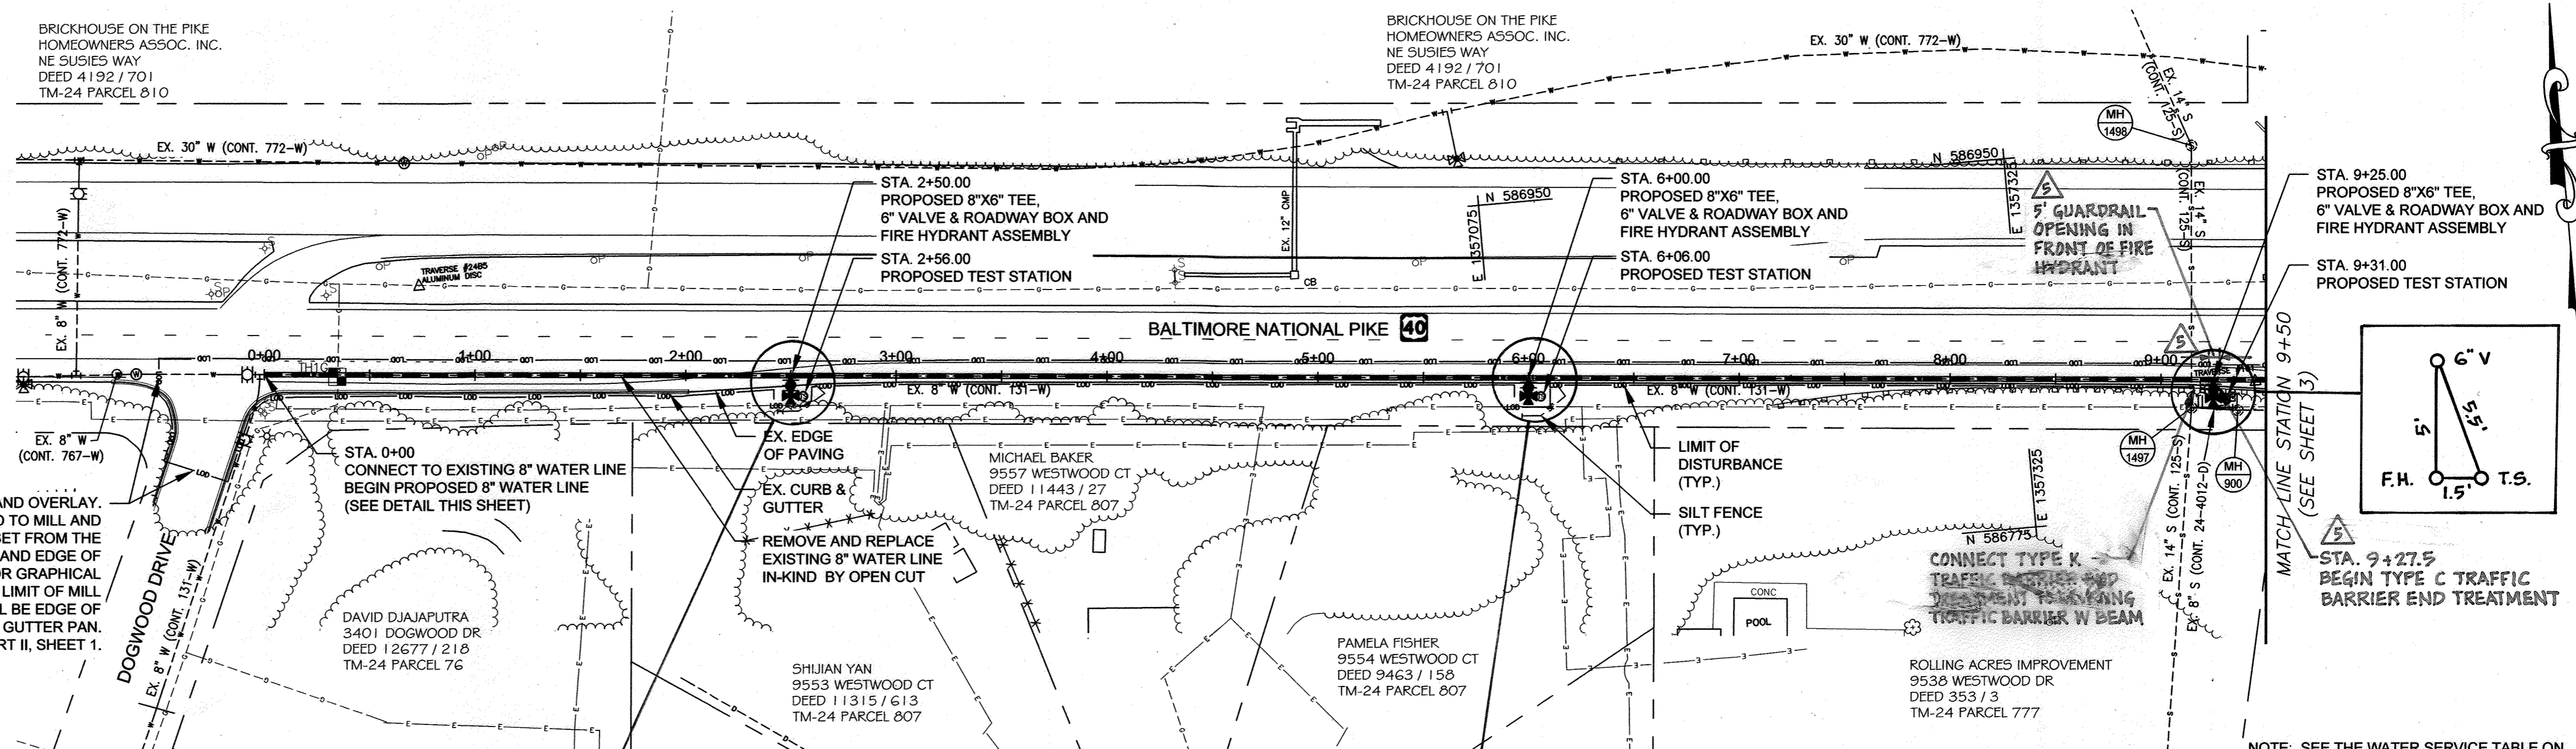

TRAVERSE COORDINATE SCHEDULE			
POINT	NORTHING	EASTING	ELEVATION
24B5	586,956.27	1,356,570.78	390.17
101	586,834.61	1,357,434.96	370.99

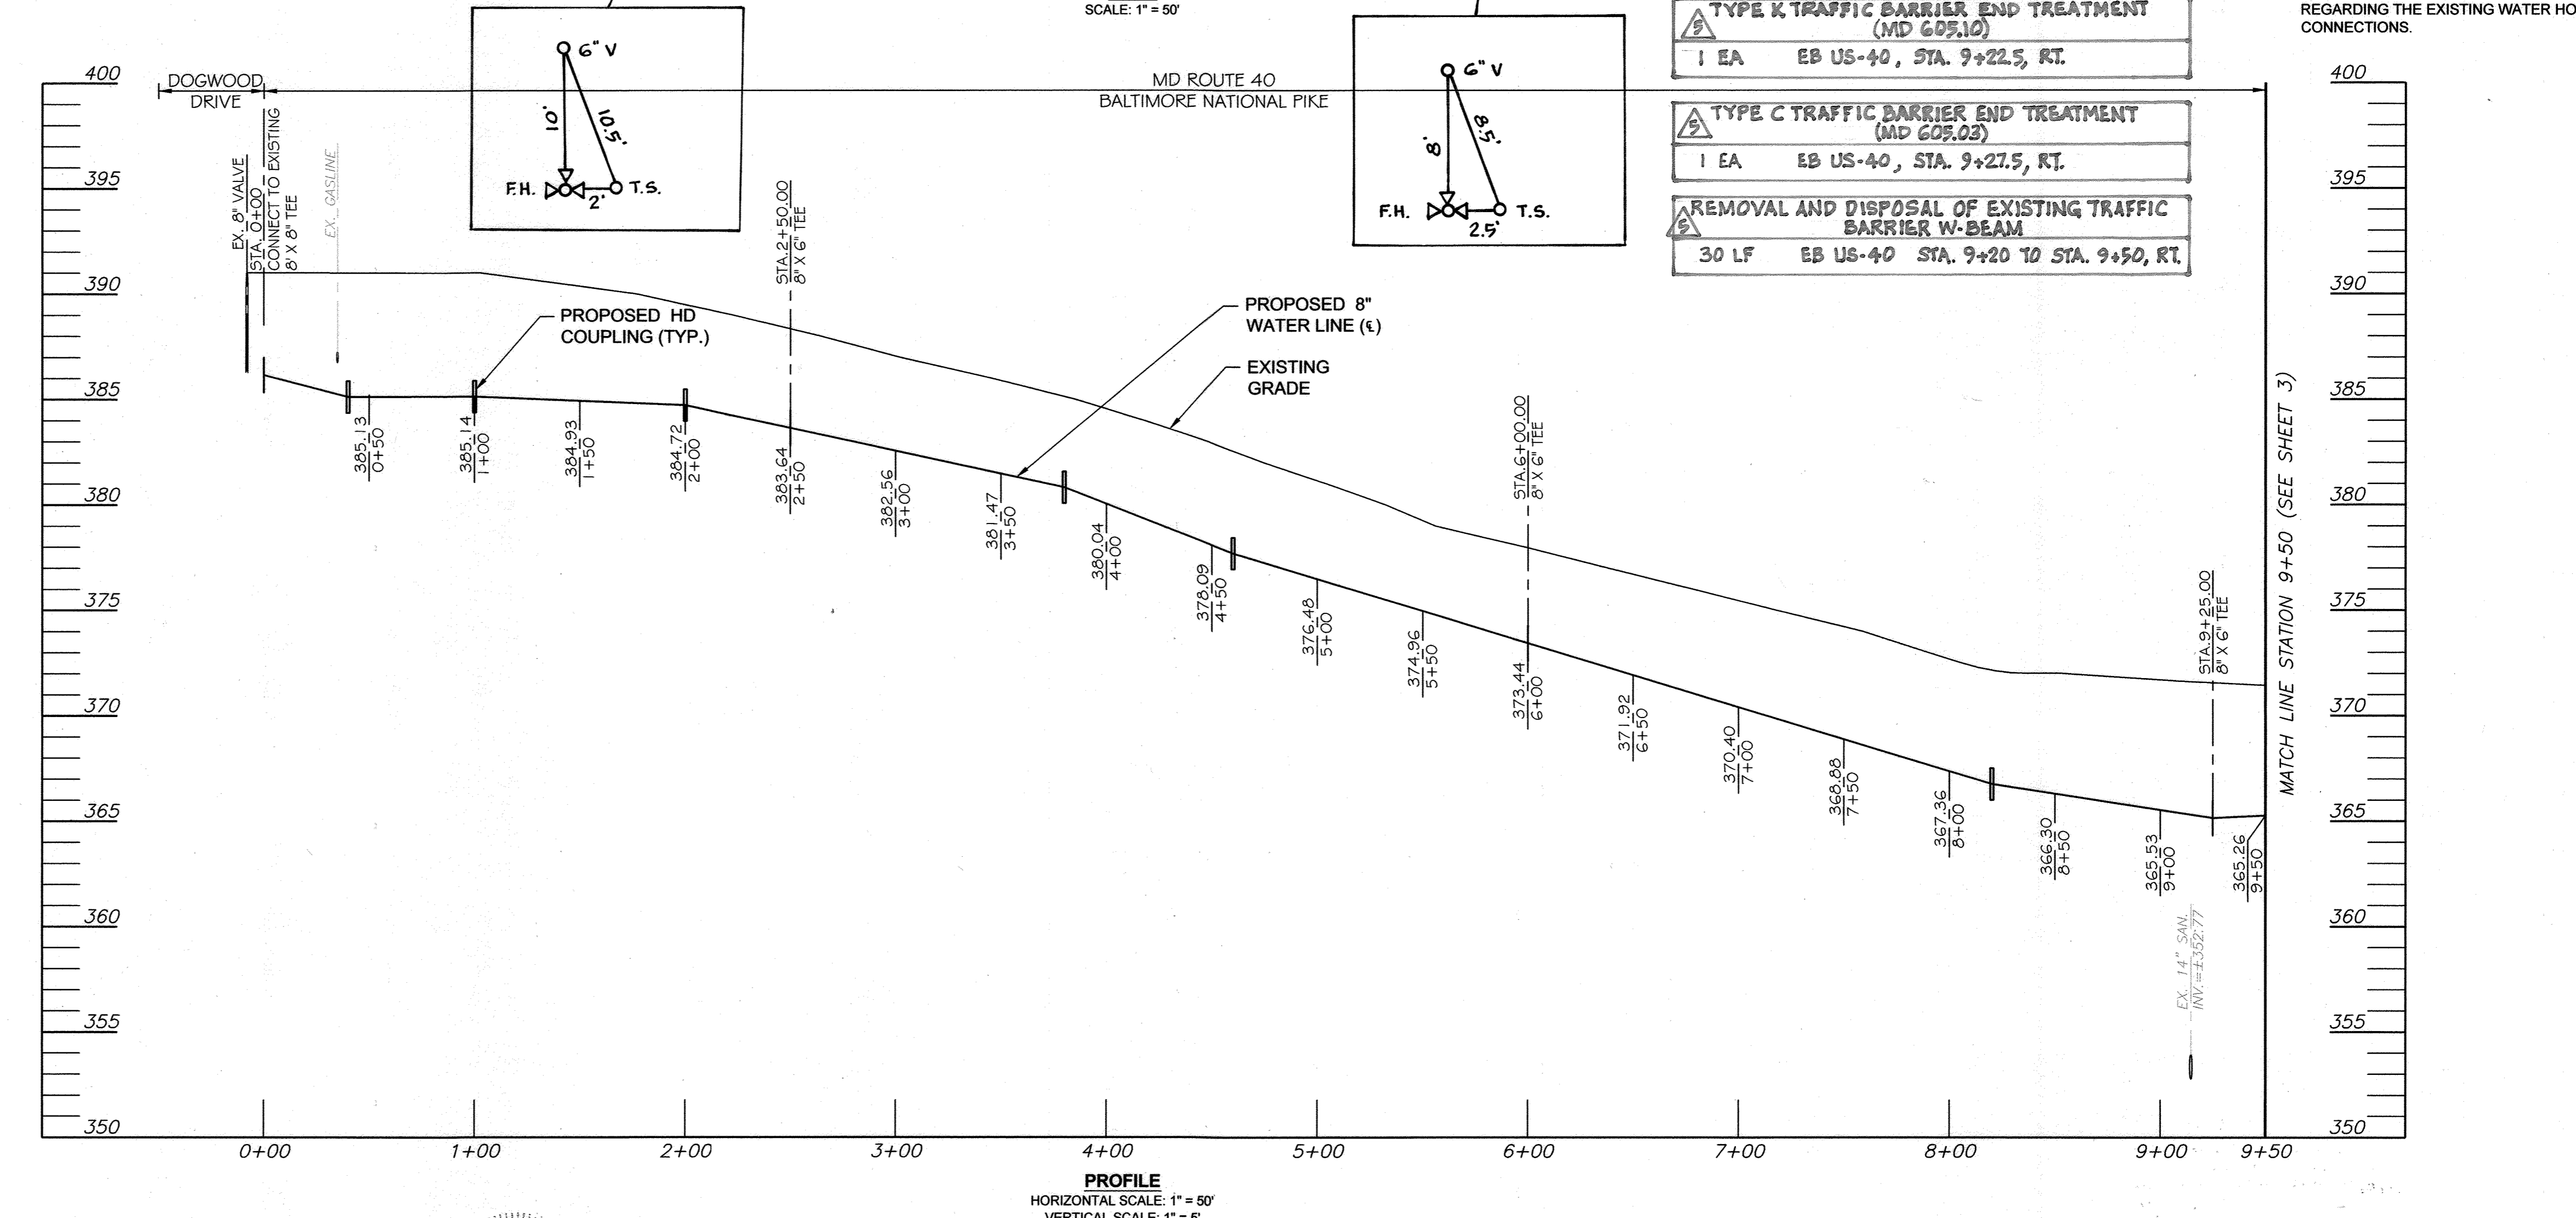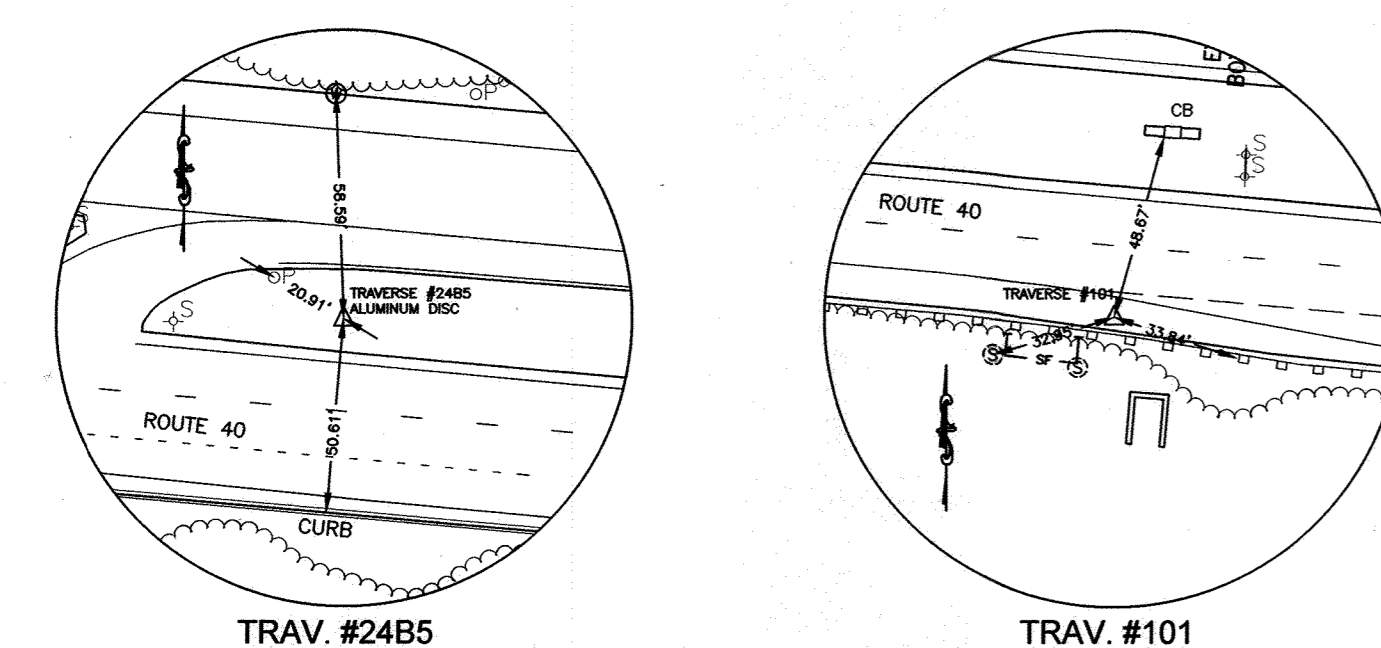

- TYPE K TRAFFIC BARRIER END TREATMENT (MD 605.10)
1 EA EB US-40, STA. 9+22.5, RT.
- TYPE C TRAFFIC BARRIER END TREATMENT (MD 603.03)
1 EA EB US-40, STA. 9+27.5, RT.
- REMOVAL AND DISPOSAL OF EXISTING TRAFFIC BARRIER W-BEAM
30 LF EB US-40 STA. 9+20 TO STA. 9+50, RT.

DEPARTMENT OF PUBLIC WORKS
HOWARD COUNTY, MARYLAND

3/13/13
DATE

3/13/13
DATE

3/12/13
DATE

URS

MONTGOMERY PARK BUSINESS CENTER
1800 WASHINGTON BOULEVARD, SUITE 410
BALTIMORE, MARYLAND 21230
(410) 468-0875

Professional Certification
I hereby certify that these documents were prepared or approved by me, and that I am a duly licensed professional engineer under the laws of the State of Maryland, License No. 28817, Expiration Date: 08/01/13

NATHAN C. ATKINSON

DESIGN:	DATE:	BY:
NCA	2/3/2014	URS
BJW		
EMT		
3/7/13	NO.	REVISION

8" WATER MAIN
PLAN AND PROFILE
STATION 0+00 - 9+50

600' SCALE MAP NO. 24
BLOCK NO. 12



U.S. 40 WATER SERVICE MAIN REPLACEMENT
CAPITAL PROJECT NO. W-8311
CONTRACT NO. 44-4731
6TH ELECTION DISTRICT
HOWARD COUNTY, MARYLAND

SCALE:
AS SHOWN

SHEET
2 OF 13








AS-BUILT 1/2015

WATER MAIN STAKE-OUT SCHEDULE				
Station	Fitting	Northing	Easting	Invert
10+00.00	0.75" HD COUPLING (VERT.)	586,830.22	1,357,489.83	367.11
11+25.04	8" x 8" TEE	586,818.94	1,357,614.35	367.31
11+40.00	0.75" HD COUPLING (VERT.)	586,817.55	1,357,629.25	367.58
13+40.00	1.50" HD COUPLING (VERT.)	586,799.04	1,357,828.39	373.72
14+60.00	3.00" HD COUPLING (VERT.)	586,787.93	1,357,947.87	374.27
14+78.98	8" x 8" TEE	586,786.17	1,357,966.78	375.39
14+78.98	8" VALVE & ROADWAY BOX	586,781.76	1,357,966.35	375.39
14+95.14	8" VALVE & ROADWAY BOX	586,784.68	1,357,982.86	376.28
15+04.74	8" x 8" TEE	586,783.79	1,357,992.42	376.81
15+09.00	TEST STATION	586,771.98	1,357,995.61	-
15+15.00	8" x 6" TEE	586,783.11	1,358,002.66	377.44
15+15.00	6" VALVE & ROADWAY BOX	586,778.90	1,358,002.22	377.44
15+15.00	FIRE HYDRANT (5'-0" BURY)	586,771.46	1,358,001.55	377.44
15+40.00	2.25" HD COUPLING (VERT.)	586,780.54	1,358,027.53	378.82
15+69.00	TEST STATION	586,766.28	1,358,055.34	-
15+75.00	8" x 6" TEE	586,777.40	1,358,062.39	379.49
15+75.00	6" VALVE & ROADWAY BOX	586,772.79	1,358,061.95	379.49
15+75.00	FIRE HYDRANT (5'-0" BURY)	586,769.75	1,358,061.28	379.49
17+50.00	1/8 BEND (HORIZ.)	586,761.20	1,358,236.64	382.99
17+55.00	1/8 BEND (HORIZ.)	586,769.72	1,358,242.08	382.68
17+66.89	8" x 8" TEE	586,764.63	1,358,253.86	382.84
17+80.60	METER CONNECTION	586,763.37	1,358,267.54	383.08
18+46.76	METER CONNECTION	586,757.33	1,358,292.88	384.26
18+73.30	8" x 6" TEE	586,754.83	1,358,353.86	384.73
18+73.30	6" VALVE & ROADWAY BOX	586,753.67	1,358,359.76	384.73
18+79.96	TEST STATION	586,729.26	1,358,364.34	-
18+95.00	1/8 BEND (HORIZ.)	586,752.98	1,358,381.46	385.15
19+00.00	1/8 BEND (HORIZ.)	586,747.57	1,358,386.02	385.24
19+10.00	1.00" HD COUPLING (VERT.)	586,746.71	1,358,395.98	385.92
19+34.24	METER CONNECTION	586,744.25	1,358,428.04	386.38
20+00.00	0.50" HD COUPLING (VERT.)	586,739.03	1,358,485.65	386.22

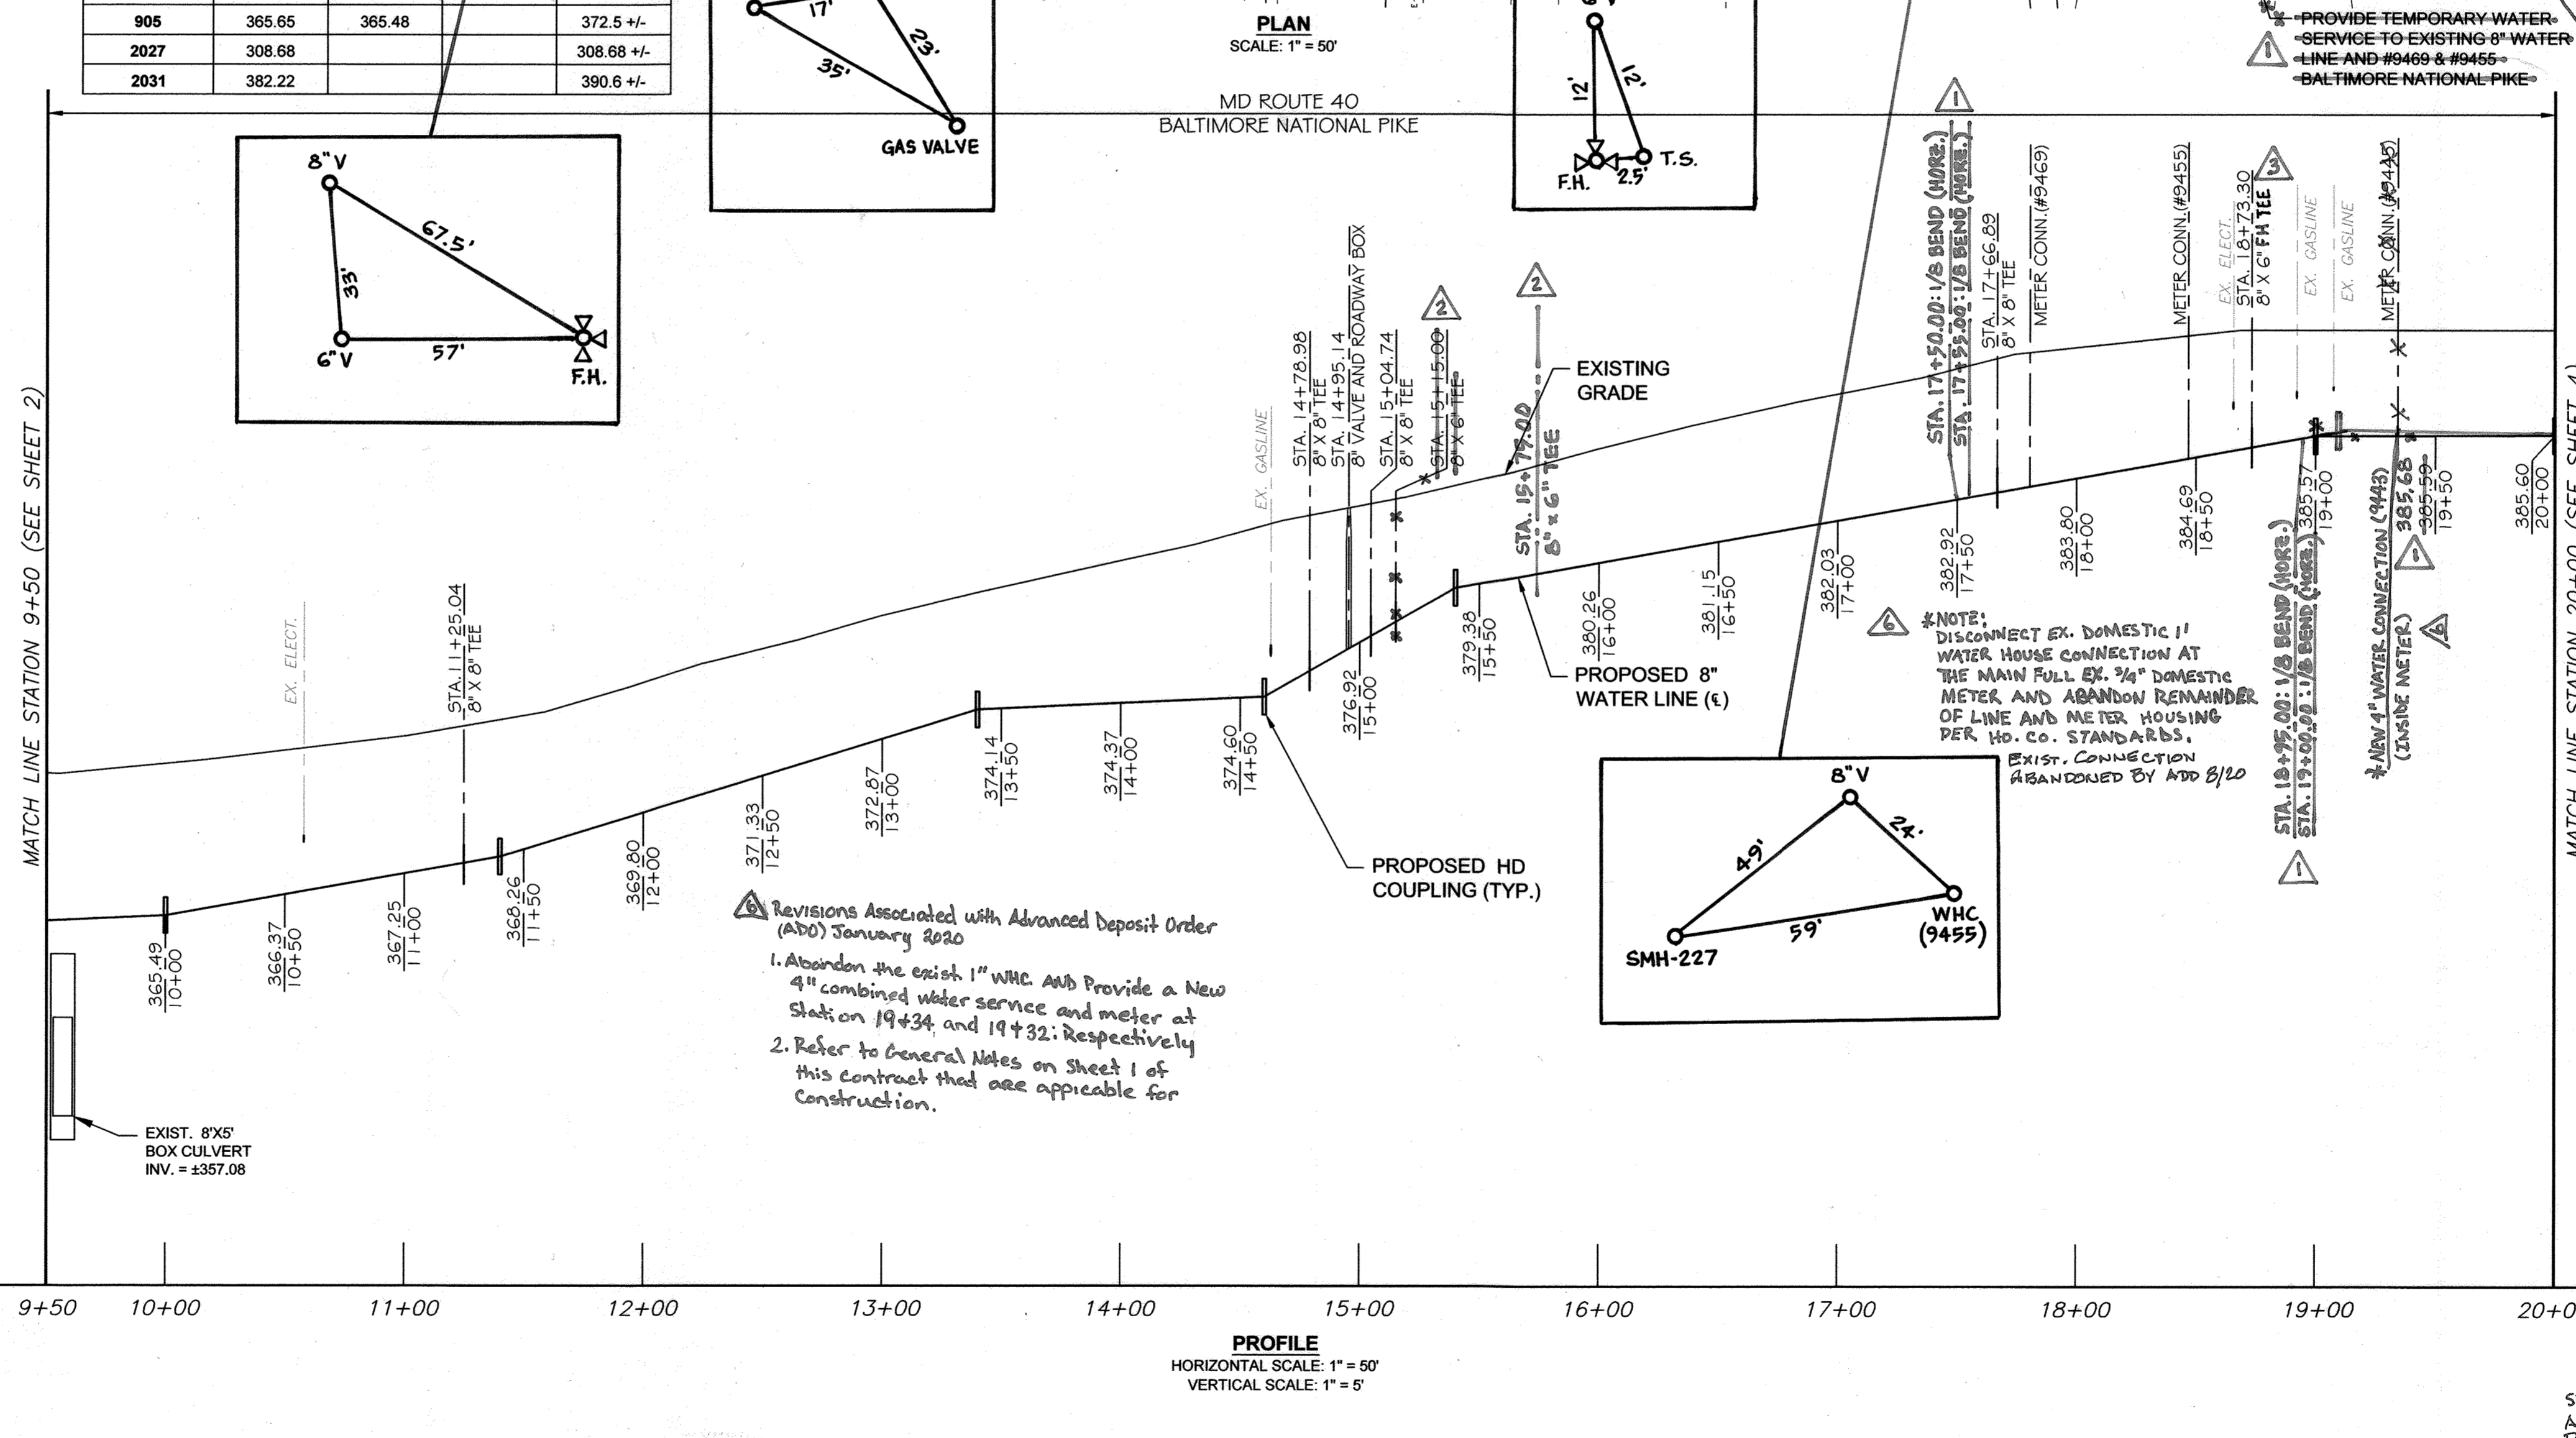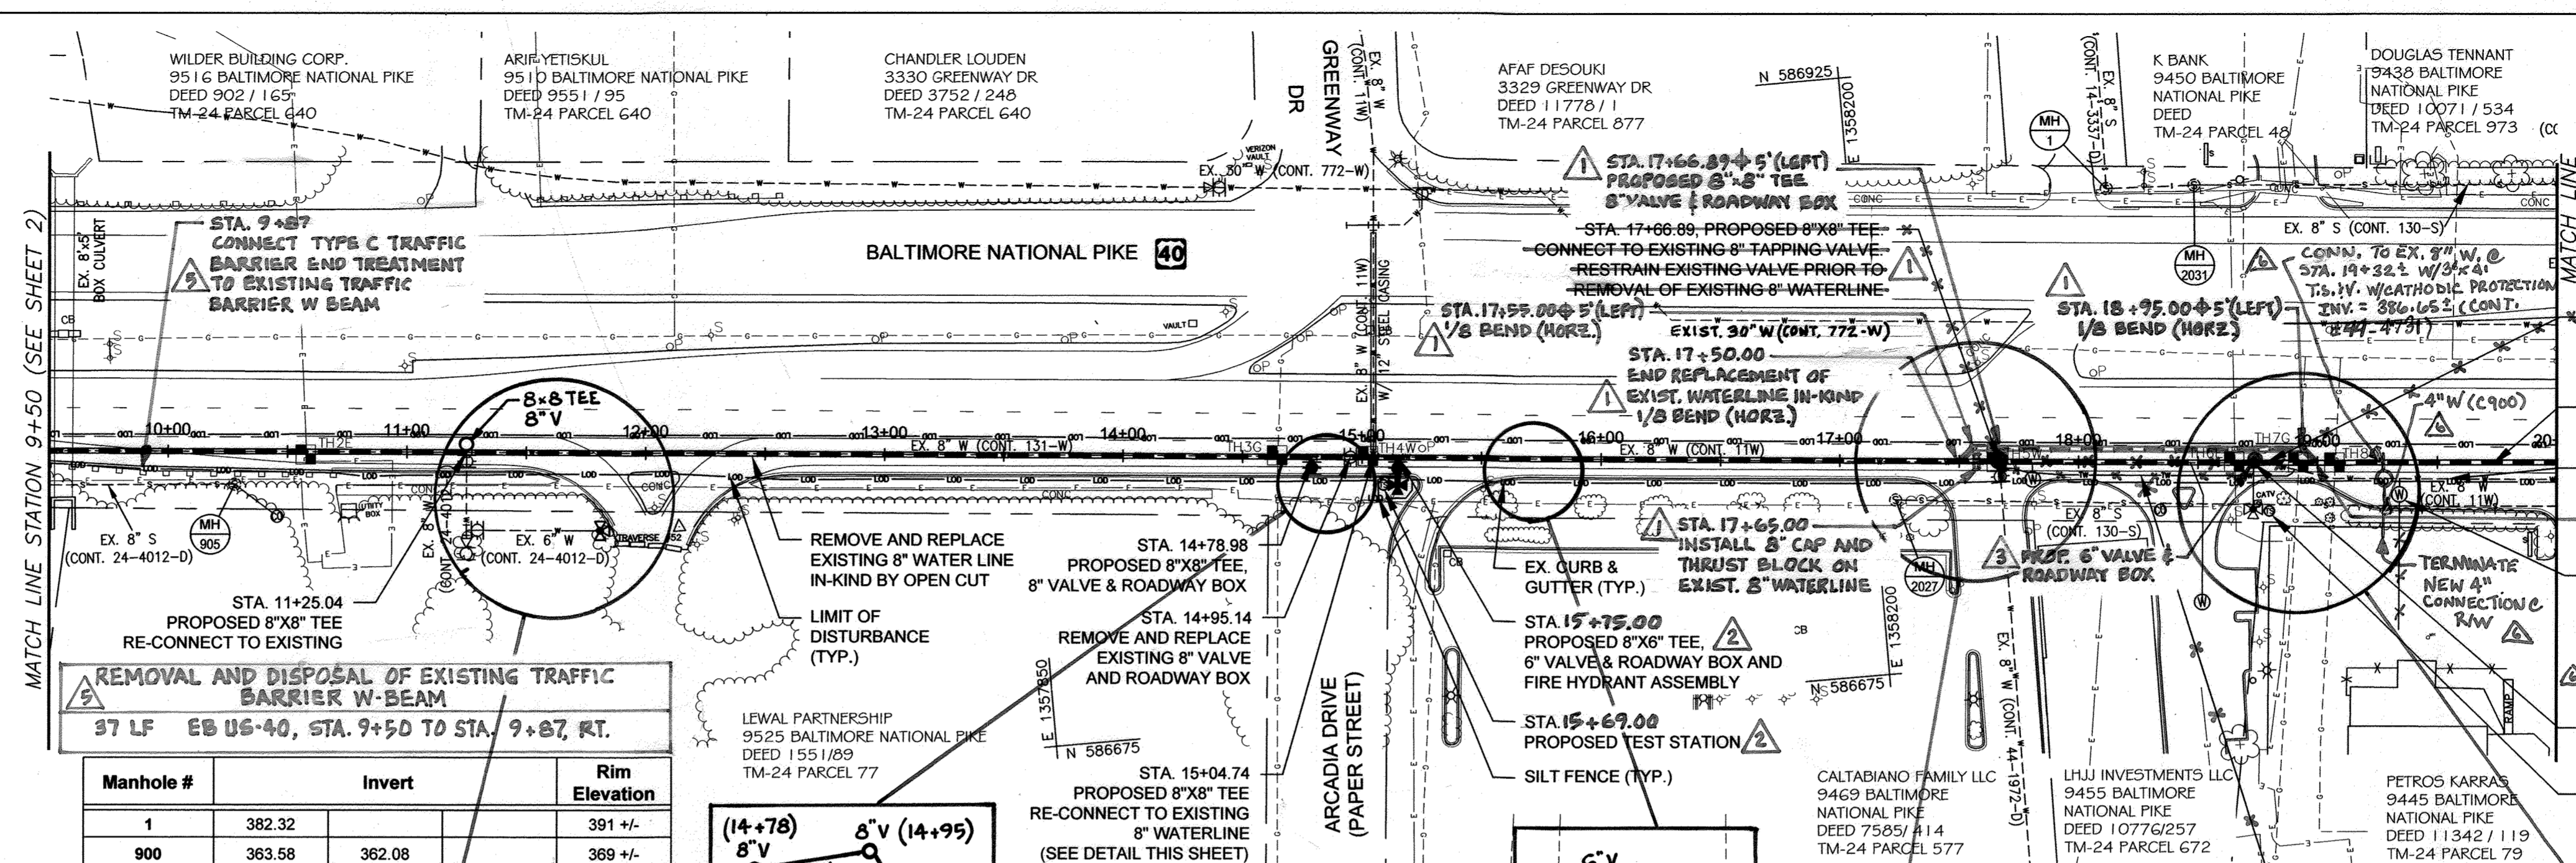

TEST PIT DATA		
TEST PIT NUMBER	TYPE OF UTILITY	TOP DEPTH
TH 2E	4" PLASTIC ELECTRIC CONDUIT	3.62
TH 3G	6" WRAPPED STEEL GAS PIPE	5.05
TH 4W	8" x 8" CAST IRON WATER TEE	5.84
TH 5W	8" x 8" CAST IRON WATER TEE	4.05
TH 6E	4" STEEL ELECTRIC CONDUIT	2.94
TH 6A	SEE TEST HOLE REPORT	DRY
TH 7G	4" STEEL GAS PIPE	2.52
TH 8G	1 1/4" PLASTIC GAS PIPE	2.34

TRAVERSE COORDINATE SCHEDULE			
POINT	NORTHING	EASTING	ELEVATION
52	586,780.17	1,357,700.32	376.13

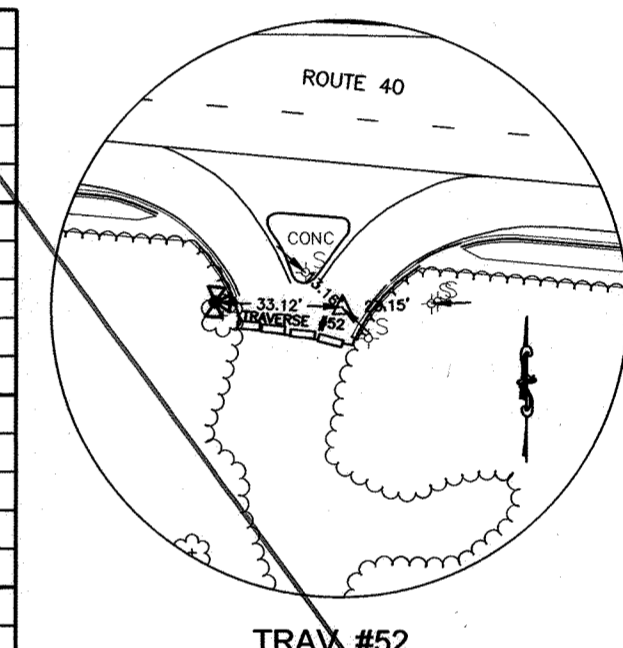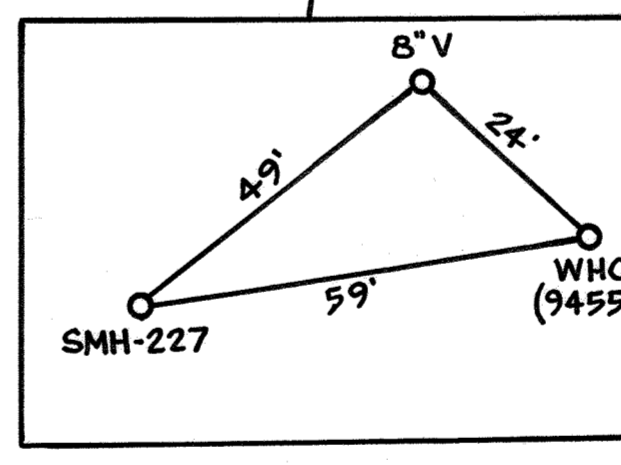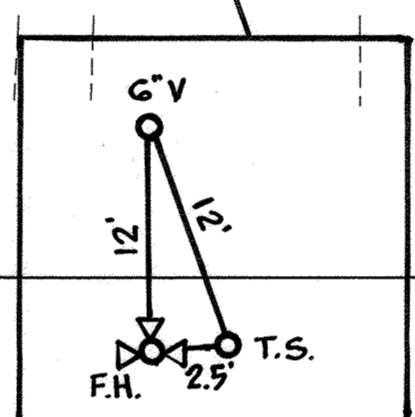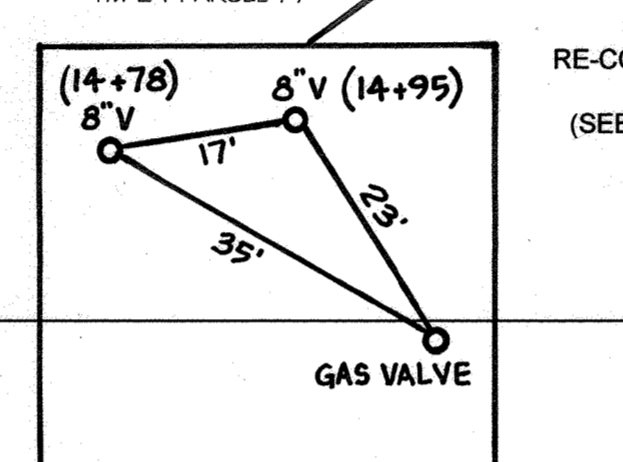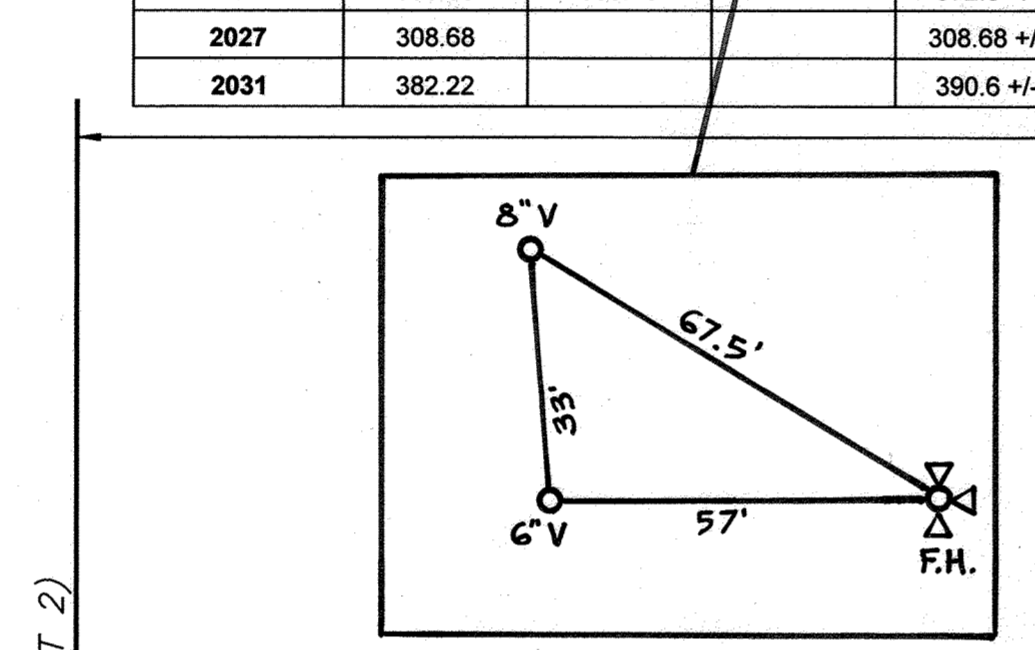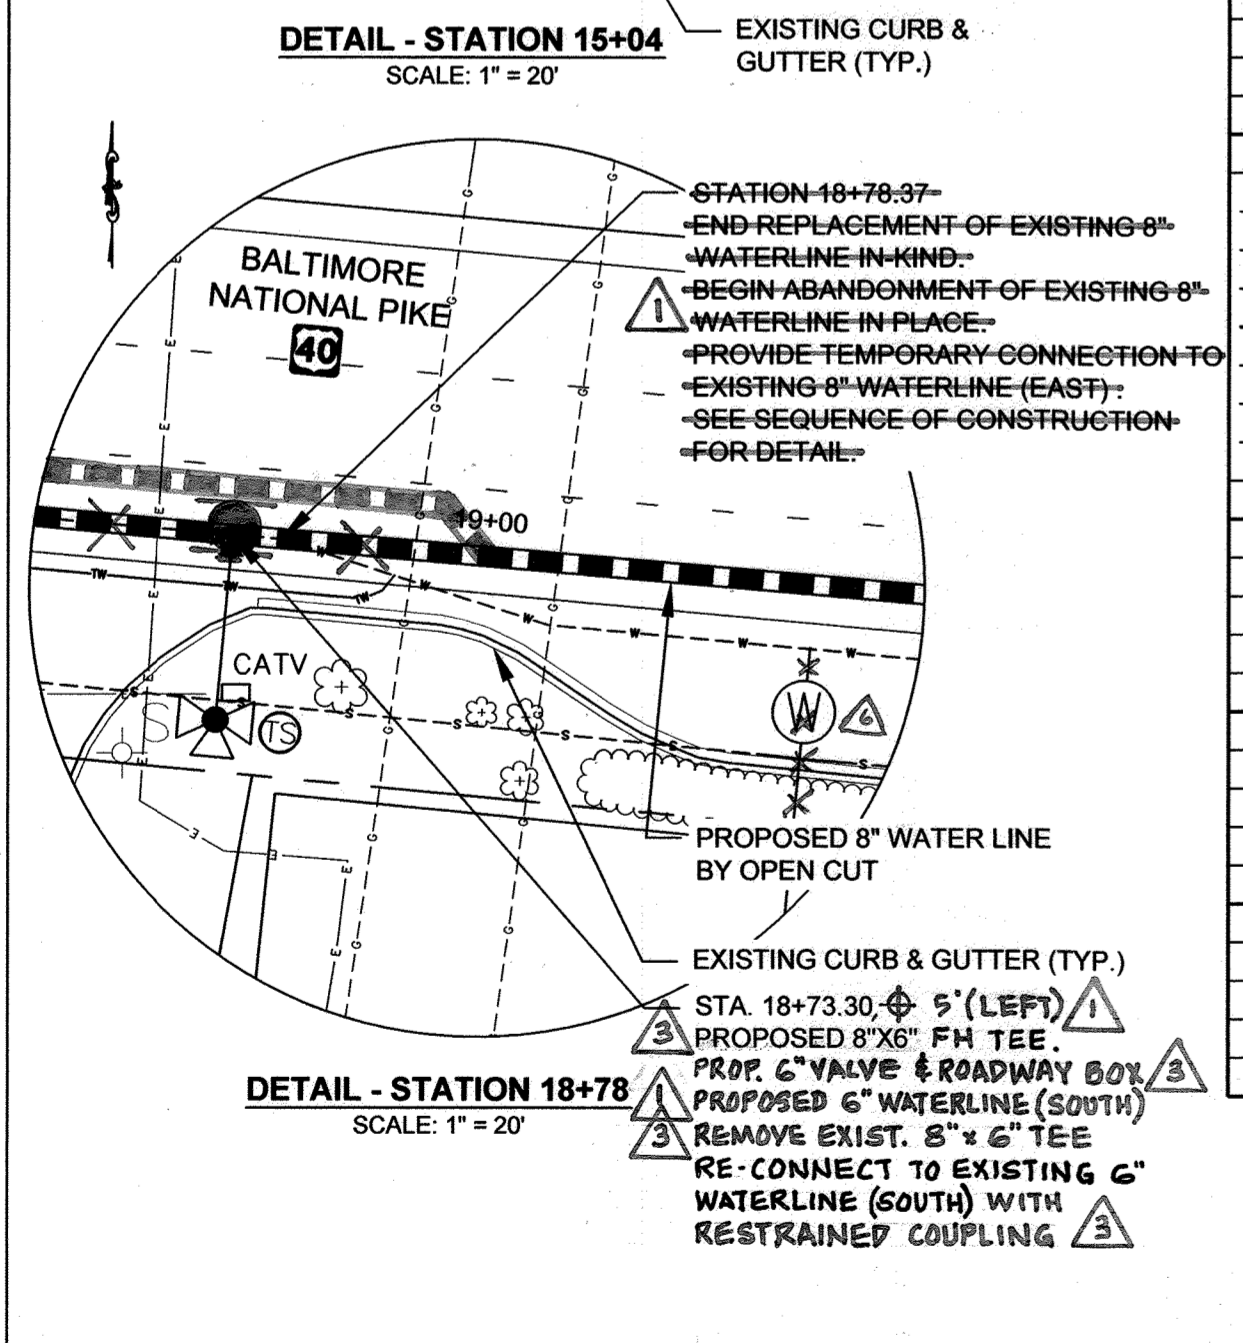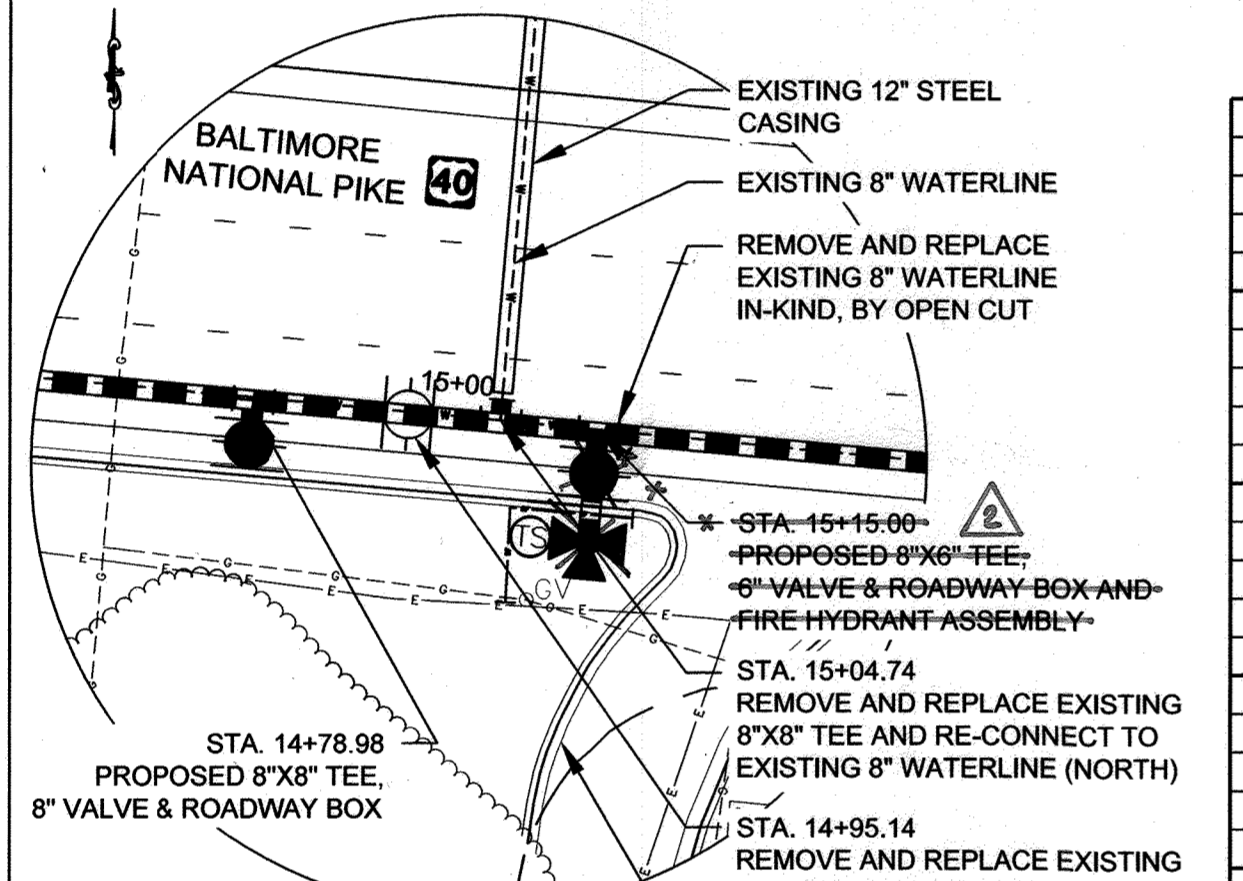

Revisions Associated with Advanced Deposit Order (ADO) January 2020

1. Abandon the exist 1" WHC and provide a New 4" combined water service and meter at Station 19+34 and 19+32; respectively
2. Refer to General Notes on Sheet 1 of this contract that are applicable for construction.

APPROVED FOR ADO
 by Bureau of Utilities
 Site Address 3425 Balt. Nat. Pk.
 Approval
 Date 3-3-2020

DEPARTMENT OF PUBLIC WORKS
 HOWARD COUNTY, MARYLAND

Jan P. Lu 3/13/13
 DIRECTOR OF PUBLIC WORKS DATE

Thomas J. Kuttler 3/13/13
 CHIEF, BUREAU OF ENGINEERING DATE

Silvia L. Lewis 3/12/13
 CHIEF, BUREAU OF UTILITIES DATE

Clayton Lewis 3/12/13
 CHIEF, UTILITY DESIGN DIVISION DATE

URS

MONTGOMERY PARK BUSINESS CENTER
 1800 WASHINGTON BOULEVARD, SUITE 410
 BALTIMORE, MARYLAND 21230
 (410) 468-0875

Professional Certification
 I hereby certify that these documents were prepared or approved by me, and that I am a duly licensed professional engineer under the laws of the State of Maryland, License No. 28817, Expiration Date: 08/01/13

NATHAN C. ATKINSON

DESIGN	REVISION	DATE	BY
NCA	REMOVE TEMP. WATER SERVICE, REVISE ALIGNMENT	9/13/2018	URS
BW	RELOCATE PROPOSED FIRE HYDRANT	10/14/2018	URS
EMT	ADD PROP. 6" VALVE AND ROADWAY BOX	11/15/2018	URS
EMT	ADD MODIFICATIONS TO EXISTING GUARDRAIL	2/3/2014	URS
EMT	REV. PLAN TO ADD 4" WATER SERVICE INSIDE METER	1/23/2020	URS

8" WATER MAIN
 PLAN AND PROFILE
 STATION 9+50 - 20+00

600' SCALE MAP NO. 24
 BLOCK NO. 12


U.S. 40 WATER SERVICE MAIN REPLACEMENT
 CAPITAL PROJECT NO. W-8311
 CONTRACT NO. 44-4731
 6TH ELECTION DISTRICT
 HOWARD COUNTY, MARYLAND

SCALE:
 AS SHOWN

SHEET
 3 OF 13




AS-BUILT 1/2015

Manhole #	Invert	Rim Elevation
2024	376.31	387.00 +/-
2025	378.84	389.38 +/-
2026	380.16	390.21 +/-
2028	375.26	384.80 +/-
2029	377.72	386.80 +/-
2030	380.09	391.10 +/-

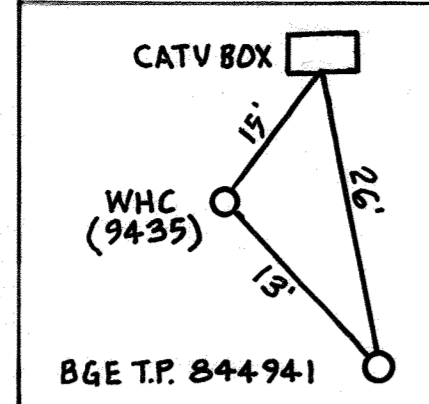

Station	Fitting	Northing	Easting	Invert
21+00.00	0.50" HD COUPLING (VERT.)	586,730.48	1,358,585.29	383.98
21+08.75	METER CONNECTION	586,729.73	1,358,594.01	383.95
21+57.45	8" x 6" TEE	586,725.40	1,358,644.52	383.74
21+59.46	6" VALVE & ROADWAY BOX	586,725.29	1,358,644.42	383.74
21+66.84	TEST STATION	586,711.58	1,358,650.72	-
22+15.78	METER CONNECTION	586,720.38	1,358,700.63	383.51
23+00.00	1.00" HD COUPLING (VERT.)	586,712.86	1,358,784.51	383.16
23+04.69	8" VALVE & ROADWAY BOX	586,705.31	1,358,869.84	381.24
23+07.83	8" x 6" REDUCER	586,676.61	1,358,869.20	381.31
23+05.84	8" VALVE AND ROADWAY BOX	586,700.59	1,358,869.58	381.31
23+05.86	8" x 6" TEE	586,705.20	1,358,870.03	381.31
23+07.03	8" VALVE & ROADWAY BOX	586,702.07	1,358,871.20	381.27
24+20.00	2.0" HD COUPLING (VERT.)	586,702.05	1,358,704.02	380.57
24+64.00	TEST STATION	586,676.29	1,358,945.82	-
24+70.00	8" x 6" TEE	586,697.43	1,358,953.81	382.11
24+70.00	6" VALVE & ROADWAY BOX	586,692.82	1,358,953.38	382.11
24+70.00	FIRE HYDRANT (6" 0" BURY)	586,675.89	1,358,951.81	382.11
25+00.00	2.50" HD COUPLING (VERT.)	586,694.67	1,358,983.68	383.04
25+26.92	METER CONNECTION	586,692.18	1,359,010.49	382.69
27+57.33	METER CONNECTION	586,670.92	1,359,239.91	379.73
27+69.00	TEST STATION	586,652.96	1,359,249.97	-
27+75.00	8" x 6" TEE	586,669.29	1,359,257.51	379.51
27+75.00	6" VALVE & ROADWAY BOX	586,664.68	1,359,257.08	379.51
27+75.00	FIRE HYDRANT (6" 0" BURY)	586,652.55	1,359,255.96	379.51
28+00.00	1.00" HD COUPLING (VERT.)	586,666.98	1,359,282.40	379.18
28+60.00	0.50" HD COUPLING (VERT.)	586,661.45	1,359,342.14	379.46
29+41.38	METER CONNECTION	586,653.94	1,359,423.18	379.13

TEST PIT NUMBER	TYPE OF UTILITY	DEPTH	TOP
TH 9G	SEE TEST HOLE REPORT	DRY	
TH 9G A	1" UNKNOWN COPPER PIPE	3.62	
TH 10G	1" STEEL GAS PIPE	2.26	
TH 11E	(6) 3/4" ELECTRIC CABLES	3.14	
TH 12E	4" PLASTIC ELECTRIC CONDUIT	3.45	
TH 12E A	(4) 1 1/2" CTY CABLES	3.50	
TH 13W	8" CAST IRON WATER PIPE	4.76	
TH 14G	4" WRAPPED STEEL GAS PIPE	5.10	
TH 15T	(3) 4" PLASTIC TELEPHONE CONDUITS	3.65	
TH 16W	8" CAST IRON WATER PIPE	3.84	
TH 17E	4" PLASTIC ELECTRIC CONDUIT	2.65	
TH 17E A	6" STEEL TELEPHONE CONDUIT	2.98	
TH 17E B	4" PLASTIC ELECTRIC CONDUIT	3.10	
TH 18G	1/2" PLASTIC GAS PIPE	2.62	

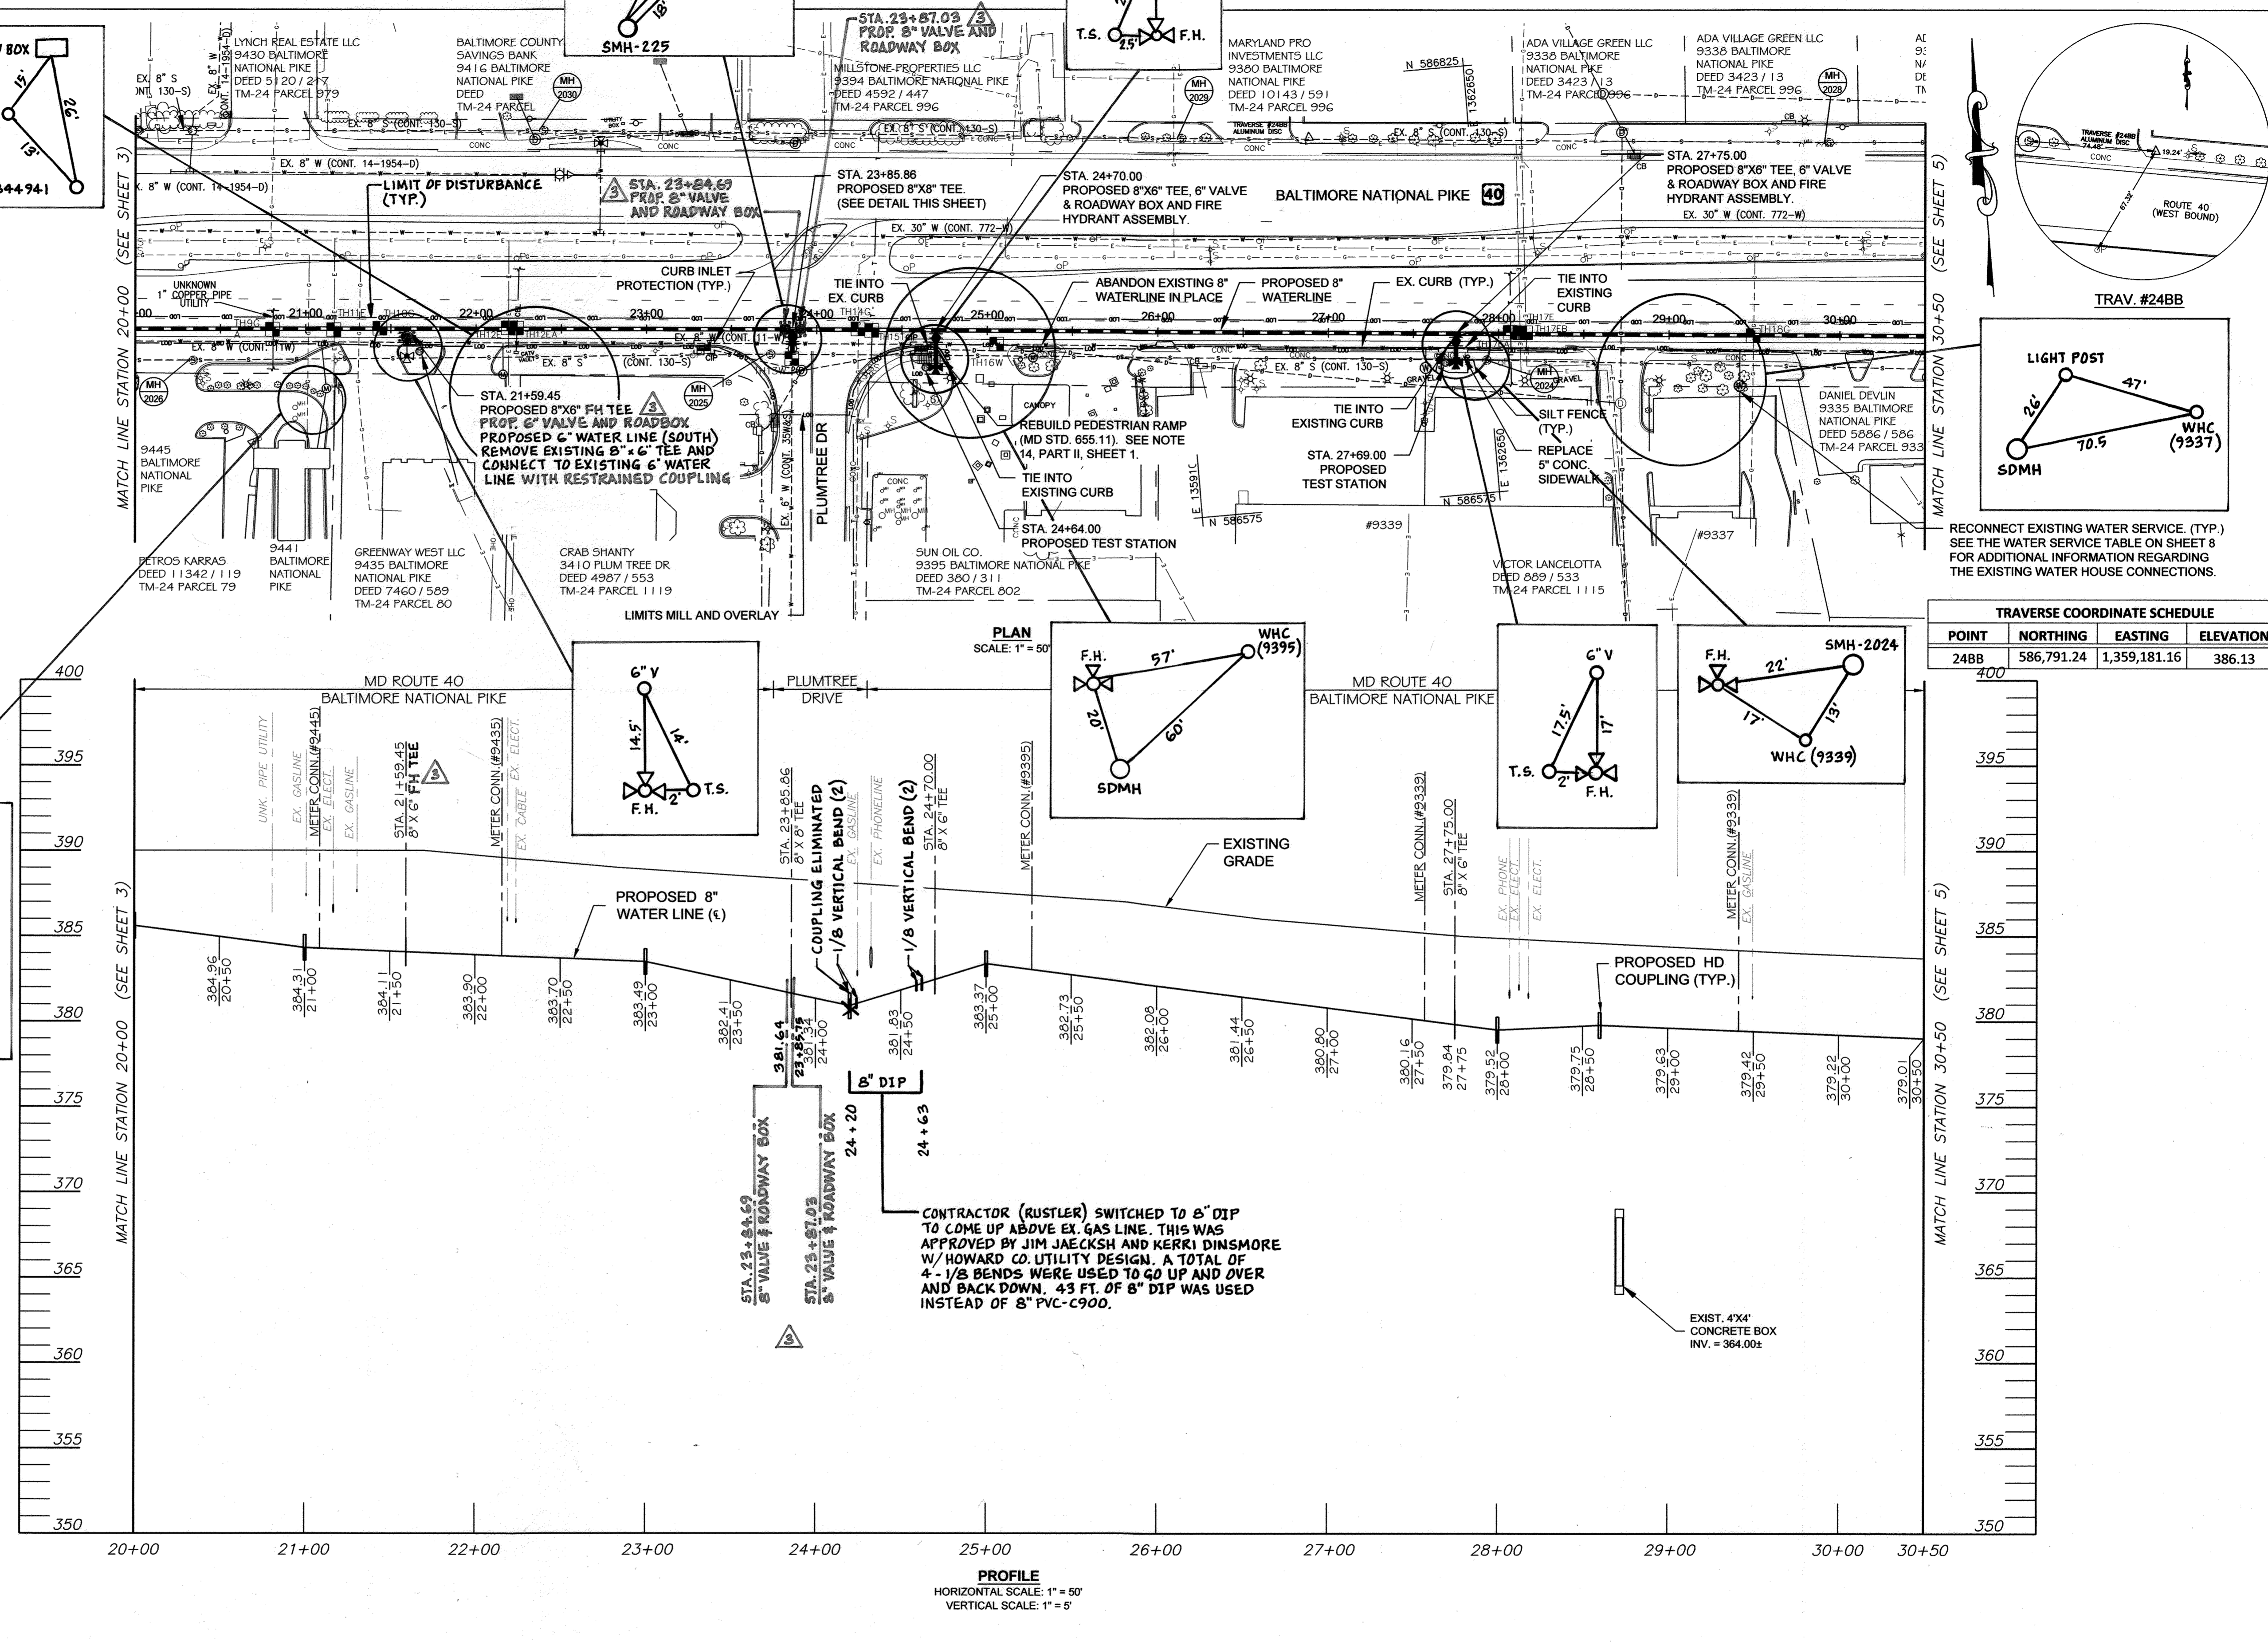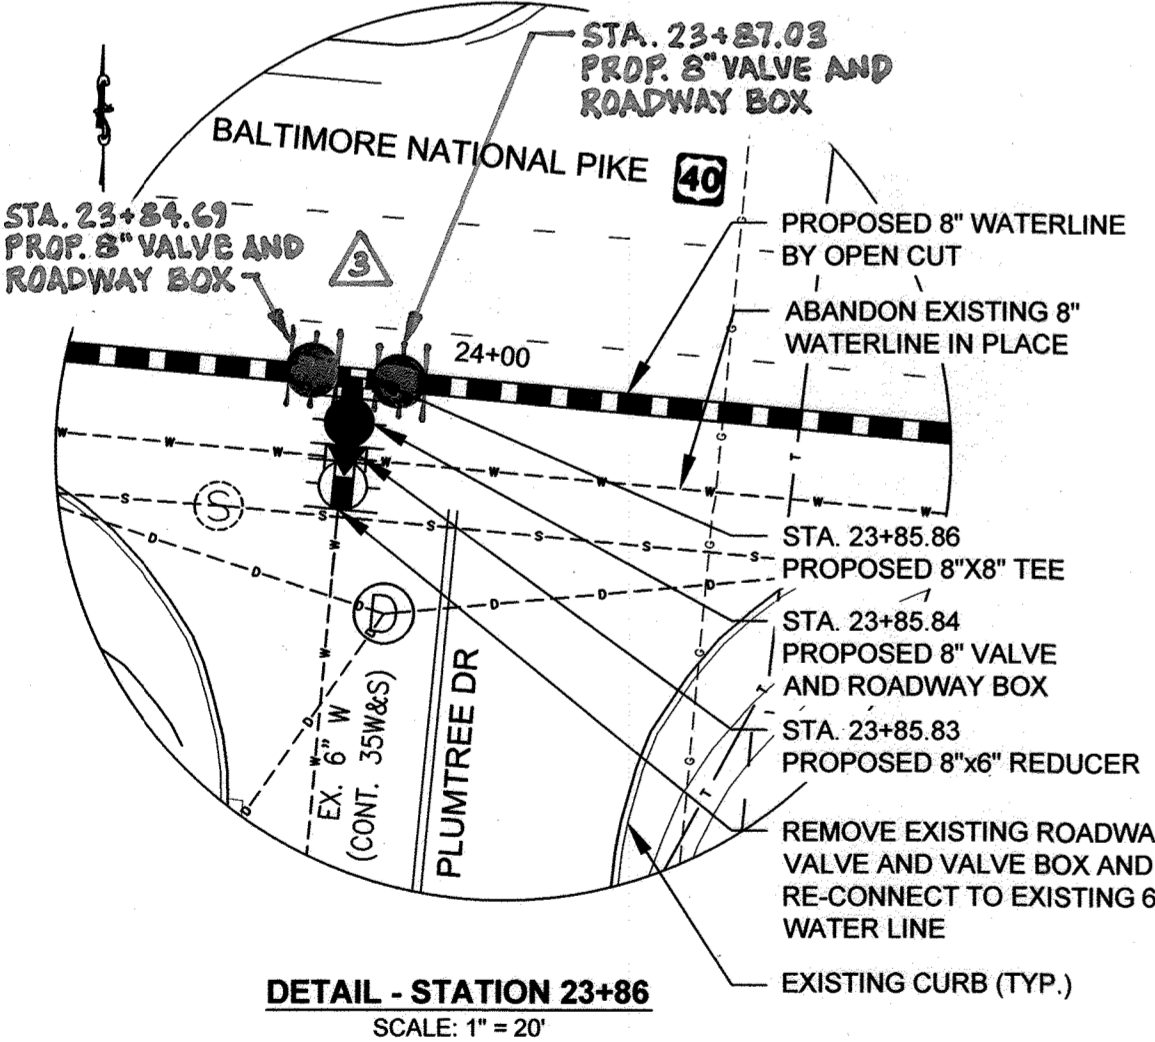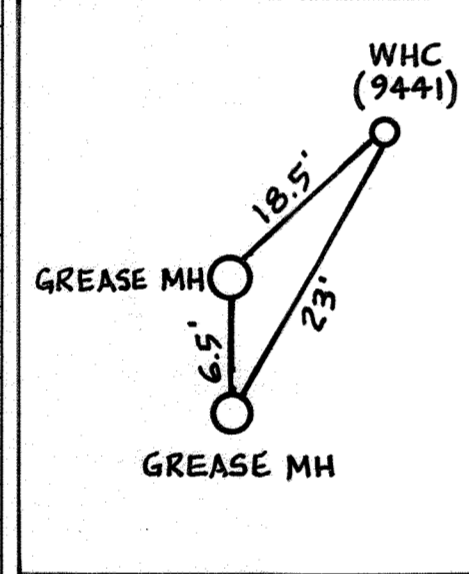

POINT	NORTHING	EASTING	ELEVATION
24BB	586,791.24	1,359,181.16	386.13

DEPARTMENT OF PUBLIC WORKS
HOWARD COUNTY, MARYLAND

Director of Public Works: *[Signature]* 3/13/13
Chief, Bureau of Engineering: *[Signature]* 3/13/13

Chief, Bureau of Utilities: *[Signature]* 3/13/13
Chief, Utility Design Division: *[Signature]* 3/12/13

URS
MONTGOMERY PARK BUSINESS CENTER
1800 WASHINGTON BOULEVARD, SUITE 410
BALTIMORE, MARYLAND 21230
(410) 468-0875

Professional Certification: I hereby certify that these documents were prepared or approved by me, and that I am a duly licensed professional engineer under the laws of the State of Maryland, License No. 28817, Expiration Date: 08/01/13
NATHAN C. ATKINSON

DESIGN:	DATE:	BY:
NCA	3/7/13	NO.
BJW		
EMT		

8" WATER MAIN
PLAN AND PROFILE
STATION 20+00 - 30+50

60' SCALE MAP NO. 24
BLOCK NO. 12

U.S. 40 WATER SERVICE MAIN REPLACEMENT
CAPITAL PROJECT NO. W-8311
CONTRACT NO. 44-4731
6TH ELECTION DISTRICT
HOWARD COUNTY, MARYLAND

SCALE: AS SHOWN
SHEET 4 OF 13










AS-BUILT 1/2015

WATER MAIN STAKE-OUT SCHEDULE				
Station	Fitting	Northing	Easting	Invert
30+51.05	METER CONNECTION	586,643.82	1,359,532.38	378.68
30+65.85	TEST STATION	586,625.35	1,359,545.53	-
30+72.67	8" x 6" TEE	586,641.82	1,359,553.91	378.59
30+72.67	6" VALVE & ROADWAY BOX	586,640.69	1,359,553.82	378.57
30+89.58	METER CONNECTION	586,640.26	1,359,570.74	378.52
32+58.84	METER CONNECTION	586,624.64	1,359,739.28	377.82
32+75.85	TEST STATION	586,606.21	1,359,754.66	-
32+81.92	8" x 6" TEE	586,622.51	1,359,762.26	377.73
32+81.92	6" VALVE & ROADWAY BOX	586,621.35	1,359,762.15	377.73
33+02.84	8" VALVE & ROADWAY BOX	586,620.58	1,359,783.09	377.64
33+10.11	8" x 8" TEE	586,619.91	1,359,790.33	377.61
33+10.15	8" VALVE & ROADWAY BOX	586,623.71	1,359,790.76	377.61
33+45.55	0.75" HD COUPLING (VERT.)	586,616.36	1,359,825.60	377.47
33+62.39	8" VALVE & ROADWAY BOX	586,614.67	1,359,841.35	377.62
33+63.56	8" x 8" TEE	586,614.55	1,359,843.51	377.63
33+63.56	8" VALVE & ROADWAY BOX	586,609.94	1,359,843.13	377.63
33+64.73	8" VALVE & ROADWAY BOX	586,614.44	1,359,844.68	377.64
33+79.61	1.50" HD COUPLING (VERT.)	586,612.99	1,359,859.49	377.77
34+25.90	0.75" HD COUPLING (VERT.)	586,608.48	1,359,905.56	376.98
35+03.54	1/8 BEND (HOR.)	586,600.90	1,359,982.83	376.66
35+11.68	1/8 BEND (HOR.)	586,606.08	1,359,989.11	376.62
35+59.87	TEST STATION	586,586.53	1,360,035.70	-
35+66.47	8" x 6" TEE	586,601.07	1,360,043.67	376.40
35+66.47	6" VALVE & ROADWAY BOX	586,599.90	1,360,043.56	376.40
35+93.90	8" VALVE & ROADWAY BOX	586,598.56	1,360,070.98	376.28
36+68.86	METER CONNECTION	586,591.70	1,360,145.63	375.98
38+08.75	8" x 6" TEE	586,578.90	1,360,284.93	375.40
38+08.75	6" VALVE & ROADWAY BOX	586,577.74	1,360,284.84	375.40
38+15.09	TEST STATION	586,561.21	1,360,289.67	-
38+50.54	1/8 BEND (VERT.)	586,575.08	1,360,326.55	375.23
38+52.01	1/8 BEND (VERT.)	586,574.95	1,360,328.01	375.23
38+71.54	1/8 BEND (VERT.)	586,573.16	1,360,347.48	375.67
38+73.02	1/8 BEND (VERT.)	586,573.02	1,360,348.93	375.12
39+67.06	METER CONNECTION	586,564.42	1,360,442.58	374.32
40+68.76	METER CONNECTION	586,555.12	1,360,543.85	373.46
40+78.63	6" VALVE & ROADWAY BOX	586,553.05	1,360,553.57	373.37
40+84.32	TEST STATION	586,539.46	1,360,558.04	-
41+00.00	2.00" HD COUPLING (VERT.)	586,552.26	1,360,574.96	373.19

TEST PIT DATA		
TEST PIT NUMBER	TYPE OF UTILITY	TOP DEPTH
TH 19G	2" WRAPPED STEEL GAS PIPE	3.08
TH 20G	2" WRAPPED STEEL GAS PIPE	2.57
TH 21W	8" DUCTILE IRON WATER PIPE	3.75
TH 22W	SEE TEST HOLE REPORT	DRY
TH 23T	(6) 4" PLASTIC TELEPHONE CONDUITS	4.96
TH 24G	12" DUCTILE IRON WATER PIPE	4.60
TH 25G	2" WRAPPED STEEL GAS PIPE	2.50
TH 26E	5" STEEL ELECTRIC CONDUIT	3.76
TH 27E	5" STEEL ELECTRIC CONDUIT	3.40
TH 28G	6" STEEL GAS PIPE	2.82

Manhole #	Invert	Rim Elevation
954	369.23	380.40 +/-
955	371.14	381.40 +/-
956	371.70	383.55 +/-
2021	370.08	381.21 +/-
2022	371.88	383.50 +/-
2023	374.16	385.30 +/-

TRAVERSE COORDINATE SCHEDULE			
POINT	NORTHING	EASTING	ELEVATION
53	586,520.50	1,360,511.69	377.37
102	586,534.34	1,360,327.28	379.99

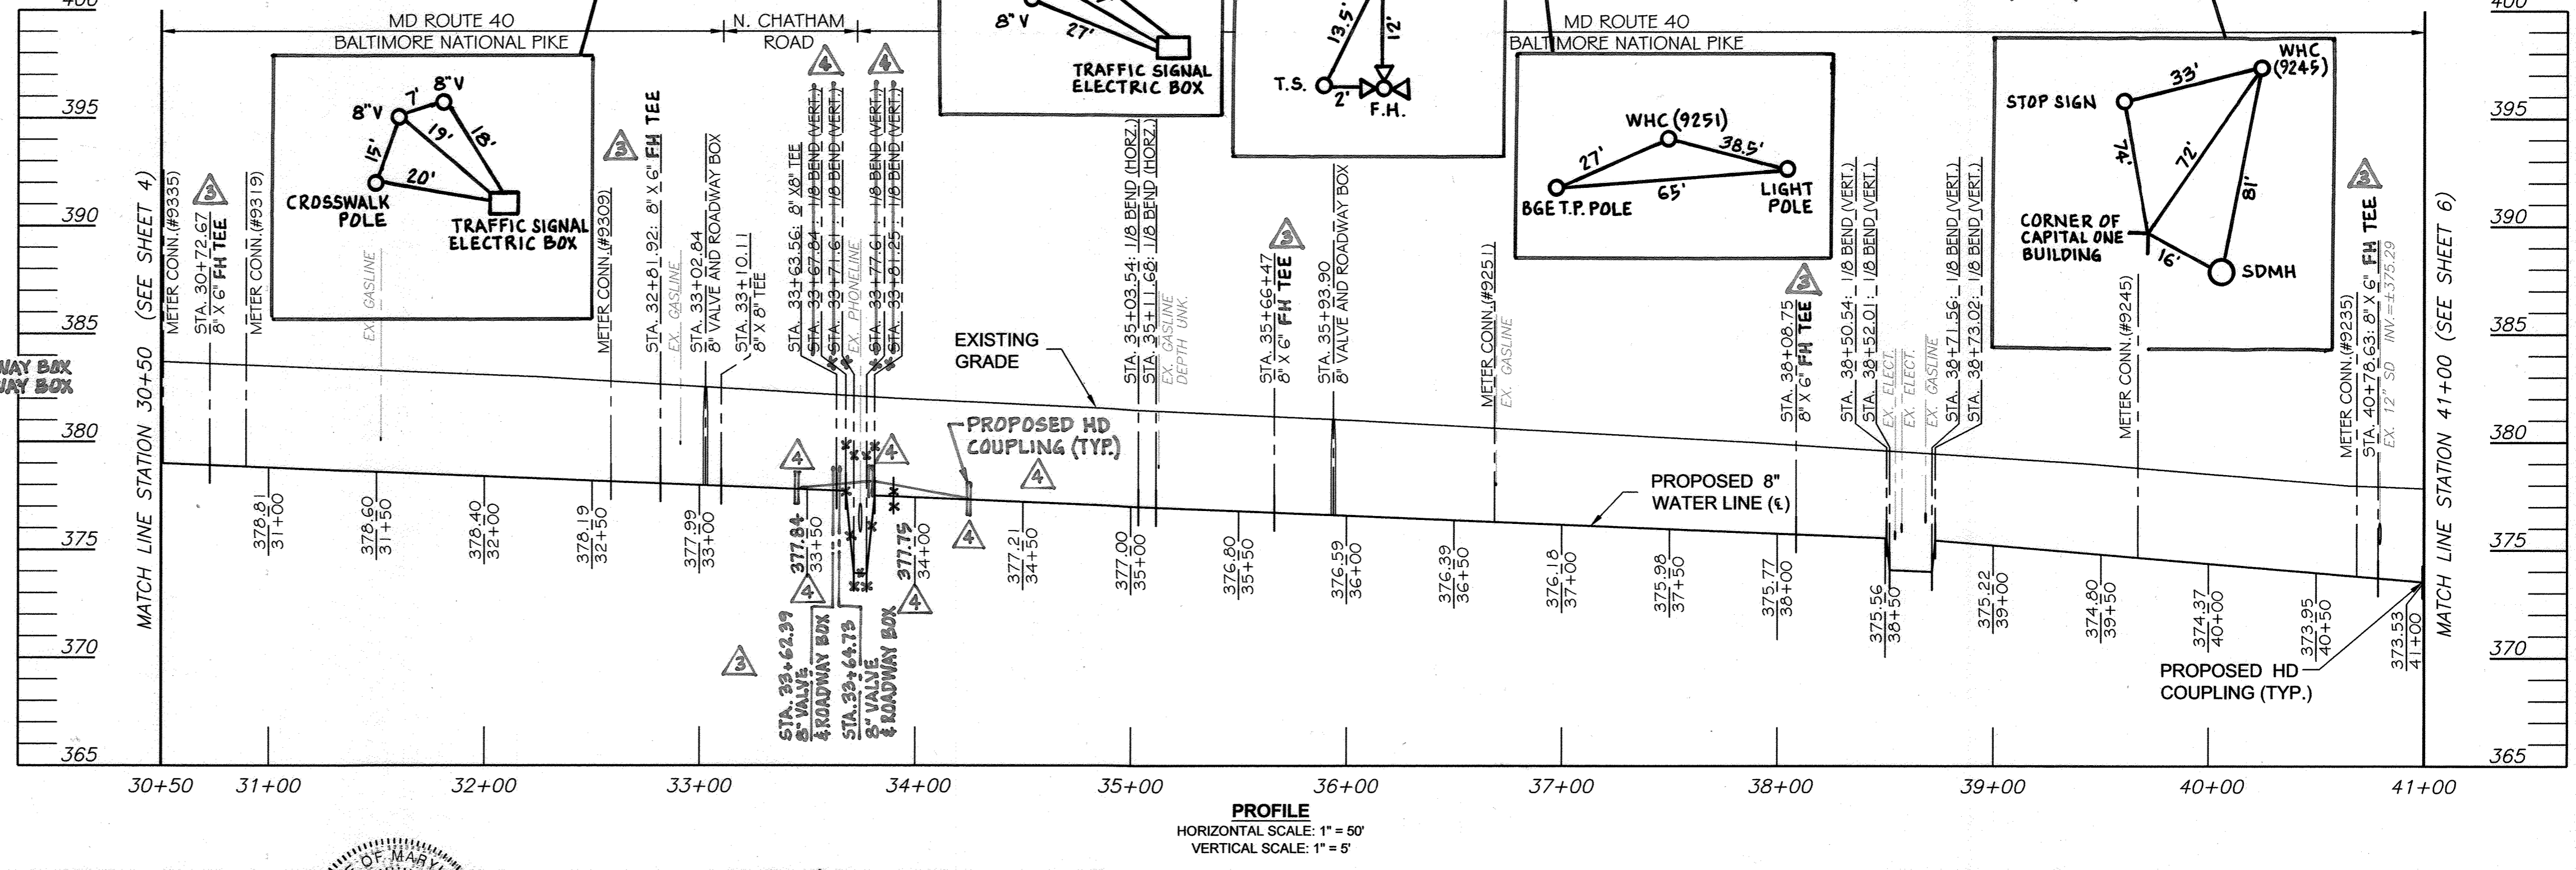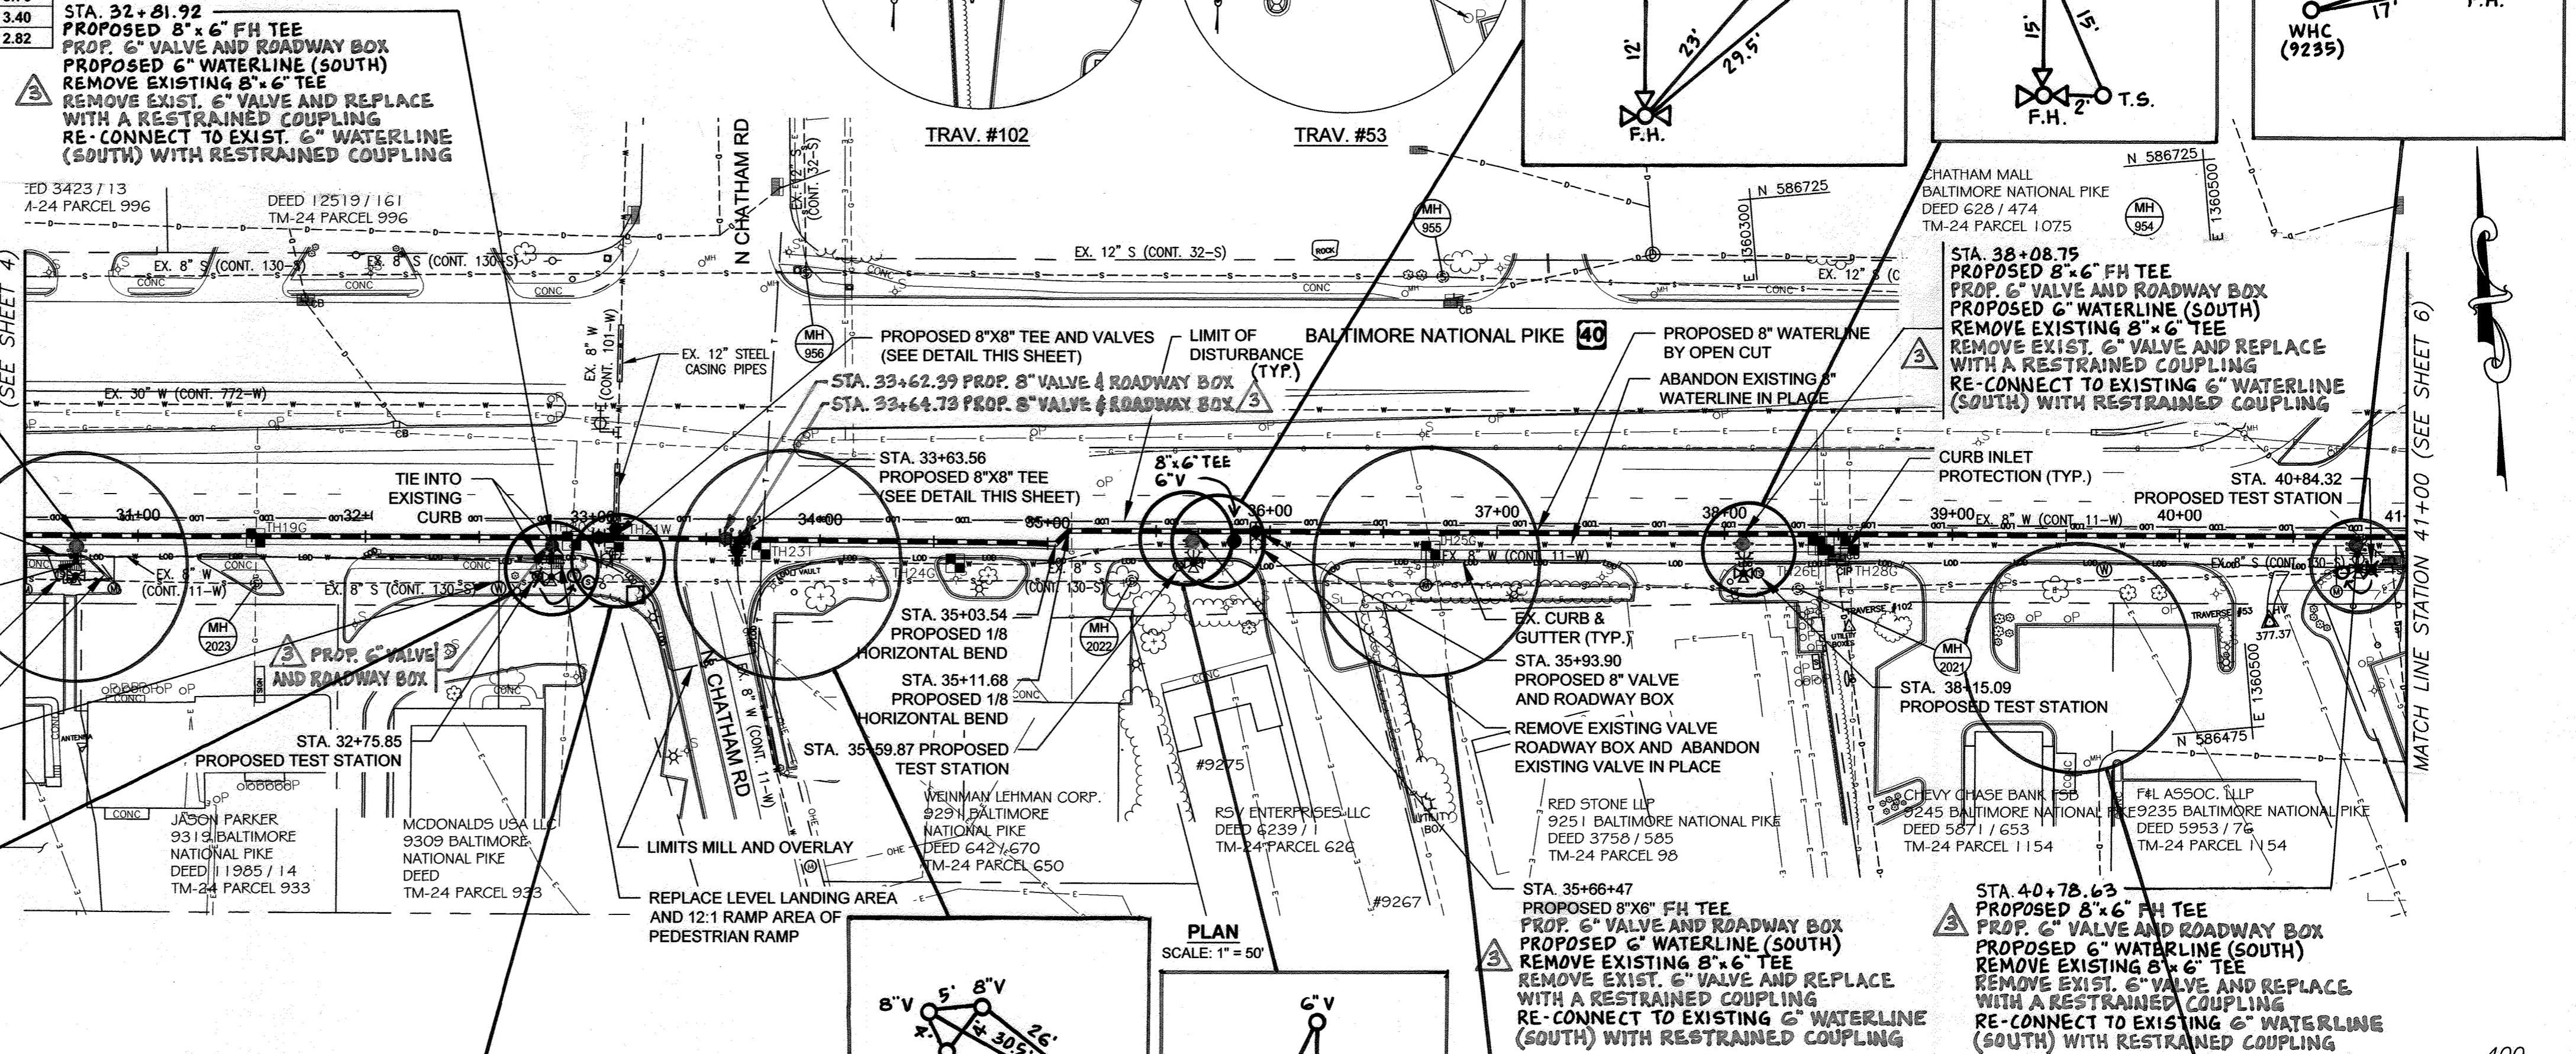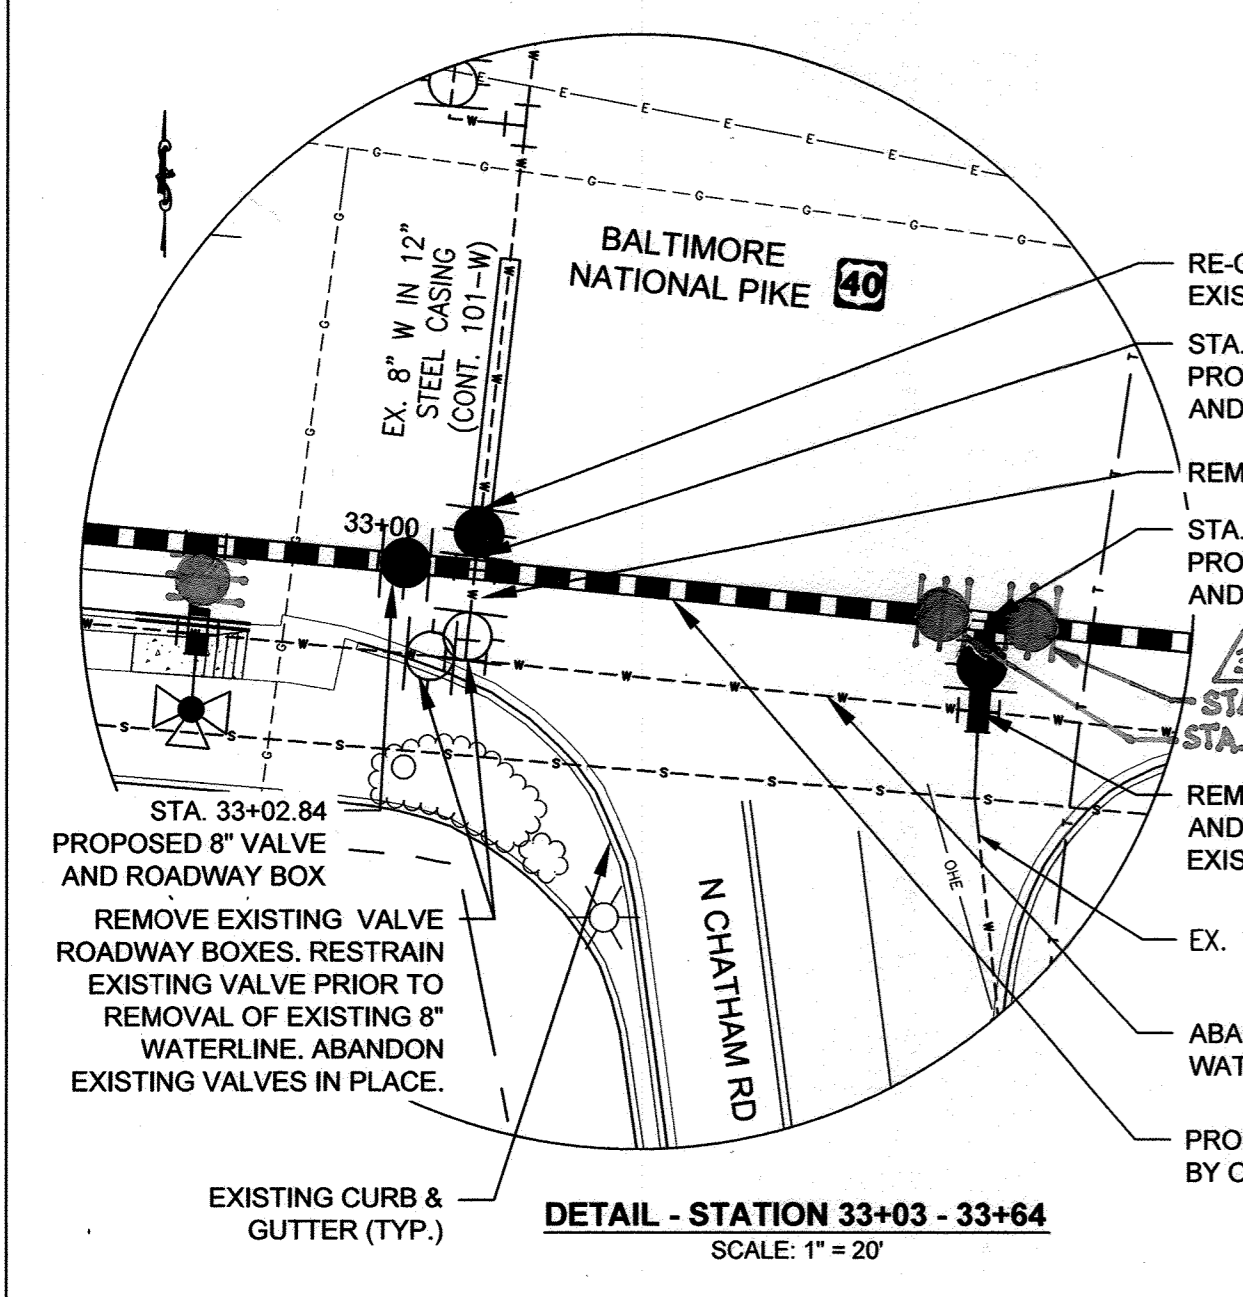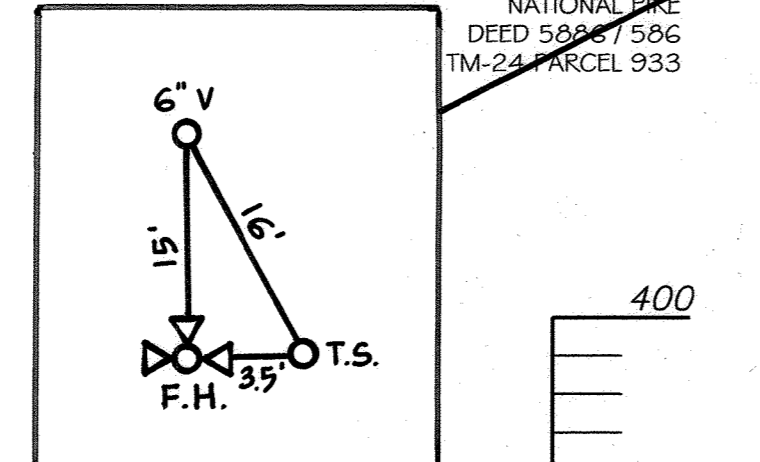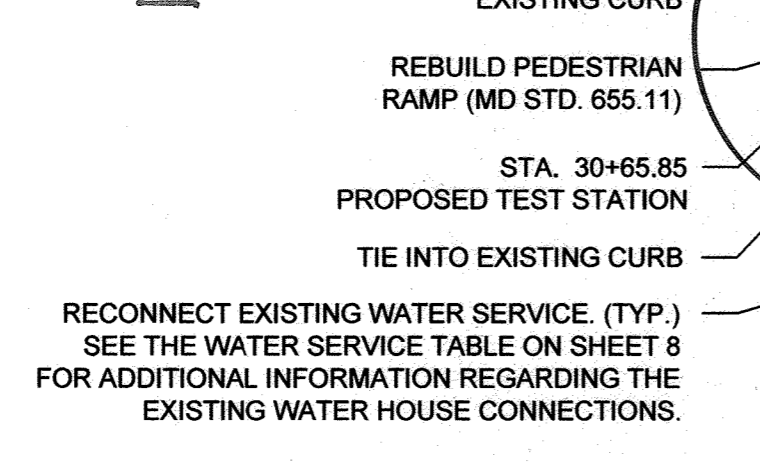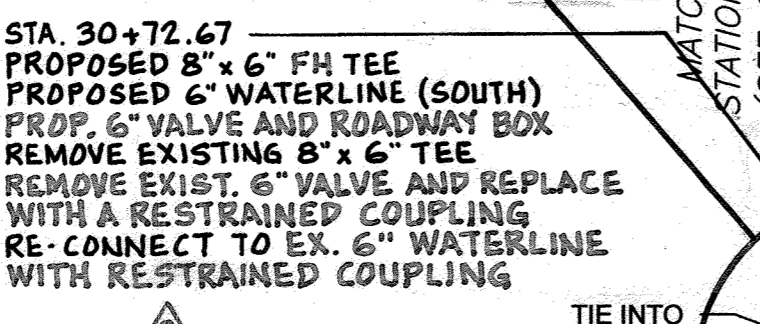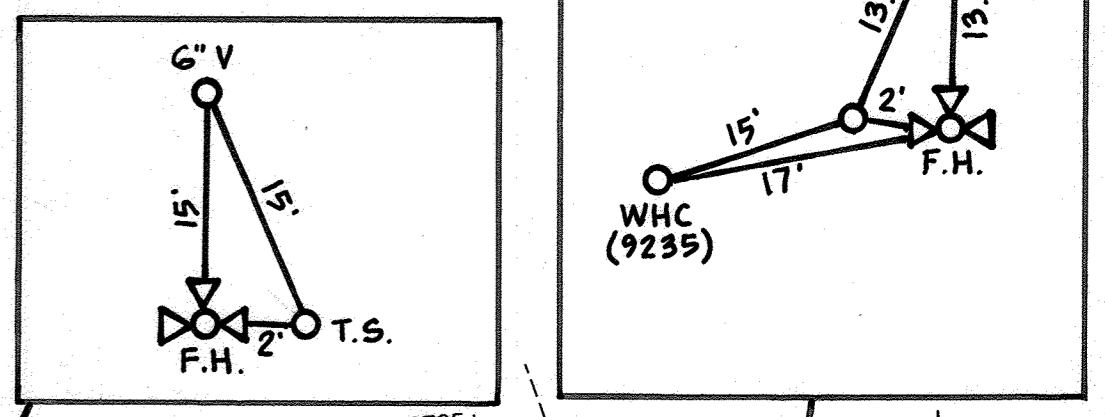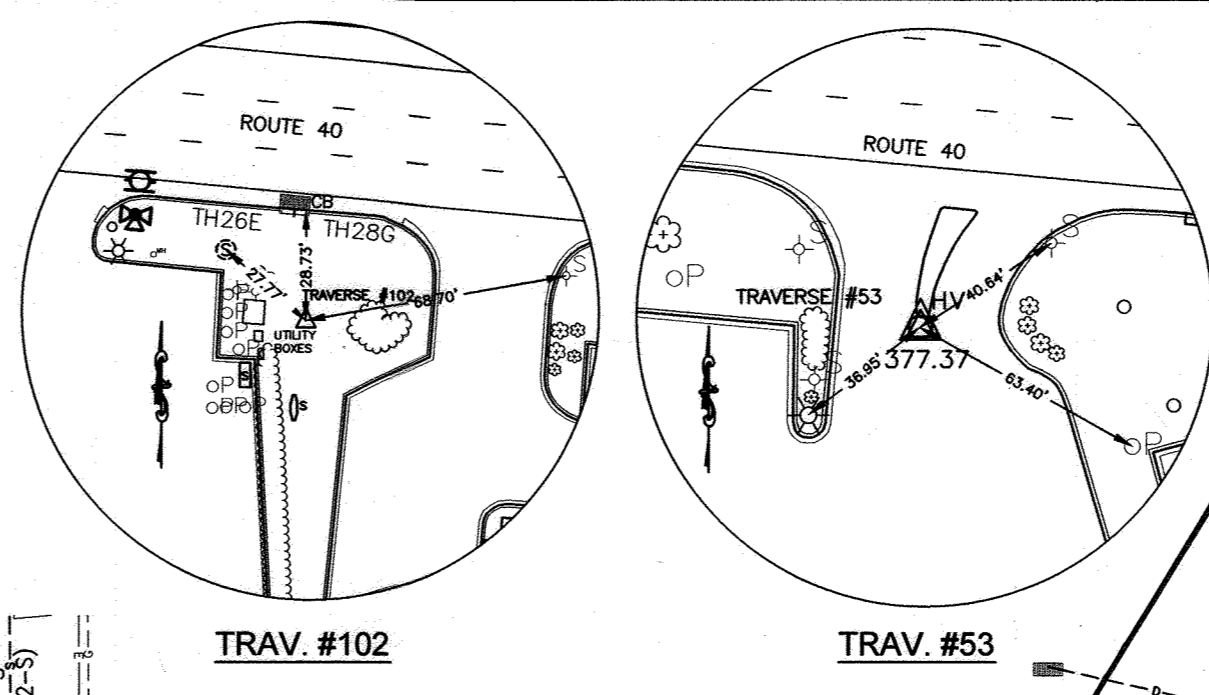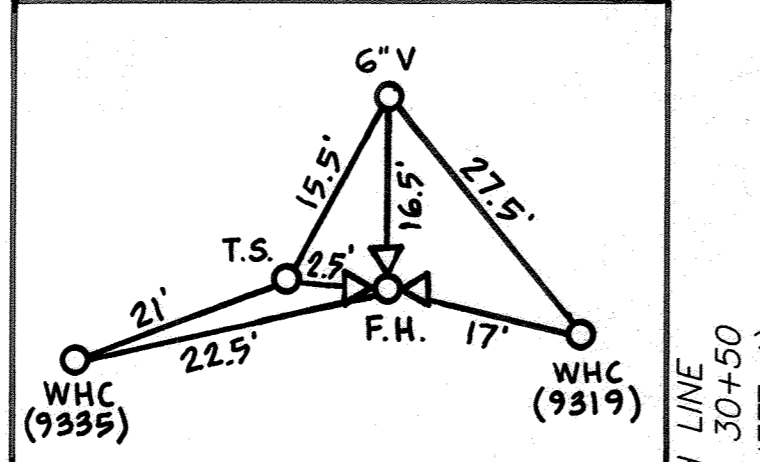

DEPARTMENT OF PUBLIC WORKS
HOWARD COUNTY, MARYLAND

John A. ... 3/13/13
DIRECTOR OF PUBLIC WORKS DATE

Mona E. ... 3/13/13
CHIEF, BUREAU OF ENGINEERING DATE

Silva ... 3/13/13
CHIEF, BUREAU OF UTILITIES DATE

... .. 3/12/13
CHIEF, UTILITY DESIGN DIVISION DATE

URS

MONTGOMERY PARK BUSINESS CENTER
1800 WASHINGTON BOULEVARD, SUITE 410
BALTIMORE, MARYLAND 21230
(410) 468-0875

Professional Certification
I hereby certify that these documents were prepared or approved by me, and that I am a duly licensed professional engineer under the laws of the State of Maryland, License No. 28817, Expiration Date: 08/01/13

NATHAN C. ATKINSON

DESIGN: NCA	ADD PROP. 6" AND 8" VALVES & ROADWAY BOXES	11/15/2013	URS
DRAWN: BJW	REVISE 8" WATERLINE VERTICAL ALIGNMENT	11/22/2013	URS
CHK: EMT			
DATE: 3/7/13	NO.	REVISION	DATE BY

8" WATER MAIN
PLAN AND PROFILE
STATION 30+50 - 41+00

600' SCALE MAP NO. 24 BLOCK NO. 12

U.S. 40 WATER SERVICE MAIN REPLACEMENT
CAPITAL PROJECT NO. W-8311
CONTRACT NO. 44-4731
6TH ELECTION DISTRICT
HOWARD COUNTY, MARYLAND

SCALE: AS SHOWN
SHEET 5 OF 13



AS-BUILT 1/2015

Manhole #	Invert	Rim Elevation
953	367.53	377.30 +/-
1171	365.50	377.60 +/-
1172	375.48	385.80 +/-
1173	383.30	393.50 +/-
2017	368.32 (W)	378.23 +/-
2018	365.17	377.43 +/-
2019	372.48	383.50 +/-
2020	385.76	397.13 +/-

RECONNECT EXISTING WATER SERVICE (TYP.) SEE THE WATER SERVICE TABLE ON SHEET 8 FOR ADDITIONAL INFORMATION REGARDING THE EXISTING WATER HOUSE CONNECTIONS.

Station	Fitting	Northing	Easting	Invert
41+20.00	2.50" HD COUPLING (VERT.)	586,550.43	1,360,594.88	372.32
41+82.11	METER CONNECTION	586,544.75	1,360,656.73	372.34
41+88.10	METER CONNECTION	586,544.20	1,360,662.69	372.34
42+74.00	TEST STATION	586,520.72	1,360,746.80	-
42+80.00	8"x6" TEE	586,535.79	1,360,754.21	372.37
42+80.00	6" VALVE & ROADWAY BOX	586,531.18	1,360,753.78	372.37
42+80.00	FIRE HYDRANT (4'-6" BURY)	586,520.32	1,360,752.78	372.37
45+00.00	1.50" HD COUPLING (VERT.)	586,515.66	1,360,973.28	372.42
45+26.69	METER CONNECTION	586,513.22	1,360,999.86	379.10
46+14.78	8"x6" TEE	586,505.16	1,361,087.98	375.32
46+14.78	6" VALVE & ROADWAY BOX	586,505.98	1,361,087.65	375.32
46+21.07	TEST STATION	586,488.16	1,361,092.34	-
46+51.68	1/8 BEND (HOR.)	586,501.78	1,361,124.33	376.26
46+63.41	1/8 BEND (HOR.)	586,492.77	1,361,131.83	376.55
46+69.41	0.50" HD COUPLING (VERT.)	586,492.22	1,361,137.80	376.71
46+97.28	METER CONNECTION	586,489.69	1,361,165.56	377.64
48+15.30	METER CONNECTION	586,478.98	1,361,283.09	381.59
49+44.00	TEST STATION	586,467.53	1,361,410.37	-
49+50.00	8"x6" TEE	586,466.76	1,361,417.23	386.10
49+50.00	6" VALVE & ROADWAY BOX	586,462.15	1,361,416.81	386.10
49+50.00	FIRE HYDRANT (6'-0" BURY)	586,457.12	1,361,416.36	386.10
49+78.61	METER CONNECTION	586,464.17	1,361,445.73	387.05
50+20.00	0.50" HD COUPLING (VERT.)	586,460.41	1,361,486.95	388.44
50+79.92	METER CONNECTION	586,454.97	1,361,546.62	391.07
51+16.88	1.33" HD COUPLING (VERT.)	586,451.62	1,361,583.43	392.69

TEST PIT NUMBER	TYPE OF UTILITY	TOP DEPTH
TH 29G	(3) 1" ELECTRIC CABLES	3.28
TH 29G A	SEE TEST HOLE REPORT	DRY
TH 30G	8" DUCTILE IRON WATER PIPE	3.42
TH 31W	8" DUCTILE IRON WATER PIPE	4.34
TH 32G	1" WRAPPED STEEL GAS PIPE	2.66
TH 33G	1/2" PLASTIC GAS PIPE	3.78
TH 33G A	6" PLASTIC ELECTRIC CONDUIT	2.62

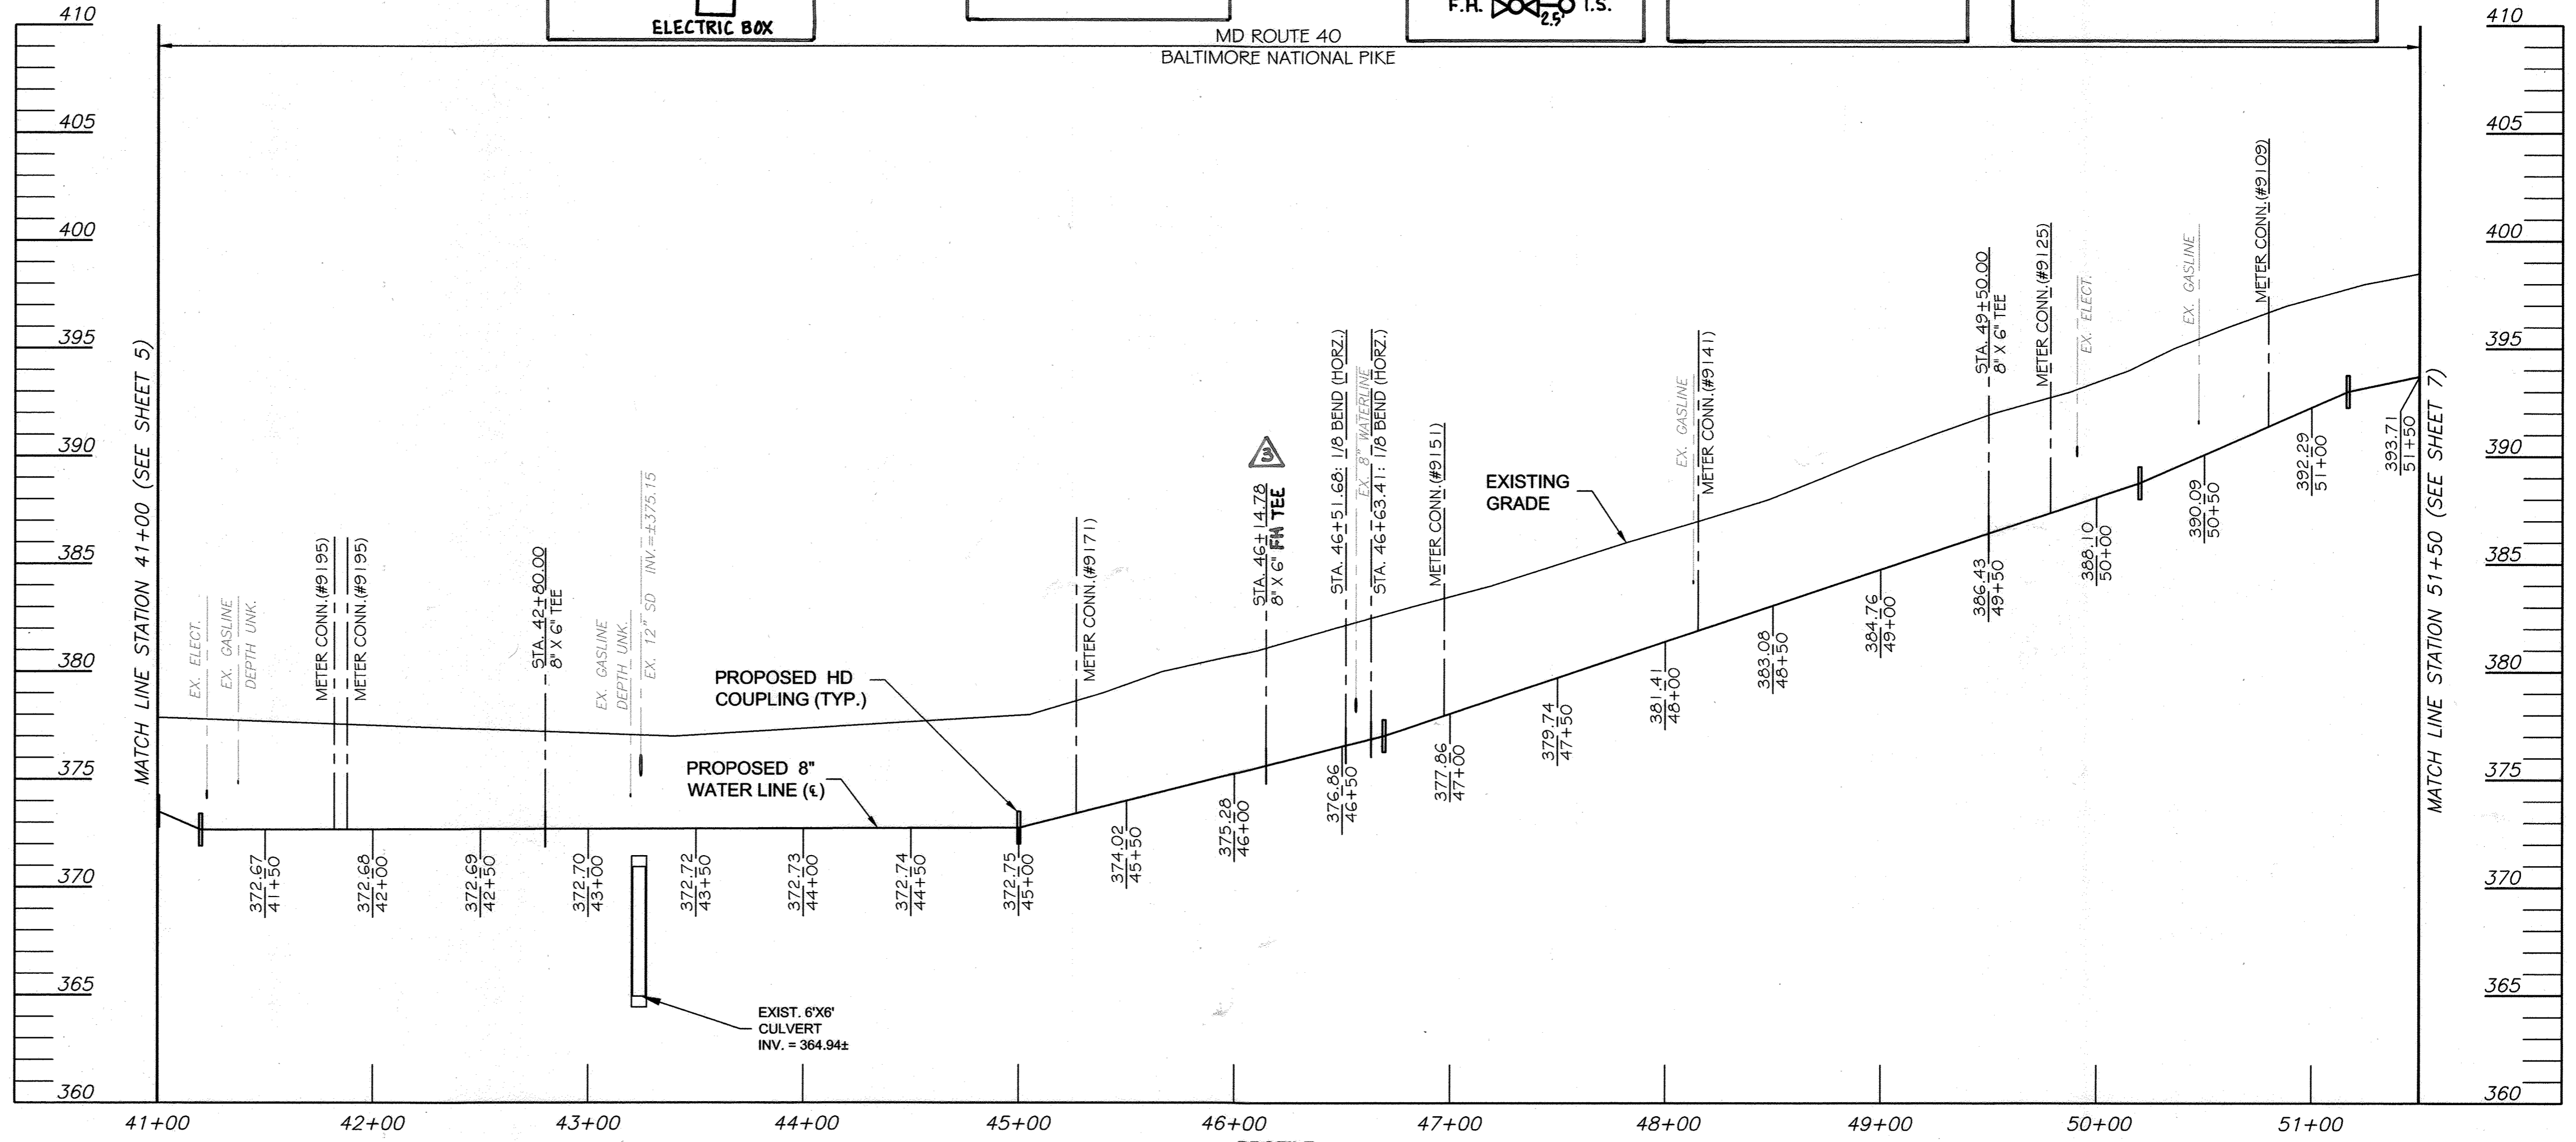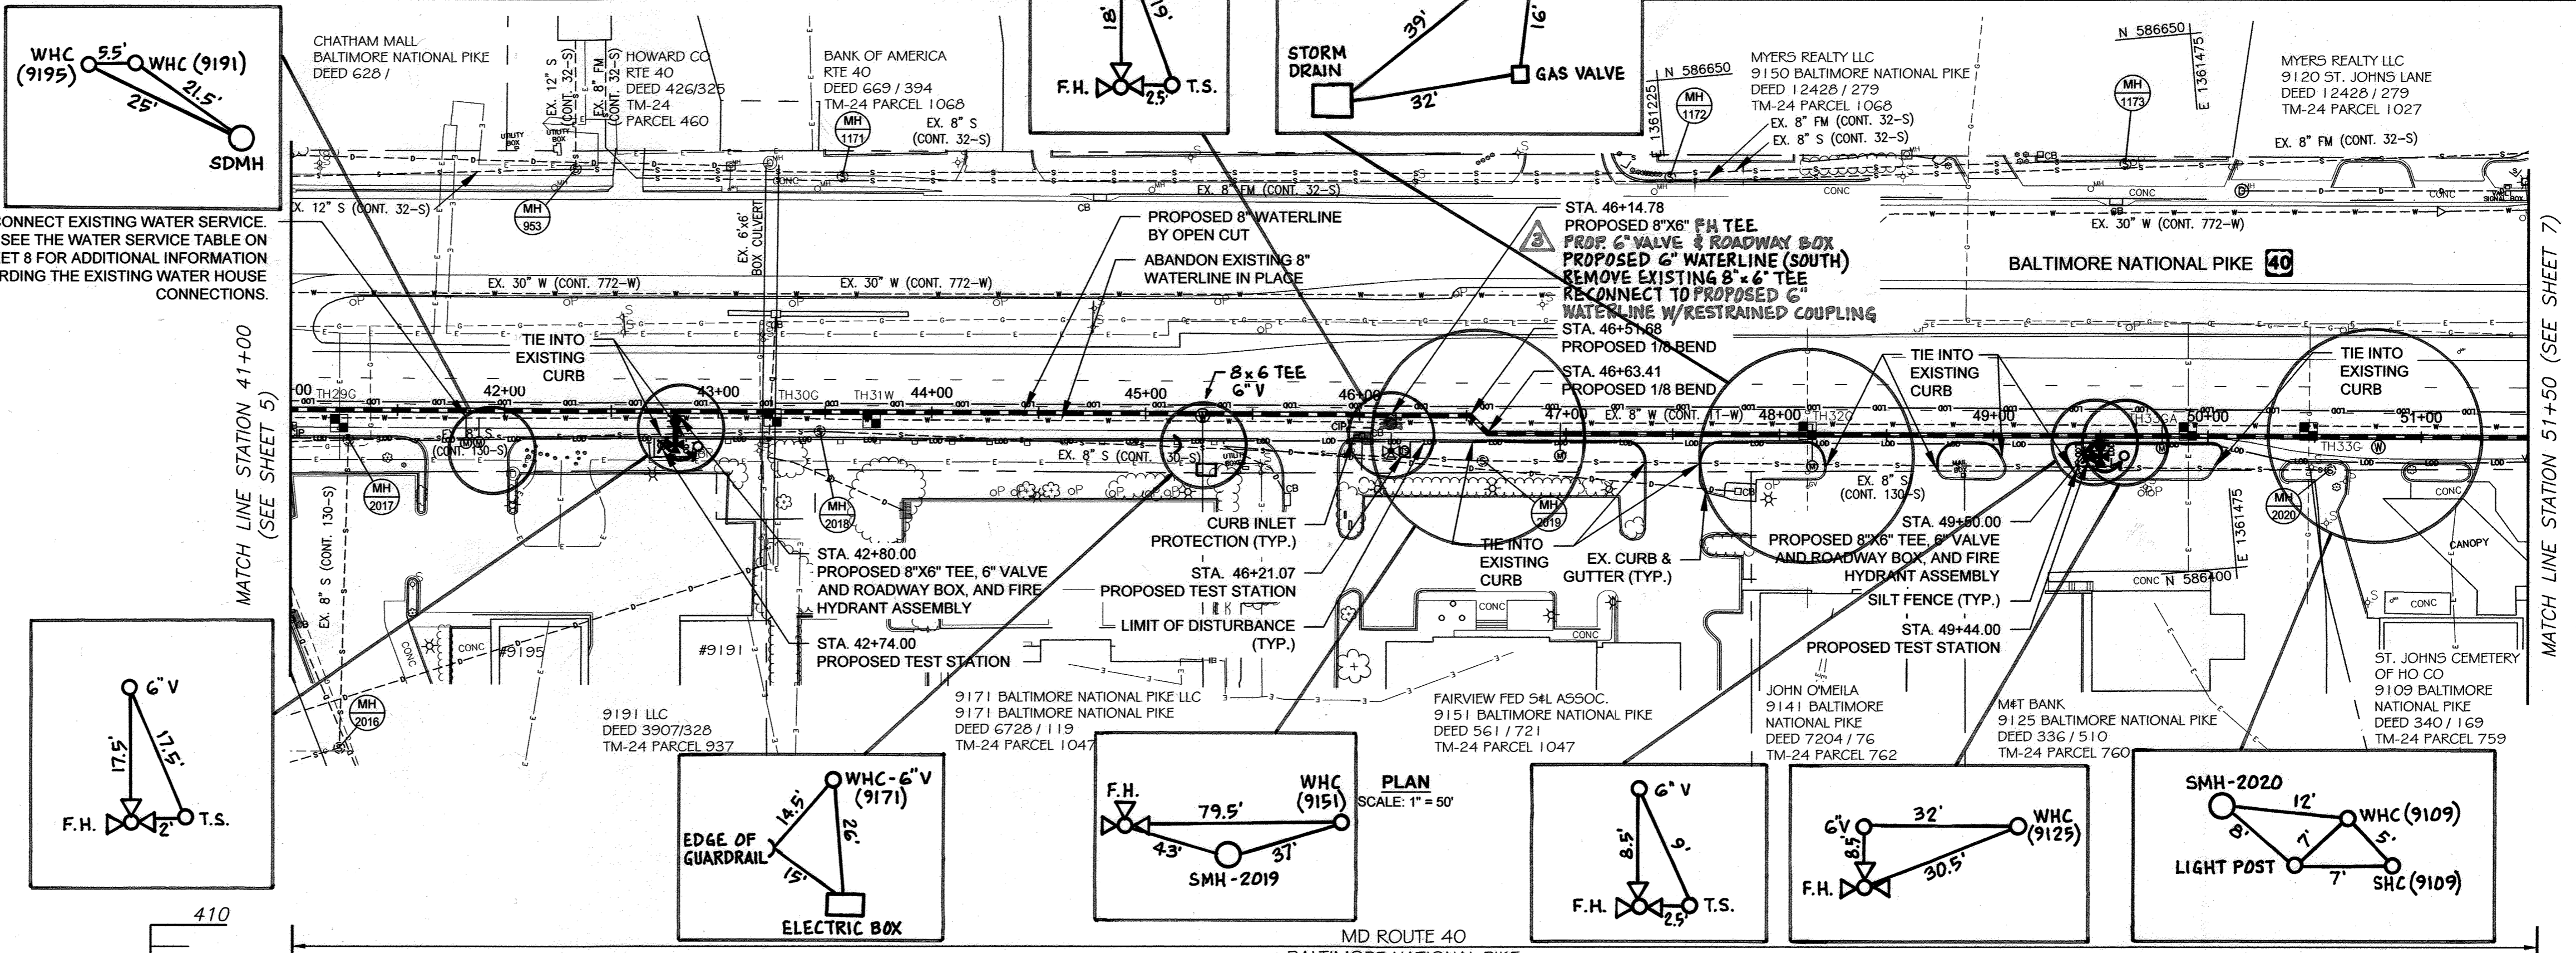

PROFILE
HORIZONTAL SCALE: 1" = 50'
VERTICAL SCALE: 1" = 5'

DEPARTMENT OF PUBLIC WORKS
HOWARD COUNTY, MARYLAND

James M. ... 3/16/13
DIRECTOR OF PUBLIC WORKS DATE

Thomas J. ... 3/13/13
CHIEF, BUREAU OF ENGINEERING DATE

William C. ... 3/13/13
CHIEF, BUREAU OF UTILITIES DATE

... 3/12/13
CHIEF, UTILITY DESIGN DIVISION DATE

URS
MONTGOMERY PARK BUSINESS CENTER
1800 WASHINGTON BOULEVARD, SUITE 410
BALTIMORE, MARYLAND 21230
(410) 468-0875

Professional Certification
I hereby certify that these documents were prepared or approved by me, and that I am a duly licensed professional engineer under the laws of the State of Maryland, License No. 28817, Expiration Date: 08/01/13

NATHAN C. ATKINSON

DESIGN: NCA	ADD PROP. 6" AND 8" VALVE AND ROADWAY BOX	11/15/2013	URS
DRAWN: BJW			
CHK: EMT			
DATE: 3/7/13	NO.	REVISION	DATE BY

8" WATER MAIN
PLAN AND PROFILE
STATION 41+00 - 51+50

60' SCALE MAP NO. 24
BLOCK NO. 12

U.S. 40 WATER SERVICE MAIN REPLACEMENT
CAPITAL PROJECT NO. W-8311
CONTRACT NO. 44-4731
6TH ELECTION DISTRICT
HOWARD COUNTY, MARYLAND




SCALE:
AS SHOWN

SHEET
6 OF 13


AS-BUILT 1/2015

WATER MAIN STAKE-OUT SCHEDULE				
Station	Fitting	Northing	Easting	Invert
51+66.88	8"x6" TEE	586,447.07	1,361,833.32	393.73
51+67.06	6" VALVE AND ROADWAY BOX	586,441.34	1,361,832.88	393.73
51+74.47	TEST STATION	586,431.25	1,361,839.40	-
51+75.87	1/16 BEND (VERT.)	586,446.27	1,361,842.17	393.92
51+78.61	1/16 BEND (VERT.)	586,446.02	1,361,844.90	395.10
51+81.61	1/8 BEND (HOR.)	586,445.75	1,361,847.89	395.15
51+88.68	1/8 BEND (HOR.)	586,450.27	1,361,853.32	395.27
51+92.58	CONNECT TO EXISTING	586,449.91	1,361,857.30	395.39
52+12.85	CONNECT TO EXISTING	586,448.02	1,361,877.38	395.62
52+16.85	1/8 BEND (HOR.)	586,447.64	1,361,881.36	395.73
52+23.86	1/8 BEND (HOR.)	586,442.24	1,361,885.84	395.85
52+55.88	2.25" HD COUPLING (HOR.)	586,439.25	1,361,717.72	396.23
53+00.00	0.50" HD COUPLING (VERT.)	586,436.86	1,361,761.77	396.76
53+95.86	0.50" HD COUPLING (HOR.)	586,431.66	1,361,857.49	397.07
54+20.00	0.50" HD COUPLING (VERT.)	586,430.56	1,361,881.61	397.15
54+40.86	METER CONNECTION	586,429.61	1,361,902.45	397.04
54+54.29	TEST STATION	586,420.54	1,361,915.48	-
54+55.86	2.00" HD COUPLING (HOR.)	586,428.92	1,361,917.43	396.96
54+60.00	8"x6" TEE	586,428.88	1,361,921.57	396.94
54+60.00	6" VALVE AND ROADWAY BOX	586,424.25	1,361,921.52	396.94
54+60.00	FIRE HYDRANT (5'-0" BURY)	586,420.47	1,361,921.48	396.94
55+00.00	1.00" HD COUPLING (VERT.)	586,428.45	1,361,961.57	396.72
55+15.86	0.50" HD COUPLING (HOR.)	586,428.29	1,361,977.43	396.35
55+75.86	1.00" HD COUPLING (HOR.)	586,428.17	1,362,037.43	394.98
56+23.55	METER CONNECTION	586,428.91	1,362,085.11	393.89
56+35.86	1.00" HD COUPLING (HOR.)	586,429.10	1,362,097.42	393.61
56+40.00	2.00" HD COUPLING (VERT.)	586,429.24	1,362,101.56	393.51
56+62.37	METER CONNECTION	586,429.98	1,362,123.92	392.22
56+90.00	2.25" HD COUPLING (VERT.)	586,430.89	1,362,151.53	390.62
57+05.57	8"x6" TEE	586,431.40	1,362,167.09	390.33
57+05.57	6" VALVE & ROADWAY BOX	586,430.23	1,362,167.10	390.33
57+11.89	TEST STATION	586,417.91	1,362,174.16	-
57+40.00	1.25" HD COUPLING (VERT.)	586,433.29	1,362,201.47	389.69
57+57.97	METER CONNECTION	586,434.27	1,362,219.41	388.97
57+65.57	1.25" HD COUPLING (HOR.)	586,434.69	1,362,227.01	388.66
58+25.57	1.00" HD COUPLING (HOR.)	586,439.28	1,362,286.83	386.24
58+40.00	0.75" HD COUPLING (VERT.)	586,440.64	1,362,301.19	385.65
58+85.57	0.75" HD COUPLING (HOR.)	586,444.92	1,362,346.56	383.22
59+45.57	1.25" HD COUPLING (HOR.)	586,451.33	1,362,406.22	380.01
60+00.00	0.50" HD COUPLING (VERT.)	586,458.34	1,362,460.19	377.09
60+05.57	1.00" HD COUPLING (HOR.)	586,459.05	1,362,465.72	376.75
60+24+00	TEST STATION	586,450.69	1,362,485.58	-
60+30.00	8"x6" TEE	586,462.62	1,362,488.89	375.23
60+30.00	6" VALVE AND ROADWAY BOX	586,458.04	1,362,490.56	375.23
60+30.00	FIRE HYDRANT (5'-5" BURY)	586,451.57	1,362,491.52	375.23
60+41.23	1/8 BEND (HOR.)	586,464.25	1,362,501.00	374.53
60+46.74	1/8 BEND (HOR.)	586,468.68	1,362,504.28	374.18
60+50.69	CONNECT TO EXISTING	586,469.23	1,362,508.19	373.94

TEST PIT DATA		
TEST PIT NUMBER	TYPE OF UTILITY	TOP DEPTH
TH 34E	4" STEEL ELECTRIC CONDUIT	2.70
TH 35T	(4) 4" PLASTIC TELEPHONE CONDUITS	5.04
TH 36G	6" WRAPPED STEEL GAS PIPE	4.68
TH 37W	8" DUCTILE IRON WATER PIPE	5.18
TH 38G	1" WRAPPED STEEL GAS PIPE	2.44
TH 38G A	4" PLASTIC ELECTRIC CONDUIT	1.74
TH 38G B	1" STEEL GAS PIPE	3.62
TH 39G	1" PLASTIC GAS PIPE	2.30
TH 40G	NO INFO UTILITY MARKS OR ELECTRIC SIGNALS ON SECONDARY LINE IN FIELD. PANNED OVER FROM 12.365 AND FOUND NO UTILITY	N/A
TH 41W	8" DUCTILE IRON WATER PIPE	3.96

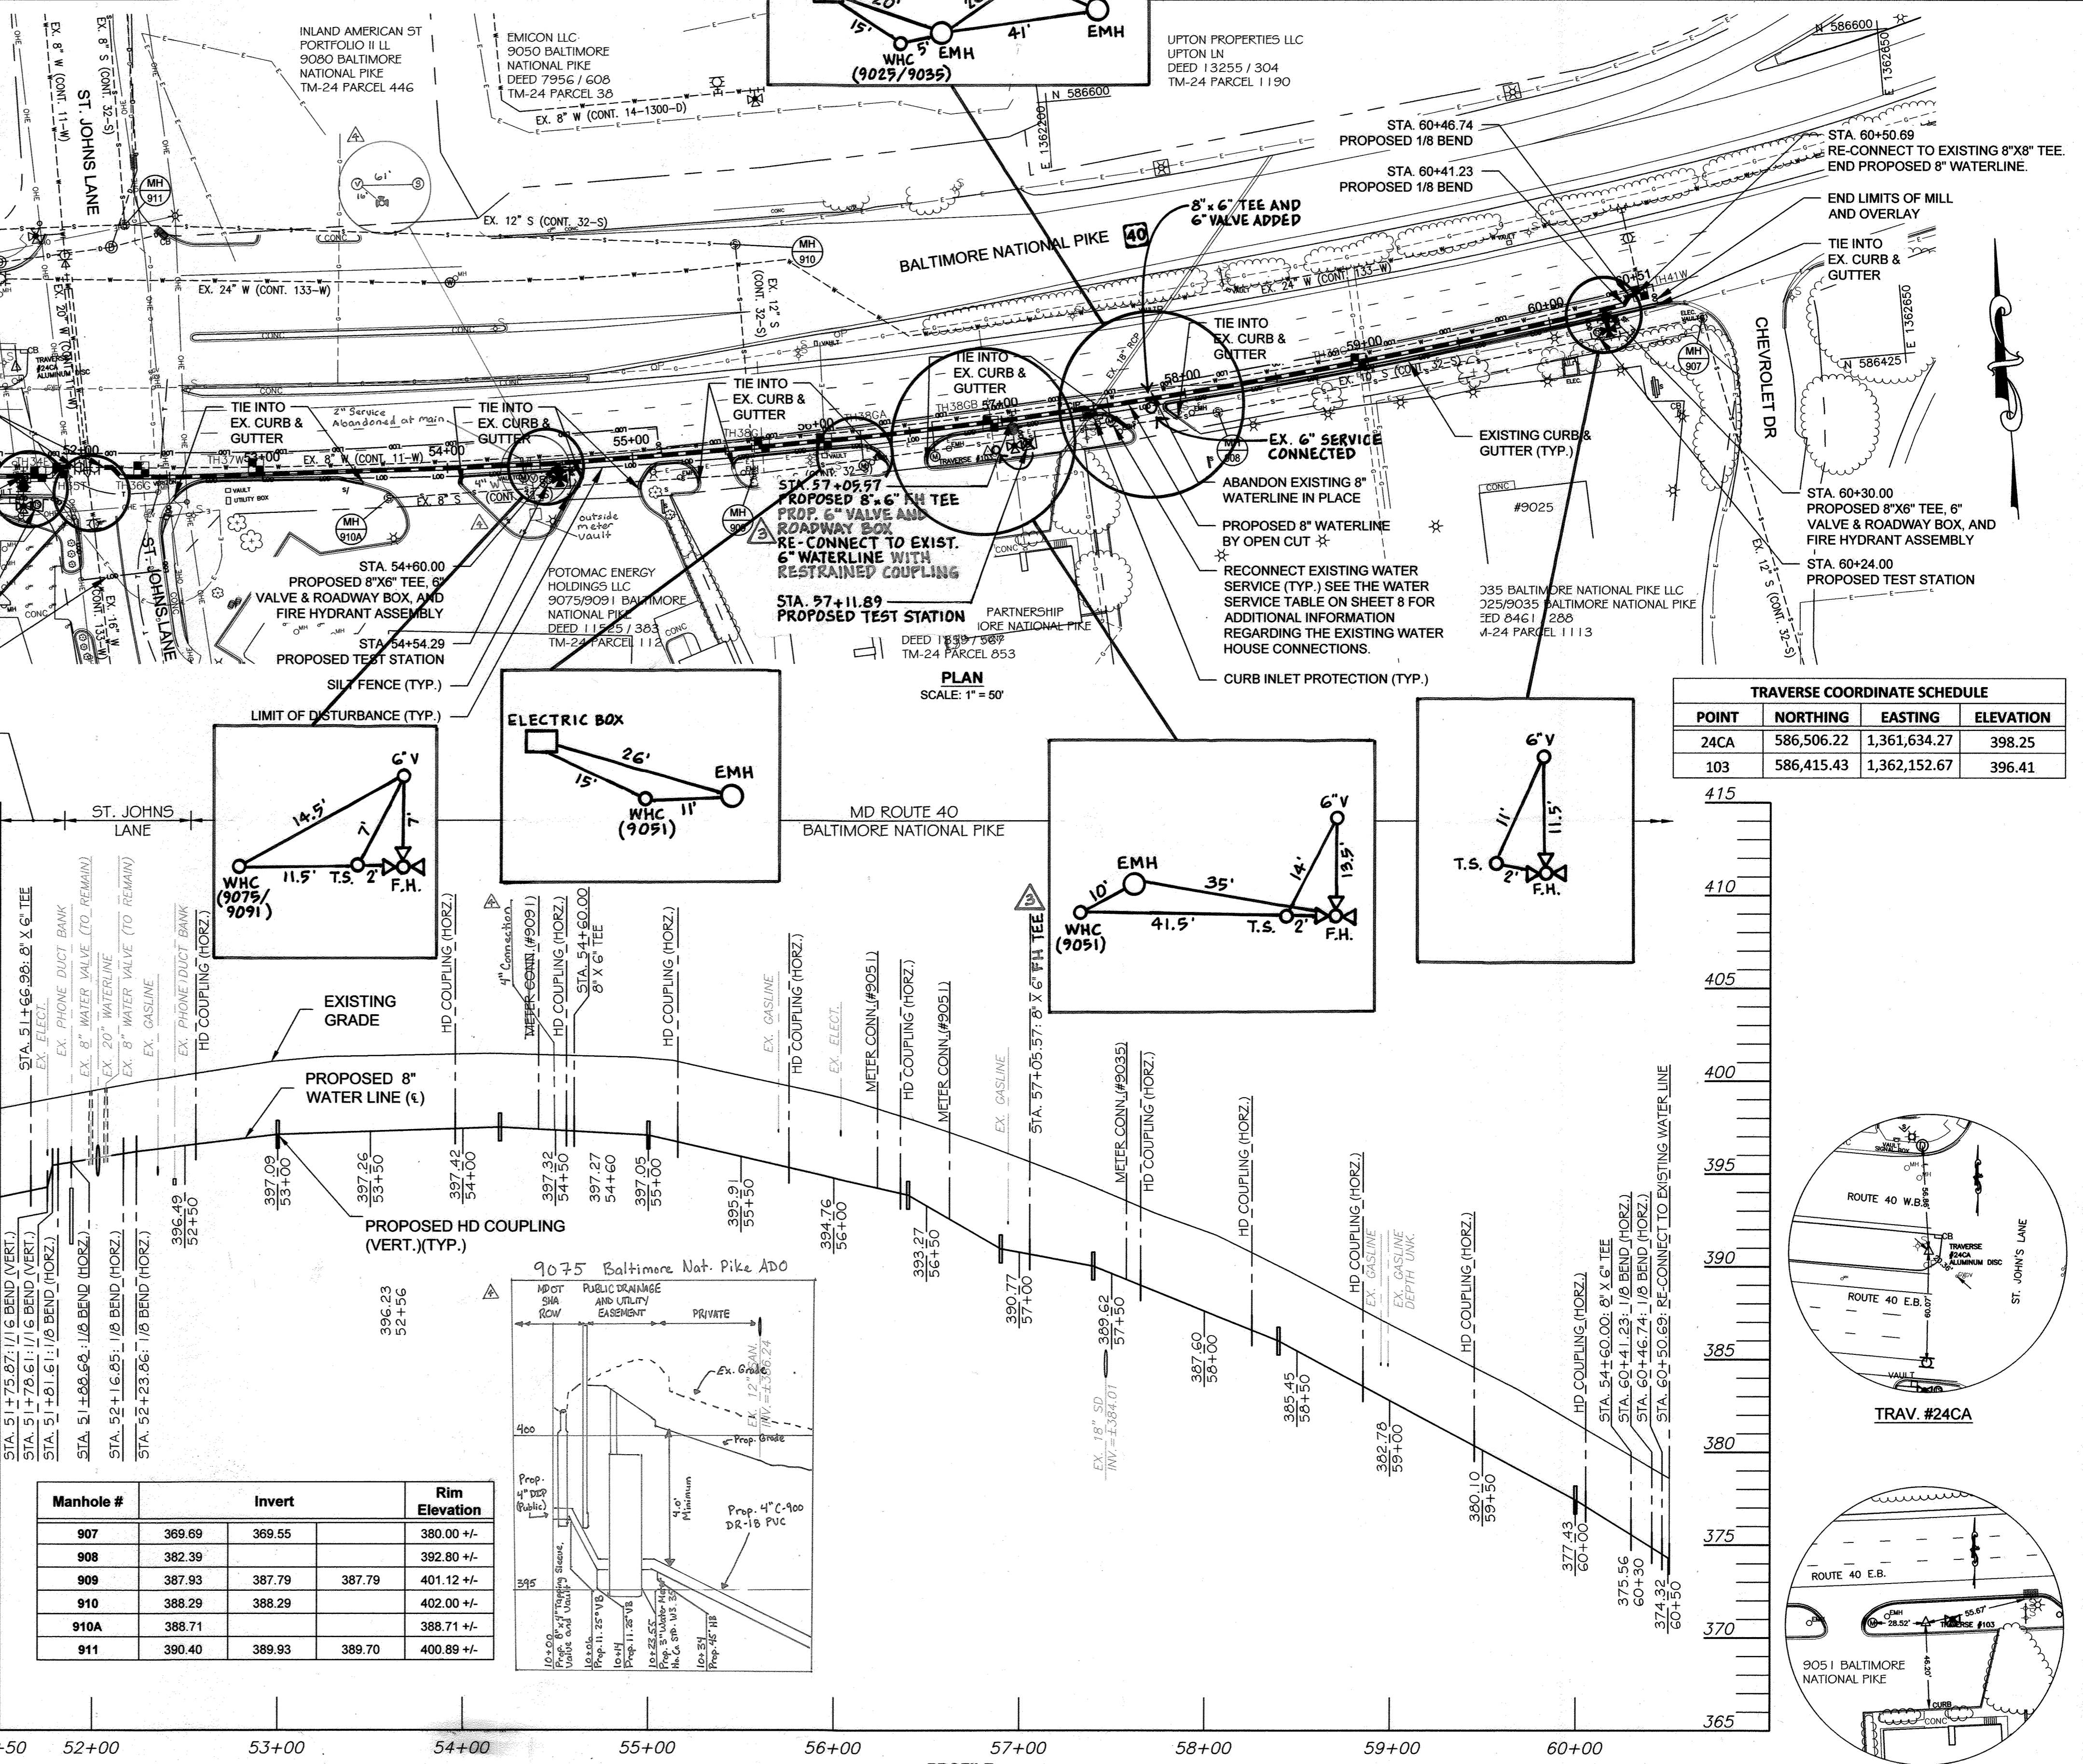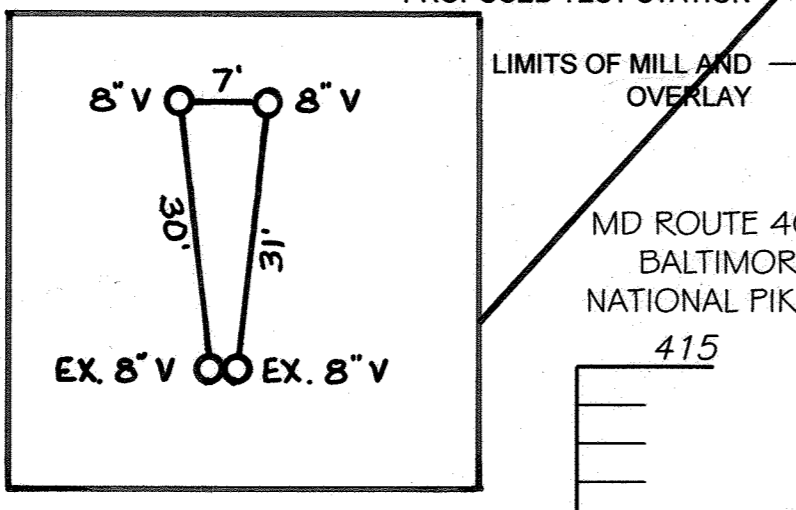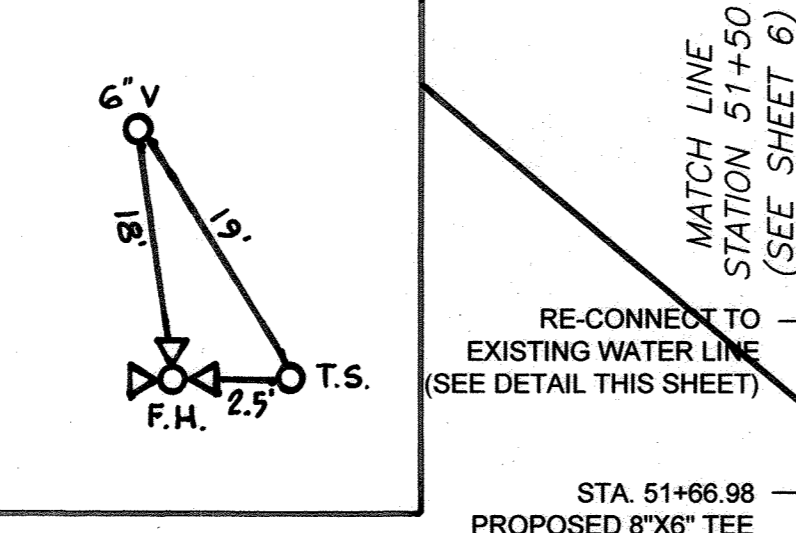

TRAVERSE COORDINATE SCHEDULE			
POINT	NORTHING	EASTING	ELEVATION
24CA	586,506.22	1,361,634.27	398.25
103	586,415.43	1,362,152.67	396.41

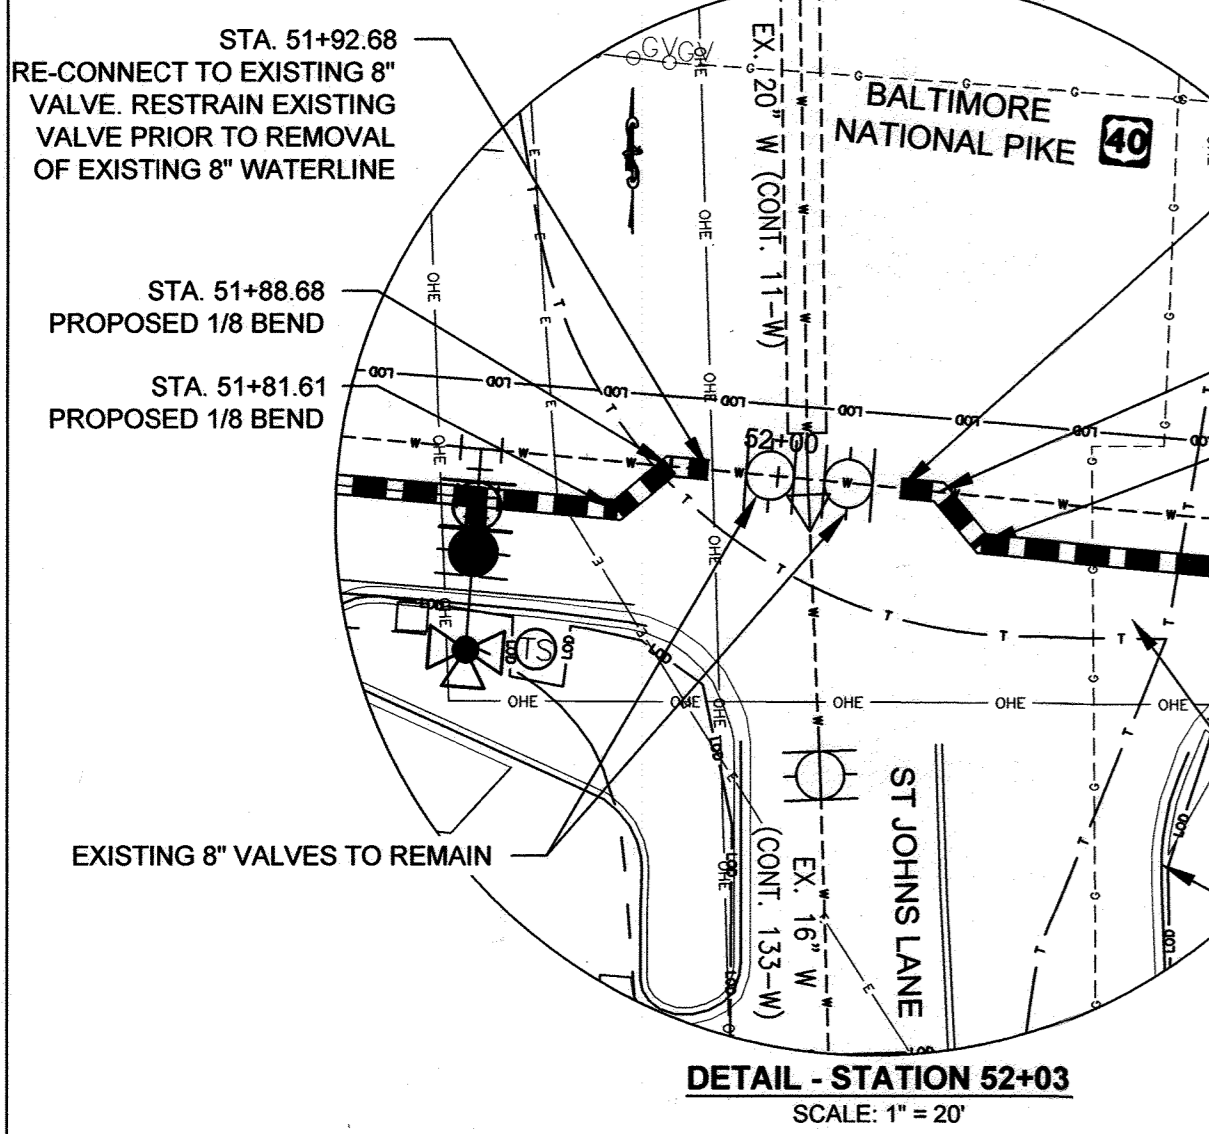

Manhole #	Invert	Rim Elevation
907	369.69	369.55
908	382.39	382.30
909	387.93	387.79
910	388.29	388.29
910A	388.71	388.71
911	390.40	389.93

DEPARTMENT OF PUBLIC WORKS
 HOWARD COUNTY, MARYLAND
 Director of Public Works: *[Signature]* 3/13/13
 Chief, Bureau of Engineering: *[Signature]* 3/13/13
 Chief, Bureau of Utilities: *[Signature]* 3/13/13
 Chief, Utility Design Division: *[Signature]* 3/12/13



URS
 MONTGOMERY PARK BUSINESS CENTER
 1800 WASHINGTON BOULEVARD, SUITE 410
 BALTIMORE, MARYLAND 21230
 (410) 468-0875
 Professional Certification: I hereby certify that these documents were prepared or approved by me, and that I am a duly licensed professional engineer under the laws of the State of Maryland, License No. 28817, Expiration Date: 08/01/13
 NATHAN C. ATKINSON

DESIGN: NCA
 DRAWN: BWJ
 CHK: EMT
 DATE: 3/7/13
 NO. REVISION
 11/15/2013 URS
 3/15/2024 WRA
 8" WATER MAIN PLAN AND PROFILE STATION 51+50 - 60+51
 U.S. 40 WATER SERVICE MAIN REPLACEMENT CAPITAL PROJECT NO. W-8311 CONTRACT NO. 44-4731 6TH ELECTION DISTRICT HOWARD COUNTY, MARYLAND
 SCALE: AS SHOWN
 SHEET 2 OF 13
 AS-BUILT 1/2015

US ROUTE 40 WATER MAIN REPLACEMENT - WATER SERVICE TABLE										
Address #	Road Name	WHC Size	As-Built WHC Size	Domestic Meter Size	As-Built Domestic Meter Size (if outside)	Fire Meter Size	Assumed Service length in public R/W	As-Built length in public R/W (if)	Remarks	As-Built Remarks
9025	Baltimore National Pike	6" (shared)		1" (inside)			25		2 buildings on this parcel, it appears one 6" line from main may serve both buildings	
9035	Baltimore National Pike			5/8" (inside)		6" (inside)				
9051	Baltimore National Pike	3/4"		5/8"			25		2 services to this parcel, multiple bldgs	
9075	Baltimore National Pike	3/4"		5/8"			25			
9109	Baltimore National Pike	2"		2" (inside)			25			
9125	Baltimore National Pike	1"		3/4"			25			
9141	Baltimore National Pike	1 1/2"		1 1/2"			25			
9151	Baltimore National Pike	2"		2"			25			
9171	Baltimore National Pike	6" (shared)		1 1/2" (inside)		6" (inside)	25		2 services to this parcel, 2 bldgs	
9191	Baltimore National Pike	1 1/2"		1 1/2" (inside)			25			
9195	Baltimore National Pike	1 1/2"		1 1/2" (inside)			25		2 services to this parcel, 2 bldgs	
9235	Baltimore National Pike	1 1/2"		1" (inside)			25			
9245	Baltimore National Pike	1"		3/4" (inside)			25			
9251	Baltimore National Pike	1 1/2"		1 1/2" (outside)			25			
9267	Baltimore National Pike	2"		2" (inside)			25		possibly one tee, then split into 2 separate services on-site - curb stops not shown on plans	
9275	Baltimore National Pike	6" (shared)		1 1/2" (inside)		4" (inside)	25			
9291	Baltimore National Pike				n/a				water served from Chatham Road WM	
9309	Baltimore National Pike	1 1/2"		1 1/2" (outside)			25			
9319	Baltimore National Pike	1"		1" (outside)			25			
9335	Baltimore National Pike	3/4"		5/8" (inside)			25			
9337	Baltimore National Pike	3/4"		5/8" (inside)			25			
9339	Baltimore National Pike	2"		1 1/2" (inside)			25			
3410	Plumtree Drive				n/a				water served from Plumtree Drive WM	
9395	Baltimore National Pike	1"		3/4"			25			
9435	Baltimore National Pike	1"		3/4" (outside)			25			
9441	Baltimore National Pike	1 1/2"		1" (outside)			25			
9445	Baltimore National Pike	1"		3/4" (outside)			25			
9449	Baltimore National Pike	1"		3/4" (outside)			60		or 9461? (served thru R/W on 9455 parcel)	
9455	Baltimore National Pike	2"		2" (inside)			25			
9469	Baltimore National Pike	6"		2" (inside)		6" (inside)	25			

Notes:

- 1 Meter & WHC size information from meter cards obtained from Bureau of Utilities 2/25/2011.
- 2 If inside/outside meter not clarified, meter location unknown/ All meter locations must be field verified.
- 3 Outside Meter Note: Contractor shall reconnect all existing water services encountered to proposed 8" waterline. Provide new materials from water main to property owner side of water meter, including new piping, fittings, tapping saddle, corporation cock assembly, water meter vault, frame & cover, valves, meter setter assembly & couplings. Transfer existing water meter from existing meter vault to new meter vault. See Howard County Standard Details W3.27, W3.28, W3.29 & W3.34. Please note that only concrete meter vaults will be accepted (no polyethylene meter vaults).
- 4 Inside Meter Note: Contractor shall reconnect all existing water services encountered to proposed 8" waterline. Provide new materials from water main to property owner side of curb stop, including new piping, fittings, tapping saddle, corporation cock assembly, couplings, valves, and valve roadway box. See Howard County Standard Details W3.21.

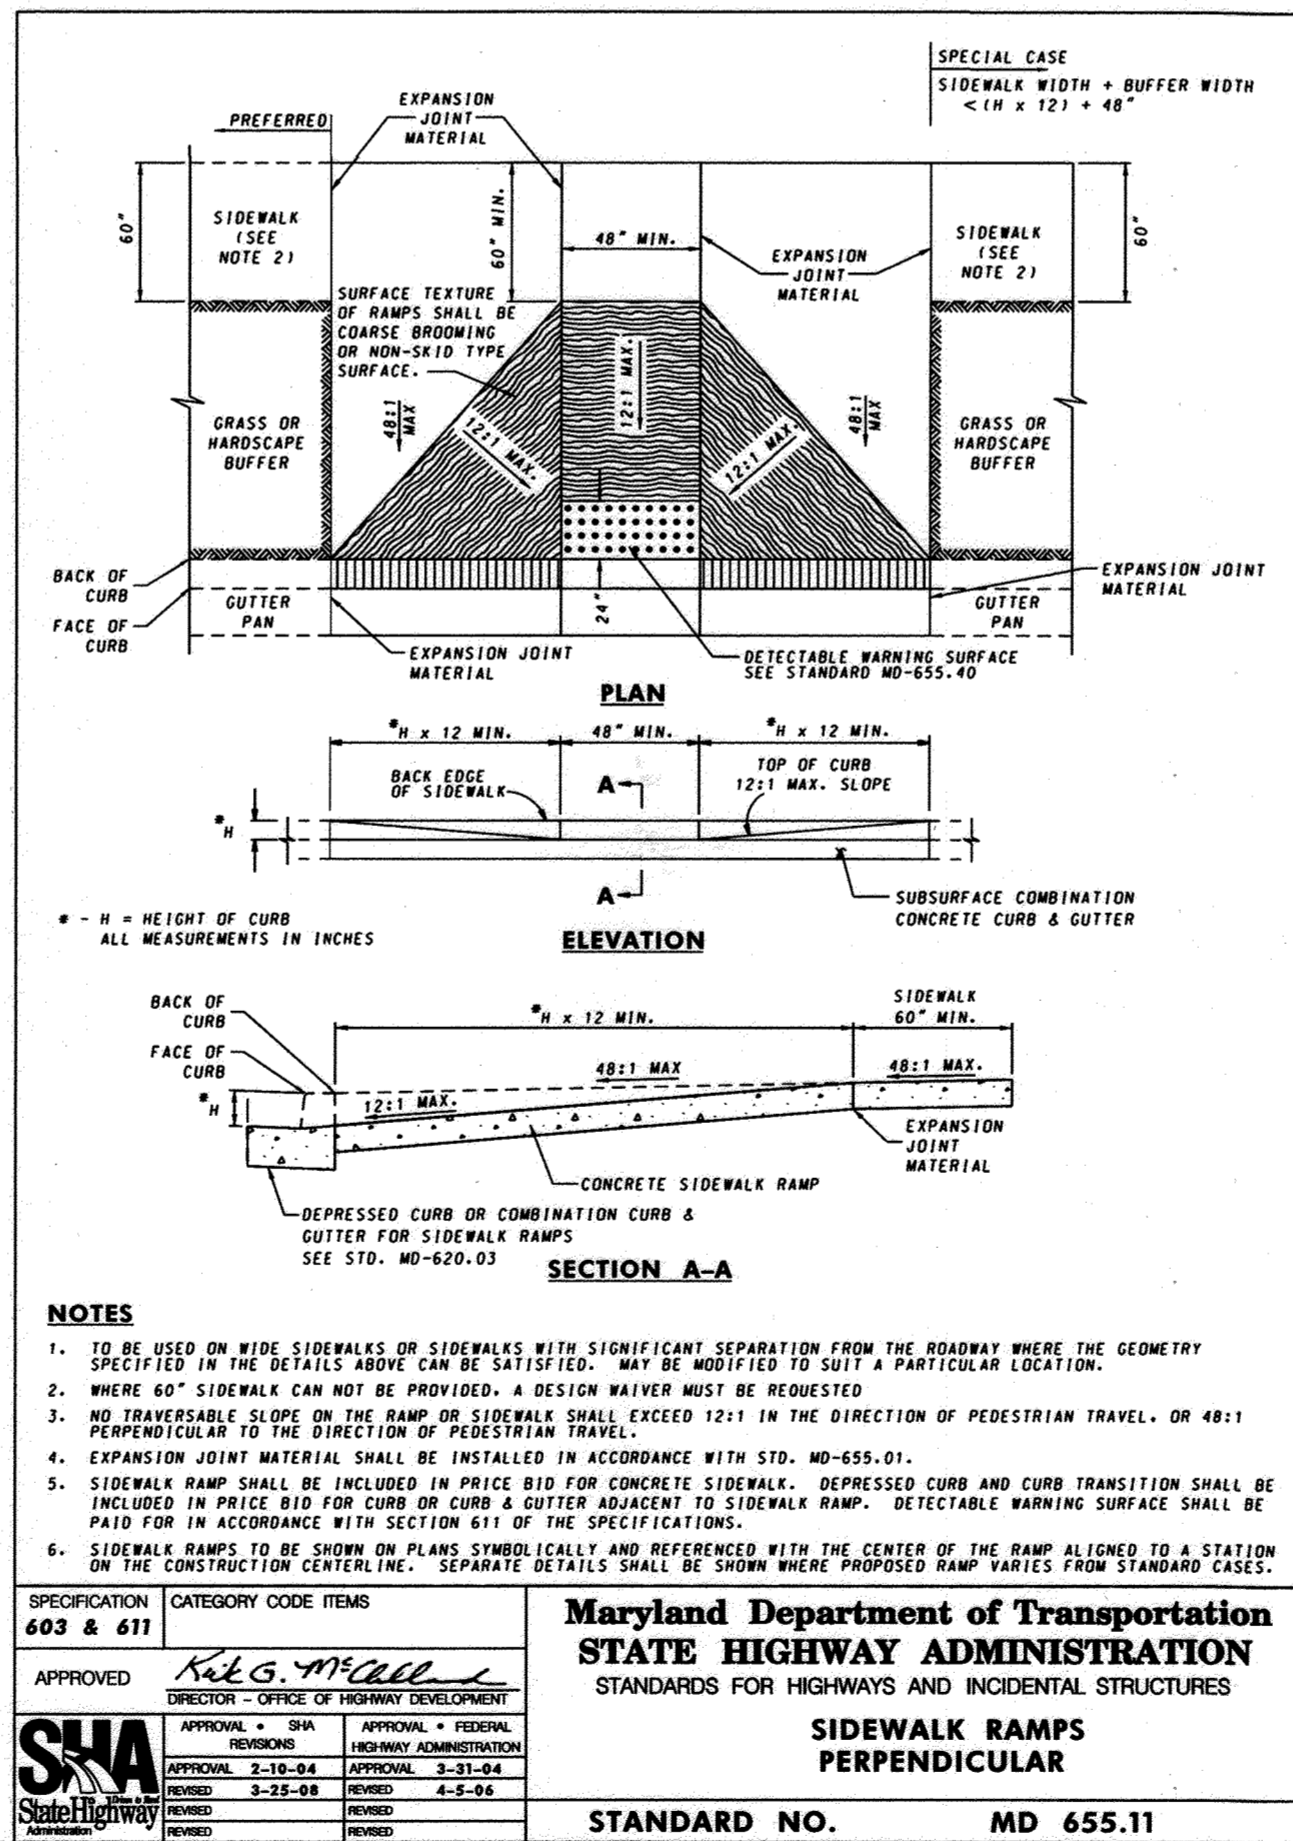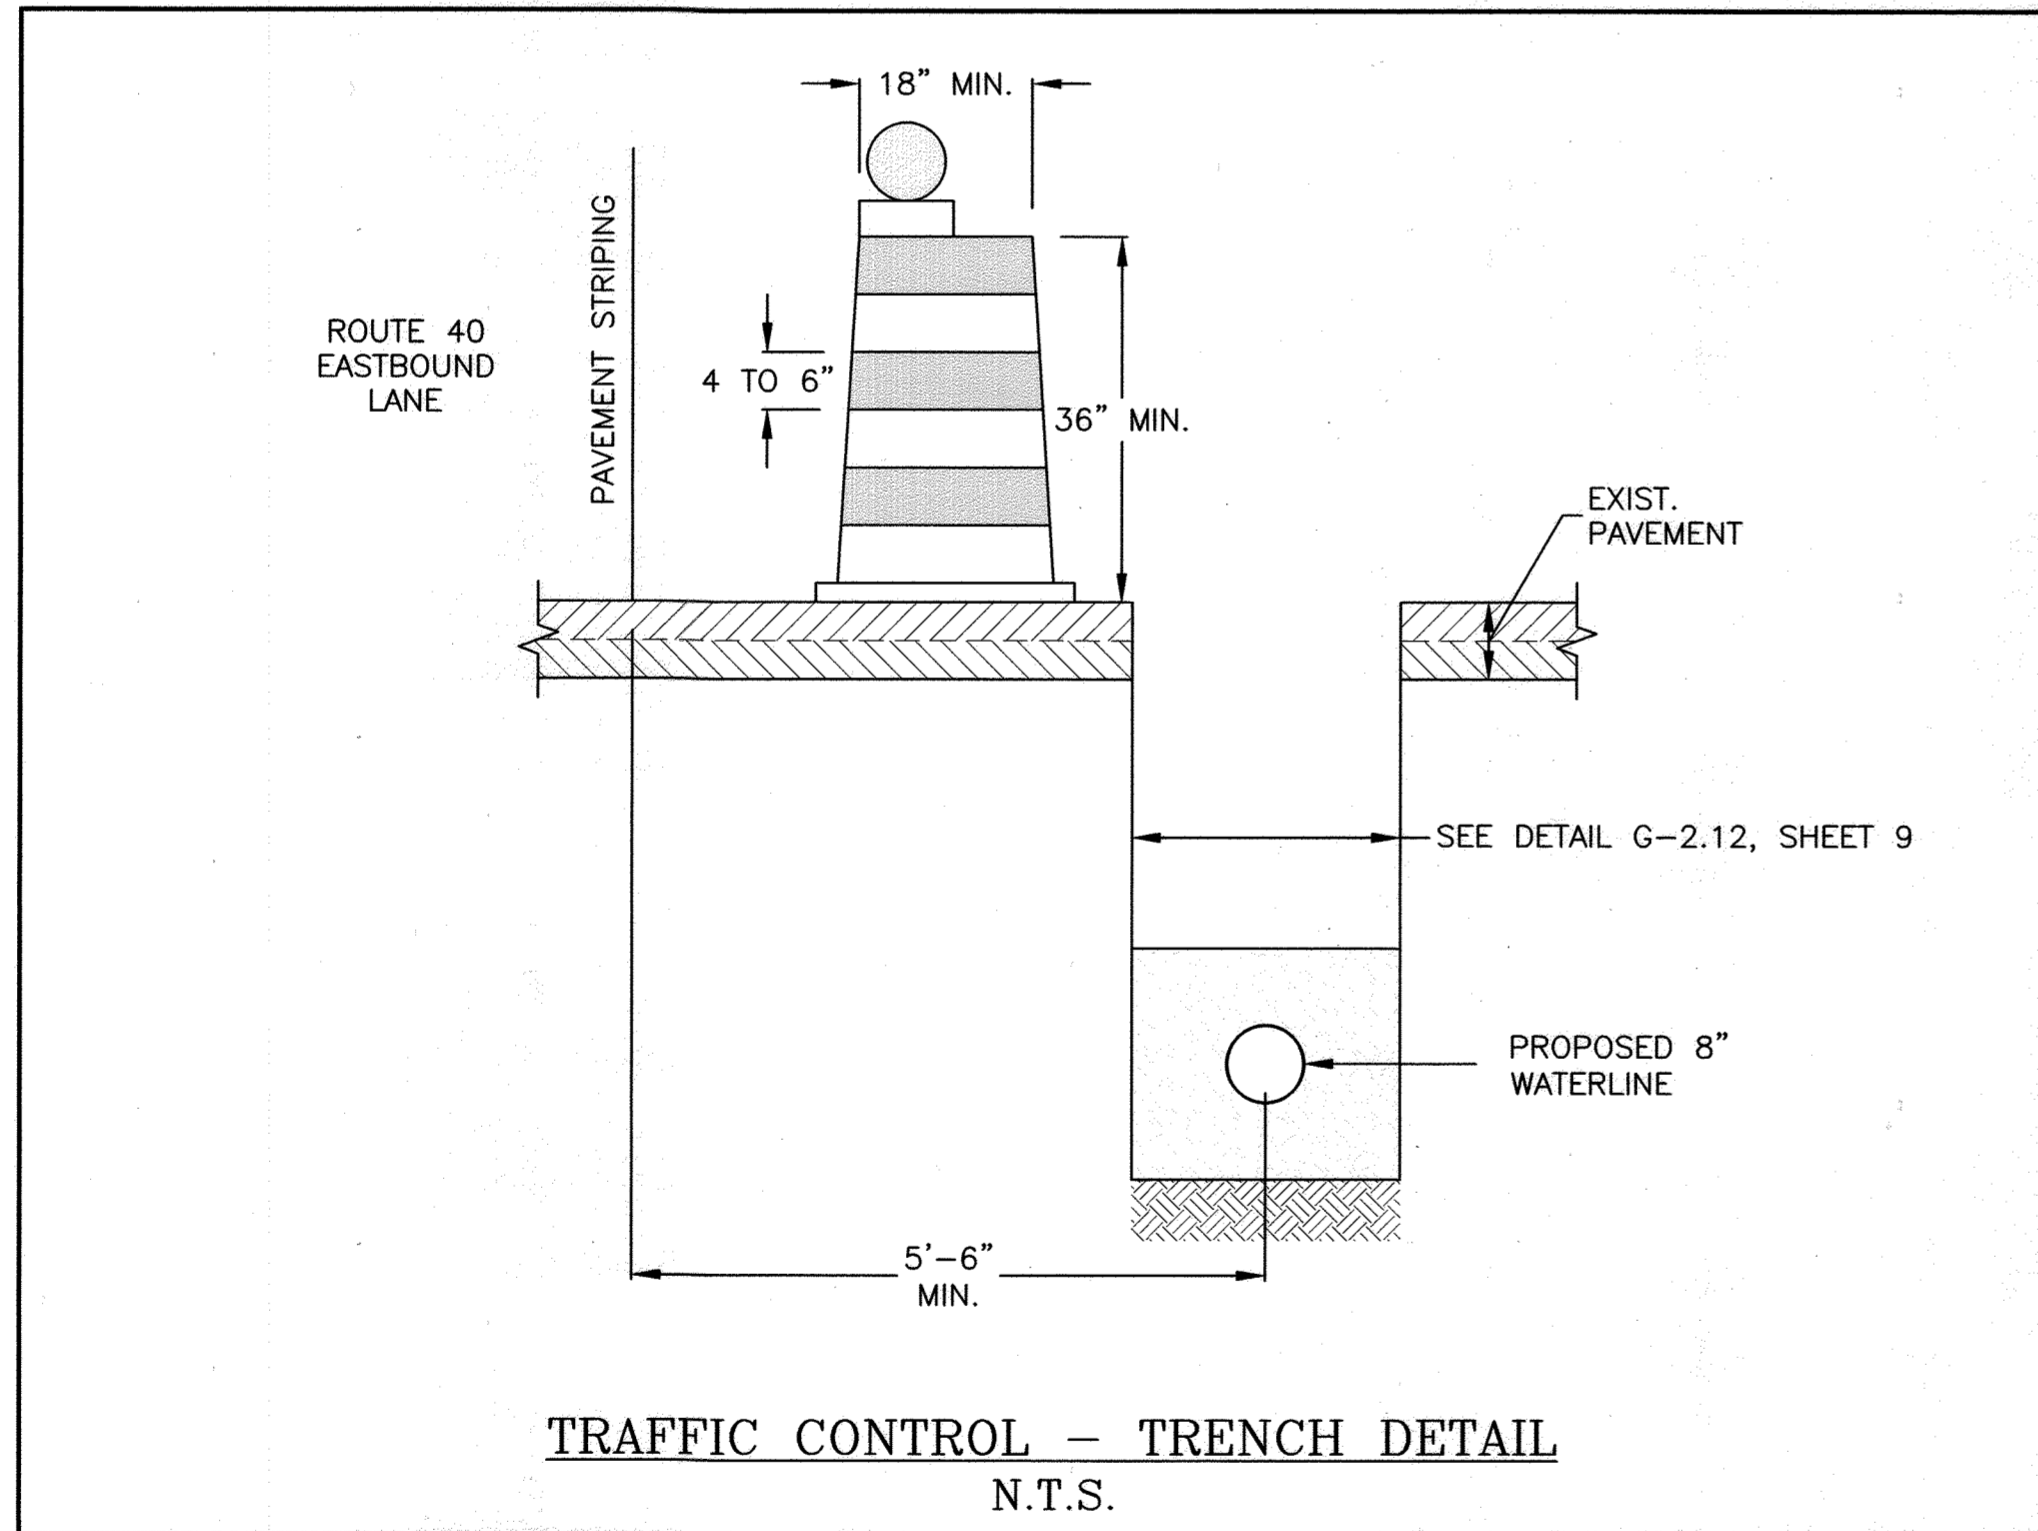


SEQUENCE OF CONSTRUCTION

1. ENGINEER TO COORDINATE PRE-CONSTRUCTION MEETING.
2. PROVIDE VIDEO TAPE TO ENGINEER DOCUMENTING EXISTING CONDITIONS.
3. OBTAIN ALL REQUIRED PERMITS AND APPROVALS FROM APPROPRIATE AGENCIES, OBTAIN GRADING PERMIT PRIOR TO STARTING CONSTRUCTION.
4. NOTIFY HOWARD COUNTY CONSTRUCTION INSPECTION DIVISION - SEDIMENT CONTROL (410)313-1855 SEVEN DAYS PRIOR TO STARTING CONSTRUCTION.
5. NOTIFY MDE INSPECTION AND COMPLIANCE (410) 537-3510 7 DAYS PRIOR TO STARTING CONSTRUCTION.
6. CONSTRUCT WATER SYSTEM IMPROVEMENTS FROM STATION 0+00 - 14+95.
 - 6.1. INSTALL TRAFFIC CONTROLS.
 - 6.2. INSTALL SEDIMENT CONTROLS.
 - 6.3. PROVIDE TEMPORARY WATER SERVICE CONNECTIONS IF SERVICES ENCOUNTERED.
 - 6.4. INSTALL NEW THRUST COLLARS ON EXISTING WATER MAIN AS REQUIRED.
 - 6.5. ISOLATE EXISTING WATERLINE AND REMOVE FROM SERVICE. CONTACT HOWARD COUNTY BUREAU OF UTILITIES (410) 313-4900 TO COORDINATE CLOSING OF VALVE UPSTREAM OF CONNECTION POINT. CONTRACTOR MUST COORDINATE CLOSING OF VALVE A MINIMUM OF 72 HOURS IN ADVANCE.
 - 6.6. REMOVE AND REPLACE EXISTING WATERLINE IN-KIND. INSTALL PROPOSED WATER MAIN AND WATER HOUSE CONNECTIONS. CONTRACTOR TO COORDINATE WATER METER LOCATION WITH HOME OWNER. LOCATION OF WATER METER AND WATER HOUSE CONNECTION IS SUBJECT TO APPROVAL BY THE COUNTY.
 - 6.7. PERFORM HYDROSTATIC PRESSURE AND LEAK TEST ON INSTALLED WATER MAIN AS PER THE LATEST EDITION OF THE HOWARD COUNTY VOLUME IV DESIGN MANUAL.
 - 6.8. DISINFECT AND BACTERIA TEST THE INSTALLED WATER MAIN. SEE HOWARD COUNTY VOLUME IV DESIGN MANUAL SECTIONS 1007 AND 1008.
 - 6.9. FLUSH NEW WATER MAIN IN PREPARATION FOR CONNECTION.
 - 6.10. CONNECT TO EXISTING WATER SYSTEM AND PLACE NEW WATERLINE INTO SERVICE.
 - 6.11. CHECK CONNECTIONS FOR LEAKS.
 - 6.12. RECONNECT EXISTING WATER SERVICES.
 - 6.13. RESTORE AREA TO ORIGINAL CONDITIONS AND REMOVE SEDIMENT & TRAFFIC CONTROLS, UPON APPROVAL FROM THE COUNTY.
7. CONSTRUCT WATER SYSTEM IMPROVEMENTS FROM STATION 14+95 - 33+15.
 - 7.1. INSTALL TRAFFIC CONTROLS.
 - 7.2. INSTALL SEDIMENT CONTROLS.
 - 7.3. INSTALL PROPOSED WATER MAIN AND WATER HOUSE CONNECTIONS. CONTRACTOR TO COORDINATE WATER METER LOCATION WITH HOME OWNER. LOCATION OF WATER METER AND WATER HOUSE CONNECTION IS SUBJECT TO APPROVAL BY THE COUNTY.
 - 7.4. PERFORM HYDROSTATIC PRESSURE AND LEAK TEST ON INSTALLED WATER MAIN AS PER THE LATEST EDITION OF THE HOWARD COUNTY VOLUME IV DESIGN MANUAL.
 - 7.5. DISINFECT AND BACTERIA TEST THE INSTALLED WATER MAIN. SEE HOWARD COUNTY VOLUME IV DESIGN MANUAL SECTIONS 1007 AND 1008.
 - 7.6. FLUSH NEW WATER MAIN IN PREPARATION FOR CONNECTION.
 - 7.7. INSTALL NEW THRUST COLLARS ON EXISTING WATER MAIN AS REQUIRED.
 - 7.8. CONNECT TO EXISTING WATER SYSTEM AND PLACE NEW WATERLINE INTO SERVICE.
 - 7.9. CHECK CONNECTIONS FOR LEAKS.
 - 7.10. RECONNECT EXISTING WATER SERVICES.
 - 7.11. ISOLATE EXISTING WATERLINE AND REMOVE FROM SERVICE CONTACT HOWARD COUNTY BUREAU OF UTILITIES (410) 313-4900 TO COORDINATE CLOSING OF VALVE UPSTREAM OF CONNECTION POINT. CONTRACTOR MUST COORDINATE CLOSING OF VALVE A MINIMUM OF 72 HOURS IN ADVANCE.
 - 7.12. ABANDON EXISTING WATERLINE IN PLACE.
 - 7.13. RESTORE AREA TO ORIGINAL CONDITIONS AND REMOVE SEDIMENT & TRAFFIC CONTROLS, UPON APPROVAL FROM THE COUNTY.
8. CONSTRUCT WATER SYSTEM IMPROVEMENTS FROM STATION 33+15 - 46+57.
 - 8.1. INSTALL TRAFFIC CONTROLS.
 - 8.2. INSTALL SEDIMENT CONTROLS.
 - 8.3. INSTALL PROPOSED WATER MAIN AND WATER HOUSE CONNECTIONS. CONTRACTOR TO COORDINATE WATER METER LOCATION WITH HOME OWNER. LOCATION OF WATER METER AND WATER HOUSE CONNECTION IS SUBJECT TO APPROVAL BY THE COUNTY.
- 8.4. PERFORM HYDROSTATIC PRESSURE AND LEAK TEST ON INSTALLED WATER MAIN AS PER THE LATEST EDITION OF THE HOWARD COUNTY VOLUME IV DESIGN MANUAL.
- 8.5. DISINFECT AND BACTERIA TEST THE INSTALLED WATER MAIN. SEE HOWARD COUNTY VOLUME IV DESIGN MANUAL SECTIONS 1007 AND 1008.
- 8.6. FLUSH NEW WATER MAIN IN PREPARATION FOR CONNECTION.
- 8.7. INSTALL NEW THRUST COLLARS ON EXISTING WATER MAIN AS REQUIRED.
- 8.8. CONNECT TO EXISTING WATER SYSTEM AND PLACE NEW WATERLINE INTO SERVICE.
- 8.9. CHECK CONNECTIONS FOR LEAKS.
- 8.10. RECONNECT EXISTING WATER SERVICES.
- 8.11. ISOLATE EXISTING WATERLINE AND REMOVE FROM SERVICE CONTACT HOWARD COUNTY BUREAU OF UTILITIES (410) 313-4900 TO COORDINATE CLOSING OF VALVE UPSTREAM OF CONNECTION POINT. CONTRACTOR MUST COORDINATE CLOSING OF VALVE A MINIMUM OF 72 HOURS IN ADVANCE.
- 8.12. ABANDON EXISTING WATERLINE IN PLACE.
- 8.13. RESTORE AREA TO ORIGINAL CONDITIONS AND REMOVE SEDIMENT & TRAFFIC CONTROLS, UPON APPROVAL FROM THE COUNTY.
9. CONSTRUCT WATER SYSTEM IMPROVEMENTS FROM STATION 46+57 - 51+97.
 - 9.1. INSTALL TRAFFIC CONTROLS.
 - 9.2. INSTALL SEDIMENT CONTROLS.
 - 9.3. INSTALL PROPOSED WATER MAIN AND WATER HOUSE CONNECTIONS. CONTRACTOR TO COORDINATE WATER METER LOCATION WITH HOME OWNER. LOCATION OF WATER METER AND WATER HOUSE CONNECTION IS SUBJECT TO APPROVAL BY THE COUNTY.
 - 9.4. TEMPORARILY RELOCATE EXISTING SERVICES ENCOUNTERED AND RECONNECT TO EXISTING WATERLINE.
 - 9.5. PERFORM HYDROSTATIC PRESSURE AND LEAK TEST ON INSTALLED WATER MAIN AS PER THE LATEST EDITION OF THE HOWARD COUNTY VOLUME IV DESIGN MANUAL.
 - 9.6. DISINFECT AND BACTERIA TEST THE INSTALLED WATER MAIN. SEE HOWARD COUNTY VOLUME IV DESIGN MANUAL SECTIONS 1007 AND 1008.
 - 9.7. FLUSH NEW WATER MAIN IN PREPARATION FOR CONNECTION.
 - 9.8. INSTALL NEW THRUST COLLARS ON EXISTING WATER MAIN AS REQUIRED.
 - 9.9. CONNECT TO EXISTING WATER SYSTEM AND PLACE NEW WATERLINE INTO SERVICE.
 - 9.10. CHECK CONNECTIONS FOR LEAKS.
 - 9.11. RECONNECT EXISTING WATER SERVICES.
 - 9.12. ISOLATE EXISTING WATERLINE AND REMOVE FROM SERVICE CONTACT HOWARD COUNTY BUREAU OF UTILITIES (410) 313-4900 TO COORDINATE CLOSING OF VALVE UPSTREAM OF CONNECTION POINT. CONTRACTOR MUST COORDINATE CLOSING OF VALVE A MINIMUM OF 72 HOURS IN ADVANCE.
 - 9.13. ABANDON EXISTING WATERLINE IN PLACE.
 - 9.14. RESTORE AREA TO ORIGINAL CONDITIONS AND REMOVE SEDIMENT & TRAFFIC CONTROLS, UPON APPROVAL FROM THE COUNTY.
10. CONSTRUCT WATER SYSTEM IMPROVEMENTS FROM STATION 51+97 - 60+51.
 - 10.1. INSTALL TRAFFIC CONTROLS.
 - 10.2. INSTALL SEDIMENT CONTROLS.
 - 10.3. INSTALL PROPOSED WATER MAIN AND WATER HOUSE CONNECTIONS. CONTRACTOR TO COORDINATE WATER METER LOCATION WITH HOME OWNER. LOCATION OF WATER METER AND WATER HOUSE CONNECTION IS SUBJECT TO APPROVAL BY THE COUNTY.
 - 10.4. TEMPORARILY RELOCATE EXISTING SERVICES ENCOUNTERED AND RECONNECT TO EXISTING WATERLINE.
 - 10.5. PERFORM HYDROSTATIC PRESSURE AND LEAK TEST ON INSTALLED WATER MAIN AS PER THE LATEST EDITION OF THE HOWARD COUNTY VOLUME IV DESIGN MANUAL.
 - 10.6. DISINFECT AND BACTERIA TEST THE INSTALLED WATER MAIN. SEE HOWARD COUNTY VOLUME IV DESIGN MANUAL SECTIONS 1007 AND 1008.
 - 10.7. FLUSH NEW WATER MAIN IN PREPARATION FOR CONNECTION.
 - 10.8. INSTALL NEW THRUST COLLARS ON EXISTING WATER MAIN AS REQUIRED.
 - 10.9. CONNECT TO EXISTING WATER SYSTEM AND PLACE NEW WATERLINE INTO SERVICE.
 - 10.10. CHECK CONNECTIONS FOR LEAKS.
 - 10.11. RECONNECT EXISTING WATER SERVICES.
 - 10.12. ISOLATE EXISTING WATERLINE AND REMOVE FROM SERVICE CONTACT HOWARD COUNTY BUREAU OF UTILITIES (410) 313-4900 TO COORDINATE CLOSING OF VALVE UPSTREAM OF CONNECTION POINT. CONTRACTOR MUST COORDINATE CLOSING OF VALVE A MINIMUM OF 72 HOURS IN ADVANCE.
 - 10.13. ABANDON EXISTING WATERLINE IN PLACE.
 - 10.14. RESTORE AREA TO ORIGINAL CONDITIONS AND REMOVE SEDIMENT & TRAFFIC CONTROLS, UPON APPROVAL FROM THE COUNTY.
11. MILL AND OVERLAY ASPHALT AND INSTALL PERMANENT PAVEMENT MARKINGS.
12. FINAL CLEANUP AND RESTORATION.
13. PROVIDE AS-BUILT RECORDS TO ENGINEER.

DEPARTMENT OF PUBLIC WORKS
HOWARD COUNTY, MARYLAND

Jerry A. ... 3/13/13 DIRECTOR OF PUBLIC WORKS
Thomas & ... 3/13/13 CHIEF, BUREAU OF ENGINEERING
William C. ... 3/12/13 CHIEF, BUREAU OF UTILITIES
... 3/12/13 CHIEF, UTILITY DESIGN DIVISION

URS
MONTGOMERY PARK BUSINESS CENTER
1800 WASHINGTON BOULEVARD, SUITE 410
BALTIMORE, MARYLAND 21230
(410) 468-0875

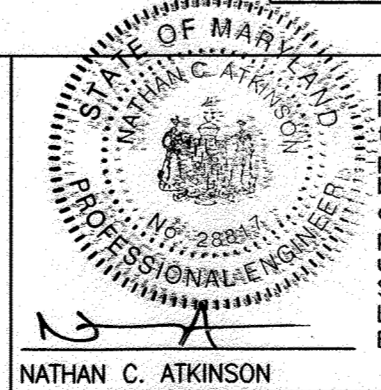

Professional Certification
I hereby certify that these documents were prepared or approved by me, and that I am a duly licensed professional engineer under the laws of the State of Maryland, License No. 28917, Expiration Date: 08/01/13

DESIGN: NCA					
DRAWN: BJW					
CHK: EMT					
DATE: 3/7/13	NO.	REVISION	DATE	BY	






MISCELLANEOUS DETAILS AND SEQUENCE OF CONSTRUCTION

60' SCALE MAP NO. 24
BLOCK NO. 12

U.S. 40 WATER SERVICE MAIN REPLACEMENT
CAPITAL PROJECT NO. W-8311
CONTRACT NO. 44-4731
6TH ELECTION DISTRICT
HOWARD COUNTY, MARYLAND

SCALE: AS SHOWN
SHEET 8 OF 13

AS-BUILT 1/2015

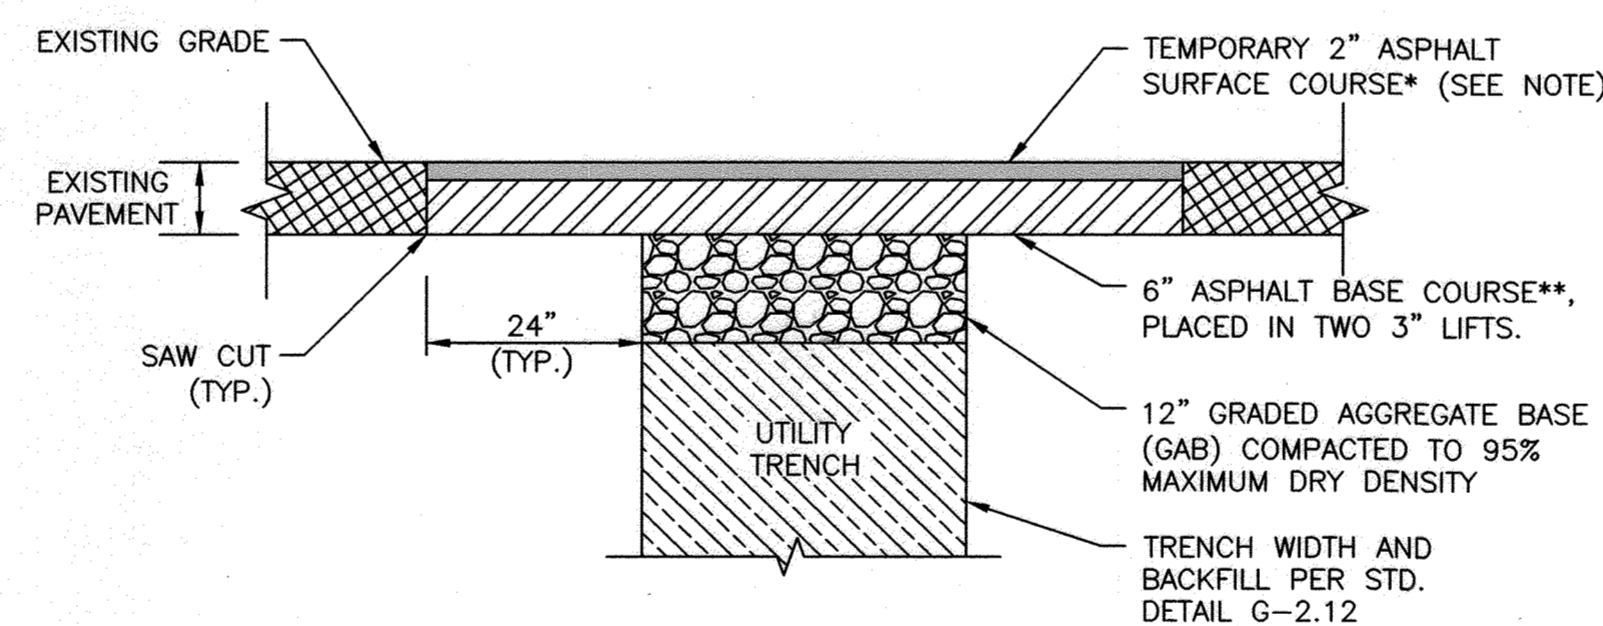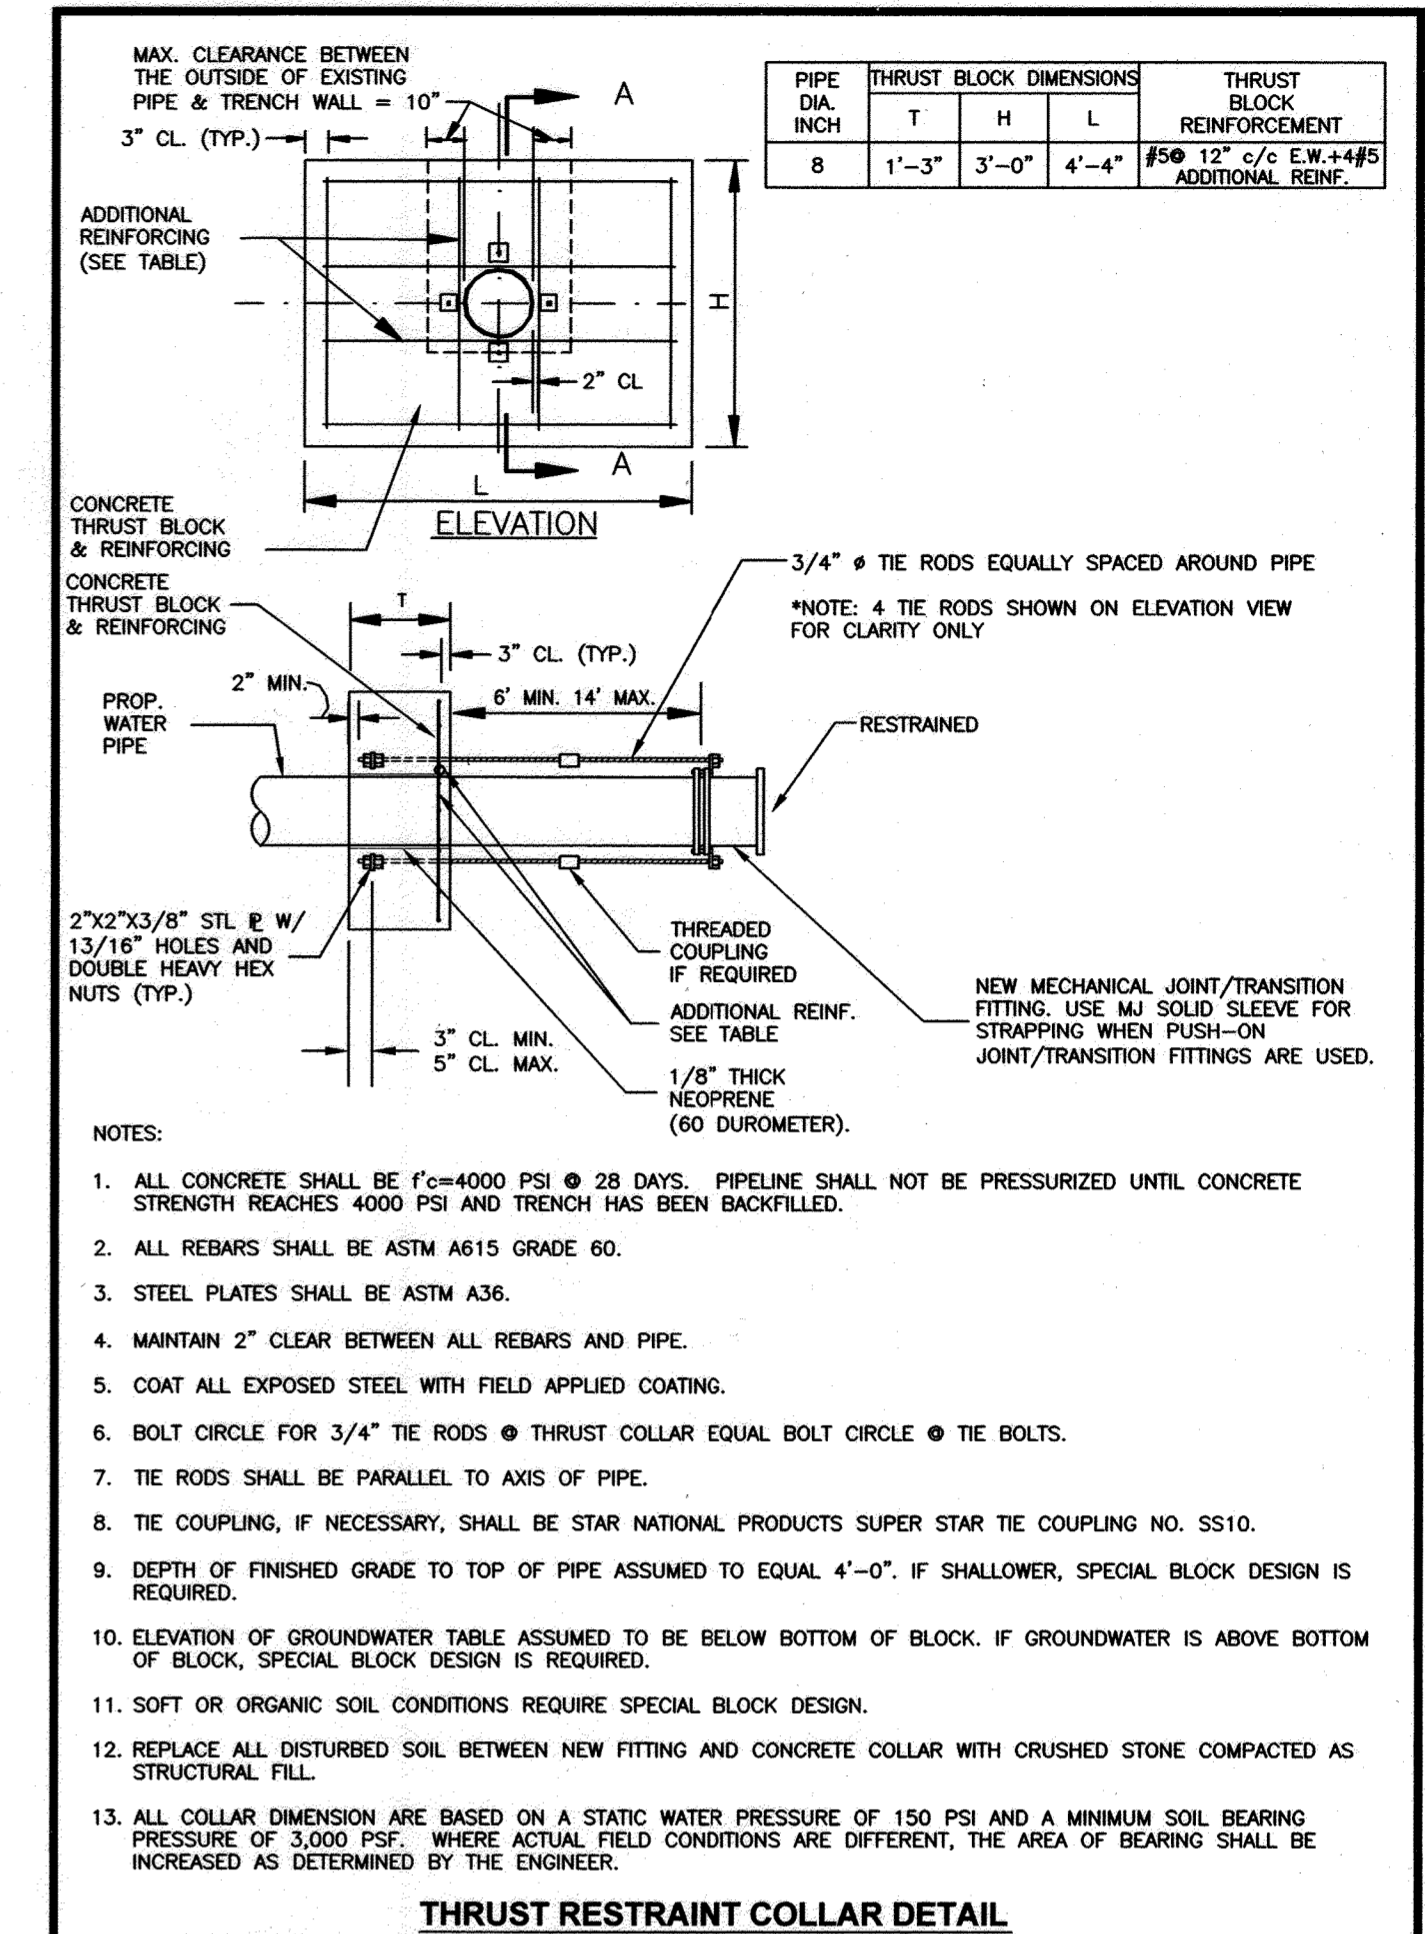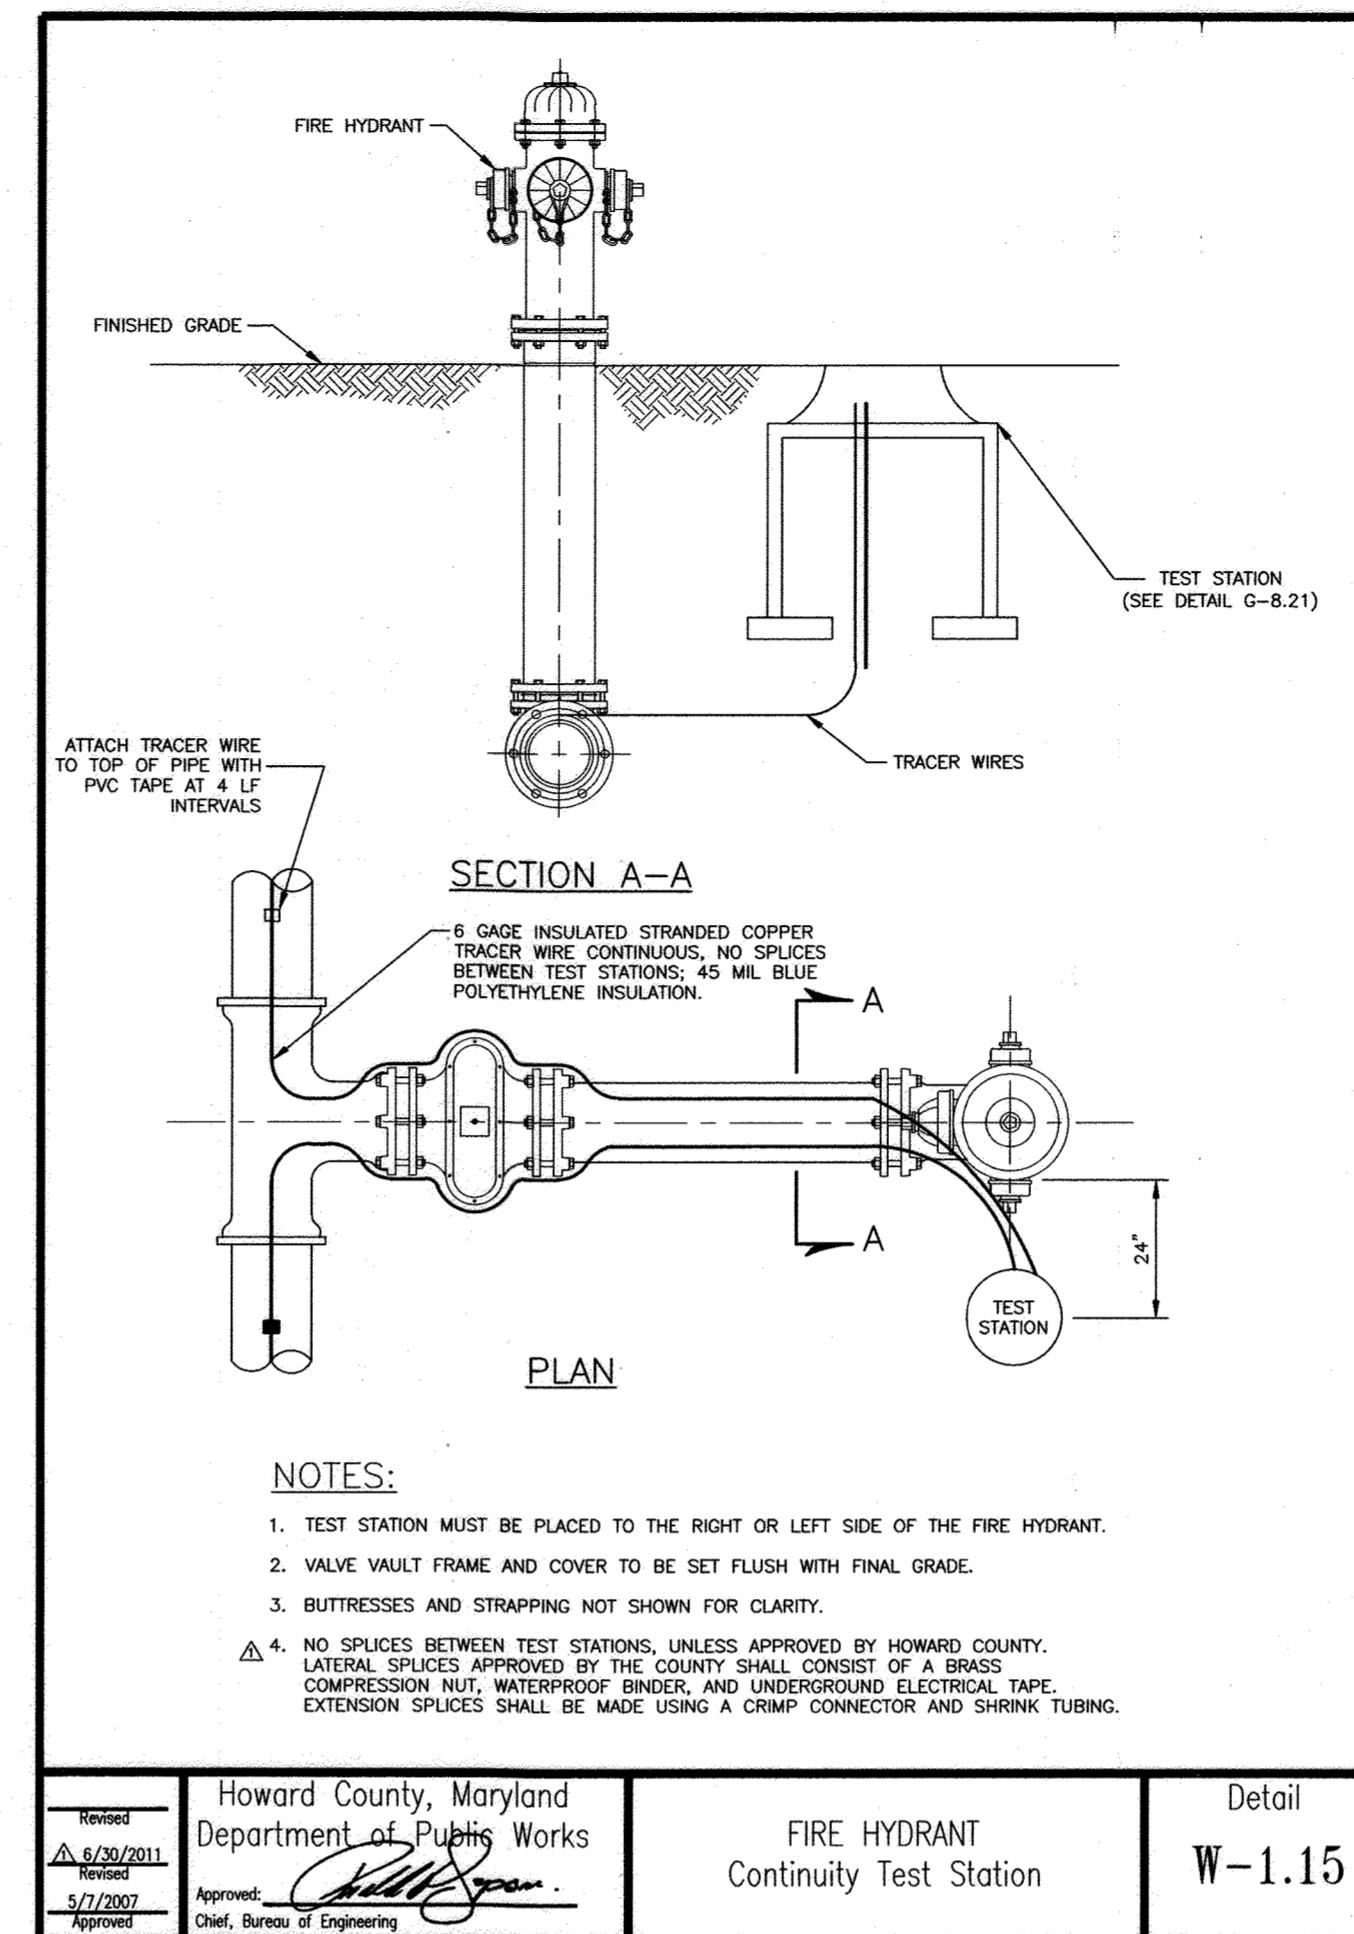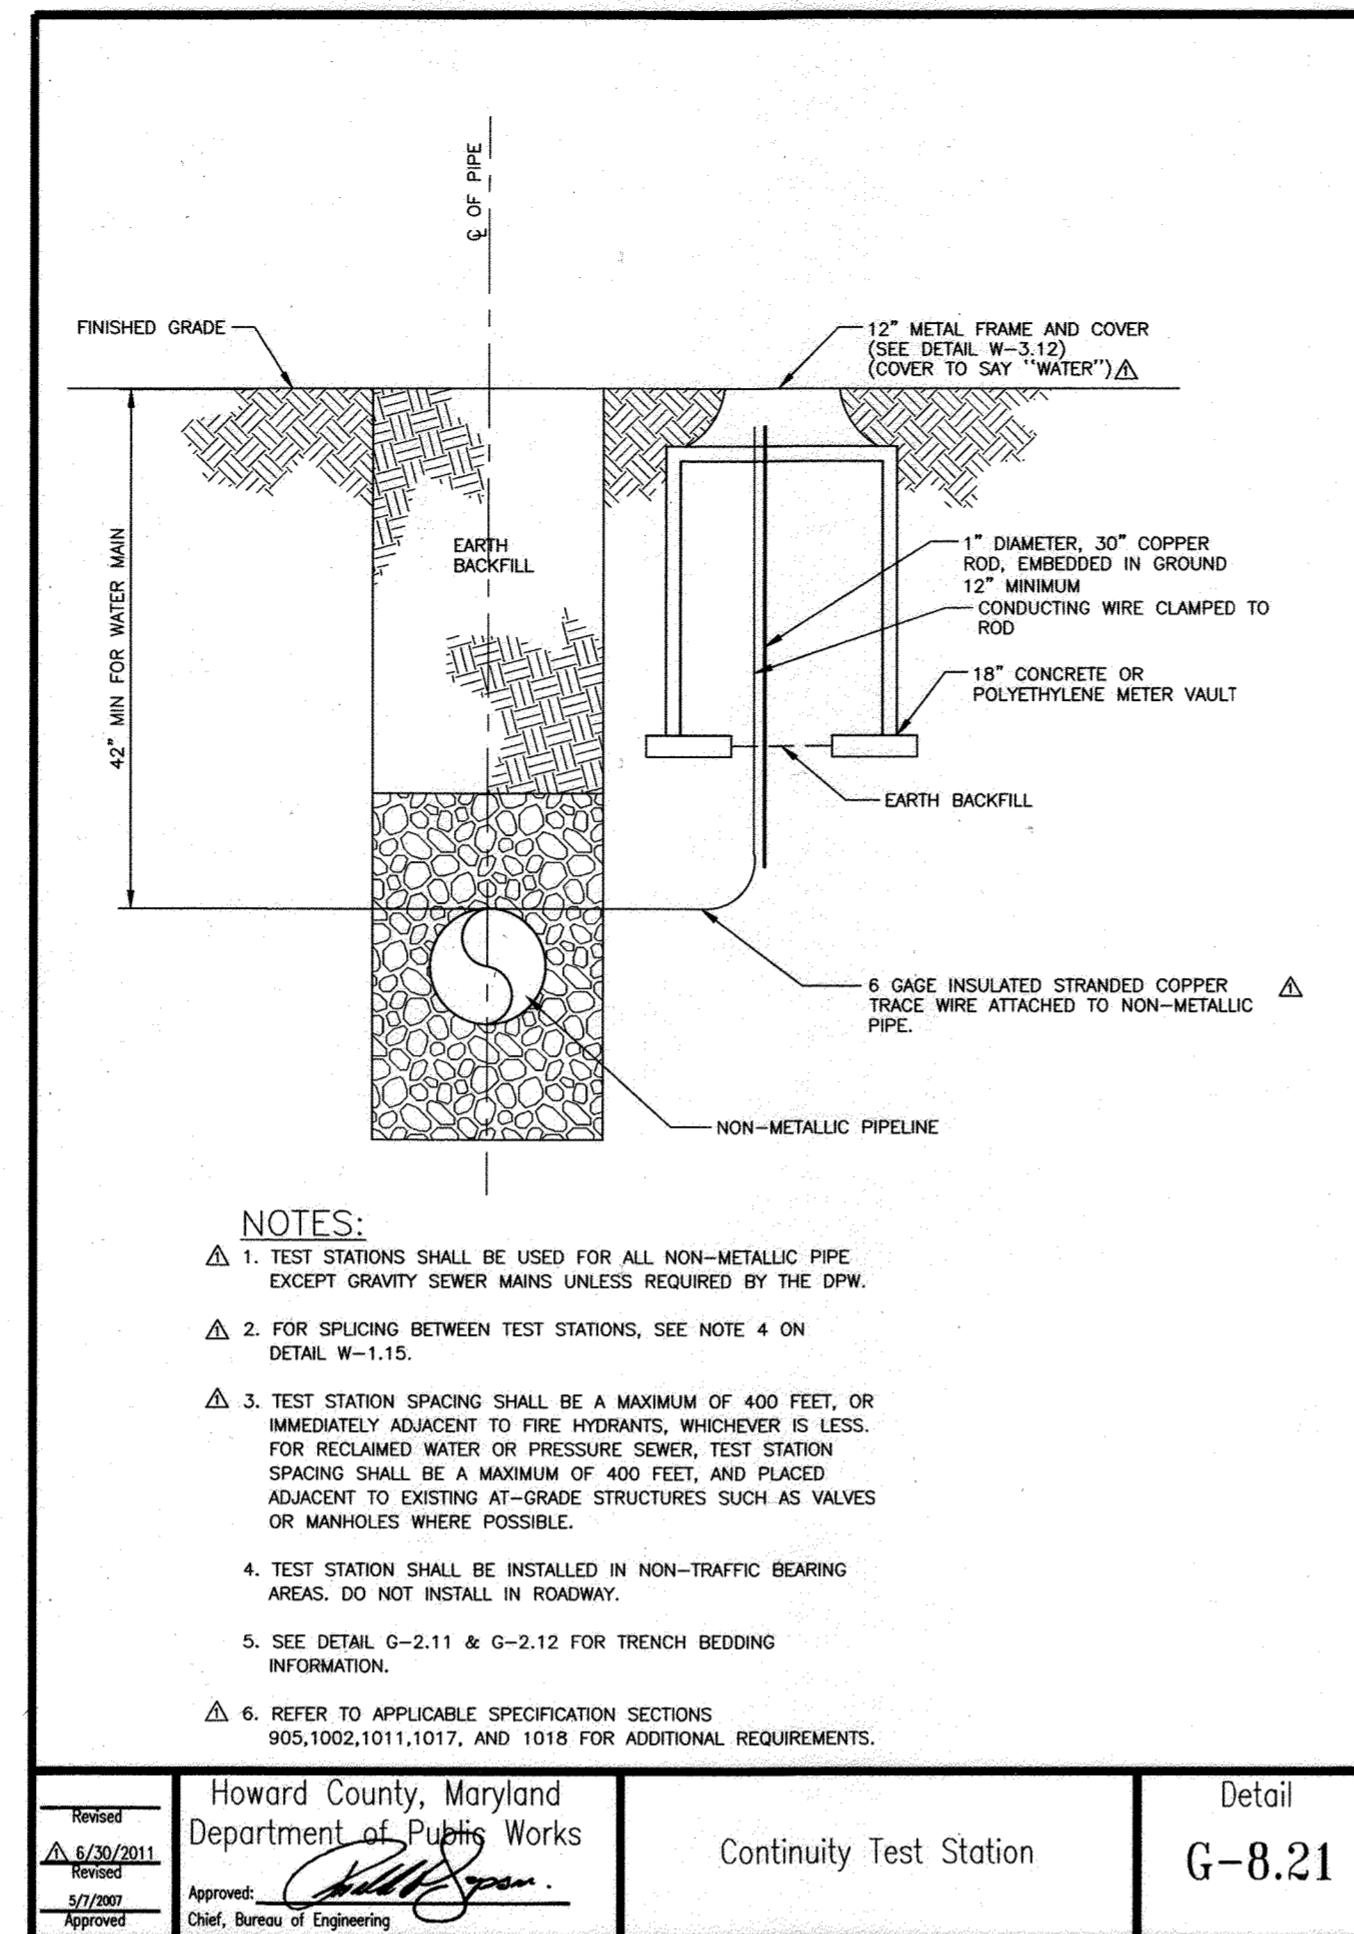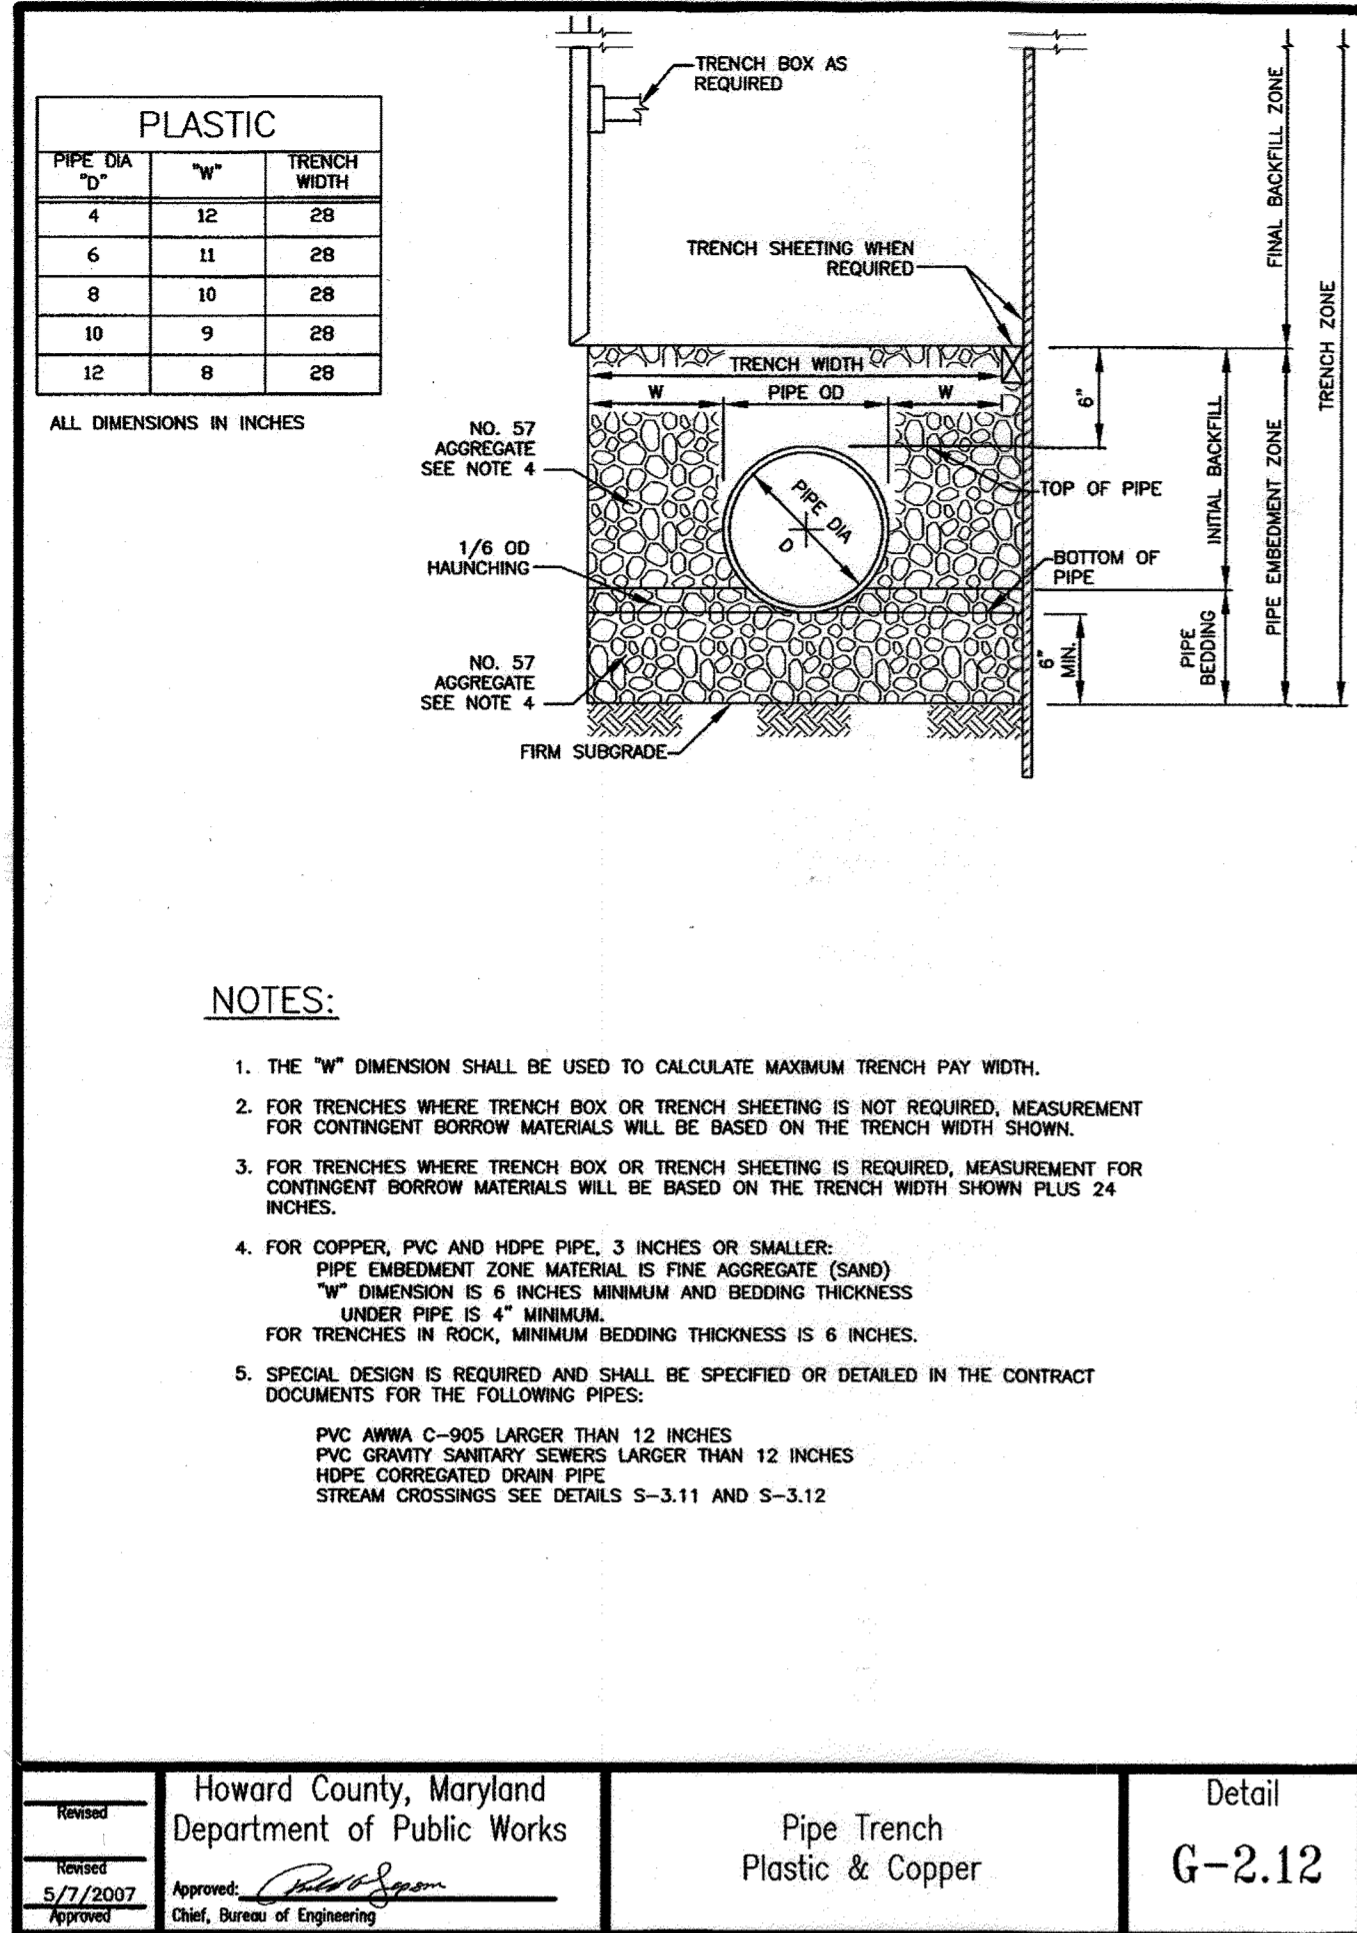


* = HOT MIX SUPERPAVE SURFACE COURSE
9.5 MM PG 64-22 LEVEL 2 OR
12.5 MM PG 76-22 LEVEL 2

** = HOT MIX SUPERPAVE BASE COURSE
19.0 MM PG 64-22 LEVEL 2

NOTE: CONTRACTOR SHALL REPAIR TRENCH AND PAVEMENT TO MATCH EXISTING ROAD GRADE. FOLLOWING COMPLETION OF WATER SYSTEM IMPROVEMENTS, CONTRACTOR SHALL MILL AND OVERLAY EXISTING ROADWAY TO LIMITS INDICATED ON THE DRAWINGS, INCLUDING TRENCH PAVEMENT REPAIR AREAS. NO SEPARATE PAVEMENT WILL BE MADE FOR TEMPORARY 2" SURFACE COURSE.

TRENCH PAVEMENT REPAIR DETAIL
NOT TO SCALE

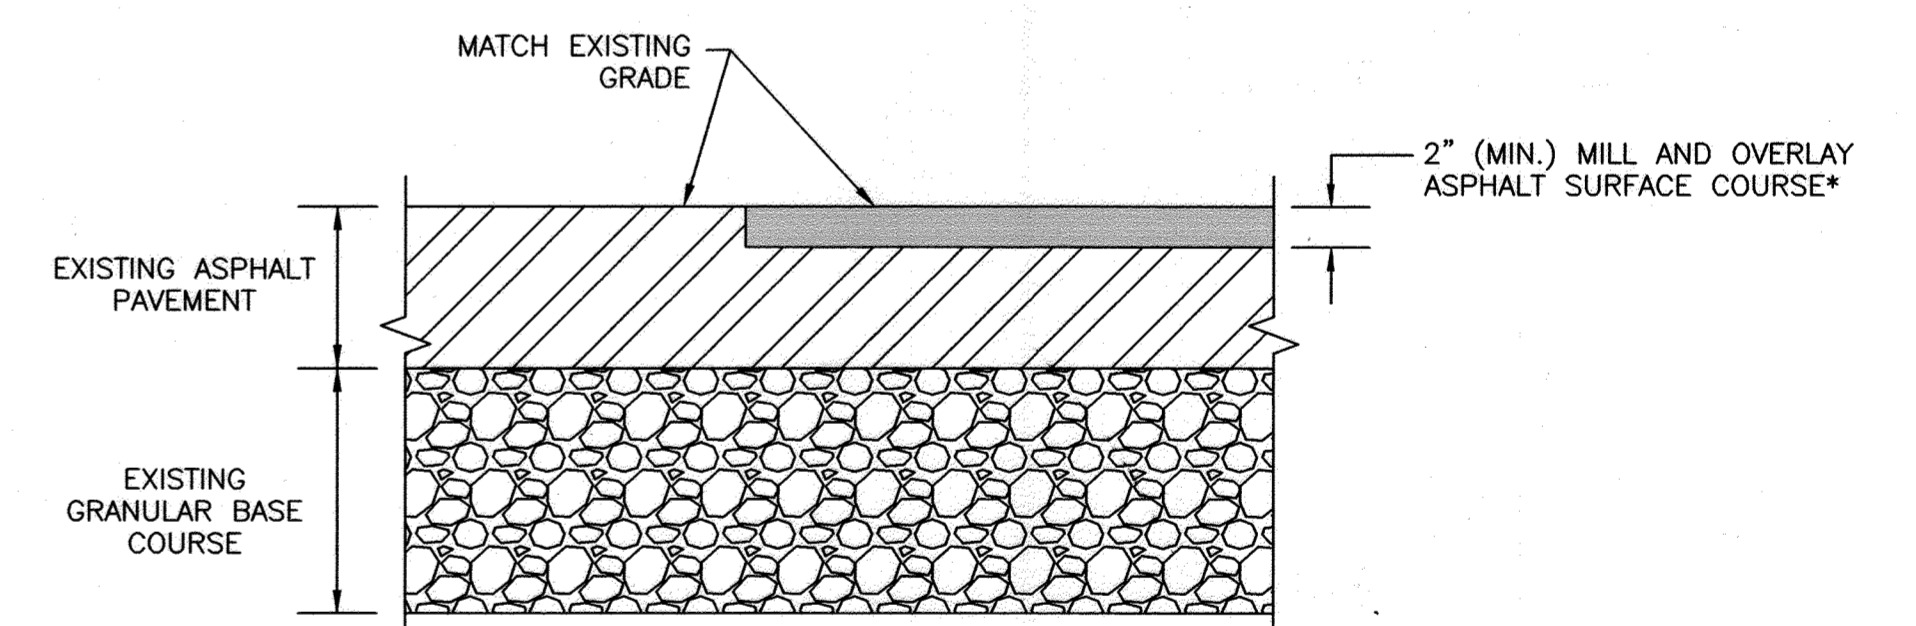

* = HOT MIX SUPERPAVE
9.5 MM PG 64-22 LEVEL 2 OR
12.5 MM PG 76-22 LEVEL 2

MILL AND OVERLAY DETAIL
NOT TO SCALE

DEPARTMENT OF PUBLIC WORKS
HOWARD COUNTY, MARYLAND

[Signature] 3/13/13
DIRECTOR OF PUBLIC WORKS DATE


[Signature] 3/13/13
CHIEF, BUREAU OF ENGINEERING DATE

[Signature] 3/13/13
CHIEF, BUREAU OF UTILITIES DATE

[Signature] 3/12/13
CHIEF, UTILITY DESIGN DIVISION DATE

URS

MONTGOMERY PARK BUSINESS CENTER
1800 WASHINGTON BOULEVARD, SUITE 410
BALTIMORE, MARYLAND 21230
(410) 468-0875

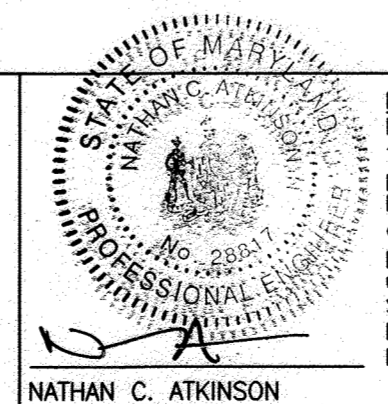

Professional Certification
I hereby certify that these documents were prepared or approved by me, and that I am a duly licensed professional engineer under the laws of the State of Maryland.
License No. 28817
Expiration Date: 08/01/13

DESIGN: NCA					
DRAWN: BJW					
CHK: EMT					
DATE: 3/7/13	NO.	REVISION	DATE	BY	

MISCELLANEOUS
DETAILS






600' SCALE MAP NO. 24
BLOCK NO. 12

U.S. 40 WATER SERVICE MAIN REPLACEMENT
CAPITAL PROJECT NO. W-8311
CONTRACT NO. 44-4731
6TH ELECTION DISTRICT
HOWARD COUNTY, MARYLAND

SCALE:
AS SHOWN

SHEET
9 OF 13

AS-BUILT 1/2015

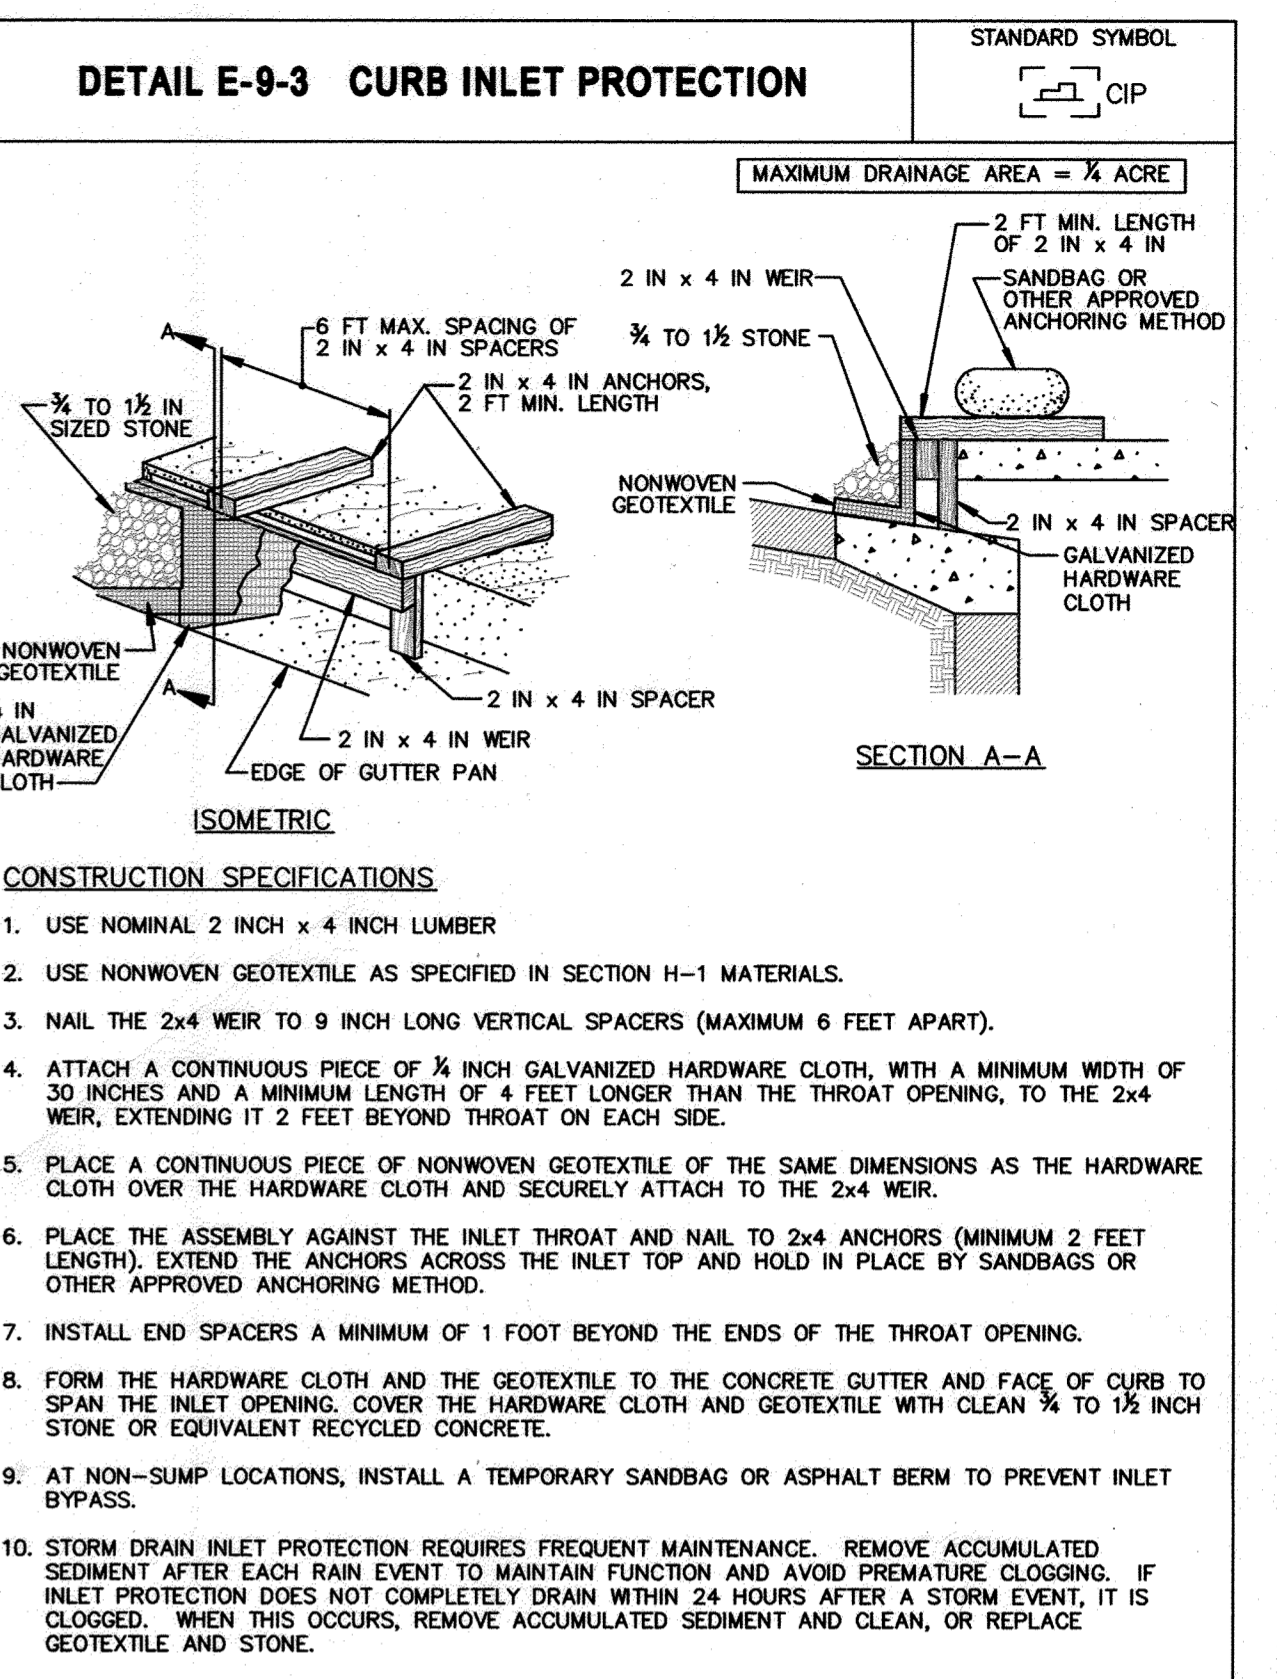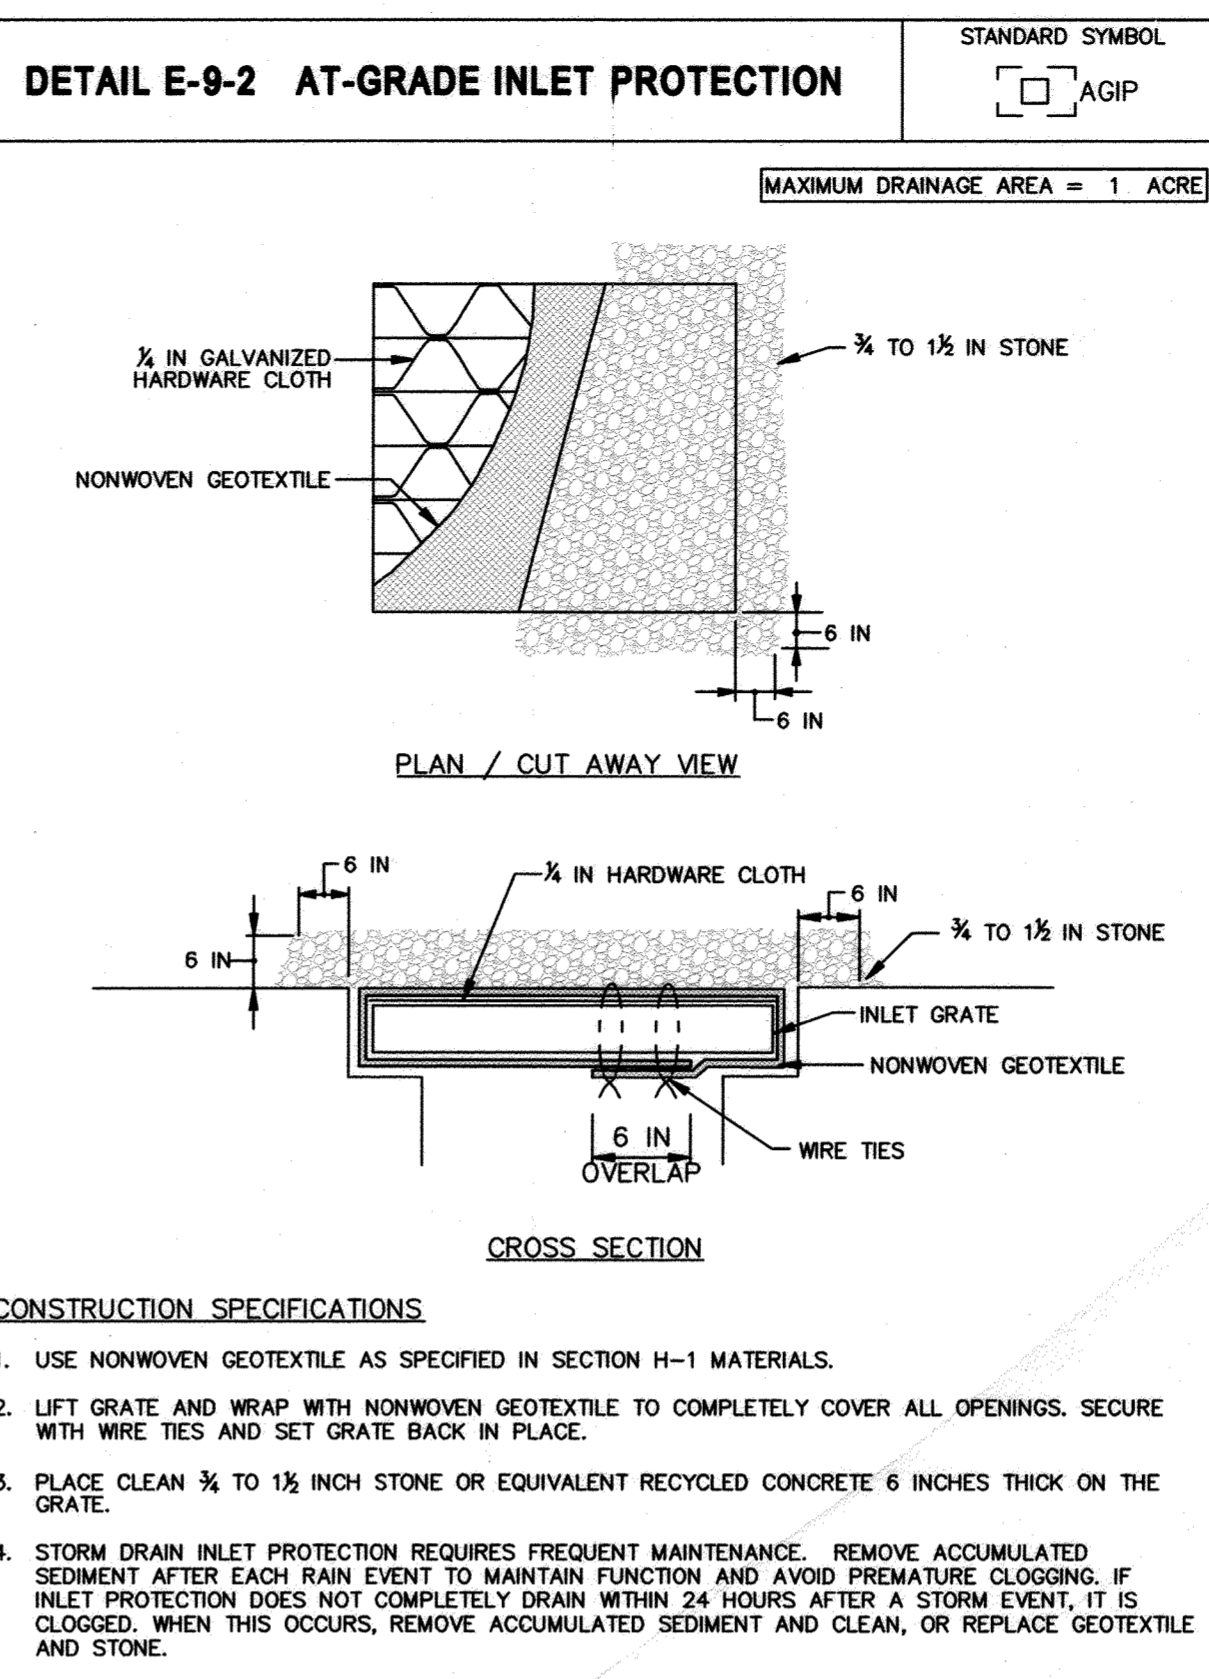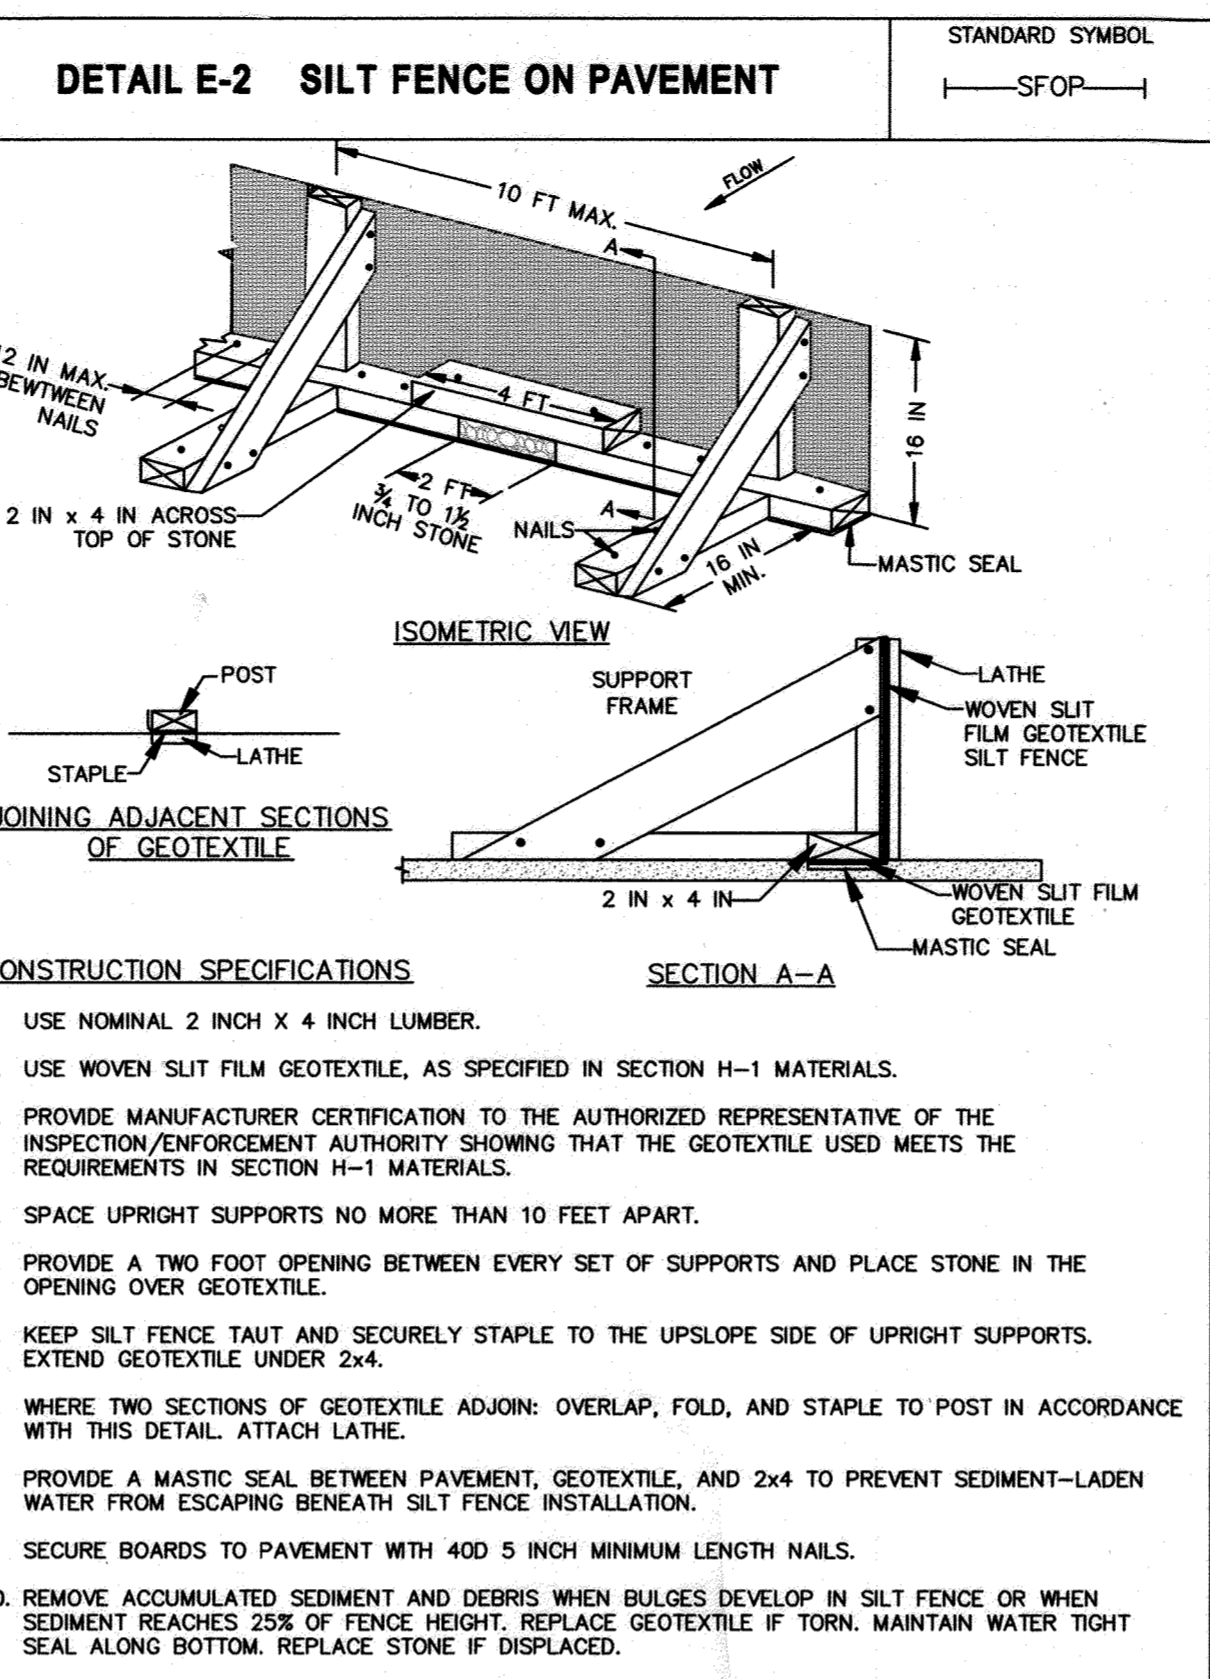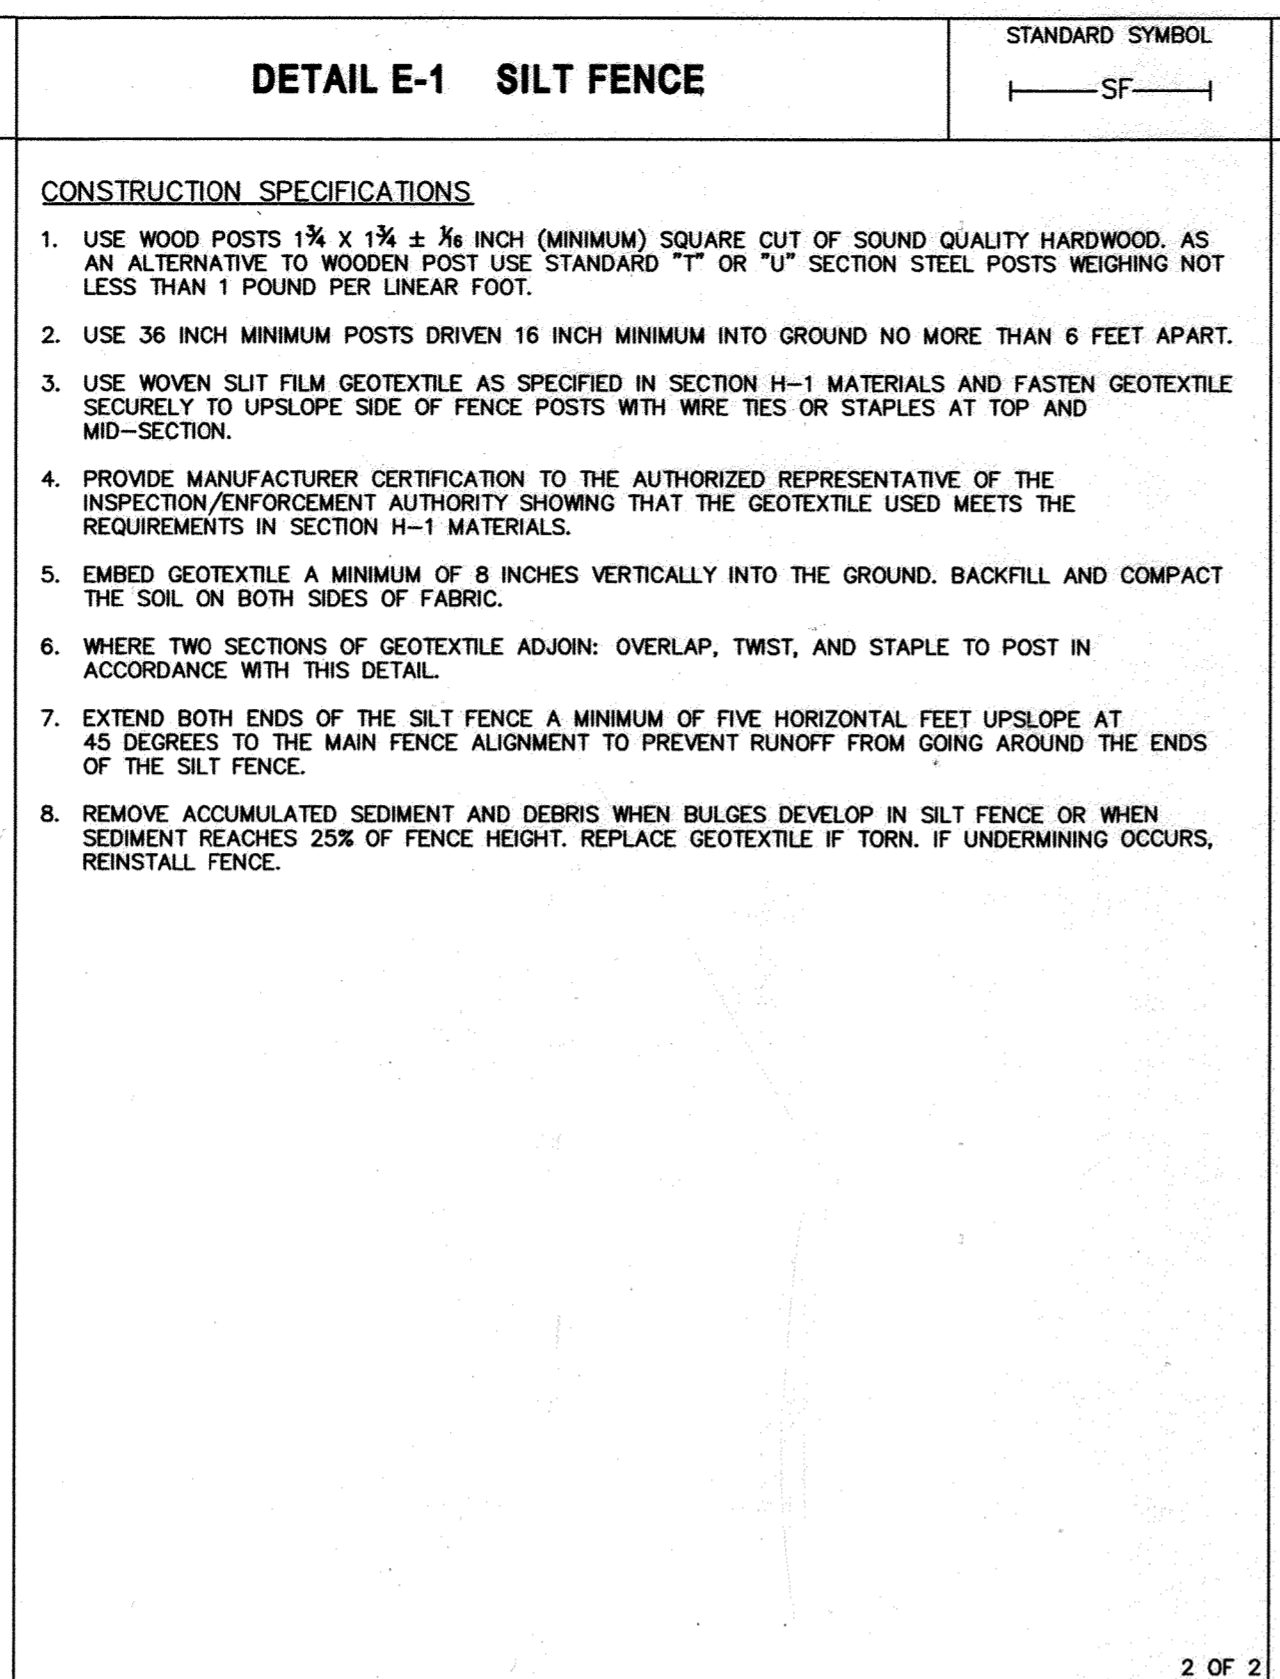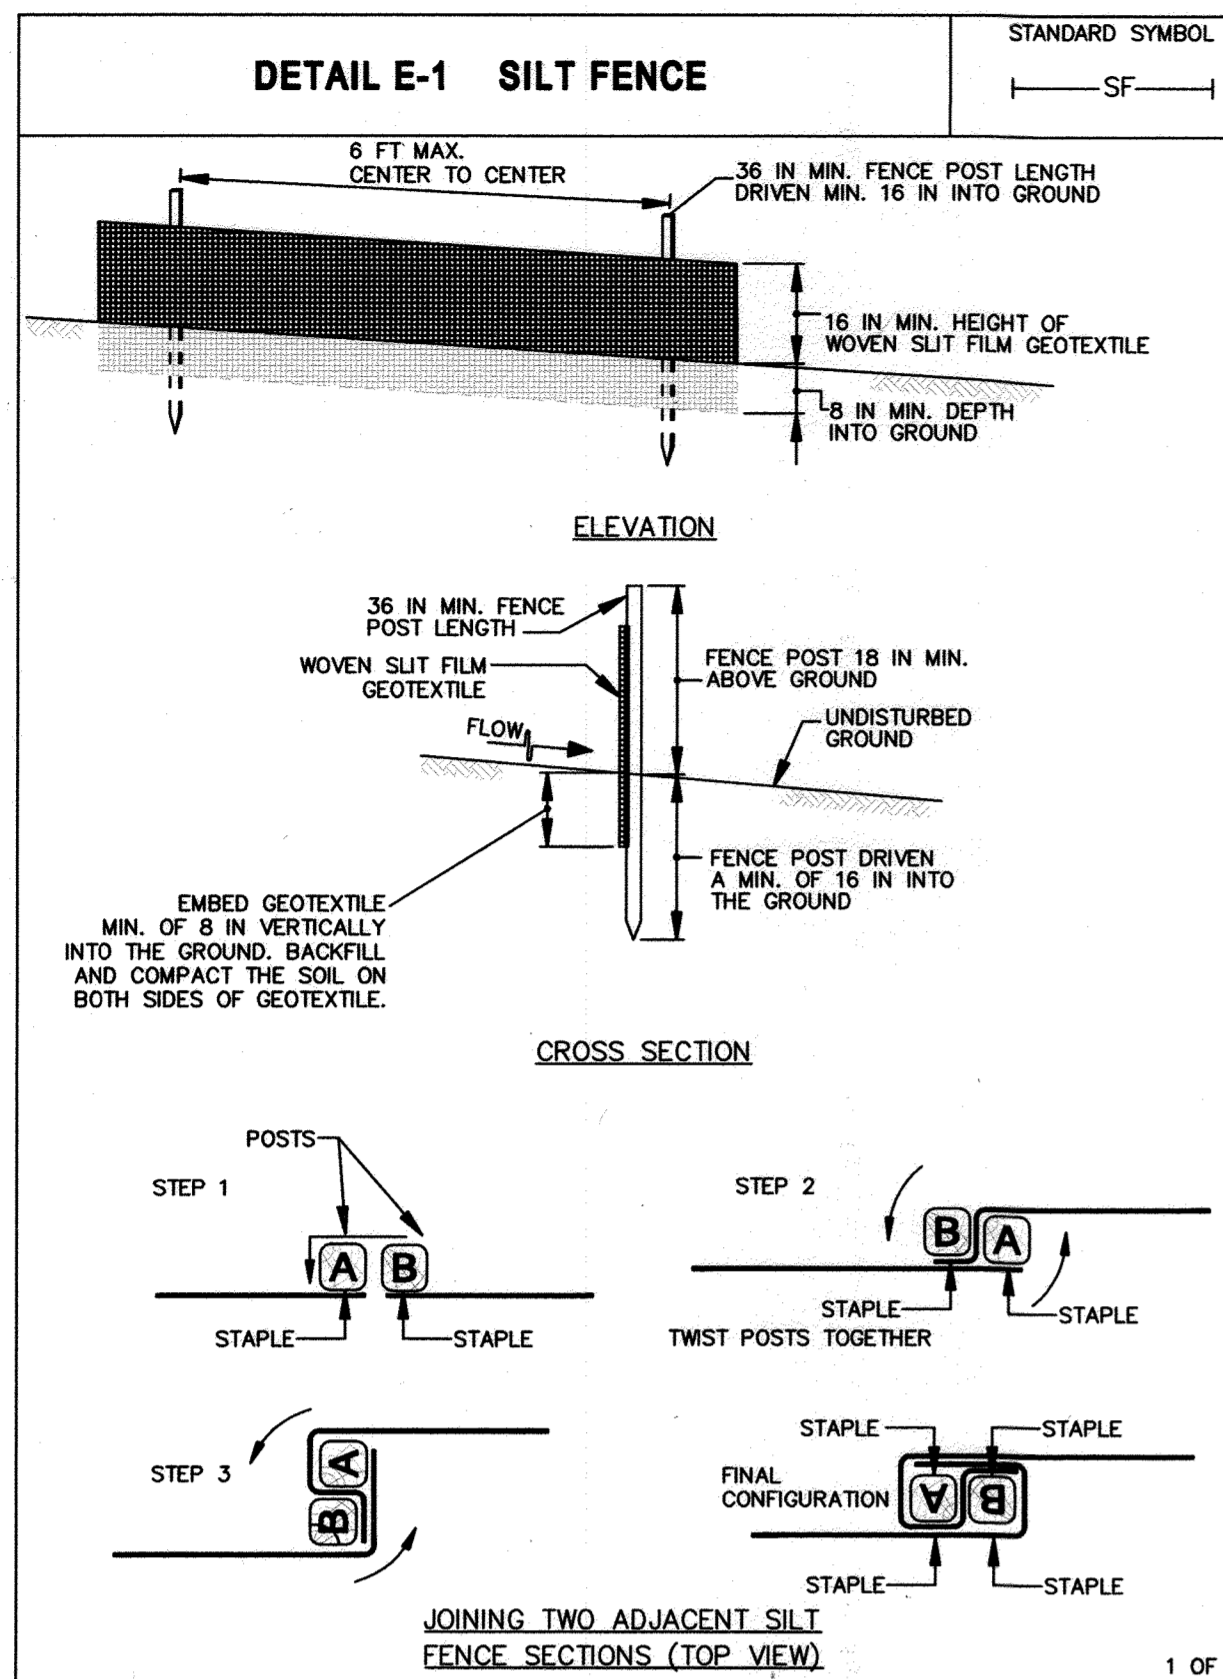

MARYLAND STANDARDS AND SPECIFICATIONS FOR SOIL EROSION AND SEDIMENT CONTROL
 U.S. DEPARTMENT OF AGRICULTURE NATURAL RESOURCES CONSERVATION SERVICE 2011
 MARYLAND DEPARTMENT OF ENVIRONMENT WATER MANAGEMENT ADMINISTRATION


MARYLAND STANDARDS AND SPECIFICATIONS FOR SOIL EROSION AND SEDIMENT CONTROL
 U.S. DEPARTMENT OF AGRICULTURE NATURAL RESOURCES CONSERVATION SERVICE 2011
 MARYLAND DEPARTMENT OF ENVIRONMENT WATER MANAGEMENT ADMINISTRATION

MARYLAND STANDARDS AND SPECIFICATIONS FOR SOIL EROSION AND SEDIMENT CONTROL
 U.S. DEPARTMENT OF AGRICULTURE NATURAL RESOURCES CONSERVATION SERVICE 2011
 MARYLAND DEPARTMENT OF ENVIRONMENT WATER MANAGEMENT ADMINISTRATION

- PERMANENT SEEDING NOTES**
- Apply to graded or cleared areas not subject to immediate further disturbance where a permanent long-lived vegetative cover is needed.
 - Seedbed Preparation: Loosen upper three inches of soil by raking, disking or other acceptable means before seeding, if not previously loosened.
 - Soil Amendments: In lieu of soil test recommendations, use one of the following schedules:
 - Preferred - Apply 2 tons/acre dolomitic limestone (92 lbs/1000 sq. ft.) and 600 lbs/acre 10-10-10 fertilizer (14 lbs/1000 sq. ft.) before seeding. Harrow or disk into upper three inches of soil. At time of seeding, apply 400 lbs/acre 30-0-0 ureaform fertilizer (9 lbs/1000 sq. ft.)
 - Acceptable - Apply 2 tons/acre dolomitic limestone (92 lbs/1000 sq. ft.) and 1000 lbs/acre 10-10-10 fertilizer (23 lbs/1000 sq. ft.) before seeding. Harrow or disk into upper three inches of soil.
 - Seeding:
 - For the periods March 1 - April 30, and August 1 - October 15, seed with 60 lbs/acre (1.4 lbs/1000 sq. ft.) of Kentucky 31 Tall fescue.
 - For the period May 1 - July 31, seed with 60 lbs Kentucky 31 Tall Fescue per acre and 2 lbs/acre (.05 lbs/1000 sq. ft.) of weeping lovegrass.
 - During the period of October 16 - February 28, protect site by:
 - Option 1 - Two tons per acre of well anchored straw mulch and seed as soon as possible in the spring.
 - Option 2 - Use sod.
 - Option 3 - Seed with 60 lbs/acre Kentucky 30 Tall Fescue and mulch with 2 tons/acre well anchored straw.
 - Mulching - Apply 1-1/2 to 2 tons per acre (70 to 90 lbs/1000 sq. ft.) of unrotted small grain straw immediately after seeding. Anchor mulch immediately after application using mulch anchoring tool or 218 gallons per acre (5 gal/1000 sq. ft.) of emulsified asphalt on flat areas. On slope 8 feet or higher, use 348 gallons per acre (8 gal/1000 sq. ft.) for anchoring.
 - Maintenance - Inspect all seeding areas and make needed repairs, replacements and reseedings.

- TEMPORARY SEEDING NOTES**
- Apply to graded or cleared areas likely to be re-disturbed where a short-term vegetative cover is needed.
 - Seedbed preparation: - Loosen upper three inches of soil by raking, disking or other acceptable means before seeding, if not previously loosened.
 - Soil Amendments: - Apply 600 lbs/acre 10-10-10 fertilizer (14 lbs/1000 sq. ft.)
 - Seeding: - For periods March 1 - April 30 and from August 15 - October 15, seed with 2-1/2 bushel per acre of annual rye (3.2 lbs/1000 sq. ft.). For the period May 1 - August 14, seed with 3 lbs/acre of weeping lovegrass (.07 lbs/1000 sq. ft.). For the period November 16 - February 28, protect site by applying 2 tons/acre of well anchored straw mulch and seed as soon as possible in the spring, or use sod.
 - Mulching: - Apply 1-1/2 to 2 tons/acre (70 to 90 lbs/1000 sq. ft.) of unrotted weed-free, small grain straw immediately after seeding. Anchor mulch immediately after application using mulch anchoring tool or 218 gal. per acre (5 gal/1000 sq. ft.) of emulsified asphalt on flat areas. On slope 8 ft. or higher, use 348 gal. per acre (8 gal/1000 sq. ft.) for anchoring.
 - Refer to the 2011 MD STANDARD AND SPECIFICATIONS FOR SOIL EROSION AND SEDIMENT CONTROL for additional rates and methods not covered.

- STANDARD SEDIMENT CONTROL NOTES**
- A MINIMUM OF 48 HOURS NOTICE MUST BE GIVEN TO THE HOWARD COUNTY DEPARTMENT OF INSPECTIONS, LICENSES AND PERMITS, SEDIMENT CONTROL DIVISION PRIOR TO THE START OF ANY CONSTRUCTION (410) 313-1855.
 - ALL VEGETATIVE AND STRUCTURAL PRACTICES ARE TO BE INSTALLED ACCORDING TO THE PROVISIONS OF THIS PLAN AND ARE TO BE IN CONFORMANCE WITH THE MOST CURRENT MARYLAND STANDARDS AND SPECIFICATIONS FOR SOIL EROSION AND SEDIMENT CONTROL AND REVISIONS THERETO.
 - FOLLOWING INITIAL SOIL DISTURBANCE OR RE-DISTURBANCE, PERMANENT OR TEMPORARY STABILIZATION SHALL BE COMPLETED WITHIN: A) 7 CALENDAR DAYS FOR ALL PERIMETER SEDIMENT CONTROL STRUCTURES, DIKES, PERIMETER SLOPES AND ALL SLOPES GREATER THAN 3:1, B) 14 DAYS AS TO ALL OTHER DISTURBED OR GRADED AREAS ON THE PROJECT SITE.
 - STOCKPILING OF THE EXCAVATED MATERIAL IS TO BE PLACED ON THE UPHILL SIDE OF THE TRENCH.
 - ALL DISTURBED AREAS MUST BE STABILIZED WITHIN THE TIME PERIOD SPECIFIED ABOVE IN ACCORDANCE WITH THE 1994 MARYLAND STANDARDS AND SPECIFICATIONS FOR SOIL EROSION AND SEDIMENT CONTROL FOR PERMANENT SEEDING (SEC. 51), SOD (SEC. 54), TEMPORARY SEEDING (SEC. 50) AND MULCHING (SEC. 52). TEMPORARY STABILIZATION WITH MULCH ALONE CAN ONLY BE DONE WHEN RECOMMENDED SEEDING DATES DO NOT ALLOW FOR PROPER GERMINATION AND ESTABLISHMENT OF GRASSES.
 - ALL SEDIMENT CONTROL STRUCTURES ARE TO REMAIN IN PLACE AND ARE TO BE MAINTAINED IN OPERATIVE CONDITION UNTIL PERMISSION FOR THEIR REMOVAL HAS BEEN OBTAINED FROM THE HOWARD COUNTY SEDIMENT CONTROL INSPECTOR.
 - SITE ANALYSIS / RESTORATION SCHEDULE:
 - TOTAL AREA OF SITE 2.3 ACRES
 - AREA DISTURBED 2.3 ACRES
 - AREA TO BE ROOFED OR PAVED 1.9 ACRES
 - AREA TO BE VEGETATIVELY STABILIZED 0.4 ACRES
 - TOTAL CUT N/A CU. YDS.
 - TOTAL FILL N/A CU. YDS.
 - OFF-SITE WASTE/BORROW AREA LOCATION: TO BE DETERMINED BY CONTRACTOR
 - ANY SEDIMENT CONTROL PRACTICE WHICH IS DISTURBED BY GRADING ACTIVITY FOR PLACEMENT OF UTILITIES MUST BE REPAIRED ON THE SAME DAY OF DISTURBANCE.
 - ADDITIONAL SEDIMENT CONTROL MUST BE PROVIDED, IF DEEMED NECESSARY BY THE HOWARD COUNTY SEDIMENT CONTROL INSPECTOR.
 - ON ALL SITES WITH DISTURBED AREAS IN EXCESS OF 2 ACRES, APPROVAL OF THE INSPECTION AGENCY SHALL BE REQUESTED UPON COMPLETION OF INSTALLATION OF PERIMETER EROSION AND SEDIMENT CONTROLS. BUT BEFORE PROCEEDING WITH ANY OTHER EARTH DISTURBANCE OR GRADING. OTHER BUILDING OR GRADING INSPECTION APPROVALS MAY NOT BE AUTHORIZED UNTIL THIS INITIAL APPROVAL BY THE INSPECTION AGENCY IS MADE.
 - TRENCHES FOR THE CONSTRUCTION OF UTILITIES IS LIMITED TO THREE PIPE LENGTHS OR THAT WHICH SHALL BE BACK-FILLED AND STABILIZED BY THE END OF EACH WORK DAY, WHICHEVER IS SHORTER.
 - CONTRACTOR SHALL PROVIDE A STABILIZED CONSTRUCTION ENTRANCE AT THE DIRECTION OF THE SEDIMENT CONTROL INSPECTOR.

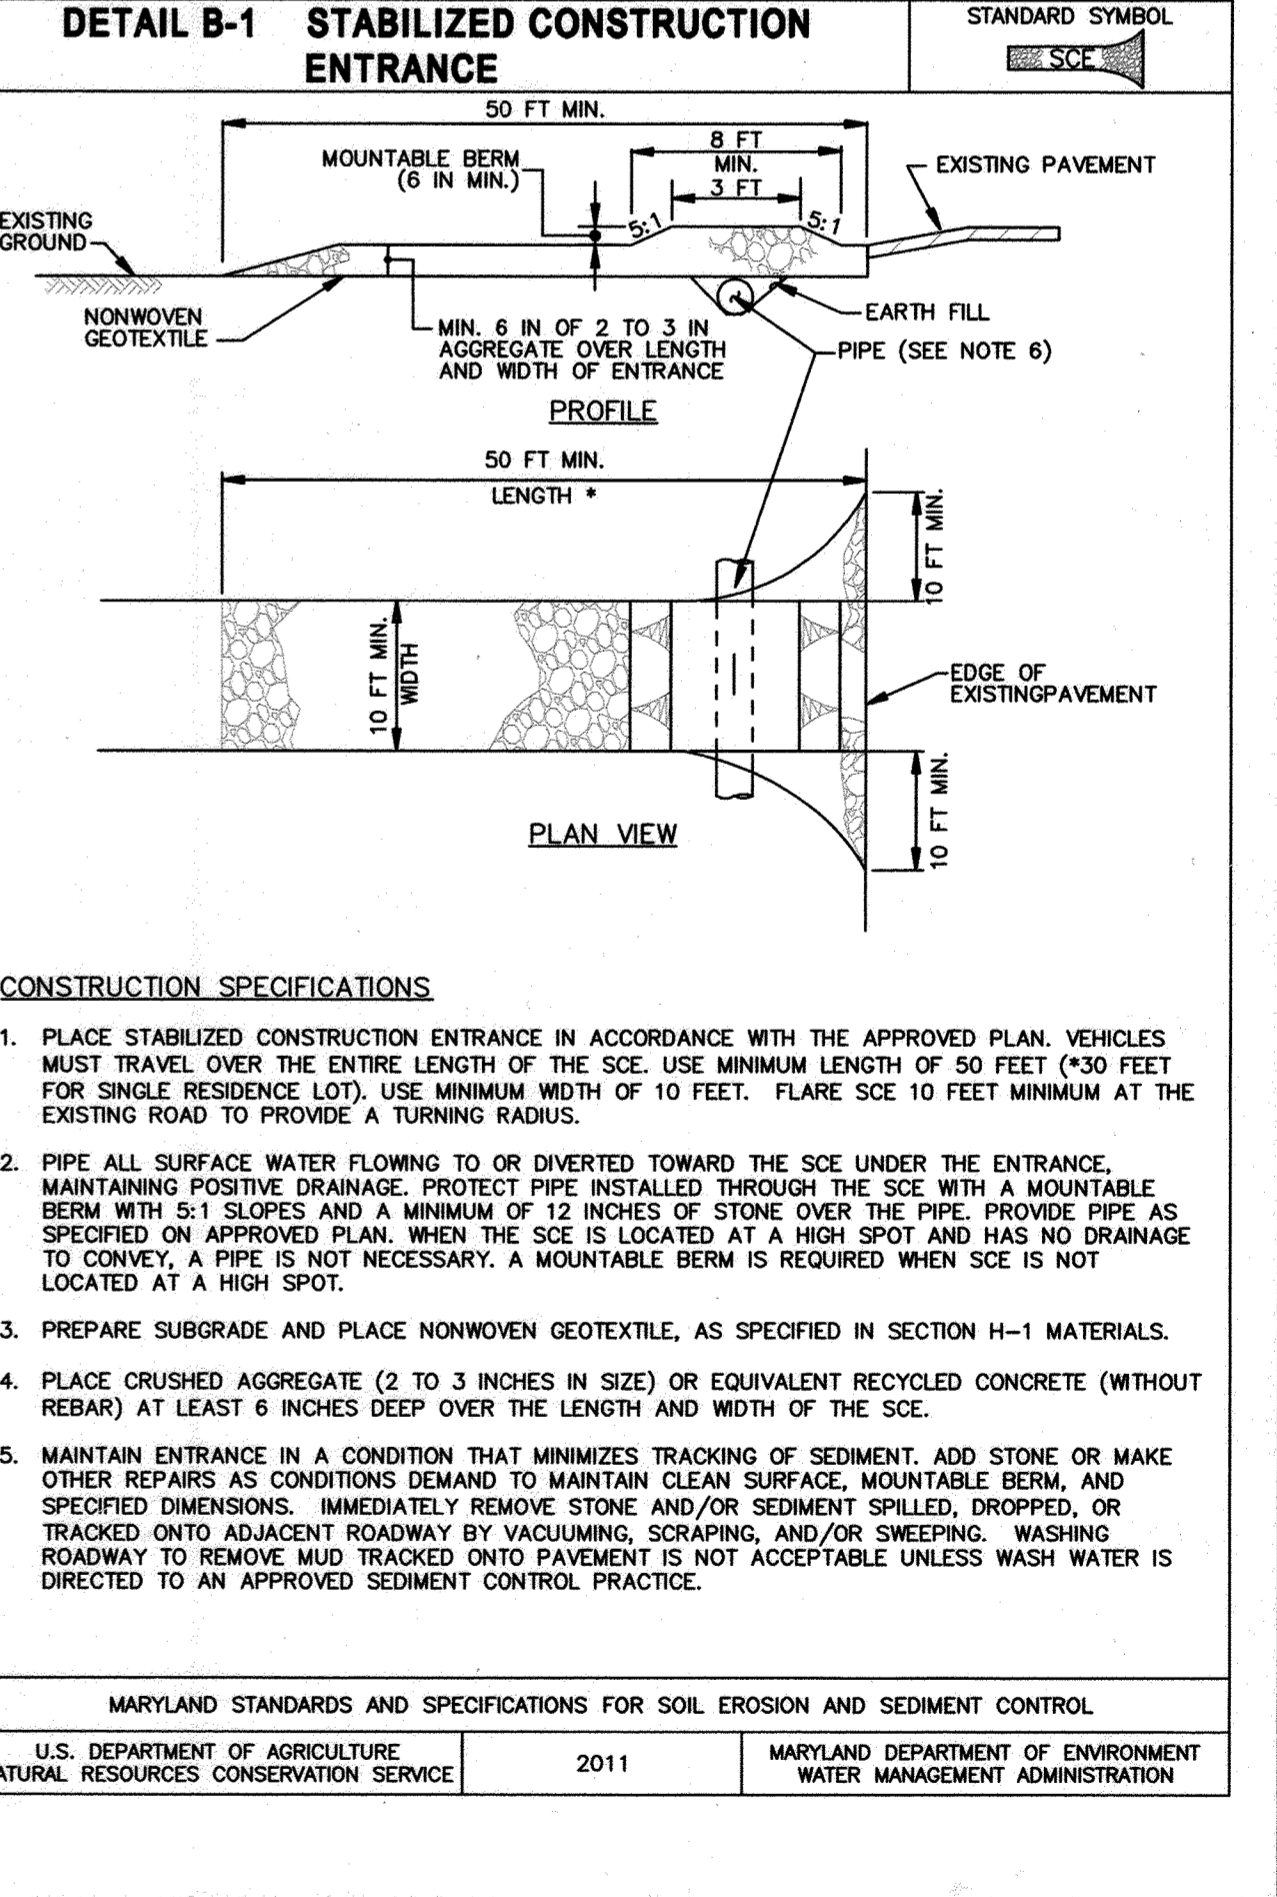

DEPARTMENT OF PUBLIC WORKS
 HOWARD COUNTY, MARYLAND

Director of Public Works: *James A. ...* 3/13/13
 Chief, Bureau of Engineering: *Thomas S. Butler* 3/13/13
 Chief, Bureau of Utilities: *Steve C. ...* 3/13/13
 Chief, Utility Design Division: *...* 3/12/13

URS
 MONTGOMERY PARK BUSINESS CENTER
 1800 WASHINGTON BOULEVARD, SUITE 410
 BALTIMORE, MARYLAND 21230
 (410) 468-0875

Professional Certification
 I hereby certify that these documents were prepared or approved by me, and that I am a duly licensed professional engineer under the laws of the State of Maryland, License No. 28817, Expiration Date: 08/01/13
 NATHAN C. ATKINSON

DESIGN: NCA									
DRAWN: BJW									
CHK: EMT									
DATE: 3/7/13	NO.	REVISION	DATE	BY	60' SCALE MAP NO. 24	BLOCK NO. 12			

EROSION & SEDIMENT CONTROL DETAILS

U.S. 40 WATER SERVICE MAIN REPLACEMENT
 CAPITAL PROJECT NO. W-8311
 CONTRACT NO. 44-4731
 6TH ELECTION DISTRICT
 HOWARD COUNTY, MARYLAND

SCALE: AS SHOWN
 SHEET 10 OF 13

AS-BUILT 1/2015

TEMPORARY TRAFFIC CONTROL GENERAL NOTES

- 1. AT THE COMPLETION OF THE WORK ACTIVITY, CONDITIONS WITHIN THE PROJECT SITE SHALL BE FULLY RESTORED TO THOSE WHICH EXISTED PRIOR TO THE WORK ACTIVITY.
- 2. ALL WARNING SIGNS SHALL BE FULLY REFLECTORIZED WITH HIGH INTENSITY, REFLECTIVE SHEETING AS PER THE CURRENT EDITION AND REVISIONS OF THE FEDERAL HIGHWAY MANUAL ON UNIFORM TRAFFIC CONTROL DEVICES FOR STREETS AND HIGHWAYS (M.U.T.C.D.).
- 3. ALL TRAFFIC CONTROLS MUST BE IN ACCORDANCE WITH THE CURRENT EDITION AND REVISIONS OF THE MARYLAND MANUAL FOR UNIFORM TRAFFIC CONTROL DEVICES (MdMUTCD).
- 4. AT THE DIRECTION OF THE ENGINEER, THE SPACING OF TEMPORARY SIGNING MAY BE ADJUSTED SLIGHTLY TO IMPROVE VISIBILITY OF THE SIGN.
- 5. CONTRACTOR SHALL MAINTAIN ACCESS TO ALL LOCAL BUSINESSES AND BUILDINGS DURING CONSTRUCTION AND COORDINATE WITH LOCAL BUSINESSES ABOUT THE RESTRICTIONS ON INGRESS AND EGRESS TRAFFIC CONTROL.
- 6. THE CONTRACTOR IS RESPONSIBLE FOR THE REPLACEMENT OF ANY PAVEMENT MARKINGS REMOVED OR DESTROYED DURING CONSTRUCTION. ALL PAVEMENT MARKINGS REMOVED OR DESTROYED DURING CONSTRUCTION WILL BE REPLACED WITH EITHER LATEX PAINT OR THERMOPLASTIC TO MATCH EXISTING MARKINGS.
- 7. PROPERLY EQUIPPED FLAGGERS SHALL BE USED TO DIRECT TRAFFIC FOR A LANE CLOSURE OF A TWO-LANE STREET AND WHEN CONSTRUCTION VEHICLES ARE ENTERING AND EXITING THE WORK AREA OR AT OTHER LOCATIONS. FLAGGERS' CLOTHING AND EQUIPMENT SHALL CONFORM TO THE LATEST EDITION OF THE M.U.T.C.D.
- 8. MUD AND CONSTRUCTION DEBRIS ON STREETS OR SIDEWALKS SHALL BE CLEANED OFF IMMEDIATELY.
- 9. TRAFFIC CONTROL DEVICES WHEN NOT IN USE SHALL BE COMPLETELY COVERED OR REMOVED FROM THE CONSTRUCTION SITE.
- 10. THE CONTRACTOR SHALL BE RESPONSIBLE FOR MAINTAINING ALL TRAFFIC CONTROL DEVICES ON AN AROUND THE CLOCK BASIS, WHETHER OR NOT WORK IS ACTIVELY BEING PURSUED AND ANY DEFICIENCIES NOTED SHALL BE CORRECTED IMMEDIATELY.

11. THE TRAFFIC CONTROL REQUIREMENTS SHOWN ON THESE PLANS ARE MINIMUM REQUIREMENTS ONLY AND DO NOT ATTEMPT TO ADDRESS IN DEPTH THE VARIETY OF SITUATIONS THAT MAY OCCUR ONCE CONSTRUCTION HAS STARTED. IN NO WAY DO THE REQUIREMENTS SHOWN ON THESE PLANS RELIEVE THE CONTRACTOR OF HIS RESPONSIBILITY FOR SELECTING THE PROPER TRAFFIC CONTROL DEVICES AND IMPLEMENTATION PROCEDURES THAT WILL ASSURE THE SAFETY OF MOTORIST, PEDESTRIANS, AND WORKERS AT ALL TIMES.

12. SHOULD THE CONTRACTOR FAIL TO ENFORCE THE TRAFFIC CONTROL PLAN OR FAIL TO CLEAN, REPAIR, REPLACE OR OTHERWISE MAINTAIN THE TRAFFIC CONTROL DEVICES WHEN DIRECTED TO DO SO BY THE ENGINEER OR HIS REPRESENTATIVE, HOWARD COUNTY MAY STOP THE WORK UNTIL DEFICIENCIES ARE CORRECTED.

13. ANY PERMANENT SIGN CONFLICTING WITH THIS TRAFFIC CONTROL PLAN SHALL BE COVERED OR REMOVED AS DIRECTED BY THE ENGINEER.

14. ACCESS SHALL BE MAINTAINED TO ALL DRIVES AND SIDE STREETS.

15. CONSTRUCTION VEHICLES SHALL BE PARKED ALONG STREETS SO AS NOT TO RESTRICT SIGHT DISTANCE FOR VEHICLES EXITING AT STREETS OR ANY DRIVES.

16. DURING ALL CONSTRUCTION PERIODS, THE CONTRACTOR SHALL HAVE AT THE JOBSITE ALL NECESSARY TRAFFIC CONTROL DEVICES (APPROPRIATE SIGNS, LIGHTED ARROW DISPLAY, CHANNELIZING DEVICES, ETC.) TO PROPERLY CLOSE AT LEAST ONE LANE OF TRAFFIC.

17. CONSTRUCTION SHALL BE SEQUENCED TO PROVIDE THE LEAST POSSIBLE ADVERSE EFFECT TO RESIDENCES.

18. THE CONTRACTOR IS RESPONSIBLE FOR AVOIDING ANY AND ALL UTILITIES WHEN SETTING SIGN POSTS AND WILL BE REQUIRED TO COORDINATE HIS ACTIVITIES WITH ANY AND ALL UTILITY COMPANIES WHETHER THEIR FACILITY IS INDICATED ON THE PLANS OR NOT.

19. TRENCH MUST BE BACKFILLED AND TEMPORARILY PATCHED DAILY OR STEEL PLATED PER SHA UTILITY PERMIT. STEEL PLATES, IF USED SHALL BE A36 CERTIFIED STEEL AT LEAST 1" THICK WITH LIFT HOOKS AND MUST BE FINNED AND COLD PATCHED DAILY. WHEN MORE THAN 1 STEEL PLATE IS USED AT A TIME THEY MUST BE TACK WELDED BY A CERTIFIED WELDER.

20. THE CONTRACTOR IS RESPONSIBLE FOR INSTALLING TEMPORARY PAVEMENT MARKINGS FOR ANY DOUBLE YELLOW OR EDGE LINES REMOVED OR DESTROYED DURING CONSTRUCTION.

21. THE CONTRACTOR SHALL COORDINATE ANY DISRUPTION OF TRAFFIC SIGNALS, SENSORS AND WIRING WITH MARYLAND STATE HIGHWAY ADMINISTRATION, OFFICE OF TRAFFIC AND SAFETY.

Formula for Determining Taper Length

Speed (S) in mph	Taper Length (L) in feet
40 mph or less	L = WS ² / 60
45 mph or more	L = WS

Where: L = taper length in feet
W = width of offset in feet
S = posted speed limit

Guidelines for Length of Longitudinal Buffer Space	
Speed* (mph)	Length (feet)
20	35
25	55
30	85
35	120
40	170
45	220
50	280

TEMPORARY TRAFFIC CONTROL TYPICAL APPLICATION TEMPORARY TRAFFIC CONTROL DEVICE SELECTION CHART

LOCATION OF WORK	SPEED	DURATION	STANDARD TRAFFIC CONTROL DEVICES													
			FLAGGER	VEHICLE MOUNTED WARNING DEVICES	CHANNELIZING DEVICES	WORK AREA	WORK AREA	WORK AREA	WORK AREA	WORK AREA	WORK AREA	WORK AREA	WORK AREA			
ON ROAD	> 40 MPH	> 12 HRS/DAY	X	X	X	X	X	X	X	X	X	X	X	X	X	X
		< 15 MIN/LOC														
ADJ TO ROAD	< 40 MPH	> 12 HRS/DAY	X	X	X	X	X	X	X	X	X	X	X	X	X	X
		< 15 MIN/LOC														
ON ROAD	> 40 MPH	> 12 HRS/DAY	X	X	X	X	X	X	X	X	X	X	X	X	X	X
		< 15 MIN/LOC														
ADJ TO ROAD	< 40 MPH	> 12 HRS/DAY	X	X	X	X	X	X	X	X	X	X	X	X	X	X
		< 15 MIN/LOC														


KEY: X - REQUIRED, / - OPTIONAL
 * TRAVELING BELOW THE POSTED SPEED (BY MORE THAN 15 MPH)
 ** FOR MOVING OPERATIONS THE APPROPRIATE ADVANCE WARNING SIGNS MAY BE VEHICLE MOUNTED.
 *** WITHIN 15' OF THE EDGE LINE OR WITHIN 2' BEHIND THE FACE OF CURB
 **** PV IS REQUIRED ON FREEWAYS, EXPRESSWAYS, AND ROADWAYS WITH POSTED SPEEDS GREATER THAN OR EQUAL TO 55 MPH DURING THE INSTALLATION OF TEMPORARY TRAFFIC CONTROL DEVICES.

Maryland Department of Transportation STATE HIGHWAY ADMINISTRATION STANDARDS FOR HIGHWAYS AND INCIDENTAL STRUCTURES

TEMPORARY TRAFFIC CONTROL DEVICE SELECTION CHART

STANDARD NO. MD 104.01-10

TEMPORARY TRAFFIC CONTROL TYPICAL APPLICATION PLACEMENT OF REGULATORY SPEED SIGNS PROJECT EQUAL TO OR LESS THAN 2 MONTHS IN DURATION

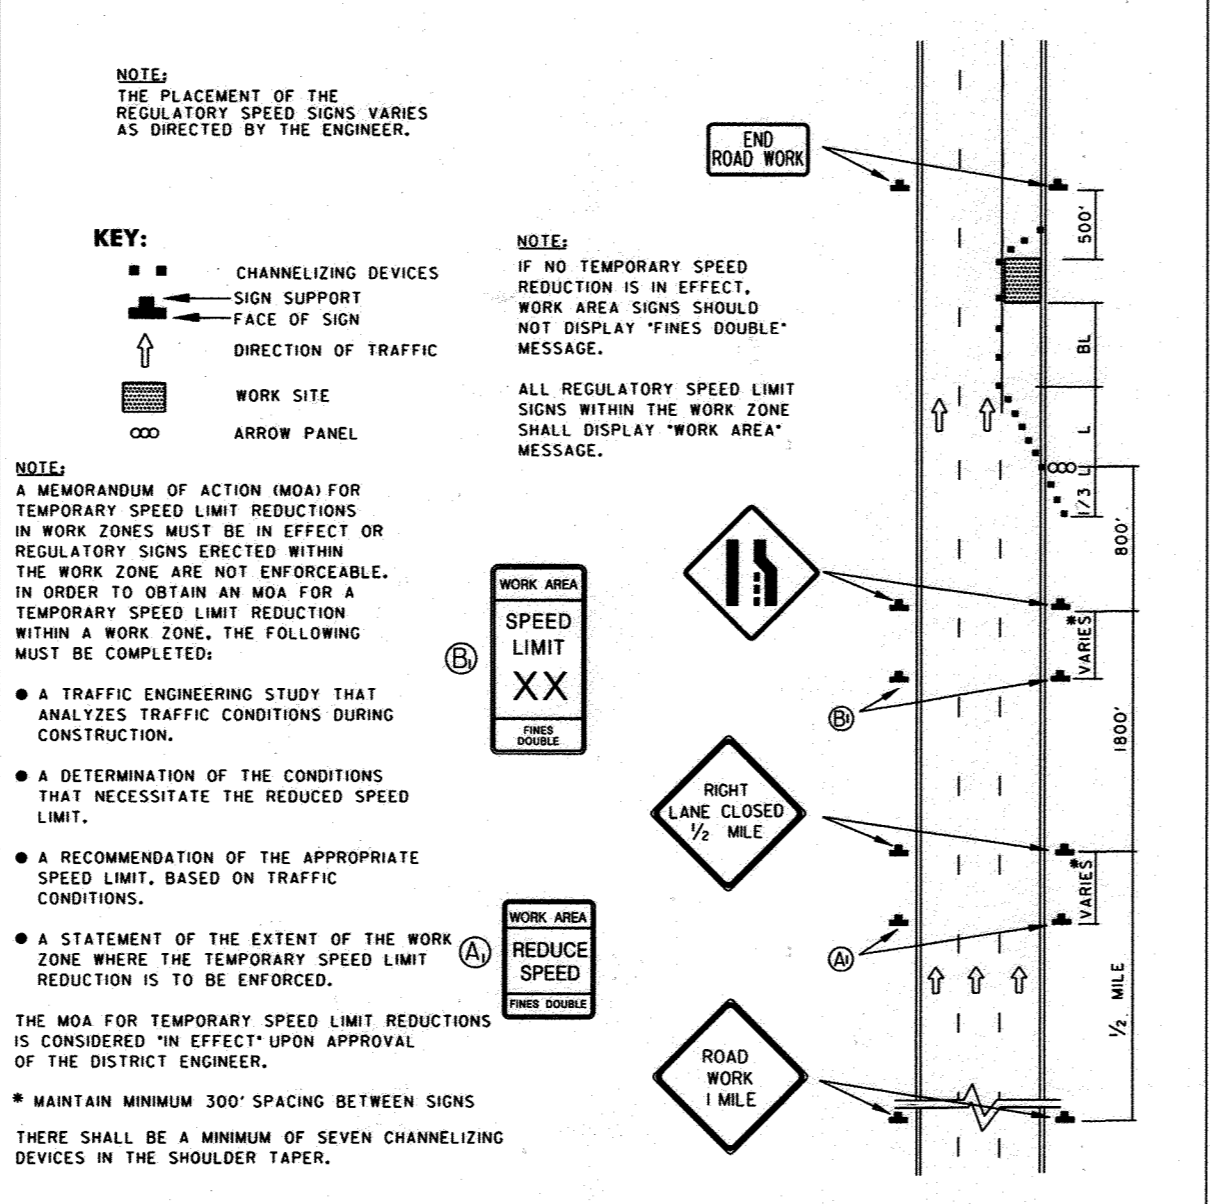


Maryland Department of Transportation STATE HIGHWAY ADMINISTRATION STANDARDS FOR HIGHWAYS AND INCIDENTAL STRUCTURES

REGULATORY SPEED SIGNS

STANDARD NO. MD 104.01-06

TEMPORARY TRAFFIC CONTROL TYPICAL APPLICATION SIGN SPACING CHART

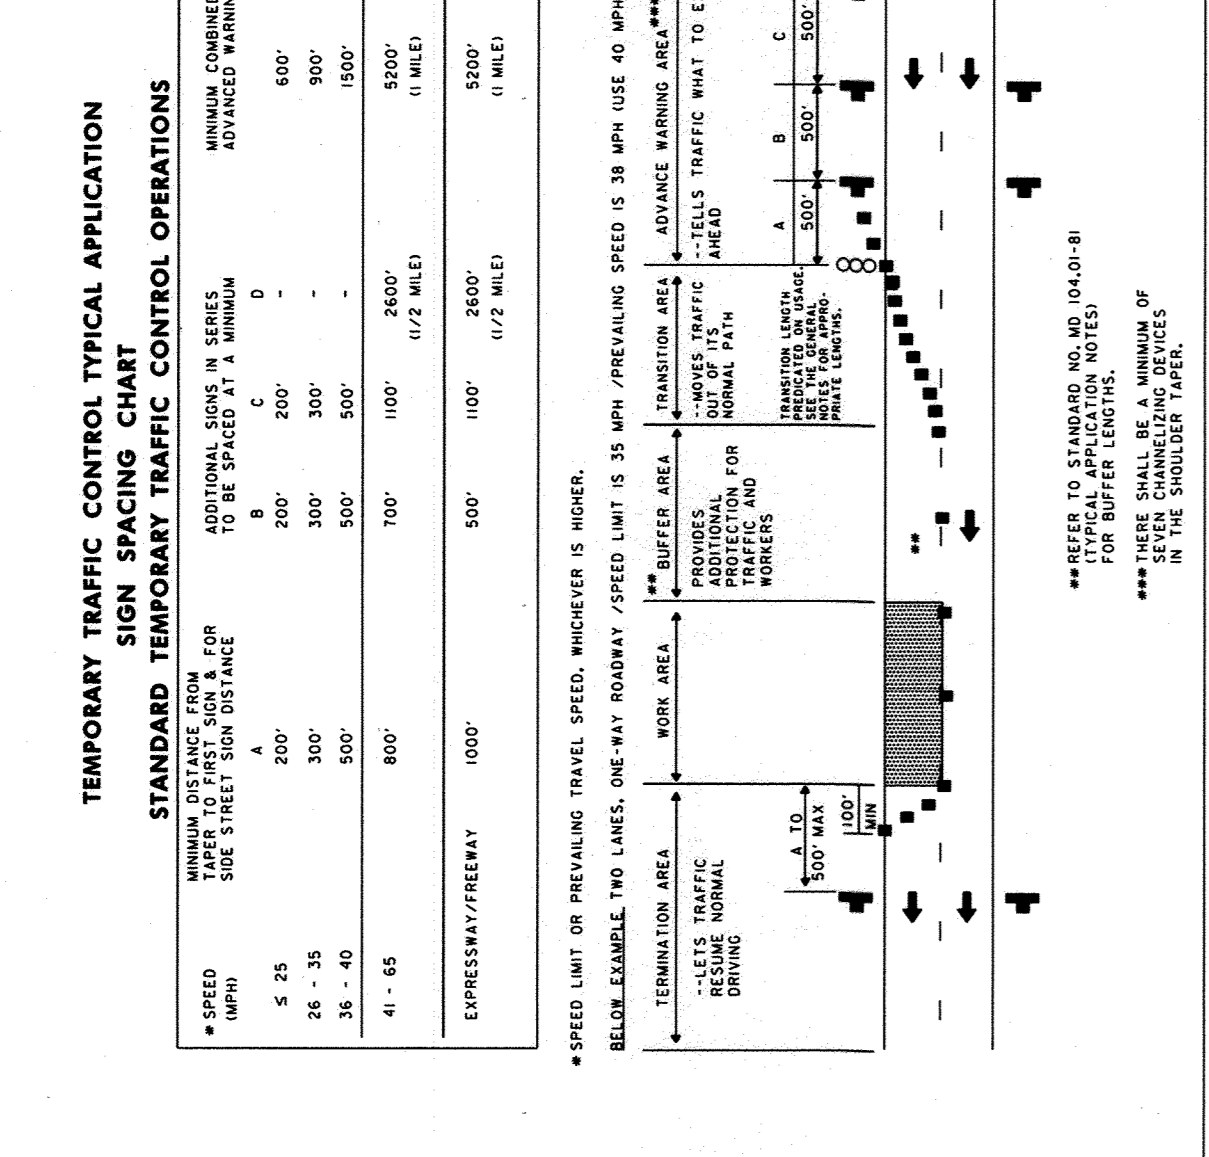


Maryland Department of Transportation STATE HIGHWAY ADMINISTRATION STANDARDS FOR HIGHWAYS AND INCIDENTAL STRUCTURES

SIGN SPACING CHART

STANDARD NO. MD 104.01-02

TEMPORARY TRAFFIC CONTROL TYPICAL APPLICATION

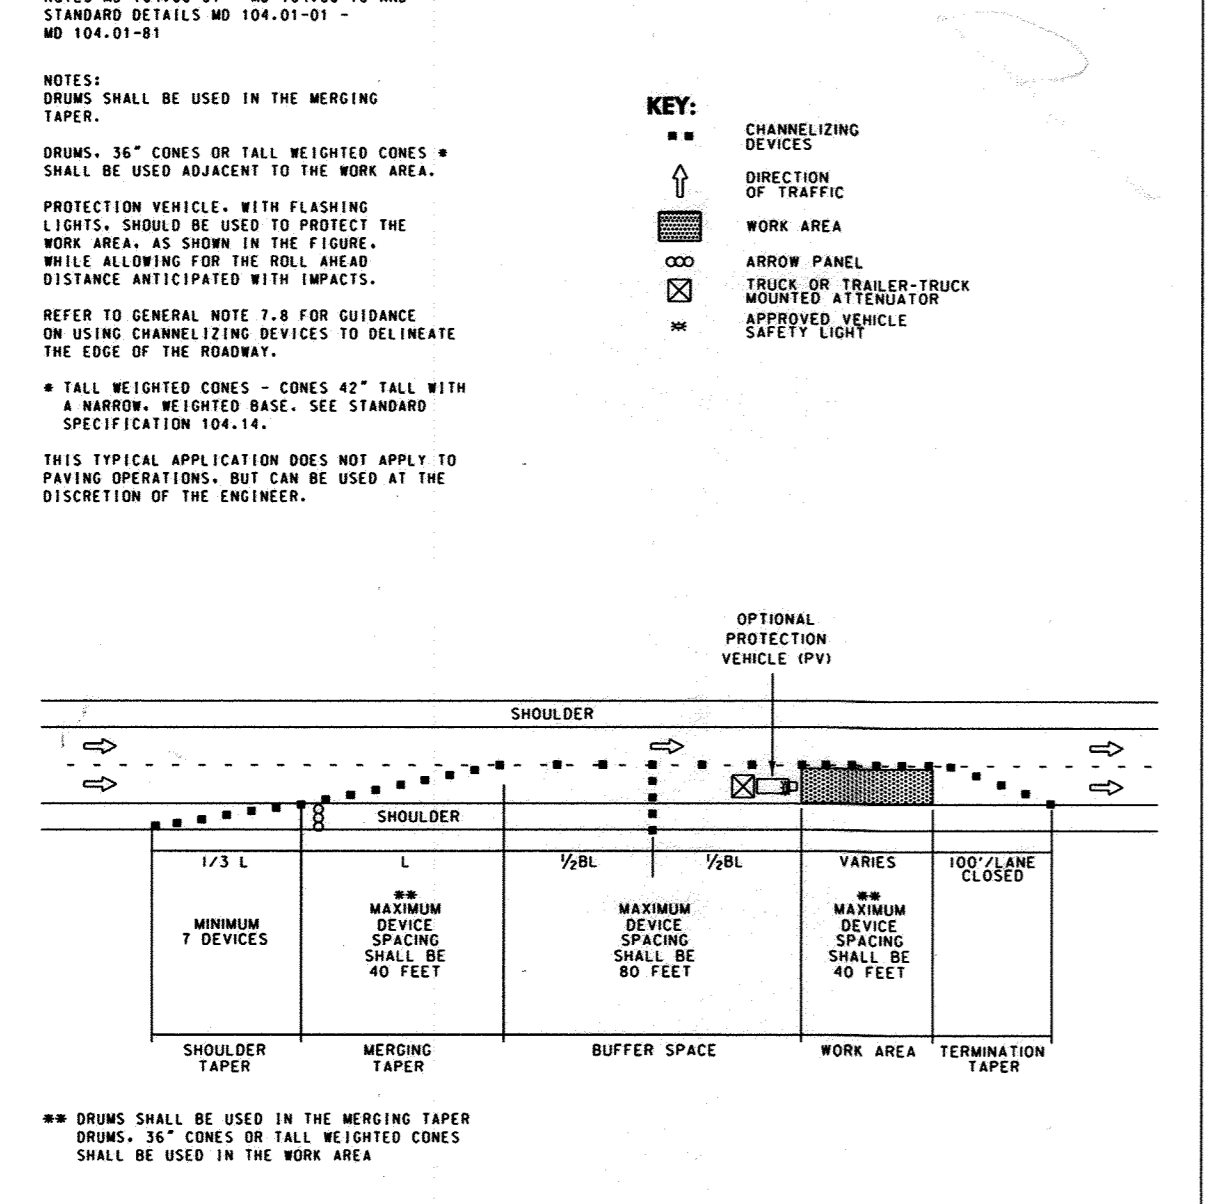


Maryland Department of Transportation STATE HIGHWAY ADMINISTRATION STANDARDS FOR HIGHWAYS AND INCIDENTAL STRUCTURES

CHANNELIZATION DEVICE SPACING GREATER THAN 40 MPH

STANDARD NO. MD 104.01-30 C

TEMPORARY TRAFFIC CONTROL TYPICAL APPLICATION

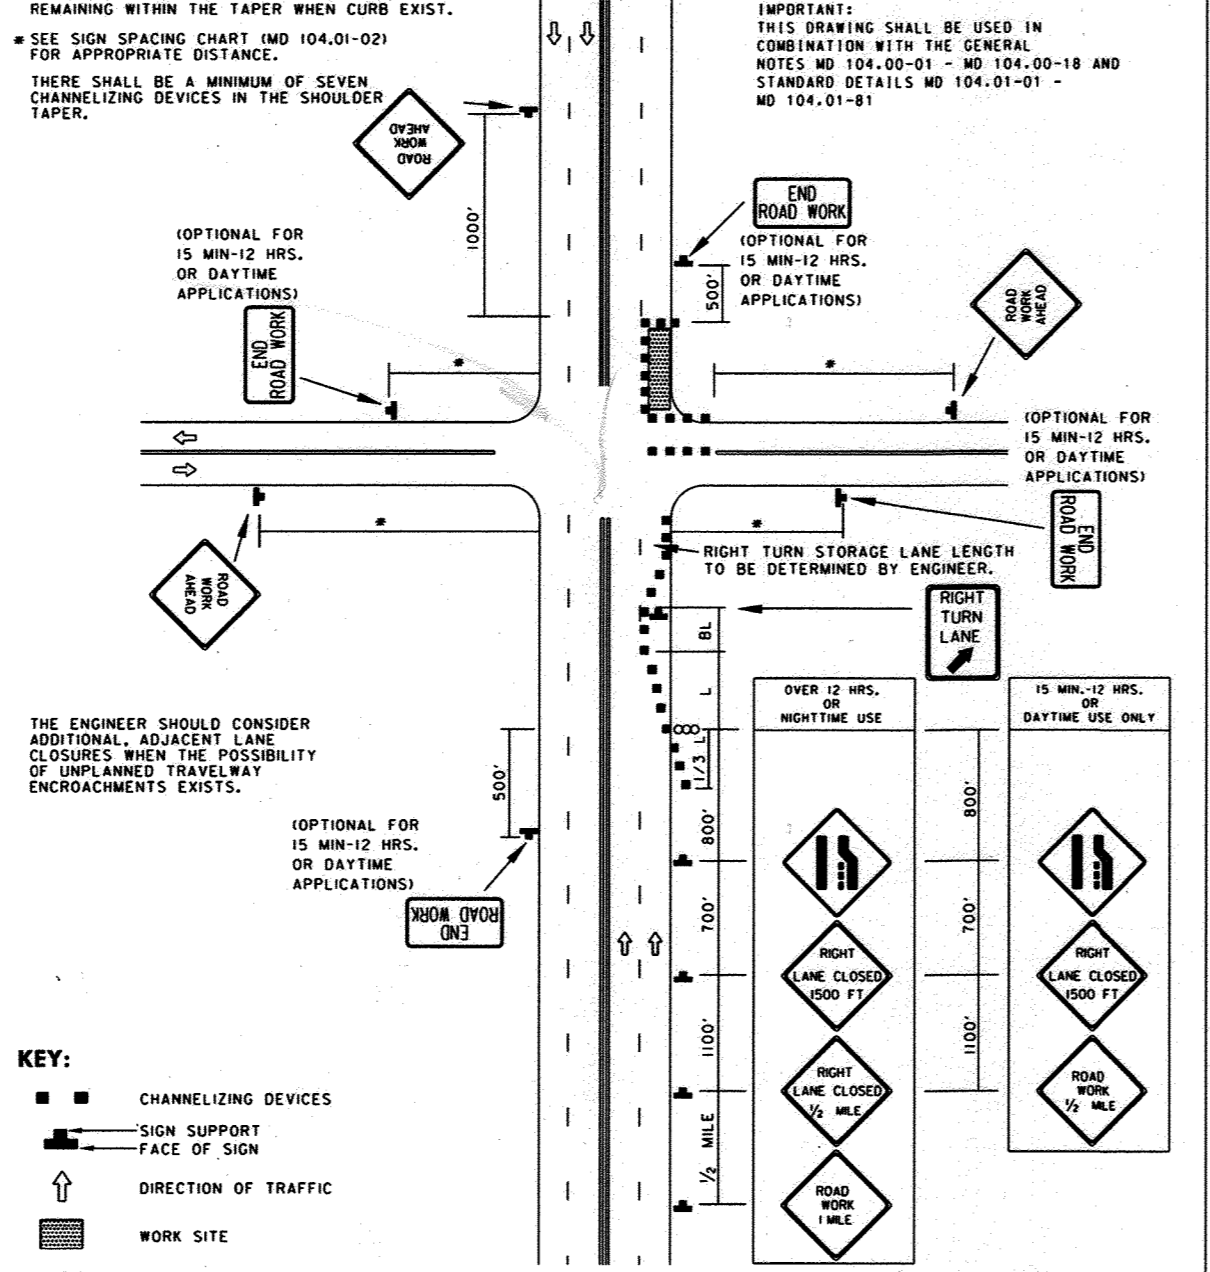


Maryland Department of Transportation STATE HIGHWAY ADMINISTRATION STANDARDS FOR HIGHWAYS AND INCIDENTAL STRUCTURES

INTER-FAR-RIGHT LANE CLOSURE/MULTILANE UNDIV. GREATER THAN 40 MPH

STANDARD NO. MD 104.03-11

TEMPORARY TRAFFIC CONTROL TYPICAL APPLICATION

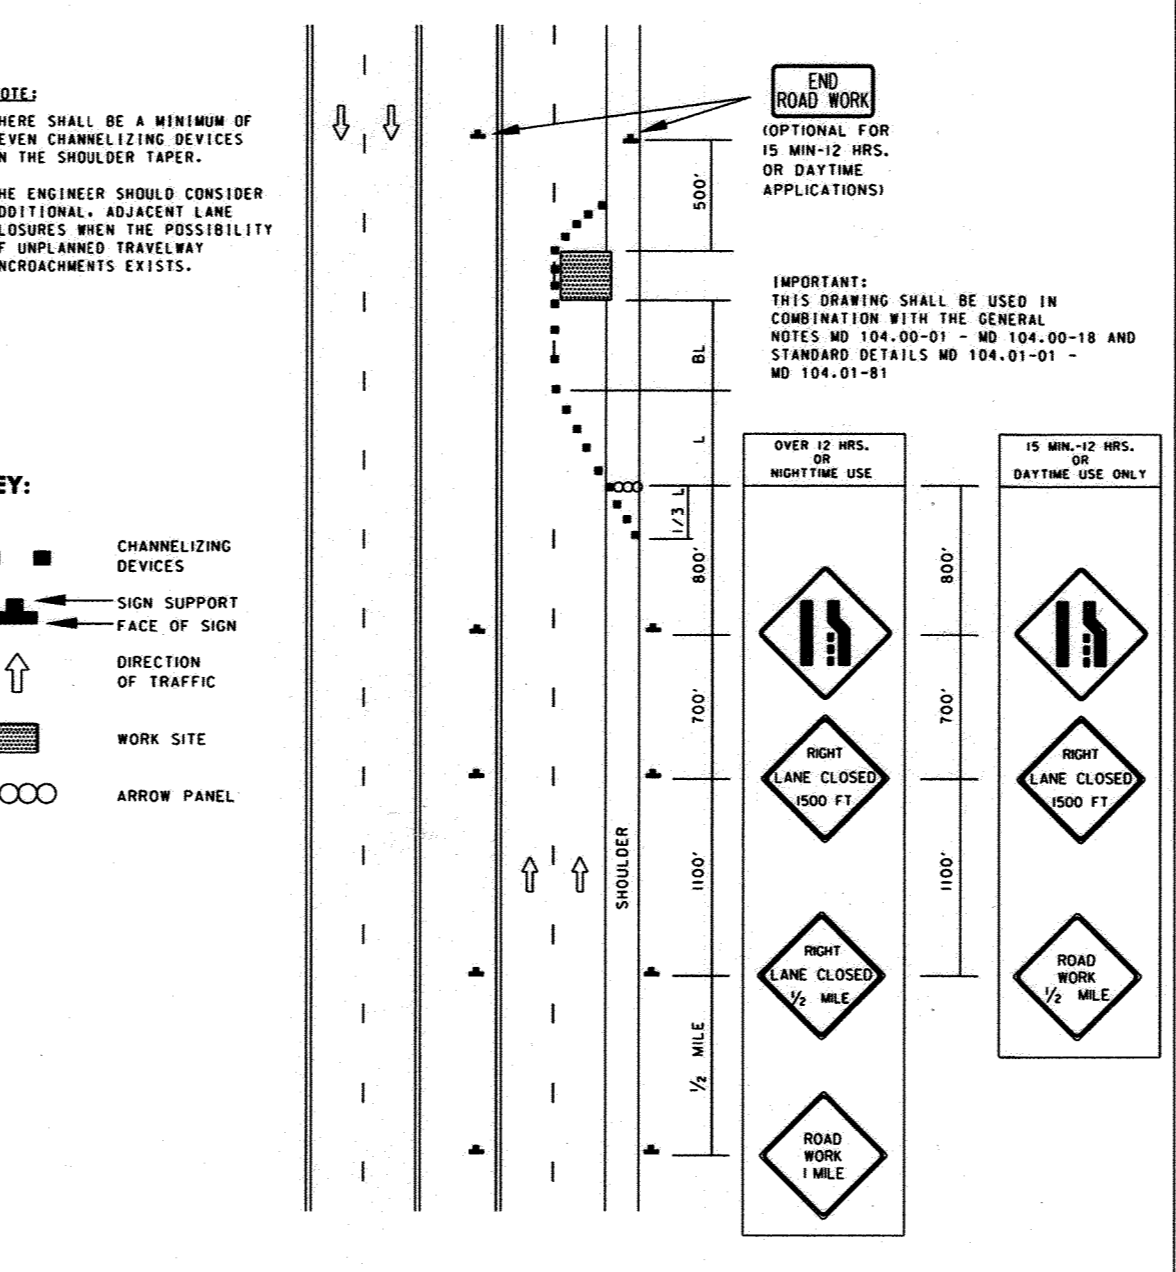

Maryland Department of Transportation STATE HIGHWAY ADMINISTRATION STANDARDS FOR HIGHWAYS AND INCIDENTAL STRUCTURES

RIGHT LANE CLOSURE/DIVIDED UNCON. GREATER THAN 40 MPH

STANDARD NO. MD 104.04-05

DEPARTMENT OF PUBLIC WORKS HOWARD COUNTY, MARYLAND

3/13/13

3/13/13

3/13/13

3/13/13

URS

MONTGOMERY PARK BUSINESS CENTER
1800 WASHINGTON BOULEVARD, SUITE 410
BALTIMORE, MARYLAND 21230
(410) 468-0875

NATHAN C. ATKINSON

Professional Certification

DESIGN: NCA
DRAWN: BJW
CHK: EMT
DATE: 3/7/13

REVISION


TRAFFIC CONTROL DETAILS

60' SCALE MAP NO. 24 BLOCK NO. 12

U.S. 40 WATER SERVICE MAIN REPLACEMENT CAPITAL PROJECT NO. W-8311 CONTRACT NO. 44-4731 6TH ELECTION DISTRICT HOWARD COUNTY, MARYLAND


SCALE: AS SHOWN SHEET 11 OF 13

AS-BUILT 1/2015

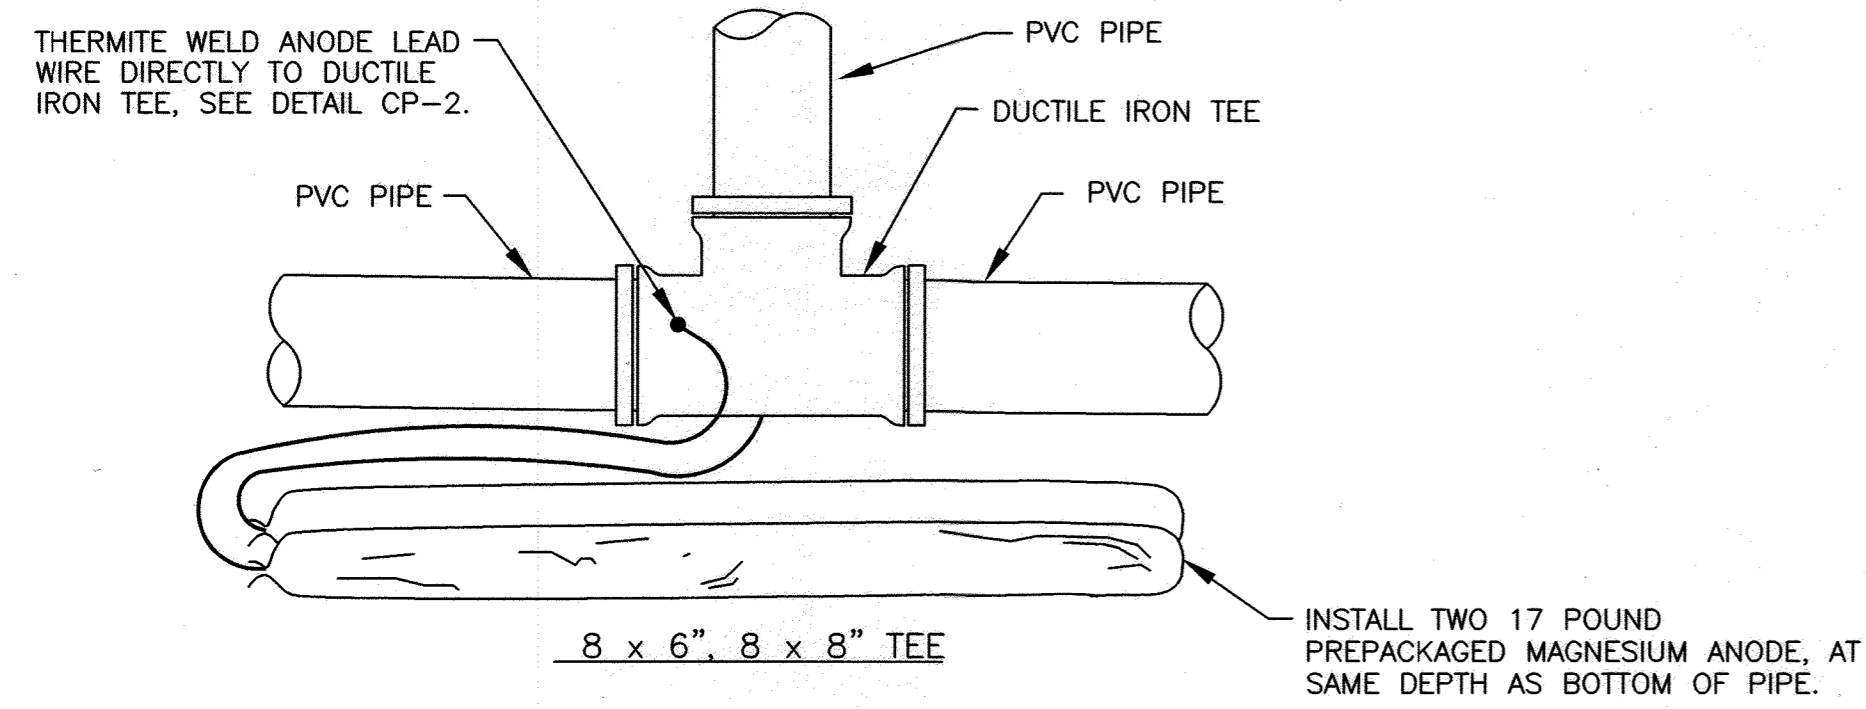


- NOTES:**
1. ANODES PLACED AT SAME DEPTH AS THE BOTTOM OF PIPE AND AT A MINIMUM OF 12" FROM EDGE OF PIPE.
 2. DO NOT THERMITE WELD TO PVC PIPE.

CP-1: CORROSION PROTECTION OF TEE FITTINGS
NOT TO SCALE

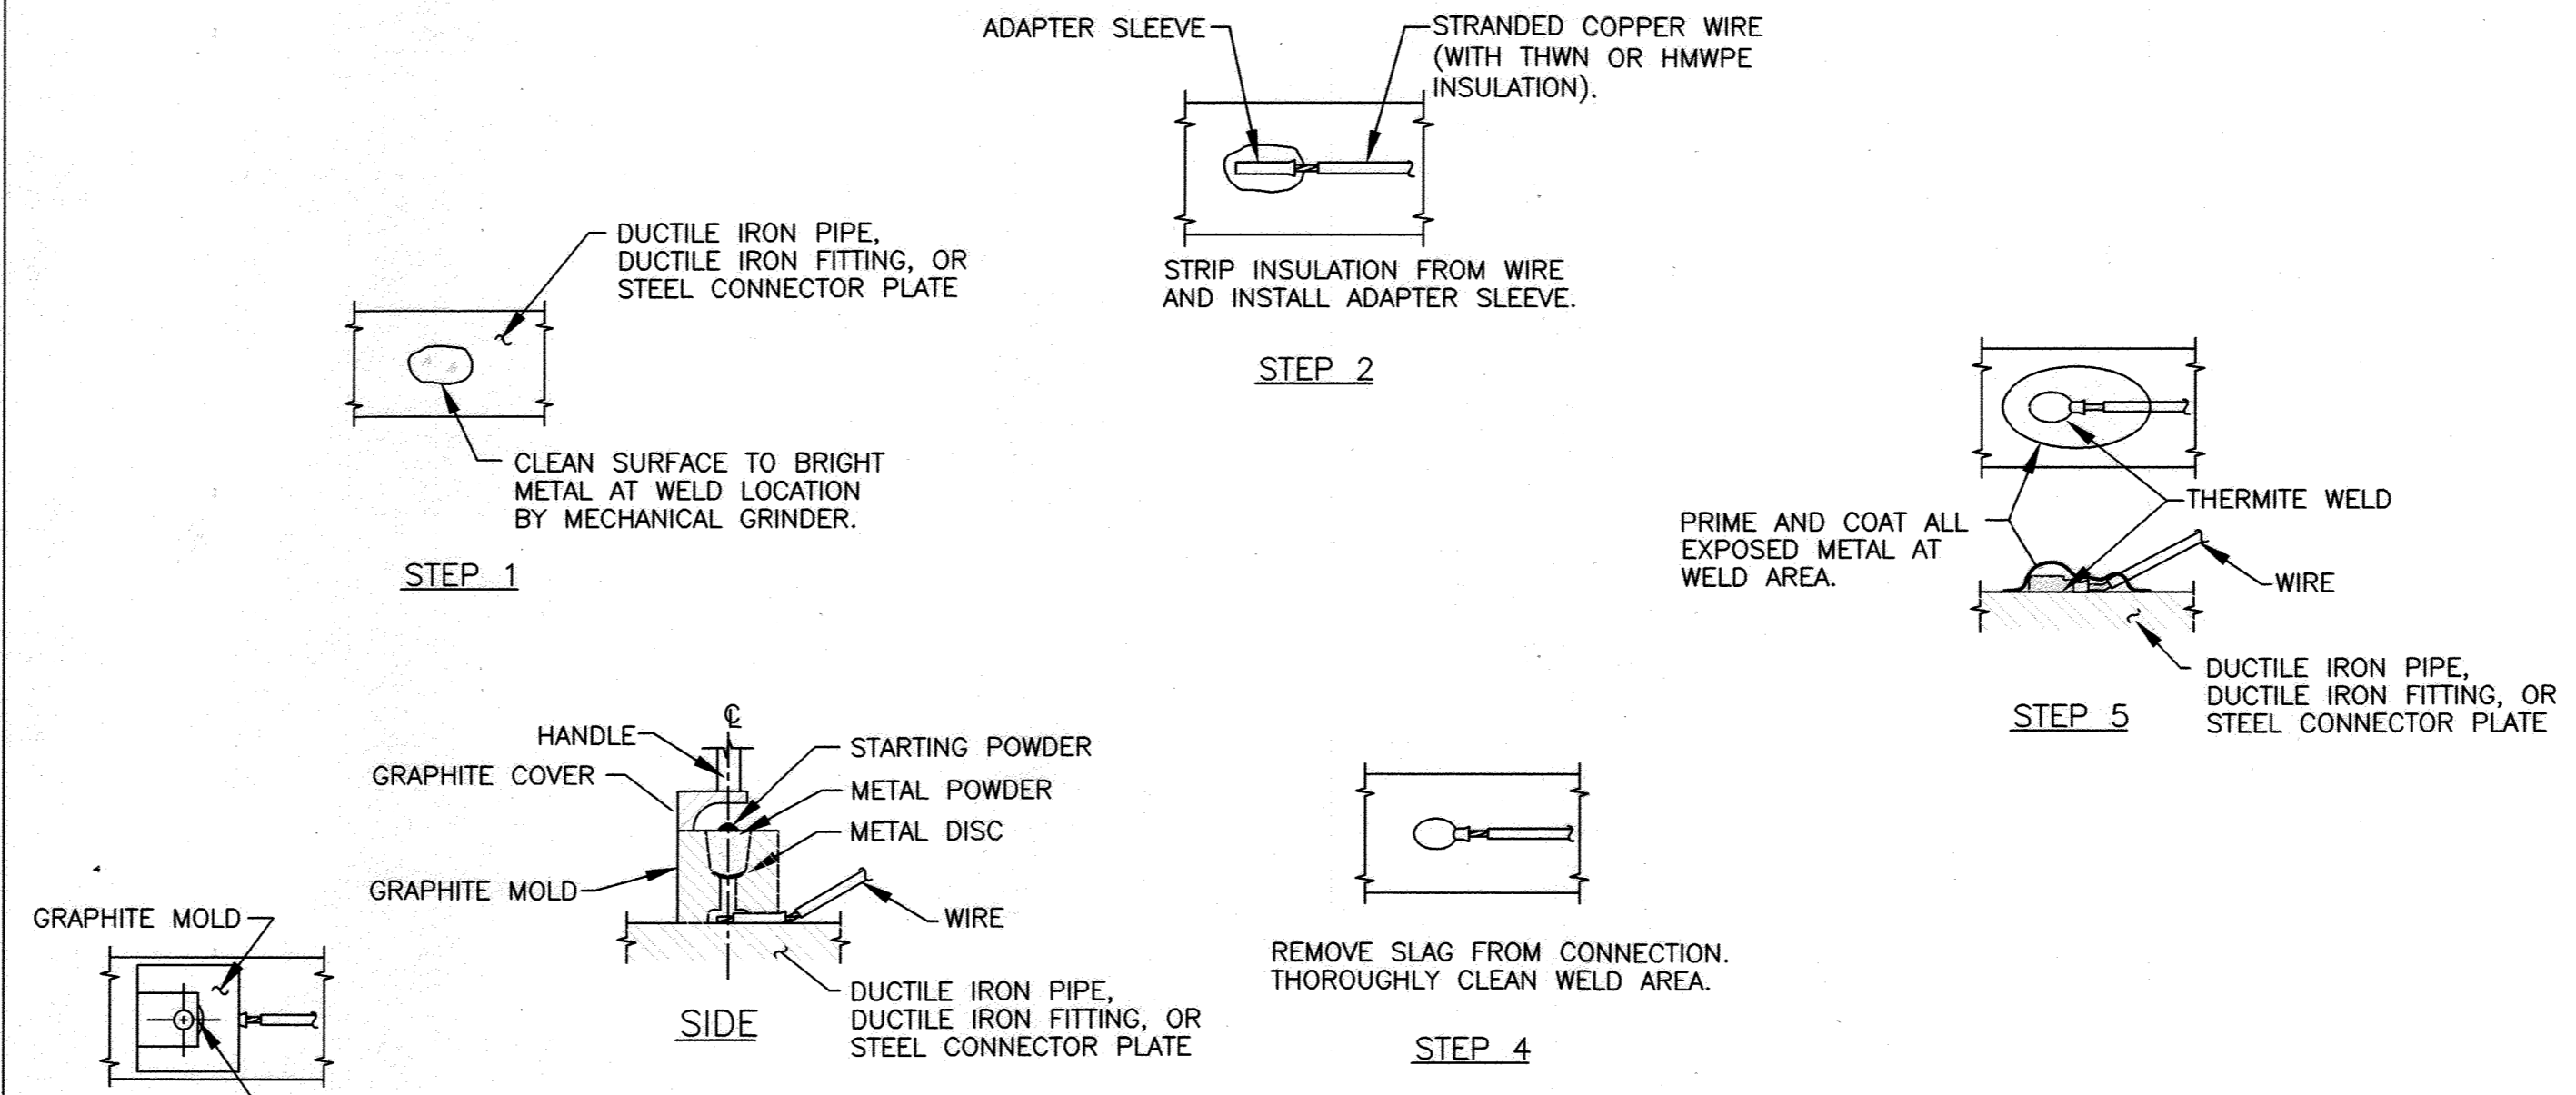


- NOTES:**
1. THERMITE WELDS SHALL BE COATED WITH A PREFABRICATED ONE PIECE PLASTIC CAP FILLED WITH ELASTOMERIC MATERIAL, ROYSTON HANDY-CAP OR APPROVED EQUAL.
 2. DO NOT THERMITE WELD TO PVC PIPE.

CP-2: HORIZONTAL THERMITE WELD
SCALE: NONE
NOT TO SCALE

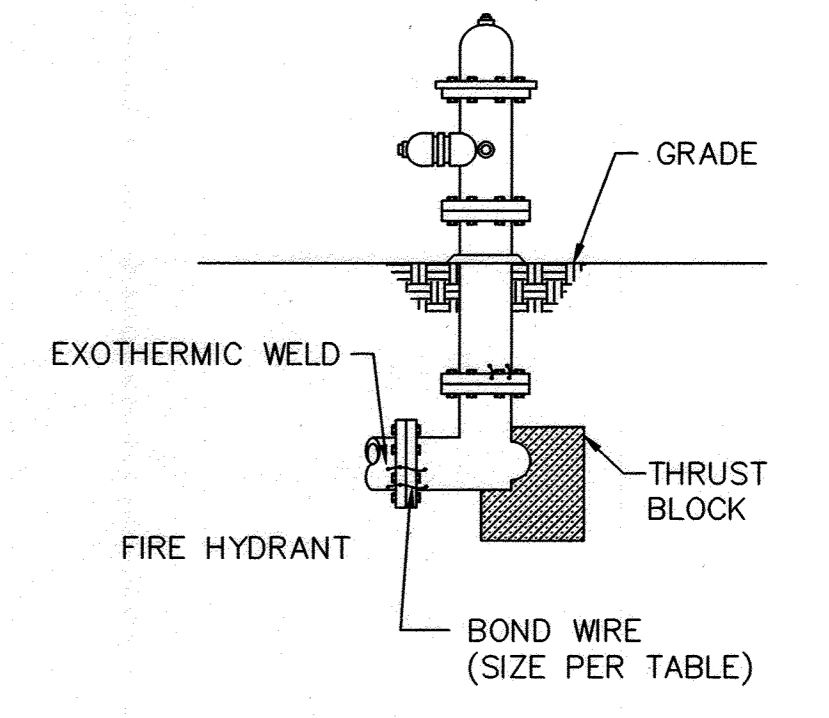


BOND WIRE SIZE	
PIPE DIAMETER	WIRE SIZE
3" THRU 18"	#4 AWG

CP-3: BONDING OF PIPE FITTINGS
SCALE: NONE
NOT TO SCALE

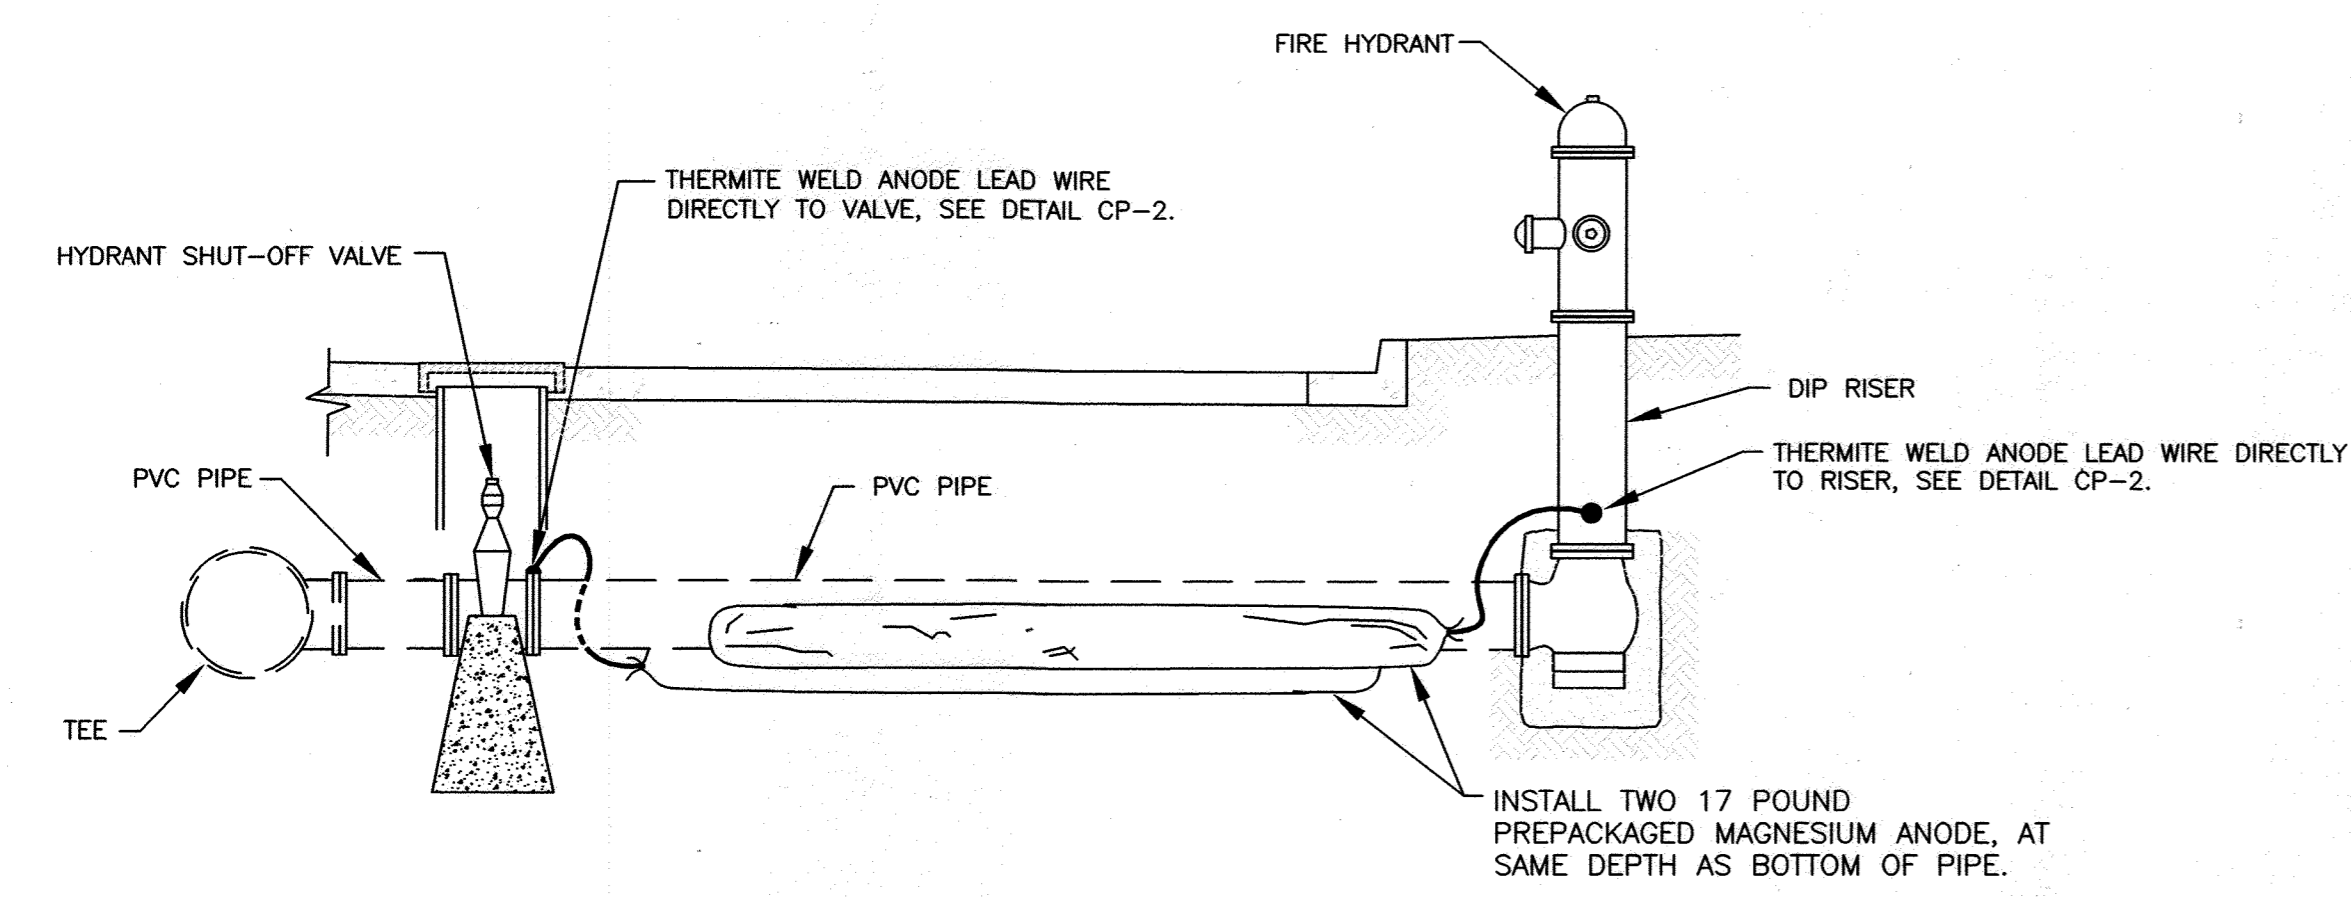


- NOTES:**
1. ANODES PLACED AT SAME DEPTH AS THE BOTTOM OF PIPE AND AT A MINIMUM OF 12" FROM EDGE OF PIPE.
 2. DO NOT THERMITE WELD TO PVC PIPE.

CP-4: CORROSION PROTECTION AT FIRE HYDRANT
NOT TO SCALE

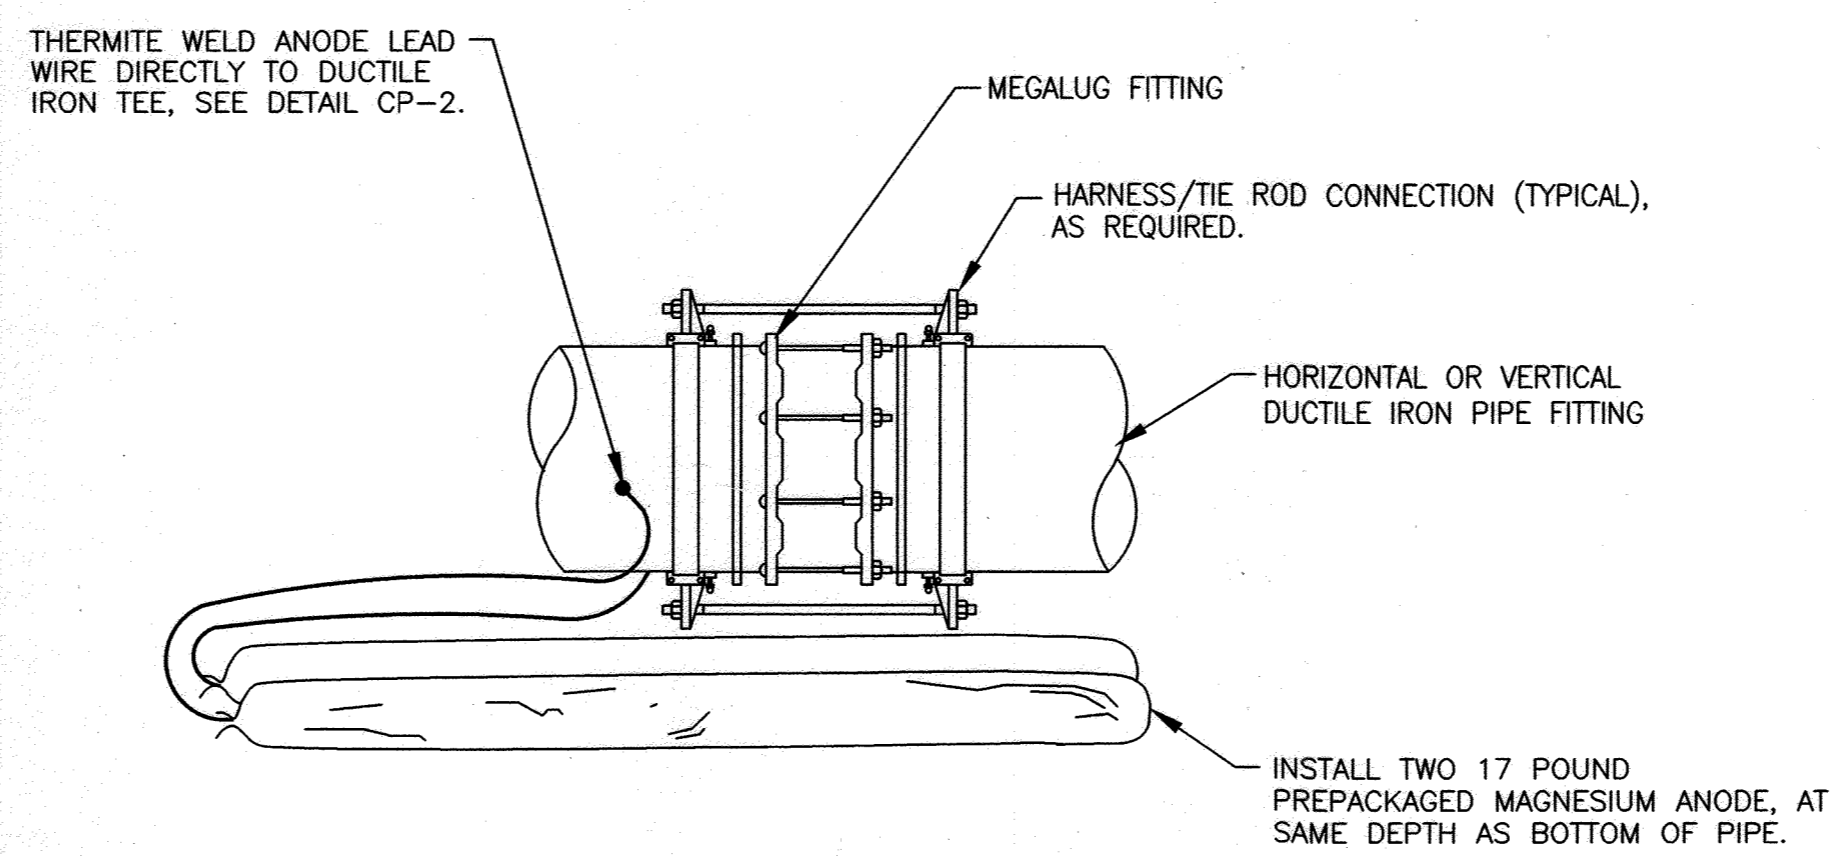

- NOTES:**
1. ANODES PLACED AT SAME DEPTH AS THE BOTTOM OF PIPE AND AT A MINIMUM OF 12" FROM EDGE OF PIPE.
 2. DO NOT THERMITE WELD TO PVC PIPE.
 3. ANODE TO BE INSTALLED AND THERMITE WELDED TO METALLIC PIPE FITTING ONLY.
 4. NO ANODES ARE RECOMMENDED FOR THE CORROSION PROTECTION OF MEGALUGS. THE MEGALUGS SHOULD BE COATED BY MANUFACTURER.

CP-5: CORROSION PROTECTION OF HORIZONTAL AND VERTICAL PIPE FITTINGS
NOT TO SCALE

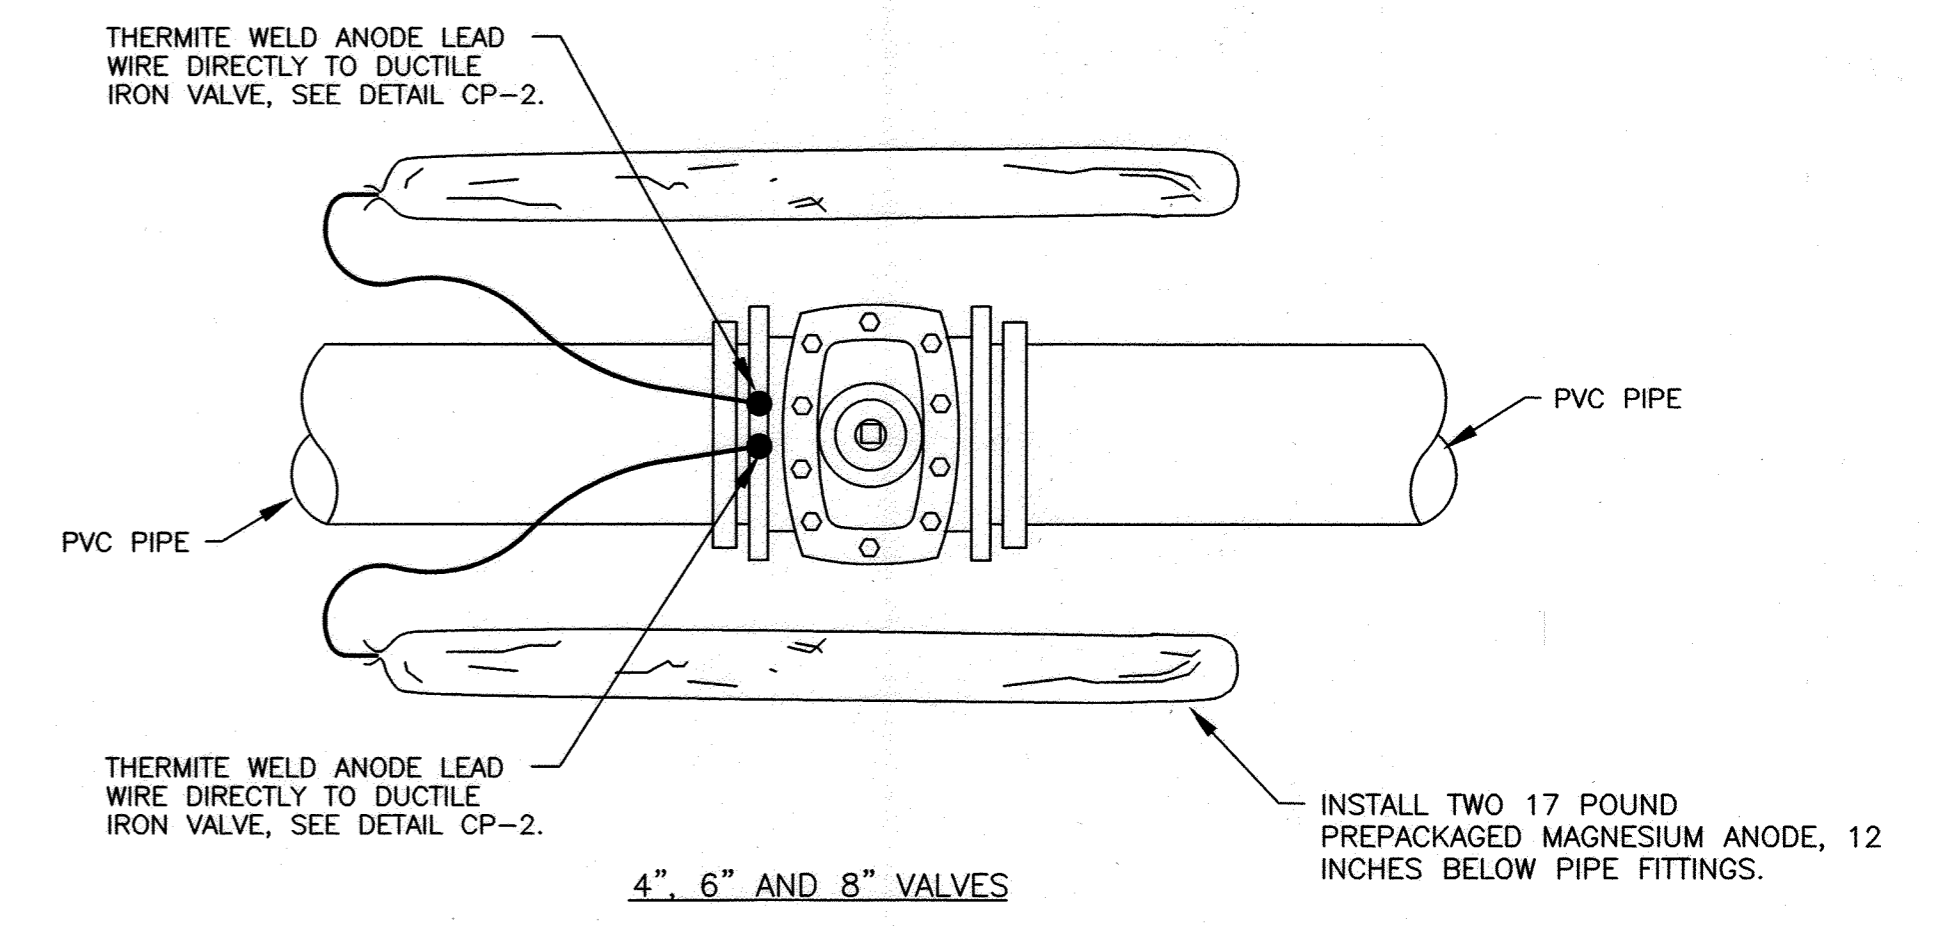

- NOTES:**
1. ANODES PLACED AT SAME DEPTH AS THE BOTTOM OF PIPE AND AT A MINIMUM OF 12" FROM EDGE OF PIPE.
 2. DO NOT THERMITE WELD TO PVC PIPE.

CP-6: CORROSION PROTECTION OF VALVES.
NOT TO SCALE

HOWARD SOIL CONSERVATION DISTRICT CERTIFICATION:
THIS DEVELOPMENT PLAN IS APPROVED FOR SOIL EROSION AND SEDIMENT CONTROL BY THE HOWARD SOIL CONSERVATION DISTRICT.

URS
MONTGOMERY PARK BUSINESS CENTER
1800 WASHINGTON BOULEVARD, SUITE 410
BALTIMORE, MARYLAND 21230
(410) 468-0875

RUSSELL CORROSION CONSULTANTS, INC.
Columbia, Maryland

STATE OF MARYLAND
PROFESSIONAL ENGINEER
NO. 225
09-25-2014

Professional Certification
I hereby certify that these documents were prepared or approved by me, and that I am a duly licensed professional engineer under the laws of the State of Maryland.
License No. 225-846
Expiration Date: 09-25-2014

DESIGN: DAS									
DRAWN: DAS									
CHK:									
DATE: 3/7/13	NO.		REVISION		DATE	BY			


CORROSION PROTECTION DETAILS (CP-1)
600' SCALE MAP NO. 24
BLOCK NO. 12

U.S. 40 WATER SERVICE MAIN REPLACEMENT
CAPITAL PROJECT NO. W-8311
CONTRACT NO. 44-4731
6TH ELECTION DISTRICT
HOWARD COUNTY, MARYLAND


SCALE: AS SHOWN
SHEET 12 OF 13

DEPARTMENT OF PUBLIC WORKS
HOWARD COUNTY, MARYLAND

<i>Jan P. Lu</i> DIRECTOR OF PUBLIC WORKS	3/13/13	<i>Thomas R. Butler</i> CHIEF, BUREAU OF ENGINEERING	3/13/13
<i>Steve C. Chen</i> CHIEF, BUREAU OF UTILITIES	3/13/13	<i>Clayton</i> CHIEF, UTILITY DESIGN DIVISION	3/12/13

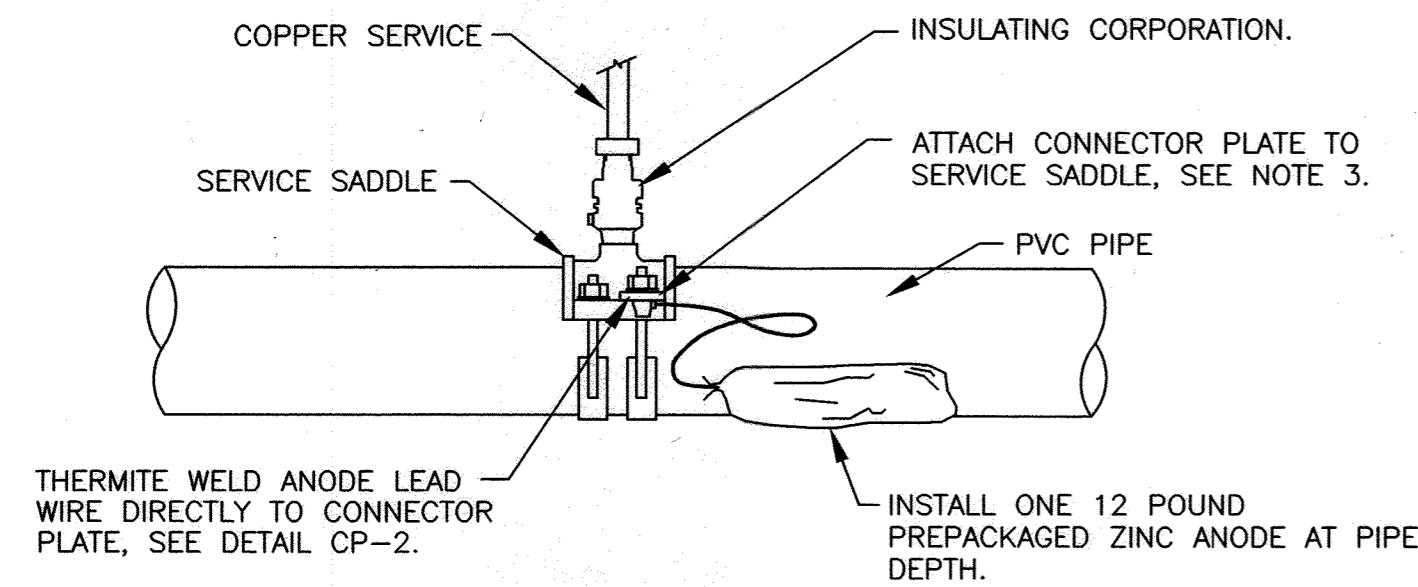

PLAN VIEW

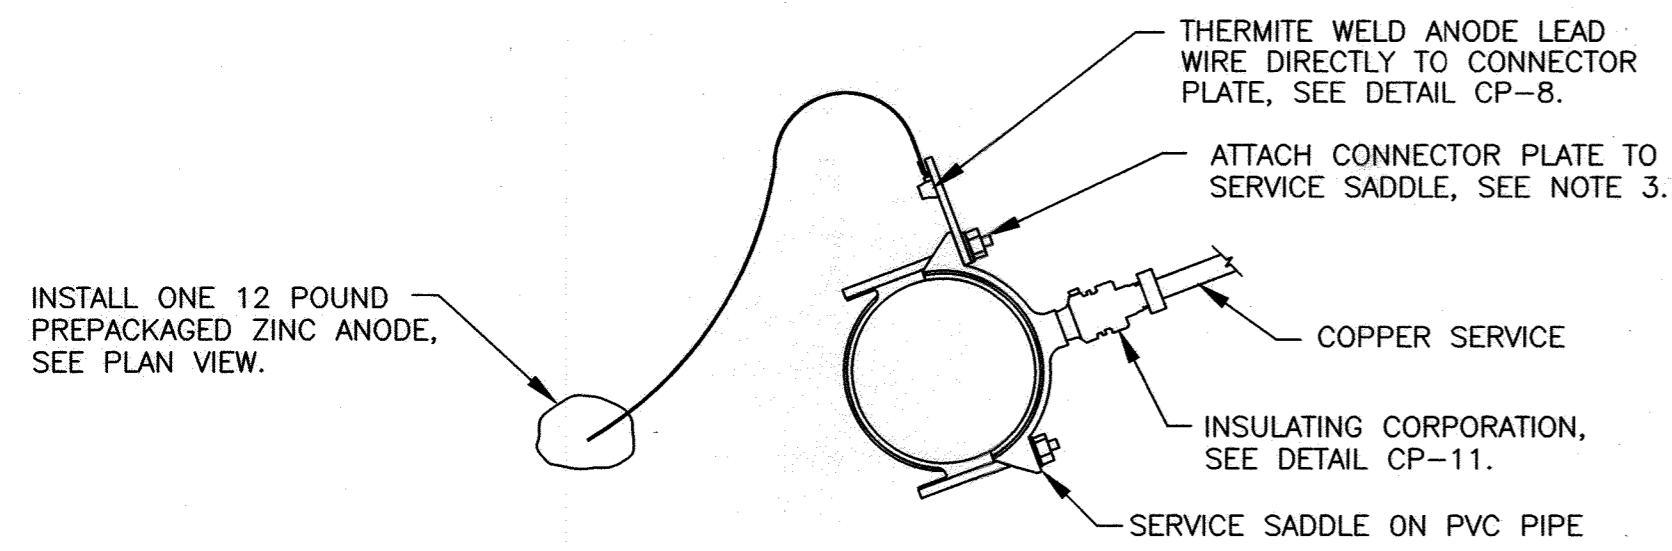


SECTION VIEW


- NOTES:
1. CONNECTOR PLATE TO BE THERMITE WELDED TO ANODE LEAD WIRE PRIOR TO ATTACHING CONNECTOR PLATE TO SERVICE SADDLE.
 2. ANODES PLACED AT SAME DEPTH AS THE BOTTOM OF PIPE AND AT A MINIMUM OF 12" FROM EDGE OF PIPE.
 3. REMOVE COATING FROM SERVICE SADDLE WHERE CONNECTOR PLATE IS TO BE MOUNTED. REMOVE COATING IMMEDIATELY PRIOR TO ATTACHING THE CONNECTOR PLATE.
 4. PLASTIC SERVICE PIPING DOES NOT REQUIRE AN INSULATING CORPORATION, A NON-INSULATING CORPORATION MAY BE USED.
 5. DO NOT THERMITE WELD TO PVC PIPE.

CP-7: CORROSION PROTECTION OF SERVICE SADDLE

NOT TO SCALE

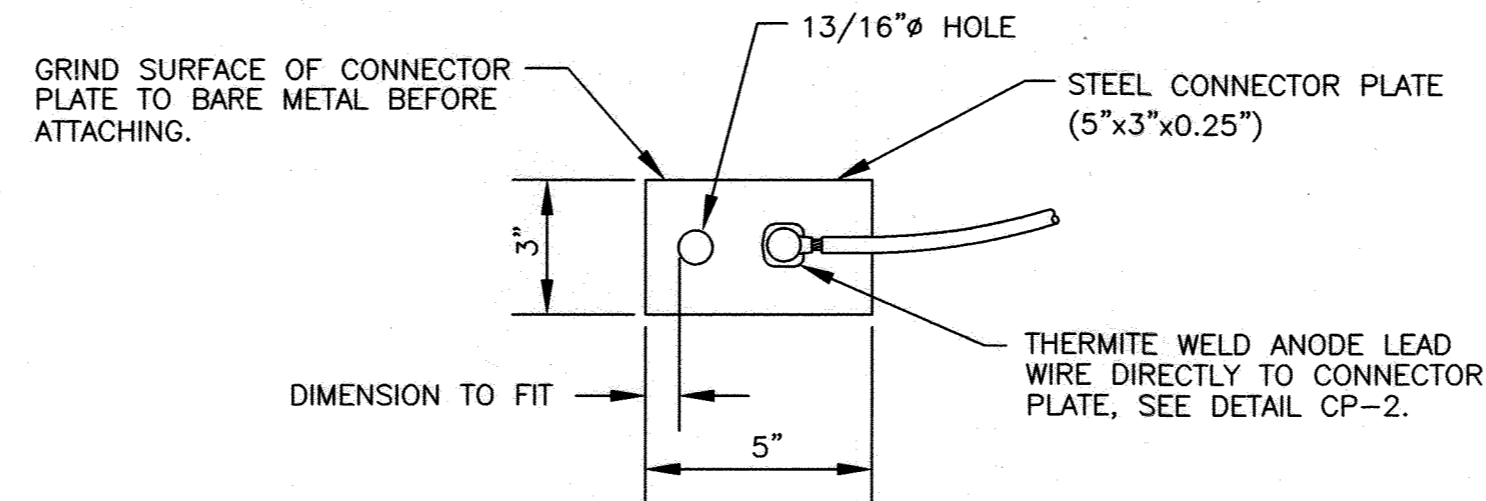

PLAN VIEW

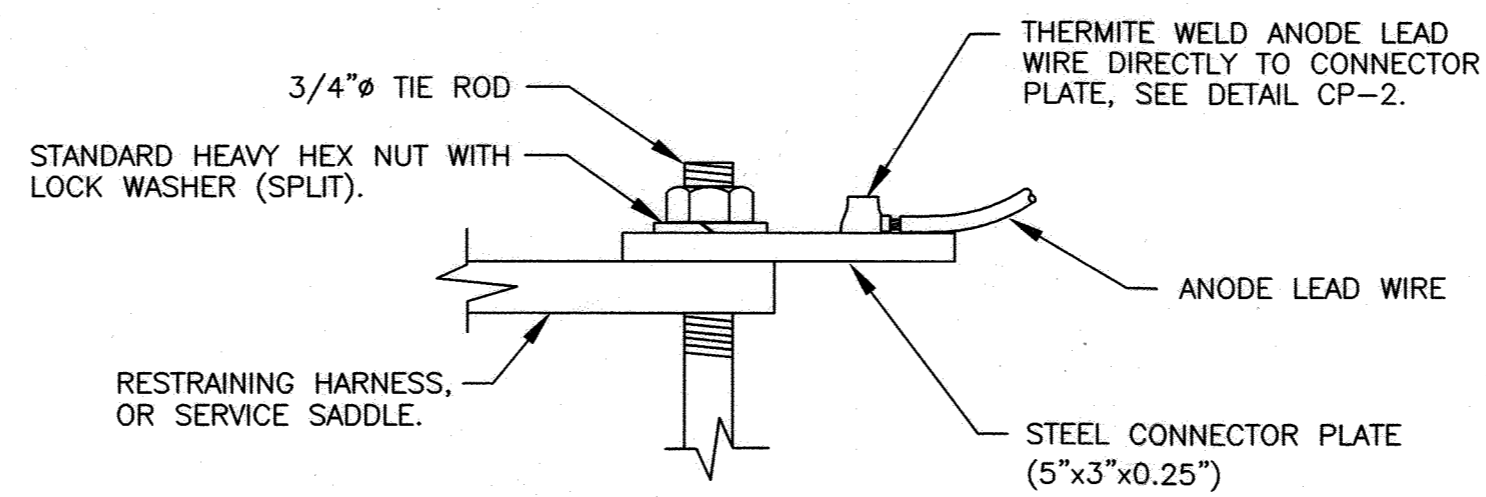


SIDE VIEW


- NOTES:
1. CONNECTOR PLATE TO BE THERMITE WELDED TO ANODE LEAD WIRE PRIOR TO ATTACHING CONNECTOR PLATE TO RESTRAINING HARNESS, OR SERVICE SADDLE.
 2. THERMITE WELDS SHALL BE COATED WITH A PREFABRICATED ONE PIECE PLASTIC CAP FILLED WITH ELASTOMERIC MATERIAL, ROYSTON HANDY-CAP OR APPROVED EQUAL.

CP-8: CONNECTION PLATE DETAIL

NOT TO SCALE

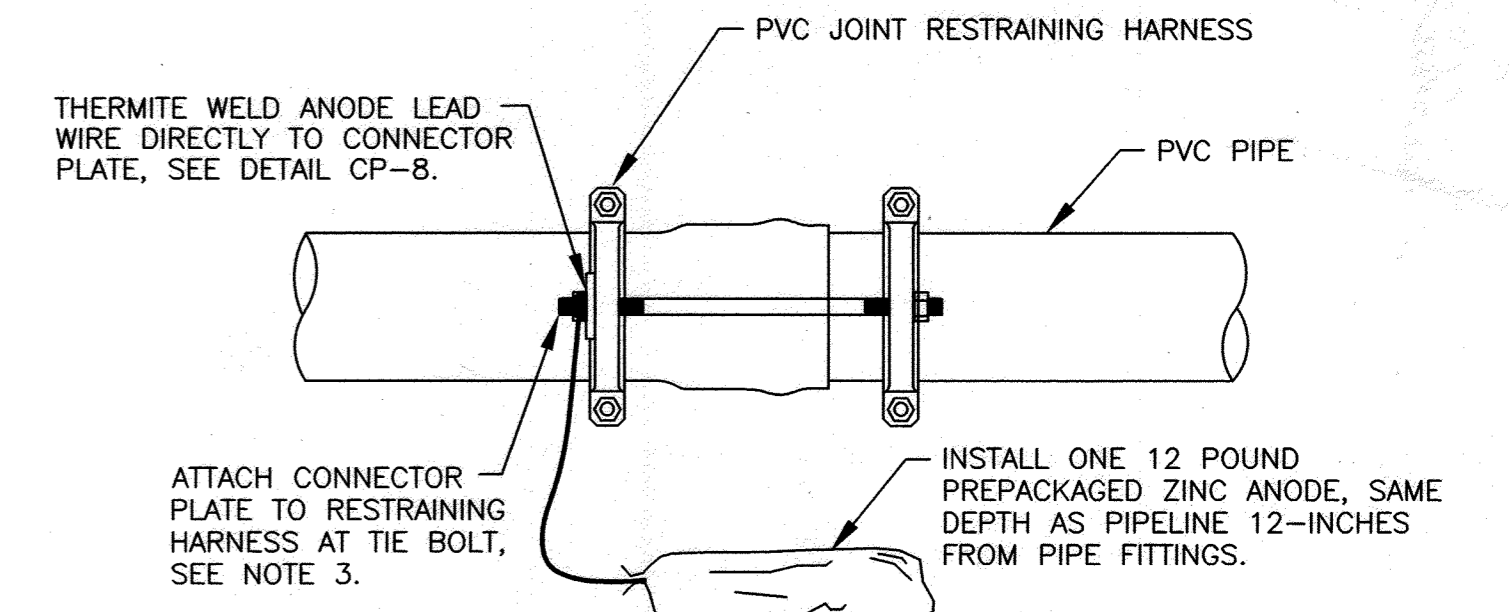

PLAN VIEW

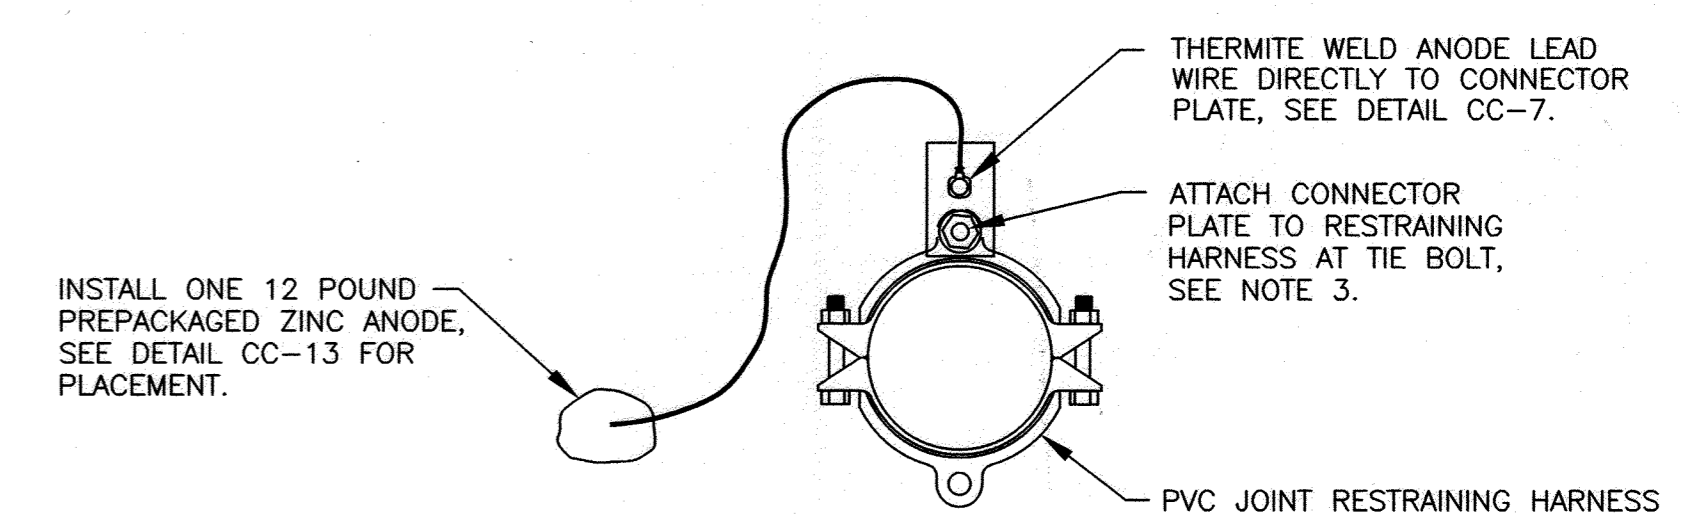


SECTION VIEW

- NOTES:
1. CONNECTOR PLATE TO BE THERMITE WELDED TO ANODE LEAD WIRE PRIOR TO ATTACHING CONNECTOR PLATE TO RESTRAINING HARNESS.
 2. ANODES PLACED AT SAME DEPTH AS THE BOTTOM OF PIPE AND AT A MINIMUM OF 12" FROM EDGE OF PIPE. SEE PLAN VIEW.
 3. REMOVE COATING FROM RESTRAINING HARNESS WHERE CONNECTOR PLATE IS TO BE MOUNTED. REMOVE COATING IMMEDIATELY PRIOR TO ATTACHING THE CONNECTOR PLATE.
 4. DO NOT THERMITE WELD TO PVC PIPE.

CP-9: CORROSION PROTECTION OF RESTRAINING HARNESS


NOT TO SCALE

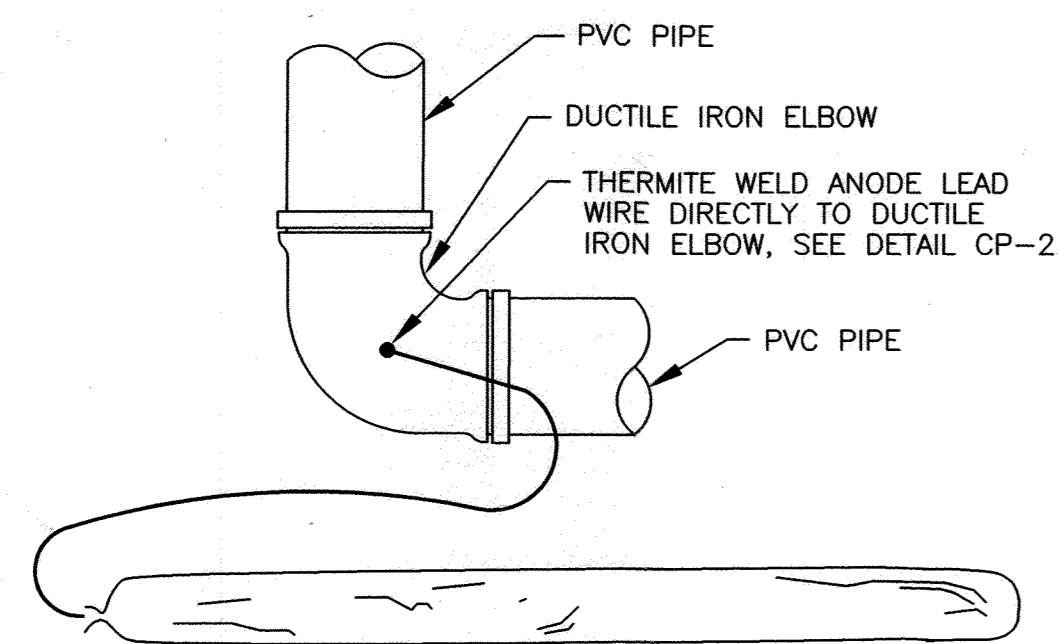

ELBOW

CP-10: CORROSION PROTECTION OF ELBOW FITTINGS

NOT TO SCALE

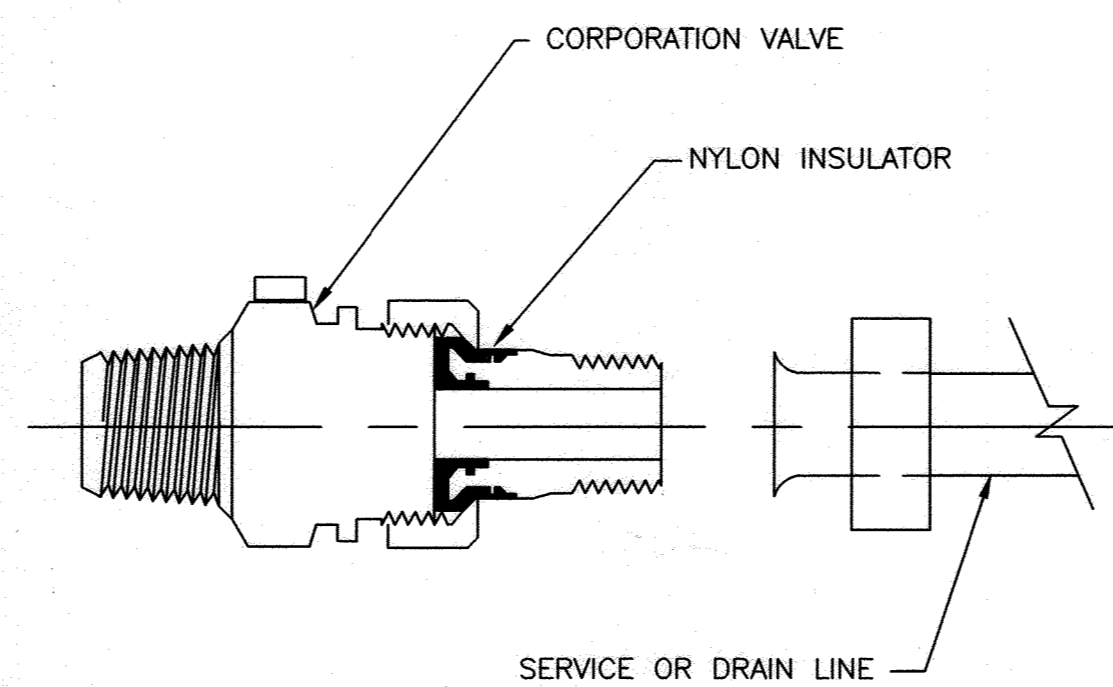


NOTES:

1. INSTALL ELECTRICAL ISOLATION ON ALL WATER SERVICE AND DRAIN LINE CONNECTIONS TO MAIN.
2. COAT EXTERIOR OF CORPORATION STOP, AND SERVICE PIPING AND/OR DRAIN LINE FOR A DISTANCE OF 12 INCHES WITH MASTIC COATING (ROYSTON ROSKOTE R28). MASTIC COATING TO BE MINIMUM OF 20 MILS IN THICKNESS.
3. INSULATED CORPORATION NOT REQUIRED FOR PLASTIC SERVICES.

CP-11: INSULATING CORPORATION

NOT TO SCALE

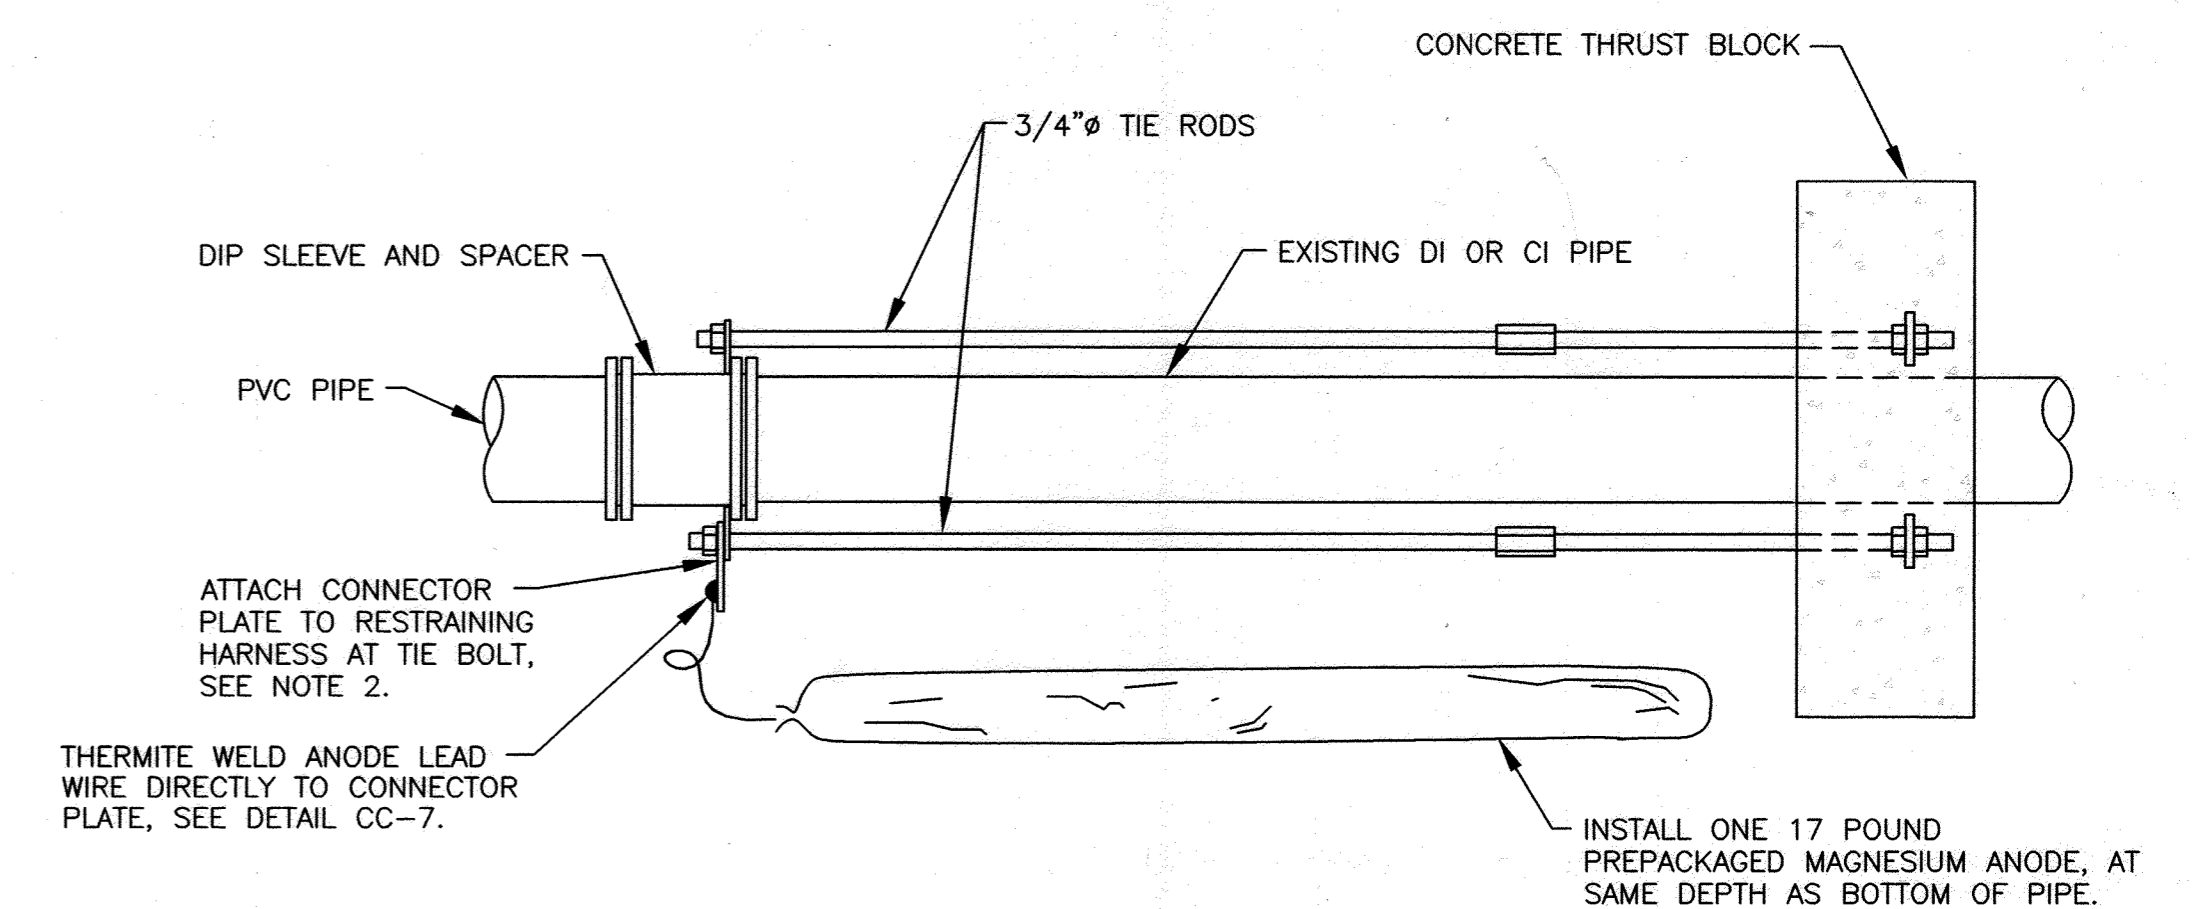

NOTES:

1. ANODES PLACED AT SAME DEPTH AS THE BOTTOM OF PIPE AND AT A MINIMUM OF 12" FROM EDGE OF PIPE.
2. REMOVE COATING FROM RESTRAINING HARNESS WHERE CONNECTOR PLATE IS TO BE MOUNTED. REMOVE COATING IMMEDIATELY PRIOR TO ATTACHING THE CONNECTOR PLATE.
3. DO NOT THERMITE WELD TO PVC PIPE.

CP-12: CORROSION PROTECTION AT IN-LINE THRUST BLOCK

NOT TO SCALE

HOWARD SOIL CONSERVATION DISTRICT CERTIFICATION:

THIS DEVELOPMENT PLAN IS APPROVED FOR SOIL EROSION AND SEDIMENT CONTROL BY THE HOWARD SOIL CONSERVATION DISTRICT.

HOWARD SCD _____ DATE _____

DEPARTMENT OF PUBLIC WORKS
HOWARD COUNTY, MARYLAND

Director of Public Works: *[Signature]* 3/13/13
 Chief, Bureau of Engineering: *[Signature]* 3/13/13
 Chief, Bureau of Utilities: *[Signature]* 3/13/13
 Chief, Utility Design Division: *[Signature]* 3/13/13

URS

MONTGOMERY PARK BUSINESS CENTER
1800 WASHINGTON BOULEVARD, SUITE 410
BALTIMORE, MARYLAND 21230
(410) 468-0875

RUSSELL CORROSION CONSULTANTS, INC.
Columbia, Maryland

Professional Certification
I hereby certify that these documents were prepared or approved by me, and that I am a duly licensed professional engineer under the laws of the State of Maryland.
License No. 21846
Expiration Date: 09-25-2014

DESIGN: DAS							
DRAWN: DAS							
CHK:							
DATE: 3/7/13	NO.	REVISION	DATE	BY	600' SCALE MAP NO. 24	BLOCK NO. 12	

CORROSION PROTECTION DETAILS (CP-2)

U.S. 40 WATER SERVICE MAIN REPLACEMENT
CAPITAL PROJECT NO. W-8311
CONTRACT NO. 44-4731
6TH ELECTION DISTRICT
HOWARD COUNTY, MARYLAND

SCALE: AS SHOWN
SHEET 13 OF 13