


QUANTITIES Δ				
ITEMS	QUANTITIES ESTIMATED	AS-BUILT		
		QUANTITIES	TYPE	MANUFACTURER/SUPPLIER
8" WATER MAIN (C900 DR18 PVC)	340 LF	340 LF	C900 DR18	NATIONAL PIPE & PLASTICS
6" WATER MAIN (C900 DR18 PVC)	283 LF	283 LF	C900 DR18	NATIONAL PIPE & PLASTICS
4" WATER MAIN (C900 DR18 PVC)	195 LF	195 LF	C900 DR18	NATIONAL PIPE & PLASTICS
1 1/2" WHC	719 LF	719 LF	COPPER	MUELLER INDUSTRIES
8" x 4" T.	1	1 EA.	DUCTILE IRON	
8" x 1/2" H.B.	3	3 EA.	PVC C400	
8" x 6" F.H.T.	1	1 EA.	DUCTILE IRON	TYLER / UNION FOUNDRY
4" VALVE	1	1 EA.	GATE VALVE	MUELLER COMPANY
6" VALVE	1	1 EA.	GATE VALVE	MUELLER COMPANY
FIRE HYDRANT	1	1 EA.	AMERICAN	AMERICAN FLOW CONTROL
8" PVC Sewer Main	859 LF	855 LF	SDR 35	NATIONAL PIPE & PLASTICS
6" Sewer Main (C900 PVC)	683 LF	683 LF	C900 DR18	NATIONAL PIPE & PLASTICS
4" SHC	651 LF	651 LF	C900 DR18	NATIONAL PIPE & PLASTICS
4" MANHOLE	10	10 EA.	CONCRETE	CONTRACTOR'S PRECAST CORP
Type B Drop Connection	2	2 EA.	CONCRETE	CONTRACTOR'S PRECAST CORP
4" 2.5" HDZ	1	1 EA.	PVC	HARCO FITTINGS
6" 0.5" HDZ	1	1 EA.	PVC	HARCO FITTINGS
6" 3.0" HDZ	1	1 EA.	PVC	HARCO FITTINGS
8" 1.5" HDZ	1	1 EA.	PVC	HARCO FITTINGS
8" 5" SHEEP BEND	3	3 EA.	PVC	HARCO FITTINGS


NAME OF UTILITY CONTRACTOR: **CONSOLIDATED CONSTRUCTION SERVICES**

SURVEY AND DRAFTING DIV. CHECKBOX: _____ AS-BUILT DATE: _____

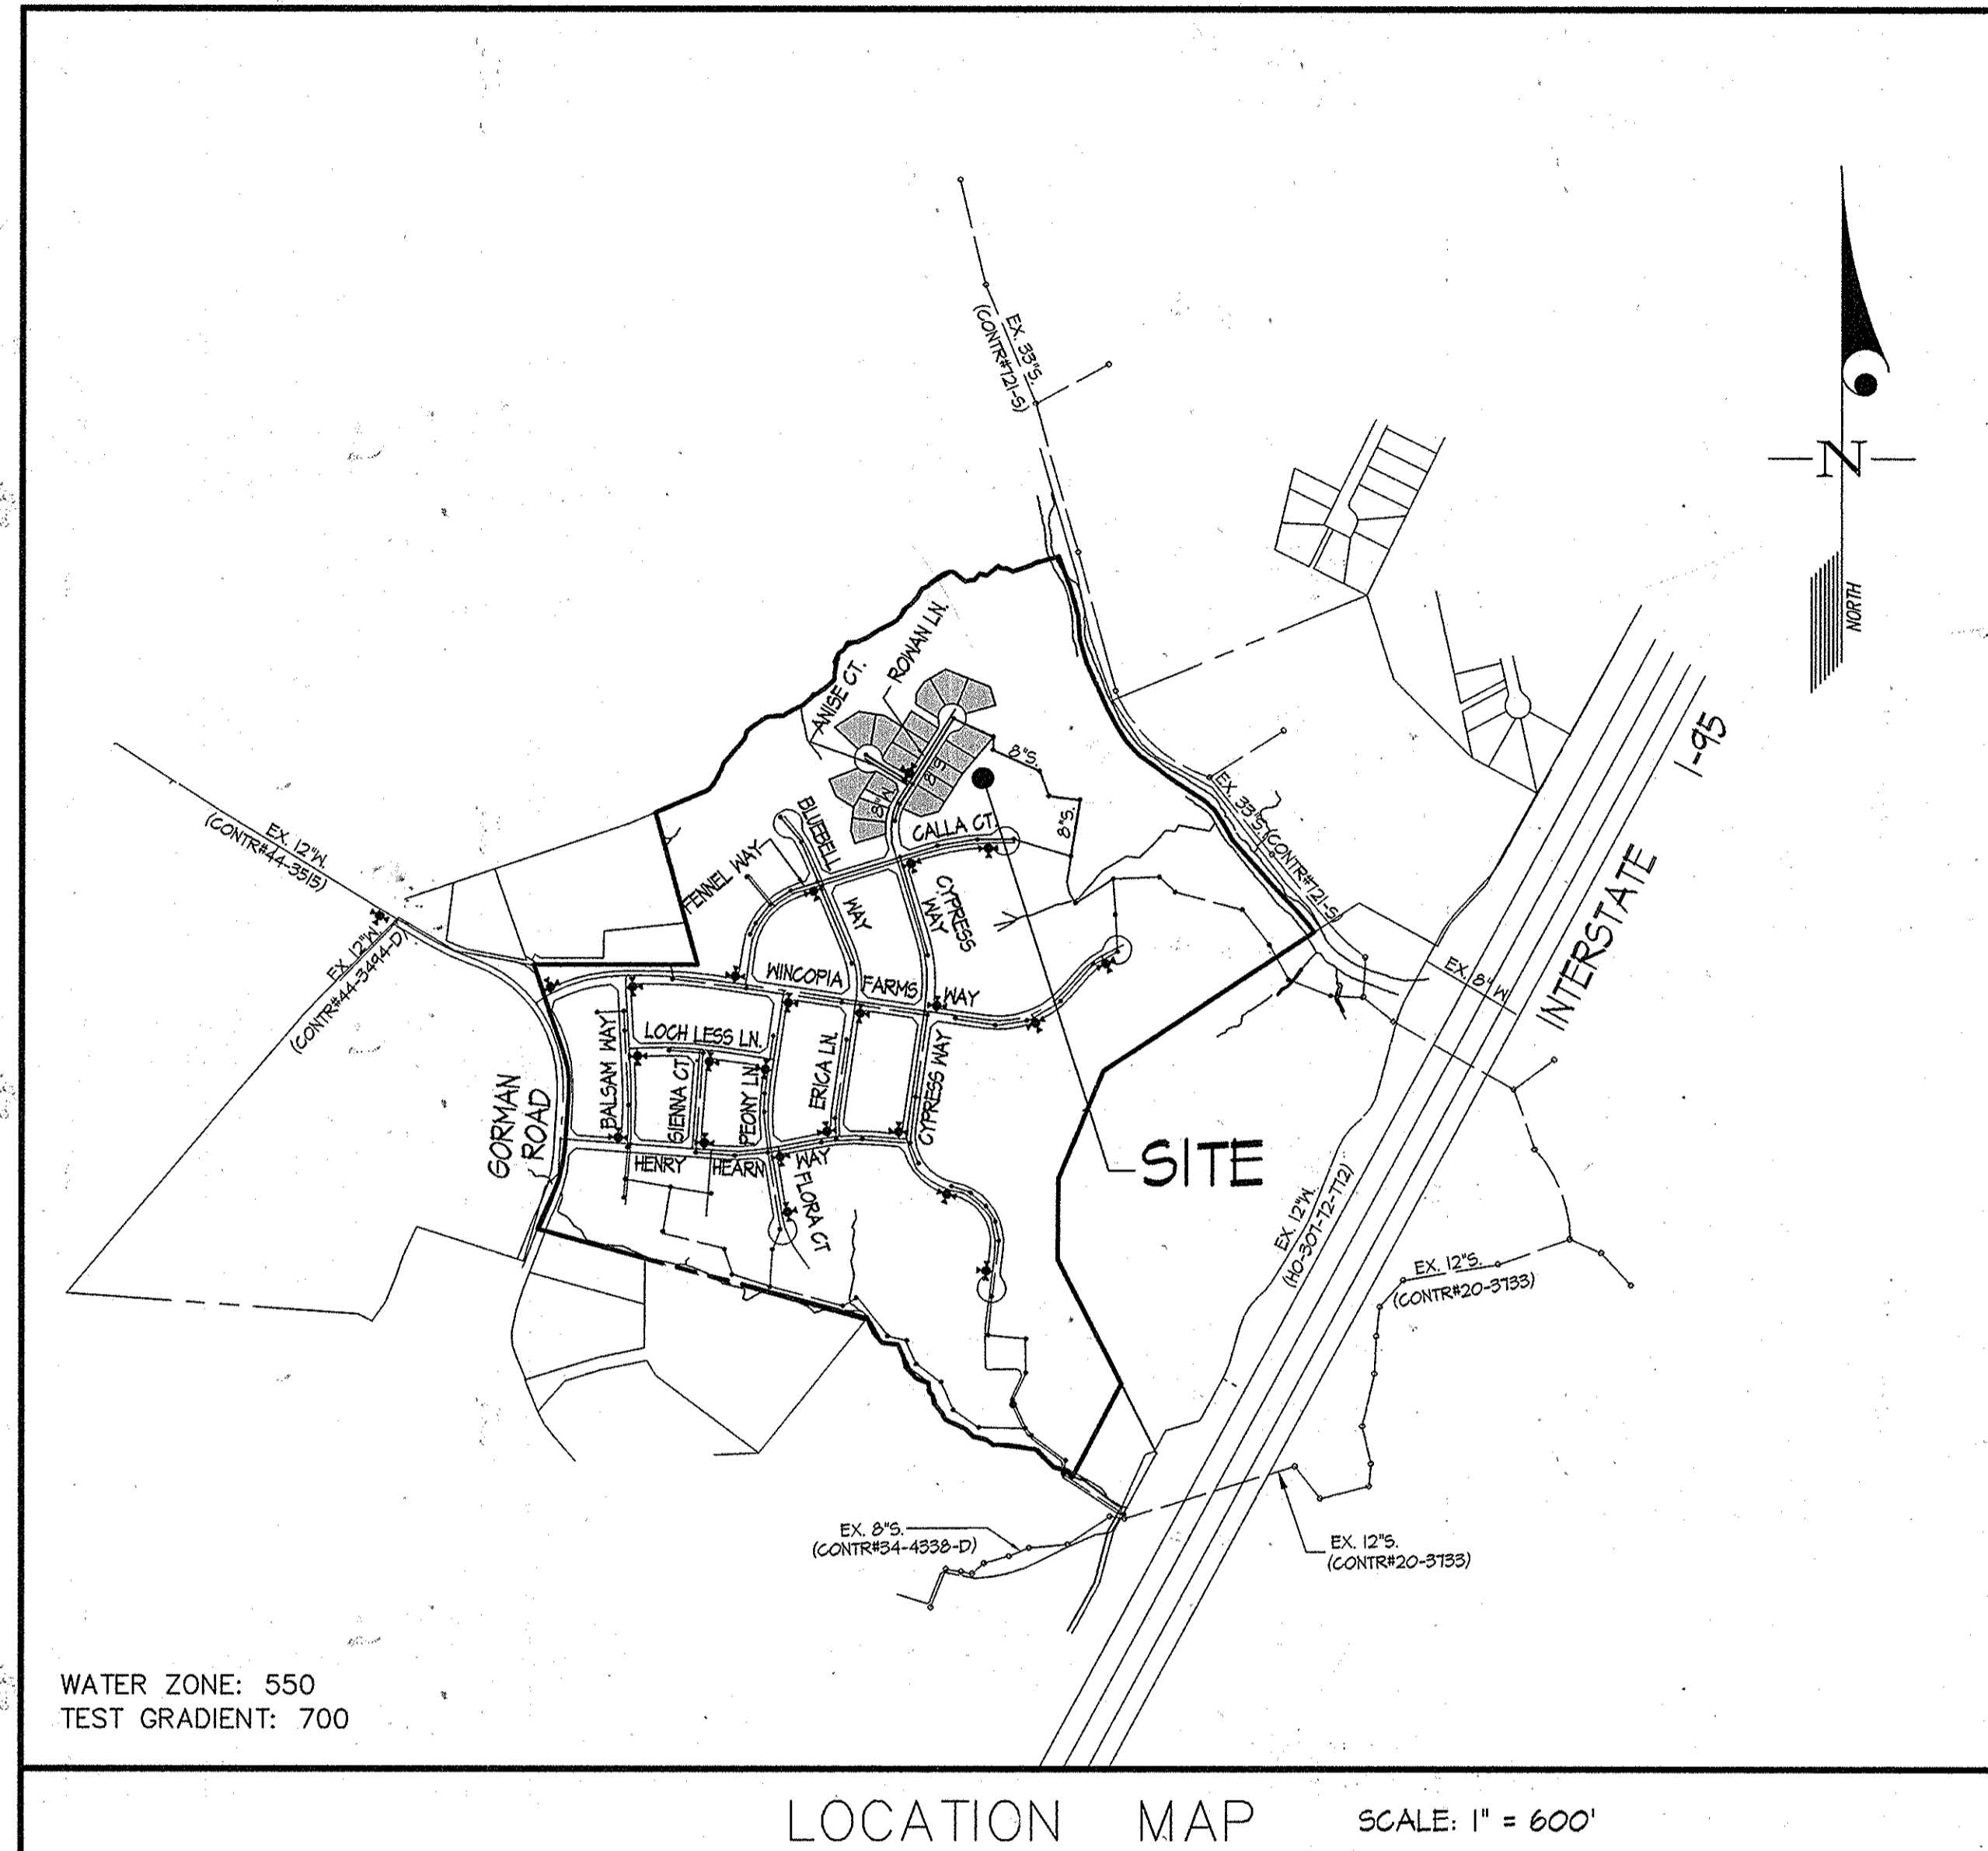

CONTRACT No. 24-4814-D
WINCOPIA FARMS - PHASE 5
LOTS 74 THRU 90
HOWARD COUNTY, MARYLAND
DEPARTMENT OF PUBLIC WORKS

TYPE OF BUILDING	RESIDENTIAL
NUMBER OF LOTS	17
NUMBER OF S.H.C.'s	17
NUMBER OF W.H.C.'s	17
AREA OF COMMERCIAL LOT/PARCEL	N/A
SEWER SHED	MIDDLE PATUWENT
PUMPING STATION	LITTLE PATUWENT RECLAMATION PLANT

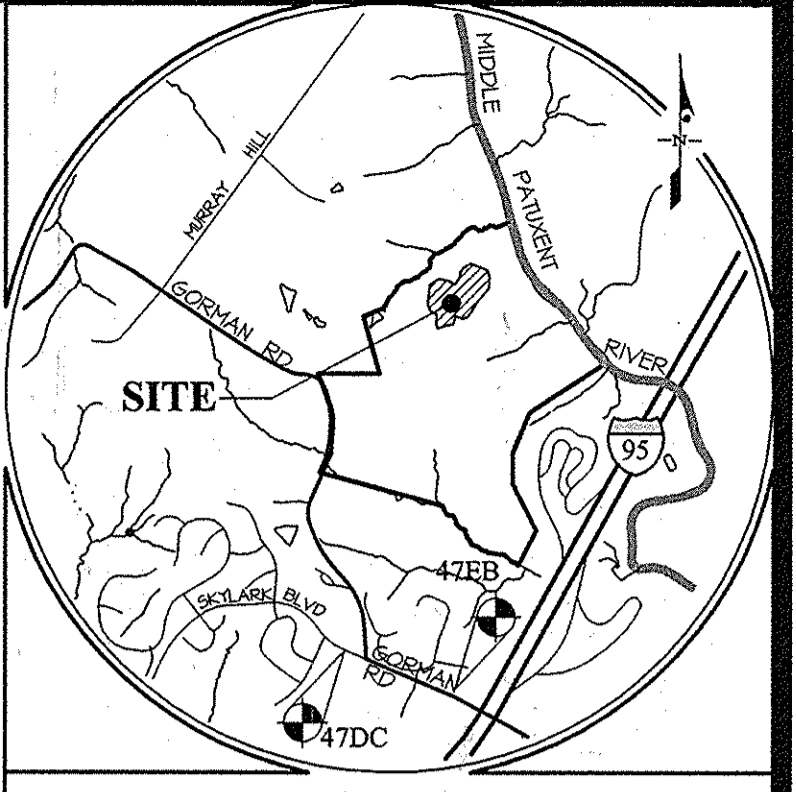

BENCHMARKS

47DC	ELEV. 348.16	N = 536.615.00	E = 1253.671.00
47EB	ELEV. = 354.23	N = 536.212.77	E = 1254.233.57

ADC MAP: 40 GRID: B-3

GENERAL NOTES
Revised - October 2013

- Part I**
- Approximate locations of existing mains are shown. The contractor shall take all necessary precautions to protect existing mains and services and maintain uninterrupted service. Any damage incurred shall be repaired immediately to the satisfaction of the Engineer at the contractor's expense.
 - Topographic AIR surveys were performed on DECEMBER, 2008 by MCKENZIE SNYDER.
 - Horizontal and Vertical Survey Controls:
 - The coordinates shown on the drawings are based on Maryland State Reference System NAD '83/'11 as projected by Howard County Geodetic Control Stations No. 47DC, and No. 47EB.
 - All vertical controls are based on NAVD '88. Vertical controls provided on the drawings are STANDARD DISCS ON CONCRETE MONUMENTS.
 - All pipe elevations shown are invert elevations unless otherwise noted on the plans.
 - Clear all utilities by a minimum of 12 inches. Clear all poles by 5'-0" minimum or tunnel as required unless otherwise noted. The owner has contacted the utility companies and has made arrangements for bracing of poles as shown on the drawings. In the event the contractor's work requires the bracing of additional poles, any cost incurred by the owner for the bracing of additional poles or damages shall be deducted from monies owed the contractor. The contractor shall coordinate with the utility companies to schedule the bracing of the poles.
 - For details not shown on the drawing, and for materials and construction methods, use Howard County Design Manual, Volume IV, Standard Specifications and Details for Construction (Latest Edition). The contractor shall have a copy of Volume IV on the job.
 - Where test pits have been made on existing utilities, they are noted by the symbol Δ at the locations of the test pits. A note or notes containing the results of the test pit or pits is included on the drawings. Existing utilities in the vicinity of the proposed work for which test pits have not been dug shall be located by the contractor two weeks in advance of construction operations at his own expense.
 - The contractor shall notify the following utility companies or agencies at least five working days before starting work shown on these plans:

AT&T	1-800-252-1139
BGE (Construction Services)	410-637-3713
BGE (Emergency)	410-685-0123
Bureau of Utilities	410-313-4900
Colonial Pipeline Co.	410-195-1340
Miss Utility	1-800-251-7777
State Highway Administration	410-531-5533
Verizon	1-800-143-0033
 - Trees and shrubs are to be protected from damage to the maximum extent. Trees and shrubs located within the construction strip are not to be removed or damaged by the contractor.
 - The contractor shall remove trees, stumps and roots along the line of excavation. Payment for such removal shall be included in the unit price bid for construction of the main.
 - The contractor shall notify the Bureau of Highways, Howard County, at (410)-313-7450 at least five working days before open cutting or boring/jacking of any County road for laying water/sewer mains or house connections. The approval of these drawings will constitute compliance with DPM requirements per Section 18.14(a) of the Howard County Code.

Part II WATER


- All water mains shall be AWWA standard C900 DR18 PVC unless otherwise noted.
- Tops of all water mains shall have a minimum of 3'-6" of cover unless otherwise noted.
- Valves adjacent to tees shall be strapped to tees.
- All fittings shall be buttressed or anchored with concrete in accordance with Standard Details unless otherwise provided for on the drawings.
- Fire hydrants shall be set to the bury line elevations shown on the drawings. All fire hydrants shall be installed in accordance with Standard Details. The soil around the fire hydrant shall be compacted in accordance with Section 1000 and Section 1005 of the Standard Specifications.
- The contractor shall not operate any water main valves on the existing water system.
- Tracer wires and continuity test stations shall be installed on all DIP and PVC water mains in accordance with the Howard County Design Manual.
- For PVC water mains, all records for the Quality Control and Qualification Test Requirements noted in Section 5.1 of the AWWA Standard C900 for PVC pressure pipe shall be submitted with the pipe material certifications or shop drawings prior to approval of the material for use. The test records shall be for the pipe to be installed under this contract. All PVC pipe shall contain markings to allow cross referencing of the pipe supplied to the test records received.
- Unless otherwise noted on the plans or in the specifications sacrificial anodes shall be installed on all valves and metallic fittings used with PVC water mains in accordance with Volume IV, Standard Specifications and Details for Construction. Seventeen (17) pound Magnesium anodes shall be installed on all valves and ductile iron fittings including restraints and harnesses. Twelve (12) pound Zinc anodes shall be installed on all stainless steel fittings and saddles used with PVC mains. All gtees+ used with PVC mains shall be ductile iron.
- Proper Assembly of Gasketed PVC Pipe Joints: The manufacturer's insertion line of gasketed PVC pipe joints indicates the maximum depth of insertion of the spigot into the bell. After assembly of the joint, the insertion line shall remain visible. Dual insertion lines on gasketed PVC pipe indicate the maximum and minimum depth of insertion of the spigot into the bell. The contractor shall not over insert or over home the spigot into the bell of PVC pipe.
- All changes in horizontal or vertical direction of PVC water pipe shall be made with standard bends, 5-degree sweeps or high deflection (HD) couplings. No bending of the pipe or deflecting of PVC pipe joints is permitted. Where high deflection couplings or 5-degree sweeps are permitted, the contractor shall provide one full pipe length (20-foot long) on either side of the high deflection coupling or 5-degree sweep. The contractor shall use a vibratory plate compactor or other approved means to thoroughly compact the #57 stone on both sides of the high deflection coupling or 5-degree sweep, taking care not to use compaction equipment directly over the fitting.

PVC high deflection couplings shall be limited to a total deflection of 3-degrees (1 1/2-degree on either end of the coupling), shall be rated for a minimum 200 psi meeting the requirements of AWWA C900, shall have a minimum lay length of 4-inches and shall have center stops. PVC High deflection couplings shall be CertainTeed PVC High Deflection (HD) Stop Couplings or equal. Five degree sweeps shall be bell by spigot, rated for a minimum 225 psi, DR18 meeting the requirements of AWWA C900 and shall be Multi Fittings (pex) Blue Brute DR18 or equal.

When PVC high deflection couplings or PVC 5-degree sweeps are used to facilitate changes in horizontal or vertical alignments of AWWA C-900 PVC pipelines, the contractor shall install devices for the prevention of over-insertion of the PVC pipe spigots or plain ends into the push on bell joint on both sides of the high deflection couplings and 5 degree sweeps. Bell stops shall be placed at the proper insertion line for the fitting. The bell stop shall be manufactured of ductile iron and incorporate an expansion retention spring to allow for pipe expansion and contraction. The bell stops shall be Series 5000 Mega-Stop, as manufactured by EBAA Iron, Inc. or approved equal.

Part III SEWER

- All sewer mains shall be D.I.P. or P.V.C. unless otherwise noted.
- All manholes shall be 4'-0" inside diameter unless otherwise noted.
- Force mains shall be D.I.P. only.
- Manholes shown with 12" and 16" walls are for brick manholes only.
- Manholes designated W.T. in plan and profile shall have watertight frame and cover, Standard Detail 6552. Where watertight manhole frames and covers are used, set top of frame 1'-6" above finished grade unless otherwise noted on the drawings.
- House(s) with the symbol "C.N.S." indicates that the cellar cannot be served.

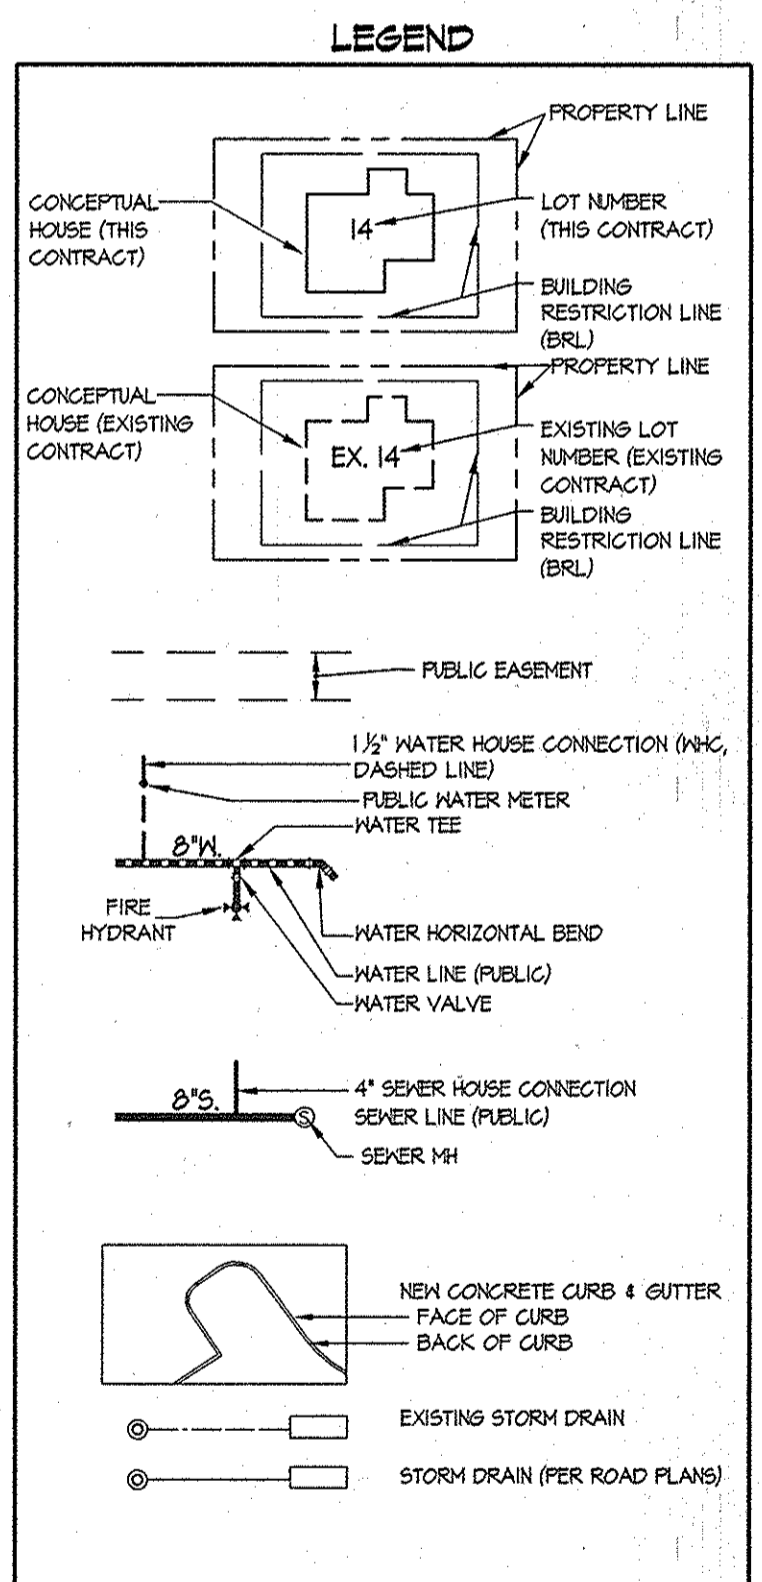

WINCOPIA FARMS PUBLIC WATER & SEWER CONSTRUCTION ORDER

CONTRACT NUMBER	CONSTRUCTION ORDER
24-4814-D	1
24-4811-D	4
24-4812-D	2
24-4815-D	5
24-4814-D	6
24-4815-D	3

- SHEET INDEX**
- TITLE SHEET
 - WATER & SEWER EXTENSION PLAN
 - WATER & SEWER PROFILE PLAN
 - SEWER PLAN PROFILE


SEDIMENT CONTROL MEASURES WILL BE IMPLEMENTED IN ACCORDANCE WITH F-13-103, SECTION 308 OF THE SPECIFICATIONS AT FINAL PLAN STAGE.

THIS DEVELOPMENT PLAN IS APPROVED FOR SOIL EROSION AND SEDIMENT CONTROL BY THE HOWARD SOIL CONSERVATION DISTRICT.

APPROVED: *John P. Robertson* 11/26/13
HOWARD S.C.D. Date

DEPARTMENT OF PUBLIC WORKS HOWARD COUNTY, MARYLAND <i>John P. Robertson</i> CHIEF, BUREAU OF UTILITIES	DEPARTMENT OF PLANNING AND ZONING HOWARD COUNTY, MARYLAND <i>John P. Robertson</i> CHIEF, DEVELOPMENT ENGINEERING DIVISION	GLW GUTSCHICK LITTLE & WEBER, P.A. CIVIL ENGINEERS, LAND SURVEYORS, LAND PLANNERS, LANDSCAPE ARCHITECTS 3909 NATIONAL DRIVE - SUITE 250 - BURTONSVILLE OFFICE PARK BURTONSVILLE, MARYLAND 20886 TEL: 301-421-4024 BAL: 410-880-1820 DC/WA: 301-989-2524 FAX: 301-421-4168	DATE OCT., 2013 G.L.W. No. 08052 PROFESSIONAL CERTIFICATION I HEREBY CERTIFY THAT THESE PLANS WERE PREPARED OR APPROVED BY ME, AND THAT I AM A DULY LICENSED PROFESSIONAL ENGINEER UNDER THE LAWS OF THE STATE OF MARYLAND, LICENSE NO. 12975, EXP. DATE: MAY 26, 2014	TITLE SHEET AS-BUILT Revised water Per change to PVC, added 1" WHC 11/05/16 4/10/14	SCALE AS SHOWN SHEET 1 OF 4
---	---	--	---	---	--------------------------------

1: CAD DRAWINGS 08052-PUB-WAT-SEW-FINAL-WAS-PHASE 5 (08052-FIN-C5.dwg)
 PLOTTED: 10/29/2013 11:13 AM, LAST SAVED: 10/29/2013 9:19 AM, PLOTTED BY: Girma Tsegaye

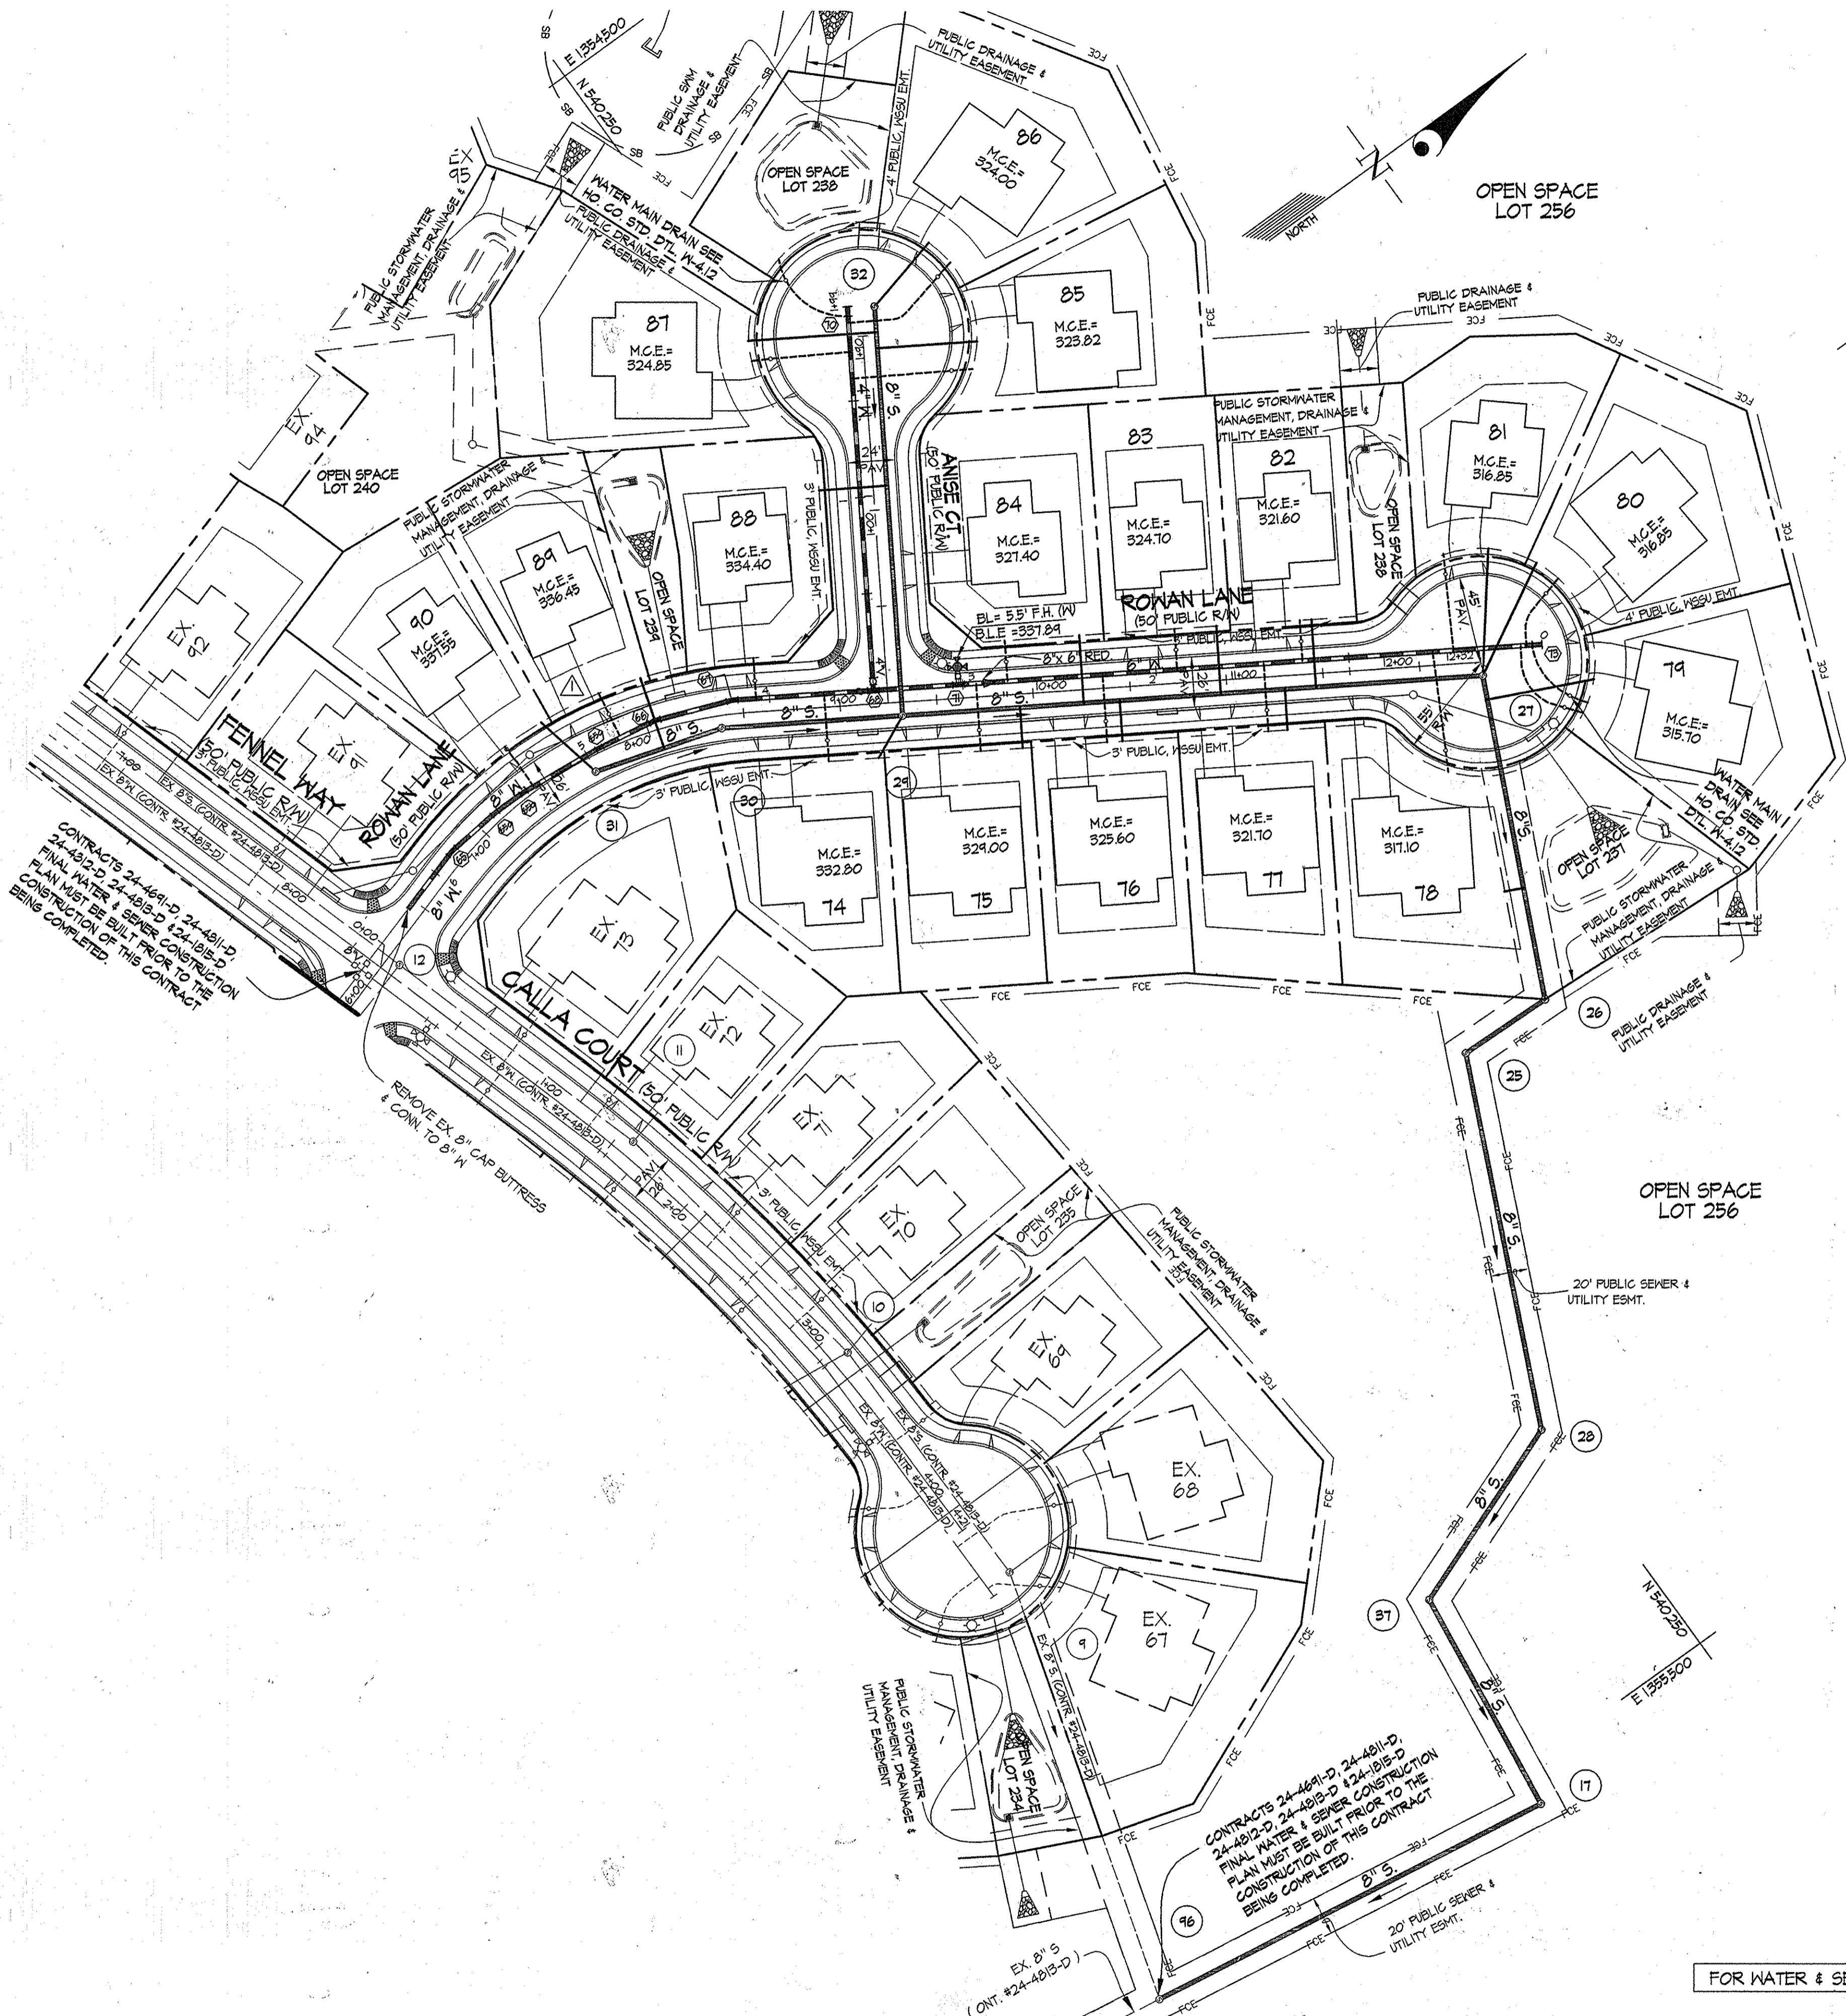

SEWER MANHOLE LOCATIONS (ROMAN LANE)		
MH No.	STATION	OFFSET
24	432	7.0' RIGHT
30	8+38	6.5' RIGHT
31	7+66	8.0' RIGHT

FITTING CHART		
STATION	FITTING	LOCATION
(65)	5+86	N. 534,968.06 E. 1,354,790.08
(65)	5+57	N. 534,991.26 E. 1,354,781.09
(65)	5+38	N. 540,015.64 E. 1,354,781.09
(65)	4+43	N. 540,060.72 E. 1,354,781.40
(66)	4+61	N. 540,092.44 E. 1,354,786.90
(67)	4+14	N. 540,131.13 E. 1,354,811.83
(68)	3+46	N. 540,143.17 E. 1,354,850.54
(70)	1+91*	N. 540,246.70 E. 1,354,804.91
(71)	3+02	N. 540,230.48 E. 1,354,873.41
(73)	0+00	N. 540,486.70 E. 1,355,034.01

*-LOCATED ON ANISE COURT




SEWER MANHOLE LOCATIONS (ROMAN LANE, CUL-DE-SAC)		
MH No.	NORTH	EAST
32	540452	1355024

SEWER MANHOLE LOCATIONS (ANISE CT, CUL-DE-SAC)		
MH No.	NORTH	EAST
32	540310	1354690

SEWER MANHOLE LOCATIONS (OPEN SPACE LOT 256)		
MH No.	NORTH	EAST
17	540135	1355514
25	540381	1355182
26	540380	1355184
28	540248	1355263
37	540130	1355400


FIRE HYDRANT INFORMATION	
FH	LOCATION
N	N. 540,235.24 E. 1,354,866.14

LOT FRONTAGE TABLE	
LOT No.	DISTANCE (feet)
ROMAN LANE	
74	109.36
75	65.00
76	65.00
77	71.50
78	73.33
79	49.25
80	44.35
81	54.35
82	70.00
84	55.00
90	46.25
ANISE COURT	
84	99.44
85	71.08
86	55.88
87	73.15

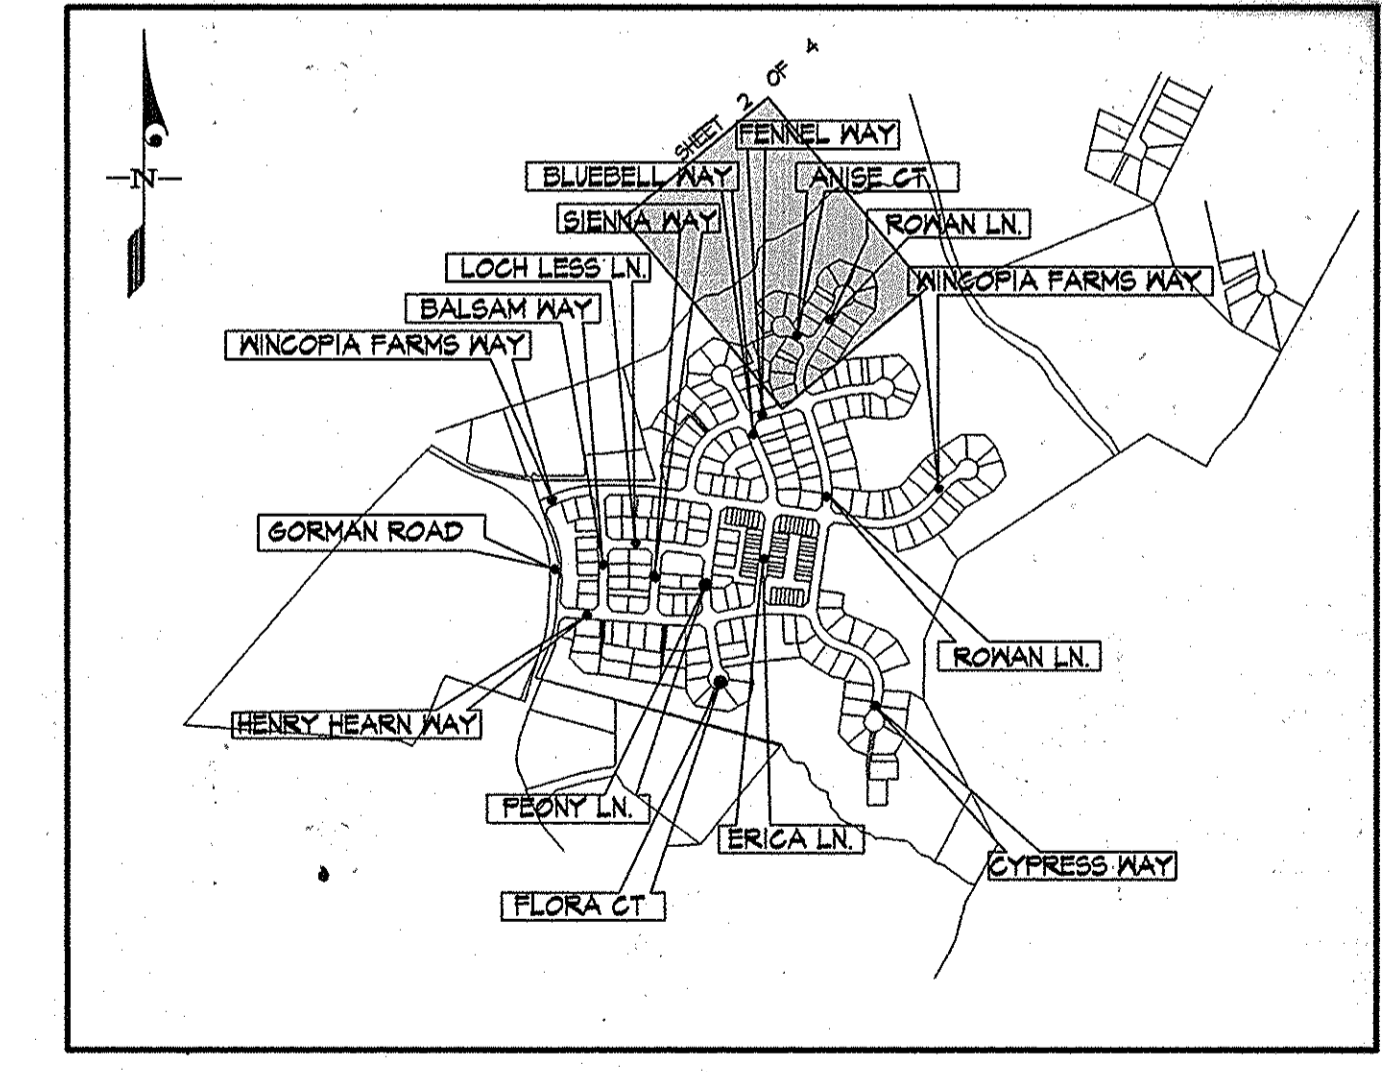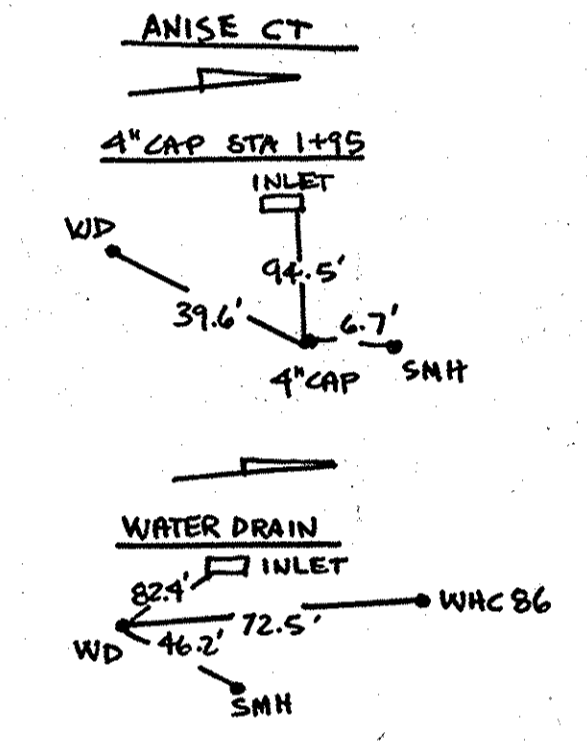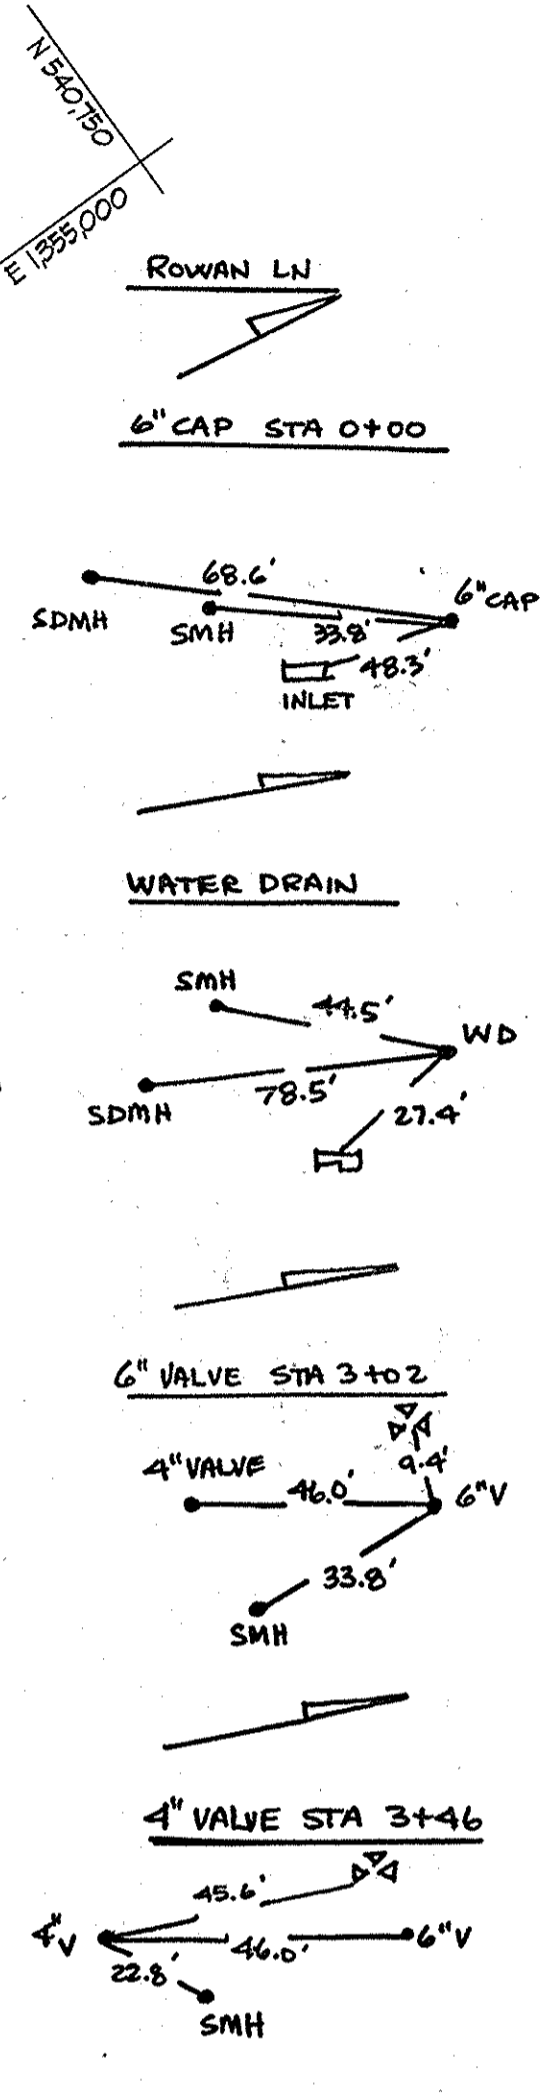

KEY MAP
SCALE: 1"=1,000'

- NOTES:
- 3" PUBLIC WATER, SEWER, SIDEWALK AND UTILITY EASEMENT = 3' PUBLIC M&U ENT. (ON MAIN ROADS)
 - 4" PUBLIC WATER, SEWER, SIDEWALK AND UTILITY EASEMENT = 4' M&U ENT. (ON CUL-DE-SACS)
 - ALL SEWER HOUSE CONNECTIONS (SHCs) ARE 4" UNLESS LABELED OTHERWISE. SEE LEGEND SHEET 1.
 - ALL WATER HOUSE CONNECTIONS (WHCs) ARE 1/2" UNLESS LABELED OTHERWISE. SEE LEGEND SHEET 1.

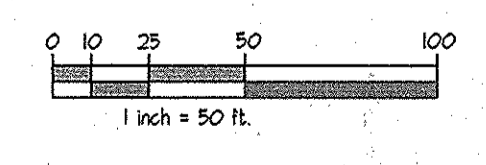

PREPARED FOR:
BEAZER HOMES CORP.
8965 GUILFORD RD., SUITE 290
COLUMBIA, MD 21046
ATTN: BRIAN KNAUFF
410-381-3222

FOR WATER & SEWER PROFILES SEE SHEET 3 & 4

DEPARTMENT OF PUBLIC WORKS
HOWARD COUNTY, MARYLAND

Steve Con
CHIEF, BUREAU OF UTILITIES

DEPARTMENT OF PLANNING AND ZONING
HOWARD COUNTY, MARYLAND

Chad Edick
CHIEF, DEVELOPMENT ENGINEERING DIVISION

5.7.14
DATE


GLW GUTSCHICK LITTLE & WEBER, P.A.
CIVIL ENGINEERS, LAND SURVEYORS, LAND PLANNERS, LANDSCAPE ARCHITECTS
3909 NATIONAL DRIVE - SUITE 250 - BURTONSVILLE OFFICE PARK
BURTONSVILLE, MARYLAND 20886
TEL: 301-421-4024 BAL: 410-880-1820 DC/VA: 301-989-2524 FAX: 301-421-4188

DATE
OCT., 2013

PROFESSIONAL CERTIFICATION
I HEREBY CERTIFY THAT THESE PLANS WERE PREPARED OR APPROVED BY ME, AND THAT I AM A DULY LICENSED PROFESSIONAL ENGINEER UNDER THE LAWS OF THE STATE OF MARYLAND, LICENSE NO. 12975
EXP. DATE: MAY 26, 2014

G.L.W. No.
08052

4/24/14

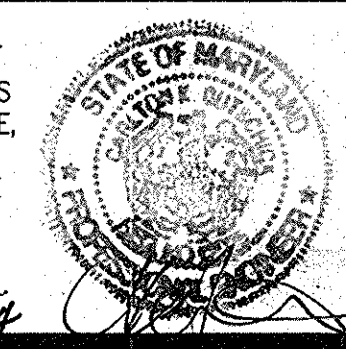

KCE	2	AS-BUILT	1/25/16
AWL	▲	REVISED WATER PER CHANGE TO C900 PVC	03/06/14
BY	NO	REVISION	DATE



WATER and SEWER EXTENSION PLAN

600' SCALE MAP NO. 47
BLOCK NO. 2,3,8&9
ZONING: R-ED


WINCOPIA FARMS
PHASE 5
LOTS 1 THRU 220 &
OPEN SPACE LOTS 221 THRU 256
L 11388 F 725
HOWARD COUNTY, MARYLAND
ELECTION DISTRICT NO. 6
CONTRACT No. 24-4814-D TAX MAP: 47-3

SCALE
1"=50'
SHEET
2 OF 4

L:\CAD\DRAWINGS\08052\FIB-WAT-SEW\FINAL W&S-PLAN 2.dwg, PLOTTED: 4/22/2014, 9:40 AM, LAST SAVED: 4/14/2014, 4:31 PM, PLOTTED BY: Tony Leppert

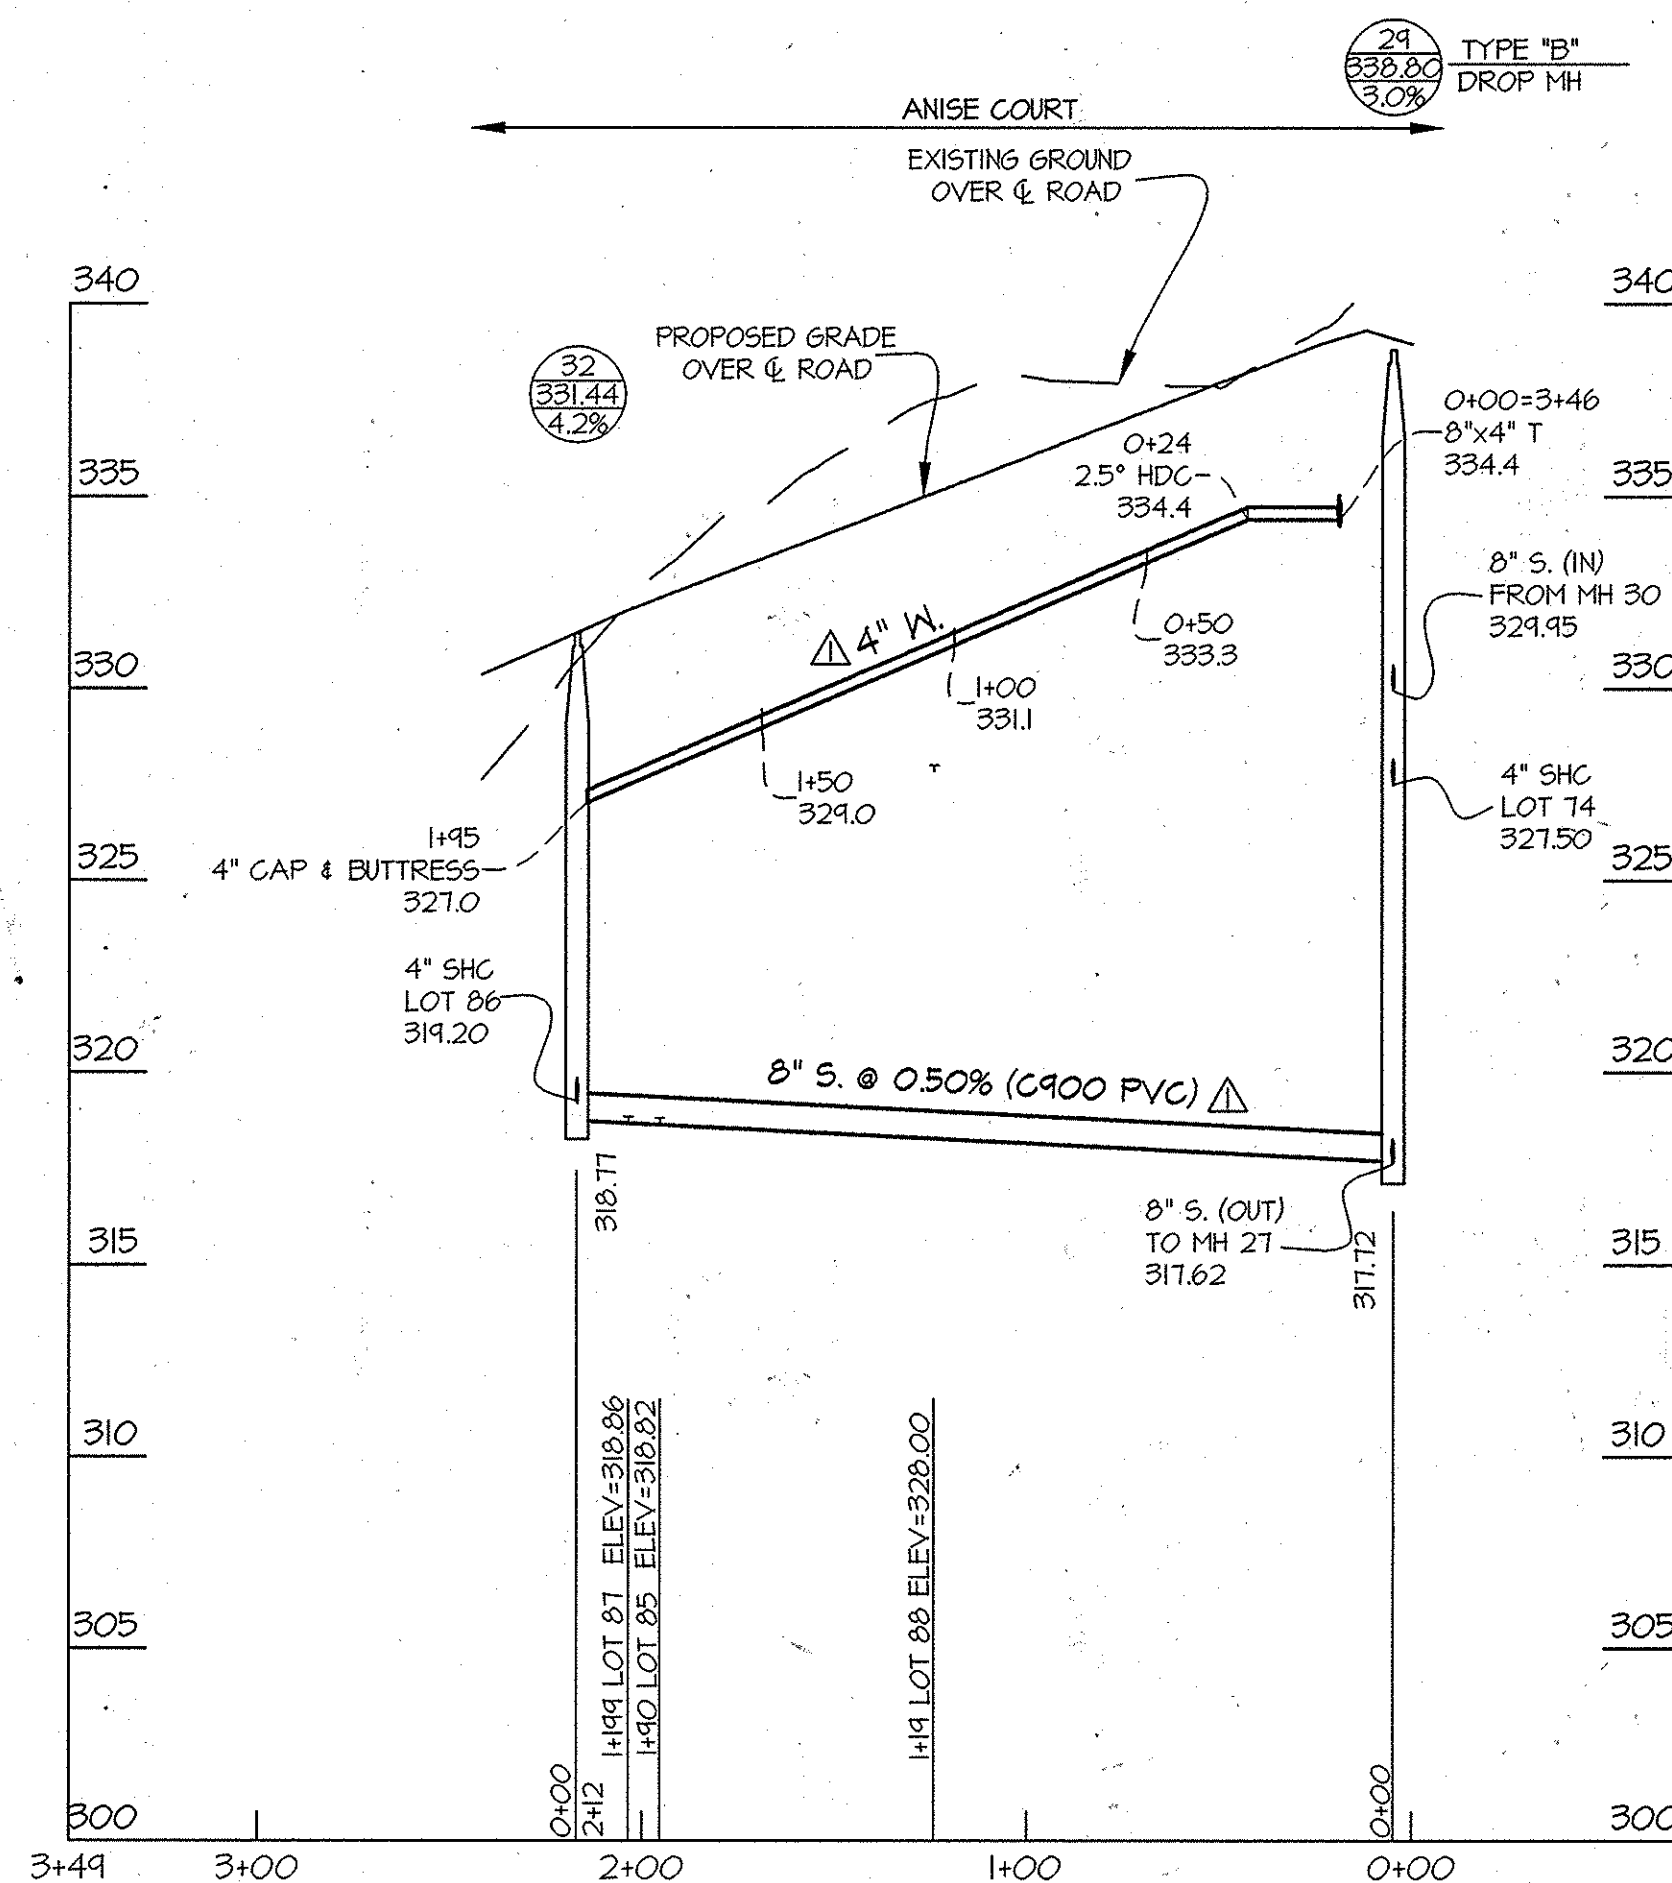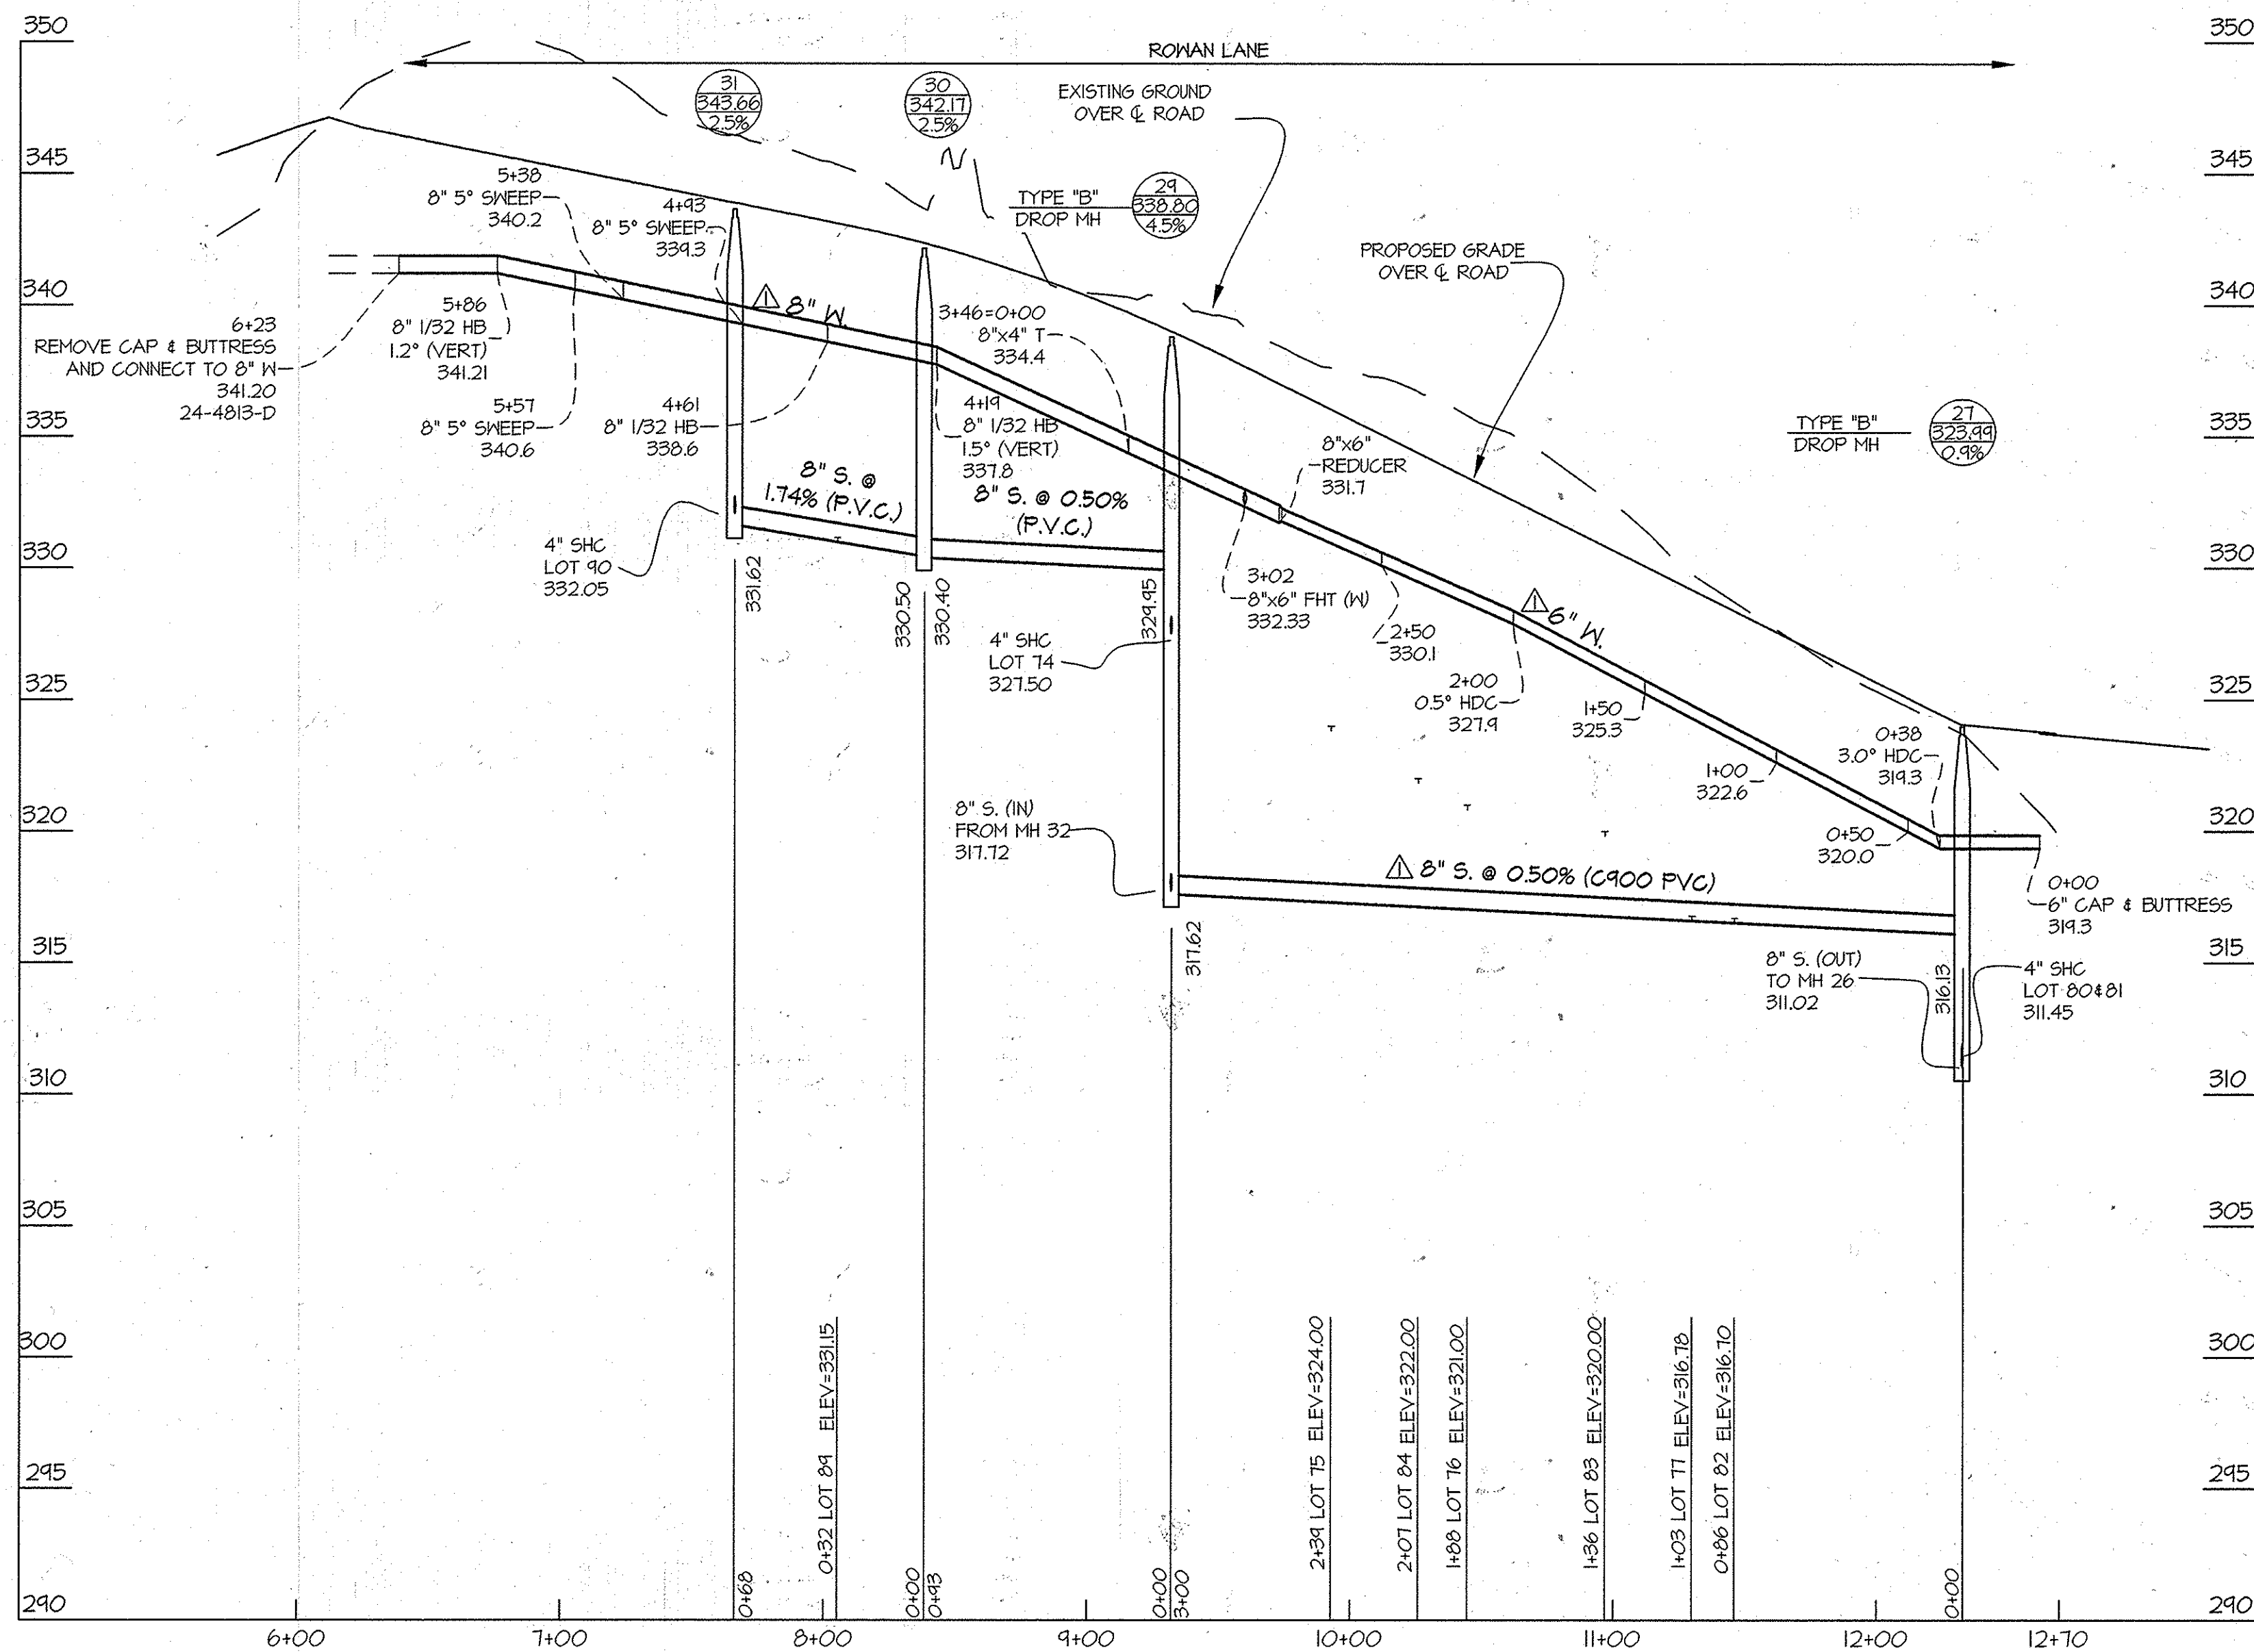

Lot #	From	To	Distance	Remarks
74	INLET	SHC	11.8'	
	SMH	SHC	25.6'	
	SMH	WHC	55.1'	
74	INLET	WHC	25.1'	
	SMH	SHC	45.1'	
	SMH	SHC	62.6'	
75	6\"/>			

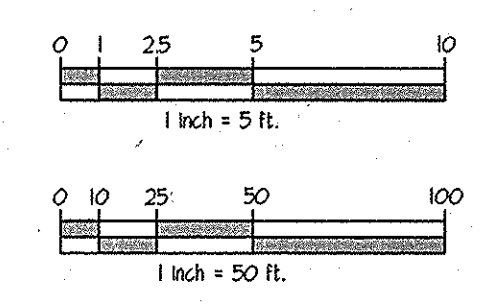


FOR WATER & SEWER PLAN VIEW SEE SHEET 2

PROFILE SCALES:
HOR. 1" = 50'
VERT. 1" = 5'

PREPARED FOR:
BEAZER HOMES CORP.
8965 GUILFORD RD., SUITE 290
COLUMBIA, MD 21046
ATTN: BRIAN KNAUFF
410-381-3222


L:\CADD\DWG\08052\08052-PUB-WAT-SEW\PHAL WKS\PHASE 3\08052-PUB-PROF 3-4.dwg
PLOTTED: 4/22/2014 9:48 AM, LAST SAVED: 4/14/2014 4:32 PM, PLOTTED BY: Tony Loggner

<p>DEPARTMENT OF PUBLIC WORKS HOWARD COUNTY, MARYLAND</p> <p><i>John C. Coan</i> 5/12/14 CHIEF, BUREAU OF UTILITIES</p>	<p>DEPARTMENT OF PLANNING AND ZONING HOWARD COUNTY, MARYLAND</p> <p><i>Paul Blumberg</i> 5.7.14 CHIEF, DEVELOPMENT ENGINEERING DIVISION</p>	<p>GLWGUTSCHICK LITTLE & WEBER, P.A. CIVIL ENGINEERS, LAND SURVEYORS, LAND PLANNERS, LANDSCAPE ARCHITECTS 3909 NATIONAL DRIVE - SUITE 250 - BURTONGVILLE OFFICE PARK BURTONGVILLE, MARYLAND 20868 TEL: 301-421-4024 BALT: 410-880-1820 DC/VA: 301-989-2524 FAX: 301-421-4188</p>	<p>DATE OCT., 2013</p> <p>G.L.W. No. 08052</p>	<p>PROFESSIONAL CERTIFICATION I HEREBY CERTIFY THAT THESE PLANS WERE PREPARED OR APPROVED BY ME, AND THAT I AM A DULY LICENSED PROFESSIONAL ENGINEER UNDER THE LAWS OF THE STATE OF MARYLAND, LICENSE NO. 12975 EXP. DATE: MAY 26, 2014</p> <p><i>4/24/14</i></p>	<table border="1" style="width: 100%; border-collapse: collapse;"> <tr><td>KCI</td><td>3</td><td>AS-BUILT REVISION</td><td>2/21/16</td></tr> <tr><td>KCI</td><td>2</td><td>AS-BUILT</td><td>7/05/16</td></tr> <tr><td>AWL</td><td>Δ</td><td>REVISED WATER TO PVC, REVISED SEW TO C900 PVC</td><td>3/10/14</td></tr> <tr><td>BY</td><td>NO</td><td>REVISION</td><td>DATE</td></tr> </table>	KCI	3	AS-BUILT REVISION	2/21/16	KCI	2	AS-BUILT	7/05/16	AWL	Δ	REVISED WATER TO PVC, REVISED SEW TO C900 PVC	3/10/14	BY	NO	REVISION	DATE	<p style="text-align: center;">WATER and SEWER PROFILES</p> <p>600' SCALE MAP NO. 47 BLOCK NO. 2,3,8&9 ZONING: R-ED</p>	<p style="text-align: center;">WINCOPIA FARMS</p> <p style="text-align: center;">PHASE 5 LOTS 1 THRU 220 & OPEN SPACE LOTS 221 THRU 256 L 11388 F 722 HOWARD COUNTY, MARYLAND ELECTION DISTRICT No. 6 CONTRACT No. 24-4814-D TAX MAP: 47-3</p>	<p>SCALE AS SHOWN</p> <p>SHEET 3 OF 4</p>
KCI	3	AS-BUILT REVISION	2/21/16																					
KCI	2	AS-BUILT	7/05/16																					
AWL	Δ	REVISED WATER TO PVC, REVISED SEW TO C900 PVC	3/10/14																					
BY	NO	REVISION	DATE																					

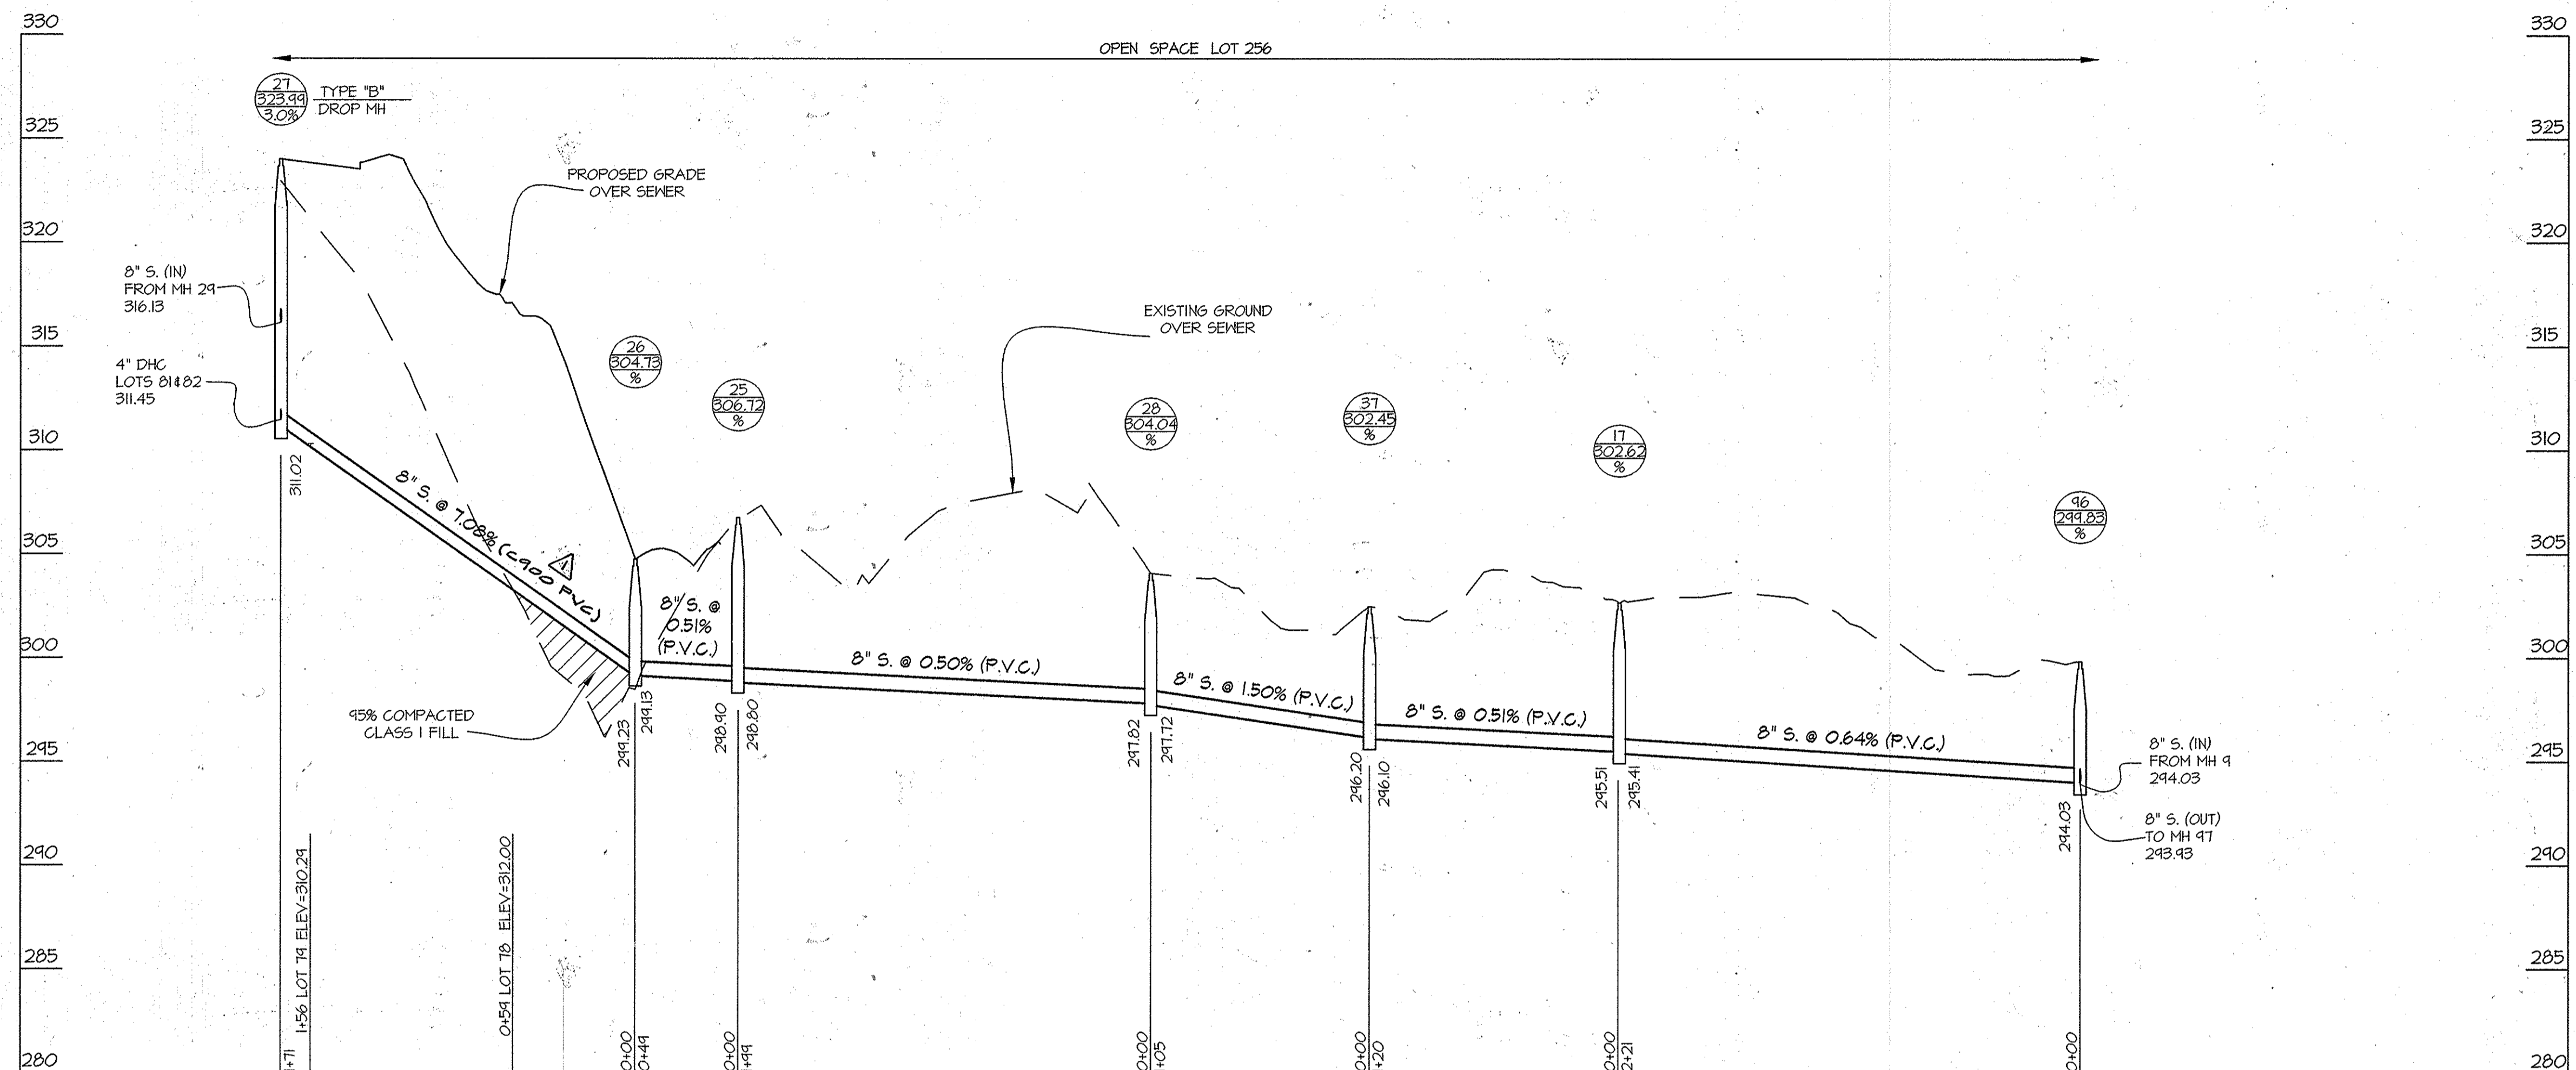

FOR WATER AND SEWER PLAN VIEW SEE SHEET 2

PROFILE SCALES:
 HOR. 1" = 50'
 VERT. 1" = 5'

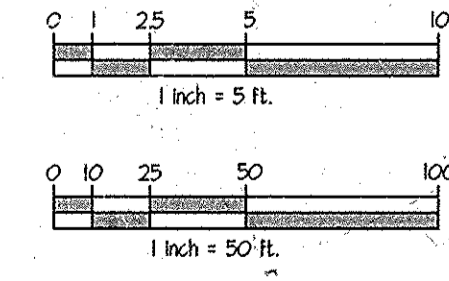

PREPARED FOR:
 BEAZER HOMES CORP.
 8965 GUILFORD RD., SUITE 290
 COLUMBIA, MD 21046
 ATTN: BRIAN KNAUFF
 410-381-3222

L:\CADD\DRAWINGS\08052\PIB-WAT-SEWER\PHASE 5\08052-PIB-PROF 3-4.dwg
 PLOTTED: 10/29/2013 11:26 AM. LAST SAVED: 10/29/2013 7:38 AM. PLOTTED BY: Cirna Tesgaye

DEPARTMENT OF PUBLIC WORKS HOWARD COUNTY, MARYLAND <i>Stefan Gern</i> CHIEF, BUREAU OF UTILITIES	DEPARTMENT OF PLANNING AND ZONING HOWARD COUNTY, MARYLAND <i>Chief Engineer</i> CHIEF, DEVELOPMENT ENGINEERING DIVISION	GLW GUTSCHICK LITTLE & WEBER, P.A. CIVIL ENGINEERS, LAND SURVEYORS, LAND PLANNERS, LANDSCAPE ARCHITECTS 3909 NATIONAL DRIVE - SUITE 200 - BURTONSVILLE OFFICE PARK BURTONSVILLE, MARYLAND 20884 TEL: 301-421-4024 BAL: 410-880-1820 DC/VA: 301-889-2524 FAX: 301-421-4186	DATE OCT., 2013 G.L.W. No. 08052	PROFESSIONAL CERTIFICATION I HEREBY CERTIFY THAT THESE PLANS WERE PREPARED OR APPROVED BY ME, AND THAT I AM A DULY LICENSED PROFESSIONAL ENGINEER UNDER THE LAWS OF THE STATE OF MARYLAND, LICENSE NO. 12975 EXP. DATE: MAY 26, 2014 <i>[Signature]</i>	<table border="1" style="width: 100%; border-collapse: collapse;"> <tr> <td style="width: 5%;">BY</td> <td style="width: 5%;">NO</td> <td style="width: 5%;">REVISION</td> <td style="width: 5%;">DATE</td> </tr> <tr> <td>gt</td> <td>1</td> <td>Revised Sewer to C900 PVC</td> <td>4/16/14</td> </tr> </table>	BY	NO	REVISION	DATE	gt	1	Revised Sewer to C900 PVC	4/16/14	SEWER PROFILE 600' SCALE MAP NO. 47 BLOCK NO. 2,3,8&9 ZONING: R-ED	WINCOPIA FARMS PHASE 5 LOTS 1 THRU 220 & OPEN SPACE LOTS 221 THRU 256 L 11388 E 725 HOWARD COUNTY, MARYLAND ELECTION DISTRICT No. 6 CONTRACT No. 24-4814-D TAX MAP: 47-3	SCALE AS SHOWN SHEET 4 OF 4
BY	NO	REVISION	DATE													
gt	1	Revised Sewer to C900 PVC	4/16/14													