

GENERAL NOTES

- APPROXIMATE LOCATIONS OF EXISTING MAINS ARE SHOWN. THE CONTRACTOR SHALL TAKE ALL NECESSARY PRECAUTIONS TO PROTECT EXISTING MAINS AND SERVICES AND MAINTAIN UNINTERRUPTED SERVICE. ANY DAMAGE INCURRED SHALL BE REPAIRED IMMEDIATELY TO THE SATISFACTION OF THE ENGINEER AT THE CONTRACTOR'S EXPENSE.
- TOPOGRAPHIC FIELD SURVEYS WERE PERFORMED MAY AND AUGUST 2011 BY JMT.
- HORIZONTAL AND VERTICAL SURVEY CONTROLS:
THE COORDINATES SHOWN ON THE DRAWINGS ARE BASED ON MARYLAND STATE REFERENCE SYSTEM NAD 83/91 AS PROJECTED BY HOWARD COUNTY GEODETIC CONTROL STATIONS NO 43BC AND 43BM2. ALL VERTICAL CONTROLS BASED ON NAVD 1988 DATUM.
- ALL PIPE ELEVATIONS SHOWN ARE INVERT (I) ELEVATIONS UNLESS OTHERWISE NOTED ON THE DRAWINGS.
- CLEAR ALL UTILITIES BY A MINIMUM OF 12". CLEAR ALL POLES BY 5'-0" MINIMUM OR TUNNEL AS REQUIRED UNLESS OTHERWISE NOTED. THE OWNER HAS CONTACTED THE UTILITY COMPANIES AND HAS MADE ARRANGEMENTS FOR BRACING OF POLES AS SHOWN ON THE DRAWINGS. IN THE EVENT THE CONTRACTOR'S WORK REQUIRES THE BRACING OF ADDITIONAL POLES, ANY COST INCURRED BY THE OWNER FOR BRACING OF ADDITIONAL POLES OR DAMAGES SHALL BE DEDUCTED FROM MONEY OWED THE CONTRACTOR. THE CONTRACTOR SHALL COORDINATE WITH THE UTILITY COMPANIES TO SCHEDULE THE BRACING OF THE POLES.
- FOR DETAILS NOT SHOWN ON THE DRAWINGS, AND FOR MATERIALS AND CONSTRUCTION METHODS, USE HOWARD COUNTY DESIGN MANUAL, VOLUME IV, STANDARD SPECIFICATIONS AND DETAILS FOR CONSTRUCTION (LATEST EDITION). THE CONTRACTOR SHALL HAVE A COPY OF VOLUME IV ON THE JOB.
- WHERE TEST PITS HAVE BEEN MADE ON THE EXISTING UTILITIES, THEY ARE NOTED BY THE SYMBOL [] AT THE LOCATION OF THE TEST PIT. A NOTE OR NOTES CONTAINING THE RESULTS OF THE TEST PIT OR PITS IS INCLUDED ON THE DRAWINGS. EXISTING UTILITIES IN THE VICINITY OF THE PROPOSED WORK FOR WHICH TEST PITS HAVE NOT BEEN DUG SHALL BE LOCATED BY THE CONTRACTOR 2 WEEKS IN ADVANCE OF CONSTRUCTION OPERATIONS AT HIS OWN EXPENSE.
- CONTRACTOR SHALL NOTIFY THE FOLLOWING UTILITY COMPANIES OR AGENCIES AT LEAST 5 WORKING DAYS BEFORE STARTING WORK SHOWN ON THESE DRAWINGS:
 AT&T 1-800-252-1133
 B&E (CONSTRUCTION SERVICES)..... 1410-637-8713
 B&E (EMERGENCY)..... 410-685-0123
 BUREAU OF UTILITIES (DPW)..... 410-313-4900
 COLONIAL PIPELINE CO..... 410-795-1390
 MISS UTILITY..... 1-800-257-7777
 STATE HIGHWAY ADMINISTRATION..... 410-531-5533
 VERIZON..... 1-800-743-0033
- TREES AND SHRUBS ARE TO BE PROTECTED FROM DAMAGE TO THE MAXIMUM EXTENT. TREES AND SHRUBS LOCATED WITHIN THE CONSTRUCTION STRIP ARE NOT TO BE REMOVED OR DAMAGED BY THE CONTRACTOR.
- THE CONTRACTOR SHALL REMOVE TREES, STUMPS AND ROOTS ALONG LINE OR EXCAVATION. PAYMENT FOR SUCH REMOVAL SHALL BE INCLUDED IN THE UNIT PRICE BID FOR CONSTRUCTION OF THE MAIN.
- THE CONTRACTOR SHALL NOTIFY THE BUREAU OF HIGHWAYS, HOWARD COUNTY, AT 410-313-7450 AT LEAST 5 WORKING DAYS BEFORE ANY OPEN CUT OR BORING/JACKING OF ANY COUNTY ROAD FOR LAYING WATER/SEWER MAINS OR HOUSE CONNECTIONS. THE APPROVAL OR THESE DRAWINGS WILL CONSTITUTE COMPLIANCE WITH DPW REQUIREMENTS PER SECTION 18.114(g) OF THE HOWARD COUNTY CODE.
- FOR ROAD WIDENING AND RELOCATION, SEDIMENT CONTROLS, AND TRAFFIC CONTROLS, REFER TO CAPITAL PROJECT NO. J-4206-1A DRAWINGS.

WATER NOTES


- ALL WATER MAINS SHALL BE PVC C900 UNLESS OTHERWISE APPROVED. FOR CORROSION CONTROL NOTES, SEE SHEET 2.
- TOP OF WATER MAINS SHALL HAVE A MINIMUM 4'-0" OF COVER UNLESS OTHERWISE NOTED.
- VALVES ADJACENT TO TEES SHALL BE STRAPPED TO TEES.
- ALL FITTINGS SHALL BE BUTTRESSED OR ANCHORED WITH CONCRETE IN ACCORDANCE WITH STANDARD DETAILS UNLESS OTHERWISE PROVIDED FOR ON THE DRAWINGS.
- FIRE HYDRANTS SHALL BE SET TO THE BURY LINE ELEVATIONS SHOWN ON THE DRAWINGS. ALL FIRE HYDRANTS SHALL BE INSTALLED IN ACCORDANCE WITH STANDARD DETAILS. THE SOIL AROUND THE FIRE HYDRANT SHALL BE COMPACTED IN ACCORDANCE WITH SECTIONS 1000 AND 1005 OF THE STANDARD DETAIL.
- THE CONTRACTOR SHALL NOT OPERATE ANY WATER MAIN VALVES ON THE EXISTING WATER SYSTEM.
- TRACER WIRES AND CONTINUITY TEST STATIONS SHALL BE INSTALLED ON ALL DIP AND PVC WATER MAINS IN ACCORDANCE WITH THE HOWARD COUNTY DESIGN MANUAL.
- FOR PVC WATER MAINS, ALL RECORDS FOR THE QUALITY CONTROL AND QUALIFICATION TEST REQUIREMENTS NOTED IN SECTION 5.1 OF THE AWWA STANDARD C900 FOR PVC PRESSURE PIPE SHALL BE SUBMITTED WITH THE PIPE MATERIAL CERTIFICATION OR SHOP DRAWING PRIOR TO APPROVAL OF THE MATERIAL FOR USE. THE TEST RECORDS SHALL BE FOR THE PIPE TO BE INSTALLED UNDER THIS CONTRACT. ALL PVC PIPE SHALL CONTAIN MARKINGS TO ALLOW CROSS REFERENCING OF THE PIPE SUPPLIED TO THE TEST RECORDS RECEIVED.
- UNLESS OTHERWISE NOTED ON THE PLANS OR IN THE SPECIFICATIONS SACRIFICIAL ANODES SHALL BE INSTALLED ON ALL VALVES AND METALLIC FITTINGS USED WITH PVC WATER MAINS IN ACCORDANCE WITH VOLUME IV, STANDARD SPECIFICATIONS AND DETAILS FOR CONSTRUCTION. SEVENTEEN (17) POUND MAGNESIUM ANODES SHALL BE INSTALLED ON ALL VALVES AND DUCTILE IRON FITTINGS INCLUDING RESTRAINTS AND HARNESSSES. TWELVE (12) POUND ZINC ANODES SHALL BE INSTALLED ON ALL STAINLESS STEEL FITTINGS AND SADDLES USED WITH PVC MAINS. ALL "TEES" USED WITH PVC MAINS SHALL BE DUCTILE IRON.
- PROPER ASSEMBLY OF GASKETED PVC PIPE JOINTS: THE MANUFACTURER'S INSERTION LINE OF GASKETED PVC PIPE JOINTS INDICATES THE MAXIMUM DEPTH OF INSERTION OF THE SPIGOT INTO THE BELL. AFTER ASSEMBLY OF THE JOINT, THE INSERTION LINE SHALL REMAIN VISIBLE. DUAL INSERTION LINES ON GASKETED PVC PIPE INDICATE THE MAXIMUM AND MINIMUM DEPTH OF INSERTION OF THE SPIGOT INTO THE BELL. THE CONTRACTOR SHALL NOT OVER INSERT OR OVER HOME THE SPIGOT INTO THE BELL OF PVC PIPE.
- ALL CHANGES IN HORIZONTAL OR VERTICAL DIRECTION OF PVC WATER PIPE SHALL BE MADE WITH STANDARD BENDS, 5-DEGREE SWEEPS OR HIGH DEFLECTION (HD) COUPLINGS. NO BENDING OF THE PIPE OR DEFLECTING OF PVC PIPE JOINTS IS PERMITTED. WHERE HIGH DEFLECTION COUPLINGS OR 5-DEGREE SWEEPS ARE PERMITTED, THE CONTRACTOR SHALL PROVIDE ONE FULL PIPE LENGTH (20-FOOT LONG) ON EITHER SIDE OF THE HIGH DEFLECTION COUPLING OR 5-DEGREE SWEEP. THE CONTRACTOR SHALL USE A VIBRATORY PLATE COMPACTOR OR OTHER APPROVED MEANS TO THOROUGHLY COMPACT THE #57 STONE ON BOTH SIDES OF THE HIGH DEFLECTION COUPLING OR 5-DEGREE SWEEP, TAKING CARE NOT TO USE COMPACTION EQUIPMENT DIRECTLY OVER THE FITTING.

 PVC HIGH DEFLECTION COUPLINGS SHALL BE LIMITED TO A TOTAL DEFLECTION OF 3-DEGREES (1/2-DEGREE ON EITHER END OF THE COUPLING). SHALL BE RATED FOR A MINIMUM 200 PSI MEETING THE REQUIREMENTS OF AWWA C900, SHALL HAVE A MINIMUM LAY LENGTH OF 9-INCHES AND SHALL HAVE CENTER STOPS. PVC HIGH DEFLECTION COUPLINGS SHALL BE CERTAINTED PVC HIGH DEFLECTION (HD) STOP COUPLINGS OR EQUAL.


 FIVE DEGREE SWEEPS SHALL BE BELL BY SPIGOT, RATED FOR A MINIMUM 225 PSI, DR18 MEETING THE REQUIREMENTS OF AWWA C900 AND SHALL BE MULTIFITTINGS (PEX) BLUE BRUTE DR18 OR EQUAL.
- WHEN PVC HIGH DEFLECTION COUPLINGS OR PVC 5-DEGREE SWEEPS ARE USED TO FACILITATE CHANGES IN HORIZONTAL OR VERTICAL ALIGNMENTS OF AWWA C-900 PVC PIPELINES, THE CONTRACTOR SHALL INSTALL DEVICES FOR THE PREVENTION OF OVER-INSERTION OF THE PVC PIPE SPIGOTS OR PLAIN ENDS INTO THE PUSH ON BELL JOINT ON BOTH SIDES OF THE HIGH DEFLECTION COUPLINGS AND 5 DEGREE SWEEPS. BELL STOPS SHALL BE PLACED AT THE PROPER INSERTION LINE FOR THE FITTING. THE BELL STOP SHALL BE MANUFACTURED OF DUCTILE IRON AND INCORPORATE AN EXPANSION RETENTION SPRING TO ALLOW FOR PIPE EXPANSION AND CONTRACTION. THE BELL STOPS SHALL BE SERIES 5000 MEGA-STOP, AS MANUFACTURED BY EBAA IRON, INC. OR APPROVED EQUAL.

RELOCATED MONTEVIDEO ROAD WATER AND SEWER PLANS PHASE 1, SEGMENT A HOWARD COUNTY, MARYLAND

DEPARTMENT OF PUBLIC WORKS
CAPITAL PROJECT NO. W8248
CONTRACT NO. 14-4852

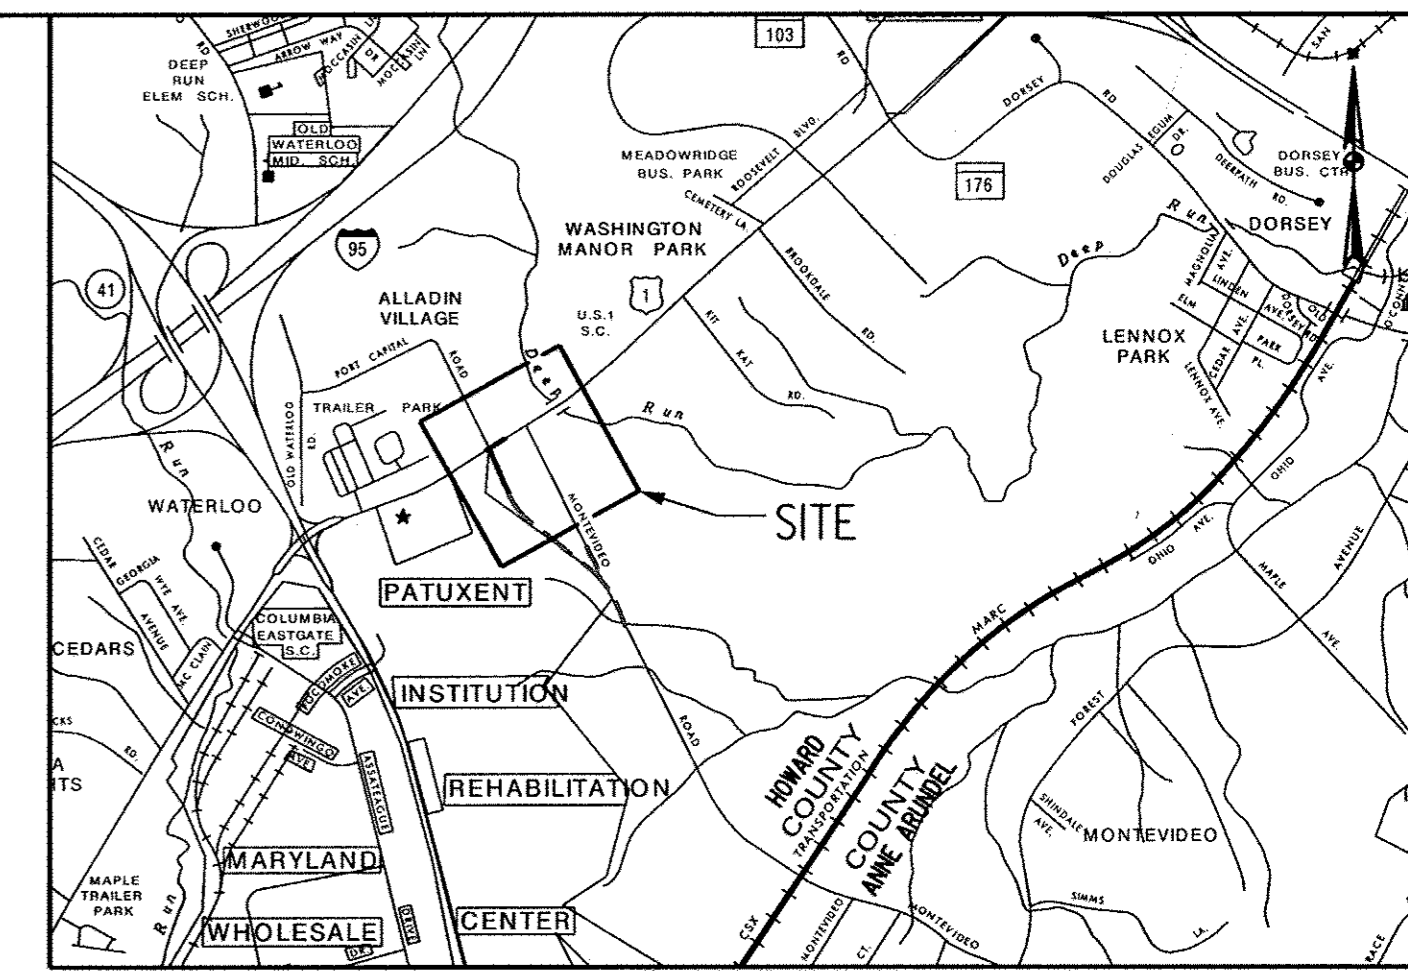



VICINITY MAP
SCALE 1" = 2000'

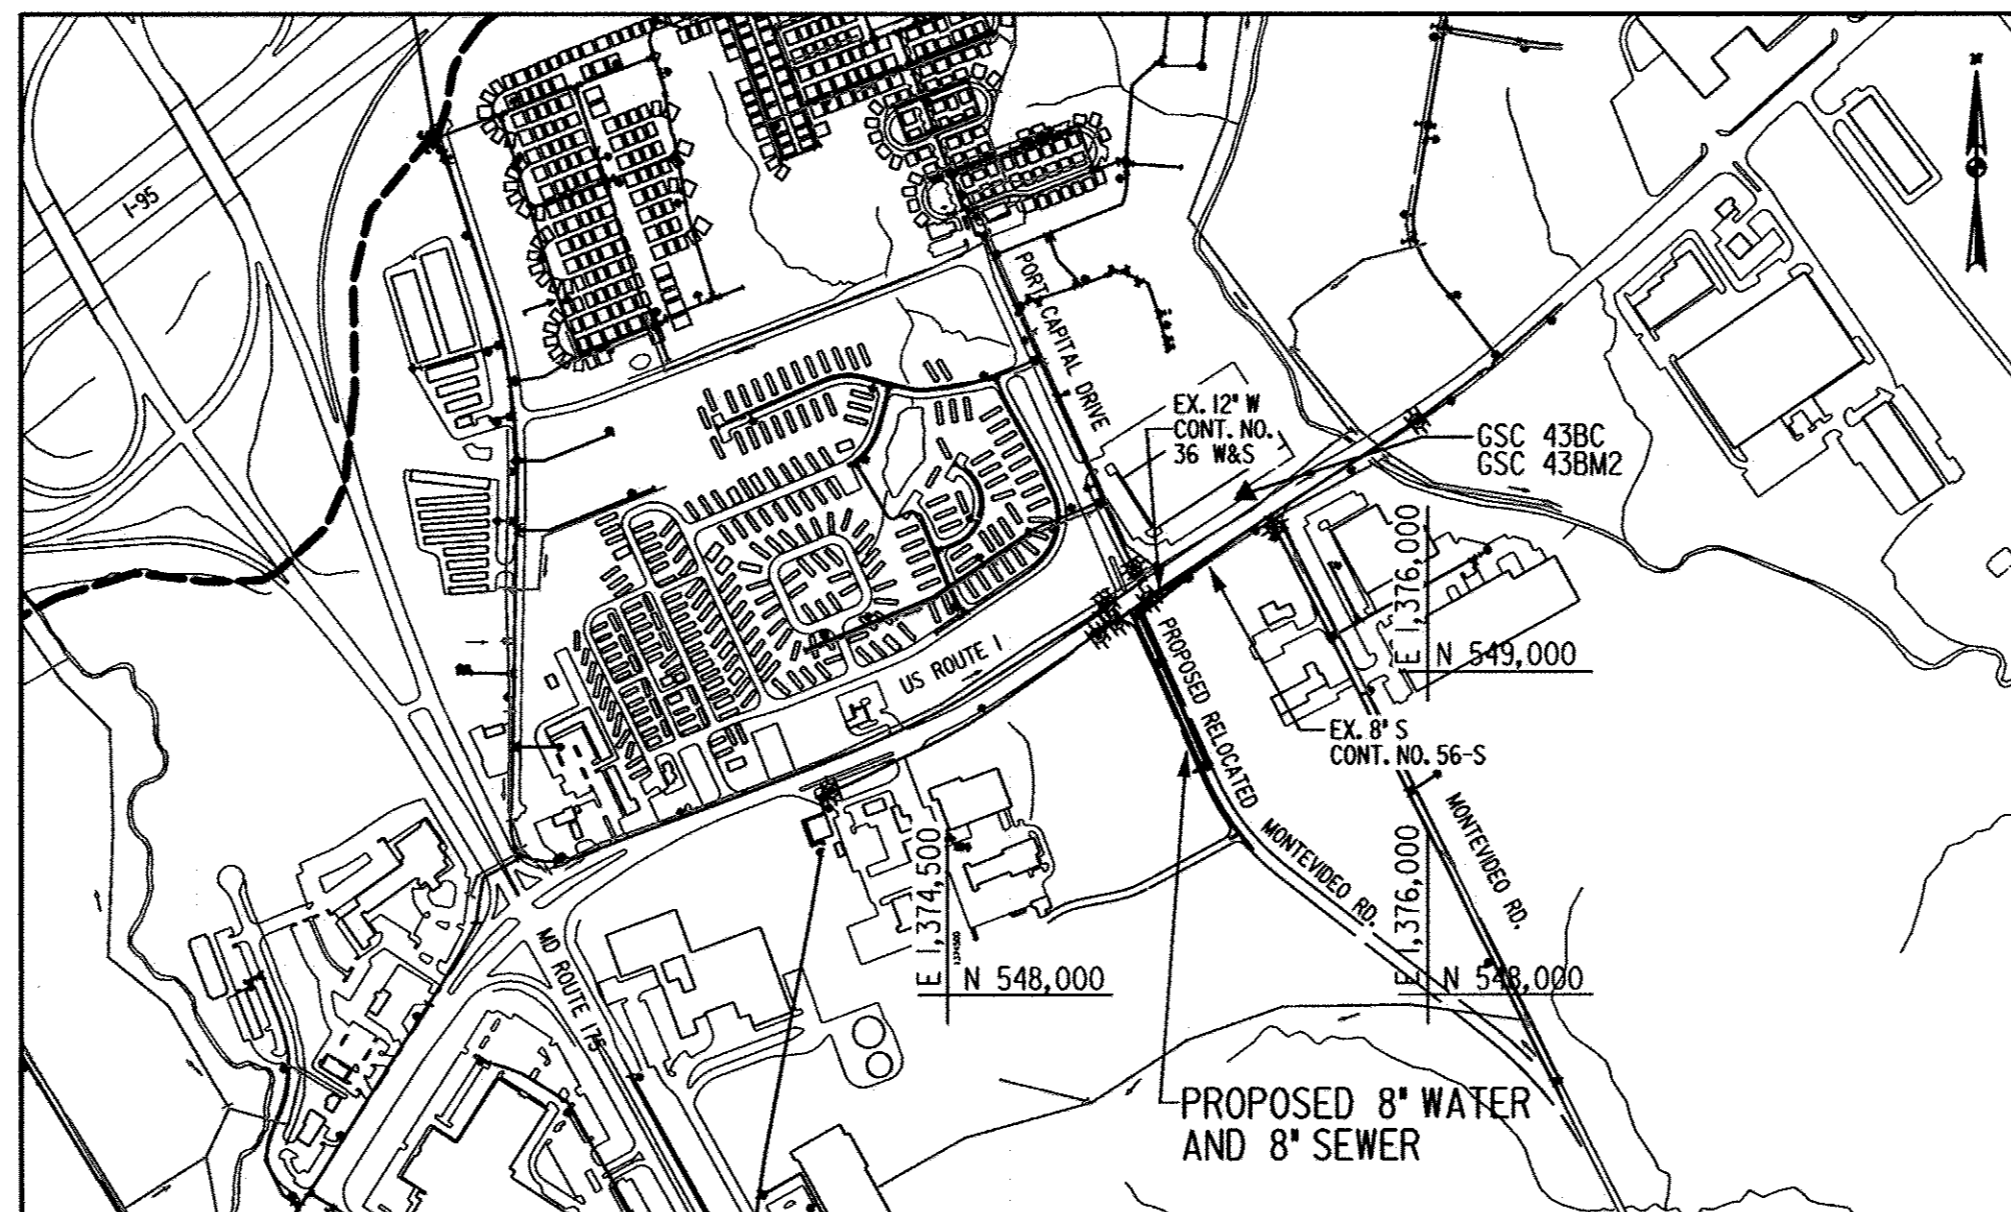

LOCATION MAP
SCALE: 1" = 600'

TYPE OF BUILDING:	COMMERCIAL
NUMBER OF HOUSE CONNECTIONS:	1 WHC and 1 SHC
DRAINAGE AREA:	PATAPSCO
PRESSURE ZONE:	400
WATER TEST PRESSURE:	150 PSI

HORIZONTAL AND VERTICAL CONTROL BASED ON MARYLAND NAD 1983/1991 AND NAVD 1988 DATUM. HOWARD COUNTY GEODETIC SURVEY CONTROL NUMBERS:	
HOWARD COUNTY MONUMENTS	
GSC 43BC (Horiz. & Vert.)	GSC 43BM2 (Horiz. & Vert.)
N 549,592.108	N 549,600.000
E 1,375,466.624	E 1,375,500.000
ELEV. 214.063	ELEV. 193.599

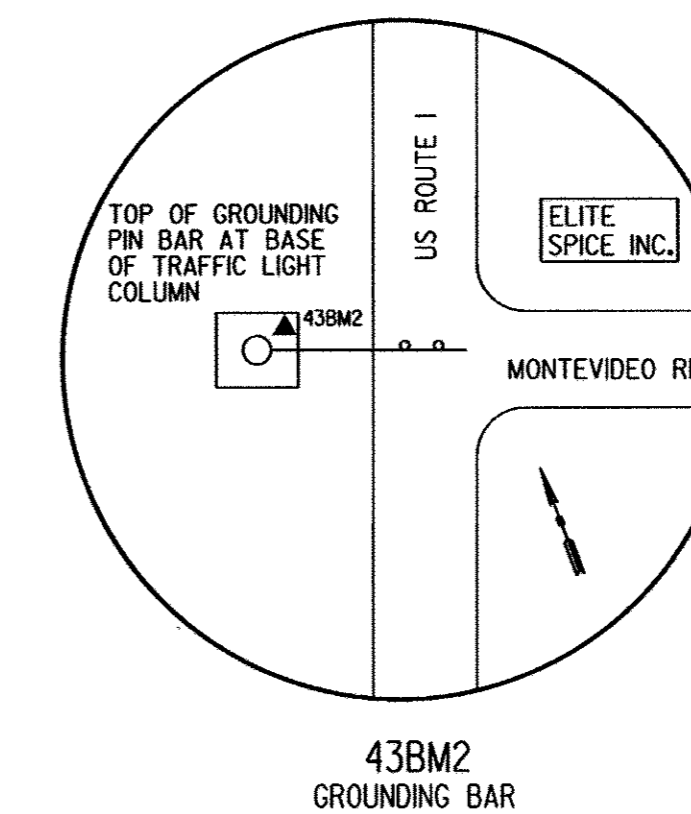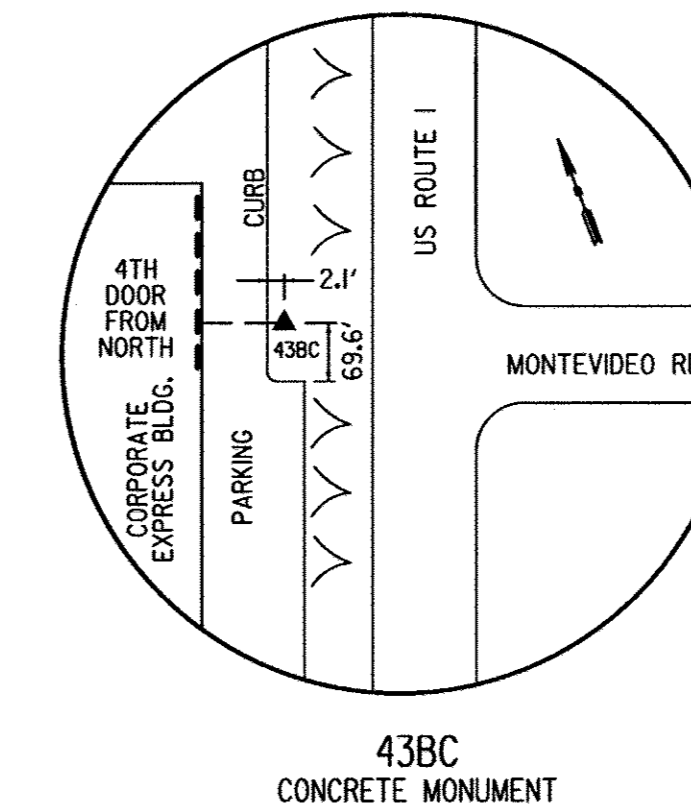

INDEX OF SHEETS	
SHEET NO.	DESCRIPTION
1	TITLE SHEET
2	PLAN
3	PROFILES

QUANTITIES				
ITEM	UNIT	ESTIMATE	AS-BUILT	MATERIAL SUPPLIER
8" W PVC	L.F.	420	425	C-900 NORTH AMERICAN PIPE
6" W PVC	L.F.	40	42	C-900 NORTH AMERICAN PIPE
6" W PVC (FH)	L.F.	46	45	DIP US PIPE
12"X8" TS&V	EA.	1	1	FORD METER BOX
8" II.25 BEND	EA.	3	1	SIGMA
FIRE HYDRANT	EA.	2	2	KENNEDY VALVE
8"X6" TEE (FH)	EA.	2	2	SIGMA
8" VALVE (FH) & SERVICE	EA.	2	3	KENNEDY VALVE
8" VALVE	EA.	1	1	KENNEDY VALVE
8" CAP	EA.	1	1	SIGMA
8" X 6" TEE SERVICE	EA.	1	1	SIGMA
8" S PVC	L.F.	705	706	SDR 35 NORTH AMERICAN PIPE
6" S PVC	L.F.	25	27	SDR 35 NORTH AMERICAN PIPE
24" FRAME & COVER	EA.	4	4	EJ GROUP
4 FT. PRECAST MH	V.F.	50	50	CONTRACTORS PRECAST CORP.
NAME OF UTILITY CONTRACTOR:				S. E. H.
				AS-BUILT DATE: 9-14-2017

SEWER NOTES

- ALL SEWER MAINS SHALL BE P.V.C. UNLESS OTHERWISE NOTED.
- ALL MANHOLES SHALL BE 4'-0" INSIDE DIAMETER UNLESS OTHERWISE NOTED.

LEGEND

FENCE LINE	— X — X —	PROPOSED SEWER MAIN	— ○ —
RIGHT OF WAY LINE	— — — — —	PROPOSED WATER MAIN	— — — — —
PROPERTY LINE	— — — — —	PROPOSED WATER VALVE	— ⊕ —
LIMIT OF DISTURBANCE	— LOD —	PROPOSED FIRE HYDRANT	— ⊕ —
WATER	— — W — —	PROPOSED WATER CAP	— W —
GAS	— — G — —	EX. WATER VALVE	— ⊕ —
SAN. SEWER	— — SAN — —	EX. FIRE HYDRANT	— ⊕ —
UG ELECTRIC	— — E — —	EX. WATER METER	— ⊕ —
UG TELEPHONE	— — T — —	PROP. STORM DRAIN PIPE (CAPITAL PROJECT NO. J-4206-1A)	— — — — —
UTILITY POLE	— ⊙ —		
TRAVERSE POINT	— △ —		

PROFESSIONAL CERTIFICATION: I HEREBY CERTIFY THAT THESE DOCUMENTS WERE PREPARED OR APPROVED BY ME, AND THAT I AM A DULY LICENSED PROFESSIONAL ENGINEER UNDER THE LAWS OF THE STATE OF MARYLAND, LICENSE NO. 25830, EXPIRATION DATE: 02/05/2017.

FILE: 03.S10.08088-00_MonteVideo_Road_CAD/2017/04/100_MonteVideo-14-01.dwg DATE: Monday, March 07, 2016 AT 12:59 PM 12/25 PM


DEPARTMENT OF PUBLIC WORKS
HOWARD COUNTY, MARYLAND

Ray H. ... 3/16/16
DIRECTOR OF PUBLIC WORKS

Thomas E. ... 3/16/16
CHIEF, BUREAU OF ENGINEERING

... 3/16/16
CHIEF, UTILITY DESIGN DIVISION

JMT
JOHNSON, MIRMIRAN & THOMPSON
Engineering A Brighter Future®
72 Loveton Circle Baltimore, Maryland 21152-0949

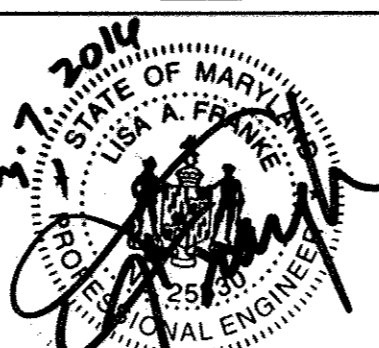


DES:	RAF	AS-BUILT 9-14-2017
DRN:	RAF	
CHK:	LAF	
DATE:	3/7/2016	
BY	NO.	
DATE	600' SCALE MAP NO. 43	BLOCK NO. 9

TITLE SHEET


RELOCATED MONTEVIDEO ROAD
WATER AND SEWER PLANS
PHASE 1, SEGMENT A
CAPITAL PROJECT NO. W8248
CONTRACT NO. 14-4852
ELECTION DISTRICT 2
HOWARD COUNTY, MARYLAND

UT-1 OF 3
SCALE AS SHOWN
SHEET 1 OF 3

AS-BUILT 9-14-2017

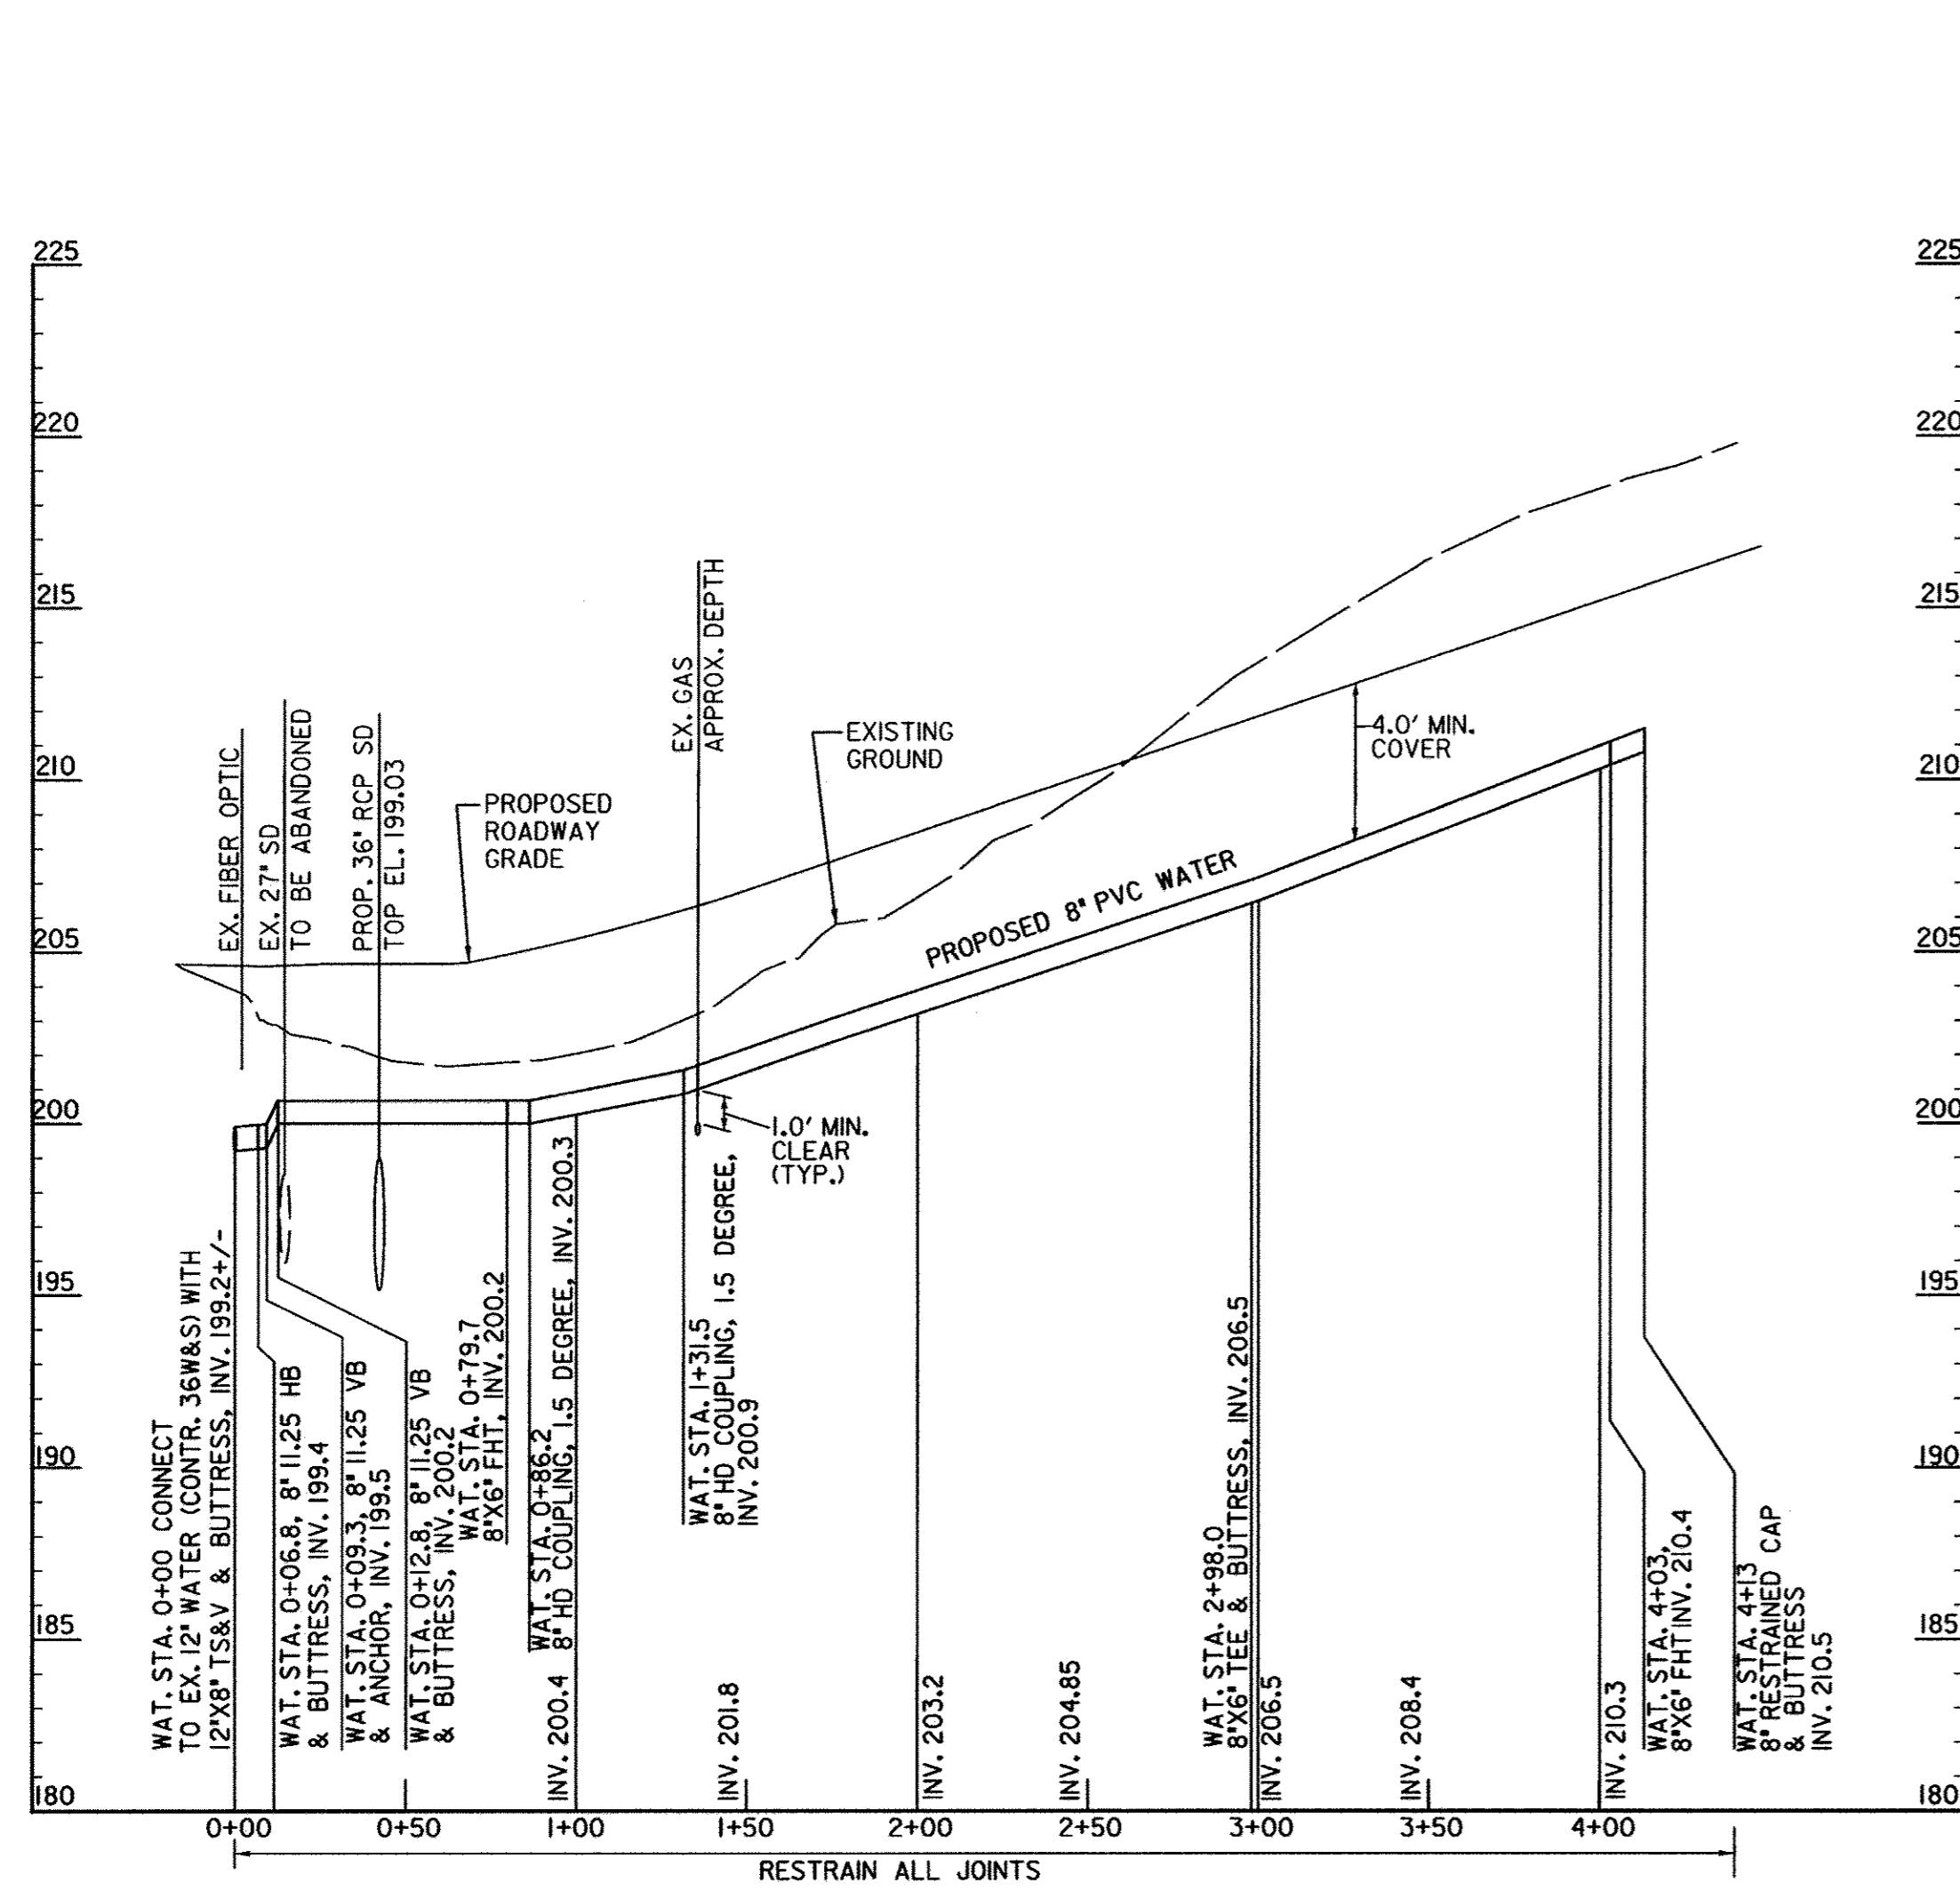

WATER PROFILE
 SCALE: HORIZONTAL 1"=50'
 VERTICAL 1"=5'

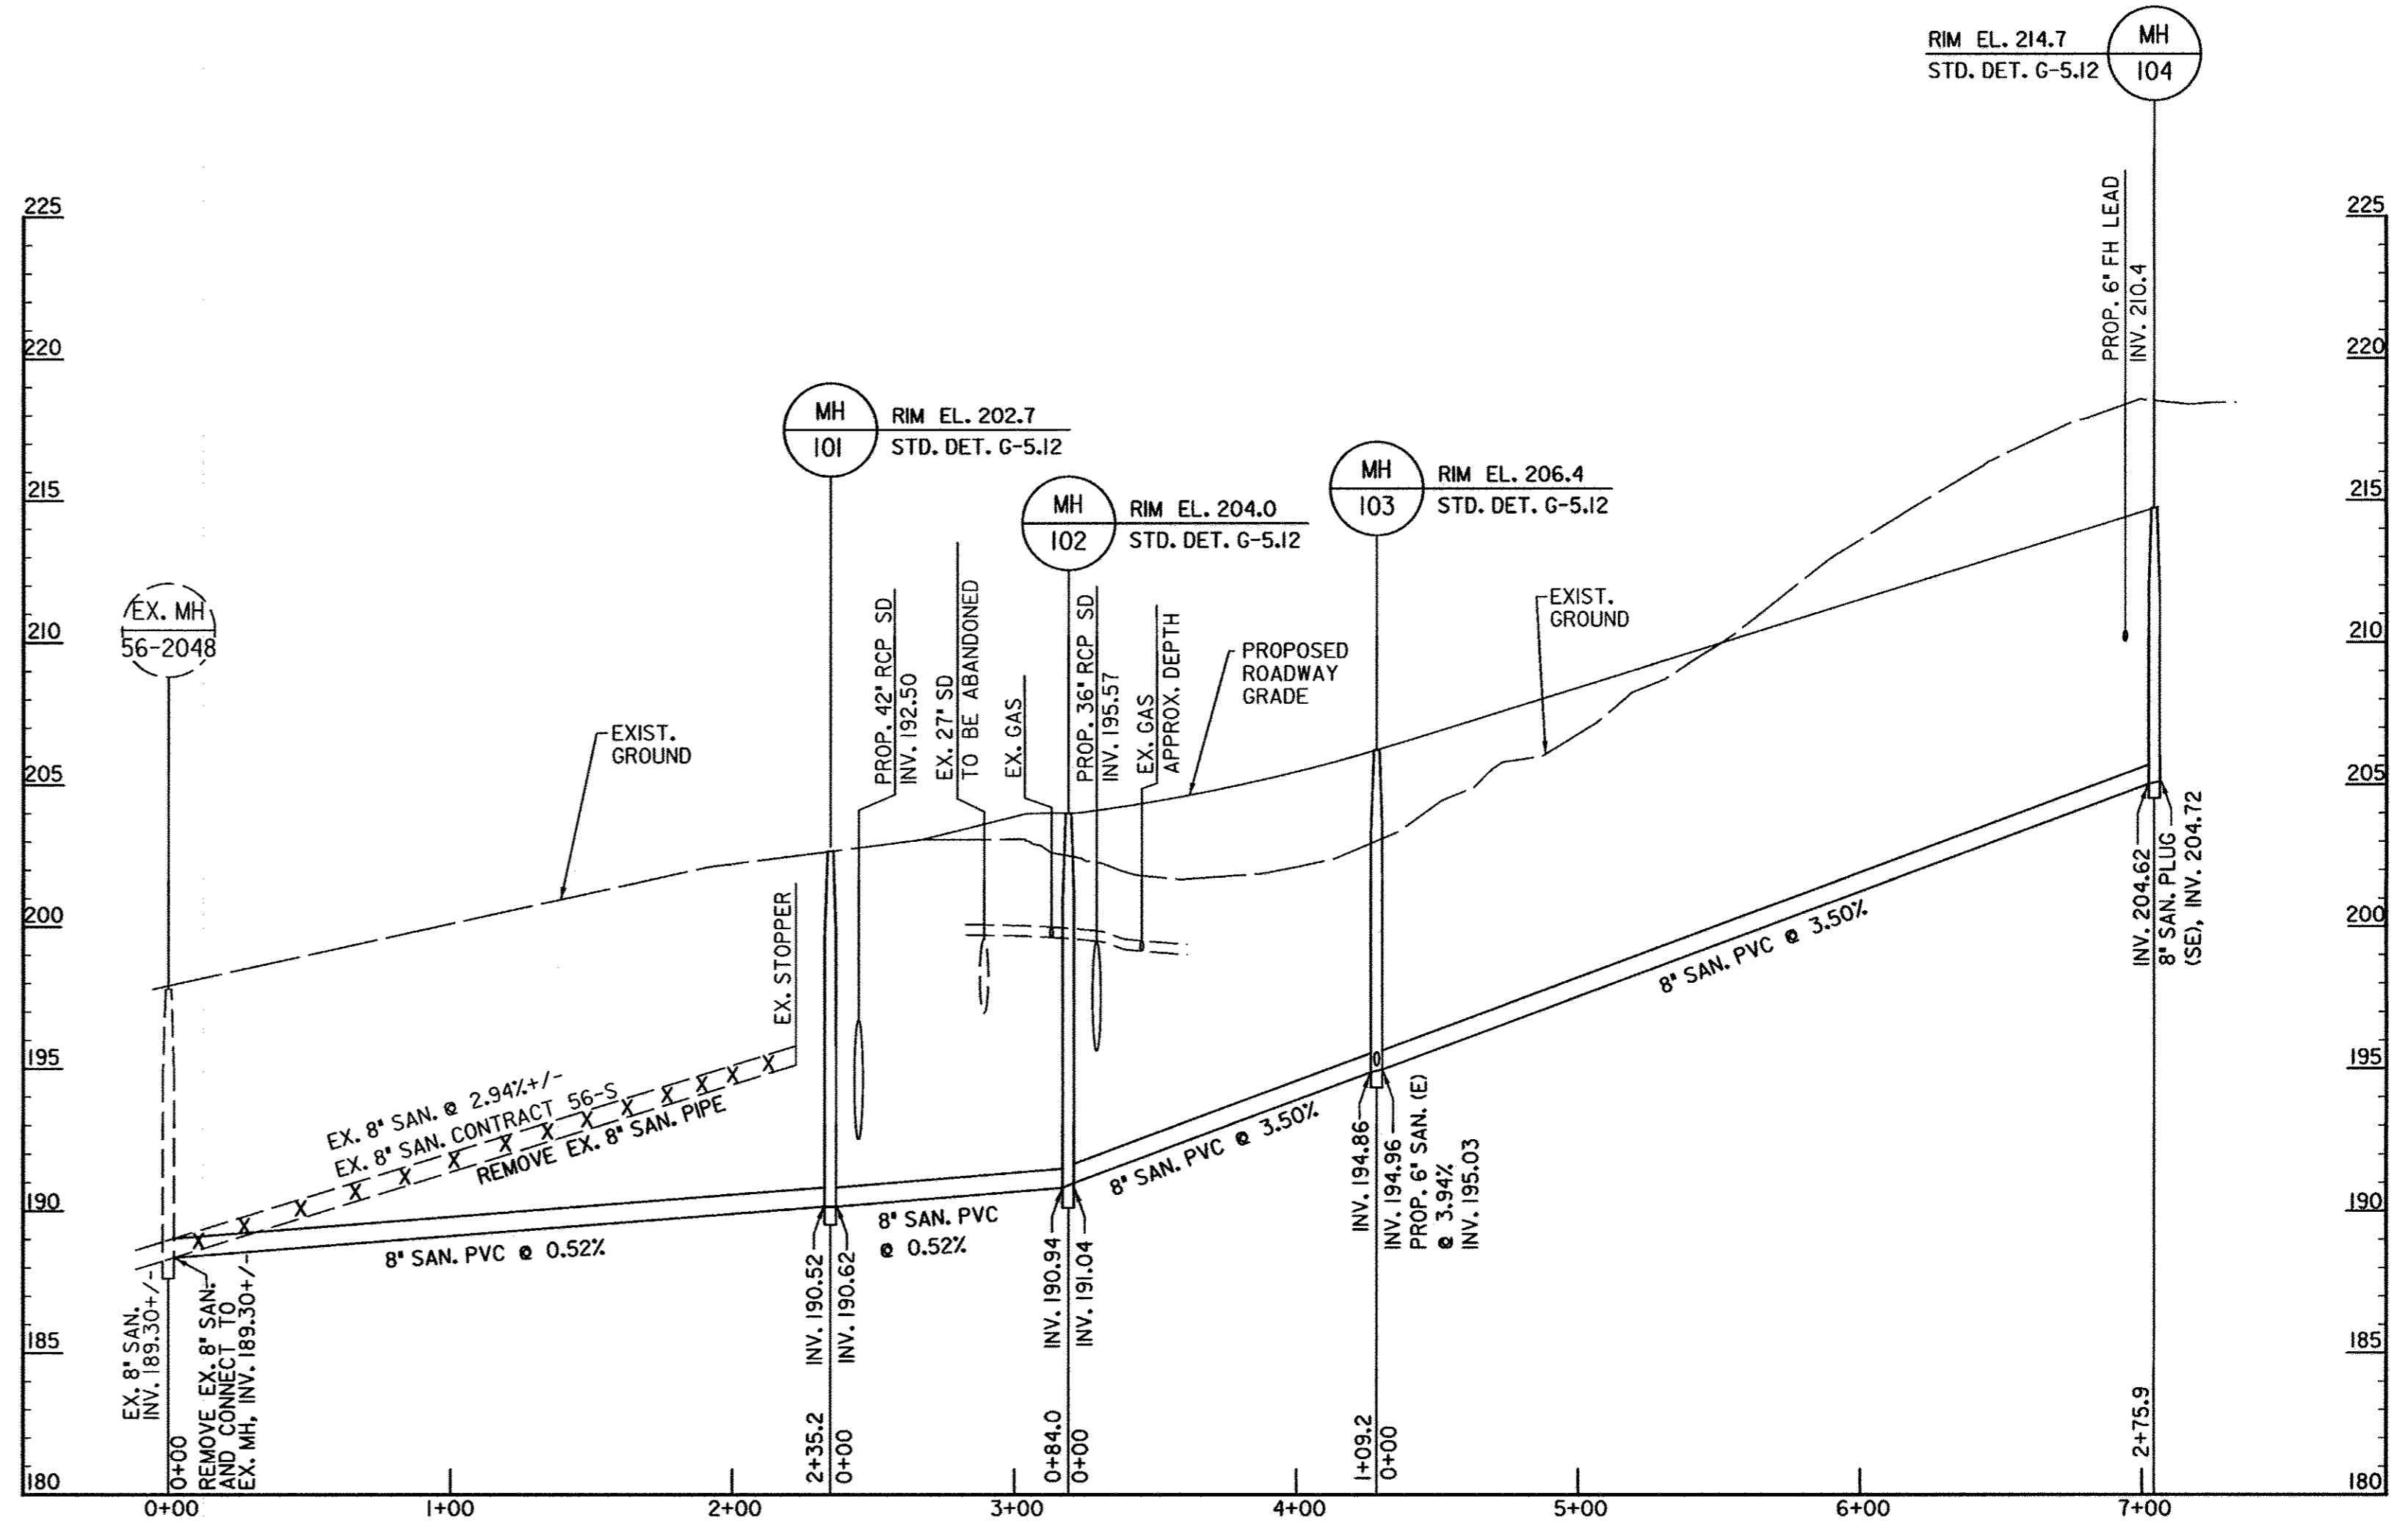

SEWER PROFILE
 SCALE: HORIZONTAL 1"=50'
 VERTICAL 1"=5'


PROFESSIONAL CERTIFICATION: I HEREBY CERTIFY THAT THESE DOCUMENTS WERE PREPARED OR APPROVED BY ME, AND THAT I AM A DULY LICENSED PROFESSIONAL ENGINEER UNDER THE LAWS OF THE STATE OF MARYLAND, LICENSE NO. 25830, EXPIRATION DATE: 02/05/2017.

G:\S\040848-00\Montevideo_Road_CAD\011-1000_Montevideo-14.dgn FILE: Monday, March 07, 2017 AT 11:22 AM

DEPARTMENT OF PUBLIC WORKS
 HOWARD COUNTY, MARYLAND

James P. Butler 3/16/16
 DIRECTOR OF PUBLIC WORKS
John K. Wilby Jr. 3/16/16
 CHIEF, BUREAU OF UTILITIES

James P. Butler 3/16/16
 CHIEF, BUREAU OF ENGINEERING
John K. Wilby Jr. 3/16/16
 CHIEF, UTILITY DESIGN DIVISION

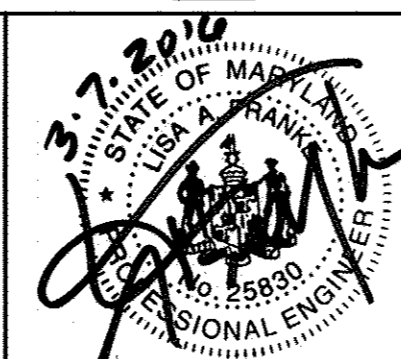

DES:	RAF		
DRN:	RAF		AS-BUILT 9-14-2017
CHK:	LAF		
DATE:	3/7/2016	BY:	NO.

PROFILES

DATE: 600' SCALE MAP NO. 43 BLOCK NO. 9

RELOCATED MONTEVIDEO ROAD WATER AND SEWER PLANS PHASE I, SEGMENT A

CAPITAL PROJECT No. W8248
 CONTRACT No. 14-4852

ELECTION DISTRICT 2

HOWARD COUNTY, MARYLAND