


L1400 DRAWINGS\1301\PLANS\BY GAWIN\FINALS\PHASE 3\PHASE 3A\301-1-PH3A-L-TRIALS-W5-KEY MAP.dwg
PICTED BY: GAWIN DATE: 1/27/2021
L1400 DRAWINGS\1301\PLANS\BY GAWIN\FINALS\PHASE 3\PHASE 3A\301-1-PH3A-L-TRIALS-W5-KEY MAP.dwg
PICTED BY: GAWIN DATE: 1/27/2021


DEPARTMENT OF
PUBLIC WORKS
HOWARD COUNTY, MARYLAND
[Signature] 2/17/2021
CHIEF, BUREAU OF UTILITIES DATE

DEPARTMENT OF
PLANNING AND ZONING
HOWARD COUNTY, MARYLAND
[Signature] 3-11-21
CHIEF, DEVELOPMENT ENGINEERING DIVISION DATE

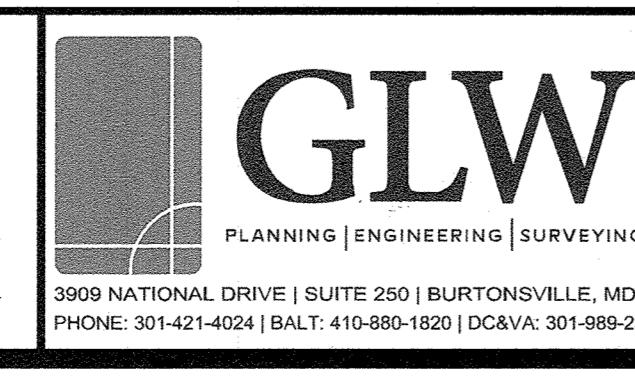

DESIGNED BY:
DATE:
DRAWN BY:
AWL
PROFESSIONAL CERTIFICATION
G.L.W. No.
CHECKED BY:
DEV
13013

PROFESSIONAL CERTIFICATION
I HEREBY CERTIFY THAT THESE PLANS
WERE PREPARED OR APPROVED BY ME,
AND THAT I AM A DULY LICENSED
PROFESSIONAL ENGINEER UNDER THE
LAWS OF THE STATE OF MARYLAND,
LICENSE NO. 12975
EXP. DATE: MAY 26, 2021
[Signature]

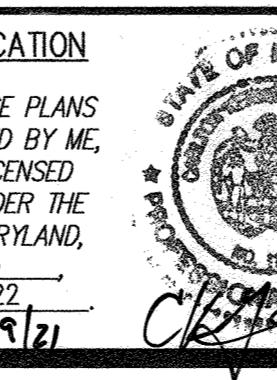

A.I.E. C
CREATED PHASES 3A THRU 3E FROM THIS CONTRACT. THE LIMITS OF PHASES
3B THRU 3E HAVE BEEN REVOKED FROM THIS CONTRACT

2-3-21

BY NO

REVISION

DATE


600' SCALE MAP NO. 23



BLOCK NO. 6 & 12

PHASING KEY MAP

WESTMOUNT
CONTRACT No. 24-4878-D
PHASE 3A
LOTS 174, 175, 196, 206-220, 228, 229, 237-241, 258-260
AND OPEN SPACE LOTS 269, 273, 278-286, 289, 290
HOWARD COUNTY, MARYLAND
ELECTION DISTRICT No. 2


SCALE
1"=80'
SHEET
2 OF 6

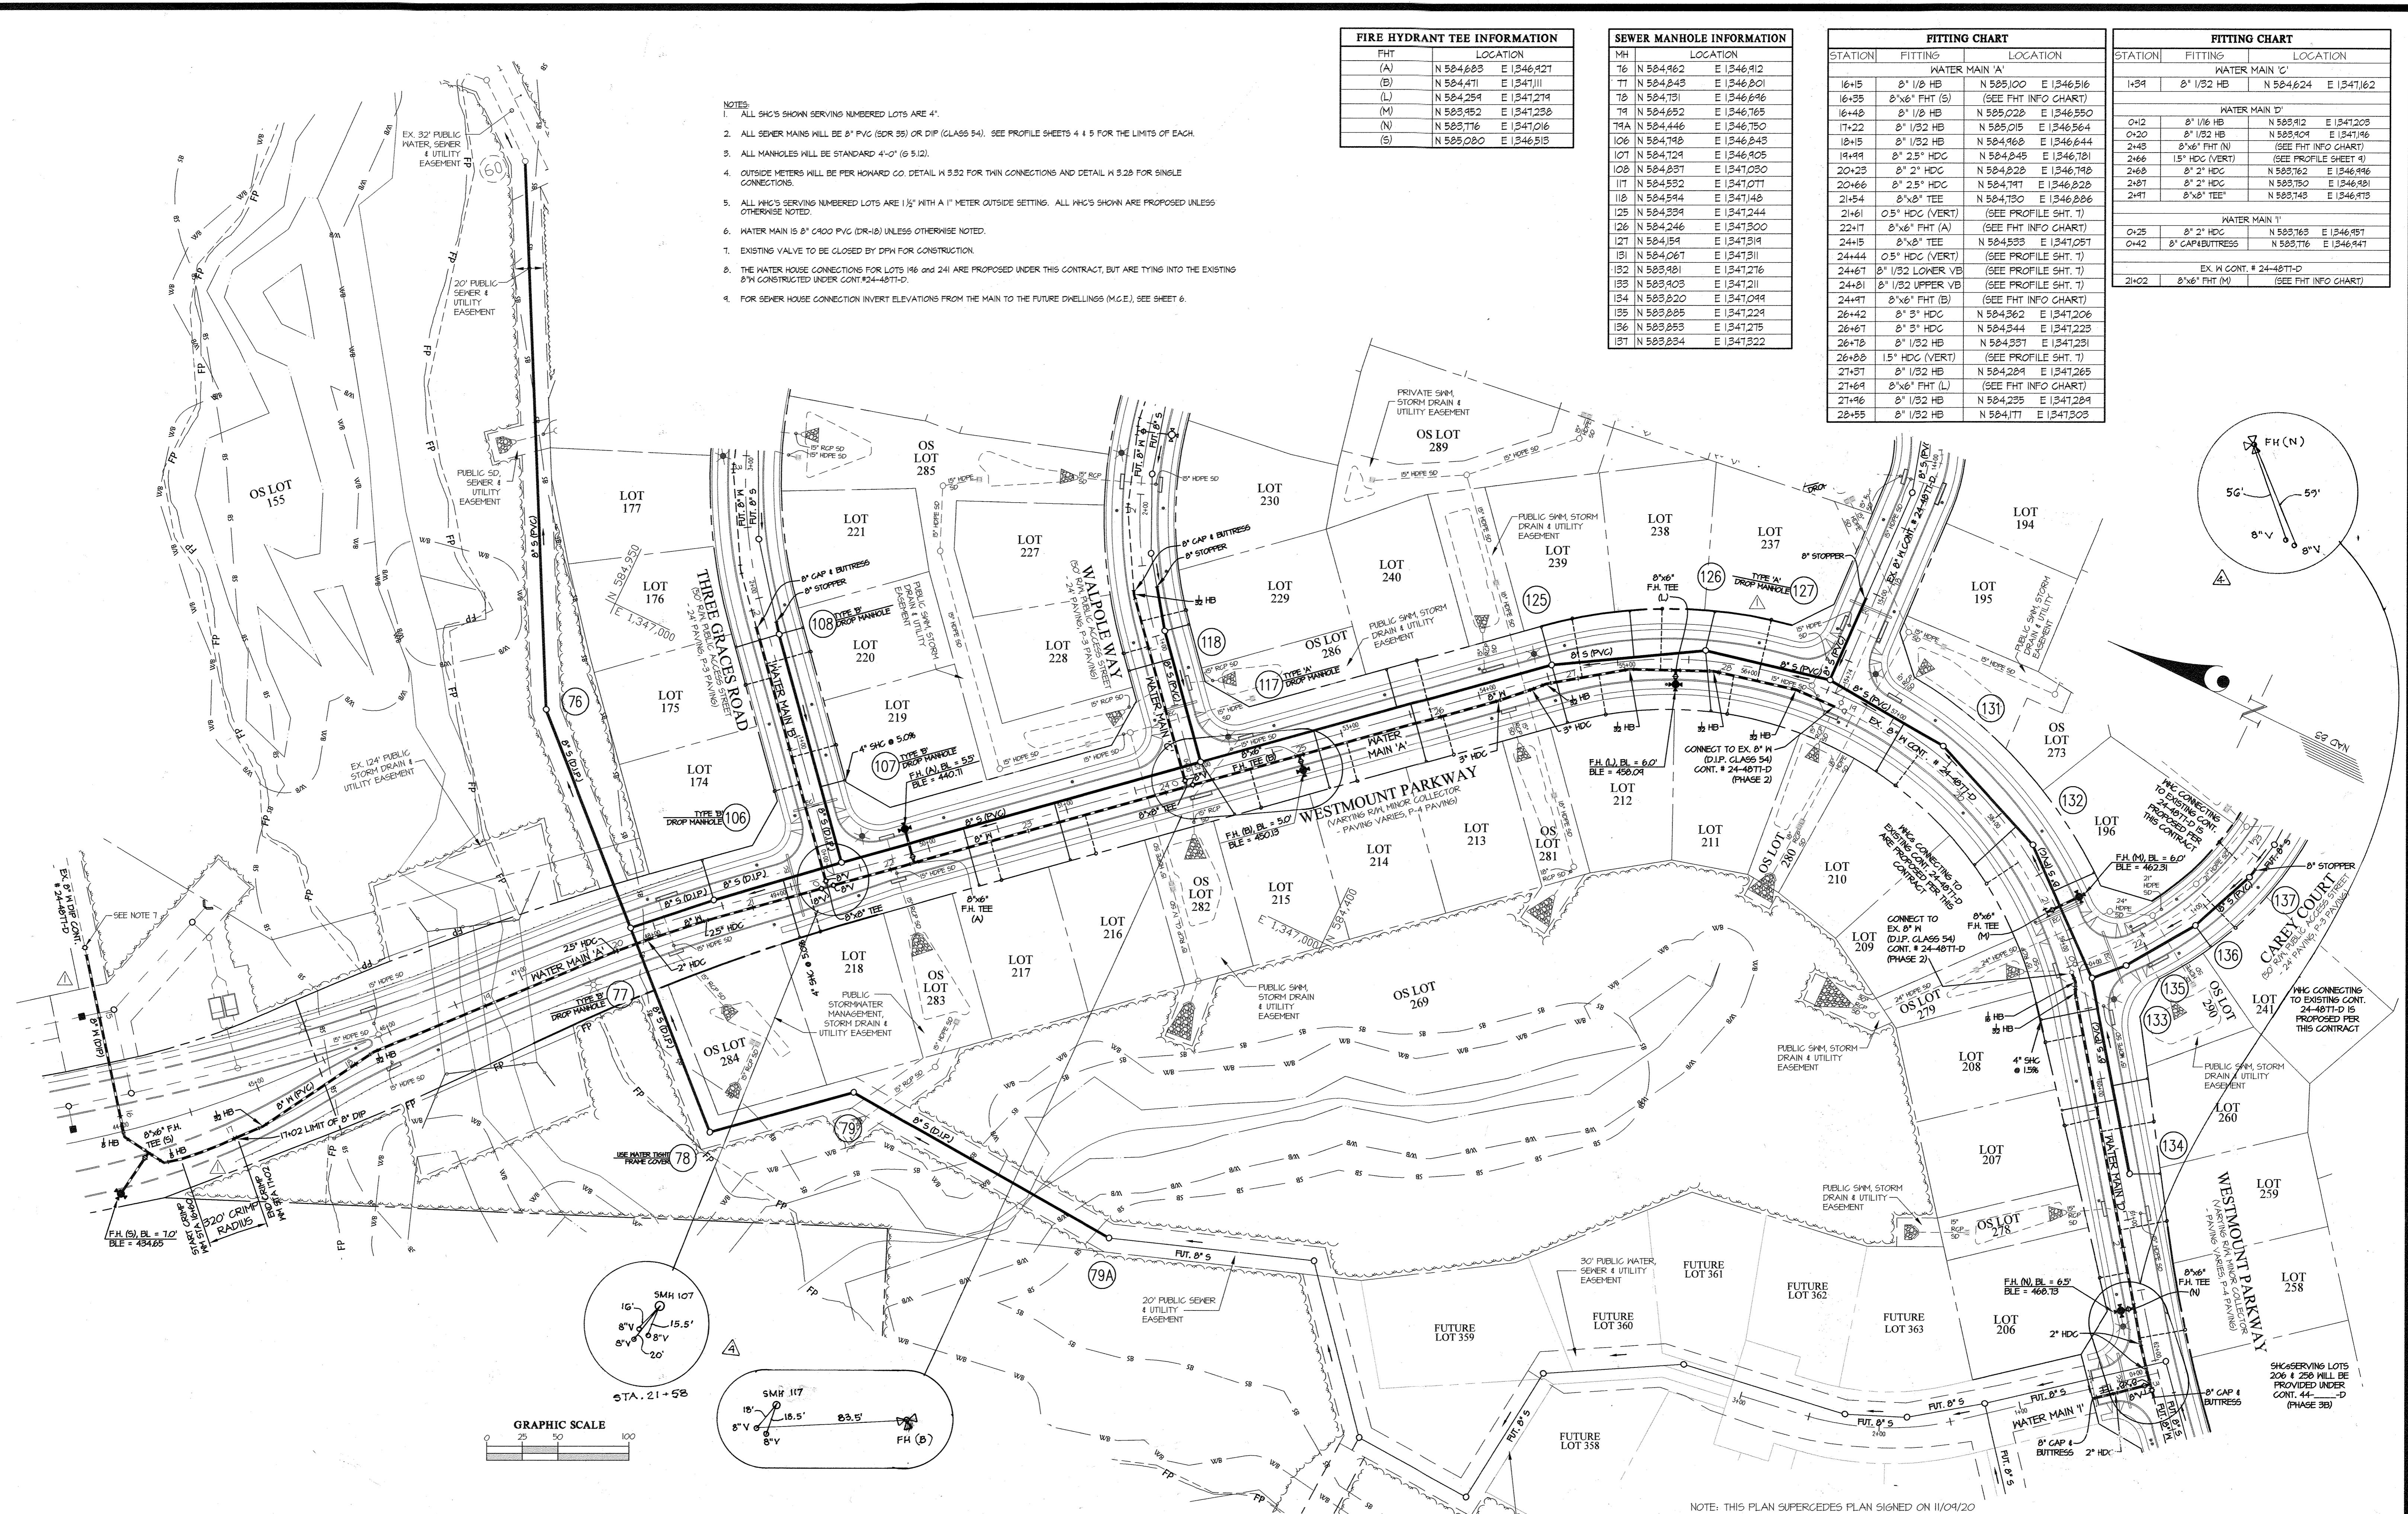

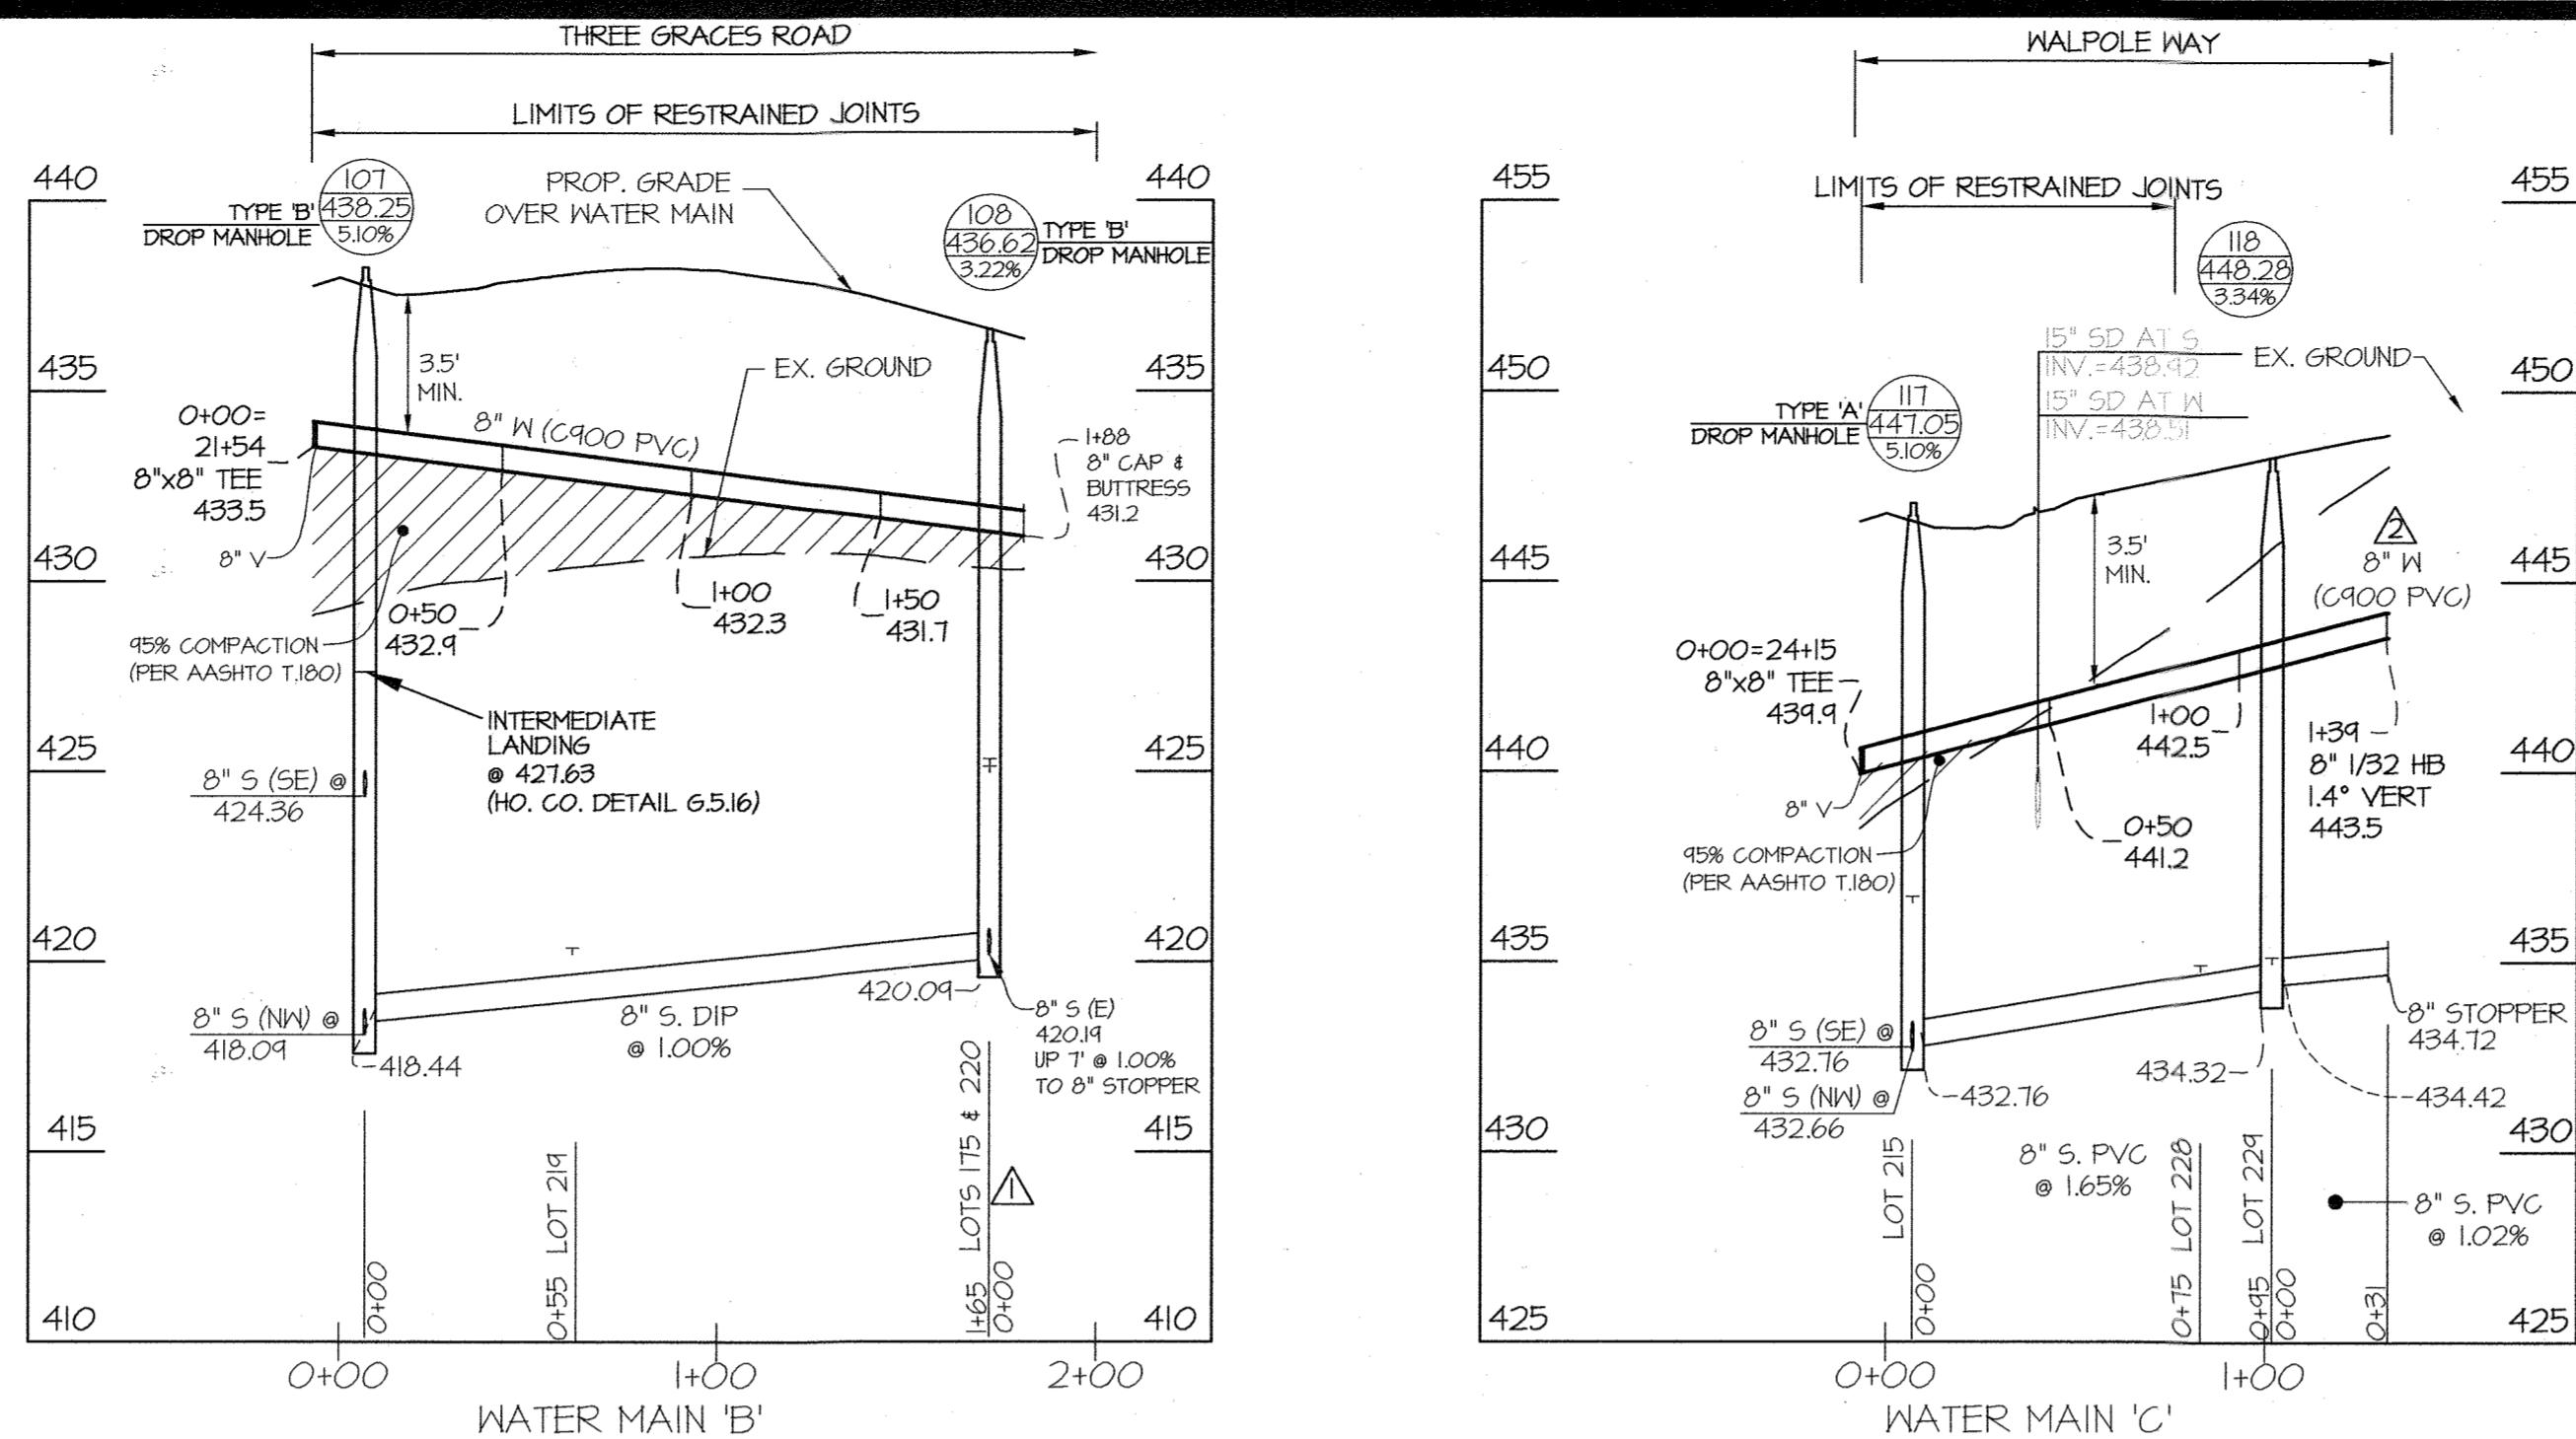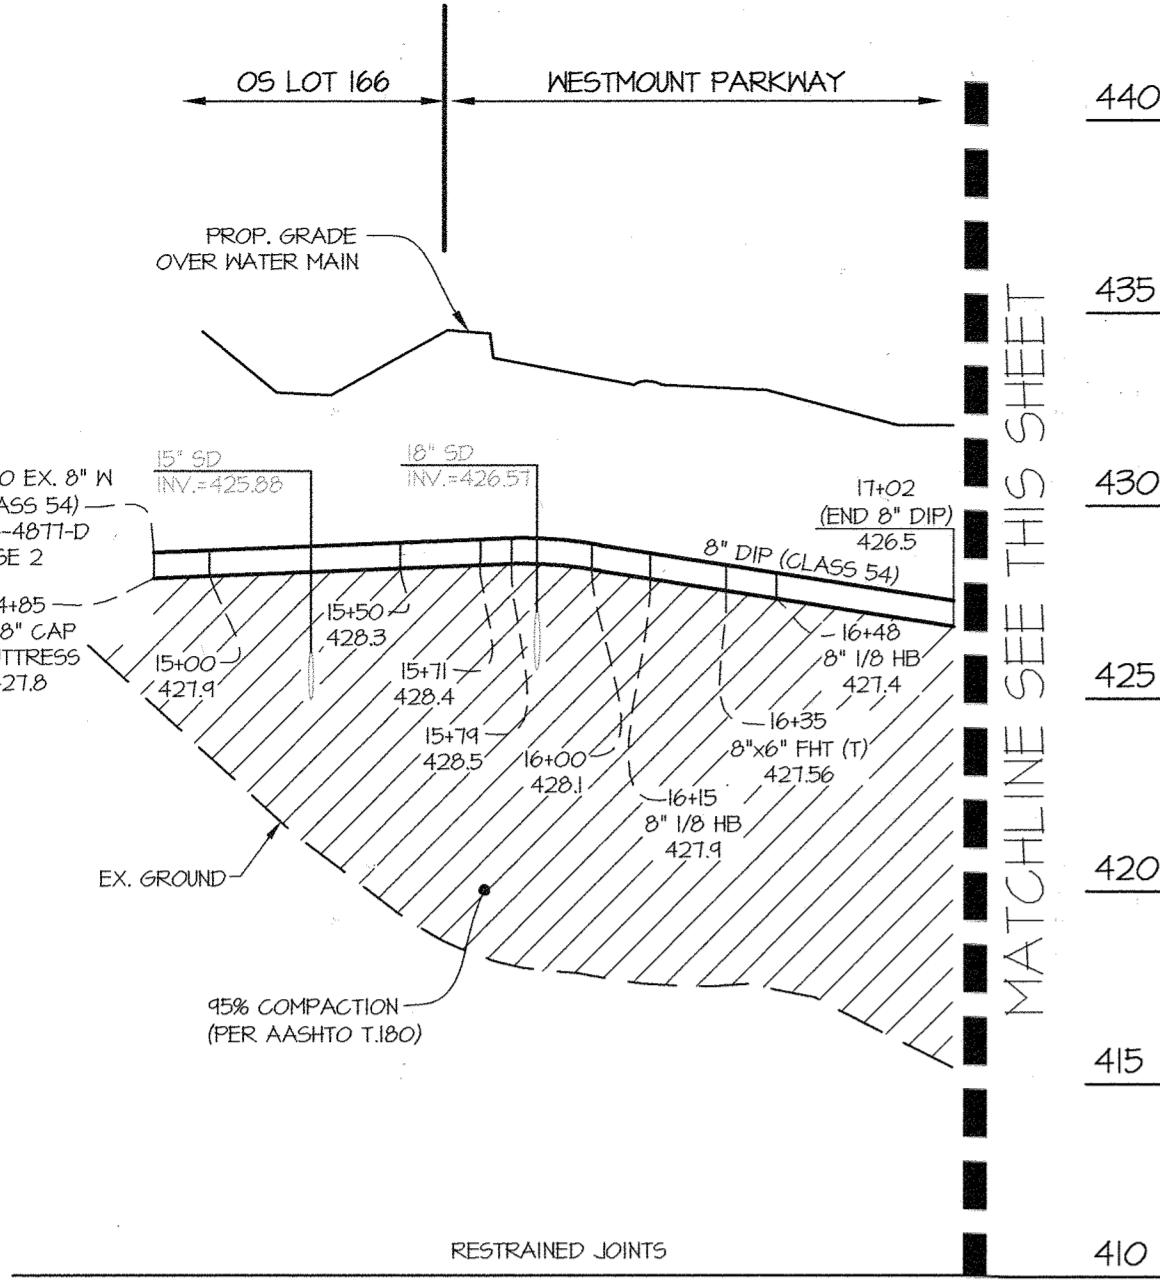


NOTES:

1. THE SYMBOL THAT REPRESENTS THE LOCATION OF A SEWER HOUSE CONNECTION IS SHOWN AT THE ELEVATION OF THE CONNECTION AT EITHER THE EDGE OF THE RIGHT-OF-WAY LINE OR EASEMENT LINE.
2. FOR SEWER HOUSE CONNECTION INVERTS AT POINTS BETWEEN THE MAIN AND FUTURE DWELLING, SEE SHEET 6.
3. FOR MINIMUM CELLAR ELEVATIONS (M.C.E.), SEE SHEET 6.
4. OTHER THAN SEWER HOUSE CONNECTIONS AT MANHOLES, ALL CONNECTIONS WILL TIE INTO THE MAIN, MATCHING CENTERLINES.
5. ALL D.I.P. WATER MAINS ARE CLASS 54 UNLESS OTHERWISE NOTED.
6. ALL P.V.C. WATER MAINS ARE C900 (DR-18) UNLESS OTHERWISE NOTED.
7. ALL P.V.C. SEWER MAINS ARE SDR 35 UNLESS OTHERWISE NOTED.
8. ALL D.I.P. SEWER MAINS ARE CLASS 54 UNLESS OTHERWISE NOTED. SEE PROFILES, THIS SHEET & SHEET 5 FOR LIMITS OF D.I.P.


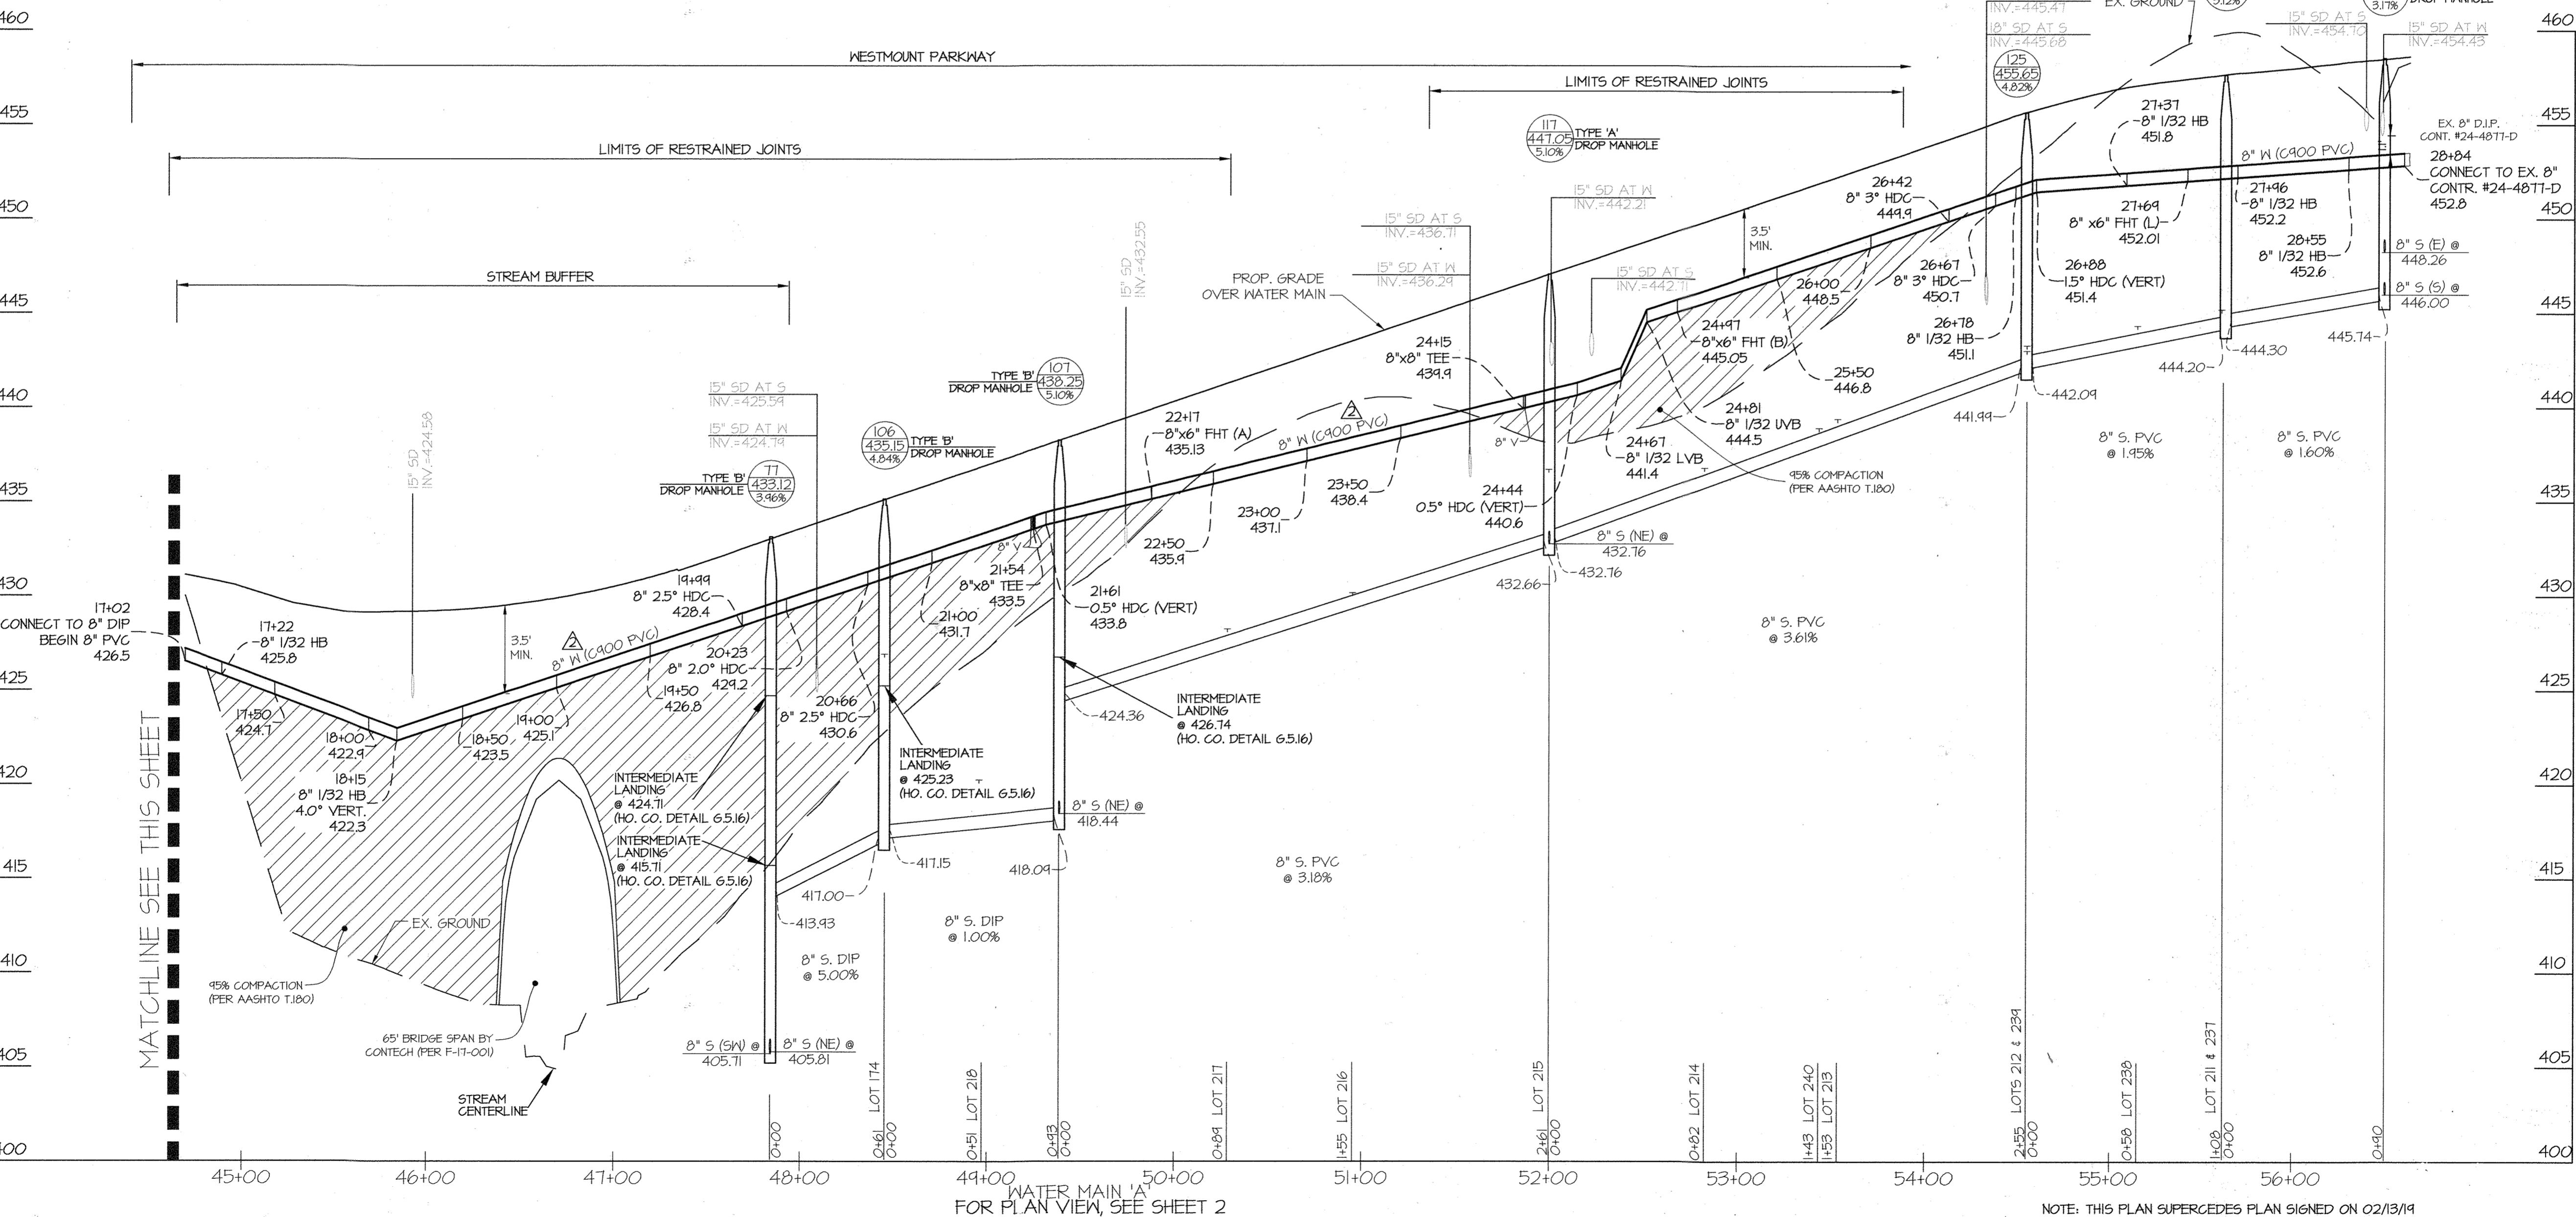


NOTE: THIS PLAN SUPERCEDES PLAN SIGNED ON 02/13/19

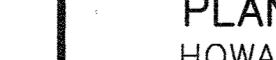
| | | | | | | | | | |
|--|--|---|--|---|--|---------------------------|-----------------------|---|--------------------------------|
| DEPARTMENT OF PUBLIC WORKS HOWARD COUNTY, MARYLAND | | DEPARTMENT OF PLANNING AND ZONING HOWARD COUNTY, MARYLAND | | GLW PLANNING ENGINEERING SURVEYING 3909 NATIONAL DRIVE SUITE 250 BURTONSVILLE, MD 20866 GLWPA.COM PHONE: 301-421-4024 BALT: 410-880-1820 DC&VA: 301-989-2524 FAX: 301-421-4186 | | DESIGNED BY: JRD | DATE FEB., 2021 | PROFESSIONAL CERTIFICATION  I HEREBY CERTIFY THAT THESE PLANS WERE PREPARED OR APPROVED BY ME, AND THAT I AM A DULY LICENSED PROFESSIONAL ENGINEER UNDER THE LAWS OF THE STATE OF MARYLAND, LICENSE NO. 12975 EXP. DATE: MAY 26, 2022 2/17/2021 | SCALE 1"=50'(H) 1"=5'(V) |
|  | |  | | WATER and SEWER PROFILES | | DRAWN BY: AWL | | | |
| CHIEF, BUREAU OF UTILITIES DATE | | CHIEF, DEVELOPMENT ENGINEERING DIVISION M.S. DATE | | | | CHECKED BY: G.L.W. No. | 13013 | | |
| | | | | | | DEV | 12-18-19 | | |
| | | | | | | GT | 12-18-19 | | |
| | | | | | | BY | NO | | |
| | | | | | | DATE | 600' SCALE MAP NO. 23 | | |
| | | | | | | | BLOCK NO. 6 & 12 | ELECTION DISTRICT No. 2 | |
| | | | | | | | | SHEET 4 OF 6 | |

NOTES:


- THE SYMBOL THAT REPRESENTS THE LOCATION OF A SEWER HOUSE CONNECTION IS SHOWN AT THE ELEVATION OF THE CONNECTION AT EITHER THE EDGE OF THE RIGHT-OF-WAY LINE OR EASEMENT LINE.
- FOR SEWER HOUSE CONNECTION INVERTS AT POINTS BETWEEN THE MAIN AND FUTURE DWELLING, SEE SHEET 6.
- FOR MINIMUM CELLAR ELEVATIONS (M.C.E.), SEE SHEET 6
- OTHER THAN SEWER HOUSE CONNECTIONS AT MANHOLES, ALL CONNECTIONS WILL TIE INTO THE MAIN, MATCHING CENTERLINES.
- ALL D.I.P. WATER MAINS ARE CLASS 54 UNLESS OTHERWISE NOTED.
- ALL P.V.C. WATER MAINS ARE C900 DR-18 UNLESS OTHERWISE NOTED.
- ALL P.V.C. SEWER MAINS ARE SDR 35 UNLESS OTHERWISE NOTED.
- ALL D.I.P. SEWER MAINS ARE CLASS 54 UNLESS OTHERWISE NOTED. SEE PROFILES, THIS SHEET AND SHEET 4 FOR LIMITS OF D.I.P.

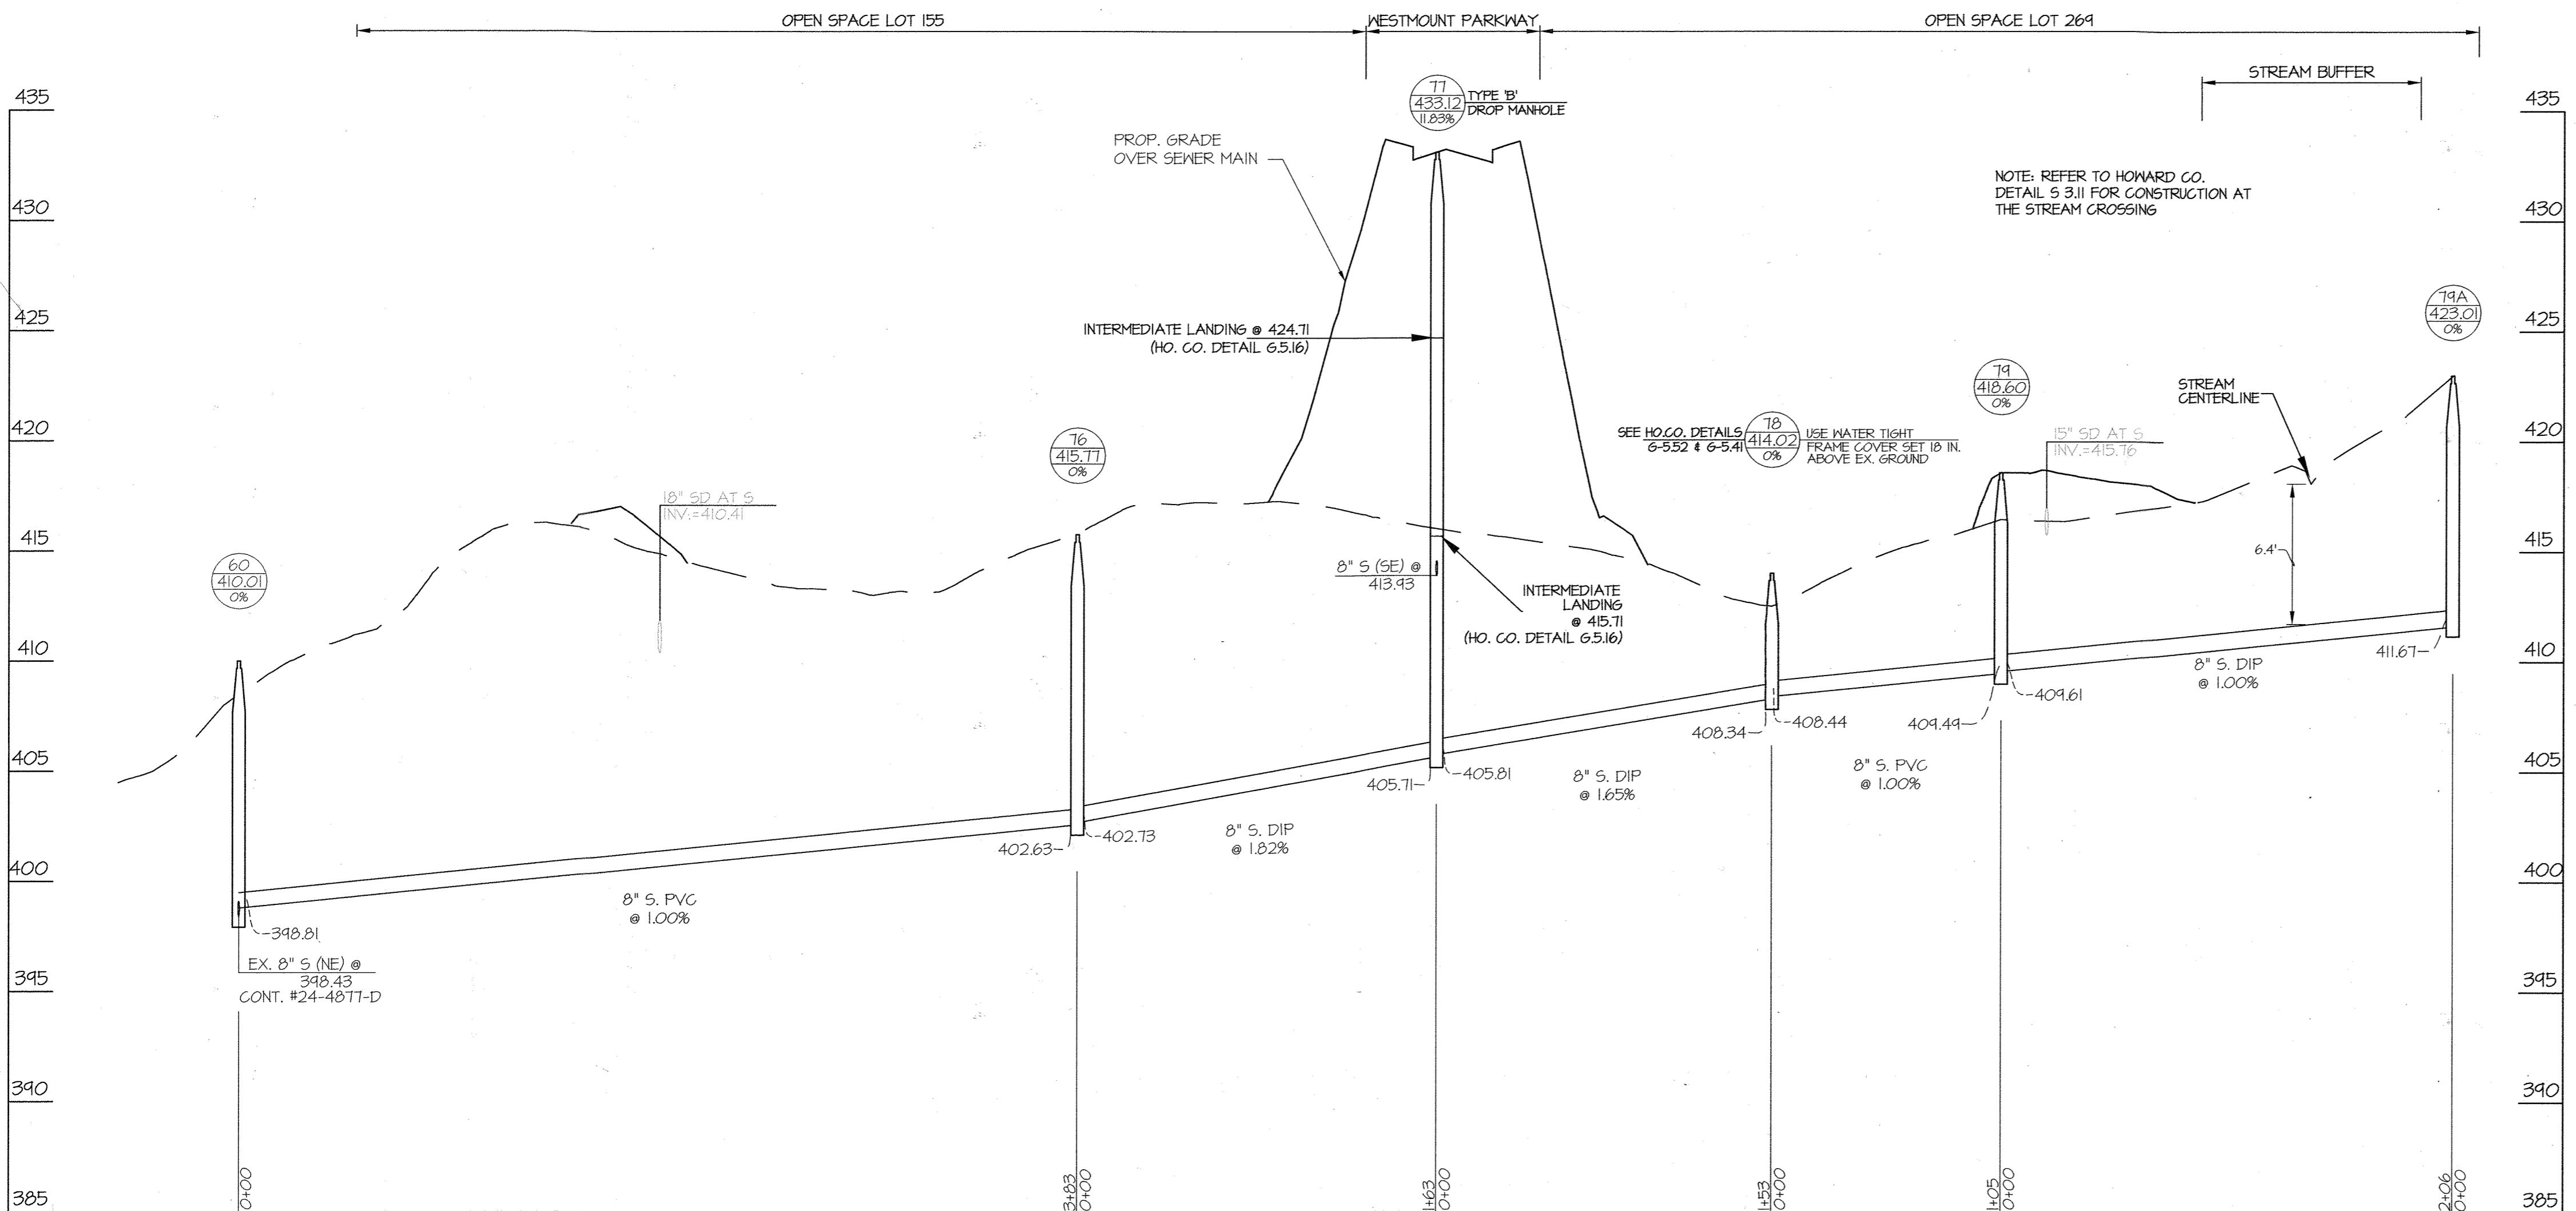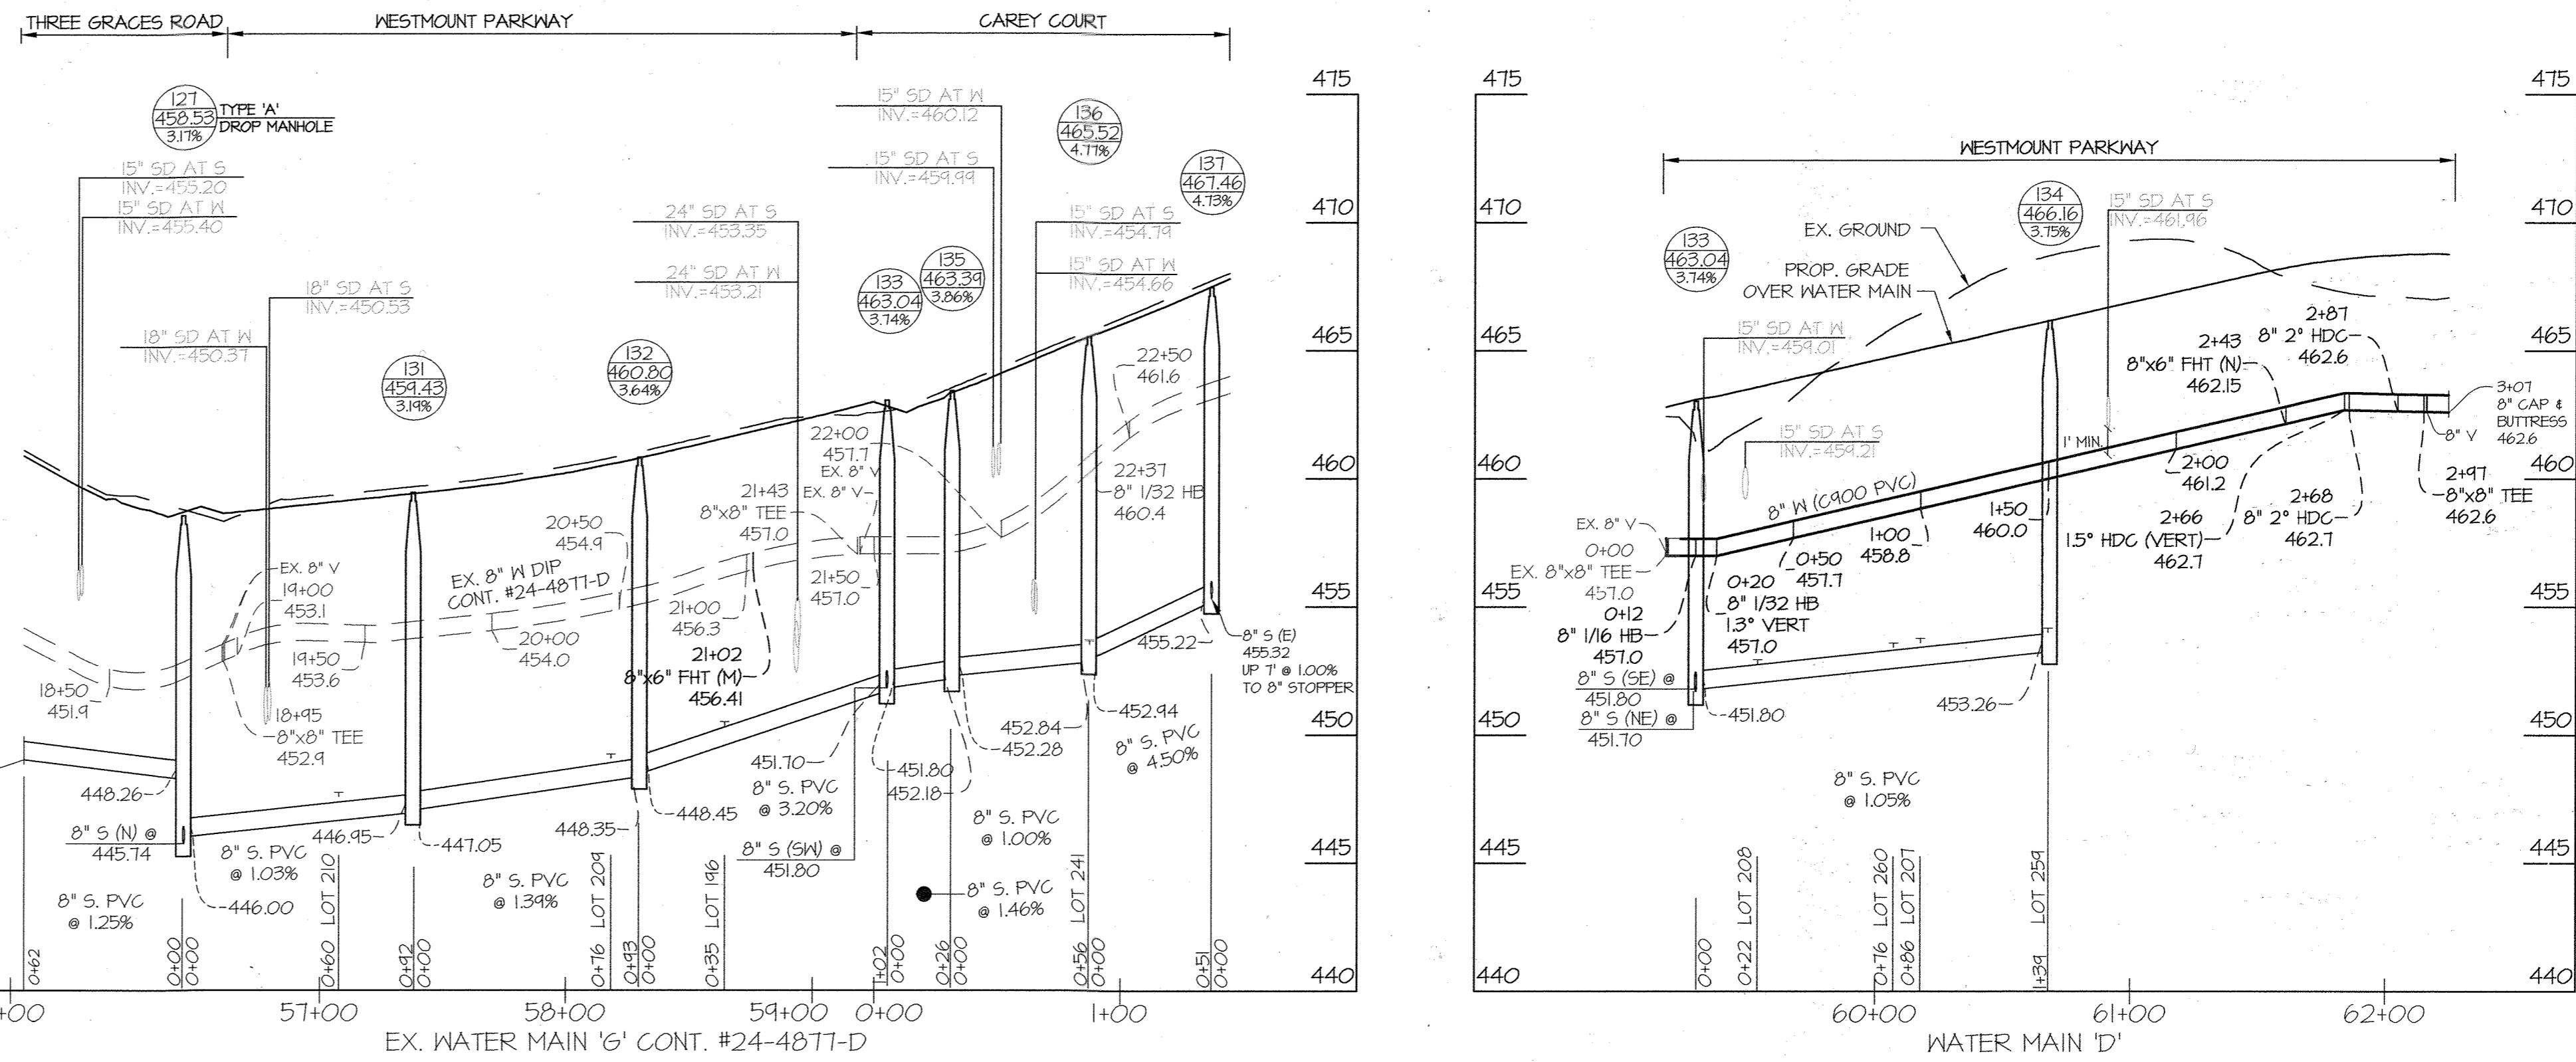


NOTE: THIS PLAN SUPERCEDES PLAN SIGNED ON 02/13/19

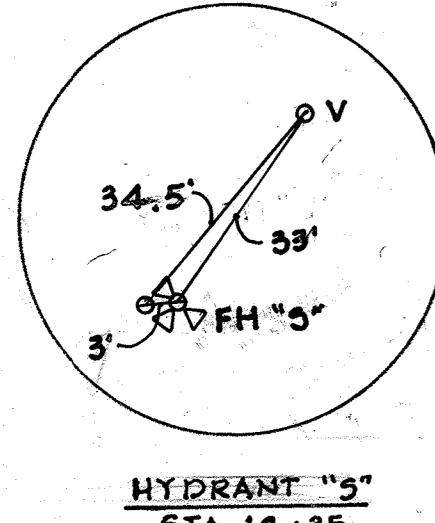


HYDRANT "5
STA. 1G +35

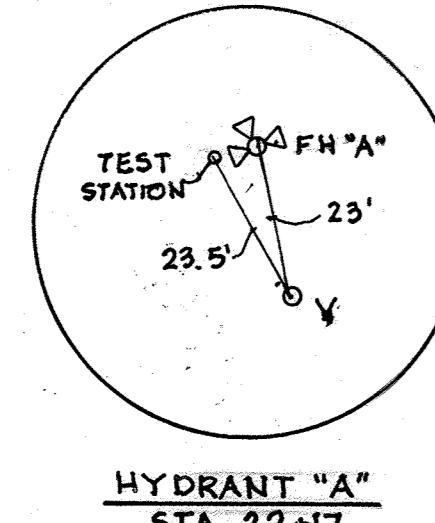


HYDRANT "A"
STA. 22 + 17

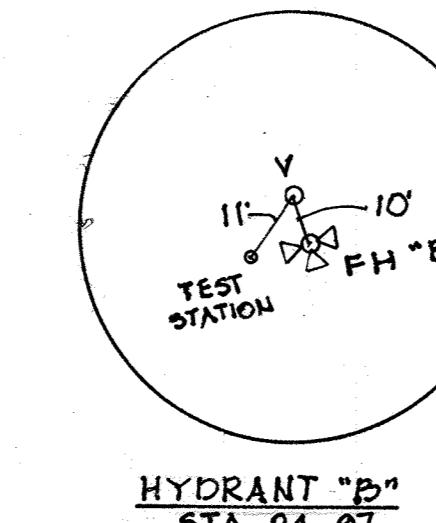


HYDRANT "STA. 24 +"

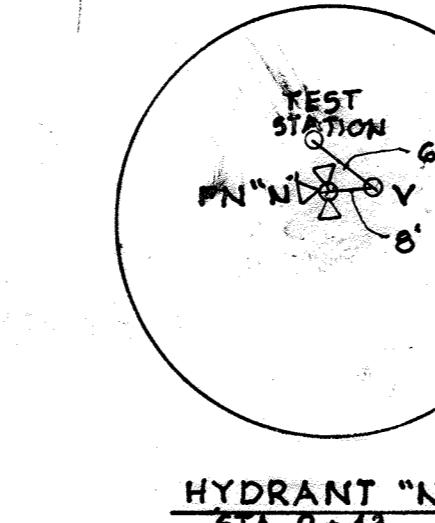

HYDRAN
STA. 2 •

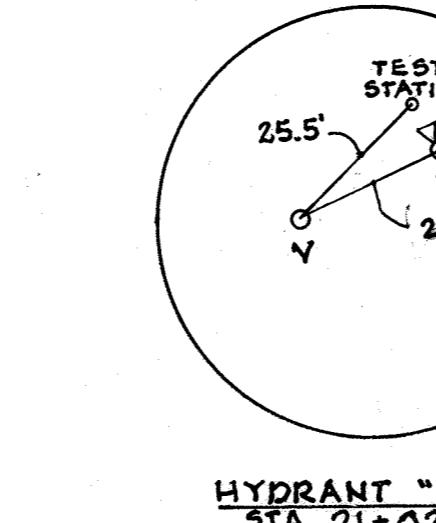

HYDRANT
STA. 21+0

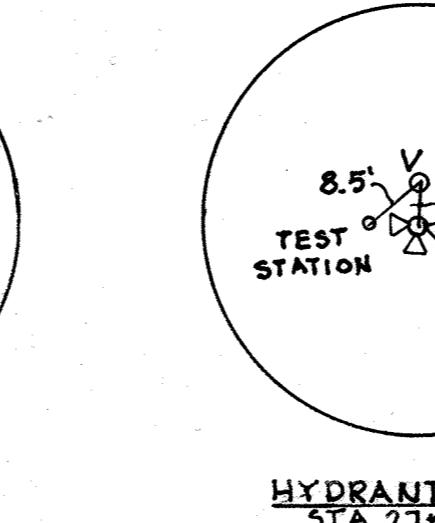

HYDRANT
STA. 27

| SEWER HOUSE CONNECTION INFORMATION AND MINIMUM CELLAR ELEVATIONS (M.C.E.) | | | | |
|--|-----------------|----------------|--------------------------|----------------------|
| LOT | SLOPE OF SHC | INV. @ MAIN/MH | INV. @ R/W SEE NOTE 1 | M.C.E. SEE NOTE 2 |
| 174 | 2.00% | 426.15 | 426.75 | 430.75 |
| 175 | 2.00% | 424.34 | 424.98 | 429.18 |
| 196 | 2.00% | 449.67 | 450.31 | 454.31 |
| 207 | 2.00% | 452.85 | 453.61 | 457.71 |
| 208 | 1.50% | 452.18 | 452.78 | 456.28 |
| 209 | 2.00% | 448.25 | 449.05 | 452.85 |
| 210 | 2.00% | 446.76 | 447.54 | 451.44 |
| 211 | 2.00% | 444.53 | 445.35 | 449.15 |
| 212 | 2.00% | 442.32 | 443.12 | 447.32 |
| 213 | 2.00% | 438.38 | 439.22 | 443.22 |
| 214 | 2.00% | 435.81 | 436.65 | 440.65 |
| 215 | 2.00% | 435.71 | 436.55 | 440.25 |
| 216 | 2.00% | 429.16 | 430.00 | 433.90 |
| 217 | 2.00% | 427.23 | 428.07 | 431.97 |
| 218 | 5.00% | 417.97 | 420.07 | 421.07 |
| 219 | 5.00% | 419.30 | 420.20 | 421.45 |
| 220 | 2.00% | 424.86 | 425.18 | 429.18 |
| 228 | 2.00% | 434.13 | 434.77 | 438.87 |
| 229 | 2.00% | 434.65 | 434.97 | 439.17 |
| 231 | 2.00% | 444.53 | 445.05 | 449.05 |
| 238 | 2.00% | 443.52 | 444.18 | 448.28 |
| 239 | 2.00% | 442.32 | 442.84 | 446.84 |
| 240 | 2.00% | 438.18 | 438.74 | 443.04 |
| 241 | 2.00% | 453.17 | 453.51 | 458.01 |
| 259 | 2.00% | 453.59 | 453.99 | 457.99 |
| 260 | 2.00% | 452.91 | 453.43 | 451.43 |

NOTE:

1. THIS VALUE IS THE INVERT OF THE S.H.C. AT EITHER THE EDGE OF THE RIGHT-OF-WAY OR EASEMENT LINE.
2. IT WILL BE THE RESPONSIBILITY OF THE ENGINEER PREPARING THE SITE DEVELOPMENT PLAN TO ENSURE THE FINAL BASEMENT ELEVATION IS ABOVE THE MINIMUM CELLAR ELEVATION (M.C.E.) SHOWN IN THIS TABLE.

| AS-BUILT INFORMATION | | | | | |
|----------------------|-------------------|---------------------------------|------------------|-----------------------------------|------------------|
| | | WATER HOUSE CONNECTION AS BUILT | | SEWER HOUSE CONNECTION AS BUILT | |
| LOT # | ADDRESS | LOCATION DIM. 1 | LOCATION DIM. 2 | LOCATION DIM. 1 | LOCATION DIM. 2 |
| 174 | THREE GRACES ROAD | MH 106 86' | MH 107 71' | MH 77 68' | MH 106 26' |
| 175 | THREE GRACES ROAD | MH 107 143' | MH 108 109' | MH 107 172' | MH 108 31' |
| 196 | CAREY COURT | MH 135 105' | MH 136 59' | MH 135 67' | HYDRANT "M" 21' |
| 206 | WESTMOUNT PARKWAY | | | (SEE CONTRACT 20-5167-D (PH. 3B)) | |
| 207 | WESTMOUNT PARKWAY | MH 134 37' | HYDRANT "N" 101' | MH 134 64.5' | MH 133 94' |
| 208 | WESTMOUNT PARKWAY | MH 133 54.5' | HYDRANT "M" 103' | MH 132 123' | MH 133 47' |
| 209 | WESTMOUNT PARKWAY | MH 131 101' | MH 132 42' | MH 131 87' | MH 132 43' |
| 210 | WESTMOUNT PARKWAY | MH 127 88' | MH 131 41.5' | MH 131 54' | MH 127 73' |
| 211 | WESTMOUNT PARKWAY | MH 127 72.5' | MH 126 47' | MH 127 84.5' | MH 126 46' |
| 212 | WESTMOUNT PARKWAY | MH 125 52' | HYDRANT "L" 53' | MH 125 41' | HYDRANT "L" 80' |
| 213 | WESTMOUNT PARKWAY | HYDRANT "B" 97' | MH 125 100' | HYDRANT "B" 86' | MH 125 111' |
| 214 | WESTMOUNT PARKWAY | HYDRANT "B" 30' | MH 117 102' | HYDRANT "B" 20' | MH 117 92' |
| 215 | WESTMOUNT PARKWAY | HYDRANT "B" 45' | MH 117 49' | HYDRANT "B" 57' | MH 117 45' |
| 216 | WESTMOUNT PARKWAY | HYDRANT "A" 127' | MH 117 101' | HYDRANT "A" 116' | MH 117 113' |
| 217 | WESTMOUNT PARKWAY | HYDRANT "A" 88' | MH 107 138' | HYDRANT "A" 67' | MH 107 97' |
| 218 | WESTMOUNT PARKWAY | MH 106 79' | MH 107 47' | MH 106 68' | MH 107 57' |
| 219 | THREE GRACES ROAD | MH 107 86' | HYDRANT "A" 76' | MH 107 61' | HYDRANT "A" 54' |
| 220 | THREE GRACES ROAD | MH 107 148' | MH 108 27' | MH 107 165' | MH 108 20' |
| 228 | WALPOLE WAY | MH 118 32' | MH 117 103' | MH 118 36' | MH 117 97' |
| 229 | WALPOLE WAY | MH 118 20' | MH 117 103' | MH 118 19' | MH 117 97' |
| 237 | WESTMOUNT PARKWAY | MH 126 48' | MH 127 58' | MH 126 27' | MH 127 93' |
| 238 | WESTMOUNT PARKWAY | HYDRANT "L" 53' | MH 126 42' | HYDRANT "L" 61' | MH 126 61' |
| 239 | WESTMOUNT PARKWAY | MH 125 35' | HYDRANT "L" 85' | MH 125 28' | HYDRANT "L" 103' |
| 240 | WESTMOUNT PARKWAY | HYDRANT "B" 111' | MH 125 92' | HYDRANT "B" 91' | MH 125 115' |
| 241 | CAREY COURT | MH 135 74' | MH 136 29' | MH 135 56' | MH 136 21' |
| 258 | WESTMOUNT PARKWAY | | | (SEE CONTRACT 20-5167-D (PH. 3B)) | |
| 259 | WESTMOUNT PARKWAY | MH 134 42' | HYDRANT "N" 72' | MH 134 23' | HYDRANT "N" 100' |
| 260 | WESTMOUNT PARKWAY | MH 134 41' | MH 133 110 | MH 134 69' | MH 133 80' |

NOTE: THIS PLAN SUPERCEDES PLAN SIGNED ON 11/09/20