

BENCHMARK INFORMATION

- B.M.#34FB HOWARD COUNTY CONTROL STATION #34FB HORIZONTAL NAD '83) LOCATED EAST OF ERIN DRIVE, ALONG GUILFORD ROAD, APPROX. 21' BEHIND EDGE OF PAVING
 - E 1,330,191,324 ELEVATION = 406.147 - VERTICAL - (NAVD '88)
- B.M.#34FE HOWARD COUNTY CONTROL STATION #34FE HORIZONTAL (NAD '03) LOCATED WEST OF GALWAY DRIVE, ALONG GUILFORD ROAD EAST OF DRIVEWAY #221. SET BEHIND THE EXISTING FIRE HYDRANT N 558,339.599
 - ELEVATION = 431.115 VERTICAL (NAVD '88)

	PR	IVATE WELL	&	PRIVATE	SEPTIC	SYSTEM C	HART
PARCEL N	10.	ADDRE55		OW	NER	ABANDON WELL	ABANDON SEPTIC
97		6166 ROUTE 32		JEANNE H	HODDINOTT	YE5	YES
	\dashv						
	+						

NOTE: WATER METERS WILL NOT BE RELEASED BY HOWARD COUNTY TO ANY NEW BUILDING UNTIL THE EXISTING WELL AND SEPTIC SYSTEM HAVE BEEN ABANDONED IN ACCORDANCE WITH HOWARD COUNTY HEALTH DEPARTMENT REGULATIONS AND THE EXISTING BUILDING IS CONNECTED TO THE PUBLIC WATER AND SEWER MAINS.

DEVELOPER'S CERTIFICATION

" I/WE HEREBY CERTIFY THAT ALL DEVELOPMENT AND CONSTRUCTION WILL BE DONE ACCORDING TO THIS PLAN OF DEVELOPMENT AND PLAN FOR EROSION AND SEDIMENT CONTROL AND THAT ALL RESPONSIBLE PERSONNEL INVOLVED IN THE CONSTRUCTION PROJECT WILL HAVE A CERTIFICATE OF ATTENDANCE AT THE DEPARTMENT OF THE ENVIRONMENT APPROVED TRAINING PROGRAM FOR THE CONTROL OF SEDIMENT AND EROSION BEFORE BEGINNING THE PROJECT. I ALSO AUTHORIZE PERIODIC ON-SITE INSPECTION BY THE HOWARD SOIL CONSERVATION DISTRICT OR THEIR AUTHORIZED AGENTS, AS

Paul W. Kaiebel; FOR:

ENGINEER'S CERTIFICATION

" I HEREBY CERTIFY THAT THIS PLAN FOR EROSION AND SEDIMENT CONTROL REPRESENTS A PRACTICAL AND WORKABLE PLAN BASED ON MY PERSONAL KNOWLEDGE OF THE SITE CONDITIONS AND THAT IT WAS PREPARED IN ACCORDANCE WITH THE REQUIREMENTS OF THE HOWARD SOIL

SEDIMENT CONTROL MEASURES FOR THIS CONTRACT WILL BE IMPLEMENTED IN ACCORDANCE WITH SECTION 308 OF THE HOWARD COUNTY DESIGN MANUAL - VOLUME IV: STANDARD SPECIFICATIONS AND DETAILS FOR CONSTRUCTION AND AS SHOWN ON THE ROAD CONSTRUCTION PLANS; F-15-110. Pour W. Koidel; FOR:


LAND DESIGN & DEVELOPMENT, INC.

F-15-110

THIS DEVELOPMENT IS APPROVED FOR EROSION AND SEDIMENT

CONTROL BY HOWARD SOIL CONSERVATION DISTRICT.

	LEGEND
	LLQLI10
SYMBOL	DESCRIPTION
	EX. WATER MAIN
	EX. SEWER MAIN
0	EX. SEWER MANHOLE
	EX. SEWER, WATER & UTILITY EASEMENT
[#]	EX. FIRE HYDRANT
•	EX. VALVE
	PROP. WATER MAIN
	PROP. SEWER MAIN
•	PROP. SEWER MANHOLE
	PROP. SEWER, WATER & UTILITY EASEMENT
	PROP. WHC
,	PROP. SHC
1 24	PROP. FIRE HYDRANT
•	PROP. VALVE

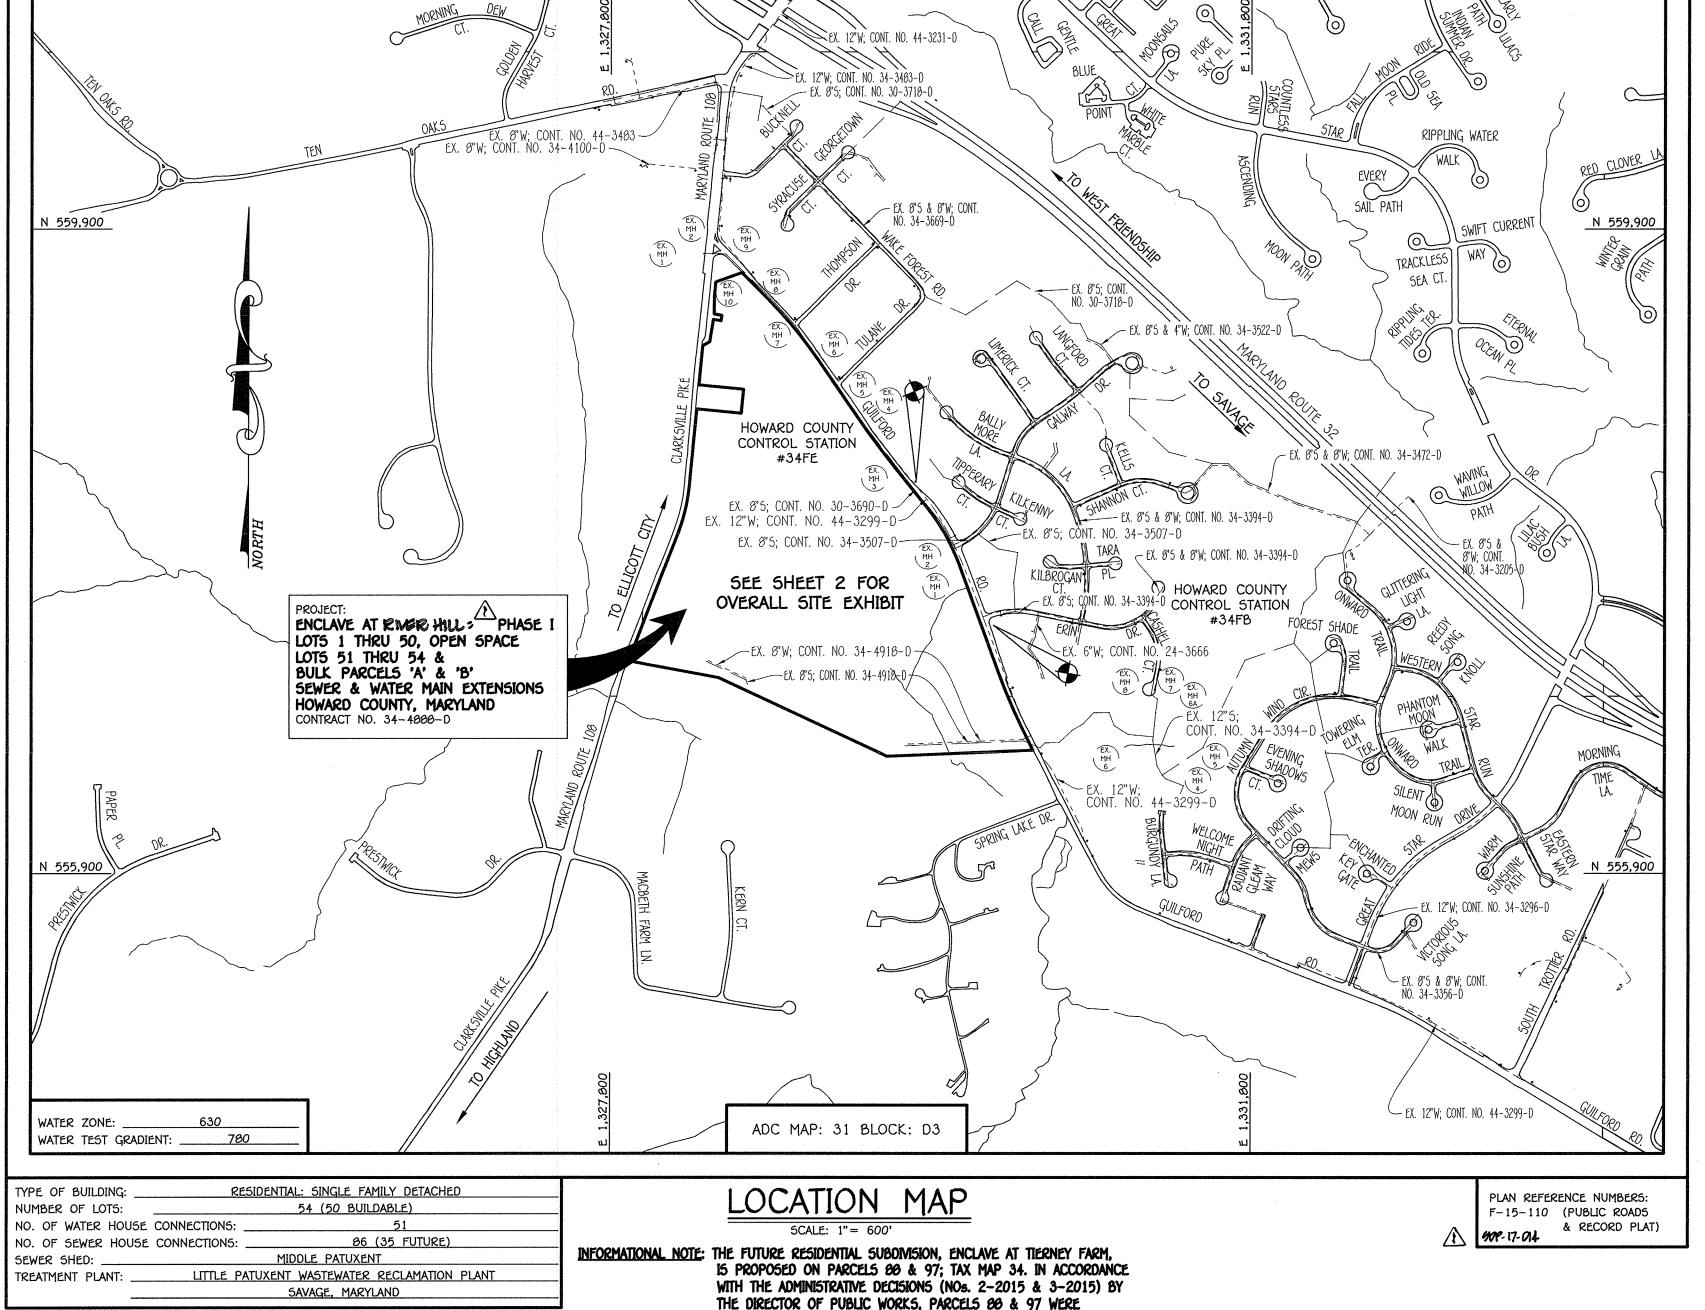

CONTRACT NO. 34-4888-D

INCORPORATED INTO THE HOWARD COUNTY METROPOLITAN DISTRICT

NO. 36-2016: APPROVED BY THE HOWARD COUNTY COUNCIL ON


MAY 02, 2016, AMENDMENTS PERTAINING TO PARCELS 80 & 97

WERE ADOPTED INTO THE MASTER PLAN FOR WATER & SEWERAGE.


ON FEBRUARY 17, 2015. IN ACCORDANCE WITH COUNCIL RESOLUTION

ENCLAVE AT RIVER HILL: PHASE I LOTS 1 THRU 50, OPEN SPACE LOTS 51 THRU 54 & AS-BUILT

> BULK PARCELS 'A' & SEWER & WATER MAIN EXTENSIONS HOWARD COUNTY, MARYLAND

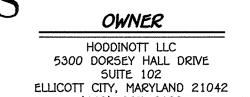

DEVELOPER BEAZER HONES U.C 8905 GUILFORD ROAD 21HE 200 COLUMBIA, MARYLAN 21046 (763) - 8-24 - (132)

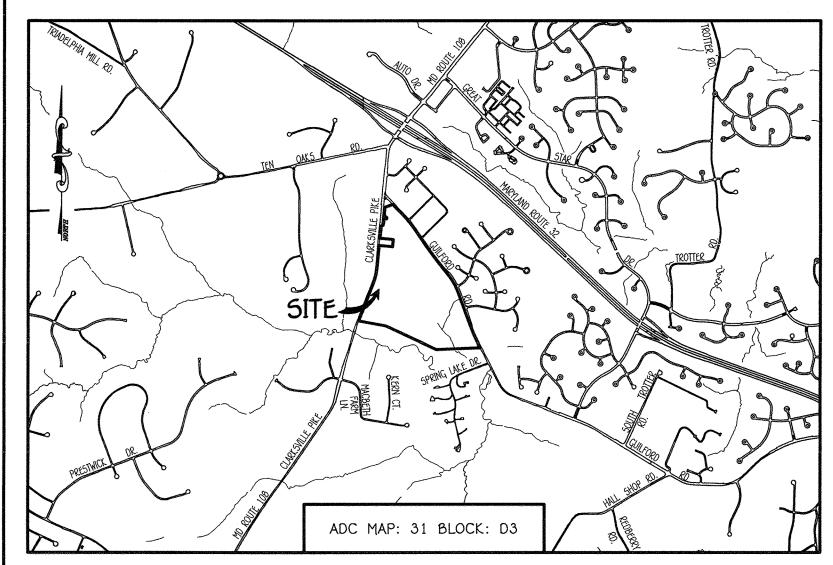

VICINITY MAP


GENERAL NOTES

3. HORIZONTAL AND VERTICAL SURVEY CONTROLS:

- 1. APPROXIMATE LOCATIONS OF EXISTING MAINS ARE SHOWN. THE CONTRACTOR SHALL TAKE ALL NECESSARY PRECAUTIONS TO PROTECT EXISTING MAINS AND SERVICES AND MAINTAIN UNINTERRUPTED SERVICE. ANY DAMAGE INCURRED SHALL BE REPAIRED IMMEDIATELY TO THE SATISFACTION OF THE ENGINEER AT THE CONTRACTOR'S EXPENSE 2. TOPOGRAPHIC FIELD SURVEYS WERE PERFORMED ON OR ABOUT FEBRUARY, 2014 BY FISHER, COLLINS & CARTER, INC.
- THE COORDINATES SHOWN ON THE DRAWINGS ARE BASED ON MARYLAND STATE REFERENCE SYSTEM NAD '03/91' AS PROJECTED BY HOWARD COUNTY GEODETIC CONTROL STATIONS NO. 34FB & NO. 34FE. ALL VERTICAL CONTROLS ARE BASED ON NAVD '86. VERTICAL CONTROLS PROVIDED ON THE DRAWINGS 4. ALL PIPE ELEVATIONS SHOWN ARE INVERT ELEVATIONS UNLESS OTHERWISE NOTED ON THE PLANS.
- 5. CLEAR ALL UTILITIES BY A MINIMUM OF 12 INCHES. CLEAR ALL POLES BY 5'-0" MINIMUM OR TUNNEL AS REQUIRED UNLESS OTHERWISE NOTED. THE OWNER HAS CONTACTED THE UTILITY COMPANIES AND HAS MADE ARRANGEMENTS FOR BRACING OF POLES AS SHOWN ON THE DRAWINGS. IN THE EVENT THE CONTRACTOR'S WORK REQUIRES BRACING OF ADDITIONAL POLES, ANY COST INCURRED BY THE OWNER FOR THE BRACING OF THE ADDITIONAL POLES OR DAMAGES SHALL BE DEDUCTED FROM MONIES OWED THE CONTRACTOR. THE CONTRACTOR SHALL COORDINATE WITH THE UTILITY COMPANIES TO SCHEDULE THE BRACING OF THE POLES.
- 6. FOR DETAILS NOT SHOWN ON THE DRAWINGS, AND FOR MATERIALS AND CONSTRUCTION METHODS, USE HOWARD COUNTY DESIGN MANUAL, VOLUME IV, STANDARD SPECIFICATIONS AND DETAILS FOR CONSTRUCTION (LATEST EDITION). THE CONTRACTOR SHALL HAVE A COPY OF VOLUME IV ON THE JOB SITE. 7. WHERE TEST PITS HAVE BEEN MADE ON EXISTING UTILITIES, THEY ARE NOTED BY THE SYMBOL . AT THE LOCATIONS OF THE TEST PITS. A NOTE OR NOTES CONTAINING THE RESULTS OF THE TEST PIT OR PITS IS INCLUDED ON THE DRAWINGS. EXISTING UTILITIES IN THE VICINITY OF THE PROPOSED WORK FOR WHICH TEST PITS HAVE NOT BEEN DUG SHALL BE LOCATED BY THE
- CONTRACTOR TWO WEEKS IN ADVANCE OF CONSTRUCTION OPERATIONS AT HIS OWN EXPENSE. 8. THE CONTRACTOR SHALL NOTIFY THE FOLLOWING UTILITY COMPANIES OR AGENCIES AT LEAST FIVE WORKING DAYS BEFORE STARTING WORK SHOWN ON THESE PLANS:

. 410-313-4900 .410-795-1390 1-800-257-777 410-531-5533

- 9 TREES AND SHRUBS ARE TO BE PROTECTED FROM DAMAGE TO THE MAXIMUM EXTENT. TREES AND SHRUBS LOCATED WITHIN THE CONSTRUCTION STRIP ARE NOT TO BE REMOVED OR DAMAGED BY THE CONTRACTOR.
- 10. CONTRACTOR SHALL REMOVE TREES, STUMPS AND ROOTS ALONG THE LINE OF EXCAVATION. PAYMENT FOR SUCH REMOVAL SHALL BE INCLUDED IN THE UNIT PRICE BID FOR THE CONSTRUCTION OF THE MAIN. THE CONTRACTOR SHALL NOTIFY THE BUREAU OF HIGHWAYS, HOWARD COUNTY, AT (410)-313-7450 AT LEAST FIVE WORKING DAYS BEFORE OPEN CUTTING OR BORING/JACKING OF ANY COUNTY ROAD FOR LAYING WATER/SEWER MAINS OR HOUSE CONNECTIONS. THE APPROVAL OF THESE DRAWINGS WILL CONSTITUTE COMPLIANCE WITH DPW REQUIREMENTS PER SECTION 18.114(a) OF THE HOWARD
- PART B: <u>WATER MAIN GENERAL NOTES</u>
 1. ALL WATER MAINS SHALL BE AWWA C900 PVC; DR-10. 2. TOPS OF ALL WATER MAINS SHALL HAVE A MINIMUM OF 3'-6" OF COVER UNLESS OTHERWISE NOTED.
- 3. VALVES ADJACENT TO TEES SHALL BE STRAPPED TO TEES. 4. ALL FITTINGS SHALL BE BUTTRESSED OR ANCHORED WITH CONCRETE IN ACCORDANCE WITH STANDARD DETAILS UNLESS OTHERWISE
- PROVIDED FOR ON THE DRAWINGS 5. FIRE HYDRANTS SHALL BE SET TO THE BURY LINE ELEVATIONS SHOWN ON THE DRAWINGS. ALL FIRE HYDRANTS SHALL BE INSTALLED IN ACCORDANCE WITH STANDARD DETAILS. THE SOIL AROUND THE FIRE HYDRANT SHALL BE COMPACTED IN ACCORDANCE WITH SECTION 1000 AND SECTION 1005 OF THE STANDARD SPECIFICATIONS.
- . THE CONTRACTOR SHALL NOT OPERATE ANY WATER MAIN VALVES ON THE EXISTING WATER SYSTEM. 7. TRACER WIRE AND CONTINUITY TEST STATIONS SHALL BE INSTALLED ON ALL D.I.P. AND PVC WATER MAINS IN ACCORDANCE
- WITH HOWARD COUNTY DESIGN MANUAL. 8. FOR PVC WATER MAINS, ALL RECORDS FOR THE QUALITY CONTROL AND QUALIFICATION TEST REQUIREMENTS NOTED IN SECTION 5.1 OF THE AWWA STANDARD C900 FOR PVC PRESSURE PIPE SHALL BE SUBMITTED WITH THE PIPE MATERIAL CERTIFICATIONS OR SHOP DRAWINGS PRIOR TO APPROVAL OF THE MATERIAL FOR USE. THE TEST RECORDS SHALL BE FOR THE PIPE TO BE INSTALLED UNDER THIS CONTRACT. ALL PVC PIPE SHALL CONTAIN MARKINGS TO ALLOW CROSS REFERENCING OF
- THE PIPE SUPPLIED TO THE TEST RECORDS RECEIVED. 9. UNLESS OTHERWISE NOTED ON THE PLANS OR IN THE SPECIFICATIONS. SEVENTEEN (17) POUND SACRIFICIAL ANODES SHALL BE INSTALLED ON ALL VALVES AND METALLIC FITTINGS USED WITH PVC WATER MAINS IN ACCORDANCE WITH VOLUME IV, STANDARD SPECIFICATIONS and details for construction. Magnesium anodes shall be installed on all valves and ductile iron fittings including
- RESTRAINTS AND HARNESSES. ZINC ANODES SHALL BE INSTALLED ON ALL STAINLESS STEEL FITTINGS AND SADDLES USED WITH PVC MAINS. ALL "TEES" USED WITH PVC MAINS SHALL BE DUCTILE IRON. 10. PROPER ASSEMBLY OF GASKETED PVC PIPE JOINTS: THE MANUFACTURER'S INSERTION LINE OF GASKETED PVC PIPE JOINTS INDICATES THE MAXIMUM DEPTH OF INSERTION OF THE SPIGOT INTO THE BELL. AFTER ASSEMBLY OF THE JOINT, THE INSERTION LINE SHALL
- REMAIN VISIBLE. DUAL INSERTION LINES ON CASKETED PVC PIPE INDICATE THE MAXIMUM AND MINIMUM DEPTH OF INSERTION OF THE SPIGOT INTO THE BELL. THE CONTRACTOR SHALL NOT OVER INSERT OR OVER HOME THE SPIGOT INTO THE BELL OF PVC PIPE. 11. ALL CHANGES IN HORIZONTAL OR VERTICAL DIRECTION OF PVC WATER PIPE SHALL BE MADE WITH STANDARD BENDS, 5—DEGREE SWEEPS OR HIGH DEFLECTION(HD) COUPLINGS. NO BENDING OF THE PIPE OR DEFLECTING OF PVC PIPE JOINTS IS PERMITTED. WHERE HIGH DEFLECTION COUPLINGS OR 5-DEGREE SWEEPS ARE PERMITTED, THE CONTRACTOR SHALL PROVIDE ONE FULL PIPE LENGTH (20 FOOT LONG) ON EITHER SIDE OF THE HIGH DEFLECTION COUPLING OR 5-DEGREE SWEEP, TAKING CARE NOT TO USE COMPACTION EQUIPMENT DIRECTLY OVER THE FITTING.
- PVC HIGH DEFLECTION COUPLINGS SHALL BE LIMITED TO A TOTAL OF 3-DEGREES (1 \(\frac{1}{2}\)-DEGREE ON EITHER END OF THE COUPLING), SHALL BE RATED FOR A MINIMUM 200 PSI MEETING THE REQUIREMENTS OF AWWA C900, SHALL HAVE A MINIMUM LAY LENGTH OF 9-INCHES AND SHALL HAVE CENTER STOPS. PVC HIGH DEFLECTION COUPLINGS SHALL BE CERTAINTEED PVC HIGH DEFLECTION (HD)
- FIVE DEGREE SWEEPS SHALL BE BELL BY SPIGOT, RATED FOR A MINIMUM 225 PSI, DR-10 MEETING THE REQUIREMENTS OF AWWA C900 AND SHALL BE MULTI FITTINGS (IPEX) BLUE BRUTE DR-10 OR EQUAL.
- 12. WHEN PVC HIGH DEFLECTION COUPLINGS OR PVC 5-DEGREE SWEEPS ARE USED TO FACILITATE CHANGES IN HORIZONTAL OR VERTICAL ALIGNMENTS OF AWWA C900 PVC PIPELINES, THE CONTRACTOR SHALL INSERT DEVICES FOR THE PREVENTION OF OVER-INSERTION OF THE PVC PIPE SPIGOTS OR PLAIN ENDS INTO THE PUSH ON BELL JOINT ON BOTH SIDES OF THE HIGH DEFLECTION COUPLINGS AND 5-DEGREE SWEEPS. BELL STOPS SHALL BE PLACED AT THE PROPER INSERTION LINE FOR THE FITTING. THE BELL STOP SHALL BE MANUFACTURED OF DUCTILE IRON AND INCORPORATE AN EXPANSION RETENTION SPRING TO ALLOW FOR PIPE EXPANSION AND
- CONTRACTION. THE BELL STOPS SHALL BE SERIES 5000 MEGA-STOP, AS MANUFACTURED BY EBAA IRON, INC. OR APPROVED EQUAL. 13. TO ACCOMMODATE A SPRINKLER SYSTEM, ALL RESIDENTIAL DWELLING UNITS SHALL HAVE A 1-1/2" WATER HOUSE CONNECTION WITH A 1" OUTSIDE METER SETTING; STD. DET. W-3.28.
- PART C: SEWER MAIN GENERAL NOTES 1. ALL SEWER MAINS SHALL BE D.I.P. OR P.V.C. UNLESS OTHERWISE NOTED.
- 2. ALL MANHOLES SHALL BE 4'-0" INSIDE DIAMETER UNLESS OTHERWISE NOTED.
- . FORCE MAINS SHALL BE D.I.P. ONLY. H. MANHOLES SHOWN WITH 12" AND 16" WALLS ARE FOR BRICK MANHOLES ONLY. 5. MANHOLES DESIGNATED W.T. IN PLAN AND PROFILE SHALL HAVE WATERTIGHT FRAME AND COVER, STANDARD DETAIL G5.52. WHERE WATERTIGHT MANHOLE FRAMES AND COVERS ARE USED, SET TOP OF FRAME 1'-6" ABOVE FINISHED GRADE UNLESS
- OTHERWISE NOTED ON THE DRAWINGS. 6. HOUSE(5) WITH THE SYMBOL "C.N.S." INDICATES THAT CELLAR CANNOT BE SERVED

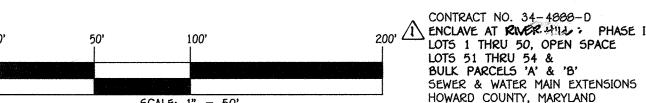

DEPARTMENT OF PUBLIC WORKS HOWARD COUNTY, MARYLAND

DEPARTMENT OF PLANNING AND ZONING HOWARD COUNTY, MARYLAND

HEREBY CERTIFY THAT THESE DOCUMENTS WERE PREPARED OR APPROVED BY ME, AND THAT I AM A DULY LICENSED PROFESSIONAL ENGINEER UNDER THE LAWS OF THE STATE OF MARYLAND. LICENSE NO. 12043 EXPIRATION DATE IS 7/16/16. FISHER, COLLINS & CARTER, INC CIVIL ENGINÉERING CONSULTANTS & LAND SURVEYORS



043	DESIGNED BY :					
	B.C.R.					SEWER & WATER MAIN EXTENSION
,,,,,,,,,,,,,,,,,,,,,,,,,,,,,,,,,,,,,,,	DRAWN BY : B.C.R.					TITLE SHEET
	CHECKED BY : P.W.K.					600' SCALE MAP NO. 34 BLOCK NO. 18
	DATE :	PCC		REAGE CONTRACT THIS TO "RIVER HILL", REAGE VEVELORIES ENTRY, RELIGIOUS "BOUNTIES AS REQUIRED & HEM "8"9 FLUG	11/10/17	F.C.C. WORK ORDER NO. <u>13000-3001</u>
	JUNE, 2016	BY	NO.	REVISION ADD	DATE	FILE NAME : SEWER & WATER MAIN EXTENSION PLAN

SEWER & WATER MAIN EXTENSIONS TITLE SHEET 600' SCALE MAP NO. 34 BLOCK NO. 18 F.C.C. WORK ORDER NO. 13008-3001

ENCLAVE AT RIVER HILL: A PHASE

LOTS 1 THRU 50, OPEN SPACE LOTS 51 THRU 54 & BULK PARCELS 'A' & 'B'

SEWER & WATER MAIN EXTENSIONS CONTRACT NO. 34-4888-D FIFTH ELECTION DISTRICT HOWARD COUNTY, MARYLAND

SHEET 1 of 13


SCALE


SHOWN

HIEF, BUREAU OF UTILITIES


CLI CANDAMANT ENGINEERING DIVISION M.(

ennial square office park — 10272 baltimore national pik ELLICOTT CITY, MARYLAND 21042

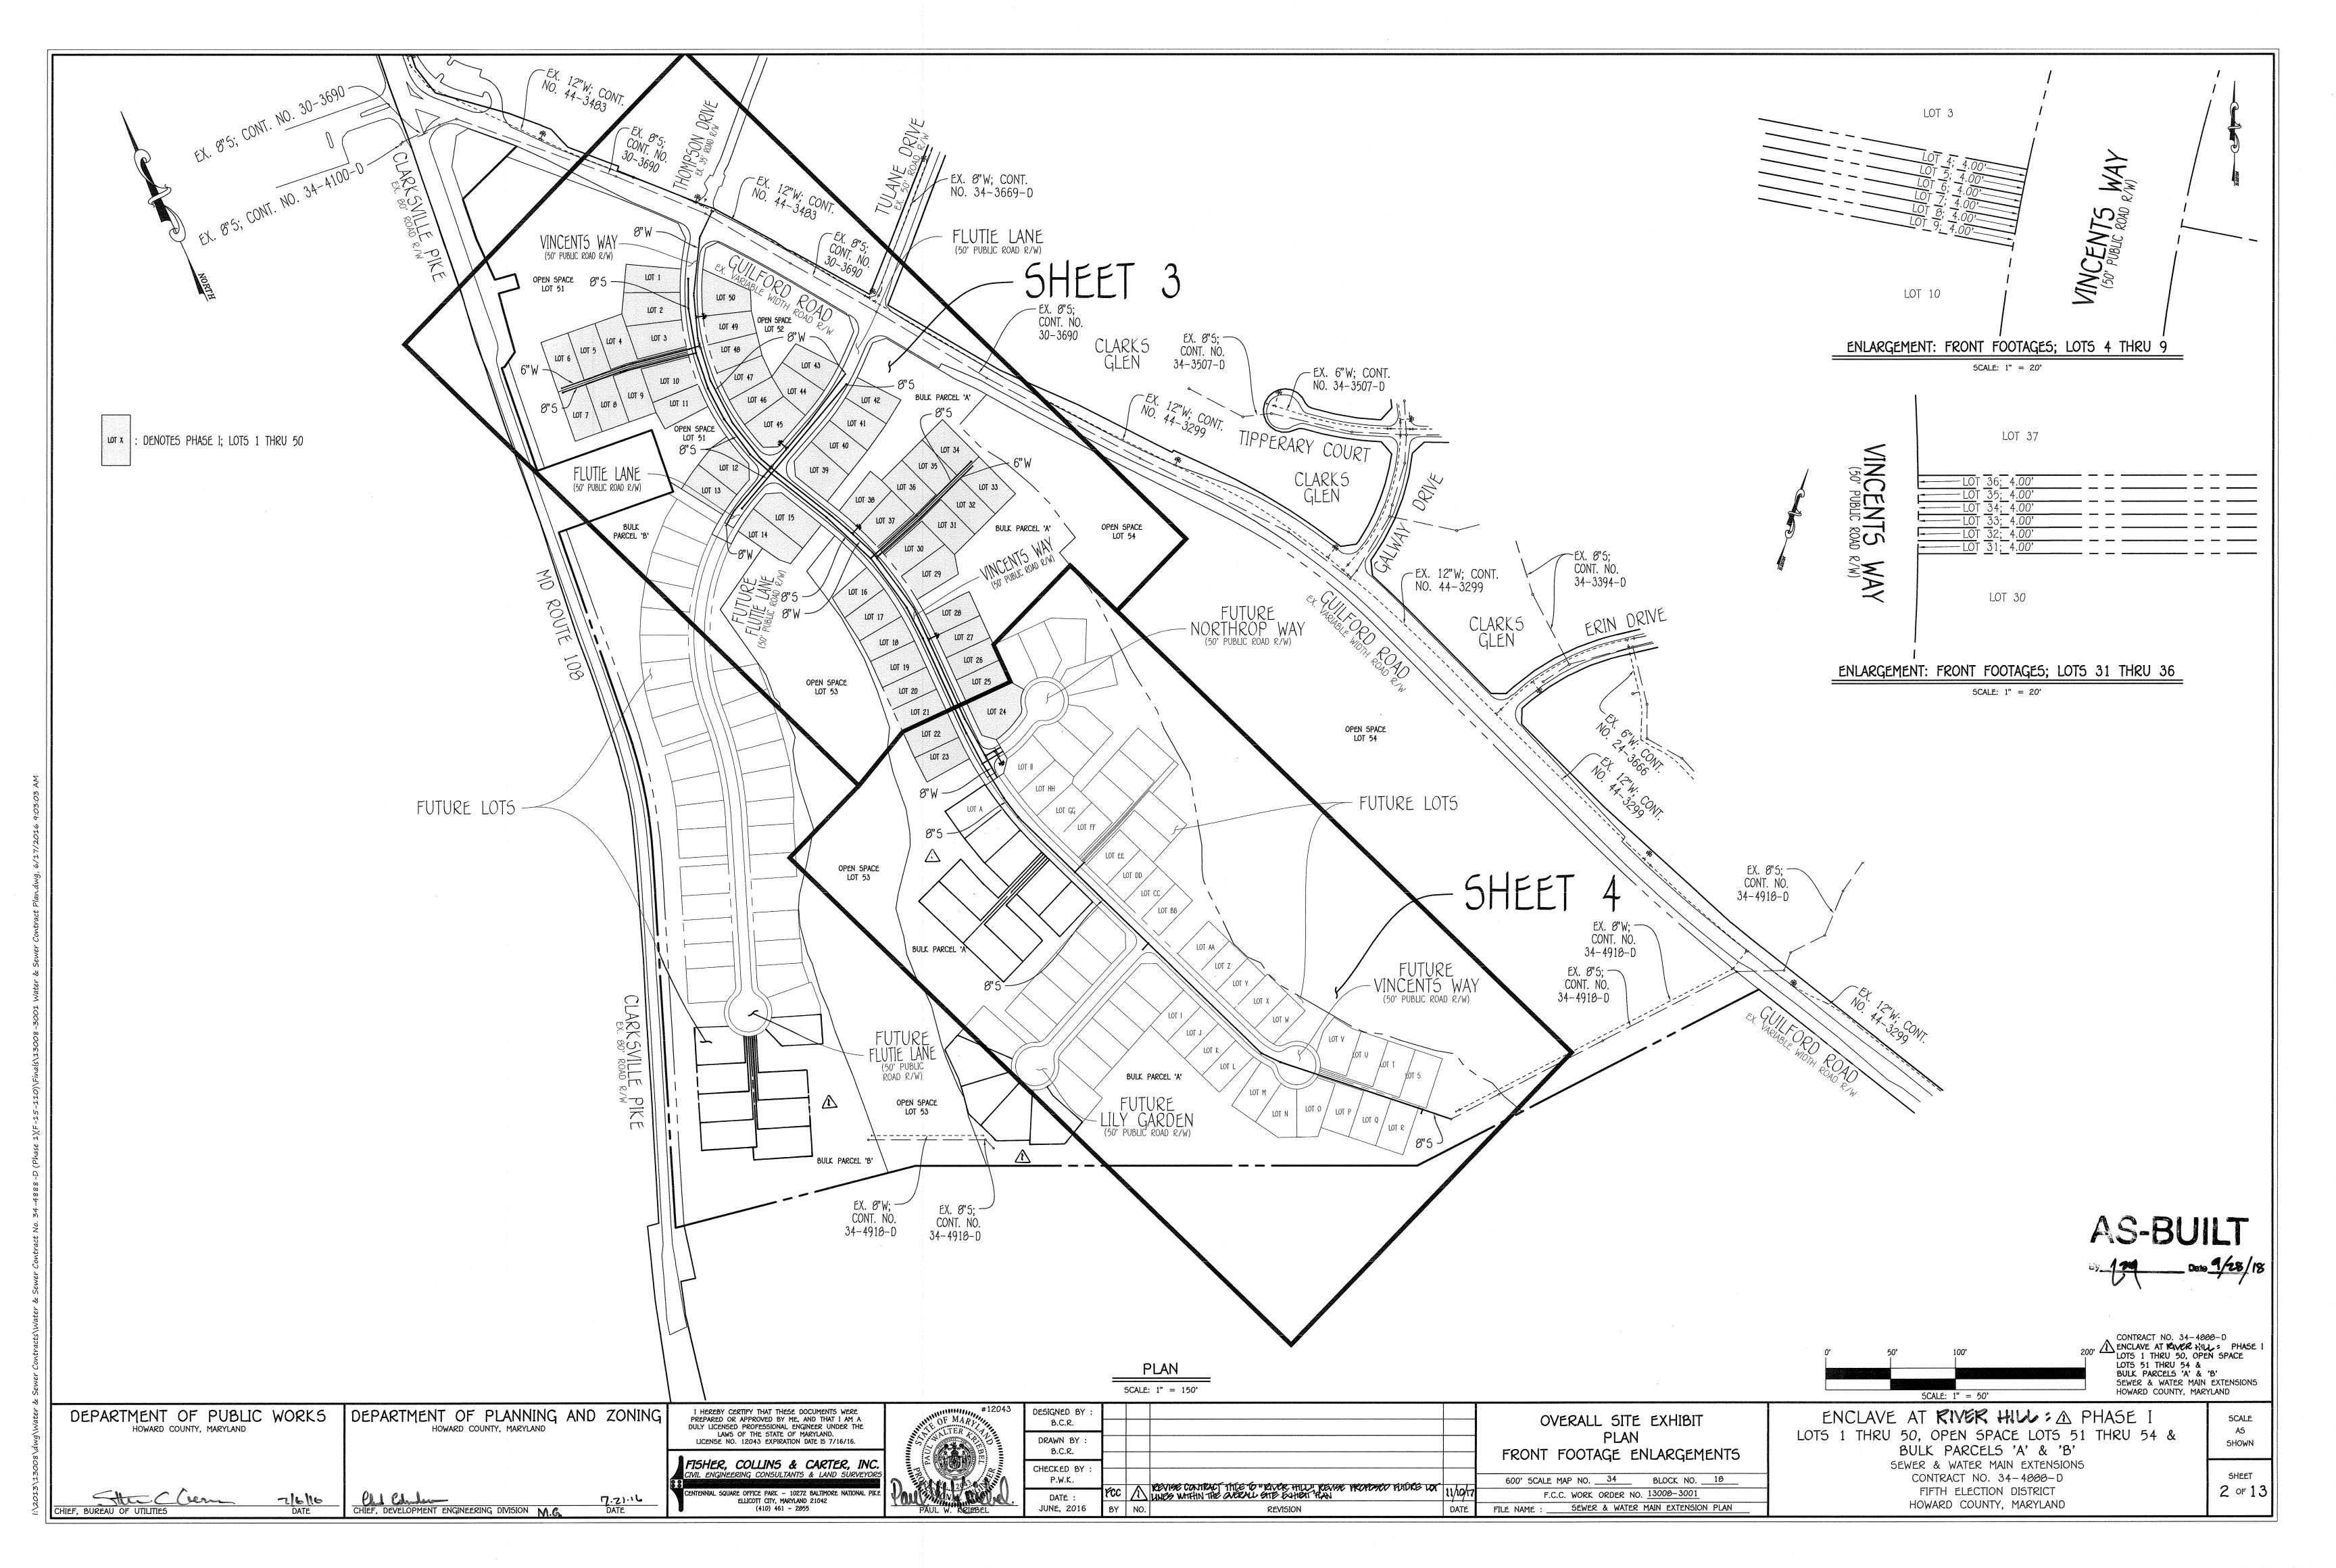


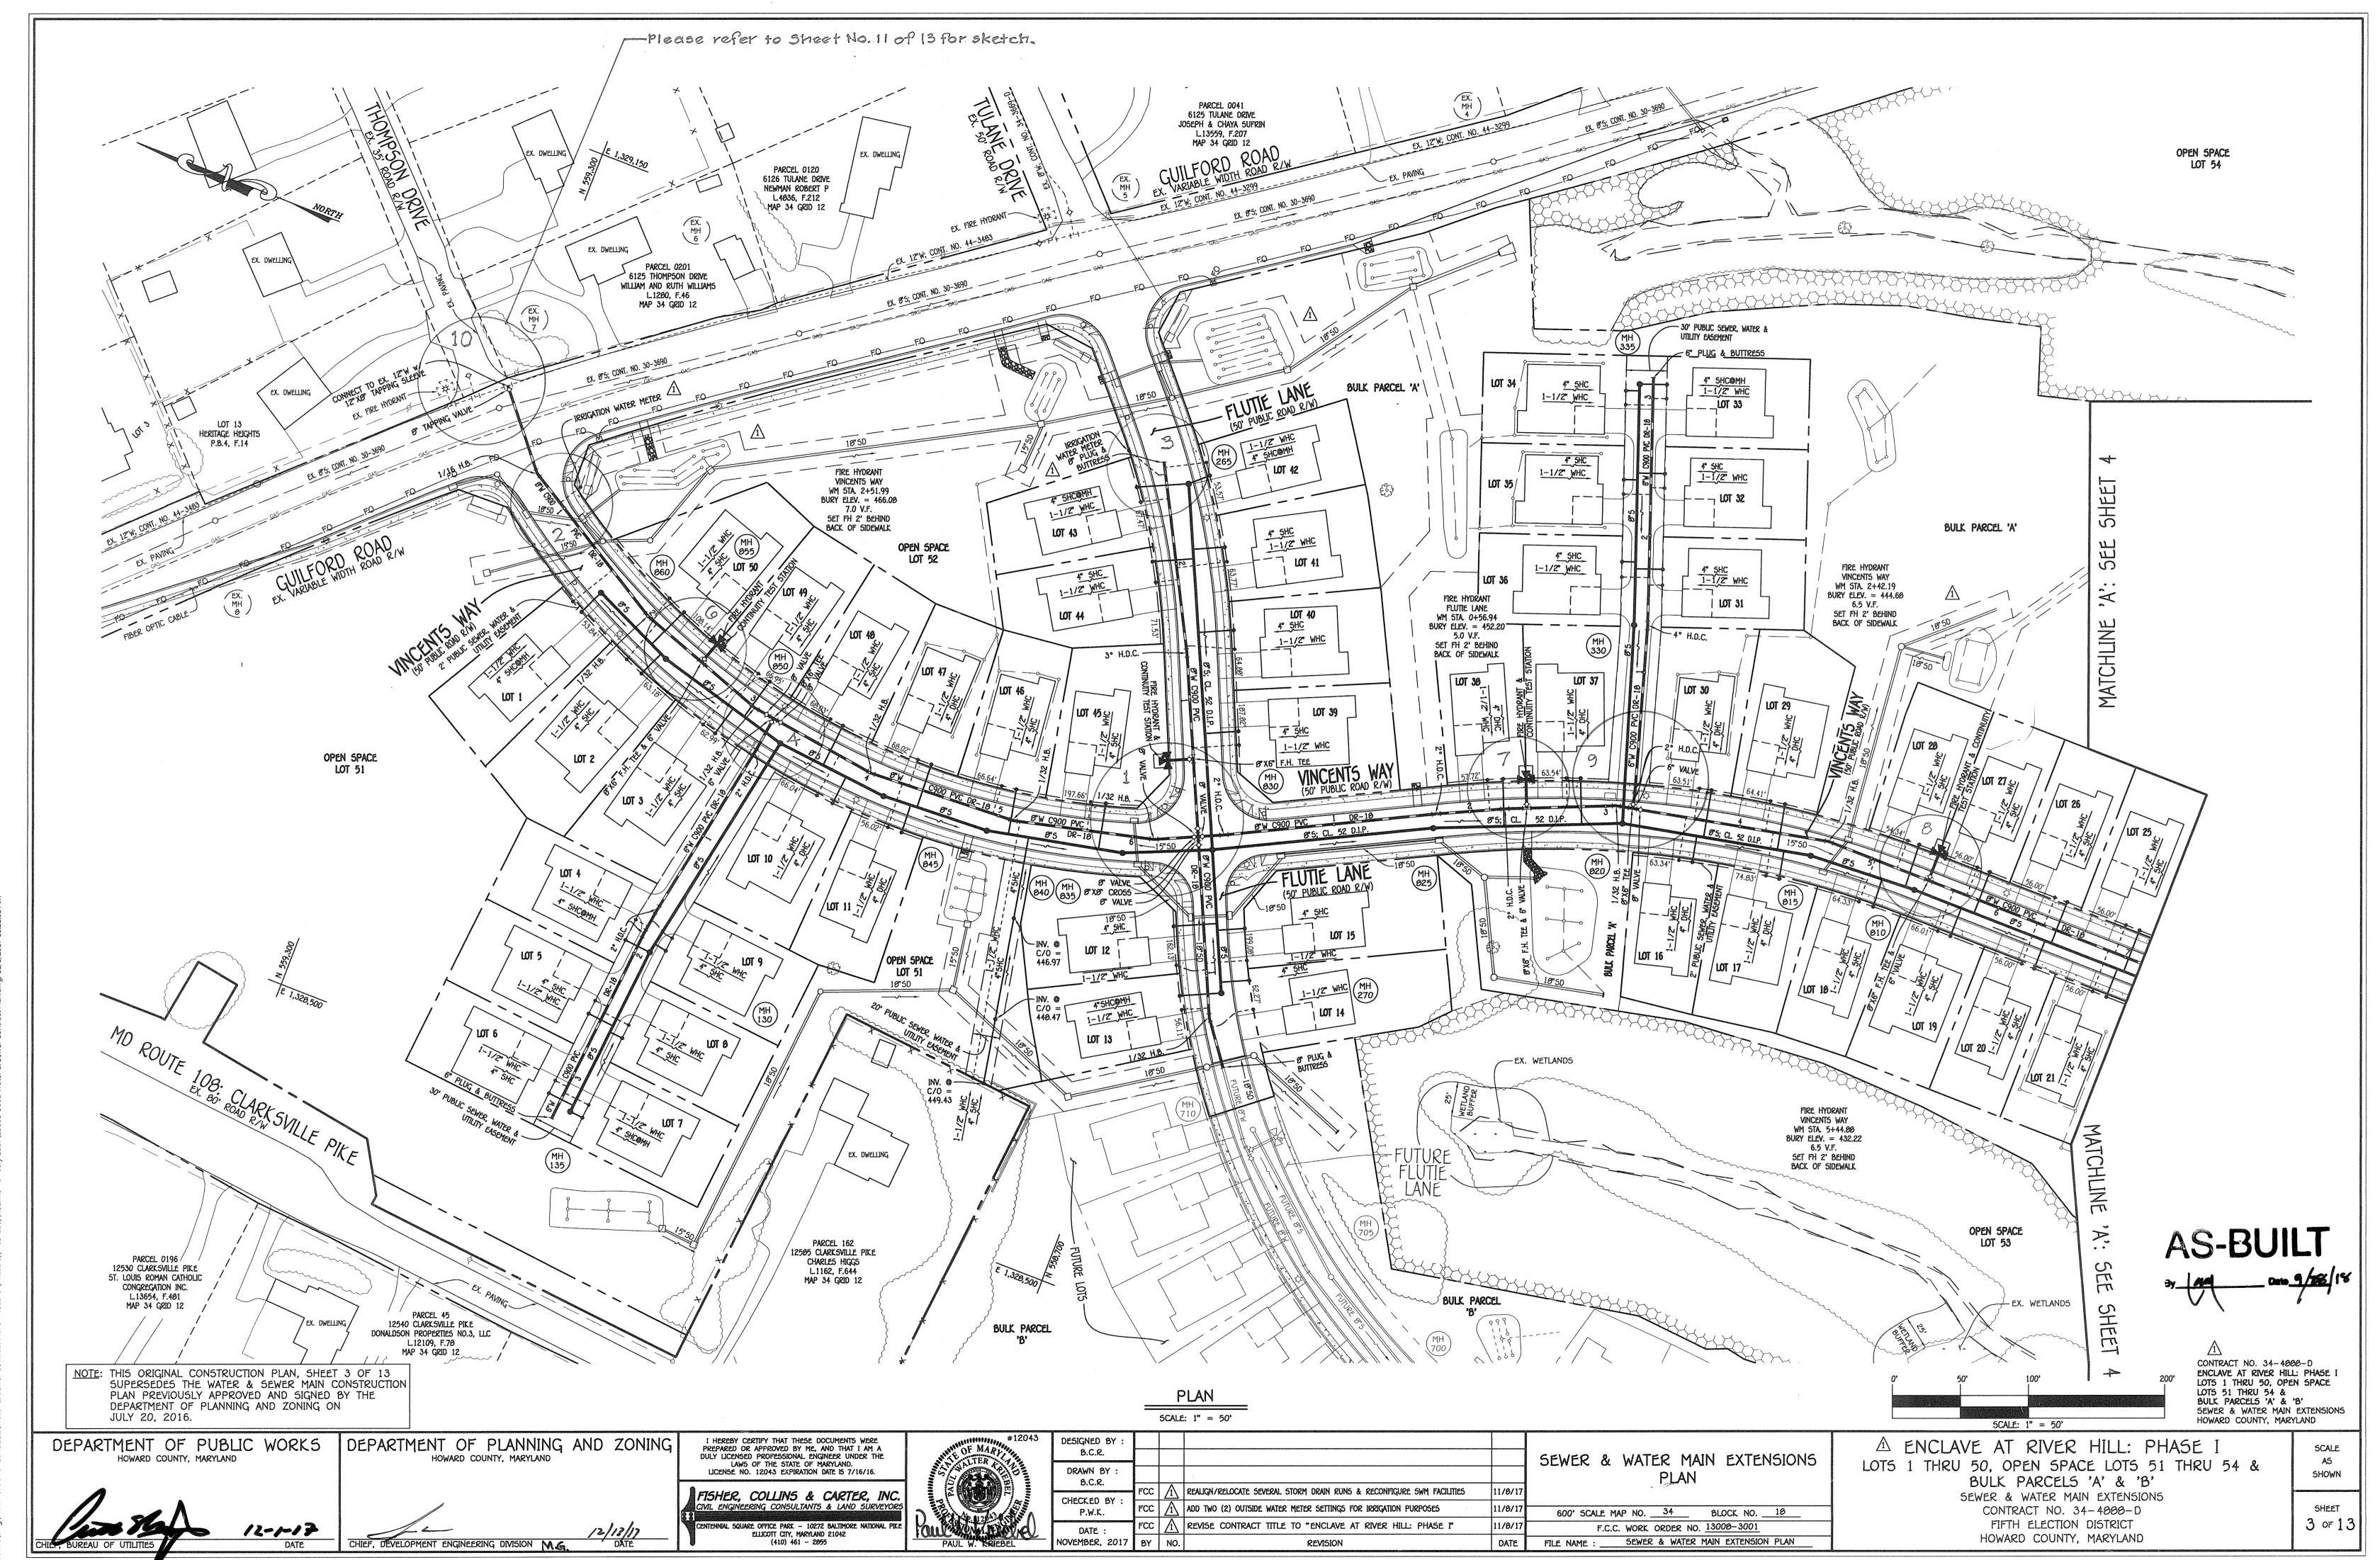

I.\2013\13008\dwq\Water & Sewer Contracts\Water & Sewer Contract No. 34-4888-D (Phase 1)(F-15-110)\Redline #1 - July 2017\13008-3001 Wat

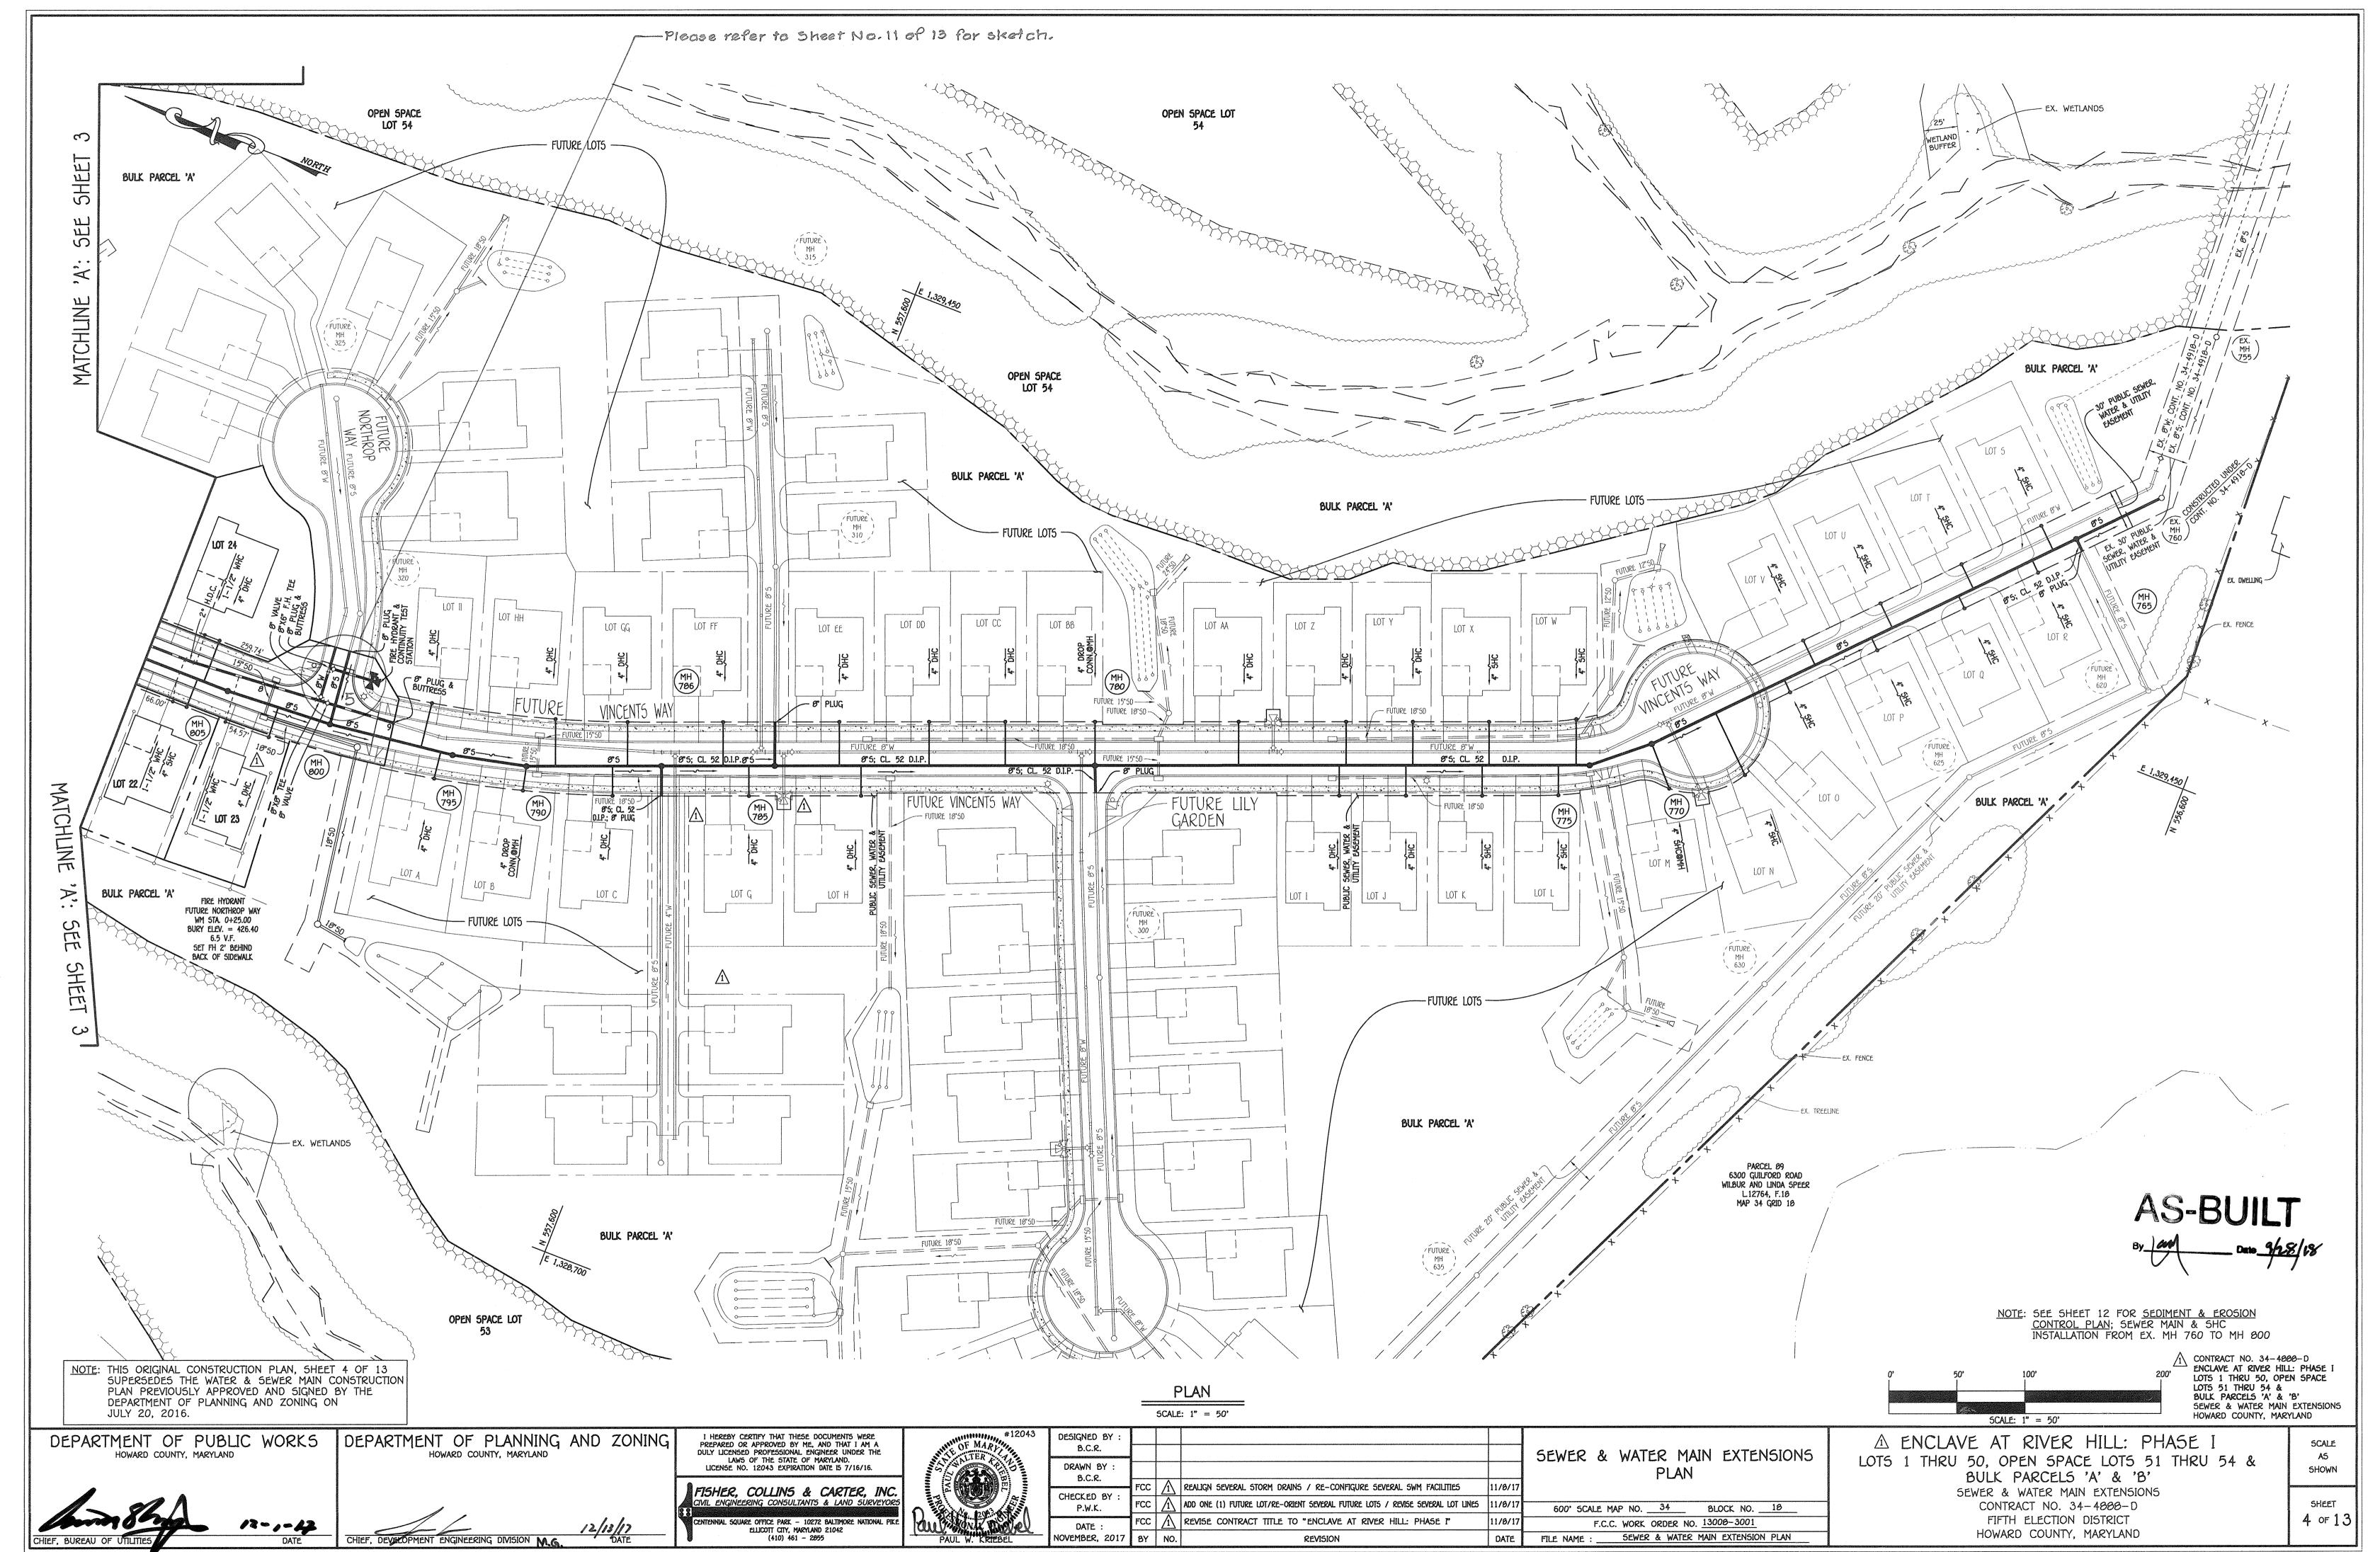

I:\2013\13008\dwg\Water & Sewer Contracts\Water & Sewer Contract No. 34-4888-D (Phase 1)(F-15-110)\Redline #1 - July 2017\13008-3001 Water & Sewe

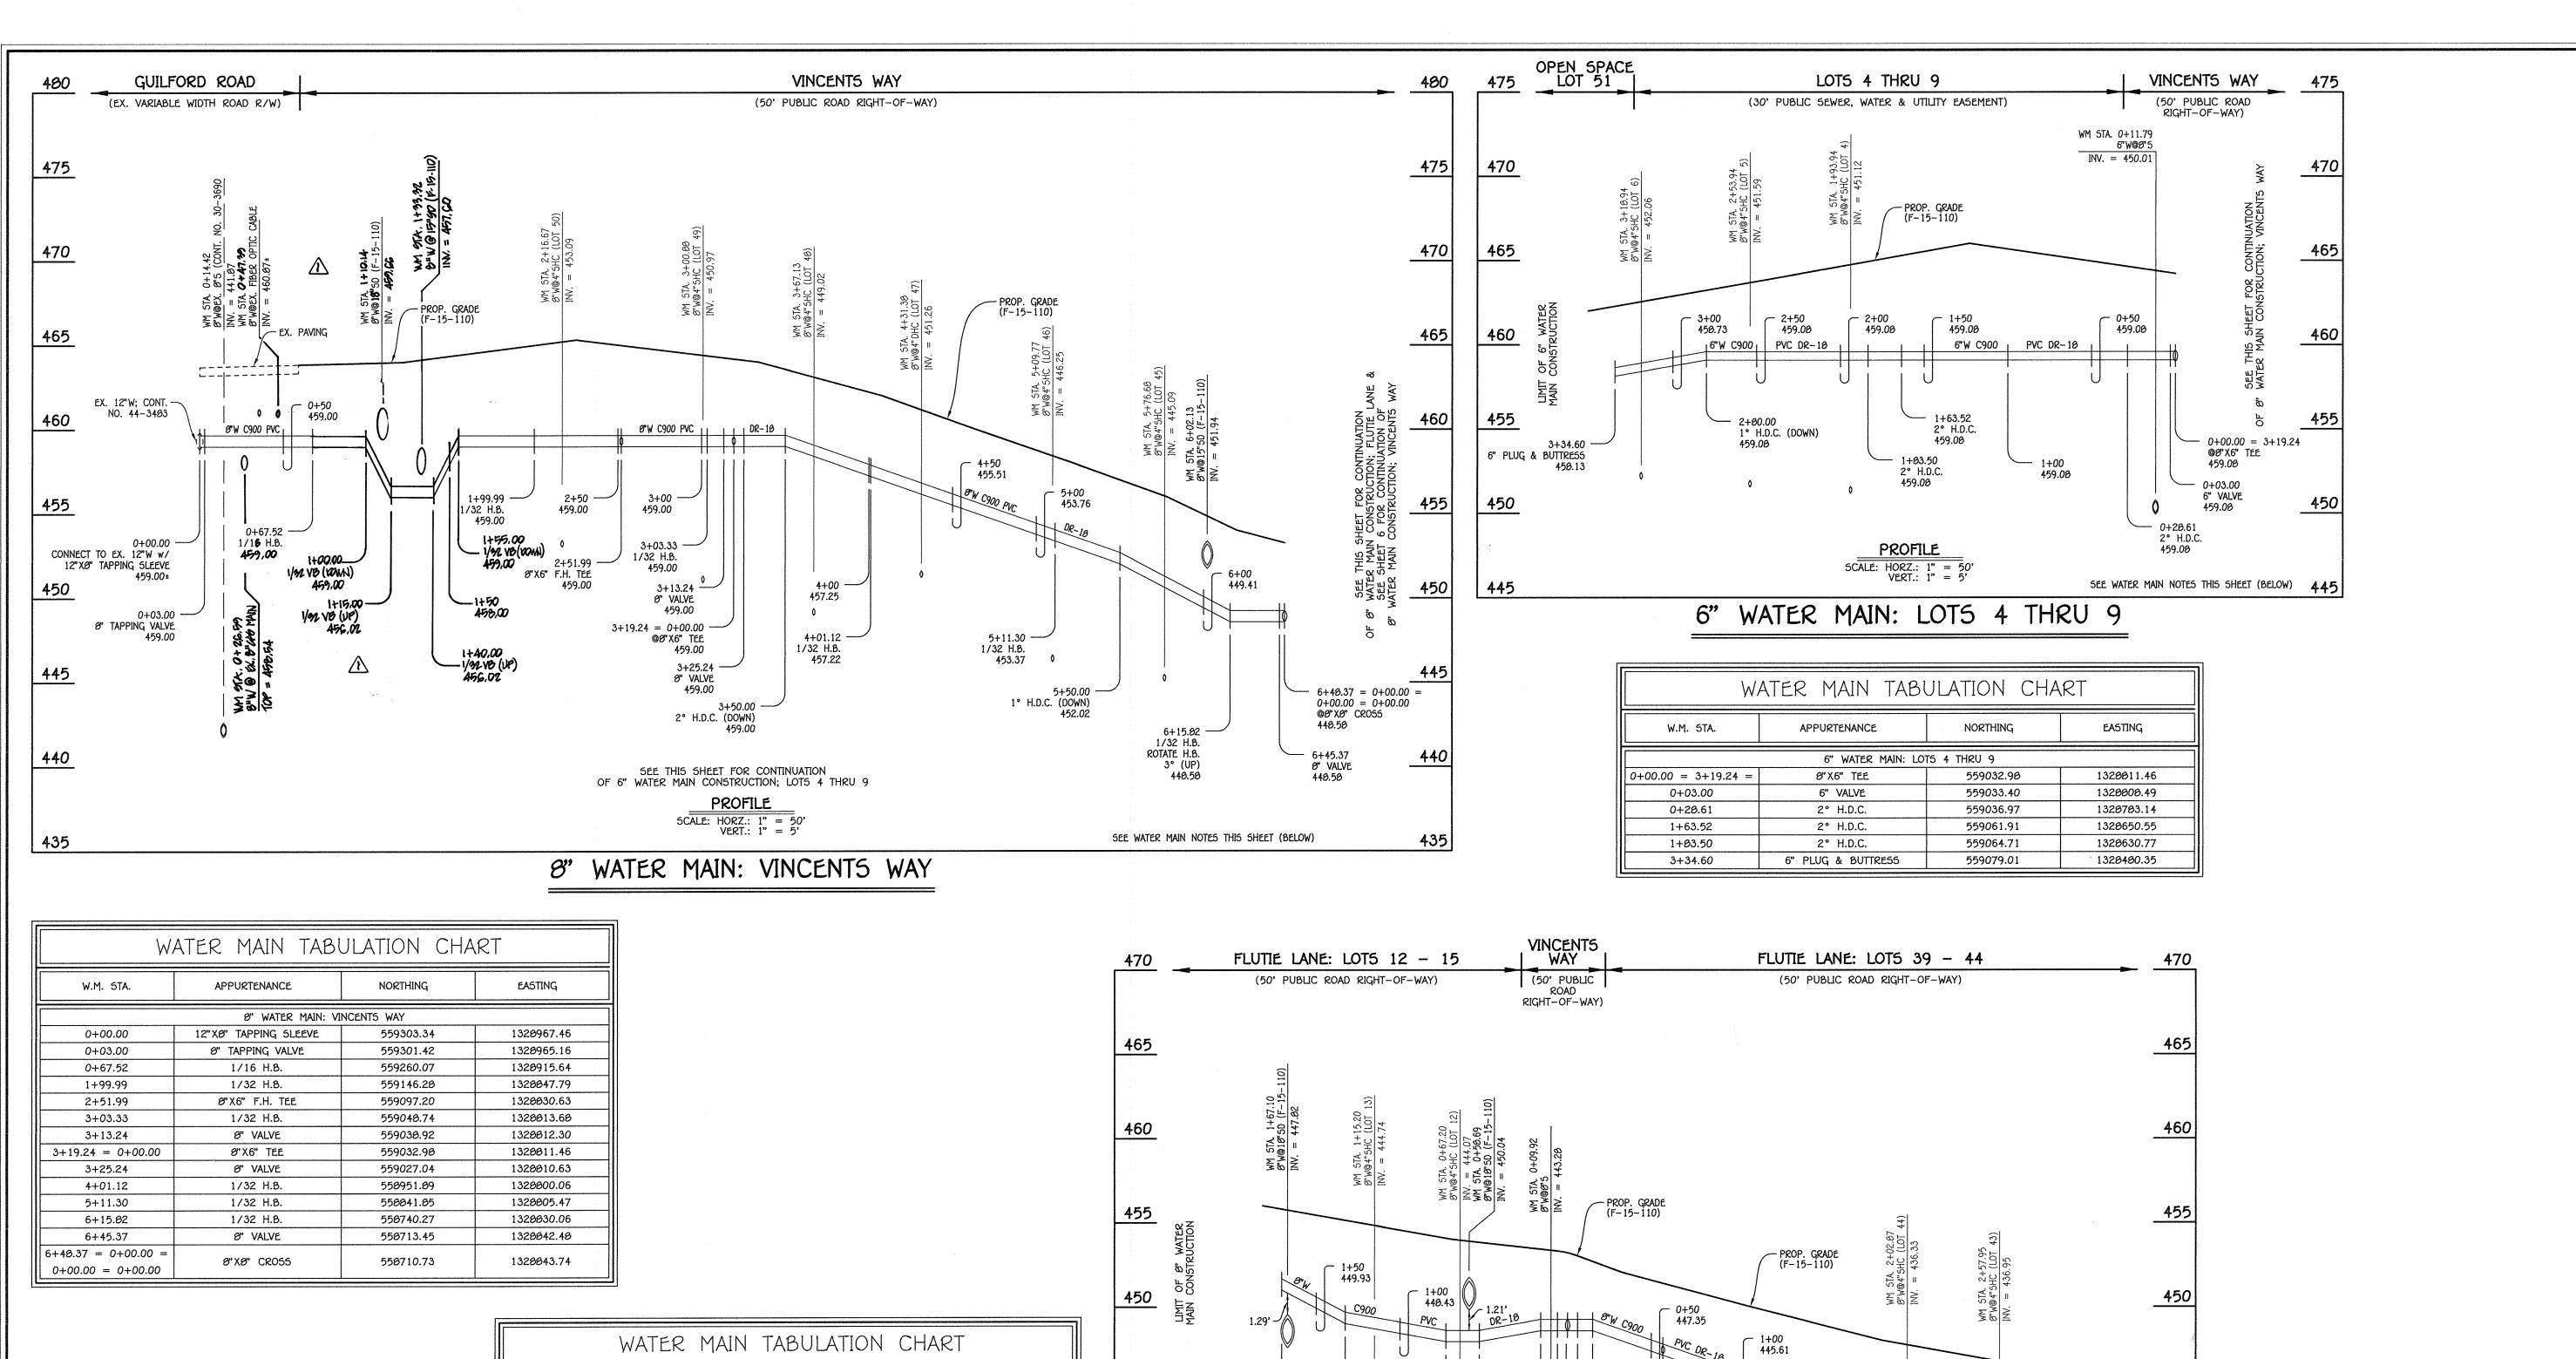

1.0	17 02 11.01	7,7,7,1,0,				
5+11.30	1/32 H.B.	558841.85	1328805.47			
6+15.02	1/32 H.B.	558740.27	1320030.06			
6+45.37	8" VALVE	558713.45	1328842.48			
6+40.37 = 0+00.00 =	011 V 021 COOSE	550710 72	1222212 74			
0+00.00 = 0+00.00	Ø"XØ" CRO55	550710.73	1320043.74			
				ATTO MAIN TAO	III ATIONI CILI	1 OT
			W	ATER MAIN TAB	ULATION CHA	ART
			W.M. STA.	APPURTENANCE	NORTHING	EASTING
				8" WATER MAIN: FLUTIE L	ANE; LOTS 12 - 15	
			0+00.00 = 6+40.37 =		VOT COOCC 550710.72	
			131	aryar mana		132001371
			0+00.00 = 0+00.00	8" X8" CRO55	550710.73	1328843.74
			0+00.00 = 0+00.00 0+06.00	8" X8" CR055	558708.21	1328843.74

1+32.63

1+70.55

WATER MAIN TABULATION CHART									
W.M. STA. APPURTENANCE NORTHING EASTING									
8" WATER MAIN: FLUTIE LANE; LOTS 39 THRU 44									
0+00.00 = 6+40.37 = 0+00.00 = 0+00.00	8" X8" CR055	558710.73	1328043.74						
0+06.00	8" VALVE	550713.25	1328849.18						
0+56.94	8"X6" F.H. TEE	558734.65	1328895.40						
1+34.40	3° H.D.C.	558767.19	1328965.70						
2+75.00	8" PLUG & BUTTRESS	550033.51	1329009.60						

7.21.16 DATE

558655.00


558632.36

1328723.38

1328692.96

1/32 H.B.

8" PLUG & BUTTRESS

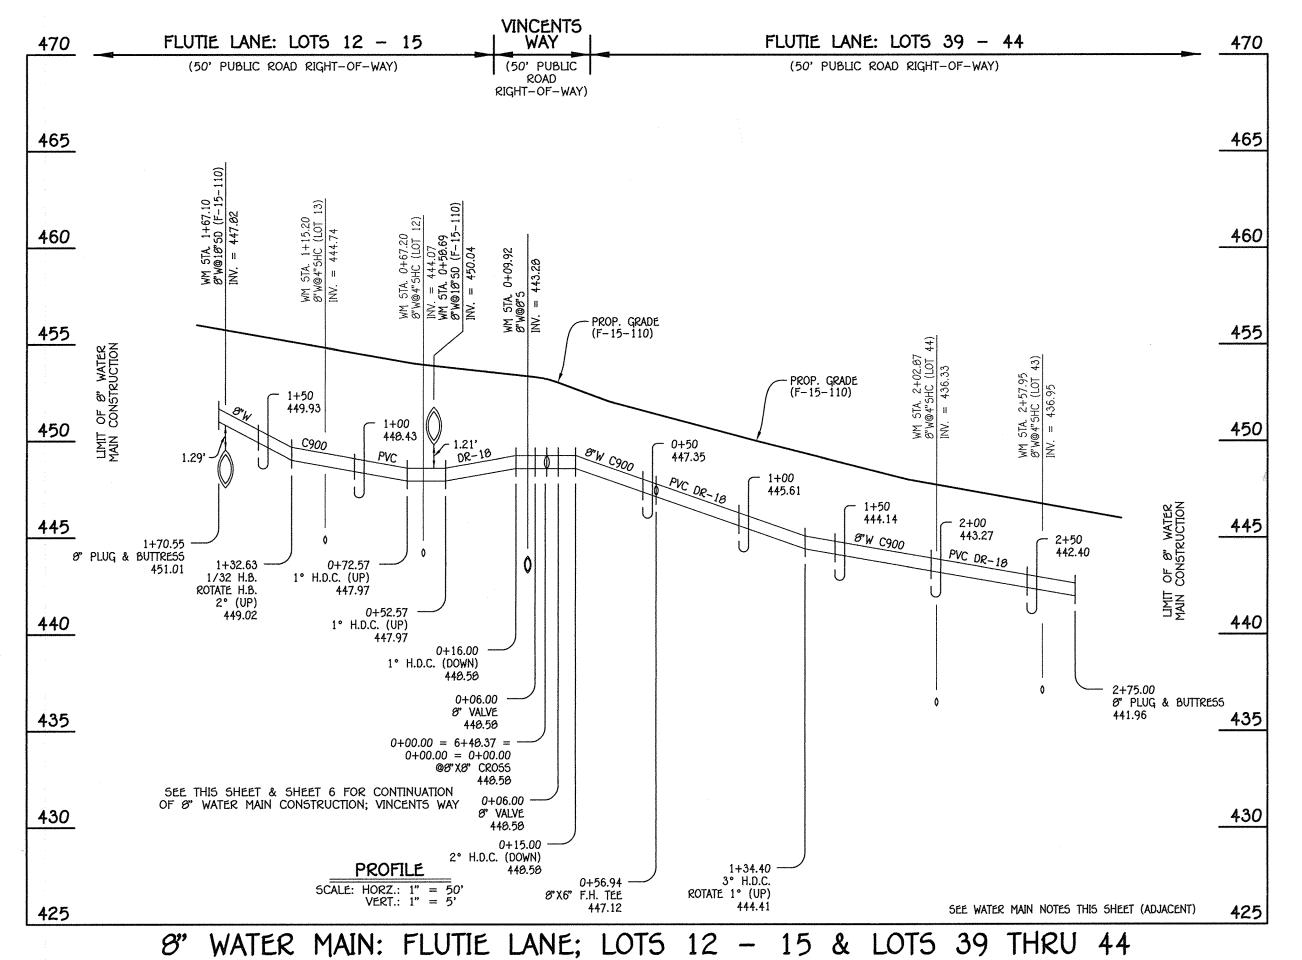

AS-BUILT

WATER MAIN NOTES:

1. ALL WATER MAINS SHALL BE AWWA C900 PVC PIPE; DR-18. 2. ALL PIPE BEDDING, TRACER WIRE, LOCATING TAPE AND OTHER APPURTENANCES SHALL BE IN ACCORDANCE WITH THE HOWARD COUNTY DESIGN MANUAL, VOLUME IV - WATER AND SEWER STANDARDS FOR AWWA C900 PVC WATER PIPE INSTALLATION 3. DEFLECTION COUPLINGS SHALL BE CERTAIN-TEED PVC HIGH

DEFLECTION COUPLINGS. 4. ALL WATER HOUSE CONNECTIONS AND TAPS SHALL BE PERFORMED USING A SADDLE.

CONTRACT NO. 34-4888-D LOTS 1 THRU 50, OPEN SPACE LOTS 51 THRU 54 & BULK PARCELS 'A' & 'B' SEWER & WATER MAIN EXTENSIONS HOWARD COUNTY, MARYLAND

DEPARTMENT OF PUBLIC WORKS DEPARTMENT OF PLANNING AND ZONING HOWARD COUNTY, MARYLAND HOWARD COUNTY, MARYLAND CHIEF, DEVELOPMENT ENGINEERING DIVISION M.G.

I HEREBY CERTIFY THAT THESE DOCUMENTS WERE PREPARED OR APPROVED BY ME, AND THAT I AM A DULY LICENSED PROFESSIONAL ENGINEER UNDER THE LAWS OF THE STATE OF MARYLAND.
LICENSE NO. 12043 EXPIRATION DATE IS 7/16/16. FISHER, COLLINS & CARTER, INC SQUARE OFFICE PARK - 10272 BALTIMORE NATIONAL PIK ELLICOTT CITY, MARYLAND 21042


				V	
DESIGNED BY : B.C.R.					LIATTO MAINL TYTTNICIONIC
DRAWN BY:					WATER MAIN EXTENSIONS PROFILES, CHARTS & NOTES
CHECKED BY :					
P.W.K.			PRANCE MARKET AND AND INTO AND THE THE WALLE WASTER MAIN FROMEN OF		600' SCALE MAP NO. <u>34</u> BLOCK NO. <u>18</u>
DATE :	FCC		VINCENTS WAY, WM STA. O+CT = 10 WM STA. 1+50 ±	11/10/17	F.C.C. WORK ORDER NO. <u>13000-3001</u>
JUNE, 2016	ВY	NO.	REVISION	DATE	FILE NAME : SEWER & WATER MAIN EXTENSION PLAN
	B.C.R. DRAWN BY: B.C.R. CHECKED BY: P.W.K. DATE:	B.C.R. DRAWN BY: B.C.R. CHECKED BY: P.W.K. DATE: FCC	B.C.R. DRAWN BY: B.C.R. CHECKED BY: P.W.K. DATE: FCC	B.C.R. DRAWN BY: B.C.R. CHECKED BY: P.W.K. DATE: FCC N KEWE CONTRACT TITLE TO "KIVEK HILL", REVISE WATER MAIN PROFILE, VINCENTS WAY, MM STA. 0+67± 10 WIM STA. 1+50±	B.C.R. DRAWN BY: B.C.R. CHECKED BY: P.W.K. DATE: FCC NEW CONTRACT TITLE TO "RIVER HILL", REVISE WATER MAIN PROFILE, 11/10/17

ENCLAVE AT RIVER HILL: A PHASE LOTS 1 THRU 50, OPEN SPACE LOTS 51 THRU 54 & BULK PARCELS 'A' & 'B'

SEWER & WATER MAIN EXTENSIONS CONTRACT NO. 34-4888-D FIFTH ELECTION DISTRICT HOWARD COUNTY, MARYLAND

5HOWN SHEET 5 of 13

SCALE

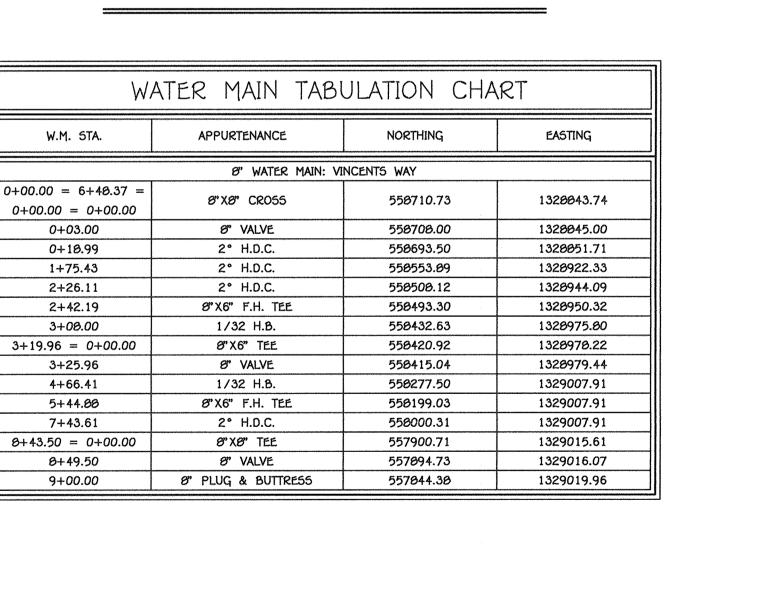

425 425 - 8"W C900 PVC DR-18 420 420 415 0+00.00 = 8+43.50 -98" X8" TEE 0" PLUG & BUTTRESS 0+03.00 -8" VALVE 419.82 0+25.00 -410 410 8"X6" F.H. TEE 405 405 SEE WATER MAIN NOTES THIS SHEET (ADJACENT) 5CALE: HORZ .: 1" = 50' 400 400 8" WATER MAIN: FUTURE NORTHROP WAY

The second of th

LOTS 31 THRU 36 VINCENTS WAY (50' PUBLIC ROAD RIGHT-OF-WAY) (30' PUBLIC SEWER, WATER & UTILITY EASEMENT) — PROP. GRADE (F-15-110) 440 - 2+00 437.00 2+50 435.25 435 - 3+00 432.62 1+25.00 2° DEFLECTION COUPLING (DOWN) 89 430 4° H.D.C. 437.95 2° DEFLECTION COUPLING (DOWN) 437.95 0+00.00 = 3+19.96@8"X6" TEE 434.11 - 3+15.36 6" PLUG & BUTTRESS 431.82 2+45.00 -1° DEFLECTION COUPLING (DOWN) 6" VALVE 434.11 0+08.00 2° H.D.C. 0+14.95 -2° H.D.C. ROTATE 1° (DOWN) 434.11 SEE WATER MAIN NOTES THIS SHEET (BELOW)

6" WATER MAIN: LOTS 31 THRU 36

WATER MAIN TABULATION CHART									
W.M. STA.	APPURTENANCE	NORTHING	EASTING						
6" WATER MAIN: LOTS 31 THRU 36									
0+00.00 = 3+19.96	Ø"X6" TEE	550420.92	1320970.22						
0+03.00	6" VALVE	550421.52	1328981.16						
0+08.00	2° H.D.C.	550422.54	1320906.06						
0+14.95	2° H.D.C.	558424.30	1328992.78						
1+34.10	4° H.D.C.	550450.90	1329106.05						
3+15.36	6" PLUG & BUTTRESS	558520.81	1329277.16						

W.M. STA. APPURTENANCE NORTHING EASTING								
8" WATER MAIN: FUTURE NORTHROP WAY								
0+00.00 = 8+43.50	8"X8" TEE	557900.71	1329015.61					
0+03.00	8" VALVE	557900.95	1329010.60					
0+25.00	8"X6" F.H. TEE	557902.64	1329040.53					
0+40.81	8" PLUG & BUTTRESS	557903.06	1329056.30					

WATER MAIN NOTES:

PERFORMED USING A SADDLE.

1. ALL WATER MAINS SHALL BE AWWA C900 PVC PIPE; DR-18. 2. ALL PIPE BEDDING, TRACER WIRE, LOCATING TAPE AND OTHER APPURTENANCES SHALL BE IN ACCORDANCE WITH THE HOWARD COUNTY DESIGN MANUAL, VOLUME IV - WATER AND SEWER STANDARDS FOR AWWA C900 PVC WATER PIPE INSTALLATION

3. DEFLECTION COUPLINGS SHALL BE CERTAIN-TEED PVC HIGH DEFLECTION COUPLINGS. 4. ALL WATER HOUSE CONNECTIONS AND TAPS SHALL BE

5CALE: 1" = 50'

CONTRACT NO. 34-4888-D ENCLAVE AT RIVER HILL: PHASE I LOTS 1 THRU 50, OPEN SPACE LOTS 51 THRU 54 & BULK PARCELS 'A' & 'B' SEWER & WATER MAIN EXTENSIONS HOWARD COUNTY, MARYLAND

DEPARTMENT OF PUBLIC WORKS

JULY 20, 2016.

NOTE: THIS ORIGINAL CONSTRUCTION PLAN, SHEET 6 OF 13

DEPARTMENT OF PLANNING AND ZONING ON

SUPERSEDES THE WATER & SEWER MAIN CONSTRUCTION

PLAN PREVIOUSLY APPROVED AND SIGNED BY THE

DEPARTMENT OF PLANNING AND ZONING HOWARD COUNTY, MARYLAND HOWARD COUNTY, MARYLAND

18-1-17

CHIEF, DEVELOPMENT ENGINEERING DIVISION MA

PREPARED OR APPROVED BY ME, AND THAT I AM A DULY LICENSED PROFESSIONAL ENGINEER UNDER THE LAWS OF THE STATE OF MARYLAND. LICENSE NO. 12043 EXPIRATION DATE IS 7/16/16. FISHER, COLLINS & CARTER, INC. CIVIL ENGINEERING CONSULTANTS & LAND SURVEYOR nnial square office park – 10272 baltimore national pik ELLICOTT CITY, MARYLAND 21042 (410) 461 - 2055

I HEREBY CERTIFY THAT THESE DOCUMENTS WERE



2043	DESIGNED BY : B.C.R.					
	DRAWN BY : B.C.R.					
	CHECKED BY : P.W.K.	FCC	Λ	REVISE PROFILE: 6" WATER MAIN: LOTS 31 THRU 36; PROPOSED GRADE REVISED.	11/8/17	
	DATE :	FCC	Λ	REVISE CONTRACT TITLE TO "ENCLAVE AT RIVER HILL: PHASE I"	11/8/17	
<u> </u>	NOVEMBER, 2017	BY	NO.	REVISION	DATE	

WATER MAIN EXTENSIONS PROFILES, CHARTS & NOTES

600' SCALE MAP NO. 34 BLOCK NO. 18 F.C.C. WORK ORDER NO. 13008-3001 FILE NAME : ____ SEWER & WATER MAIN EXTENSION PLAN


ENCLAVE AT RIVER HILL: PHASE I LOTS 1 THRU 50, OPEN SPACE LOTS 51 THRU 54 & BULK PARCELS 'A' & 'B'


SEWER & WATER MAIN EXTENSIONS CONTRACT NO. 34-4888-D FIFTH ELECTION DISTRICT HOWARD COUNTY, MARYLAND


SHEET 6 of 13

5CALE

SHOWN

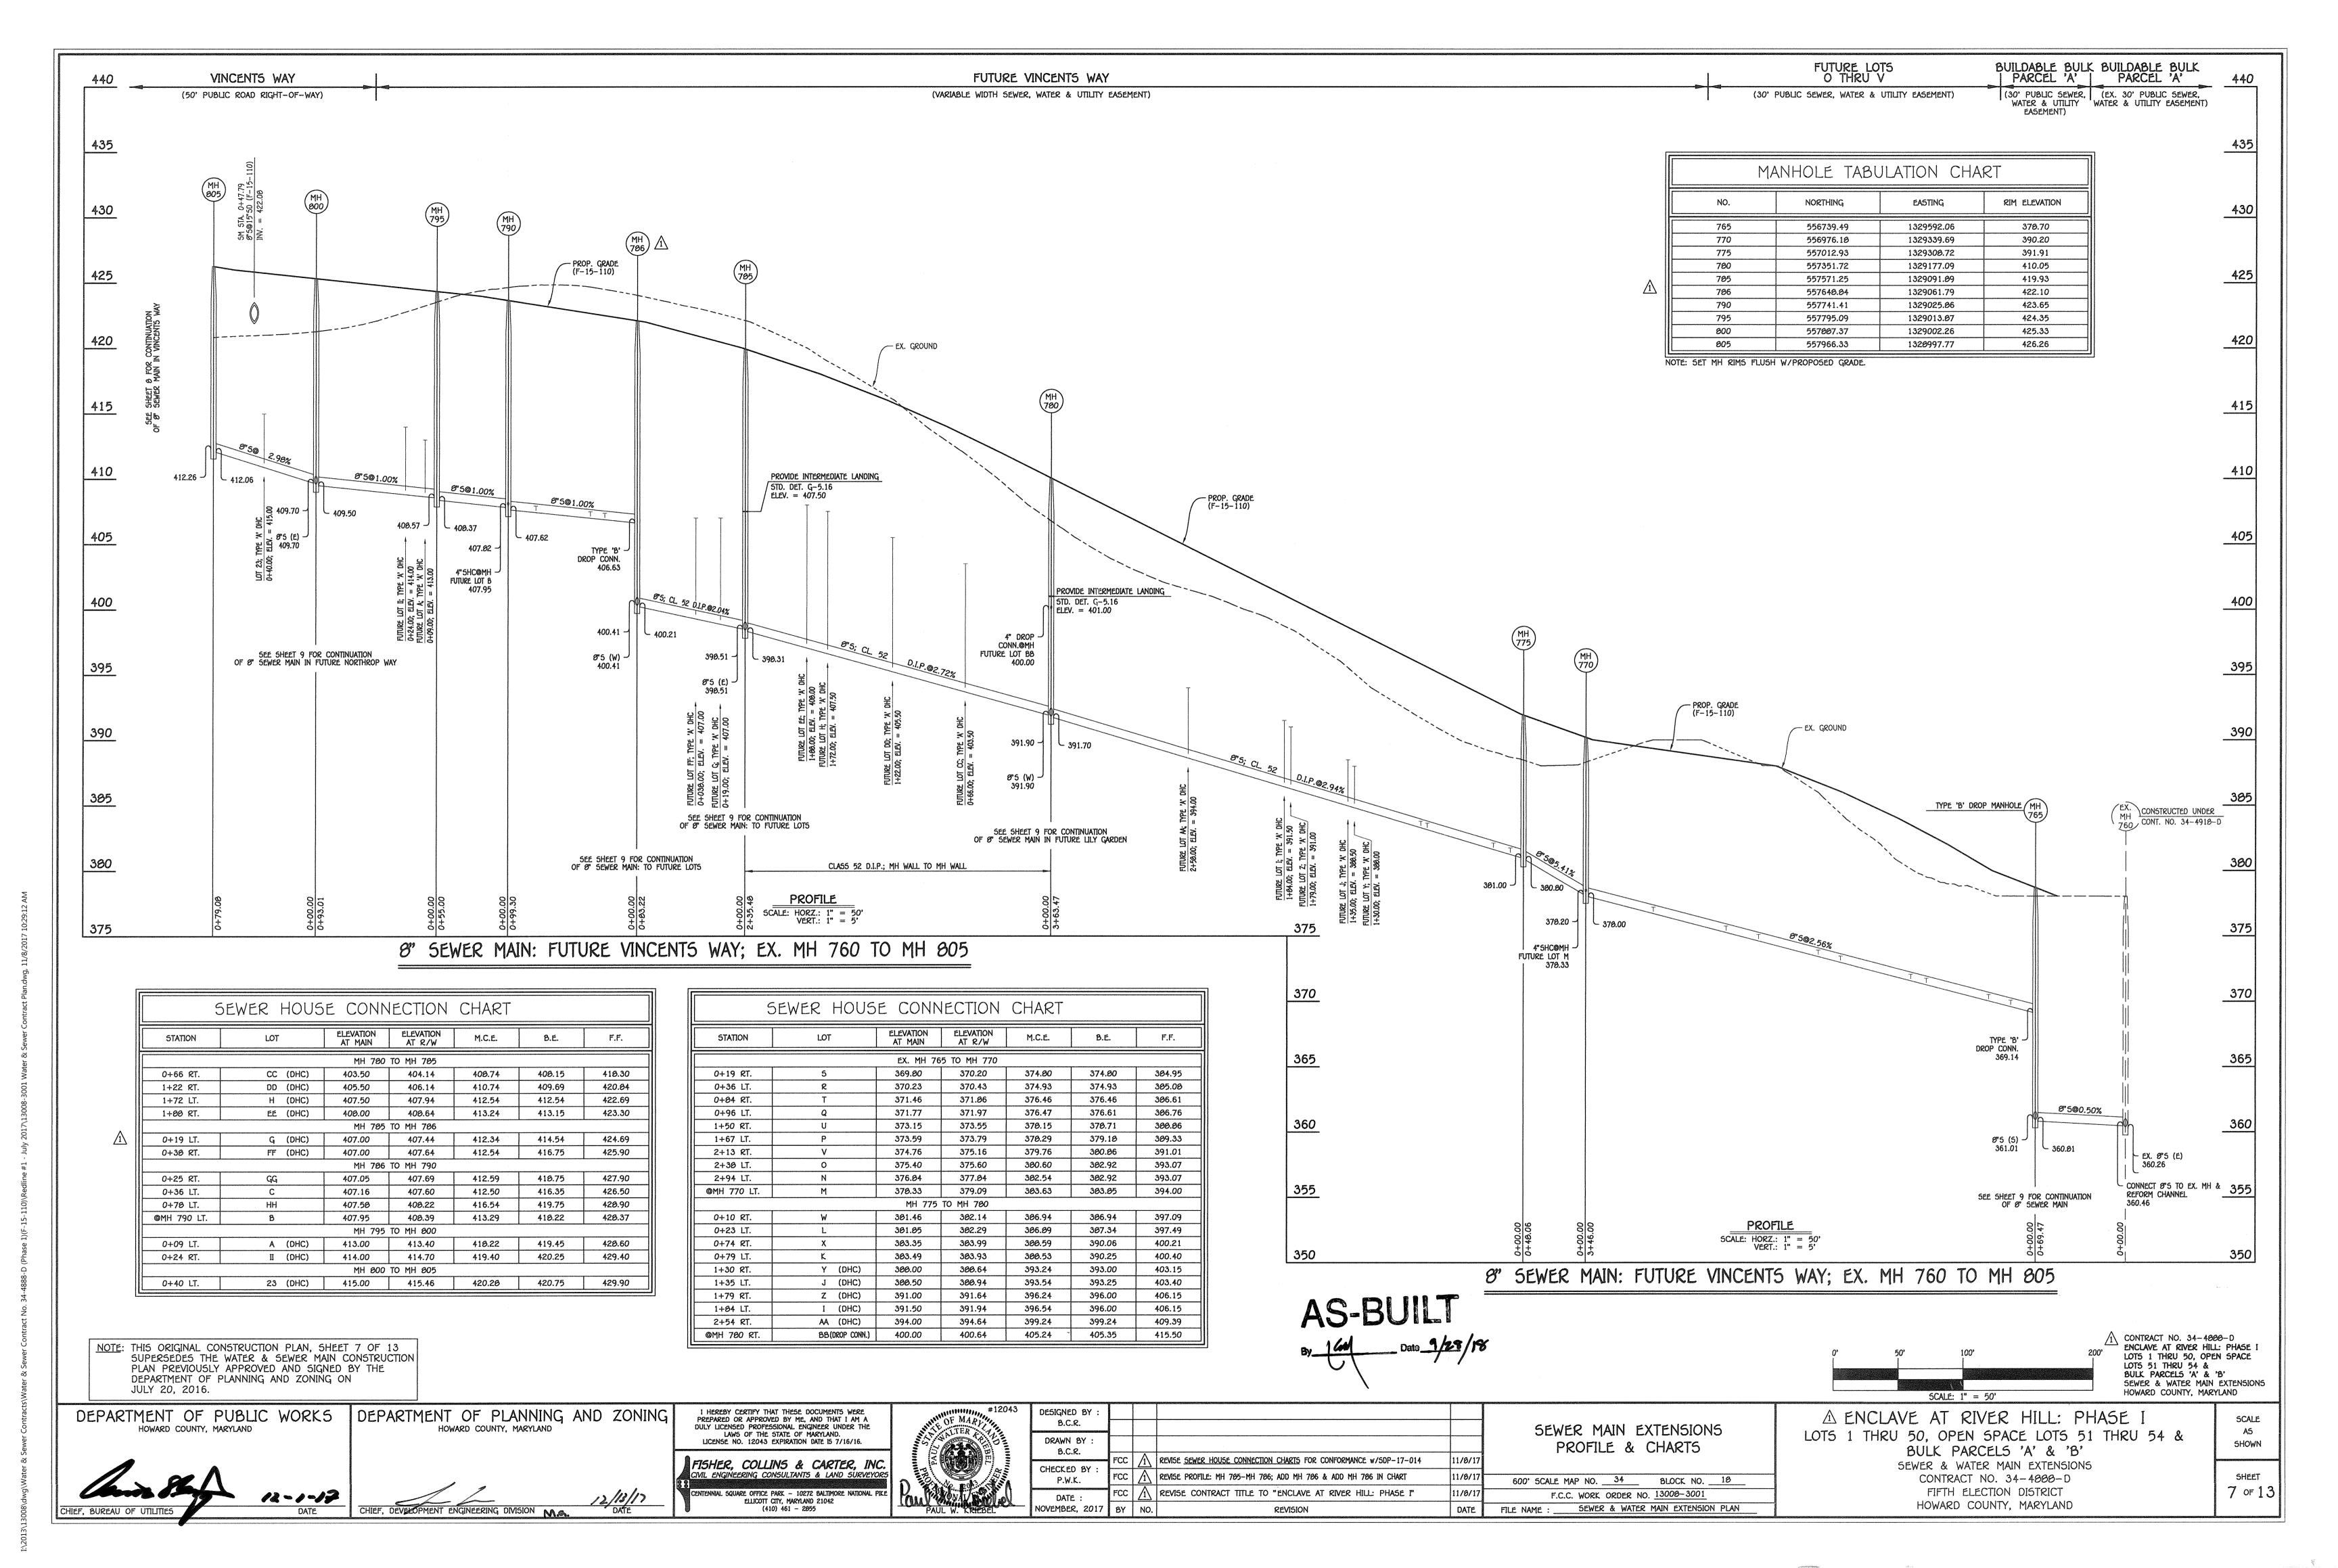

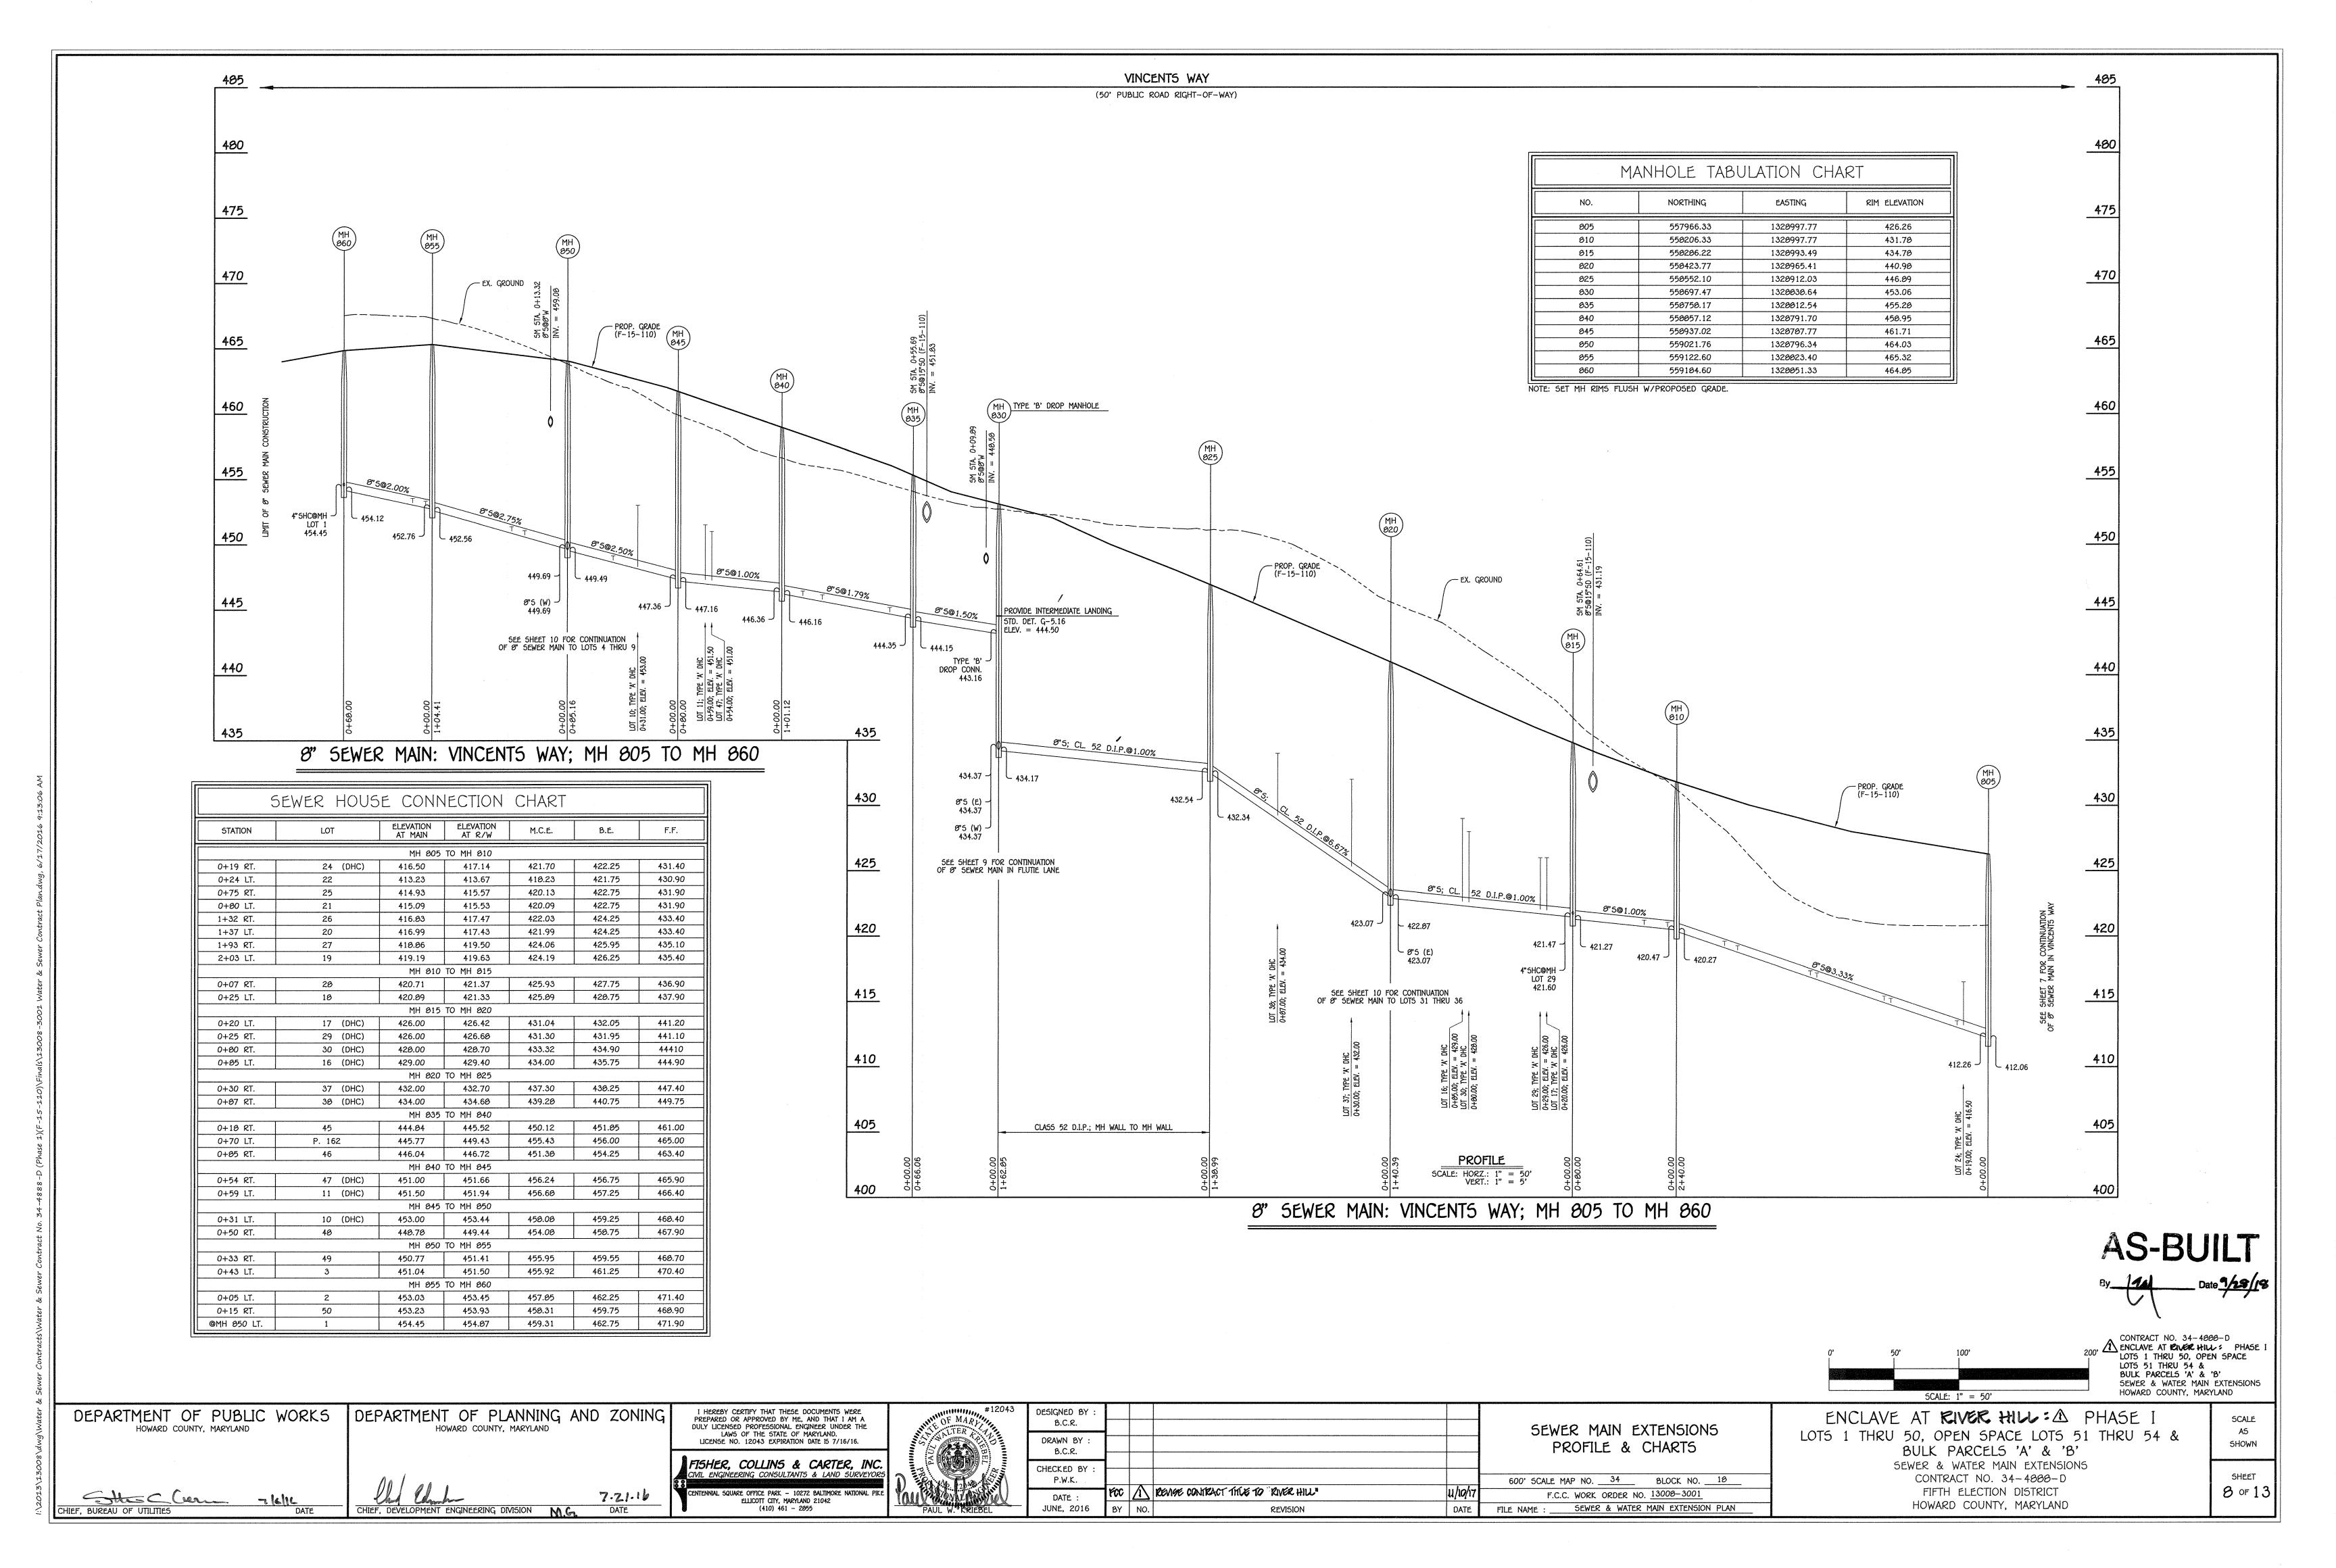

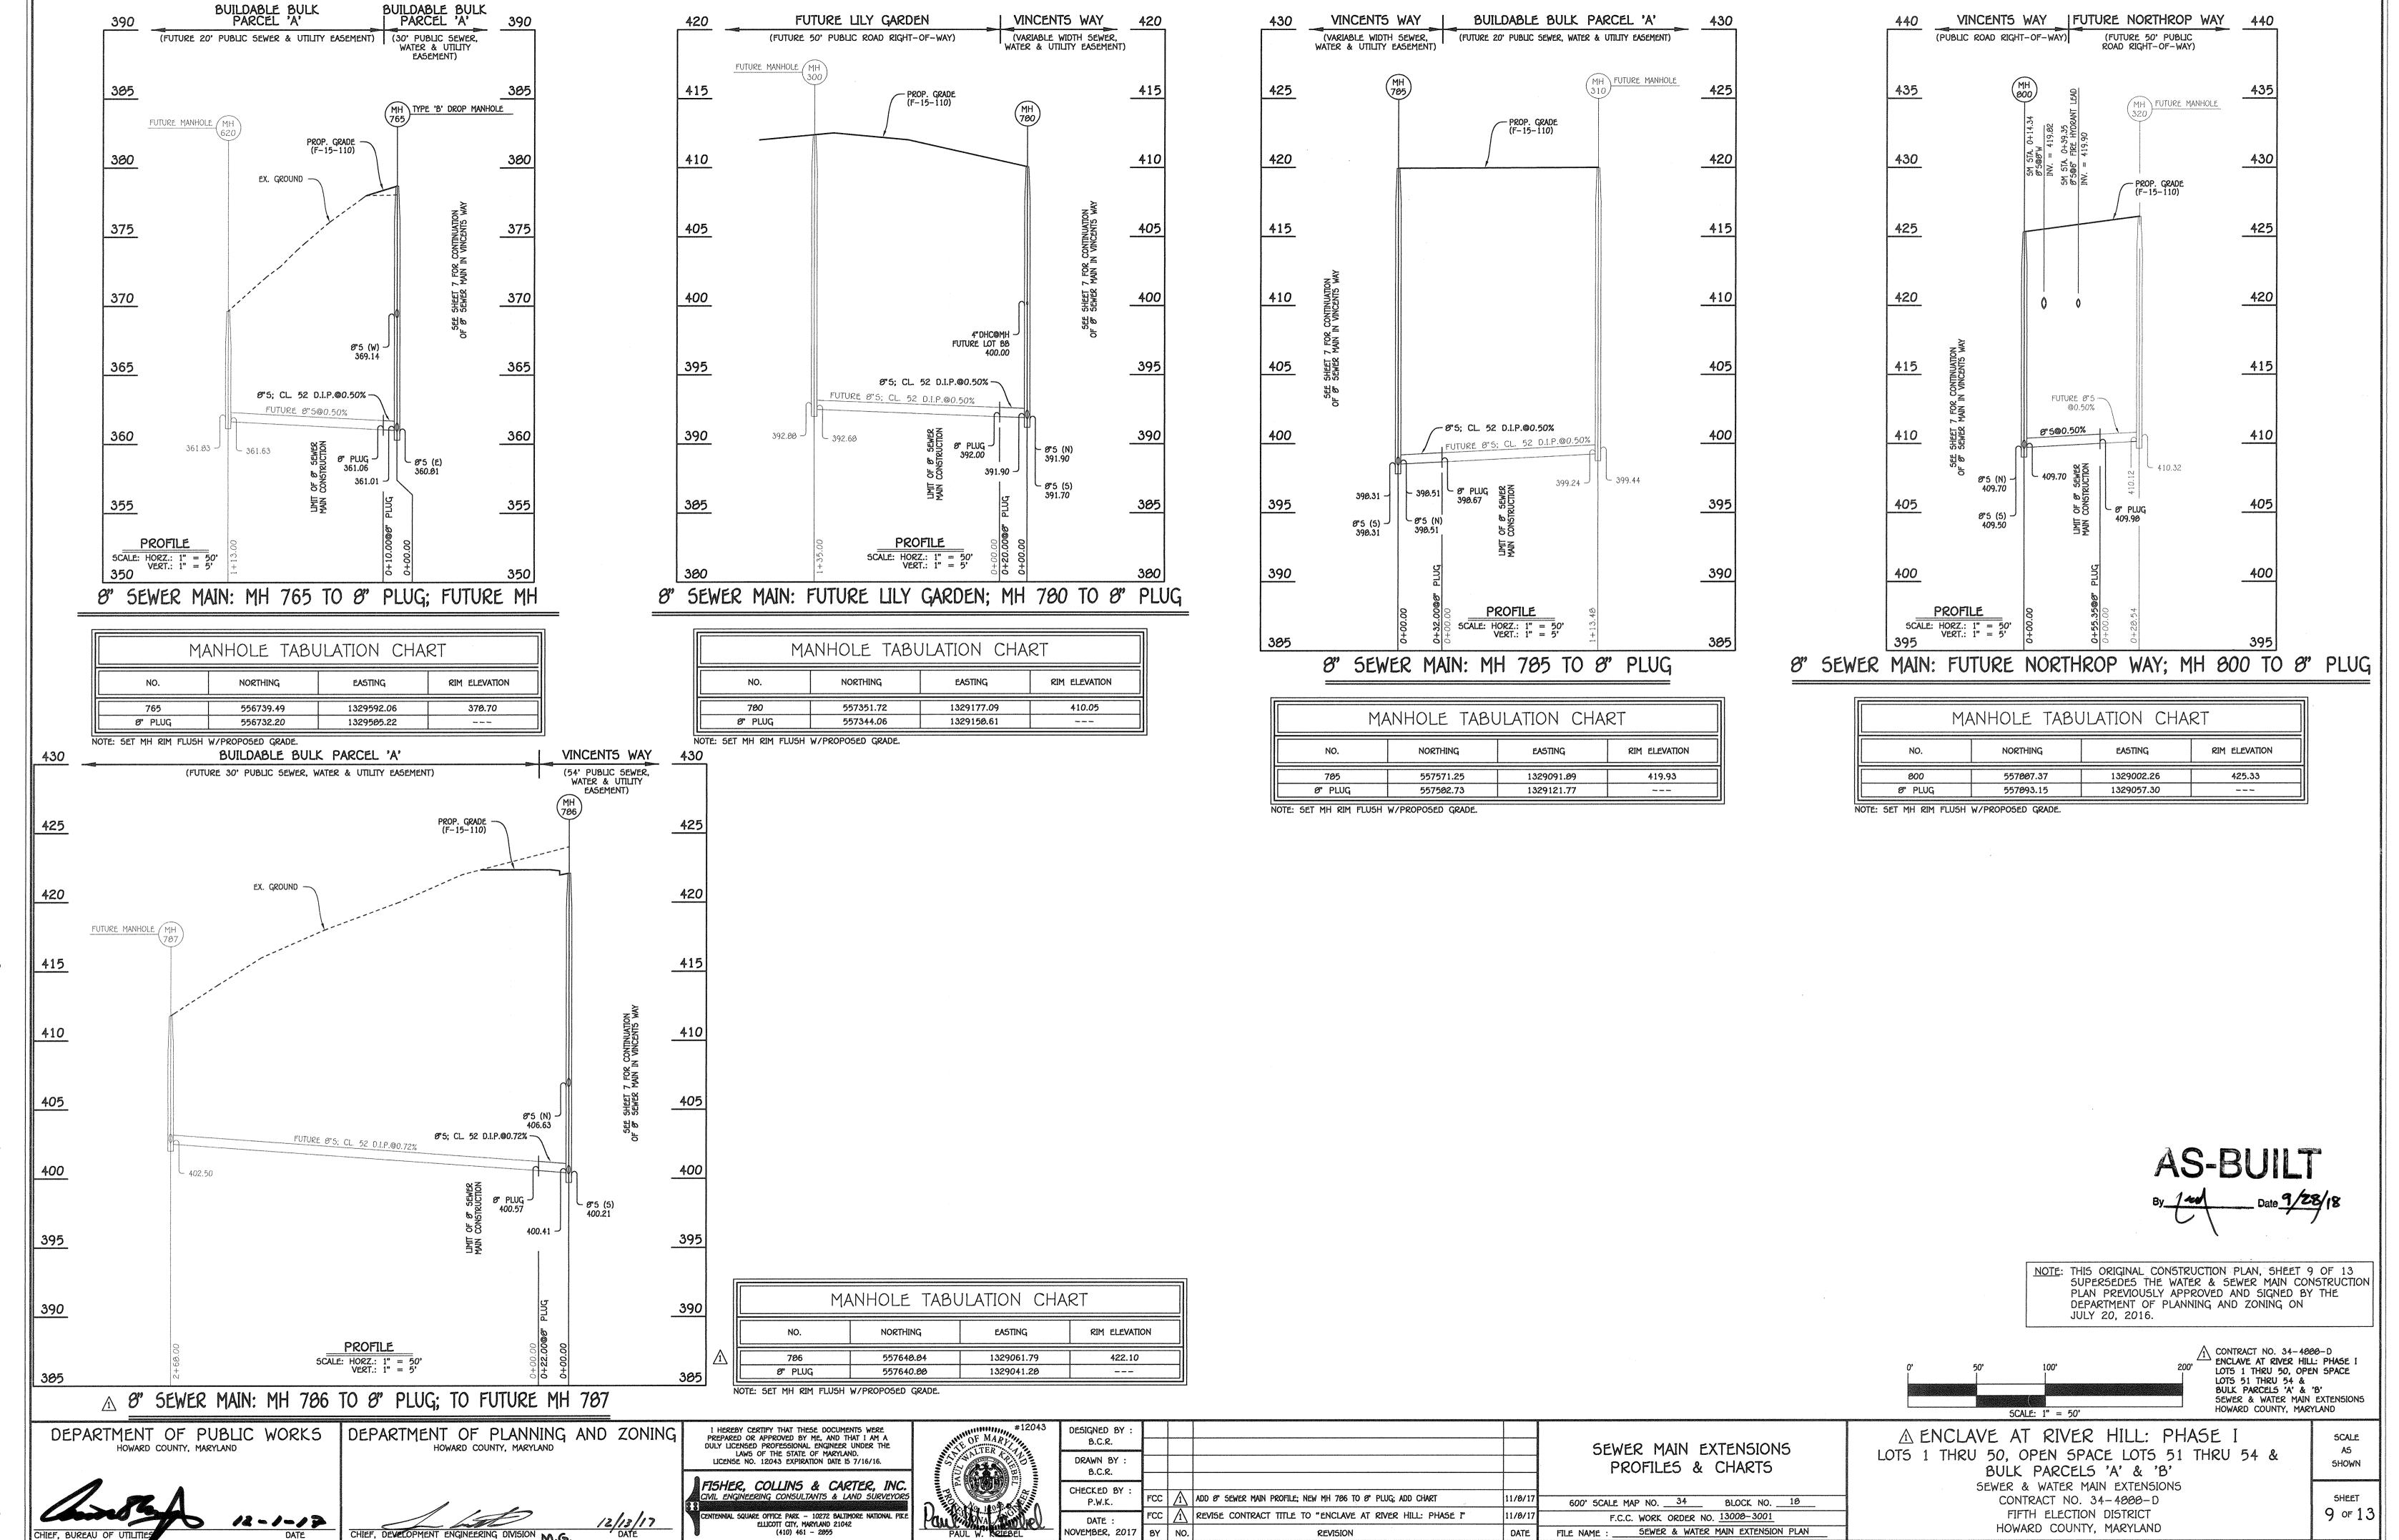


DATE

FILE NAME : _

REVISION

HIEF. BUREAU OF UTILIT

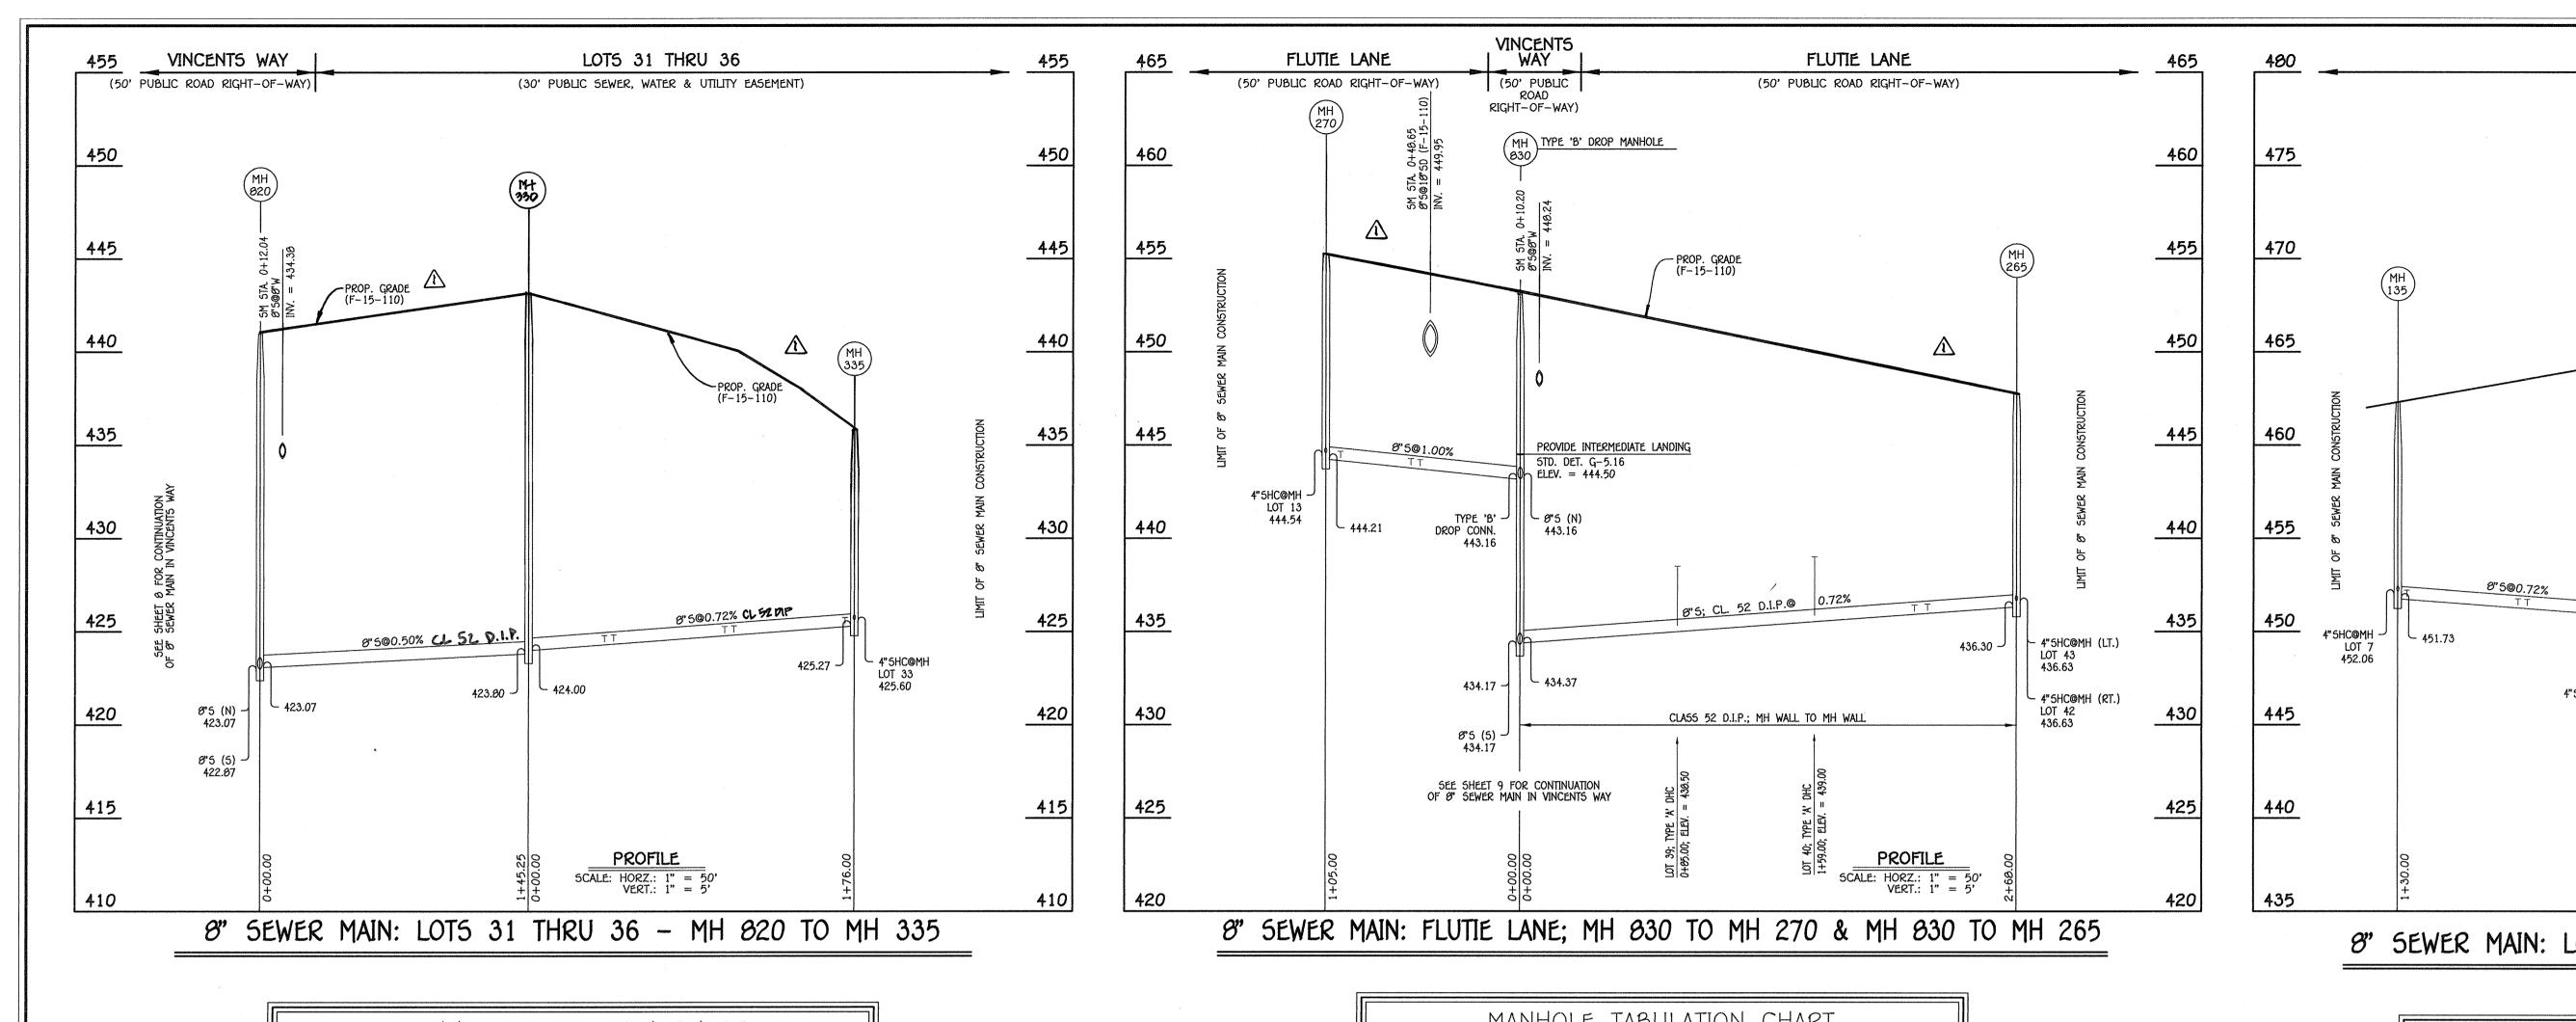

M	ANHOLE TABL	ILATION CHA	ART .
NO.	NORTHING	easting	RIM ELEVATION
820	558423.77	1328965.41	440.98
330	558468.44	1329103.61	443,09
335	558528.50	1329269.05	436.00

	SEWER HOUS	E CONN	IECTION	CHART						
STATION	LOT	ELEVATION AT MAIN	ELEVATION AT R/W	M.C.E.	8.E.	F.F.				
	MH 330 TO MH 335									
0+41 RT.	31	424.47	424.87	429.47	437.25	446.40				
0+46 LT.	36	424.50	424.70	429.30	436.75	445.90				
1+06 LT.	35	424.93	425.13	429.73	432.75	441.90				
1+11 RT.	32	424.97	425.37	429.97	436.25	445.40				
1+71 LT.	34	425.40	425.60	430.20	432.75	441.90				
@MH 335 RT.	33	425.60	426.00	430.60	432.05	441.20				

M	ANHOLE TABL	JLATION CHA	ART
NO.	NORTHING	EASTING	RIM ELEVATION
<i>8</i> 30	550697.47	1328838.64	453.06
265	558810.90	1329081.45	447.29
270	558653.36	1320743.35	455.10

	SEWER HOUS	E CONN	IECTION	CHART		
STATION	LOT	ELEVATION AT MAIN	ELEVATION AT R/W	M.C.E.	B.E.	F.F.
		MH 830	TO MH 265			
0+85 RT.	39 (DHC)	438.50	439.00	443.60	445.75	454.90
1+59 RT.	40 (DHC)	439.00	439.50	444.10	444.75	453.90
2+13 LT.	44	436.07	436.65	441.25	443.25	452.40
2+20 RT.	41	436.12	436.60	441.00	443.05	452.20
@MH 265 LT.	43	436.63	437.41	442.01	442.75	451.90
@MH 265 RT.	42	436.63	436.97	441.37	441.75	450.90

	SEWER HOUS	E CONN	IECTION	CHART		
STATION	LOT	ELEVATION AT MAIN	ELEVATION AT R/W	M.C.E.	B.E.	F.F.
		MH 830	TO MH 270		,,	
0+54 RT.	12	443.87	444.51	448.95	449.25	458.40
0+59 LT.	15	443.92	444.32	448.70	449.25	450.40
0+97 LT.	14	444.30	444.70	449.08	450.25	459.40
@MH 270 RT.	13	44.54	445.18	449.56	450.25	459.40

<u>75</u>		475	
70	MH 135 PROP. GRADE (F-15-110)	470	
<u>65</u>		465	
<u>60</u>	SEWER MAIN CONSTRUCTION WINCENTS WAY	460	
<u>55</u>	AAIN IN OF S	455	
50	8"5@0.72% TT 8"5@0.50% 4"5HC@MH LOT 7 452.06 450.79	450	
<u>45</u>	4"5HC@MH LOT 4 450.92 449.69 449.69 8"5 (N) 449.69 8"5 (5) 449.49	445	
<u>40</u>		440	
35	0. 0. 0. 0. 0. 0. 0. 0. 0. 0. 0. 0. 0. 0	435	
	8" SEWER MAIN: LOTS 4 THRU 9 - MH 850 TO MH 135		

LOTS 4 THRU 9


(30' PUBLIC SEWER, WATER & UTILITY EASEMENT)

M	ANHOLE TABL	JLATION CHA	RT	
NO.	NO. NORTHING		RIM ELEVATION	
850	559021.76	1328796.34	464.02	
130	559055.74	1328619.42	464.68	
135			462.30	

NOTE: SET MH RIMS FLUSH W/PROPOSED GRADE.

	SEWER HOUS	SE CONN	IECTION	CHART		
STATION	LOT	ELEVATION AT MAIN	ELEVATION AT R/W	M.C.E.	B.E.	F.F.
W-11000-1000-1000-1000-1000-1000-1000-1		MH 850	TO MH 130			
1+73 LT.	9	450.73	450.93	455.57	458.75	467.90
@MH 130 RT.	4	450.92	451.32	456.04	460.45	469.60
		MH 130	TO MH 135			
0+60 RT.	5	451.39	451.79	456.11	459.25	468.40
0+65 LT.	8	451.43	451.63	456.11	458.75	467.90
1+25 RT.	6	451.86	452.26	456.58	457.75	466.90
@MH 135 LT.	7	452.06	452.26	456.66	457.25	466.40



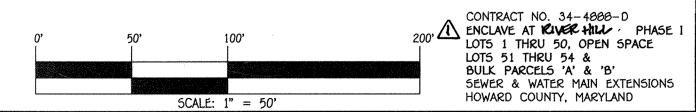

DEPARTMENT OF PUBLIC WORKS DEPARTMENT OF PLANNING AND ZONING HOWARD COUNTY, MARYLAND HOWARD COUNTY, MARYLAND

I HEREBY CERTIFY THAT THESE DOCUMENTS WERE PREPARED OR APPROVED BY ME, AND THAT I AM A DULY LICENSED PROFESSIONAL ENGINEER UNDER THE LAWS OF THE STATE OF MARYLAND.
LICENSE NO. 12043 EXPIRATION DATE IS 7/16/16. FISHER, COLLINS & CARTER, INC. CIVIL ENGINEERING CONSULTANTS & LAND SURVEYORS tennial square office park — 10272 Baltimore national Pii 7.21.11 ELLICOTT CITY, MARYLAND 21042 (410) 461 - 2055

			L		<u></u>	ــــــــــــــــــــــــــــــــــــــ
BEL	JUNE, 2016	ВΥ	NO.	REVISION	DATE	Г
	DATE :	FCC	1	REMAR CONTRACT THUE TO "RIVER HILL" COMME PROPOSED CRACE & COMMENTAL CHARLES WHITHIN SEVER MAIN PROPILES & CHARLES	11/10/17	
	CHECKED BY : P.W.K.			PENNER CONTINUE THE ETO "EN KE LINE !" "EN NEE WORMINGO LEDNE ! "		
EBELL	DRAWN BY : B.C.R.					
#12043	DESIGNED BY : B.C.R.					

SEWER MAIN EXTENSIONS PROFILES & CHARTS 600' SCALE MAP NO. 34 BLOCK NO. 18

ENCLAVE AT RIVER HILL: A PHASE I LOTS 1 THRU 50, OPEN SPACE LOTS 51 THRU 54 & BULK PARCELS 'A' & 'B' SEWER & WATER MAIN EXTENSIONS

SCALE A5 SHOWN 10 of 13

480


CONTRACT NO. 34-4888-D

F.C.C. WORK ORDER NO. 13008-3001 FILE NAME : SEWER & WATER MAIN EXTENSION PLAN

FIFTH ELECTION DISTRICT HOWARD COUNTY, MARYLAND

		ONNECTION AS-BUILT LOCAT	ION INDEL
LOT NUMBER	1 1/2" ADDRESS	LOCATION DIMENSION 1	LOCATION DIMENSION 2
1	34	SMH-860 TO WM - 21'	SHC-1 TO WM-11'
2	32	SMH-855 TO WM-28'	SHC-2 TO WM-16'
3	32	SMH-850 TO WM-60'	SHC-3 TO WM-11'
4	8	SMH - 130 TO WM - 27'	5HC-4 TO WM-17'
5	8	SMH-130 TO WM-53'	SHC-5 TO WM -12'
6	වි	SMH-135 TO WM-24	SHC-6 TO WM-10'
7	19	SM41-135 TO WM-14'	SHC-7 TO WM -10'
8	19	SMH-135 TO WM-77'	SHC-8 TO WM-11'
9	19	SMH - 130 TO WM - 19'	SHC-9 TO WM-11'
10	35	SMH - 850 TO WM-45'	<u> </u>
11	35	SM+1-845 TO WM-23	The state of the s
12	22	SMH - 270 TO WM-40	SHC-12 TO WM-27
13	21	SMH - 270 TO WM-31'	5HC-13 TO WM-12'
14	35	SMH - 270 TO WM-27	SHC-14 TO WM - 22'
15	29	SMH - 270 TO WM -31'	SHC-15 TO WM- 23'
16	31	SMH- 820 TO WM-49'	SHC-16 TO WM-10'
17	32	SMH - 815 TO WM - 36'	SHC - 17 TO WM - 10'
18	92	SMH - 810 TO WM - 44'	SHC-18 TO WM - 12'
19	32	SMH-810 TO WM-35'	SHC-19 TO WM-11'
20	32	SMH-810 TO WM-95' SMH-805 TO WM-93'	
21	35		SHC-21 TO WM-12' SHC-22 TO WM-11'
22	35		
23	36	SMH-805 TO WM-24'	
24	18	SMH-805 TO WM-44' SMH-805 TO WM-91'	SHC-24 TO WM-13 SHC-25 TO WM-12
25 26	18		
27	21 21	SMH-810 TO WM-102' SMH-810 TO WM-48'	SHC-27 TO WM-11'
28	21	SM41 - BIO TO WM - 36'	511C-28 TO WM-9'
29	22	SMH - 815 TO WM - 50'	SHE- 29 TO WM - 12'
30	22	SMH - 820 TO WM - 62'	SHC-30 TO WM-9'
31	11	5MH - 330 TO WM - 35'	SHC-31 TO WM-13'
32	lii	SMH - 335 TO WM - 78'	
33		SMH-335 TO WM-24	
34	20	SMH - 335 TO WM - 20'	SHC - 34 TO WM - 11'
35	20	5MH - 335 TO WM - 82'	SHC - 35 TO WM - 13'
36	20	5MH-330 TO WM-36	SHC - 36 TO WM - 11"
37	22	FHT TO WM-31'	5HC - 37 TO WM-11'
38	22	FHT TO WM-28	
39	36	FH7 TO WM-54	SHC- 39 TO WM-10
40	38	SHC-39 TO WM-60"	SHC-40 TO WM-15
41	37	SMH-265 TO WM-64	SHC-41 TO WM-12
42	31	5MH-265 TO WM-20"	SHC- 42 TO WM - 12
43	20	5MH - 265 TO WM-38'	SHC - 43 TO WM - 12'
44	15	SMH - 265 TO WM-76'	SHC-44 TO WM-16
45	53	SMH-835 TO WM-46'	SHC- 45 TO WM- 13'
46	93	5MH - 840 TO WM - 35'	SHC-46 TO WM-11'
47	33	SMH-845 TO WM-38	SHC-47 TO WM-11'
48	22	5MH - 850 TO WM - 41'	6HC-48 TO WM-10
49	21	9MH-850 ТО WM-54	SHC-49 TO WM-11
50	18	SMH - 860 TO WM - 54'	SHC - 50 TO WM - 16'
[62	190	3-9 TO WM-67'	I-8 TO WM-72

10T NUMBER	100000	LOCATION OWENEROUS	LOCATION OTHERICION O
LOT NUMBER	ADDRE55	LOCATION DIMENSION 1	LOCATION DIMENSION 2
1	(8	SMH-860 TO 9C-21'	WM-1 TO 5C-11'
3	18	SMH-855 TO 3C-20' SMH-850 TO 5C-49'	WM - 2 TO SC-16'
4	18	5MH - 130 TO SC - 21'	WM-4 TO SC-17'
5	20	3MH - 130 TO 3C-64'	WM-5 TO SC-12'
6	20	SMH - 135 TO SC-20'	WM-6 TO SC-10'
7	8	SMH - 135 TO SC-12'	WM-7 TO SC-10'
9	8 8	SMH-135 TO SC-66' SMH-130 TO SC-13'	WM-8 TO SC-11'
10	21	SMH - 845 TO SC-38'	WM-10 TO SC-15'
11	21	SMH - 845 TO SC-31'	WM-11 TO SC-12'
12	31	SMH - 270 TO SC-62'	WM-12 TO SC-27
13	31	SMH - 270 TO SC-32'	WM-13 TO SC-12'
14 15	18	SMH - 270 TO 5C-25'	WM-14 TO 5C-22'
16	18	SMH - 820 TO SC-59'	WM-16 70 5C-10'
17	18	SMH - 815 TO SC-30!	WM-17 TO SC-10'
18	2.1	SMH - 810 TO 5C-35'	WM-18 TO 5C-12'
19	21	SMH - 810 TO 3C-43'	WM-19 TO SC-11'
20	21	5MH - 810 TO SC-105'	WM-20 10 SC-11'
21	22	SMH-805 TO 9C-83'	WM-21 TO SC-12' WM-22 TO SE-11'
23	22	SMH-800 TO 3C-46'	WM-23 TO SC-33'
24	33	SMH-805 TO SC-38'	WM - 24 TO SC-13'
25	33	5MH - 805 TO 5C-82'	WM-25 TO SC-12'
26	32	SMH- 810 TO SC-112'	
27	32	SMH-810 TO SC-56'	WM-27 TO SC-11'
29	33	SMH-810 TO SC-33' SMH-815 TO SC-44'	WM-28 TO SC-9'
30	93	5MH-815 TO SC-89"	WM-30 TO 5C-9'
31	9	5MH - 350 TO SC-47'	WM-31 TO SC-13'
32	9	SMH - 335 TO SC - 69'	
33	18	SMH - 335 TO SC-22'	WM-33 TO SC-13'
34 35	9	SMH-335 TO SC-15' SMH-335 TO SC-71'	WM-34 TO SC-11' WM-35 TO SC-13'
36	18	SMH - 330 TO SC-48'	WM-36 TO 5C-11'
37	33	SMH-820 TO SC-45'	WM - 37 TO SC-11'
38	34	FHT TO SC-16'	WM - 38 70 SC-12'
39	26	FHT TO 92-59'	WM -39 TO SC-10'
40	26	WM-44 TO 9C-67'	WM-40 TO SC-15' WM-41 TO SC-12'
42	12	SMH - 265 TO SC-54'	WM-41 TO SC-12'
43	33	SMH - 265 TO SC-40'	WM-43 TO 50-12'
44	29	SMH - 265 TO SC-64"	WM - 44 TO 5C-16'
. 45	34	FHT - TO 5C-52'	WM-45 TO SC-13'
46	34	3MH-840 TO 3C-40	WM-46 TO SC-11'
47 48	34 32	SMH-845 TO SC-44' SMH-850 TO SC-47'	WM-47 TO SC-11' WM-48 TO SC-10'
49	32	FHT TO 9C-49'	WM-49 TO SC-11'
50	32	SMH-855 TO 90-39'	WM - 50 TO SC-16'
Α			
В			
С			
D E			
F			
G		, , , , , , , , , , , , , , , , , , , ,	
Н		1	
I .		<u>.</u>	
J K			
L			•
M			
N			
0			
P			
Q R			
5			
Т		:	
U			
V			
X			
<u> </u>			
Z			
АА			
ВВ			
СС			
D D		<u> </u>	
E E F F			
GG			
НН			
I I			
			I-8 TO CO-64'

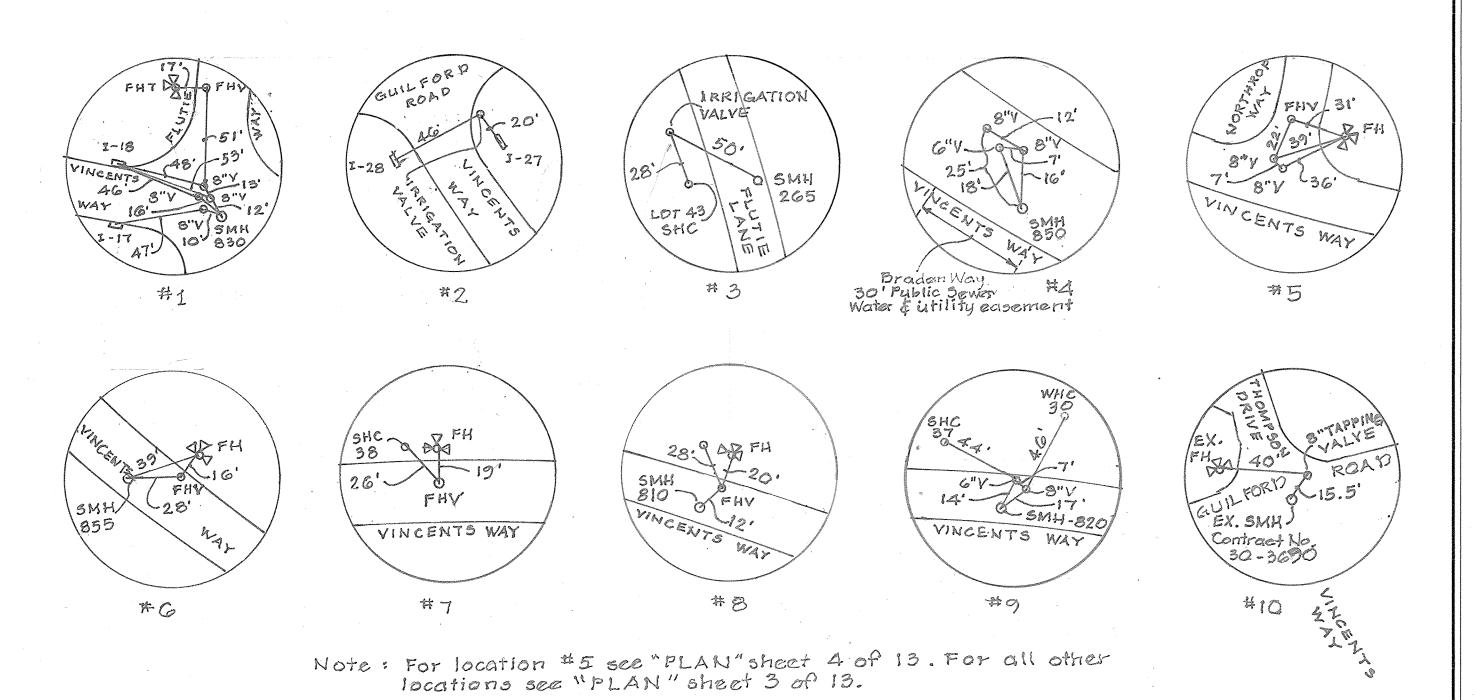

AS-BUILT

CONTRACT NO. 34-4888-D
ENCLAVE AT RIVER HILL: PHASE I
LOTS 1 THRU 50, OPEN SPACE
LOTS 51 THRU 54 &
BULK PARCELS 'A' & 'B'
SEWER & WATER MAIN EXTENSIONS
HOWARD COUNTY, MARYLAND 5CALE: 1" = 50'

DEPARTMENT OF PLANNING AND ZONING HOWARD COUNTY, MARYLAND DEPARTMENT OF PUBLIC WORKS HOWARD COUNTY, MARYLAND

CHIEF, DEVELOPMENT ENGINEERING DIVISION M.G.





<u>d</u>	DATE : JUNE, 2016	FCC BY	NO.	REVISE CONTRACT THUE TO "RIVERHILL" REVISION	11/10/1 DATE
	CHECKED BY : P.W.K.				
,,,,,,,,,,,,,,,,,,,,,,,,,,,,,,,,,,,,,,,	DRAWN BY : B.C.R.				
043	DESIGNED BY : B.C.R.				

SEWER & WATER MAIN EXTENSIONS "AS-BUILT" LOCATION TABLES

600' 5CALE MAP NO. 34 BLOCK NO. 18 F.C.C. WORK ORDER NO. 13008-3001 FILE NAME : SEWER & WATER MAIN EXTENSION PLAN


ENCLAVE AT RIVER HILL: A PHASE I LOTS 1 THRU 50, OPEN SPACE LOTS 51 THRU 54 & BULK PARCELS 'A' & 'B' SEWER & WATER MAIN EXTENSIONS CONTRACT NO. 34-4888-D

5HOWN SHEET 11 of 13

SCALE

NIAL SQUARE OFFICE PARK — 10272 BALTIMORE NATIONAL PIK ELLICOTT CITY, MARYLAND 21042 (410) 461 — 2055

FIFTH ELECTION DISTRICT HOWARD COUNTY, MARYLAND

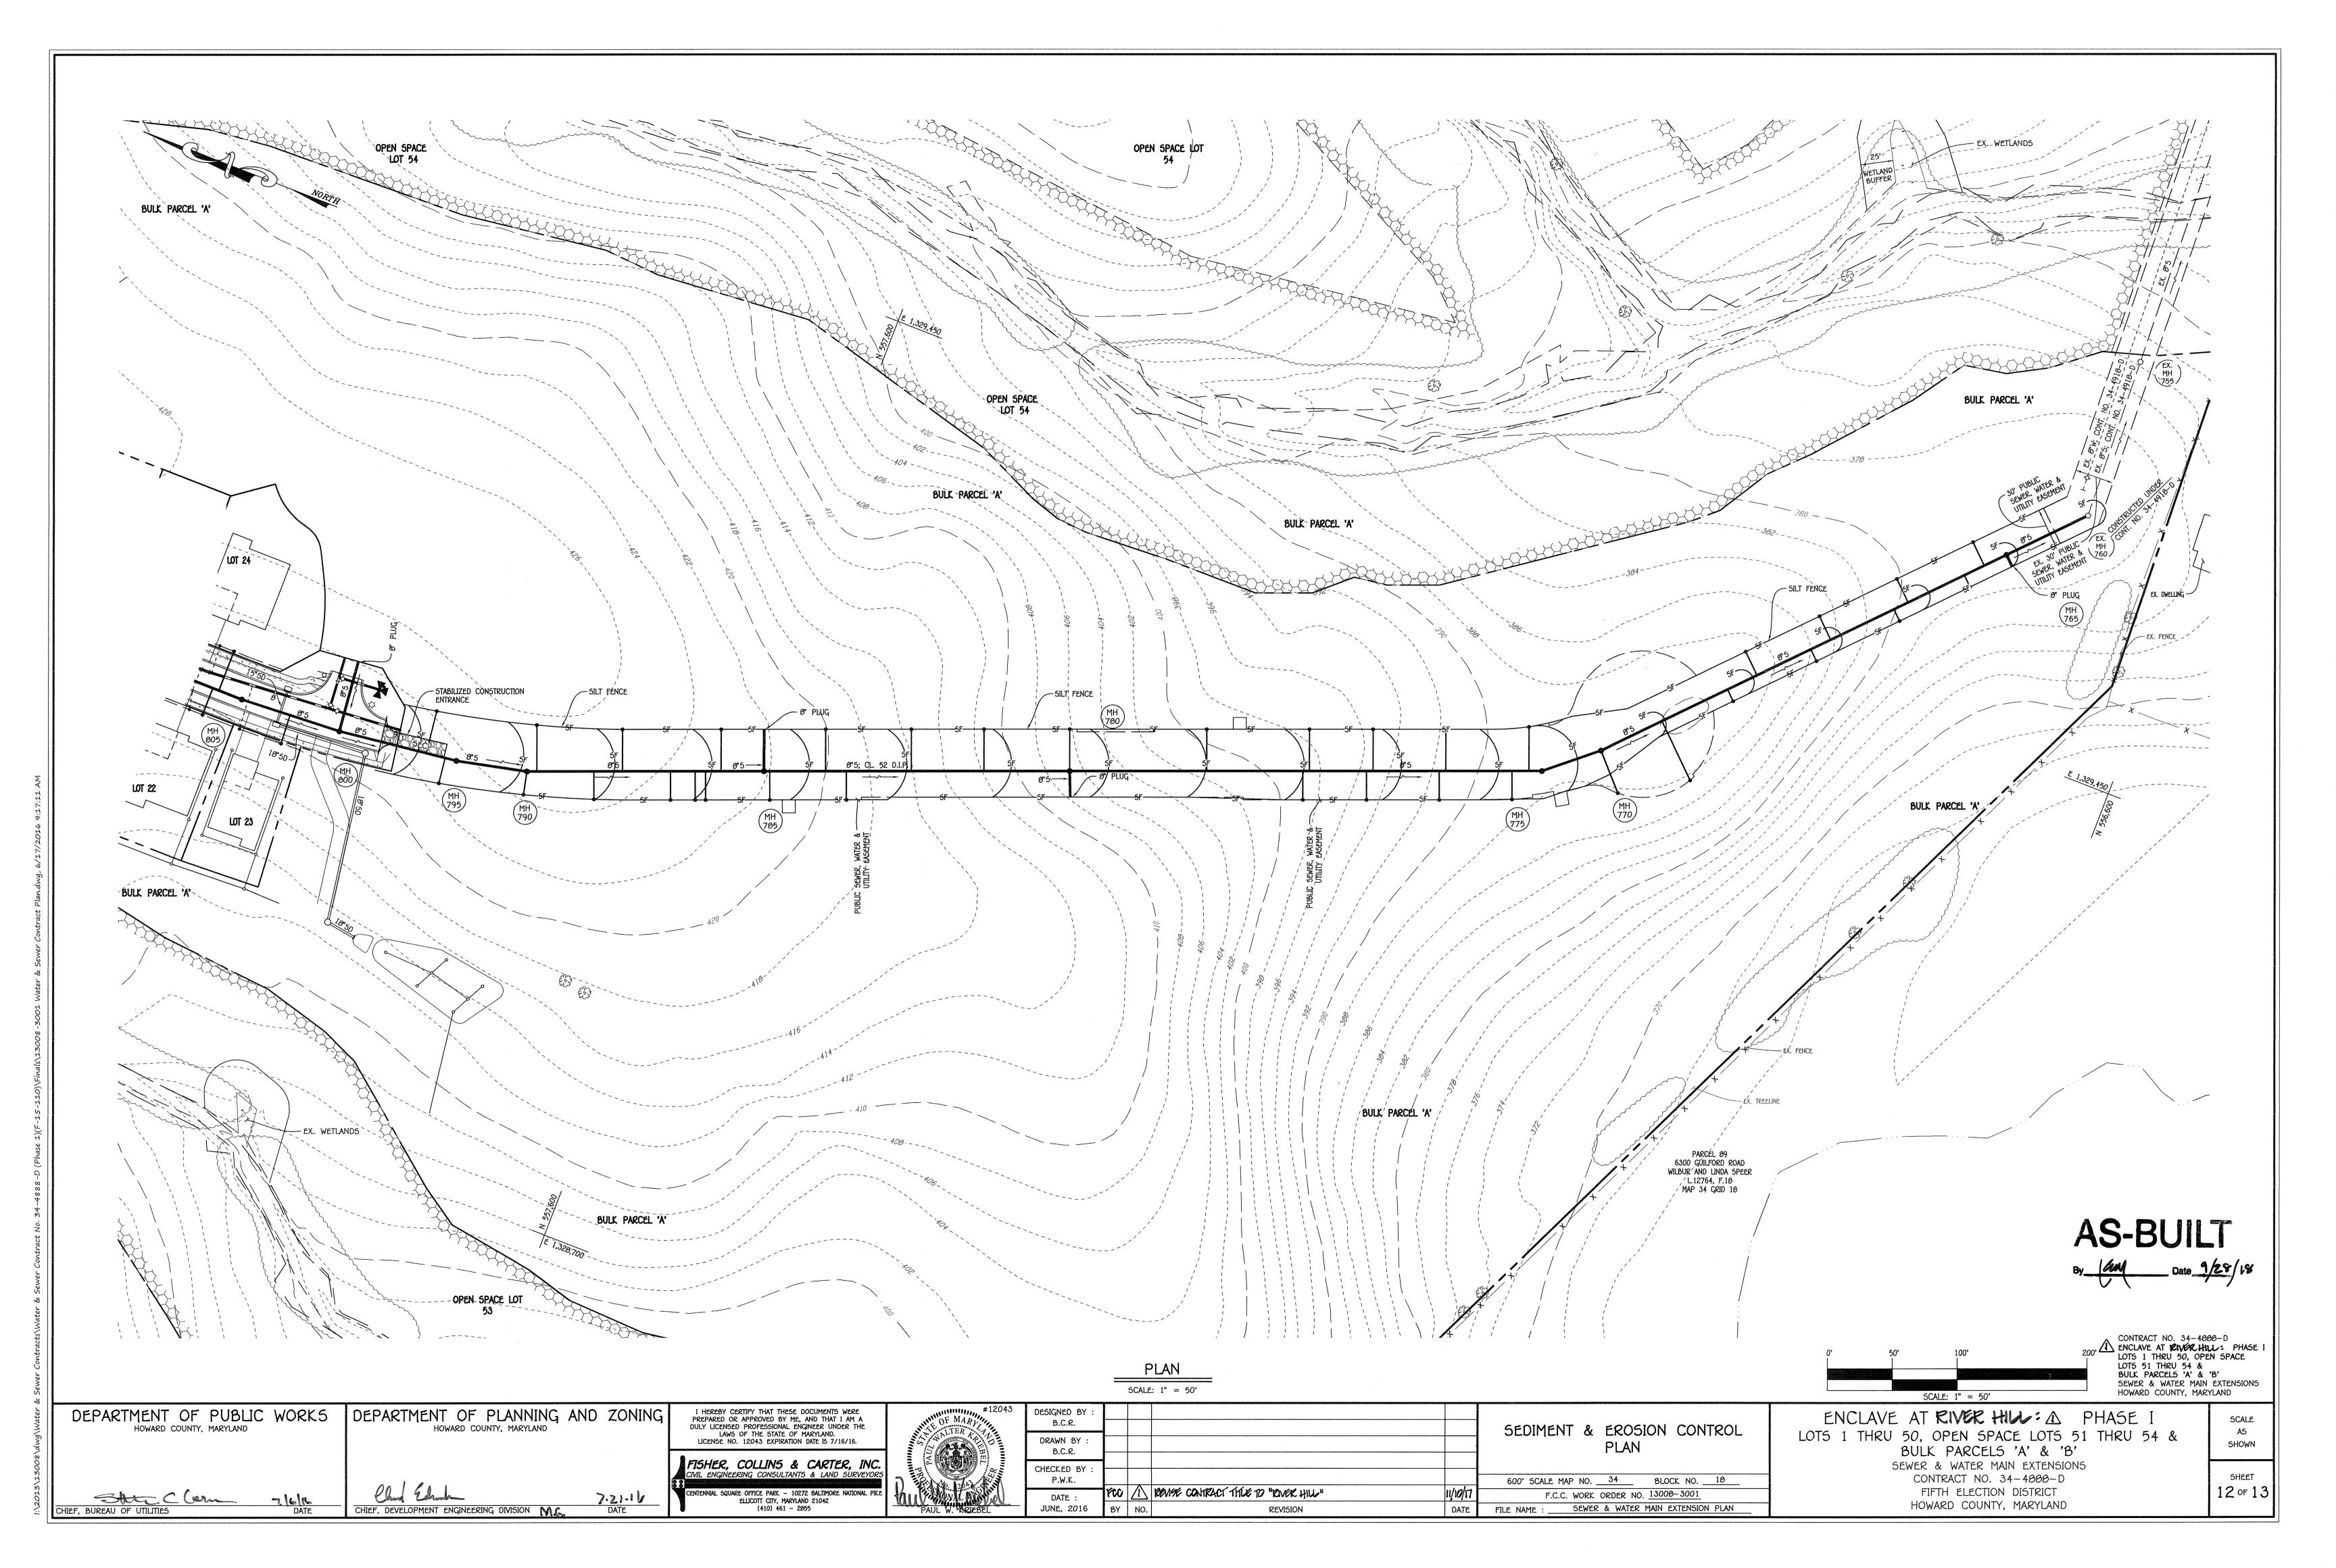

A. SEEDBED PREPARATION CONSISTS OF LOOSENING SOIL TO A DEPTH OF 3 TO 5 INCHES BY MEANS OF SUITABLE AGRICULTURAL OR CONSTRUCTION EQUIPMENT, SUCH AS DISC HARROWS OR CHISEL PLOWS OR RIPPERS MOUNTED ON CONSTRUCTION EQUIPMENT. AFTER THE SOIL IS LOOSENED, IT MUST NOT BE ROLLED OR DRAGGED SMOOTH BUT LEFT IN THE ROUGHENED CONDITION. SLOPES 3:1 OR FLATTER ARE TO BE TRACKED WITH RIDGES RUNNING PARALLEL TO THE CONTOUR OF THE SLOPE.

B. APPLY FERTILIZER AND LIME AS PRESCRIBED ON THE PLANS.

. INCORPORATE LIME AND FERTILIZER INTO THE TOP 3 TO 5 INCHES OF SOIL BY DISKING OR OTHER SUITABLE MEANS.

2. PERMANENT STABILIZATION

A. A SOIL TEST IS REQUIRED FOR ANY EARTH DISTURBANCE OF 5 ACRES OR MORE. THE MINIMUM SOIL CONDITIONS REQUIRED FOR PERMANENT VEGETATIVE ESTABLISHMENT ARE:

I. SOIL PH BETWEEN 6.0 AND 7.0.

II. SOLUBLE SALTS LESS THAN 500 PARTS PER MILLION (PPM). III. SOIL CONTAINS LESS THAN 40 PERCENT CLAY BUT ENOUGH FINE GRAINED MATERIAL (GREATER THAN 30 PERCENT SILT PLUS CLAY) TO PROVIDE THE CAPACITY TO HOLD A MODERATE AMOUNT OF MOISTURE. AN EXCEPTION: IF LOVEGRASS WILL BE PLANTED, THEN A SANDY SOIL (LESS THAN 30 PERCENT SILT PLUS CLAY) WOULD BE ACCEPTABLE.

IV. SOIL CONTAINS 1.5 PERCENT MINIMUM ORGANIC MATTER BY WEIGHT. V. SOIL CONTAINS SUFFICIENT PORE SPACE TO PERMIT ADEQUATE ROOT PENETRATION.

B. APPLICATION OF AMENDMENTS OR TOPSOIL IS REQUIRED IF ON-SITE SOILS DO NOT MEET THE ABOVE CONDITIONS

C. GRADED AREAS MUST BE MAINTAINED IN A TRUE AND EVEN GRADE AS SPECIFIED ON THE APPROVED PLAN, THEN SCARIFIED OR OTHERWISE LOOSENED TO A DEPTH OF 3 TO 5 INCHES.

D. APPLY SOIL AMENDMENTS AS SPECIFIED ON THE APPROVED PLAN OR AS INDICATED BY THE

RESULTS OF A SOIL TEST.

E. MIX SOIL AMENDMENTS INTO THE TOP 3 TO 5 INCHES OF SOIL BY DISKING OR OTHER SUITABLE MEANS. RAKE LAWN AREAS TO SMOOTH THE SURFACE, REMOVE LARGE OBJECTS LIKE STONES AND BRANCHES, AND READY THE AREA FOR SEED APPLICATION. LOOSEN SURFACE SOIL BY DRAGGING WITH A HEAVY CHAIN OR OTHER EQUIPMENT TO ROUGHEN THE SURFACE WHERE SITE CONDITIONS WILL NOT PERMIT NORMAL SEEDBED PREPARATION. TRACK SLOPES 3:1 OR FLATTER WITH TRACKED EQUIPMENT LEAVING THE SOIL IN AN IRREGULAR CONDITION WITH RIDGES RUNNING PARALLEL TO THE CONTOUR OF THE SLOPE. LEAVE THE TOP 1 TO 3 INCHES OF SOIL LOOSE AND FRIABLE. SEEDBED LOOSENING MAY BE UNNECESSARY ON NEWLY DISTURBED AREAS.

B. TOPSOILING

TOPSOIL IS PLACED OVER PREPARED SUBSOIL PRIOR TO ESTABLISHMENT OF PERMANENT VEGETATION. THE PURPOSE IS TO PROVIDE A SUITABLE SOIL MEDIUM FOR VEGETATIVE GROWTH. SOILS OF CONCERN HAVE LOW MOISTURE CONTENT, LOW NUTRIENT LEVELS, LOW PH, MATERIALS TOXIC TO PLANTS, AND/OR UNACCEPTABLE SOIL GRADATION.

2. TOPSOIL SALVAGED FROM AN EXISTING SITE MAY BE USED PROVIDED IT MEETS THE STANDARDS AS SET FORTH IN THESE SPECIFICATIONS. TYPICALLY, THE DEPTH OF TOPSOIL TO BE SALVAGED FOR A GIVEN SOIL TYPE CAN BE FOUND IN THE REPRESENTATIVE SOIL PROFILE SECTION IN THE SOIL SURVEY PUBLISHED BY USDA-NRCS.

5. TOPSOILING IS LIMITED TO AREAS HAVING 2:1 OR FLATTER SLOPES WHERE: A. THE TEXTURE OF THE EXPOSED SUBSOIL/PARENT MATERIAL IS NOT ADEQUATE TO PRODUCE VEGETATIVE GROWTH. B. THE SOIL MATERIAL IS SO SHALLOW THAT THE ROOTING ZONE IS NOT DEEP ENOUGH TO SUPPORT PLANTS OR FURNISH CONTINUING SUPPLIES OF MOISTURE AND PLANT NUTRIENTS. C. THE ORIGINAL SOIL TO BE VEGETATED CONTAINS MATERIAL TOXIC TO PLANT GROWTH. D. THE SOIL IS SO ACIDIC THAT TREATMENT WITH LIMESTONE IS NOT FEASIBLE.

. AREAS HAVING SLOPES STEEPER THAN 2:1 REQUIRE SPECIAL CONSIDERATION AND DESIGN.

5. TOPSOIL SPECIFICATIONS: SOIL TO BE USED AS TOPSOIL MUST MEET THE FOLLOWING CRITERIA:

A. TOPSOIL MUST BE A LOAM, SANDY LOAM, CLAY LOAM, SILT LOAM, SANDY CLAY LOAM, OR LOAMY SAND. OTHER SOILS MAY BE USED IF RECOMMENDED BY AN AGRONOMIST OR SOIL SCIENTIST AND APPROVED BY THE APPROPRIATE APPROVAL AUTHORITY. TOPSOIL MUST NOT BE A MIXTURE OF CONTRASTING TEXTURED SUBSOILS AND MUST CONTAIN LESS THAN 5 PERCENT BY VOLUME OF CINDERS, STONES, SLAG, COARSE FRAGMENTS, GRAVEL, STICKS, ROOTS, TRASH, OR OTHER MATERIALS ARGER THAN 1 1/2 INCHES IN DIAMETER.

3. TOPSOIL MUST BE FREE OF NOXIOUS PLANTS OR PLANT PARTS SUCH AS BERMUDA GRASS, QUACK KADD, JUHNDUN GKADD, NUI DEDGE, POIDUN IVY, IHIDILE, OK OTHEKD AD DPECIFIEI

TOPSOIL SUBSTITUTES OR AMENDMENTS, AS RECOMMENDED BY A QUALIFIED AGRONOMIST OR SOIL SCIENTIST AND APPROVED BY THE APPROPRIATE APPROVAL AUTHORITY, MAY BE USED IN LIEU OF NATURAL TOPSOIL.

. TOPSOIL APPLICATION

. EROSION AND SEDIMENT CONTROL PRACTICES MUST BE MAINTAINED WHEN APPLYING TOPSOIL.

3. UNIFORMLY DISTRIBUTE TOPSOIL IN A 5 TO $oldsymbol{artheta}$ INCH LAYER AND LIGHTLY COMPACT TO A MINIMUM IHICKNESS OF 4 INCHES. SPREADING IS TO BE PERFORMED IN SUCH A MANNER THAT SODDING OR SEEDING CAN PROCEED WITH A MINIMUM OF ADDITIONAL SOIL PREPARATION AND TILLAGE. ANY IRREGULARITIES IN THE SURFACE RESULTING FROM TOPSOILING OR OTHER OPERATIONS MUST BE CORRECTED IN ORDER TO PREVENT THE FORMATION OF DEPRESSIONS OR WATER POCKETS.

:. TOPSOIL MUST NOT BE PLACED IF THE TOPSOIL OR SUBSOIL IS IN A FROZEN OR MUDDY CONDITION, WHEN THE SUBSOIL IS EXCESSIVELY WET OR IN A CONDITION THAT MAY OTHERWISE BE DETRIMENTAL TO PROPER GRADING AND SEEDBED PREPARATION.

: SOIL AMENDMENTS (FERTILIZER AND LIME SPECIFICATIONS)

SOIL TESTS MUST BE PERFORMED TO DETERMINE THE EXACT RATIOS AND APPLICATION RATES FOR BOTH LIME AND FERTILIZER ON SITES HAVING DISTURBED AREAS OF 5 ACRES OR MORE. SOIL ANALYSIS MAY BE PERFORMED BY A RECOGNIZED PRIVATE OR COMMERCIAL LABORATORY. SOIL SAMPLES TAKEN FOR ENGINEERING PURPOSES MAY ALSO BE USED FOR CHEMICAL ANALYSES.

. FERTILIZERS MUST BE UNIFORM IN COMPOSITION, FREE FLOWING AND SUITABLE FOR ACCURATE APPLICATION BY APPROPRIATE EQUIPMENT. MANURE MAY BE SUBSTITUTED FOR FERTILIZER WITH PRIOR APPROVAL FROM THE APPROPRIATE APPROVAL AUTHORITY. FERTILIZERS MUST ALL BE DELIVERED TO THE SITE FULLY LABELED ACCORDING TO THE APPLICABLE LAWS AND MUST BEAR THE NAME, TRADE NAME OR TRADEMARK AND WARRANTY OF THE PRODUCER.

3. LIME MATERIALS MUST BE GROUND LIMESTONE (HYDRATED OR BURNT LIME MAY BE SUBSTITUTED EXCEPT WHEN HYDROSEEDING) WHICH CONTAINS AT LEAST 50 PERCENT TOTAL OXIDES (CALCIUM OXIDE PLUS MAGNESIUM OXIDE). LIMESTONE MUST BE GROUND TO SUCH FINENESS THAT AT LEAST 50 PERCENT WILL PASS THROUGH A #100 MESH SIEVE AND 90 TO 100 PERCENT WILL PASS THROUGH A #20 MESH SIEVE.

4. LIME AND FERTILIZER ARE TO BE EVENLY DISTRIBUTED AND INCORPORATED INTO THE TOP 3 TO 5 INCHES OF SOIL BY DISKING OR OTHER SUITABLE MEANS.

5. WHERE THE SUBSOIL IS EITHER HIGHLY ACIDIC OR COMPOSED OF HEAVY CLAYS, SPREAD GROUND LIMESTONE AT THE RATE OF 4 TO 8 TONS/ACRE (200-400 POUNDS PER 1,000 SQUARE FEET) PRIOR TO THE PLACEMENT OF TOPSOIL.

<u>STANDARD STABILIZATION NOTE</u>

FOLLOWING INITIAL SOIL DISTURBANCE OR RE-DISTURBANCE, PERMANENT OR TEMPORARY STABILIZATION MUST BE COMPLETED WITHIN:

A.) THREE (3) CALENDAR DAYS AS TO THE SURFACE OF ALL PERIMETER DIKES, SWALES, DITCHES, PERIMETER SLOPES, AND ALL SLOPES STEEPER THAN 3 HORIZONTAL TO 1 VERTICAL (3:1); AND

B.) SEVEN (7) CALENDAR DAYS AS TO ALL OTHER DISTURBED OR GRADED AREAS ON THE PROJECT SITE NOT UNDER ACTIVE GRADING.

PERMANENT SEEDING NOTES (B-4-5)

A. SELECT ONE OR MORE OF THE SPECIES OR MIXTURES LISTED IN TABLE B.3 FOR THE APPROPRIATE PLANT HARDINESS ZONE (FROM FIGURE B.3) AND BASED ON THE SITE CONDITION OR PURPOSE FOUND ON TABLE B.2. ENTER SELECTED MIXTURE(5), APPLICATION RATES, AND SEEDING DATES IN THE PERMANENT SEEDING SUMMARY. THE SUMMARY IS TO BE PLACED ON THE

B. ADDITIONAL PLANTING SPECIFICATIONS FOR EXCEPTIONAL SITES SUCH AS SHORELINES, STREAM BANKS, OR DUNES OR FOR SPECIAL PURPOSES SUCH AS WILDLIFE OR AESTHETIC TREATMENT MAY BE FOUND IN USDA-NRC5 TECHNICAL FIELD OFFICE GUIDE, SECTION 342 - CRITICAL AREA PLANTING.

C. FOR SITES HAVING DISTURBED AREA OVER 5 ACRES, USE AND SHOW THE RATES RECOMMENDED BY THE SOIL TESTING AGENCY.

D. FOR AREAS RECEIVING LOW MAINTENANCE, APPLY UREA FORM FERTILIZER (46-0-0) AT 3 1/2 POUNDS PER 1000 SQUARE FEET (150 POUNDS PER ACRE) AT THE TIME OF SEEDING IN ADDITION TO THE SOIL AMENDMENTS SHOWN IN THE PERMANENT SEEDING SUMMARY.

2. TURFGRASS MIXTURES

A. AREAS WHERE TURFGRASS MAY BE DESIRED INCLUDE LAWNS, PARKS, PLAYGROUNDS, AND COMMERCIAL SITES WHICH WILL RECEIVE A MEDIUM TO HIGH LEVEL OF MAINTENANCE.

B. SELECT ONE OR MORE OF THE SPECIES OR MIXTURES LISTED BELOW BASED ON THE SITE CONDITIONS OR PURPOSE. ENTER SELECTED MIXTURE(5), APPLICATION RATES, AND SEEDING DATES IN THE PERMANENT SEEDING SUMMARY. THE SUMMARY IS TO BE PLACED ON THE PLAN.

I. KENTUCKY BLUEGRASS: FULL SUN MIXTURE: FOR USE IN AREAS THAT RECEIVE INTENSIVE MANAGEMENT. IRRIGATION REQUIRED IN THE AREAS OF CENTRAL MARYLAND AND EASTERN SHORE. RECOMMENDED CERTIFIED KENTUCKY BLUEGRASS CULTIVARS SEEDING RATE: 1.5 TO 2.0 POUNDS PER 1000 SQUARE FEET. CHOOSE A MINIMUM OF THREE KENTUCKY BLUEGRASS CULTIVARS WITH EACH RANGING FROM 10 TO 35 PERCENT OF THE TOTAL MIXTURE BY WEIGHT.

II. KENTUCKY BLUEGRASS/PERENNIAL RYE: FULL SUN MIXTURE: FOR USE IN FULL SUN AREAS WHERE RAPID ESTABLISHMENT IS NECESSARY AND WHEN TURF WILL RECEIVE MEDIUM TO INTENSIVE MANAGEMENT. CERTIFIED PERENNIAL RYEGRASS CULTIVARS/CERTIFIED KENTUCKY BLUEGRASS SEEDING RATE: 2 POUNDS MIXTURE PER 1000 SQUARE FEET. CHOOSE A MINIMUM OF THREE KENTUCKY BLUEGRASS CULTIVARS WITH EACH

RANGING FROM 10 TO 35 PERCENT OF THE TOTAL MIXTURE BY WEIGHT. III. TALL FESCUE/KENTUCKY BLUEGRASS: FULL SUN MIXTURE: FOR USE IN DROUGHT PRONE AREAS AND/OR FOR AREAS RECEIVING LOW TO

MEDIUM MANAGEMENT IN FULL SUN TO MEDIUM SHADE. RECOMMENDED MIXTURE INCLUDES; CERTIFIED TALL FESCUE CULTIVARS 95 TO 100 PERCENT, CERTIFIED KENTUCKY BLUEGRASS CULTIVARS 0 TO 5 PERCENT. SEEDING RATE: 5 TO 0 POUNDS PER 1000 SQUARE FEET. ONE OR MORE CULTIVARS MAY BE BLENDED.

IV. KENTUCKY BLUEGRASS/FINE FESCUE: SHADE MIXTURE: FOR USE IN AREAS WITH SHADE IN BLUEGRASS LAWNS. FOR ESTABLISHMENT IN HIGH QUALITY, INTENSIVELY MANAGED TURF AREA. MIXTURE INCLUDES; CERTIFIED KENTUCKY BLUEGRASS CULTIVARS 30 TO 40 PERCENT AND CERTIFIED FINE FESCUE AND 60 TO 70 PERCENT. SEEDING RATE: 1 1/2 TO 3 POUNDS PER 1000 SQUARE FEET.

SELECT TURFGRASS VARIETIES FROM THOSE LISTED IN THE MOST CURRENT UNIVERSITY OF MARYLAND PUBLICATION, AGRONOMY MEMO #77, "TURFGRASS CULTIVAR RECOMMENDATIONS FOR MARYLAND'

THE CERTIFICATION PROGRAM OF THE MARYLAND DEPARTMENT OF AGRICULTURE, TURF AND SEED SECTION, PROVIDES A RELIABLE MEANS OF CONSUMER PROTECTION AND ASSURES A PURE C. IDEAL TIMES OF SEEDING FOR TURF GRASS MIXTURES WESTERN MD: MARCH 15 TO JUNE 1,

CHOOSE CERTIFIED MATERIAL. CERTIFIED MATERIAL IS THE BEST GUARANTEE OF CULTIVAR PURITY.

AUGUST 1 TO OCTOBER 1 (HARDINESS ZONES: 5B, 6A) CENTRAL MD: MARCH 1 TO MAY 15, AUGUST 15 TO OCTOBER 15 (HARDINESS ZONE: 6B) SOUTHERN MD, EASTERN SHORE: MARCH 1 TO MAY 15, AUGUST 15 TO OCTOBER 15 (HARDINESS ZONES: 7A, 7B) D. TILL AREAS TO RECEIVE SEED BY DISKING OR OTHER APPROVED METHODS TO A DEPTH OF 2

TO 4 INCHES, LEVEL AND RAKE THE AREAS TO PREPARE A PROPER SEEDBED. REMOVE STONES AND DEBRIS OVER 1 1/2 INCHES IN DIAMETER. THE RESULTING SEEDBED MUST BE IN SUCH CONDITION THAT FUTURE MOWING OF GRASSES WILL POSE NO DIFFICULTY.

E. IF SOIL MOISTURE IS DEFICIENT, SUPPLY NEW SEEDINGS WITH ADEQUATE WATER FOR PLANT GROWTH (1/2 TO 1 INCH EVERY 3 TO 4 DAYS DEPENDING ON SOIL TEXTURE) UNTIL THEY ARE FIRMLY ESTABLISHED. THIS IS ESPECIALLY TRUE WHEN SEEDINGS ARE MADE LATE IN THE PLANTING SEASON, IN ABNORMALLY DRY OR HOT SEASONS, OR ON ADVERSE SITES.

Permanent Seeding Summan

Hardiness Zone (from Figure B.3):6 Seed Mixture (from Table B.3):8					Ferțiliz	Lime Rațe		
No.	Species	Application Rate (lb/ac)	Seeding Dațes	Seeding Depths	N	P ₂ O ₅	K ₂ 0	
8	TALL FESCUE	100	Mar. 1-May 15 Aug. 15-Oct. 15	1/4-1/2 in.	45 lbs. per acre (1.0 lb/ 1000 sf)	90 lb/ac (2 lb/ 1000 sf)	90 b/ac (2 b/ 1000 sf)	2 tons/ac (90 lb/ 1000 sf)
					,			

B-4-8 STANDARDS AND SPECIFICATIONS FOR STOCKPILE AREA DEFINITION

A MOUND OR PILE OF SOIL PROTECTED BY APPROPRIATELY DESIGNED EROSION AND SEDIMENT CONTROL MEASURES.

TO PROVIDE A DESIGNATED LOCATION FOR THE TEMPORARY STORAGE OF SOIL THAT CONTROLS THE POTENTIAL FOR EROSION, SEDIMENTATION, AND CHANGES TO DRAINAGE PATTERNS. CONDITIONS WHERE PRACTICE APPLIES STOCKPILE AREAS ARE UTILIZED WHEN IT IS NECESSARY TO SALVAGE AND STORE SOIL FOR LATER USE.

1. THE STOCKPILE LOCATION AND ALL RELATED SEDIMENT CONTROL PRACTICES MUST BE CLEARLY INDICATED ON THE EROSION AND SEDIMENT CONTROL PLAN. 2. THE FOOTPRINT OF THE STOCKPILE MUST BE SIZED TO ACCOMMODATE THE ANTICIPATED VOLUME OF

MATERIAL AND BASED ON A SIDE SLOPE RATIO NO STEEPER THAN 2:1. BENCHING MUST BE PROVIDED IN ACCORDANCE WITH SECTION B-3 LAND GRADING. 3. RUNOFF FROM THE STOCKPILE AREA MUST DRAIN TO A SUITABLE SEDIMENT CONTROL PRACTICE.

4. ACCESS THE STOCKPILE AREA FROM THE UPGRADE SIDE. 5. CLEAR WATER RUNOFF INTO THE STOCKPILE AREA MUST BE MINIMIZED BY USE OF A DIVERSION DEVICE SUCH AS AN EARTH DIKE, TEMPORARY SWALE OR DIVERSION FENCE. PROVISIONS MUST BE MADE FOR

DISCHARGING CONCENTRATED FLOW IN A NON-EROSIVE MANNER. 6. WHERE RUNOFF CONCENTRATES ALONG THE TOE OF THE STOCKPILE FILL, AN APPROPRIATE EROSION/SEDIMENT CONTROL PRACTICE MUST BE USED TO INTERCEPT THE DISCHARGE. 7. STOCKPILES MUST BE STABILIZED IN ACCORDANCE WITH THE 3/7 DAY STABILIZATION REQUIREMENT AS WELL AS STANDARD B-4-1 INCREMENTAL STABILIZATION AND STANDARD B-4-4 TEMPORARY STABILIZATION. 8. IF THE STOCKPILE IS LOCATED ON AN IMPERVIOUS SURFACE, A LINER SHOULD BE PROVIDED BELOW THE STOCKPILE TO FACILITATE CLEANUP. STOCKPILES CONTAINING CONTAMINATED MATERIAL MUST BE COVERED

THE STOCKPILE AREA MUST CONTINUOUSLY MEET THE REQUIREMENTS FOR ADEQUATE VEGETATIVE ESTABLISHMENT IN ACCORDANCE WITH SECTION 8-4 VEGETATIVE STABILIZATION. SIDE SLOPES MUST BE MAINTAINED AT NO STEEPER THAN A 2:1 RATIO. THE STOCKPILE AREA MUST BE KEPT FREE OF EROSION. IF THE VERTICAL HEIGHT OF A STOCKPILE EXCEEDS 20 FEET FOR 2:1 SLOPES, 30 FEET FOR 3:1 SLOPES, OR 40 FEET FOR 4:1 SLOPES, BENCHING MUST BE PROVIDED IN ACCORDANCE WITH SECTION B-3 LAND GRADING.

TEMPORARY SEEDING NOTES (B-4-4)

TO STABILIZE DISTURBED SOILS WITH VEGETATION FOR UP TO 6 MONTHS.

PURPOSE TO USE FAST GROWING VEGETATION THAT PROVIDES COVER ON DISTURBED SOILS.

CONDITIONS WHERE PRACTICE APPLIES

EXPOSED SOILS WHERE GROUND COVER IS NEEDED FOR A PERIOD OF 6 MONTHS OR LESS. FOR LONGER DURATION OF TIME, PERMANENT STABILIZATION PRACTICES ARE REQUIRED.

CRITERIA

1. SELECT ONE OR MORE OF THE SPECIES OR SEED MIXTURES LISTED IN TABLE 8.1 FOR THE APPROPRIATE PLANT HARDINESS ZONE (FROM FIGURE B.3), AND ENTER THEM IN THE TEMPORARY SEEDING SUMMARY BELOW ALONG WITH APPLICATION RATES, SEEDING DATES AND SEEDING DEPTHS. IF THIS SUMMARY IS NOT PUT ON THE PLAN AND COMPLETED, THEN TABLE B.1 PLUS FERTILIZER AND LIME RATES MUST BE PUT ON THE PLAN.

2. FOR SITES HAVING SOIL TESTS PERFORMED, USE AND SHOW THE RECOMMENDED RATES BY THE TESTING AGENCY. SOIL TESTS ARE NOT REQUIRED FOR TEMPORARY SEEDING.

3. WHEN STABILIZATION IS REQUIRED OUTSIDE OF A SEEDING SEASON, APPLY SEED AND MULCH OR STRAW MULCH ALONE AS PRESCRIBED IN SECTION 8-4-3.A.1.B AND MAINTAIN UNTIL THE NEXT SEEDING SEASON.

Temporary Seeding Summary

	ne (from Figure B. (from Table B.1):	Fertilizer Rate (10-20-20)	Lime Rațe		
Species	Application Rate (lb/ac)	Seeding Dațes	Seeding Depths		
BARLEY	96	3/1 - 5/15	1"	436 lb/ac	2 tons/ac
OAT5	72	3/1 - 5/15, 8/15 - 10/15	1"	(10 lb/ 1000 sf)	(90 lb/ 1000 sf)
RYE	112		1"		

HOWARD SOIL CONSERVATION DISTRICT (HSCD) STANDARD SEDIMENT CONTROL NOTES

1. A PRE-CONSTRUCTION MEETING MUST OCCUR WITH THE HOWARD COUNTY DEPARTMENT OF PUBLIC WORKS, CONSTRUCTION INSPECTION DIVISION (CID), 410-313-1055 AFTER THE FUTURE LOD AND PROTECTED AREAS ARE MARKED CLEARLY IN THE FIELD. A MINIMUM OF 40 HOUR NOTICE TO CID MUST BE GIVEN AT THE FOLLOWING STAGES:

A. PRIOR TO THE START OF EARTH DISTURBANCE,

AND SEDIMENT CONTROL. AND REVISIONS THERETO.

B. UPON COMPLETION OF THE INSTALLATION OF PERIMETER EROSION AND SEDIMENT CONTROLS, BUT BEFORE PROCEEDING WITH ANY OTHER EARTH DISTURBANCE OR GRADING, C. PRIOR TO THE START OF ANOTHER PHASE OF CONSTRUCTION OR OPENING OF ANOTHER GRADING UNIT,

D. PRIOR TO THE REMOVAL OR MODIFICATION OF SEDIMENT CONTROL PRACTICES. OTHER BUILDING OR GRADING INSPECTION APPROVALS MAY NOT BE AUTHORIZED UNTIL THIS INITIAL APPROVAL BY THE INSPECTION AGENCY IS MADE. OTHER RELATED STATE AND FEDERAL PERMITS SHALL BE REFERENCED,

TO ENSURE COORDINATION AND TO AVOID CONFLICTS WITH THIS PLAN. 2. ALL VEGETATIVE AND STRUCTURAL PRACTICES ARE TO BE INSTALLED ACCORDING TO THE PROVISIONS OF THIS PLAN AND ARE TO BE IN CONFORMANCE WITH THE 2011 MARYLAND STANDARDS AND SPECIFICATIONS FOR SOIL EROSION

3. FOLLOWING INITIAL SOIL DISTURBANCE OR RE-DISTURBANCE, PERMANENT OR TEMPORARY STABILIZATION IS REQUIRED WITHIN THREE (3) CALENDAR DAYS AS TO THE SURFACE OF ALL PERIMETER CONTROLS, DIKES, SWALES, DITCHES, PERIMETER SLOPES, AND ALL SLOPES STEEPER THAN 3 HORIZONTAL TO 1 VERTICAL (3:1); AND SEVEN (7) CALENDAR DAYS AS TO ALL OTHER DISTURBED AREAS ON THE PROJECT SITE EXCEPT FOR THOSE AREAS UNDER ACTIVE GRADING. 4. ALL DISTURBED AREAS MUST BE STABILIZED WITHIN THE TIME PERIOD SPECIFIED ABOVE IN ACCORDANCE WITH THE 2011 MARYLAND STANDARDS AND SPECIFICATIONS FOR SOIL EROSION AND SEDIMENT CONTROL FOR TOPSOIL (SEC. B-4-2), PERMANENT SEEDING (SEC. B-4-5), TEMPORARY SEEDING (SEC. B-4-4) AND MULCHING (SEC. B-4-3). TEMPORARY STABILIZATION WITH MULCH ALONE CAN ONLY BE APPLIED BETWEEN THE FALL AND SPRING SEEDING DATES IF THE GROUND IS FROZEN. INCREMENTAL STABILIZATION (SEC. B-4-1) SPECIFICATIONS SHALL BE ENFORCED IN AREAS WITH >15' OF CUT AND/OR FILL. STOCKPILES (SEC. B-4-8) IN EXCESS OF 20 FT. MUST BE BENCHED WITH STABLE OUTLET. ALL CONCENTRATED FLOW, STEEP SLOPE, AND HIGHLY ERODIBLE AREAS SHALL RECEIVE SOIL STABILIZATION MATTING

5. ALL SEDIMENT CONTROL STRUCTURES ARE TO REMAIN IN PLACE, AND ARE TO BE MAINTAINED IN OPERATIVE CONDITION UNTIL PERMISSION FOR THEIR REMOVAL HAS BEEN OBTAINED FROM THE CID.

TOTAL AREA OF SITE: 88.960 ACRES AREA DISTURBED: 4.1000 ACRES AREA TO BE ROOFED OR PAVED: 2.8900 ACRES AREA TO BE VEGETATIVELY STABILIZED: 1.2100 ACRES TOTAL CUT: CU. YDS. TOTAL FILL: CU. YD5.

OFFSITE WASTE/BORROW AREA LOCATION: 7. ANY SEDIMENT CONTROL PRACTICE WHICH IS DISTURBED BY GRADING ACTIVITY FOR PLACEMENT OF UTILITIES MUST BE REPAIRED ON THE SAME DAY OF DISTURBANCE.

8. ADDITIONAL SEDIMENT CONTROL MUST BE PROVIDED, IF DEEMED NECESSARY BY THE CID. THE SITE AND ALL CONTROLS SHALL BE INSPECTED BY THE CONTRACTOR WEEKLY; AND THE NEXT DAY AFTER EACH RAIN EVENT. A WRITTEN REPORT BY THE CONTRACTOR. MADE AVAILABLE UPON REQUEST, IS PART OF EVERY INSPECTION AND SHOULD INCLUDE:

INSPECTION DATE

6. SITE ANALYSIS:

• INSPECTION TYPE (ROUTINE, PRE-STORM EVENT, DURING RAIN EVENT)

 NAME AND TITLE OF INSPECTOR WEATHER INFORMATION (CURRENT CONDITIONS AS WELL AS TIME AND AMOUNT OF LAST RECORDED PRECIPITATION) • BRIEF DESCRIPTION OF PROJECT'S STATUS (E.G., PERCENT COMPLETE) AND/OR CURRENT ACTIVITIES

• IDENTIFICATION OF SEDIMENT CONTROLS THAT REQUIRE MAINTENANCE

• IDENTIFICATION OF MISSING OR IMPROPERLY INSTALLED SEDIMENT CONTROLS · COMPLIANCE STATUS REGARDING THE SEQUENCE OF CONSTRUCTION AND STABILIZATION REQUIREMENTS

 PHOTOGRAPHS MONITORING/5AMPLING

EVIDENCE OF SEDIMENT DISCHARGES

IDENTIFICATION OF PLAN DEFICIENCIES

MAINTENANCE AND/OR CORRECTIVE ACTION PERFORMED

· OTHER INSPECTION ITEMS AS REQUIRED BY THE GENERAL PERMIT FOR STORMWATER ASSOCIATED WITH CONSTRUCTION ACTIVITIES (NPDES, MDE).

9. TRENCHES FOR THE CONSTRUCTION OF UTILITIES IS LIMITED TO THREE PIPE LENGTHS OR THAT WHICH CAN AND SHALL BE BACK-FILLED AND STABILIZED BY THE END OF EACH WORKDAY, WHICHEVER IS SHORTER.

10. ANY MAJOR CHANGES OR REVISIONS TO THE PLAN OR SEQUENCE OF CONSTRUCTION MUST BE REVIEWED AND APPROVED BY THE HSCD PRIOR TO PROCEEDING WITH CONSTRUCTION. MINOR REVISIONS MAY BE ALLOWED BY THE CID PER THE LIST OF HSCD-APPROVED FIELD CHANGES.

11. DISTURBANCE SHALL NOT OCCUR OUTSIDE THE L.O.D. A PROJECT IS TO BE SEQUENCED SO THAT GRADING ACTIVITIES BEGIN ON ONE GRADING UNIT (MAXIMUM ACREAGE OF 20 AC. PER GRADING UNIT) AT A TIME. WORK MAY PROCEED TO A SUBSEQUENT GRADING UNIT WHEN AT LEAST 50 PERCENT OF THE DISTURBED AREA IN THE PRECEDING GRADING UNIT HAS BEEN STABILIZED AND APPROVED BY THE CID. UNLESS OTHERWISE SPECIFIED AND APPROVED BY THE CID, NO MORE THAN 30 ACRES CUMULATIVELY MAY BE DISTURBED AT A GIVEN TIME.


12. WASH WATER FROM ANY EQUIPMENT, VEHICLES, WHEELS, PAVEMENT, AND OTHER SOURCES MUST BE TREATED IN A SEDIMENT BASIN OR OTHER APPROVED WASHOUT STRUCTURE. 13. TOPSOIL SHALL BE STOCKPILED AND PRESERVED ON-SITE FOR REDISTRIBUTION ONTO FINAL GRADE.

14. ALL SILT FENCE AND SUPER SILT FENCE SHALL BE PLACED ON-THE-CONTOUR, AND BE IMBRICATED AT 25' MINIMUM INTERVALS, WITH LOWER ENDS CURLED UPHILL BY 2' IN ELEVATION. 15. STREAM CHANNELS MUST NOT BE DISTURBED DURING THE FOLLOWING RESTRICTED TIME PERIODS (INCLUSIVE):

• USE I: AND IP: MARCH 1 - JUNE 15 • USE III: AND IIIP: OCTOBER 1 - APRIL 30

USE IV: MARCH 1 - MAY 31

16. A COPY OF THIS PLAN, THE 2011 MARYLAND STANDARDS AND SPECIFICATIONS FOR SOIL EROSION AND SEDIMENT CONTROL, AND ASSOCIATED PERMITS SHALL BE ON-SITE AND AVAILABLE WHEN THE SITE IS ACTIVE.

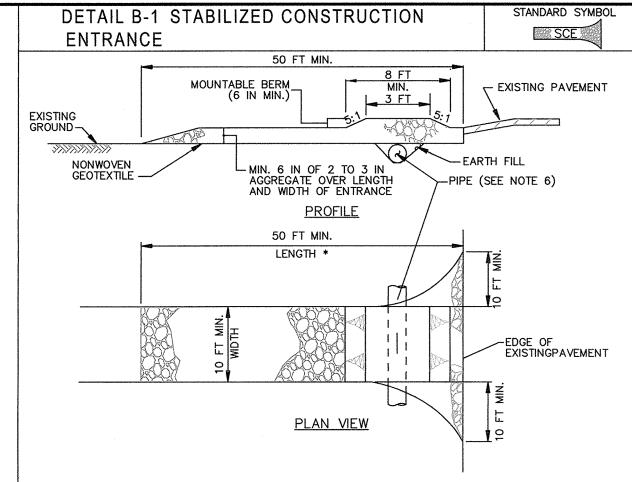

CONSTRUCTION SPECIFICATIONS

 PLACE STABILIZED CONSTRUCTION ENTRANCE IN ACCORDANCE WITH THE APPROVED PLAN. VEHICLES MUST TRAVEL OVER THE ENTIRE LENGTH OF THE SCE. USE MINIMUM LENGTH OF 50 FEET (*30 FEET FOR SINGLE RESIDENCE LOT). USE MINIMUM WIDTH OF 10 FEET. FLARE SCE 10 FEET MINIMUM AT THE EXISTING ROAD TO PROVIDE A TURNING RADIUS.

PIPE ALL SURFACE WATER FLOWING TO OR DIVERTED TOWARD THE SCE UNDER THE ENTRANCE, MAINTAINING POSITIVE DRAINAGE. PROTECT PIPE INSTALLED THROUGH THE SCE WITH A MOUNTABLE BERM WITH 5:1 SLOPES AND A MINIMUM OF 12 INCHES OF STONE OVER THE PIPE. PROVIDE PIPE AS SPECIFIED ON APPROVED PLAN. WHEN THE SCE IS LOCATED AT A HIGH SPOT AND HAS NO DRAINAGE TO CONVEY, A PIPE IS NOT NECESSARY. A MOUNTABLE BERM IS REQUIRED WHEN SCE IS NOT LOCATED AT A HIGH SPOT.

4. PLACE CRUSHED AGGREGATE (2 TO 3 INCHES IN SIZE) OR EQUIVALENT RECYCLED CONCRETE (WITHOUT REBAR) AT LEAST 6 INCHES DEEP OVER THE LENGTH AND WIDTH OF THE SCE.

MAINTAIN ENTRANCE IN A CONDITION THAT MINIMIZES TRACKING OF SEDIMENT. ADD STONE OR MAKE OTHER REPAIRS AS CONDITIONS DEMAND TO MAINTAIN CLEAN SURFACE, MOUNTABLE BERM, AND SPECIFIED DIMENSIONS. IMMEDIATELY REMOVE STONE AND/OR SEDIMENT SPILLED, DROPPED, OR TRACKED ONTO ADJACENT ROADWAY BY VACUUMING, SCRAPING, AND/OR SWEEPING. WASHING ROADWAY TO REMOVE MUD TRACKED ONTO PAVEMENT IS NOT ACCEPTABLE UNLESS WASH WATER IS DIRECTED TO AN APPROVED SEDIMENT CONTROL PRACTICE

MARYLAND STANDARDS AND SPECIFICATIONS FOR SOIL EROSION AND SEDIMENT CONTROL MARYLAND DEPARTMENT OF ENVIRONMENT U.S. DEPARTMENT OF AGRICULTURE NATURAL RESOURCES CONSERVATION SERVICE WATER MANAGEMENT ADMINISTRATION


ENGINEER'S CERTIFICATION

I HEREBY CERTIFY THAT THIS PLAN FOR EROSION AND SEDIMENT CONTROL REPRESENTS A PRACTICAL AND WORKABLE PLAN BASED ON MY PERSONAL KNOWLEDGE OF THE SITE CONDITIONS AND THAT IT WAS PREPARED IN ACCORDANCE WITH THE REQUIREMENTS OF THE HOWARD SOIL CONSERVATION DISTRICT.



DEVELOPER'S CERTIFICATION I/WE HEREBY CERTIFY THAT ALL DEVELOPMENT AND CONSTRUCTION WILL BE DONE ACCORDING TO THIS PLAN OF DEVELOPMENT AND PLAN FOR EROSION AND SEDIMENT CONTROL AND THAT ALL RESPONSIBLE PERSONNEL INVOLVED IN THE CONSTRUCTION PROJECT WILL HAVE A CERTIFICATE OF ATTENDANCE AT A DEPARTMENT OF THE ENVIRONMENT APPROVED TRAINING PROGRAM FOR THE CONTROL OF SEDIMENT AND EROSION BEFORE BEGINNING THE PROJECT. I ALSO AUTHORIZE PERIODIC ON-SITE INSPECTION BY THE HOWARD SOIL CONSERVATION DISTRICT OR THEIR AUTHORIZED AGENTS, AS ARE DEEMED NECESSARY.

Paul W. Kerebel; FOR: LAND DESIGN & DEVELOPMENT, INC.

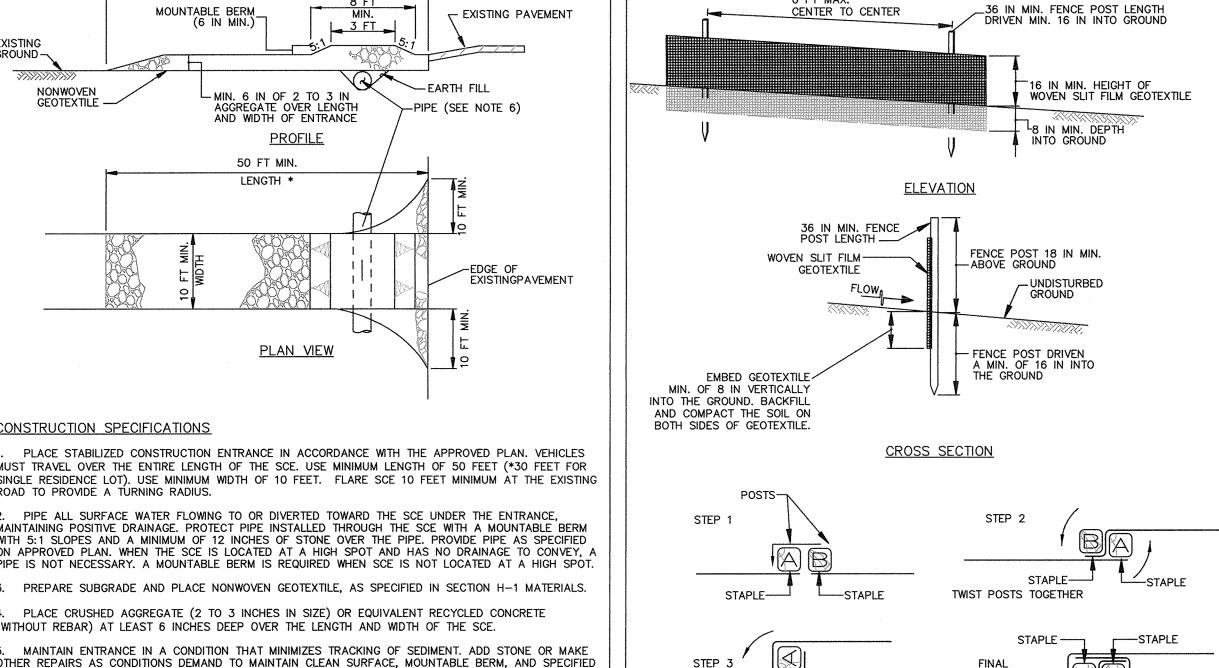

DETAIL E-1 SILT FENCE

____SF___

CONSTRUCTION SPECIFICATIONS

USE WOOD POSTS $1\frac{7}{4}$ X $1\frac{7}{4}$ \pm $\frac{7}{16}$ INCH (MINIMUM) SQUARE CUT OF SOUND QUALITY HARDWOOD. AS AN ALTERNATIVE TO WOODEN POST USE STANDARD "T" OR "U" SECTION STEEL POSTS WEIGHING NOT LESS THAN 1 POUND PER LINEAR FOOT.

JOINING TWO ADJACENT SILT

FENCE SECTIONS (TOP VIEW)

CONFIGURATION

STAPLE-

2. USE 36 INCH MINIMUM POSTS DRIVEN 16 INCH MINIMUM INTO GROUND NO MORE THAN 6 FEET APART 3. USE WOVEN SLIT FILM GEOTEXTILE AS SPECIFIED IN SECTION H-1 MATERIALS AND FASTEN GEOTEXTILE SECURELY TO UPSLOPE SIDE OF FENCE POSTS WITH WIRE TIES OR STAPLES AT TOP AND

PROVIDE MANUFACTURER CERTIFICATION TO THE AUTHORIZED REPRESENTATIVE OF THE INSPECTION/ENFORCEMENT AUTHORITY SHOWING THAT THE GEOTEXTILE USED MEETS THE REQUIREMENTS IN SECTION H-1 MATERIALS.

5. EMBED GEOTEXTILE A MINIMUM OF 8 INCHES VERTICALLY INTO THE GROUND. BACKFILL AND COMPACT THE SOIL ON BOTH SIDES OF FABRIC.

6. WHERE TWO SECTIONS OF GEOTEXTILE ADJOIN: OVERLAP, TWIST, AND STAPLE TO POST IN ACCORDANCE WITH THIS DETAIL.

EXTEND BOTH ENDS OF THE SILT FENCE A MINIMUM OF FIVE HORIZONTAL FEET UPSLOPE AT 45 DEGREES TO THE MAIN FENCE ALIGNMENT TO PREVENT RUNOFF FROM GOING AROUND THE ENDS

8. REMOVE ACCUMULATED SEDIMENT AND DEBRIS WHEN BULGES DEVELOP IN SILT FENCE OR WHEN SEDIMENT REACHES 25% OF FENCE HEIGHT. REPLACE GEOTEXTILE IF TORN. IF UNDERMINING OCCURS,

MARYLAND STANDARDS AND SPECIFICATIONS FOR SOIL EROSION AND SEDIMENT CONTROL U.S. DEPARTMENT OF AGRICULTURE MARYLAND DEPARTMENT OF ENVIRONMENT NATURAL RESOURCES CONSERVATION SERVICE WATER MANAGEMENT ADMINISTRATION

SEQUENCE OF CONSTRUCTION

OBTAIN GRADING PERMIT. (7 DAYS) 2. NOTIFY 'MISS UTILITY' AT 40 HOURS BEFORE BEGINNING ANY WORK AT 1-000-257-7777. NOTIFY THE HOWARD COUNTY OFFICE OF CONSTRUCTION/INSPECTION AT 410-313-1330 40 HOURS BEFORE


3. REQUEST FOR A PRE-CONSTRUCTION MEETING WITH THE APPROPRIATE ENFORCEMENT AUTHORITY. (1 DAY)

4. INSTALL STABILIZED CONSTRUCTION ENTRANCE AND SEDIMENT CONTROLS AS INDICATED ON SHEET 12. THE CONTRACTOR SHALL INSPECT AND PROVIDE THE NECESSARY MAINTENANCE ON ALL SEDIMENT CONTROL DEVICES/PRACTICES ON A DAILY BASIS AND IMMEDIATELY AFTER A RAINFALL. (7 DAYS)

5. CLEARING AND GRUBBING AS NECESSARY FOR THE INSTALLATION OF THE WATER & SEWER MAINS. (1 DAY)

6. INSTALL REMAINING PERIMETER CONTROL MEASURES AND INSTALL TEMPORARY SEEDING AS REQUIRED. (1 DAY) 7. CONSTRUCT WATER & SEWER MAINS AND CONNECTIONS. (6 WEEKS)

6. APPROVAL OF THE APPROPRIATE ENFORCEMENT AUTHORITY PRIOR TO REMOVAL OF SEDIMENT CONTROLS. (1 DAY) 9. REMOVAL OF CONTROLS AND STABILIZATION OF AREAS THAT ARE DISTURBED BY REMOVAL OF SEDIMENT

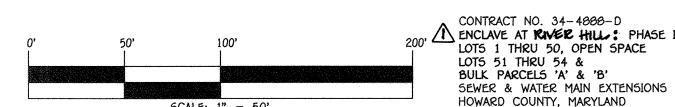

5CALE: 1" = 50"ENCLAVE AT RIVER HILL: A PHASE

LOTS 1 THRU 50, OPEN SPACE LOTS 51 THRU 54 & BULK PARCELS 'A' & 'B' SEWER & WATER MAIN EXTENSIONS CONTRACT NO. 34-4888-D

FIFTH ELECTION DISTRICT

HOWARD COUNTY, MARYLAND

DESIGNED BY

B.C.R.

DRAWN BY B.C.R. CHECKED BY P.W.K. DATE :

FCC | /1\ | REMARE CONTRACT TITLE TO "RIVER HIL"

REVISION DATE

JUNE, 2016 BY NO.

600' SCALE MAP NO. ___34___ FILE NAME :

BLOCK NO. ___18 F.C.C. WORK ORDER NO. 13008-3001 SEWER & WATER MAIN EXTENSION PLAN

SEDIMENT & EROSION CONTROL

NOTES & DETAILS

13 of 13

SCALE

SHOWN

Stac Con HEF, BUREAU OF UTILITIES

DEPARTMENT OF PUBLIC WORKS

HOWARD COUNTY, MARYLAND

CHIEF. DEVELOPMENT ENGINEERING DIVISION NA

DEPARTMENT OF PLANNING AND ZONING

HOWARD COUNTY, MARYLAND

WITH IMPERMEABLE SHEETING.

7.21.16 DATE

ennial square office park — 10272 baltimore national pii ELLICOTT CITY, MARYLAND 21042 (410) 461 - 2055

HEREBY CERTIFY THAT THESE DOCUMENTS WERE

PREPARED OR APPROVED BY ME, AND THAT I AM A

DULY LICENSED PROFESSIONAL ENGINEER UNDER THE

LAWS OF THE STATE OF MARYLAND.

LICENSE NO. 12043 EXPIRATION DATE IS 7/16/16.

FISHER, COLLINS & CARTER, INC

CIVIL ENGINEERING CONSULTANTS & LAND SURVEYOR

SHEET