









**TECHNICAL SPECIFICATIONS FOR UNDERGROUND WATER STORAGE TANKS FOR FIRE PROTECTION CONTINUED**

3.12.6 WHEN THE TANK HAS BEEN BACKFILLED TO SUBGRADE (BEFORE PLACEMENT OF ASPHALT OR CONCRETE), TAKE A MEASUREMENT OF THE INTERNAL DIAMETER OF THE TANK. RECORD THIS MEASUREMENT AS FINAL INTERNAL DIAMETER ON THE TANK INSTALLATION CHECKLIST.

3.12.7 COMPLETE THE TANK INSTALLATION CHECKLIST.

**4. TESTING AND ACCEPTANCE**

**4.1 GENERAL**

- 4.1.1 THE TANK SHALL BE OPERABLE WITH A RATE OF FLOW (FIRE FLOW) OF 1000 GALLONS PER MINUTE (GPM) MINIMUM USING A FIRE DEPARTMENT PUMPER OPERATING UNDER NORMAL CONDITIONS. CONTACT (410) 313-6300 TO SCHEDULE THE TEST.
- 4.1.2 AN OPERATIONAL FLOW TEST SHALL BE PERFORMED WHEN CONSTRUCTION IS COMPLETED, IN ACCORDANCE WITH THE APPROVED PROCEDURES. THE TEST SHALL BE CONDUCTED BY THE FIRE DEPARTMENT AND THE INSTALLER. WHEN TESTING HAS BEEN COMPLETED, THE INSTALLER SHALL REFILL THE TANK TO FULL CAPACITY AS REQUIRED. ONCE ACCEPTED, FURTHER USE OF THE TANK SHALL BE LIMITED TO FIREFIGHTING OPERATIONS AND ROUTINE TESTING. THE CONTRACTOR SHALL BE RESPONSIBLE FOR PROVIDING WATER FOR TESTING AND TO FILL TANK.
- 4.1.3 FINAL APPROVAL WILL BE MADE PER NOTIFICATION IN WRITING BY THE HOWARD COUNTY FIRE OFFICIAL.
- 4.1.4 ALL TESTING SHALL BE WITNESSED BY THE HOWARD COUNTY INSPECTOR OR OTHER REPRESENTATIVE AS APPROVED BY THE HOWARD COUNTY PROJECT MANAGER.

**4.2 POST INSTALLATION TESTING**

- 4.2.1 REMOVE ALL TEMPORARY SERVICE-FITTING PLUGS.
- 4.2.2 RE-DOPE FITTINGS AND INSTALL PLUGS IN ALL OPENINGS, EXCEPT ONE SERVICE FITTING (NEEDED FOR THE TEST MANIFOLD).
- 4.2.3 INSTALL THE TEST MANIFOLD IN THE OPEN SERVICE FITTING. CONNECT THE PRESSURE SOURCE TO THE TEST MANIFOLD.
- 4.2.4 PRESSURIZE THE TANK TO 5 PSIG/MAXIMUM. ALLOW THE PRESSURE TO STABILIZE BY ADDING OR REMOVING AIR AS NECESSARY, AS PER TANK MANUFACTURER SPECIFICATION.
- 4.2.5 CLOSE THE AIR-SUPPLY VALVE ON THE TEST MANIFOLD. DISCONNECT THE AIR-SUPPLY LINE.
- 4.2.6 SOAP THE ENTIRE EXTERIOR OF THE TANK, CHECKING FOR LEAKS. WATCH FOR ACTIVE AIR BUBBLES, WHICH INDICATE A LEAK. PAY SPECIAL ATTENTION TO FITTINGS AND MANWAYS.
- 4.2.7 MONITOR THE PRESSURE FOR ONE HOUR. 5 PSIG SHALL BE MAINTAINED.
- 4.2.8 WHEN THE TEST IS COMPLETE, CAREFULLY RELEASE THE AIR PRESSURE FROM THE TANK BY OPENING THE AIR-SUPPLY VALVE.
- 4.2.9 WHEN AIRFLOW STOPS, REMOVE THE TEST MANIFOLD.
- 4.2.10 REPLACE THE PROTECTIVE COVERS IN THE SERVICE FITTINGS.

**4.3 DEFLECTION MEASUREMENTS**

- 4.3.1 OBTAIN THE DEFLECTION MEASUREMENTS BY TAKING A MINIMUM OF TWO MEASUREMENTS OF THE INTERNAL DIAMETER OF THE TANK.
- 4.3.2 MEASURING THE INTERNAL DIAMETER OF THE TANK CAN BE PERFORMED BY USING A DIPSTICK OR USING A TAPE MEASURE, ETC.
- 4.3.3 TAKE THE INITIAL INTERNAL DIAMETER MEASUREMENT BEFORE BACKFILLING THE TANK, AND RECORD THIS MEASUREMENT ON THE TANK INSTALLATION CHECKLIST. IN A GROUNDWATER INSTALLATION, TAKE THIS MEASUREMENT BEFORE THE TANK IS PLACED IN THE EXCAVATION HOLE.
- 4.3.4 TAKE OTHER DIAMETER MEASUREMENTS DURING THE BACKFILLING PROCESS TO DETERMINE WHETHER VERTICAL DEFLECTION CONTINUES TO BE WITHIN THE LIMITS SPECIFIED BY THE TANK MANUFACTURER.
- 4.3.5 TAKE THE FINAL INTERNAL DIAMETER MEASUREMENT WHEN THE TANK HAS BEEN BACKFILLED TO SUBGRADE.
- 4.3.6 TO GET THE DEFLECTION MEASUREMENT AT ANY TIME, SUBTRACT THE CURRENT INTERNAL DIAMETER MEASUREMENT FROM THE INITIAL INTERNAL DIAMETER MEASUREMENT.
- 4.3.7 COMPARE THIS MEASUREMENT TO THE ALLOWABLE DEFLECTIONS PROVIDED BY THE TANK MANUFACTURER AND RECORD THE INFORMATION ON THE TANK INSTALLATION CHECKLIST.
- 4.3.8 VERTICAL DEFLECTION IN EXCESS OF ALLOWABLE DEFLECTION INDICATES IMPROPER INSTALLATION AND VOIDS THE TANK WARRANTY.

**5. ACCESSIBILITY SIGNS AND SURROUNDING FEATURES**

- 5.1 A PULLOFF SHALL BE CONSTRUCTED AS SHOWN ON THE DRAWINGS. THE REQUIREMENTS FOR EACH SITE WILL BE EVALUATED AND APPROVED BY THE FIRE OFFICIAL PRIOR TO START OF WORK. DETAILS SHALL BE INDICATED AS APPLICABLE. THE EDGE OF PAVEMENT SHALL BE MIN. 8 FT FROM EDGE OF SLAB.
- 5.2 NO OBSTRUCTIONS SHALL IMPEDE ACCESS TO TANK FITTINGS. THE FACILITY SHALL REMAIN ACCESSIBLE ON A YEAR-ROUND BASIS.
- 5.3 LANDSCAPING, BRUSH, AND TREES SHALL BE TRIMMED AWAY FROM FITTINGS. OVERHANGING BRANCHES SHALL BE TRIMMED AWAY AT A MINIMUM OF 12 FEET OVERHEAD. GRASS AND WEEDS SHALL BE CUT AS NEEDED.
- 5.4 PROTECTIVE DEVICES SHALL BE USED AS APPLICABLE TO PREVENT DAMAGE TO THE FITTINGS AND TO PROVIDE SAFETY TO OPERATORS. THESE INCLUDE, BUT ARE NOT LIMITED TO THE FOLLOWING:
  - A. BOLLARDS
  - B. GUARD RAILS
  - C. FENCING
  - D. WALKWAYS
  - E. CURBS
  - F. ANY OTHER BARRIERS/DEVICES AS DETERMINED BY THE FIRE OFFICIAL
- 5.5 A REFLECTIVE SIGN SHALL BE POSTED WHICH CLEARLY INDICATES TANK FULL CAPACITY AND IDENTIFICATION (ID) NUMBER. AN IDENTIFICATION NUMBER SHALL BE ASSIGNED BY THE COUNTY AND POSTED AT THE SITE. SIGNS SHALL BE PLACED ON ALL MAJOR ROADS, INDICATING THE DISTANCE AND DIRECTION TO TANK WITHIN A 2,500 FOOT RADIUS. FINAL PLACEMENT OF SIGNS SHALL BE APPROVED BY MARTIN LEPORE @ 410-313-0513.
- 5.6 AN APPROVED NO PARKING SIGN SHALL BE PAINTED WITH EXTERIOR-GRADE ENAMEL. COLOR SHALL BE YELLOW UNLESS OTHERWISE SPECIFIED, WITH THE EXCEPTION OF THE DRAFT CONNECTION, WHICH SHALL BE PAINTED RED.
- 5.7 ALL PLANTINGS SHALL BE INSTALLED AND MAINTAINED PER HOWARD COUNTY STANDARDS.

**6. OPERATING GUIDELINES**


- 6.1 NO PERSON SHALL BE PERMITTED TO ENTER THE TANK UNLESS IT HAS BEEN PROPERLY EMPTIED AND VENTED, AND UNLESS THE PERSON ENTERING THE TANK HAS BEEN TRAINED IN CONFINED SPACE ENTRY PROCEDURES, APPLICABLE OSHA REGULATIONS, AND IS IN POSSESSION OF A VALID HOWARD COUNTY CONFINED SPACE ENTRY PERMIT.
- 6.2 NEVER OVERFILL THE TANK.
- 6.3 EACH TIME THE TANK IS FILLED, THE OWNER/OPERATOR SHALL MAKE SURE THE TANK IS PROPERLY VENTED TO PREVENT PUTTING TANK UNDER PRESSURE.
- 6.4 OWNER/OPERATOR SHALL DETERMINE WHETHER THE TANK HAS OVERFILL PROTECTION, SUCH AS AUTOMATIC SHUT-OFF DEVICES OR VENT-RESTRICTION DEVICES (BALL-FLOAT VALVES), WHICH WILL CLOSE OFF THE INTERNAL PIPING AND REDUCE THE TANK'S CAPACITY.
- 6.5 OWNER/OPERATOR SHALL NOTIFY WHOEVER FILLS THE TANK THAT IT HAS OVERFILL PROTECTION, WHICH REDUCES THE TANK'S CAPACITY.
- 6.6 BEFORE EACH TANK FILLING, OWNER/OPERATOR OR THE DELIVERY SERVICE MUST DETERMINE THE TANK'S REDUCED CAPACITY DUE TO THE OVERFILL PROTECTION, AND CONSULT THE INSTRUCTION OR GUIDELINES PROVIDED BY THE INSTALLER AND MANUFACTURER OF THE OVERFILL PROTECTION DEVICE TO DETERMINE HOW MUCH ADDITIONAL PRODUCT THE TANK CAN HOLD.
- 6.7 THE MAXIMUM TEMPERATURE FOR STORING NON-POTABLE WATER IS 150° F.
- 6.8 POTABLE WATER IS TO BE STORED AT AMBIENT TEMPERATURE.

**7. REFERENCES**

- 7.1 PUBLISHED STANDARDS
  - 7.1.1 NFPA 1963 - STANDARD FOR FIRE HOSE SCREW THREADS
  - 7.1.2 NFPA 1142 - STANDARD FOR WATER SUPPLIES FOR SUBURBAN AND RURAL FIRE PROTECTION
  - 7.1.3 NFPA 1141 - STANDARD FOR FIRE PROTECTION IN PLANNED BUILDING GROUPS
  - 7.1.4 ASTM C33 - STANDARD SPECIFICATION FOR CONCRETE AGGREGATES
- 7.2 OTHER REFERENCED DOCUMENTS
  - 7.2.1 THE CODE OF PUBLIC LOCAL LAWS AND ORDINANCES OF HOWARD COUNTY MARYLAND, CHAPTER 112.
  - 7.2.2 UNDERGROUND TANKS & DRY FIRE HYDRANTS MAINTENANCE AND INSPECTION, CHIEF GREG DODS / REGIONAL FIRE PROTECTION COMMITTEE, 2003.

**AS-BUILTS** DEC 28 2015


Printed by (name) on Pdf Date: Jul 11, 2014 - 11:05am  
 User: c:\users\m...  
 Unit: Service...  
 Job: 11, 2014 - 11:05am  
 Job: 11, 2014 - 11:05am  
 Job: 11, 2014 - 11:05am

<p><b>DEPARTMENT OF PUBLIC WORKS</b> HOWARD COUNTY, MARYLAND</p> <p><i>[Signature]</i> 7/2/14 DIRECTOR OF PUBLIC WORKS DATE</p> <p><i>[Signature]</i> 7/2/14 CHIEF, BUREAU OF UTILITIES DATE</p> <p><i>[Signature]</i> 7/17/14 CHIEF, UTILITY DESIGN DIVISION DATE</p>	<p><b>Dewberry</b> Dewberry Consultants, LLC</p> <p>3108 LORD BALTIMORE DRIVE SUITE 110 BALTIMORE, MD 21244-2692 410.266.9500 FAX: 410.265.8875</p>		<p>DES: LAL</p> <p>DRN: RLI</p> <p>CHK: TND</p> <p>DATE: 07/2014</p>	<p><b>SPECIFICATIONS - 2</b></p>	<p>UNDERGROUND WATER STORAGE TANK FOR FIRE SUPPRESSION</p> <p>F-5972 65-4908</p> <p>ELECTION DISTRICT NO. 4</p> <p>HOWARD COUNTY, MARYLAND</p>	<p>SCALE: SHOWN</p> <p>SHEET 3 OF 8</p>								
			<table border="1" style="border-collapse: collapse;"> <thead> <tr> <th>BY</th> <th>NO.</th> <th>REVISIONS</th> <th>DATE</th> </tr> </thead> <tbody> <tr> <td> </td> <td> </td> <td> </td> <td> </td> </tr> </tbody> </table>	BY	NO.	REVISIONS	DATE					<p>600' SCALE MAP NO. 15</p> <p>BLOCK NO. 10</p>		
BY	NO.	REVISIONS	DATE											









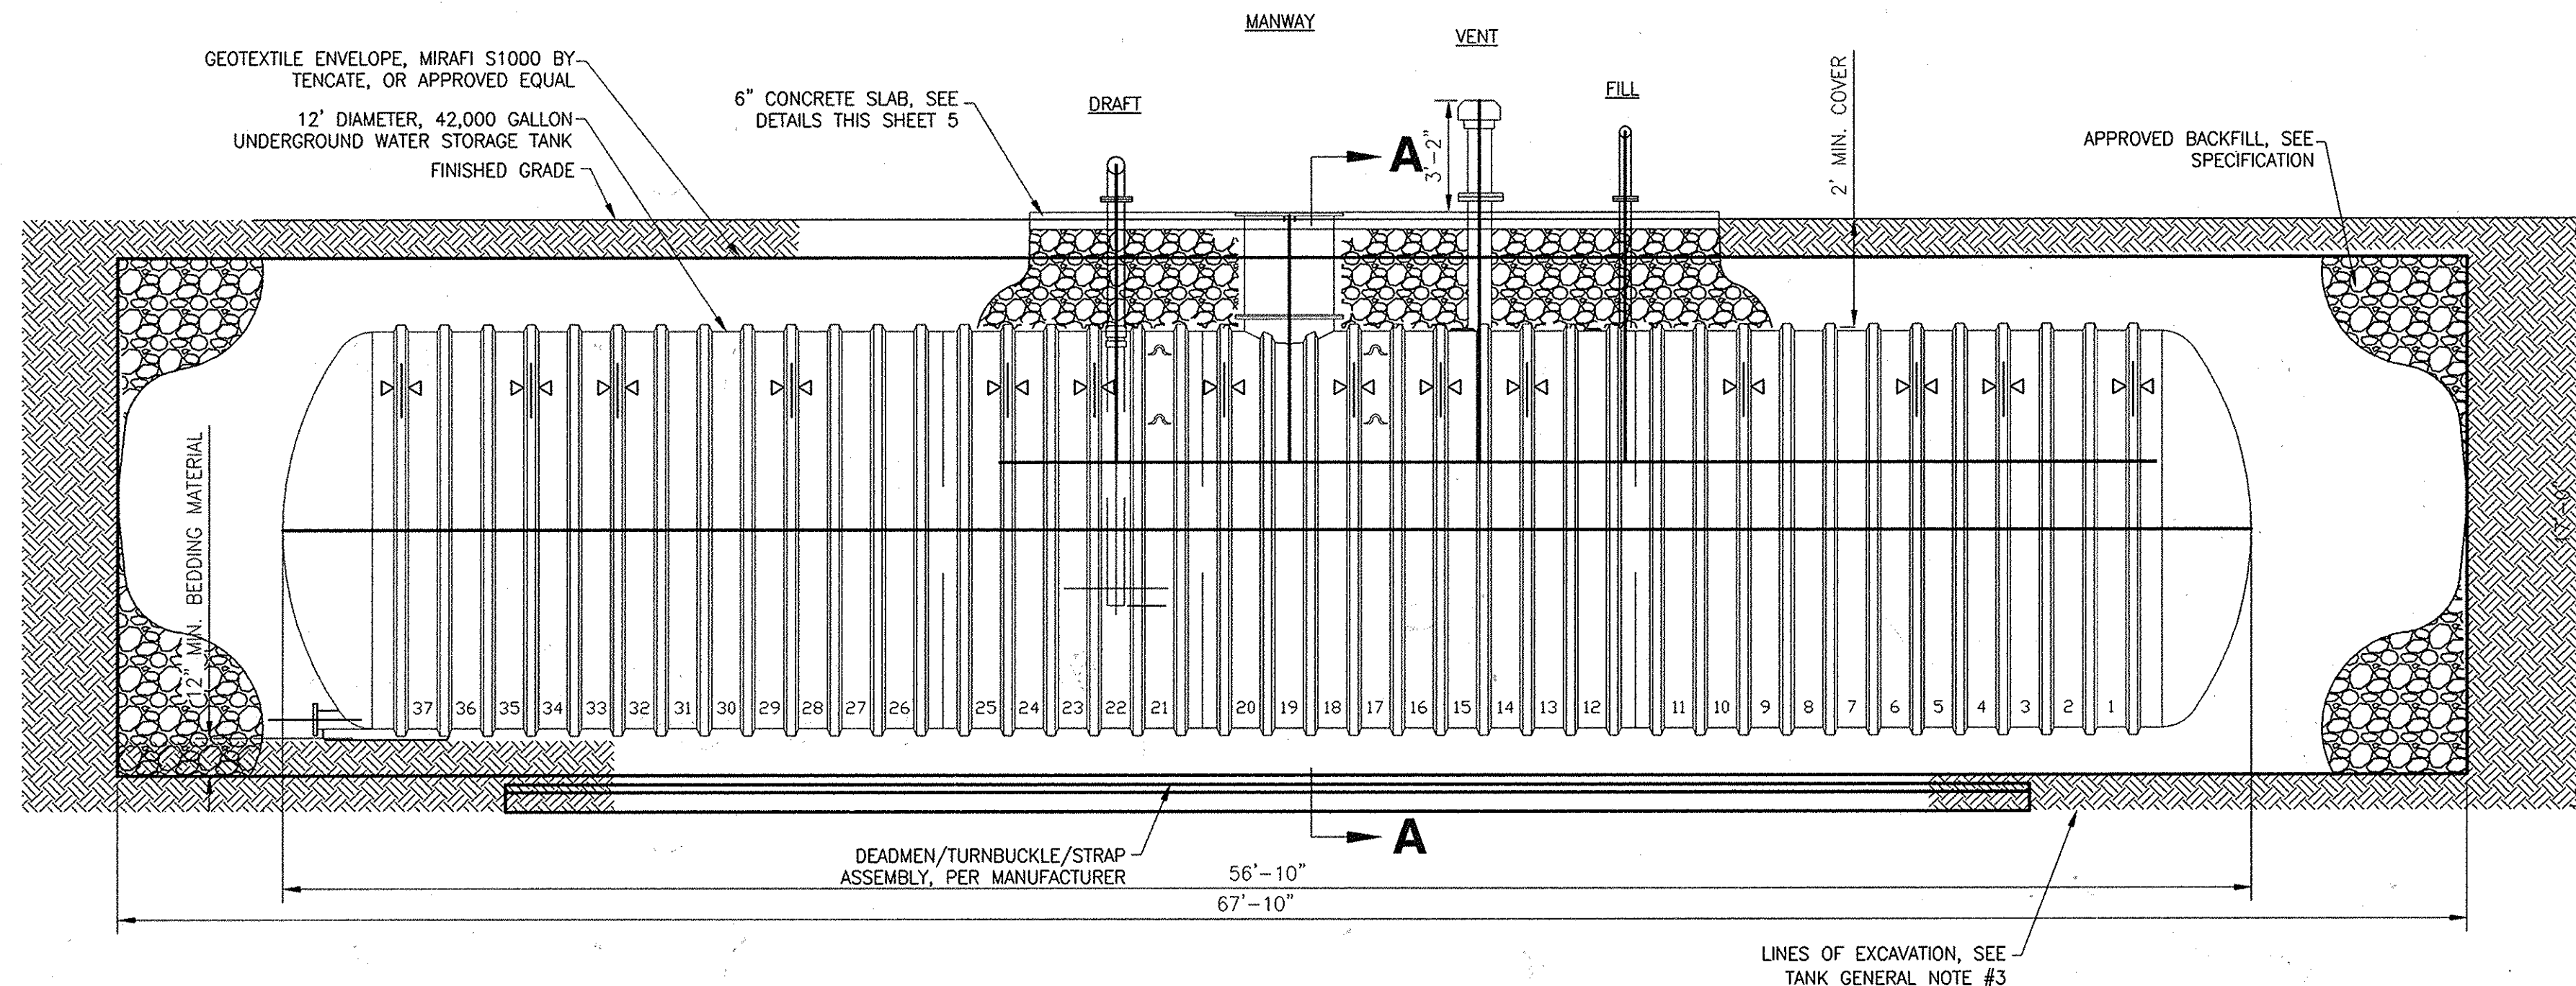


**ELEVATION: 42,000 GALLON FIRE SUPPRESSION WATER STORAGE TANK**  
SCALE 1/4" = 1'-0"

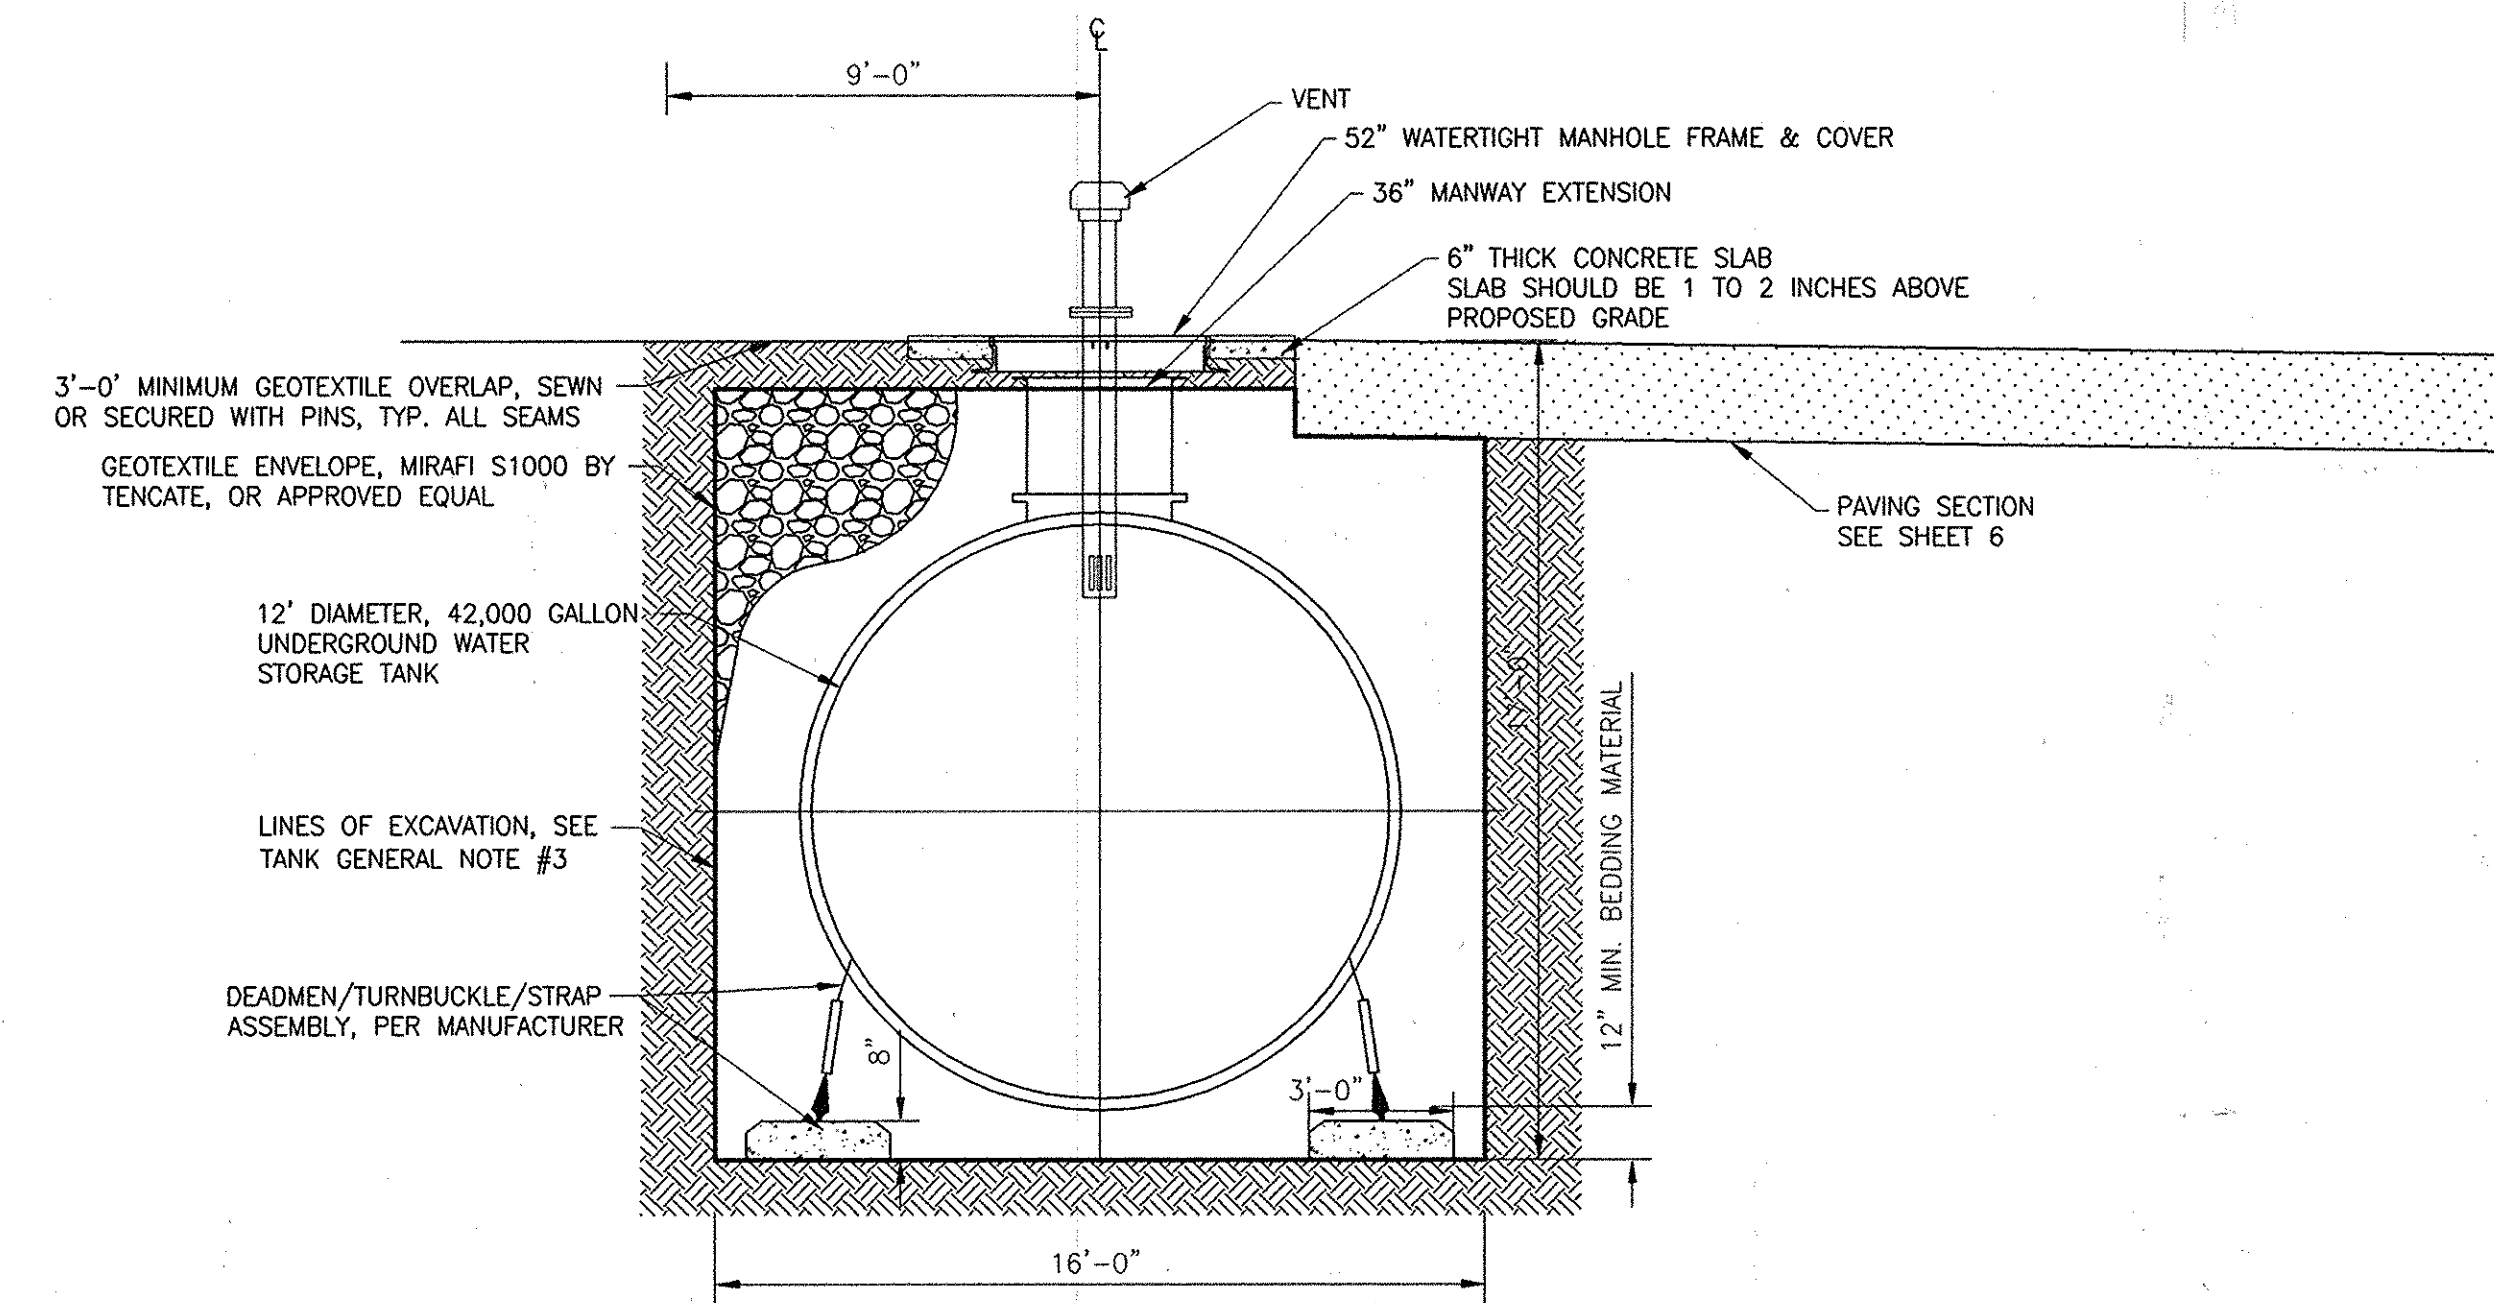


**SECTION A-A**  
SCALE 1/4" = 1'-0"

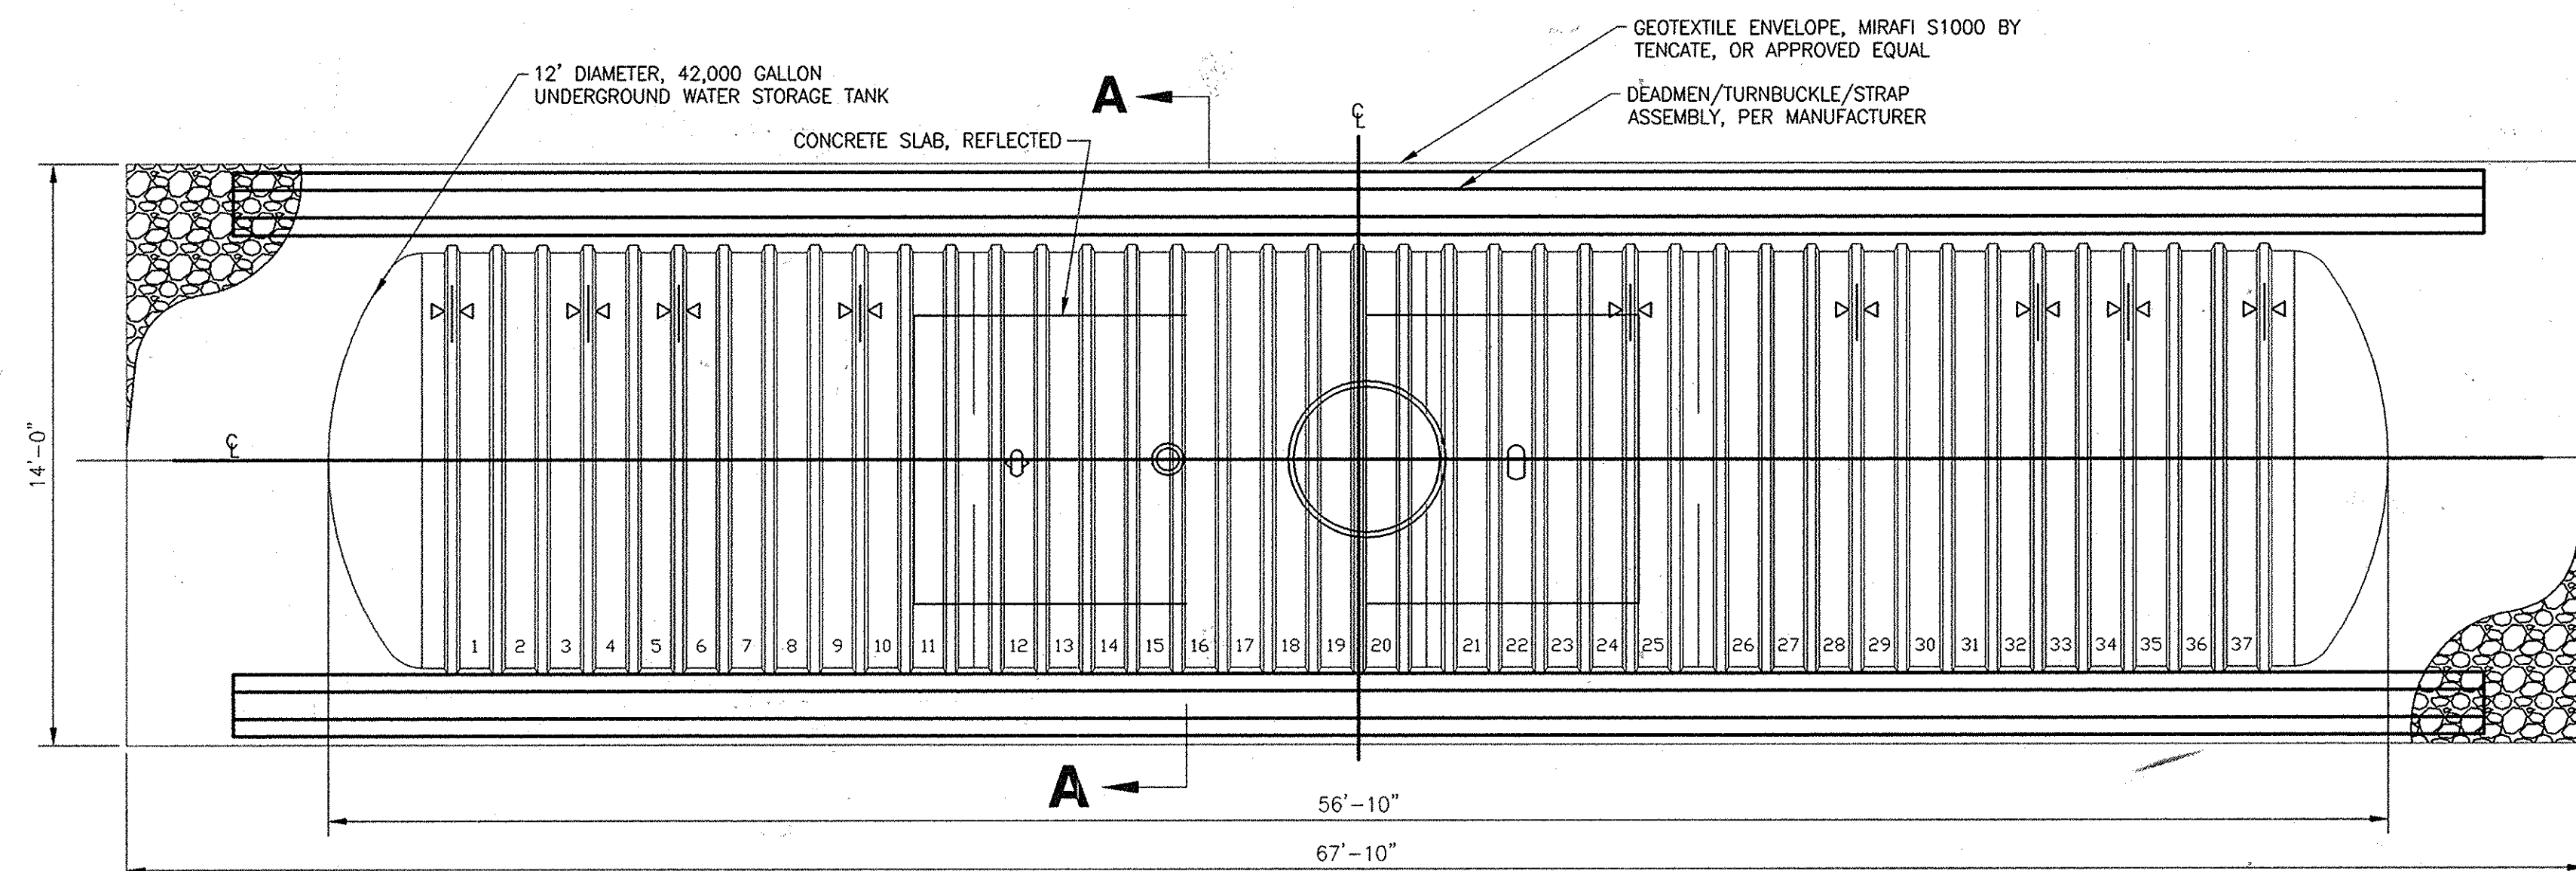

**PLAN: 42,000 GALLON FIRE SUPPRESSION WATER STORAGE TANK**  
SCALE 1/4" = 1'-0"

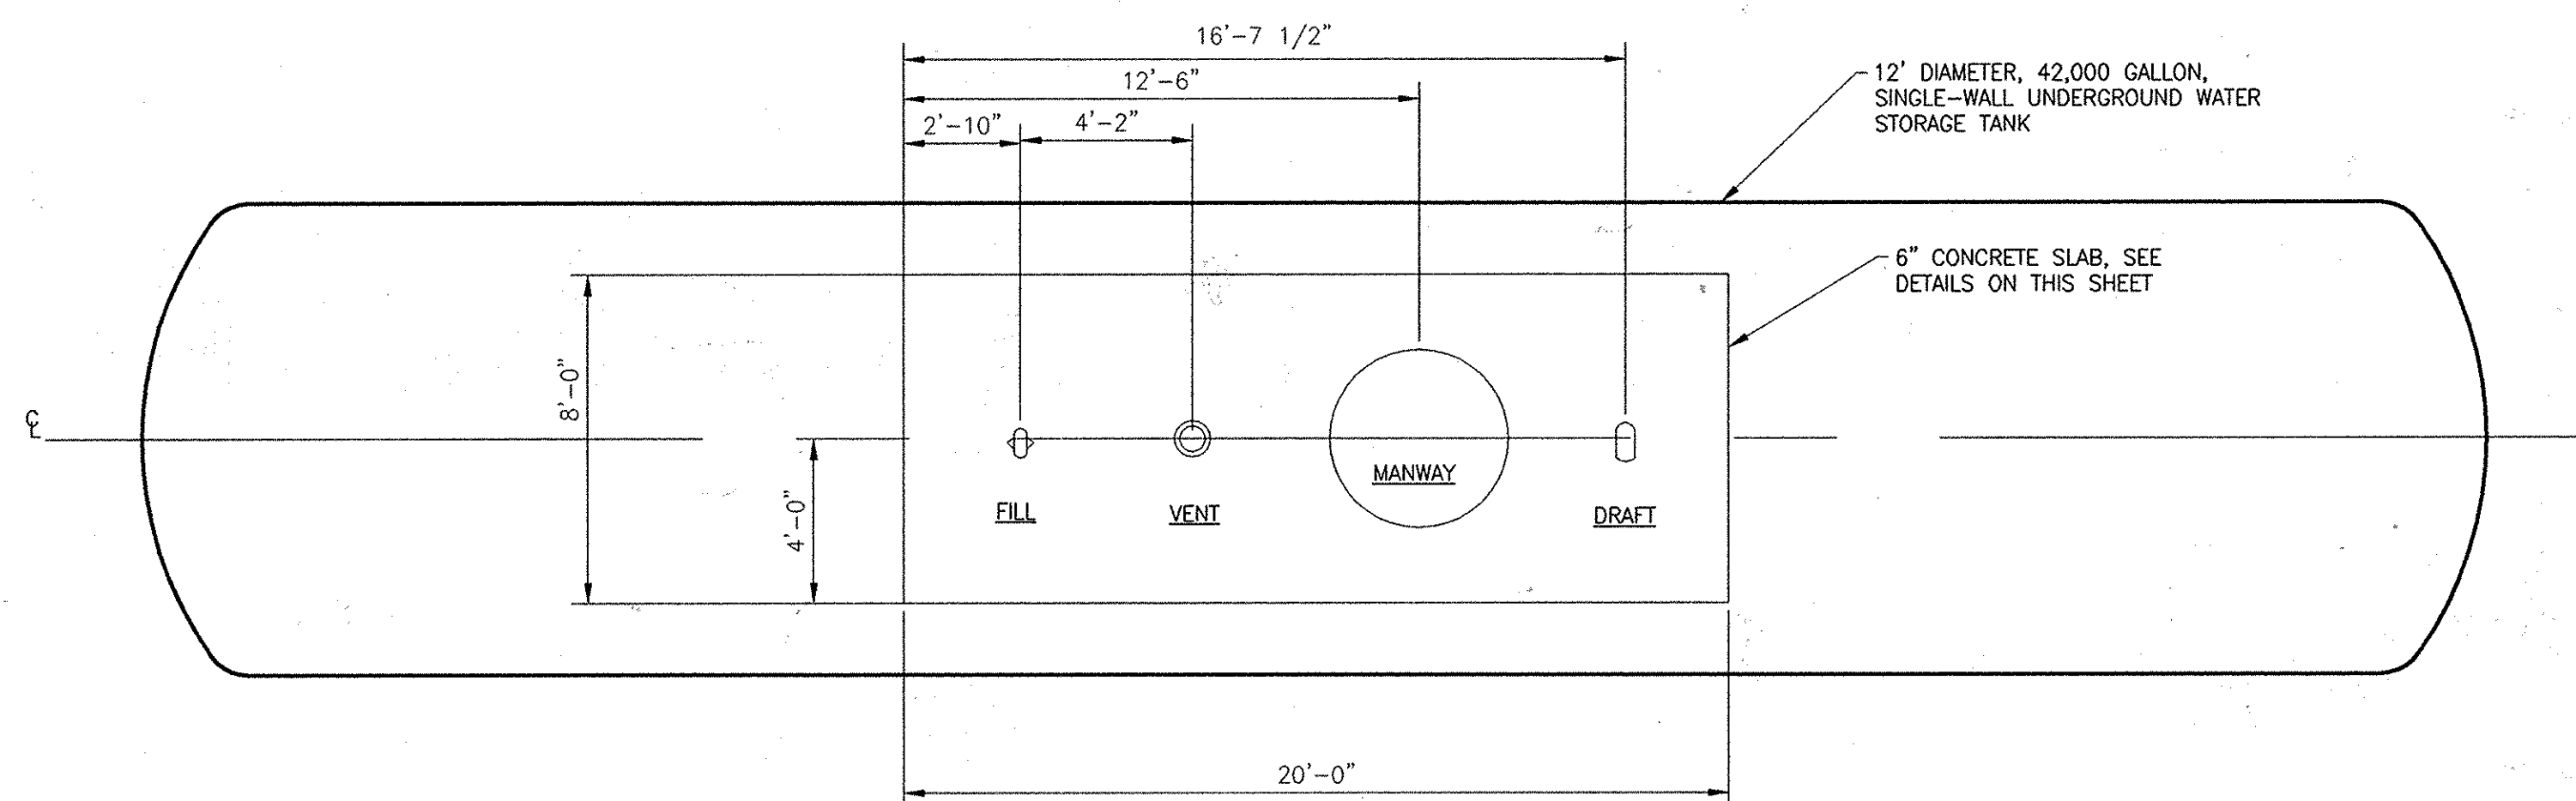

**DETAIL: CONCRETE SLAB**  
SCALE 1/4" = 1'-0"

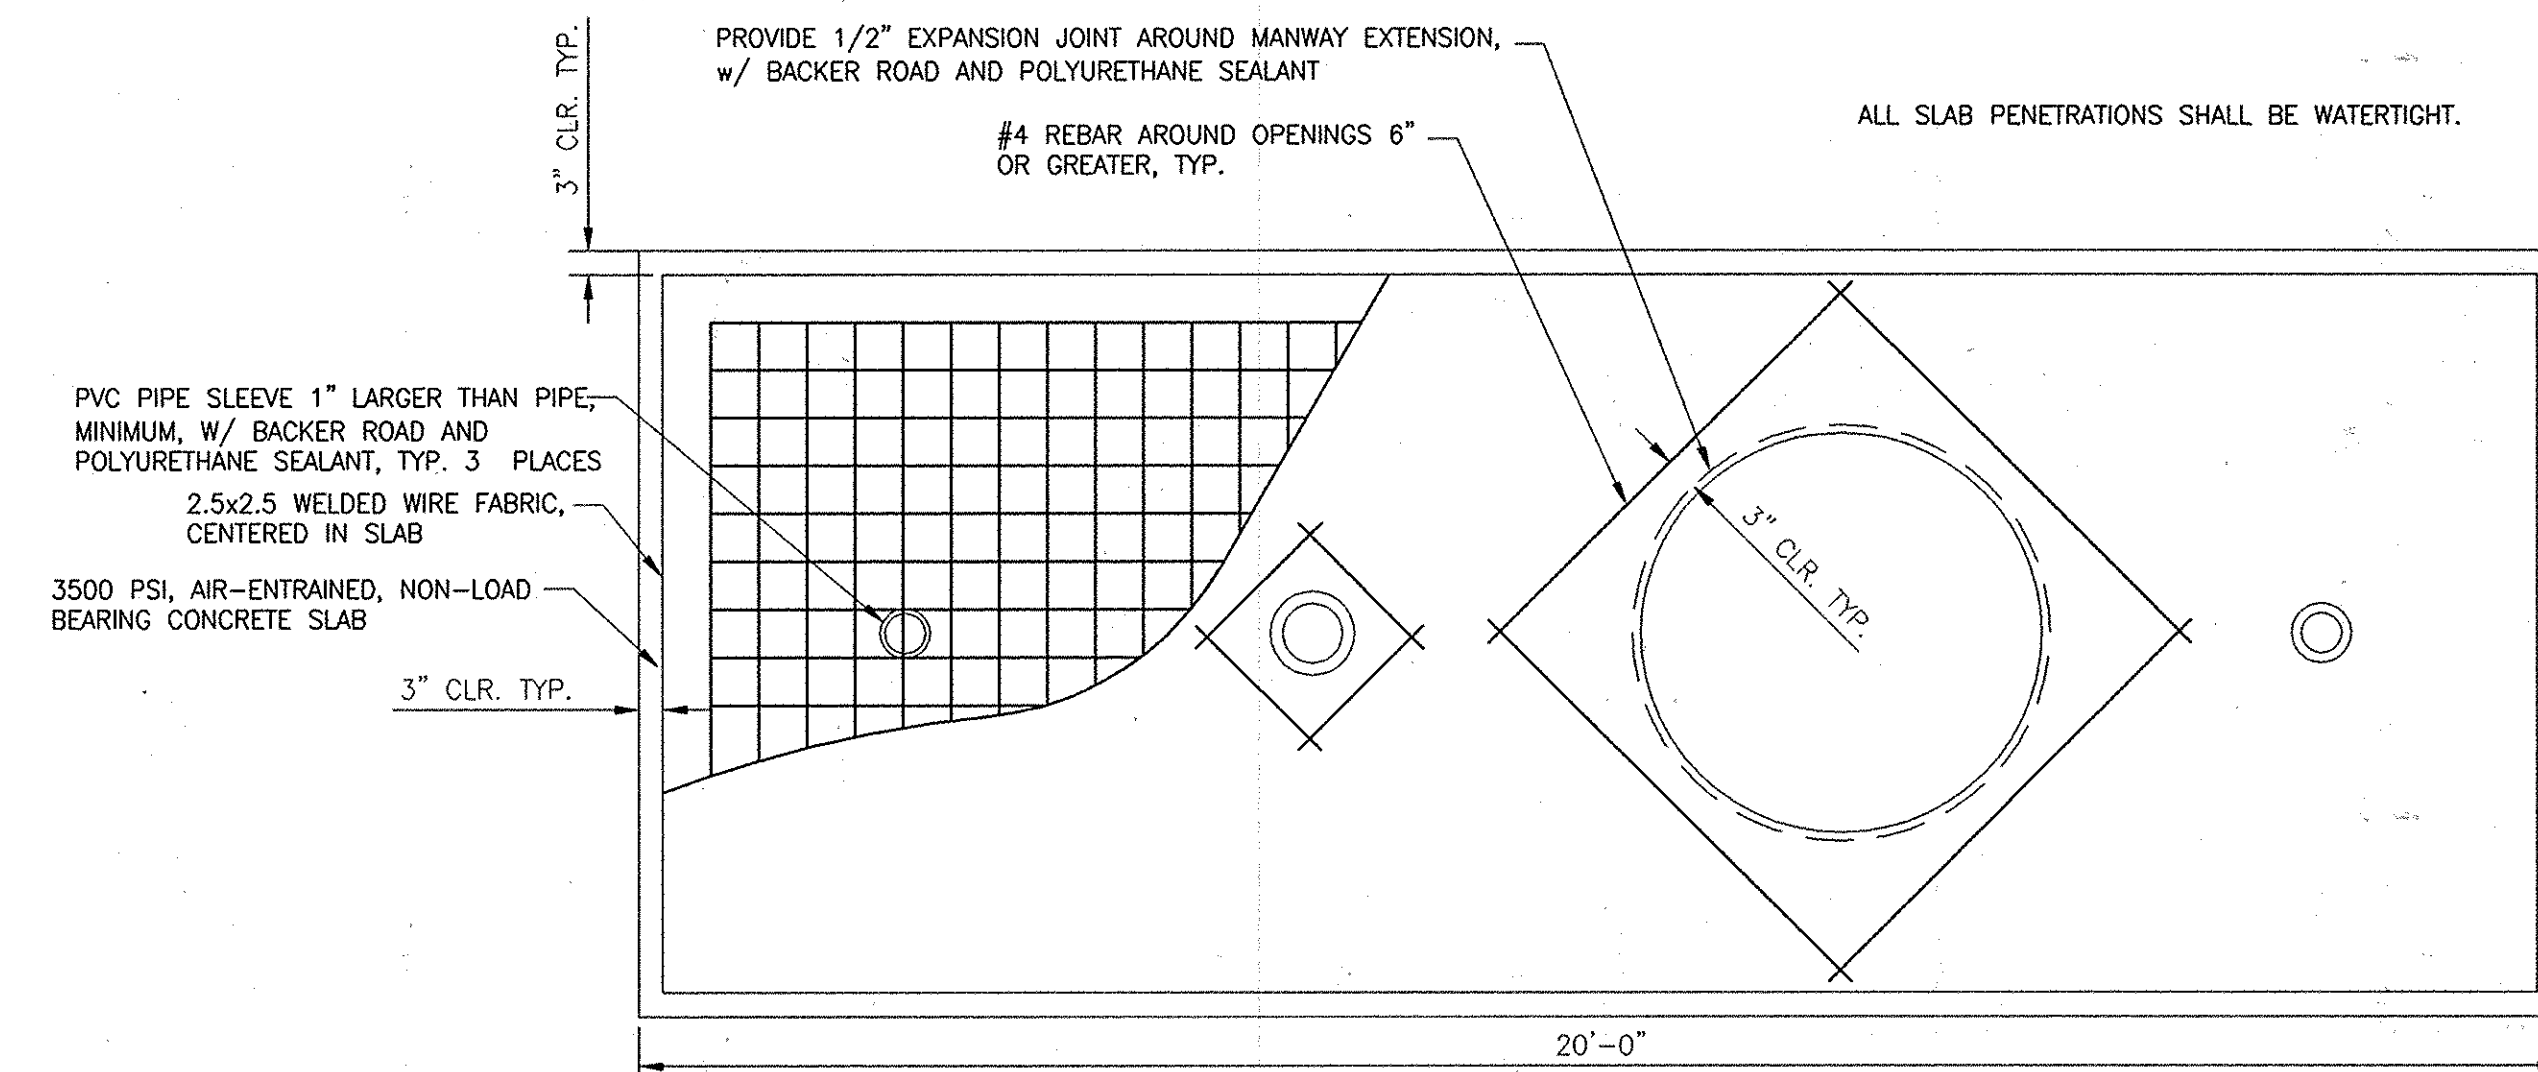

**DETAIL: CONCRETE SLAB REINFORCEMENT**  
SCALE 1/2" = 1'-0"

**AS-BUILTS** DEC 28 2015

**DEPARTMENT OF PUBLIC WORKS**  
HOWARD COUNTY, MARYLAND

DIRECTOR OF PUBLIC WORKS: *[Signature]* DATE: 7/2/14  
 CHIEF, BUREAU OF UTILITIES: *[Signature]* DATE: 7/17/14  
 CHIEF, UTILITY DESIGN DIVISION: *[Signature]* DATE: 7/17/14

**Dewberry**  
Dewberry Consultants, LLC  
3108 LORD BALTIMORE DRIVE  
SUITE 110  
BALTIMORE, MD 21244-2662  
410.285.9500  
FAX: 410.285.8875



DES: LAL				
DRN: RLI				
CHK: TND				
DATE: 07/2014	BY: NO.	REVISIONS	DATE	

**GENERAL DETAILS 1**

600' SCALE MAP NO. 15 BLOCK NO. 10


**UNDERGROUND WATER STORAGE TANK FOR FIRE SUPPRESSION**  
F-5972 65-4908

ELECTION DISTRICT NO. 4 HOWARD COUNTY, MARYLAND

SCALE: SHOWN  
SHEET 5 OF 8

Printed by: [unclear] on: [unclear] Date: Jul 16, 2014 - 12:34pm  
 Path: S:\Projects\2014\07\16\14\071614\DWG\DWG\FireSuppTank.dwg  
 User: [unclear]  
 Plot: [unclear]  
 Plot Date: Jul 16, 2014 - 12:34pm  
 PLOT: [unclear]  
 PLOT DATE: Jul 16, 2014 - 12:34pm  
 PLOT BY: [unclear]



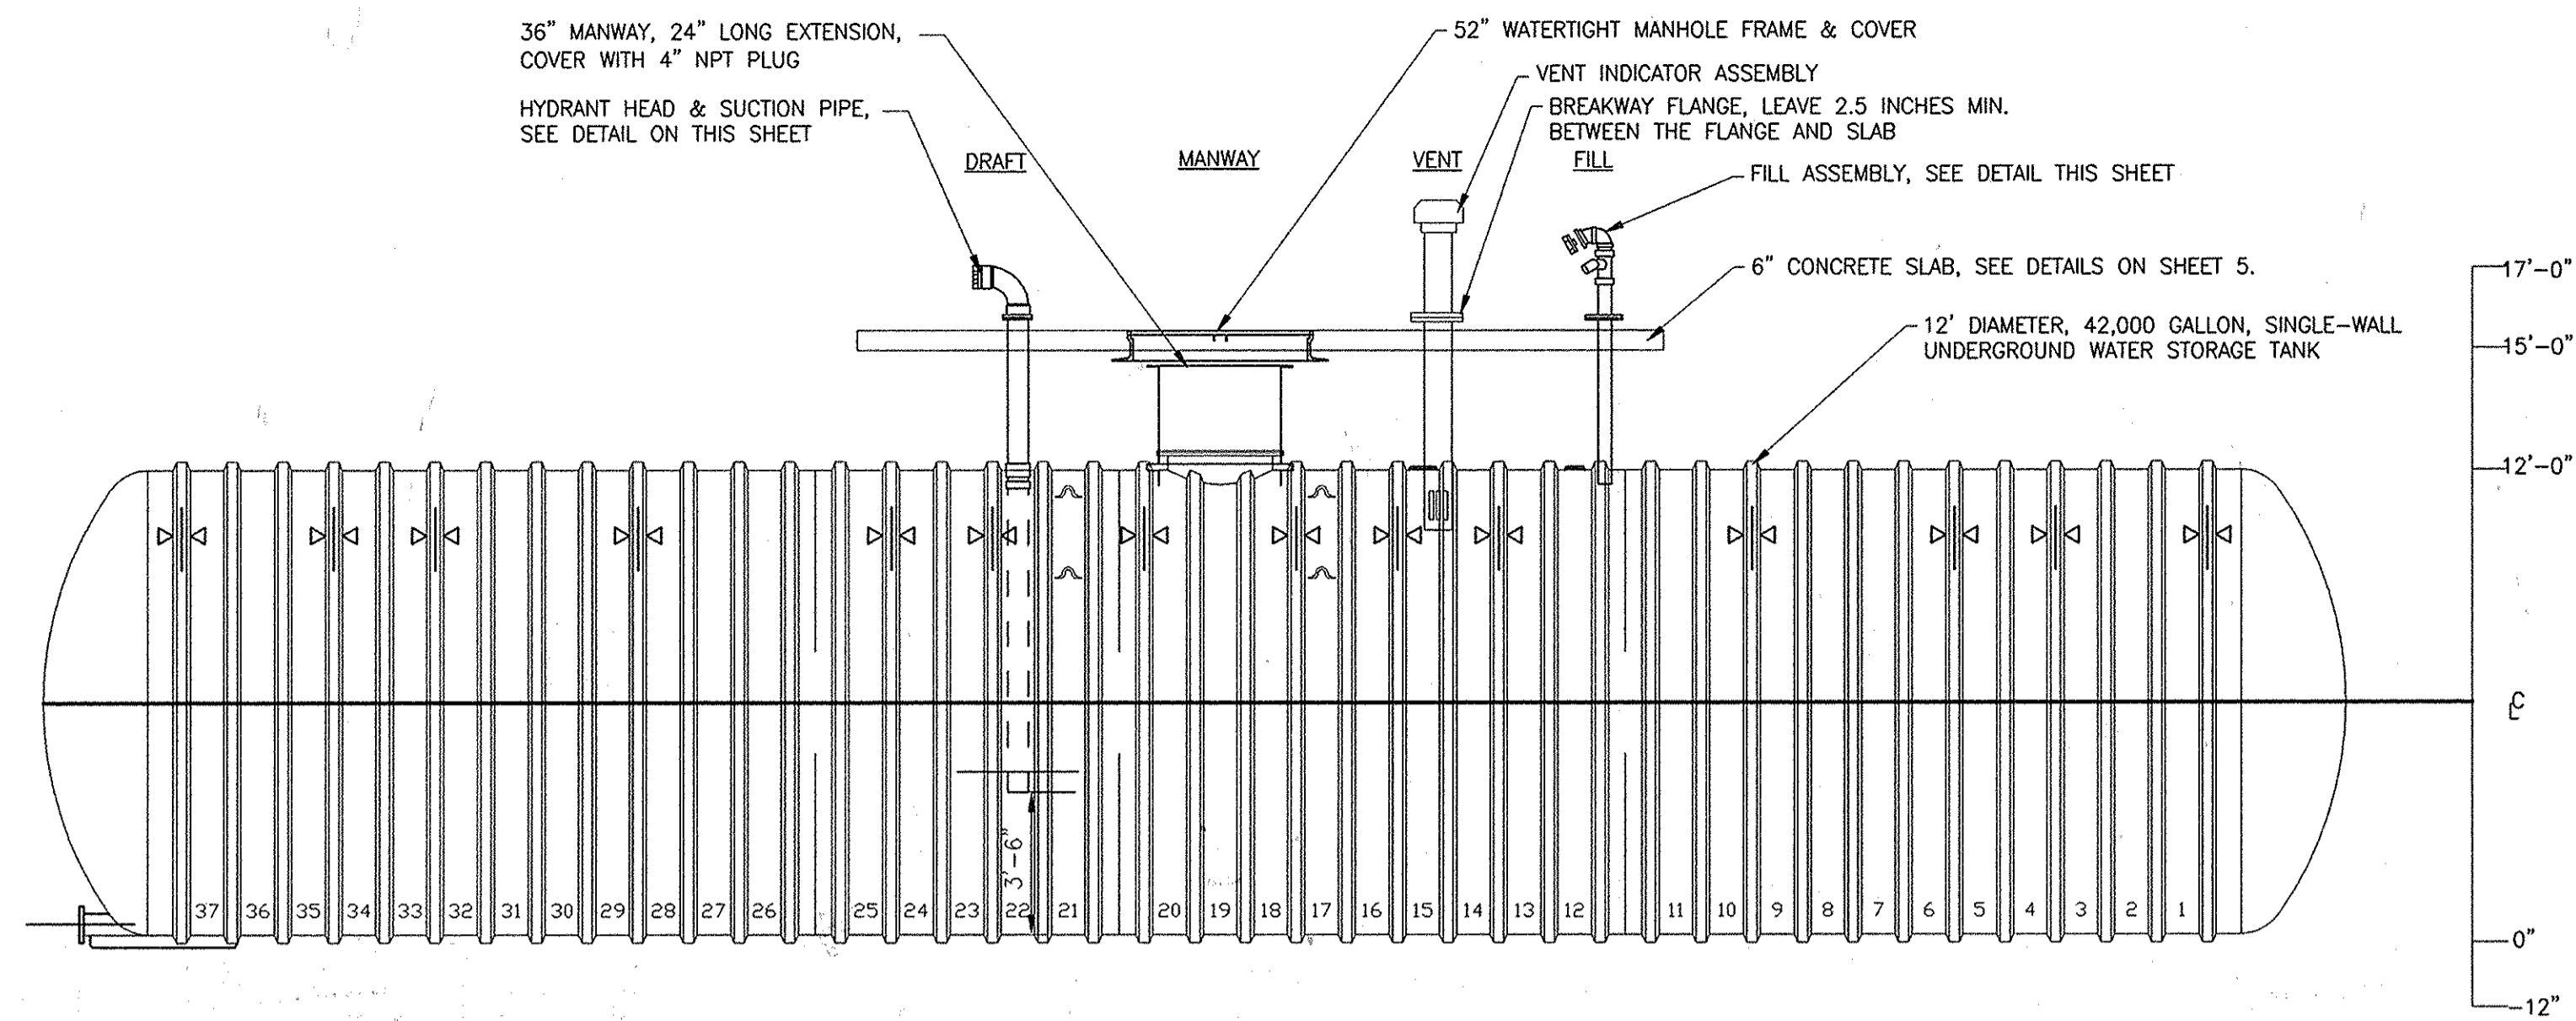

**SECTION THROUGH 42,000 GALLON FIRE SUPPRESSION WATER STORAGE TANK**

SCALE 1/4" = 1'-0"

TABLE 1 - CONNECTION & FITTING SCHEDULE

FITTING	CONNECTION DESCRIPTION	DESCRIPTION	SPECIFICATION	CENTER DRAFT	
				SECTION*	OFFSET**
DRAFT	6" 6NH FEMALE SWIVEL (SCH 40 BLACK)	6" NPT FULL COUPLING	2.3.2	22	29'-4 1/2"
FILL	4" SCH 40 BLACK (2) 2 1/2" FEMALE SIAMESE AND (1) 4" STORZ	4" NPT FULL COUPLING	2.3.4	12	14'-10 1/2"
VENT	8" PVC	10" CLASS 150 FLANGE	2.3.3	15	19'-0"
MANWAY	36" DIAMETER, 52" COVER	36" MANWAY, 24" EXTENSION, 4" NPT COUPLING AND PLUG	2.2.7	18-20	24'-4 1/2"

\* SEE ELEVATION ON SHEET 5 FOR SECTION NUMBER

\*\* OFFSET FROM CENTER OF SECTION 1

TABLE 2 - DIMENSIONS


DIMENSION	DESCRIPTION
17'-0" (MAX)	DRAFT PIPE CENTERLINE
15'-0"	TOP OF SLAB
12'-0"	TOP OF TANK
0	BOTTOM OF TANK
-10"	BOTTOM OF EXCAVATION

**NOTES**

- TANK DIMENSIONS AND LAYOUT ARE FOR REFERENCE ONLY. ACTUAL TANK DIMENSIONS WILL VARY WITH MANUFACTURER.
- BOLLARDS SHALL ONLY BE INSTALLED AT THE DIRECTION OF HOWARD COUNTY.


**PAVING NOTES**

- LATEST EDITION OF THE HOWARD COUNTY VOLUME IV DESIGN MANUAL STANDARD SPECIFICATIONS AND DETAILS FOR CONSTRUCTION.
- PAVING FOR THE ASPHALT PULLOFF SHALL CONFORM TO DETAIL R-2.02, SECTION NUMBER P-6 OF THE MAY 18, 2007 EDITION OF THE HOWARD COUNTY DESIGN MANUAL.
- HOWARD COUNTY DPW RESERVES THE RIGHT TO REQUIRE AN ALTERNATE PAVING SECTION, BASED ON SITE CONDITIONS OR VEHICULAR REQUIREMENTS.
- ALL PAVING THICKNESSES SHOWN, DIMENSIONED OR OTHERWISE NOTED ARE MINIMUM THICKNESSES.

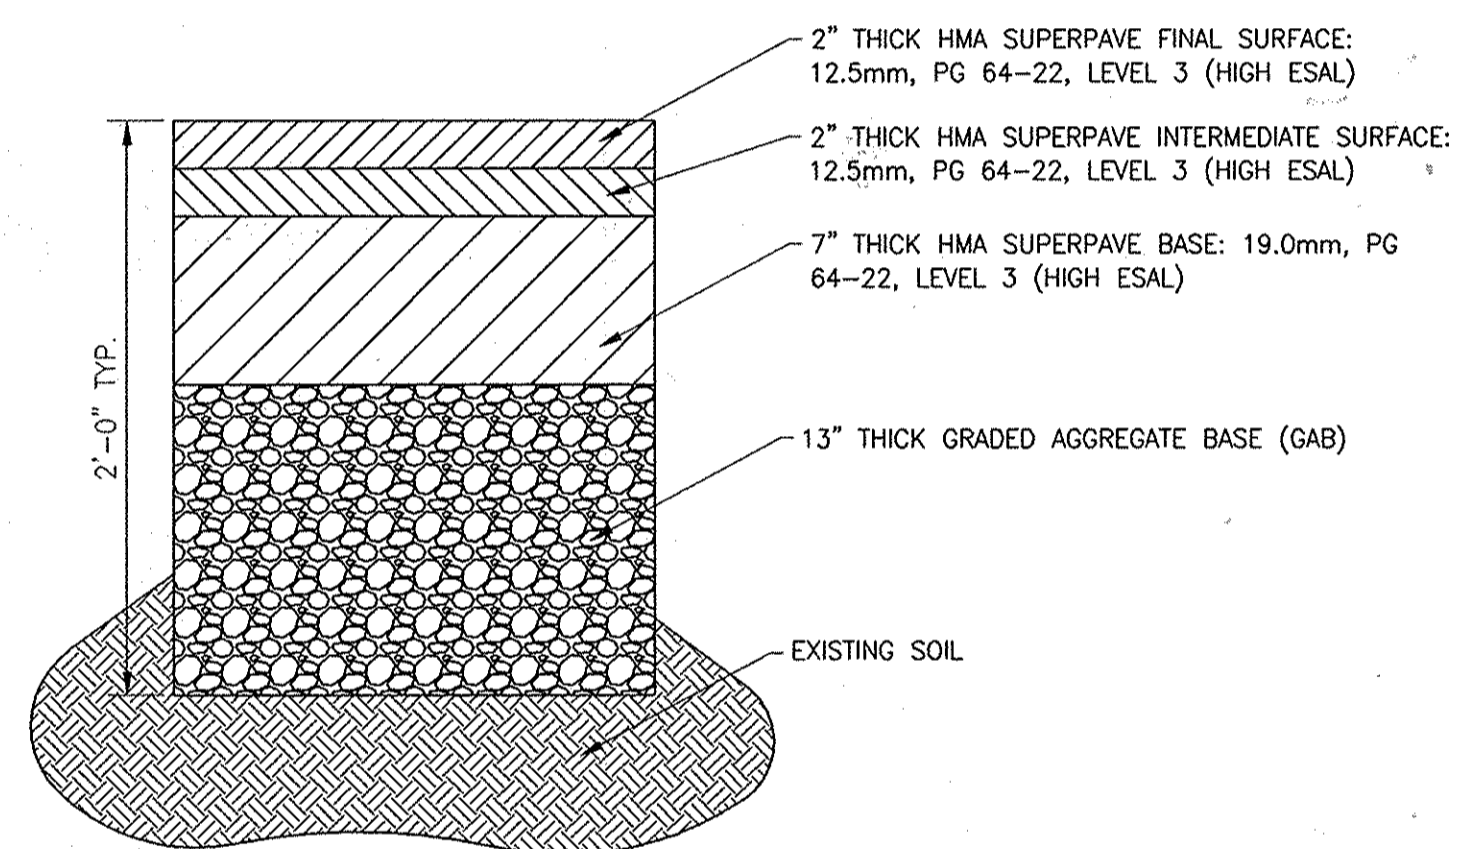


**DETAIL: PAVING SECTION**

SCALE 1-1/2" = 1'-0"

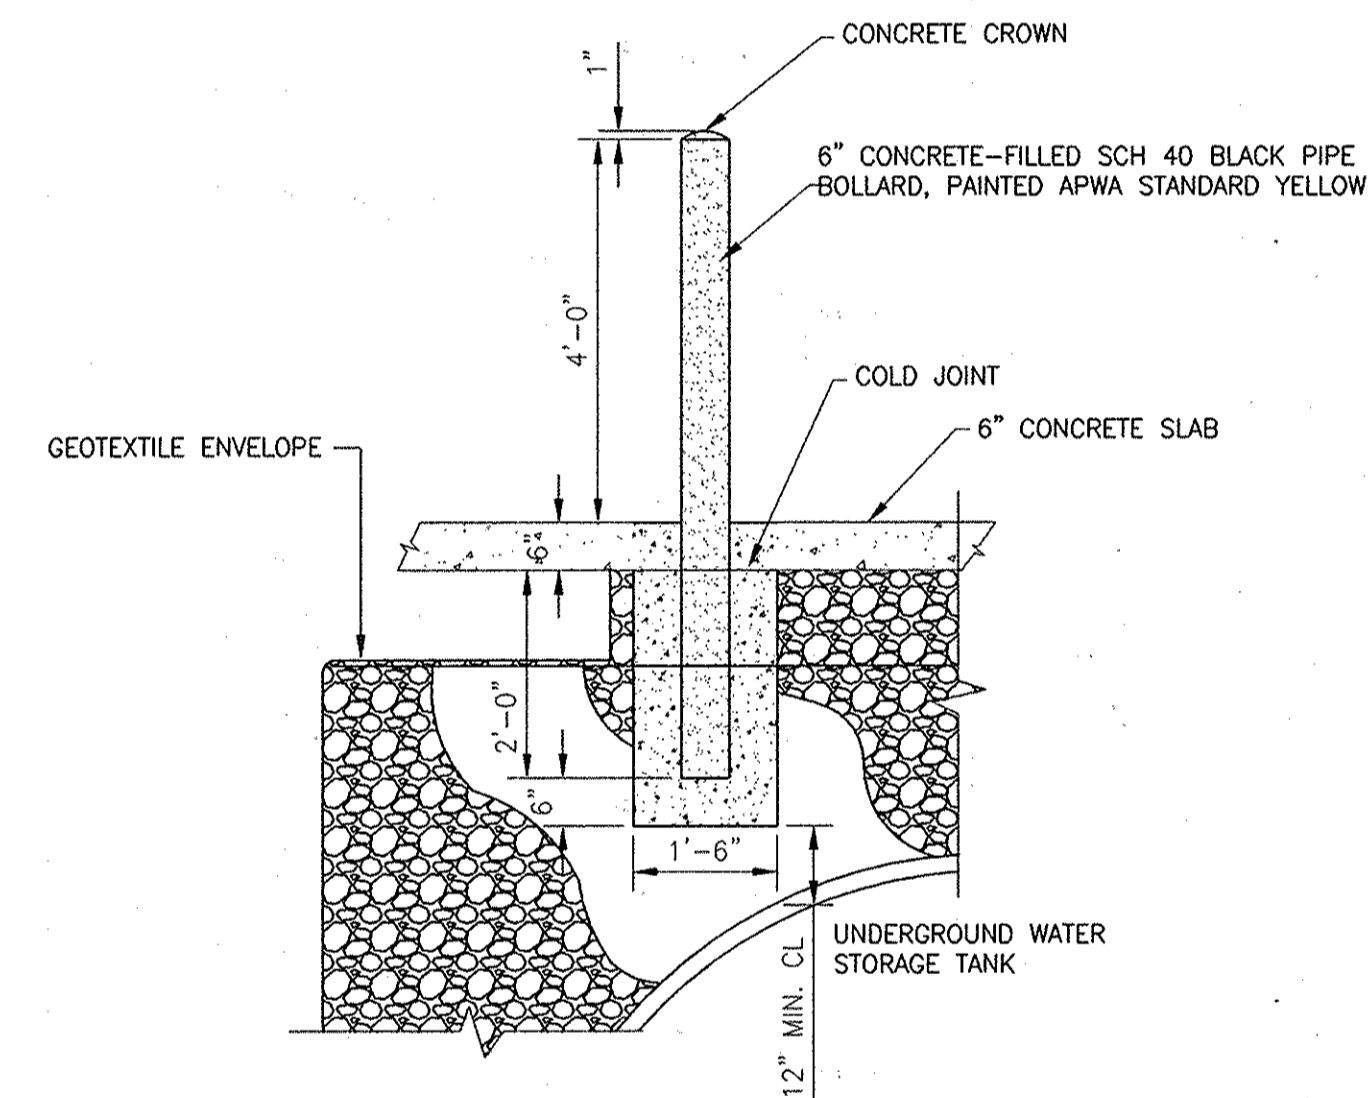


**DETAIL: TYPICAL BOLLARD**

SCALE 1/2" = 1'-0"

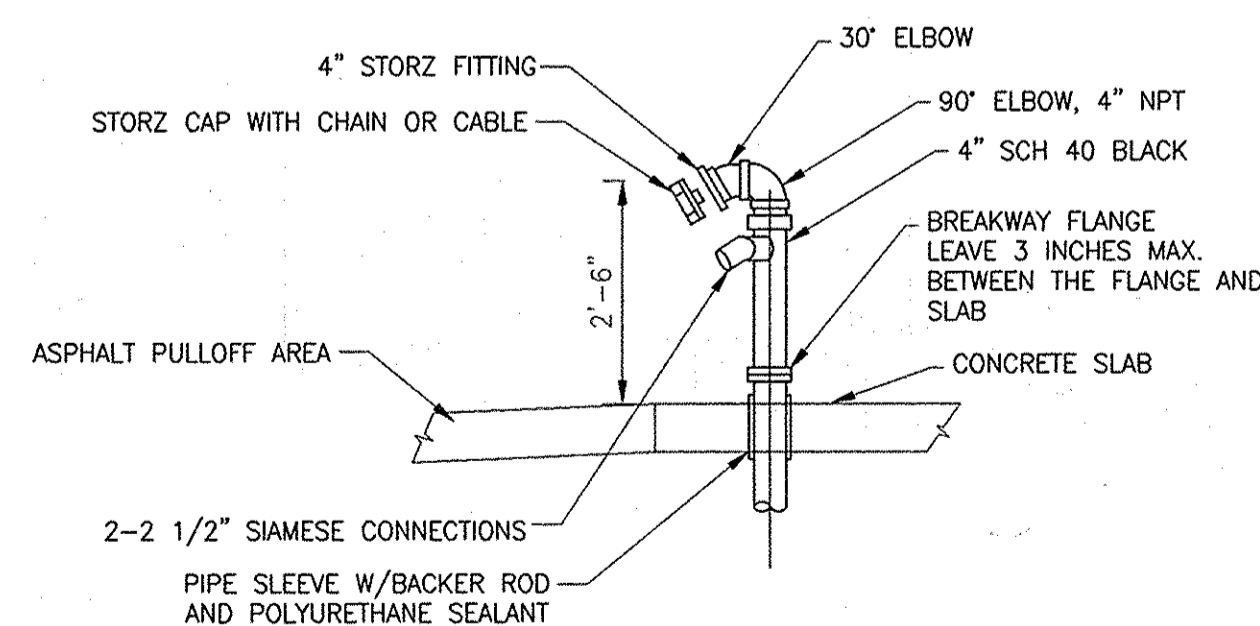


**DETAIL: FILL ASSEMBLY**

SCALE 1/2" = 1'-0"

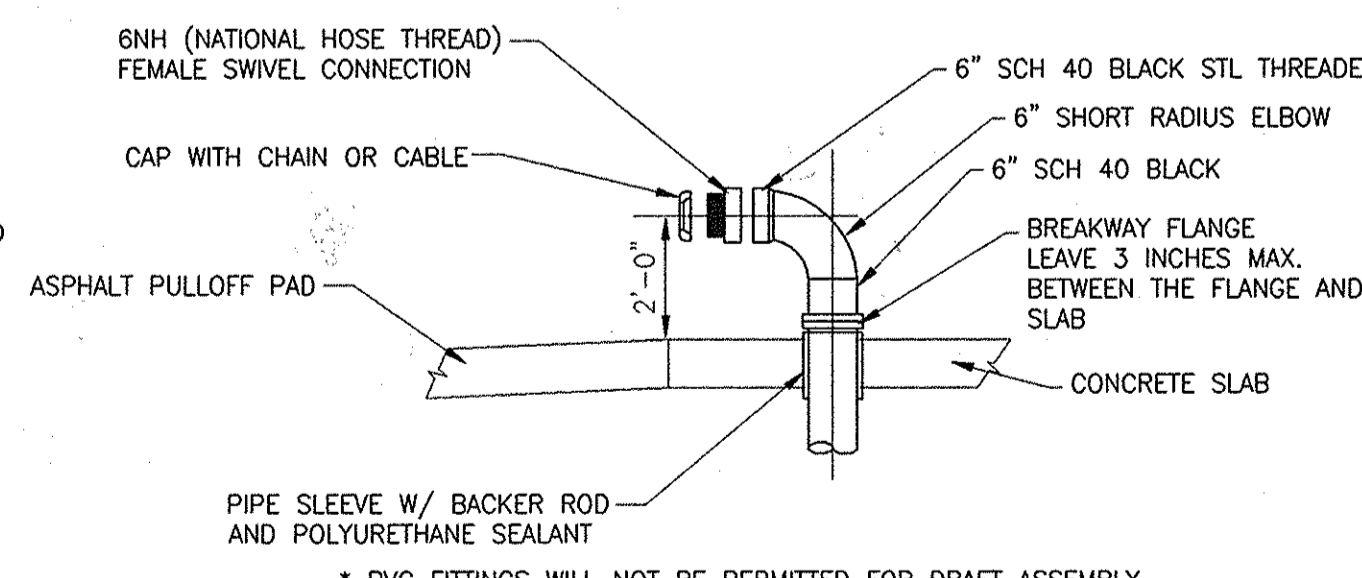


**DETAIL: HYDRANT HEAD (DRAFT) ASSEMBLY**

SCALE 1/2" = 1'-0"

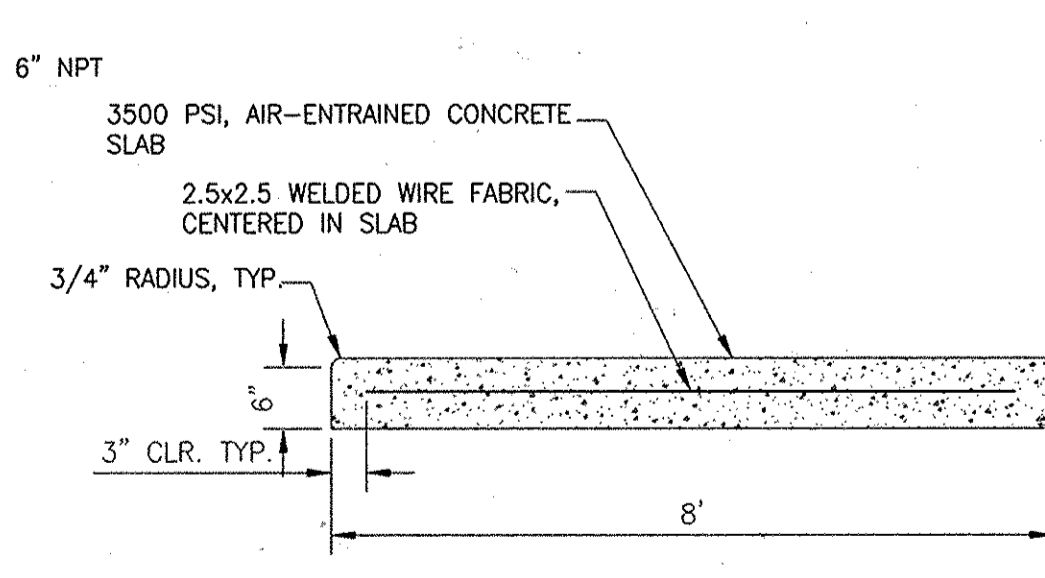


**DETAIL: CONCRETE SLAB TYPICAL SECTION**

SCALE 3/4" = 1'-0"

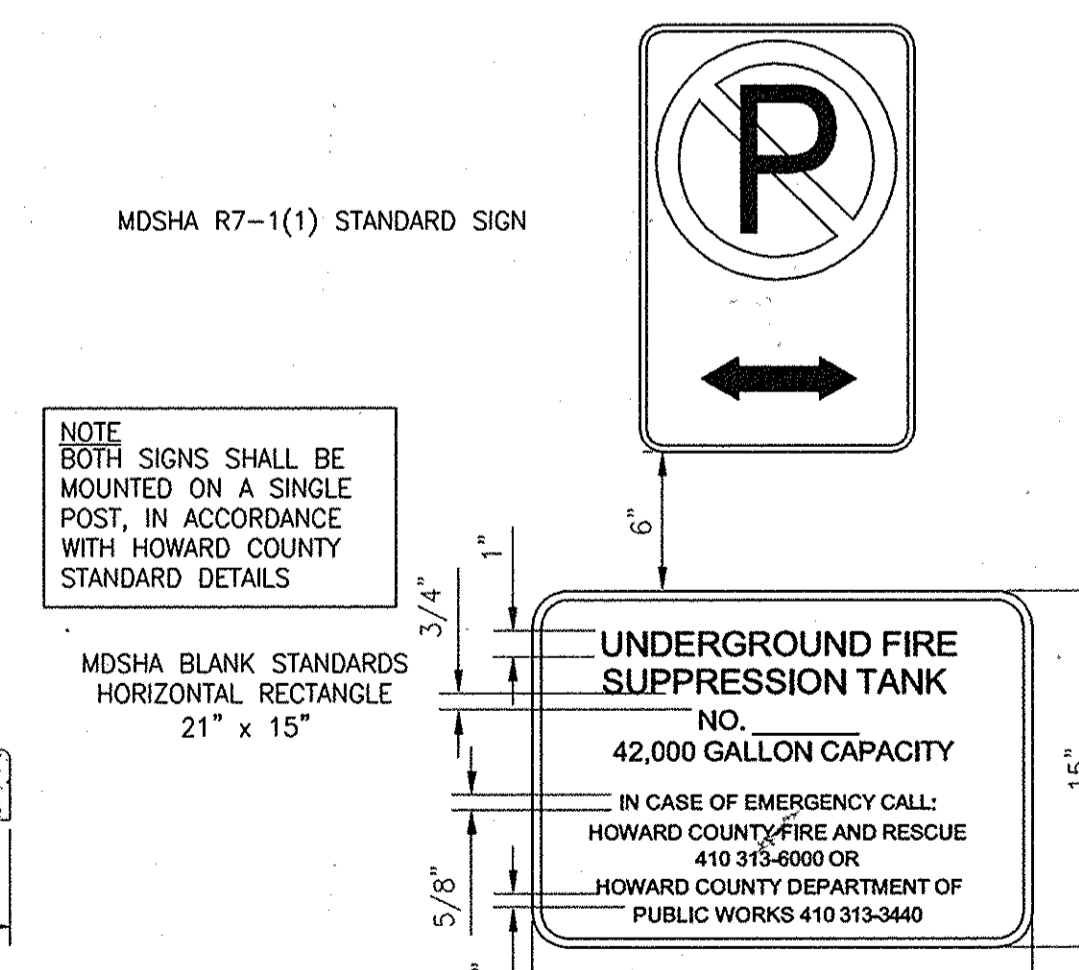

**DETAIL: TYPICAL TANK SIGNAGE**

SCALE 1/2" = 1'-0"

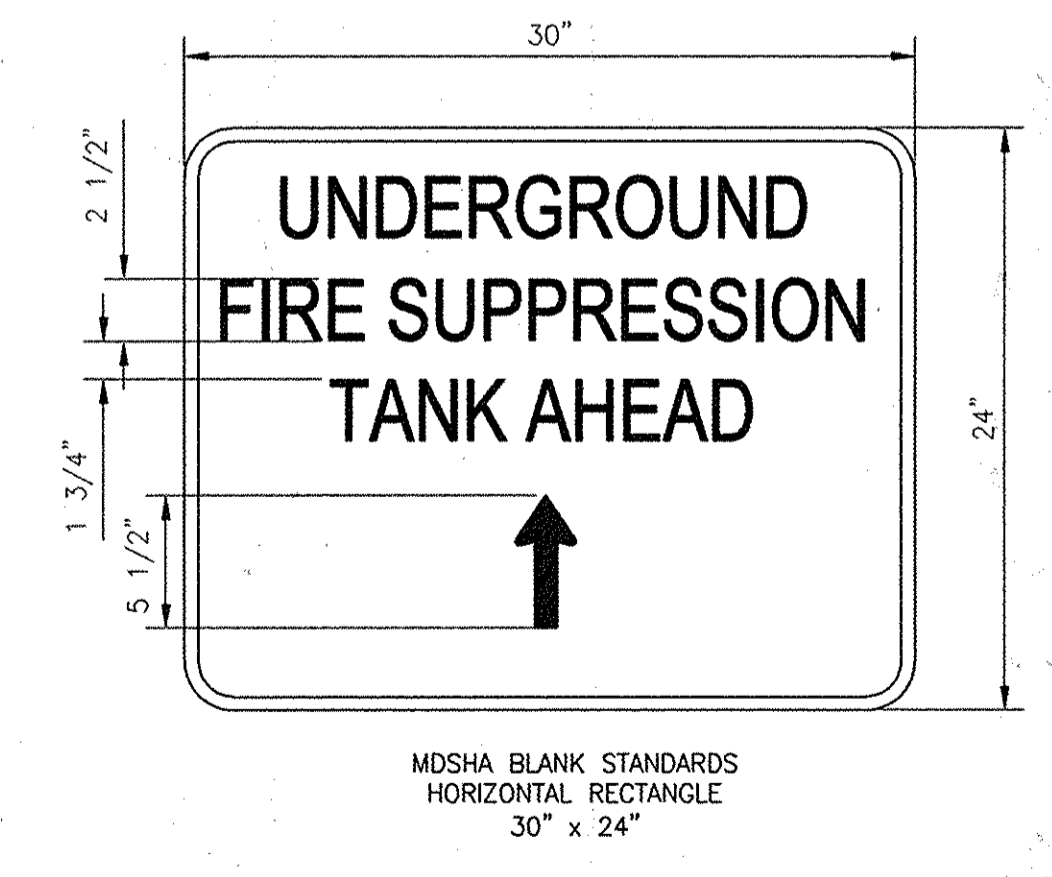

**DETAIL: TYPICAL ADVANCE SIGNAGE**


SCALE 1/2" = 1'-0"

**AS-BUILTS** DEC 28 2015

**DEPARTMENT OF PUBLIC WORKS**  
HOWARD COUNTY, MARYLAND

Director of Public Works: [Signature] 7/2/14  
 Chief, Bureau of Utilities: [Signature] 7/17/14  
 Chief, Utility Design Division: [Signature] PSD

**Dewberry**  
Dewberry Consultants, LLC  
3108 LORD BALTIMORE DRIVE  
SUITE 110  
BALTIMORE, MD 21244-2662  
410.285.8500  
FAX: 410.285.9875

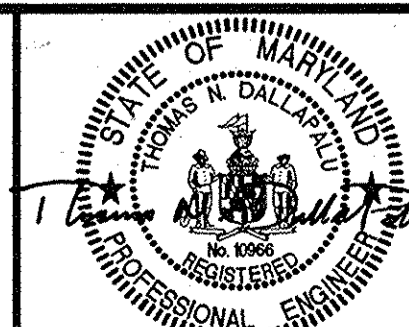

DES: LAL				
DRN: RLJ				
CHK: TND				
DATE: 07/2014	BY NO.	REVISIONS	DATE	

**GENERAL DETAILS - 2**


600' SCALE MAP NO. 15 BLOCK NO. 10

**UNDERGROUND WATER STORAGE TANK FOR FIRE SUPPRESSION**  
F-5972 65-4908

ELECTION DISTRICT NO. 4


HOWARD COUNTY, MARYLAND

SCALE: SHOWN  
SHEET 6 OF 8

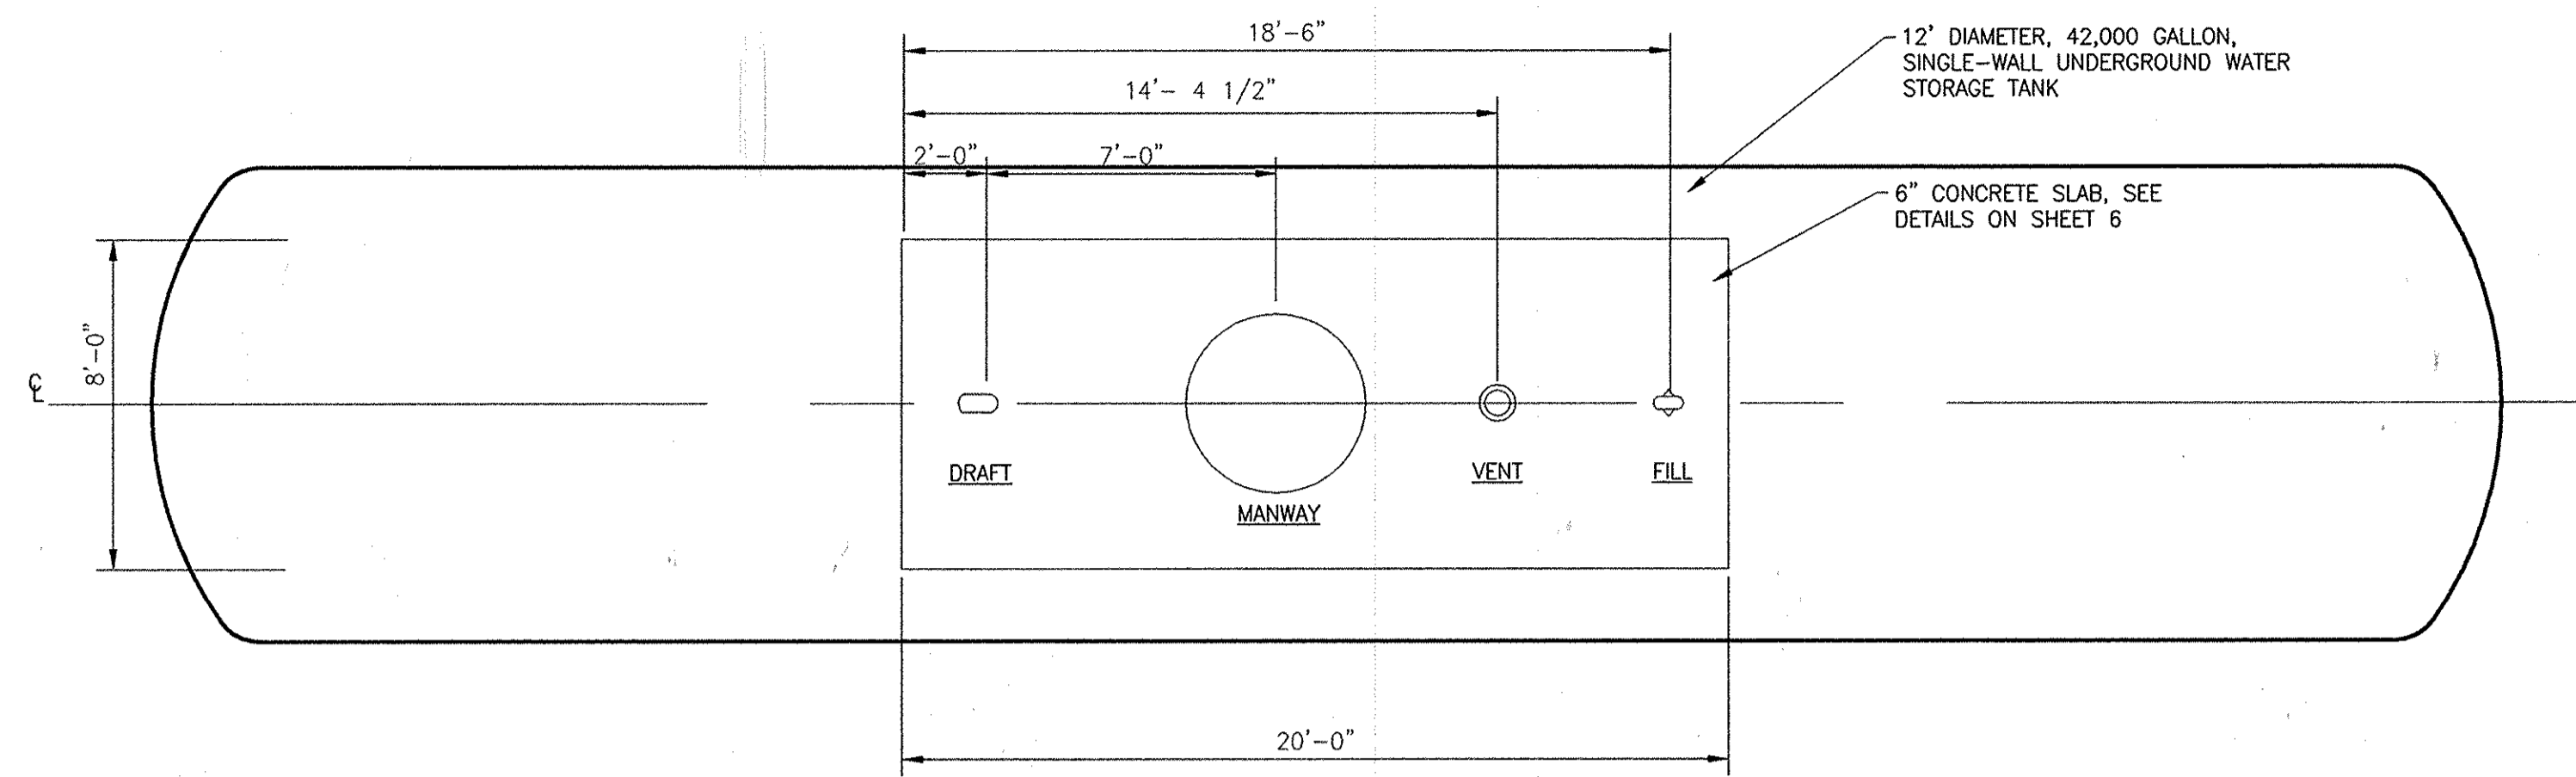


**PLAN: 42,000 GALLON FIRE SUPPRESSION WATER STORAGE  
TANK DRAFT CONFIGURATION**

SCALE 1/4" = 1'-0"

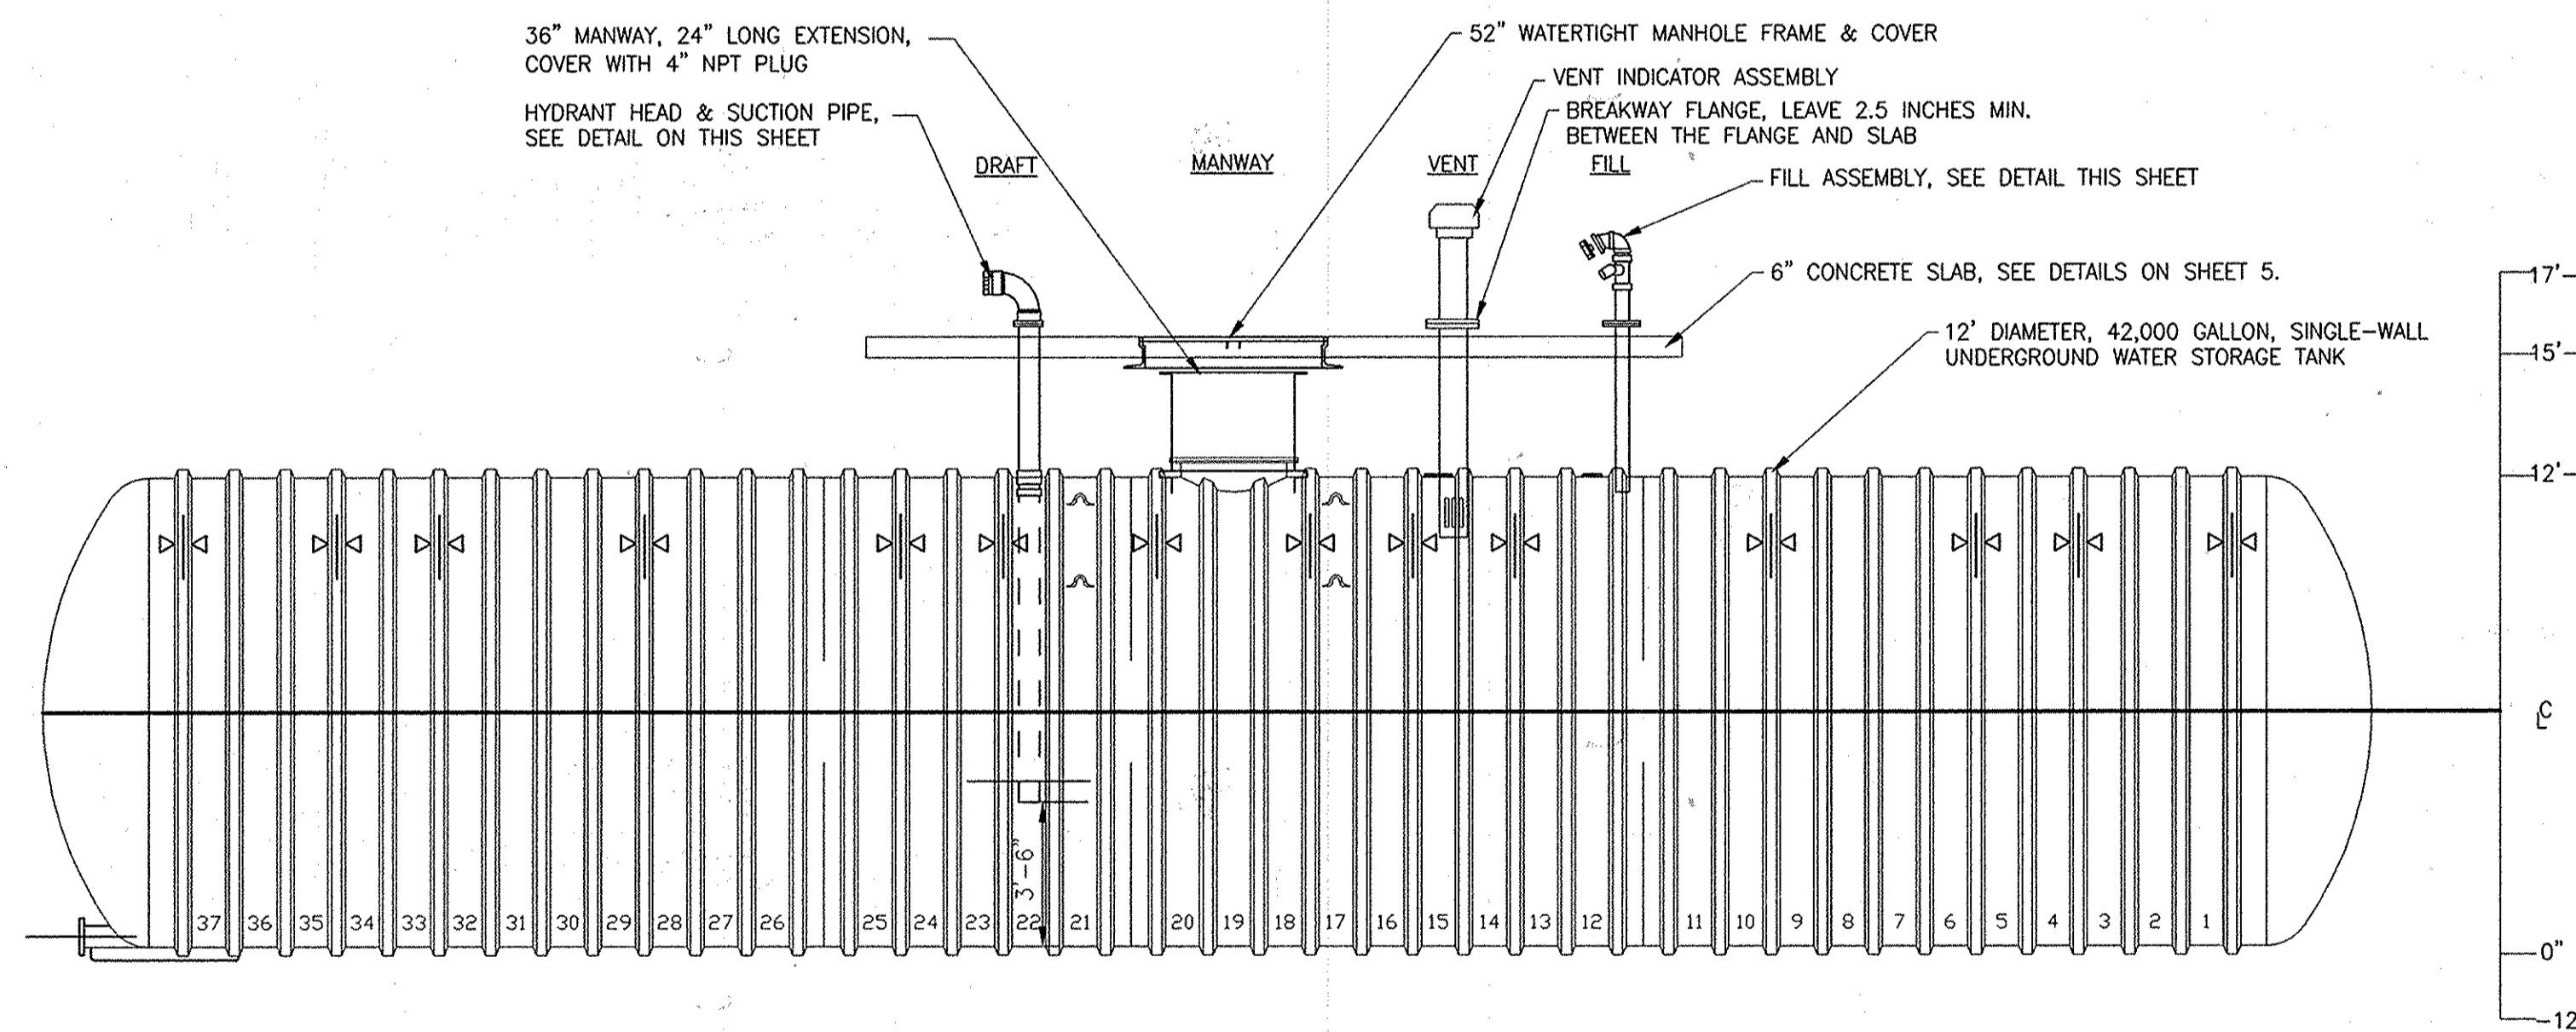

**SECTION THROUGH 42,000 GALLON FIRE SUPPRESSION  
WATER STORAGE TANK DRAFT CONFIGURATION**

SCALE 1/4" = 1'-0"

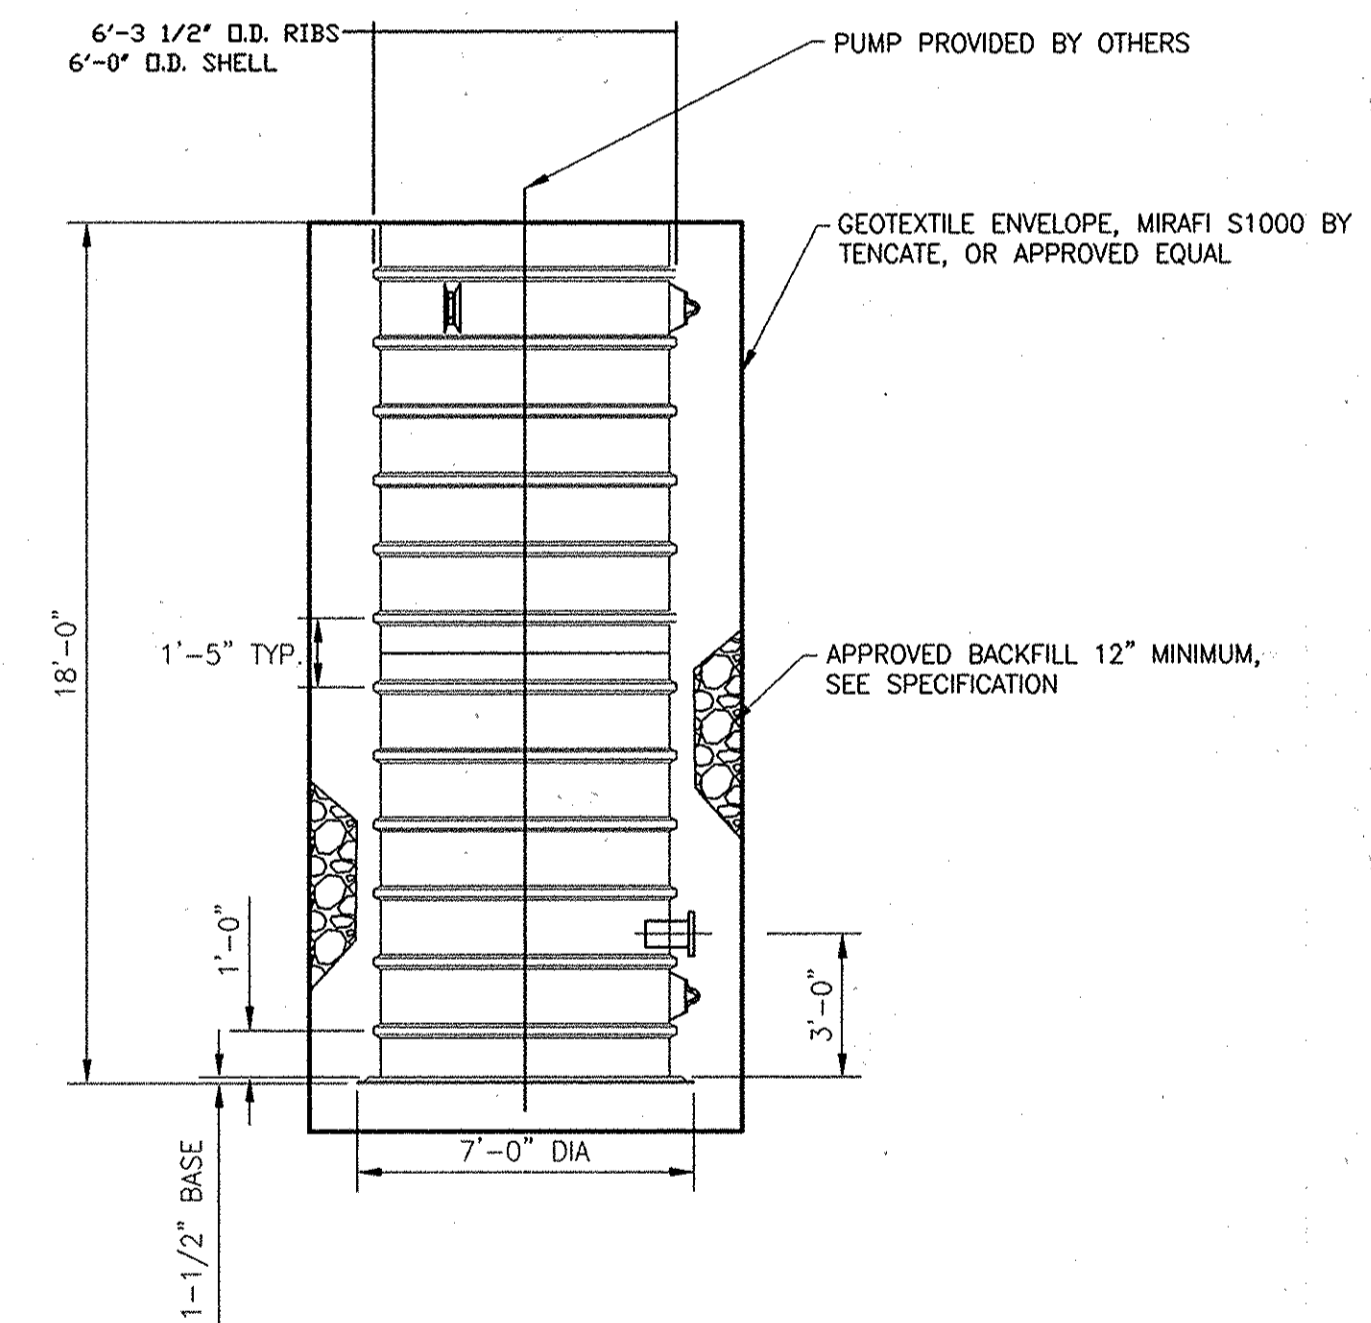

**DETAIL: WET WELL**

SCALE 1/4" = 1'-0"


**AS-BUILTS**

DEC 28 2015

**DEPARTMENT OF PUBLIC WORKS  
HOWARD COUNTY, MARYLAND**

Director of Public Works: *[Signature]* DATE: 7/18/14  
 Chief, Bureau of Engineering: *[Signature]* DATE: 7/17/14  
 Chief, Utility Design Division: *[Signature]* DATE: 7/17/14

**Dewberry**  
 Dewberry Consultants, LLC  
 3100 LORD BALTIMORE DRIVE  
 SUITE 110  
 BALTIMORE, MD 21244-2662  
 410.285.9300  
 FAX: 410.295.9875

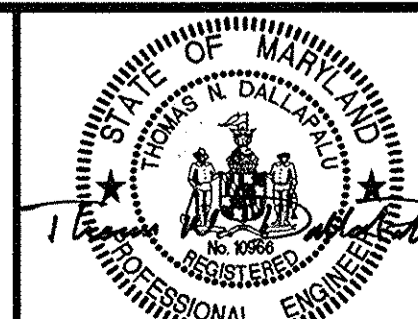

DES: LAL					
DRN: RLI					
CHK: TND					
DATE: 07/2014	BY	NO.	REVISIONS	DATE	

**GENERAL DETAILS - 3**

600' SCALE MAP NO. 15 BLOCK NO. 10

**UNDERGROUND WATER STORAGE TANK  
FOR FIRE SUPPRESSION**

F-5972 GS-490B

ELECTION DISTRICT NO. 4

HOWARD COUNTY, MARYLAND

SCALE:

SHOWN

SHEET

7 OF 8

Plotted by: (User) on: Thu, 16 Dec 2015, 10:52am  
 Path: > C:\00008781\000\Civil\Fredrick Detail Sheets.dwg  
 User: Fredrick  
 Plot Date: 12/16/2015  
 Plot Time: 12:23pm  
 XREFS: > C:\00008781\000\Civil\Fredrick\_Border.dwg



**SEDIMENT CONTROL GENERAL NOTES**

- 1. A MINIMUM OF 48 HOURS NOTICE MUST BE GIVEN TO HOWARD COUNTY DEPARTMENT OF INSPECTIONS, LICENSES AND PERMITS, SEDIMENT CONTROL DIVISION PRIOR TO THE START OF ANY CONSTRUCTION. 410-313-1855.
2. ALL VEGETATIVE AND STRUCTURAL PRACTICES ARE TO BE INSTALLED ACCORDING TO THE PROVISIONS OF THE PLAN AND ARE TO BE IN CONFORMANCE WITH THE MOST CURRENT MARYLAND STANDARDS AND SPECIFICATIONS FOR SOIL EROSION AND SEDIMENT CONTROL AND REVISIONS THERETO.
3. FOLLOWING INITIAL SOIL DISTURBANCE OR RE-DISTURBANCE, PERMANENT OR TEMPORARY STABILIZATION SHALL BE COMPLETED WITHIN: A) 3 CALENDAR DAYS FOR ALL PERIMETER SEDIMENT CONTROL STRUCTURES, DIKES, PERIMETER SLOPES AND ALL SLOPES GREATER THAN 3:1, B) 7 DAYS AS TO ALL OTHER DISTURBED OR GRADED AREAS ON THE PROJECT SITE.
4. ALL DISTURBED AREAS MUST BE STABILIZED WITHIN THE TIME PERIOD SPECIFIED ABOVE IN ACCORDANCE WITH THE 2011 MARYLAND STANDARDS AND SPECIFICATIONS FOR SOIL EROSION AND SEDIMENT CONTROL FOR PERMANENT SEEDING (SEC. B-4-5), TEMPORARY SEEDING (SEC. B-4-4) AND MULCHING (SEC. B-4-3). TEMPORARY STABILIZATION WITH MULCH ALONE CAN ONLY BE DONE WHEN RECOMMENDED SEEDING DATES DO NOT ALLOW FOR PROPER GERMINATION AND ESTABLISHMENT OF GRASSES.
5. ALL SEDIMENT CONTROL STRUCTURES ARE TO REMAIN IN PLACE AND ARE TO BE MAINTAINED IN OPERATIVE CONDITION UNTIL PERMISSION FOR THEIR REMOVAL HAS BEEN OBTAINED FROM THE HOWARD COUNTY SEDIMENT CONTROL INSPECTOR.
6. ANY SEDIMENT CONTROL PRACTICES WHICH IS DISTURBED BY GRADING ACTIVITY FOR PLACEMENT OF UTILITIES MUST BE REPAIRED ON THE SAME DAY OF DISTURBANCE.
7. ADDITIONAL SEDIMENT CONTROL MUST BE PROVIDED, IF DEEMED NECESSARY BY THE HOWARD COUNTY SEDIMENT CONTROL INSPECTOR.
8. ON ALL SITES WITH DISTURBED AREAS IN EXCESS OF 2 ACRES, APPROVAL OF THE INSPECTION AGENCY SHALL BE REQUESTED UPON COMPLETION OF INSTALLATION OF PERIMETER EROSION AND SEDIMENT CONTROLS, BUT BEFORE PROCEEDING WITH ANY OTHER EARTH DISTURBANCE OR GRADING. OTHER BUILDING OR GRADING INSPECTION APPROVALS MAY NOT BE AUTHORIZED UNTIL THIS INITIAL APPROVAL BY THE INSPECTION AGENCY IS MADE.
9. TRENCHES FOR THE CONSTRUCTION OF UTILITIES IS LIMITED TO THREE PIPE LENGTHS OR THAT WHICH SHALL BE BACK-FILLED AND STABILIZED BY THE END OF EACH WORK DAY, WHICHEVER IS SHORTER.
10. ANY CHANGES OR REVISIONS TO THE SEQUENCE OF CONSTRUCTION MUST BE REVIEWED AND APPROVED BY THE PLAN APPROVAL AUTHORITY PRIOR TO PROCEEDING WITH CONSTRUCTION.
11. A PROJECT IS TO BE SEQUENCED SO THAT GRADING ACTIVITIES BEGIN ON ONE GRADING UNIT (MAXIMUM ACREAGE OF 20 AC. PER GRADING UNIT) AT A TIME. WORK MAY PROCEED TO A SUBSEQUENT GRADING UNIT WHEN AT LEAST 50 PERCENT OF THE DISTURBED AREA IN THE PRECEDING GRADING UNIT HAS TO BE STABILIZED AND APPROVED BY THE ENFORCEMENT AUTHORITY. UNLESS OTHERWISE SPECIFIED AND APPROVED BY THE APPROVAL AUTHORITY, NO MORE THAN 30 ACRES CUMULATIVELY MAY BE DISTURBED AT A GIVEN TIME.

**SEQUENCE OF CONSTRUCTION**

- 1. OBTAIN A GRADING PERMIT.
2. REQUEST FOR A PRE-CONSTRUCTION MEETING WITH THE APPROPRIATE ENFORCEMENT AUTHORITY.
3. CLEARING AND GRUBBING AS NECESSARY FOR THE INSTALLATION OF PERIMETER CONTROLS.
4. CONSTRUCTION AND STABILIZATION OF PERIMETER SEDIMENT CONTROLS.
5. SITE EXCAVATION AND GRADING, (3 DAYS), SITE STAGING AND STOCKPILE AREAS.
6. EXCAVATION FOR TANK. (2 DAYS)
7. INSTALL TANK ACCORDING TO PLAN AND DETAILS. (3 DAYS)
8. BACKFILL AROUND TANK. (1 DAY)
9. INSTALL CONCRETE SLAB ACCORDING TO PLAN AND DETAILS. (5 DAYS)
10. INSTALL ASPHALT PULLOFF ACCORDING TO PLAN AND DETAILS. (2 DAYS)
11. FINAL GRADING, LANDSCAPING, AND STABILIZATION.
12. APPROVAL OF THE APPROPRIATE ENFORCEMENT AUTHORITY PRIOR TO REMOVAL OF SEDIMENT CONTROLS.
13. REMOVAL OF CONTROLS AND STABILIZATION OF AREAS THAT ARE DISTURBED BY REMOVAL OF SEDIMENT CONTROLS.

**BEST MANAGEMENT PRACTICES FOR WORKING IN NONTIDAL WETLANDS, WETLAND BUFFERS, WATERWAYS, AND 100 YEAR FLOODPLAIN**

- 1. NO EXCESS FILL, CONSTRUCTION MATERIAL, OR DEBRIS SHALL BE STOCKPILED OR STORED IN NONTIDAL WETLANDS, NONTIDAL WETLAND BUFFERS, WATERWAYS, OR THE 100 YEAR FLOODPLAIN.
2. PLACE MATERIALS IN A LOCATION AND MANNER WHICH DOES NOT ADVERSELY IMPACT SURFACE OR SUBSURFACE WATER FLOW INTO OR OUT OF NONTIDAL WETLANDS, NONTIDAL WETLAND BUFFERS, WATERWAYS, OR THE 100 YEAR FLOODPLAIN.
3. DO NOT USE THE EXCAVATED MATERIAL AS BACKFILL IF IT CONTAINS WASTE METAL PRODUCTS, UNSIGHTLY DEBRIS, TOXIC MATERIAL, OR ANY OTHER DELETERIOUS SUBSTANCE. IF ADDITIONAL BACKFILL IS REQUIRED, USE CLEAN MATERIAL FREE OF ANY WASTE METAL PRODUCTS, UNSIGHTLY DEBRIS, TOXIC MATERIAL, OR ANY OTHER DELETERIOUS SUBSTANCE.
4. PLACE HEAVY EQUIPMENT ON MATS OR SUITABLY OPERATE THE EQUIPMENT TO PREVENT DAMAGE TO NONTIDAL WETLANDS, NONTIDAL WETLAND BUFFERS, OR WATERWAYS, OR PERMANENT MODIFICATION OF THE 100 YEAR FLOODPLAIN IN EXCESS OF THAT LOST UNDER THE ORIGINALLY AUTHORIZED STRUCTURE OR FILL.
5. REPAIR AND MAINTAIN ANY SERVICEABLE STRUCTURE OR FILL SO THERE IS NO PERMANENT LOSS OF NONTIDAL WETLANDS, NONTIDAL WETLAND BUFFERS, OR WATERWAYS, OR PERMANENT MODIFICATION OF THE 100 YEAR FLOODPLAIN IN EXCESS OF THAT LOST UNDER THE ORIGINALLY AUTHORIZED STRUCTURE OR FILL.
6. RECTIFY ANY NONTIDAL WETLANDS, WETLAND BUFFERS, WATERWAYS, OR 100 YEAR FLOODPLAIN TEMPORARILY IMPACTED BY ANY CONSTRUCTION.
7. ALL STABILIZATION IN THE NONTIDAL WETLAND AND NONTIDAL WETLAND BUFFER SHALL CONSIST OF THE FOLLOWING SPECIES: ANNUAL RYEGRASS (LOLIUM MULTIFLORUM), MILLET (SETARIA ITALICA), BARLEY (HORDEUM SP.), OATS (UNICA SP.), AND/OR RYE (SECALE CEREALE). THESE SPECIES WILL ALLOW FOR THE STABILIZATION OF THE SITE WHILE ALSO ALLOWING FOR THE VOLUNTARY REVEGETATION OF NATURAL WETLAND SPECIES. OTHER NON-PERSISTENT VEGETATION MAY BE ACCEPTABLE, BUT MUST BE APPROVED BY THE NONTIDAL WETLANDS AND WATERWAYS DIVISION. KENTUCKY 31 FESCUE SHALL NOT BE UTILIZED IN WETLAND OR BUFFER AREAS. THE AREA SHOULD BE SEEDING AND MULCHED TO REDUCE EROSION AFTER CONSTRUCTION ACTIVITIES HAVE BEEN COMPLETED.
8. AFTER INSTALLATION HAS BEEN COMPLETED, MAKE POST-CONSTRUCTION GRADES AND ELEVATIONS THE SAME AS THE ORIGINAL GRADES AND ELEVATIONS IN TEMPORARILY IMPACTED AREAS.
9. TO PROTECT AQUATIC SPECIES, IN-STREAM WORK IS PROHIBITED AS DETERMINED BY THE CLASSIFICATION OF THE STREAM: USE III WATERS: IN-STREAM WORK SHALL NOT BE CONDUCTED DURING THE PERIOD OCTOBER 1 THROUGH APRIL 30, INCLUSIVE, DURING ANY YEAR.
10. STORMWATER RUNOFF FROM IMPERVIOUS SURFACES SHALL BE CONTROLLED TO PREVENT THE WASHING OF DEBRIS INTO THE WATERWAY.
11. CULVERTS SHALL BE CONSTRUCTED AND ANY RIPRAP PLACED SO AS NOT TO OBSTRUCT THE MOVEMENT OF AQUATIC SPECIES, UNLESS THE PURPOSE OF THE ACTIVITY IS TO IMPOUND WATER.

**PERMANENT SEEDING NOTES**

APPLY TO GRADED OR CLEARED AREAS NOT SUBJECT TO IMMEDIATE FURTHER DISTURBANCE WHERE A PERMANENT LONG-LIVED VEGETATIVE COVER IS NEEDED.

SEEDBED PREPARATION: LOOSEN UPPER THREE INCHES OF SOIL BY RAKING, DISKING OR OTHER ACCEPTABLE MEANS BEFORE SEEDING, IF NOT PREVIOUSLY LOOSENED.

SOIL AMENDMENTS: IN LIEU OF SOIL TEST RECOMMENDATIONS, USE ONE OF THE FOLLOWING SCHEDULES:

- 1. PREFERRED -- APPLY 2 TONS/ACRE DOLOMITIC LIMESTONE (92 LBS/1000 SQ. FT.) AND 600 LBS/ACRE 10-10-10 FERTILIZER (14 LBS/1000 SQ. FT.) BEFORE SEEDING. HARROW OR DISK INTO UPPER THREE INCHES OF SOIL. AT TIME OF SEEDING, APPLY 400 LBS/ACRE 30-0-0 UREAFORM FERTILIZER (9 LBS/1000 SQ. FT.)
2. ACCEPTABLE -- APPLY 2 TONS/ACRE DOLOMITIC LIMESTONE (92 LBS/1000 SQ. FT.) AND 1000 LBS/ACRE 10-10-10 FERTILIZER (23 LBS/1000 SQ. FT.) BEFORE SEEDING. HARROW OR DISK INTO UPPER THREE INCHES OF SOIL.

SEEDING -- FOR THE PERIODS MARCH 1 - APRIL 30, AND AUGUST 1 - OCTOBER 15, SEED WITH 60 LBS/ACRE (1.4 LBS/1000 SQ. FT.) OF KENTUCKY 31 TALL FESCUE. FOR THE PERIOD MAY 1 - JULY 31, SEED WITH 60 LBS KENTUCKY 31 TALL FESCUE PER ACRE AND 2 LBS/ACRE (.05 LBS/1000 SQ. FT.) OF WEEPING LOVEGRASS. DURING THE PERIOD OF OCTOBER 16 - FEBRUARY 28, PROTECT SITE BY: OPTION 1 - TWO TONS PER ACRE OF WELL ANCHORED STRAW MULCH AND SEED AS SOON AS POSSIBLE IN THE SPRING. OPTION 2 - USE SOD. OPTION 3 - SEED WITH 60 LBS/ACRE KENTUCKY 30 TALL FESCUE AND MULCH WITH 2 TONS/ACRE WELL ANCHORED STRAW.

MULCHING -- APPLY 1-1/2 TO 2 TONS PER ACRE (70 TO 90 LBS/1000 SQ. FT.) OF UNROTTED SMALL GRAIN STRAW IMMEDIATELY AFTER SEEDING. ANCHOR MULCH IMMEDIATELY AFTER APPLICATION USING MULCH ANCHORING TOOL OR 218 GALLONS PER ACRE (5 GAL/1000 SQ. FT.) OF EMULSIFIED ASPHALT ON FLAT AREAS. ON SLOPE 8 FEET OR HIGHER, USE 348 GALLONS PER ACRE (8 GAL/1000 SQ. FT.) FOR ANCHORING.

MAINTENANCE -- INSPECT ALL SEEDING AREAS AND MAKE NEEDED REPAIRS, REPLACEMENTS AND RESEEDINGS.

**TEMPORARY SEEDING NOTES**

APPLY TO GRADED OR CLEARED AREAS LIKELY TO BE RE-DISTURBED WHERE A SHORT-TERM VEGETATIVE COVER IS NEEDED.

SEEDBED PREPARATION: -- LOOSEN UPPER THREE INCHES OF SOIL BY RAKING, DISKING OR OTHER ACCEPTABLE MEANS BEFORE SEEDING, IF NOT PREVIOUSLY LOOSENED.

SOIL AMENDMENTS: -- APPLY 600 LBS/ACRE 10-10-10 FERTILIZER (14 LBS/1000 SQ. FT.).

SEEDING: -- FOR PERIODS MARCH 1 - APRIL 30 AND FROM AUGUST 15 - OCTOBER 15, SEED WITH 2-1/2 BUSHEL PER ACRE OF ANNUAL RYE (3.2 LBS/1000 SQ. FT.). FOR THE PERIOD MAY 1 - AUGUST 14, SEED WITH 3 LBS/ACRE OF WEEPING LOVEGRASS (.07 LBS/1000 SQ. FT.). FOR THE PERIOD NOVEMBER 16 - FEBRUARY 28, PROTECT SITE BY APPLY 2 TONS/ACRE OF WELL ANCHORED STRAW MULCH AND SEED AS SOON AS POSSIBLE IN THE SPRING, OR USE SOD.


MULCHING: -- APPLY 1-1/2 TO 2 TONS/ACRE (70 TO 90 LBS/1000 SQ. FT.) OF UNROTTED WEED-FREE, SMALL GRAIN STRAW IMMEDIATELY AFTER SEEDING. ANCHOR MULCH IMMEDIATELY AFTER APPLICATION USING MULCH ANCHORING TOOL OR 218 GAL. PER ACRE (5 GAL/1000 SQ. FT.) OF EMULSIFIED ASPHALT ON FLAT AREAS. ON SLOPE 8 FT. OR HIGHER, USE 348 GAL. PER ACRE (8 GAL/1000 SQ. FT.) FOR ANCHORING.

REFER TO THE 2011 MARYLAND STANDARDS AND SPECIFICATIONS FOR SOIL EROSION AND SEDIMENT CONTROL FOR ADDITIONAL RATES AND METHODS NOT COVERED.

Table B.1: Temporary Seeding for Site Stabilization







Table with 4 columns: Plant Species, Seeding Rate (lb/acre, lb/1000 ft²), Seeding Depth (inches), and Recommended Seeding Dates by Plant Hardiness Zone (5b and 6a, 6b, 7a and 7b). Rows include Annual Ryegrass, Barley, Oats, Wheat, Cereal Rye, Foxtail Millet, and Pearl Millet.

NOTES: 1/ Seeding rates for the warm-season grasses are in pounds of Pure Live Seed (PLS). Actual planting rates shall be adjusted to reflect percent seed germination and purity, as tested. Adjustments are usually not needed for the cool-season grasses.
2/ For sandy soils, plant seeds at twice the depth listed above.
3/ The planting dates listed are averages for each zone and may require adjustment to reflect local conditions, especially near the boundaries of the zone.

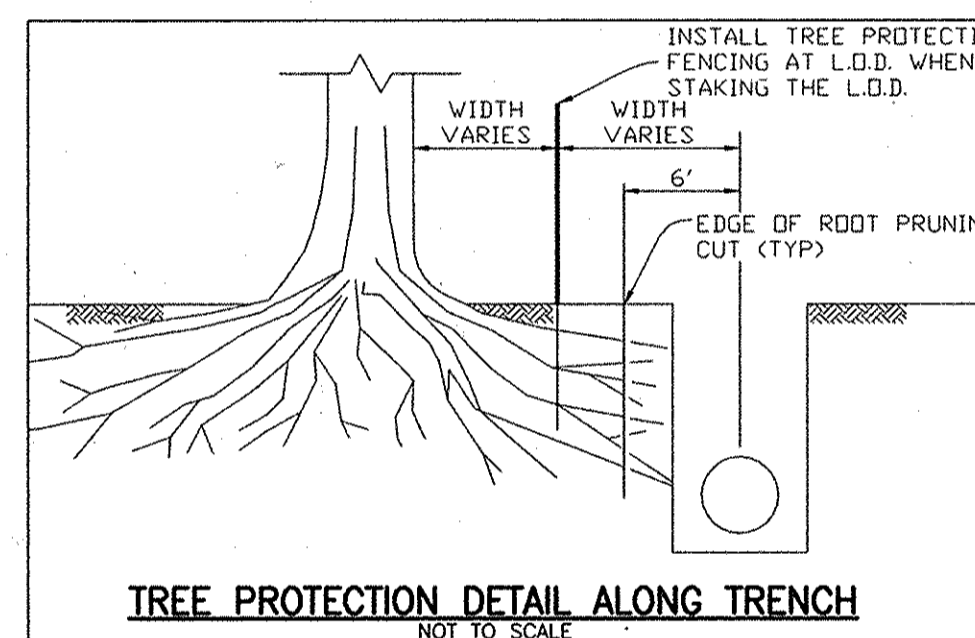

This plan is approved for soil erosion and sediment control by the Howard Soil Conservation District.

Handwritten signature and date: J. L. Blanton, 7/22/14, HOWARD SOIL CONSERVATION DISTRICT.

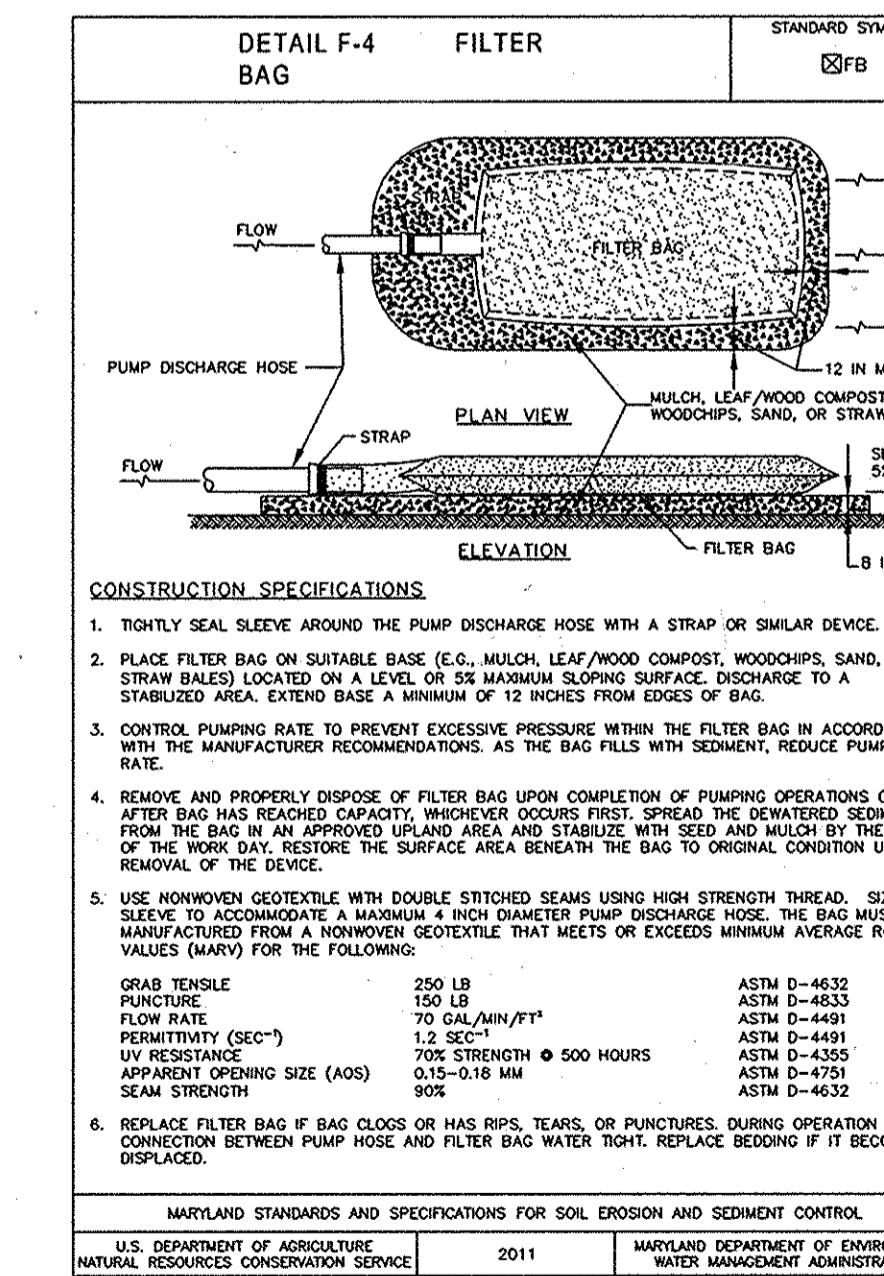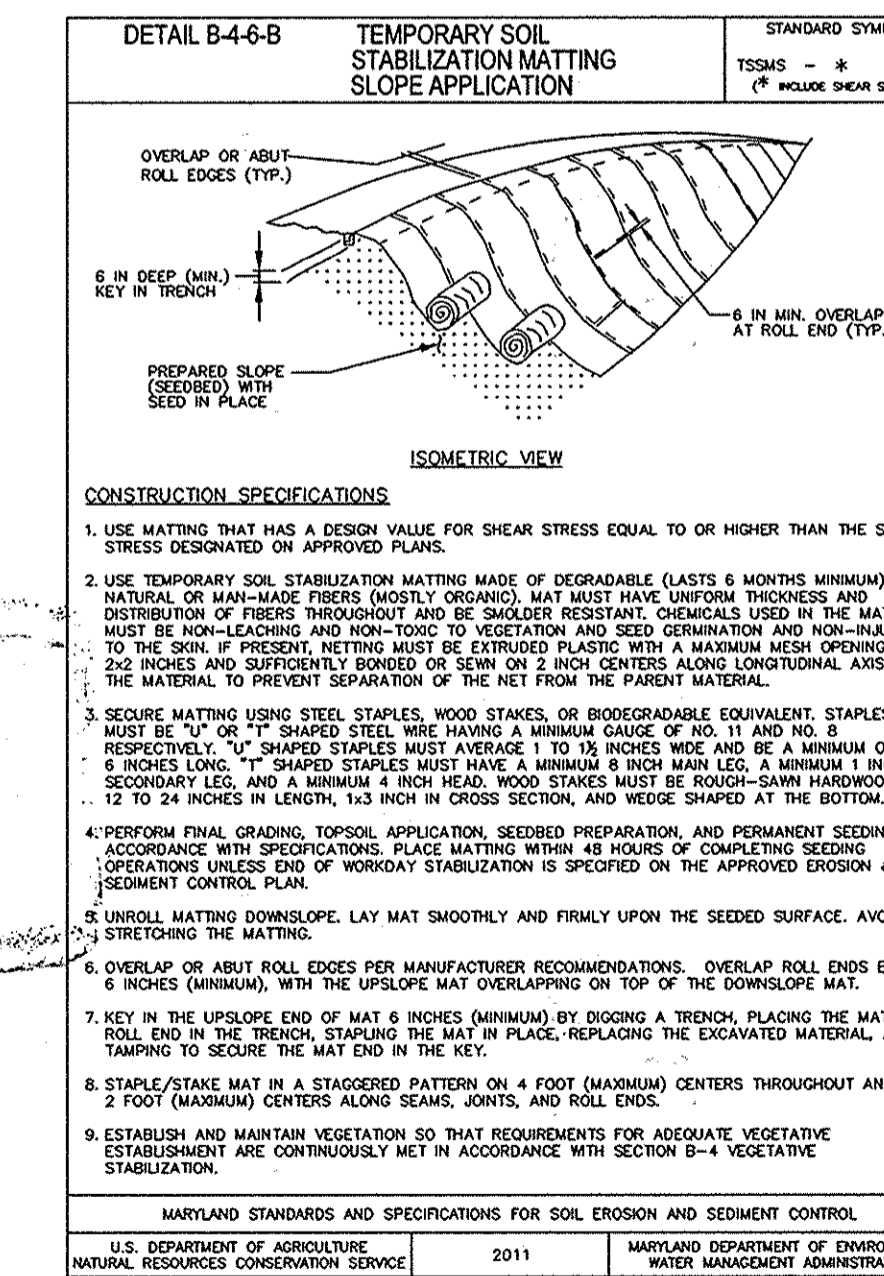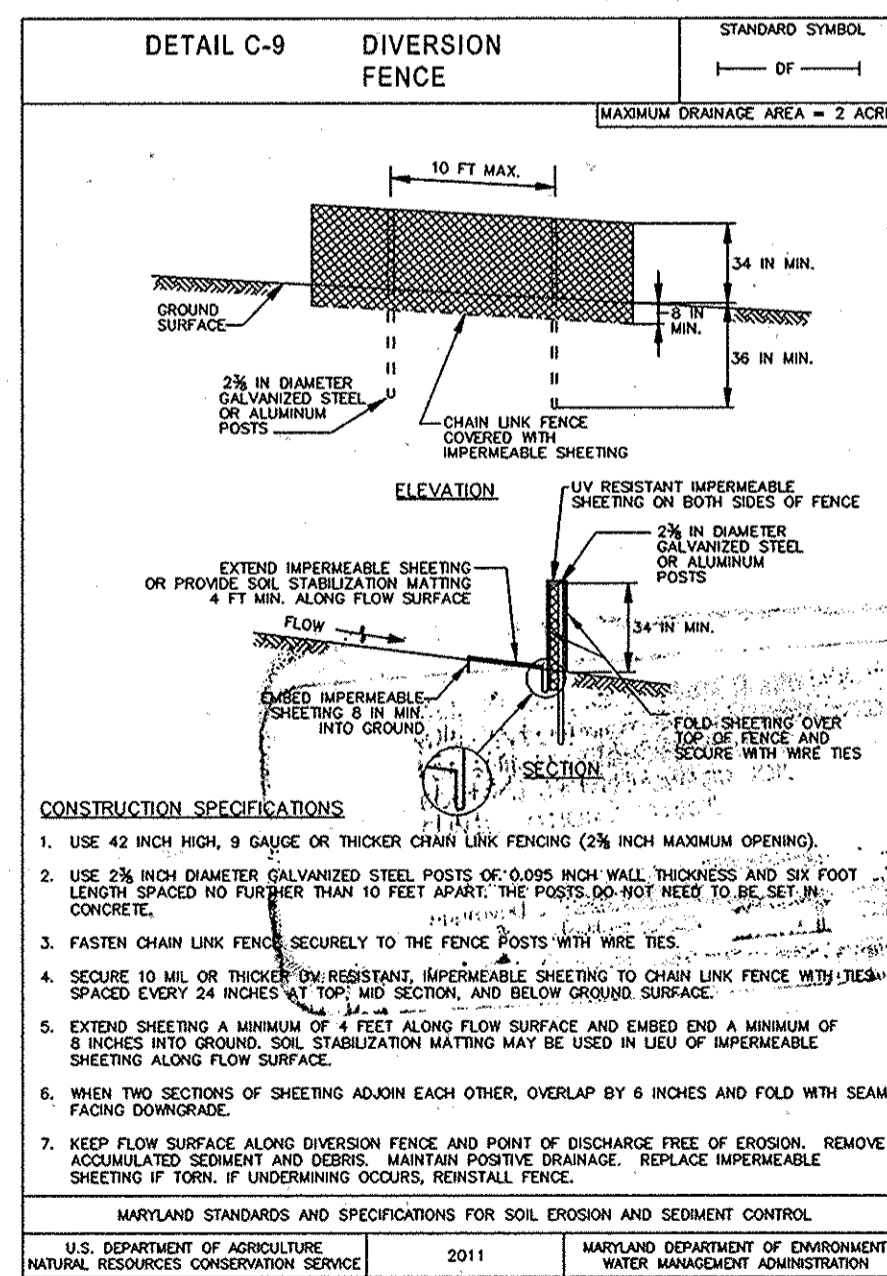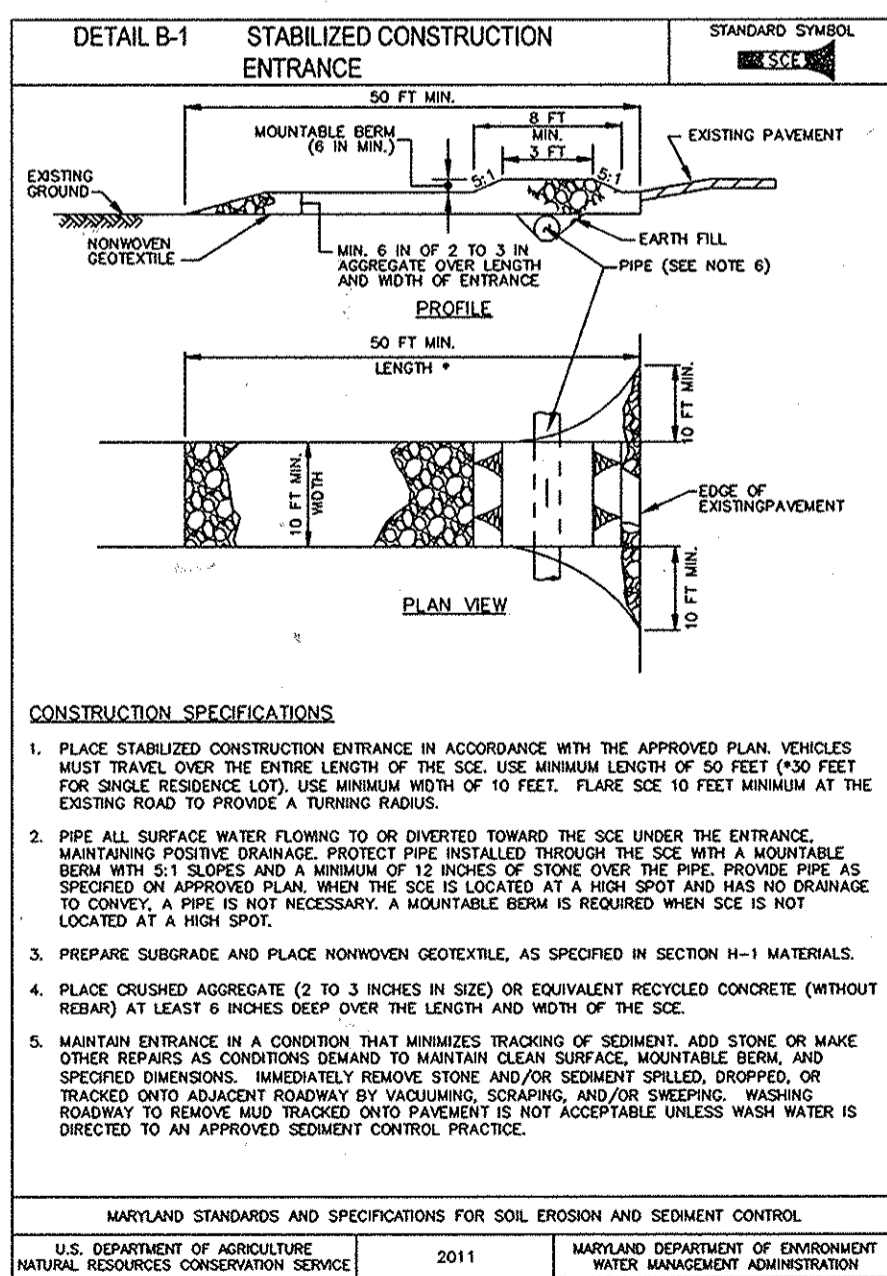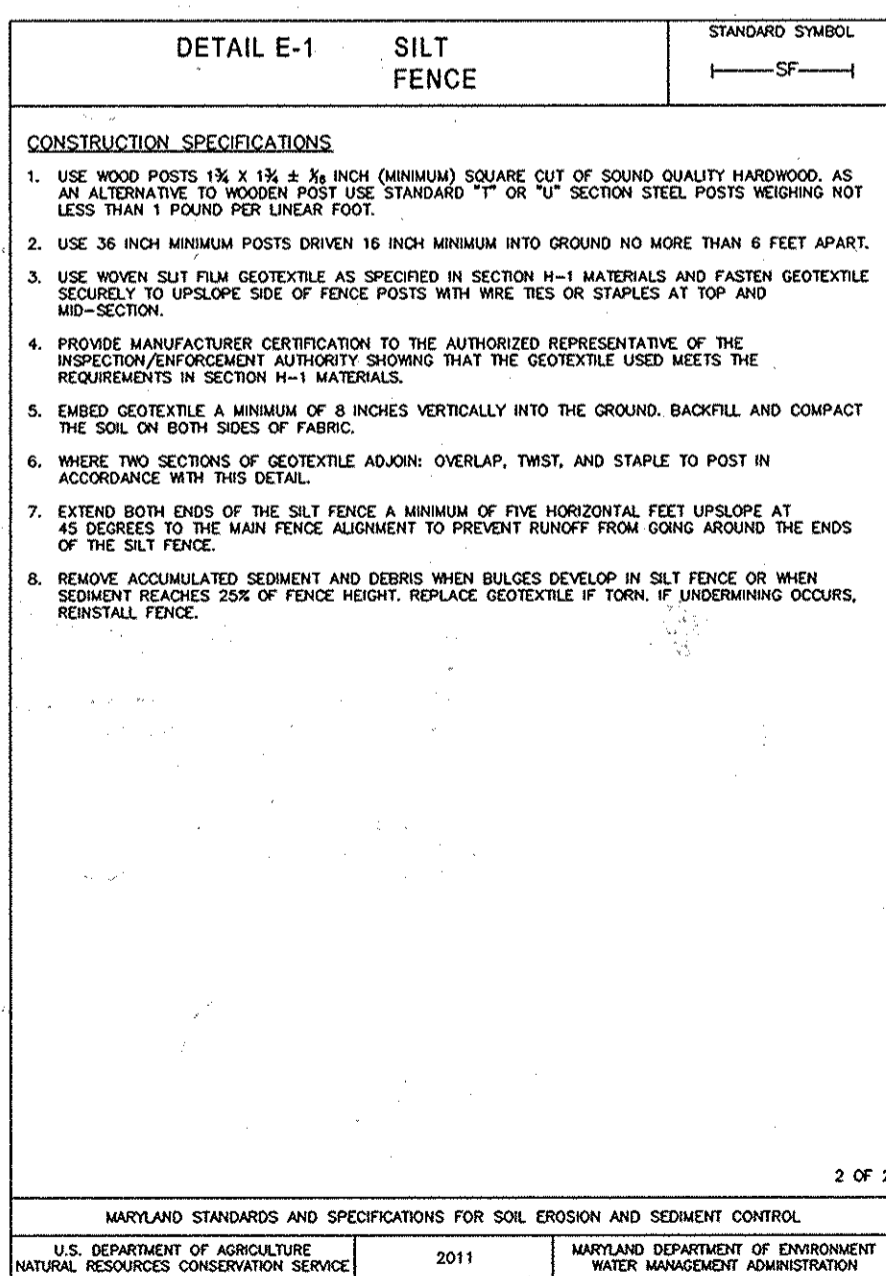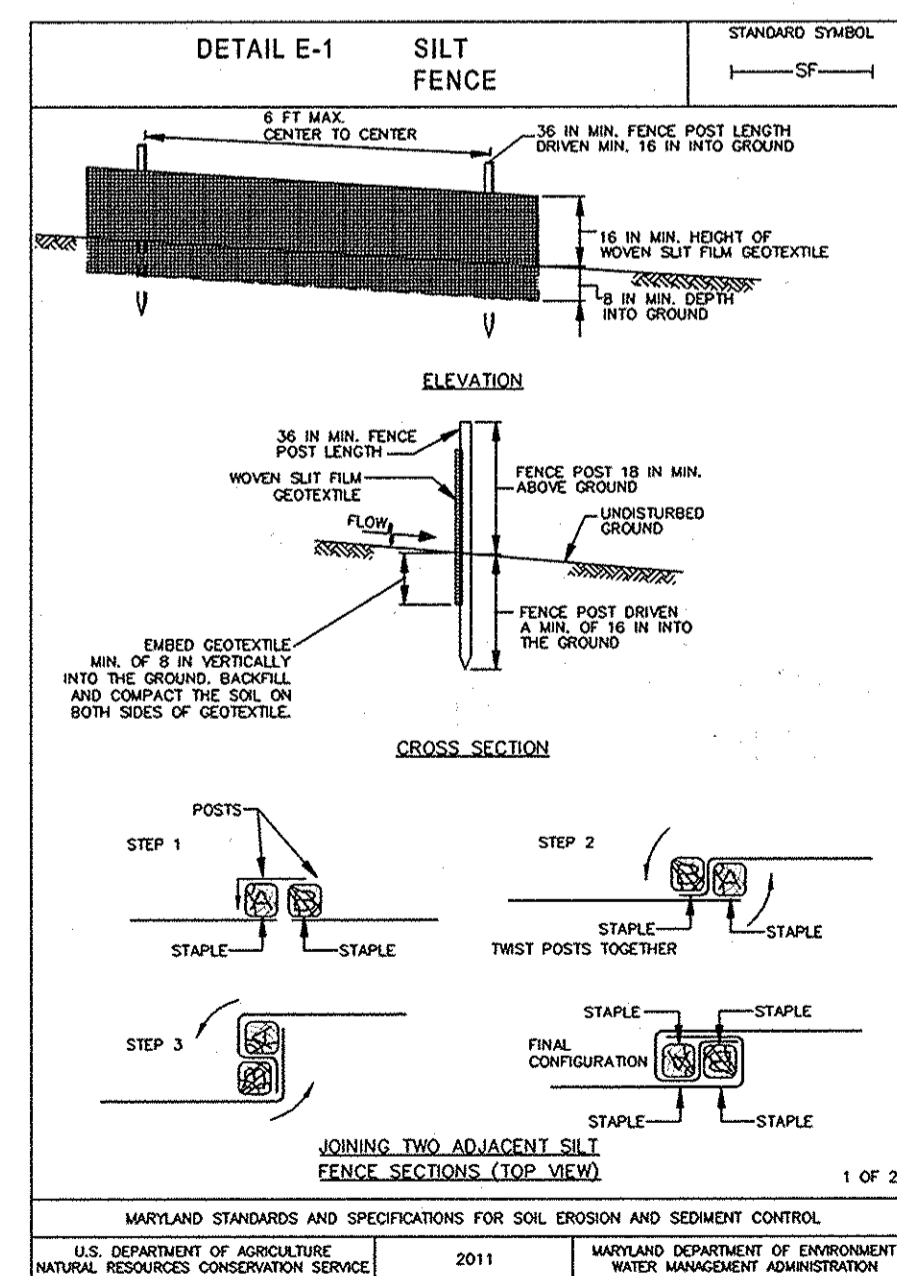


**DEPARTMENT OF PUBLIC WORKS HOWARD COUNTY, MARYLAND**

Director of Public Works: [Signature] DATE: 7/22/14
Chief, Bureau of Engineering: [Signature] DATE: 7/17/14
Chief, Utility Design Division: [Signature] DATE: 7/17/14

**Dewberry Dewberry Consultants, LLC**

3108 LORD BALTIMORE DRIVE SUITE 110 BALTIMORE, MD 21244-2662 410.285.9500 FAX: 410.285.8875

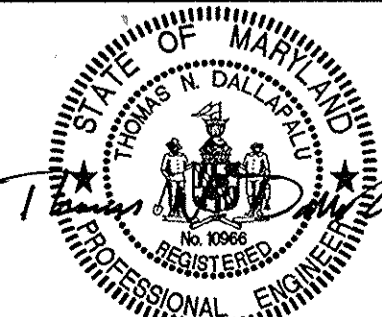

DES: LAL
DRN: RLJ
CHK: TND
DATE: 07/2014

**SEDIMENT & EROSION CONTROL NOTES**

600' SCALE MAP NO. 15 BLOCK NO. 10

**UNDERGROUND WATER STORAGE TANK FOR FIRE SUPPRESSION**

F.5972 C5-4908

ELECTION DISTRICT NO. 4 HOWARD COUNTY, MARYLAND

SCALE: SHOWN SHEET 8 OF 8