

**SHEET INDEX**

NO.	DESCRIPTION
1	TITLE SHEET
2	EXISTING CONDITIONS PLAN AND PROFILE
3	PROPOSED IMPROVEMENTS PLAN AND PROFILE
4	EROSION AND SEDIMENT CONTROL PLAN
5	STREAM SLOPE STABILIZATION PLAN
6	STREAM SLOPE STABILIZATION EROSION & SEDIMENT CONTROL PLAN
7	EROSION AND SEDIMENT CONTROL DETAILS
8	EROSION AND SEDIMENT CONTROL DETAILS
9	EROSION AND SEDIMENT CONTROL NOTES
10	NOTES AND LEGEND
11	CONSTRUCTION DETAILS
12	ELECTRICAL DETAILS

**STRUCTURE SCHEDULE**

STRUCTURE	TYPE	LOCATION ①	INV. IN	INV. OUT	RIM ELEV.	REMARKS
MH-P70A	4" PRECAST MANHOLE	REPLACE EXISTING EXISTING	150.98 (16")	150.73 (15")	166.62	HO. CO. STD. DETAIL G-5.12
MH-70A	4" PRECAST MANHOLE	REPLACE EXISTING	152.48 (16")	152.38 (16")	161.39	HO. CO. STD. DETAIL G-5.12
MH-71A	5" PRECAST MANHOLE w/ NEW FLOW METER	N 585370.16 E 1370711.74	155.04 (16")	154.26 (16")	165.28	SEE DETAIL SHEETS 12 & 13

- NOTES:
- LOCATION OF MANHOLES IS GIVEN AT CENTER OF STRUCTURE.
  - RIM ELEVATION IS SET 1'-6" ABOVE EXISTING GROUND PER STD. DETAIL G-5.41.
  - MANHOLE NUMBERS P69, 69, 68A AND 68 ARE TO BE LINED IN ACCORDANCE WITH THE SPECIFICATIONS.

**TRAVERSE TABLE**

NO.	LOCATION
TP-110	N 585489.68 E 1370617.66
TP-111	N 585338.20 E 1370752.83
TP-112	N 585230.10 E 1370998.58
TP-113	N 585139.60 E 1371170.39
TP-114	N 585018.64 E 1371275.78
TP-115	N 584959.92 E 1371413.45

**BILL OF MATERIALS**

ITEMS	QUANTITIES ESTIMATED	AS-BUILT		MANUFACTURER / SUPPLIER
		QUANTITIES	TYPE	
16" PVC SEWER	247 LF	247 LF	C-300 PIPE	NATIONAL PIPE
4" DIA. PRECAST MANHOLES	2 EA.	1 EA.		CONTR.'S PRECAST CORP.
5" DIA PRECAST MANHOLES	1 EA.	1 EA.		CONTR.'S PRECAST CORP.
4" DIA. MH ADDITIONAL DEPTH	13 V.F.	3 V.F.		CONTR.'S PRECAST CORP.
5" DIA. MH ADDITIONAL DEPTH	5 V.F.			CONTR.'S PRECAST CORP.
LINING OF 15" SEWER	656 LF	656 LF		LAYNE
6" SHC	15 LF	8 LF	EDR-35 PIPE	NATIONAL PIPE

NAME OF UTILITY CONTRACTOR : W. F. WILSON

Sediment control measures for this contract will be implemented in accordance with Section 308 of the Specifications and as shown on these plans.

CHECKBOX  
AS-BUILT DATE \_\_\_\_\_  
SURVEY AND DRAFTING DIVISION \_\_\_\_\_

**EP-16-010**  
This plan is approved for soil erosion and sediment control by the Howard Soil Conservation District.  
*[Signature]*  
HOWARD SOIL CONSERVATION DISTRICT  
DATE: 6/17/17


BY THE DEVELOPER :  
I/WE CERTIFY THAT ALL DEVELOPMENT AND CONSTRUCTION WILL BE DONE ACCORDING TO THIS PLAN, AND THAT ANY RESPONSIBLE PERSONNEL INVOLVED IN THE CONSTRUCTION PROJECT WILL HAVE A CERTIFICATE OF ATTENDANCE AT A DEPARTMENT OF THE ENVIRONMENT APPROVED TRAINING PROGRAM FOR THE CONTROL OF SEDIMENT AND EROSION BEFORE BEGINNING THE PROJECT. I ALSO AUTHORIZE PERIODIC ON-SITE INSPECTIONS BY THE HOWARD SOIL CONSERVATION DISTRICT.  
*[Signature]*  
DEVELOPER  
DATE: 6-5-2017

BY THE ENGINEER :  
I CERTIFY THAT THIS PLAN FOR EROSION AND SEDIMENT CONTROL REPRESENTS A PRACTICAL AND WORKABLE PLAN BASED ON MY PERSONAL KNOWLEDGE OF THE SITE CONDITIONS AND THAT IT WAS PREPARED IN ACCORDANCE WITH THE REQUIREMENTS OF THE HOWARD SOIL CONSERVATION DISTRICT.  
*[Signature]*  
ENGINEER  
DATE: 6-31-17

PROFESSIONAL CERTIFICATION :  
I HEREBY CERTIFY THAT THESE DOCUMENTS WERE PREPARED OR APPROVED BY ME, AND THAT I AM A DULY LICENSED PROFESSIONAL ENGINEER UNDER THE LAWS OF THE STATE OF MARYLAND, LICENSE NO. 27909, EXPIRATION DATE AUGUST 23, 2018.  
*[Signature]*  
DAVID A. VANDERBEEK, P.E.

DEPARTMENT OF PUBLIC WORKS  
HOWARD COUNTY, MARYLAND  
Director of Public Works: *[Signature]* DATE: 6/6/17  
Chief, Bureau of Engineering: *[Signature]* DATE: 6/5/17  
Chief, Bureau of Utilities: *[Signature]* DATE: 6/5/17  
Chief, Utility Design Division: *[Signature]* DATE: 6/2/17


**GMB**  
GEORGE, MILES & BUHR, LLC  
ARCHITECTS & ENGINEERS  
SALISBURY - BALTIMORE - SEAFORD  
www.gmbnet.com

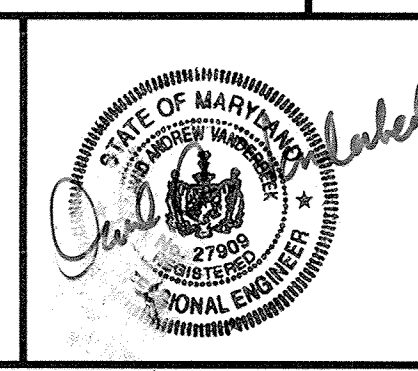

DES: D.A.V.	
DRN: M.A.D.	
CHK: W.B.F.	
DATE: 05/17	
BY: NO.	REVISION
DATE	600 SCALE MAP NO. 25
	BLOCK NO. 8

**TITLE SHEET**

**SYLVAN LANE  
INTERCEPTOR SEWER IMPROVEMENTS**  
CONTRACT NO. 10-4915  
2ND ELECTION DISTRICT  
HOWARD COUNTY, MARYLAND  
SCALE AS SHOWN  
SHEET 1 OF 12

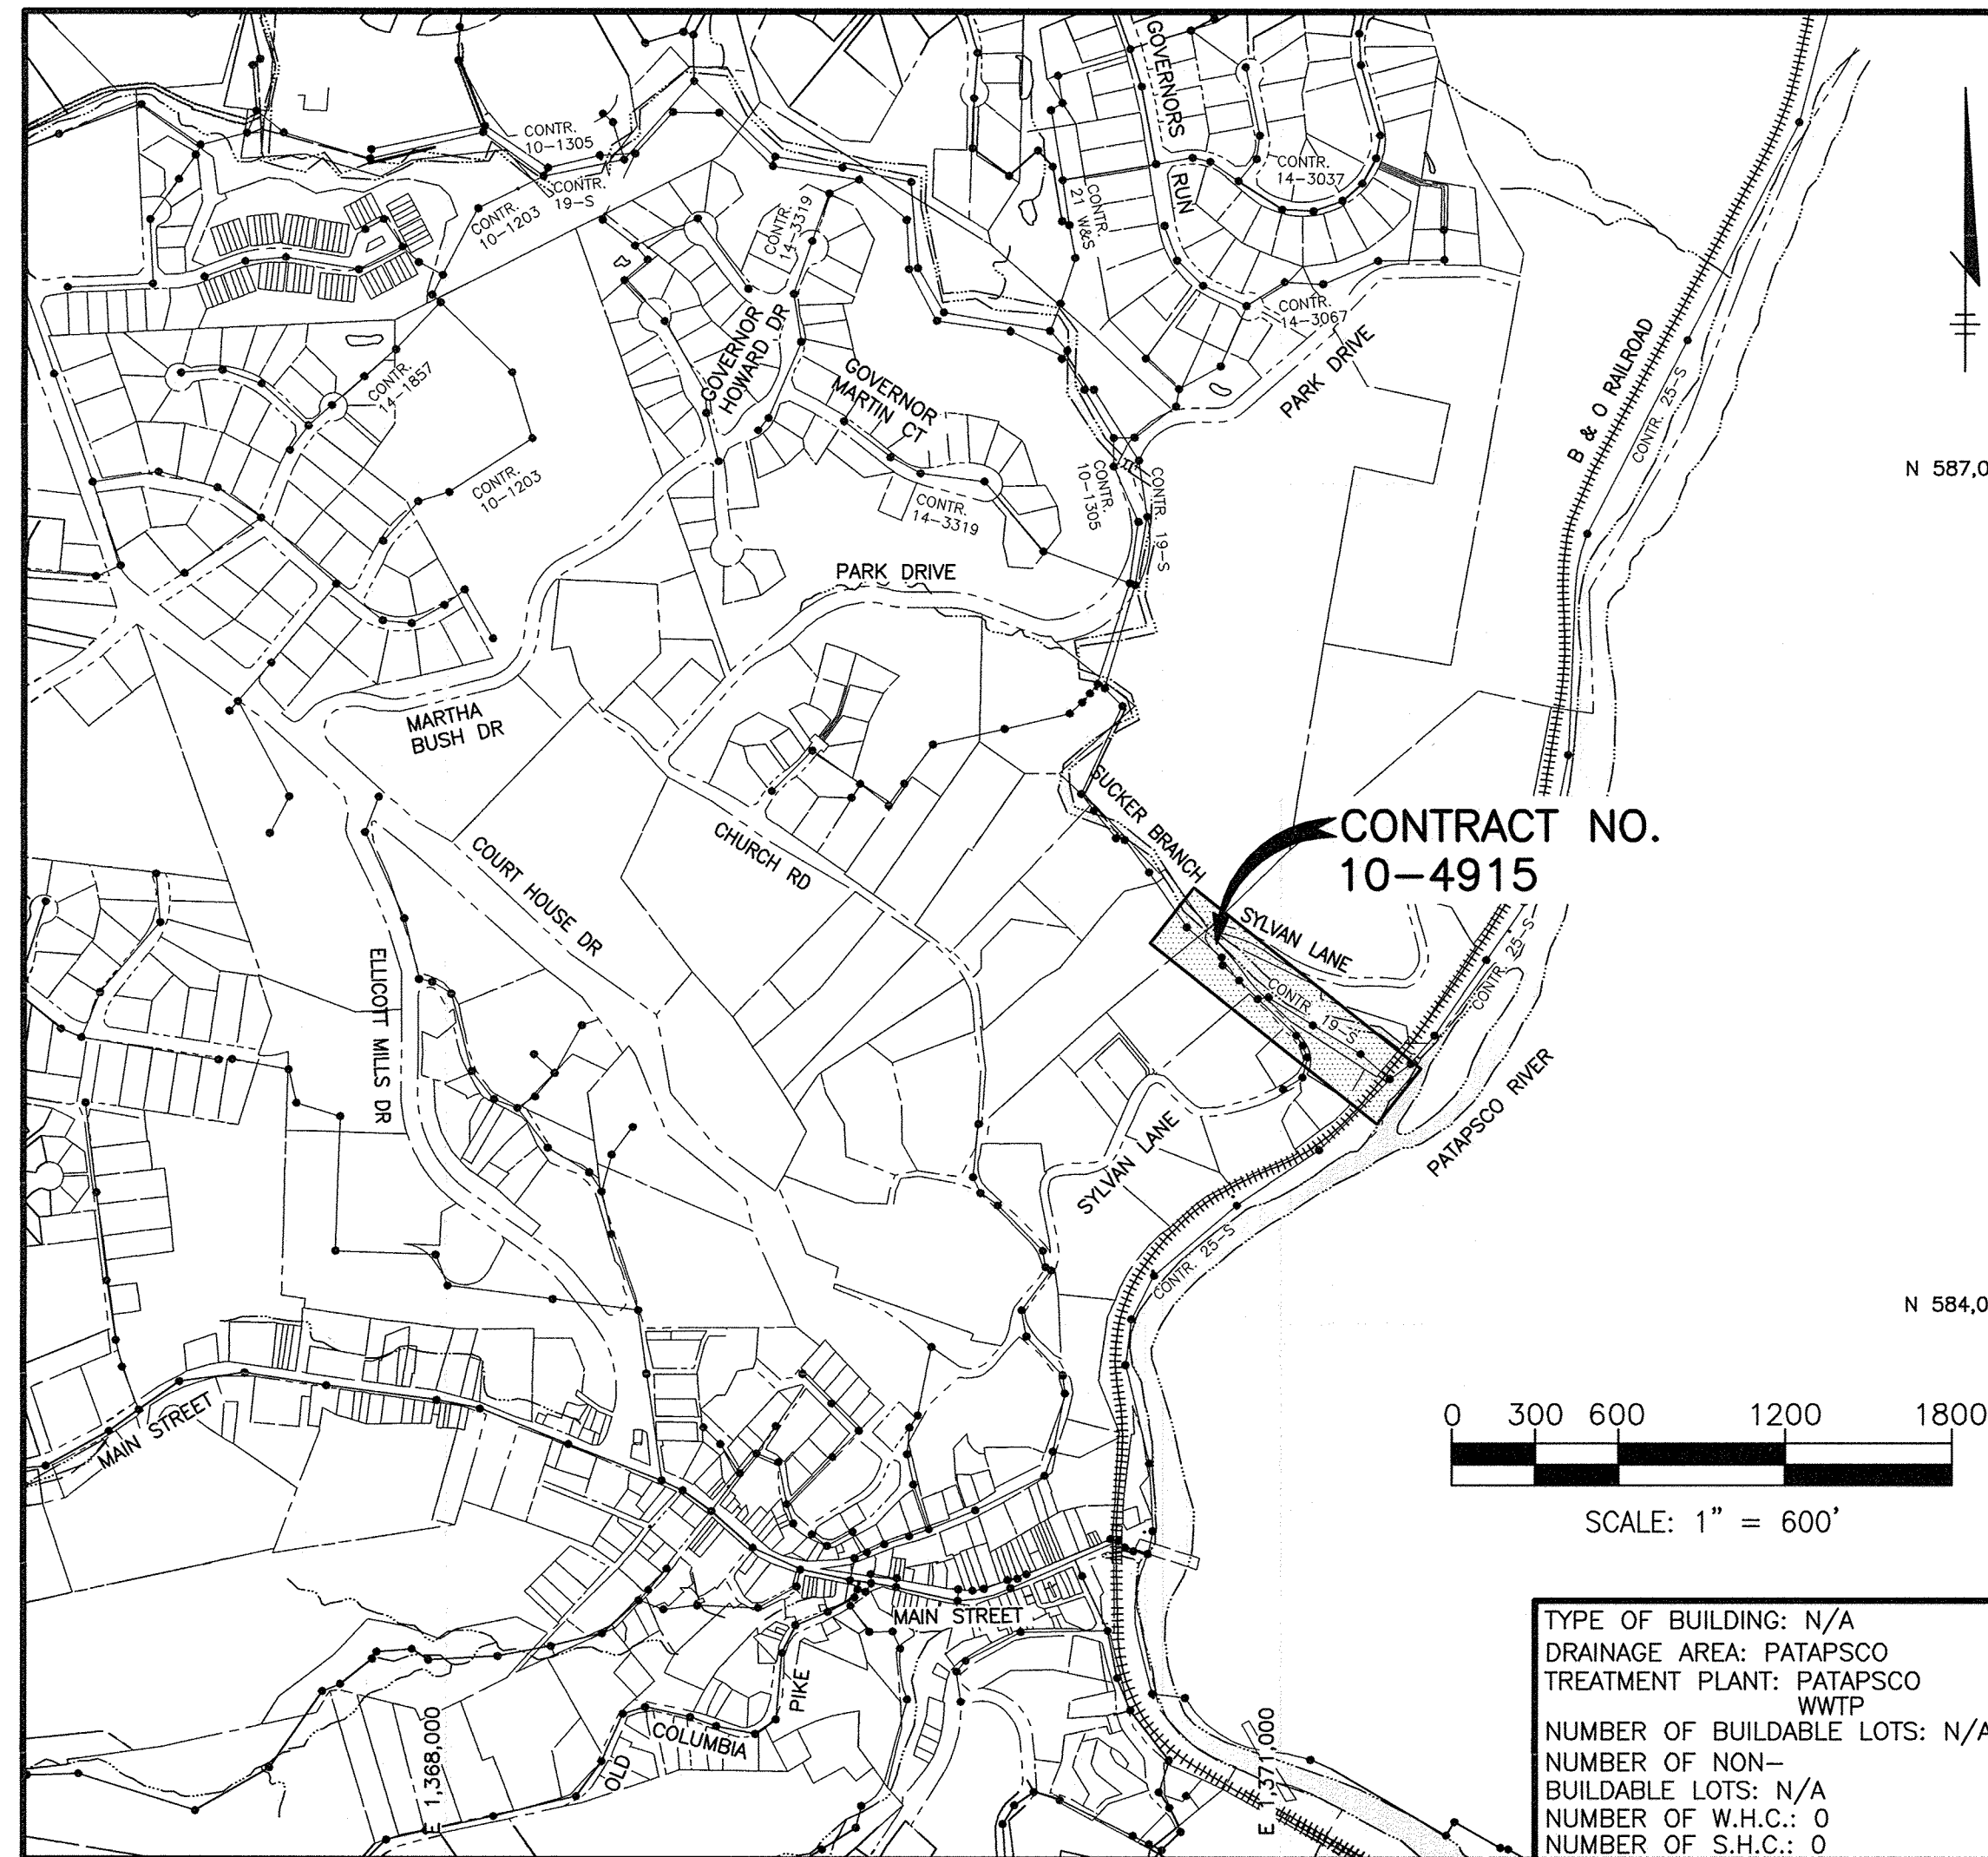

**VICINITY MAP**

# SYLVAN LANE INTERCEPTOR SEWER IMPROVEMENTS CONTRACT NO. 10-4915 HOWARD COUNTY, MARYLAND

**GENERAL NOTES**


- Approximate locations of existing mains are shown. The contractor shall take all necessary precautions to protect existing mains and services and maintain uninterrupted service. Any damage incurred shall be repaired immediately to the satisfaction of the Engineer at the Contractor's expense.
- Topographic field surveys were performed during May and June, 2014, by Navarro & Wright Consulting Engineers, Inc.
- Horizontal and Vertical Survey Controls:  
The coordinates shown on the drawings are based on Maryland State Reference System NAD '83/'91 as projected by Howard County Geodetic Control Station Nos. 24C2 and 24FA. All vertical controls are based on NAVD '88. Vertical Controls on the drawings are based on Howard County Geodetic Control Station No. 24C2.  
24C2 - N 588648.340, E 1366038.209, Elev. 354.022  
24FA - N 583751.408, E 1366091.890, Elev. 262.818
- All pipe elevations shown are invert elevations unless otherwise noted on the plans.
- Clear all utilities by a minimum of 12 inches. Clear all poles by 5'-0" minimum or tunnel as required unless otherwise noted. The owner has contacted the utility companies and has made arrangements for bracing of poles as shown on the drawings. In the event the contractor's work requires the bracing of additional poles, any cost incurred by the owner for the bracing of additional poles or damages shall be deducted from monies owed the contractor. The contractor shall coordinate with the utility companies to schedule the bracing of the poles.
- For details not shown on the drawings, and for materials and construction methods, use Howard County Design Manual, Volume IV, Standard Specifications and Details for Construction (Latest Edition). The contractor shall have a copy of Volume IV on the job.
- Where test pits have been made on existing utilities, they are noted by the symbol  $\square$  at the locations of the test pits. A note or notes containing the results of the test pit or pits is included on the drawings. Existing utilities in the vicinity of the proposed work for which test pits have not been dug shall be located by the contractor two weeks in advance of construction operations at his own expense.
- The contractor shall notify the following utility companies or agencies at least five working days before starting work shown on these plans:  
AT&T 1-800-252-1133  
BGE (Construction Services) 410-850-4620  
BGE (Emergency) 410-685-1400  
Bureau of Utilities 410-313-4900  
Colonial Pipeline Co. 410-795-1390  
Miss Utility 1-800-257-7777  
State Highway Administration 410-531-5533  
Verizon 1-800-743-0033 / 410-224-9210  
CSX 904-279-3843  
CSX Flagging Coordinator 904-279-3805
- The contractor shall install tree protection fence along the limit of disturbance (LOD) for the entire project. In areas where Super Silt Fence (SSF) is required along the LOD, tree protection fence is not also required to be furnished and installed. Trees within the temporary construction strips and temporary construction easements shall not be removed or damaged by the contractor. Shrubs within the temporary construction strips and temporary construction easements shall be protected from damage to the maximum extent possible.
- The contractor shall remove trees, stumps and roots along the line of excavation. Payment for such removal shall be included in the Lump Sum prices bid for Tree Removal and Clearing and Grubbing.
- The contractor shall notify the Bureau of Highways, Howard County, at 410-313-7450 at least five working days before open cutting or boring/jacking of any County road for laying water/sewer mains or house connections. The approval of these drawings will constitute compliance with DPW requirements per Section 18.114(a) of the Howard County Code.
- Spoil from trenching operations is to be placed on the uphill side of the trench.
- The contractor shall be responsible for acquiring any additional staging and/or stockpile areas that the contractor deems necessary.
- The contractor shall be responsible for repairing and replacing any existing fences, signs, concrete curb, driveways, paving, curb and gutter pan, walkways, etc., damaged or removed during construction. All disturbed areas shall be returned to their original or better condition.
- This project is exempt from Forest Conservation requirements under section 16.1202.b.1.x of the Howard County Forest Conservation Code.
- MDE Authorization No.: 201560104/15-NI-3019.
- CSXT Agreement No.: BO L48696
- Contractor shall provide adequate notification to CSX prior to beginning any work within the rail corridor. The Contractor shall be responsible for all coordination and costs associated with working within the CSX rail corridor including, but not limited to, providing CSX flagmen and/or CSX inspectors, safety training and any additional insurance requirements. All work within the rail corridor shall meet CSXT Specifications.
- The site is not located within a Tier II watershed.
- The site is located within an impaired waterway with respect to total suspended solids, sulfates and chlorides.

**SEWER NOTES**


- Sewer mains for stream crossings shall be CL 54 DIP with lining. All other sewer mains shall be AWWA C-905/DR-25 PVC unless otherwise noted.
- All manholes shall be 4'-0" or 5'-0" inside diameter as noted in the Structure Schedule.
- Manholes designated W.T. in profile shall have watertight frames and covers. Where watertight manhole frames and covers are used, set top of manhole with embedded frame 1'-6" above finished grade unless otherwise noted on the drawings.
- The existing sewer shall remain in service at all times and be protected during construction.

AS-BUILT: 9/15/2019




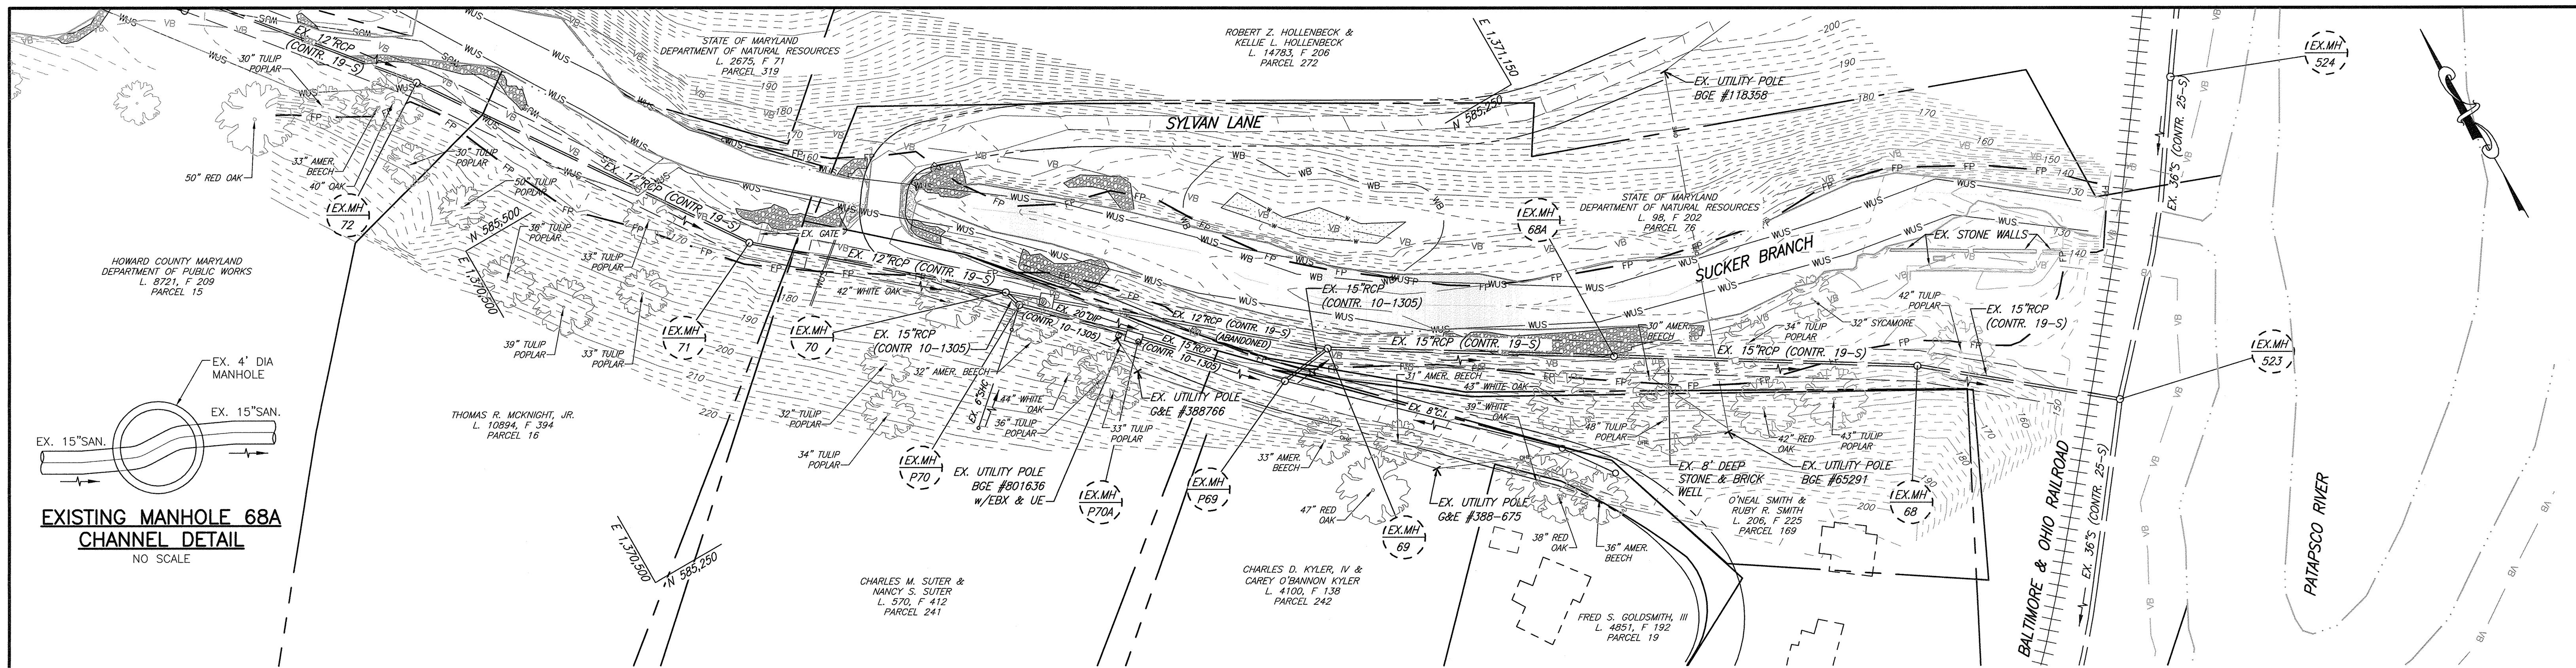

PLAN  
SCALE: 1"=50'

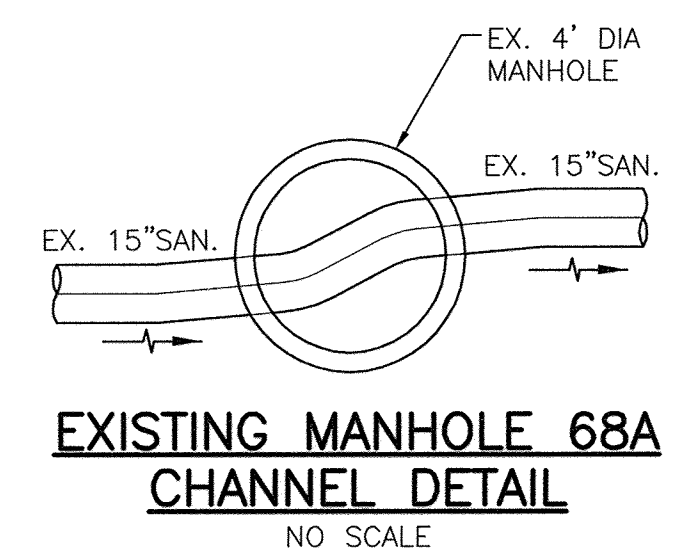


EXISTING MANHOLE 68A  
CHANNEL DETAIL  
NO SCALE

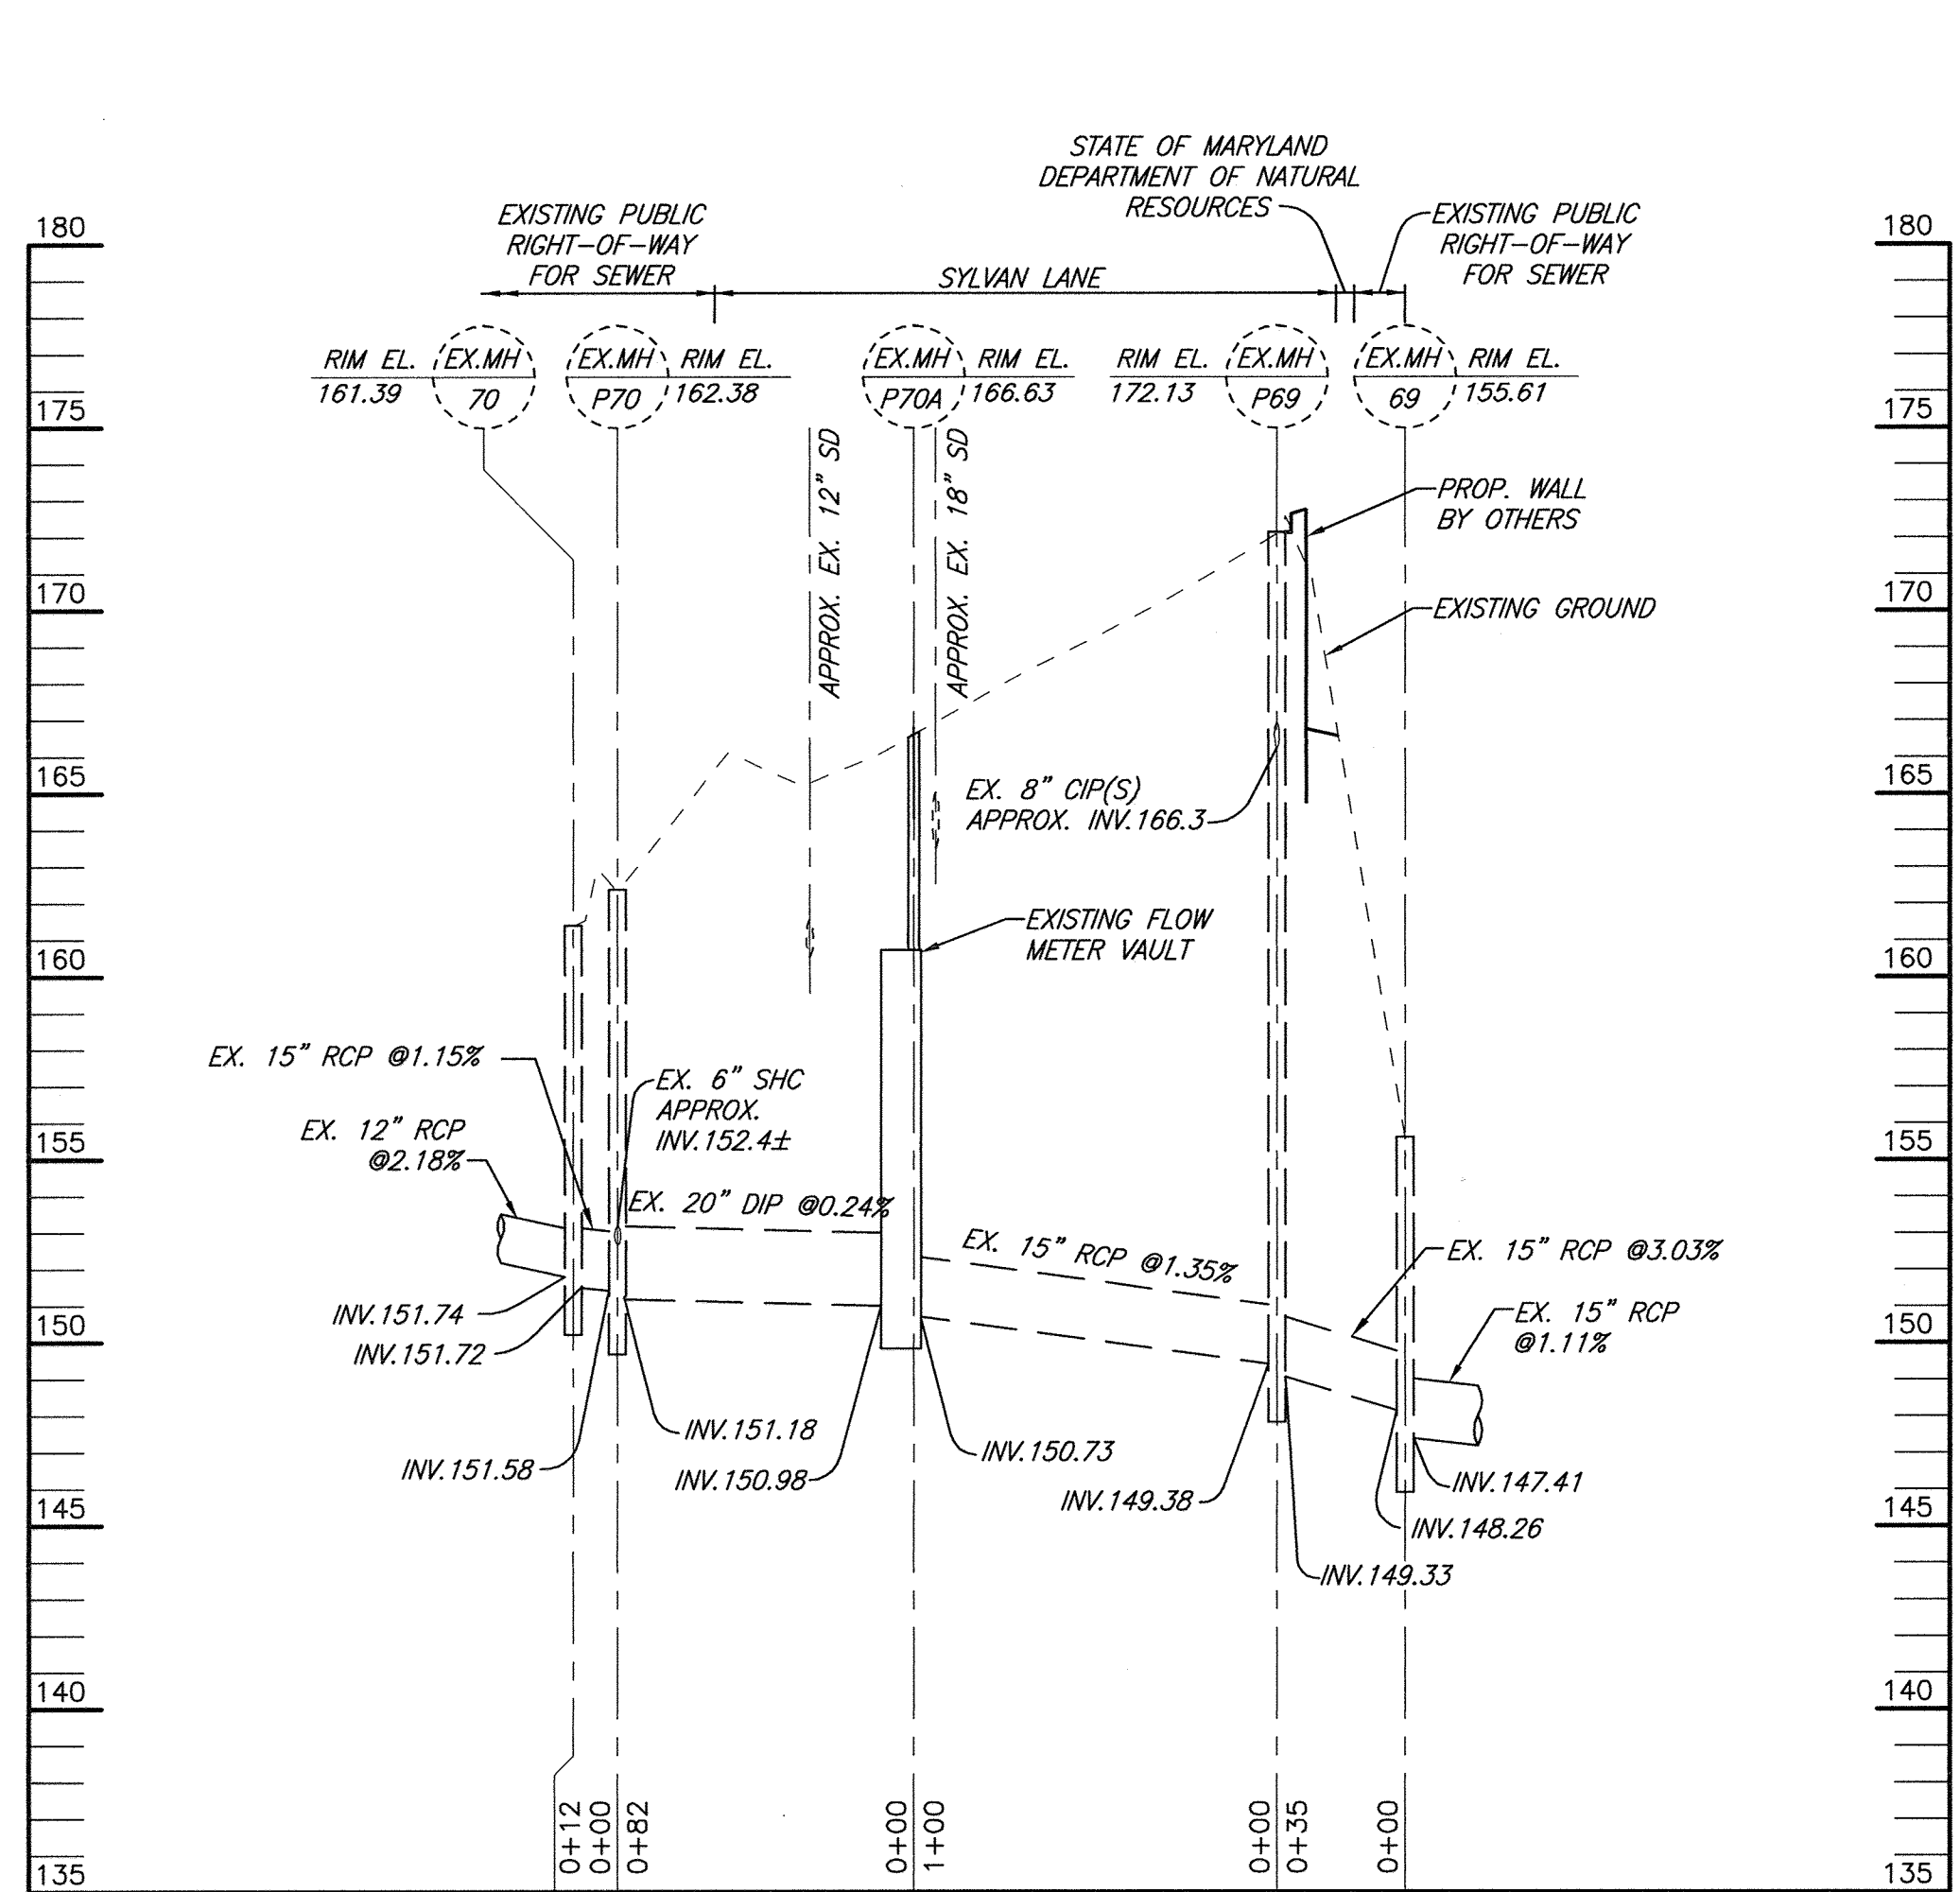

SEWER PROFILE (CONTRACT 10-1305)


SCALE: HOR.: 1"=50'  
VERT.: 1"=5'

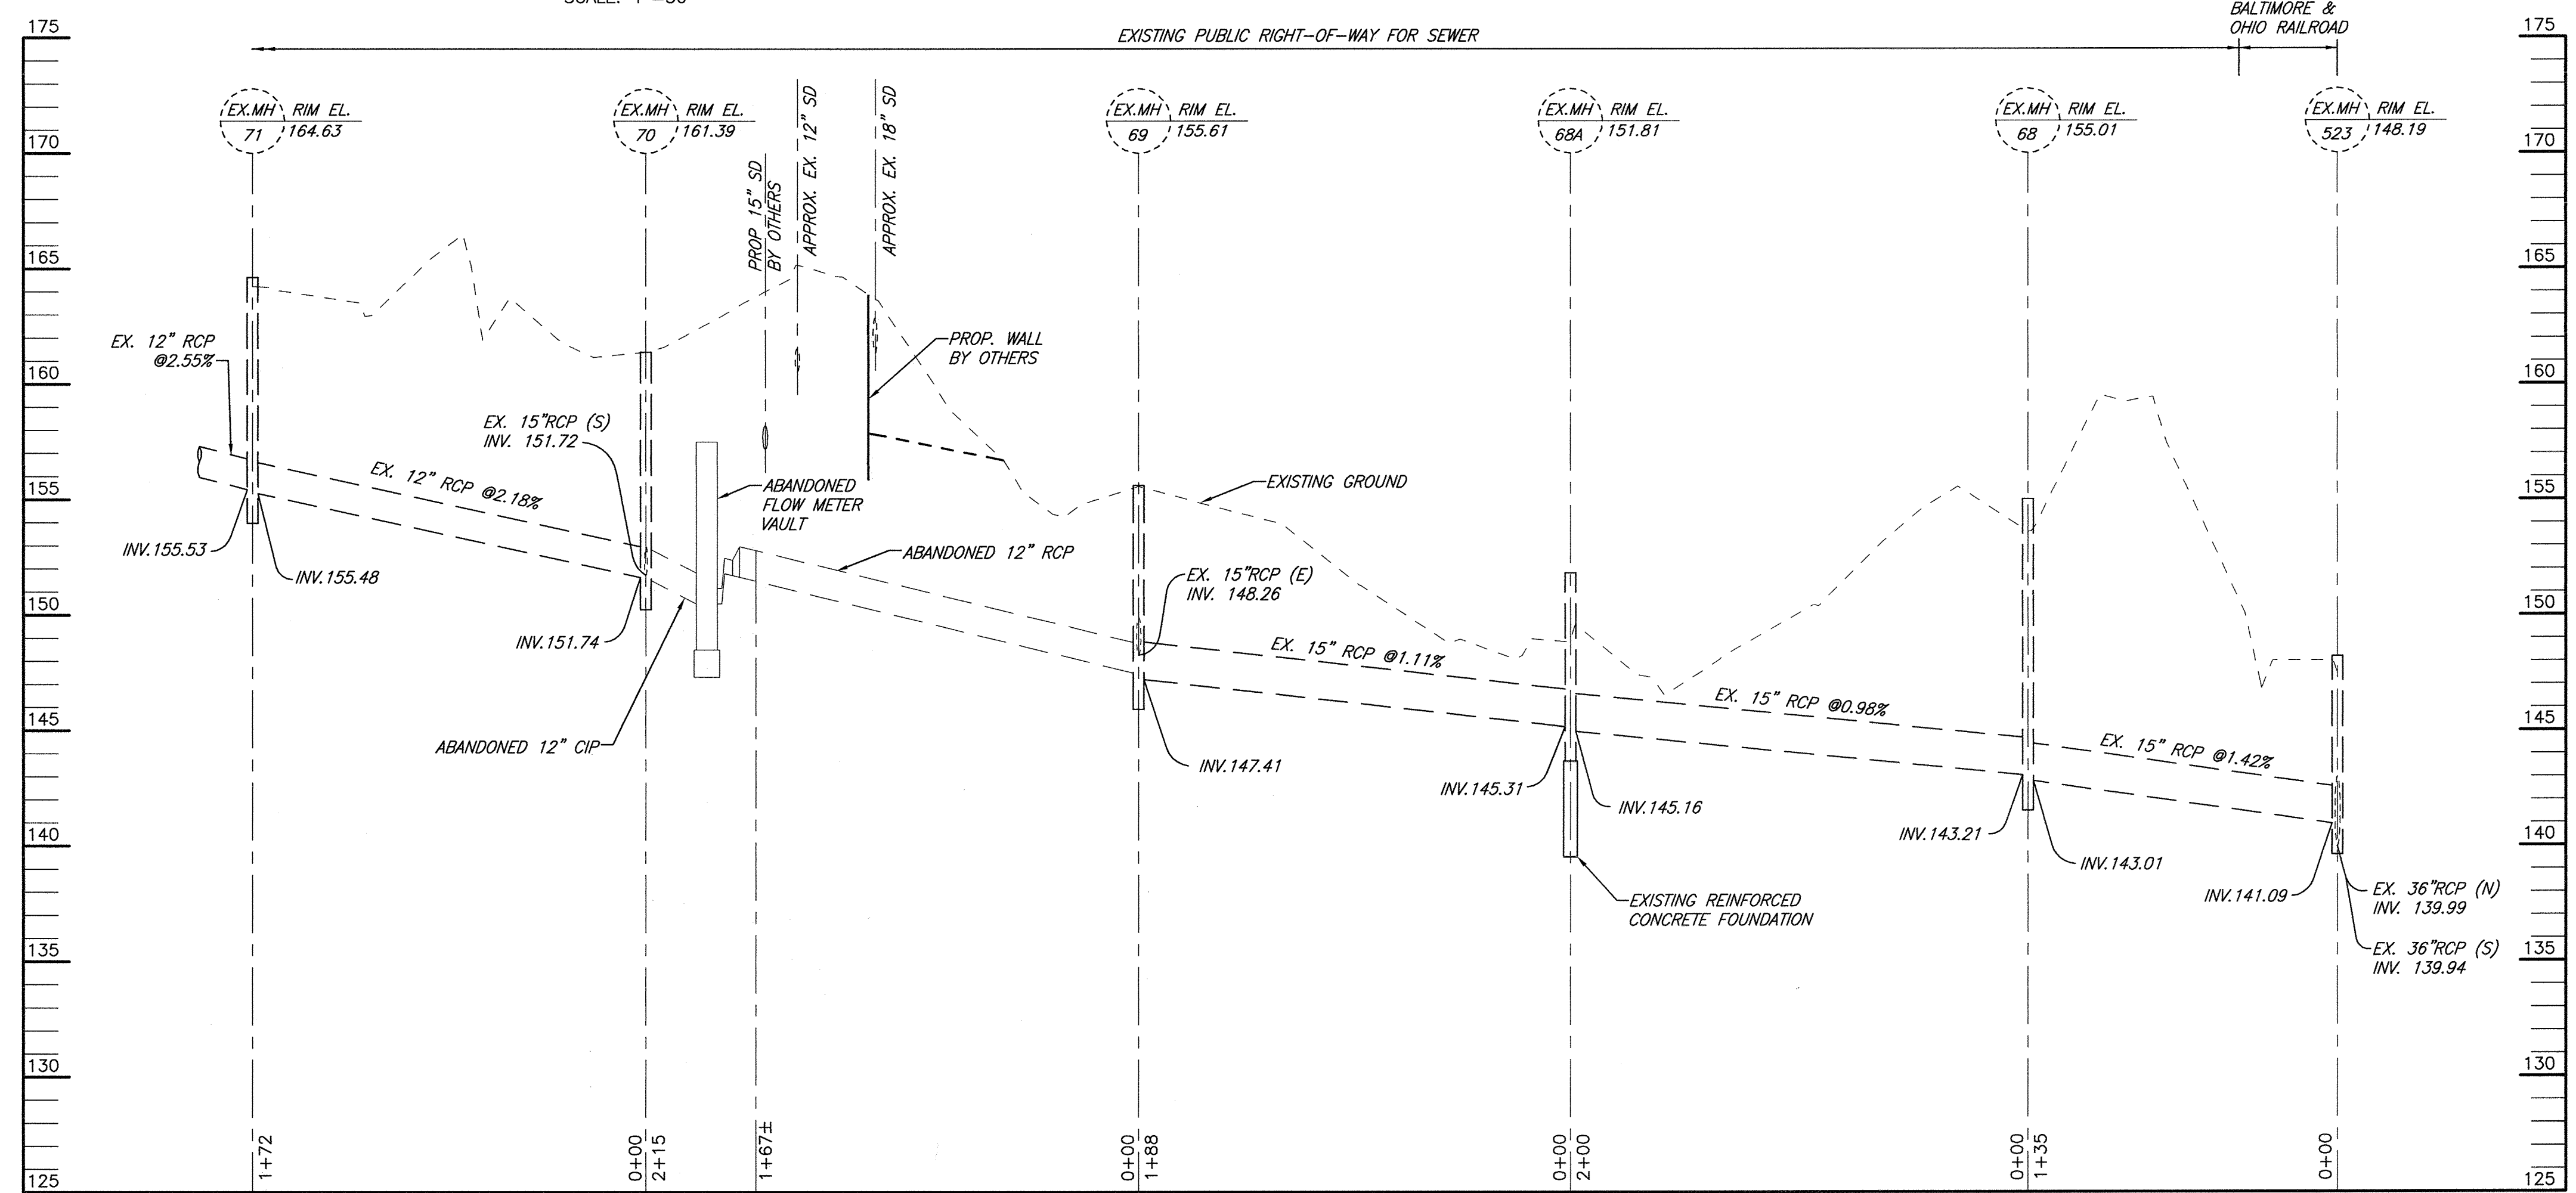

SEWER PROFILE (CONTRACT 19-S)


SCALE: HOR.: 1"=50'  
VERT.: 1"=5'

\*THIS SHEET IS FOR REFERENCE ONLY\*

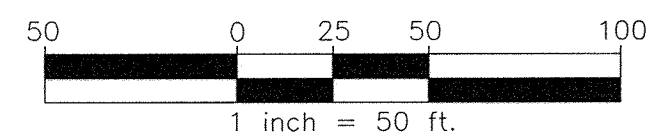

DEPARTMENT OF PUBLIC WORKS HOWARD COUNTY, MARYLAND	
<i>[Signature]</i> DIRECTOR OF PUBLIC WORKS	<i>[Signature]</i> CHIEF, BUREAU OF ENGINEERING
<i>[Signature]</i> CHIEF, BUREAU OF UTILITIES	<i>[Signature]</i> CHIEF, UTILITY DESIGN DIVISION
DATE: 6/6/17	DATE: 6/15/17
DATE: 5/16/17	DATE: 6/2/17

**GMB**  
GEORGE, MILES & BUHR, LLC  
ARCHITECTS & ENGINEERS  
SALISBURY - BALTIMORE - SEAFORD  
www.gmbnet.com

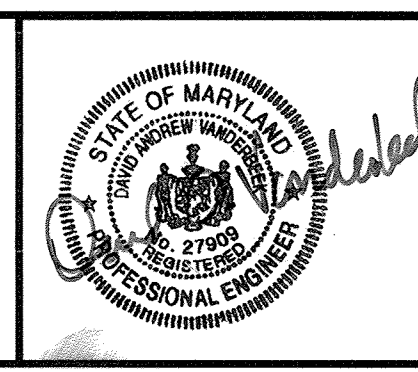

DES: D.A.V.	
DRN: M.A.D.	
CHK: W.B.F.	
DATE: 05/17	
BY: NO.	REVISION

EXISTING CONDITIONS PLAN AND PROFILE	
600 SCALE MAP NO. 25	BLOCK NO. 8

SYLVAN LANE  
INTERCEPTOR SEWER IMPROVEMENTS  
CONTRACT NO. 10-4915  
2ND ELECTION DISTRICT  
HOWARD COUNTY, MARYLAND


SCALE AS SHOWN  
SHEET 2 OF 12

C:\DRAWINGS\3041-TIBER SUCKER BRANCH INTERCEPTOR SEWER IMPROVEMENTS\CURRENT\Sylvan Lane.VC 12-PLAN.dwg, 5/16/2017 11:26:37 AM, HP, Designer, J. T. 530, PS, MyMicro3








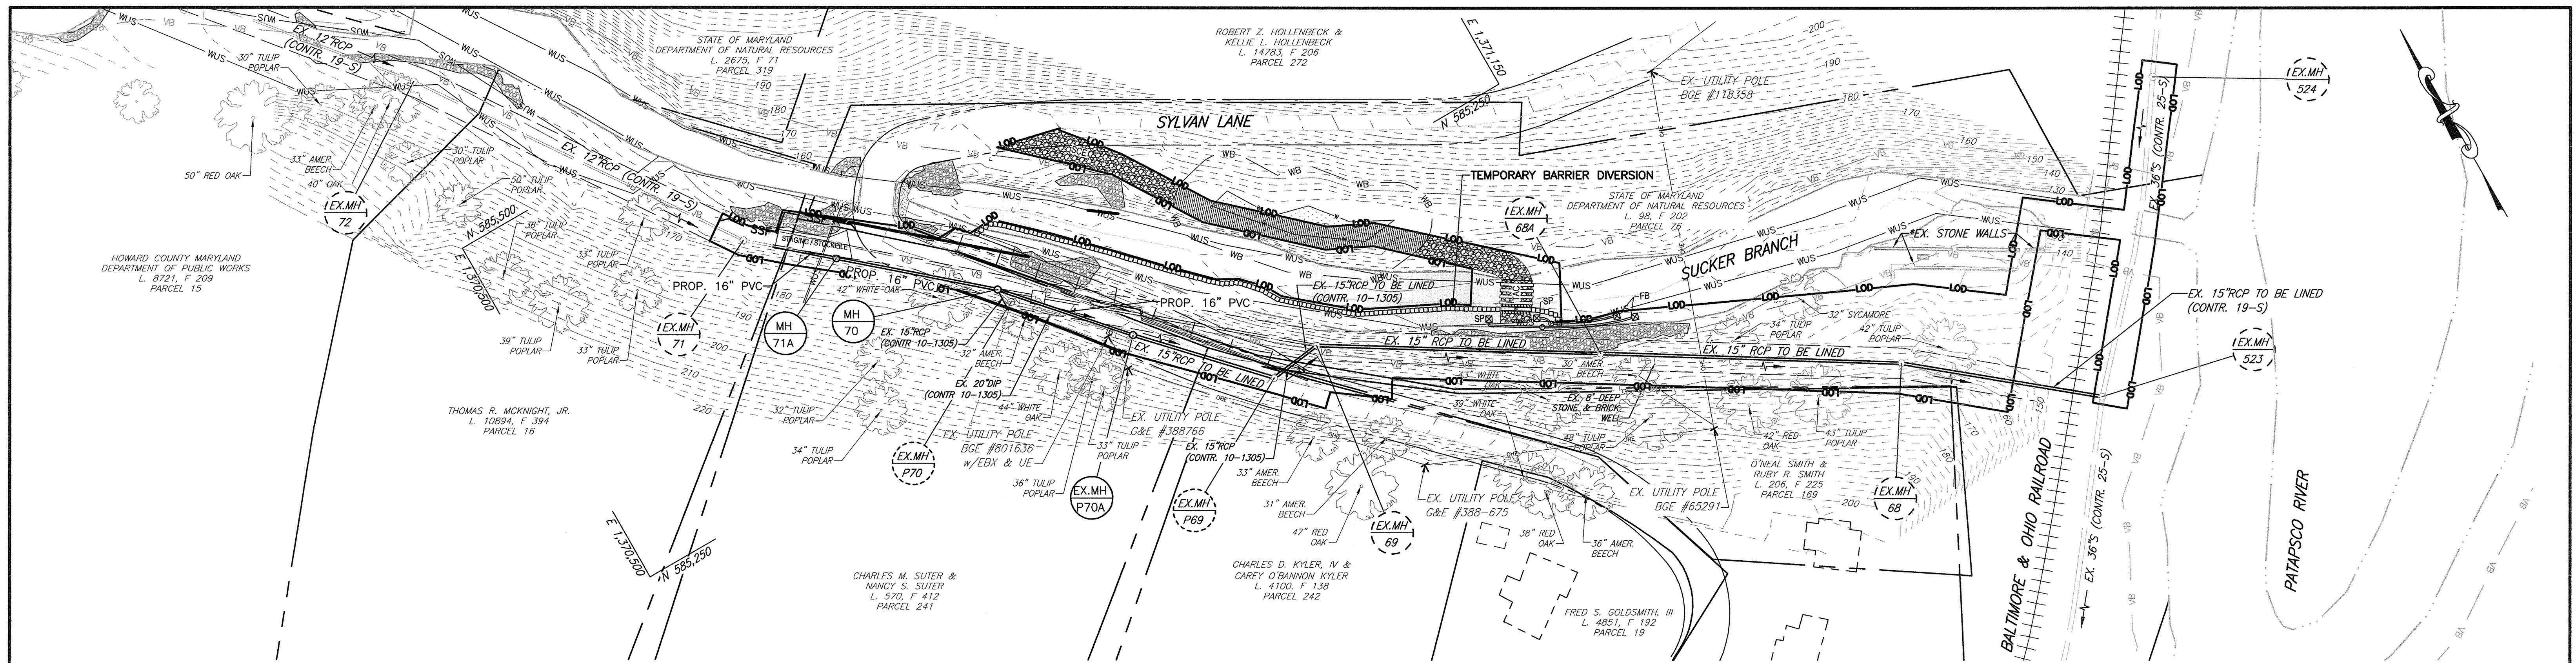


**PLAN**  
SCALE: 1"=50' \* DO NOT DISTURB EXISTING STONE WALLS

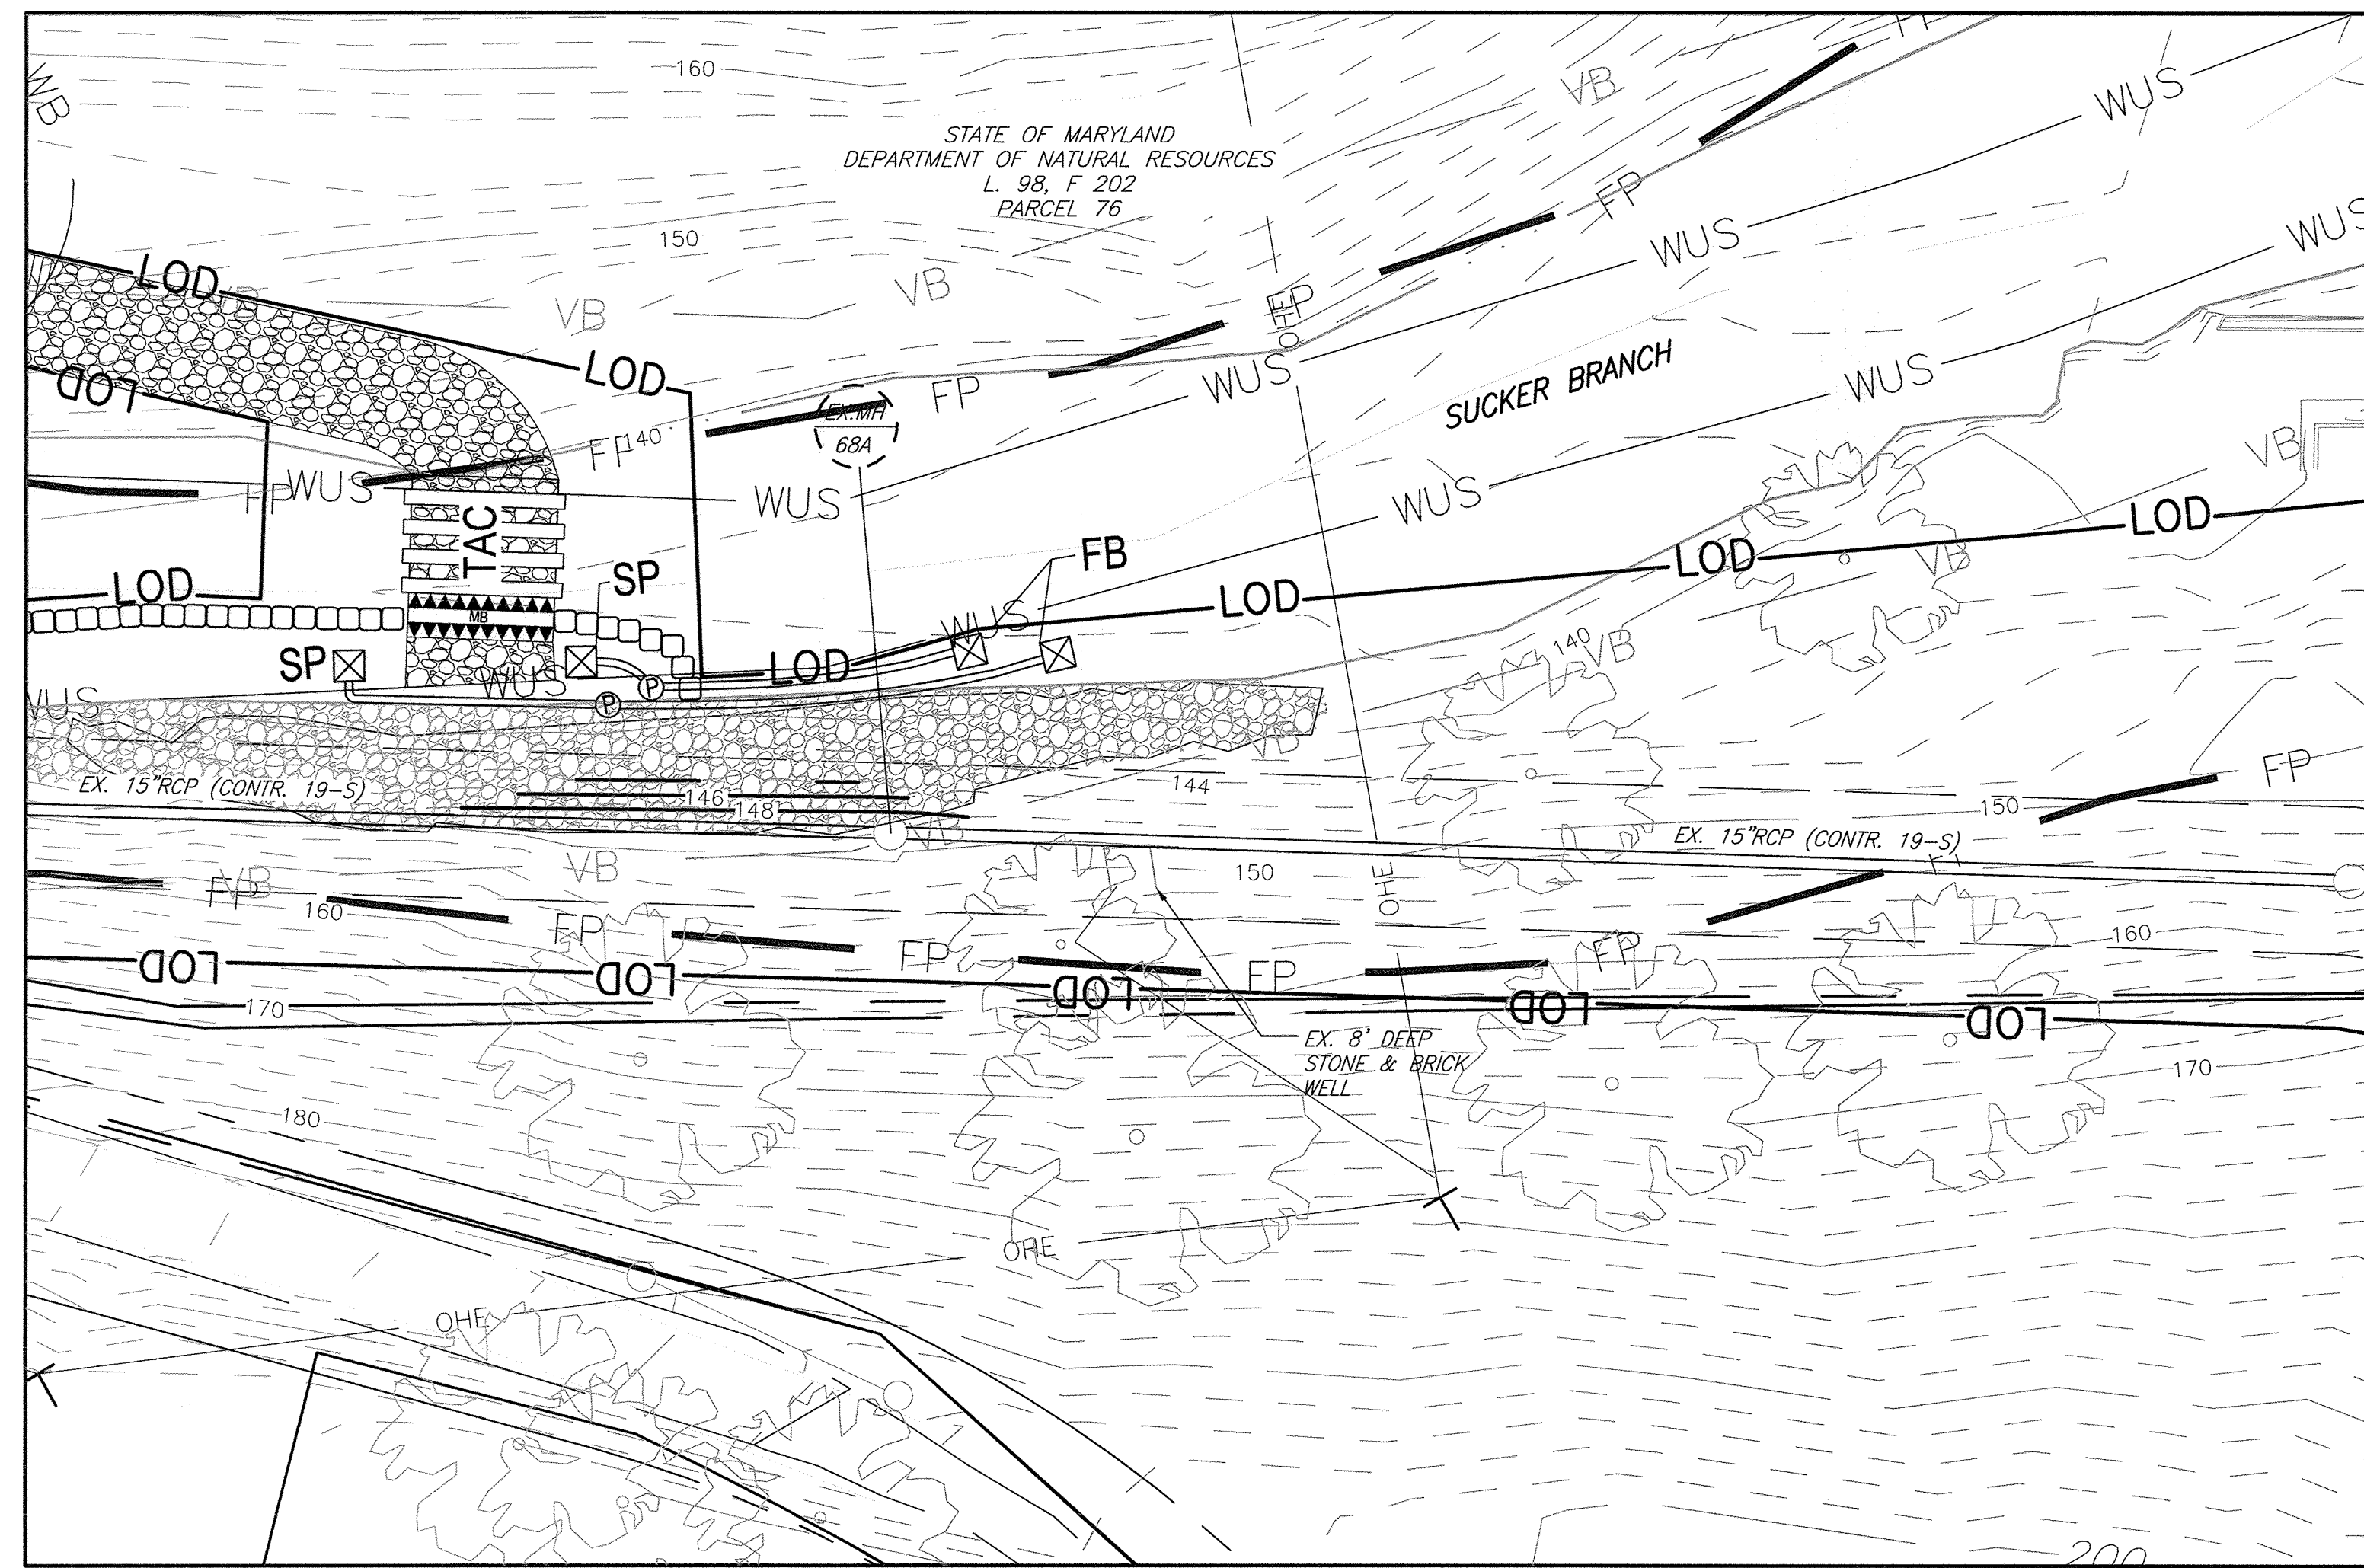


**CONSTRUCTION ACCESS FROM SYLVAN LANE**  
THE CONTRACTOR SHALL BE RESPONSIBLE FOR CONSTRUCTING, MAINTAINING AND REMOVING ANY KIND OF ACCESS ROAD. THE CONTRACTOR SHALL BE RESPONSIBLE FOR MAINTAINING THE ACCESS ROAD DURING ITS USE AND, WHEN DONE, SHALL RESTORE THE AREA TO ITS ORIGINAL OR BETTER CONDITION.

**CONSTRUCTION ACCESS TO MANHOLE 523**  
THE CONTRACTOR SHALL HAVE ONLY LIMITED ACCESS TO MANHOLE 523 AND THE EAST SIDE OF THE RAILROAD CORRIDOR. ALL ACCESS SHALL BE VIA SUCKER BRANCH CULVERT ONLY. NO ACCESS IS ALLOWED ACROSS THE RAILROAD TRACKS AT ANY TIME. ALL WORK WITHIN THE CSX RAIL CORRIDOR SHALL BE IN ACCORDANCE WITH THE CSX PERMIT. THERE SHALL BE NO ACCESS ALLOWED TO THE EAST SIDE OF THE RAILROAD CORRIDOR OR MANHOLE 523 FOR ANY HEAVY EQUIPMENT, BOILER TRUCKS OR EQUIPMENT OTHER THAN THAT WHICH CAN BE HAND-CARRIED BY PERSONNEL VIA THE CULVERT ACCESS. NO PIPELINES MAY BE LAID ACROSS THE TRACKS SUCH AS BYPASS PUMPING FORCE MAINS OR RECIRCULATING PIPES FOR THE CIPP LINING.

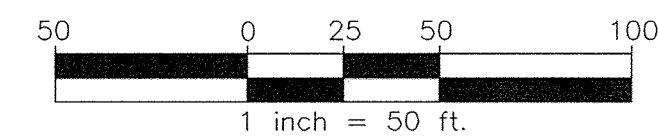

DEPARTMENT OF PUBLIC WORKS HOWARD COUNTY, MARYLAND	
<i>[Signature]</i> DIRECTOR OF PUBLIC WORKS	<i>[Signature]</i> CHIEF, BUREAU OF ENGINEERING
DATE: 6/6/17	DATE: 6/5/17
<i>[Signature]</i> CHIEF, BUREAU OF UTILITIES	<i>[Signature]</i> CHIEF, UTILITY DESIGN DIVISION
DATE: 5/15/17	DATE: 6-2-17

**GMB**  
 GEORGE, MILES & BUHR, LLC  
 ARCHITECTS & ENGINEERS  
 SALISBURY - BALTIMORE - SEAFORD  
 www.gmbnet.com

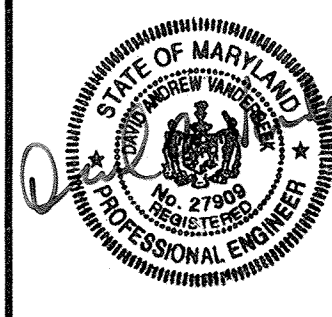

DES: D.A.V.			
DRN: M.A.D.			
CHK: W.B.F.			
DATE: 05/17			
BY: NO.		REVISION	DATE


<b>EROSION &amp; SEDIMENT CONTROL PLAN</b>	
600 SCALE MAP NO. 25	BLOCK NO. 8

<b>SYLVAN LANE          INTERCEPTOR SEWER IMPROVEMENTS</b> CONTRACT NO. 10-4915 2ND ELECTION DISTRICT HOWARD COUNTY, MARYLAND	
SCALE AS SHOWN	SHEET 4 OF 12

C:\DRAWINGS\3041-TBFR-SUCKER BRANCH INTERCEPTOR SEWER IMPROVEMENTS\CURRENT\Syner-Lane-C-04-ESC.dwg, 5/26/2017 12:26:46 PM, HP DesignJet T1530 PPS Mylex.pdf






	BOULDER TOE STABILIZATION			BOULDER SLOPE STABILIZATION		BOULDER SLOPE STABILIZATION WITH DEFLECTOR			BOULDER SLOPE STABILIZATION			
	A	B	C	C	D	D	E	F	G	G	H	I
NORTHING	585331.0829	55273.6495	585227.5341	585227.5341	585218.7171	585218.7171	585212.3471	585204.2103	585192.6619	585192.6619	585156.7953	585132.1407
EASTING	1370810.3328	1370870.2121	1370906.9026	1370906.9026	1370916.7242	1370916.7242	1370930.3411	1370937.0923	1370943.4076	1370943.4076	1370985.2416	1371030.7809
SELECT CLASS III BOULDERS	341 TONS			35 TONS		159 TONS			283 TONS			

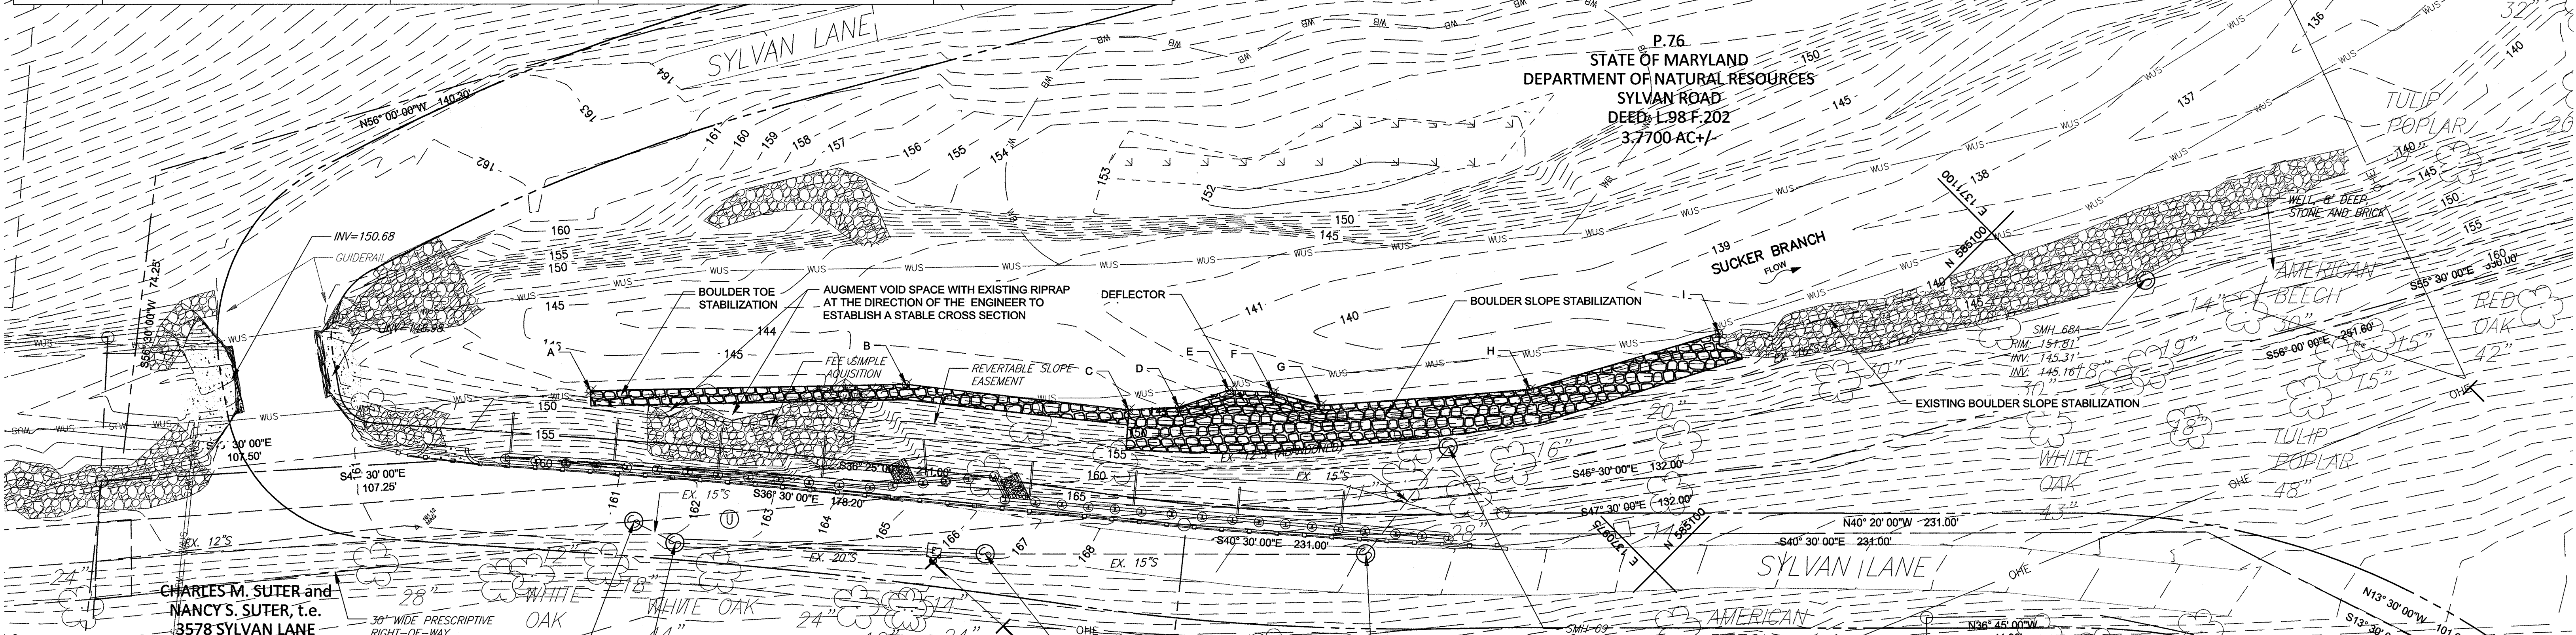

CHARLES M. SUTER and  
NANCY S. SUTER, t.e.  
3578 SYLVAN LANE  
DEED: L.9874 F.681  
2.5530 AC +/-

- NOTES:
- IT SHALL BE DISTINCTLY UNDERSTOOD THAT FAILURE TO MENTION SPECIFICALLY ANY WORK WHICH WOULD NATURALLY BE REQUIRED TO COMPLETE THE PROJECT SHALL NOT RELIEVE THE CONTRACTOR OF HIS RESPONSIBILITY TO COMPLETE SUCH WORK.
  - DUE TO INTERIM STREAM BED AND BANK EROSION PROPOSED STREAM STABILIZATION STRUCTURES SHALL BE CONSTRUCTED AS DIRECTED BY THE ENGINEER IN THE FIELD.
  - SUCKER BRANCH IS DESIGNATED AS STREAM USE I. IN STREAM WORK SHALL NOT BE CONDUCTED DURING THE PERIOD MARCH 1 THROUGH JUNE 15, INCLUSIVE, DURING ANY YEAR (COMAR 26.08.02.11).

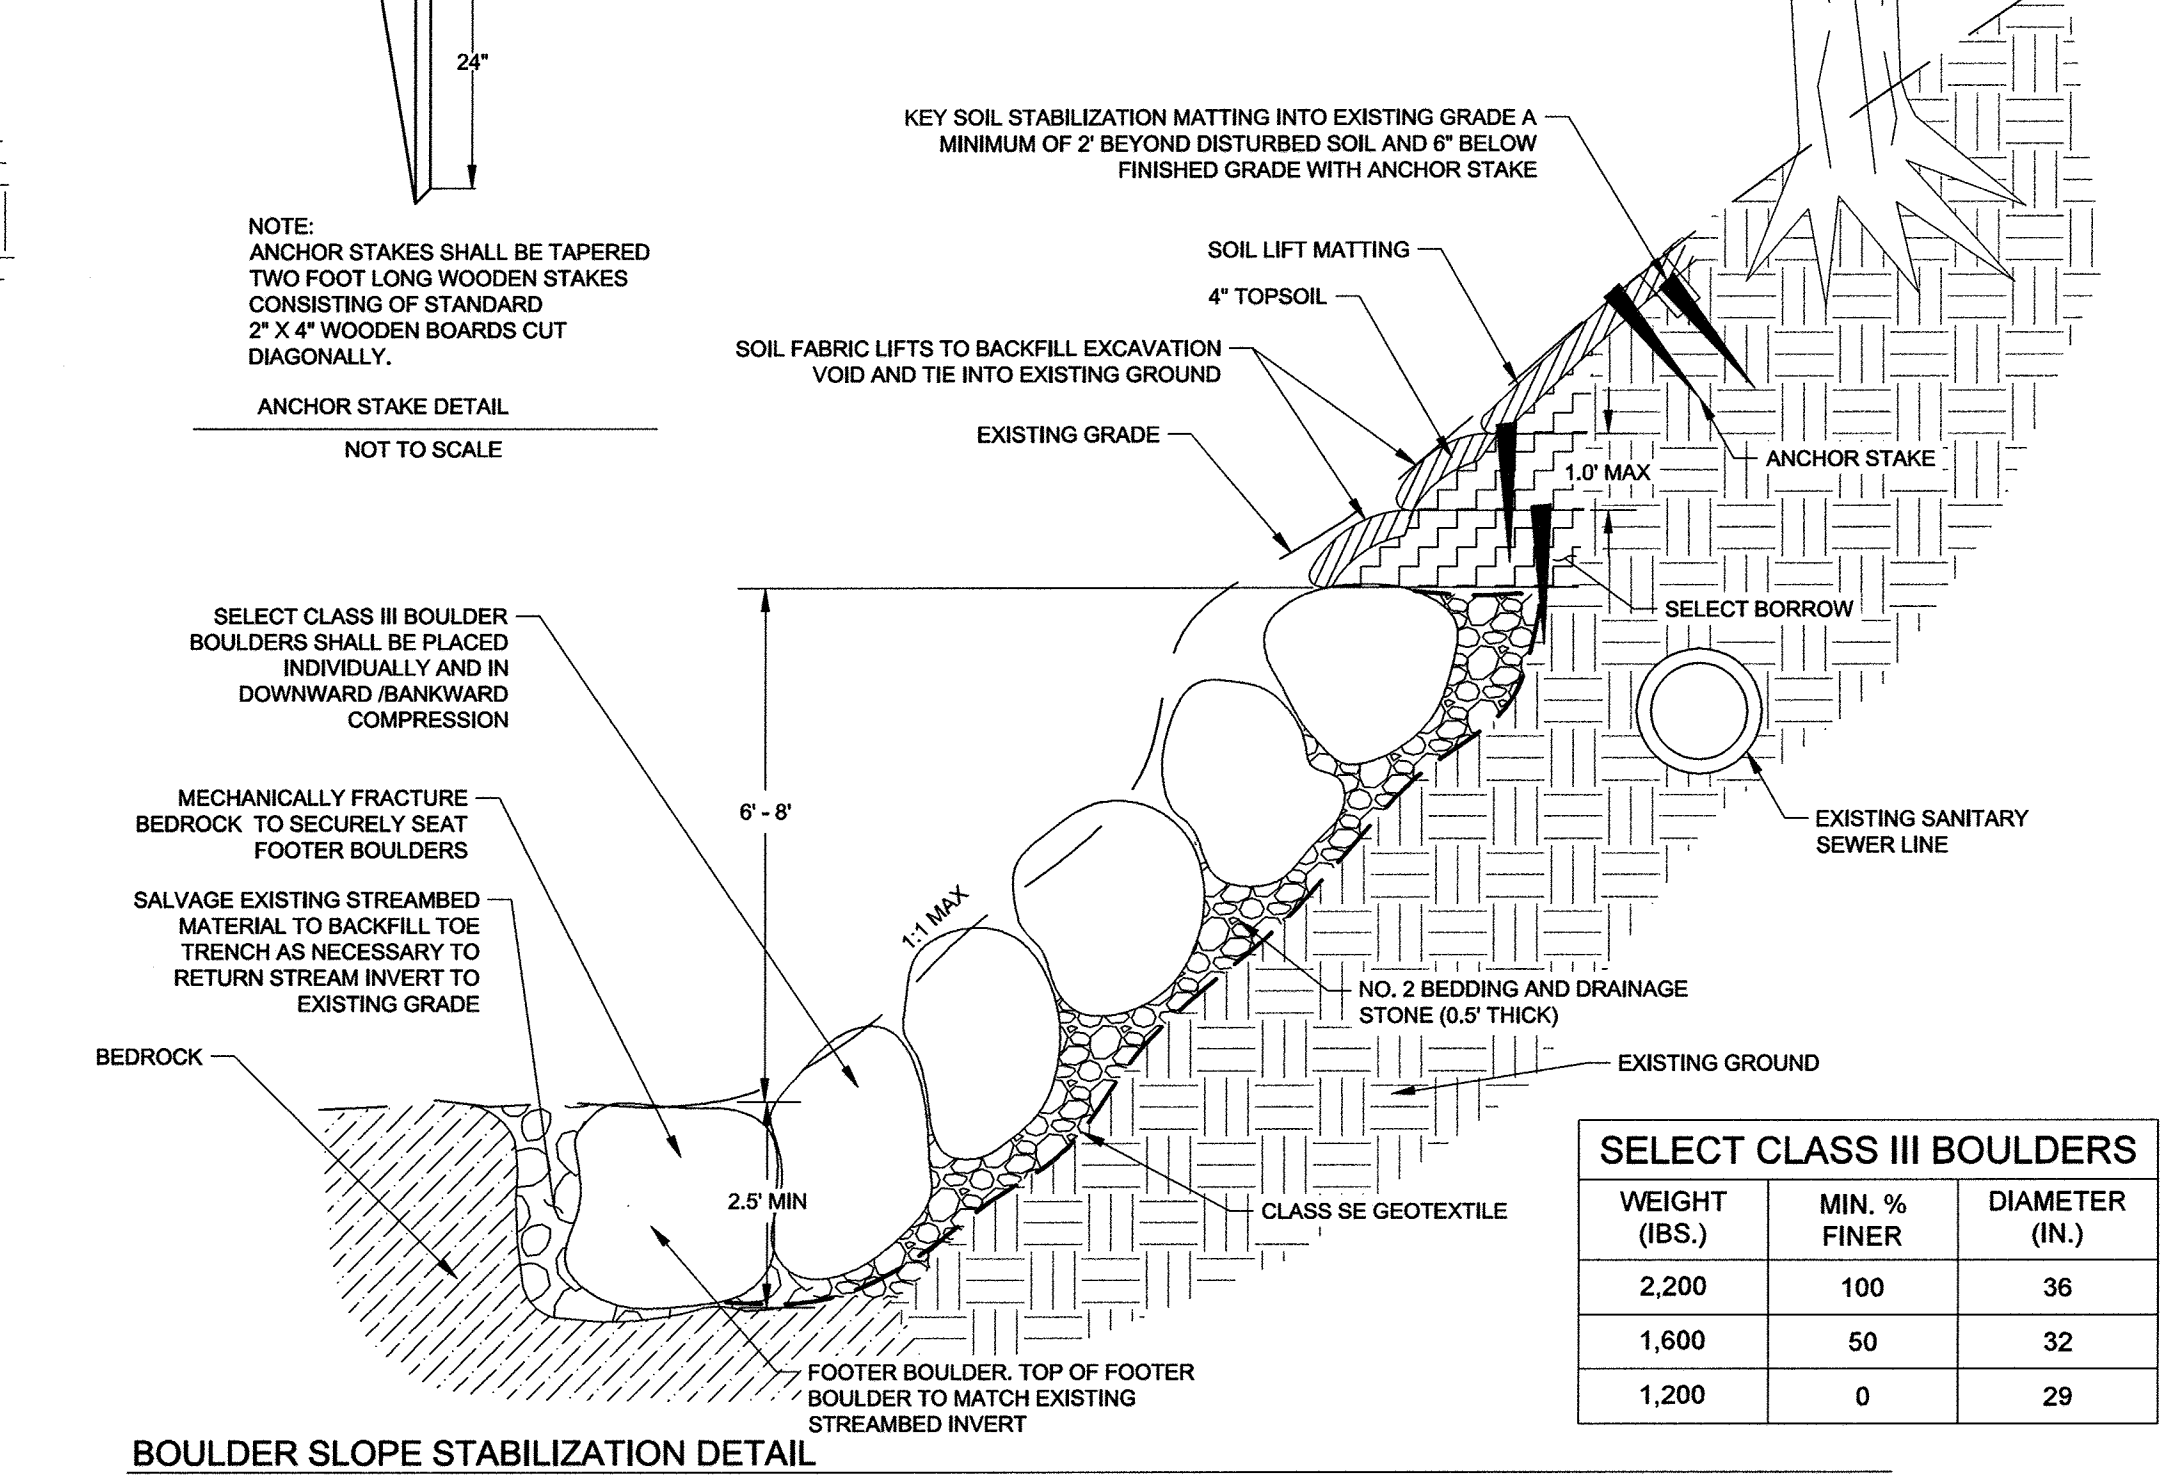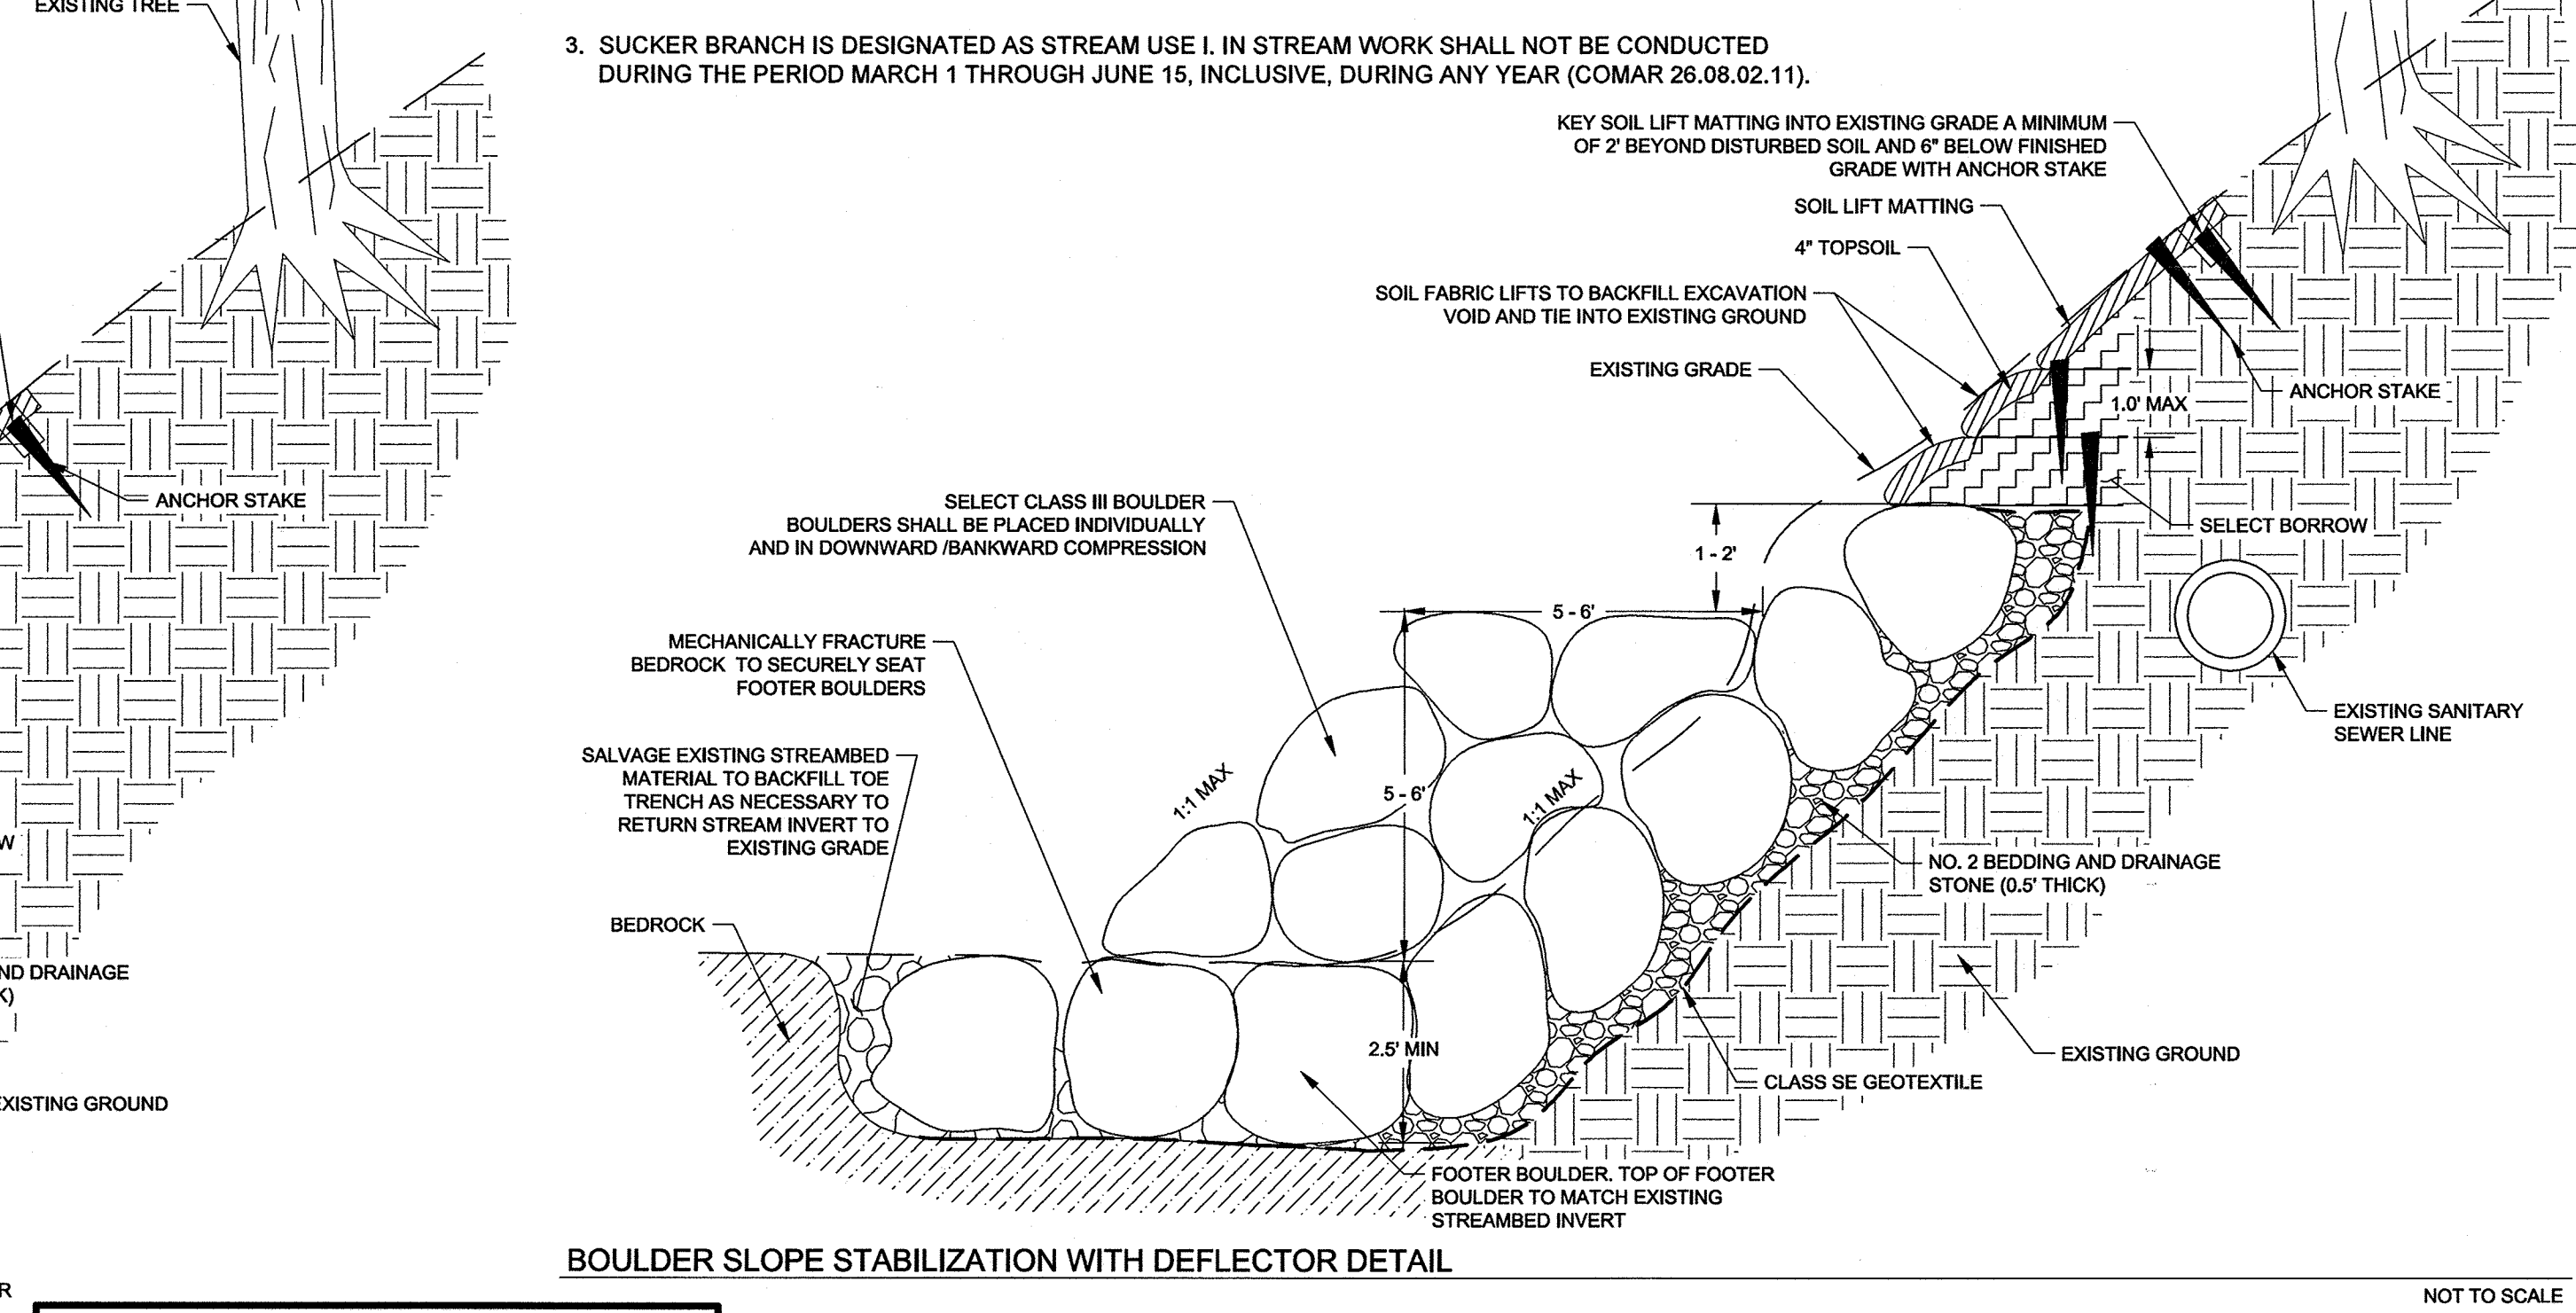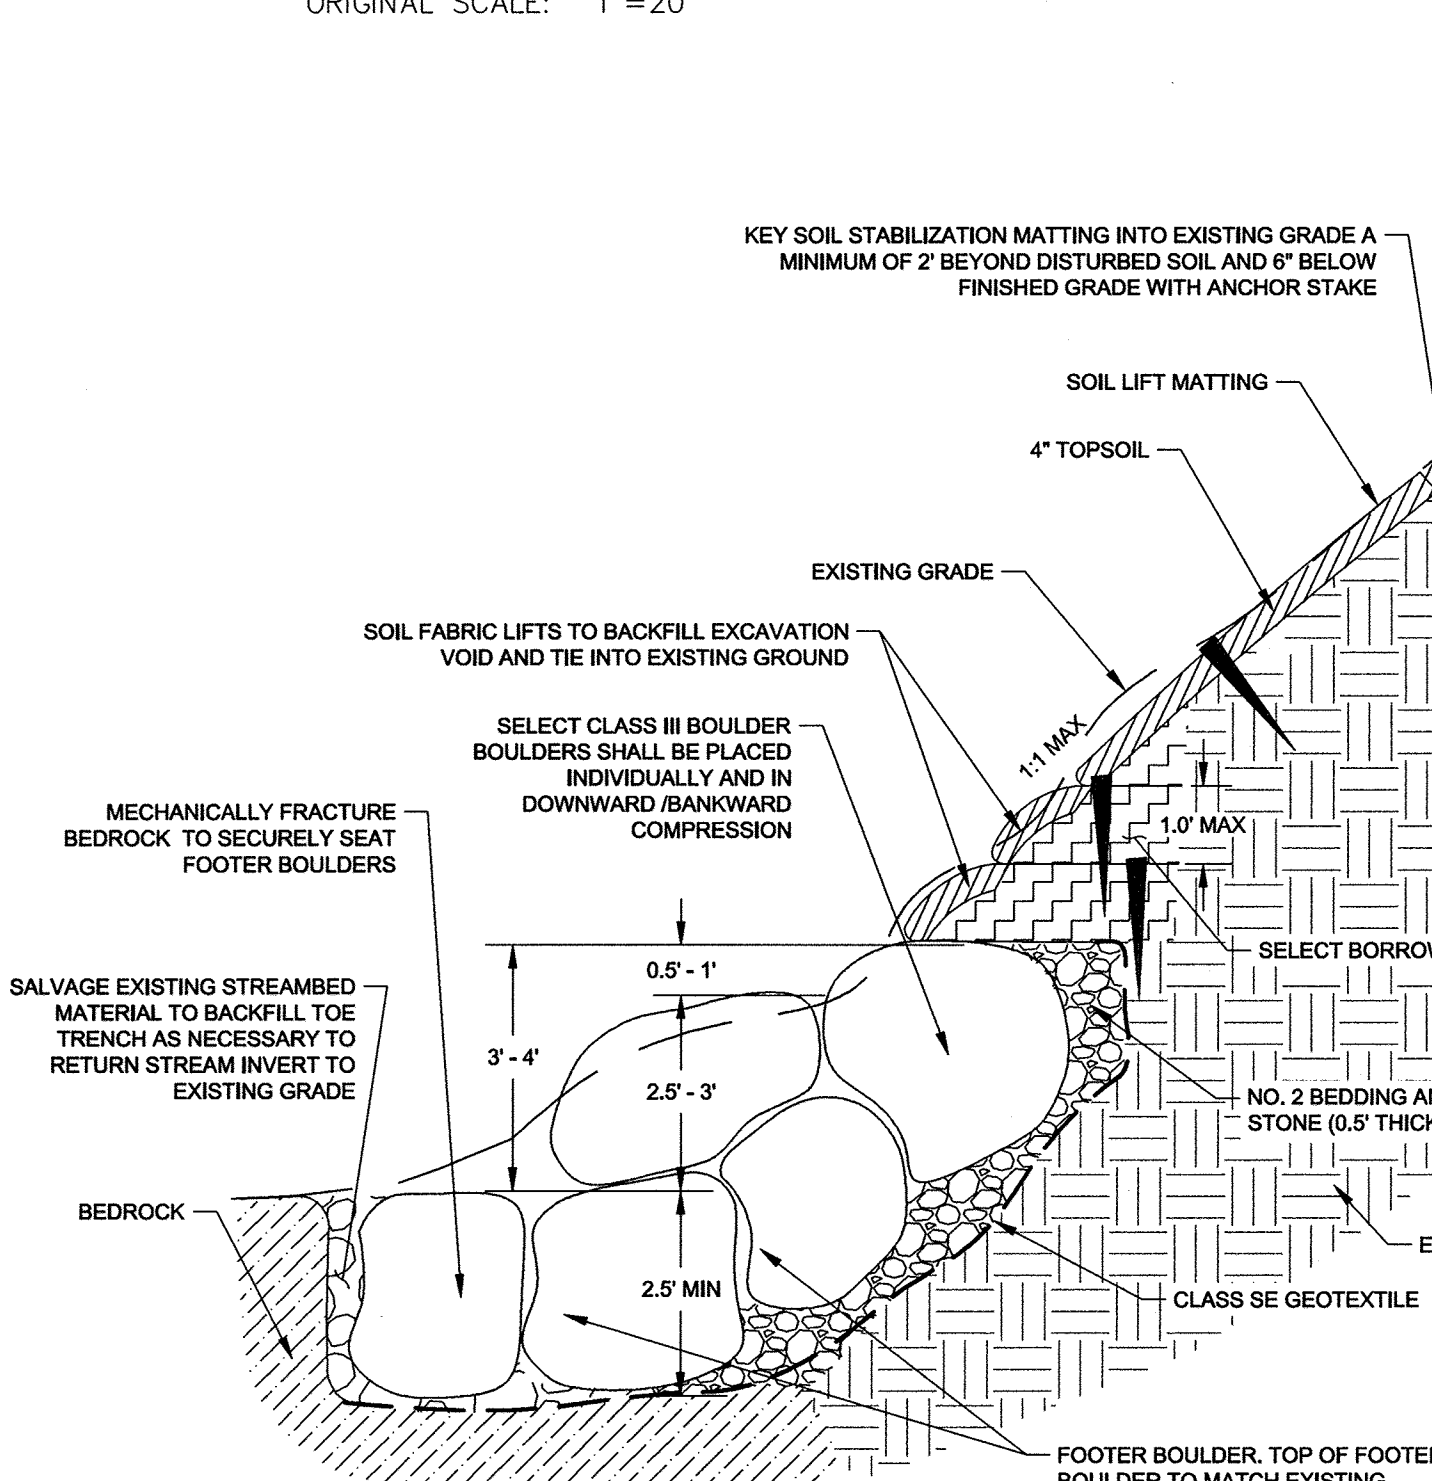

SELECT CLASS III BOULDERS		
WEIGHT (IBS.)	MIN. % FINER	DIAMETER (IN.)
2,200	100	36
1,600	50	32
1,200	0	29

DEPARTMENT OF PUBLIC WORKS  
HOWARD COUNTY, MARYLAND


*[Signature]* 6/15/17  
DIRECTOR OF PUBLIC WORKS DATE

*[Signature]* 6/2/17  
CHIEF, BUREAU OF ENGINEERING DATE

*[Signature]* 6/2/17  
CHIEF, UTILITY DESIGN DIVISION DATE

**CENTURY ENGINEERING**  
CONSULTING ENGINEERS - PLANNERS  
10710 Gilroy Road, Hunt Valley, MD 21031  
Phone: 443.589.2400 Fax: 443.589.2401  
www.centuryeng.com

**GMB**  
GEORGE, MILES & BUHR, LLC  
ARCHITECTS & ENGINEERS  
SALISBURY - BALTIMORE - SEAFORD  
www.gmbnet.com

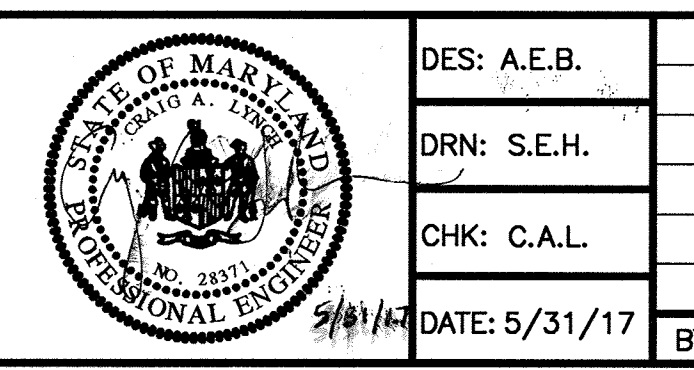

DES: A.E.B.			
DRN: S.E.H.			
CHK: C.A.L.			
DATE: 5/31/17	BY: NO.	REVISION	DATE



STREAM SLOPE STABILIZATION PLAN

600 SCALE MAP NO. 25 BLOCK NO. 8

SYLVAN LANE  
INTERCEPTOR SEWER IMPROVEMENTS  
CONTRACT NO. 10-4915  
2ND ELECTION DISTRICT  
HOWARD COUNTY, MARYLAND

SCALE 1"=20'  
SHEET 5 OF 12



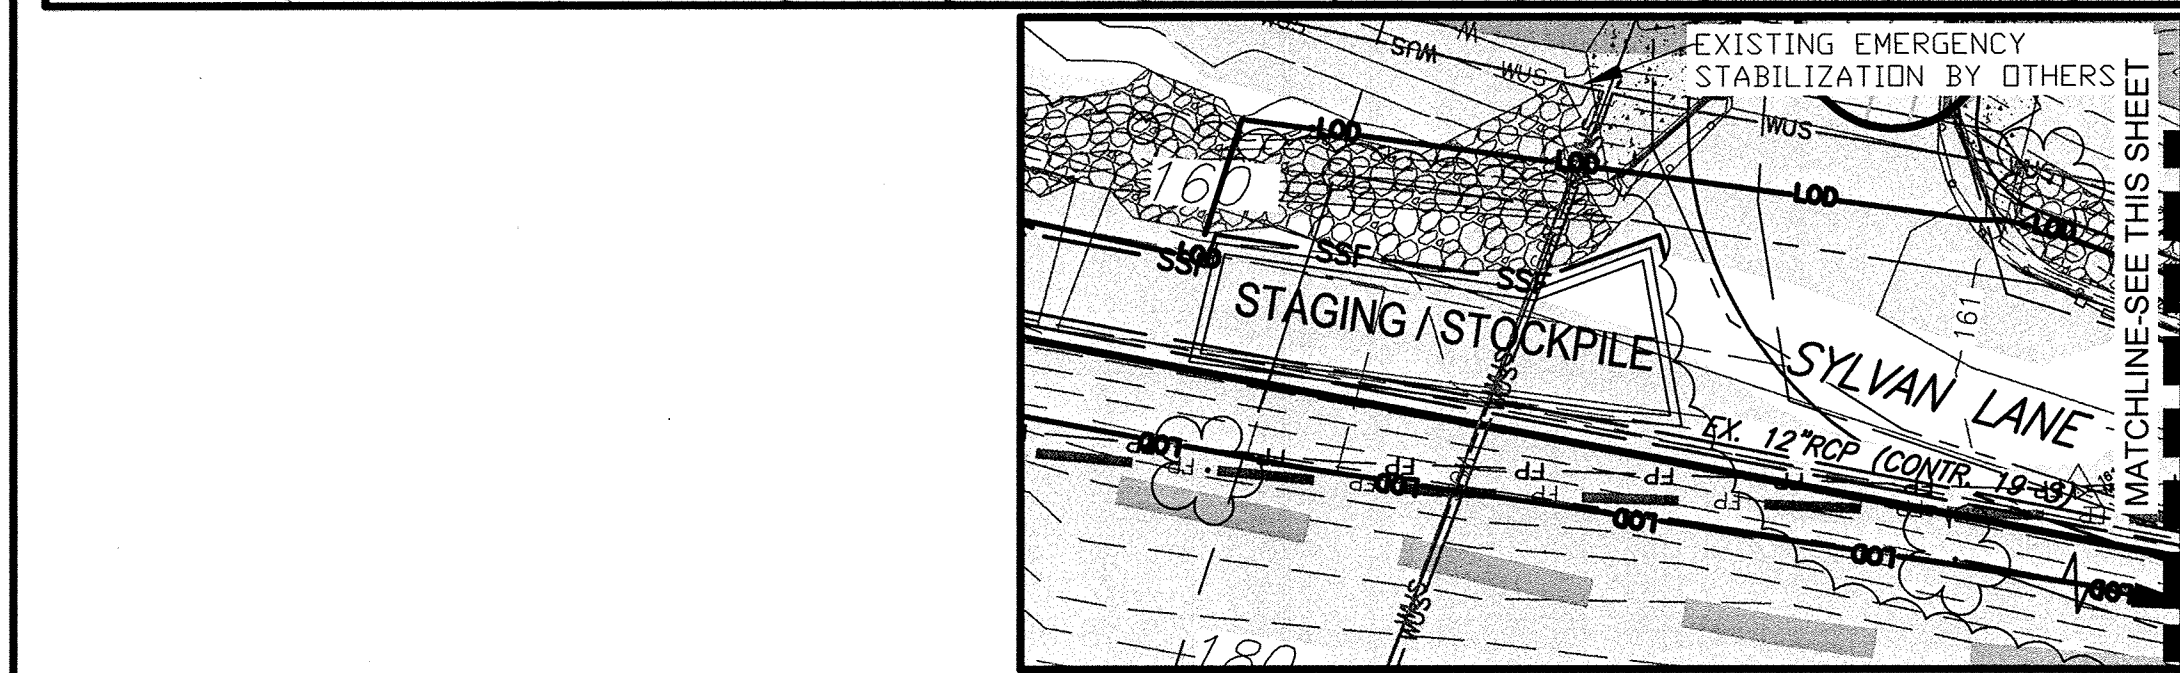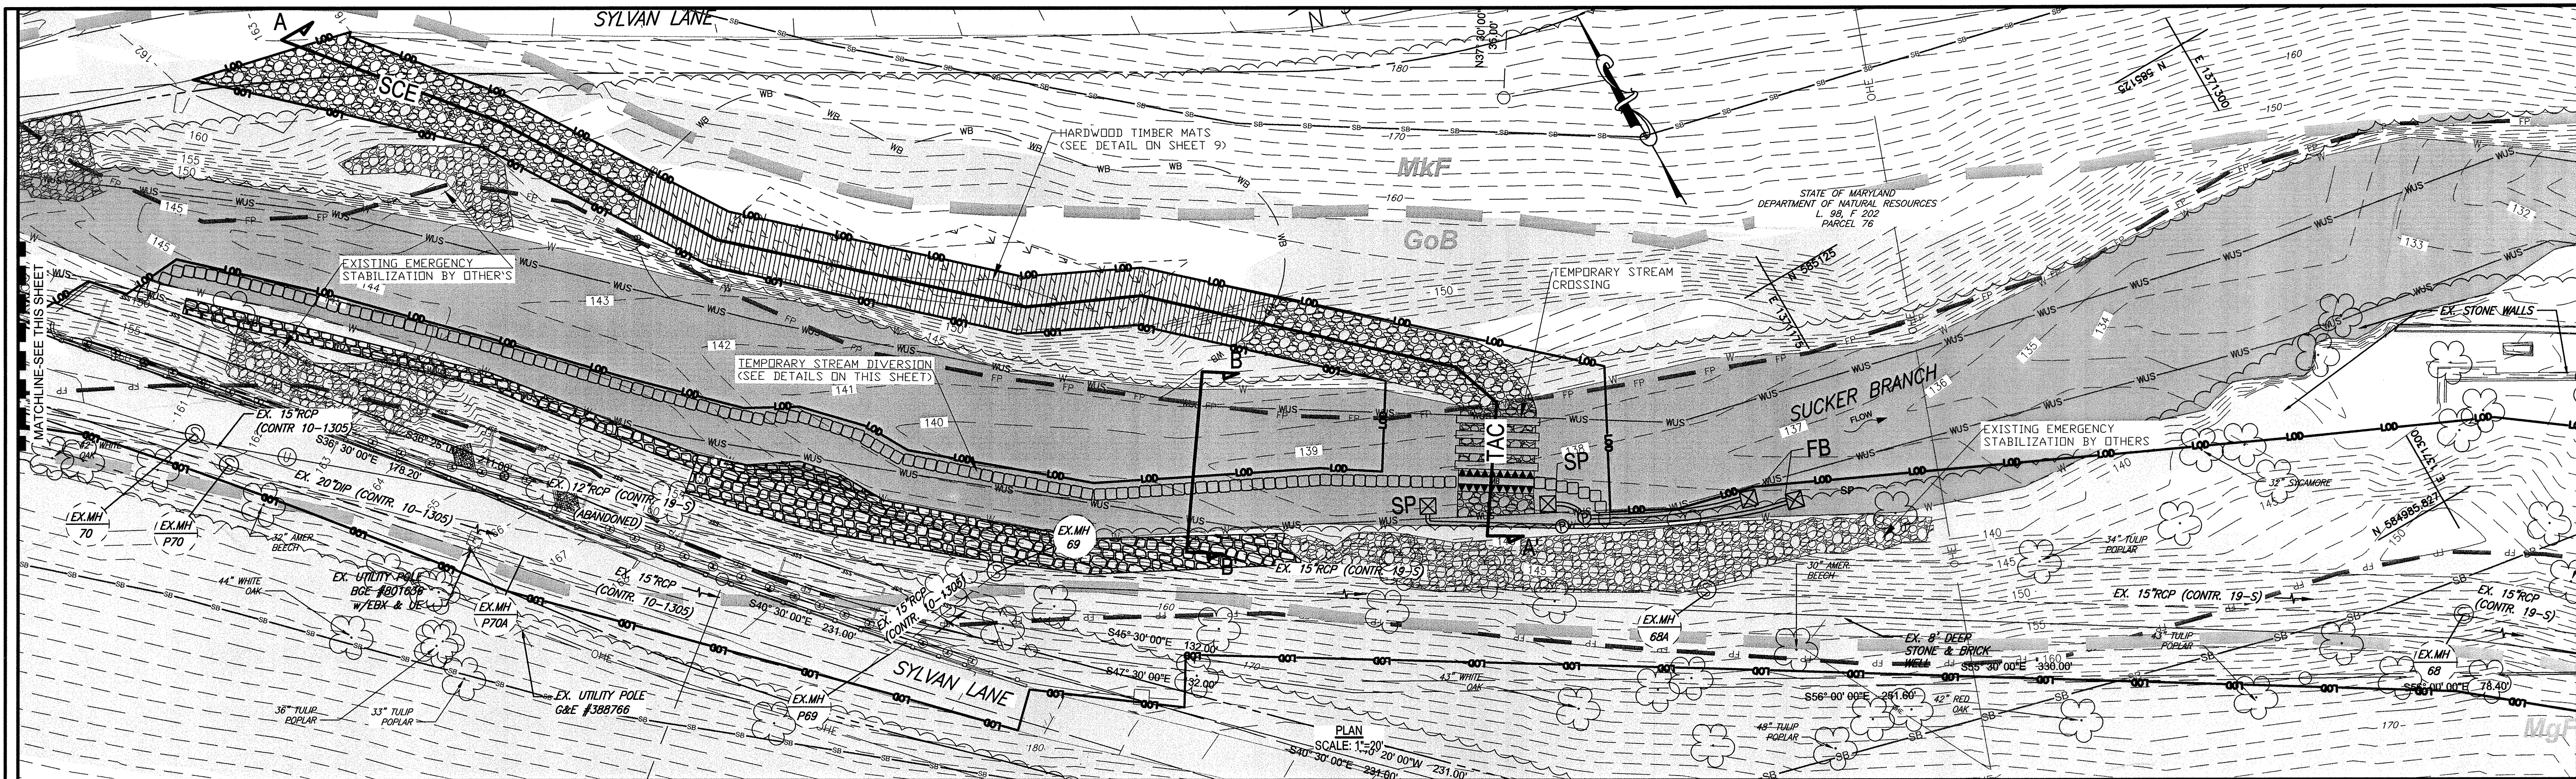

**TEMPORARY ACCESS CULVERT NOTES**

1. THE CONTRACTOR SHALL USE FOUR 24" CORRUGATED METAL PIPES (CMP 14 GA.) OR FOUR 24" REINFORCED CONCRETE PIPE (RCP).
2. THE MINIMUM LENGTH OF EACH PIPE SHALL BE 16'. THE MAXIMUM LENGTH OF EACH PIPE SHALL BE 20'.
3. THE TEMPORARY ACCESS CULVERTS SHALL BE PLACED PARALLEL TO THE STREAM CHANNEL.
4. THE TOP ELEVATION OF THE TEMPORARY ACCESS CULVERTS SHALL BE LOWER THAN THE TEMPORARY STREAM DIVERSION TO ALLOW HIGHER STREAM FLOWS TO PASS OVER THE TEMPORARY ACCESS CULVERT INSTEAD OF THE SAND BAG DIVERSION.



**TEMPORARY STREAM CROSSING NOTES**

1. ANY DAMAGE TO STREAM CROSSING OR EXISTING STREAM CHANNEL DURING BASEFLOW OR FLOOD EVENTS SHALL BE PROMPTLY REPAIRED.
2. INSPECT TEMPORARY STREAM CROSSING AND SANDBAG DIVERSION EACH DAY AND MAINTAIN THEM IN EFFECTIVE OPERATING CONDITION. MAINTENANCE OF STRUCTURES SHALL BE PROACTIVE, NOT REACTIVE. THE STREAM CROSSING AND SANDBAGS SHALL BE INSPECTED WITHIN 24 HOURS OF RAIN EVENTS AND, IF NECESSARY, PERFORM MAINTENANCE IMMEDIATELY.
3. THE STREAM CROSSING AND SANDBAGS SHALL REMAIN IN PLACE UNTIL NO LONGER NEEDED AND SHALL BE REMOVED PRIOR TO THE END OF CONSTRUCTION.


**STREAM DIVERSION NOTES**

1. CONTRACTOR MAY USE EITHER SANDBAGS OR TEMPORARY BARRIER DIVERSIONS (DETAIL C-7), PROVIDED THE CONTRACTOR CAN PROVE STABILITY OF THE TEMPORARY BARRIER DIVERSIONS AGAINST THE 2-YEAR FLOW DEPTH (5.36').

NOTE: ALL SOILS SHOWN ON THIS PLAN ARE HIGHLY ERODIBLE SOILS PER COMAR 26.17.01.01

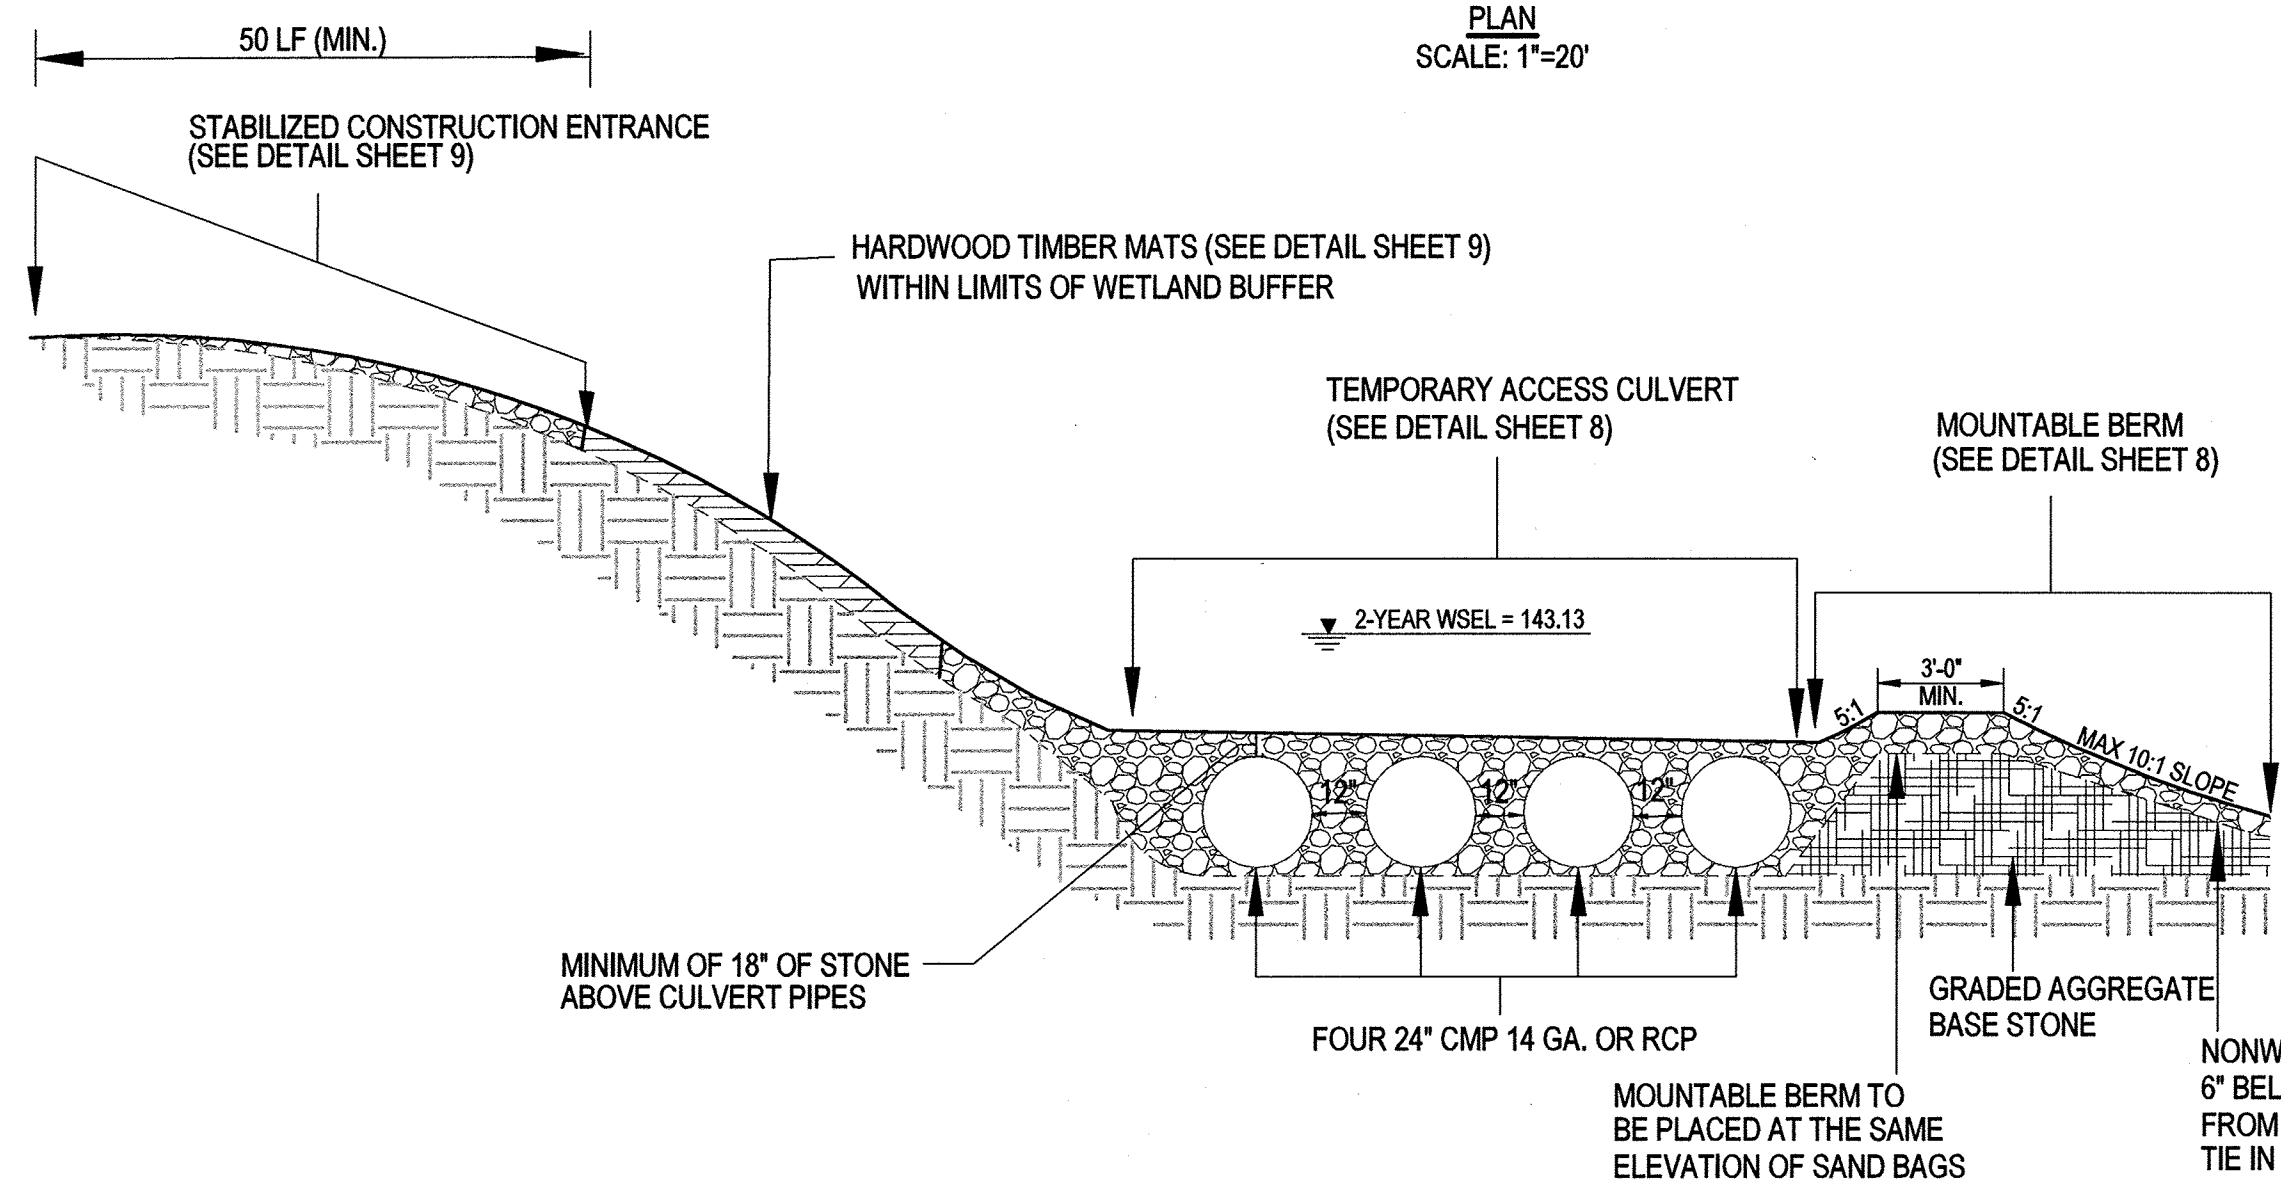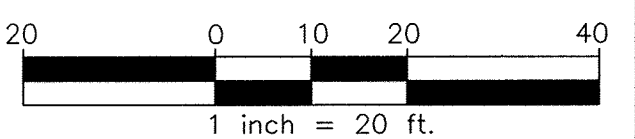

**SECTION A-A': STABILIZED CONSTRUCTION ENTRANCE, ACCESS ROAD, AND TEMPORARY ACCESS CULVERT DETAIL**  
NOT TO SCALE

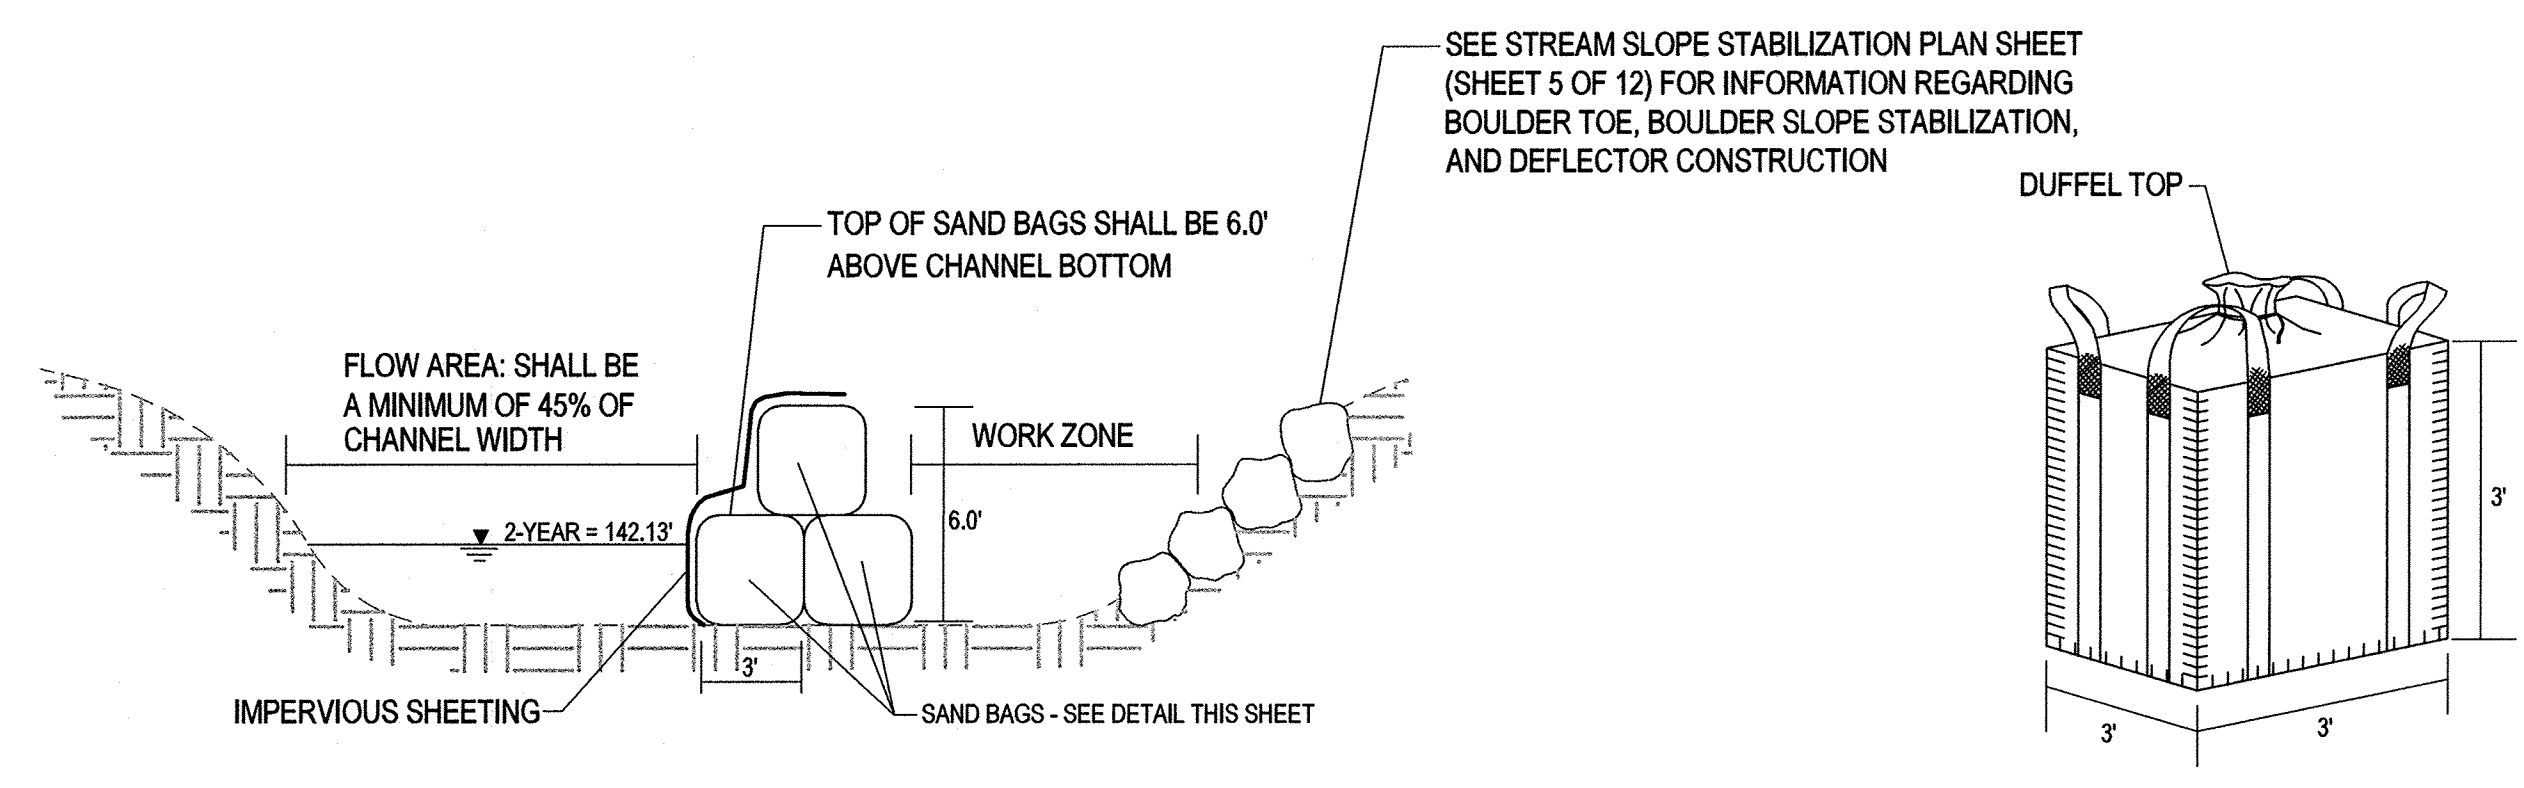

- NOTES:
1. SEE MGWC 1.5: SANDBAG/STONE CHANNEL DIVERSION FOR CONSTRUCTION AND SPECIFICATIONS.
  2. ALL POOLED WATER WITHIN THE WORK ZONE SHALL BE PUMPED THROUGH A FILTER BAG OR PST (DETAIL F-4) BEFORE BEING DISCHARGED TO A STABLE OUTFALL.

**SECTION B-B': TEMPORARY STREAM DIVERSION DETAIL**  
NOT TO SCALE

**SAND BAG DETAIL**  
NOT TO SCALE

BAG TO BE CONSTRUCTED OF MATERIALS WHICH ARE RESISTANT TO ULTRA-VIOLET RADIATION, TEARING, AND PUNCTURE. THE BAGS SHALL BE WOVEN TIGHTLY ENOUGH TO PREVENT LEAKAGE OF THE FILL MATERIAL.

DEPARTMENT OF PUBLIC WORKS  
HOWARD COUNTY, MARYLAND


*John P. Decker* 6/5/17  
DIRECTOR OF PUBLIC WORKS DATE

*Marcus E. Butler* 6/5/17  
CHIEF, BUREAU OF ENGINEERING DATE

*Chris Slaf* 6/5/17  
CHIEF, BUREAU OF UTILITIES DATE

*Paul Sheu* 6.2.17  
CHIEF, UTILITY DESIGN DIVISION DATE

**GMB**  
GEORGE, MILES & BUHR, LLC  
ARCHITECTS & ENGINEERS  
SALISBURY - BALTIMORE - SEAFORD  
www.gmbnet.com

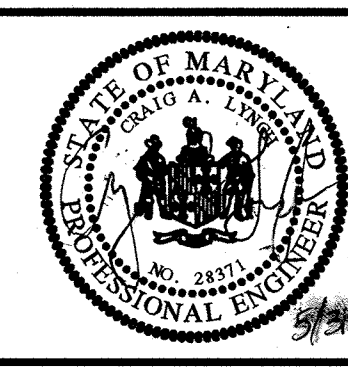

DES: J.B.	CEI 1	REVISE PER STREAM GEOMORPH CHANGES
	CEI 2	REVISE PER DPW ARMORING REQUESTED CHANGES
DRN: D.Y.		
CHK: C.L.		
DATE: 5/31/17	BY: NO.	REVISION










**STREAM SLOPE STABILIZATION  
EROSION & SEDIMENT  
CONTROL PLAN**

600 SCALE MAP NO. 25 BLOCK NO. 8

**SYLVAN LANE  
INTERCEPTOR SEWER IMPROVEMENTS**  
CONTRACT NO. 10-4915  
2ND ELECTION DISTRICT  
HOWARD COUNTY, MARYLAND

SCALE AS SHOWN  
SHEET 6 OF 12



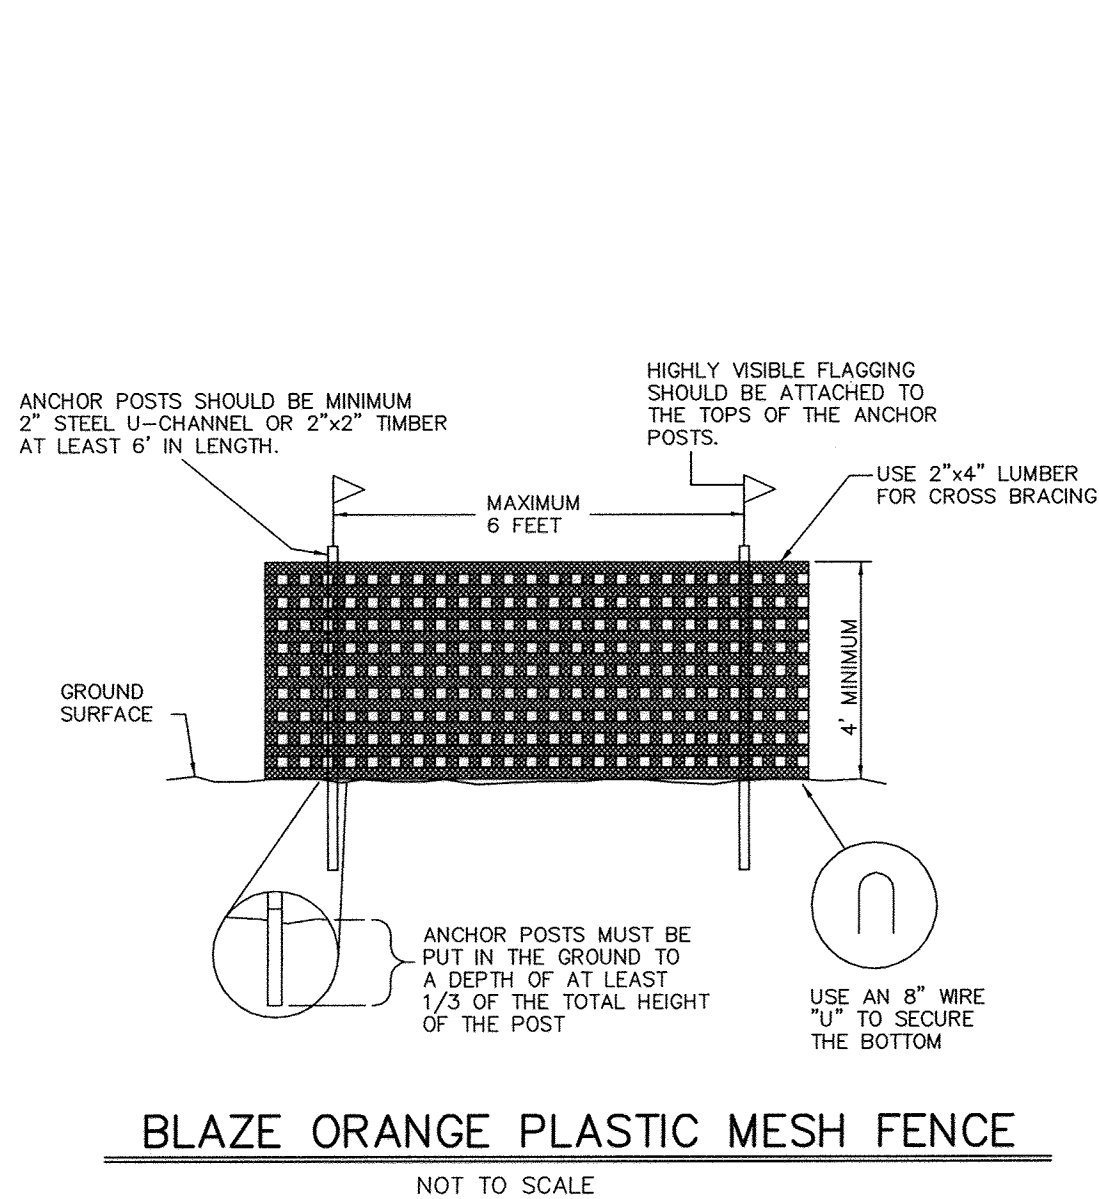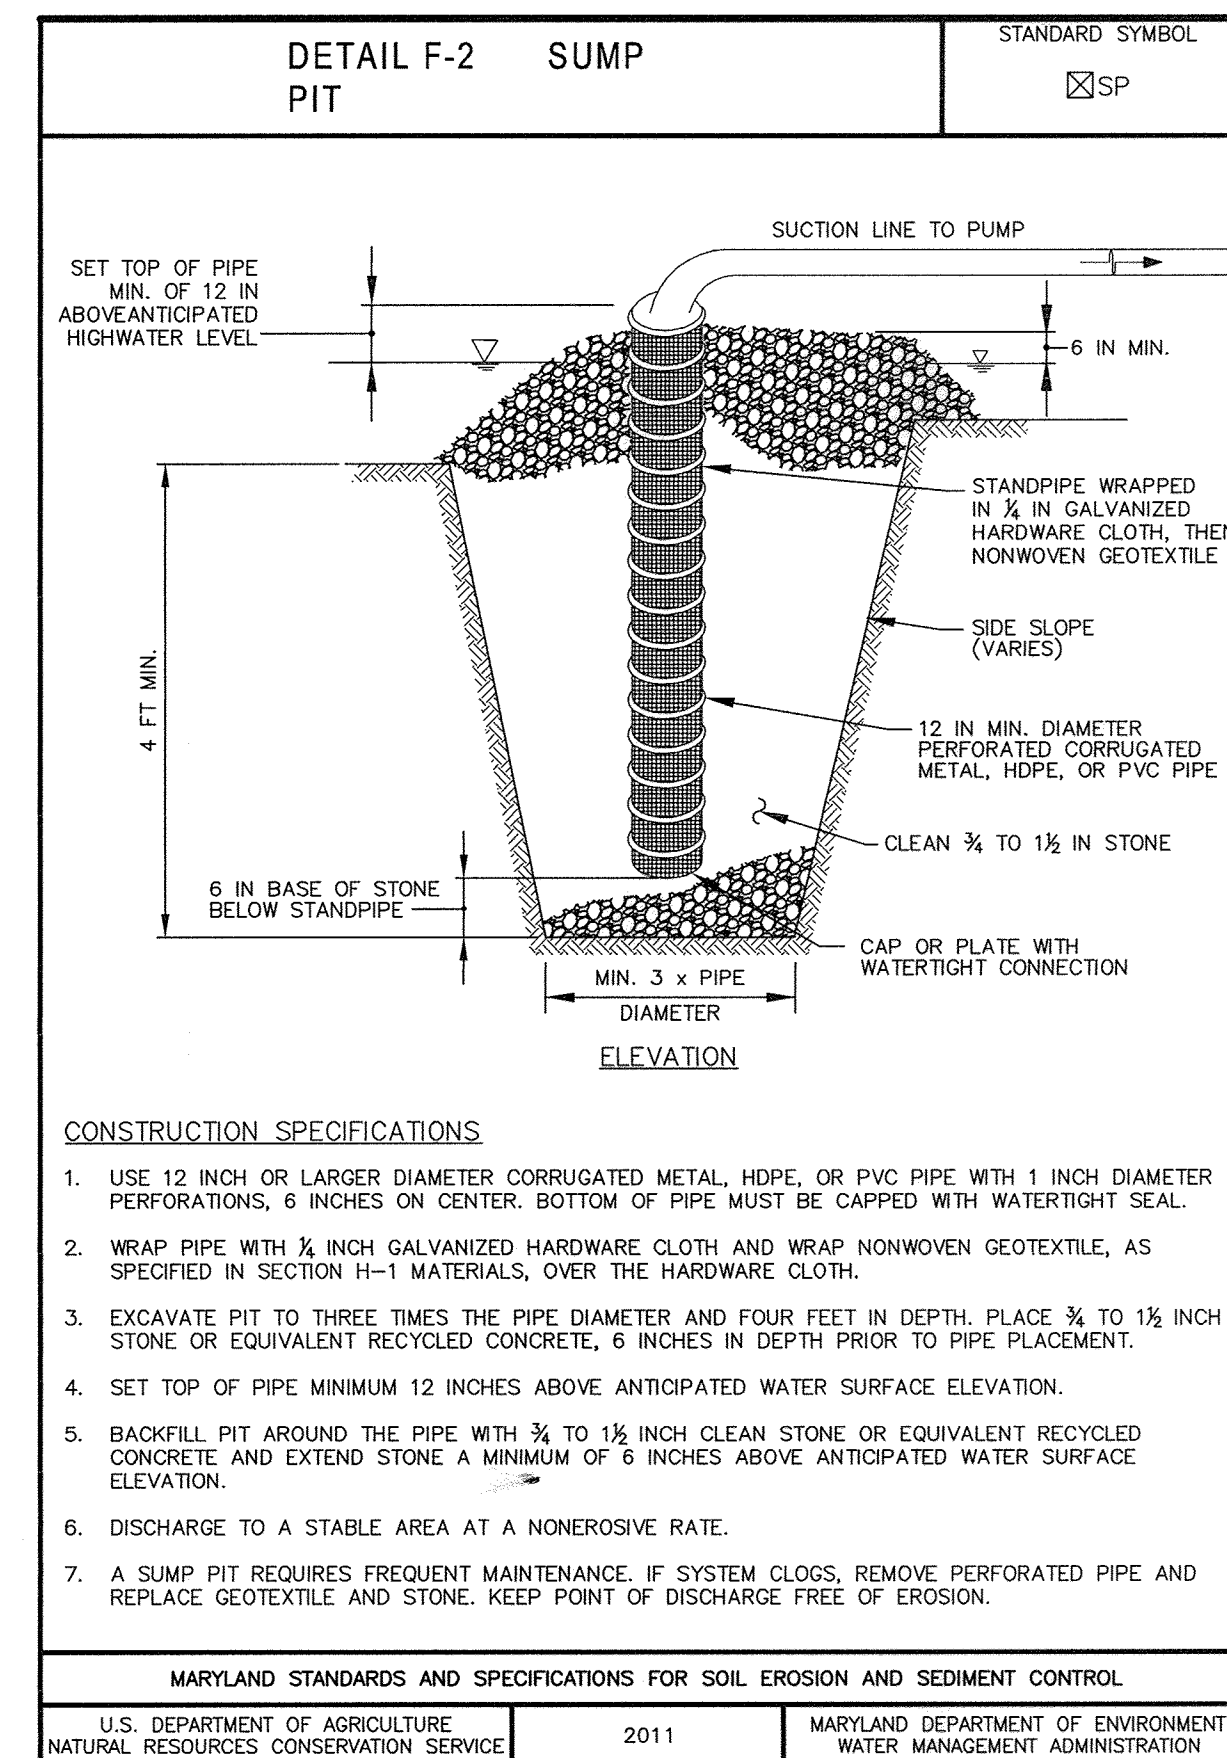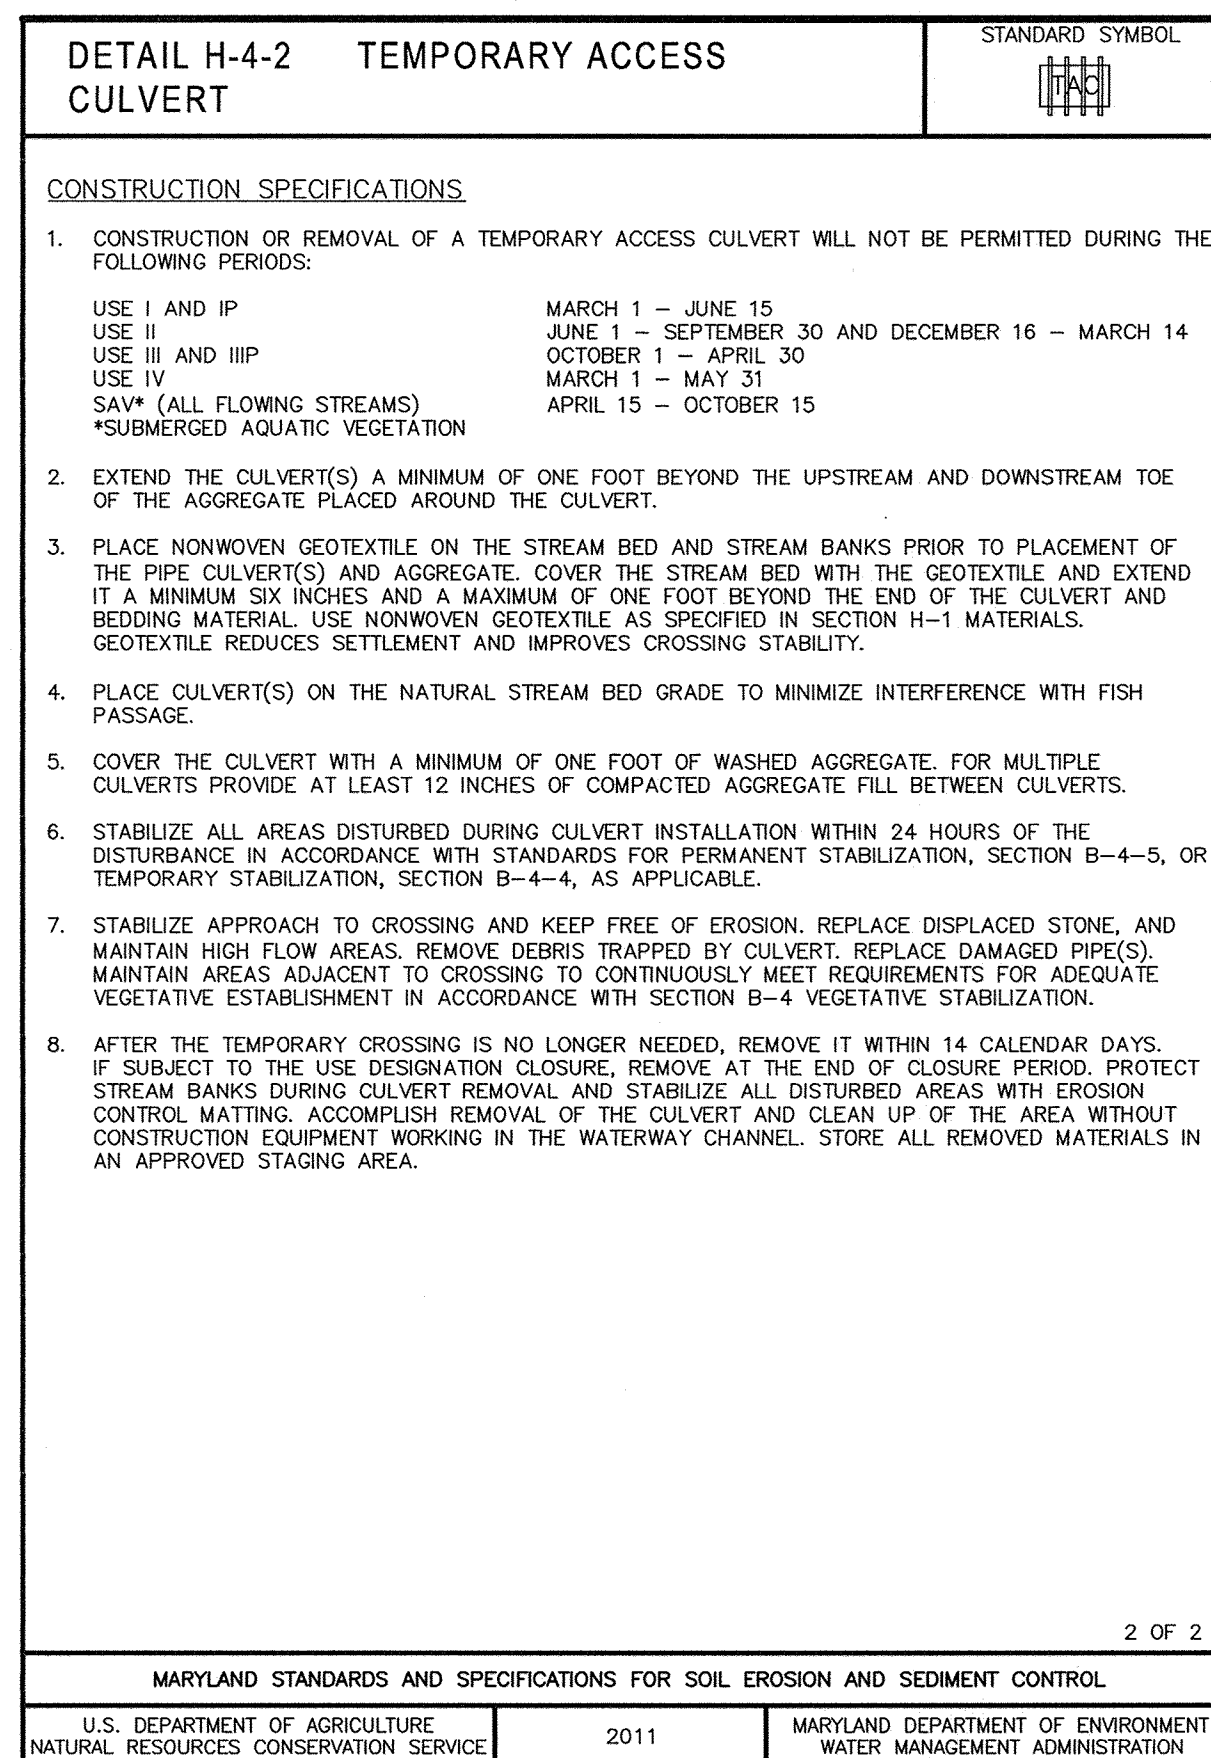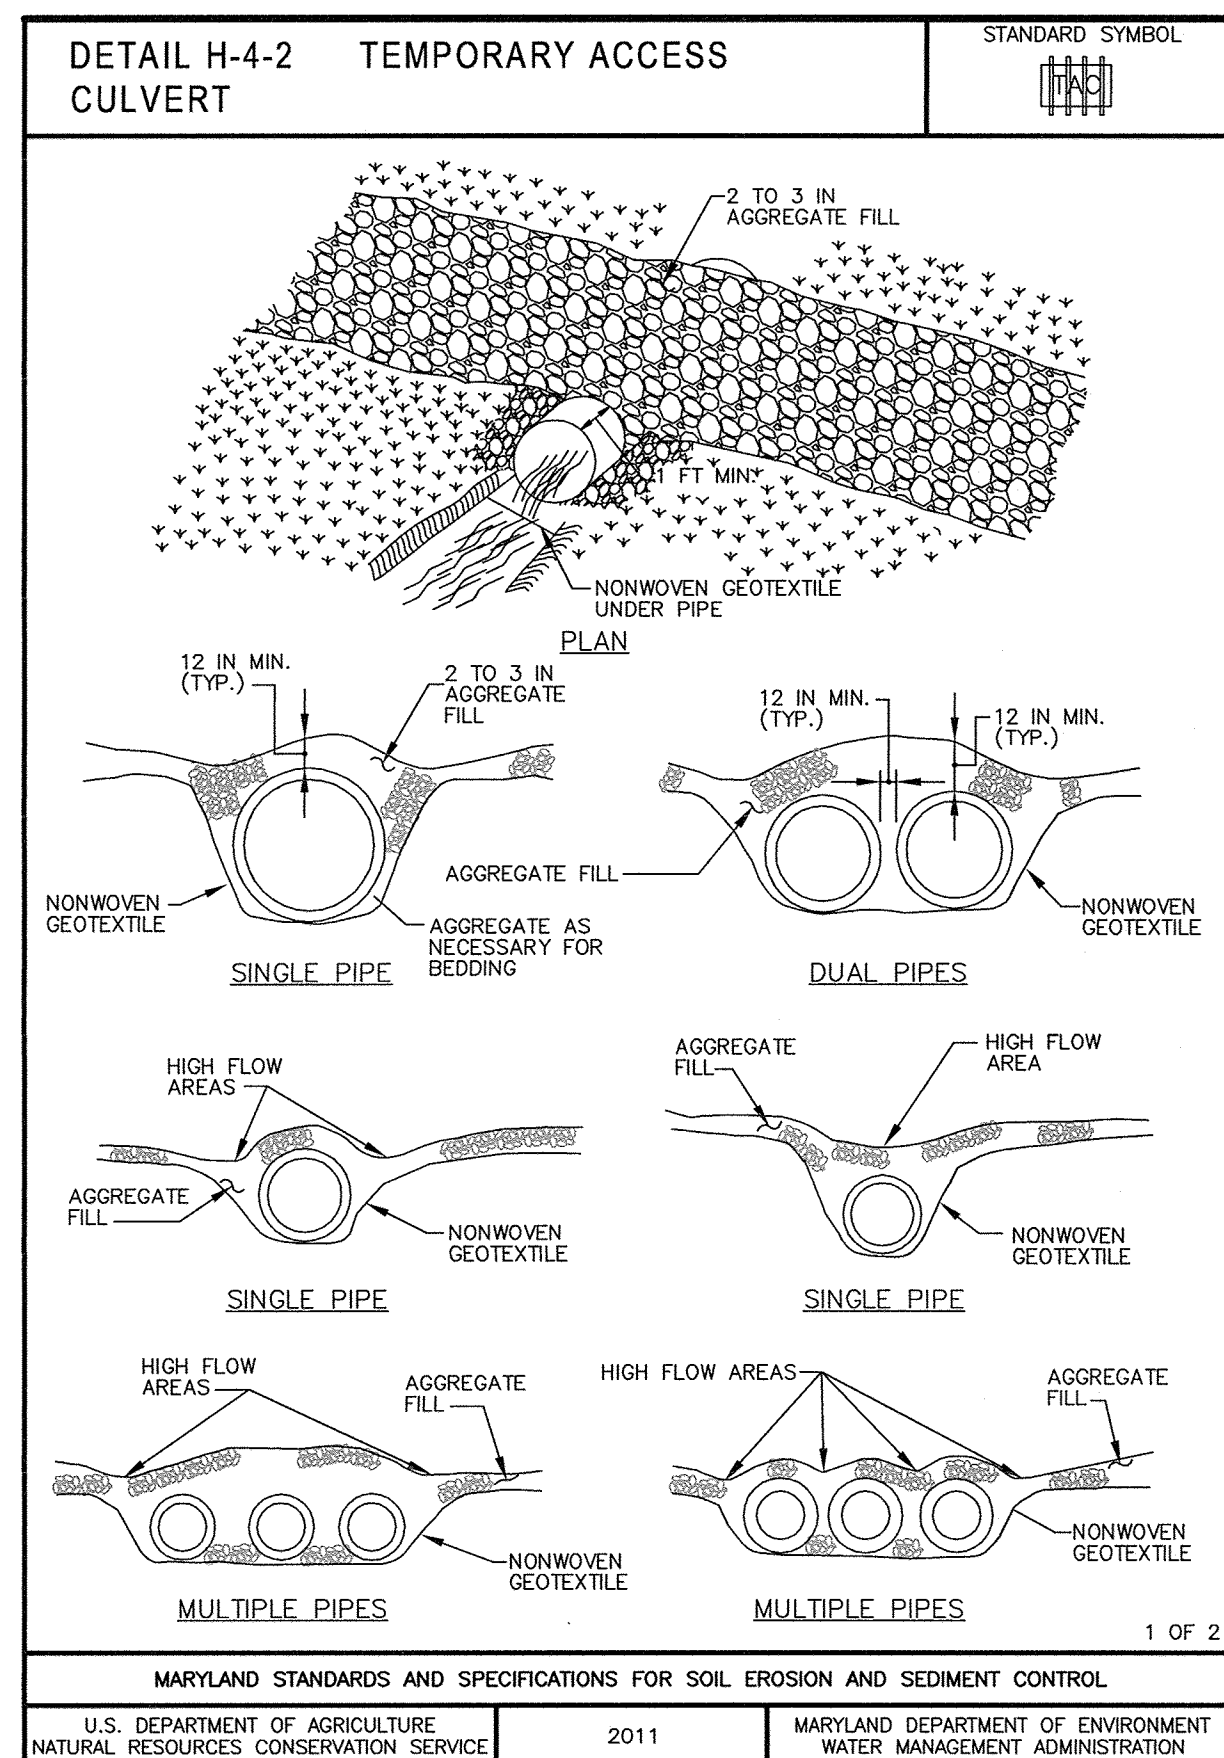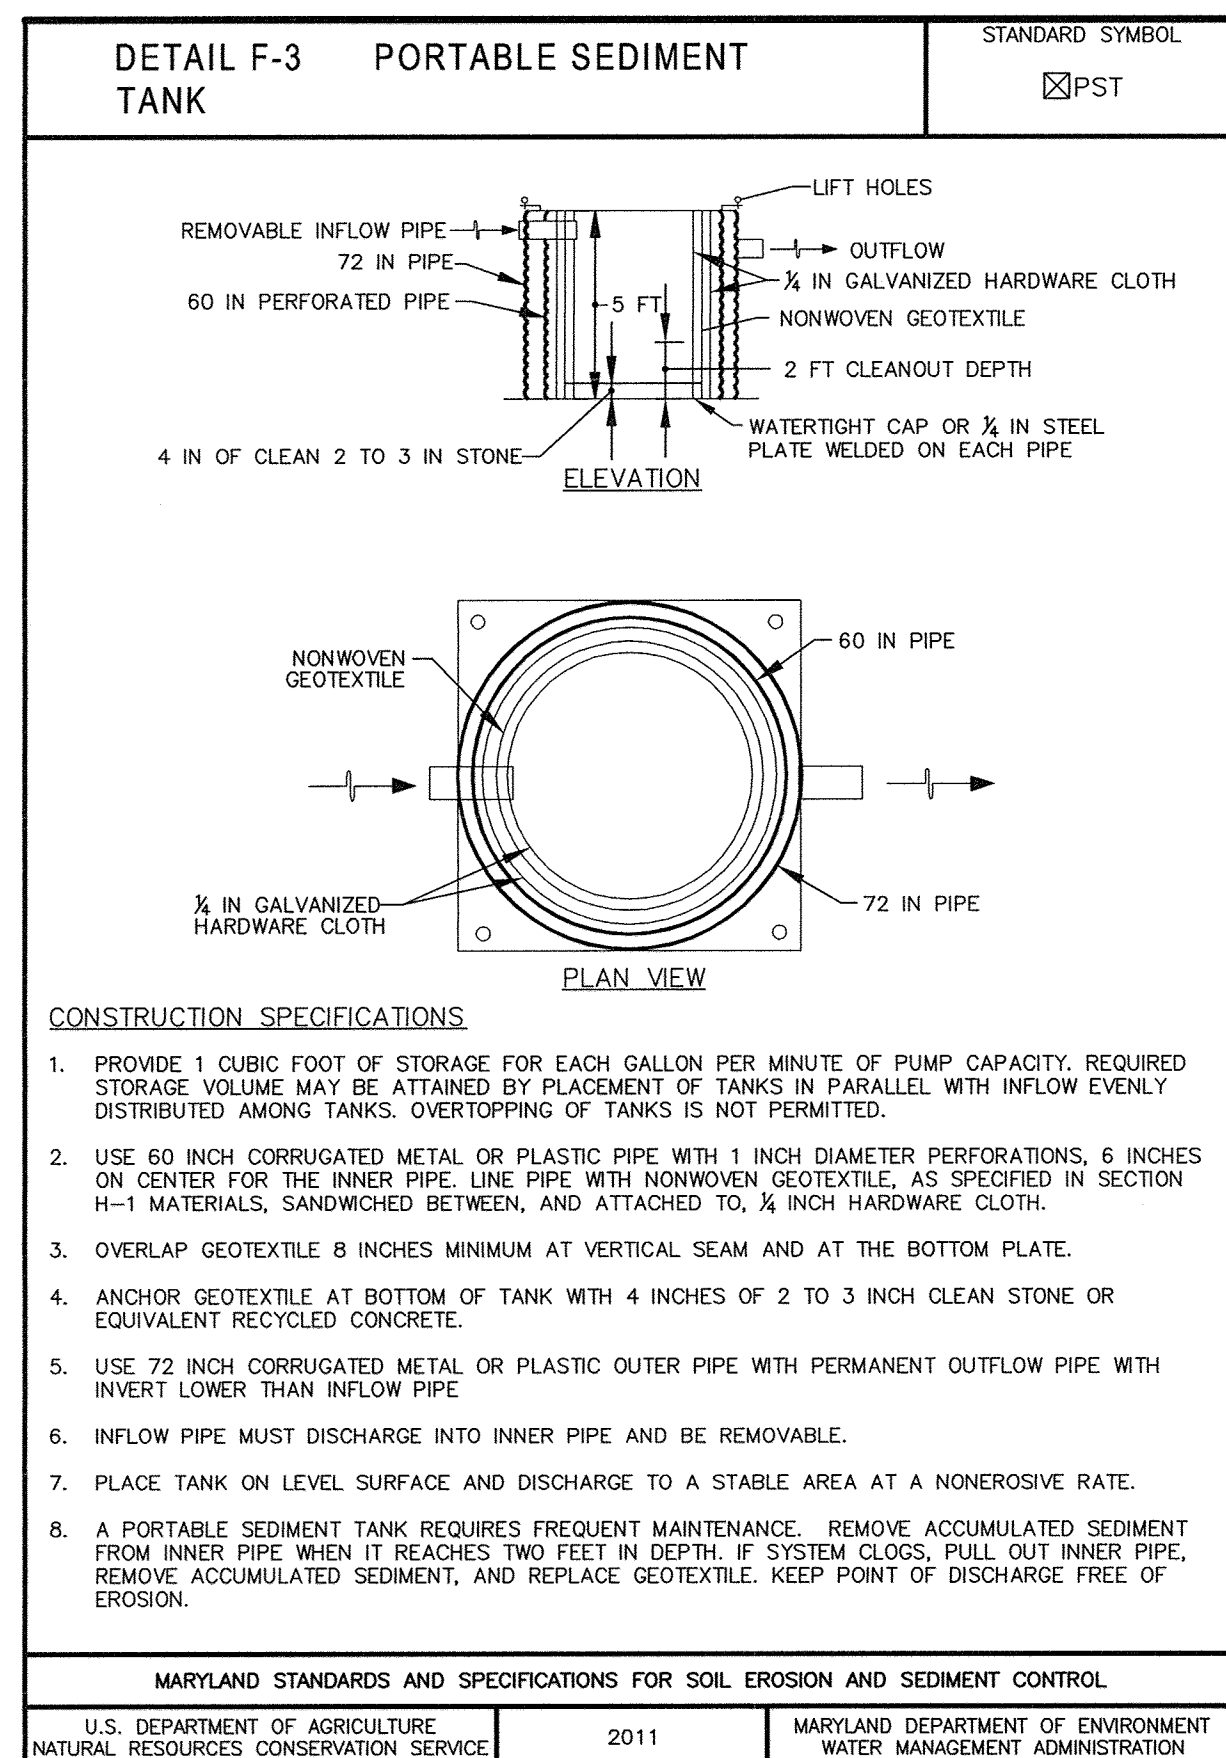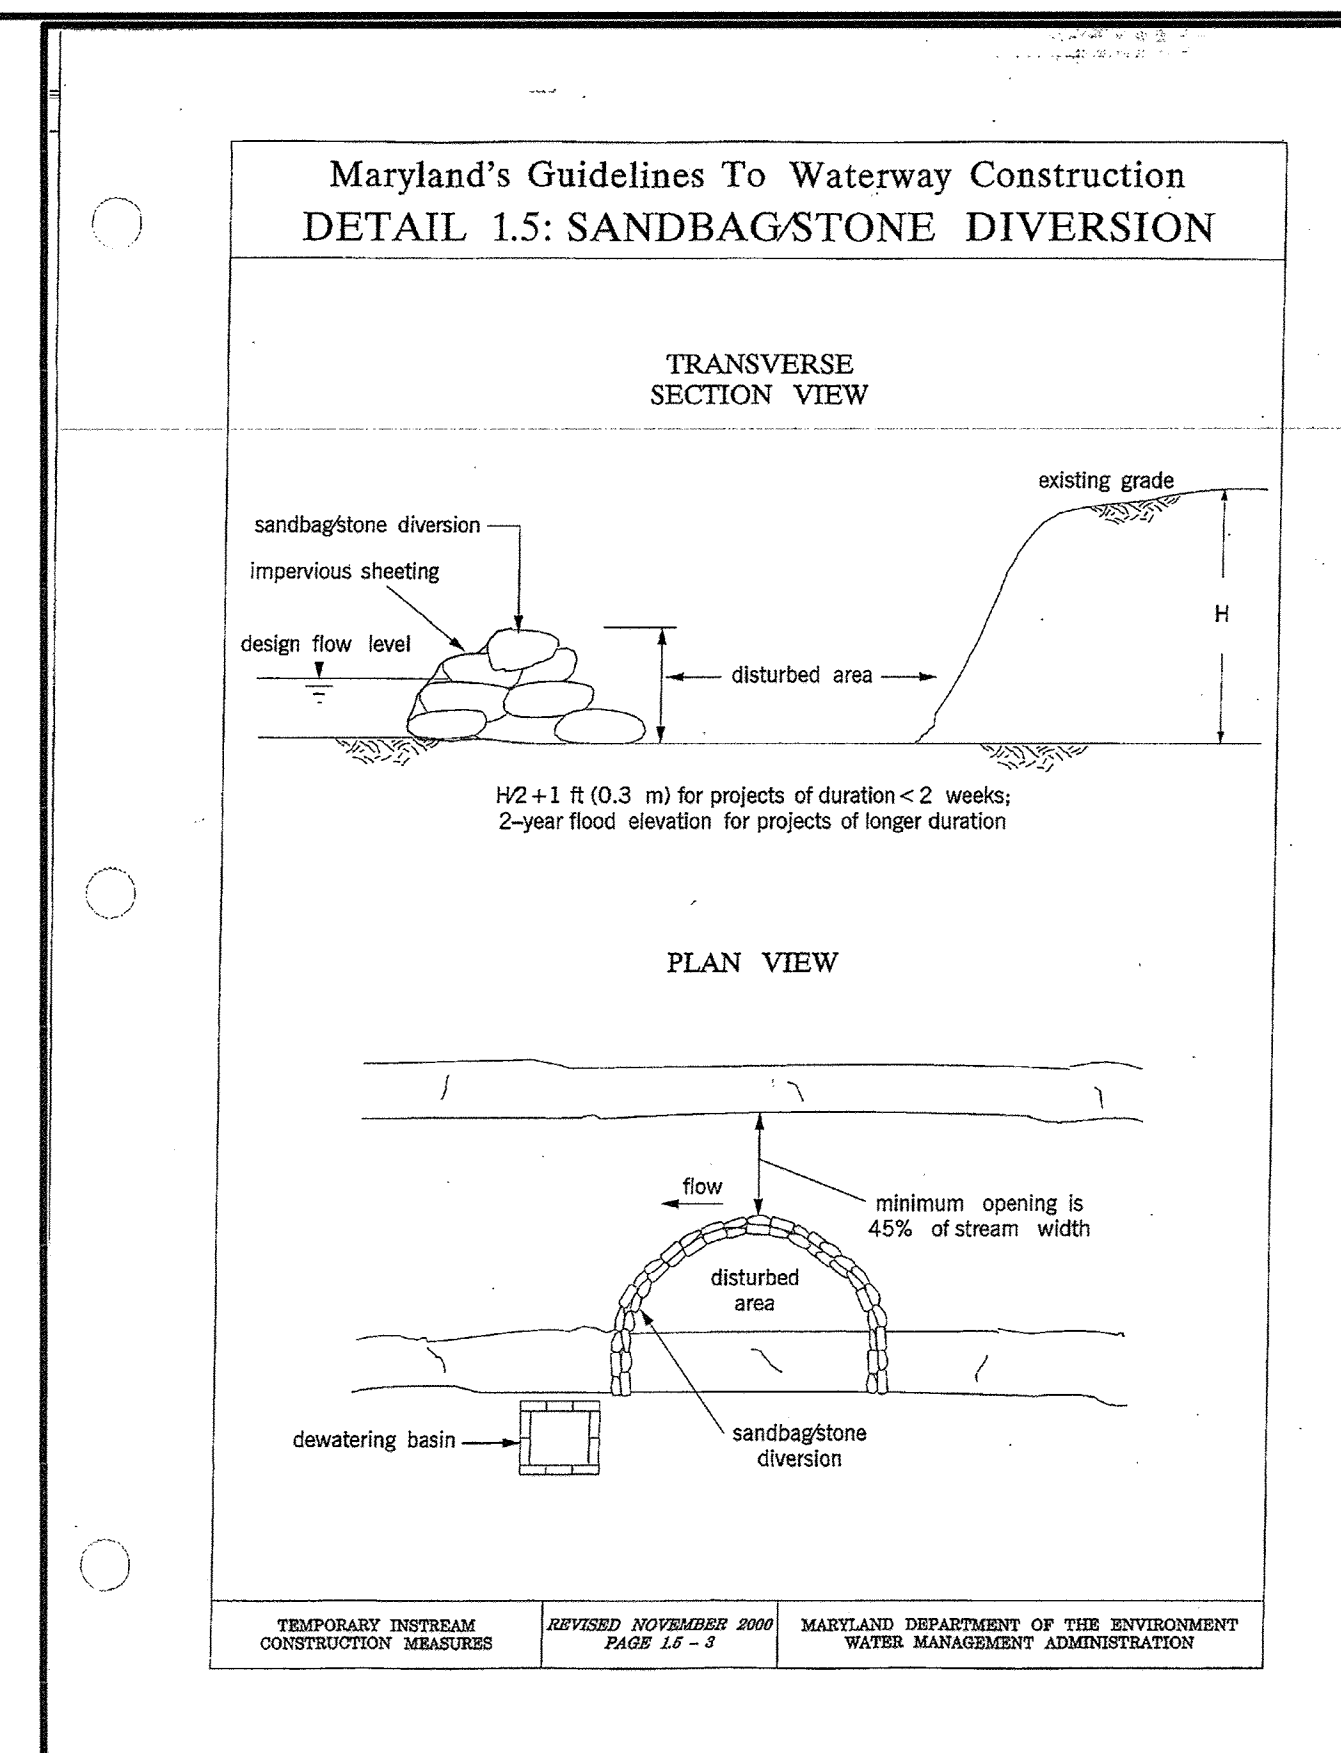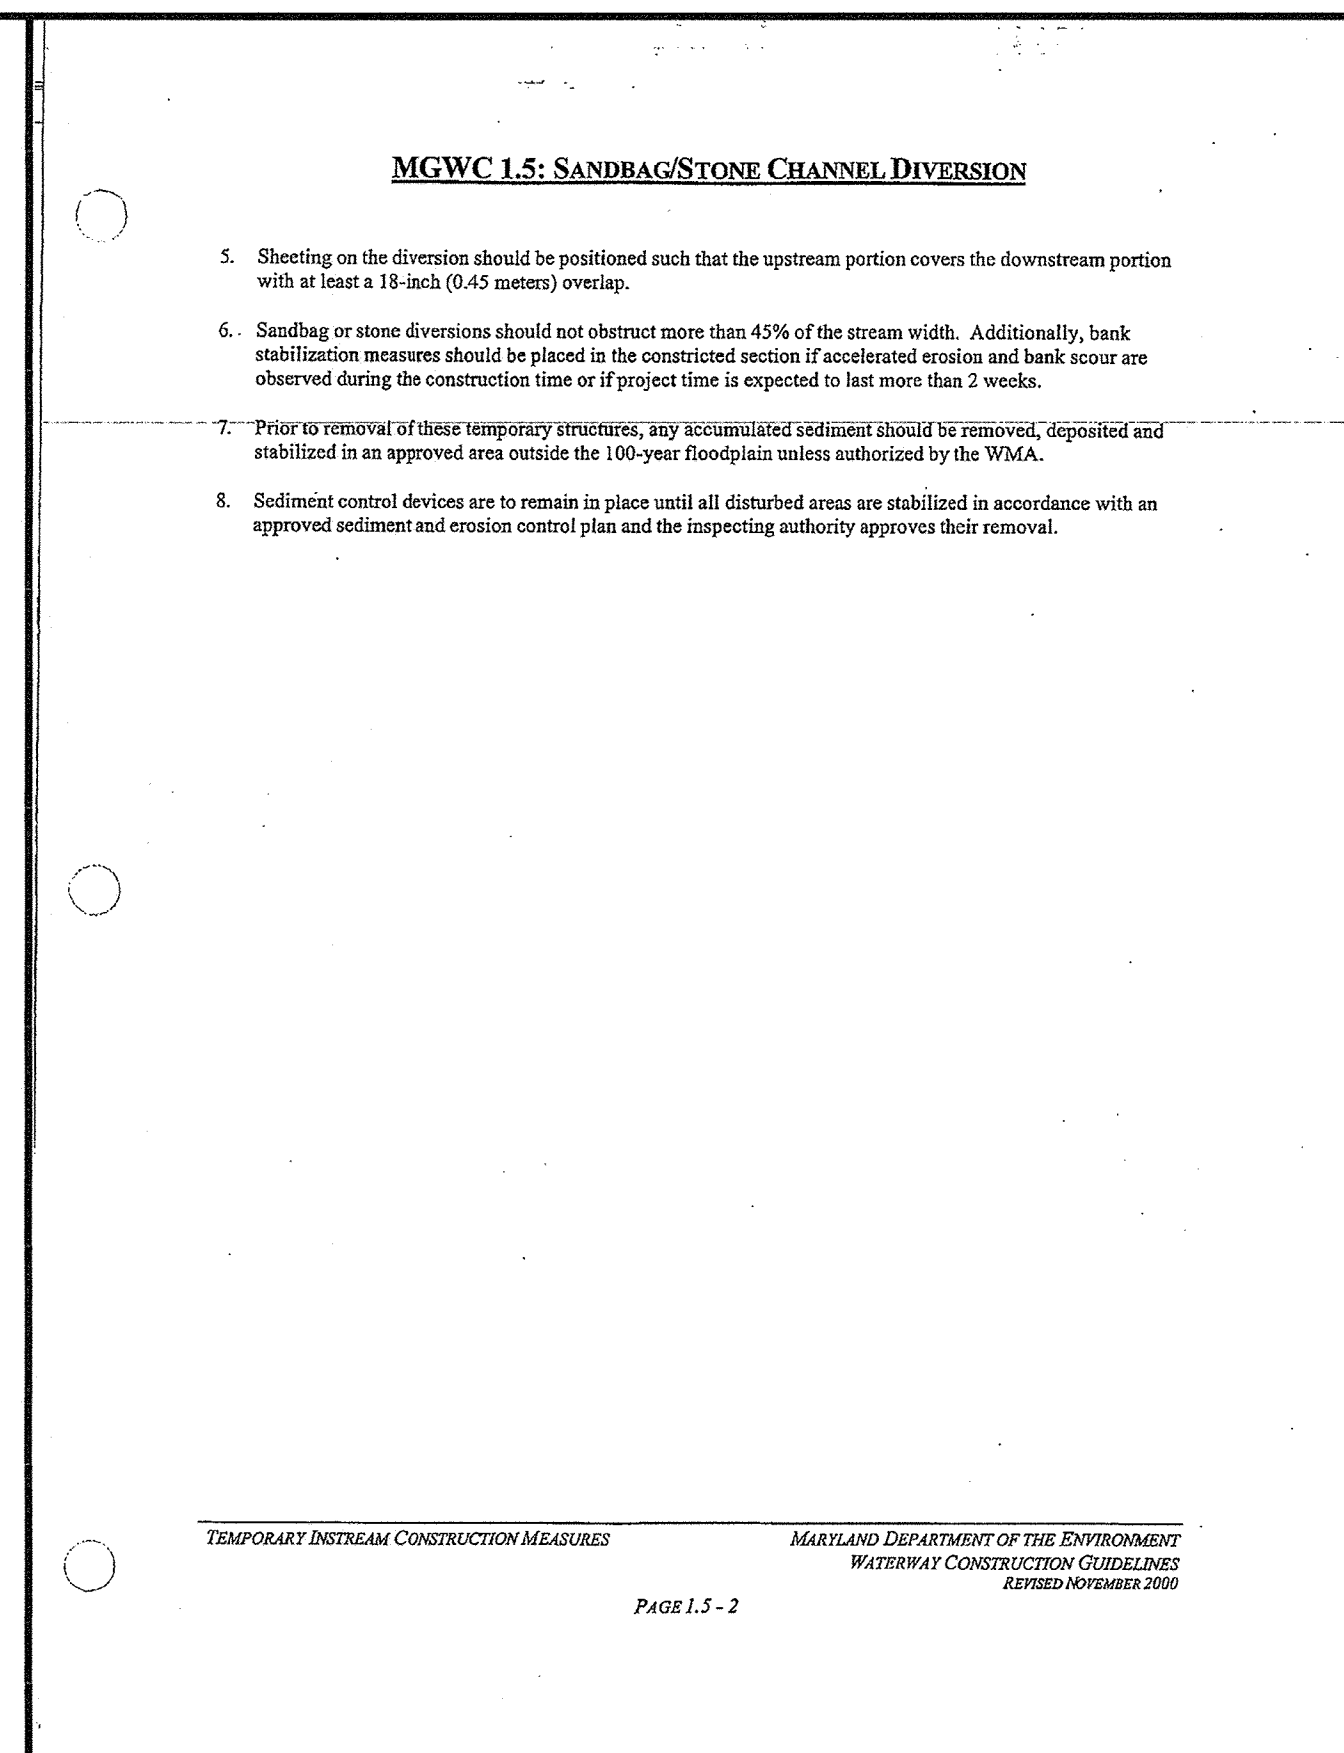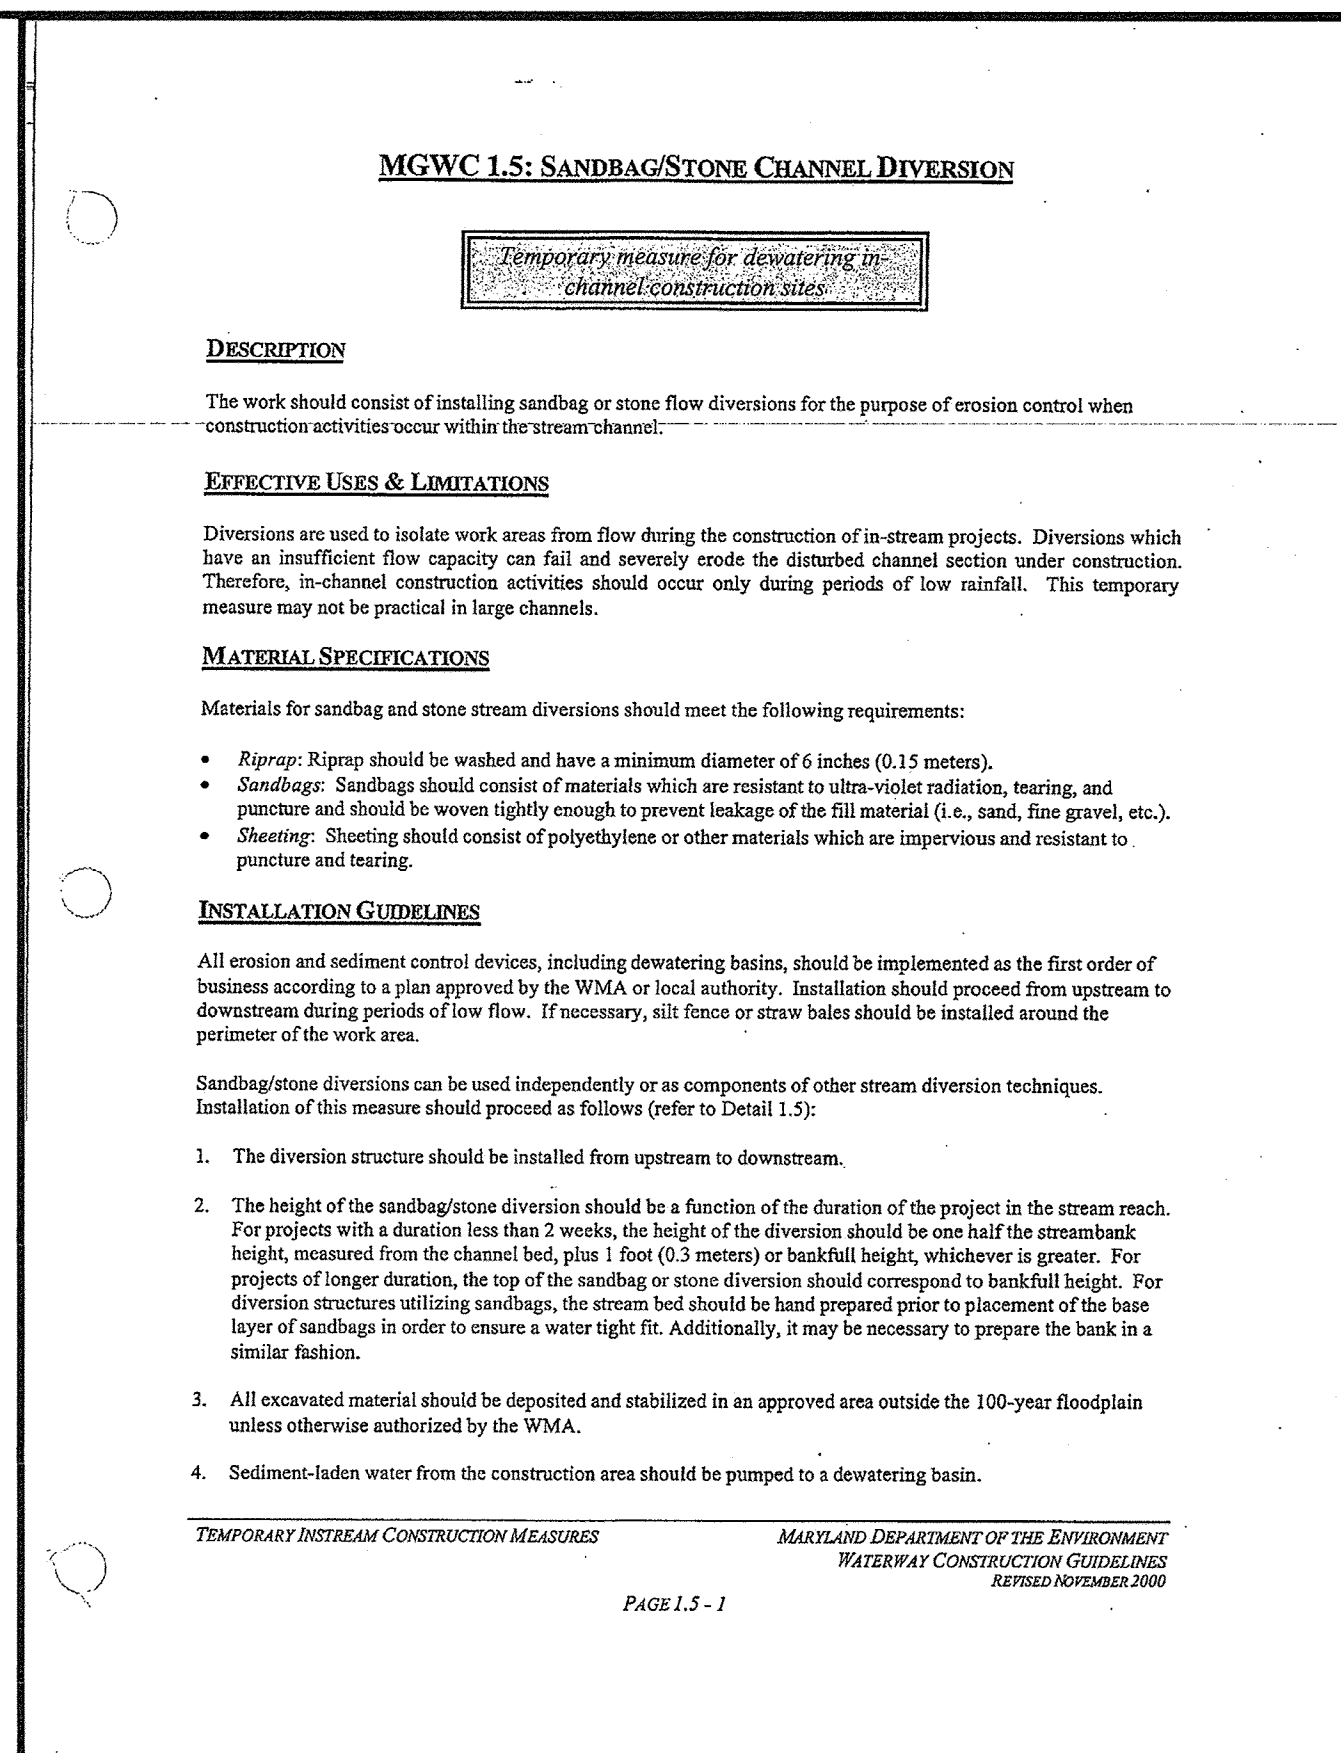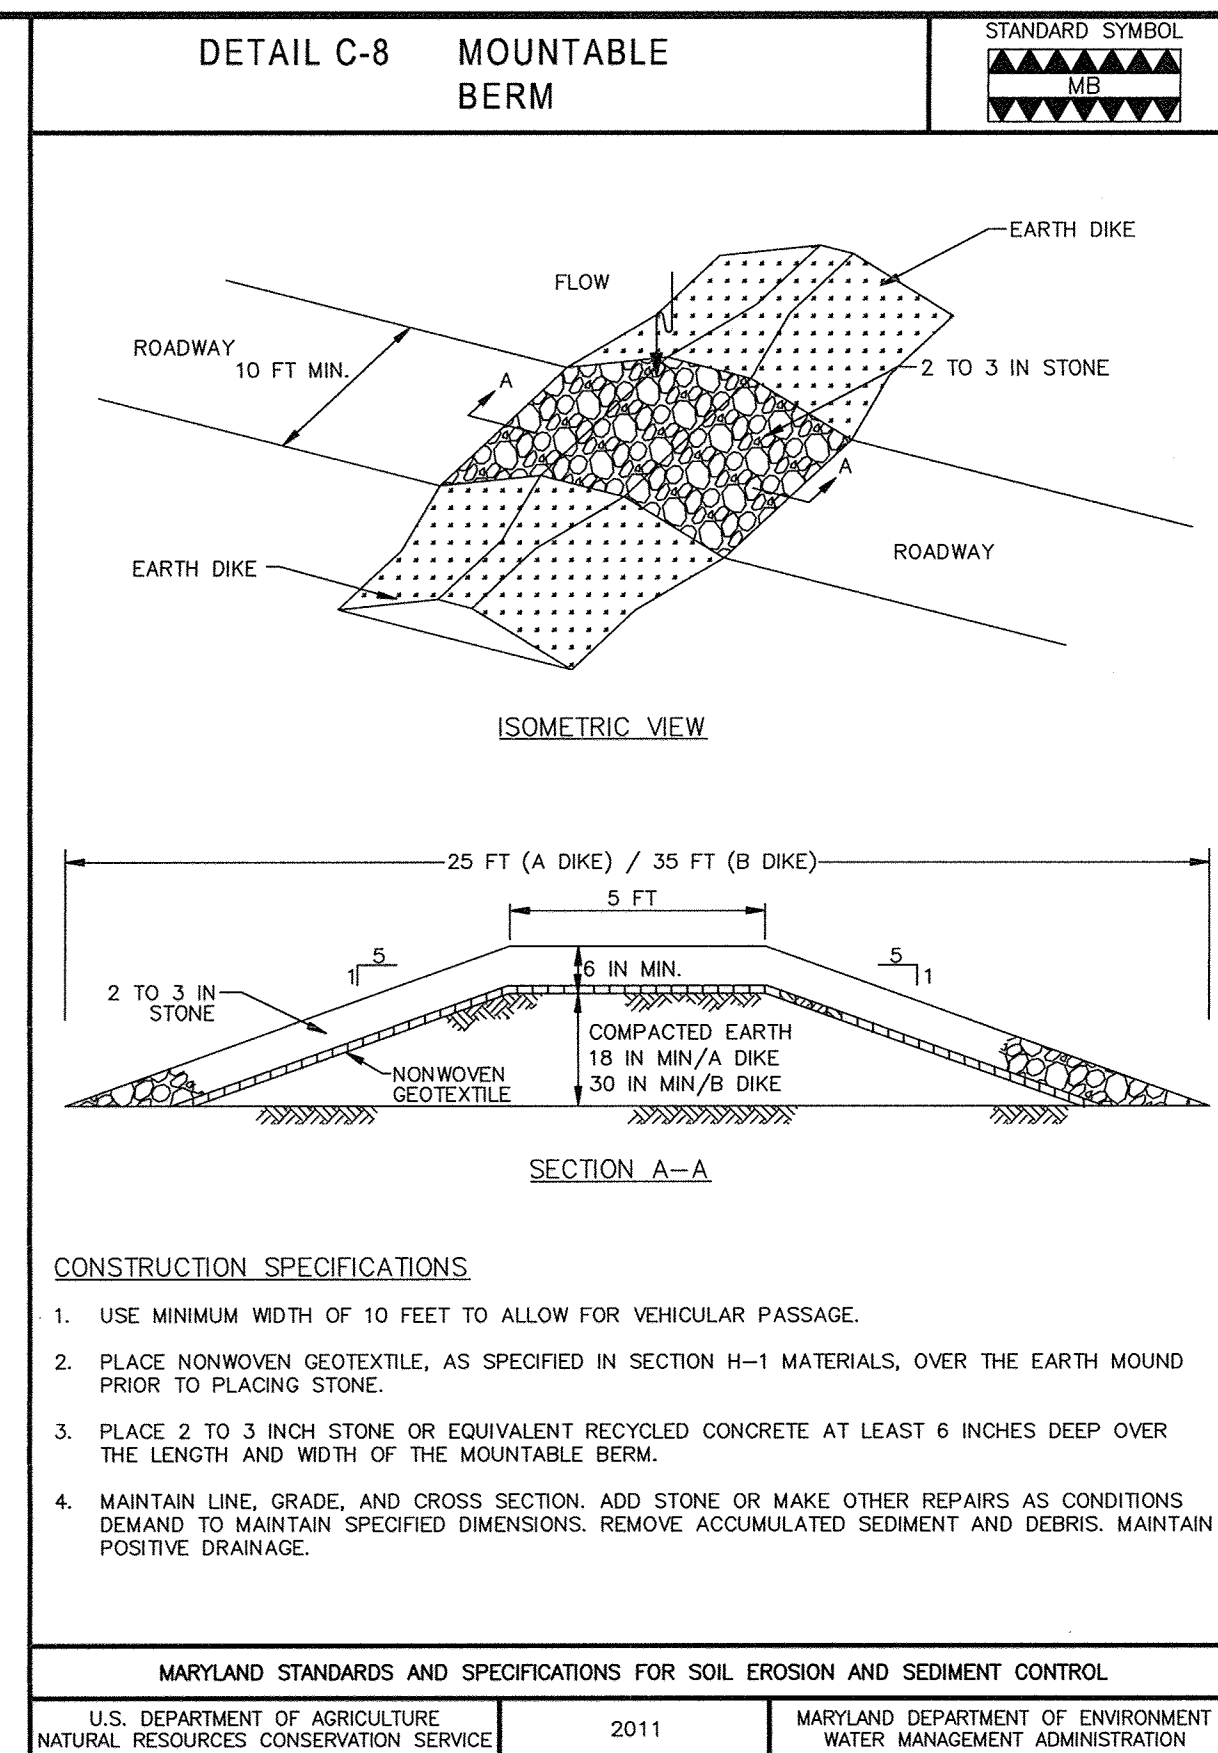

DEPARTMENT OF PUBLIC WORKS  
HOWARD COUNTY, MARYLAND

Director of Public Works: *John A. Glavin* DATE: *6/5/17*

Chief, Bureau of Engineering: *Morgan E. Buttle* DATE: *6/5/17*

Chief, Bureau of Utilities: *Paul J. Blum* DATE: *6-8-17*

**GMB**  
GEORGE, MILES & BUHR, LLC  
ARCHITECTS & ENGINEERS  
SALISBURY • BALTIMORE • SEAFORD  
www.gmbnet.com

Professional Engineer Seal: *George Miles*

DES: D.A.V.  
DRN: M.A.D.  
CHK: W.B.F.  
DATE: 05/17

BY NO. REVISION DATE

**EROSION AND SEDIMENT CONTROL DETAILS**

600 SCALE MAP NO. 25 BLOCK NO. 8

SYLVAN LANE  
INTERCEPTOR SEWER IMPROVEMENTS  
CONTRACT NO. 10-4915  
2ND ELECTION DISTRICT  
HOWARD COUNTY, MARYLAND

SCALE AS SHOWN  
SHEET 7 OF 12

C:\DRAWINGS\30-41-TIBER SUCKER BRANCH INTERCEPTOR SEWER IMPROVEMENTS\CURRENT\SYNER\Level C-08-ESC-DETAIL.cwg, 6/7/2017 12:31:28 PM, HP Designer, T:\30-PS-M\m\p\c







**B-4 STANDARDS AND SPECIFICATIONS**

**FOR**

**VEGETATIVE STABILIZATION**

**Definition**

Using vegetation as cover to protect exposed soil from erosion.

**Purpose**

To promote the establishment of vegetation on exposed soil.

**Conditions Where Practice Applies**

On all disturbed areas not stabilized by other methods. This specification is divided into sections on incremental stabilization, soil preparation, soil amendments and topsoiling, seeding and mulching, temporary stabilization, and permanent stabilization.

**Effects on Water Quality and Quantity**

Stabilization practices are used to promote the establishment of vegetation on exposed soil. When soil is stabilized with vegetation, the soil is less likely to erode and more likely to allow infiltration of rainfall, thereby reducing sediment loads and runoff to downstream areas.

Planting vegetation in disturbed areas will have an effect on the water budget, especially on volumes and rates of runoff, infiltration, evaporation, transpiration, percolation, and groundwater recharge. Over time, vegetation will increase organic matter content and improve the water holding capacity of the soil and subsequent plant growth.

Vegetation will help reduce the movement of sediment, nutrients, and other chemicals carried by runoff to receiving waters. Plants will also help protect groundwater supplies by assimilating those substances present within the root zone.

**Sediment control practices must remain in place during grading, seedbed preparation, seeding, mulching, and vegetative establishment.**

**Adequate Vegetative Establishment**

Inspect seeded areas for vegetative establishment and make necessary repairs, replacements, and reseedings within the planting season.

1. Adequate vegetative stabilization requires 95 percent groundcover.
2. If an area has less than 40 percent groundcover, reestablish following the original recommendations for time, fertilizer, seedbed preparation, and seeding.
3. If an area has between 40 and 94 percent groundcover, over-seed and fertilize using half of the rates originally specified.
4. Maintenance fertilizer rates for permanent seeding are shown in Table B.6.

**B-4.1 STANDARDS AND SPECIFICATIONS**

**FOR**

**INCREMENTAL STABILIZATION**

**Definition**

Establishment of vegetative cover on cut and fill slopes.

**Purpose**

To provide timely vegetative cover on cut and fill slopes as work progresses.

**Conditions Where Practice Applies**

Any cut or fill slope greater than 15 feet in height. This practice also applies to stockpiles.

**Criteria**


1. Incremental Stabilization - Cut Slopes
  - a. Excavate and stabilize cut slopes in increments not to exceed 15 feet in height. Prepare seedbed and apply seed and mulch on all cut slopes as the work progresses.
  - b. Construction sequence example (Refer to Figure B.1):
    1. Construct and stabilize all temporary berms or dikes that will be used to convey runoff around the excavation.
    2. Perform Phase 1 excavation, prepare seedbed, and stabilize.
    3. Perform Phase 2 excavation, prepare seedbed, and stabilize. Overseed Phase 1 areas as necessary.
    4. Perform final phase excavation, prepare seedbed, and stabilize. Overseed previously seeded areas as necessary.
2. Note: Once excavation has begun the operation should be continuous from grubbing through the completion of grading and placement of topsoil (if required) and permanent seed and mulch. Any interruptions in the operation or completing the operation out of the seeding season will necessitate the application of temporary stabilization.

**Incremental Stabilization - Fill Slopes**


1. Construct and stabilize fill slopes in increments not to exceed 15 feet in height. Prepare seedbed and apply seed and mulch on all slopes as the work progresses.
2. Stabilize slopes immediately when the vertical height of a fill reaches 15 feet or when the grading operation ceases as prescribed in the plans.
3. At the end of each day, install temporary water conveyance practice(s), as necessary, to intercept surface runoff and convey it down the slope in a non-erosive manner.
4. Construction sequence example (Refer to Figure B.2):
  - a. Construct and stabilize all temporary berms or dikes that will be used to divert runoff around the fill. Construct silt fence or low side of fill unless other methods shown on the plans address this area.
  - b. At the end of each day, install temporary water conveyance practice(s), as necessary, to intercept surface runoff and convey it down the slope in a non-erosive manner.
  - c. Place Phase 1 fill, prepare seedbed, and stabilize.
  - d. Place Phase 2 fill, prepare seedbed, and stabilize.
  - e. Place final phase fill, prepare seedbed, and stabilize. Overseed previously seeded areas as necessary.

**Note:** Once the placement of fill has begun the operation should be continuous from grubbing through the completion of grading and placement of topsoil (if required) and permanent seed and mulch. Any interruptions in the operation or completing the operation out of the seeding season will necessitate the application of temporary stabilization.

**Figure B.1: Incremental Stabilization - Cut**

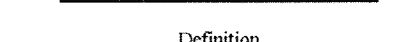

**Figure B.2: Incremental Stabilization - Fill**

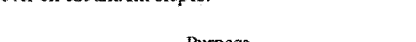

**B-4.2 STANDARDS AND SPECIFICATIONS**

**FOR**

**SOIL PREPARATION, TOPSOILING, AND SOIL AMENDMENTS**

**Definition**

The process of preparing the soils to sustain adequate vegetative stabilization.

**Purpose**

To provide a suitable soil medium for vegetative growth.

**Conditions Where Practice Applies**

Where vegetative stabilization is to be established.

**Criteria**

1. Soil Preparation
  1. Temporary Stabilization
    - a. Seedbed preparation consists of loosening soil to a depth of 3 to 5 inches by means of suitable agricultural or construction equipment, such as disc harrows or chisel plows or ripper mounted on construction equipment. After the soil is loosened, it must be rolled or dragged smooth but left in the roughened condition. Slopes 3:1 or flatter are to be tracked with ridges running parallel to the contour of the slope.
    - b. Apply fertilizer and lime as prescribed on the plans.
    - c. Incorporate lime and fertilizer into the top 3 to 5 inches of soil by disk or other suitable means.
  2. Permanent Stabilization
    - a. A soil test is required for any earth disturbance of 5 acres or more. The minimum soil conditions required for permanent vegetative establishment are:
      - i. Soil pH between 6.0 and 7.0.
      - ii. Soluble salts less than 500 parts per million (ppm).
      - iii. Soil contains less than 40 percent clay but enough fine grained material (greater than 30 percent silt plus clay) to provide the capacity to hold a moderate amount of moisture. An exception: if loess will be planted, then a sandy soil (less than 30 percent silt plus clay) would be acceptable.
      - iv. Soil contains 1.5 percent minimum organic matter by weight.
      - v. Soil contains sufficient pore space to permit adequate root penetration.
    - b. Application of amendments or topsoil is required if on-site soils do not meet the above conditions.
    - c. Graded areas must be maintained in a true and even grade as specified on the approved plan, then scarified or otherwise loosened to a depth of 3 to 5 inches.
    - d. Apply soil amendments as specified on the approved plan or as indicated by the results of a soil test.
    - e. Mix soil amendments into the top 3 to 5 inches of soil by disk or other suitable means. Rake lawn areas to smooth the surface, remove large objects like stones and trunks, and ready the area for seed application. Loosen surface soil by dragging with a heavy chain or other equipment to roughen the surface where site conditions will not permit normal seedbed preparation. Track slopes 3:1 or flatter with tracked equipment leaving the soil in an irregular condition with ridges running parallel to the contour of the slope. Leave the top 1 to 3 inches of soil loose and friable. Seedbed loosening may be unnecessary on newly disturbed areas.
2. Topsoiling
  1. Topsoil is placed over prepared subsoil prior to establishment of permanent vegetation. The purpose is to provide a suitable soil medium for vegetative growth. Soils of concern have low moisture content, low nutrient levels, low pH, materials toxic to plants, and/or unacceptable soil gradation.
  2. Topsoil salvaged from an existing site may be used provided it meets the standards set forth in these specifications. Typically, the depth of topsoil to be salvaged for a given soil type can be found in the representative soil profile section in the Soil Survey published by USDA-NRCS.
  3. Topsoiling is limited to areas having 2:1 or flatter slopes where:
    - a. The texture of the exposed subsoil/parent material is not adequate to produce vegetative growth.
    - b. The soil material is so shallow that the rooting zone is not deep enough to support plants or furnish containing supplies of moisture and plant nutrients.
    - c. The original soil to be vegetated contains material toxic to plant growth.
    - d. The soil is so acidic that treatment with limestone is not feasible.
  4. Areas having slopes steeper than 2:1 require special consideration and design.
  5. Topsoil Specifications: Soil to be used as topsoil must meet the following criteria:
    - a. Topsoil must be a loam, sandy loam, clay loam, silt loam, sandy clay loam, or loamy sand. Other soils may be used if recommended by an agronomist or soil scientist and approved by the appropriate approval authority. Topsoil must not be a mixture of contrasting textured subsoils and must contain less than 5 percent by volume of cinders, stones, slag, coarse fragments, gravel, sticks, roots, trash, or other materials larger than 1 1/2 inches in diameter.
    - b. Topsoil must be free of noxious plants or plant parts such as Bermuda grass, quack grass, Johnson grass, nut sedge, poison ivy, thistle, or others as specified.
    - c. Topsoil substitutes or amendments, as recommended by a qualified agronomist or soil scientist and approved by the appropriate approval authority, may be used in lieu of natural topsoil.
  6. Topsoil Application
    - a. Erosion and sediment control practices must be maintained when applying topsoil.
    - b. Uniformly distribute topsoil in a 5 to 8 inch layer and lightly compact to a minimum thickness of 4 inches. Spreading is to be performed in such a manner that sodding or seeding can proceed with a minimum of additional soil preparation and tillage. Any irregularities in the surface resulting from topsoiling or other operations must be corrected in order to prevent the formation of depressions or water pockets.
    - c. Topsoil must not be placed if the topsoil or subsoil is in a frozen or muddy condition, when the subsoil is excessively wet or in a condition that may otherwise be detrimental to proper grading and seedbed preparation.
3. Soil Amendments (Fertilizer and Lime Specifications)
  1. Soil tests must be performed to determine the exact ratios and application rates for both lime and fertilizer on sites having disturbed areas of 5 acres or more. Soil analysis may be performed by a recognized private or commercial laboratory. Soil samples taken for engineering purposes may also be used for chemical analysis.
  2. Fertilizers must be uniform in composition, free flowing and suitable for accurate application by appropriate equipment. Manure may be substituted for fertilizer with prior approval from the appropriate approval authority. Fertilizers must all be delivered to the site fully labeled according to the applicable laws and must bear the name, trade name or trademark and warranty of the producer.
  3. Lime materials must be ground limestone (hydrated or burnt lime may be substituted except when hydroseeding) which contains at least 90 percent total oxides (calcium oxide plus magnesium oxide). Limestone must be ground to such fineness that at least 90 percent will pass through a #100 mesh sieve and 98 to 100 percent will pass through a #200 mesh sieve.
  4. Lime and fertilizer are to be evenly distributed and incorporated into the top 3 to 5 inches of soil by disk or other suitable means.
  5. Where the subsoil is either highly acidic or composed of heavy clays, spread ground limestone at the rate of 4 to 8 tons/acre (200-400 pounds per 1,000 square feet) prior to the placement of topsoil.

**B-4.3 STANDARDS AND SPECIFICATIONS**

**FOR**

**SEEDING AND MULCHING**

**Definition**

The application of seed and mulch to establish vegetative cover.

**Purpose**

To protect disturbed soils from erosion during and at the end of construction.

**Conditions Where Practice Applies**

To the surface of all perimeter contours, slopes, and any disturbed area not under active grading.

**Criteria**

1. Seeding
  1. Specifications
    - a. All seed must meet the requirements of the Maryland State Seed Law. All seed must be subject to testing by a recognized seed laboratory. All seed used must have been tested within the 6 months immediately preceding the date of sowing such material on any project. Refer to Table B.4 regarding the quality of seed. Seed tags must be available upon request to the inspector to verify type of seed and seeding rate.
    - b. Mulch alone may be applied between the fall and spring seeding dates only if the ground is frozen. The appropriate seeding mixture must be applied when the ground thaws.
    - c. Inoculants: The inoculant for treating legume seed in the seed mixtures must be a pure culture of nitrogen fixing bacteria prepared specifically for the species. Inoculants must not be used later than the date indicated on the container. Add fresh inoculants as directed on the package. Use four times the recommended amount when hydroseeding. Nitrogen is very important to keep inoculant as cool as possible until use. Temperatures above 75 to 80 degrees Fahrenheit can weaken bacteria and make the inoculant less effective.
    - d. Soil or seed must not be placed on soil which has been treated with soil sterilants or chemicals used for weed control until sufficient time has elapsed (14 days min.) to permit dissipation of phytotoxic materials.
  2. Application
    - a. Dry Seeding: This includes use of conventional drop or broadcast spreaders.
      - i. Incorporate seed into the subsoil at the rates prescribed on Temporary Seeding Table B.1, Permanent Seeding Table B.3, or site-specific seeding summaries.
      - ii. Apply seed in two directions, perpendicular to each other. Apply half the seeding rate in each direction. Roll the seeded area with a weighted roller to provide good seed to soil contact.
    - b. Drill or Chiselplow Seeding: Mechanized seeders that apply and cover seed with soil.
      - i. Chiselplow seeders are required to bury the seed in such a fashion as to provide at least 1/4 inch of soil covering. Seedbed must be firm after planting.
      - ii. Apply seed in two directions, perpendicular to each other. Apply half the seeding rate in each direction.
    - c. Hydroseeding: Apply seed uniformly with hydroseeder (slurry includes seed and fertilizer).
      - i. If fertilizer is being applied at the time of seeding, the application rates should not exceed the following: nitrogen, 100 pounds per acre total of soluble nitrogen; P<sub>2</sub>O<sub>5</sub> (phosphorus), 200 pounds per acre; K<sub>2</sub>O (potassium), 200 pounds per acre.
      - ii. Lime: Use only ground agricultural limestone (up to 3 tons per acre may be applied by hydroseeding). Normally, not more than 2 tons are applied by hydroseeding at any one time. Do not use burnt or hydrated lime when hydroseeding.
      - iii. Mix seed and fertilizer on site and seed immediately and without interruption.
      - iv. When hydroseeding do not incorporate seed into the soil.
  2. Mulching
    - a. Mulch Materials (in order of preference)
      - i. Straw consisting of thoroughly threshed wheat, oat, or barley and reasonably bright in color. Straw is to be free of noxious weed seeds as specified in the Maryland Seed Law and not moldy, rotting, colored, decayed, or excessively dusty. Note: Only sterile straw mulch is areas where one species of grass is desired.
      - ii. Wood Cellulose Fiber Mulch (WCFFM) consisting of specially prepared wood cellulose processed into a uniform fibrous physical state.
        1. WCFFM is to be dyed green or contain a green dye in the package that will provide an appropriate color or facilitates visual inspection of the uniformly spread slurry.
        2. WCFFM, including dye, must contain no germination or growth inhibiting factors.
        3. WCFFM materials are to be manufactured and processed in such a manner that the wood cellulose fiber mulch will remain in uniform suspension in water under agitation and will blend with seed, fertilizer and other additives to form a homogeneous slurry. The mulch material must form a blotter-like ground cover, on application, having moisture absorption and retention properties and must cover and hold grass seeds in contact with the soil without inhibiting the growth of the grass seedlings.
        4. WCFFM material must not contain elements or compounds at concentrations levels that will be phytotoxic.
      - iii. WCFFM must conform to the following physical requirements: fiber length of approximately 10 millimeters, diameter approximately 1 millimeter, pH range of 4.0 to 8.5, ash content of 1.6 percent maximum and water holding capacity of 90 percent minimum.
    - b. Application
      1. Apply mulch to all seeded areas immediately after seeding.
      2. When straw mulch is used, spread it over all seeded areas at the rate of 2 tons per acre to a uniform loose depth of 1 to 2 inches. Apply mulch to achieve a uniform distribution and depth so that the soil surface is not exposed. When using a mulch anchoring tool, increase the application rate to 2.5 tons per acre.
      3. Wood cellulose fiber used as mulch must be applied at a net dry weight of 1500 pounds per acre. Mix the wood cellulose fiber with water to obtain a mixture with a maximum of 50 pounds of wood cellulose fiber per 100 gallons of water.
    - c. Anchoring
      1. Perform mulch anchoring immediately following application of mulch to minimize loss by wind or water. This may be done by one of the following methods (listed by preference), depending upon the size of the area and erosion hazard:
        - i. A mulch anchoring tool is a tractor drawn implement designed to punch and anchor mulch into the soil surface a minimum of 2 inches. This practice is most effective on large areas, but is limited to flatter slopes where equipment can operate safely. If used on sloping land, this practice should follow the contour.
        - ii. Wood cellulose fiber may be used for anchoring water. Apply the fiber binder at a net dry weight of 750 pounds per acre. Mix the wood cellulose fiber with water at a maximum of 50 pounds of wood cellulose fiber per 100 gallons of water.
        - iii. Synthetic binders such as Acrylic DLR (Agro-Tack), DCA-70, Petrosol, Terra Tex II, Terra Tack AR or other approved equal may be used. Follow application rates as specified by the manufacturer. Application of liquid binders needs to be heavier at the edges where wind catches mulch, such as in valleys and on crests of banks. Use of asphalt binders is strictly prohibited.
        - iv. Lightweight plastic netting may be stapled over the mulch according to manufacturer recommendations. Netting is usually available in rolls 4 to 15 feet wide and 300 to 3,000 feet long.

**B-4.4 STANDARDS AND SPECIFICATIONS**

**FOR**

**TEMPORARY STABILIZATION**

**Definition**

To stabilize disturbed soils with vegetation for up to 6 months.

**Purpose**

To use fast growing vegetation that provides cover on disturbed soils.

**Conditions Where Practice Applies**

Exposed soils where ground cover is needed for a period of 6 months or less. For longer duration of time, permanent stabilization practices are required.

**Criteria**

1. Select one or more of the species or seed mixtures listed in Table B.1 for the appropriate Plant Hardiness Zone (from Figure B.3), and enter them in the Temporary Seeding Summary below along with application rates, seeding dates and seeding depths. If this Summary is not put on the plan and completed, then Table B.1 plus fertilizer and lime rates must be put on the plan.
2. For sites having soil tests performed, use and show the recommended rates by the testing agency. Soil tests are not required for Temporary Seeding.
3. When stabilization is required outside of a seeding season, apply seed and mulch or straw mulch alone as prescribed in Section B-4.3.1.b and maintain until the next seeding season.

**Temporary Seeding Summary**

No.	Hardness Zone (from Figure B.3): Seed Mixture (from Table B.1):			Seeding Dates	Seeding Depth	Fertilizer Rate (10-20-20)	Lime Rate
	Species	Application Rate (lb/ac)	Seeding Rate (lb/ac)				
1	ANNUAL RYE	40	3 1/2-5/15	1"	436 lb/ac (110 lb/1000 sq ft)	2 tons/ac (90 lb/1000 sq ft)	
2	BOWLE	90	8/15-10/15	1/2"			
3	FOXTAIL MILET	30	5/16-7/31	1/2"			

**B-4.5 STANDARDS AND SPECIFICATIONS**

**FOR**

**PERMANENT STABILIZATION**

**Definition**

To stabilize disturbed soils with permanent vegetation.

**Purpose**

To use long-lived perennial grasses and legumes to establish permanent ground cover on disturbed soils.

**Conditions Where Practice Applies**

Exposed soils where ground cover is needed for 6 months or more.

**Criteria**

1. General Use
  1. Select one or more of the species or mixtures listed in Table B.3 for the appropriate Plant Hardiness Zone (from Figure B.3) and based on the site condition or purpose found on Table B.2. Enter selected mixture(s), application rates, and seeding dates in the Permanent Seeding Summary. The Summary is to be placed on the plan.
  2. Additional planting specifications for exceptional sites such as shorelines, stream banks, or dunes or for special purposes such as wildlife or aesthetic treatment may be found in USDA-NRCS Technical Field Office Guide, Section 342 - Critical Area Planting.
  3. For sites having disturbed area over 5 acres, use and show the rates recommended by the soil testing agency.
  4. For areas receiving low maintenance, apply urea form fertilizer (46-0-0) at 3 1/2 pounds per 1000 square feet (150 pounds per acre) at the time of seeding to increase the soil amendments shown in the Permanent Seeding Summary.
2. Turfgrass Mixtures
  - a. Areas where turfgrass may be desired include lawns, parks, playgrounds, and commercial sites which will receive a medium to high level of maintenance.
  - b. Select one or more of the species or mixtures listed below based on the site conditions or purpose. Enter selected mixture(s), application rates, and seeding dates in the Permanent Seeding Summary. The Summary is to be placed on the plan.
    1. Kentucky Bluegrass: Full Sun Mixture: For use in areas that receive intensive management. Irrigation required in the areas of central Maryland and Eastern Shore. Recommended Certified Kentucky Bluegrass Cultivars Seeding Rate: 1.5 to 2.0 pounds per 1000 square feet. Choose a minimum of three Kentucky bluegrass cultivars with each ranging from 10 to 35 percent of the total mixture by weight.
    2. Kentucky Bluegrass/Perennial Ryegrass: Full Sun Mixture: For use in full sun areas where rapid establishment is necessary and when turf will receive medium to intensive management. Certified Perennial Ryegrass Cultivars/Certified Kentucky Bluegrass Seeding Rate: 2 pounds mixture per 1000 square feet. Choose a minimum of three Kentucky bluegrass cultivars with each ranging from 10 to 15 percent of the total mixture by weight.
    3. Tall Fescue/Kentucky Bluegrass: Full Sun Mixture: For use in drought prone areas and/or for areas receiving low to medium management in full sun to medium shade. Recommended mixture includes: Certified Tall Fescue Cultivars 95 to 100 percent, Certified Kentucky Bluegrass Cultivars 0 to 5 percent. Seeding Rate: 5 to 8 pounds per 1000 square feet. One or more cultivars may be blended.
    4. Kentucky Bluegrass/Fine Fescue: Shade Mixture: For use in areas with shade in bluegrass lawns. For establishment in high quality, intensively managed turf area. Mixture includes: Certified Kentucky Bluegrass Cultivars 30 to 40 percent and Certified Fine Fescue and 60 to 70 percent. Seeding Rate: 1 1/2 to 3 pounds per 1000 square feet.

**Note:** Select turfgrass varieties from those listed in the most current University of Maryland Publication, Agronomy Memo #77, "Turfgrass Cultivar Recommendations for Maryland"

**Choose certified material. Certified material is the best guarantee of cultivar purity. The certification program of the Maryland Department of Agriculture, Turf and Seed Section, provides a reliable means of consumer protection and assures a pure genetic line.**

1. Ideal Times of Seeding for Turf Grass Mixtures
  1. Western MD: March 15 to June 1, August 1 to October 1 (Hardness Zones: 5b, 6a)
  2. Central MD: March 1 to May 15, August 15 to October 15 (Hardness Zone: 6b)
  3. Southern MD, Eastern Shore: March 1 to May 15, August 15 to October 15 (Hardness Zones: 7a, 7b)
2. Till areas to receive seed by disk or other approved methods to a depth of 2 to 4 inches, level and rake the areas to prepare a proper seedbed. Remove stones and debris over 1/4 inch in diameter. The resulting seedbed must be in such condition that future mowing of grasses will pose no difficulty.
3. If soil moisture is deficient, supply new seedlings with adequate water for plant growth (1/2 to 1 inch every 3 to 4 days depending on soil texture) until they are firmly established. This is especially true when seedlings are made late in the planting season, in abnormally dry or hot seasons, or on adverse sites.

**PERMANENT SEEDING SUMMARY**

NO.	SPECIES	APPLICATION RATE (lb/ac)	SEEDING DATES	SEEDING DEPTHS	FERTILIZER RATE (10-20-20)			LIME RATE
					N	P2O5	K2O	
1	SWITCH GRASS CREEPING RED FESCUE PARTRIDGE PEA	10 15 4	3/1-5/15 8/15-10/15	1/12" 1/4"	45 lb/ac (100 lb/1000 sq ft)	90 lb/ac (200 lb/1000 sq ft)	90 lb/ac (200 lb/1000 sq ft)	2 tons/ac (90 lb/1000 sq ft)
2	BIG BLUESTEM LITTLE BLUESTEM CREEPING RED FESCUE PARTRIDGE PEA DEEP SOUCE	8 6 15 15 4	3/1-5/15 8/15-10/15	1/12" 1/4"				
4	CREEPING RED FESCUE VIRGINIA BLUE RYE	15 20	3/1-5/15 8/15-10/15	1/12" 1/4"				

1. Sod: To provide quick cover on disturbed areas (2:1 grade or flatter).
  1. General Specifications
    - a. Class of turfgrass sod must be Maryland State Certified. Sod labels must be made available to the job foreman and inspector.
    - b. Sod must be machine cut at a uniform soil thickness of 1/4 inch, plus or minus 1/8 inch, at the time of cutting. Measurement for thickness must exclude top growth and thatch. Broken pads and torn or uneven ends will not be acceptable.
    - c. Standard size sections of sod must be strong enough to support their own weight and retain their size and shape when suspended vertically with a firm grasp on the upper 10 percent of the section.
    - d. Sod must not be harvested or transplanted when moisture content (excessively dry or wet) may adversely affect its survival.
    - e. Sod must be harvested, delivered, and installed within a period of 36 hours. Sod not transplanted within this period must be approved by an agronomist or soil scientist prior to its installation.
  2. Sod Installation
    - a. During periods of excessively high temperature or in areas having dry subsoil, lightly irrigate the subsoil immediately prior to laying the sod.
    - b. Lay the first row of sod in a straight line with subsequent rows placed parallel to it and tightly wedged against each other. Stagger lateral joints to promote more uniform growth and strength. Ensure that sod is not stretched or overlapped and that all joints are butted tight in order to prevent voids which would cause air drying of the roots.
    - c. Wherever possible, lay sod with the long edges parallel to the contour and with staggering joints. Roll and tamp, peg or otherwise secure the sod to prevent slippage on slopes. Ensure solid contact exists between sod roots and the underlying soil surface.
    - d. Water the sod immediately following rolling and tamping until the underside of the new sod pad and soil surface below the sod are thoroughly wet. Complete the operations of laying, tamping and irrigating for any piece of sod within eight hours.
  3. Sod Maintenance
    - a. In the absence of adequate rainfall, water daily during the first week or as often and sufficiently as necessary to maintain moist soil to a depth of 4 inches. Water sod during the best of the day to prevent wilting.
    - b. After the first week, sod watering is required as necessary to maintain adequate moisture content.
    - c. Do not mow until the sod is firmly rooted. No more than 1/2 of the grass leaf must be removed by the initial cutting or subsequent cuttings. Maintain a grass height of at least 3 inches unless otherwise specified.

**Site Analysis:**

Total Area of Site:	1,436	Acres
Area Disturbed or to be vegetatively stabilized:	1,436	Acres
Area to be seeded or paved:	0.10	Acres
Total Cut:	1.17	Acres
Total Fill:	810	Cu. Yds.
Off-site waste/borrow area location:	N/A	

1. All sediment control structures are to remain in place, and are to be maintained in operative condition until permission for their removal has been obtained from the CID.
2. Additional sediment control must be provided, if deemed necessary by the CID. The site and all controls shall be inspected by the contractor weekly, and the most day after each rain event. A written report by the contractor, made available upon request, is part of every inspection and should include:
  - Inspection date
  - Inspection type (routine, pre-storm event, during rain event)
  - Name and title of inspector
  - Weather information (current conditions as well as time and amount of last recorded precipitation)
  - Brief description of project's status (e.g., percent complete) and/or current activities
  - Evidence of sediment discharges
  - Identification of plan deficiencies
  - Identification of sediment controls that require maintenance
  - Identification of missing or improperly installed sediment controls
  - Compliance status regarding the sequence of construction and stabilization requirements
  - Photographs
  - Monitoring/sampling
  - Maintenance and/or corrective action performed
  - Other inspection items as required by the General Permit for Stormwater Associated with Construction Activities (NPDES, MDE).
3. Trenches for the construction of utilities is limited to three pipe lengths or that which can and shall be back-filled and stabilized by the end of each working day, whichever is shorter.
4. Any major changes or revisions to the plan or sequence of construction must be reviewed and approved by the HSCD prior to proceeding with construction. Minor revisions may be allowed by the CID per the list of HSCD-approved field changes.
5. Disturbance shall not occur outside the L.O.D. A project is to be sequenced so that grading activities begin on one grading unit (maximum average of 20 ac. per grading unit) at a time. Work may proceed to a subsequent grading unit when at least 50 percent of the disturbed area in the preceding grading unit has been stabilized and approved by the CID. Unless otherwise specified and approved by the HSCD, no more than 30 acres cumulatively may be disturbed at a given time.
6. Wash water from any



**BEST MANAGEMENT PRACTICES FOR WORKING IN NONTIDAL WETLANDS, WETLAND BUFFERS, WATERWAYS, AND 100-YEAR FLOODPLAINS**

- NO EXCESS FILL, CONSTRUCTION MATERIAL, OR DEBRIS SHALL BE STOCKPILED OR STORED IN NONTIDAL WETLANDS, NONTIDAL WETLAND BUFFERS, WATERWAYS, OR THE 100-YEAR FLOODPLAIN.
- PLACE MATERIALS IN A LOCATION AND MANNER WHICH DOES NOT ADVERSELY IMPACT SURFACE OR SUBSURFACE WATER FLOW INTO OR OUT OF NONTIDAL WETLANDS, NONTIDAL WETLAND BUFFERS, WATERWAYS, OR THE 100-YEAR FLOODPLAIN.
- DO NOT USE THE EXCAVATED MATERIAL AS BACKFILL IF IT CONTAINS WASTE METAL PRODUCTS, UNSIGHTLY DEBRIS, TOXIC MATERIAL, OR ANY OTHER DELETERIOUS SUBSTANCE. IF ADDITIONAL BACKFILL IS REQUIRED, USE CLEAN MATERIAL FREE OF WASTE METAL PRODUCTS, UNSIGHTLY DEBRIS, TOXIC MATERIAL, OR ANY OTHER DELETERIOUS SUBSTANCE.
- PLACE HEAVY EQUIPMENT ON MATS OR SUITABLY OPERATE THE EQUIPMENT TO PREVENT DAMAGE TO NONTIDAL WETLANDS, NONTIDAL WETLAND BUFFERS, WATERWAYS, OR THE 100-YEAR FLOODPLAIN.
- REPAIR AND MAINTAIN ANY SERVICEABLE STRUCTURE OR FILL SO THERE IS NO PERMANENT LOSS OF NONTIDAL WETLANDS, NONTIDAL WETLAND BUFFERS, OR WATERWAYS, OR PERMANENT MODIFICATION OF THE 100-YEAR FLOODPLAIN IN EXCESS OF THAT LOST UNDER THE ORIGINALLY AUTHORIZED STRUCTURE OR FILL.
- RECTIFY ANY NONTIDAL WETLANDS, NONTIDAL WETLAND BUFFERS, WATERWAYS, OR THE 100-YEAR FLOODPLAIN TEMPORARILY IMPACTED BY ANY CONSTRUCTION.
- ALL STABILIZATION IN THE NONTIDAL WETLAND AND NONTIDAL WETLAND BUFFER SHALL CONSIST OF THE FOLLOWING SPECIES: ANNUAL RYEGRASS (LOLIUM MULTIFLORUM), MILLET (SETARIA ITALICA), BARLEY (HORDEUM SP.), OATS (UNIOLA SP.), AND/OR RYE (SECALE CEREALE). THESE SPECIES WILL ALLOW FOR STABILIZATION OF THE SITE WHILE ALSO ALLOWING FOR THE VOLUNTARY REVEGETATION OF NATURAL WETLAND SPECIES. OTHER NON-PERSISTENT VEGETATION MAY BE ACCEPTABLE, BUT MUST BE APPROVED BY THE NONTIDAL WETLANDS AND WATERWAYS DIVISION. KENTUCKY 31 FESCUE SHALL NOT BE UTILIZED IN WETLAND OR BUFFER AREAS. THE AREA SHOULD BE SEEDED AND MULCHED TO REDUCE EROSION AFTER CONSTRUCTION ACTIVITIES HAVE BEEN COMPLETED.
- AFTER INSTALLATION HAS BEEN COMPLETED, MAKE POST-CONSTRUCTION GRADES AND ELEVATIONS THE SAME AS THE ORIGINAL GRADES AND ELEVATIONS IN TEMPORARILY IMPACTED AREAS.
- TO PROTECT AQUATIC SPECIES, IN-STREAM WORK IS PROHIBITED AS DETERMINED BY CLASSIFICATION OF THE STREAM.  
  
USE 1 WATERS: IN-STREAM WORK SHALL NOT BE CONDUCTED DURING THE PERIOD OF MARCH 1 THROUGH JUNE 15, INCLUSIVE, DURING ANY YEAR.
- STORMWATER RUNOFF FROM IMPERVIOUS SURFACES SHALL BE CONTROLLED TO PREVENT THE WASHING OF DEBRIS INTO THE WATERWAY.
- CULVERTS SHALL BE CONSTRUCTED AND ANY RIPRAP PLACED SO AS NOT TO OBSTRUCT THE MOVEMENT OF THE AQUATIC SPECIES, UNLESS THE PURPOSE OF THE ACTIVITY IS TO IMPOUND WATER.

**SEQUENCE OF CONSTRUCTION**

NOTE: A MDE NONTIDAL WATERWAYS CONSTRUCTION AUTHORIZATION (201560104/15-NT-3019) HAS BEEN ISSUED FOR THIS PROJECT. NO WORK MAY BE PERFORMED IN STREAM BETWEEN MARCH 1 AND JUNE 15 INCLUSIVE OF ANY YEAR.

**EROSION AND SEDIMENT CONTROL SETUP - 5 DAYS**

- (DAY 1) THE CONTRACTOR SHALL STAKE OUT THE LIMITS OF DISTURBANCE AS SHOWN ON THE GRADING PLAN.
- (DAY 1) NOTIFY MISS UTILITY (1-800-257-7777) AT LEAST 48 HOURS PRIOR TO BEGINNING WORK.
- (DAY 2) THE CONTRACTOR SHALL CONDUCT A PRE-CONSTRUCTION MEETING ON-SITE WITH THE SEDIMENT CONTROL INSPECTOR AND ENGINEER TO REVIEW THE LIMITS OF DISTURBANCE, STRUCTURE STAKEOUT, EROSION AND SEDIMENT CONTROL REQUIREMENTS, AND THE SEQUENCE OF CONSTRUCTION. THE PARTICIPANTS WILL ALSO VERIFY THE LOCATION OF THE TEMPORARY STOCKPILE AREA AND ANY NECESSARY STAGING AREA, AND FLAG ANY TREES WITHIN THE LIMITS OF DISTURBANCE WHICH WILL BE REMOVED FOR CONSTRUCTION ACCESS AND GRADING.
- (DAY 3) THE CONTRACTOR SHALL INSTALL THE STABILIZED CONSTRUCTION ENTRANCE AND BLAZE ORANGE CONSTRUCTION FENCE AND TREE PROTECTION AREAS AS SHOWN ON THE GRADING PLANS.
- (DAY 3) THE CONTRACTOR SHALL ESTABLISH THE TEMPORARY STOCKPILE AREA IN THE LOCATION INDICATED ON THE GRADING PLAN.
- (DAY 4) INSTALL REMAINING PERIMETER EROSION AND SEDIMENT CONTROL DEVICES AS SHOWN ON THE PLAN INCLUDING THE SUPER SILT FENCE.
- (DAY 5) THE HOWARD COUNTY CONSTRUCTION INSPECTION DIVISION SHALL BE NOTIFIED UPON COMPLETION OF CONTROLS. UPON COMPLETION OF CONTROL INSTALLATION, AND WITH APPROVAL OF THE SEDIMENT CONTROL INSPECTOR, THE CONTRACTOR MAY BEGIN OPERATIONS. CONSTRUCTION SHALL BE DONE IN ACCORDANCE WITH THE SEQUENCE OF CONSTRUCTION AND GRADING PLANS, AND EROSION AND SEDIMENT CONTROL STANDARD DETAILS AND NOTES.

**CONSTRUCTION - 60 DAYS**

**PHASE 1**

- (DAY 6-12) INSTALL TEMPORARY ACCESS CULVERT, TEMPORARY STREAM CROSSING, AND STREAM DIVERSION ACCORDING TO THE PHASE 1 PLANS. THE STREAM DIVERSION MUST BE INSPECTED EVERY DAY AND BE MAINTAINED IN EFFECTIVE OPERATING CONDITION.
- (DAY 13-14) CLEAR AND GRUB AREA WITHIN THE LIMIT OF DISTURBANCE. ANY WATER PONDED WITHIN THE WORK ZONE MUST BE PUMPED THROUGH A FILTER BAG OR PORTABLE SEDIMENT TANK BEFORE BEING DISCHARGED TO A STABLE OUTFALL.
- (DAY 15-30) CONSTRUCT PROPOSED BOULDER TOE, BOULDER SLOPE STABILIZATION, AND DEFLECTOR ACCORDING TO PHASE 1 PLANS. BEGIN EXCAVATING AND INSTALLATION OF UTILITIES. CONNECT TO EXISTING UTILITIES WHERE APPLICABLE. WORK SHALL BE LIMITED TO THAT WHICH CAN BE BACKFILLED AND STABILIZED IN ONE DAY. ALL AREAS NOT DRAINING TO AN EROSION AND SEDIMENT CONTROL DEVICE MUST BE STABILIZED AT THE END OF THE WORK DAY.
- (DAY 31-32) REMOVE STREAM DIVERSION AND TEMPORARY ACCESS CULVERT, AND RETURN THE STREAM TO ITS ORIGINAL CONDITIONS.

**LEGEND**

---	EX. BUILDING		PROPOSED UTILITY EASEMENT
--- C ---	EX. UNDERGROUND CABLE		TEMPORARY CONSTRUCTION EASEMENT
--- E ---	EX. UNDERGROUND ELECTRIC		TEMPORARY CONSTRUCTION STRIP
--- O/E ---	EX. OVERHEAD ELECTRIC LINES		PROPOSED SANITARY SEWER MAIN
---	EX. 100 YR. FLOODPLAIN EASEMENT		PROPOSED CLAY DAM
	EX. UTILITY EASEMENT		PROPOSED WATER MAIN, FIRE HYDRANT, VALVE & REDUCER
--- X ---	EX. CHAIN LINK FENCE		PROPOSED 10 FOOT CONTOUR
--- // --- // ---	EX. WOOD FENCE		PROPOSED 2 FOOT CONTOUR
--- FP --- FP ---	EX. 100 YR. FLOODPLAIN		EARTH DIKE
---	EX. UNDERGROUND GAS MAIN		LIMIT OF DISTURBANCE
--- 180 ---	EX. 10 FOOT CONTOURS		SILT FENCE
--- 182 ---	EX. 2 FOOT CONTOURS		SUPER SILT FENCE
---	EX. FOOT PATH		TREE PROTECTION FENCE
---	EX. PROPERTY BOUNDARY		PROPOSED SANDBAG DIVERSION
---	EX. ADJACENT PROPERTY BOUNDARY		PROPOSED TEMPORARY ACCESS CULVERTS
---	EX. BRIDGE		PROPOSED SUMP PIT
---	EX. CENTERLINE ROAD		PROPOSED PORTABLE SEDIMENT TANK
---	EX. CURB & GUTTER		PROPOSED FILTER BAG
---	EX. EDGE OF PAVEMENT		PROPOSED BOLDER SLOPE PROTECTION
---	EX. GUARDRAIL		PROPOSED TEMPORARY STOCKPILE AREA
---	EX. PAVEMENT MARKINGS		EX. WATER MAIN, FIRE HYDRANT, VALVE & REDUCER
---	EX. ROAD RIGHT-OF-WAY		EX. ELECTRICAL MANHOLE
+++++	EX. RAILROAD TRACKS		EX. SEWER MANHOLE
--- WUS --- WUS ---	EX. WATERS OF THE U.S.		EX. WATER METER
---	EX. SANITARY SEWER		EX. AIR RELEASE MANHOLE
---	EX. STORM DRAIN		EX. STORM DRAIN MANHOLE
---	EX. STREAM		EX. TELEPHONE MANHOLE
--- VB --- VB ---	EX. VEGETATION BUFFER		EX. LIGHT POLE
--- T ---	EX. UNDERGROUND TELEPHONE LINE		EX. GAS MANHOLE
---	EX. SIDEWALK		EX. UTILITY PEDESTAL
---	EX. WALLS		EX. UTILITY POLE
---	EX. WETLANDS		EX. SIGN
--- WB --- WB ---	EX. WETLAND BUFFER		BENCHMARK
	STEEP SLOPES (25% +)		SOIL BORING
	SSURGO SOIL BOUNDARY		TRAVERSE
--- FP --- FP ---	100-YEAR FLOODPLAIN		TEST PIT
---	EX. TREELINE		
	EX. SPECIMEN TREE		

Soil Name	Symbol	% Slopes	Hydric	Landform	Hydric Component	Kf
Glenville-Codorus silt loams	GoB	0-8%	N	~	~	0.43
Manor-Bannertown sandy loams, rocky	MgF	25-65%	N	~	~	0.20
Manor-Brinklow complex, rocky	MkF	25-65%	N	~	~	0.32

DEPARTMENT OF PUBLIC WORKS  
HOWARD COUNTY, MARYLAND


*John P. K...* 6/16/17  
DIRECTOR OF PUBLIC WORKS DATE

*Thomas E. Butler* 6/15/17  
CHIEF, BUREAU OF ENGINEERING DATE

*Paul J. ...* 6/2/17  
CHIEF, BUREAU OF UTILITIES DATE

*Paul J. ...* 6/2/17  
CHIEF, UTILITY DESIGN DIVISION DATE

**GMB**  
GEORGE, MILES & BUHR, LLC  
ARCHITECTS & ENGINEERS  
SALISBURY - BALTIMORE - SEAFORD  
www.gmbnet.com

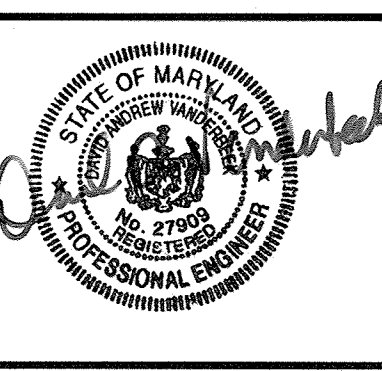

DES: D.A.V.			
DRN: M.A.D.			
CHK: W.B.F.			
DATE: 05/17			
BY	NO.	REVISION	DATE

NOTES AND LEGEND

600 SCALE MAP NO. 25 BLOCK NO. 8

SYLVAN LANE  
INTERCEPTOR SEWER IMPROVEMENTS  
CONTRACT NO. 10-4915  
2ND ELECTION DISTRICT  
HOWARD COUNTY, MARYLAND

SCALE AS SHOWN

SHEET 10 OF 12

C:\DRAWINGS\3014 - TIEBER SUCKER BRANCH INTERCEPTOR SEWER IMPROVEMENTS\CURRENT\SYLVAN LANE\LEGEND.dwg, 5/26/2017 12:46:58 PM, HP DesignPlotter, T:\330\_85\_Mylar.pps3







