

QUANTITIES				
ITEM	ESTIMATED	QUANTITIES	AS-BUILT	SUPPLIER
8" PVC, SDR-35	2,555 L.F.	2,550	National Pipe	FERGUSON
8" CL. 52 D.I.P.	1,373	1,409	McVane Inc.	..
4" PVC, SDR-35	1,021 L.F.	1,049	National Pipe	..
CLEAN-OUT	09 EACH	64	Horne Concrete	HORNE
MANHOLE	23 EACH	22	Atlantic Precast	ATLANTIC CONCRETE
8" C900 PVC, DR-18	4,300 L.F.	4,415	National Pipe	FERGUSON
6" C900 PVC, DR-18	256 L.F.	241	National Pipe	..
1-1/2" WHC	2,619 L.F.	2,595	Mueller Industries	..
OUTSIDE METER SETTING	101 EACH	98	AY McDonald	..
1/8 H.B.	6 EACH	6	Tyler/Union	..
1/16 H.B.	5 EACH	1	Tyler/Union	..
1/32 H.B.	9 EACH	6	Tyler/Union	..
2" H.D.C.	3 EACH	1	CertainTeed	..
3" H.D.C.	1 EACH	1	CertainTeed	..
8" VALVE	10 EACH	11	Mueller Comp.	..
6" VALVE	9 EACH	10	Mueller Comp.	..
8" X 8" TEE	2 EACH	2
8" X 6" F.H. TEE	9 EACH	9	Tyler/Union	..
FIRE HYDRANT	9 EACH	9	Mueller Comp.	..
CONTINUITY TEST STATION	9 EACH	9	Vestal	..
8" PLUG & BUTTRESS	2 EACH	2	Mueller Industries	..
8" X 4" TEE	1 EACH	1
4" VALVE	1 EACH	1
4" C900 PVC, DR-18	295 L.F.	291

BENCHMARK INFORMATION

B.M.#34FB - HOWARD COUNTY CONTROL STATION #34FB - HORIZONTAL - NAD '83
 LOCATED EAST OF ERIN DRIVE, ALONG GUILFORD ROAD, APPROX. 21' BEHIND EDGE OF PAVING
 N 557,439.911
 E 1,330,191.324
 ELEVATION = 406.147 - VERTICAL - (NAVD '88)

B.M.#34FE - HOWARD COUNTY CONTROL STATION #34FE - HORIZONTAL - (NAD '83)
 LOCATED WEST OF GALWAY DRIVE, ALONG GUILFORD ROAD EAST OF DRIVEWAY #221, SET BEHIND THE EXISTING FIRE HYDRANT
 N 558,339.599
 E 1,329,709.033
 ELEVATION = 431.115 - VERTICAL - (NAVD '88)

DEVELOPER'S CERTIFICATION

I/WE HEREBY CERTIFY THAT ALL DEVELOPMENT AND CONSTRUCTION WILL BE DONE ACCORDING TO THIS PLAN OF DEVELOPMENT AND PLAN FOR EROSION AND SEDIMENT CONTROL AND THAT ALL RESPONSIBLE PERSONNEL INVOLVED IN THE CONSTRUCTION PROJECT WILL HAVE A CERTIFICATE OF ATTENDANCE AT THE DEPARTMENT OF THE ENVIRONMENT APPROVED TRAINING PROGRAM FOR THE CONTROL OF SEDIMENT AND EROSION BEFORE BEGINNING THE PROJECT. I ALSO AUTHORIZE PERIODIC ON-SITE INSPECTION BY THE HOWARD SOIL CONSERVATION DISTRICT OR THEIR AUTHORIZED AGENTS, AS AGE DEMAND NECESSARY.

Paul W. Kriebel;
 FOR: BEAZER HOMES, LLC 06/30/17
 SIGNATURE OF DEVELOPER DATE

ENGINEER'S CERTIFICATION

I HEREBY CERTIFY THAT THIS PLAN FOR EROSION AND SEDIMENT CONTROL REPRESENTS A PRACTICAL AND WORKABLE PLAN BASED ON MY PERSONAL KNOWLEDGE OF THE SITE CONDITIONS AND THAT IT WAS PREPARED IN ACCORDANCE WITH THE REQUIREMENTS OF THE HOWARD SOIL CONSERVATION DISTRICT.

Paul W. Kriebel
 SIGNATURE OF ENGINEER 06/30/17
 DATE

SEDIMENT CONTROL MEASURES FOR THIS CONTRACT WILL BE IMPLEMENTED IN ACCORDANCE WITH SECTION 30B OF THE HOWARD COUNTY DESIGN MANUAL - VOLUME IV, STANDARD SPECIFICATIONS AND DETAILS FOR CONSTRUCTION AND AS SHOWN ON THE ROAD CONSTRUCTION PLANS, F-17-003, AND ON THESE PLANS.


Paul W. Kriebel;
 FOR: BEAZER HOMES, LLC 06/30/17
 SIGNATURE OF DEVELOPER DATE

F-17-003

THIS DEVELOPMENT IS APPROVED FOR EROSION AND SEDIMENT CONTROL BY HOWARD SOIL CONSERVATION DISTRICT.

APPROVED: John F. Blanton 7/19/17
 HOWARD SOIL CONSERVATION DISTRICT

LEGEND	
SYMBOL	DESCRIPTION
---	EX. WATER MAIN
---	EX. SEWER MAIN
○	EX. SEWER MANHOLE
○	EX. SEWER, WATER & UTILITY EASEMENT
○	EX. FIRE HYDRANT
○	EX. VALVE
---	PROP. WATER MAIN
---	PROP. SEWER MAIN
---	PROP. SEWER MANHOLE
---	PROP. SEWER, WATER & UTILITY EASEMENT
---	PROP. WHC
---	PROP. SHC
---	PROP. FIRE HYDRANT
---	PROP. VALVE

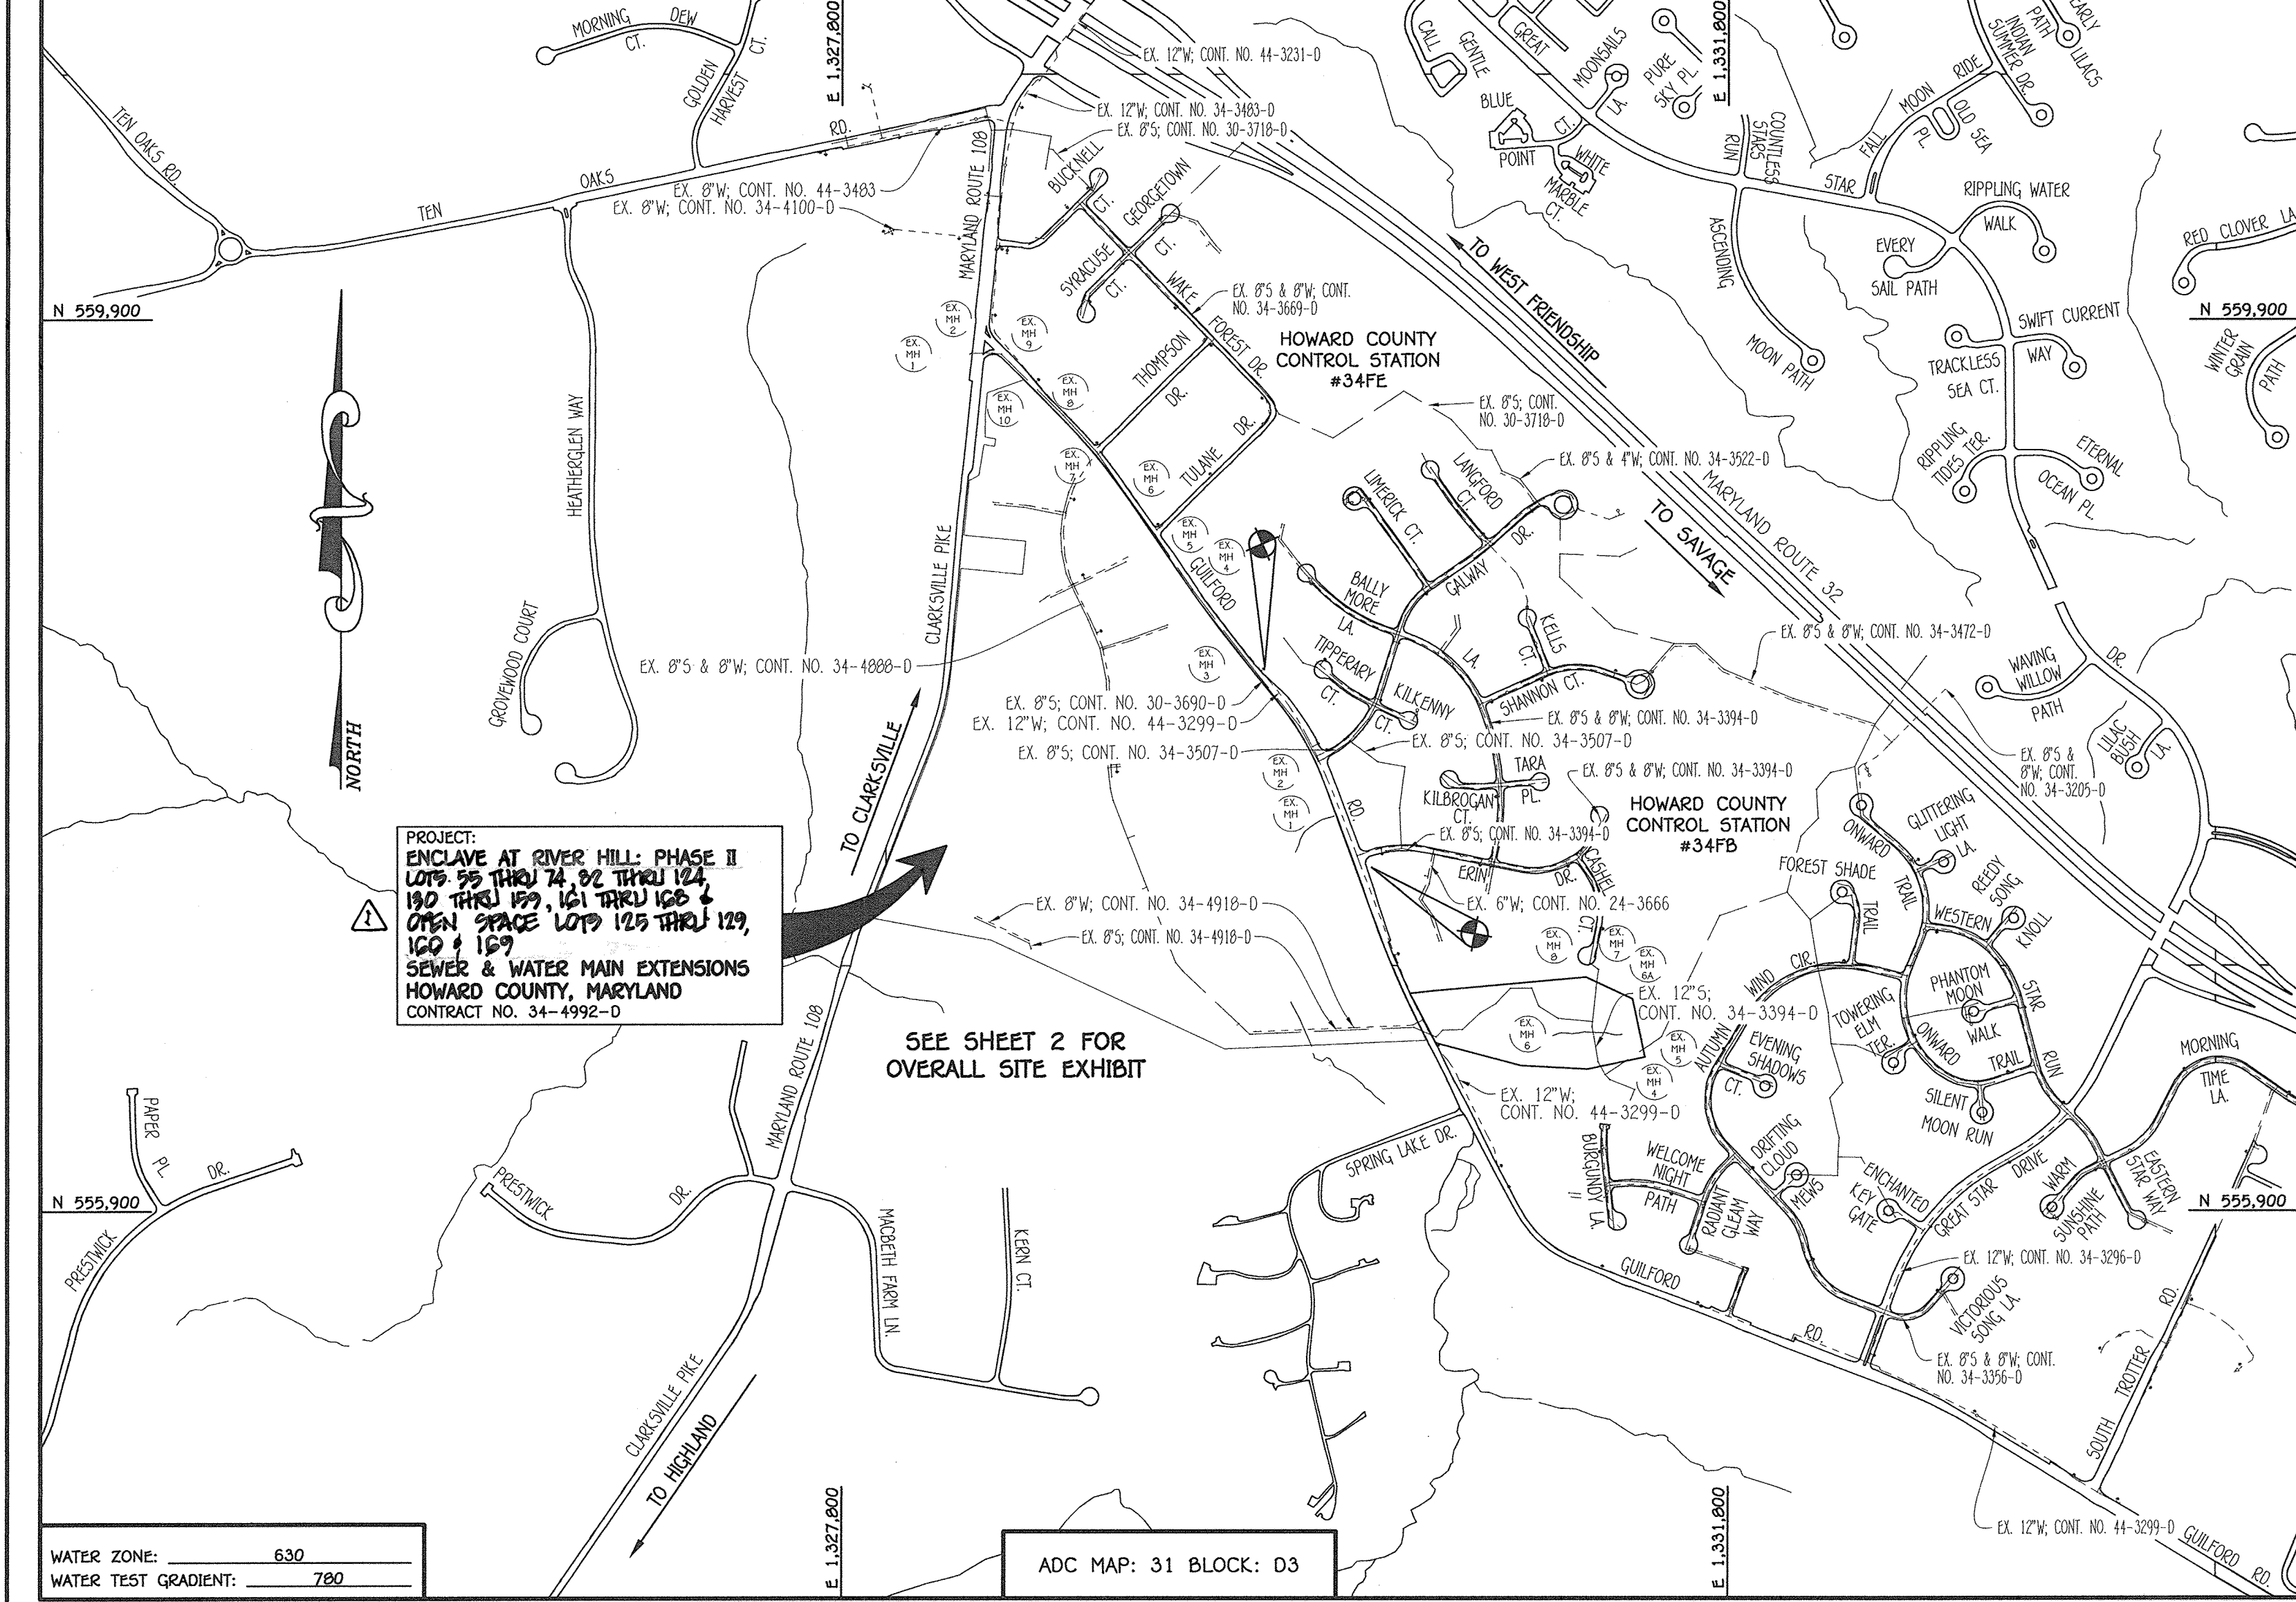

TYPE OF BUILDING:	RESIDENTIAL - SINGLE FAMILY DETACHED
NUMBER OF LOTS:	(110) BUILDABLE
NO. OF WATER HOUSE CONNECTIONS:	101
NO. OF SEWER HOUSE CONNECTIONS:	92
SEWER SHED:	MIDDLE PATUXENT
TREATMENT PLANT:	LITTLE PATUXENT WASTEWATER RECLAMATION PLANT SAVAGE, MARYLAND

LOCATION MAP
 SCALE: 1" = 600'

PLAN REFERENCE NUMBERS:
 F-17-003 (PUBLIC ROADS & RECORD PLAT)
 SDP-18-003

CONTRACT NO. 34-4992-D

ENCLAVE AT RIVER HILL: PHASE II

LOTS 55 THRU 74, 82 THRU 124, 130 THRU 159, 161 THRU 168 & OPEN SPACE LOTS 125 THRU 129, 160 & 169


SEWER & WATER MAIN EXTENSIONS

HOWARD COUNTY, MARYLAND

AS-BUILT
 Date 11/2/18

OWNER
 TIERNY FARMS - CLARKSVILLE, L.P.
 24151 VENTURA BOULEVARD
 CALABASAS, CALIFORNIA 91302
 PH: (818) 385-3697

DEVELOPER
 BEAZER HOMES, LLC
 8965 GUILFORD ROAD
 SUITE 250
 COLUMBIA, MARYLAND 21046
 PH: (765) 894-0182

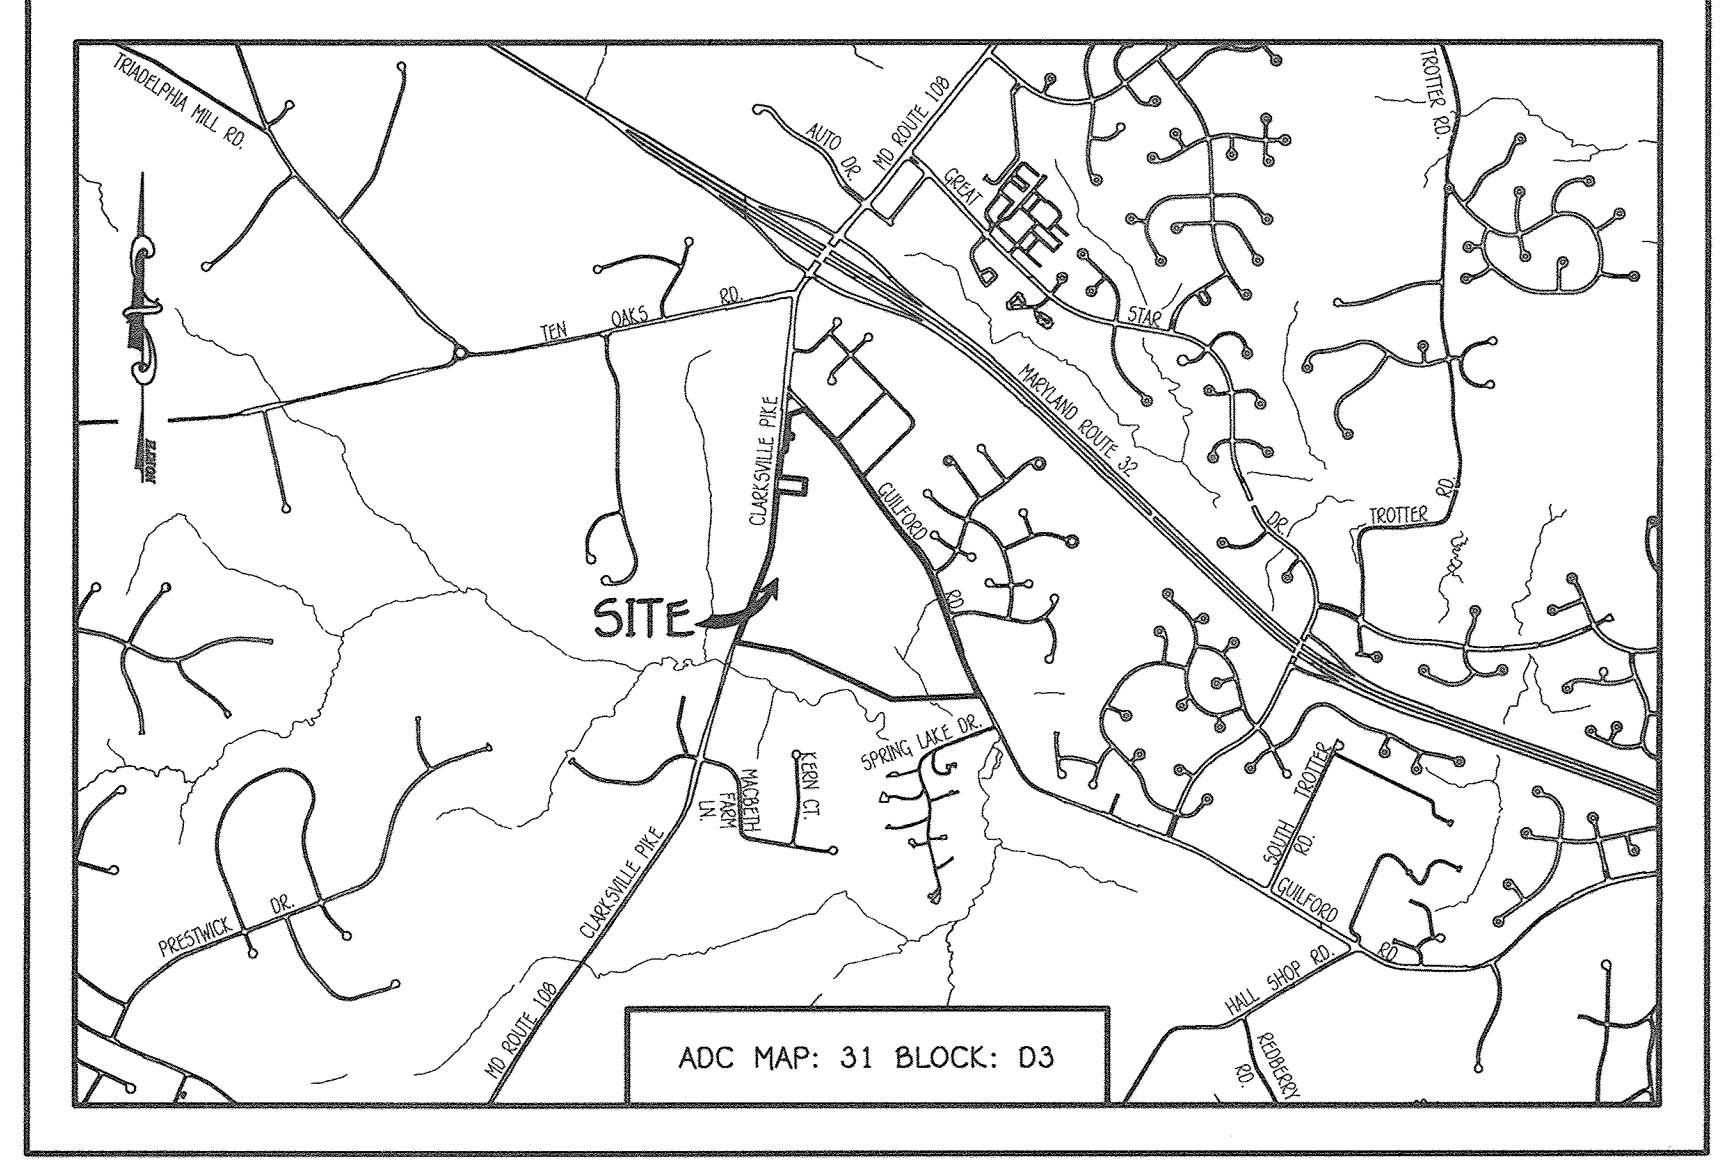


GENERAL NOTES
 SCALE: 1" = 2000'

- PART A**
- APPROXIMATE LOCATIONS OF EXISTING MAINS ARE SHOWN. THE CONTRACTOR SHALL TAKE ALL NECESSARY PRECAUTIONS TO PROTECT EXISTING MAINS AND SERVICES AND MAINTAIN UNINTERRUPTED SERVICE. ANY DAMAGE INCURRED SHALL BE REPAIRED IMMEDIATELY TO THE SATISFACTION OF THE ENGINEER AT THE CONTRACTOR'S EXPENSE.
 - TOPOGRAPHIC FIELD SURVEYS WERE PERFORMED ON OR ABOUT FEBRUARY, 2014 BY FISHER, COLLINS & CARTER, INC.
 - HORIZONTAL AND VERTICAL SURVEY CONTROLS: THE COORDINATES SHOWN ON THE DRAWINGS ARE BASED ON MARYLAND STATE REFERENCE SYSTEM NAD '83/91' AS PROJECTED BY HOWARD COUNTY GEODETIC CONTROL STATIONS #34A & #34E. ALL VERTICAL CONTROLS ARE BASED ON NAVD '88. VERTICAL CONTROLS PROVIDED ON THE DRAWINGS.
 - ALL PIPE ELEVATIONS SHOWN ARE INVERT ELEVATIONS UNLESS OTHERWISE NOTED ON THE PLANS.
 - CLEAN ALL UTILITIES BY A MINIMUM OF 12 INCHES. CLEAR ALL POLES BY 2'-0" MINIMUM OR TUNNEL AS REQUIRED UNLESS OTHERWISE NOTED. THE OWNER HAS CONTACTED THE UTILITY COMPANIES AND HAS MADE ARRANGEMENTS FOR BRACING OF POLES AS SHOWN ON THE DRAWINGS. IN THE EVENT THE CONTRACTOR'S WORK REQUIRES BRACING OF ADDITIONAL POLES, ANY COST INCURRED BY THE OWNER FOR THE BRACING OF THE ADDITIONAL POLES OR DAMAGES SHALL BE DEDUCTED FROM MONIES OWED THE CONTRACTOR. THE CONTRACTOR SHALL COORDINATE WITH THE UTILITY COMPANIES TO SCHEDULE THE BRACING OF THE POLES.
 - FOR DETAILS NOT SHOWN ON THE DRAWINGS, AND FOR MATERIALS AND CONSTRUCTION METHODS, USE HOWARD COUNTY DESIGN MANUAL VOLUME IV, STANDARD SPECIFICATIONS AND DETAILS FOR CONSTRUCTION (LATEST EDITION). THE CONTRACTOR SHALL HAVE A COPY OF VOLUME IV ON THE JOB SITE.
 - WHERE TEST PITS HAVE BEEN MADE ON EXISTING UTILITIES, THEY ARE NOTED BY THE SYMBOL (P) AT THE LOCATIONS OF THE TEST PITS. A NOTE OR NOTES CONTAINING THE RESULTS OF THE TEST PIT OR PITS IS INCLUDED ON THE DRAWINGS. EXISTING UTILITIES IN THE VICINITY OF THE PROPOSED WORK FOR WHICH TEST PITS HAVE NOT BEEN DUG SHALL BE LOCATED BY THE CONTRACTOR TWO WEEKS IN ADVANCE OF CONSTRUCTION OPERATIONS AT HIS OWN EXPENSE.
 - THE CONTRACTOR SHALL NOTIFY THE FOLLOWING UTILITY COMPANIES OR AGENCIES AT LEAST FIVE WORKING DAYS BEFORE STARTING WORK SHOWN ON THESE PLANS:
 - AT&T 1-800-252-1133
 - BGE (CONTRACTOR SERVICES) 410-637-8713
 - BGE (EMERGENCY) 410-669-0123
 - BUREAU OF UTILITIES 410-313-4900
 - COLUMBIA PIPELINE CO 410-795-1390
 - MESS UTILITY 1-800-287-7777
 - STATE HIGHWAY ADMINISTRATION 410-531-5533
 - VERIZON 1-800-745-0033 / 410-224-9210
 - TREES AND SHRUBS ARE TO BE PROTECTED FROM DAMAGE TO THE MAXIMUM EXTENT. TREES AND SHRUBS LOCATED WITHIN THE CONSTRUCTION STOP ARE NOT TO BE REMOVED OR DAMAGED BY THE CONTRACTOR.
 - CONTRACTOR SHALL REMOVE TREES, STUMPS AND ROOTS ALONG THE LINE OF EXCAVATION. PAYMENT FOR SUCH REMOVAL SHALL BE INCLUDED IN THE UNIT PRICE BID FOR THE CONSTRUCTION OF THE MAIN.
 - THE CONTRACTOR SHALL NOTIFY THE BUREAU OF HIGHWAY ADMINISTRATION AT (410)-313-7450 AT LEAST FIVE WORKING DAYS BEFORE OPEN CUTTING OR BORING/JACKING OF ANY COUNTY ROAD FOR LAYING WATER/SEWER MAINS OR HOUSE CONNECTIONS. THE APPROVAL OF THESE DRAWINGS WILL CONSTITUTE COMPLIANCE WITH DPW REQUIREMENTS PER SECTION 18.114(a) OF THE HOWARD COUNTY CODE.
- PART B: WATER MAIN GENERAL NOTES**
- ALL WATER MAINS SHALL BE ANNA C900 PVC, DR-18.
 - TOPS OF ALL WATER MAINS SHALL HAVE A MINIMUM OF 3'-6" OF COVER UNLESS OTHERWISE NOTED.
 - VALVES ADJACENT TO TEES SHALL BE STRAPPED TO TEES.
 - ALL FITTINGS SHALL BE BUTTERFUSED OR ANCHORED WITH CONCRETE IN ACCORDANCE WITH STANDARD DETAILS UNLESS OTHERWISE PROVIDED FOR ON THE DRAWINGS.
 - FIRE HYDRANTS SHALL BE SET TO THE BURY LINE ELEVATIONS SHOWN ON THE DRAWINGS. ALL FIRE HYDRANTS SHALL BE INSTALLED IN ACCORDANCE WITH STANDARD DETAILS. THE SOIL AROUND THE FIRE HYDRANT SHALL BE COMPACTED IN ACCORDANCE WITH SECTION 1000 AND SECTION 1005 OF THE STANDARD SPECIFICATIONS.
 - THE CONTRACTOR SHALL NOT OPERATE ANY WATER MAIN VALVES ON THE EXISTING WATER SYSTEM.
 - TRACES WIRE AND CONTINUITY TEST STATIONS SHALL BE INSTALLED ON ALL D.I.P. AND PVC WATER MAINS IN ACCORDANCE WITH HOWARD COUNTY DESIGN MANUAL.
 - FOR PVC WATER MAINS, ALL RECORDS FOR THE QUALITY CONTROL AND QUALIFICATION TEST REQUIREMENTS NOTED IN SECTION 5.1 OF THE ANNA STANDARD C900 FOR PVC PRESSURE PIPE SHALL BE SUBMITTED WITH THE PIPE MATERIAL CERTIFICATIONS OR SHOP DRAWINGS PRIOR TO APPROVAL OF THE MATERIAL FOR USE. THE TEST RECORDS SHALL BE FOR THE PIPE TO BE INSTALLED UNDER THIS CONTRACT. ALL PVC PIPE SHALL CONTAIN MARKINGS TO ALLOW CROSS REFERENCING OF THE PIPE SUPPLIED TO THE TEST RECORDS RECEIVED.
 - UNLESS OTHERWISE NOTED ON THE PLANS OR IN THE SPECIFICATIONS, SEVENTEEN (17) POUND SACRIFICIAL ANODES SHALL BE INSTALLED ON ALL VALVES AND METALLIC FITTINGS USED IN ACCORDANCE WITH VOLUME IV, STANDARD SPECIFICATIONS AND DETAILS FOR CONSTRUCTION. MAGNESIUM ANODES SHALL BE INSTALLED ON ALL VALVES AND DUCTILE IRON FITTINGS INCLUDING RESTRAINTS AND HARNESSES. ZINC ANODES SHALL BE INSTALLED ON ALL STAINLESS STEEL FITTINGS AND SADDLES USED WITH PVC MAINS. ALL TEST USED PVC MAINS SHALL BE DUCTILE IRON.
 - PROPER ASSEMBLY OF GASKETED PVC PIPE JOINTS: THE MANUFACTURER'S INSERTION LINE OF GASKETED PVC PIPE JOINTS INDICATES THE MAXIMUM DEPTH OF INSERTION OF THE SPIGOT INTO THE BELL. AFTER ASSEMBLY OF THE JOINT, THE INSERTION LINE SHALL REMAIN VISIBLE. DUAL INSERTION LINES ON GASKETED PVC PIPE INDICATE THE MAXIMUM AND MINIMUM DEPTH OF INSERTION OF THE SPIGOT INTO THE BELL. THE CONTRACTOR SHALL NOT OVER INSERT OR OVER HOME THE SPIGOT INTO THE BELL OF PVC PIPE.
 - ALL CHANGES IN HORIZONTAL OR VERTICAL DIRECTION OF PVC WATER PIPE SHALL BE MADE WITH STANDARD BENDS, 5-DEGREE SWEEPS OR HIGH DEFLECTION COUPLINGS. NO BENDING OF THE PIPE OR DEFLECTING OF PVC PIPE JOINTS IS PERMITTED, UNLESS HIGH DEFLECTION COUPLINGS OR 5-DEGREE SWEEPS ARE PERMITTED. THE CONTRACTOR SHALL PROVIDE ONE FULL PIPE LENGTH (20 FOOT LONG) ON EITHER SIDE OF THE HIGH DEFLECTION COUPLING OR 5-DEGREE SWEEP, TAKING CARE NOT TO USE COMPACTION EQUIPMENT DIRECTLY OVER THE FITTING.
 - PVC HIGH DEFLECTION COUPLINGS SHALL BE LIMITED TO A TOTAL OF 3-DEGREES (1 1/2-DEGREE ON EITHER END OF THE COUPLING). SHALL BE RATED FOR A MINIMUM 200 PSI MEETING THE REQUIREMENTS OF ANNA C900. SHALL HAVE A MINIMUM LENGTH OF 9-INCHES AND SHALL HAVE CENTER STOPS. PVC HIGH DEFLECTION COUPLINGS SHALL BE CERTAINTIZED PVC HIGH DEFLECTION (HD) STOP COUPLINGS OR EQUAL.
 - FIVE DEGREE SWEEPS SHALL BE BELL BY SPIGOT, RATED FOR A MINIMUM 225 PSI, DR-18 MEETING THE REQUIREMENTS OF ANNA C900 AND SHALL BE MULTI FITTINGS (IPEX) BLUE BRUTE DR-18 OR EQUAL.
 - WHEN PVC HIGH DEFLECTION COUPLINGS OR PVC 5-DEGREE SWEEPS ARE USED TO FACILITATE CHANGES IN HORIZONTAL OR VERTICAL ALIGNMENTS OF ANNA C900 PVC PIPELINES, THE CONTRACTOR SHALL INSERT DEVICES FOR THE PREVENTION OF OVER-INSERTION OF THE PVC PIPE SPIGOTS INTO THE BELL OR BELL JOINT ON BOTH SIDES OF THE HIGH DEFLECTION COUPLINGS AND 5-DEGREE SWEEPS. BELL STOPS SHALL BE PLACED AT THE PROPER INSERTION LINE FOR THE FITTING. THE BELL STOP SHALL BE MANUFACTURED OF DUCTILE IRON AND INCORPORATE AN EXPANSION RESTRICTION SPRING TO ALLOW FOR PIPE EXPANSION AND CONTRACTION. THE BELL STOPS SHALL BE SET AS MANUFACTURED BY FEMA IRON, INC. OR APPROVED EQUAL.
 - TO ACCOMMODATE A SPRINKLER SYSTEM, ALL RESIDENTIAL DWELLING UNITS SHALL HAVE A 1-1/2" WATER HOUSE CONNECTION WITH A 1" OUTSIDE METER SETTING, STD. DET. W-3.2B.
- PART C: SEWER MAIN GENERAL NOTES**
- ALL SEWER MAINS SHALL BE D.I.P. OR P.V.C. UNLESS OTHERWISE NOTED.
 - ENCLAVES SHALL BE 4'-0" INSIDE DIAMETER UNLESS OTHERWISE NOTED.
 - FORCE MAINS SHALL BE D.I.P. ONLY.
 - MANHOLES SHOWN WITH 12" AND 18" WALLS ARE FOR BRICK MANHOLES ONLY.
 - WHERE WATER TIGHT MANHOLE FRAMES AND COVERS ARE USED, SET TOP OF FRAME 1'-6" ABOVE FINISHED GRADE UNLESS OTHERWISE NOTED ON THE DRAWINGS.
 - HOUSE(S) WITH THE SYMBOL "C.N.S." INDICATES THAT CELLAR CANNOT BE SERVED.

DEPARTMENT OF PUBLIC WORKS HOWARD COUNTY, MARYLAND CHIEF, BUREAU OF UTILITIES DATE 7/2/17	DEPARTMENT OF PLANNING AND ZONING HOWARD COUNTY, MARYLAND CHIEF, DEVELOPMENT ENGINEERING DIVISION DATE 7/19/17	I HEREBY CERTIFY THAT THESE DOCUMENTS WERE PREPARED OR APPROVED BY ME, AND THAT I AM A DULY LICENSED PROFESSIONAL ENGINEER UNDER THE LAWS OF THE STATE OF MARYLAND. LICENSE NO. 12043 EXPIRATION DATE IS 7/18/18. FISHER, COLLINS & CARTER, INC. CIVIL ENGINEERING CONSULTANTS & LAND SURVEYORS CENTRAL SQUARE OFFICE PARK - 1072 BALDORRE NATIONAL FEE ELICOTT CITY, MARYLAND 21042 (410) 461-2295	DESIGNED BY: B.C.R. DRAWN BY: B.C.R. CHECKED BY: P.M.K. DATE: JULY, 2017 PCC BY NO.	600' SCALE MAP NO. 34 BLOCK NO. 10 F.C.C. WORK ORDER NO. 13008-3001 FILE NAME: SEWER & WATER MAIN EXTENSION PLAN	ENCLAVE AT RIVER HILL: PHASE II LOTS 55 THRU 74, 82 THRU 124, 130 THRU 159, 161 THRU 160 & OPEN SPACE LOTS 125 THRU 129, 160 & 169 SEWER & WATER MAIN EXTENSIONS CONTRACT NO. 34-4992-D FIFTH ELECTION DISTRICT HOWARD COUNTY, MARYLAND	SCALE AS SHOWN SHEET 1 OF 16
--------------------------------------------------------------------------------------------------------	-----------------------------------------------------------------------------------------------------------------------------	---------------------------------------------------------------------------------------------------------------------------------------------------------------------------------------------------------------------------------------------------------------------------------------------------------------------------------------------------------------------------------------------------------------------------	-------------------------------------------------------------------------------------------------	------------------------------------------------------------------------------------------------------------------------	------------------------------------------------------------------------------------------------------------------------------------------------------------------------------------------------------------------------------------------------------------------------------	---------------------------------

I:\2013\13008\Utility\Water & Sewer\Contract\34-4992-D\Phase II\final\13008-3001-Water & Sewer\Contract\Planning

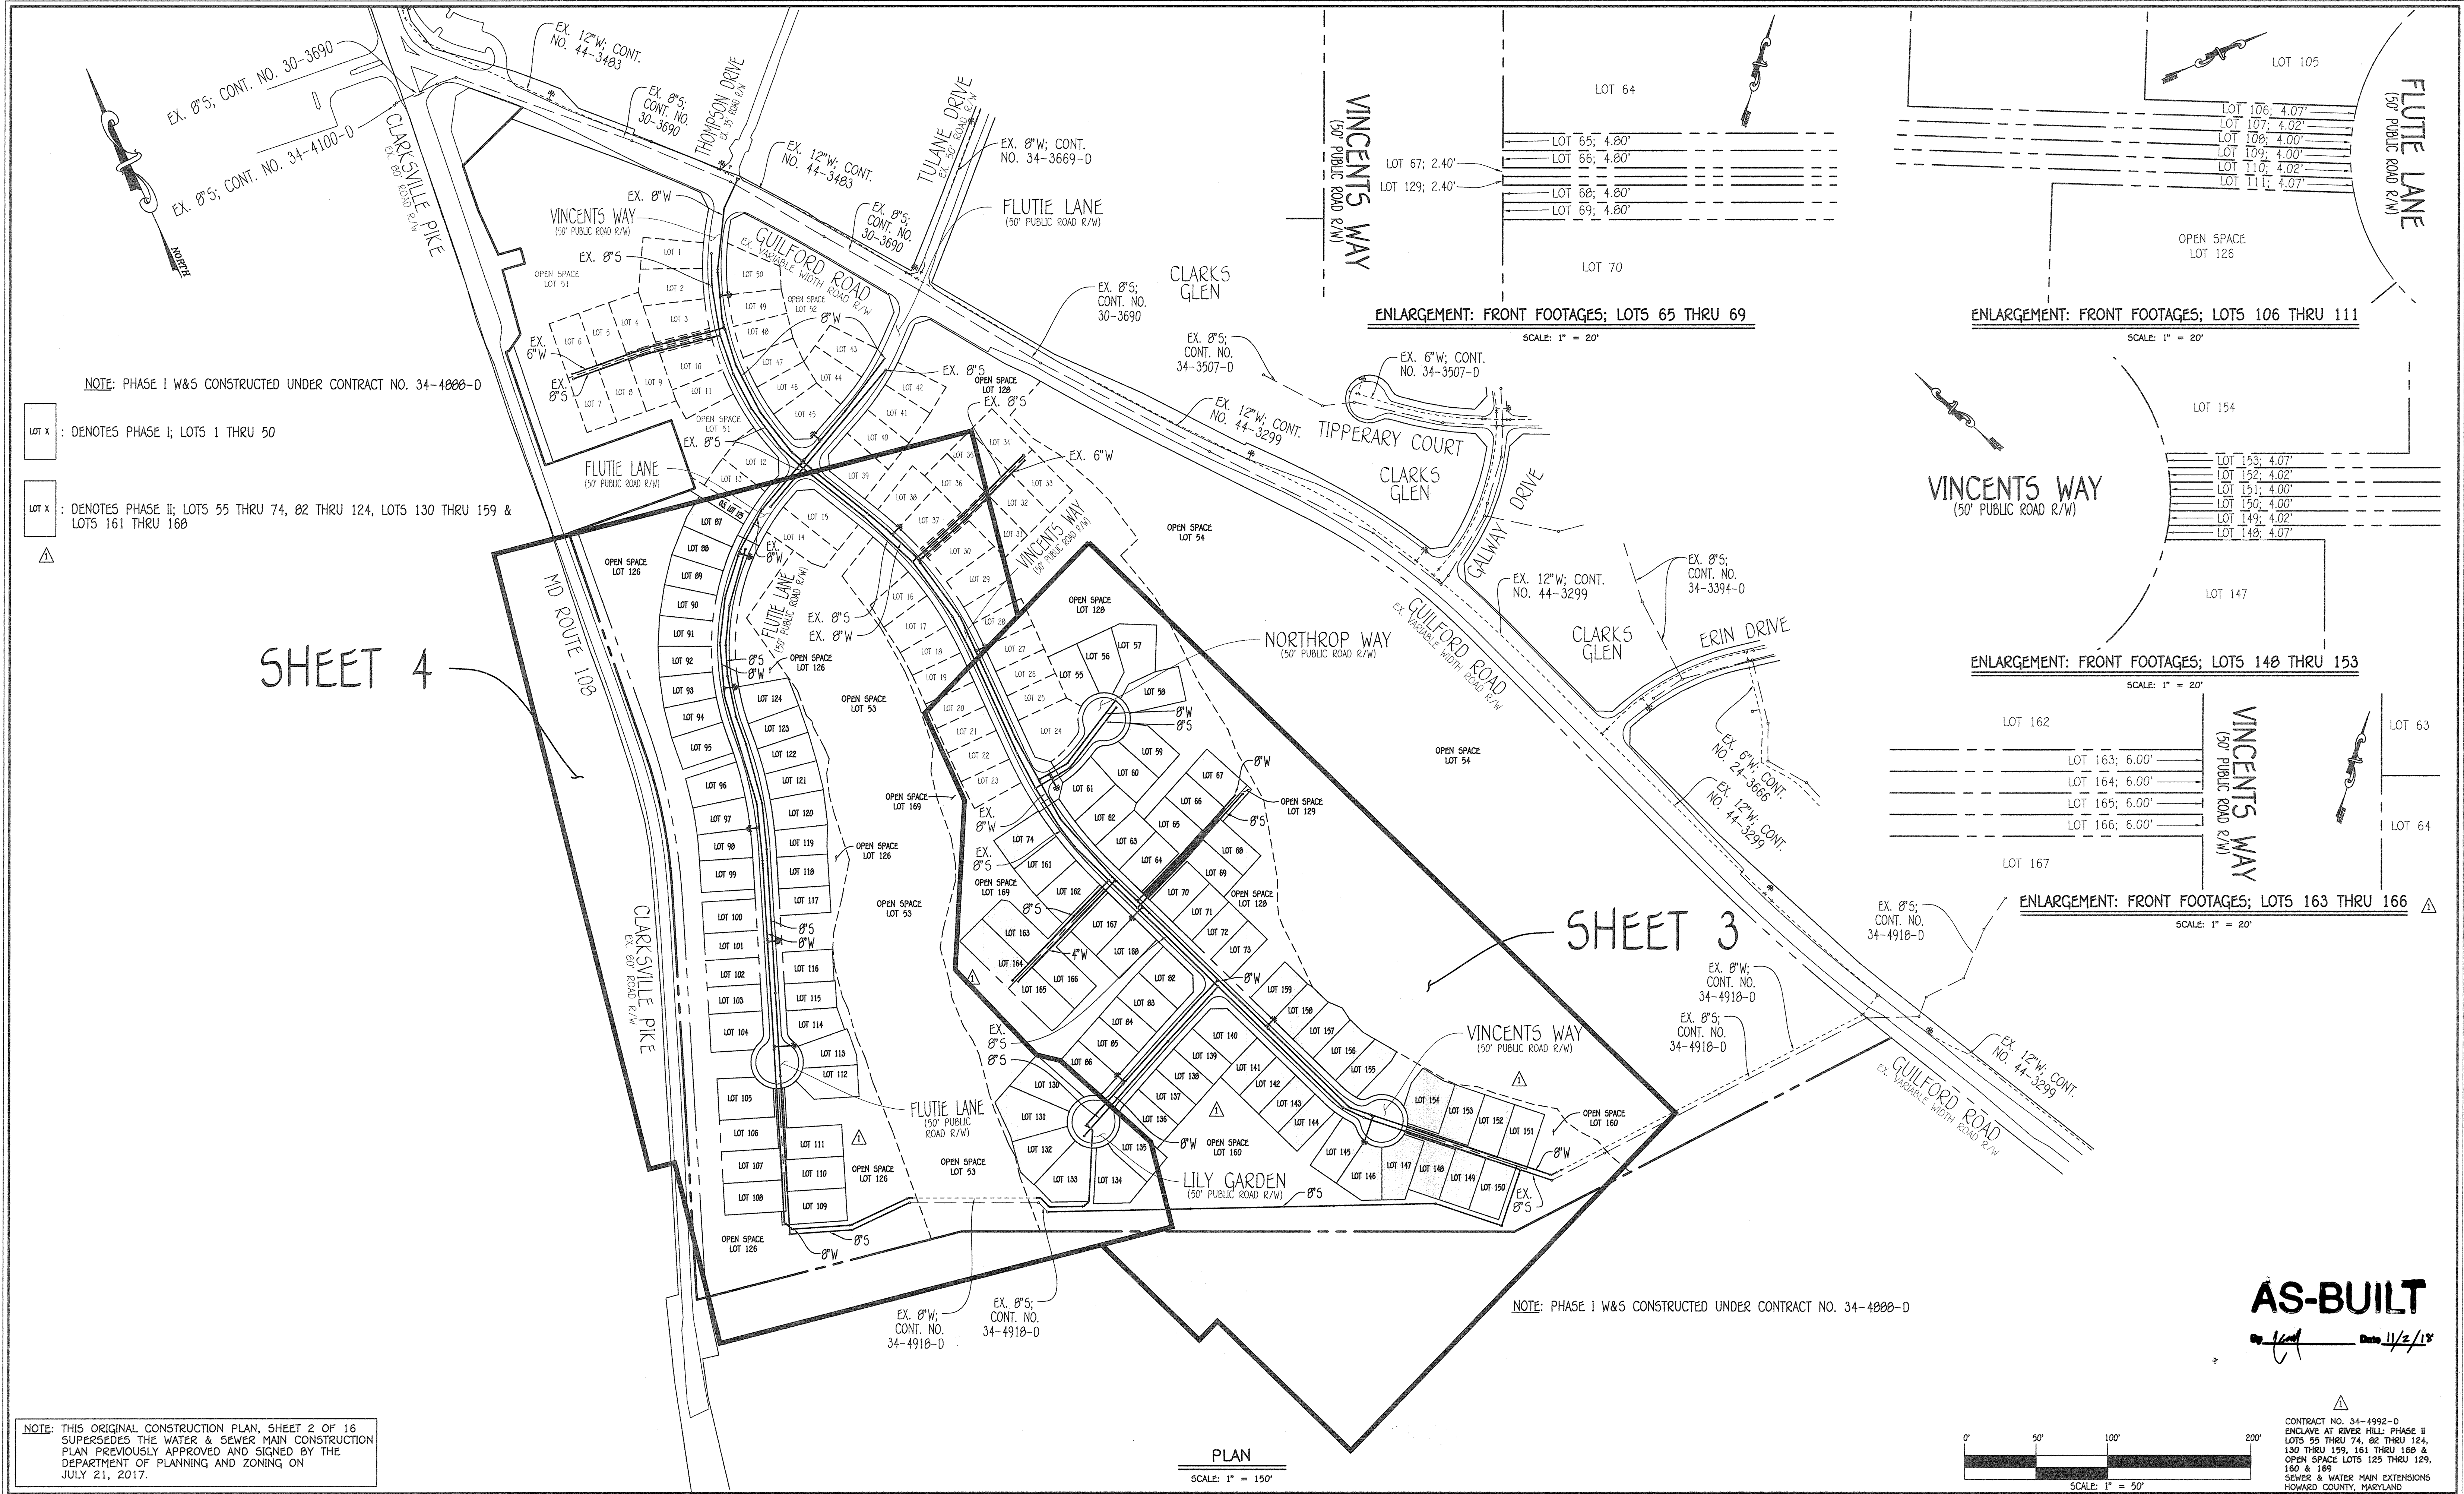

SHEET 4

SHEET 3

PLAN
SCALE: 1" = 150'

NOTE: PHASE I W&S CONSTRUCTED UNDER CONTRACT NO. 34-4888-D


NOTE: PHASE I W&S CONSTRUCTED UNDER CONTRACT NO. 34-4888-D

NOTE: THIS ORIGINAL CONSTRUCTION PLAN, SHEET 2 OF 16 SUPERSEDES THE WATER & SEWER MAIN CONSTRUCTION PLAN PREVIOUSLY APPROVED AND SIGNED BY THE DEPARTMENT OF PLANNING AND ZONING ON JULY 21, 2017.

DEPARTMENT OF PUBLIC WORKS
HOWARD COUNTY, MARYLAND
[Signature]
CHIEF, BUREAU OF UTILITIES
DATE: 2-23-18

DEPARTMENT OF PLANNING AND ZONING
HOWARD COUNTY, MARYLAND
[Signature]
CHIEF, DEVELOPMENT ENGINEERING DIVISION
DATE: 3-9-18

I HEREBY CERTIFY THAT THESE DOCUMENTS WERE PREPARED OR APPROVED BY ME, AND THAT I AM A DULY LICENSED PROFESSIONAL ENGINEER UNDER THE LAWS OF THE STATE OF MARYLAND.
LICENSE NO. 12043 EXPIRATION DATE IS 7/18/18.
FISHER, COLLINS & CARTER, INC.
CIVIL ENGINEERING CONSULTANTS & LAND SURVEYORS
CENTRAL SQUARE OFFICE PARK - 10272 BALTIMORE NATIONAL PIKE
ELLIOTT CITY, MARYLAND 21042
(410) 461-2895

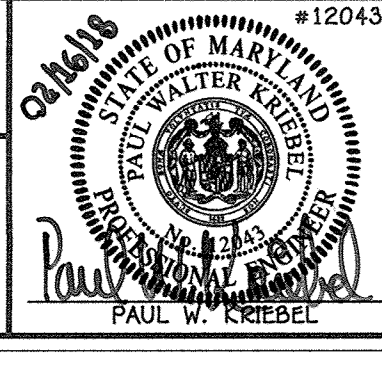


DESIGNED BY:	DATE:	BY:	NO.	REVISION	DATE:
B.C.R.					
FCC	1-5-18	ADD FRONT FOOTAGE ENLARGEMENT FOR LOTS 163 THRU 168			
FCC	1-5-18	REVISE LOT LINES: LOTS 55 THRU 58, 136 THRU 159 & LOTS 161 THRU 168			
FCC	1-5-18	REVISE LOT LINES: LOTS 105 THRU 111			
FCC	1-5-18	REVISE CONTRACT TITLE & PLAN TO REFLECT LOT NUMBER CHANGES			

OVERALL SITE EXHIBIT
PLAN
FRONT FOOTAGE ENLARGEMENTS
600' SCALE MAP NO. 34 BLOCK NO. 1B
F.C.C. WORK ORDER NO. 13008-3001
FILE NAME: SEWER & WATER MAIN EXTENSION PLAN


ENCLAVE AT RIVER HILL: PHASE II
LOTS 55 THRU 74, 82 THRU 124, 130 THRU 159, 161 THRU 168 &
OPEN SPACE LOTS 125 THRU 129, 160 & 169
SEWER & WATER MAIN EXTENSIONS
CONTRACT NO. 34-4992-D
FIFTH ELECTION DISTRICT
HOWARD COUNTY, MARYLAND
SCALE: AS SHOWN
SHEET 2 OF 16

AS-BUILT
[Signature] 11/2/18

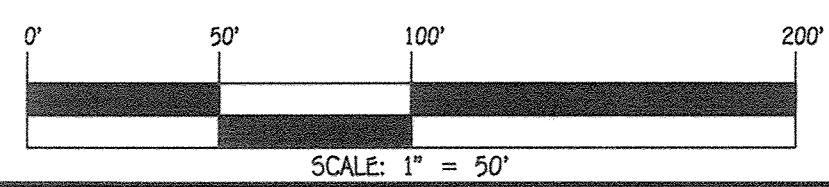

CONTRACT NO. 34-4992-D
ENCLAVE AT RIVER HILL: PHASE II
LOTS 55 THRU 74, 82 THRU 124,
130 THRU 159, 161 THRU 168 &
OPEN SPACE LOTS 125 THRU 129,
160 & 169
SEWER & WATER MAIN EXTENSIONS
HOWARD COUNTY, MARYLAND

I:\2013\13009_Ang\Water & Sewer Contracts\Water & Sewer Contract Plans\dwg, 2/15/2018 6:37:23 PM

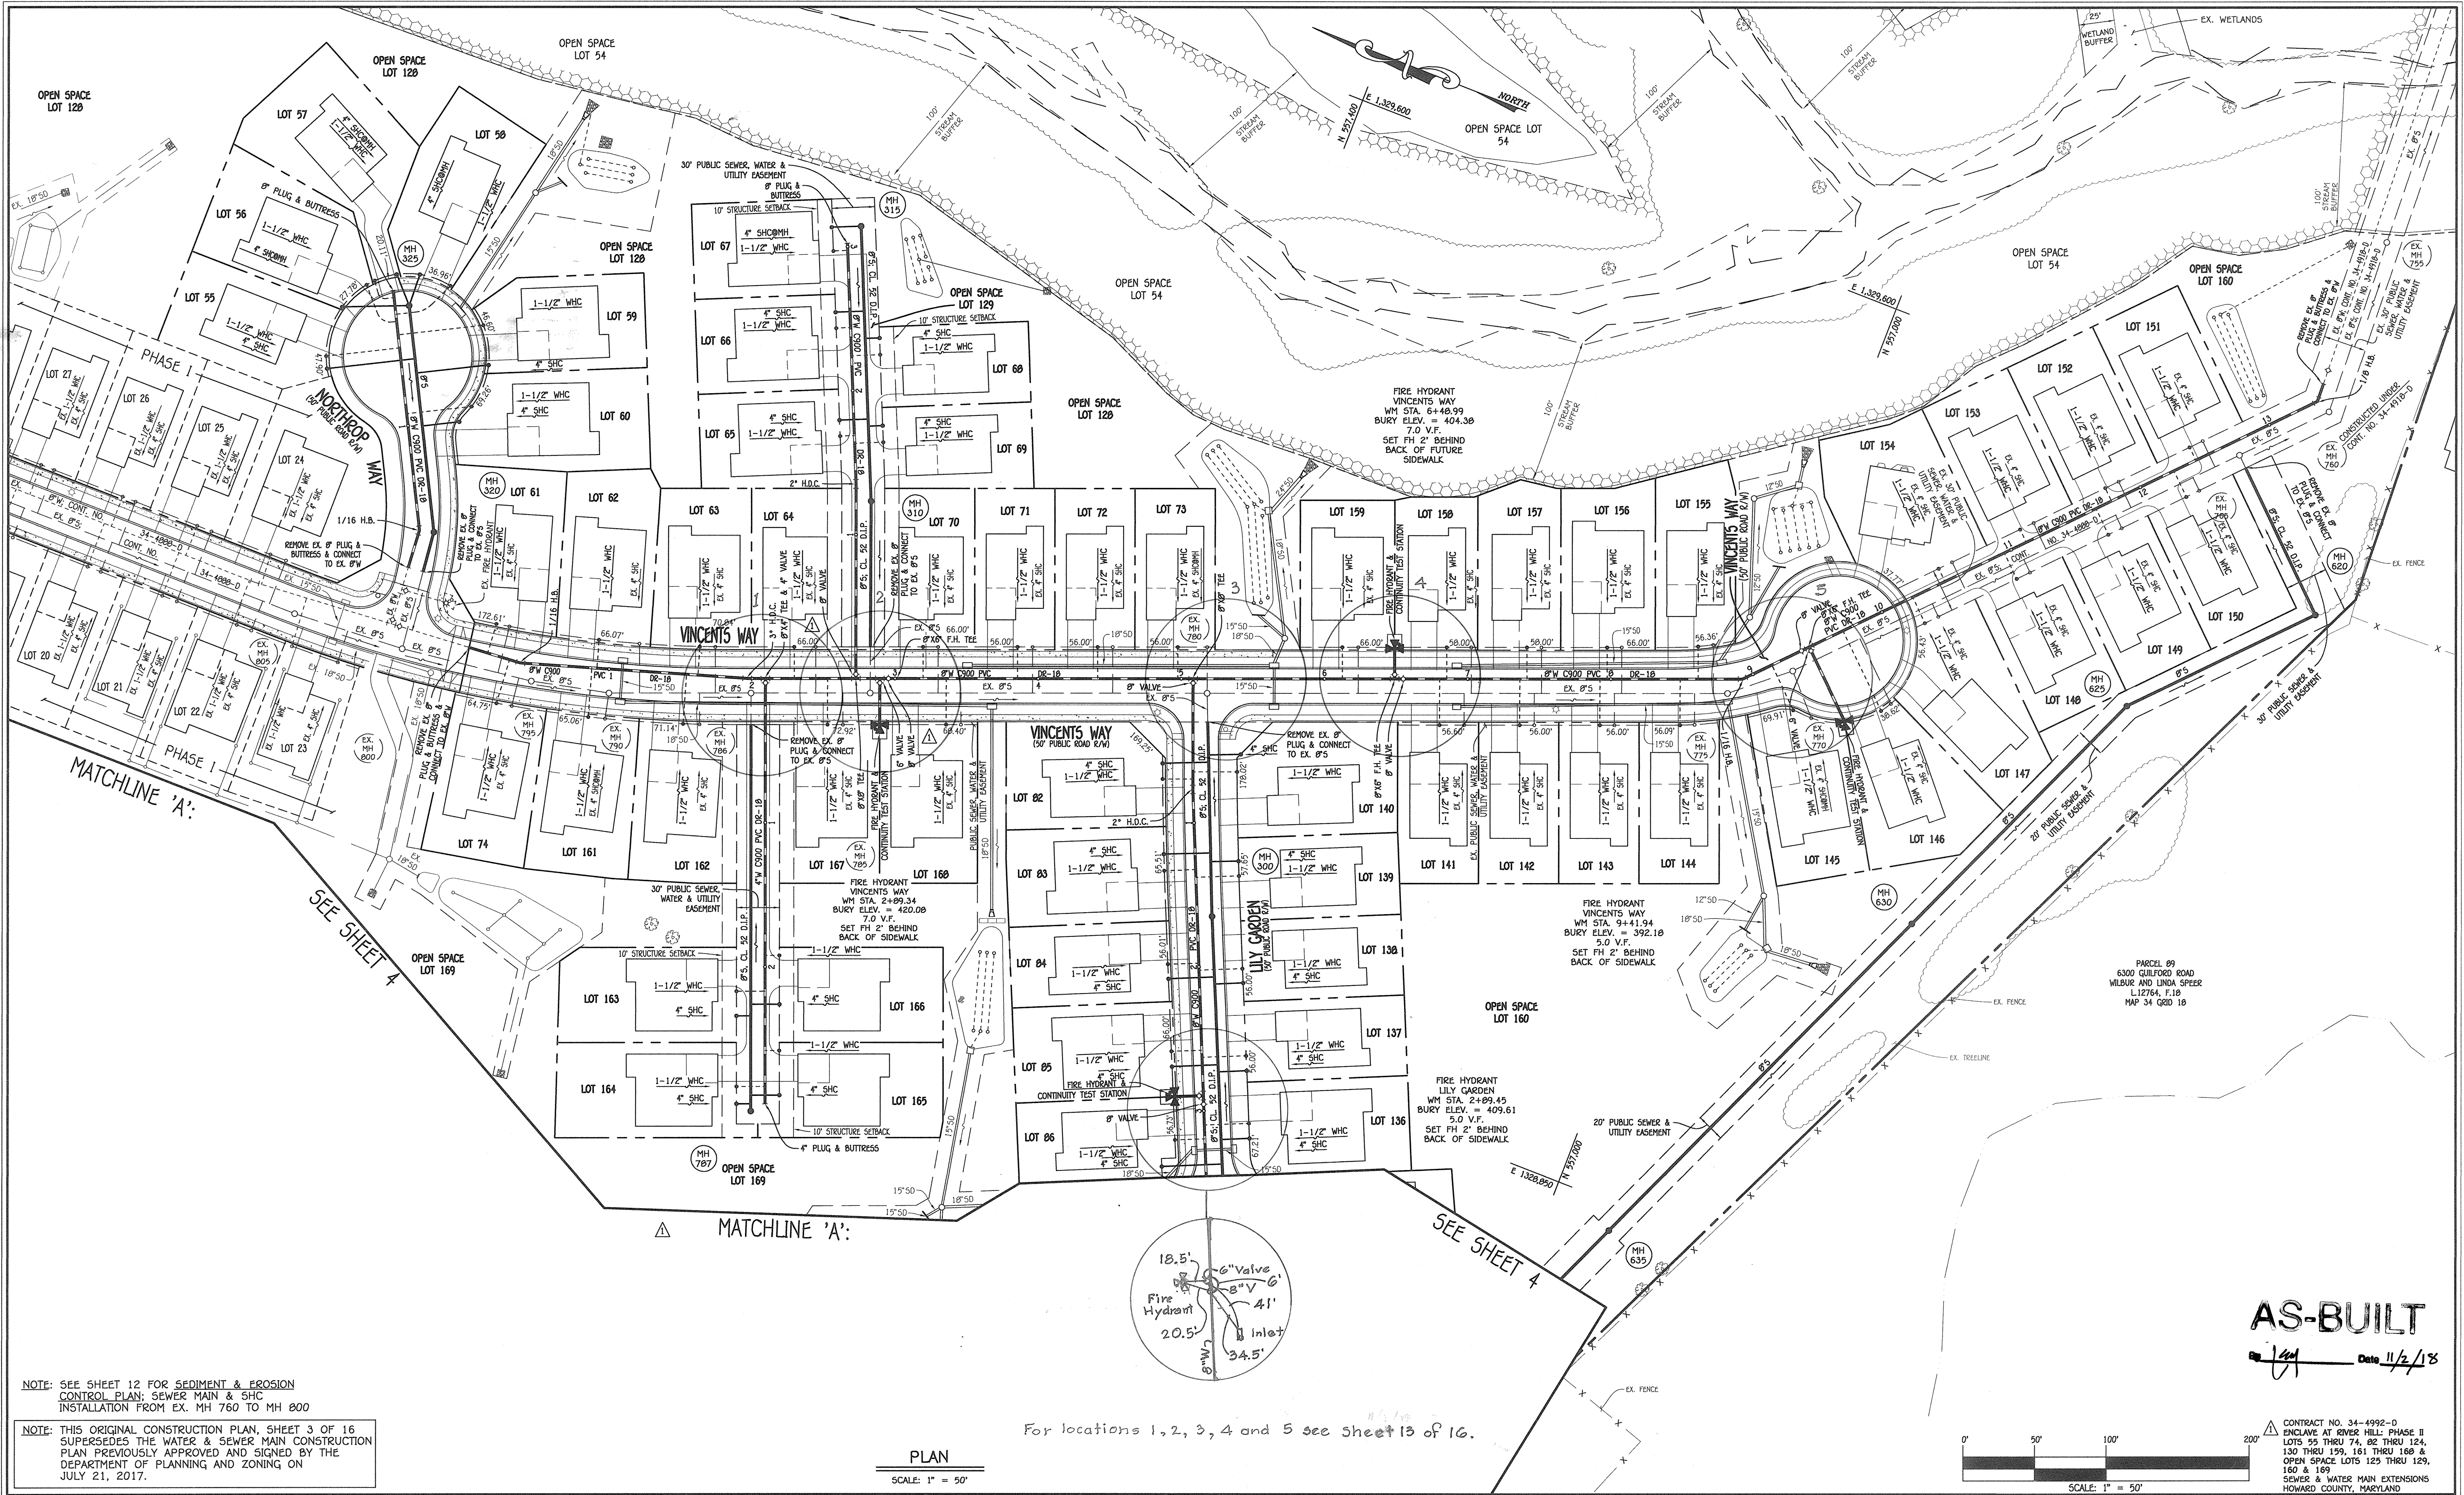


NOTE: SEE SHEET 12 FOR SEDIMENT & EROSION CONTROL PLAN; SEWER MAIN & SHC INSTALLATION FROM EX. MH 760 TO MH 800

NOTE: THIS ORIGINAL CONSTRUCTION PLAN, SHEET 3 OF 16 SUPERSEDES THE WATER & SEWER MAIN CONSTRUCTION PLAN PREVIOUSLY APPROVED AND SIGNED BY THE DEPARTMENT OF PLANNING AND ZONING ON JULY 21, 2017.

PLAN
SCALE: 1" = 50'

For locations 1, 2, 3, 4 and 5 see sheet 13 of 16.

AS-BUILT
Date 11/2/18

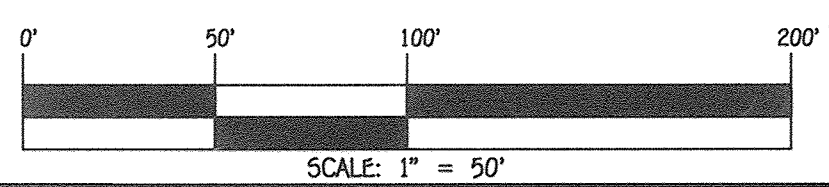

CONTRACT NO. 34-4992-D
ENCLAVE AT RIVER HILL: PHASE II
LOTS 55 THRU 74, 82 THRU 124,
130 THRU 159, 161 THRU 168 &
OPEN SPACE LOTS 125 THRU 129,
160 & 169
SEWER & WATER MAIN EXTENSIONS
HOWARD COUNTY, MARYLAND

DEPARTMENT OF PUBLIC WORKS
HOWARD COUNTY, MARYLAND

[Signature]
CHIEF, BUREAU OF UTILITIES

2-2-18
DATE


DEPARTMENT OF PLANNING AND ZONING
HOWARD COUNTY, MARYLAND

[Signature]
CHIEF, DEVELOPMENT ENGINEERING DIVISION

3-9-18
DATE

I HEREBY CERTIFY THAT THESE DOCUMENTS WERE PREPARED OR APPROVED BY ME, AND THAT I AM A DULY LICENSED PROFESSIONAL ENGINEER UNDER THE LAWS OF THE STATE OF MARYLAND.
LICENSE NO. 12043 EXPIRATION DATE IS 7/15/18.

FISHER, COLLINS & CARTER, INC.
CIVIL ENGINEERING CONSULTANTS & LAND SURVEYORS
CENTRAL SQUARE OFFICE PARK - 10272 BALDORNE NATIONAL PIKE
ELLSWORTH CITY, MARYLAND 21042
(410) 461 - 2995

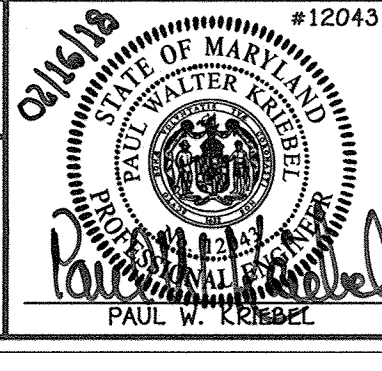

DESIGNED BY:	FCC	RELOCATE FIRE HYDRANT ALONG VINCENTS WAY TO STA. 2+89.34	1-5-18
B.C.R.	▲		
DRAWN BY: <td>FCC</td> <td>REVERSE LOT LINES: LOTS 55 THRU 58, 136 THRU 159 & LOTS 161 THRU 168</td> <td>1-5-18</td>	FCC	REVERSE LOT LINES: LOTS 55 THRU 58, 136 THRU 159 & LOTS 161 THRU 168	1-5-18
B.C.R.	▲		
CHECKED BY: <td>FCC</td> <td>ADD W&S MAIN EXTENSIONS FOR LOTS 163-166</td> <td>1-5-18</td>	FCC	ADD W&S MAIN EXTENSIONS FOR LOTS 163-166	1-5-18
P.W.K.	▲		
DATE: <td>FCC</td> <td>ADD TWO (2) LOTS OFF VINCENTS WAY, BETWEEN LOTS 162 & 167</td> <td>1-5-18</td>	FCC	ADD TWO (2) LOTS OFF VINCENTS WAY, BETWEEN LOTS 162 & 167	1-5-18
FEBRUARY, 2018	▲	REVISE CONTRACT TITLE & PLAN TO REFLECT LOT NUMBER CHANGES	1-5-18
BY NO.			

SEWER & WATER MAIN EXTENSIONS PLAN	
600' SCALE MAP NO. 34	BLOCK NO. 18
F.C.C. WORK ORDER NO. 13008-3001	
FILE NAME:	SEWER & WATER MAIN EXTENSION PLAN


ENCLAVE AT RIVER HILL: PHASE II
LOTS 55 THRU 74, 82 THRU 124, 130 THRU 159, 161 THRU 168 &
OPEN SPACE LOTS 125 THRU 129, 160 & 169
SEWER & WATER MAIN EXTENSIONS
CONTRACT NO. 34-4992-D
FIFTH ELECTION DISTRICT
HOWARD COUNTY, MARYLAND

SCALE AS SHOWN
SHEET 3 OF 16

I:\2013\13008\Fig\Water & Sewer Contract\Plan.dwg, 2/16/2018 10:52:49 AM

NOTE: THIS ORIGINAL CONSTRUCTION PLAN, SHEET 4 OF 16 SUPERSEDES THE WATER & SEWER MAIN CONSTRUCTION PLAN PREVIOUSLY APPROVED AND SIGNED BY THE DEPARTMENT OF PLANNING AND ZONING ON JULY 21, 2017.

For locations 6, 7, 8, 9, 10 and 11 see Sheet 13 of 16.

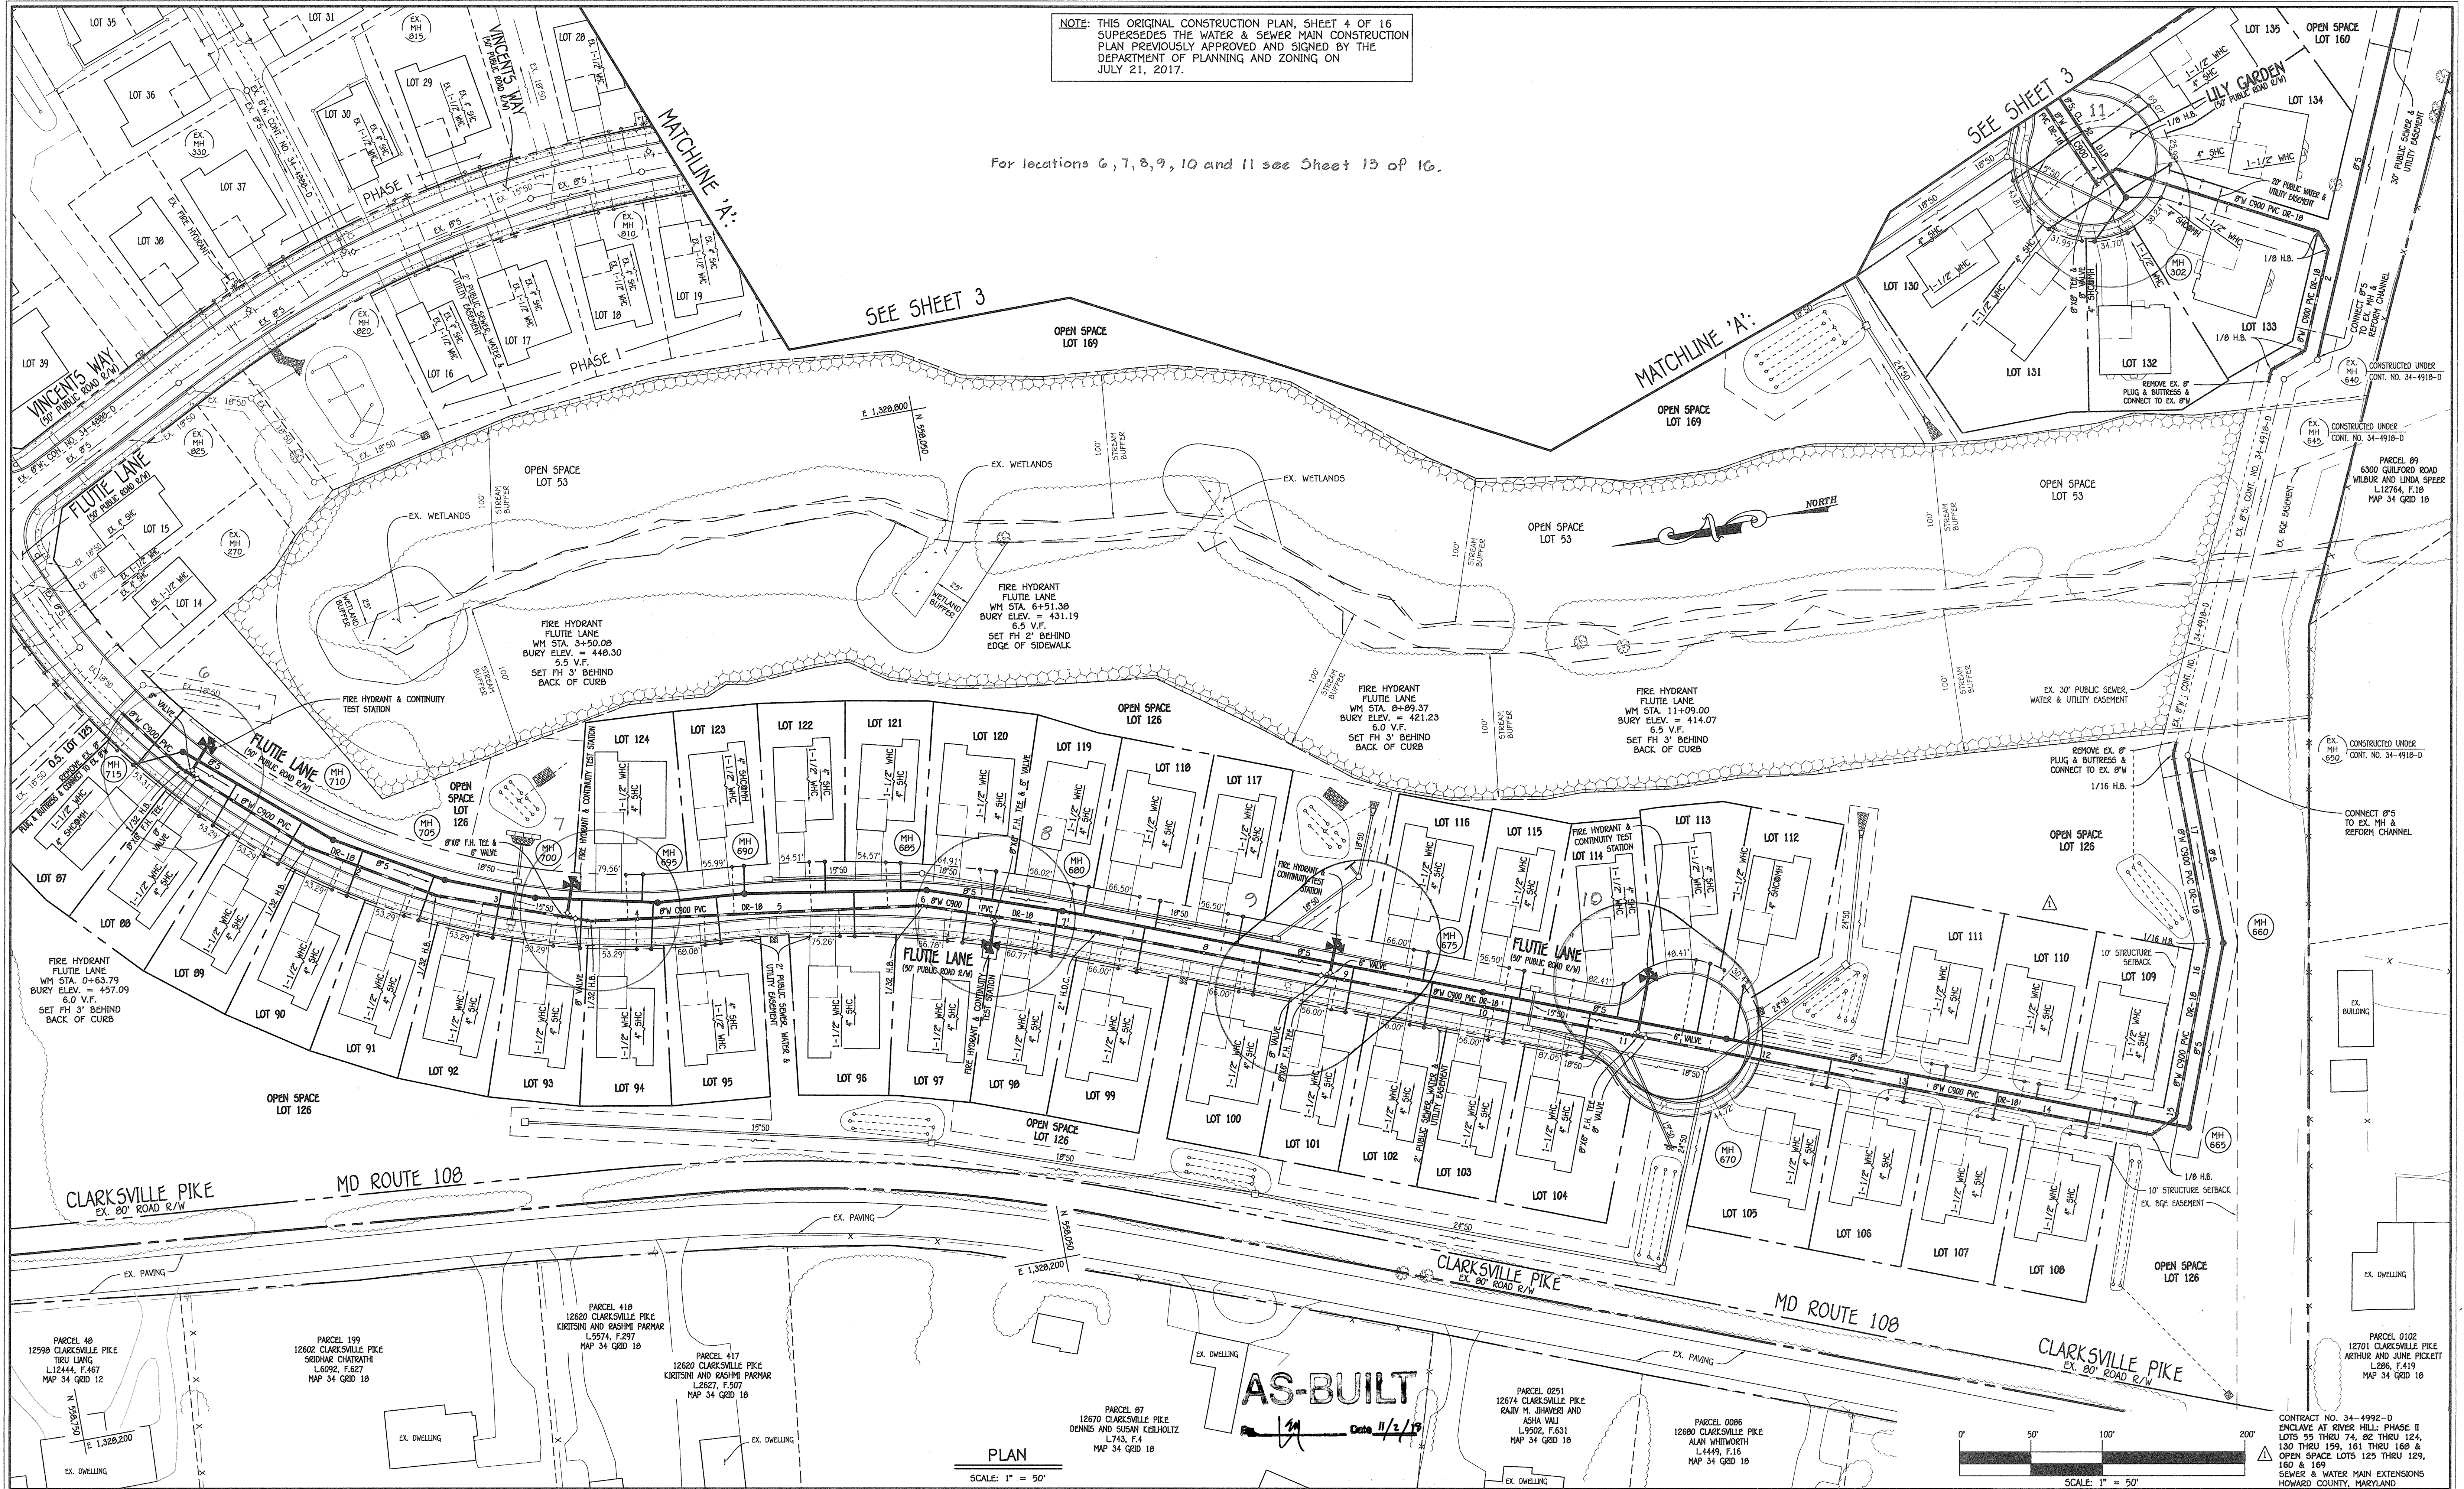

PLAN
SCALE: 1" = 50'

SCALE: 1" = 50'

DEPARTMENT OF PUBLIC WORKS
HOWARD COUNTY, MARYLAND

DEPARTMENT OF PLANNING AND ZONING
HOWARD COUNTY, MARYLAND

1. I HEREBY CERTIFY THAT THESE DOCUMENTS WERE PREPARED OR APPROVED BY ME, AND THAT I AM A DULY LICENSED PROFESSIONAL ENGINEER UNDER THE LAWS OF THE STATE OF MARYLAND. LICENSE NO. 12043 EXPIRATION DATE IS 7/15/18.

FISHER, COLLINS & CARTER, INC.
CIVIL ENGINEERING CONSULTANTS & LAND SURVEYORS
CENTRAL SQUARE OFFICE PARK - 10722 BALTIMORE NATIONAL PIKE
ELLSWORTH CITY, MARYLAND 21042
(410) 461-2995

PAUL W. KRUEPPEL
#12043

DESIGNED BY: B.C.R.
DRAWN BY: B.C.R.
CHECKED BY: P.W.K.
DATE: FEBRUARY, 2018


REVISION

FILE NAME: SEWER & WATER MAIN EXTENSION PLAN

600' SCALE MAP NO. 34 BLOCK NO. 18
F.C.C. WORK ORDER NO. 13008-3001

ENCLAVE AT RIVER HILL: PHASE II
LOTS 55 THRU 74, 82 THRU 124, 130 THRU 159, 161 THRU 168 &
OPEN SPACE LOTS 125 THRU 129, 160 & 169
SEWER & WATER MAIN EXTENSIONS
CONTRACT NO. 34-4992-D
FIFTH ELECTION DISTRICT
HOWARD COUNTY, MARYLAND

SCALE AS SHOWN
SHEET 4 OF 16

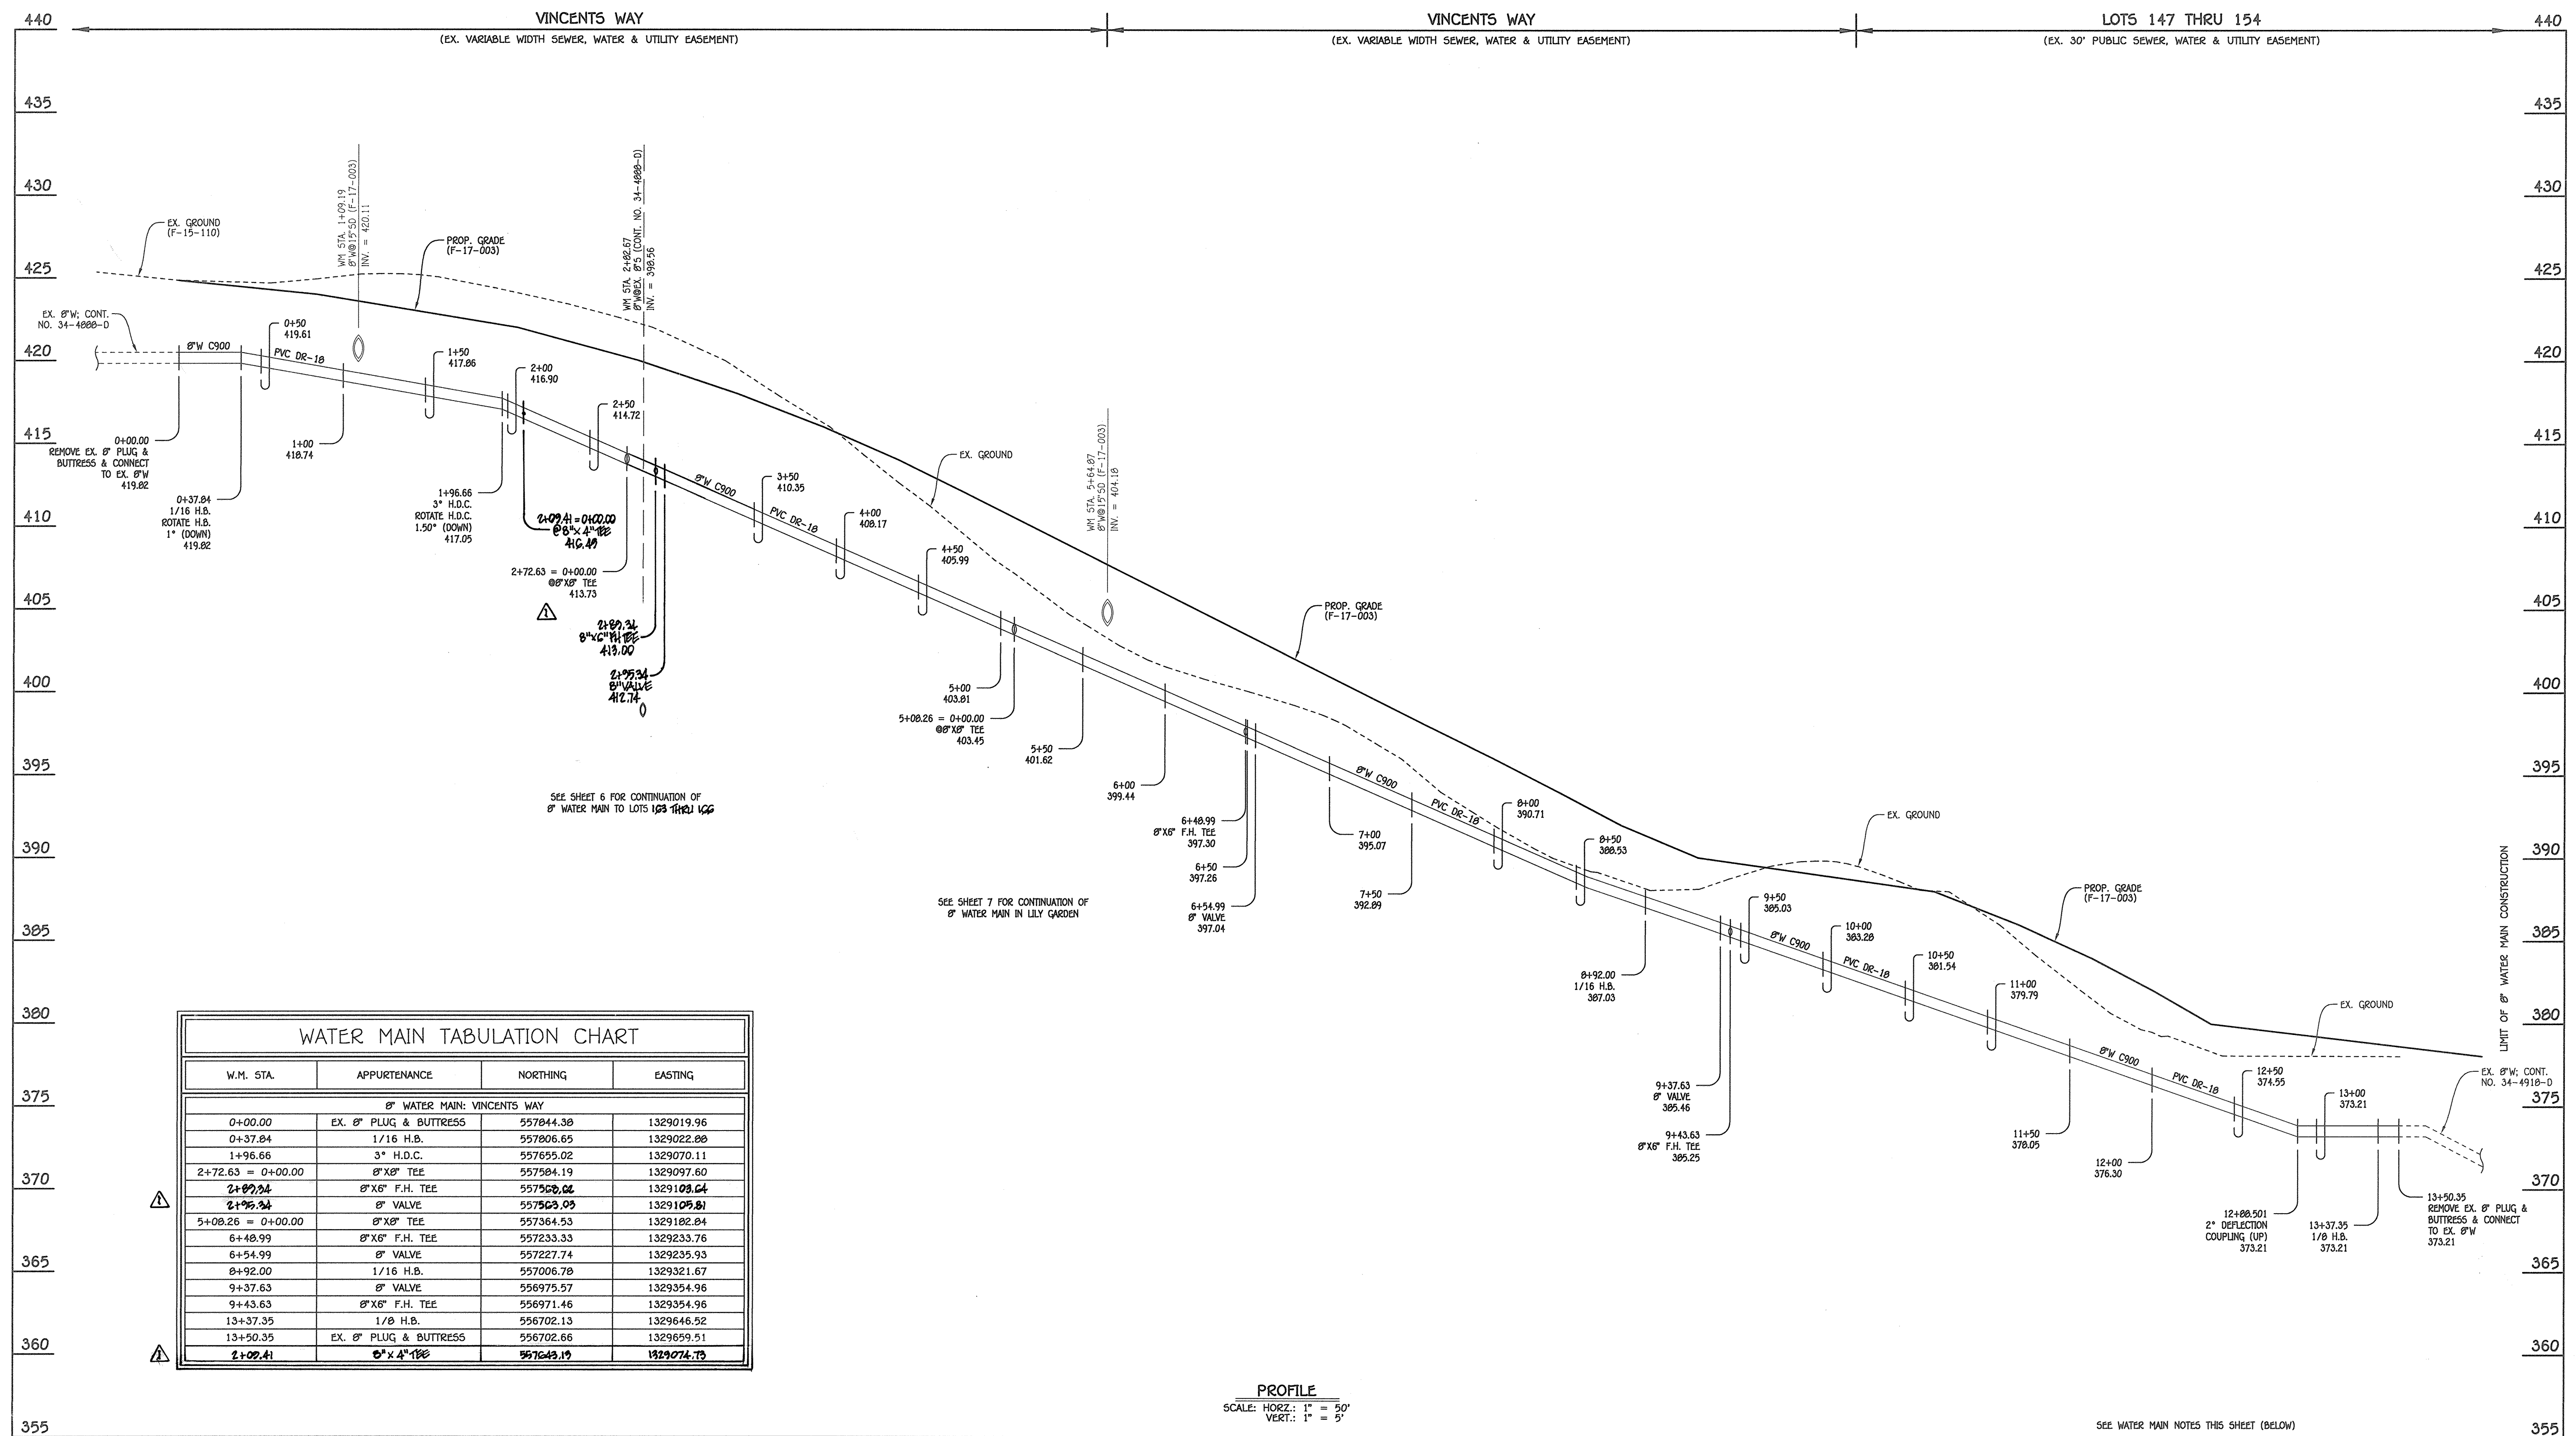


WATER MAIN TABULATION CHART			
W.M. STA.	APPURTENANCE	NORTHING	EASTING
8" WATER MAIN: VINCENTS WAY			
0+00.00	EX. 8" PLUG & BUTTRESS	557844.38	1329019.96
0+37.84	1/16 H.B.	557806.65	1329022.88
1+96.66	3" H.D.C.	557655.02	1329070.11
2+72.63 = 0+00.00	8" X 8" TEE	557584.19	1329097.60
2+89.24	8" X 8" F.H. TEE	557520.02	1329108.64
2+95.34	8" VALVE	557520.09	1329105.81
5+08.26 = 0+00.00	8" X 8" TEE	557364.53	1329182.84
6+48.99	8" X 8" F.H. TEE	557233.33	1329233.76
6+54.99	8" VALVE	557227.74	1329235.93
8+92.00	1/16 H.B.	557006.78	1329321.67
9+37.63	8" VALVE	556975.57	1329354.96
9+43.63	8" X 8" F.H. TEE	556971.46	1329354.96
13+37.35	1/8 H.B.	556702.13	1329646.52
13+50.35	EX. 8" PLUG & BUTTRESS	556702.66	1329659.51
2+02.41	8" X 4" TEE	557643.19	1329074.73

PROFILE
 SCALE: HORIZ.: 1" = 50'
 VERT.: 1" = 5'

8" WATER MAIN: VINCENTS WAY

- WATER MAIN NOTES:
- ALL WATER MAINS SHALL BE AWMA C900 PVC PIPE; DR-18.
 - ALL PIPE BEDDING, TRACER WIRE, LOCATING TAPE AND OTHER APPURTENANCES SHALL BE IN ACCORDANCE WITH THE HOWARD COUNTY DESIGN MANUAL, VOLUME IV - WATER AND SEWER STANDARDS FOR AWMA C900 PVC WATER PIPE INSTALLATION.
 - DEFLECTION COUPLINGS SHALL BE CERTAIN-TIED PVC HIGH DEFLECTION COUPLINGS.
 - ALL WATER HOUSE CONNECTIONS AND TAPS SHALL BE PERFORMED USING A SADDLE.

AS-BUILT
 Date 11/2/18

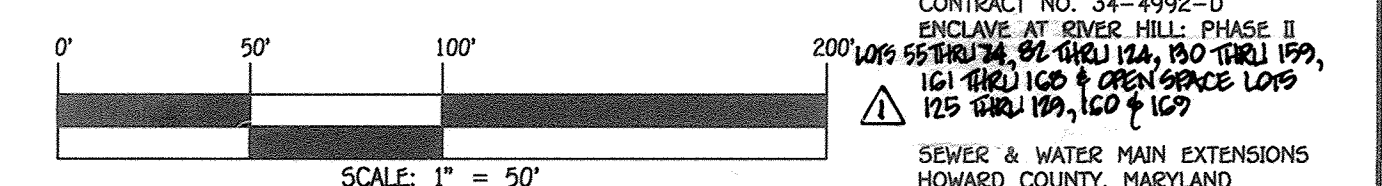

DEPARTMENT OF PUBLIC WORKS
 HOWARD COUNTY, MARYLAND


Charles T. [Signature]
 CHIEF, BUREAU OF UTILITIES
 DATE 7/2/18

DEPARTMENT OF PLANNING AND ZONING
 HOWARD COUNTY, MARYLAND

[Signature]
 CHIEF, DEVELOPMENT-ENGINEERING DIVISION
 DATE 7/2/18

I HEREBY CERTIFY THAT THESE DOCUMENTS WERE PREPARED OR APPROVED BY ME, AND THAT I AM A DULY LICENSED PROFESSIONAL ENGINEER UNDER THE LAWS OF THE STATE OF MARYLAND.
 LICENSE NO. 12043 EXPIRATION DATE IS 7/18/18.

FISHER, COLLINS & CARTER, INC.
 CIVIL ENGINEERING CONSULTANTS & LAND SURVEYORS
 CENTRAL SQUARE OFFICE PARK - 10272 BALTIMORE NATIONAL PIKE
 SUITE 200, CLYDE HILL, MARYLAND 21114
 (410) 461-2895

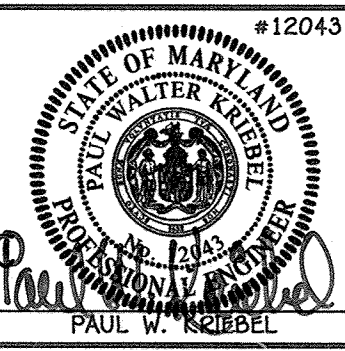

DESIGNED BY: B.C.R.
 DRAWN BY: B.C.R.
 CHECKED BY: P.W.K.
 DATE: JULY, 2017

DATE: 7/2/18
 BY: P.W.K.

WATER MAIN EXTENSIONS
 PROFILE, CHART & NOTES

600' SCALE MAP NO. 34 BLOCK NO. 18
 F.C.C. WORK ORDER NO. 13008-3001


FILE NAME: SEWER & WATER MAIN EXTENSION PLAN

ENCLAVE AT RIVER HILL: PHASE II
 LOTS 95 THRU 124, 130 THRU 159, 161 THRU 168 & OPEN SPACE LOTS 125 THRU 129, 160 & 169

SEWER & WATER MAIN EXTENSIONS
 CONTRACT NO. 34-4992-D
 FIFTH ELECTION DISTRICT
 HOWARD COUNTY, MARYLAND


SCALE AS SHOWN
 SHEET 5 OF 16

I:\2013\13008.dwg Water & Sewer Contract No. 34-4992-D Phase 2\Finals\13008-3001 Water & Sewer Contract Planning

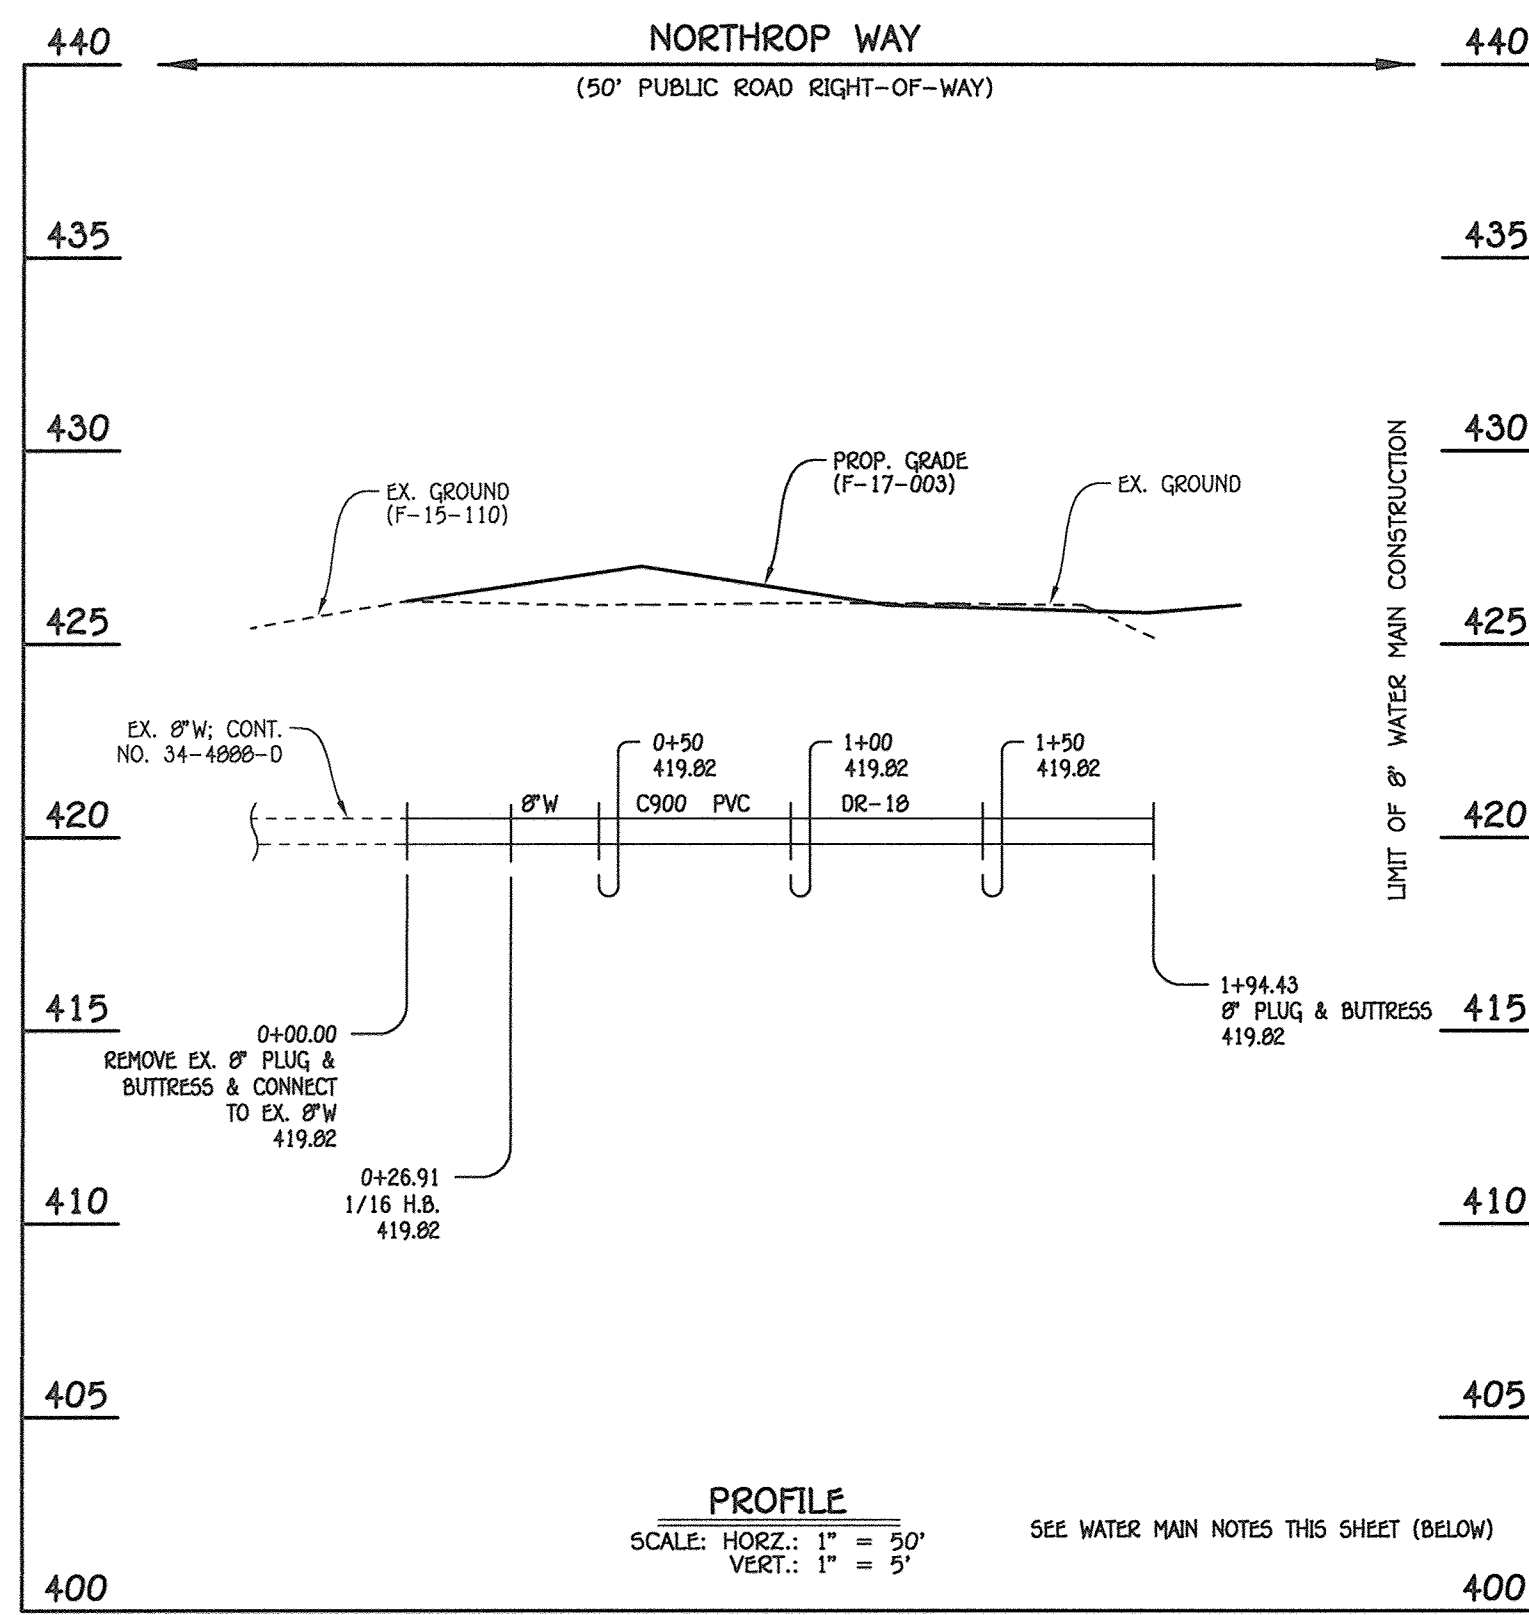


8" WATER MAIN: NORTHROP WAY

SCALE: HORIZ.: 1" = 50'
VERT.: 1" = 5'

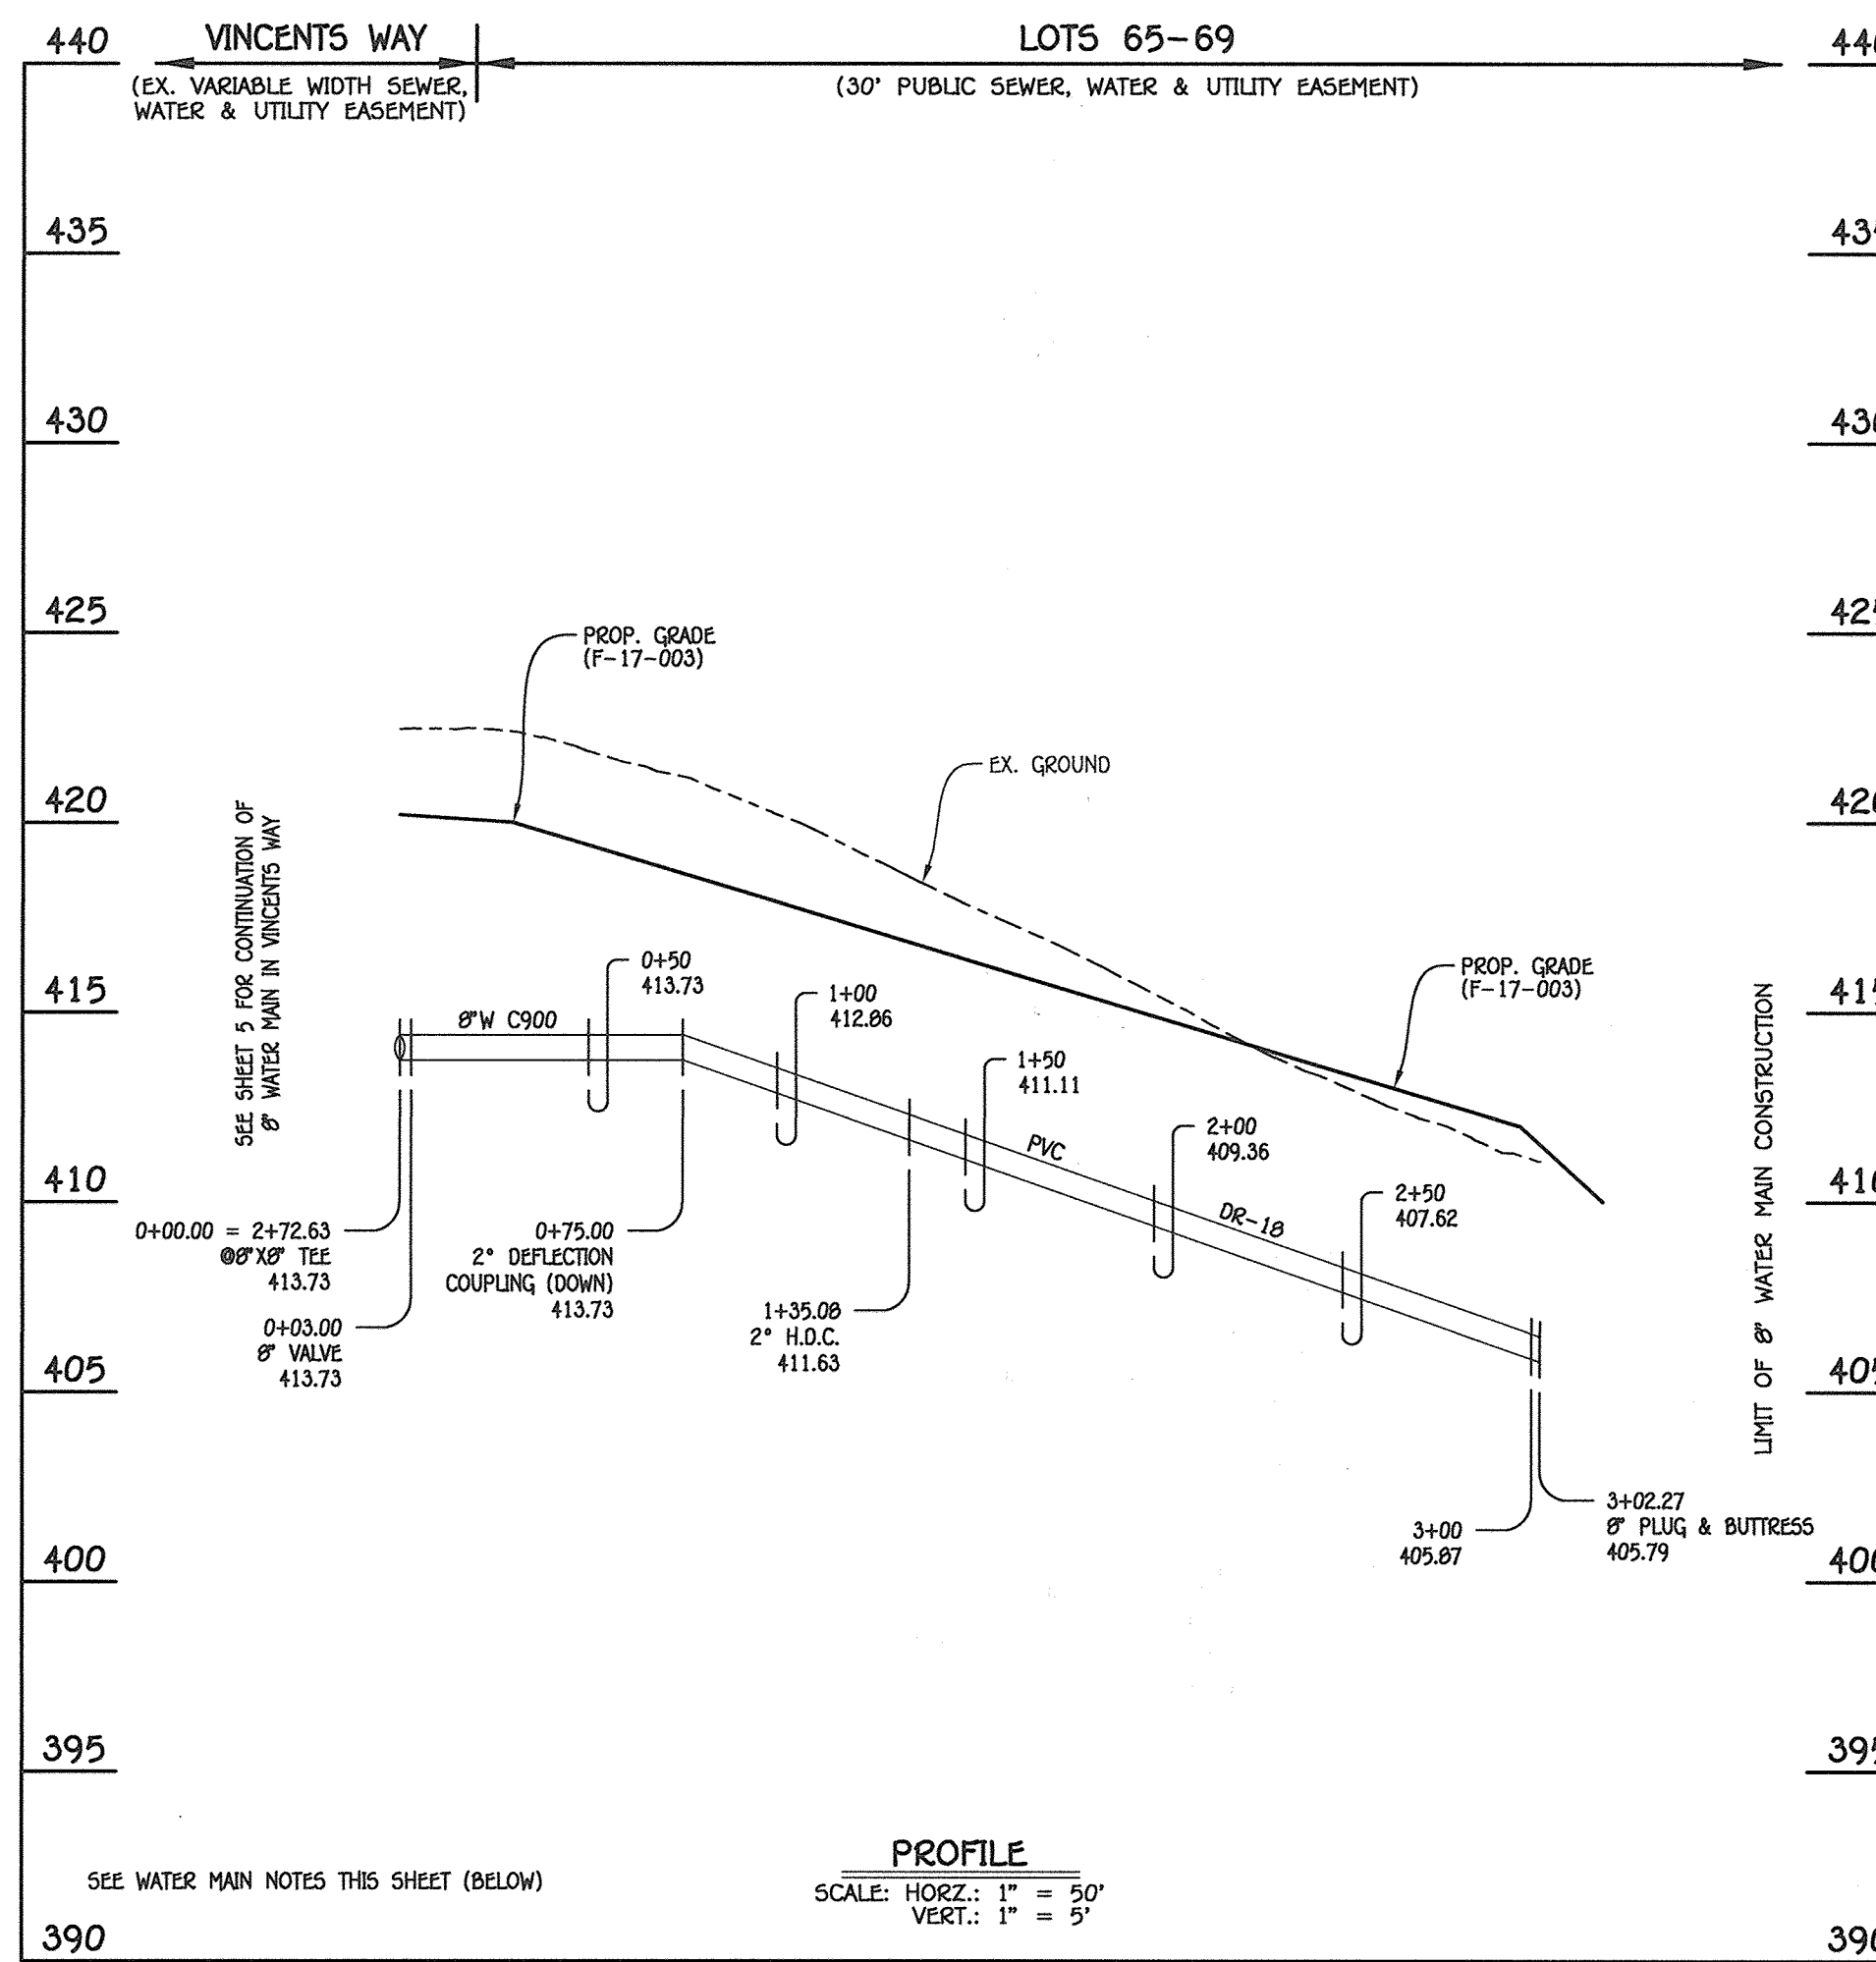

8" WATER MAIN: LOTS 65-69

SCALE: HORIZ.: 1" = 50'
VERT.: 1" = 5'

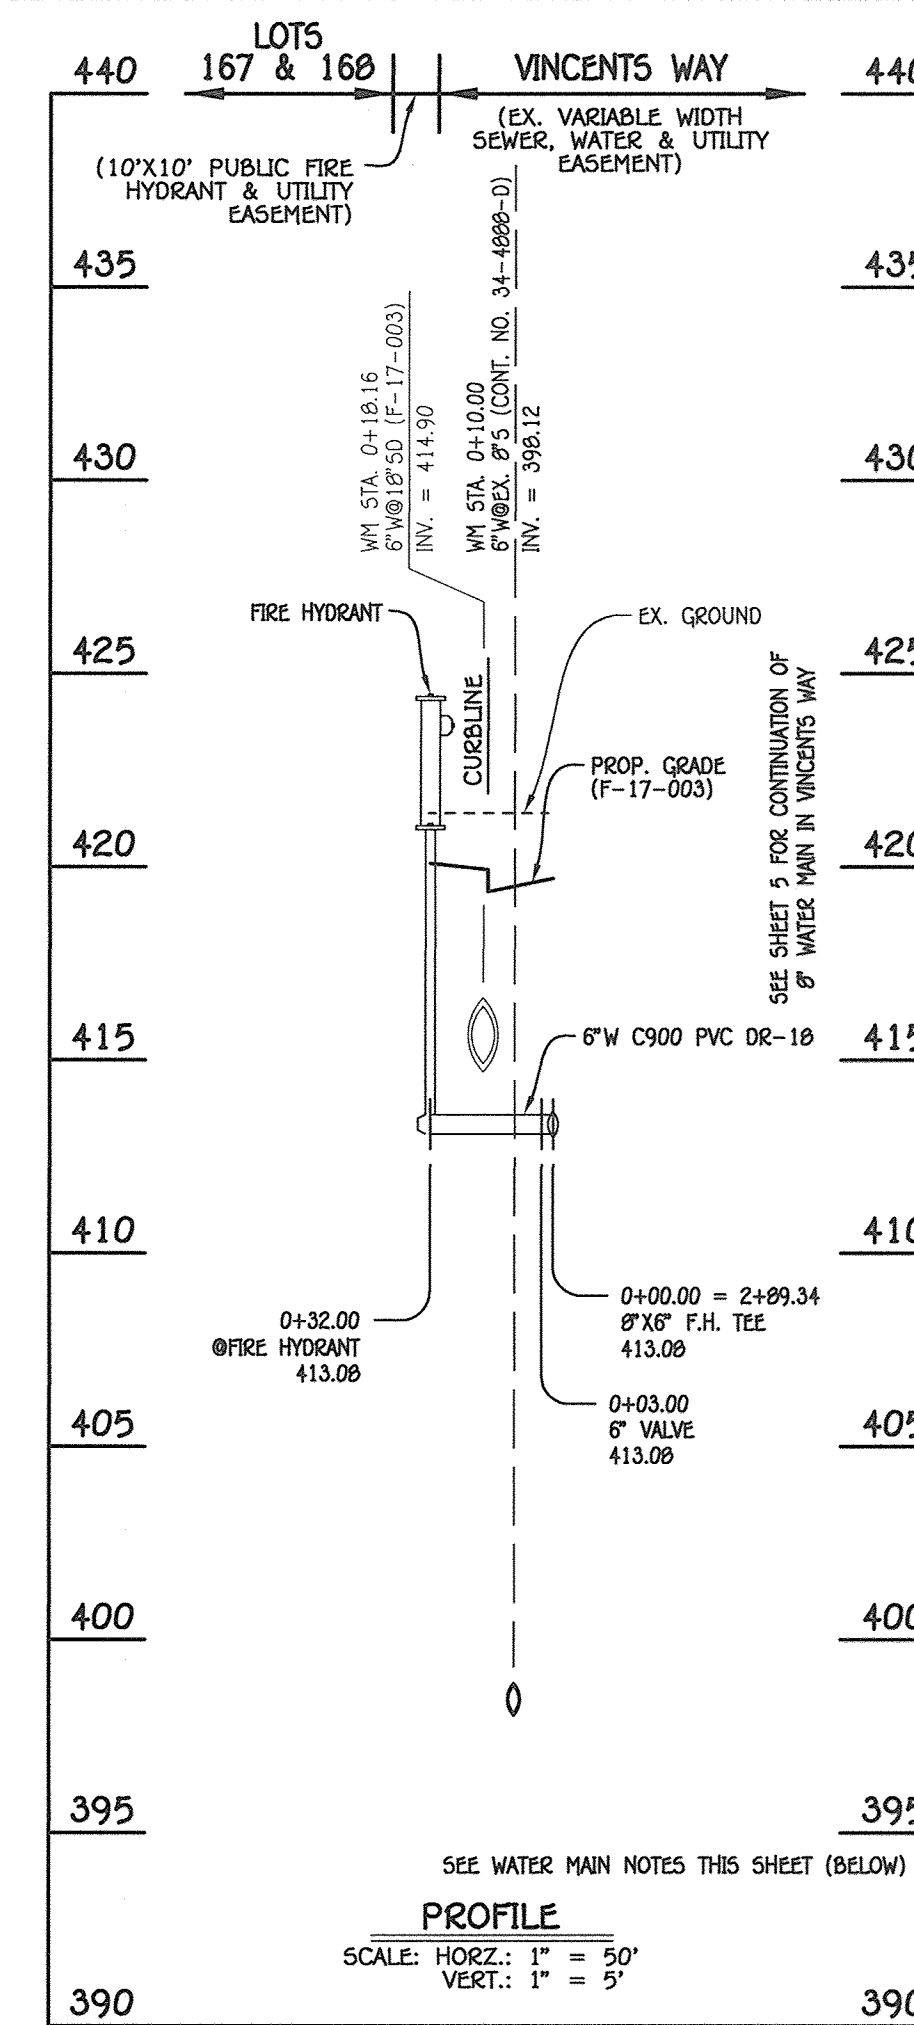


6" FIRE HYDRANT LEAD: VINCENTS WAY

SCALE: HORIZ.: 1" = 50'
VERT.: 1" = 5'

W.M. STA.	APPURTENANCE	NORTHING	EASTING
8" WATER MAIN: NORTHROP WAY			
0+00.00	EX. 8" PLUG & BUTTRESS	557903.86	1329056.30
0+26.91	1/16 H.B.	557905.93	1329083.13
1+94.43	8" PLUG & BUTTRESS	557983.41	1329231.65

W.M. STA.	APPURTENANCE	NORTHING	EASTING
8" WATER MAIN: LOTS 65-69			
0+00.00 = 2+72.63	8" X 8" TEE	557584.19	1329097.60
0+03.00	8" VALVE	557585.28	1329100.40
1+35.08	2" H.O.C.	557633.06	1329223.53
3+02.27	8" PLUG & BUTTRESS	557699.38	1329377.00

W.M. STA.	APPURTENANCE	NORTHING	EASTING
6" FIRE HYDRANT LEAD: VINCENTS WAY			
0+00.00 = 2+89.34	8" X 8" F.H. TEE	557568.62	1329103.64
0+03.00	6" VALVE	557567.54	1329100.84
0+32.00	FIRE HYDRANT	557557.04	1329073.81

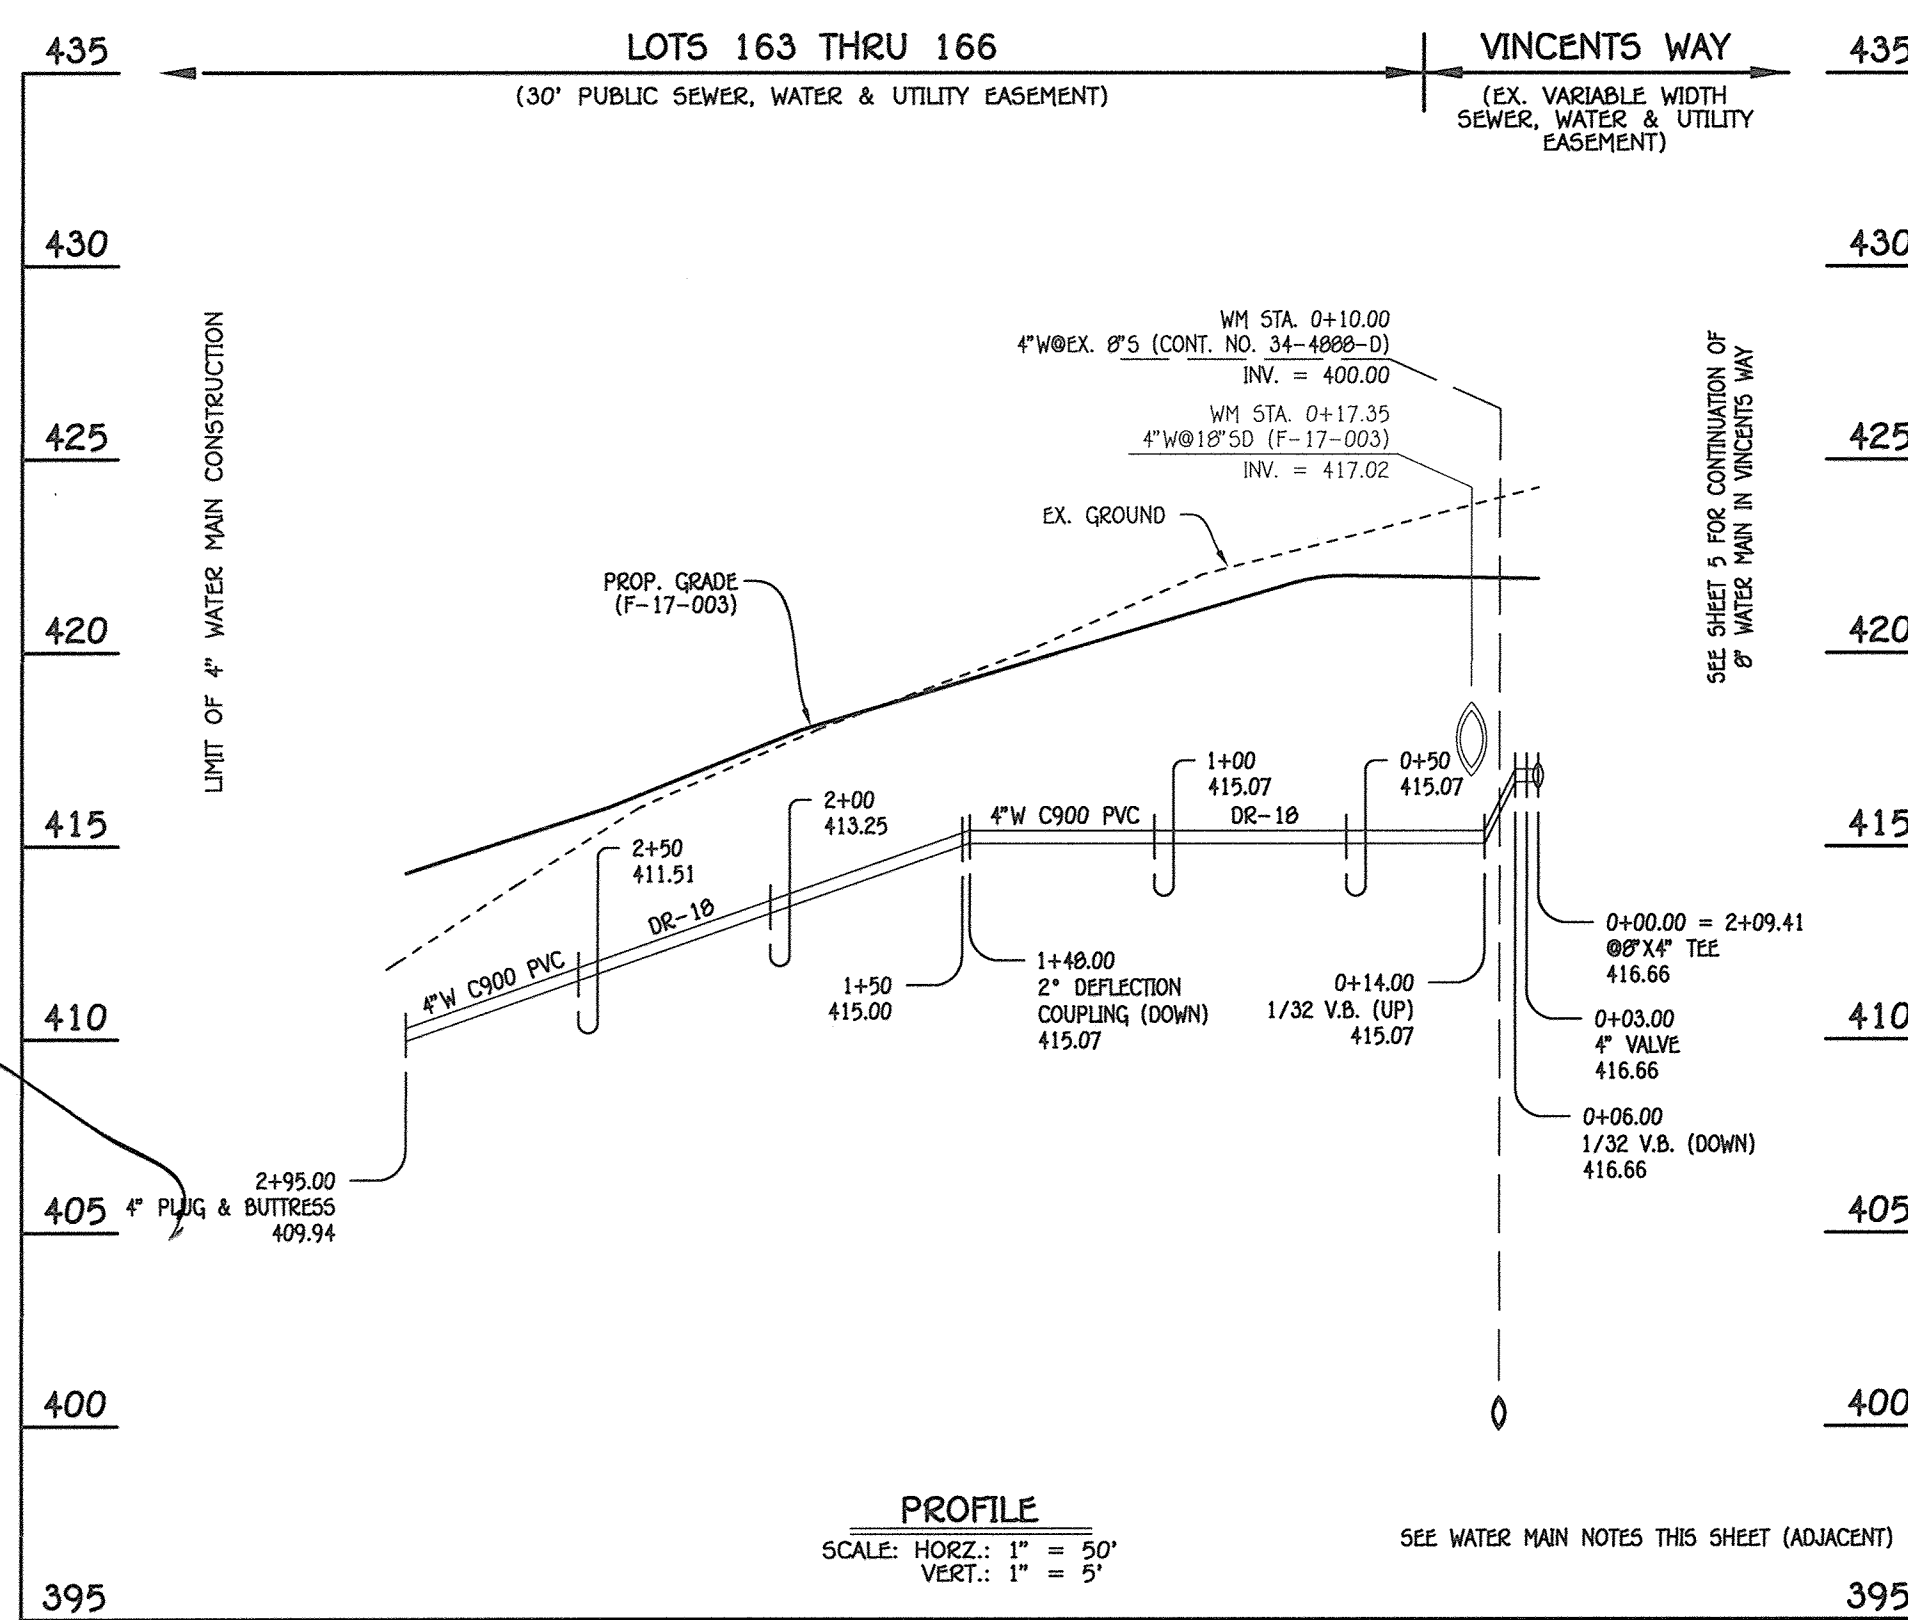

4" WATER MAIN: LOTS 163 THRU 166

SCALE: HORIZ.: 1" = 50'
VERT.: 1" = 5'


W.M. STA.	APPURTENANCE	NORTHING	EASTING
4" WATER MAIN: LOTS 163 THRU 166			
0+00.00 = 2+09.41	8" X 4" TEE	557643.13	1329074.73
0+03.00	4" VALVE	557642.05	1329071.93
2+95.00	4" PLUG & BUTTRESS	557536.41	1328799.71

AS-BUILT

Date 11/2/18

NOTE: THIS ORIGINAL CONSTRUCTION PLAN, SHEET 6 OF 16 SUPERSEDES THE WATER & SEWER MAIN CONSTRUCTION PLAN PREVIOUSLY APPROVED AND SIGNED BY THE DEPARTMENT OF PLANNING AND ZONING ON JULY 21, 2017.

- WATER MAIN NOTES:**
- ALL WATER MAINS SHALL BE AWWA C900 PVC PIPE; DR-18.
 - ALL PIPE BEDDING, TRACER WIRE, LOCATING TAPE AND OTHER APPURTENANCES SHALL BE IN ACCORDANCE WITH THE HOWARD COUNTY DESIGN MANUAL, VOLUME IV - WATER AND SEWER STANDARDS FOR AWWA C900 PVC WATER PIPE INSTALLATION.
 - DEFLECTION COUPLINGS SHALL BE CERTAIN-TEED PVC HIGH DEFLECTION COUPLINGS.
 - ALL WATER HOUSE CONNECTIONS AND TAPS SHALL BE PERFORMED USING A SADDLE.

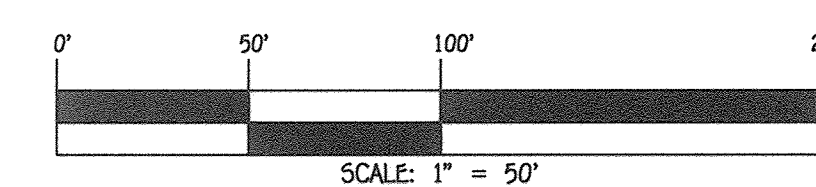


CONTRACT NO. 34-4992-D ENCLAVE AT RIVER HILL: PHASE II LOTS 55 THRU 74, 82 THRU 124, 130 THRU 159, 161 THRU 168 & OPEN SPACE LOTS 125 THRU 129, 160 & 169 SEWER & WATER MAIN EXTENSIONS HOWARD COUNTY, MARYLAND

DEPARTMENT OF PUBLIC WORKS
HOWARD COUNTY, MARYLAND

DEPARTMENT OF PLANNING AND ZONING
HOWARD COUNTY, MARYLAND

I HEREBY CERTIFY THAT THESE DOCUMENTS WERE PREPARED OR APPROVED BY ME, AND THAT I AM A DULY LICENSED PROFESSIONAL ENGINEER UNDER THE LAWS OF THE STATE OF MARYLAND. LICENSE NO. 12043 EXPIRATION DATE IS 7/16/18.

FISHER, COLLINS & CARTER, INC.
CIVIL ENGINEERING CONSULTANTS & LAND SURVEYORS
CENTRAL SQUARE OFFICE PARK - 10272 BALTIMORE NATIONAL PIKE
ELLIOTT CITY, MARYLAND 21042
(410) 461-2895

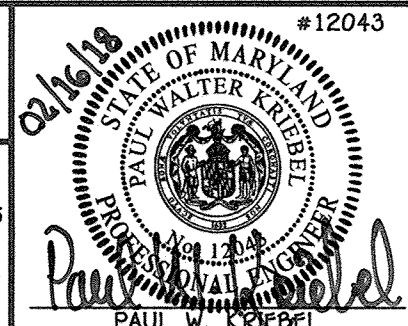


DESIGNED BY:	B.C.R.	DATE:
DRAWN BY: <td>B.C.R. <td></td> </td>	B.C.R. <td></td>	
CHECKED BY: <td>P.M.K. <td></td> </td>	P.M.K. <td></td>	
DATE: <td>FEBRUARY, 2018 <td></td> </td>	FEBRUARY, 2018 <td></td>	

**WATER MAIN EXTENSIONS
PROFILES, CHARTS & NOTES**

600' SCALE MAP NO. 34 BLOCK NO. 18
F.C.C. WORK ORDER NO. 13008-3001
FILE NAME: SEWER & WATER MAIN EXTENSION PLAN


ENCLAVE AT RIVER HILL: PHASE II
LOTS 55 THRU 74, 82 THRU 124, 130 THRU 159, 161 THRU 168 & OPEN SPACE LOTS 125 THRU 129, 160 & 169
SEWER & WATER MAIN EXTENSIONS
CONTRACT NO. 34-4992-D
FIFTH ELECTION DISTRICT
HOWARD COUNTY, MARYLAND

SCALE AS SHOWN
SHEET 6 OF 16

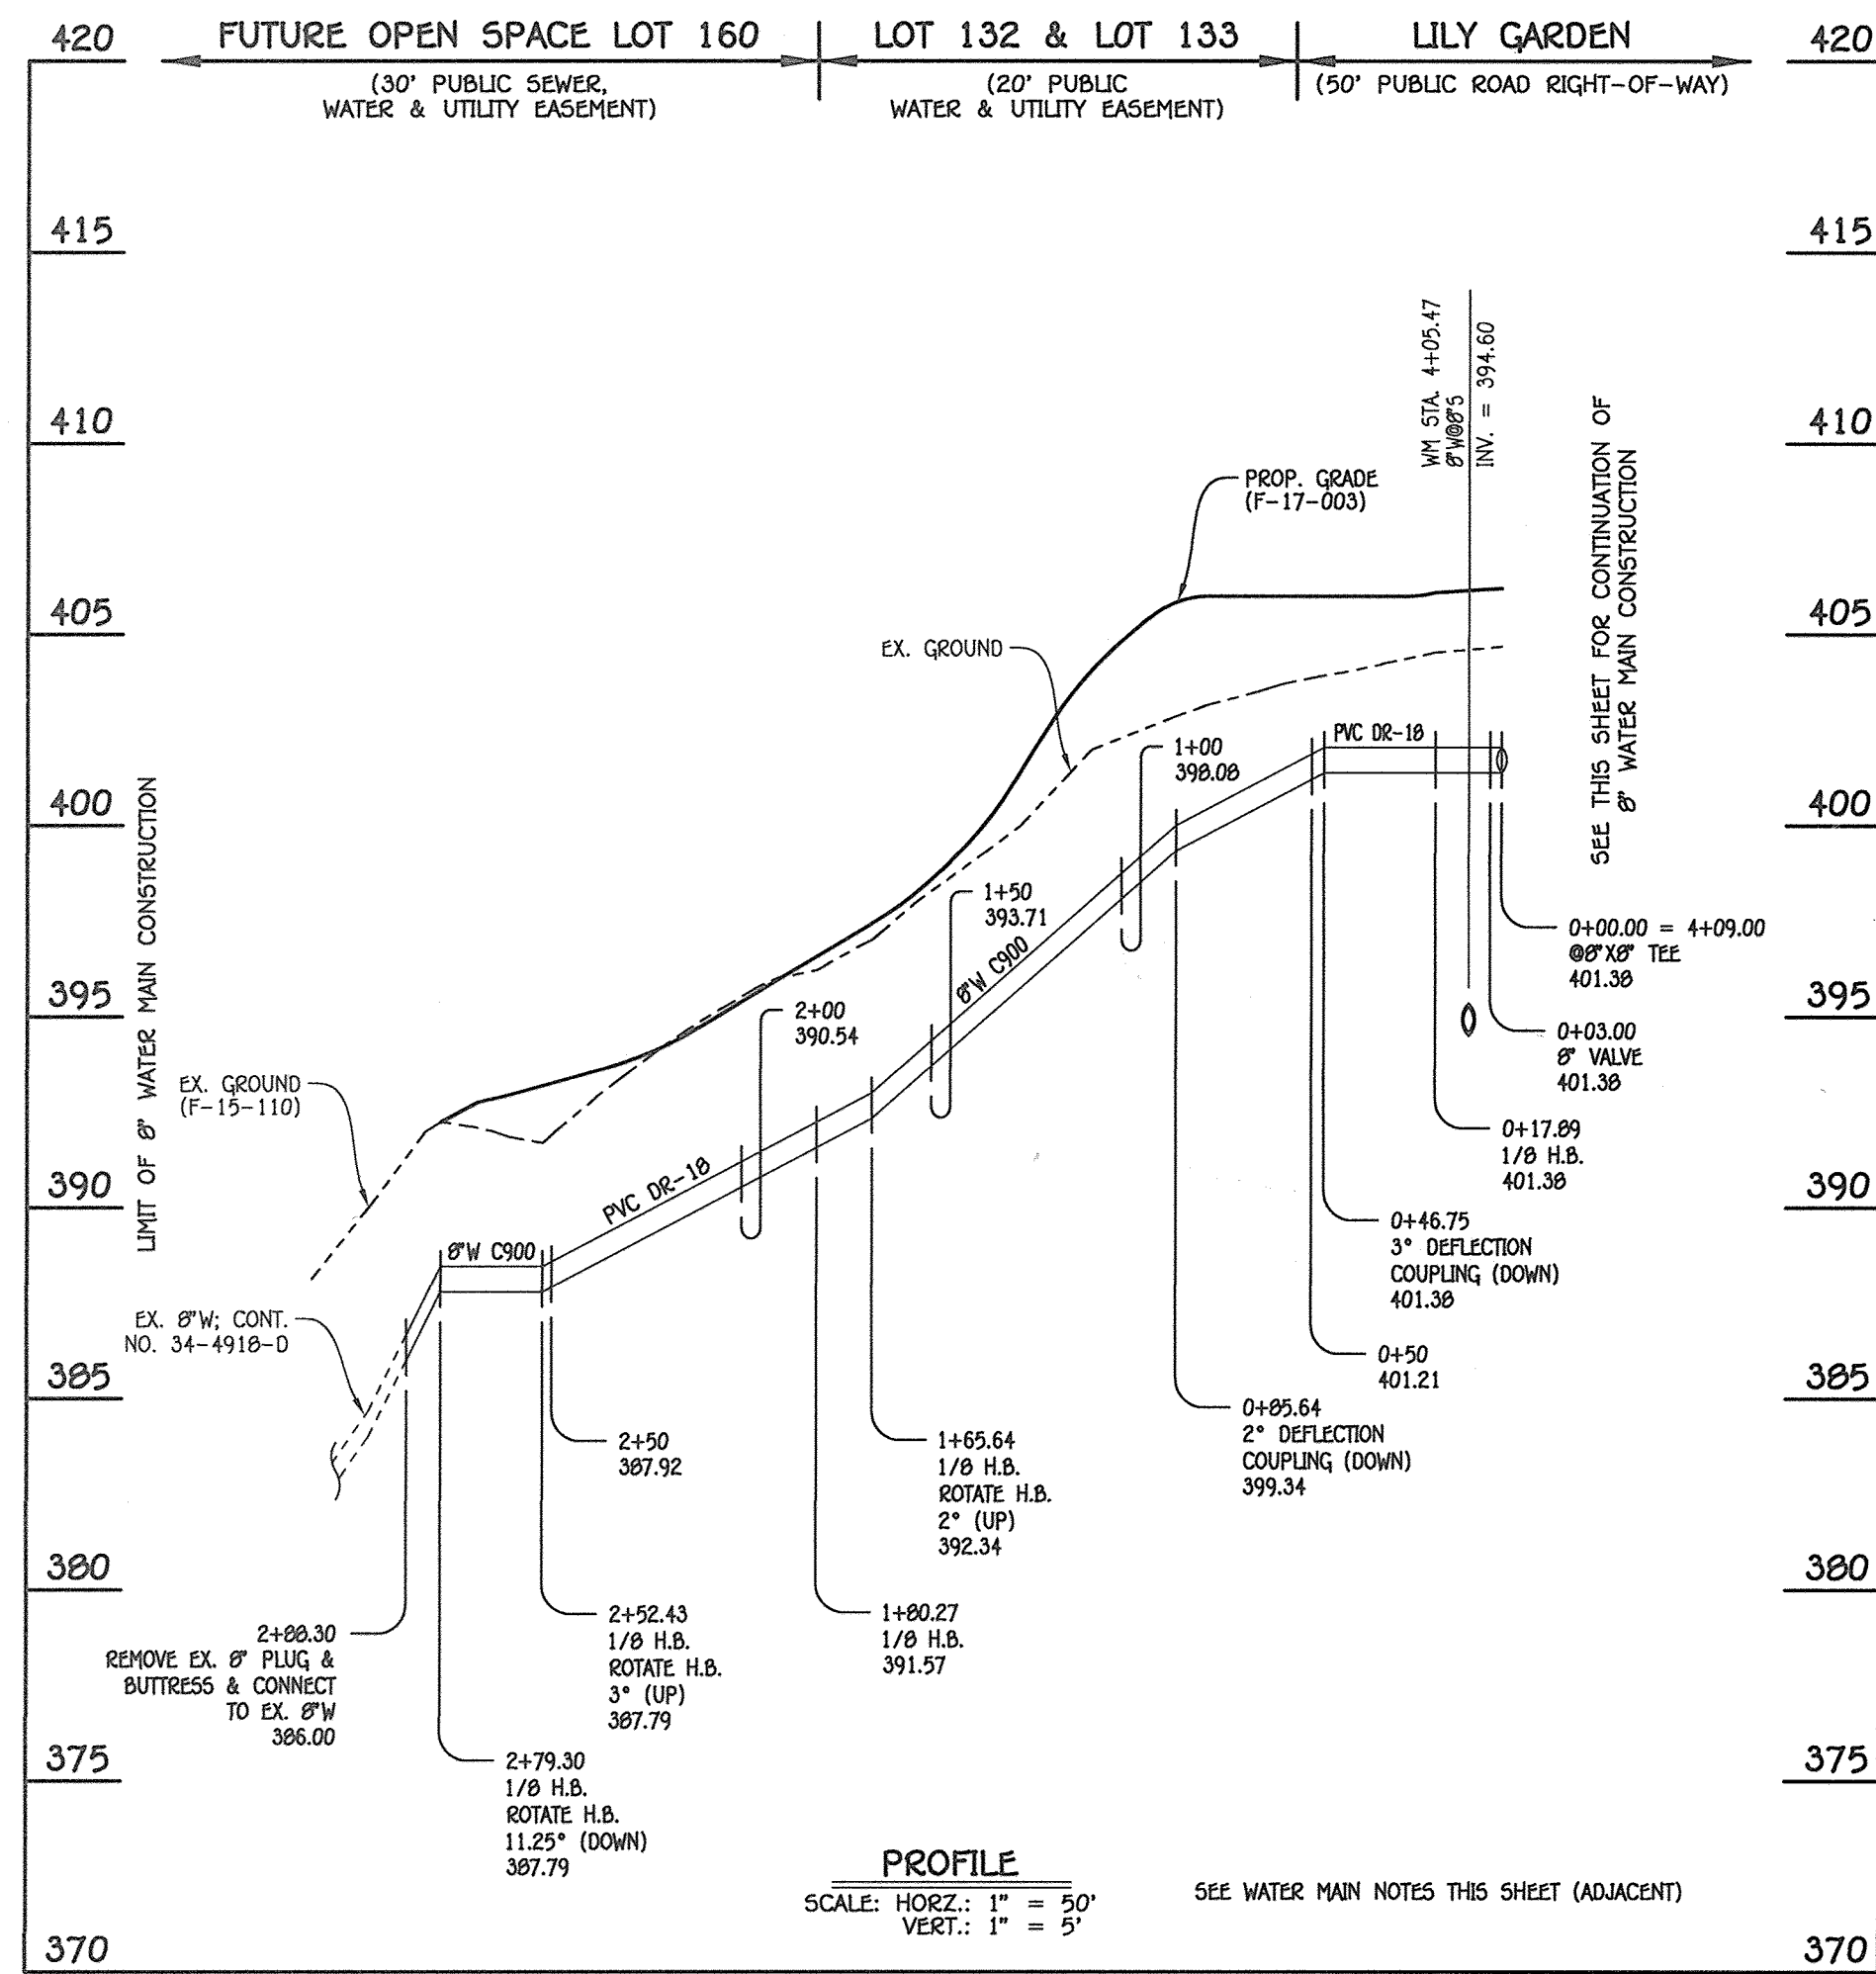

8" WATER MAIN: LILY GARDEN

W.M. STA.	APPURTENANCE	NORTHING	EASTING
8" WATER MAIN: LILY GARDEN			
0+00.00 = 4+09.00	8" X 8" TEE	557205.72	1328005.90
0+03.00	8" VALVE	557202.97	1328007.16
0+17.39	8" X 8" TEE	557189.76	1328012.83
1+65.64	1/8" H.B.	557058.40	1328744.09
1+80.27	1/8" H.B.	557053.54	1328730.29
2+52.43	1/8" H.B.	557082.41	1328664.15
2+79.30	1/8" H.B.	557107.77	1328655.27
2+88.30	EX. 8" PLUG & BUTTRESS	557111.54	1328647.10

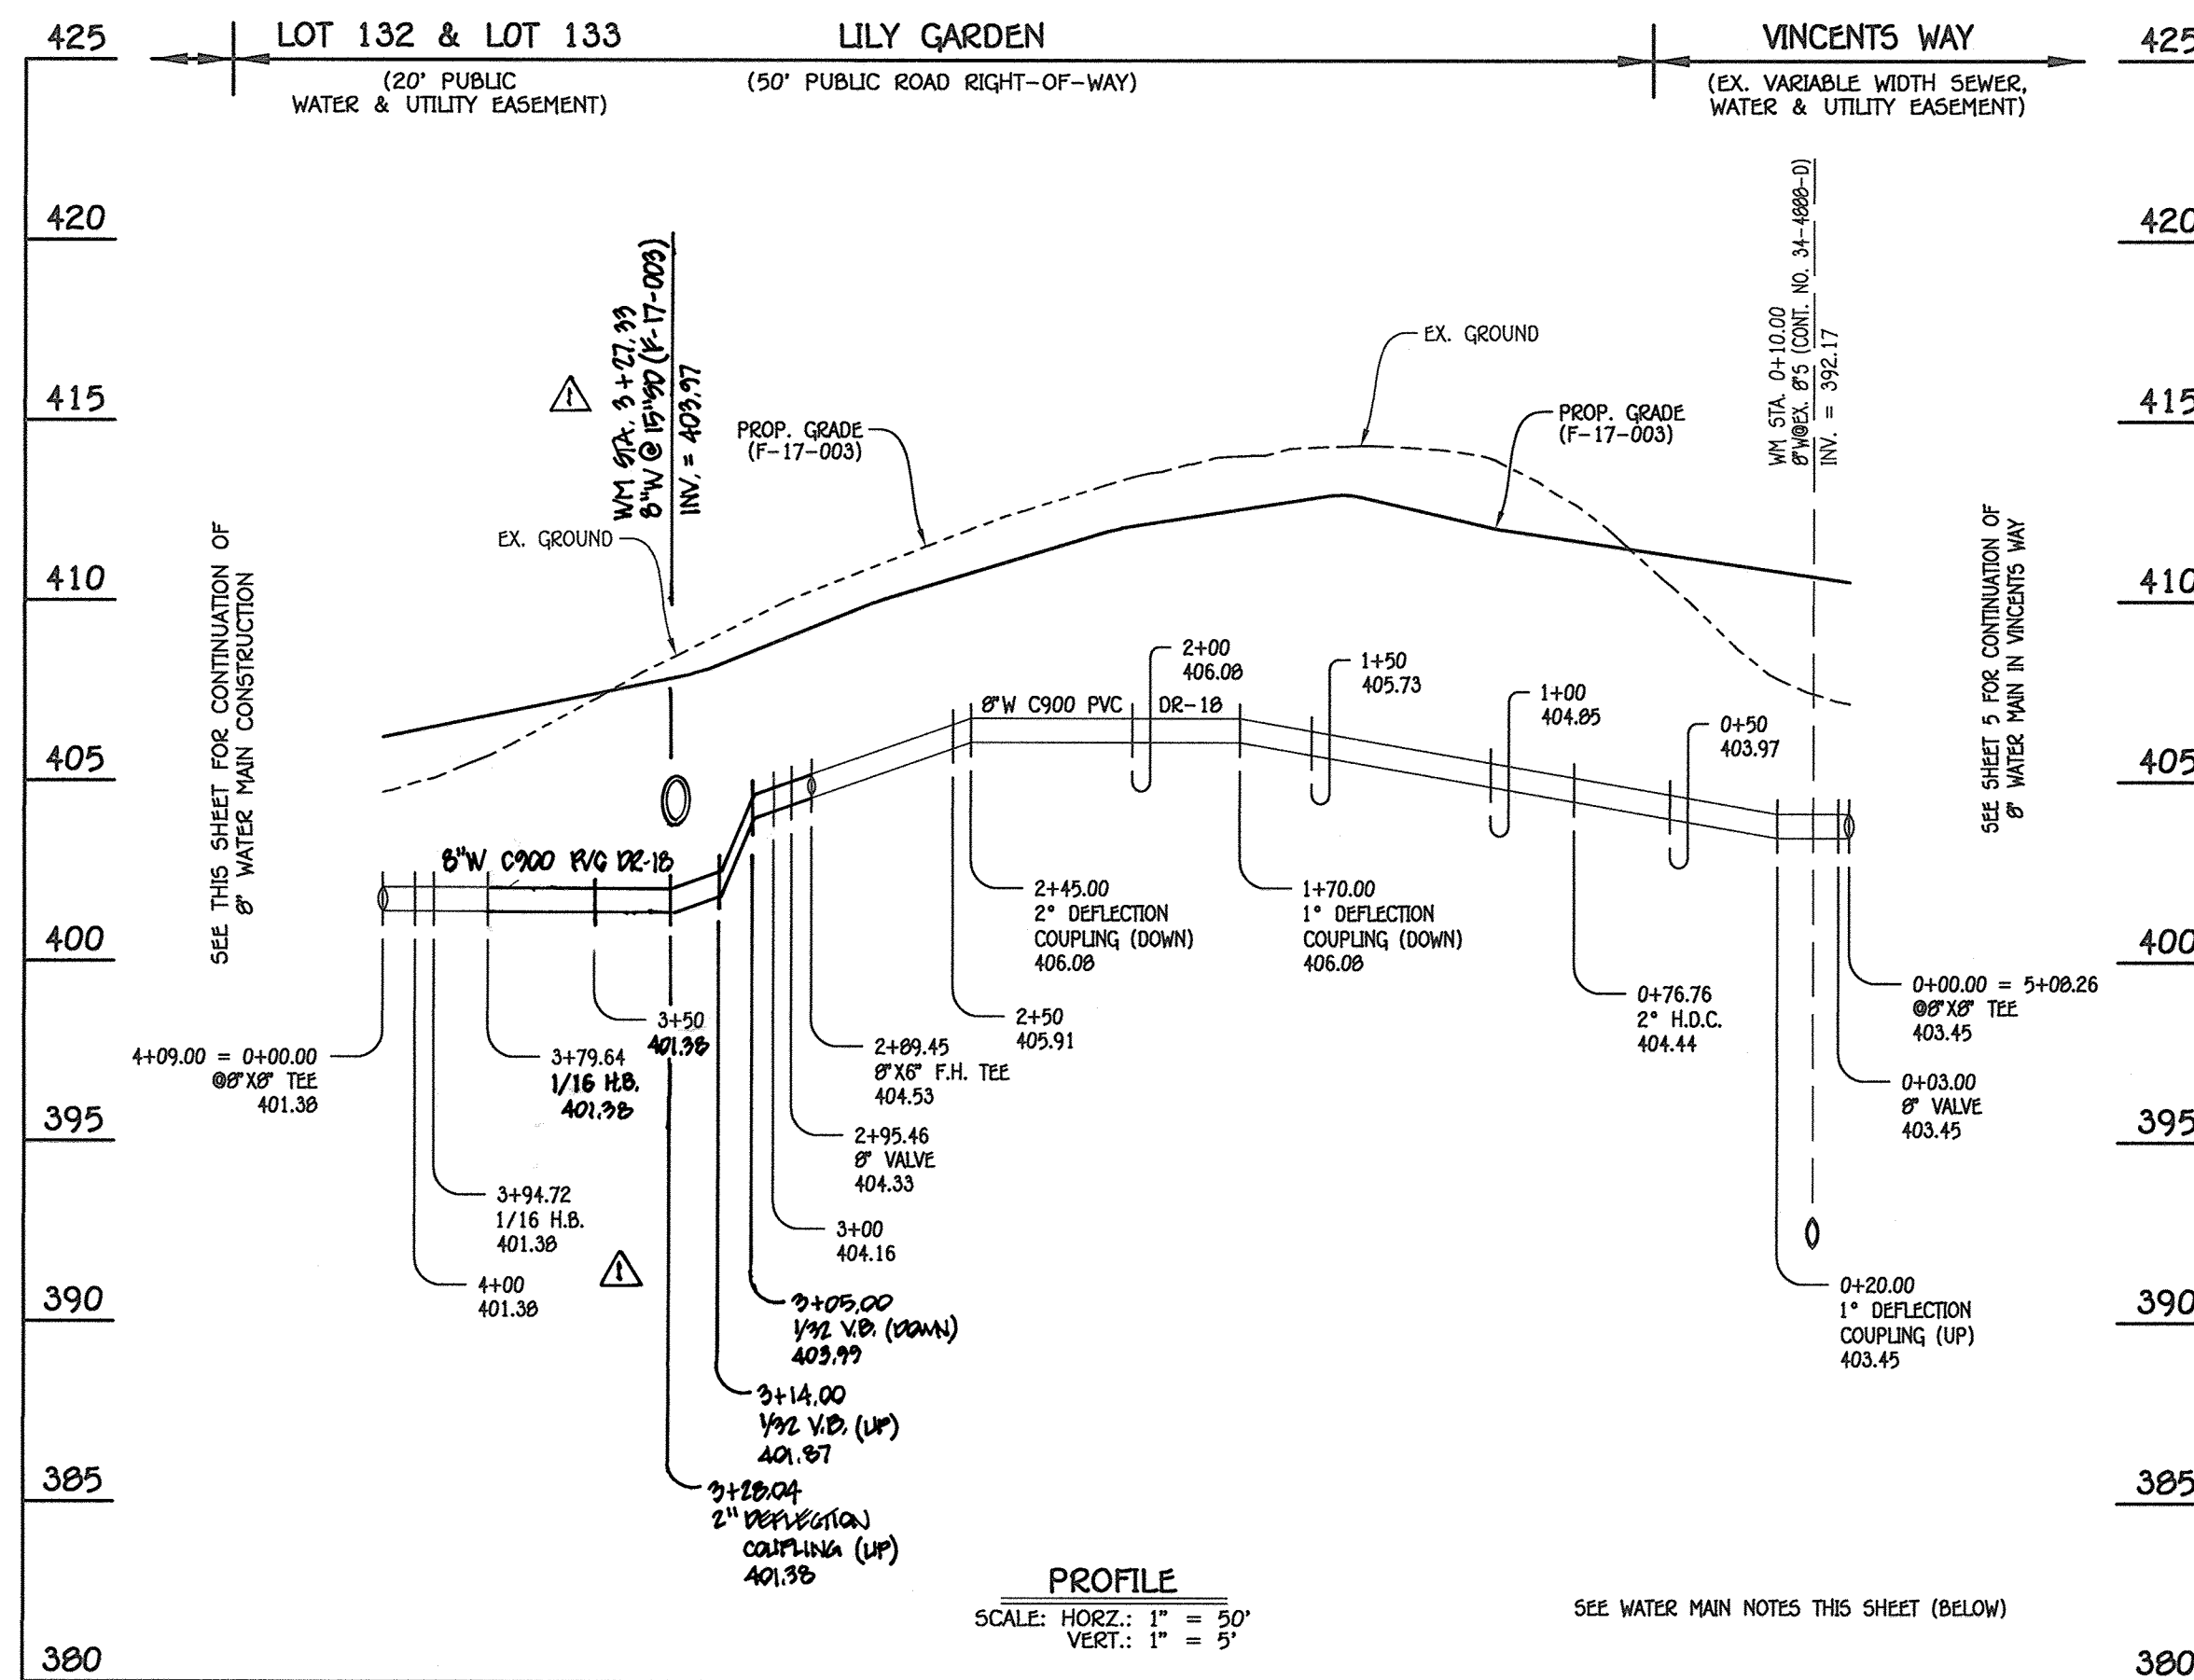


8" WATER MAIN: LILY GARDEN

W.M. STA.	APPURTENANCE	NORTHING	EASTING
8" WATER MAIN: LILY GARDEN			
0+00.00 = 5+08.26	8" X 8" TEE	557364.53	1329182.84
0+03.00	8" VALVE	557363.44	1329180.05
0+76.76	2" H.D.C.	557336.76	1329111.28
2+85.45	8" X 6" F.H. TEE	527252.87	1328915.84
2+91.45	8" VALVE	557250.51	1328910.32
4+09.00 = 0+00.00	8" X 8" TEE	557205.72	1328005.90

- WATER MAIN NOTES:**
1. ALL WATER MAINS SHALL BE AMWA C900 PVC PIPE, DR-18.
 2. ALL PIPE BEDDING, TRACER WIRE, LOCATING TAPE AND OTHER APPURTENANCES SHALL BE IN ACCORDANCE WITH THE HOWARD COUNTY DESIGN MANUAL, VOLUME IV - WATER AND SEWER STANDARDS FOR AMWA C900 PVC WATER PIPE INSTALLATION.
 3. DEFLECTION COUPLINGS SHALL BE CERTAIN-TEED PVC HIGH DEFLECTION COUPLINGS.
 4. ALL WATER HOUSE CONNECTIONS AND TAPS SHALL BE PERFORMED USING A SADDLE.

AS-BUILT

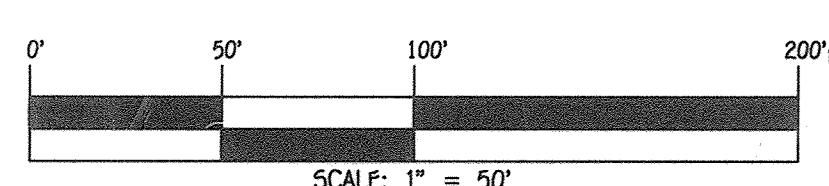

DEPARTMENT OF PUBLIC WORKS
HOWARD COUNTY, MARYLAND

DEPARTMENT OF PLANNING AND ZONING
HOWARD COUNTY, MARYLAND

1. I HEREBY CERTIFY THAT THESE DOCUMENTS WERE PREPARED OR APPROVED BY ME, AND THAT I AM A FULLY LICENSED PROFESSIONAL ENGINEER UNDER THE LAWS OF THE STATE OF MARYLAND. LICENSE NO. 12043 EXPIRATION DATE IS 7/16/18.

FISHER, COLLINS & CARTER, INC.
CIVIL ENGINEERING CONSULTANTS & LAND SURVEYORS
CENTENNIAL SQUARE OFFICE PARK - 10272 BALTIMORE NATIONAL PIKE
ELLSWORTH CITY, MARYLAND 21042
(410) 461 - 2995

PAUL V. FISHER
#12043

DESIGNED BY : B.C.R.
DRAWN BY : B.C.R.
CHECKED BY : P.W.K.
DATE : JULY, 2017

CHIEF, BUREAU OF UTILITIES
DATE: 7/2/17

CHIEF, DEVELOPMENT ENGINEERING DIVISION
DATE: 7/16/17

WATER MAIN EXTENSIONS
PROFILE, CHART & NOTES

600' SCALE MAP NO. 34 BLOCK NO. 18
F.C.C. WORK ORDER NO. 13008-3001


FILE NAME : SEWER & WATER MAIN EXTENSION PLAN

ENCLAVE AT RIVER HILL: PHASE II
LOTS 55 THRU 74, 82 THRU 124, 130 THRU 159, 161 THRU 166 & OPEN SPACE LOTS 125 THRU 129, 160 & 169

SEWER & WATER MAIN EXTENSIONS
CONTRACT NO. 34-4992-D
FIFTH ELECTION DISTRICT
HOWARD COUNTY, MARYLAND

SCALE AS SHOWN
SHEET 7 OF 16

1:2013113008.dwg | Water & Sewer Contracts | Water & Sewer Contract No. 34-4992-D | Phase 2 | Final | 13008-3001 | Water & Sewer Contract Planning

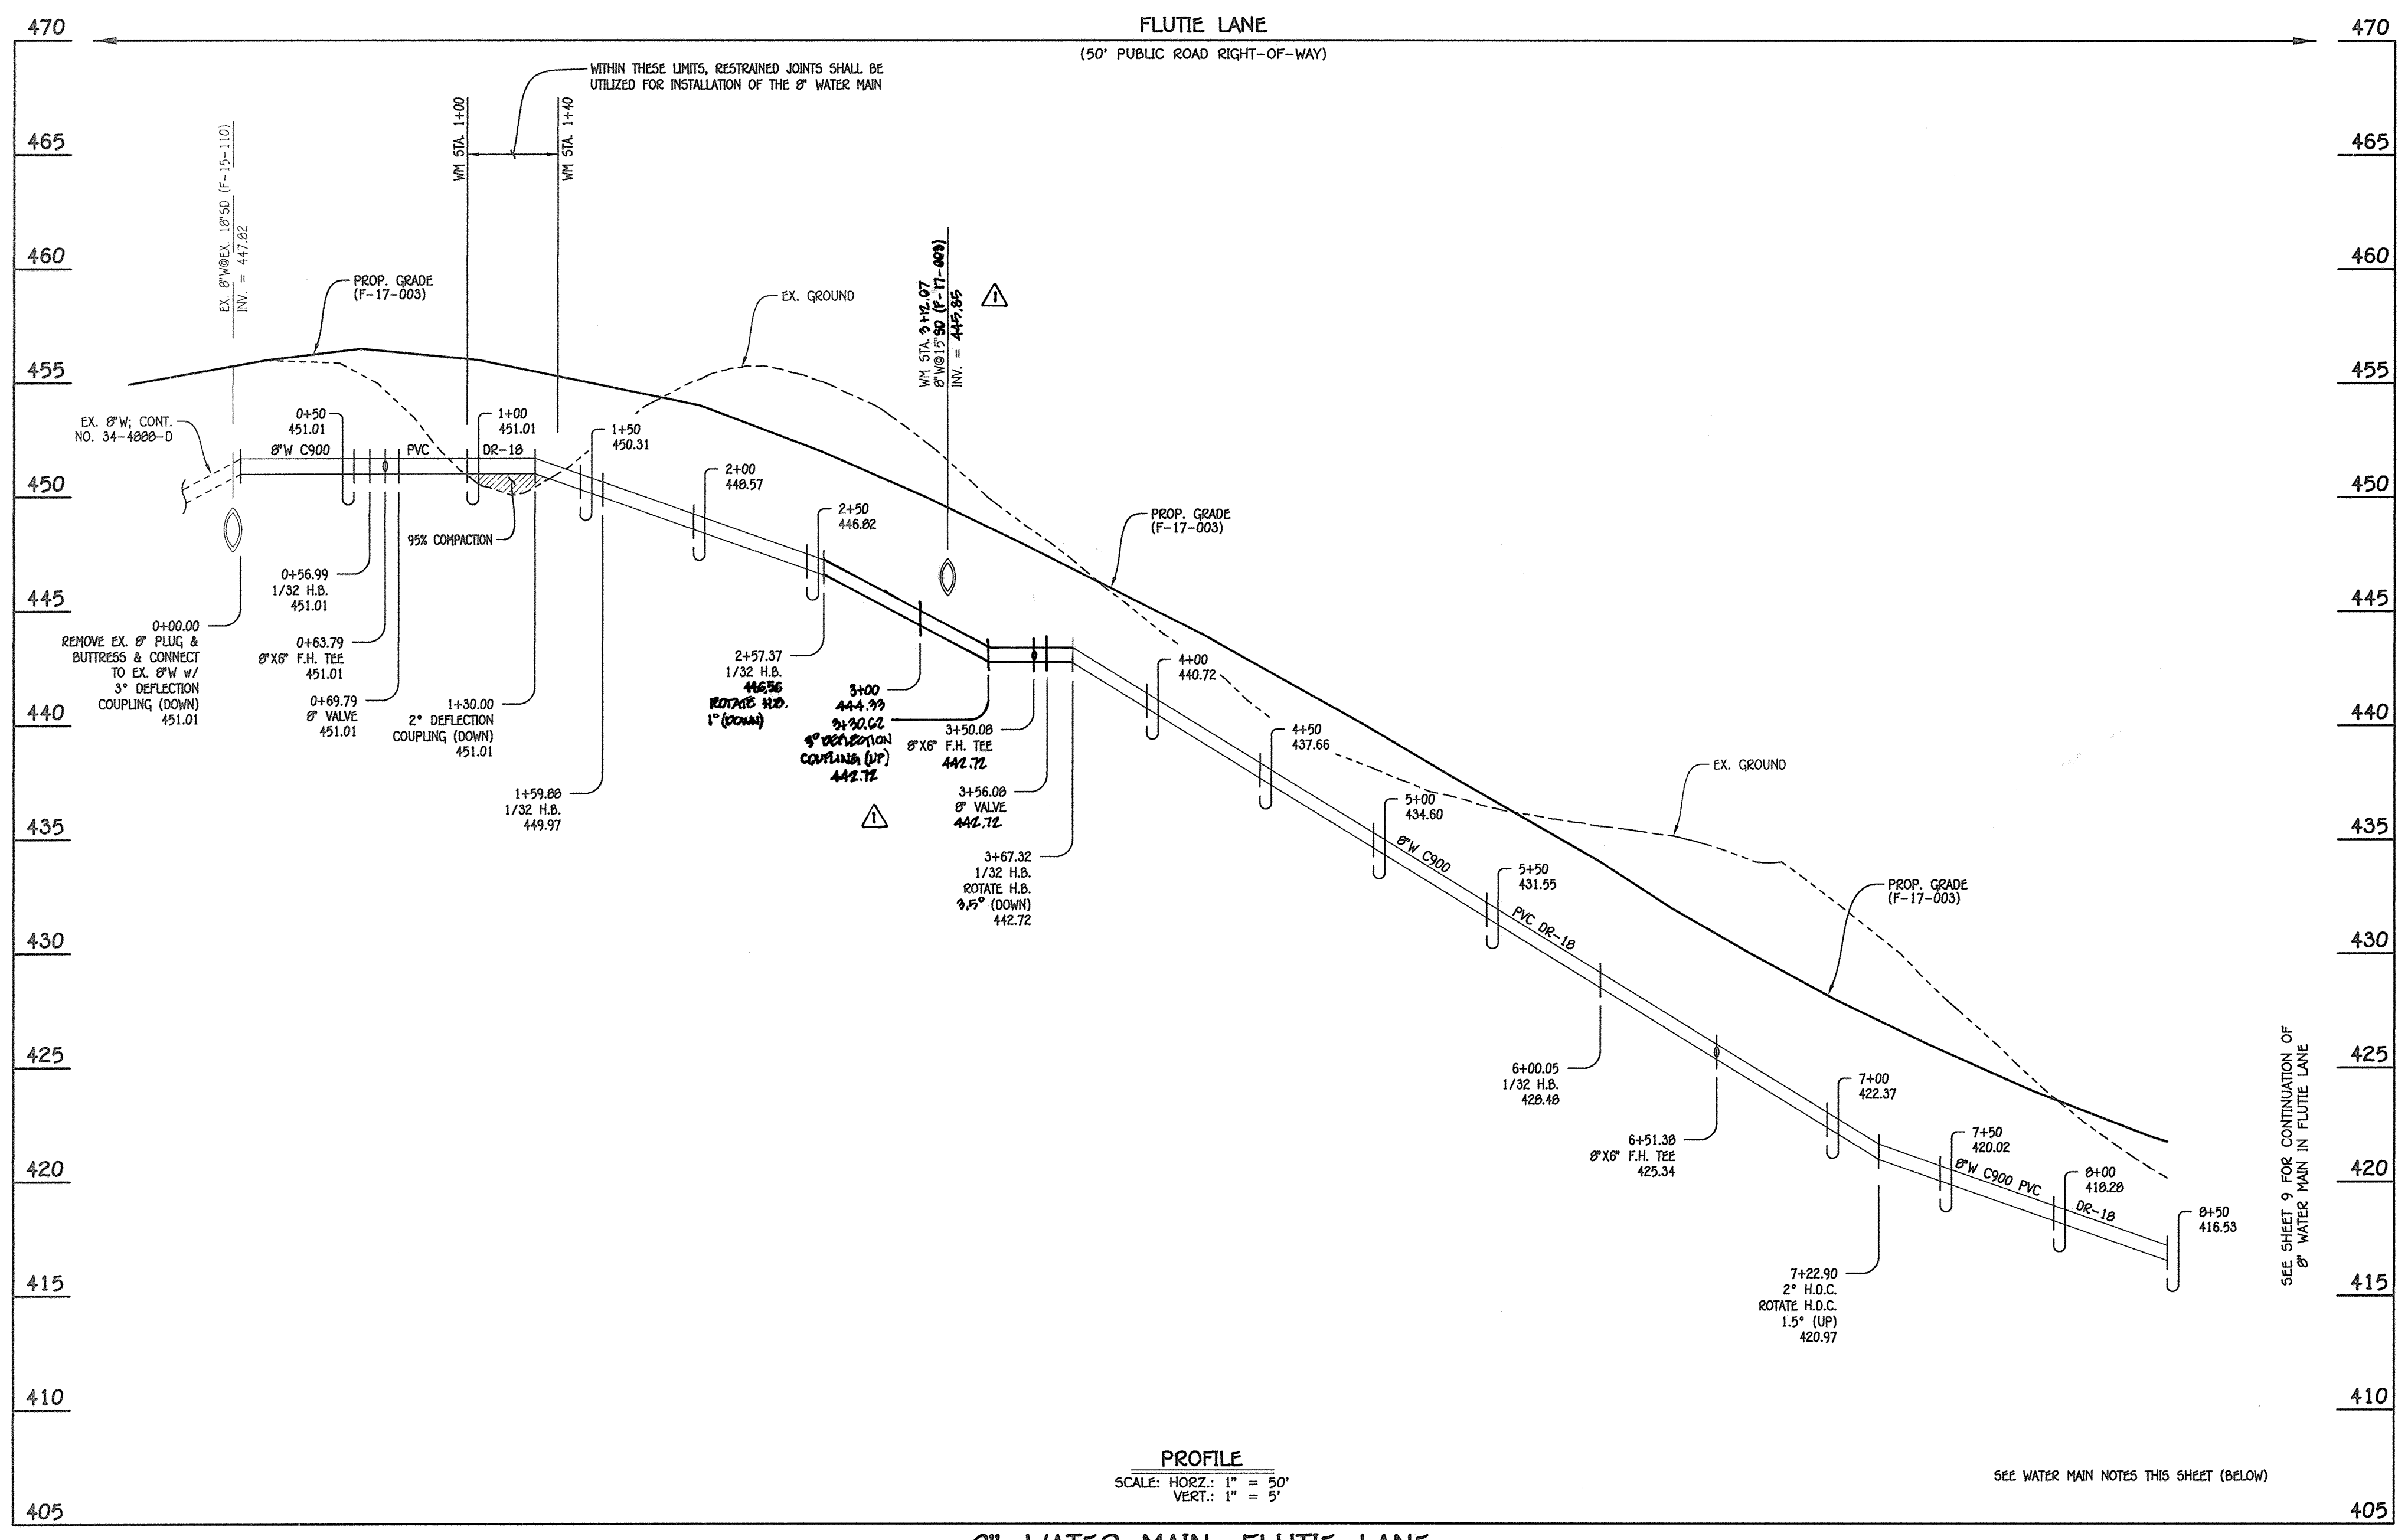


8" WATER MAIN: FLUTIE LANE

WATER MAIN TABULATION CHART			
W.M. STA.	APPURTENANCE	NORTHING	EASTING
8" WATER MAIN: FLUTIE LANE			
0+00.00	EX. 8" PLUG & BUTTRESS	558632.36	1328692.96
0+56.99	1/32 H.B.	558998.33	1328647.26
0+63.79	8" X6" F.H. TEE	558993.30	1328642.68
0+69.79	8" VALVE	558988.86	1328638.65
1+59.88	1/32 H.B.	558922.19	1328578.05
2+57.37	1/32 H.B.	558438.61	1328527.85
3+50.08	8" X6" F.H. TEE	558351.35	1328496.56
3+56.08	8" VALVE	558345.70	1328494.53
3+67.32	1/32 H.B.	558335.11	1328490.74
6+00.05	1/32 H.B.	558104.55	1328459.11
6+51.38	8" X6" F.H. TEE	558056.02	1328442.38
7+22.90	2" H.D.C.	557988.40	1328419.07

- WATER MAIN NOTES:**
1. ALL WATER MAINS SHALL BE AWWA C900 PVC PIPE; DR-18.
 2. ALL PIPE BEDDING, TRACER WIRE, LOCATING TAPE AND OTHER APPURTENANCES SHALL BE IN ACCORDANCE WITH THE HOWARD COUNTY DESIGN MANUAL, VOLUME IV - WATER AND SEWER STANDARDS FOR AWWA C900 PVC WATER PIPE INSTALLATION.
 3. DEFLECTION COUPLINGS SHALL BE CERTAIN-TIED PVC HIGH DEFLECTION COUPLINGS.
 4. ALL WATER HOUSE CONNECTIONS AND TAPS SHALL BE PERFORMED USING A SADDLE.

AS-BUILT
[Signature] Date 11/2/18

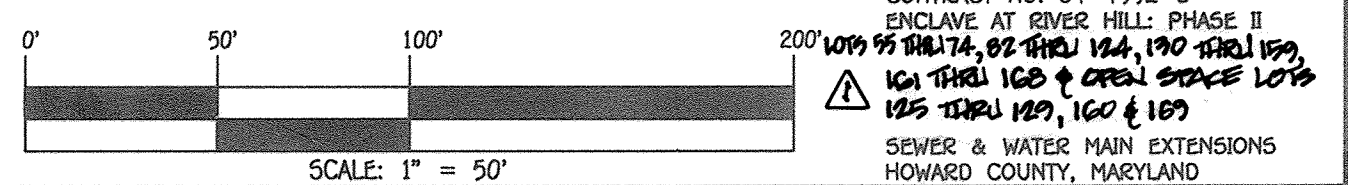


DEPARTMENT OF PUBLIC WORKS
 HOWARD COUNTY, MARYLAND
[Signature]
 CHIEF, BUREAU OF UTILITIES

DEPARTMENT OF PLANNING AND ZONING
 HOWARD COUNTY, MARYLAND
[Signature] 7/16/17
 CHIEF, DEVELOPMENT ENGINEERING DIVISION

I HEREBY CERTIFY THAT THESE DOCUMENTS WERE PREPARED OR APPROVED BY ME, AND THAT I AM A DULY LICENSED PROFESSIONAL ENGINEER UNDER THE LAWS OF THE STATE OF MARYLAND. LICENSE NO. 12043 EXPIRATION DATE 5/7/16/18.

FISHER, COLLINS & CARTER, INC.
 CIVIL ENGINEERING CONSULTANTS & LAND SURVEYORS
 CENTENAL SQUARE OFFICE PARK - 10272 BALTIMORE NATIONAL PIKE
 ELICOTT CITY, MARYLAND 21042
 (410) 461-2895

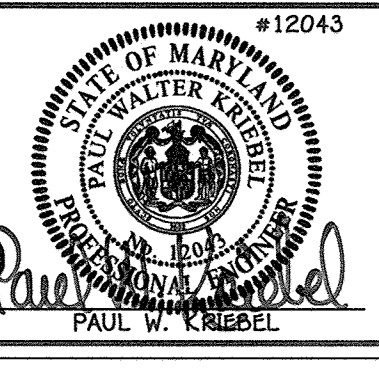

DESIGNED BY: B.C.R.
 DRAWN BY: B.C.R.
 CHECKED BY: P.W.K.
 DATE: JULY, 2017

REVISION: REMOVE WM PROFILES TO CLEAR GROUND DRAIN CROSSING AT STA. 5+112.07 REMOVE CONTRACT TITLE & PLAN TO REFLECT LOT NUMBER CHANGES

WATER MAIN EXTENSIONS
 PROFILE, CHART & NOTES


600' SCALE MAP NO. 34 BLOCK NO. 18
 F.C.C. WORK ORDER NO. 13008-3001
 FILE NAME: SEWER & WATER MAIN EXTENSION PLAN

ENCLAVE AT RIVER HILL: PHASE II
 LOTS 55 THRU 74, 82 THRU 124, 130 THRU 159, 161 THRU 165 & OPEN SPACE LOTS 125 THRU 129, 160 & 169

SEWER & WATER MAIN EXTENSIONS
 CONTRACT NO. 34-4992-D
 FIFTH ELECTION DISTRICT
 HOWARD COUNTY, MARYLAND

SCALE AS SHOWN
 SHEET 8 OF 16


1/20/13 13008.dwg Water & Sewer Contracts Water & Sewer Contract No. 34-4992-D (Phase 2) Final 13008-3001 Water & Sewer Contract Planning

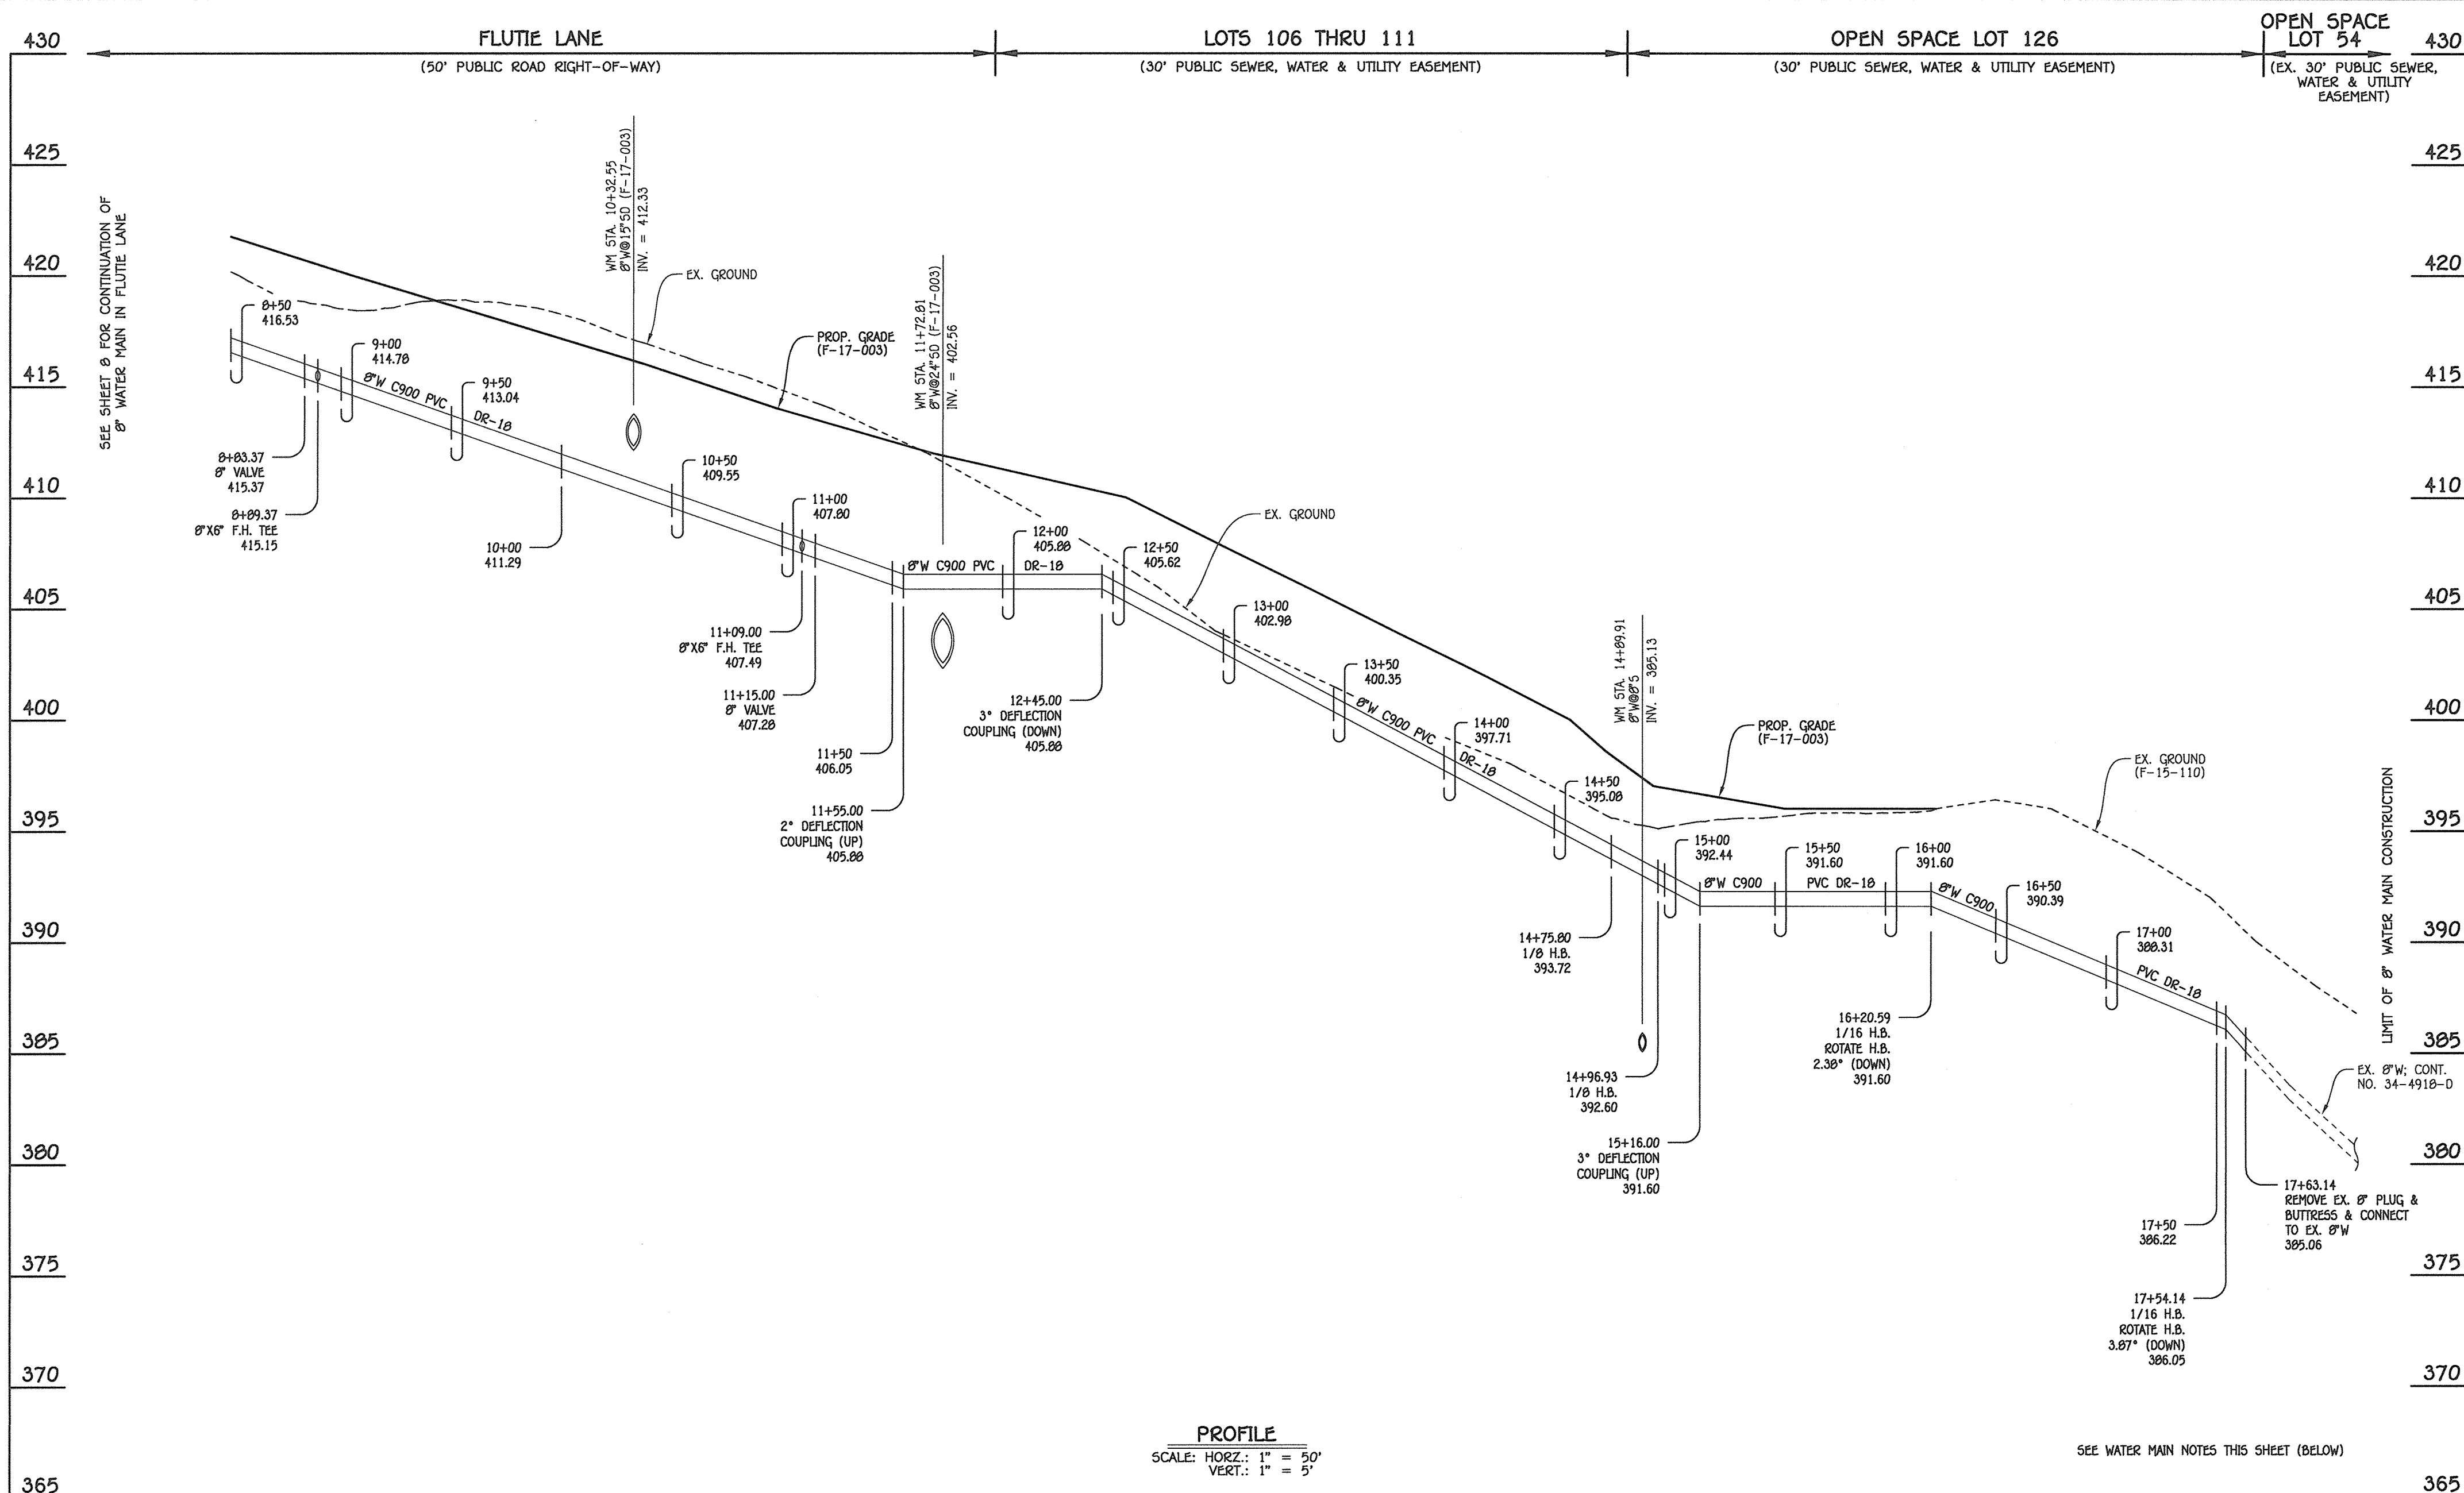

8" WATER MAIN: FLUTIE LANE

W.M. STA.	APPURTENANCE	NORTHING	EASTING
8" WATER MAIN: FLUTIE LANE			
8+83.37	8" VALVE	557838.83	1328360.95
8+89.37	8"X6" F.H. TEE	557833.23	1328358.78
11+09.00	8"X6" F.H. TEE	557628.52	1328279.23
11+15.00	8" VALVE	557622.93	1328277.05
14+75.80	1/8" H.B.	557286.63	1328146.37
14+96.93	1/8" H.B.	557267.31	1328154.93
16+20.59	1/16" H.B.	557223.00	1328270.38
17+54.14	1/16" H.B.	557223.97	1328403.92
17+63.14	EX. 8" PLUG & BUTTRESS	557220.19	1328412.09

- WATER MAIN NOTES:**
- ALL WATER MAINS SHALL BE AWWA C900 PVC PIPE; DR-18.
 - ALL PIPE BEDDING, TRACER WIRE, LOCATING TAPE AND OTHER APPURTENANCES SHALL BE IN ACCORDANCE WITH THE HOWARD COUNTY DESIGN MANUAL, VOLUME IV - WATER AND SEWER STANDARDS FOR AWWA C900 PVC WATER PIPE INSTALLATION.
 - DEFLECTION COUPLINGS SHALL BE CERTAIN-TIED PVC HIGH DEFLECTION COUPLINGS.
 - ALL WATER HOUSE CONNECTIONS AND TAPS SHALL BE PERFORMED USING A SADDLE.

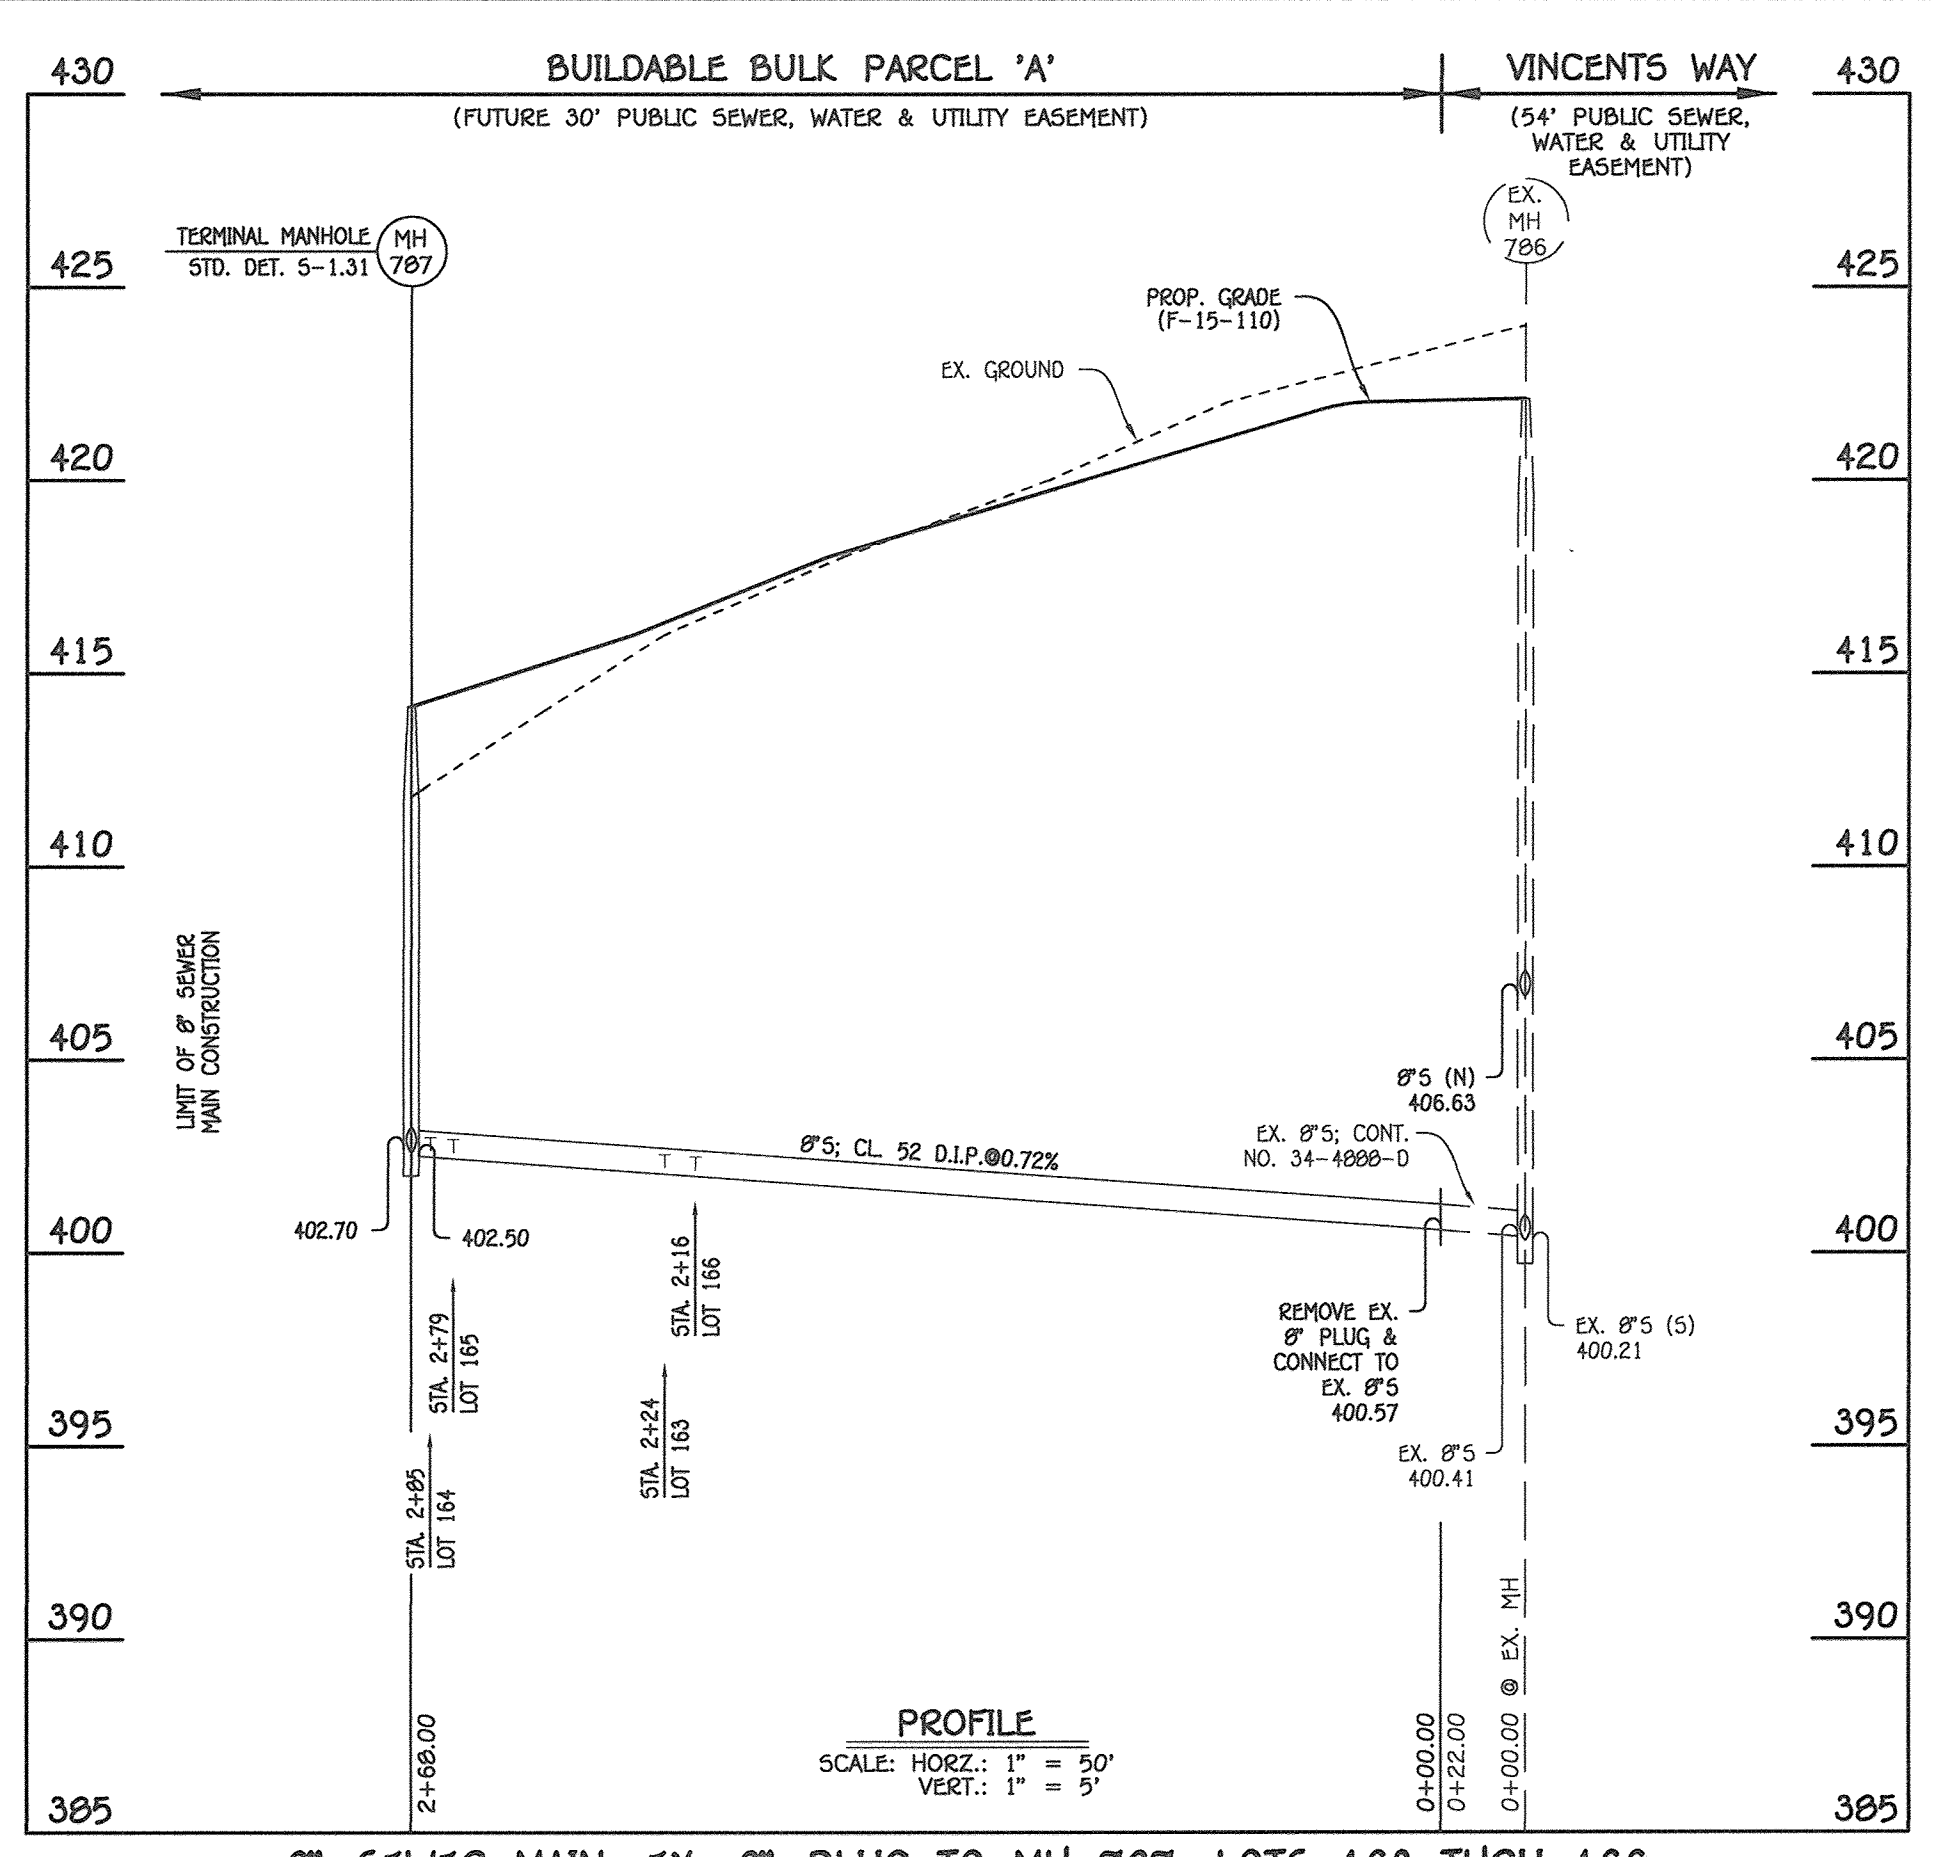

8" SEWER MAIN: EX. 8" PLUG TO MH 787; LOTS 163 THRU 166


MANHOLE TABULATION CHART			
NO.	NORTHING	EASTING	RIM ELEVATION
EX. 8" PLUG	557640.88	1329041.28	---
787 (TERMINAL)	557543.92	1328791.43	414.14

NOTE: SET MH RIM FLUSH W/PROPOSED GRADE.

SEWER HOUSE CONNECTION CHART						
STATION	LOT	ELEVATION AT MAIN	ELEVATION AT EASEMENT	M.C.E.	B.E.	F.F.
EX. 8" PLUG TO MH 787; LOTS 163 THRU 166						
2+16 LT.	166	402.14	402.54	407.04	410.58	420.73
2+24 RT.	163	402.19	402.39	407.09	410.58	420.73
2+79 LT.	165	402.59	402.99	407.59	408.10	418.25
2+85 RT.	164	402.63	402.83	407.33	408.10	418.25

AS-BUILT
11/2/18

NOTE: THIS ORIGINAL CONSTRUCTION PLAN, SHEET 9 OF 16 SUPERSEDES THE WATER & SEWER MAIN CONSTRUCTION PLAN PREVIOUSLY APPROVED AND SIGNED BY THE DEPARTMENT OF PLANNING AND ZONING ON JULY 21, 2017.

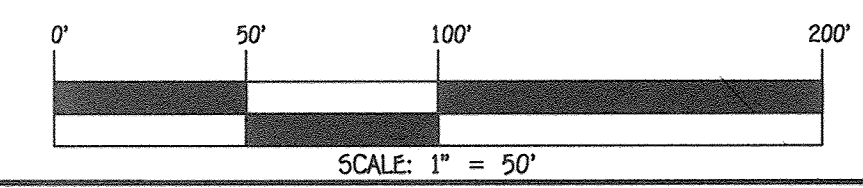


CONTRACT NO. 34-4992-0 ENCLAVE AT RIVER HILL: PHASE II LOTS 55 THRU 74, 82 THRU 124, 130 THRU 159, 161 THRU 168 & OPEN SPACE LOTS 125 THRU 129, 160 & 169 SEWER & WATER MAIN EXTENSIONS HOWARD COUNTY, MARYLAND

DEPARTMENT OF PUBLIC WORKS
HOWARD COUNTY, MARYLAND
CHIEF, BUREAU OF UTILITIES

DEPARTMENT OF PLANNING AND ZONING
HOWARD COUNTY, MARYLAND
CHIEF, DEVELOPMENT ENGINEERING DIVISION

I HEREBY CERTIFY THAT THESE DOCUMENTS WERE PREPARED OR APPROVED BY ME AND THAT I AM A DULY LICENSED PROFESSIONAL ENGINEER UNDER THE LAWS OF THE STATE OF MARYLAND.
LICENSE NO. 12943 EXPIRATION DATE IS 7/16/18.
FISHER, COLLINS & CARTER, INC.
CIVIL ENGINEERING CONSULTANTS & LAND SURVEYORS
CENTRAL SQUARE OFFICE PARK - 10272 BALDORGE NATIONAL PIKE
ELICOTT CITY, MARYLAND 21042
(410) 461 - 2222

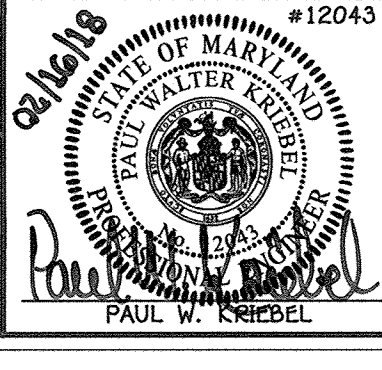


DESIGNED BY: B.C.R.
DRAWN BY: B.C.R.
CHECKED BY: P.W.K.
DATE: FEBRUARY, 2018

FCC ADD 8" PROFILE & CHARTS FOR LOTS 163 THRU 166 1-5-18
FCC REVISE CONTRACT TITLE & PLAN TO REFLECT LOT NUMBER CHANGES 1-5-18

SEWER & WATER MAIN EXTENSIONS
PROFILES, CHARTS & NOTES
600' SCALE MAP NO. 34 BLOCK NO. 18
F.C.C. WORK ORDER NO. 13008-3001
FILE NAME: SEWER & WATER MAIN EXTENSION PLAN

ENCLAVE AT RIVER HILL: PHASE II
LOTS 55 THRU 74, 82 THRU 124, 130 THRU 159, 161 THRU 168 &
OPEN SPACE LOTS 125 THRU 129, 160 & 169
SEWER & WATER MAIN EXTENSIONS
CONTRACT NO. 34-4992-0
FIFTH ELECTION DISTRICT
HOWARD COUNTY, MARYLAND

SCALE AS SHOWN
SHEET 9 OF 16

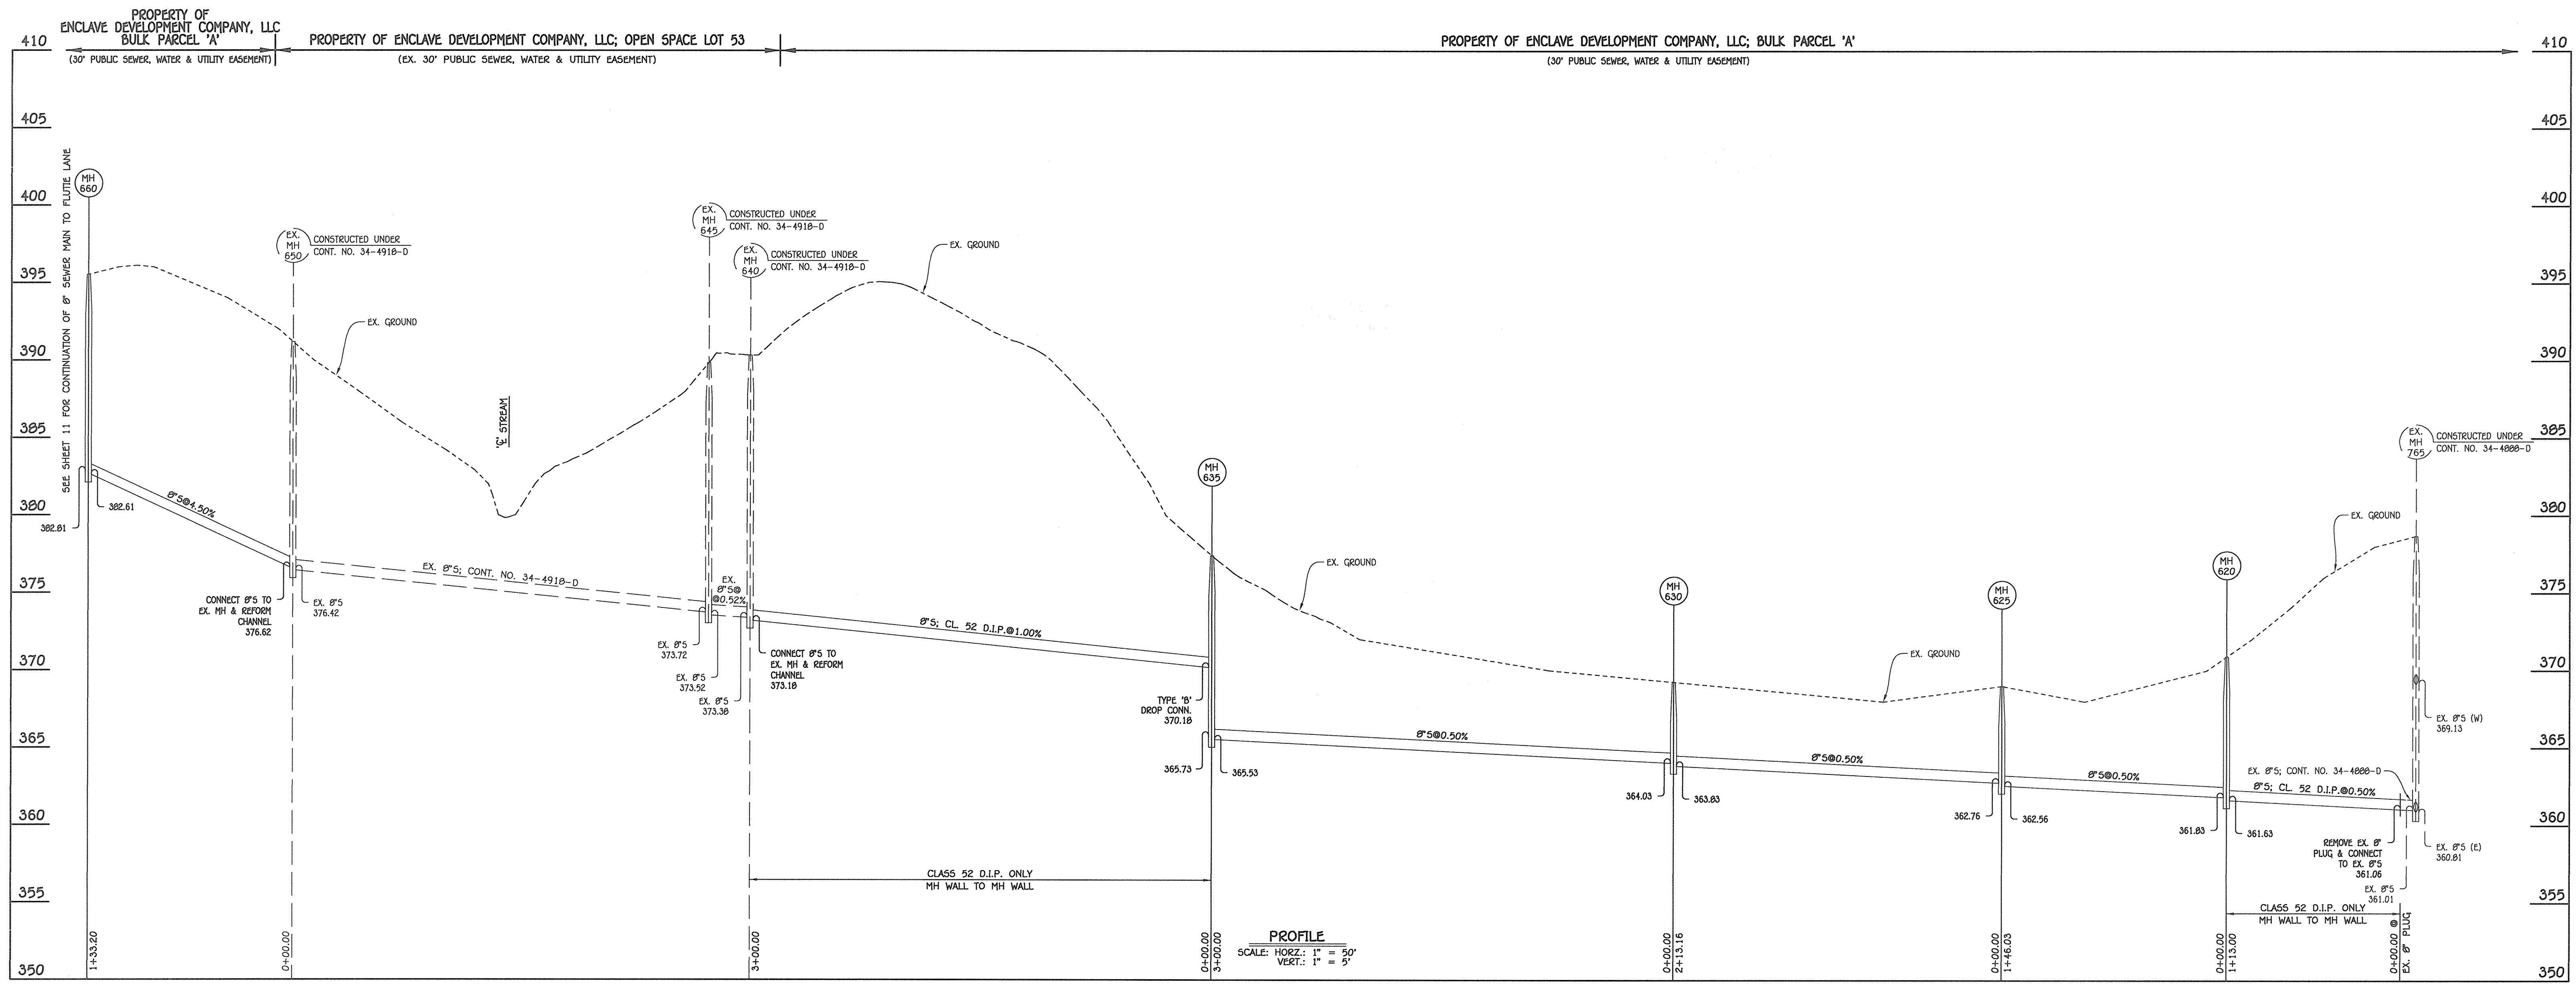


8" SEWER MAIN OUTFALL: EX. MH 765 TO MH 660

MANHOLE TABULATION CHART			
NO.	NORTHING	EASTING	RIM ELEVATION
620	556649.77	1329507.92	370.91
625	556749.67	1329401.41	369.00
630	556834.95	1329206.05	369.25
635	556954.96	1328931.10	377.39
660	557212.99	1328268.56	395.52

NOTE: SET MH RIMS FLUSH W/EXISTING GROUND.

AS-BUILT
[Signature] 11/2/18

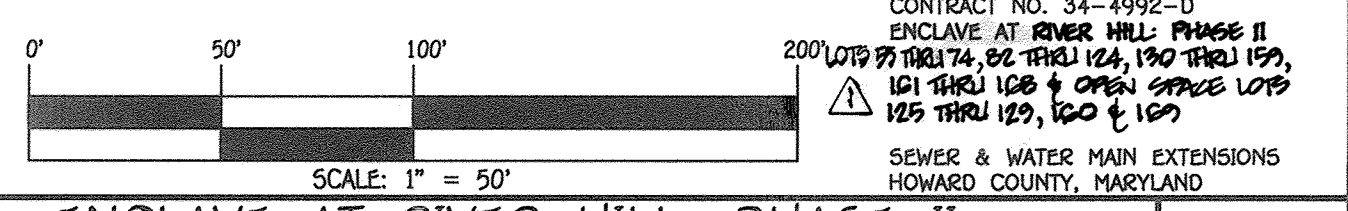

DEPARTMENT OF PUBLIC WORKS
 HOWARD COUNTY, MARYLAND

DEPARTMENT OF PLANNING AND ZONING
 HOWARD COUNTY, MARYLAND


[Signature] 2/2/18
 CHIEF, BUREAU OF UTILITIES

[Signature] 7/1/17
 CHIEF, DEVELOPMENT ENGINEERING DIVISION

I HEREBY CERTIFY THAT THESE DOCUMENTS WERE PREPARED OR APPROVED BY ME, AND THAT I AM A DULY LICENSED PROFESSIONAL ENGINEER UNDER THE LAWS OF THE STATE OF MARYLAND. LICENSE NO. 12043 EXPIRATION DATE IS 7/16/18.

FISHER, COLLINS & CARTER, INC.
 CIVIL ENGINEERING CONSULTANTS & LAND SURVEYORS

CENTENAL SQUARE OFFICE PARK - 10272 BALTIMORE NATIONAL PIKE
 ELLSWORTH CITY, MARYLAND 21042
 (410) 461 - 2995

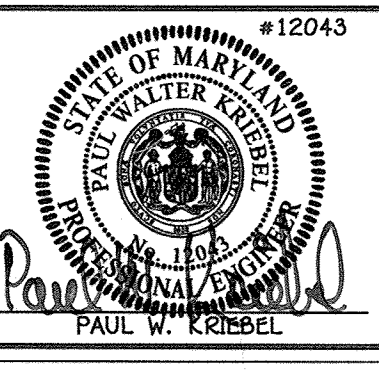

DESIGNED BY : B.C.R.
 DRAWN BY : B.C.R.
 CHECKED BY : P.W.K.
 DATE : JULY, 2017

REVISION
 1. CHANGE CONTRACT TITLE & PLAN TO REFLECT LOT NUMBER CHANGES 2/2/18

SEWER MAIN EXTENSIONS
 PROFILE & CHART

600' SCALE MAP NO. 34 BLOCK NO. 18
 F.C.C. WORK ORDER NO. 13008-3001

FILE NAME : SEWER & WATER MAIN EXTENSION PLAN


ENCLAVE AT RIVER HILL: PHASE II
 LOTS 55 THRU 74, 82 THRU 124, 130 THRU 159, 161 THRU 168 & OPEN SPACE LOTS 125 THRU 129, 160 & 169

SEWER & WATER MAIN EXTENSIONS
 CONTRACT NO. 34-4992-D
 FIFTH ELECTION DISTRICT
 HOWARD COUNTY, MARYLAND

SCALE AS SHOWN

SHEET 10 OF 16

1/20/13 13208.dwg (Water & Sewer Contract) No. 34-4992-D (Phase 2) (Final) 13008-3001 Water & Sewer Contract Planning

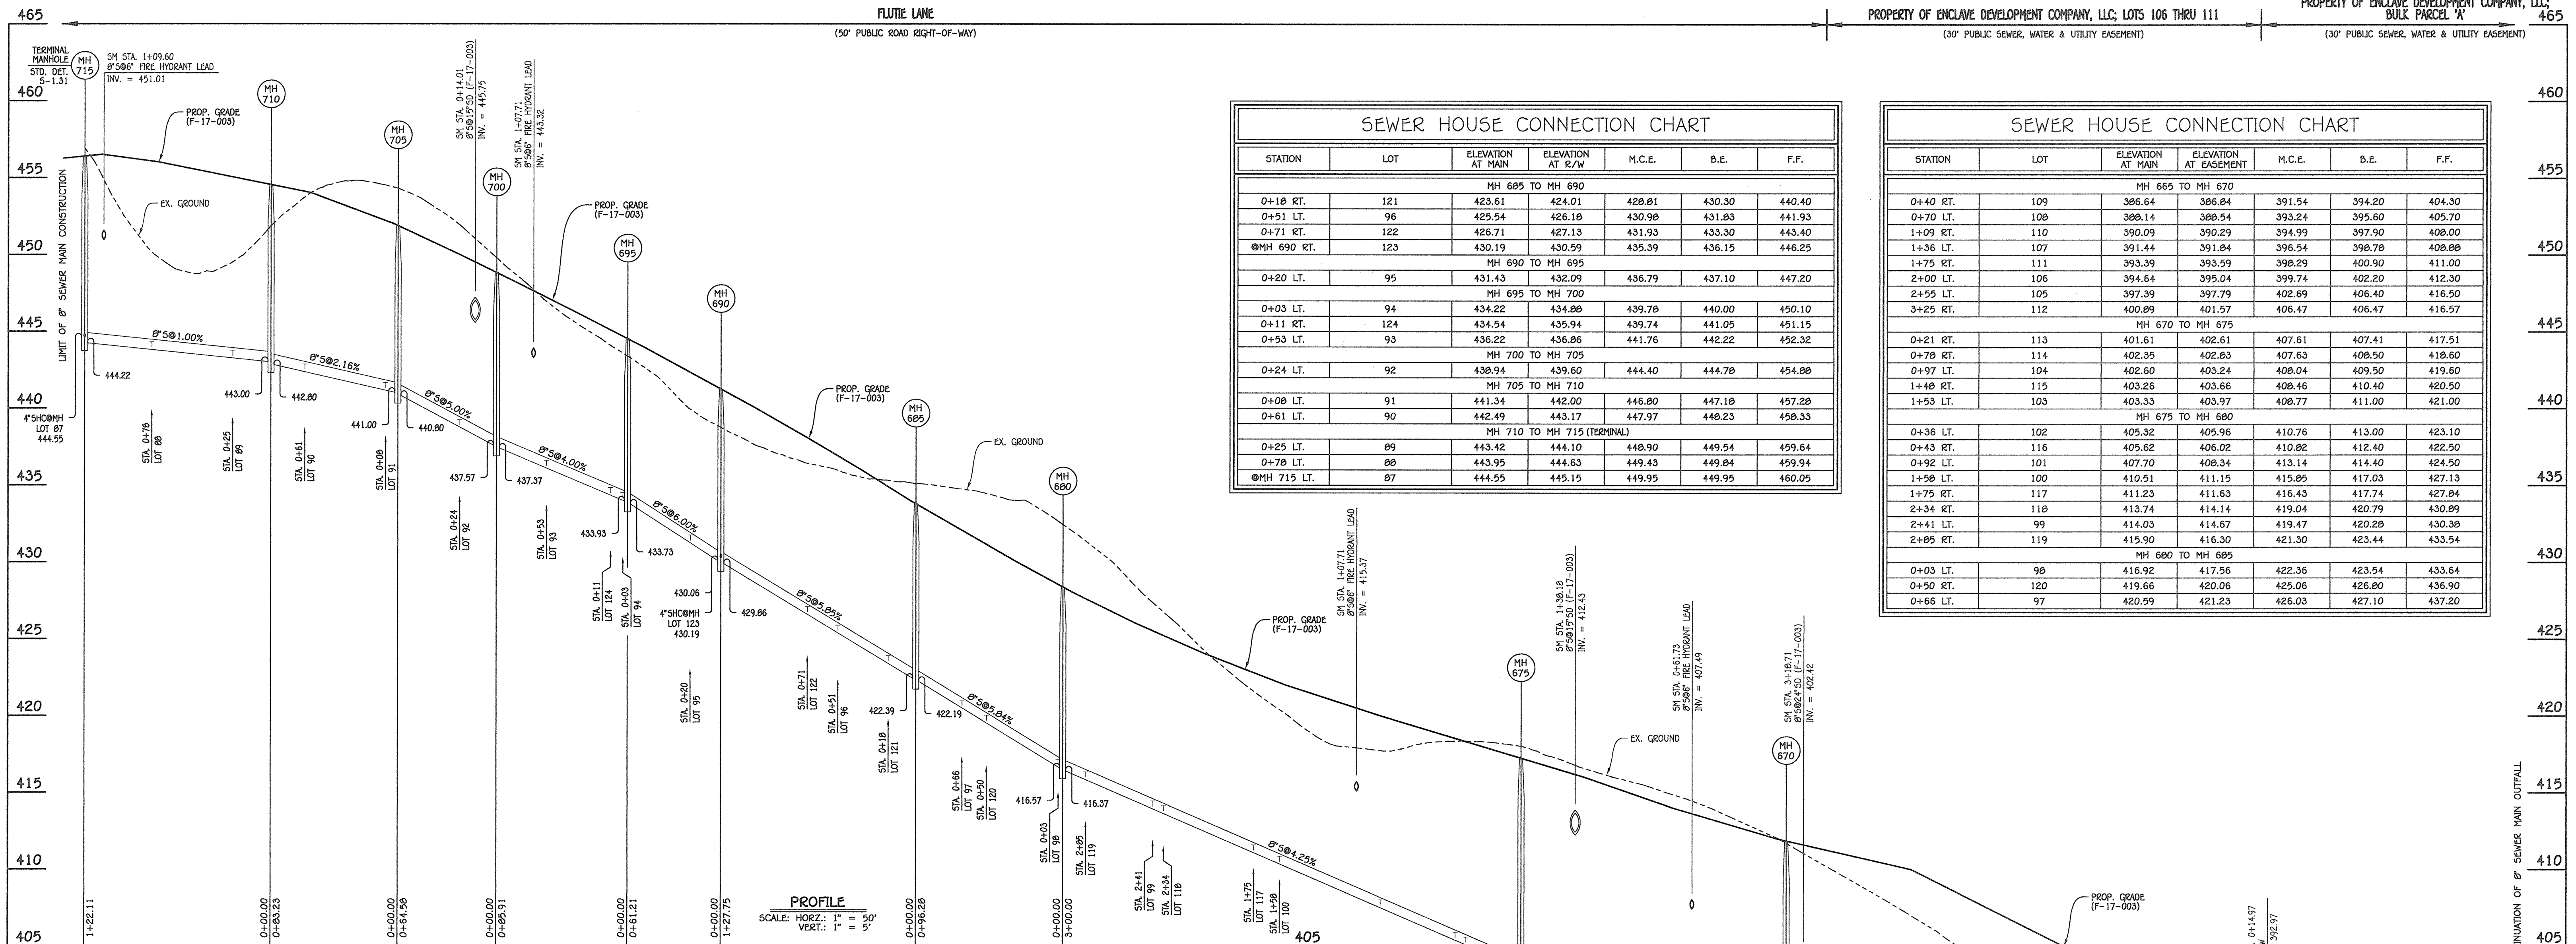

SEWER HOUSE CONNECTION CHART

STATION	LOT	ELEVATION AT MAIN	ELEVATION AT R/W	M.C.E.	B.E.	F.F.
MH 685 TO MH 690						
0+18 RT.	121	423.61	424.01	428.81	430.30	440.40
0+51 LT.	96	425.54	426.18	430.98	431.83	441.93
0+71 RT.	122	426.71	427.13	431.93	433.30	443.40
0+690 RT.	123	430.19	430.59	435.39	436.15	446.25
MH 690 TO MH 695						
0+20 LT.	95	431.43	432.09	436.79	437.10	447.20
MH 695 TO MH 700						
0+03 LT.	94	434.22	434.88	439.78	440.00	450.10
0+11 RT.	124	434.54	435.94	439.74	441.05	451.15
0+53 LT.	93	436.22	436.86	441.76	442.22	452.32
MH 700 TO MH 705						
0+24 LT.	92	438.94	439.60	444.40	444.78	454.88
MH 705 TO MH 710						
0+08 LT.	91	441.34	442.00	446.80	447.18	457.28
0+61 LT.	90	442.49	443.17	447.97	448.23	458.33
MH 710 TO MH 715 (TERMINAL)						
0+25 LT.	89	443.42	444.10	448.90	449.54	459.64
0+78 LT.	88	443.95	444.63	449.43	449.84	459.94
0+715 LT.	87	444.55	445.15	449.95	449.95	460.05

SEWER HOUSE CONNECTION CHART


STATION	LOT	ELEVATION AT MAIN	ELEVATION AT EASEMENT	M.C.E.	B.E.	F.F.
MH 665 TO MH 670						
0+40 RT.	109	386.64	386.84	391.54	394.20	404.30
0+70 LT.	108	388.14	388.54	393.24	395.60	405.70
1+09 RT.	110	390.09	390.29	394.99	397.90	408.00
1+36 LT.	107	391.44	391.84	396.54	398.78	408.88
1+75 RT.	111	393.39	393.59	398.29	400.90	411.00
2+00 LT.	106	394.64	395.04	399.74	402.20	412.30
2+55 LT.	105	397.39	397.79	402.69	406.40	416.50
3+25 RT.	112	400.89	401.57	406.47	406.47	416.57
MH 670 TO MH 675						
0+21 RT.	113	401.61	402.61	407.61	407.41	417.51
0+78 RT.	114	402.35	402.83	407.63	408.50	418.60
0+97 LT.	104	402.60	403.24	408.04	409.50	419.60
1+48 RT.	115	403.26	403.66	408.46	410.40	420.50
1+53 LT.	103	403.33	403.97	408.77	411.00	421.00
MH 675 TO MH 680						
0+36 LT.	102	405.32	405.96	410.76	413.00	423.10
0+43 RT.	116	405.62	406.02	410.82	412.40	422.50
0+92 LT.	101	407.70	408.34	413.14	414.40	424.50
1+58 LT.	100	410.51	411.15	415.85	417.03	427.13
1+75 RT.	117	411.23	411.63	416.43	417.74	427.84
2+34 RT.	118	413.74	414.14	419.04	420.79	430.89
2+41 LT.	99	414.03	414.67	419.47	420.28	430.38
2+85 RT.	119	415.90	416.30	421.30	423.44	433.54
MH 680 TO MH 685						
0+03 LT.	98	416.92	417.56	422.36	423.54	433.64
0+50 RT.	120	419.66	420.06	425.06	426.80	436.90
0+66 LT.	97	420.59	421.23	426.03	427.10	437.20

8" SEWER MAIN: MH 660 TO MH 715 - FLUTIE LANE

MANHOLE TABULATION CHART

NO.	NORTHING	EASTING	RIM ELEVATION
665	557259.77	1328146.66	394.50
670	557967.36	1328266.19	411.86
675	557729.22	1328329.09	417.24
680	558008.85	1328437.75	428.35
685	558099.85	1328469.21	433.75
690	558225.89	1328490.01	441.21
695	558286.90	1328494.93	444.50
700	558370.69	1328513.91	448.81
705	558430.78	1328537.55	451.87
710	558502.84	1328579.22	454.53
715 (TERMINAL)	558595.49	1328658.75	456.39

NOTE: SET MH RIMS FLUSH W/EXISTING GROUND OR PROPOSED GRADE, AS APPLICABLE.

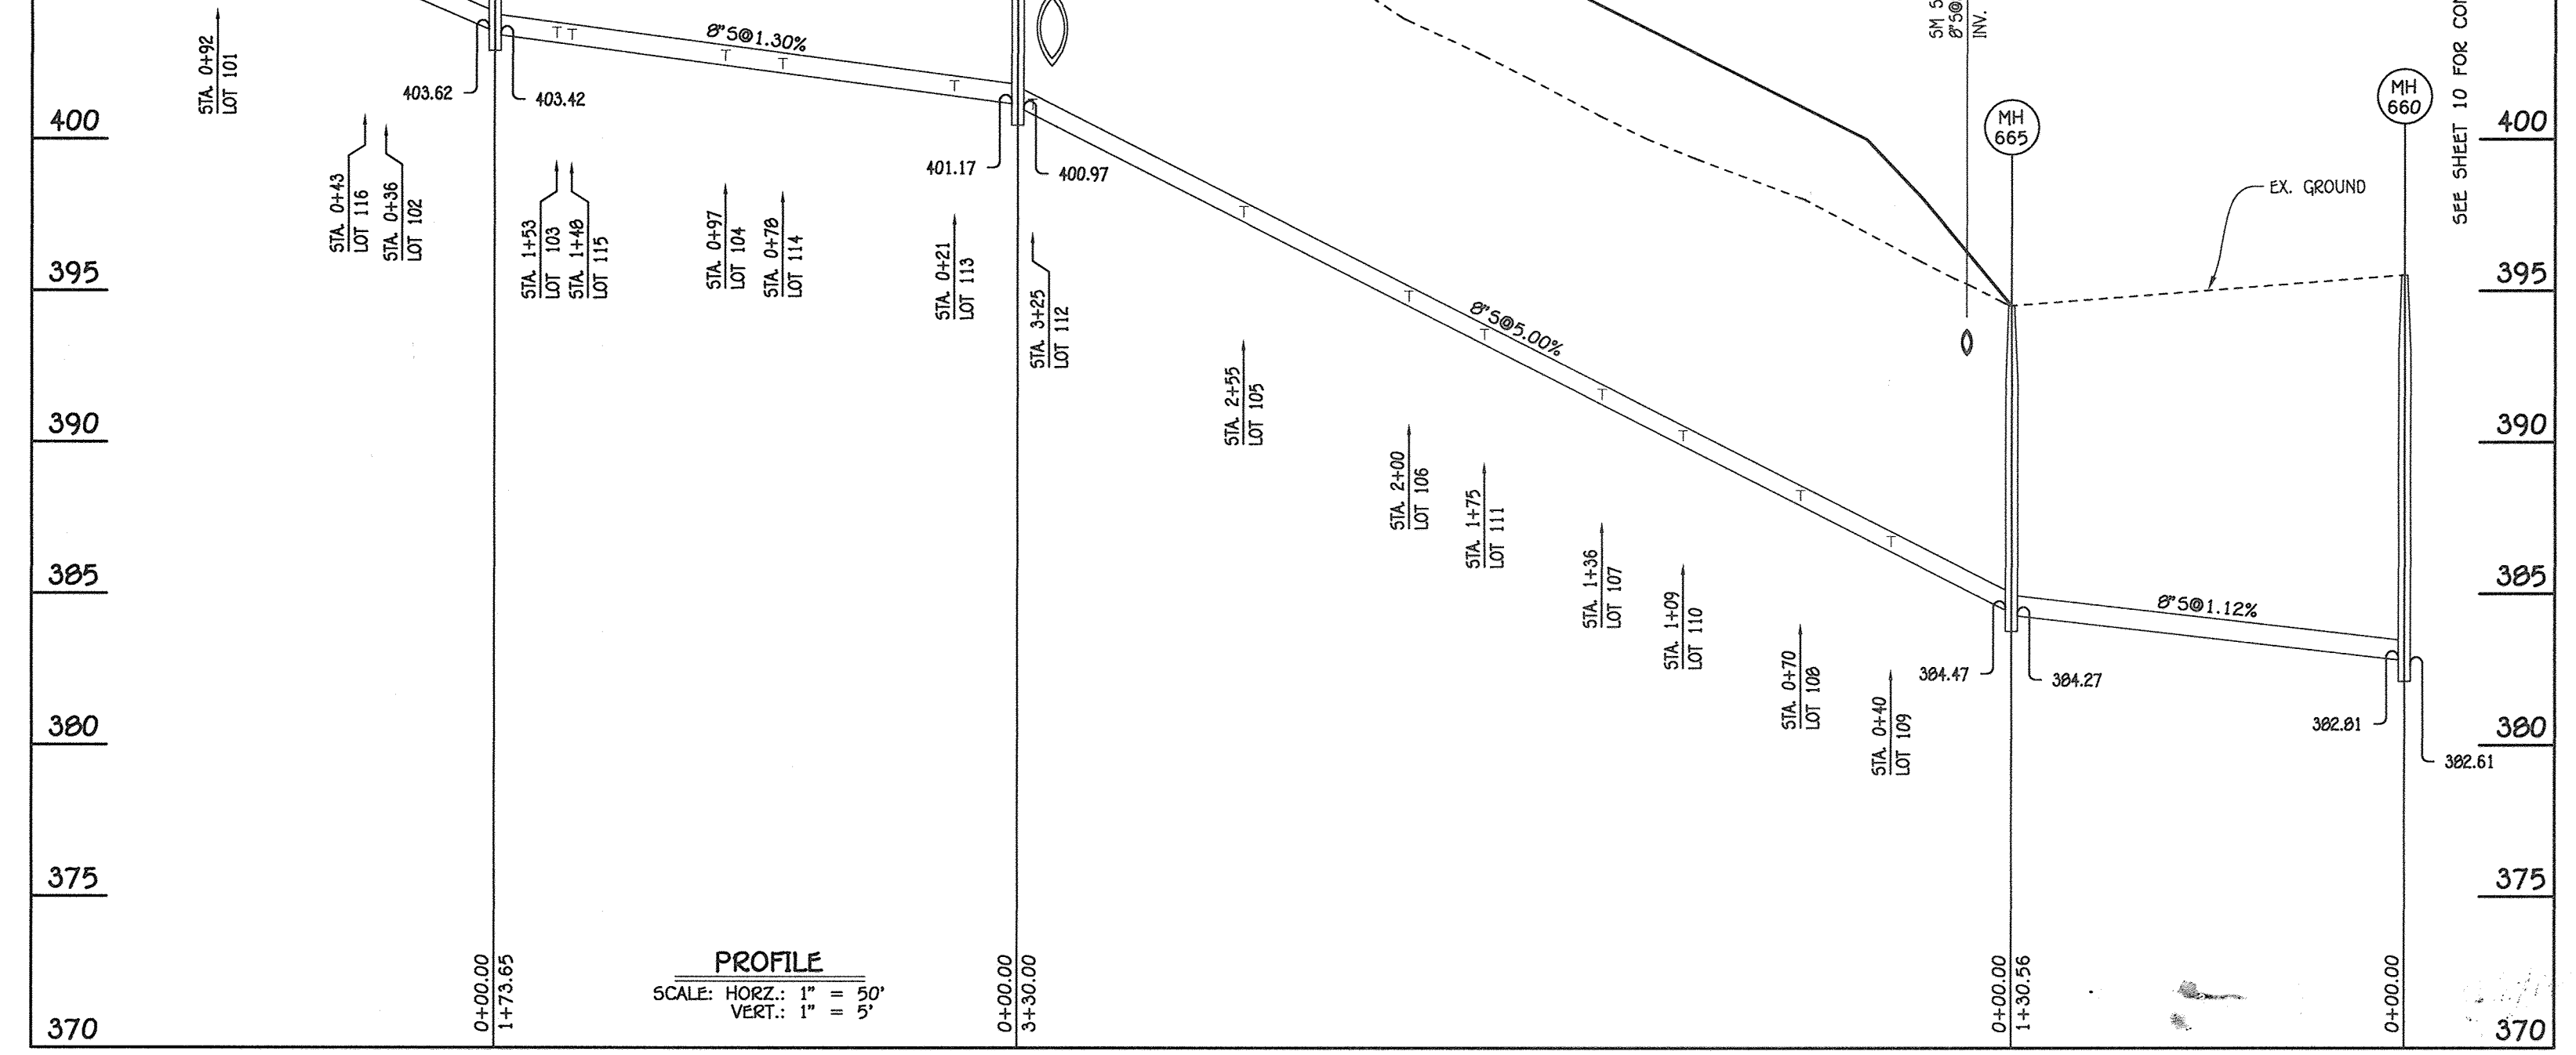

AS-BUILT

8" SEWER MAIN: MH 660 TO MH 715 - FLUTIE LANE

NOTE: THIS ORIGINAL CONSTRUCTION PLAN, SHEET 11 OF 16 SUPERSEDES THE WATER & SEWER MAIN CONSTRUCTION PLAN PREVIOUSLY APPROVED AND SIGNED BY THE DEPARTMENT OF PLANNING AND ZONING ON JULY 21, 2017.

DEPARTMENT OF PUBLIC WORKS
HOWARD COUNTY, MARYLAND

[Signature]
CHIEF, BUREAU OF UTILITIES

DEPARTMENT OF PLANNING AND ZONING
HOWARD COUNTY, MARYLAND

[Signature]
CHIEF, DEVELOPMENT ENGINEERING DIVISION

I HEREBY CERTIFY THAT THESE DOCUMENTS WERE PREPARED OR APPROVED BY ME, AND THAT I AM A DULY LICENSED PROFESSIONAL ENGINEER UNDER THE LAWS OF THE STATE OF MARYLAND.
LICENSE NO. 12043 EXPIRATION DATE IS 7/16/18.

FISHER, COLLINS & CARTER, INC.
CIVIL ENGINEERING CONSULTANTS & LAND SURVEYORS
CONTONIAL SQUARE OFFICE PARK - 1072 BALTIMORE NATIONAL PKWY.
ELICOTT CITY, MARYLAND 21042
(410) 461-2295



DESIGNED BY: B.C.R.
DRAWN BY: B.C.R.
CHECKED BY: P.W.K.
DATE: FEBRUARY, 2018

FCC Δ REVISE 8" PROFILE & CHARTS FROM MH 675 TO 715; LOWER TO SERVE B.E.'s 1-5-18
FCC Δ REVISE CONTRACT TITLE & PLAN TO REFLECT LOT NUMBER CHANGES 1-5-18

SEWER MAIN EXTENSIONS
PROFILE & CHARTS

600' SCALE MAP NO. 34 BLOCK NO. 18
F.C.C. WORK ORDER NO. 13008-3001
FILE NAME: SEWER & WATER MAIN EXTENSION PLAN

ENCLAVE AT RIVER HILL: PHASE II
LOTS 55 THRU 74, 82 THRU 124, 130 THRU 159, 161 THRU 168 & OPEN SPACE LOTS 125 THRU 129, 160 & 169
SEWER & WATER MAIN EXTENSIONS
CONTRACT NO. 34-4992-D
FIFTH ELECTION DISTRICT
HOWARD COUNTY, MARYLAND

SCALE AS SHOWN
SHEET 11 OF 16

I:\2013\13008\3001\Water & Sewer\Contract\3001\Water & Sewer\Contract\Plan\dwg. 2/16/2018 11:20:00 AM

SEWER HOUSE CONNECTION AS-BUILT LOCATION TABLE


LOT NUMBER	4" PVC ADDRESS	LOCATION DIMENSION 1	LOCATION DIMENSION 2
55	63'	CO-9' - WHC-55	CO-73' - MH-325
56	46'	CO-24' - WHC-56	CO-48' - MH-325
57	19'	CO-17' - WHC-57	CO-23' - MH-325
58	22'	CO-22' - WHC-58	CO-17' - CO-57
59	27'	CO-27' - WHC-59	CO-45' - CO-60
60	26'	CO-14' - WHC-60	CO-45' - CO-59
65	18'	CO-12' - WHC-65	CO-35' - WHC-69
66	10'	CO-11' - WHC-66	CO-43' - WHC-67
67	18'	CO-17' - WHC-67	CO-34' - MH-
68	8'	CO-13' - WHC-68	CO-34' - WHC-66'
69	8'	CO-13' - WHC-69	CO-53' - MH-310
82	31'	CO-12' - WHC-82	CO-57' - MH-780
83	31'	CO-12' - WHC-83	CO-56' - WHC-139
84	31'	CO-10' - WHC-84	CO-53' - MH-300
85	31'	CO-10' - WHC-85	CO-21' - FHT
86	33'	CO-22' - WHC-86	CO-26' - I-51
87	32'	CO-14' - WHC	CO-62' - FHT
88	30'	CO-12' - WHC	CO-46' - SMH-710
89	30'	CO-12' - WHC	CO-92' - SMH-710
90	30'	CO-9' - WHC	CO-77' - SMH-705
91	30'	CO-10' - WHC	CO-37' - SMH-705
92	31'	CO-10' - WHC	CO-47' - SMH-700
93	31'	CO-18' - WHC	CO-44' - FHT
94	31'	CO-10' - WHC	CO-34' - SMH-695
95	30'	CO-10' - WHC	CO-45' - SMH-690
96	32'	CO-10' - WHC	CO-57' - WHC-122
97	30'	CO-9' - WHC	CO-30' - FHT
98	31'	CO-11' - WHC	CO-34' - SMH-680
99	32'	CO-12' - WHC	CO-55' - SMH-680
100	31'	CO-10' - WHC	CO-74' - FHT
101	31'	CO-10' - WHC	CO-44' - FHT
102	31'	CO-9' - WHC	CO-56' - SMH-675
103	30'	CO-11' - WHC	CO-34' - SMH-675
104	32'	CO-11' - WHC	CO-33' - I-34
105	18'	CO-10' - WHC	CO-76' - WHC-111
106	18'	CO-12' - WHC	CO-35' - WHC-111
107	18'	CO-10' - WHC	CO-34' - WHC-110
108	20'	CO-12' - WHC	CO-34' - WHC-109
109	10'	CO-13' - WHC	CO-44' - SMH-665
110	10'	CO-11' - WHC	CO-43' - WHC-108
111	10'	CO-11' - WHC	CO-48' - WHC-106
112	42'	CO-16' - WHC	CO-42' - SMH-670
113	51'	CO-10' - WHC	CO-55' - SMH-670
114	25'	CO-34' - WHC	CO-18' - FHT
115	18'	CO-11' - WHC	CO-33' - SMH-675
116	18'	CO-10' - WHC	CO-56' - SMH-675
117	20'	CO-12' - WHC	CO-55' - WHC-100
118	20'	CO-17' - WHC	CO-56' - SMH-680
119	20'	CO-8' - WHC	CO-21' - SMH-680
120	20'	CO-12' - WHC	CO-53' - FHT
121	20'	CO-10' - WHC	CO-35' - SMH-685
122	22'	CO-13' - WHC	CO-31' - I-40
123	19'	CO-10' - WHC	CO-27' - I-40
124	18'	CO-13' - WHC	CO-31' - SMH-695
130	87'	CO-24' - WHC-130	CO-42' - CO-131
131	57'	CO-18' - WHC-131	CO-26' - CO-130
132	36'	CO-9' - WHC-132	CO-35' - CO-131
133	22'	CO-14' - WHC-133	CO-30' - I-51
134	37'	CO-25' - WHC-134	CO-25' - WHC-134
135	41'	CO-10' - WHC-135	CO-69' - MH-302
136	19'	CO-11' - WHC-136	CO-14' - I-67
137	19'	CO-11' - WHC-137	CO-55' - FHT
138	19'	CO-11' - WHC-138	CO-54' - CO-84
139	18'	CO-11' - WHC-139	CO-55' - CO-83
140	18'	CO-14' - WHC-140	CO-50' - MH-780
141	8'	CO-17' - WHC-141	CO-34' - CO-166
142	8'	CO-14' - WHC-142	CO-12' - MH-787
143	18'	CO-34' - WHC-143	CO-24' - MH-787
144	18'	CO-33' - WHC-144	CO-34' - CO-63
70	33'	CO-12' - WHC-70	CO-24' - I-57
71	33'	CO-10' - WHC-71	CO-47' - I-57
72	34'	CO-11' - WHC-72	CO-46' - WHC-73
73	28'	CO-20' - WHC-73	CO-49' - I-55
74	18'	CO-10' - WHC-74	CO-25' - MH-795
141	19'	CO-17' - WHC-141	CO-19' - I-63
142	19'	CO-11' - WHC-142	CO-55' - I-63
143	19'	CO-10' - WHC-143	CO-57' - WHC-166
144	19'	CO-11' - WHC-144	CO-29' - I-52
145	34'	CO-13' - WHC-145	CO-22' - FHT
146	51'	CO-9' - WHC-146	CO-35' - FHT
147	9'	CO-11' - WHC-147	CO-42' - CO-154
148	9'	CO-12' - WHC-148	CO-38' - CO-153
149	9'	CO-10' - WHC-149	CO-30' - WHC-152
150	9'	CO-11' - WHC-150	CO-36' - MH-765
151	19'	CO-10' - WHC-151	CO-28' - MH-765
152	19'	CO-10' - WHC-152	CO-35' - CO-149
153	19'	CO-12' - WHC-153	CO-38' - CO-148
154	19'	CO-10' - WHC-154	CO-42' - CO-147
155	31'	CO-12' - WHC-155	CO-16' - I-59
156	31'	CO-11' - WHC-156	CO-58' - WHC-143
157	31'	CO-11' - WHC-157	CO-60' - I-60
158	31'	CO-20' - WHC-158	CO-18' - I-60
159	31'	CO-12' - WHC-159	CO-26' - FHT
167	22'	CO-12' - WHC-167	CO-26' - FHT
168	22'	CO-11' - WHC-168	CO-25' - I-46

WATER HOUSE CONNECTION AS-BUILT LOCATION TABLE

LOT NUMBER	1/2" COPPER ADDRESS	LOCATION DIMENSION 1	LOCATION DIMENSION 2
55	55'	WHC-9' - CO	WHC-69' - MH-325
56	20'	WHC-24' - CO	WHC-35' - MH-325
57	17'	WHC-17' - CO	WHC-3' - MH-325
58	48'	WHC-22' - CO	WHC-38' - CO-57
59	57'	WHC-27' - CO	WHC-66' - CO-60
60	46'	WHC-14' - CO	WHC-31' - CO-59
61	21'	WHC-10' - CO	WHC-45' - MH-795
62	18'	WHC-28' - CO	WHC-36' - MH-790
63	19'	WHC-11' - CO	I-50
64	22'	WHC-15' - CO	WHC-43' - MH-786
65	3'	WHC-12' - CO	WHC-33' - CO-69
66	3'	WHC-11' - CO	WHC-35' - CO-68
67	3'	WHC-17' - CO	WHC-28' - MH-315
68	20'	WHC-13' - CO	WHC-42' - CO-66
69	22'	WHC-13' - CO	WHC-41' - MH-310
70	21'	WHC-12' - CO	WHC-34' - I-57
71	21'	WHC-10' - CO	WHC-9' - I-57
72	21'	WHC-11' - CO	WHC-46' - CO-71
73	19'	WHC-20' - CO	WHC-69' - I-55
74	29'	WHC-10' - CO	WHC-30' - MH-795
161	32'	WHC-8' - CO	WHC-25' - I-49
162	34'	WHC-14' - CO	WHC-52' - MH-786
163	22'	WHC-17' - CO	WHC-35' - CO-166
164	22'	WHC-14' - CO	WHC-19' - MH-787
165	12'	WHC-34' - CO	WHC-46' - MH-787
166	11'	WHC-35' - CO	WHC-31' - CO-163
167	33'	WHC-12' - CO	WHC-37' - FHT
82	18'	WHC-12' - CO	WHC-67' - MH-780
83	20'	WHC-12' - CO	WHC-54' - CO-139
84	20'	WHC-10' - CO	WHC-46' - MH-300
85	20'	WHC-10' - CO	WHC-31' - FHT
86	19'	WHC-22' - CO	WHC-15' - I-51
87	23'	WHC-14' - CO	WHC-64' - FHT
88	24'	WHC-12' - CO	WHC-50' - FHT
89	24'	WHC-12' - CO	WHC-49' - SMH-710
90	24'	WHC-9' - CO	WHC-34' - SMH-710
91	24'	WHC-10' - CO	WHC-37' - SMH-705
92	23'	WHC-10' - CO	WHC-44' - SMH-705
93	22'	WHC-18' - CO	WHC-44' - FHT
94	23'	WHC-10' - CO	WHC-64' - FHT
95	22'	WHC-10' - CO	WHC-44' - SMH-695
96	20'	WHC-10' - CO	WHC-72' - SMH-690
97	23'	WHC-9' - CO	WHC-39' - SMH-685
98	22'	WHC-11' - CO	WHC-33' - FHT
99	22'	WHC-12' - CO	WHC-56' - SMH-680
100	10'	WHC-10' - CO	WHC-46' - I-38
101	10'	WHC-10' - CO	WHC-44' - FHT
102	9'	WHC-9' - CO	WHC-56' - SMH-675


WATER HOUSE CONNECTION AS-BUILT LOCATION TABLE

LOT NUMBER	1/2" COPPER ADDRESS	LOCATION DIMENSION 1	LOCATION DIMENSION 2
103	11'	WHC-11' - CO	WHC-34' - SMH-675
104	11'	WHC-11' - CO	WHC-33' - I-34
105	10'	WHC-10' - CO	WHC-34' - WHC-111
106	12'	WHC-12' - CO	WHC-48' - CO-111
107	10'	WHC-10' - CO	WHC-39' - WHC-110
108	12'	WHC-12' - CO	WHC-84' - SMH-665
109	13'	WHC-13' - CO	WHC-56' - SMH-665
110	11'	WHC-11' - CO	WHC-34' - CO-107
111	11'	WHC-11' - CO	WHC-76' - CO-105
112	16'	WHC-16' - CO	WHC-48' - SMH-670
113	10'	WHC-10' - CO	WHC-36' - FHT
114	34'	WHC-34' - CO	WHC-51' - FHT
115	11'	WHC-11' - CO	WHC-24' - SMH-675
116	10'	WHC-10' - CO	WHC-56' - FHT
117	12'	WHC-12' - CO	WHC-79' - FHT
118	17'	WHC-17' - CO	WHC-55' - SMH-680
119	8'	WHC-8' - CO	WHC-21' - SMH-680
120	12'	WHC-12' - CO	WHC-54' - FHT
121	10'	WHC-10' - CO	WHC-35' - SMH-685
122	13'	WHC-13' - CO	WHC-49' - SMH-690
123	13'	WHC-10' - CO	WHC-22' - SMH-690
124	15'	WHC-13' - CO	WHC-39' - FHT
130	50'	WHC-24' - CO	WHC-18' - CO-131
131	48'	WHC-26' - CO	WHC-26' - CO-131
132	48'	WHC-9' - CO	WHC-57' - CO-131
133	11'	WHC-14' - CO	WHC-40' - I-51
134	8'	WHC-25' - CO	WHC-25' - CO-133
135	56'	WHC-10' - CO	WHC-73' - MH-302
136	30'	WHC-11' - CO	WHC-20' - I-67
137	29'	WHC-11' - CO	WHC-67' - FHT
138	28'	WHC-11' - CO	WHC-62' - CO-84
139	28'	WHC-11' - CO	WHC-56' - CO-83
140	29'	WHC-14' - CO	WHC-60' - MH-780
141	21'	WHC-17' - CO	WHC-15' - I-63
142	28'	WHC-11' - CO	WHC-45' - I-63
143	28'	WHC-10' - CO	WHC-53' - CO-156
144	18'	WHC-11' - CO	WHC-38' - I-52
145	30'	WHC-13' - CO	WHC-36' - FHT
146	62'	WHC-9' - CO	WHC-27' - FHT
147	20'	WHC-11' - CO	WHC-48' - CO-154
148	20'	WHC-12' - CO	WHC-43' - CO-153
149	20'	WHC-10' - CO	WHC-40' - WHC-152
150	20'	WHC-11' - CO	WHC-46' - MH-765
151	10'	WHC-10' - CO	WHC-36' - MH-765
152	10'	WHC-10' - CO	WHC-30' - CO-149
153	18'	WHC-12' - CO	WHC-33' - CO-148
154	11'	WHC-10' - CO	WHC-36' - CO-147
155	32'	WHC-12' - CO	WHC-41' - MH-775
156	18'	WHC-11' - CO	WHC-90' - MH-775
157	18'	WHC-11' - CO	WHC-50' - I-60
158	19'	WHC-20' - CO	WHC-16' - I-60
159	19'	WHC-12' - CO	WHC-32' - FHT
160	30'	WHC-11' - CO	WHC-35' - I-46

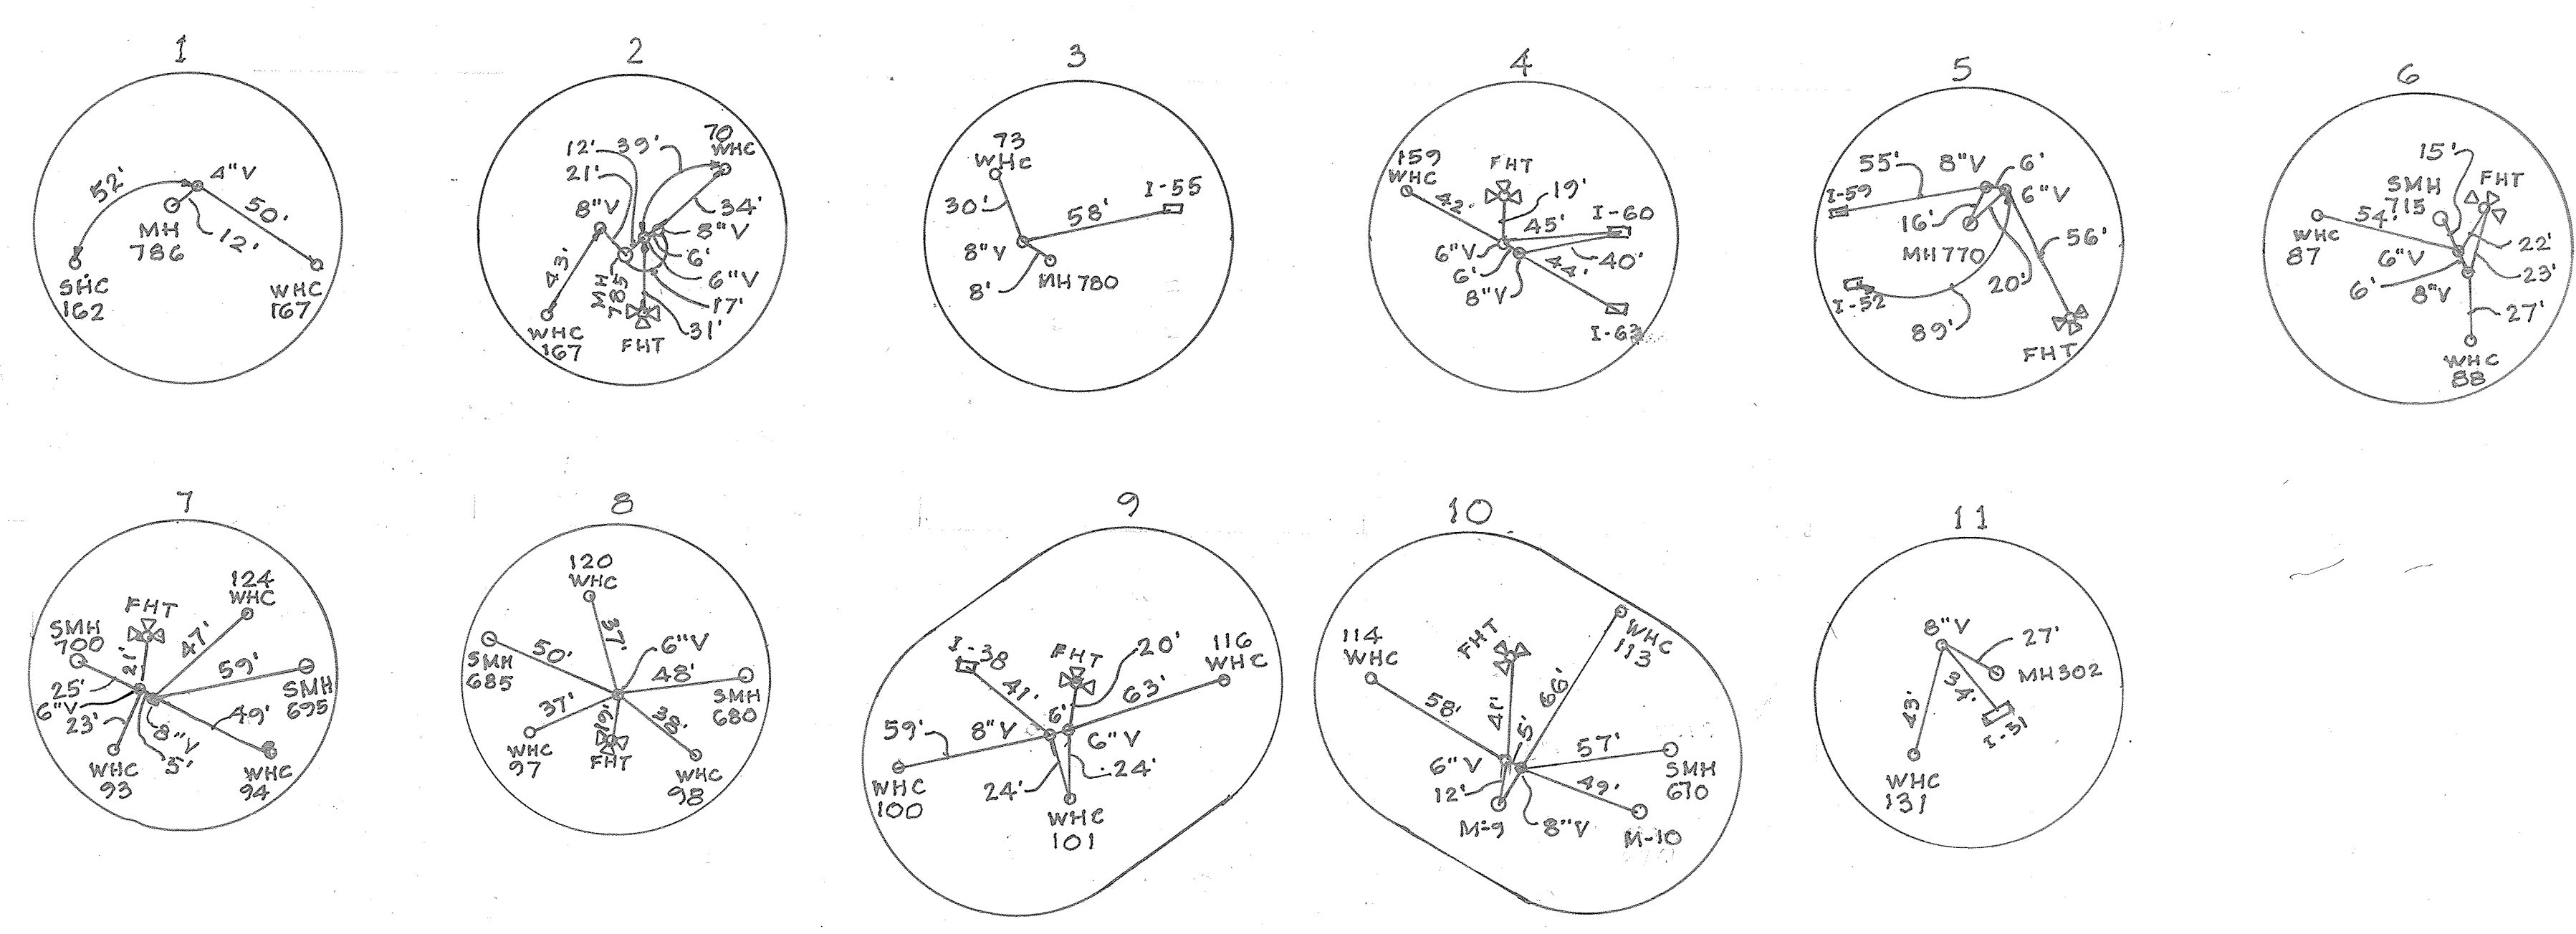

For locations 1, 2, 3, 4 and 5 see Sheet 3 of 16.
For locations 6, 7, 8, 9, 10 and 11 see Sheet 4 of 16.

AS-BUILT
Date 11/2/18

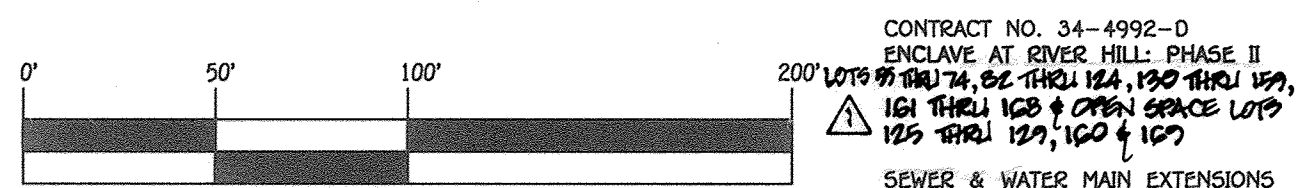

CONTRACT NO. 34-4992-D
ENCLAVE AT RIVER HILL: PHASE II
LOTS 74, 82 THRU 124, 130 THRU 159, 161 THRU 165 & 169
OPEN SPACE LOTS 125 THRU 129, 160 & 167

DEPARTMENT OF PUBLIC WORKS
HOWARD COUNTY, MARYLAND

DEPARTMENT OF PLANNING AND ZONING
HOWARD COUNTY, MARYLAND

CHIEF, BUREAU OF UTILITIES
DATE 7/2/18

CHIEF, DEVELOPMENT ENGINEERING DIVISION
DATE 7/2/18

I HEREBY CERTIFY THAT THESE DOCUMENTS WERE PREPARED OR APPROVED BY ME, AND THAT I AM A DULY LICENSED PROFESSIONAL ENGINEER UNDER THE LAWS OF THE STATE OF MARYLAND. LICENSE NO. 12043 EXPIRATION DATE 5/7/18/18.

FISHER, COLLINS & CARTER, INC.
CIVIL ENGINEERING CONSULTANTS & LAND SURVEYORS
CENTRAL SQUARE OFFICE PARK - 10772 BALTIMORE NATIONAL PIKE
ELIOTT CITY, MARYLAND 21042
(410) 461-2895

PAUL W. SCHEBEL

DESIGNED BY: B.C.R.

DRAWN BY: B.C.R.

CHECKED BY: P.W.K.

DATE: JULY, 2017

REVISION: 2/10/18

FILE NAME: SEWER & WATER MAIN EXTENSION PLAN

SEWER & WATER MAIN EXTENSIONS
"AS-BUILT" LOCATION TABLES

60' SCALE MAP NO. 34 BLOCK NO. 18


F.C.C. WORK ORDER NO. 13008-3001

ENCLAVE AT RIVER HILL: PHASE II
LOTS 74, 82 THRU 124, 130 THRU 159, 161 THRU 165 & 169
OPEN SPACE LOTS 125 THRU 129, 160 & 167

SCALE AS SHOWN

SHEET 13 OF 16


1/20/18 13:08:40 (dwg) Water & Sewer Contract Plan.dwg

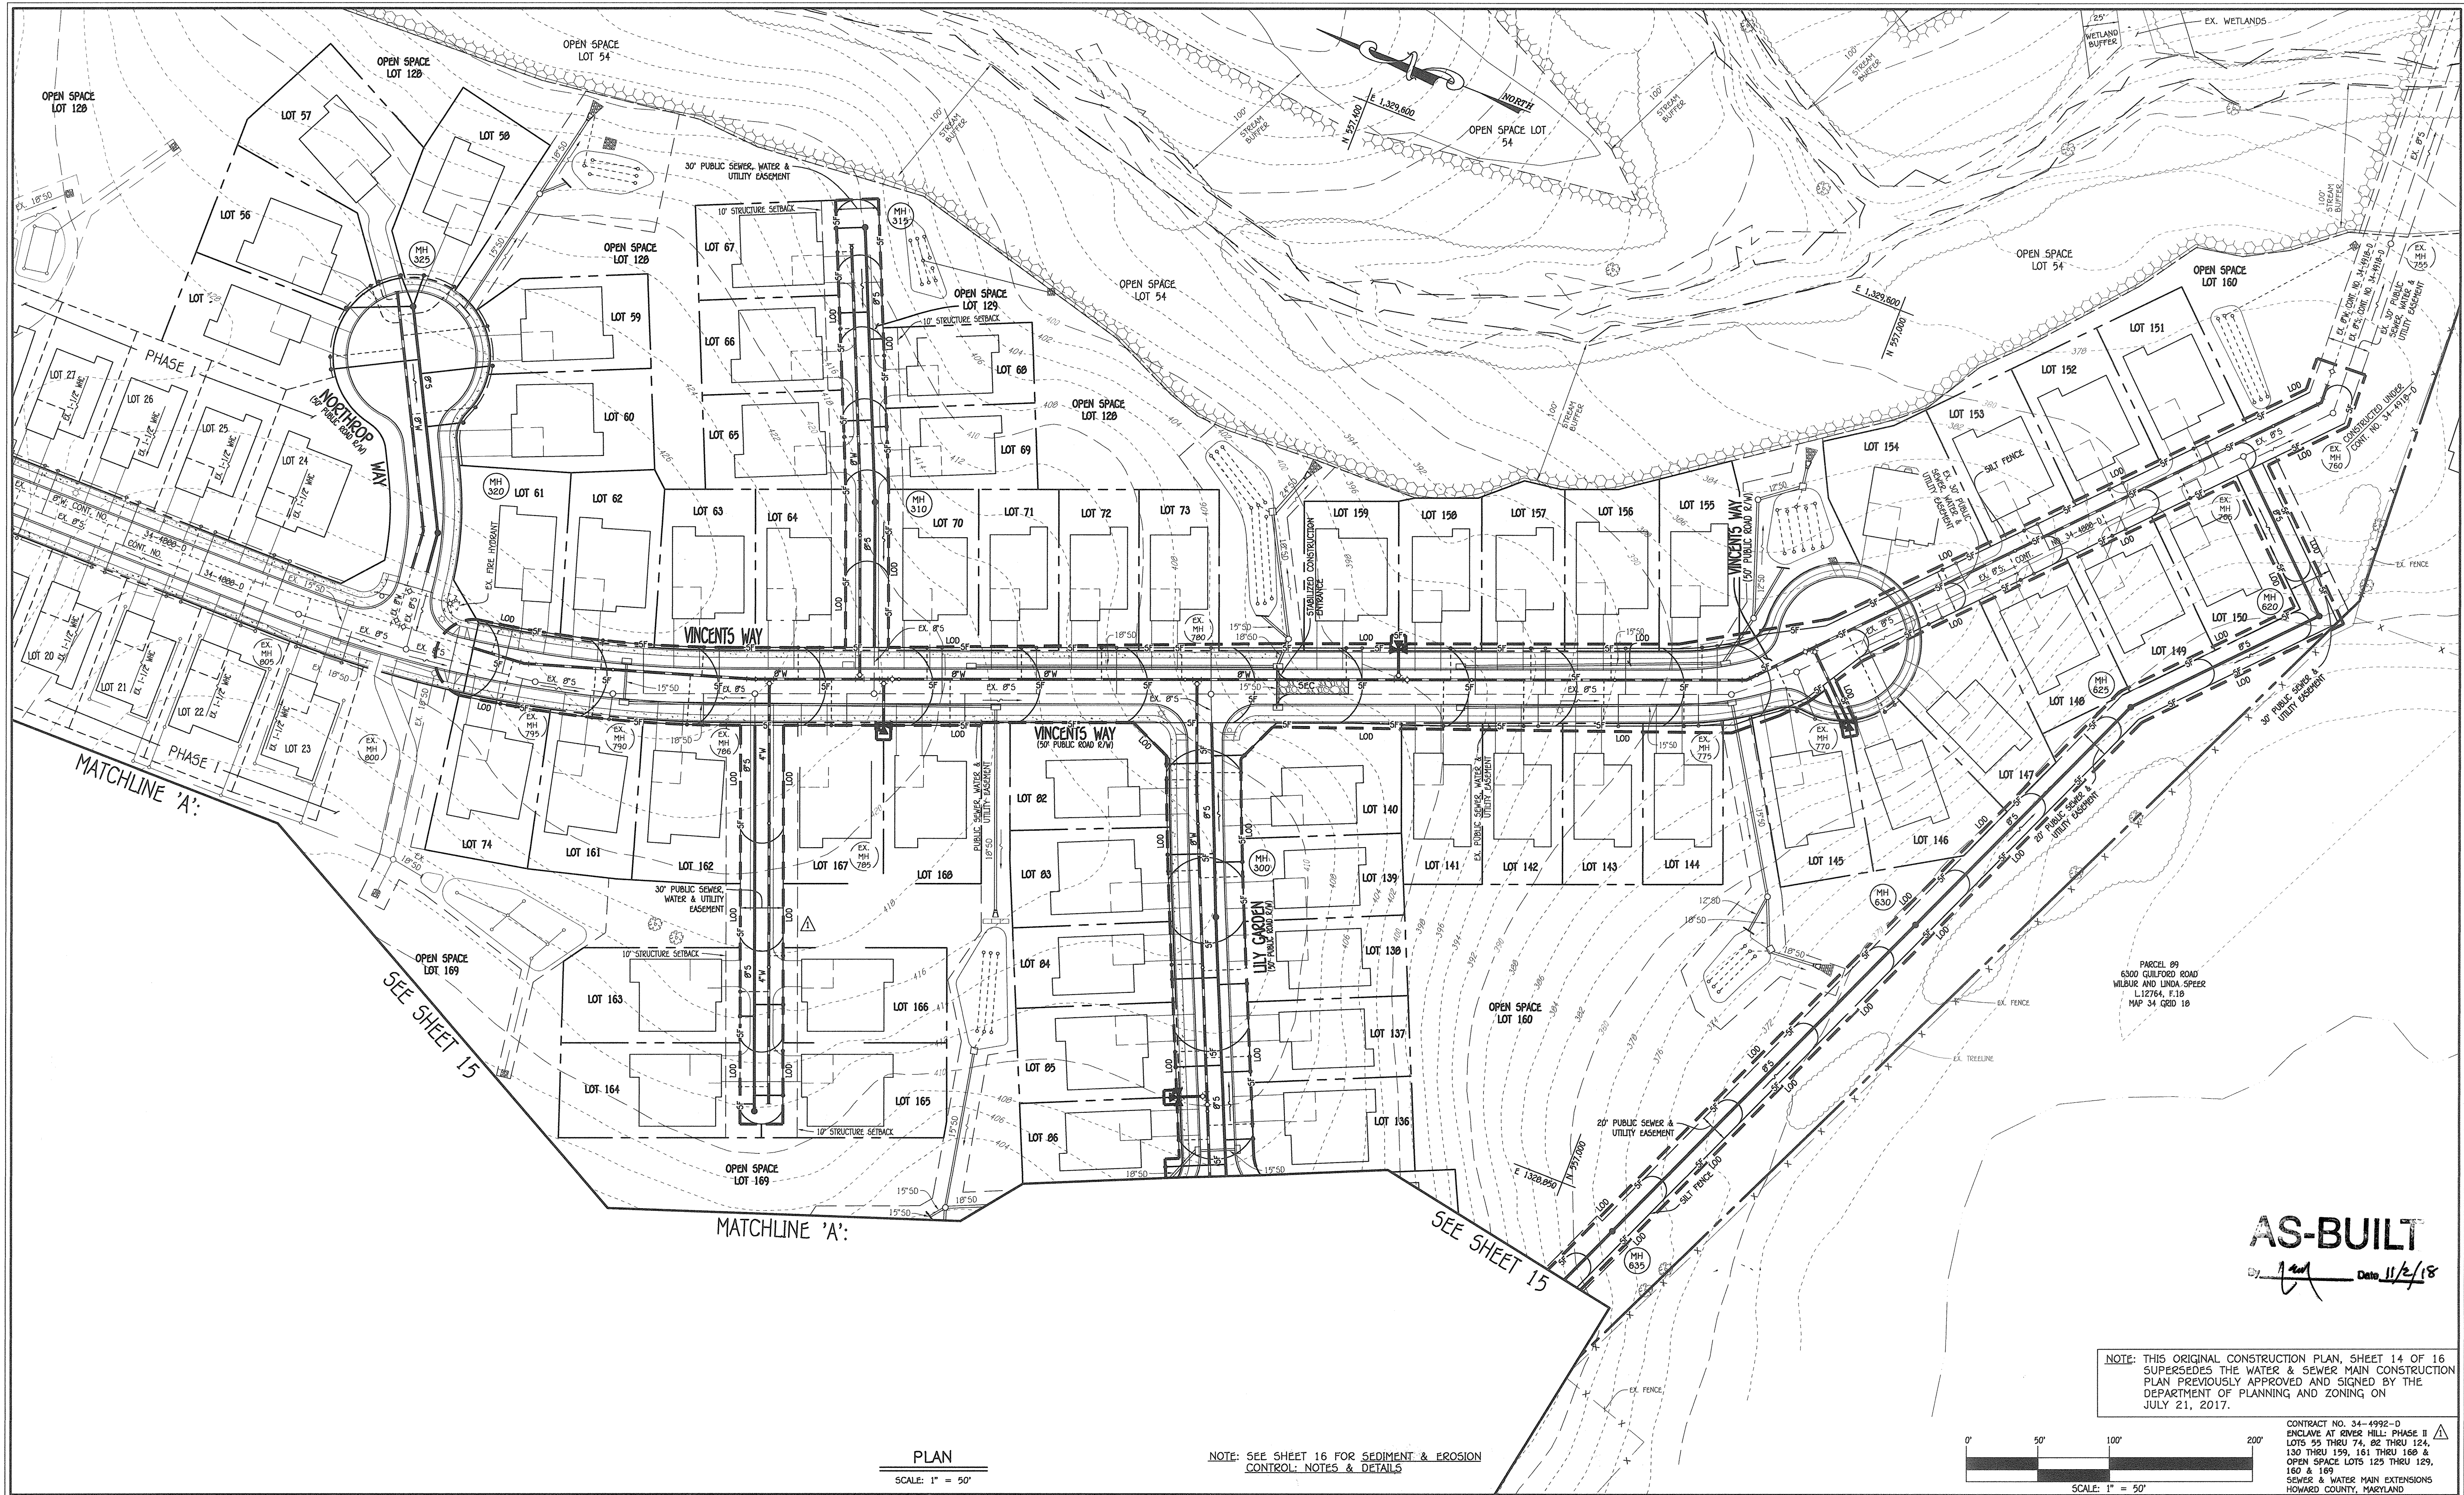

AS-BUILT

1/11/18 Date 11/2/18

NOTE: THIS ORIGINAL CONSTRUCTION PLAN, SHEET 14 OF 16 SUPERSEDES THE WATER & SEWER MAIN CONSTRUCTION PLAN PREVIOUSLY APPROVED AND SIGNED BY THE DEPARTMENT OF PLANNING AND ZONING ON JULY 21, 2017.

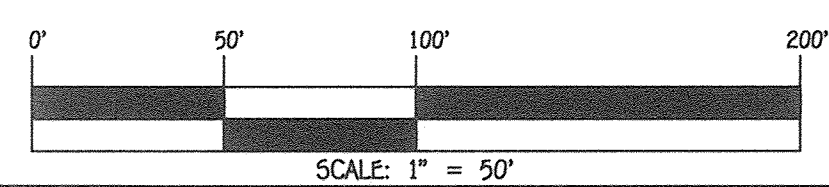

CONTRACT NO. 34-4992-D
ENCLAVE AT RIVER HILL: PHASE II
LOTS 55 THRU 74, 82 THRU 124,
130 THRU 159, 161 THRU 168 &
OPEN SPACE LOTS 125 THRU 129,
150 & 169
SEWER & WATER MAIN EXTENSIONS
HOWARD COUNTY, MARYLAND

PLAN
SCALE: 1" = 50'


NOTE: SEE SHEET 16 FOR SEDIMENT & EROSION CONTROL NOTES & DETAILS

DEPARTMENT OF PUBLIC WORKS
HOWARD COUNTY, MARYLAND

DEPARTMENT OF PLANNING AND ZONING
HOWARD COUNTY, MARYLAND

I HEREBY CERTIFY THAT THESE DOCUMENTS WERE PREPARED OR APPROVED BY ME, AND THAT I AM A DULY LICENSED PROFESSIONAL ENGINEER UNDER THE LAWS OF THE STATE OF MARYLAND.
LICENSE NO. 12043 EXPIRATION DATE IS 7/18/18.

FISHER, COLLINS & CARTER, INC.
CIVIL ENGINEERING CONSULTANTS & LAND SURVEYORS
CENTRAL SQUARE OFFICE PARK - 10272 BALTIMORE NATIONAL PKWY
GILCOTT CITY, MARYLAND 21042
(410) 461-2295

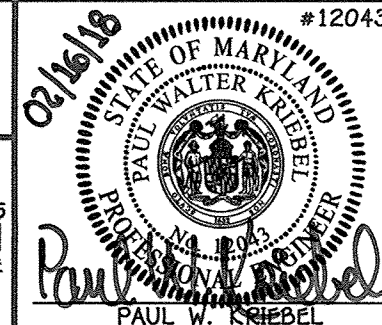

DESIGNED BY:	B.C.R.		
DRAWN BY:	B.C.R.		
CHECKED BY:	P.M.K.		
DATE:	FEBRUARY, 2018		
FCC BY:	NO.	REVISION	DATE
FCC	ADD SEDIMENT CONTROL AND L.O.D. TO LOTS 163 THRU 168		1-5-18
FCC	REVISE CONTRACT TITLE & PLAN TO REFLECT LOT NUMBER CHANGES		1-5-18

SEDIMENT & EROSION CONTROL PLAN

600' SCALE MAP NO. 34 BLOCK NO. 18
F.C.C. WORK ORDER NO. 13008-3001
FILE NAME: SEWER & WATER MAIN EXTENSION PLAN


ENCLAVE AT RIVER HILL: PHASE II
LOTS 55 THRU 74, 82 THRU 124, 130 THRU 159, 161 THRU 168 &
OPEN SPACE LOTS 125 THRU 129, 160 & 169
SEWER & WATER MAIN EXTENSIONS
CONTRACT NO. 34-4992-D
FIFTH ELECTION DISTRICT
HOWARD COUNTY, MARYLAND

SCALE AS SHOWN
SHEET 14 OF 16

I:\2013\13008\13008-3001\Water & Sewer\Contract\Water & Sewer\Contract\Plan\34-4992-D (Phase 2)\Scale 1" = 50' (Phase 2)\13008-3001 Water & Sewer Contract Plan.dwg, 2/16/2018 10:43 AM

NOTE: SEE SHEET 16 FOR SEDIMENT & EROSION CONTROL NOTES & DETAILS


NOTE: THIS ORIGINAL CONSTRUCTION PLAN, SHEET 15 OF 16 SUPERSEDES THE WATER & SEWER MAIN CONSTRUCTION PLAN PREVIOUSLY APPROVED AND SIGNED BY THE DEPARTMENT OF PLANNING AND ZONING ON JULY 21, 2017.

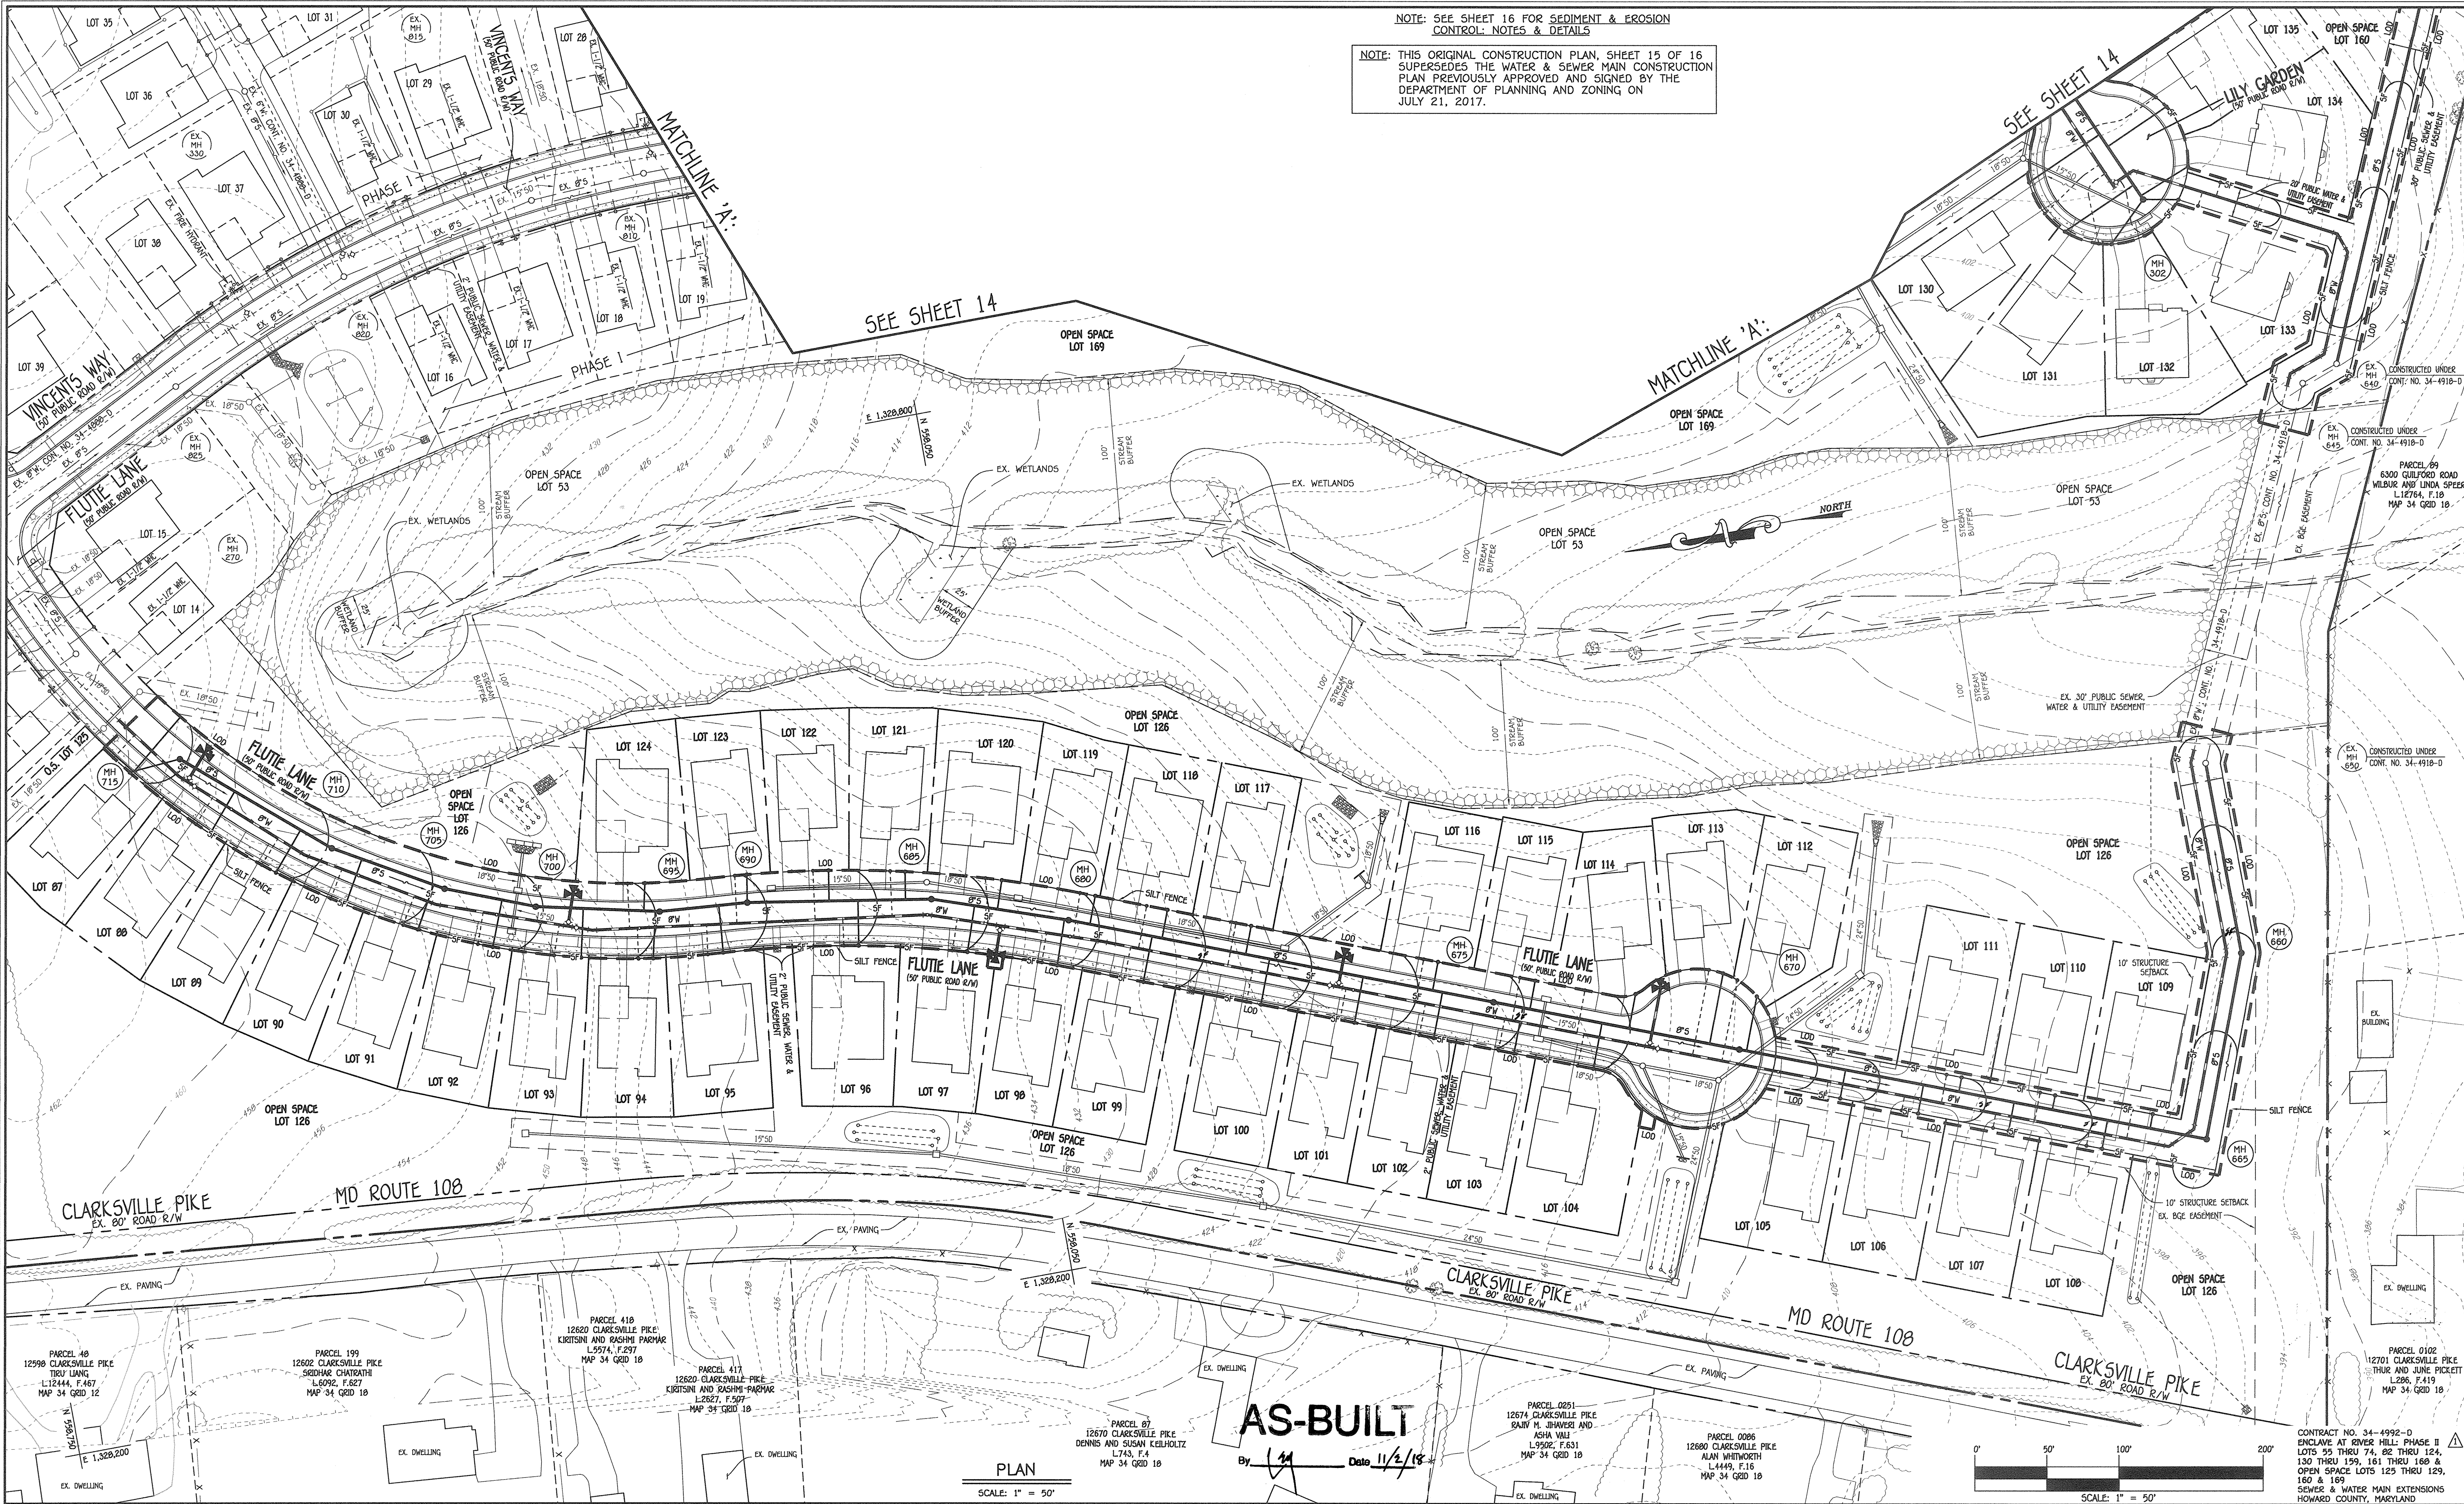

AS-BUILT

By *[Signature]* Date 11/2/18

SCALE: 1" = 50'

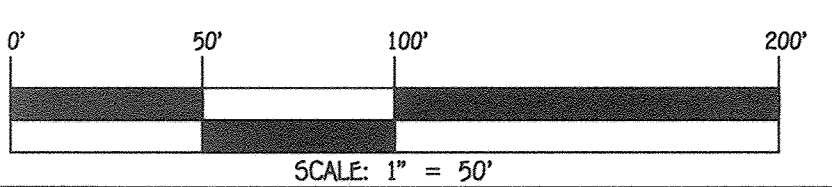

DEPARTMENT OF PUBLIC WORKS
HOWARD COUNTY, MARYLAND


[Signature]
CHIEF, BUREAU OF UTILITIES

DEPARTMENT OF PLANNING AND ZONING
HOWARD COUNTY, MARYLAND

[Signature]
CHIEF, DEVELOPMENT ENGINEERING DIVISION

I HEREBY CERTIFY THAT THESE DOCUMENTS WERE PREPARED OR APPROVED BY ME, AND THAT I AM A DULY LICENSED PROFESSIONAL ENGINEER UNDER THE LAWS OF THE STATE OF MARYLAND.
LICENSE NO. 12043 EXPIRATION DATE 8/7/18/18.

FISHER, COLLINS & CARTER, INC.
CIVIL ENGINEERING CONSULTANTS & LAND SURVEYORS
CENTENNIAL SQUARE OFFICE PARK - 10272 BALTIMORE NATIONAL PIKE
ELLIOTT CITY, MARYLAND 21142
(410) 461-2995

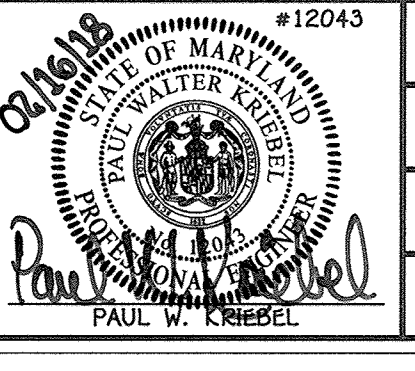

DESIGNED BY:	B.C.R.
DRAWN BY:	B.C.R.
CHECKED BY:	P.W.K.
DATE:	FEBRUARY, 2018
REVISION:	

SEDIMENT & EROSION CONTROL PLAN	
FCC	REVISE CONTRACT TITLE & PLAN TO REFLECT LOT NUMBER CHANGES
DATE:	1-5-18
FILE NAME:	SEWER & WATER MAIN EXTENSION PLAN

ENCLAVE AT RIVER HILL: PHASE II
LOTS 55 THRU 74, 82 THRU 124, 130 THRU 159, 161 THRU 168 &
OPEN SPACE LOTS 125 THRU 129, 160 & 169
SEWER & WATER MAIN EXTENSIONS
CONTRACT NO. 34-4992-D
FIFTH ELECTION DISTRICT
HOWARD COUNTY, MARYLAND

SCALE AS SHOWN
SHEET 15 OF 16

I:\2013\130008\Ang\Water & Sewer Contract\34-4992-D (Phase 2)\Redline #1 - December, 2017\130008-3001 Water & Sewer Contract Plan.dwg, 2/16/2018 11:02:39 AM

SOIL PREPARATION, TOPSOILING AND SOIL AMENDMENTS (B-4-2)

A. SOIL PREPARATION

1. TEMPORARY STABILIZATION
A. SEEDBED PREPARATION CONSISTS OF LOOSENING SOIL TO A DEPTH OF 3 TO 5 INCHES BY MEANS OF SUITABLE AGRICULTURE CONSTRUCTION EQUIPMENT...

2. PERMANENT STABILIZATION

A. A SOIL TEST IS REQUIRED FOR ANY EARTH DISTURBANCE OF 5 ACRES OR MORE. THE MINIMUM SOIL CONDITIONS REQUIRED FOR PERMANENT VEGETATIVE ESTABLISHMENT ARE:
I. SOIL PH BETWEEN 6.0 AND 7.0.
II. SOLUBLE SALTS LESS THAN 500 PARTS PER MILLION (PPM).

B. APPLICATION OF AMENDMENTS OR TOPSOIL IS REQUIRED IF ON-SITE SOILS DO NOT MEET THE ABOVE CONDITIONS.
C. GRADED AREAS MUST BE MAINTAINED IN A TRUE AND EVEN GRADE AS SPECIFIED ON THE APPROVED PLAN, THEN SCARIFIED OR OTHERWISE LOOSENEED TO A DEPTH OF 3 TO 5 INCHES.

E. MIX SOIL AMENDMENTS INTO THE TOP 3 TO 5 INCHES OF SOIL BY DISKING OR OTHER SUITABLE MEANS.
F. AREAS TO BE SALVAGED FROM AN EXISTING SITE MAY BE USED PROVIDED IT MEETS THE STANDARDS AS SET FORTH IN THESE SPECIFICATIONS...

B. TOPSOILING

1. TOPSOIL IS PLACED OVER PREPARED SUBSOIL PRIOR TO ESTABLISHMENT OF PERMANENT VEGETATION. THE PURPOSE IS TO PROVIDE A SUITABLE SOIL MEDIUM FOR VEGETATIVE GROWTH.
2. TOPSOIL SALVAGED FROM AN EXISTING SITE MAY BE USED PROVIDED IT MEETS THE STANDARDS AS SET FORTH IN THESE SPECIFICATIONS...

3. TOPSOILING IS LIMITED TO AREAS HAVING 2:1 OR FLATTER SLOPES WHERE: A. THE TEXTURE OF THE EXPOSED SUBSOIL/PARENT MATERIAL IS NOT ADEQUATE TO PRODUCE VEGETATIVE GROWTH.
4. AREAS HAVING SLOPES STEEPER THAN 2:1 REQUIRE SPECIAL CONSIDERATION AND DESIGN.

5. TOPSOIL SPECIFICATIONS: SOIL TO BE USED AS TOPSOIL MUST MEET THE FOLLOWING CRITERIA:
A. TOPSOIL MUST BE A LOAM, SANDY LOAM, CLAY LOAM, SILT LOAM, SANDY CLAY LOAM, OR LOAMY SAND. OTHER SOILS MAY BE USED IF RECOMMENDED BY AN AGRONOMIST OR SOIL SCIENTIST AND APPROVED BY THE APPROPRIATE APPROVAL AUTHORITY.

B. TOPSOIL MUST BE FREE OF NOXIOUS PLANTS OR PLANT PARTS SUCH AS BERMUDA GRASS, QUACK GRASS, JOHNSON GRASS, NUT SEDGE, POISON IVY, THISTLE, OR OTHERS AS SPECIFIED.
C. TOPSOIL SUBSTITUTES OR AMENDMENTS, AS RECOMMENDED BY A QUALIFIED AGRONOMIST OR SOIL SCIENTIST AND APPROVED BY THE APPROPRIATE APPROVAL AUTHORITY, MAY BE USED IN LIEU OF NATURAL TOPSOIL.

6. TOPSOIL APPLICATION
A. EROSION AND SEDIMENT CONTROL PRACTICES MUST BE MAINTAINED WHEN APPLYING TOPSOIL.
B. UNIFORMLY DISTRIBUTE TOPSOIL IN A 5 TO 8 INCH LAYER AND LIGHTLY COMPACT TO A MINIMUM THICKNESS OF 4 INCHES. SPREADING IS TO BE PERFORMED IN SUCH A MANNER THAT SOODING OR SEEDING CAN PROCEED WITH A MINIMUM OF ADDITIONAL SOIL PREPARATION AND TILLAGE.

C. TOPSOIL MUST NOT BE PLACED IF THE TOPSOIL OR SUBSOIL IS IN A FROZEN OR MUDDY CONDITION, WHEN THE SUBSOIL IS EXCESSIVELY WET OR IN A CONDITION THAT MAY OTHERWISE BE DETRIMENTAL TO PROPER GRADING AND SEEDBED PREPARATION.

C. SOIL AMENDMENTS (FERTILIZER AND LIME SPECIFICATIONS)
1. SOIL TESTS MUST BE PERFORMED TO DETERMINE THE EXACT RATIOS AND APPLICATION RATES FOR BOTH LIME AND FERTILIZER ON DISTURBED AREAS OF 5 ACRES OR MORE...

2. FERTILIZERS MUST BE UNIFORM IN COMPOSITION, FREE FLOWING AND SUITABLE FOR ACCURATE APPLICATION BY APPROPRIATE EQUIPMENT. MANURE MAY BE SUBSTITUTED FOR FERTILIZER WITH PRIOR APPROVAL FROM THE APPROPRIATE APPROVAL AUTHORITY.
3. LIME MATERIALS MUST BE GROUND LIMESTONE (HYDRATED OR BURNT LIME MAY BE SUBSTITUTED EXCEPT WHEN HYDROSEEDING) WHICH CONTAINS AT LEAST 50 PERCENT TOTAL OXIDES (CALCIUM OXIDE PLUS MAGNESIUM OXIDE). LIMESTONE MUST BE GROUND TO SUCH FINENESS THAT AT LEAST 50 PERCENT WILL PASS THROUGH A #100 MESH SIEVE AND 98 TO 100 PERCENT WILL PASS THROUGH A #20 MESH SIEVE.

4. LIME AND FERTILIZER ARE TO BE EVENLY DISTRIBUTED AND INCORPORATED INTO THE TOP 3 TO 5 INCHES OF SOIL BY DISKING OR OTHER SUITABLE MEANS.
5. WHERE THE SUBSOIL IS EITHER HIGHLY ACIDIC OR COMPOSED OF HEAVY CLAYS, SPREAD GROUND LIMESTONE AT THE RATE OF 4 TO 8 TONS/ACRE (200-400 POUNDS PER 1,000 SQUARE FEET) PRIOR TO THE PLACEMENT OF TOPSOIL.

STANDARD STABILIZATION NOTE
FOLLOWING INITIAL SOIL DISTURBANCE OR RE-DISTURBANCE, PERMANENT OR TEMPORARY STABILIZATION MUST BE COMPLETED WITHIN:
A.) THREE (3) CALENDAR DAYS AS TO THE SURFACE OF ALL PERIMETER DIKES, SWALES, DITCHES, PERIMETER SLOPES, AND ALL SLOPES STEEPER THAN 3:1 HORIZONTAL TO 1 VERTICAL (3:1); AND
B.) SEVEN (7) CALENDAR DAYS AS TO ALL OTHER DISTURBED OR GRADED AREAS ON THE PROJECT SITE NOT UNDER ACTIVE GRADING.

PERMANENT SEEDING NOTES (B-4-5)

A. SEED MIXTURES
1. GENERAL USE
A. SELECT ONE OR MORE OF THE SPECIES OR MIXTURES LISTED IN TABLE B.3 FOR THE APPROPRIATE PLANT HARDINESS ZONE (FROM FIGURE B.3) AND BASED ON THE SITE CONDITION OR PURPOSE...

2. TURFGRASS MIXTURES
A. AREAS WHERE TURFGRASS MAY BE DESIRED INCLUDE LAWNS, PARKS, PLAYGROUNDS, AND COMMERCIAL SITES WHICH WILL RECEIVE A MEDIUM TO HIGH LEVEL OF MAINTENANCE.
B. SELECT ONE OR MORE OF THE SPECIES OR MIXTURES LISTED BELOW BASED ON THE SITE CONDITIONS OR PURPOSE...

3. TALL FESCUE/KENTUCKY BLUEGRASS
FULL SUN MIXTURE: FOR USE IN DROUGHT PRONE AREAS AND/OR FOR AREAS RECEIVING LOW TO MEDIUM MANAGEMENT IN FULL SUN TO MEDIUM SHADE.
4. KENTUCKY BLUEGRASS/FESCUE
SHADE MIXTURE: FOR USE IN AREAS WITH SHADE IN BLUEGRASS LAWNS.

NOTES:
SELECT TURFGRASS VARIETIES FROM THOSE LISTED IN THE MOST CURRENT UNIVERSITY OF MARYLAND PUBLICATION, AGRONOMY MEMO #77, "TURFGRASS CULTIVAR RECOMMENDATIONS FOR MARYLAND"

C. IDEAL TIMES OF SEEDING FOR TURF GRASS MIXTURES WESTERN MD: MARCH 15 TO JUNE 1, AUGUST 1 TO OCTOBER 1 (HARDINESS ZONES: 5B, 6A) CENTRAL MD: MARCH 1 TO MAY 15, AUGUST 15 TO OCTOBER 15 (HARDINESS ZONES: 6B) SOUTHERN MD, EASTERN SHORE: MARCH 1 TO MAY 15, AUGUST 15 TO OCTOBER 15 (HARDINESS ZONES: 7A, 7B)

D. TILL AREAS TO RECEIVE SEED BY DISKING OR OTHER APPROVED METHODS TO A DEPTH OF 2 TO 4 INCHES, LEVEL AND RAKE THE AREAS TO PREPARE A PROPER SEEDBED. REMOVE STONES AND DEBRIS OVER 1 1/2 INCHES IN DIAMETER. THE RESULTING SEEDBED MUST BE IN SUCH CONDITION THAT FUTURE MOWING OF GRASSES WILL POSE NO DIFFICULTY.

E. IF SOIL MOISTURE IS DEFICIENT, SUPPLY NEW SEEDINGS WITH ADEQUATE WATER FOR PLANT GROWTH (1 1/2 TO 1 INCH EVERY 3 TO 4 DAYS DEPENDING ON SOIL TEXTURE) UNTIL THEY ARE FIRMLY ESTABLISHED. THIS IS ESPECIALLY TRUE WHEN SEEDINGS ARE MADE LATE IN THE PLANTING SEASON, IN ABNORMALLY DRY OR HOT SEASONS, OR ON ADVERSE SITES.

PERMANENT SEEDING SUMMARY
Hardness Zone (from Figure B.3): 6b
Seed Mixture (from Table B.3): B
Fertilizer Rate (10-20-20): 2 tons/ac (90 lb/1000 sf)

Table with 4 columns: No., Species, Application Rate (lb/ac), Seeding Dates, Seeding Depths, N, P2O5, K2O, Lime Rate. Row 1: B, TALL FESCUE, 100, Mar. 1-May 15 / Aug. 15-Oct. 15, 1 1/2-1/4 in., 45 lbs. per acre (1000 sf), 90 lb/ac (2 lb/1000 sf), 90 lb/ac (2 lb/1000 sf), 2 tons/ac (90 lb/1000 sf)

Table with 4 columns: No., Species, Application Rate (lb/ac), Seeding Dates, Seeding Depths, N, P2O5, K2O, Lime Rate. Row 1: B, TALL FESCUE, 100, Mar. 1-May 15 / Aug. 15-Oct. 15, 1 1/2-1/4 in., 45 lbs. per acre (1000 sf), 90 lb/ac (2 lb/1000 sf), 90 lb/ac (2 lb/1000 sf), 2 tons/ac (90 lb/1000 sf)

B-4-8 STANDARDS AND SPECIFICATIONS FOR STOCKPILE AREA

DEFINITION
A MOUND OR PILE OF SOIL PROTECTED BY APPROPRIATELY DESIGNED EROSION AND SEDIMENT CONTROL MEASURES.
PURPOSE
TO PROVIDE A DESIGNATED LOCATION FOR THE TEMPORARY STORAGE OF SOIL THAT CONTROLS THE POTENTIAL FOR EROSION, SEDIMENTATION, AND CHANGES TO DRAINAGE PATTERNS.

CRITERIA
1. THE STOCKPILE LOCATION AND ALL RELATED SEDIMENT CONTROL PRACTICES MUST BE CLEARLY INDICATED ON THE EROSION AND SEDIMENT CONTROL PLAN.
2. THE FOOTPRINT OF THE STOCKPILE MUST BE SIZED TO ACCOMMODATE THE ANTICIPATED VOLUME OF MATERIAL AND BASED ON A SIDE SLOPE RATIO NO STEEPER THAN 2:1. BENCHING MUST BE PROVIDED IN ACCORDANCE WITH SECTION B-3 LAND GRADING.

MAINTENANCE
THE STOCKPILE AREA MUST CONTINUOUSLY MEET THE REQUIREMENTS FOR ADEQUATE VEGETATIVE ESTABLISHMENT IN ACCORDANCE WITH SECTION B-4 VEGETATIVE STABILIZATION. SIDE SLOPES MUST BE MAINTAINED AT NO STEEPER THAN A 2:1 RATIO. THE STOCKPILE AREA MUST BE KEPT FREE OF EROSION. IF THE VERTICAL HEIGHT OF A STOCKPILE EXCEEDS 20 FEET FOR 2:1 SLOPES, 30 FEET FOR 3:1 SLOPES, OR 40 FEET FOR 4:1 SLOPES, BENCHING MUST BE PROVIDED IN ACCORDANCE WITH SECTION B-3 LAND GRADING.

TEMPORARY SEEDING NOTES (B-4-4)

DEFINITION
TO STABILIZE DISTURBED SOILS WITH VEGETATION FOR UP TO 6 MONTHS.
PURPOSE
TO USE FAST GROWING VEGETATION THAT PROVIDES COVER ON DISTURBED SOILS.
CONDITIONS WHERE PRACTICE APPLIES
EXPOSED SOILS WHERE GROUND COVER IS NEEDED FOR A PERIOD OF 6 MONTHS OR LESS. FOR LONGER DURATION OF TIME, PERMANENT STABILIZATION PRACTICES ARE REQUIRED.

CRITERIA
1. SELECT ONE OR MORE OF THE SPECIES OR SEED MIXTURES LISTED IN TABLE B.1 FOR THE APPROPRIATE PLANT HARDINESS ZONE (FROM FIGURE B.3), AND ENTER THEM IN THE TEMPORARY SEEDING SUMMARY BELOW ALONG WITH APPLICATION RATES, SEEDING DATES AND SEEDING DEPTHS. IF THIS SUMMARY IS NOT PUT ON THE PLAN AND COMPLETED, THEN TABLE B.1 PLUS FERTILIZER AND LIME RATES MUST BE PUT ON THE PLAN.

2. FOR SITES HAVING SOIL TESTS PERFORMED, USE AND SHOW THE RECOMMENDED RATES BY THE TESTING AGENCY. SOIL TESTS ARE NOT REQUIRED FOR TEMPORARY SEEDING.
3. WHEN STABILIZATION IS REQUIRED OUTSIDE OF A SEEDING SEASON, APPLY SEED AND MULCH OR STRAW MULCH ALONE AS PRESCRIBED IN SECTION B-4-3A.1.B AND MAINTAIN UNTIL THE NEXT SEEDING SEASON.

Temporary Seeding Summary table with columns: Hardness Zone, Fertilizer Rate, Lime Rate, Species, Application Rate, Seeding Dates, Seeding Depths. Rows for BARLEY, OATS, RYE.

HOWARD SOIL CONSERVATION DISTRICT (HSCD) STANDARD SEDIMENT CONTROL NOTES

1. A PRE-CONSTRUCTION MEETING MUST OCCUR WITH THE HOWARD COUNTY DEPARTMENT OF PUBLIC WORKS, CONSTRUCTION INSPECTION DIVISION (CID), 410-313-1895 AFTER THE FUTURE LOD AND PROTECTED AREAS ARE MARKED CLEARLY IN THE FIELD. A MINIMUM OF 48 HOUR NOTICE TO CID MUST BE GIVEN AT THE FOLLOWING STAGES:
A. PRIOR TO THE START OF EARTH DISTURBANCE.
B. UPON COMPLETION OF THE INSTALLATION OF PERIMETER EROSION AND SEDIMENT CONTROLS, BUT BEFORE PROCEEDING WITH ANY OTHER EARTH DISTURBANCE OR GRADING.

2. ALL VEGETATIVE AND STRUCTURAL PRACTICES ARE TO BE INSTALLED ACCORDING TO THE PROVISIONS OF THIS PLAN AND ARE TO BE IN CONFORMANCE WITH THE 2011 MARYLAND STANDARDS AND SPECIFICATIONS FOR SOIL EROSION AND SEDIMENT CONTROL, AND REVISIONS THERETO.
3. FOLLOWING INITIAL SOIL DISTURBANCE OR RE-DISTURBANCE, PERMANENT OR TEMPORARY STABILIZATION IS REQUIRED WITHIN THREE (3) CALENDAR DAYS AS TO THE SURFACE OF ALL PERIMETER CONTROL, DIKES, SWALES, DITCHES, PERIMETER SLOPES, AND ALL SLOPES STEEPER THAN 1 VERTICAL (3:1) AND SEVEN (7) CALENDAR DAYS AS TO ALL OTHER DISTURBED AREAS ON THE PROJECT SITE EXCEPT THOSE AREAS UNDER ACTIVE GRADING.

4. ALL DISTURBED AREAS MUST BE STABILIZED WITHIN THE TIME PERIOD SPECIFIED ABOVE IN ACCORDANCE WITH THE 2011 MARYLAND STANDARDS AND SPECIFICATIONS FOR SOIL EROSION AND SEDIMENT CONTROL FOR TOPSOIL (SEC. B-4-2), PERMANENT SEEDING (SEC. B-4-5), TEMPORARY SEEDING (SEC. B-4-4) AND MULCHING (SEC. B-4-3).
5. TEMPORARY STABILIZATION WITH MULCH ALONE CAN ONLY BE APPLIED BETWEEN THE FALL AND SPRING SEEDING DATES IF THE GROUND IS FROZEN, INCREMENTAL STABILIZATION (SEC. B-4-1) SPECIFICATIONS SHALL BE ENFORCED IN AREAS WITH 3:1 OF CUT AND/OR FILL STOCKPILES (SEC. B-4-8) IN EXCESS OF 20 FT. MUST BE BENCHING WITH STABLE OUTLET. ALL CONCENTRATED FLOW, STEEP SLOPE, AND HIGHLY ERODIBLE AREAS SHALL RECEIVE SOIL STABILIZATION MATING (SEC. B-4-6).

6. SITE ANALYSIS
TOTAL AREA OF SITE: 88,960 ACRES
AREA DISTURBED: 4,100 ACRES
AREA TO BE ROOFED OR PAVED: 2,990 ACRES
AREA TO BE VEGETATIVELY STABILIZED: 1,210 ACRES
TOTAL CUT: 0 CU. YDS.
TOTAL FILL: 0 CU. YDS.
OFFSITE WASTE/ROOFWATER AREA LOCATION: N/A

7. ANY SEDIMENT CONTROL PRACTICE WHICH IS DISTURBED BY GRADING ACTIVITY FOR PLACEMENT OF UTILITIES MUST BE REPAIRED ON THE SAME DAY OF DISTURBANCE.
8. ADDITIONAL SEDIMENT CONTROL MUST BE PROVIDED, IF DEEMED NECESSARY BY THE CID. THE SITE AND ALL CONTROLS SHALL BE INSPECTED BY THE CONTRACTOR WEEKLY, AND THE NEXT DAY AFTER EACH RAIN EVENT. A WRITTEN REPORT BY THE CONTRACTOR, MADE AVAILABLE UPON REQUEST, IS PART OF EVERY INSPECTION AND SHOULD INCLUDE:

- INSPECTION DATE
INSPECTION TYPE (ROUTINE, PRE-STORM EVENT, DURING RAIN EVENT)
NAME AND TITLE OF INSPECTOR
WEATHER INFORMATION (CURRENT CONDITIONS AS WELL AS TIME AND AMOUNT OF LAST RECORDED PRECIPITATION)
BRIEF DESCRIPTION OF PROJECT'S STATUS (E.G., PERCENT COMPLETE) AND/OR CURRENT ACTIVITIES
EVIDENCE OF SEDIMENT DISCHARGES
IDENTIFICATION OF PLAN DEFICIENCIES
IDENTIFICATION OF SEDIMENT CONTROLS THAT REQUIRE MAINTENANCE
IDENTIFICATION OF MISSING OR IMPROPERLY INSTALLED SEDIMENT CONTROLS
COMPLIANCE STATUS REGARDING THE SEQUENCE OF CONSTRUCTION AND STABILIZATION REQUIREMENTS
PHOTOGRAPHS
MONITORING/SAMPLING
MAINTENANCE AND/OR CORRECTIVE ACTION PERFORMED
OTHER INSPECTION ITEMS AS REQUIRED BY THE GENERAL PERMIT FOR STORMWATER ASSOCIATED WITH CONSTRUCTION
ACTIVITIES (NPDES, MDS)


9. TRENCHES FOR THE CONSTRUCTION OF UTILITIES IS LIMITED TO THREE PIPE LENGTHS OR THAT WHICH CAN AND SHALL BE BACK-FILLED AND STABILIZED BY THE END OF EACH WORKDAY, WHICHEVER IS SHORTER.
10. ANY MAJOR CHANGES OR REVISIONS TO THE PLAN OR SEQUENCE OF CONSTRUCTION MUST BE REVIEWED AND APPROVED BY THE HSCD PRIOR TO PROCEEDING WITH CONSTRUCTION. MINOR REVISIONS MAY BE ALLOWED BY THE CID PER THE LIST OF HSCD-APPROVED FIELD CHANGES.

11. DISTURBANCE SHALL NOT OCCUR OUTSIDE THE LOD. A PROJECT IS TO BE SEQUENCED SO THAT GRADING ACTIVITIES BEGIN ON ONE GRADING UNIT (MAXIMUM ACREAGE OF 20 AC. PER GRADING UNIT) AT A TIME. WORK MAY PROCEED TO A SUBSEQUENT GRADING UNIT WHEN AT LEAST 50 PERCENT OF THE DISTURBED AREA IN THE PRECEDING GRADING UNIT HAS BEEN STABILIZED AND APPROVED BY THE CID, UNLESS OTHERWISE SPECIFIED AND APPROVED BY THE CID, NO MORE THAN 30 ACRES CUMULATIVELY MAY BE DISTURBED AT A GIVEN TIME.
12. WASH WATER FROM ANY EQUIPMENT, VEHICLES, WHEELS, PAVEMENT, AND OTHER SOURCES MUST BE TREATED IN A SEDIMENT BASIN OR OTHER APPROVED WASHOUT STRUCTURE.

13. TOPSOIL SHALL BE STOCKPILED AND PRESERVED ON-SITE FOR REDISTRIBUTION ONTO FINAL GRADE.
14. ALL SILT FENCE AND SUPER SILT FENCE SHALL BE PLACED ON-THE-CONTOUR, AND BE IMBERGATED AT 25' MINIMUM INTERVALS, WITH LOWER ENDS CURLED UPHILL BY 2' IN ELEVATION.
15. STREAM CHANNELS MUST NOT BE DISTURBED DURING THE FOLLOWING RESTRICTED TIME PERIODS (INCLUDES):
• USE I AND II: MARCH 1 - JUNE 15
• USE III AND IIII: OCTOBER 1 - APRIL 30
• USE IV: MARCH 1 - MAY 31

16. A COPY OF THIS PLAN, THE 2011 MARYLAND STANDARDS AND SPECIFICATIONS FOR SOIL EROSION AND SEDIMENT CONTROL, AND ASSOCIATED PERMITS SHALL BE ON-SITE AND AVAILABLE WHEN THE SITE IS ACTIVE.

DETAIL B-1 STABILIZED CONSTRUCTION ENTRANCE

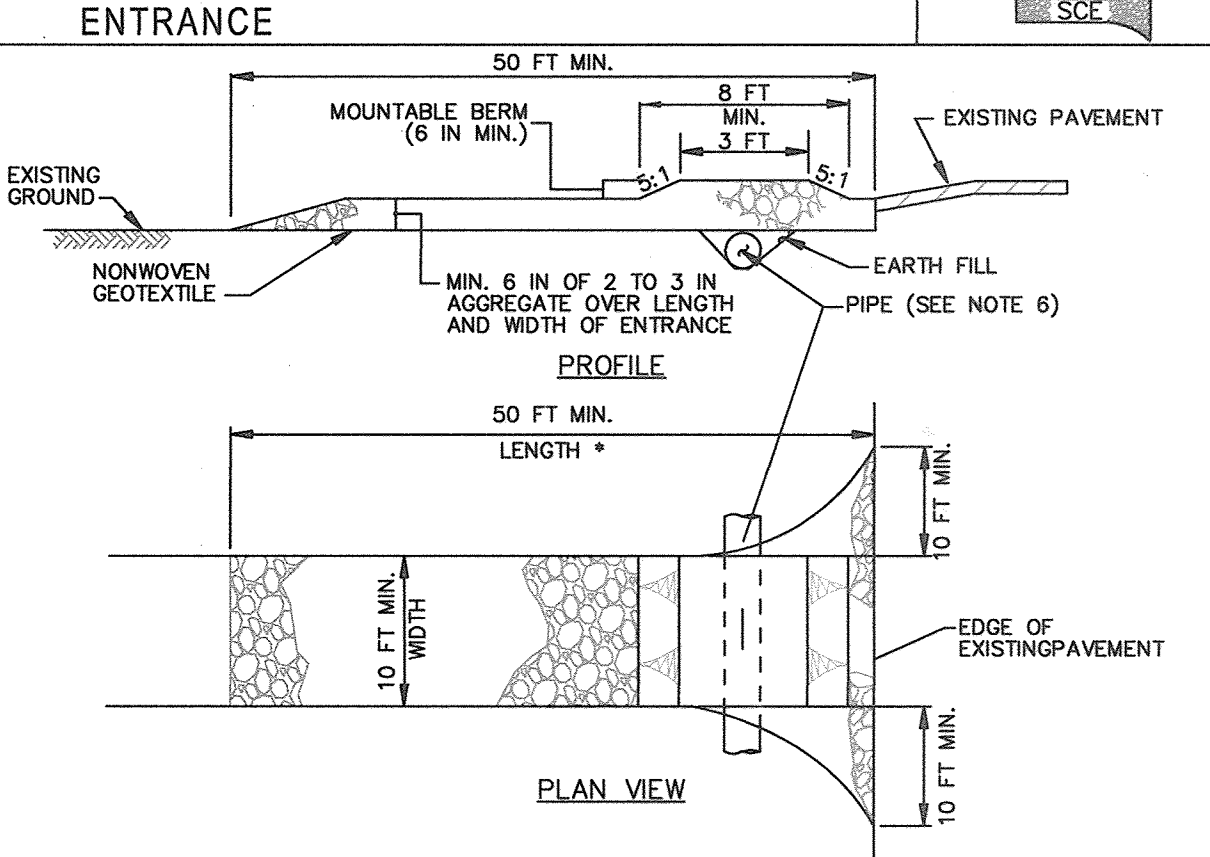

CONSTRUCTION SPECIFICATIONS
1. PLACE STABILIZED CONSTRUCTION ENTRANCE IN ACCORDANCE WITH THE APPROVED PLAN. VEHICLES MUST TRAVEL OVER THE ENTIRE LENGTH OF THE SCE. USE MINIMUM LENGTH OF 50 FEET (*30 FEET FOR SINGLE RESIDENCE LOT). USE MINIMUM WIDTH OF 10 FEET. FLARE SCE 10 FEET MINIMUM AT THE EXISTING ROAD TO PROVIDE A TURNING RADIUS.
2. PIPE ALL SURFACE WATER FLOWING TO OR DIVERTED TOWARD THE SCE UNDER THE ENTRANCE, MAINTAINING POSITIVE DRAINAGE. PROTECT PIPE INSTALLED THROUGH THE SCE WITH A MOUNTABLE BERM WITH 5:1 SLOPES AND A MINIMUM OF 12 INCHES OF STONE OVER THE PIPE. PROVIDE PIPE AS SPECIFIED ON APPROVED PLAN. WHEN THE SCE IS LOCATED AT A HIGH SPOT AND HAS NO DRAINAGE TO CONVEY, A PIPE IS NOT NECESSARY. A MOUNTABLE BERM IS REQUIRED WHEN SCE IS NOT LOCATED AT A HIGH SPOT.

3. PREPARE SUBGRADE AND PLACE NONWOVEN GEOTEXTILE, AS SPECIFIED IN SECTION H-1 MATERIALS.
4. PLACE CRUSHED AGGREGATE (2 TO 3 INCHES IN SIZE) OR EQUIVALENT RECYCLED CONCRETE (WITHOUT REBAR) AT LEAST 6 INCHES DEEP OVER THE LENGTH AND WIDTH OF THE SCE.
5. MAINTAIN ENTRANCE IN A CONDITION THAT MINIMIZES TRACKING OF SEDIMENT, ADD STONE OR MAKE OTHER REPAIRS AS CONDITIONS DEMAND TO MAINTAIN CLEAN SURFACE, MOUNTABLE BERM, AND SPECIFIED DIMENSIONS. IMMEDIATELY REMOVE STONE AND/OR SEDIMENT SPILLED, DROPPED, OR TRACKED ONTO ADJACENT ROADWAY BY VACUUMING, SCRAPPING, AND/OR SWEEPING. WASHING ROADWAY TO REMOVE MUD TRACKED ONTO PAVEMENT IS NOT ACCEPTABLE UNLESS WASH WATER IS DIRECTED TO AN APPROVED SEDIMENT CONTROL PRACTICE.

MARYLAND STANDARDS AND SPECIFICATIONS FOR SOIL EROSION AND SEDIMENT CONTROL
U.S. DEPARTMENT OF AGRICULTURE NATURAL RESOURCES CONSERVATION SERVICE 2011 MARYLAND DEPARTMENT OF ENVIRONMENT WATER MANAGEMENT ADMINISTRATION

ENGINEER'S CERTIFICATION
I HEREBY CERTIFY THAT THIS PLAN FOR EROSION AND SEDIMENT CONTROL REPRESENTS A PRACTICAL AND WORKABLE PLAN BASED ON MY PERSONAL KNOWLEDGE OF THE SITE CONDITIONS AND THAT IT WAS PREPARED IN ACCORDANCE WITH THE REQUIREMENTS OF THE HOWARD SOIL CONSERVATION DISTRICT.


Paul W. Keibel 06/30/17
SIGNATURE OF ENGINEER DATE

DEVELOPER'S CERTIFICATION
I/WE HEREBY CERTIFY THAT ALL DEVELOPMENT AND CONSTRUCTION WILL BE DONE ACCORDING TO THIS PLAN OF DEVELOPMENT AND PLAN FOR EROSION AND SEDIMENT CONTROL, AND THAT ALL RESPONSIBLE PERSONNEL INVOLVED IN THE CONSTRUCTION PROJECT WILL HAVE A CERTIFICATE OF ATTENDANCE AT A DEPARTMENT OF THE ENVIRONMENT APPROVED TRAINING PROGRAM FOR THE CONTROL OF SEDIMENT AND EROSION BEFORE BEGINNING THE PROJECT. I ALSO AUTHORIZE PERIODIC ON-SITE INSPECTION BY THE HOWARD SOIL CONSERVATION DISTRICT OR THEIR AUTHORIZED AGENTS, AS ARE DEEMED NECESSARY.

Paul W. Keibel 06-30-17
FOR: BEAZER HOMES, LLC SIGNATURE OF DEVELOPER DATE

SEQUENCE OF CONSTRUCTION
1. OBTAIN GRADING PERMIT. (10 DAYS)
2. NOTIFY "MISS UTILITY" AT 48 HOURS BEFORE BEGINNING ANY WORK AT 1-800-257-7777. NOTIFY THE HOWARD COUNTY OFFICE OF CONSTRUCTION/INSPECTION AT 410-313-1330 48 HOURS BEFORE STARTING WORK.
3. REQUEST FOR A PRE-CONSTRUCTION MEETING WITH THE APPROPRIATE ENFORCEMENT AUTHORITY. (3 DAYS)
4. INSTALL STABILIZED CONSTRUCTION ENTRANCE AND SEDIMENT CONTROLS AS INDICATED ON SHEETS 14 & 15. THE CONTRACTOR SHALL INSPECT AND PROVIDE THE NECESSARY MAINTENANCE ON ALL SEDIMENT CONTROL DEVICES/PRACTICES ON A DAILY BASIS AND IMMEDIATELY AFTER A RAINFALL. (5 DAYS)
5. CLEARING AND GRUBBING AS NECESSARY FOR THE INSTALLATION OF THE WATER & SEWER MAINS. (1 DAY)
6. INSTALL REMAINING PERIMETER CONTROL MEASURES AND INSTALL TEMPORARY SEEDING AS REQUIRED. (1 DAY)
7. CONSTRUCT WATER & SEWER MAINS AND CONNECTIONS. (8 WEEKS)
8. APPROVAL OF THE APPROPRIATE ENFORCEMENT AUTHORITY PRIOR TO REMOVAL OF SEDIMENT CONTROLS. (1 DAY)
9. REMOVAL OF CONTROLS AND STABILIZATION OF AREAS THAT ARE DISTURBED BY REMOVAL OF SEDIMENT CONTROLS. (2 DAYS)

DETAIL E-1 SILT FENCE

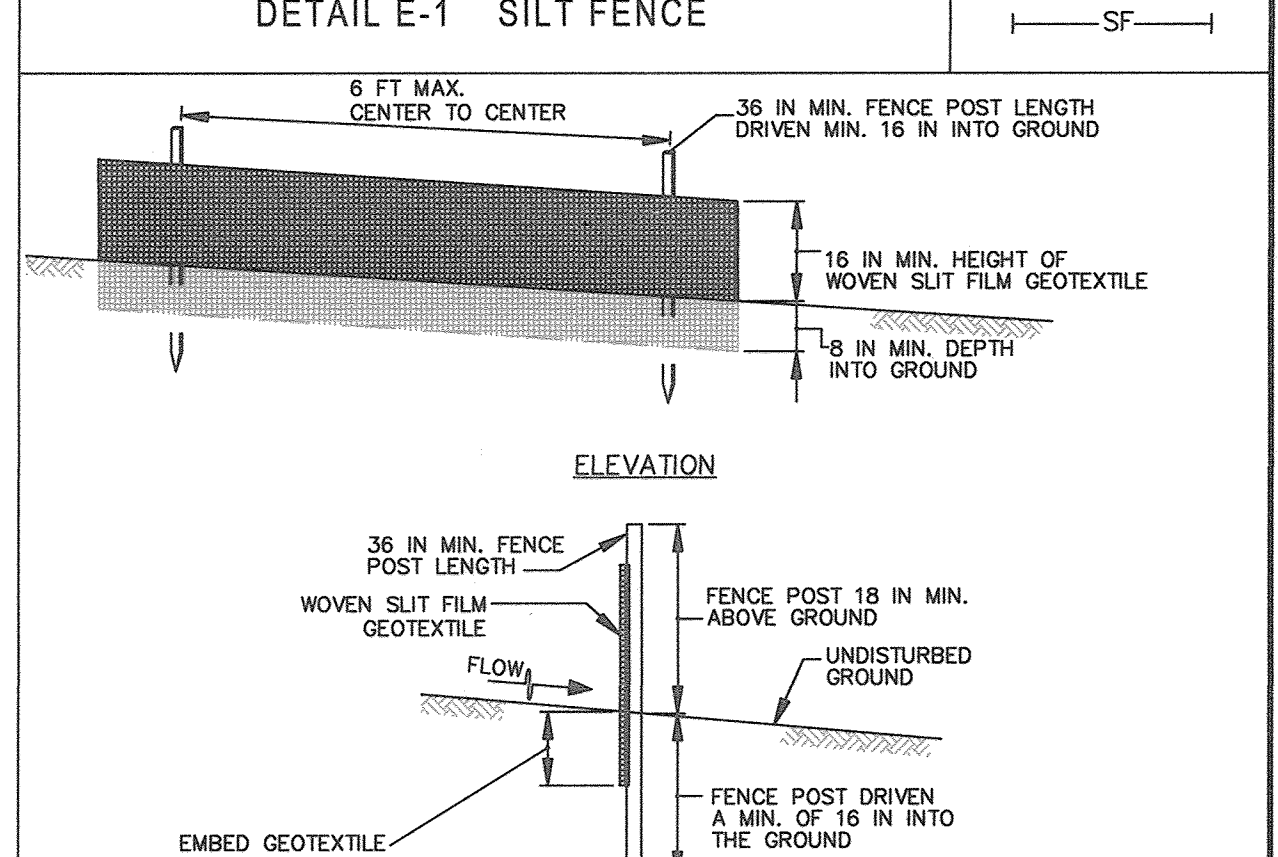

CONSTRUCTION SPECIFICATIONS
1. USE WOOD POSTS 1 1/2 X 1 1/2 X 3/8 INCH (MINIMUM) SQUARE CUT OF SOUND QUALITY HARDWOOD, AS AN ALTERNATIVE TO WOODEN POST USE STANDARD "T" OR "U" SECTION STEEL POSTS WEIGHING NOT LESS THAN 1 POUND PER LINEAR FOOT.
2. USE 36 INCH MINIMUM POSTS DRIVEN 16 INCH MINIMUM INTO GROUND NO MORE THAN 6 FEET APART.
3. USE WOVEN SILT FILM GEOTEXTILE AS SPECIFIED IN SECTION H-1 MATERIALS AND FASTEN GEOTEXTILE SECURELY TO UPSLOPE SIDE OF FENCE POSTS WITH WIRE TIES OR STAPLES AT TOP AND MID-SECTION.
4. PROVIDE MANUFACTURER CERTIFICATION TO THE AUTHORIZED REPRESENTATIVE OF THE INSPECTION/ENFORCEMENT AUTHORITY SHOWING THAT THE GEOTEXTILE USED MEETS THE REQUIREMENTS IN SECTION H-1 MATERIALS.
5. EMBED GEOTEXTILE A MINIMUM OF 8 INCHES VERTICALLY INTO THE GROUND, BACKFILL AND COMPACT THE SOIL ON BOTH SIDES OF FABRIC.
6. WHERE TWO SECTIONS OF GEOTEXTILE ADJOIN: OVERLAP, TWIST, AND STAPLE TO POST IN ACCORDANCE WITH THIS DETAIL.
7. EXTEND BOTH ENDS OF THE SILT FENCE A MINIMUM OF FIVE HORIZONTAL FEET UPSLOPE AT 45 DEGREES TO THE MAIN FENCE ALIGNMENT TO PREVENT RUNOFF FROM GOING AROUND THE ENDS OF THE SILT FENCE.
8. REMOVE ACCUMULATED SEDIMENT AND DEBRIS WHEN BULES DEVELOP IN SILT FENCE OR WHEN SEDIMENT REACHES 25% OF FENCE HEIGHT. REPLACE GEOTEXTILE IF TORN, IF UNDERMINING OCCURS, REINSTALL FENCE.

MARYLAND STANDARDS AND SPECIFICATIONS FOR SOIL EROSION AND SEDIMENT CONTROL
U.S. DEPARTMENT OF AGRICULTURE NATURAL RESOURCES CONSERVATION SERVICE 2011 MARYLAND DEPARTMENT OF ENVIRONMENT WATER MANAGEMENT ADMINISTRATION

AS-BUILT
DATE 11/2/18

NOTE: SEE SHEETS 14 & 15 FOR SEDIMENT & EROSION CONTROL PLAN

CONTRACT NO. 34-4992-D ENCLAVE AT RIVER HILL - PHASE II
LOTS 55 THRU 74, 82 THRU 124, 130 THRU 159, 161 THRU 168 & OPEN SPACE LOTS 155 THRU 159, 160 & 169

SEWER & WATER MAIN EXTENSIONS HOWARD COUNTY, MARYLAND

ENCLAVE AT RIVER HILL: PHASE II
LOTS 55 THRU 74, 82 THRU 124, 130 THRU 159, 161 THRU 168 & OPEN SPACE LOTS 155 THRU 159, 160 & 169

SEWER & WATER MAIN EXTENSIONS CONTRACT NO. 34-4992-D FIFTH ELECTION DISTRICT HOWARD COUNTY, MARYLAND

DEPARTMENT OF PUBLIC WORKS
HOWARD COUNTY, MARYLAND
CHIEF, BUREAU OF UTILITIES

DEPARTMENT OF PLANNING AND ZONING
HOWARD COUNTY, MARYLAND
CHIEF, DEVELOPMENT ENGINEERING DIVISION

FISHER, COLLINS & CARTER, INC.
CIVIL ENGINEERING CONSULTANTS & LAND SURVEYORS
CONTINENTAL SQUARE OFFICE PARK - 10772 BALTIMORE NATIONAL FREE ELLIOTT CITY, MARYLAND 21042 (410) 461-2999

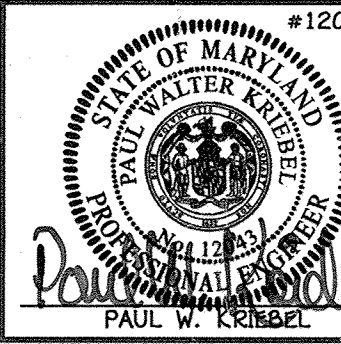


Table with columns: DESIGNED BY (B.C.R.), DRAWN BY (B.C.R.), CHECKED BY (P.W.K.), DATE (JULY, 2017), PCC, REVISION, DATE.

SEDIMENT & EROSION CONTROL NOTES & DETAILS
600' SCALE MAP NO. 34 BLOCK NO. 18
F.C.C. WORK ORDER NO. 13008-3001
FILE NAME: SEWER & WATER MAIN EXTENSION PLAN

SCALE AS SHOWN
SHEET 16 OF 16