

PURPOSE STATEMENT

THE PURPOSE OF THIS PROJECT IS TO REPLACE THE CAST IRON WATER MAIN, INSTALLED UNDER CONTRACT 2-W, ALONG OLD LAWYERS HILL ROAD BETWEEN LAWYERS HILL ROAD AND THE DEAD END OF OLD LAWYERS HILL ROAD.


GENERAL NOTES

- APPROXIMATE LOCATION OF EXISTING UTILITIES ARE SHOWN. THE CONTRACTOR SHALL TAKE ALL NECESSARY PRECAUTIONS TO PROTECT EXISTING UTILITIES AND SERVICES AND MAINTAIN UNINTERRUPTED SERVICE. ANY DAMAGE INCURRED SHALL BE REPAIRED IMMEDIATELY TO THE SATISFACTION OF THE ENGINEER AT THE CONTRACTOR EXPENSE.
- TOPOGRAPHIC FIELD SURVEYS WERE PERFORMED ON 9/14/2016 BY KCI TECHNOLOGIES, INC.
- HORIZONTAL AND VERTICAL SURVEY CONTROLS:
THE COORDINATES SHOWN ON THE DRAWINGS ARE BASED ON MARYLAND STATE REFERENCE SYSTEM NAD 83/91 AS PROJECTED BY HOWARD COUNTY GEODETIC CONTROL STATIONS NO. 38AA, 3111, AND 0024. ALL VERTICAL CONTROLS ARE BASED ON NAVD 88. VERTICAL CONTROLS PROVIDED ON THE DRAWINGS ARE REBAR & CAP AND NAILS.
- ALL PIPE ELEVATIONS SHOWN ARE INVERT ELEVATIONS UNLESS OTHERWISE NOTED ON THE PLANS.
- CLEAR ALL UTILITIES BY A MINIMUM OF 12". CLEAR ALL POLES BY 5'-0" MINIMUM OR TUNNEL AS REQUIRED. IN THE EVENT THE CONTRACTOR'S WORK REQUIRES THE BRACING OF ADDITIONAL POLES AS SHOWN ON THE DRAWINGS, ANY COST INCURRED BY THE OWNER FOR THE BRACING OF ADDITIONAL POLES OR DAMAGES SHALL BE DEDUCTED FROM MONIES OWED THE CONTRACTOR. THE CONTRACTOR SHALL COORDINATE WITH THE UTILITY COMPANIES TO SCHEDULE THE BRACING OF THE POLES.
- FOR DETAILS NOT SHOWN ON THE DRAWINGS, AND FOR MATERIALS AND CONSTRUCTION METHODS, USE HOWARD COUNTY DESIGN MANUAL, VOLUME IV, STANDARD SPECIFICATIONS AND DETAILS FOR CONSTRUCTION (LATEST EDITION). THE CONTRACTOR SHALL HAVE A COPY OF VOLUME IV ON THE JOB.
- WHERE TEST PITS HAVE BEEN MADE ON EXISTING UTILITIES, THEY ARE NOTED BY THE SYMBOL. AT THE LOCATIONS OF THE TEST PITS, A TABLE CONTAINING THE RESULTS OF THE TEST PITS IS INCLUDED ON THE DRAWINGS. EXISTING UTILITIES IN THE VICINITY OF THE PROPOSED WORK FOR WHICH TEST PITS HAVE NOT BEEN NOTED SHALL BE LOCATED BY THE CONTRACTOR TWO WEEKS IN ADVANCE OF CONSTRUCTION OPERATIONS AT HIS OWN EXPENSE.
- THE CONTRACTOR SHALL NOTIFY THE FOLLOWING UTILITY COMPANIES OR AGENCIES AT LEAST FIVE WORKING DAYS BEFORE STARTING WORK SHOWN ON THESE PLANS:
AT&T.....1-800-252-1133
BG&E (CONSTRUCTION SERVICES).....410-637-8713
BG&E (EMERGENCY).....410-685-0123
BUREAU OF UTILITIES (DPW).....410-313-4900
COLONIAL PIPELINE CO.....410-795-1390
MISS UTILITY.....1-800-257-7777
STATE HIGHWAY ADMINISTRATION.....410-531-5533
VERIZON.....1-800-743-0033 / 410-224-9210
- TREES AND SHRUBS ARE TO BE PROTECTED FROM DAMAGE TO THE MAXIMUM EXTENT. TREES AND SHRUBS LOCATED WITHIN THE CONSTRUCTION STRIP ARE NOT TO BE REMOVED OR DAMAGED BY THE CONTRACTOR.
- CONTRACTOR SHALL REMOVE TREES, STUMPS AND ROOTS ALONG LINE OF EXCAVATION. PAYMENT FOR SUCH REMOVAL SHALL BE INCLUDED IN THE UNIT PRICE BID FOR CONSTRUCTION OF THE MAIN.
- THE CONTRACTOR SHALL NOTIFY THE BUREAU OF HIGHWAYS, HOWARD COUNTY, AT (410)313-7450 AT LEAST FIVE WORKING DAYS BEFORE ANY OPEN CUT OF ANY COUNTY ROAD OR BORING/JACKING OPERATION IN COUNTY ROADS FOR LAYING WATER/SEWER MAINS OR HOUSE CONNECTIONS. THE APPROVAL OF THESE DRAWINGS WILL CONSTITUTE COMPLIANCE WITH DPW REQUIREMENTS PER SECTION 18.114(a) OF THE HOWARD COUNTY CODE.
- THE CONTRACTOR SHALL PROVIDE SURVEY CONSTRUCTION STAKEOUT FOR ALL NECESSARY LINES.
- THE CONTRACTOR SHALL PROVIDE STAGING/STORAGE AREA. THE WORK SHALL BE CONDUCTED UNDER STRICT ADHERENCE TO SECTION 308 - EROSION AND SEDIMENT CONTROL OF THE HOWARD COUNTY DESIGN MANUAL, VOLUME IV.
- THE CONTRACTOR IS RESPONSIBLE FOR CONTACTING THE VARIOUS BUSINESSES AND RESIDENCES AND COORDINATE THE WORK ACTIVITIES SO AS NOT TO NEGATIVELY IMPACT THE CONNECTED CUSTOMERS. THE INSTALLATION OF WATER MAIN SHALL CAUSE MINIMUM DISTURBANCE TO THE EXISTING BUSINESSES AND RESIDENCES AND NOTIFICATION OF ANY INTERRUPTIONS OF SERVICE SHALL BE THE RESPONSIBILITY OF THE CONTRACTOR. THE COUNTY REQUIRES THAT THE CONTRACTOR NOTIFY EACH AFFECTED BUSINESS AND RESIDENCE OF THE IMPENDING INTERRUPTION BY LETTER OR WITH DOOR TAGS AT LEAST 48 HOURS IN ADVANCE OF THE PLANNED INTERRUPTION. IN THE EVENT OF UNPLANNED INTERRUPTION, THE CONTRACTOR WILL BE RESPONSIBLE FOR NOTIFYING THE BUSINESSES AND RESIDENCES BY DOOR-TO-DOOR CANVASSING.

WATER MAIN NOTES

- ALL WATER MAINS SHALL BE C900 PVC PIPE UNLESS OTHERWISE NOTED. SEE THE HOWARD COUNTY DESIGN MANUAL VOLUME IV-STANDARD SPECIFICATIONS AND DETAILS FOR CONSTRUCTION AND ALL SUBSEQUENT AMENDMENTS THERETO.
- TOPS OF WATER MAIN SHALL HAVE A MINIMUM OF 4'-0" OF COVER UNLESS OTHERWISE NOTED.
- VALVES ADJACENT TO TEES SHALL BE STRAPPED TO TEES.
- ALL FITTINGS SHALL BE BUTTRESSED OR ANCHORED WITH CONCRETE IN ACCORDANCE WITH STANDARD DETAILS UNLESS OTHERWISE PROVIDED FOR ON THE DRAWINGS.
- FIRE HYDRANTS SHALL BE SET TO THE BURY LINE ELEVATIONS SHOWN ON THE DRAWINGS. ALL FIRE HYDRANTS SHALL BE INSTALLED IN ACCORDANCE WITH STANDARD DETAILS. THE SOIL AROUND THE FIRE HYDRANT SHALL BE COMPACTED IN ACCORDANCE WITH SECTION 1000 AND SECTION 1005 OF THE STANDARD DETAIL AND SPECIFICATIONS. ALL FIRE HYDRANT LEADS SHALL BE DUCTILE IRON (DI) PIPE AND CONSTRUCTED IN ACCORDANCE WITH HOWARD COUNTY DESIGN MANUAL VOLUME IV-STANDARD SPECIFICATIONS AND DETAILS FOR CONSTRUCTION.
- THE CONTRACTOR SHALL NOT OPERATE ANY WATER MAIN VALVES ON THE EXISTING WATER SYSTEM.
- TRACER WIRES AND CONTINUITY TEST STATIONS SHALL BE INSTALLED ON ALL PVC WATER MAINS IN ACCORDANCE WITH THE HOWARD COUNTY DESIGN MANUAL.
- FOR PVC WATER MAINS, ALL RECORDS FOR THE QUALITY CONTROL AND QUALIFICATION TEST REQUIREMENTS NOTED IN SECTION 5.1 OF THE AWWA STANDARD C900 FOR PVC PRESSURE PIPE SHALL BE SUBMITTED WITH THE PIPE MATERIAL CERTIFICATIONS OR SHOP DRAWINGS PRIOR TO APPROVAL OF THE MATERIAL FOR USE. THE TEST RECORDS SHALL BE FOR THE PIPE TO BE INSTALLED UNDER THIS CONTRACT. ALL PVC PIPE SHALL CONTAIN MARKINGS TO ALLOW CROSS REFERENCING OF THE PIPE SUPPLIED TO THE TEST RECORDS RECEIVED.
- UNLESS OTHERWISE NOTED ON THE PLANS OR IN THE SPECIFICATIONS SACRIFICIAL ANODES SHALL BE INSTALLED ON ALL VALVES AND METALLIC FITTINGS USED WITH PVC WATER MAINS IN ACCORDANCE WITH VOLUME IV, STANDARD SPECIFICATIONS AND DETAILS FOR CONSTRUCTION. SEVENTEEN (17) POUND MAGNESIUM ANODES SHALL BE INSTALLED ON ALL VALVES AND DUCTILE IRON FITTINGS INCLUDING RESTRAINTS AND HARNESSSES. TWELVE (12) POUND ZINC ANODES SHALL BE INSTALLED ON ALL STAINLESS STEEL FITTINGS AND SADDLES USED WITH PVC MAINS. ALL "TEES" USED WITH PVC MAINS SHALL BE DUCTILE IRON.
- PROPER ASSEMBLY OF GASKETED PVC PIPE JOINTS: THE MANUFACTURER'S INSERTION LINE OF GASKETED PVC PIPE JOINTS INDICATES THE MAXIMUM DEPTH OF INSERTION OF THE SPIGOT INTO THE BELL. AFTER ASSEMBLY OF THE JOINT, THE INSERTION LINE SHALL REMAIN VISIBLE. DUAL INSERTION LINES ON GASKETED PVC PIPE INDICATE THE MAXIMUM AND MINIMUM DEPTH OF INSERTION OF THE SPIGOT INTO THE BELL. THE CONTRACTOR SHALL NOT OVER INSERT OR OVER HOME THE SPIGOT INTO THE BELL OF PVC PIPE.
- ALL CHANGES IN HORIZONTAL OR VERTICAL DIRECTION OF PVC WATER PIPE SHALL BE MADE WITH STANDARD BENDS, 5-DEGREE SWEEPS OR HIGH DEFLECTION (HD) COUPLINGS. NO BENDING OF THE PIPE OR DEFLECTING OF PVC PIPE JOINTS IS PERMITTED. WHERE HIGH DEFLECTION COUPLINGS OR 5-DEGREE SWEEPS ARE PERMITTED, THE CONTRACTOR SHALL PROVIDE ONE FULL PIPE LENGTH (20-FOOT LONG) ON EITHER SIDE OF THE HIGH DEFLECTION COUPLING OR 5-DEGREE SWEEP. THE CONTRACTOR SHALL USE A VIBRATORY PLATE COMPACTOR OR OTHER APPROVED MEANS TO THOROUGHLY COMPACT THE #57 STONE ON BOTH SIDES OF THE HIGH DEFLECTION COUPLING OR 5-DEGREE SWEEP, TAKING CARE NOT TO USE COMPACTION EQUIPMENT DIRECTLY OVER THE FITTING.
PVC HIGH DEFLECTION COUPLINGS SHALL BE LIMITED TO A TOTAL DEFLECTION OF 3-DEGREES (1/2-DEGREE ON EITHER END OF THE COUPLING), SHALL BE RATED FOR A MINIMUM 200 PSI MEETING THE REQUIREMENTS OF AWWA C900, SHALL HAVE A MINIMUM LAY LENGTH OF 9-INCHES AND SHALL HAVE CENTER STOPS. PVC HIGH DEFLECTION COUPLINGS SHALL BE CERTAINTED PVC HIGH DEFLECTION (HD) STOP COUPLINGS OR EQUAL. FIVE DEGREE SWEEPS SHALL BE BELL BY SPIGOT, RATED FOR A MINIMUM 225 PSI, DR18 MEETING THE REQUIREMENTS OF AWWA C900 AND SHALL BE MULTI FITTINGS (IPEX) BLUE BRUTE DR18 OR EQUAL.
- WHEN PVC HIGH DEFLECTION COUPLINGS OR PVC 5-DEGREE SWEEPS ARE USED TO FACILITATE CHANGES IN HORIZONTAL OR VERTICAL ALIGNMENTS OF AWWA C-900 PVC PIPELINES, THE CONTRACTOR SHALL INSTALL DEVICES FOR THE PREVENTION OF OVER-INSERTION OF THE PVC PIPE SPIGOTS OR PLAIN ENDS INTO THE PUSH ON BELL JOINT ON BOTH SIDES OF THE HIGH DEFLECTION COUPLINGS AND 5 DEGREE SWEEPS. BELL STOPS SHALL BE PLACED AT THE PROPER INSERTION LINE FOR THE FITTING. THE BELL STOP SHALL BE MANUFACTURED OF DUCTILE IRON AND INCORPORATE AN EXPANSION RETENTION SPRING TO ALLOW FOR PIPE EXPANSION AND CONTRACTION. THE BELL STOPS SHALL BE SERIES 5000 MEGA-STOP, AS MANUFACTURED BY EBAA IRON, INC. OR APPROVED EQUAL.
- THE TEMPORARY BYPASS WATER MAIN PIPING SHALL BE CERTA-LOK YELOMINE RESTRAINED JOINT PVC PRESSURE PIPE AND COUPLING. TEMPORARY BYPASS WATER SHALL NOT BE USED BETWEEN NOVEMBER 15 AND MARCH 1.

PROFESSIONAL CERTIFICATION: I hereby certify that these documents were prepared or approved by me, and that I am a duly licensed professional engineer under the laws of the State of Maryland, License No. 31363, Expiration Date 1/16/2020.

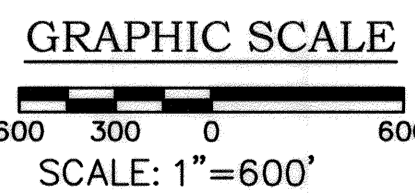


OLD LAWYERS HILL ROAD WATER SUPPLY MAIN REPLACEMENT HOWARD COUNTY, MARYLAND

DEPARTMENT OF PUBLIC WORKS

CAPITAL PROJECT No. W8327

CONTRACT No. 44-5018

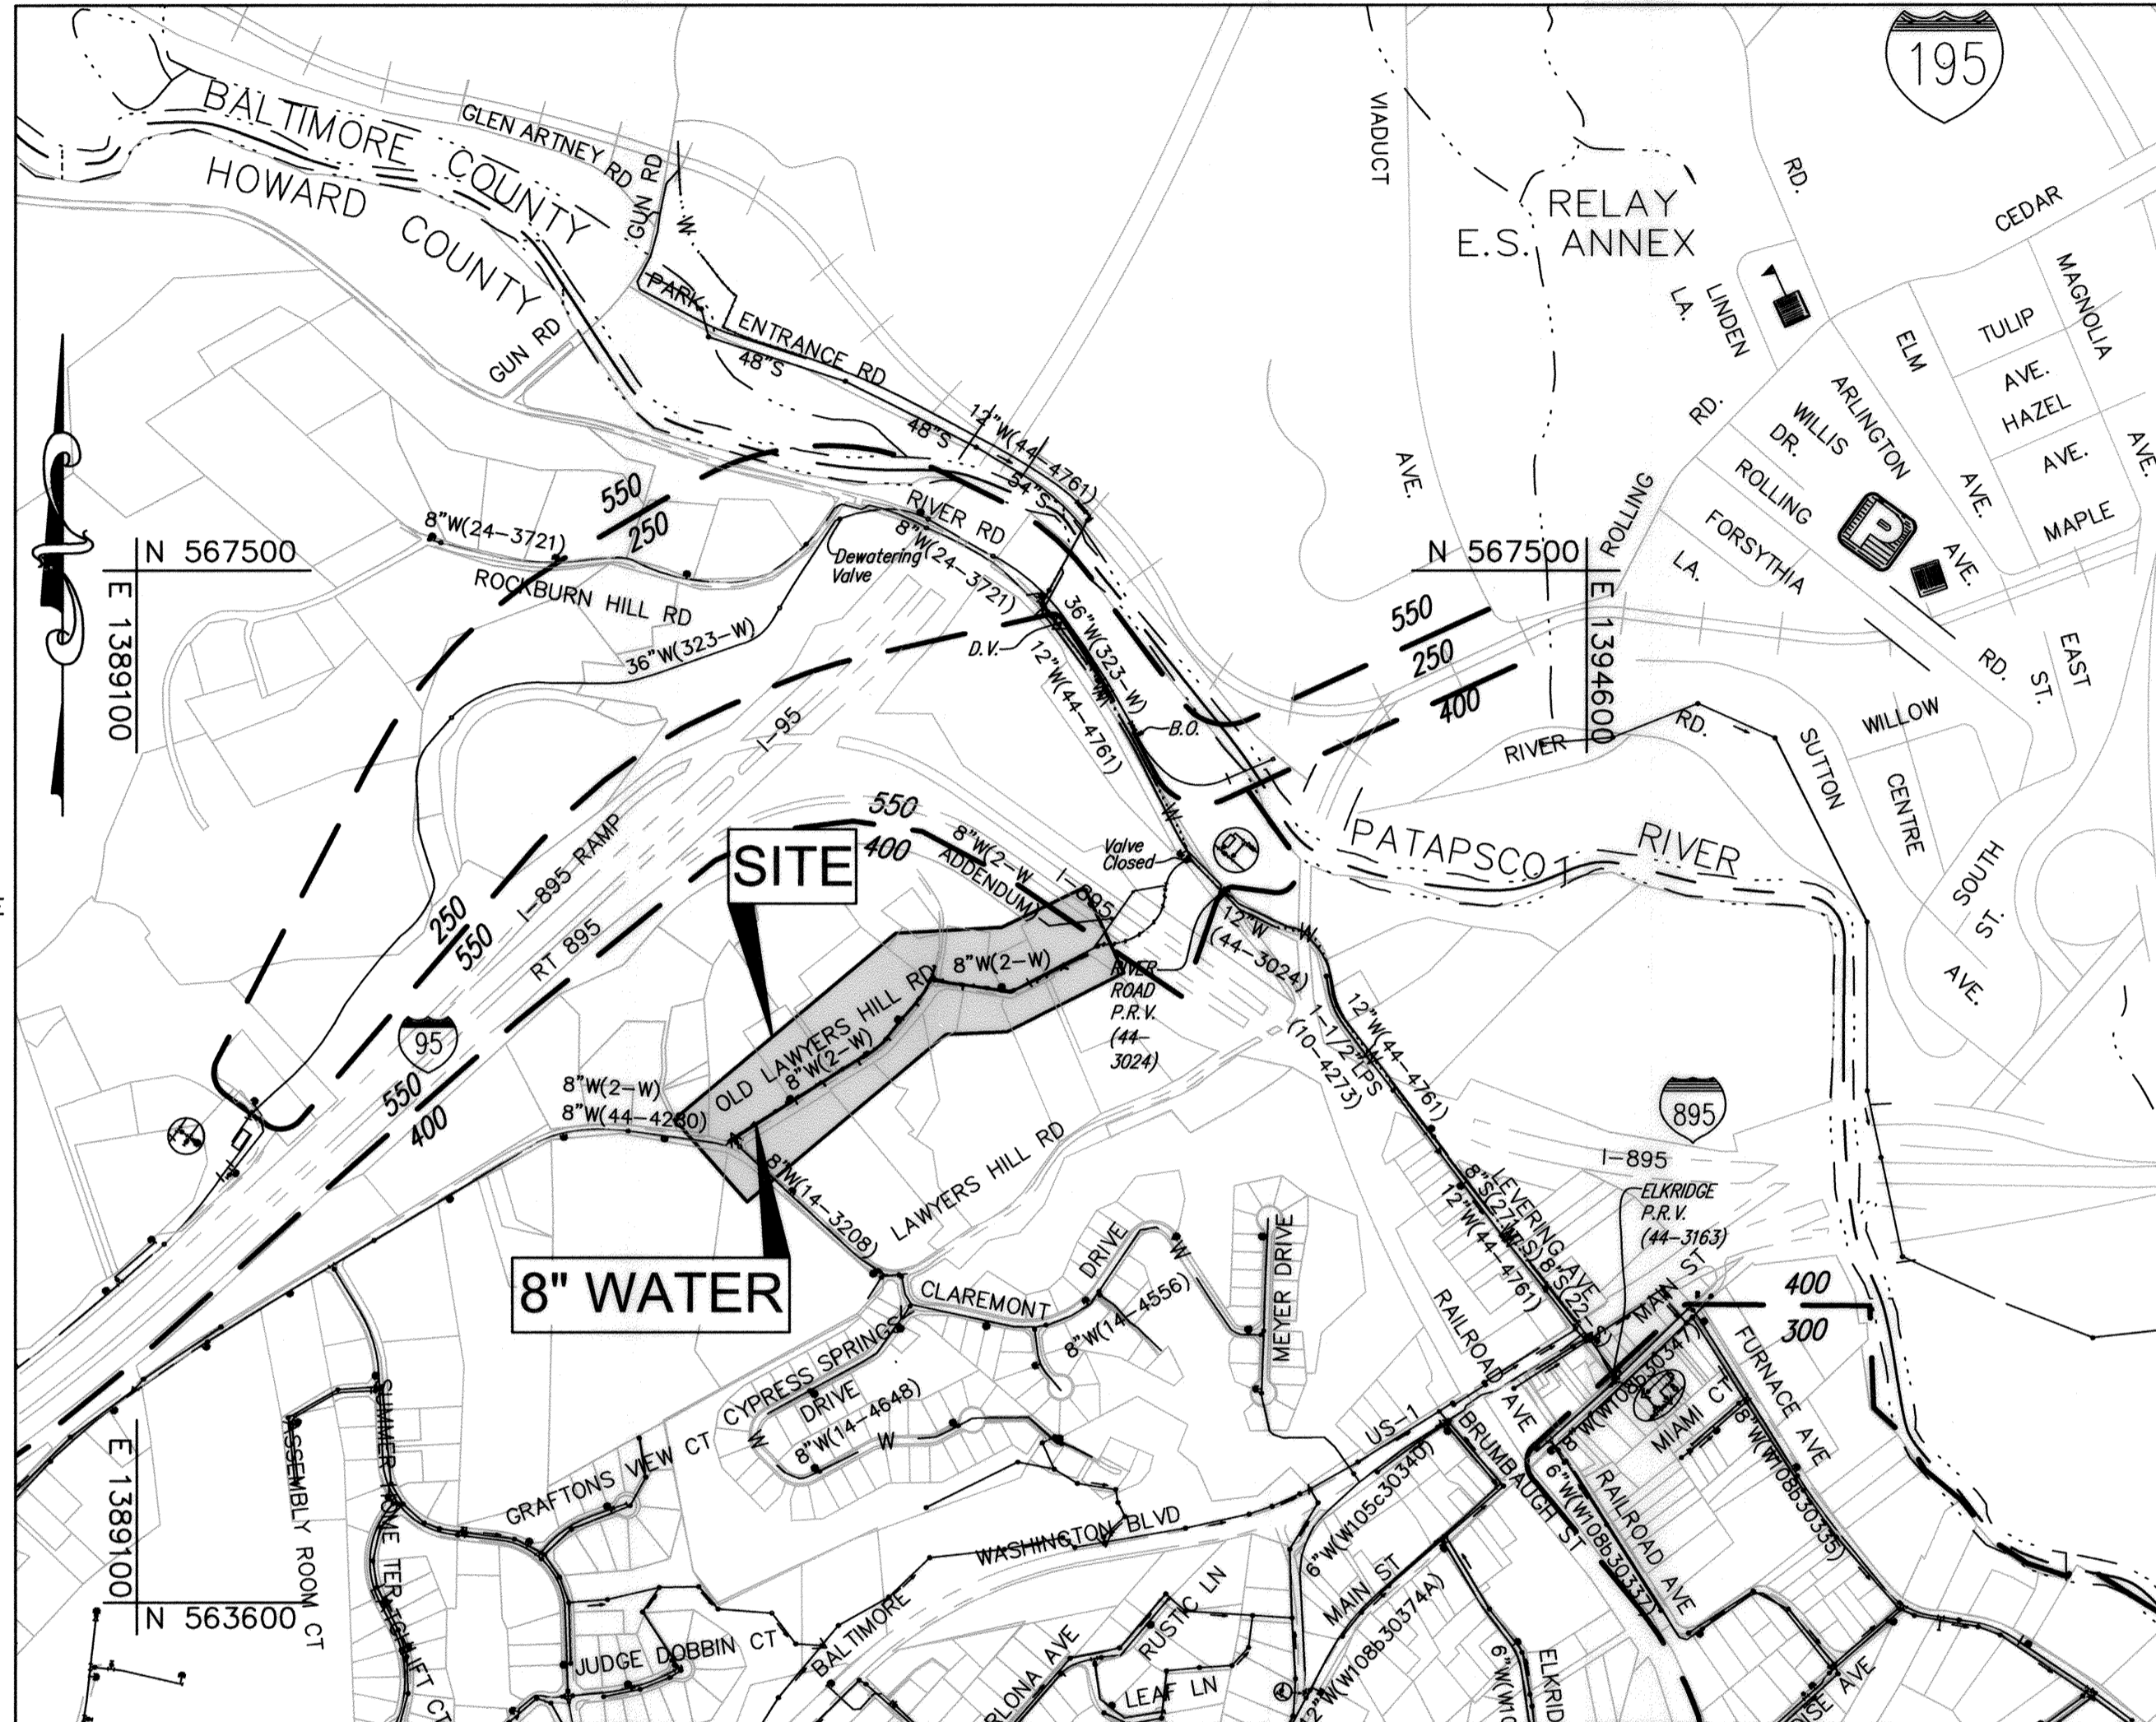

LOCATION MAP

SCALE: 1" = 600'

HOWARD COUNTY GEODETIC SURVEY CONTROL

THE HORIZONTAL AND VERTICAL DATUM BASED ON NAD83/91 (HORIZONTAL) NAVD 88 (VERTICAL)

38AA N 561158.85 3111 N 565004.73
E 1389726.32 E 13891586.89
ELEV.219.99 ELEV.305.93

0024 N 565065.48
E 1395212.08
ELEV.26.89

DRAINAGE AREA: PATAPSCO
PRESSURE ZONE: 400
WATER TEST GRADIENT: 608
NUMBER OF WATER HOUSE CONNECTIONS: 17

INDEX OF SHEETS	
SHEET NO.	DESCRIPTION
1	TITLE SHEET
2	TEMPORARY WATER PLAN
3	TEMPORARY WATER PLAN
4	WATER MAIN PLAN
5	WATER MAIN PLAN
6	EROSION AND SEDIMENT CONTROL PLAN
7	EROSION AND SEDIMENT CONTROL NOTES AND DETAILS
8	EROSION AND SEDIMENT NOTES

QUANTITIES

ITEM	UNIT	ESTIMATE	AS-BUILT	MANUFACTURER
8" C900 DR14 FUSIBLE PVC	L.F.	1610	1611	
FIRE HYDRANT AND 6" VALVE	EA.	3	3	
8" VALVE	EA.	4	4	
1" WATER HOUSE CONNECTION	L.F.	280	296	
6" TEMPORARY WATER	L.F.	1850	1728	
TEMPORARY FIRE HYDRANT CONNECTION	EA.	3	3	

NAME OF UTILITY CONTRACTOR: _____

CHECKBOX AS-BUILT DATE: 1-29-2020

SURVEY AND DRAFTING DIVISION

RESTORATION SCHEDULE

LOCATION	DISTANCE	TYPE
OLD LAWYERS HILL ROAD	129'	SEED & MULCH
OLD LAWYERS HILL ROAD	212'	MACADAM

LEGEND

- | | |
|--|--------------------------------------|
| PROPOSED | EXISTING |
| ▲ TRAVERSE POINT | DECIDUOUS TREE |
| — WATER MAIN | CONIFEROUS TREE |
| ⊕ FIRE HYDRANT | EXISTING FIRE HYDRANT |
| ⊕ VALVE | EXISTING VALVE |
| ⊕ CONTINUITY TEST STATION (C.T.S.) | EXISTING AIR RELEASE VALVE AND VAULT |
| ⊕ TEST PIT | EXISTING WATER MAIN |
| ⊕ SOIL BORING (COMPLETED, SEE GEOTECHNICAL REPORT) | EXISTING GAS MAIN |
| — TW — TEMPORARY WATER | EXISTING UNDERGROUND ELECTRIC |
| --- UTILITY EASEMENT | EXISTING OVERHEAD ELECTRIC |
| --- TEMPORARY CONSTRUCTION EASEMENT | WETLAND LIMIT |
| | WETLAND BUFFER |
| | 100 YEAR FLOODPLAIN |
| | SOIL LIMITS AND MAPPING UNITS |

AS-BUILT
DATE 03-10-2020

DESIGN CERTIFICATION

"I HEREBY CERTIFY THAT THIS PLAN HAS BEEN DESIGNED IN ACCORDANCE WITH CURRENT MARYLAND EROSION AND SEDIMENT CONTROL LAWS, REGULATIONS AND STANDARDS, THAT IT REPRESENTS A PRACTICAL AND WORKABLE PLAN BASED ON MY PERSONAL KNOWLEDGE OF THE SITE, AND THAT IT WAS PREPARED IN ACCORDANCE WITH THE REQUIREMENTS OF THE HOWARD COUNTY CONSERVATION DISTRICT."

OWNER'S/DEVELOPER'S CERTIFICATION

"I/WE CERTIFY THAT ALL CLEARING, GRADING, CONSTRUCTION OR DEVELOPMENT WILL BE DONE PURSUANT TO THIS APPROVED EROSION AND SEDIMENT CONTROL PLAN, INCLUDING INSPECTING AND MAINTAINING CONTROLS, AND THAT THE RESPONSIBLE PERSONNEL INVOLVED IN THE CONSTRUCTION PROJECT WILL HAVE A CERTIFICATE OF TRAINING AT A MARYLAND DEPARTMENT OF THE ENVIRONMENT (MDE) APPROVED TRAINING PROGRAM FOR THE CONTROL OF EROSION AND SEDIMENT PRIOR TO THE BEGINNING OF THE PROJECT. I CERTIFY RIGHT-OF-ENTRY FOR PERIODIC ON-SITE EVALUATION BY HOWARD COUNTY, THE HOWARD COUNTY CONSERVATION DISTRICT AND/OR MDE."

OWNER'S / DEVELOPER'S SIGNATURE: *Silver Chai* DATE: 03/10/2020
PRINTED NAME & TITLE: SILVER CHAI PROJECT MANAGER

DESIGNER'S SIGNATURE: *Guhua Wang* DATE: 03/01/2019
PRINTED NAME: GUHUA WANG MD REGISTRATION NO. 31363 (P.E./R.L.S. OR R.L.A. (CIRCLE ONE))
THIS SITE SHALL BE CONTROLLED IN ACCORDANCE WITH THE HOWARD COUNTY CONSERVATION DISTRICT "STANDARD EROSION AND SEDIMENT CONTROL PLAN FOR MINOR EARTH DISTURBANCE" AND ADHERE TO THE LIMITATIONS, CONDITIONS AND REQUIREMENTS THEREIN. A COPY OF THE STANDARD PLAN SHALL BE ON-SITE FOR REFERENCE DURING WORKING HOURS.

KCI TECHNOLOGIES PROJECT No.: 13122677.47

Mar 01, 2019 - 1:42pm User: herry.jackson File: 13122677.dwg

DEPARTMENT OF PUBLIC WORKS
HOWARD COUNTY, MARYLAND

Director of Public Works: *[Signature]* DATE: 3-5-19
Chief, Bureau of Engineering: *[Signature]* DATE: 3-5-19
Chief, Bureau of Utilities: *[Signature]* DATE: 3-6-19
Chief, Utility Design Division: *[Signature]* DATE: 3-5-19

ENGINEERS
PLANNERS
SCIENTISTS
CONSTRUCTION MANAGERS

KCI TECHNOLOGIES
936 Rotebrook Road
Sparks, MD 21152
Phone: (410) 316-7800
Fax: (410) 316-7817
www.kci.com

STATE OF MARYLAND
GUHUA WANG
No. 31363
PROFESSIONAL ENGINEER
03/01/2019

DES: CB, KJ					
DRN: KJ					
CHK: GW					
DATE: MARCH 2019	BY	NO.	REVISION	DATE	600' SCALE MAP NO. 32 BLOCK NO. 20.21

TITLE SHEET


OLD LAWYERS HILL ROAD
WATER SUPPLY MAIN REPLACEMENT

CAPITAL PROJECT No. W8327
CONTRACT No. 44-5018

ELECTION DISTRICT NO. 1 HOWARD COUNTY, MARYLAND

SCALE AS SHOWN
SHEET 1 OF 8


KCI TECHNOLOGIES PROJECT No.: 13122677.47

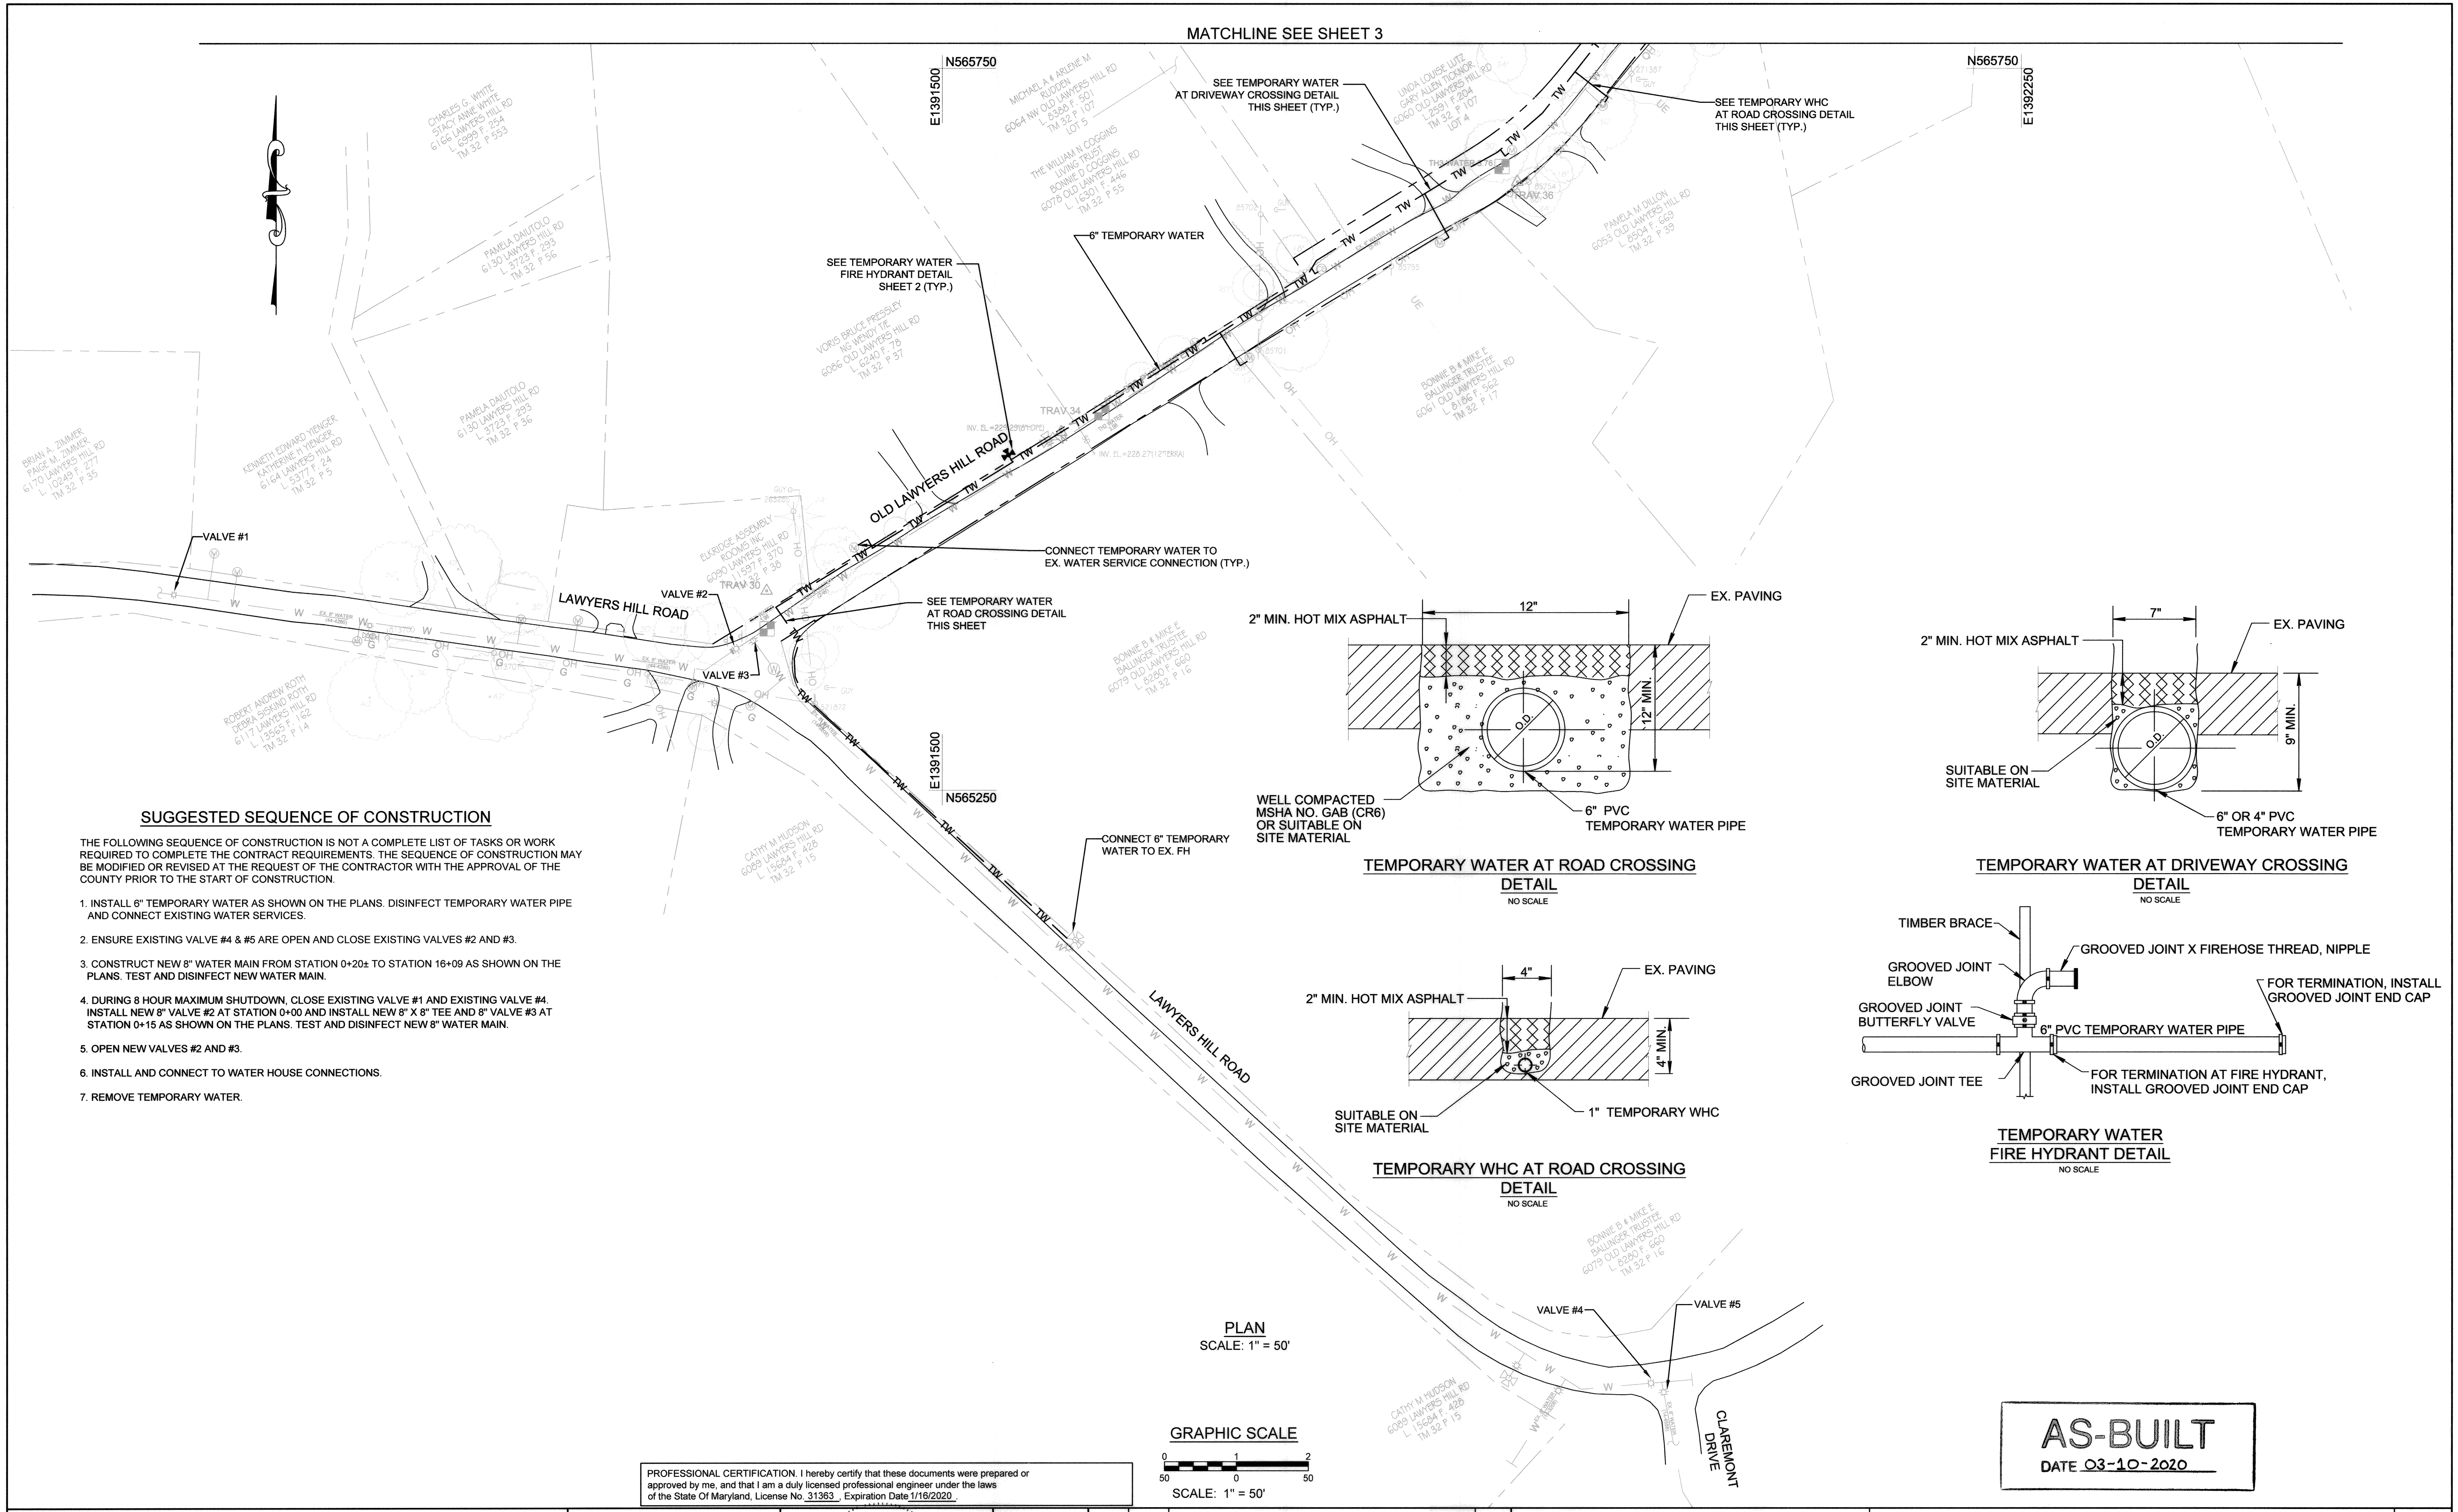


SUGGESTED SEQUENCE OF CONSTRUCTION

THE FOLLOWING SEQUENCE OF CONSTRUCTION IS NOT A COMPLETE LIST OF TASKS OR WORK REQUIRED TO COMPLETE THE CONTRACT REQUIREMENTS. THE SEQUENCE OF CONSTRUCTION MAY BE MODIFIED OR REVISED AT THE REQUEST OF THE CONTRACTOR WITH THE APPROVAL OF THE COUNTY PRIOR TO THE START OF CONSTRUCTION.


1. INSTALL 6" TEMPORARY WATER AS SHOWN ON THE PLANS. DISINFECT TEMPORARY WATER PIPE AND CONNECT EXISTING WATER SERVICES.
2. ENSURE EXISTING VALVE #4 & #5 ARE OPEN AND CLOSE EXISTING VALVES #2 AND #3.
3. CONSTRUCT NEW 8" WATER MAIN FROM STATION 0+20± TO STATION 16+09 AS SHOWN ON THE PLANS. TEST AND DISINFECT NEW WATER MAIN.
4. DURING 8 HOUR MAXIMUM SHUTDOWN, CLOSE EXISTING VALVE #1 AND EXISTING VALVE #4. INSTALL NEW 8" VALVE #2 AT STATION 0+00 AND INSTALL NEW 8" X 8" TEE AND 8" VALVE #3 AT STATION 0+15 AS SHOWN ON THE PLANS. TEST AND DISINFECT NEW 8" WATER MAIN.
5. OPEN NEW VALVES #2 AND #3.
6. INSTALL AND CONNECT TO WATER HOUSE CONNECTIONS.
7. REMOVE TEMPORARY WATER.

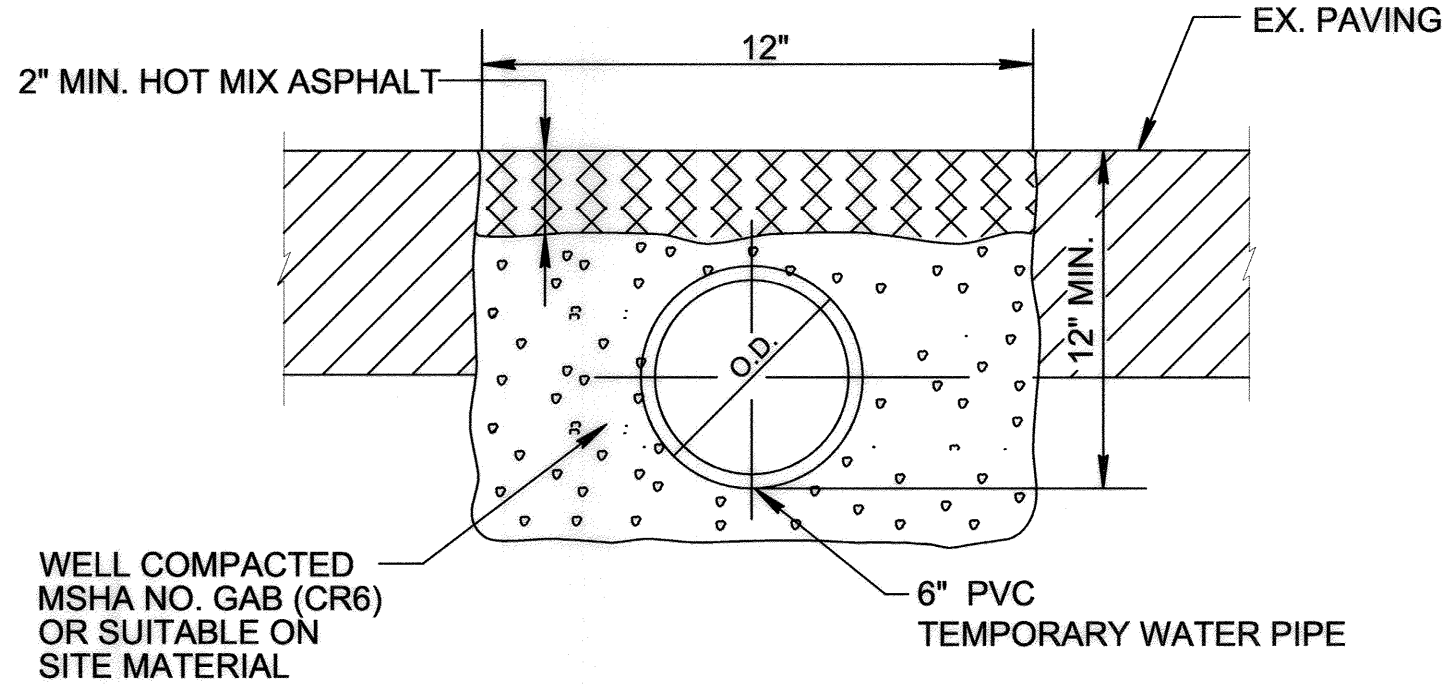


TEMPORARY WATER AT ROAD CROSSING
DETAIL
NO SCALE

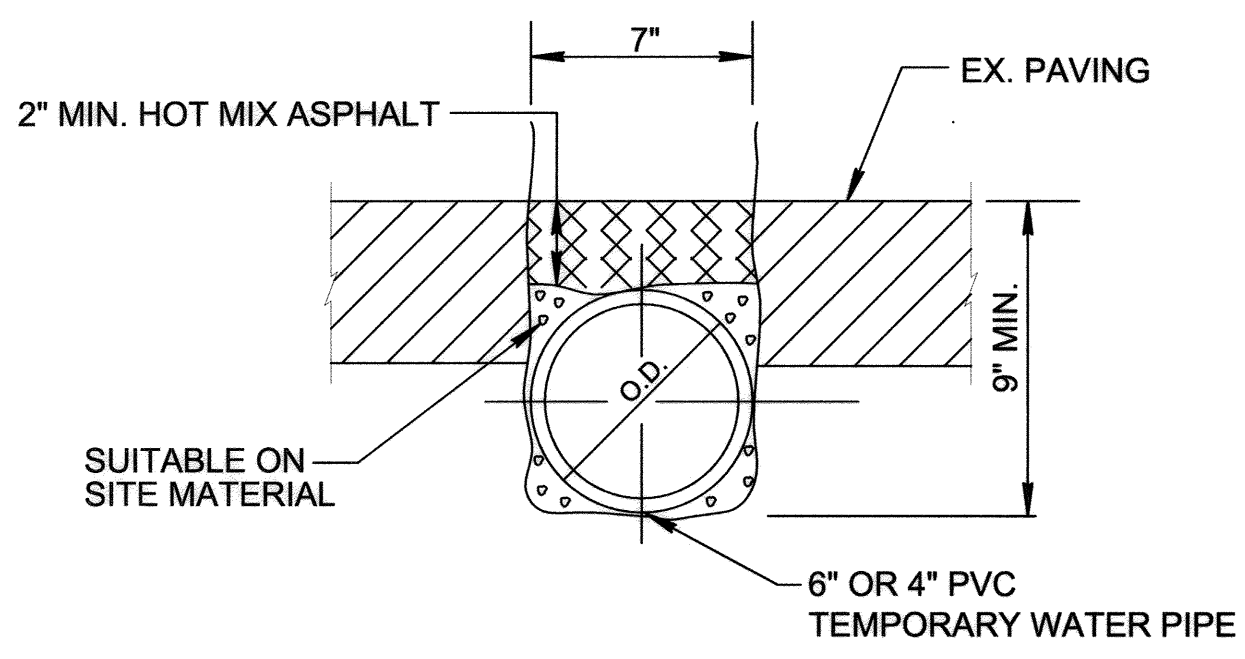

TEMPORARY WATER AT DRIVEWAY CROSSING
DETAIL
NO SCALE

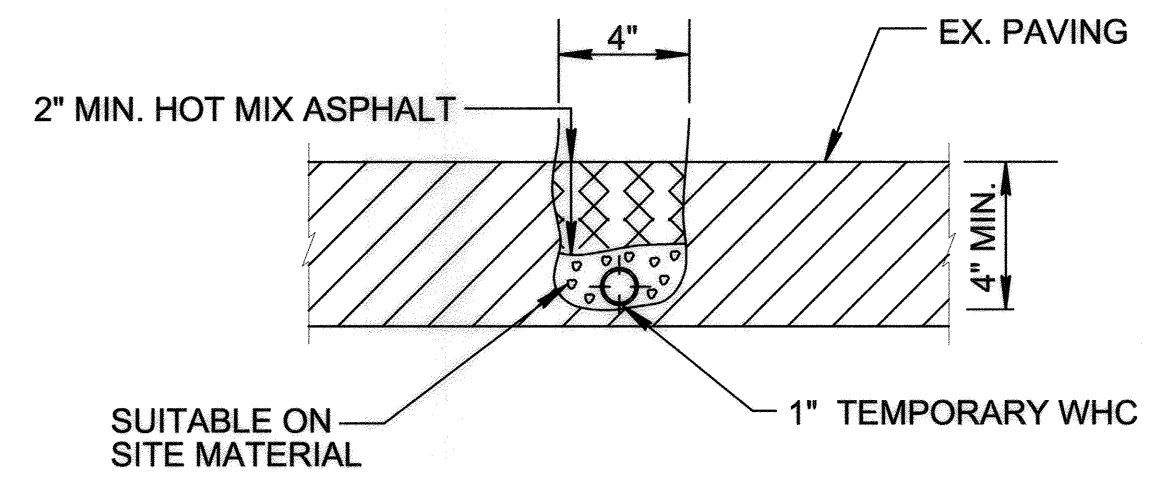


TEMPORARY WHC AT ROAD CROSSING
DETAIL
NO SCALE

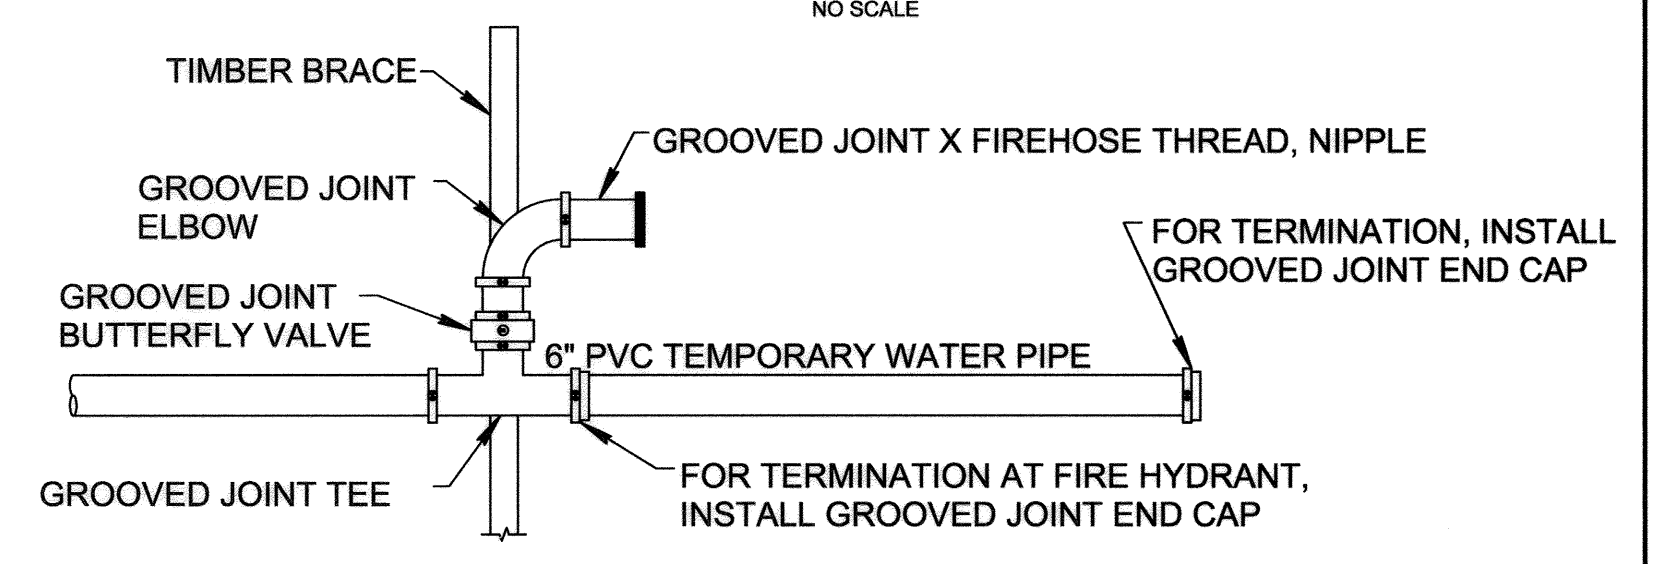

TEMPORARY WATER FIRE HYDRANT DETAIL
NO SCALE

PLAN
SCALE: 1" = 50'

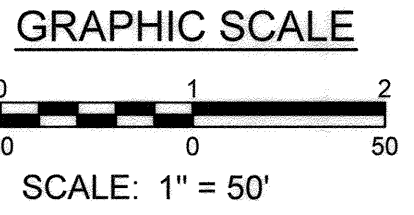

PROFESSIONAL CERTIFICATION: I hereby certify that these documents were prepared or approved by me, and that I am a duly licensed professional engineer under the laws of the State of Maryland, License No. 31363, Expiration Date 1/18/2020.

AS-BUILT
DATE 03-10-2020

Mar 01, 2019 - 1:42pm User: harrisa.jackson M:\2019\13122677\47\TemporaryWater.dwg

DEPARTMENT OF PUBLIC WORKS
HOWARD COUNTY, MARYLAND

3/7/19
DIRECTOR OF PUBLIC WORKS DATE

3-6-19
CHIEF, BUREAU OF UTILITIES DATE

3/5/19
CHIEF, UTILITY DESIGN DIVISION DATE

ENGINEERS
PLANNERS
SCIENTISTS
CONSTRUCTION MANAGERS

KCI
TECHNOLOGIES

936 Rotelbrook Road
Sparks, MD 21152
Phone: (410) 316-7800
Fax: (410) 316-7817
www.kci.com

STATE OF MARYLAND
JULIUS WANKER
PROFESSIONAL ENGINEER
NO. 31363
03/01/2019

DES: CB, KJ					
DRN: KJ					
CHK: GW					
DATE: MARCH 2019	BY	NO.	REVISION	DATE	

TEMPORARY WATER PLAN

600' SCALE MAP NO. 32 BLOCK NO. 20.21


**OLD LAWYERS HILL ROAD
WATER SUPPLY MAIN REPLACEMENT**

CAPITAL PROJECT No. W8327
CONTRACT No. 44-5018

ELECTION DISTRICT NO. 1 HOWARD COUNTY, MARYLAND

SCALE
AS SHOWN




SHEET
2 OF 8

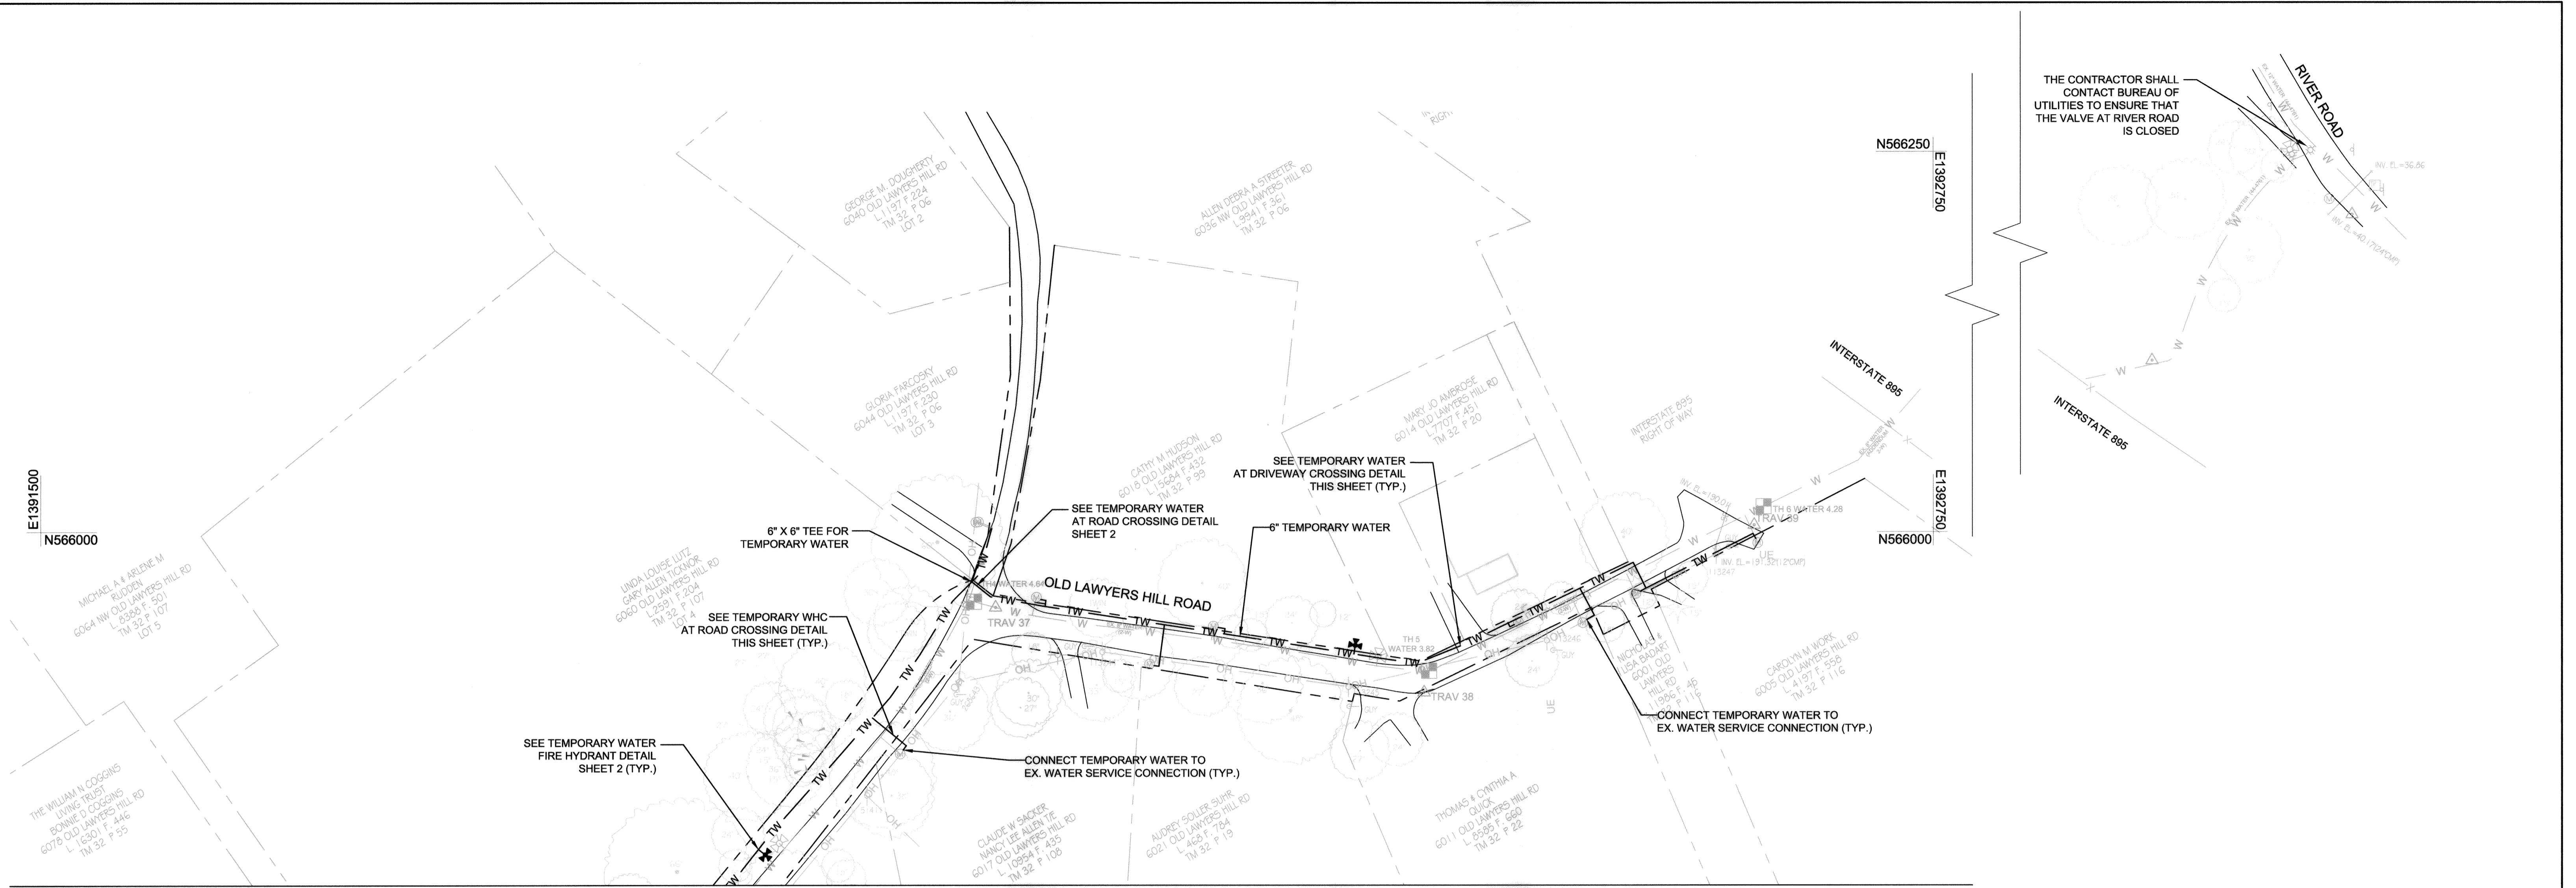

MATCHLINE SEE SHEET 2

PLAN
SCALE: 1" = 50'

THE CONTRACTOR SHALL CONTACT BUREAU OF UTILITIES TO ENSURE THAT THE VALVE AT RIVER ROAD IS CLOSED

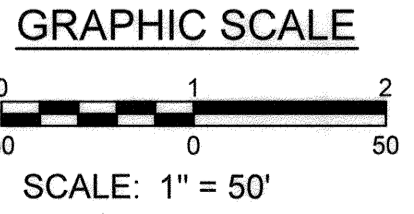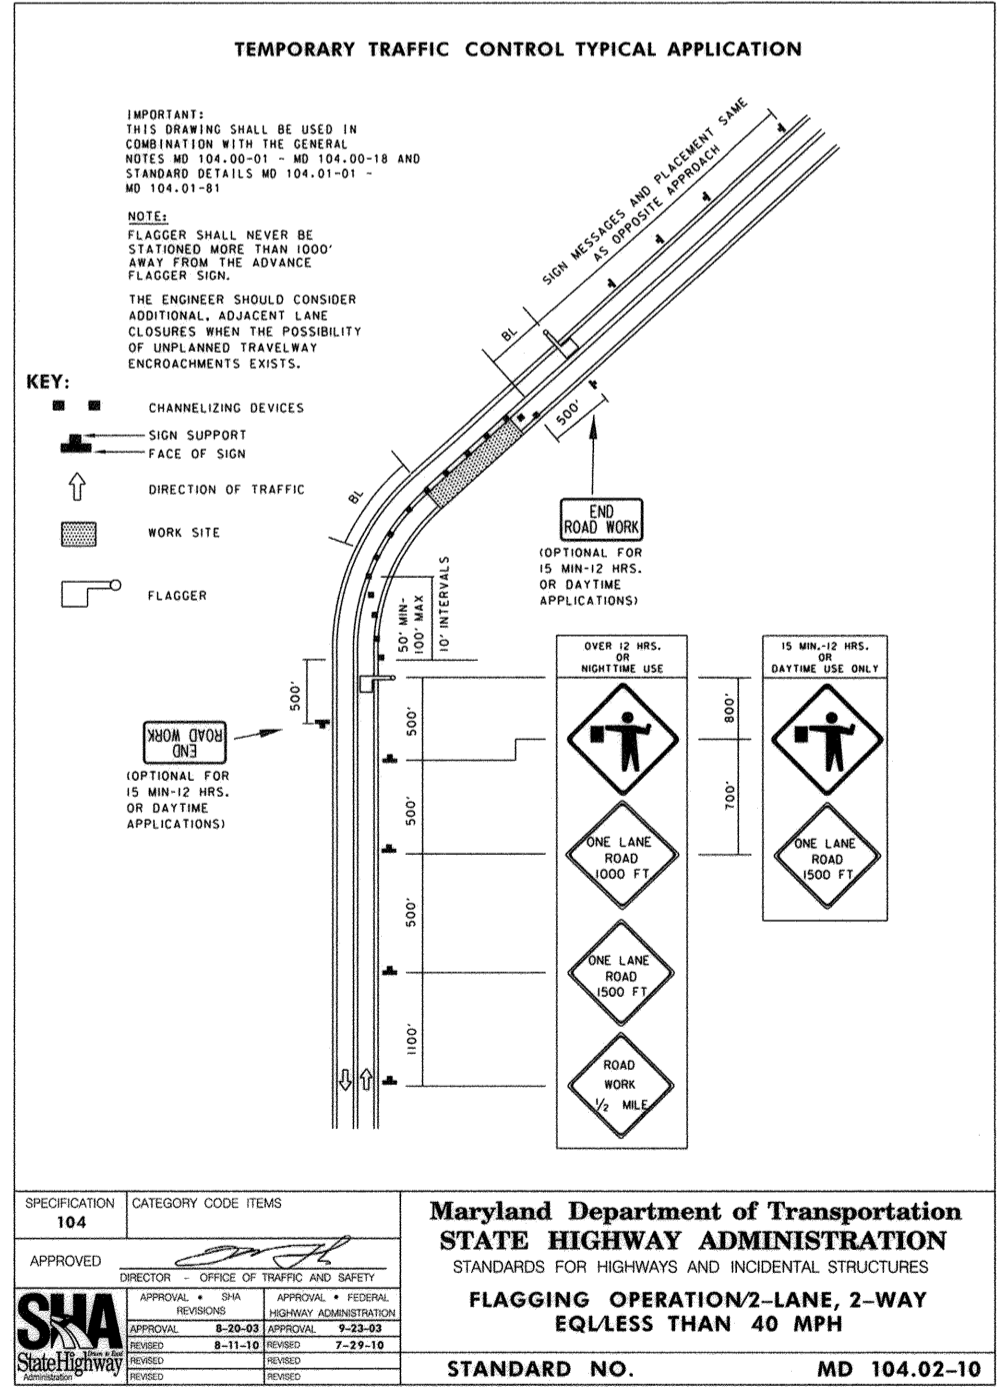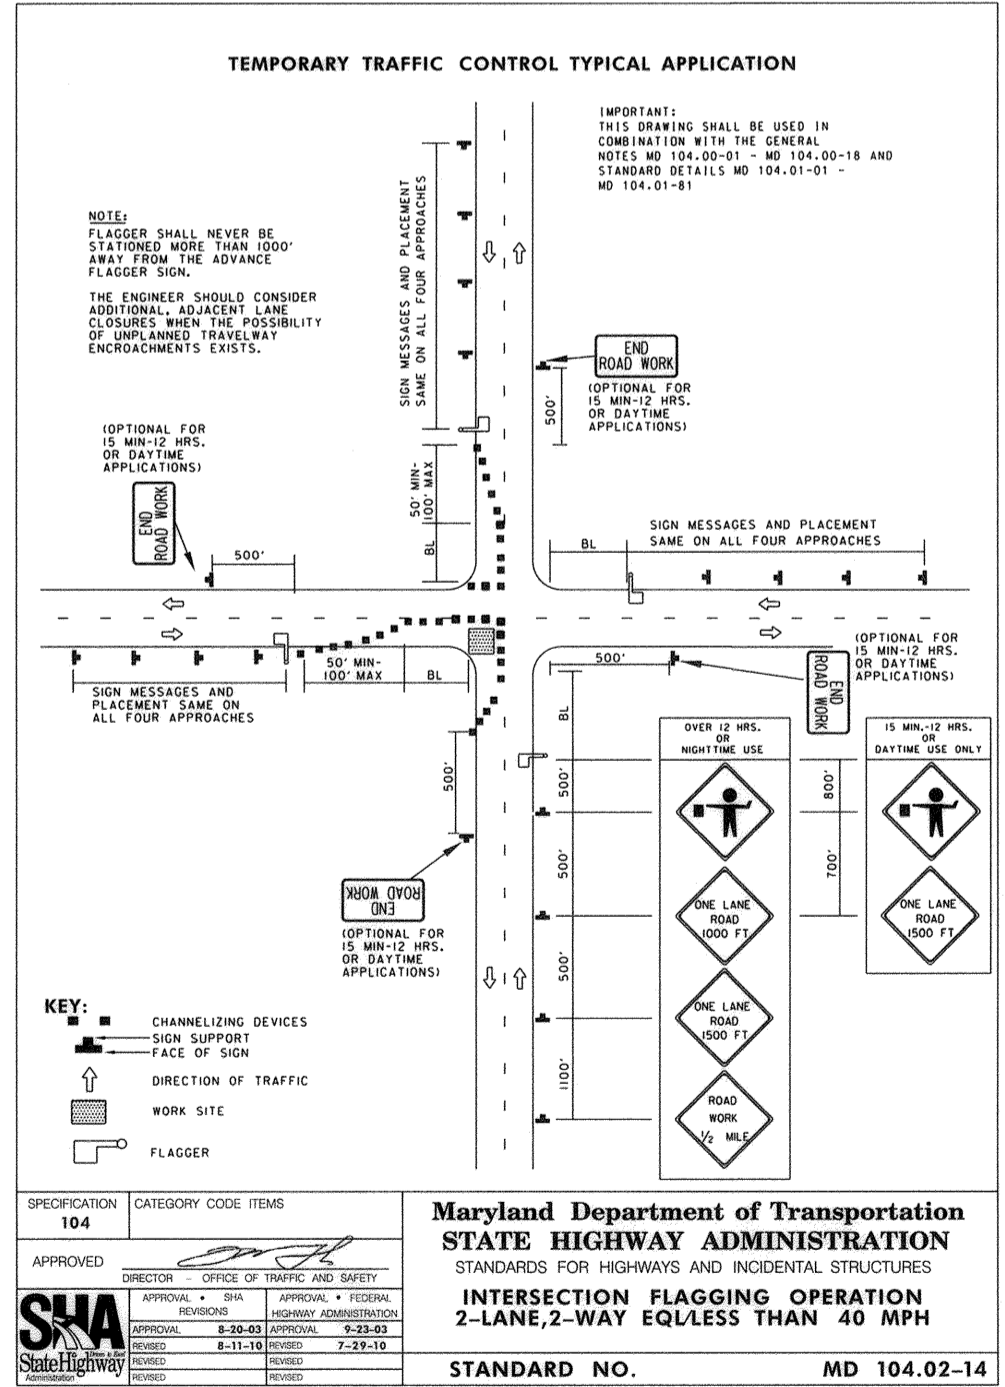

PROFESSIONAL CERTIFICATION. I hereby certify that these documents were prepared or approved by me, and that I am a duly licensed professional engineer under the laws of the State of Maryland, License No. 31363, Expiration Date 1/16/2020.

AS-BUILT
DATE 03-10-2020

MFD 01-2019-1420m User: henneladon
 M:\2019\13122677_47\Drawings\C-03 TEMPORARY WATER.dwg

DEPARTMENT OF PUBLIC WORKS HOWARD COUNTY, MARYLAND Director: <i>[Signature]</i> 3/6/19 DATE: 3-6-19 CHIEF, BUREAU OF UTILITIES		ENGINEERS PLANNERS SCIENTISTS CONSTRUCTION MANAGERS KCI TECHNOLOGIES 936 Rotelbrook Road Sparks, MD 21152 Phone: (410) 316-7800 Fax: (410) 316-7817 www.kci.com		STATE OF MARYLAND PROFESSIONAL ENGINEER No. 31363 03/01/2019		DES: CB, KJ DRN: KJ CHK: GW DATE: MARCH 2019	
--	--	--	--	---	--	---	--


BY	NO.	REVISION	DATE

TEMPORARY WATER PLAN



**OLD LAWYERS HILL ROAD
 WATER SUPPLY MAIN REPLACEMENT**
 CAPITAL PROJECT No. W8327
 CONTRACT No. 44-5018
 ELECTION DISTRICT NO. 1 HOWARD COUNTY, MARYLAND

SCALE
AS SHOWN
SHEET
3 OF 8





KCI TECHNOLOGIES PROJECT No.: 13122677.47

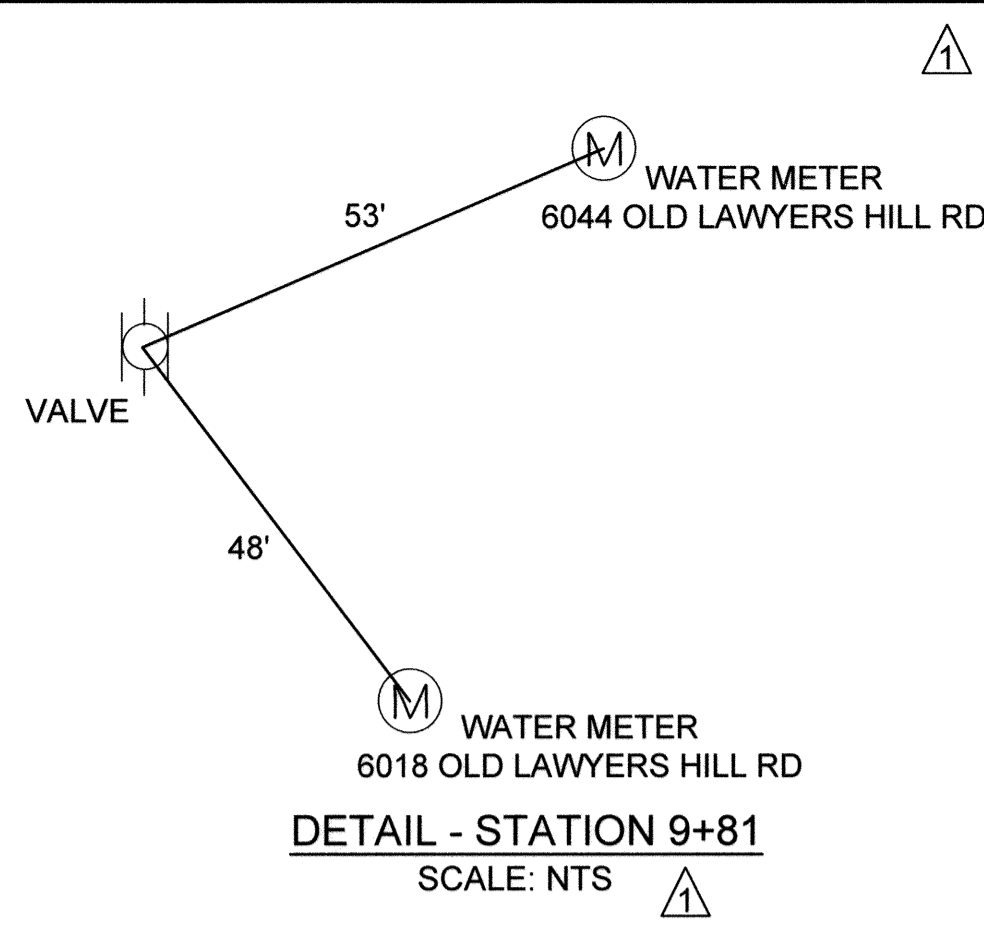

OLD LAWYERS HILL (W-8327, CONTRACT NO. 44-5018) TIES				
ADDRESS	LOCATION 1	MEASUREMENT	LOCATION 2	MEASUREMENT
6005 OLD LAWYERS HILL ROAD	WATER VALVE	54'	6001 METER PIT	104'
6001 OLD LAWYERS HILL ROAD	6005 METER PIT	104'	6011 METER PIT	40'
6011 OLD LAWYERS HILL ROAD	6005 METER PIT	40'	6014 METER PIT	46'
6014 OLD LAWYERS HILL ROAD	6011 METER PIT	46'	FH	92'
6018 OLD LAWYERS HILL ROAD	FH VALVE	109'	FH	107'
6036 OLD LAWYERS HILL ROAD	WATER VALVE	47'	6042 METER PIT	63'
6040 OLD LAWYERS HILL ROAD	WATER VALVE	52'	6036 METER PIT	63'
6044 OLD LAWYERS HILL ROAD	WATER VALVE	53'	6036 METER PIT	63'
6021 OLD LAWYERS HILL ROAD	WATER VALVE	101'	6017 METER PIT	7'
6017 OLD LAWYERS HILL ROAD	WATER VALVE	108'	6021 METER PIT	7'
6053 OLD LAWYERS HILL ROAD	FH	109'	FH VALVE	108'
6066 OLD LAWYERS HILL ROAD	FH VALVE	35'	FH	35'
6061 OLD LAWYERS HILL ROAD	FH	49'	FH	51'
6064 OLD LAWYERS HILL ROAD	6061 METER PIT	80'	6078 METER PIT	103'
6078 OLD LAWYERS HILL ROAD	6064 METER PIT	103'	6078 METER PIT	80'
6079 OLD LAWYERS HILL ROAD	6064 METER PIT	80'	6078 METER PIT	38'
6086 OLD LAWYERS HILL ROAD	FH VALVE	155'	FH VALVE	156'

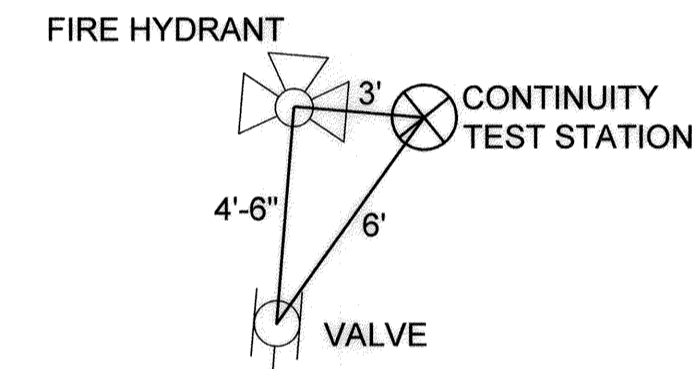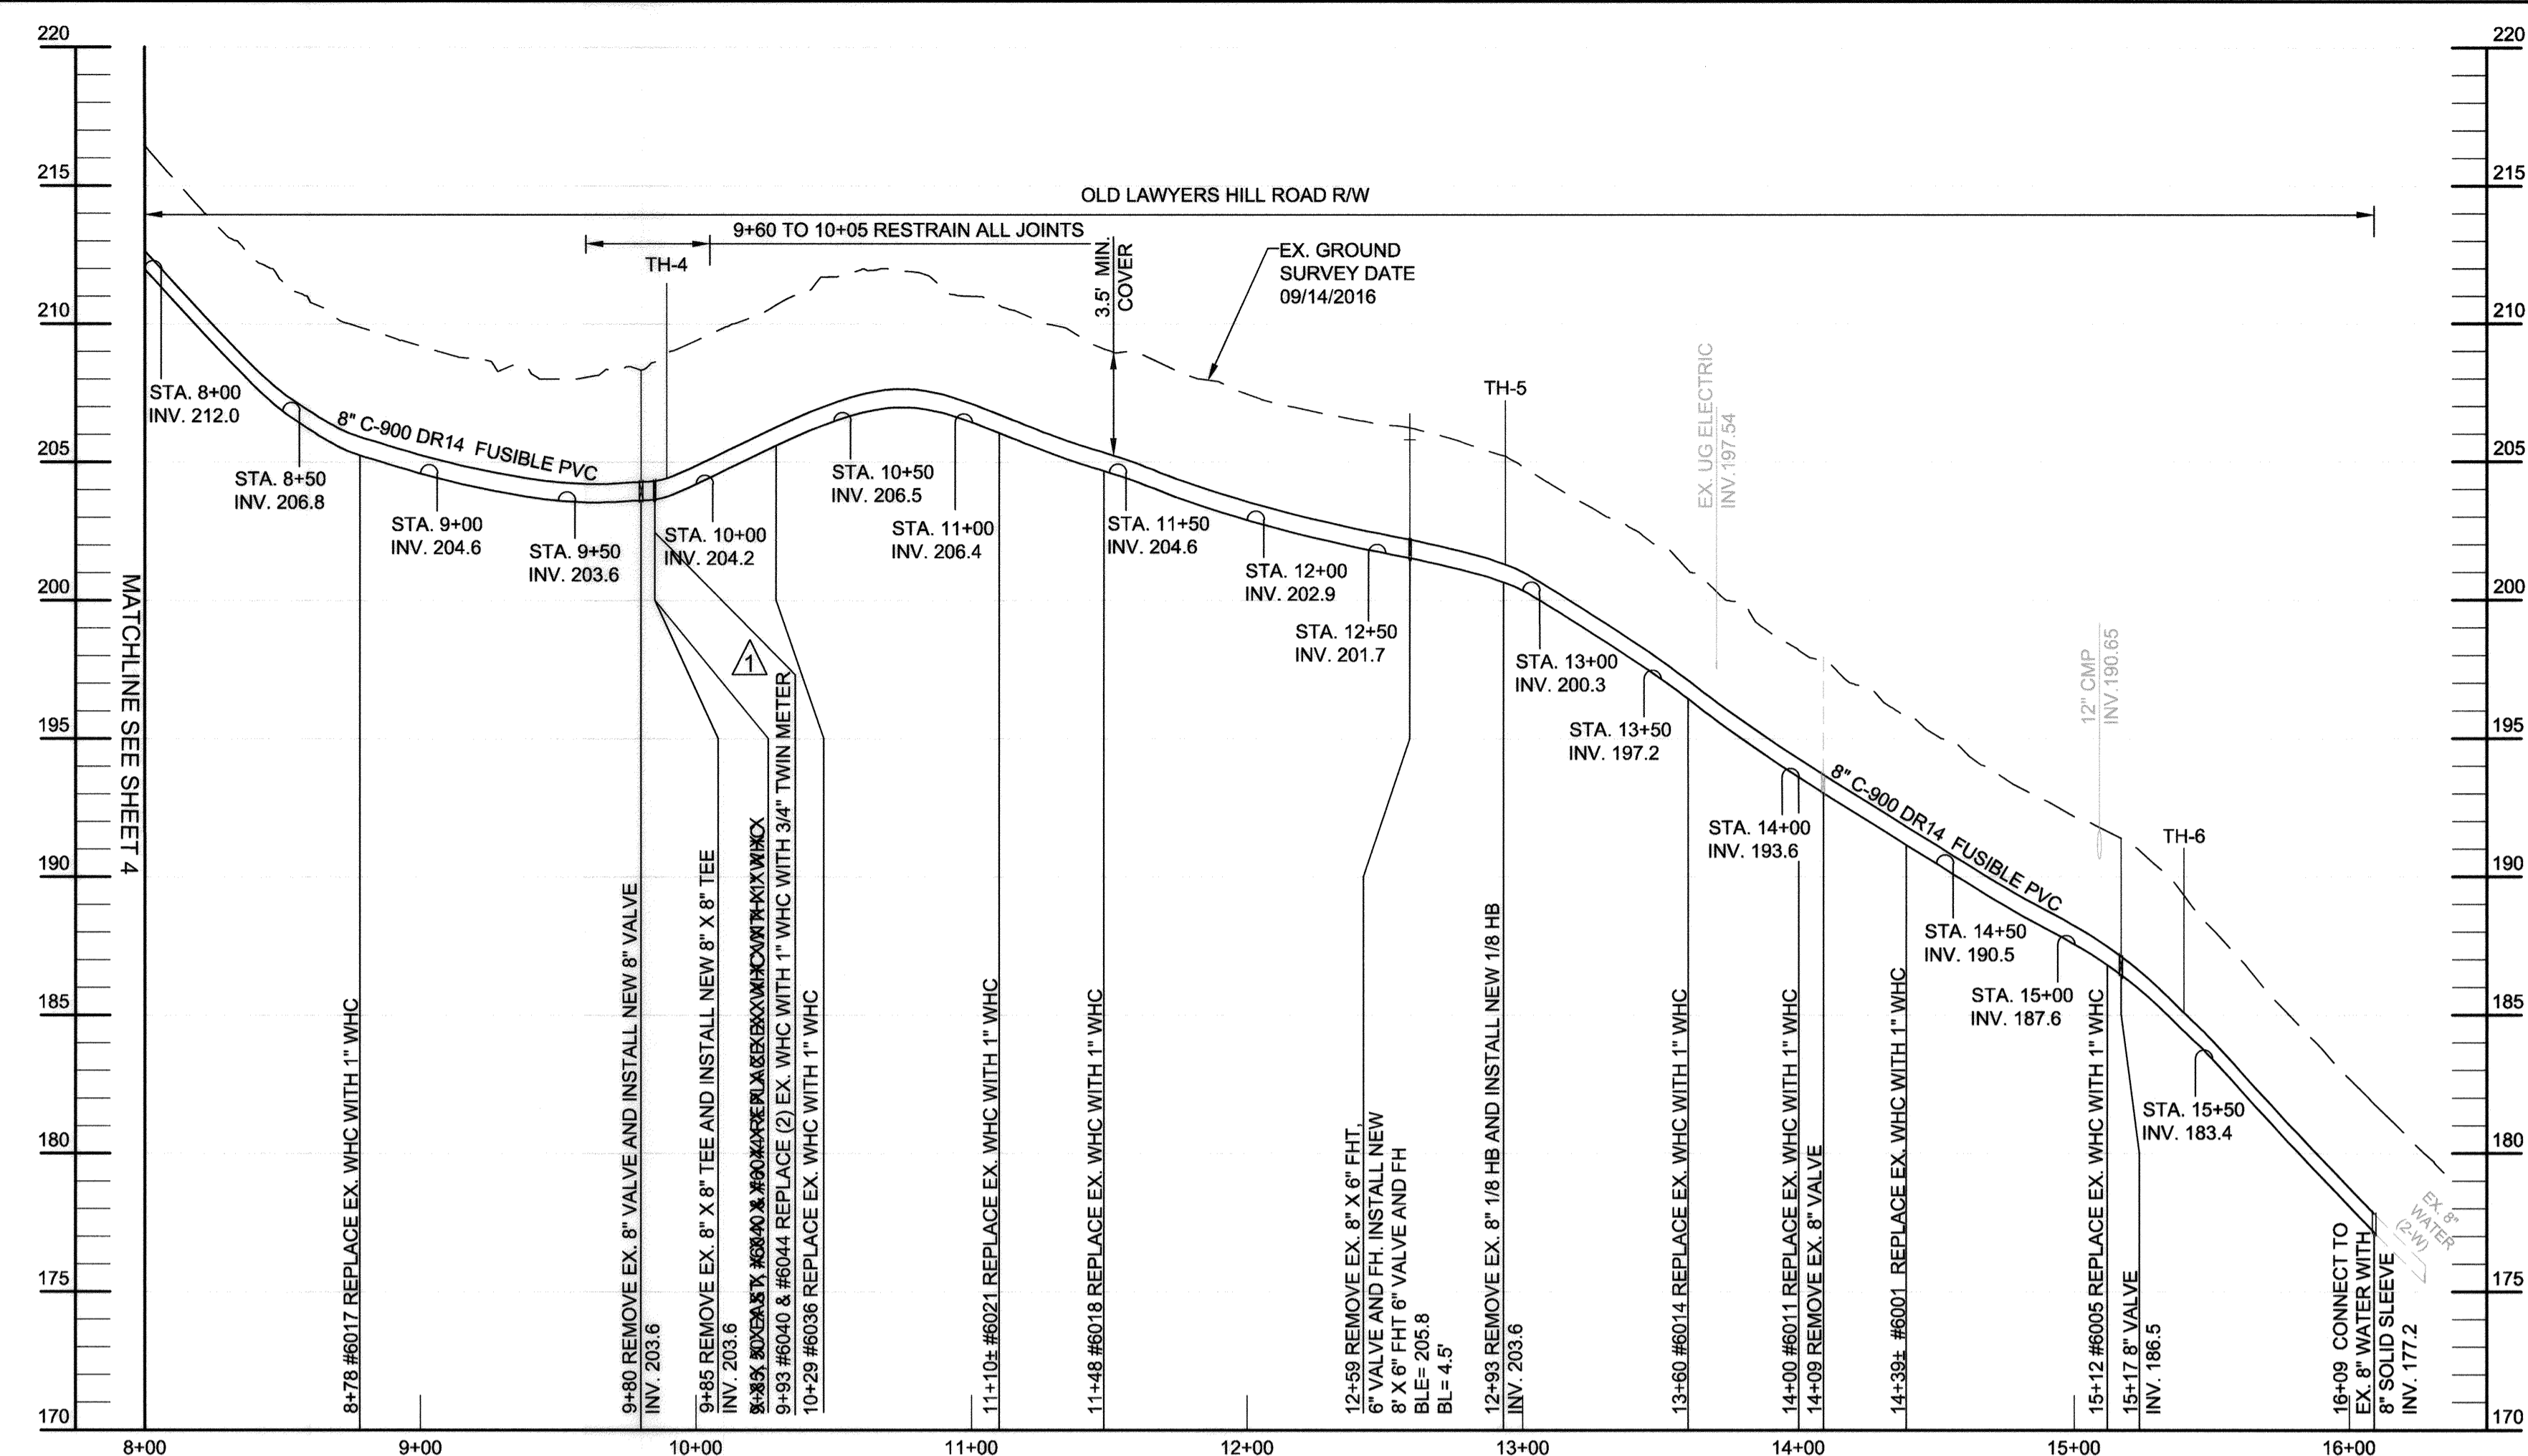

TEST HOLE TABLE			
NUMBER	UTILITY	GROUND ELEVATION	DEPTH TO TOP OF UTILITY
TH-4	8" WATER	208.91	4.64'
TH-5	8" WATER	205.16	3.82'
TH-6	8" WATER	189.30	4.28'

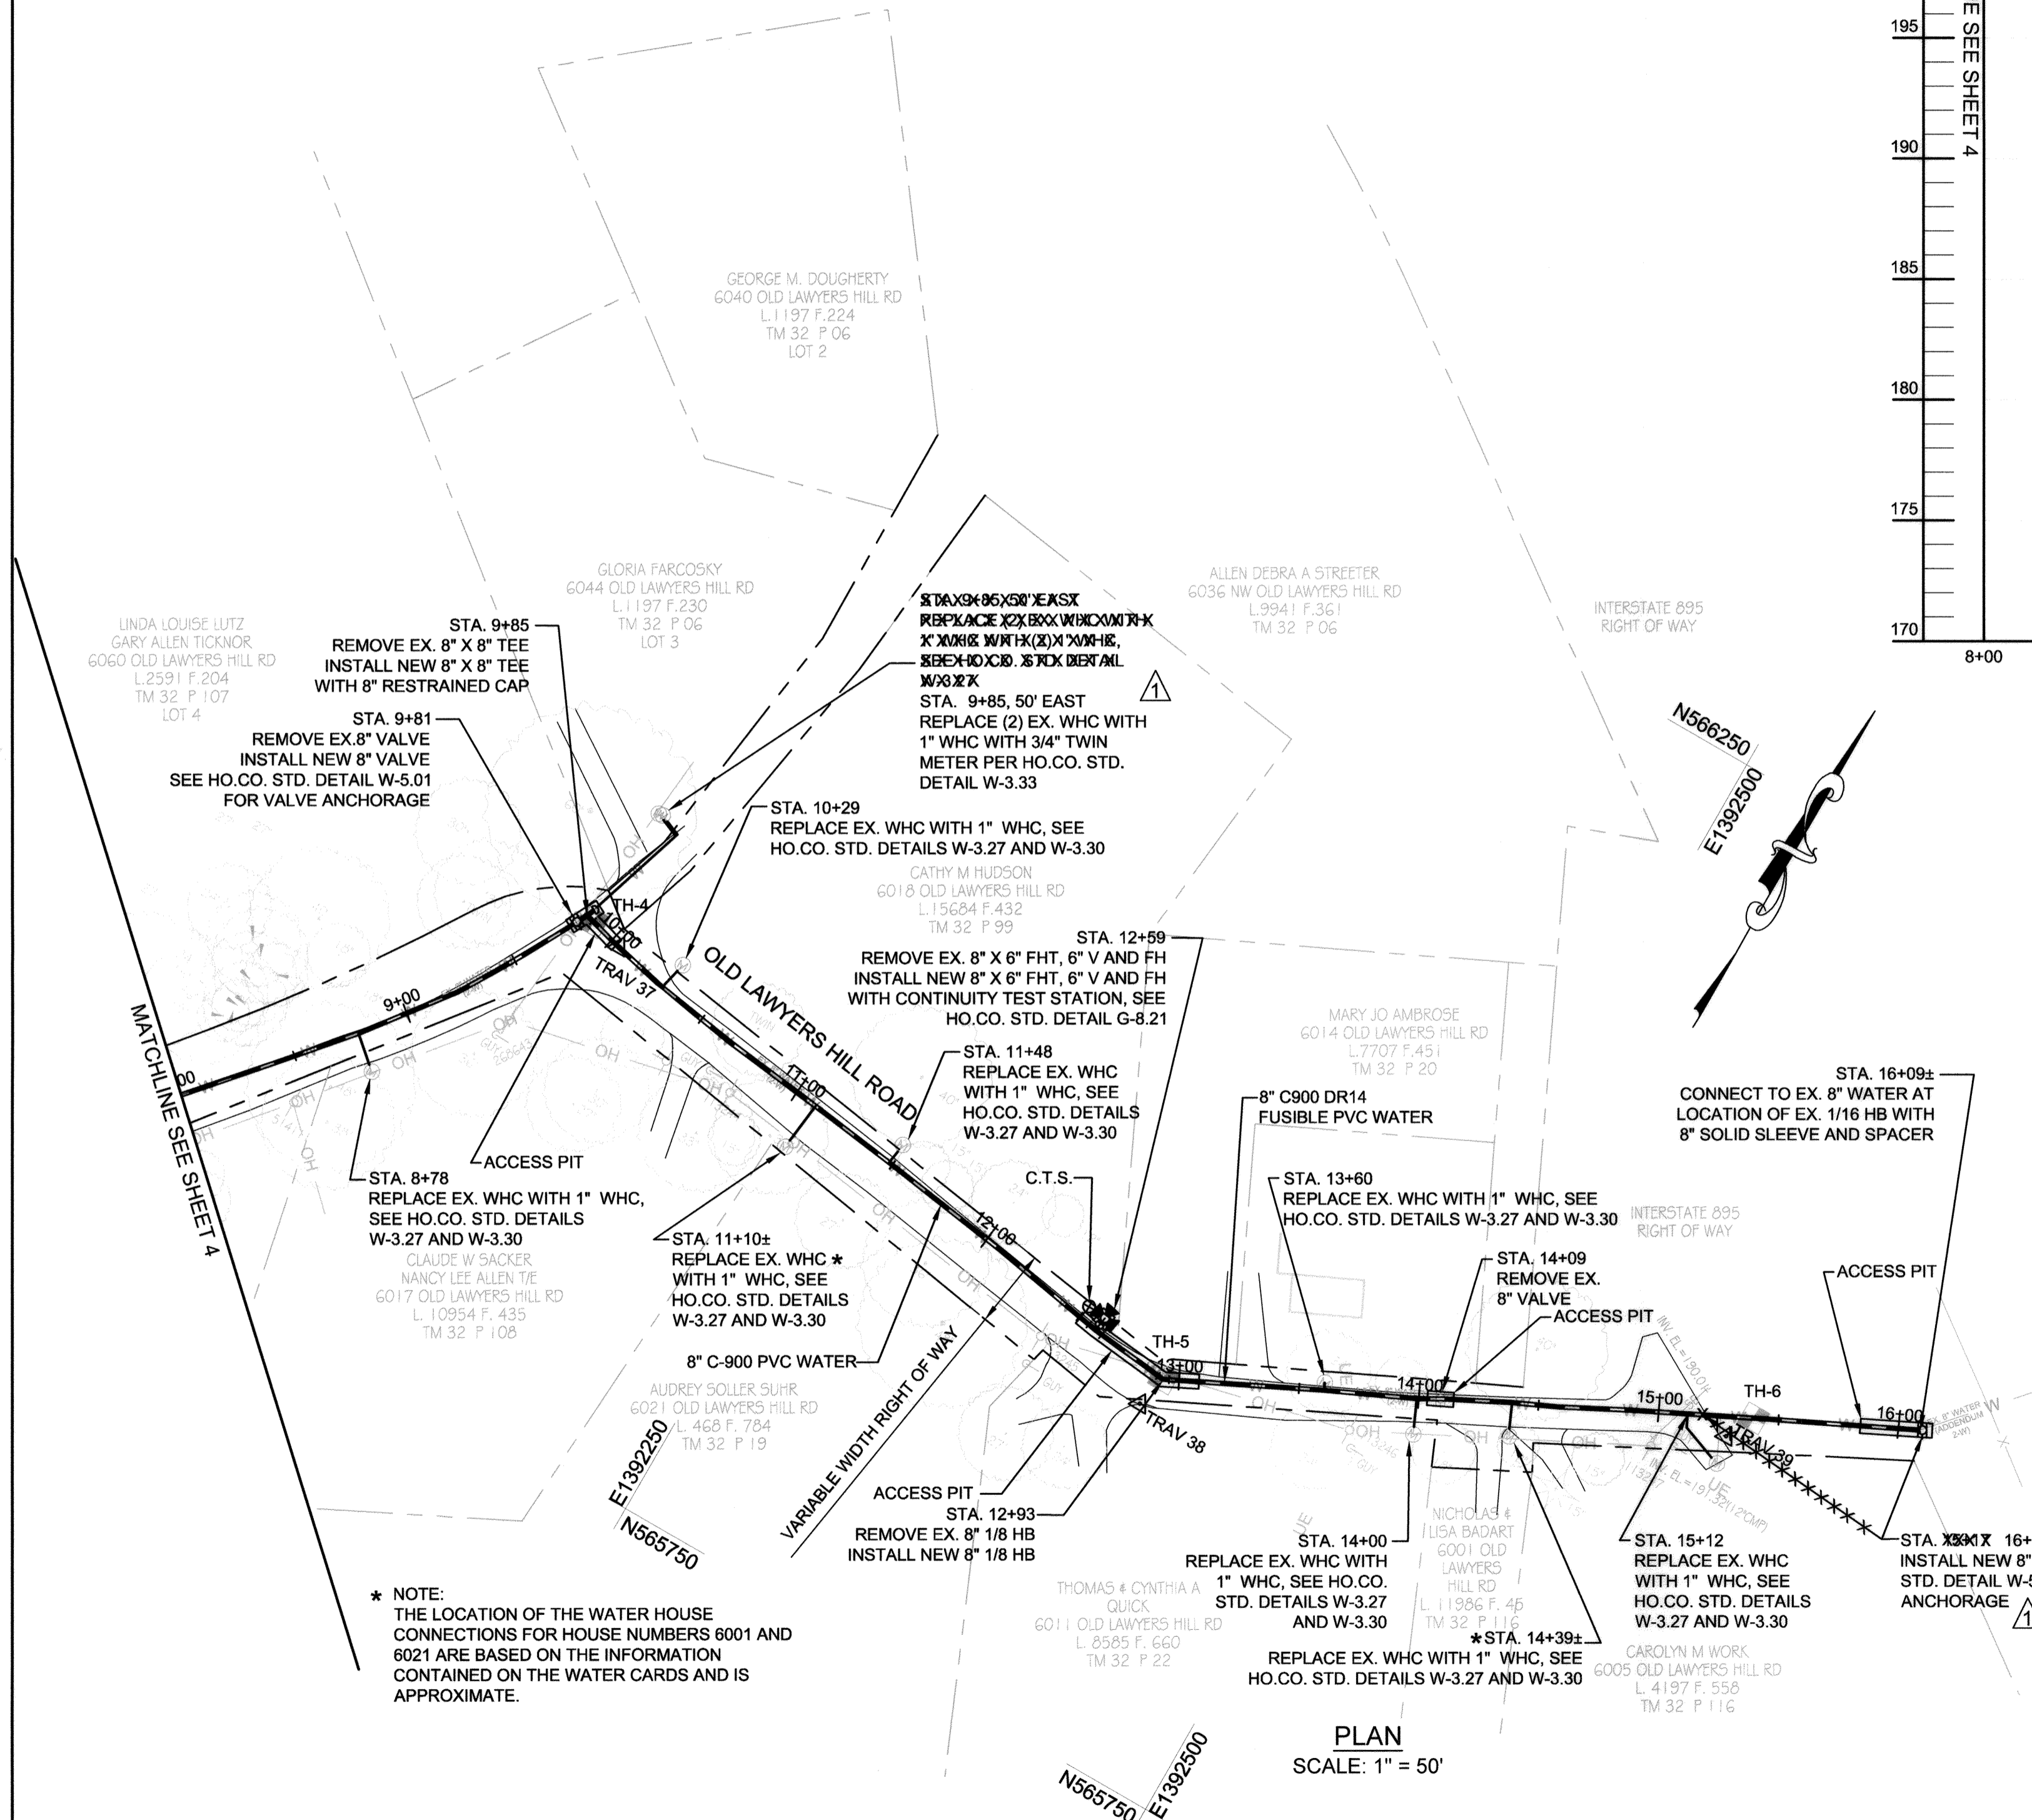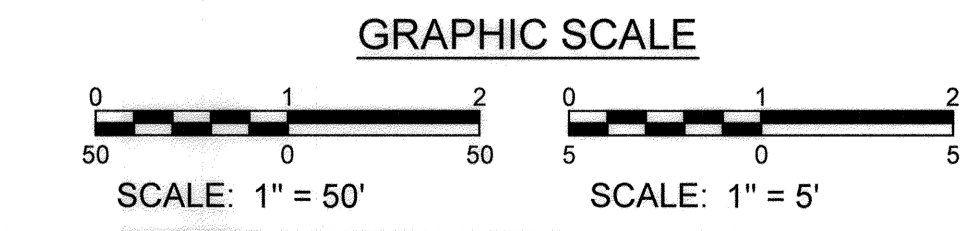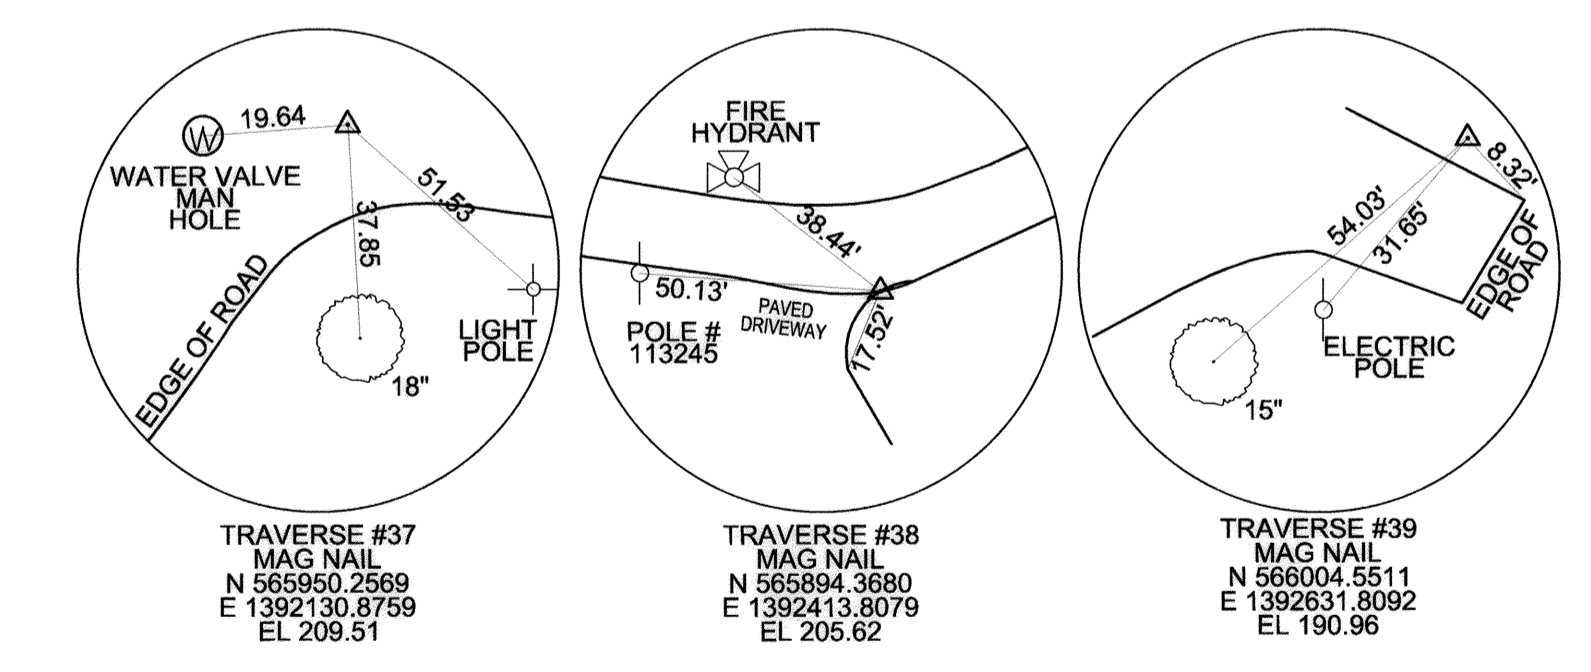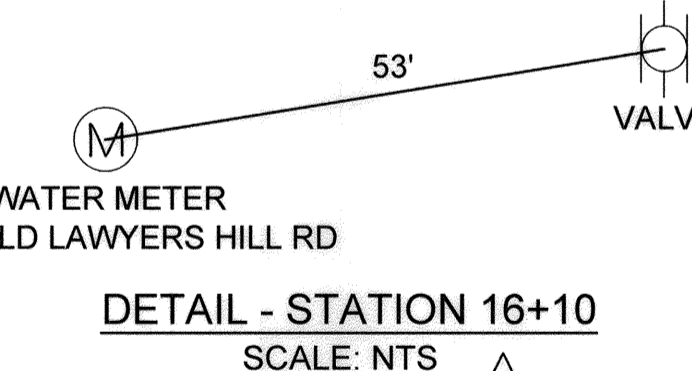

* NOTE:
THE LOCATION OF THE WATER HOUSE CONNECTIONS FOR HOUSE NUMBERS 6001 AND 6021 ARE BASED ON THE INFORMATION CONTAINED ON THE WATER CARDS AND IS APPROXIMATE.

PROFESSIONAL CERTIFICATION. I hereby certify that these documents were prepared or approved by me, and that I am a duly licensed professional engineer under the laws of the State of Maryland, License No. 31363, Expiration Date 1/16/2022.

Mar 13, 2020 - 9:33am User: Kevin Johnson K:\2019\13122677_2\Drawings\AS-BUILT WATER.dwg

DEPARTMENT OF PUBLIC WORKS HOWARD COUNTY, MARYLAND	
DIRECTOR OF PUBLIC WORKS	DATE
CHIEF, BUREAU OF ENGINEERING	DATE
CHIEF, BUREAU OF UTILITIES	DATE
CHIEF, UTILITY DESIGN DIVISION	DATE

KCI TECHNOLOGIES
ENGINEERS
PLANNERS
SCIENTISTS
CONSTRUCTION MANAGERS
936 Ridgely Road
Sparks, MD 21152
PHONE: (410) 316-7800
FAX: (410) 316-7817
www.kci.com

STATE OF MARYLAND
SULLIVAN WALKER
PROFESSIONAL ENGINEER
03/13/2020


DES: CB, KJ	
DRN: KJ	
CHK: GW	
DATE: MARCH 2020	
BY: [Signature]	NO. [Signature]
SPK: AS-BUILT	03/13/20
REVISION	DATE

WATER MAIN PLAN	
600' SCALE MAP NO. 32	BLOCK NO. 20.21

AS-BUILT REPLACEMENT SHEET	
OLD LAWYERS HILL ROAD WATER SUPPLY MAIN REPLACEMENT	
CAPITAL PROJECT No. W8327 CONTRACT No. 44-5018	
ELECTION DISTRICT NO. 1	HOWARD COUNTY, MARYLAND

SCALE AS SHOWN
SHEET 5 OF 8

KCI TECHNOLOGIES PROJECT NO.: 13122677.47

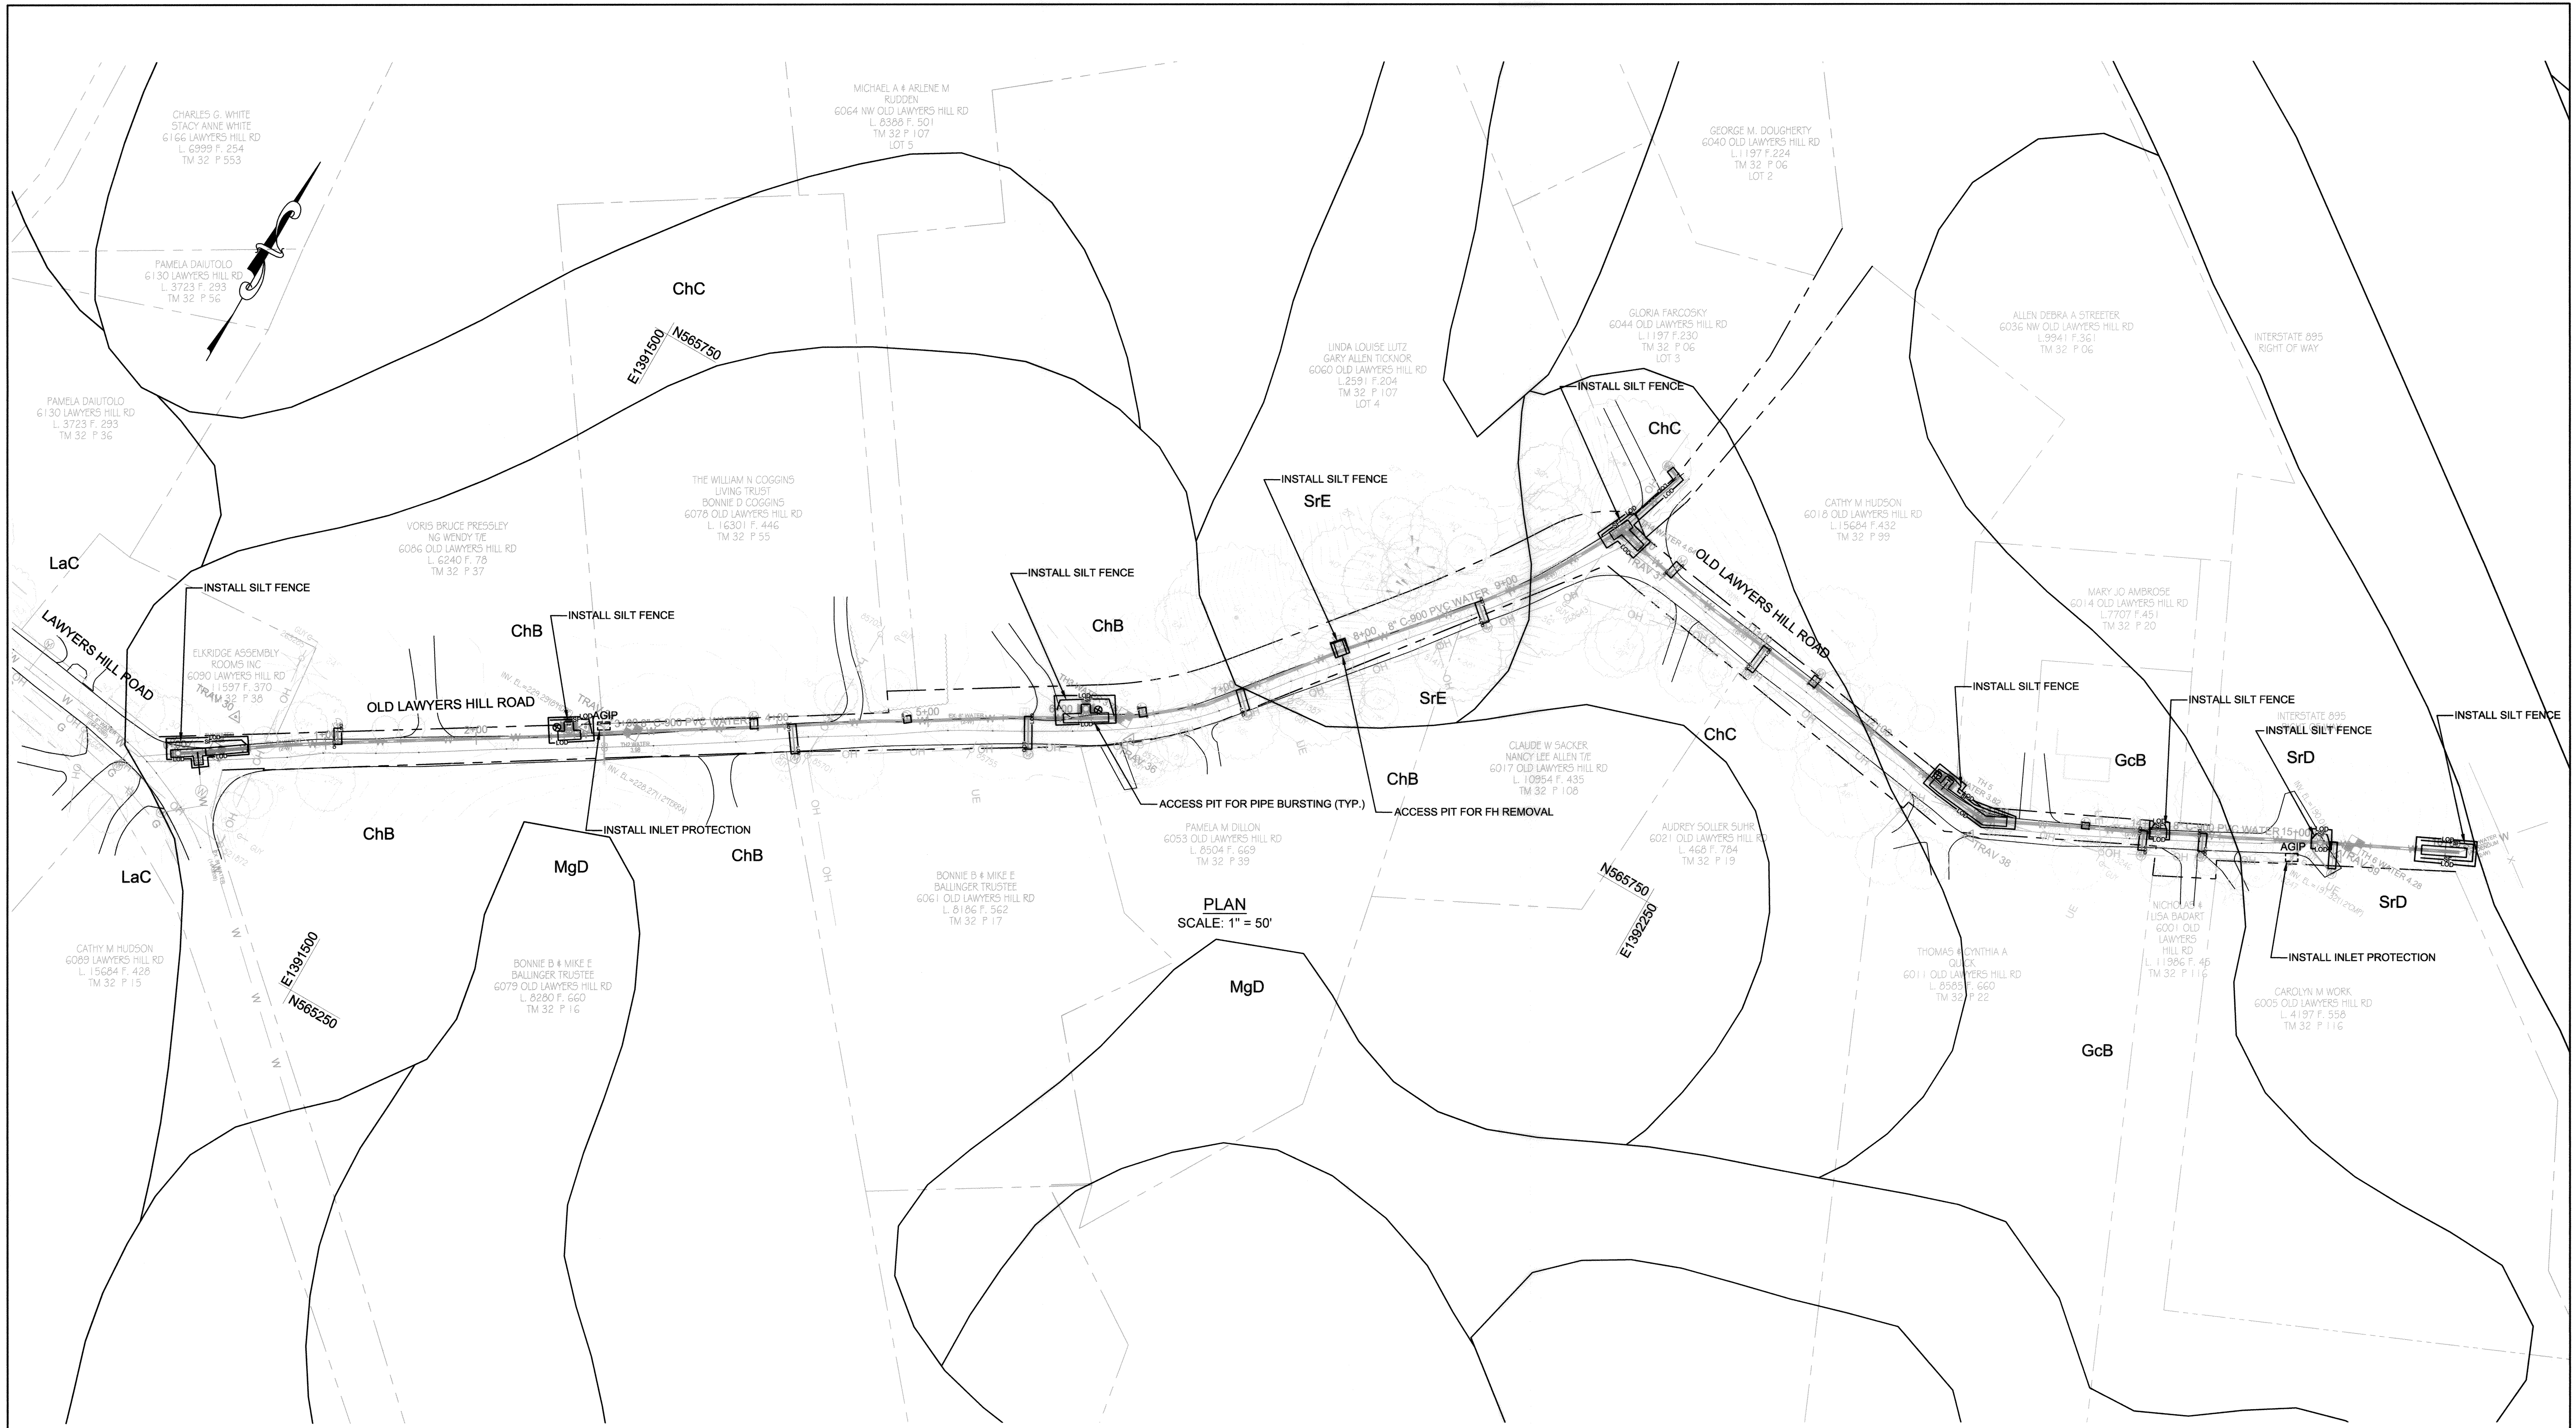


PLAN
SCALE: 1" = 50'

SOILS MAPPING UNITS

- ChB CHILLUM-RUSSET LOAMS, 2 TO 5 PERCENT SLOPES
- ChC CHILLUM-RUSSET LOAMS, 5 TO 10 PERCENT SLOPES
- GcB GLADSTONE-LEGORE COMPLEX, 3 TO 8 PERCENT SLOPES
- LaC LEGORE SILT LOAM, 8 TO 15 PERCENT SLOPES
- MgD MANOR-BANNERTON SANDY LOAMS, 15 TO 25 PERCENT SLOPES
- SrD SASSAFRAS AND CROOM SOILS, 10 TO 15 PERCENT SLOPES
- SrE SASSAFRAS AND CROOM SOILS, 15 TO 25 PERCENT SLOPES

GRAPHIC SCALE

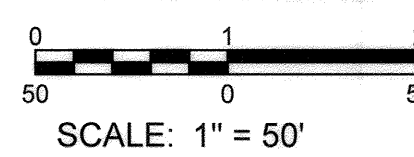

AS-BUILT

DATE 03-10-2020

PROFESSIONAL CERTIFICATION: I hereby certify that these documents were prepared or approved by me, and that I am a duly licensed professional engineer under the laws of the State of Maryland, License No. 31363, Expiration Date 1/16/2020.

Mar 01, 2019 1:42pm User: hennelackon M:\2019\13122677_47\Drawings\C08 ESC PLAN.dwg

DEPARTMENT OF PUBLIC WORKS
HOWARD COUNTY, MARYLAND

[Signature] 3/1/19
DIRECTOR OF PUBLIC WORKS DATE

[Signature] 3-6-19
CHIEF, BUREAU OF UTILITIES DATE


[Signature] 3-5-19
CHIEF, BUREAU OF ENGINEERING DATE

[Signature] 3/5/19
CHIEF, UTILITY DESIGN DIVISION DATE

KCI TECHNOLOGIES

ENGINEERS
PLANNERS
SCIENTISTS
CONSTRUCTION MANAGERS

936 Rotelbrook Road
Sparks, MD 21152
Phone: (410) 316-7800
Fax: (410) 316-7817
www.kci.com

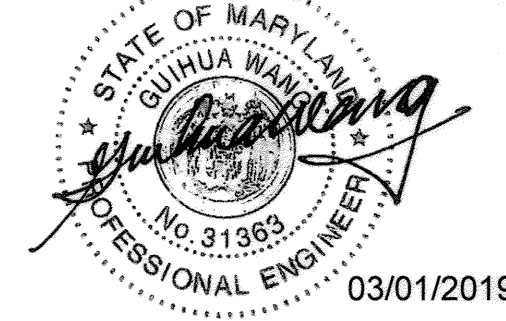

DES: CB, KJ					
DRN: KJ					
CHK: GW					
DATE: MARCH 2019	BY	NO.	REVISION	DATE	

EROSION AND SEDIMENT CONTROL PLAN

**OLD LAWYERS HILL ROAD
WATER SUPPLY MAIN REPLACEMENT**

CAPITAL PROJECT No. W8327
CONTRACT No. 44-5018
ELECTION DISTRICT NO. 1
HOWARD COUNTY, MARYLAND

SCALE
AS SHOWN

SHEET
6 OF 8

**HOWARD SOIL CONSERVATION DISTRICT (HSCD)
STANDARD SEDIMENT CONTROL NOTES**

- A pre-construction meeting must occur with the Howard County Department of Public Works, Construction Inspection Division (CID), 410-313-1855 after the future LOD and protected areas are marked clearly in the field. A minimum of 48 hour notice to CID must be given at the following stages:
 - Prior to the start of earth disturbance.
 - Upon completion of the installation of perimeter erosion and sediment controls, but before proceeding with any other earth disturbance or grading.
 - Prior to the start of another phase of construction or opening of another grading unit.
 - Prior to the removal or modification of sediment control practices.

Other building or grading inspection approvals may not be authorized until this initial approval by the inspection agency is made. Other related state and federal permits shall be referenced, to ensure coordination and to avoid conflicts with this plan.

- All vegetative and structural practices are to be installed according to the provisions of this plan and are to be in conformance with the 2011 MARYLAND STANDARDS AND SPECIFICATIONS FOR SOIL EROSION AND SEDIMENT CONTROL, and revisions thereto.
- Following initial soil disturbance or re-disturbance, permanent or temporary stabilization is required within three (3) calendar days as to the surface of all perimeter controls, dikes, swales, ditches, perimeter slopes, and all slopes steeper than 3 horizontal to 1 vertical (3:1); and seven (7) calendar days as to all other disturbed areas on the project site except for those areas under active grading.
- All disturbed areas must be stabilized within the time period specified above in accordance with the 2011 MARYLAND STANDARDS AND SPECIFICATIONS FOR SOIL EROSION AND SEDIMENT CONTROL for topsoil (Sec. B-4-2), permanent seeding (Sec. B-4-5), temporary seeding (Sec. B-4-4) and mulching (Sec. B-4-3). Temporary stabilization with mulch alone can only be applied between the fall and spring seeding dates if the ground is frozen. Incremental stabilization (Sec. B-4-1) specifications shall be enforced in areas with >15' of cut and/or fill. Stockpiles (Sec. B-4-8) in excess of 20 ft. must be benched with stable outlet. All concentrated flow, steep slope, and highly erodible areas shall receive soil stabilization matting (Sec. B-4-6).
- All sediment control structures are to remain in place, and are to be maintained in operative condition until permission for their removal has been obtained from the CID.
- Site Analysis:

Total Area of Site:	0.554	Acres
Area Disturbed:	0.127	Acres
Area to be roofed or paved:	0.066	Acres
Area to be vegetatively stabilized:	0.061	Acres
Total Cut:	191	Cu. Yds.
Total Fill:	191	Cu. Yds.
Offsite waste/borrow area location:	N/A	
- Any sediment control practice which is disturbed by grading activity for placement of utilities must be repaired on the same day of disturbance.
- Additional sediment control must be provided, if deemed necessary by the CID. The site and all controls shall be inspected by the contractor weekly; and the next day after each rain event. A written report by the contractor, made available upon request, is part of every inspection and should include:
 - Inspection date
 - Inspection type (routine, pre-storm event, during rain event)
 - Name and title of inspector
 - Weather information (current conditions as well as time and amount of last recorded precipitation)
 - Brief description of project's status (e.g., percent complete) and/or current activities
 - Evidence of sediment discharges
 - Identification of plan deficiencies
 - Identification of sediment controls that require maintenance
 - Identification of missing or improperly installed sediment controls
 - Compliance status regarding the sequence of construction and stabilization requirements
 - Photographs
 - Monitoring/sampling
 - Maintenance and/or corrective action performed
 - Other inspection items as required by the General Permit for Stormwater Associated with Construction Activities (NPDES, MDE).

- Trenches for the construction of utilities is limited to three pipe lengths or that which can and shall be back-filled and stabilized by the end of each workday, whichever is shorter.
- Any major changes or revisions to the plan or sequence of construction must be reviewed and approved by the HSCD prior to proceeding with construction. Minor revisions may be allowed by the CID per the list of HSCD-approved field changes.
- Disturbance shall not occur outside the L.O.D. A project is to be sequenced so that grading activities begin on one grading unit (maximum acreage of 20 ac. per grading unit) at a time. Work may proceed to a subsequent grading unit when at least 50 percent of the disturbed area in the preceding grading unit has been stabilized and approved by the HSCD. Unless otherwise specified and approved by the HSCD, no more than 30 acres cumulatively may be disturbed at a given time.
- Wash water from any equipment, vehicles, wheels, pavement, and other sources must be treated in a sediment basin or other approved washout structure.
- Topsoil shall be stockpiled and preserved on-site for redistribution onto final grade.
- All Silt Fence and Super Silt Fence shall be placed on-the-contour, and be imbricated at 25' minimum intervals, with lower ends curled uphill by 2' in elevation.
- Stream channels must not be disturbed during the following restricted time periods (inclusive):
 - Use I and IP March 1 - June 15
 - Use III and IIIIP October 1 - April 30
 - Use IV March 1 - May 31
- A copy of this plan, the 2011 MARYLAND STANDARDS AND SPECIFICATIONS FOR SOIL EROSION AND SEDIMENT CONTROL, and associated permits shall be on-site and available when the site is active.

SEQUENCE OF CONSTRUCTION

- OBTAIN GRADING PERMIT.
- REQUEST PRE-CONSTRUCTION MEETING ON-SITE WITH REPRESENTATIVE OF HOWARD COUNTY CONSTRUCTION & INSPECTION DIVISION.
- LAYOUT ALIGNMENT AT SITE. (2 DAYS)
- THE CONTRACTOR SHALL INSTALL SEDIMENT CONTROL DEVICES PER THE "HOWARD SOIL CONSERVATION DISTRICT STANDARD EROSION & SEDIMENT CONTROL PLAN FOR EARTH DISTURBANCES BETWEEN 5,000 SF AND 30'000 SF.
- INSTALL TEMPORARY WATER AND CONNECT TO EXISTING WATER SERVICES AS SHOWN ON THE PLANS.
- EXCAVATE ACCESS PITS TO THE GRADE NECESSARY, INSTALL WATER MAIN, BACKFILL ACCESS PITS, STABILIZE / RESURFACE AS APPROPRIATE (30 DAYS). ALL VEGETATED AREAS DISTURBED DURING THE COURSE OF CONSTRUCTION SHALL BE TEMPORARILY STABILIZED IN ACCORDANCE WITH THE TEMPORARY SEEDING SUMMARY SHOWN ON SHEET 6 OF 6 AND THE 2011 MARYLAND STANDARDS AND SPECIFICATIONS FOR SOIL EROSION AND SEDIMENT CONTROL, SECTION B-4-4. AT THE END OF EACH WORKING DAY ALL DISTURBED PAVING AREAS WITHIN THE EXISTING ROAD SHALL BE PLATED UNTIL ACCESS PIT WORK IS COMPLETED AND CAN BE BACKFILLED, REPLACED WITH PERMANENT SUBGRADE AND BASE ASPHALT, THEN TEMPORARILY PATCHED, SEE TEMPORARY PAVING DETAIL ON SHEET 2.
- UPON COMPLETION OF PIPE BURSTING OPERATION AND INSPECTOR'S APPROVAL, PERMANENTLY STABILIZE ALL DISTURBED VEGETATED AREAS IN ACCORDANCE WITH STANDARDS AND SPECIFICATIONS FOR PERMANENT STABILIZATION SHOWN ON SHEET 6 OF 6 AND THE 2011 MARYLAND STANDARDS AND SPECIFICATIONS FOR SOIL EROSION AND SEDIMENT CONTROL, SECTION B-4-5.
- CLEAN UP CONSTRUCTION SITE. (1 DAY)
- REMOVE SEDIMENT CONTROL DEVICES AFTER PERMISSION IS GRANTED BY THE HOWARD COUNTY INSPECTOR. (1 DAY)

KCI TECHNOLOGIES PROJECT No.: 13122677.47

DETAIL E-9-2 AT-GRADE INLET PROTECTION	STANDARD SYMBOL AGIP
---	-------------------------

CONSTRUCTION SPECIFICATIONS

- USE NONWOVEN GEOTEXTILE AS SPECIFIED IN SECTION H-1 MATERIALS.
- LIFT GRATE AND WRAP WITH NONWOVEN GEOTEXTILE TO COMPLETELY COVER ALL OPENINGS. SECURE WITH WIRE TIES AND SET GRATE BACK IN PLACE.
- PLACE CLEAN 3/4 TO 1 1/2 INCH STONE OR EQUIVALENT RECYCLED CONCRETE 6 INCHES THICK ON THE GRATE.
- STORM DRAIN INLET PROTECTION REQUIRES FREQUENT MAINTENANCE. REMOVE ACCUMULATED SEDIMENT AFTER EACH RAIN EVENT TO MAINTAIN FUNCTION AND AVOID PREMATURE CLOGGING. IF INLET PROTECTION DOES NOT COMPLETELY DRAIN WITHIN 24 HOURS AFTER A STORM EVENT, IT IS CLOGGED, WHEN THIS OCCURS, REMOVE ACCUMULATED SEDIMENT AND CLEAN, OR REPLACE GEOTEXTILE AND STONE.

MARYLAND STANDARDS AND SPECIFICATIONS FOR SOIL EROSION AND SEDIMENT CONTROL	2011	MARYLAND DEPARTMENT OF ENVIRONMENT WATER MANAGEMENT ADMINISTRATION
U.S. DEPARTMENT OF AGRICULTURE NATURAL RESOURCES CONSERVATION SERVICE		

DETAIL E-1 SILT FENCE	STANDARD SYMBOL SF
------------------------------	-----------------------

CONSTRUCTION SPECIFICATIONS

- USE WOOD POSTS 1 1/4 X 1 1/4 ± 1/8 INCH (MINIMUM) SQUARE CUT OF SOUND QUALITY HARDWOOD. AS AN ALTERNATIVE TO WOODEN POST USE STANDARD "T" OR "U" SECTION STEEL POSTS WEIGHING NOT LESS THAN 1 POUND PER LINEAR FOOT.
- USE 36 INCH MINIMUM POSTS DRIVEN 16 INCH MINIMUM INTO GROUND NO MORE THAN 6 FEET APART.
- USE WOVEN SLIT FILM GEOTEXTILE AS SPECIFIED IN SECTION H-1 MATERIALS AND FASTEN GEOTEXTILE SECURELY TO UPSLOPE SIDE OF FENCE POSTS WITH WIRE TIES OR STAPLES AT TOP AND MID-SECTION.
- PROVIDE MANUFACTURER CERTIFICATION TO THE AUTHORIZED REPRESENTATIVE OF THE INSPECTION/ENFORCEMENT AUTHORITY SHOWING THAT THE GEOTEXTILE USED MEETS THE REQUIREMENTS IN SECTION H-1 MATERIALS.
- EMBED GEOTEXTILE A MINIMUM OF 8 INCHES VERTICALLY INTO THE GROUND. BACKFILL AND COMPACT THE SOIL ON BOTH SIDES OF FABRIC.
- WHERE TWO SECTIONS OF GEOTEXTILE ADJOIN: OVERLAP, TWIST, AND STAPLE TO POST IN ACCORDANCE WITH THIS DETAIL.
- EXTEND BOTH ENDS OF THE SILT FENCE A MINIMUM OF FIVE HORIZONTAL FEET UPSLOPE AT 45 DEGREES TO THE MAIN FENCE ALIGNMENT TO PREVENT RUNOFF FROM GOING AROUND THE ENDS OF THE SILT FENCE.
- REMOVE ACCUMULATED SEDIMENT AND DEBRIS WHEN BULGES DEVELOP IN SILT FENCE OR WHEN SEDIMENT REACHES 25% OF FENCE HEIGHT. REPLACE GEOTEXTILE IF TORN. IF UNDERMINING OCCURS, REINSTALL FENCE.

JOINING TWO ADJACENT SILT FENCE SECTIONS (TOP VIEW)

1 OF 2

MARYLAND STANDARDS AND SPECIFICATIONS FOR SOIL EROSION AND SEDIMENT CONTROL	2011	MARYLAND DEPARTMENT OF ENVIRONMENT WATER MANAGEMENT ADMINISTRATION
U.S. DEPARTMENT OF AGRICULTURE NATURAL RESOURCES CONSERVATION SERVICE		

DETAIL E-1 SILT FENCE	STANDARD SYMBOL SF
------------------------------	-----------------------

CONSTRUCTION SPECIFICATIONS

- USE WOOD POSTS 1 1/4 X 1 1/4 ± 1/8 INCH (MINIMUM) SQUARE CUT OF SOUND QUALITY HARDWOOD. AS AN ALTERNATIVE TO WOODEN POST USE STANDARD "T" OR "U" SECTION STEEL POSTS WEIGHING NOT LESS THAN 1 POUND PER LINEAR FOOT.
- USE 36 INCH MINIMUM POSTS DRIVEN 16 INCH MINIMUM INTO GROUND NO MORE THAN 6 FEET APART.
- USE WOVEN SLIT FILM GEOTEXTILE AS SPECIFIED IN SECTION H-1 MATERIALS AND FASTEN GEOTEXTILE SECURELY TO UPSLOPE SIDE OF FENCE POSTS WITH WIRE TIES OR STAPLES AT TOP AND MID-SECTION.
- PROVIDE MANUFACTURER CERTIFICATION TO THE AUTHORIZED REPRESENTATIVE OF THE INSPECTION/ENFORCEMENT AUTHORITY SHOWING THAT THE GEOTEXTILE USED MEETS THE REQUIREMENTS IN SECTION H-1 MATERIALS.
- EMBED GEOTEXTILE A MINIMUM OF 8 INCHES VERTICALLY INTO THE GROUND. BACKFILL AND COMPACT THE SOIL ON BOTH SIDES OF FABRIC.
- WHERE TWO SECTIONS OF GEOTEXTILE ADJOIN: OVERLAP, TWIST, AND STAPLE TO POST IN ACCORDANCE WITH THIS DETAIL.
- EXTEND BOTH ENDS OF THE SILT FENCE A MINIMUM OF FIVE HORIZONTAL FEET UPSLOPE AT 45 DEGREES TO THE MAIN FENCE ALIGNMENT TO PREVENT RUNOFF FROM GOING AROUND THE ENDS OF THE SILT FENCE.
- REMOVE ACCUMULATED SEDIMENT AND DEBRIS WHEN BULGES DEVELOP IN SILT FENCE OR WHEN SEDIMENT REACHES 25% OF FENCE HEIGHT. REPLACE GEOTEXTILE IF TORN. IF UNDERMINING OCCURS, REINSTALL FENCE.

2 OF 2

MARYLAND STANDARDS AND SPECIFICATIONS FOR SOIL EROSION AND SEDIMENT CONTROL	2011	MARYLAND DEPARTMENT OF ENVIRONMENT WATER MANAGEMENT ADMINISTRATION
U.S. DEPARTMENT OF AGRICULTURE NATURAL RESOURCES CONSERVATION SERVICE		

PROFESSIONAL CERTIFICATION: I hereby certify that these documents were prepared or approved by me, and that I am a duly licensed professional engineer under the laws of the State Of Maryland, License No. 31363, Expiration Date 1/18/2020.

AS-BUILT
DATE 03-10-2020

Mar 01, 2019 - 1:42pm User: hmc@kci.com M:\2019\122677-47\Drawings-CID\ESC NOTES_DETAILS.dwg

DEPARTMENT OF PUBLIC WORKS HOWARD COUNTY, MARYLAND Director of Public Works DATE 3/7/19 Chief, Bureau of Utilities DATE 3-6-19		KCI TECHNOLOGIES ENGINEERS PLANNERS SCIENTISTS CONSTRUCTION MANAGERS 936 Rotelbrook Road Sparks, MD 21152 Phone: (410) 316-7800 Fax: (410) 316-7817 www.kci.com Chief, Utility Design Division DATE 3/19	
---	--	--	--

STATE OF MARYLAND
 PROFESSIONAL ENGINEER
 License No. 31363
 03/01/2019

DES: CB, KJ			
DRN: KJ			
CHK: GW			
DATE: MARCH 2019	BY	NO.	REVISION

EROSION & SEDIMENT CONTROL NOTES AND DETAILS

600' SCALE MAP NO. 32 BLOCK NO. 20.21

OLD LAWYERS HILL ROAD WATER SUPPLY MAIN REPLACEMENT

CAPITAL PROJECT No. W8327
 CONTRACT No. 44-5018

ELECTION DISTRICT NO. 1 HOWARD COUNTY, MARYLAND

SCALE AS SHOWN
 SHEET 7 OF 8

B-4.2 STANDARDS AND SPECIFICATIONS

FOR

SOIL PREPARATION, TOPSOILING, AND SOIL AMENDMENTS

Definition

The process of preparing the soils to sustain adequate vegetative stabilization.

Purpose

To provide a suitable soil medium for vegetative growth.

Conditions Where Practice Applies

Where vegetative stabilization is to be established.

Criteria

- A. Soil Preparation
1. Temporary Stabilization
a. Seedbed preparation consists of loosening soil to a depth of 3 to 5 inches by means of suitable agricultural or construction equipment...
2. Permanent Stabilization
a. A soil test is required for any earth disturbance of 5 acres or more...
B. Topsoiling
1. Topsoil is placed over prepared subsoil prior to establishment of permanent vegetation...
2. Topsoil salvaged from an existing site may be used provided it meets the standards as set forth in these specifications...
3. Topsoiling is limited to areas having 2:1 or flatter slopes where:
a. The texture of the exposed subsoil/parent material is not adequate to produce vegetative growth...
4. Areas having slopes steeper than 2:1 require special consideration and design.
5. Topsoil Specifications: Soil to be used as topsoil must meet the following criteria:
a. Topsoil must be a loam, sandy loam, clay loam, silt loam, sandy clay loam, or loamy sand...
6. Topsoil Application
a. Erosion and sediment control practices must be maintained when applying topsoil...
C. Soil Amendments (Fertilizer and Lime Specifications)
1. Soil tests must be performed to determine the exact ratios and application rates for both lime and fertilizer on sites having disturbed areas of 5 acres or more...
2. Fertilizers must be uniform in composition, free flowing and suitable for accurate application by appropriate equipment...
3. Lime materials must be ground limestone (hydrated or burnt lime may be substituted except when hydroseeding) which contains at least 50 percent total oxides (calcium oxide plus magnesium oxide)...

B-4.3 STANDARDS AND SPECIFICATIONS

FOR

SEEDING AND MULCHING

Definition

The application of seed and mulch to establish vegetative cover.

Purpose

To protect disturbed soils from erosion during and at the end of construction.

Conditions Where Practice Applies

To the surface of all perimeter controls, slopes, and any disturbed area not under active grading.

Criteria

- A. Seeding
1. Specifications
a. All seed must meet the requirements of the Maryland State Seed Law. All seed must be subject to re-testing by a recognized seed laboratory...
b. Mulch alone may be applied between the fall and spring seeding dates only if the ground is frozen...
c. Inoculants: The inoculant for treating legume seed in the seed mixtures must be a pure culture of nitrogen fixing bacteria prepared specifically for the species...
d. Sod or seed must not be placed on soil which has been treated with soil sterilants or chemicals used for weed control until sufficient time has elapsed (14 days min.)...
2. Application
a. Dry Seeding: This includes use of conventional drop or broadcast spreaders...
b. Drill or Cultipacker Seeding: Mechanized seeders that apply and cover seed with soil...
c. Hydroseeding: Apply seed uniformly with hydroseeder (slurry includes seed and fertilizer)...
B. Mulching
1. Mulch Materials (in order of preference)
a. Straw consisting of thoroughly threshed wheat, rye, oat, or barley and reasonably bright in color...
b. Wood Cellulose Fiber Mulch (WCFM) consisting of specially prepared wood cellulose processed into a uniform fibrous physical state...
2. Application
a. Apply mulch to all seeded areas immediately after seeding...
b. When straw mulch is used, spread it over all seeded areas at the rate of 2 tons per acre to a uniform loose depth of 1 to 2 inches...

- c. Wood cellulose fiber used as mulch must be applied at a net dry weight of 1500 pounds per acre...
3. Anchoring
a. Perform mulch anchoring immediately following application of mulch to minimize loss by wind or water...
i. A mulch anchoring tool is a tractor drawn implement designed to punch and anchor mulch into the soil surface...
ii. Wood cellulose fiber may be used for anchoring straw...
iii. Synthetic binders such as Acrylic DLR (Agro-Tack), DCA-70, Petroset, Terra Tax II, Terra Tack AR or other approved equal may be used...
iv. Lightweight plastic netting may be stapled over the mulch according to manufacturer recommendations...

B-4.4 STANDARDS AND SPECIFICATIONS

FOR

TEMPORARY STABILIZATION

Definition

To stabilize disturbed soils with vegetation for up to 6 months.

Purpose

To use fast growing vegetation that provides cover on disturbed soils.

Conditions Where Practice Applies

Exposed soils where ground cover is needed for a period of 6 months or less. For longer duration of time, permanent stabilization practices are required.

Criteria

- 1. Select one or more of the species or seed mixtures listed in Table B.1 for the appropriate Plant Hardiness Zone...
2. For sites having soil tests performed, use and show the recommended rates by the testing agency...
3. When stabilization is required outside of a seeding season, apply seed and mulch or straw mulch alone as prescribed in Section B-4-3.A.1.b and maintain until the next seeding season.

Temporary Seeding Summary

Table with columns: No., Species, Application Rate (lb/ac), Seeding Dates, Seeding Depths, Fertilizer Rate (10-20-20), Lime Rate. Includes rows for ANNUAL RYEGRASS, BARLEY, OATS, FOXTAIL, and MILLET.

NOTES:

- 1/ Seeding rates for the warm-season grasses are in pounds of Pure Live Seed (PLS). Actual planting rates shall be adjusted to reflect percent seed germination and purity...
2/ For sandy soils, plant seeds at twice the depth listed above...
3/ The planting dates listed are averages for each Zone and may require adjustment to reflect local conditions, especially near the boundaries of the zone.

B-4.5 STANDARDS AND SPECIFICATIONS

FOR

PERMANENT STABILIZATION

Definition

To stabilize disturbed soils with permanent vegetation.

Purpose

To use long-lived perennial grasses and legumes to establish permanent ground cover on disturbed soils.

Conditions Where Practice Applies

Exposed soils where ground cover is needed for 6 months or more.

Criteria

- A. Seed Mixtures
1. General Use
a. Select one or more of the species or mixtures listed in Table B.3 for the appropriate Plant Hardiness Zone...
b. Additional planting specifications for exceptional sites such as shorelines, stream banks, or dunes...

- c. For sites having disturbed area over 5 acres, use and show the rates recommended by the soil testing agency...
2. Turfgrass Mixtures
a. Areas where turfgrass may be desired include lawns, parks, playgrounds, and commercial sites...
b. Select one or more of the species or mixtures listed below based on the site conditions or purpose...
i. Kentucky Bluegrass: Full Sun Mixture: For use in areas that receive intensive management...
ii. Kentucky Bluegrass/Perennial Rye: Full Sun Mixture: For use in full sun areas where rapid establishment is necessary...
iii. Tall Fescue/Kentucky Bluegrass: Full Sun Mixture: For use in drought prone areas and/or for areas receiving low to medium management...
iv. Kentucky Bluegrass/Fine Fescue: Shade Mixture: For use in areas with shade in Bluegrass lawns...

Notes: Select turfgrass varieties from those listed in the most current University of Maryland Publication, Agronomy Memo #77, "Turfgrass Cultivar Recommendations for Maryland"

Choose certified material. Certified material is the best guarantee of cultivar purity. The certification program of the Maryland Department of Agriculture, Turf and Seed Section, provides a reliable means of consumer protection and assures a pure genetic line

- c. Ideal Times of Seeding for Turf Grass Mixtures
Western MD: March 15 to June 1, August 1 to October 1 (Hardiness Zones: 5b, 6a)
Central MD: March 1 to May 15, August 15 to October 15 (Hardiness Zone: 6b)
Southern MD, Eastern Shore: March 1 to May 15, August 15 to October 15 (Hardiness Zones: 7a, 7b)
d. Till areas to receive seed by disking or other approved methods to a depth of 2 to 4 inches, level and rake the areas to prepare a proper seedbed...
e. If soil moisture is deficient, supply new seedlings with adequate water for plant growth...


Permanent Seeding Summary

Table with columns: No., Species, Application Rate (lb/ac), Seeding Dates, Seeding Depths, Fertilizer Rate (10-20-20), Lime Rate. Includes rows for TALL FESCUE, PERENNIAL RYEGRASS, WHITE CLOVER.

- B. Sod: To provide quick cover on disturbed areas (2:1 grade or flatter).

- 1. General Specifications
a. Class of turfgrass sod must be Maryland State Certified. Sod labels must be made available to the job foreman and inspector...
b. Sod must be machine cut at a uniform soil thickness of 1/4 inch, plus or minus 1/4 inch...
c. Standard size sections of sod must be strong enough to support their own weight and retain their size and shape when suspended vertically...
d. Sod must not be harvested or transplanted when moisture content (excessively dry or wet) may adversely affect its survival...
2. Sod Installation
a. During periods of excessively high temperature or in areas having dry subsoil, lightly irrigate the subsoil immediately prior to laying the sod...
b. Lay the first row of sod in a straight line with subsequent rows placed parallel to it and tightly wedged against each other...
c. Wherever possible, lay sod with the long edges parallel to the contour and with staggering joints...
d. Water the sod immediately following rolling and tamping until the underside of the new sod pad and soil surface below the sod are thoroughly wet...
3. Sod Maintenance
a. In the absence of adequate rainfall, water daily during the first week or as often and sufficiently as necessary to maintain moist soil to a depth of 4 inches...
b. After the first week, sod watering is required as necessary to maintain adequate moisture content...
c. Do not mow until the sod is firmly rooted. No more than 1/2 of the grass leaf must be removed by the initial cutting or subsequent cuttings...

PROFESSIONAL CERTIFICATION. I hereby certify that these documents were prepared or approved by me, and that I am a duly licensed professional engineer under the laws of the State Of Maryland, License No. 31363, Expiration Date 1/16/2020.

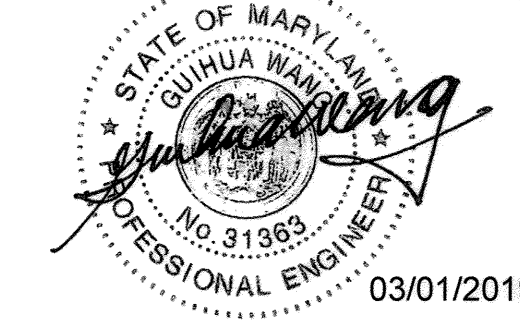

DES: CB, KJ
DRN: KJ
CHK: GW
DATE: MARCH 2019

EROSION & SEDIMENT CONTROL NOTES
AS-BUILT DATE 03-10-2020

OLD LAWYERS HILL ROAD WATER SUPPLY MAIN REPLACEMENT
CAPITAL PROJECT No. W8327
CONTRACT No. 44-5018
ELECTION DISTRICT NO. 1 HOWARD COUNTY, MARYLAND

SCALE AS SHOWN
SHEET 8 OF 8