


INDEX OF SHEETS	
NO.	DESCRIPTION
1	TITLE SHEET
2	LEGEND, NOTES, AND DETAILS
3	EXISTING PLAN AND PROFILE
4	EXISTING PLAN AND PROFILE
5	EXISTING PLAN AND PROFILE
6	EXISTING PLAN AND PROFILE
7	EXISTING PLAN AND PROFILE
8	EXISTING AND PROPOSED PLAN AND PROFILE AT MANHOLE 128
9	STRUCTURE SCHEDULE
10	PROPOSED BILLING FLOW METER - PLANS AND SECTIONS
11	ELECTRICAL PLAN, DETAILS AND NOTES
12	EROSION AND SEDIMENT CONTROL DETAILS AND NOTES
13	EROSION AND SEDIMENT CONTROL NOTES
14	MAINTENANCE OF TRAFFIC
15	MAINTENANCE OF TRAFFIC
16	MAINTENANCE OF TRAFFIC

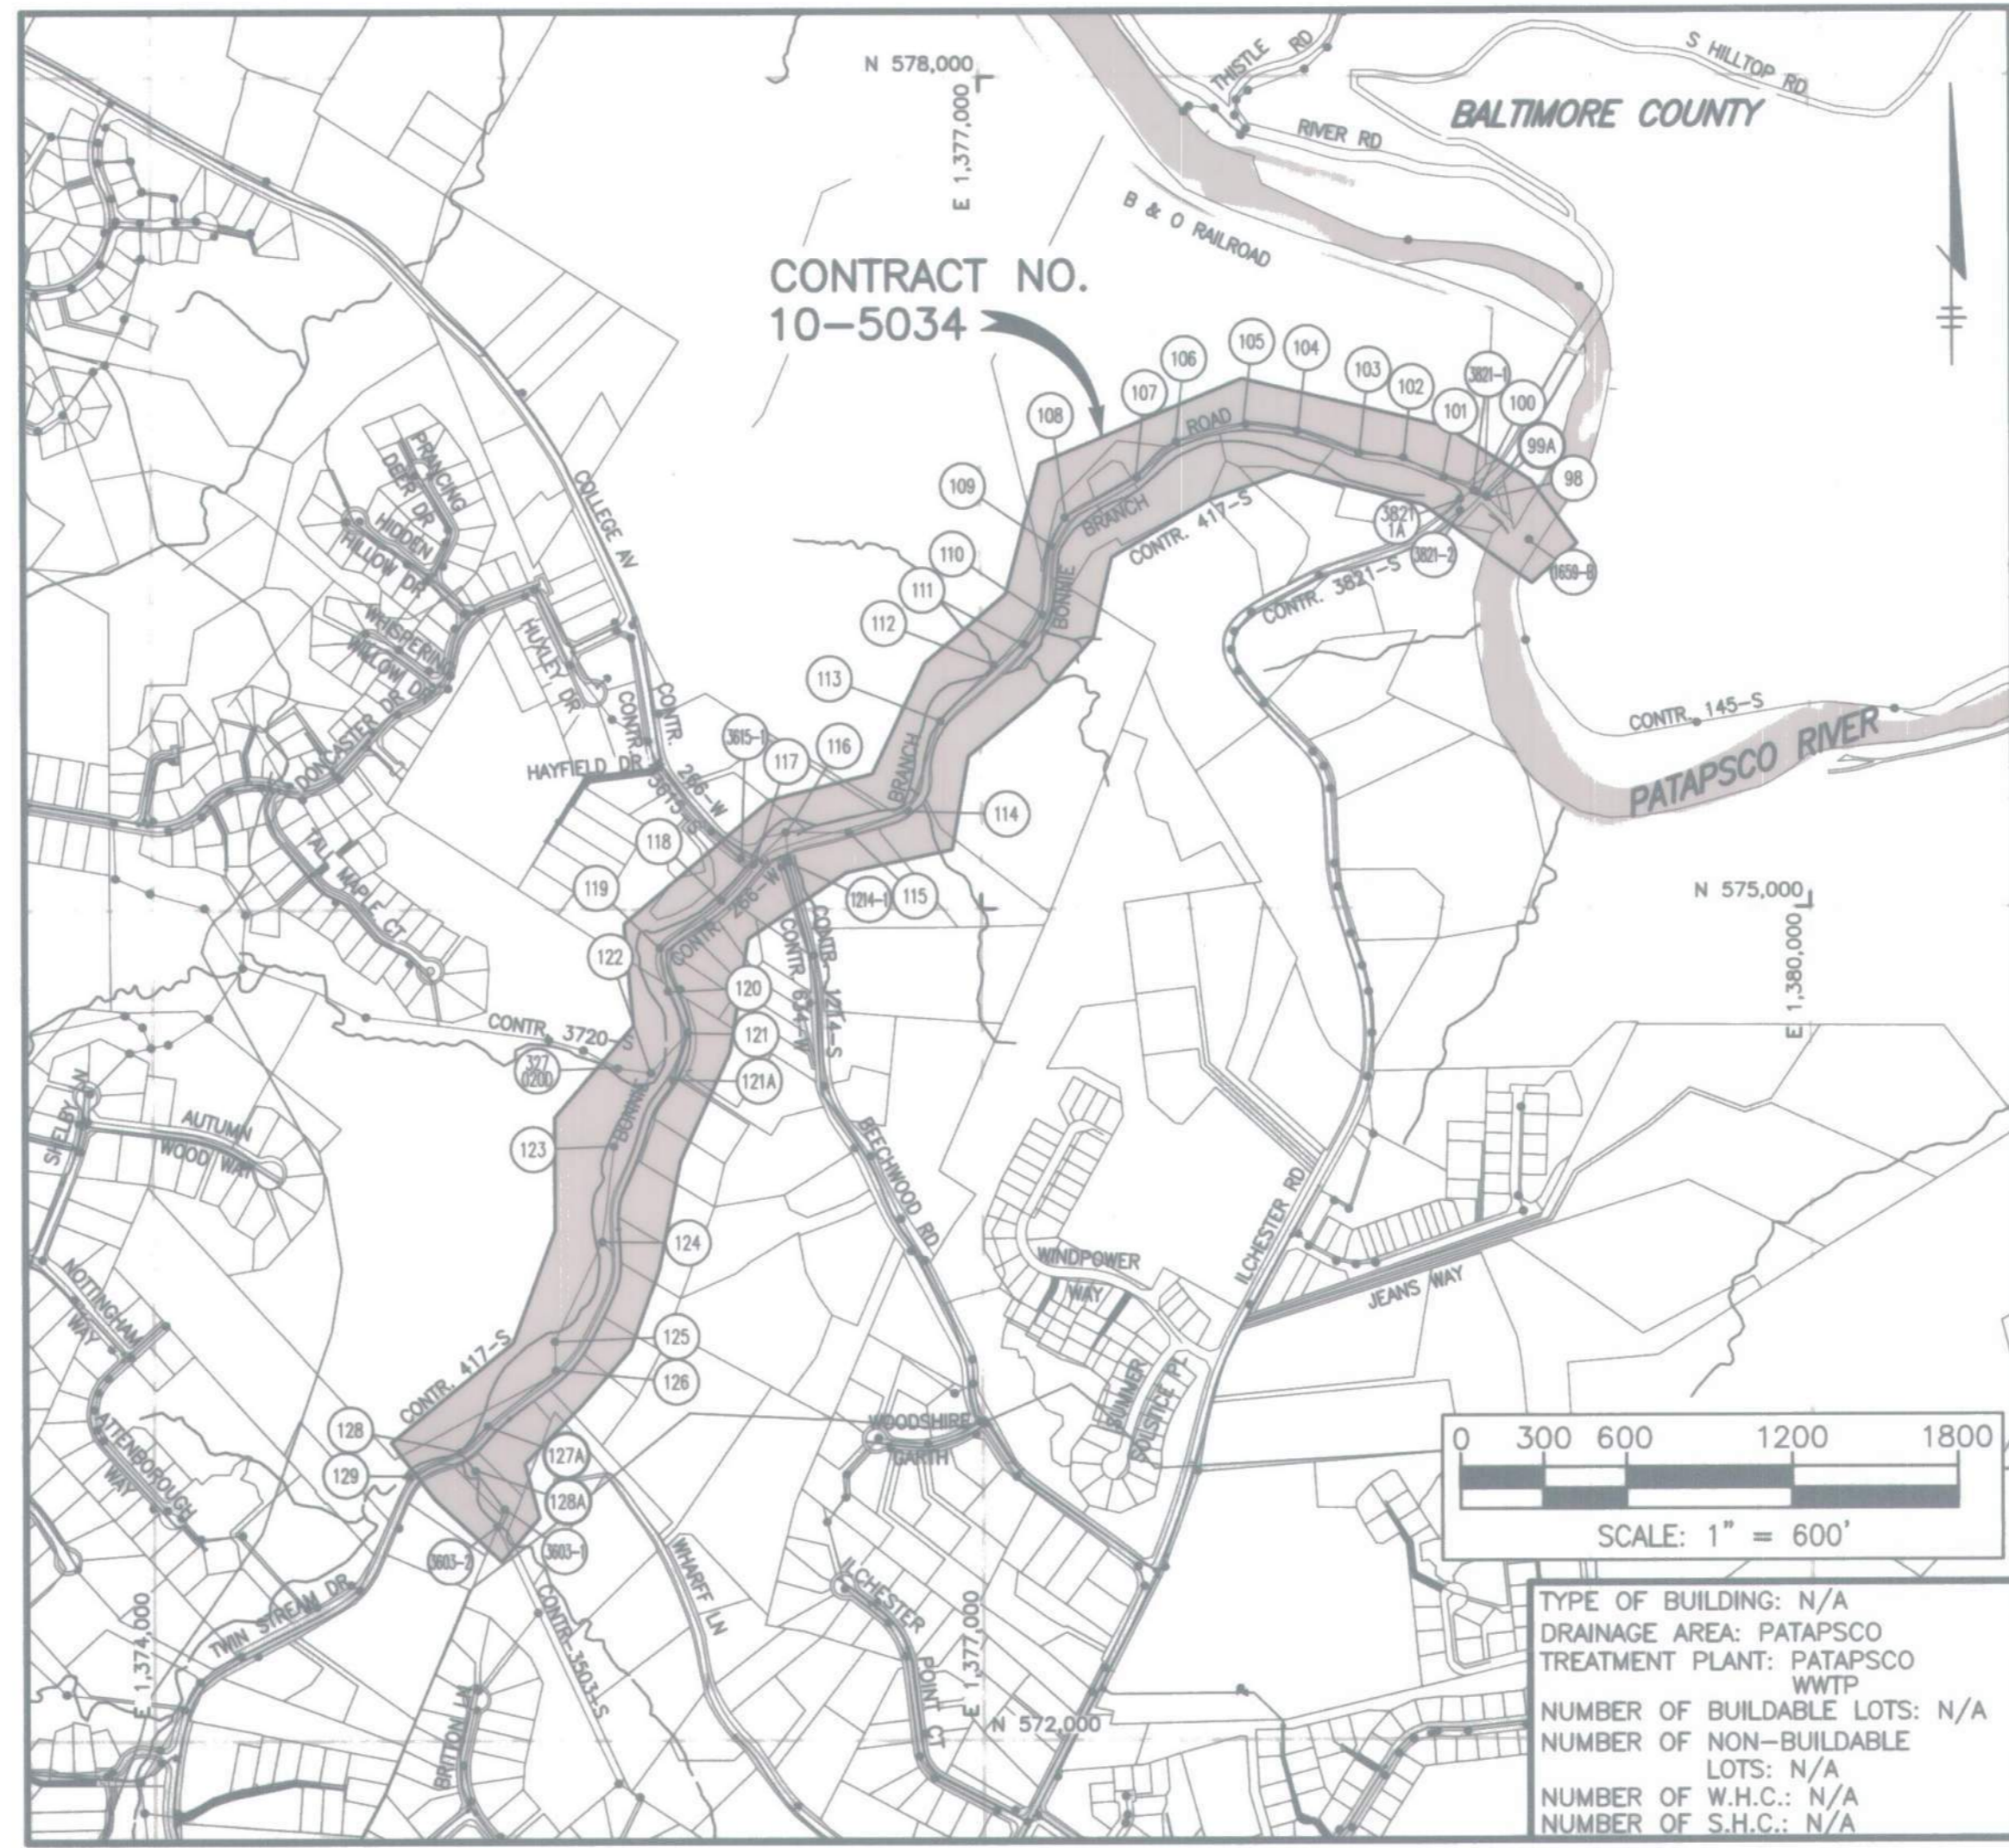

VICINITY MAP

GENERAL NOTES

- Approximate locations of existing mains are shown. The contractor shall take all necessary precautions to protect existing mains and services and maintain uninterrupted service. Any damage incurred shall be repaired immediately to the satisfaction of the Engineer at the Contractor's expense.
- Topographic field surveys were performed during May and June, 2017, by C.C. Johnson & Malhotra, P.C. for the areas from existing MH 101 to existing MH 098 and for the area from existing MH 127 to existing MH 3503-1. Howard County GIS topography is used in all other areas.
- Horizontal and Vertical Survey Controls:
The coordinates shown on the drawings are based on Maryland State Reference System NAD '83 / '91 and the vertical controls shown on the drawings are based on NAVD '88 as projected by the following Howard County Geodetic Control Stations:
31BA - N 575987.759, E 1375729.958, Elev. 376.098
31DA - N 571982.665, E 1372145.130, Elev. 481.603
31EA - N 569641.138, E 1374816.086, Elev. 468.877
31EB - N 568730.995, E 1376273.635, Elev. 452.657
0081 - N 572335.338, E 1377504.092, Elev. 477.919
- All pipe elevations shown are invert elevations unless otherwise noted on the plans.
- Maintain a minimum of ten (10) feet horizontal and eighteen (18) inches vertical separation (outside diameter to outside diameter) from all water mains. Clear all other utilities by a minimum of 12 inches. Clear all poles by 5'-0" minimum or tunnel as required unless otherwise noted. The owner has contacted the utility companies and has made arrangements for bracing of poles as shown on the drawings. In the event the contractor's work requires the bracing of additional poles, any cost incurred by the owner for the bracing of additional poles or damages shall be deducted from monies owed the contractor. The contractor shall coordinate with the utility companies to schedule the bracing of the poles.
- For details not shown on the drawings, and for materials and construction methods, use Howard County Design Manual, Volume IV, Standard Specifications and Details for Construction (Latest Edition). The contractor shall have a copy of Volume IV on the job.
- Where test pits have been made on existing utilities, they are noted by the symbol (M) at the locations of the test pits. A note or notes containing the results of the test pit or pits is included on the drawings. Existing utilities in the vicinity of the proposed work for which test pits have not been dug shall be located by the contractor two weeks in advance of construction operations at his own expense.
- The contractor shall notify the following utility companies or agencies at least five working days before starting work shown on these plans:
AT&T 1-800-252-1133
BGE (Construction Services) 410-850-4620
BGE (Emergency) 410-685-1400
Bureau of Utilities 410-313-4900
Colonial Pipeline Co. 410-795-1390
COMCAST 1-888-987-8600
Miss Utility 1-800-257-7777
State Highway Administration 410-531-5533
Verizon 1-800-743-0033 / 410-224-9210
- Trees within the temporary construction strips and temporary construction easements shall not be removed or damaged by the contractor. Shrubs within the temporary construction strips and temporary construction easements shall be protected from damage to the maximum extent possible.
- The contractor shall remove trees, stumps and roots along the line of excavation. Payment for such removal shall be included in the bid item prices for contingent Tree Removal and Clearing and Grubbing.
- The contractor shall notify the Bureau of Highways, Howard County, at 410-313-7450 at least five working days before open cutting or boring/jacking of any County road for laying water/sewer mains or house connections. The approval of these drawings will constitute compliance with DPW requirements per Section 18.114(a) of the Howard County Code.

PROJECT PURPOSE

The purpose of this Capital Project is to rehabilitate 30 existing Manholes of Contract 417-S, make various point repairs to existing Sanitary Sewer Pipe, provide a smoother transition of flow from Contract No. 3503-S to Contract No. 417-S at existing Manhole 128, and replace the existing Billing Flow Meter and Vault with a new Billing Flow Meter and Vault at Ichester Road.

BILL OF MATERIALS				
ITEMS	QUANTITIES ESTIMATED	AS-BUILT		
		QUANTITIES	UNITS	PRODUCT MANUFACTURER.
INSTALL MANHOLE INSERT	32 EA			PARSON ENVIRONMENTAL
MH WALL GROUT INJECTION	14 EA	14		PARSON ENVIRONMENTAL
EPOXY/POLYURETHANE MH INTERIOR RESURFACING	33 EA	33		PARSON ENVIRONMENTAL
OPEN CUT 12" SEWER POINT REPAIR - 13 LINEAR FEET	6 EA			
OPEN CUT 12" SEWER POINT REPAIR - ADDITIONAL REPAIR LENGTH	39 EA			
GROUT MAINLINE SEWER PIPE JOINT	8 EA	11		AVANTI
LATERAL SEWER POINT REPAIR	1 EA	1		
GROUT LATERAL SEWER PIPE JOINT	3 EA	3		AVANTI
12" PVC SEWER PIPE / 12 IN C-900	47 LF	4/167		NATIONAL PIPE / NORTH AMERICAN PIPE
16" PVC SEWER PIPE / 16 IN C-900	25 LF	26		NATIONAL PIPE / NORTH AMERICAN PIPE
NEW 5' DIAMETER PRECAST MANHOLE INSTALLATION	2 EA	2		ATLANTIC CONCRETE
NEW 5' DIAMETER PRECAST DOGHOUSE MANHOLE INSTALLATION	1 EA	1		ATLANTIC CONCRETE
NEW 5' DIAMETER PRECAST MANHOLE INSTALLATION - ADDITIONAL DEPTH	6 VLF			ATLANTIC CONCRETE
FLOW METER	1 EA			NOT APPLICABLE
REPLACE MANHOLE COVER W/IT F/C	1 EA	3		
REPLACE MH STEPS	285 EA	178		M.A. INDUSTRIES

BONNIE BRANCH INTERCEPTOR SEWER IMPROVEMENTS CAPITAL PROJECT S6282 CONTRACT NO. 10-5034 HOWARD COUNTY, MARYLAND

NAME OF UTILITY CONTRACTOR : _____

Sediment control measures for this contract will be implemented in accordance with Section 308 of the Specifications and as shown on these plans.

CHECKBOX
 AS-BUILT DATE
 SURVEY AND DRAFTING DIVISION

BY THE OWNER / DEVELOPER:
 I/WE CERTIFY THAT ALL CLEARING, GRADING, CONSTRUCTION OR DEVELOPMENT WILL BE DONE PURSUANT TO THIS APPROVED EROSION AND SEDIMENT CONTROL PLAN, INCLUDING INSPECTING AND MAINTAINING CONTROLS, AND THAT THE RESPONSIBLE PERSONNEL INVOLVED IN THE CONSTRUCTION PROJECT WILL HAVE A CERTIFICATE OF TRAINING AT A MARYLAND DEPARTMENT OF THE ENVIRONMENT (MDE) APPROVED TRAINING PROGRAM FOR THE CONTROL OF EROSION AND SEDIMENT PRIOR TO THE BEGINNING OF THE PROJECT. I CERTIFY RIGHT-OF-ENTRY FOR PERIODIC ON-SITE EVALUATION BY HOWARD COUNTY, THE HOWARD SOIL CONSERVATION DISTRICT AND/OR MDE.
 DATE: 01/06/2021
 DEVELOPER/OWNER: Silver Choi

BY THE ENGINEER :
 I HEREBY CERTIFY THAT THIS PLAN HAS BEEN DESIGNED IN ACCORDANCE WITH CURRENT MARYLAND EROSION AND SEDIMENT CONTROL LAWS, REGULATIONS AND STANDARDS, THAT IT REPRESENTS A PRACTICAL AND WORKABLE PLAN BASED ON MY PERSONAL KNOWLEDGE OF THE SITE, AND THAT IT WAS PREPARED IN ACCORDANCE WITH THE REQUIREMENTS OF THE HOWARD COUNTY SOIL CONSERVATION DISTRICT.
 DATE: 01/04/2021
 ENGINEER: W. Mark Gardocky

PROFESSIONAL CERTIFICATION :
 I HEREBY CERTIFY THAT THESE DOCUMENTS WERE PREPARED OR APPROVED BY ME, AND THAT I AM A DULY LICENSED PROFESSIONAL ENGINEER UNDER THE LAWS OF THE STATE OF MARYLAND, LICENSE NO. 30875, EXPIRATION DATE NOVEMBER 29, 2022.
 W. MARK GARDOCKY, P.E.

AS-BUILT
 DATE 12-22-2021

DEPARTMENT OF PUBLIC WORKS
 HOWARD COUNTY, MARYLAND
 DATE: 1/12/2021
 DATE: 1-11-21

GMB
 GEORGE, MILES & BUHR, LLC
 ARCHITECTS & ENGINEERS
 SALESBURY - BALTIMORE - SEAFORD
 www.gmbnet.com



DES: WMG	
DRN: JWB	
CHK: AWW	
DATE: 12/2020	
BY: AMP	AS-BUILT
NO.:	
REVISION:	
DATE:	

TITLE SHEET
 BONNIE BRANCH INTERCEPTOR SEWER IMPROVEMENTS
 CONTRACT NO. 10-5034
 2ND ELECTION DISTRICT
 HOWARD COUNTY, MARYLAND

SCALE AS SHOWN
 SHEET 01 OF 16

600 SCALE MAP NO. 31 BLOCK NO. 4

PROJECT NOTES




1. Spoil from trenching operations is to be placed on the uphill side of the trench.
2. The contractor shall be responsible for acquiring any additional staging and/or stockpile areas that the contractor deems necessary.
3. The contractor shall be responsible for repairing and replacing any existing fences, signs, concrete curb, driveways, paving, curb and gutter pan, walkways, etc., damaged or removed during construction. All disturbed areas shall be returned to their original or better condition.
4. This project is exempt from Forest Conservation requirements under section 16.1202.b.1.x of the Howard County Forest Conservation Code.
5. The site is not located within a Tier II watershed.
6. The site is located within an impaired waterway with respect to total suspended solids, sulfates and chlorides.
7. Work shall be limited to that which can be stabilized in the same day. Soil stabilization matting shall be used as appropriate per Table B.7 Soil Stabilization on Slopes on Sheet 13.

SEWER NOTES

1. All sewer mains shall be AWWA C-900 / DR-25 PVC unless otherwise noted.
2. All manholes shall be 4'-0" or 5'-0" inside diameter as noted in the Existing Manhole Schedule and Proposed Manhole Schedule.
3. Manholes designated W.T. in profile shall have watertight frames and covers. Where watertight manhole frames and covers are used, set top of manhole with embedded frame 1'-6" above finished grade unless otherwise noted on the drawings.
4. The existing sewer shall remain in service at all times and be protected during construction.
5. Contractor shall CCTV the pipe prior to any excavation to verify repair location.

HANDLING ASBESTOS CONTAINING MATERIAL


1. The existing water main is asbestos cement pipe (ACP). It must be removed in accordance with applicable federal, state, and local regulations, including but not limited to, 29CFR1926.1101, 40CFR61, 262, and 263 and COMAR 26.11.21. This work requires submission and acceptance of an asbestos abatement work plan that describes in detail the methods the contractor will use to comply with applicable regulations including training, respiratory protection, and waste disposal. This item also includes design and implementation of engineering controls and dust control measures to reduce visible emissions while performing asbestos abatement. The contractor shall dispose of all ACP in a permitted facility.
2. The work may require entry into permit-required confined spaces. The contractor is responsible for complying with applicable regulations including 29CFR1910.146.

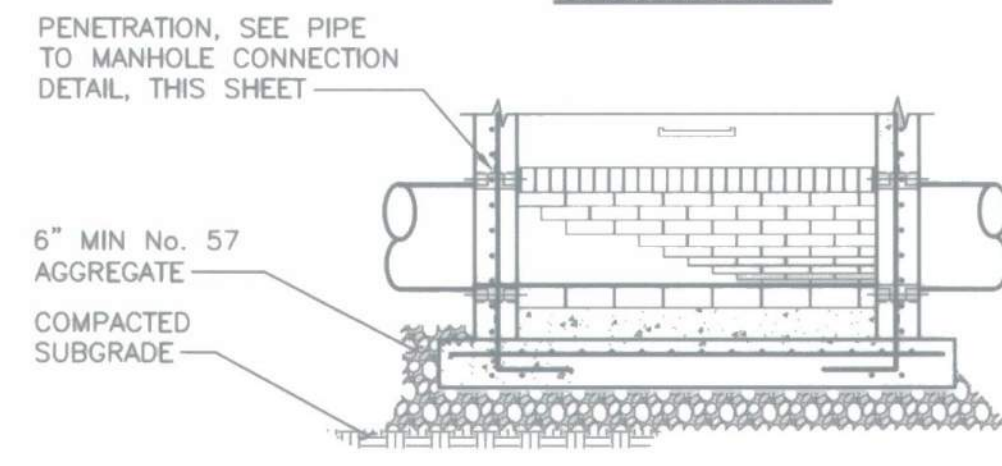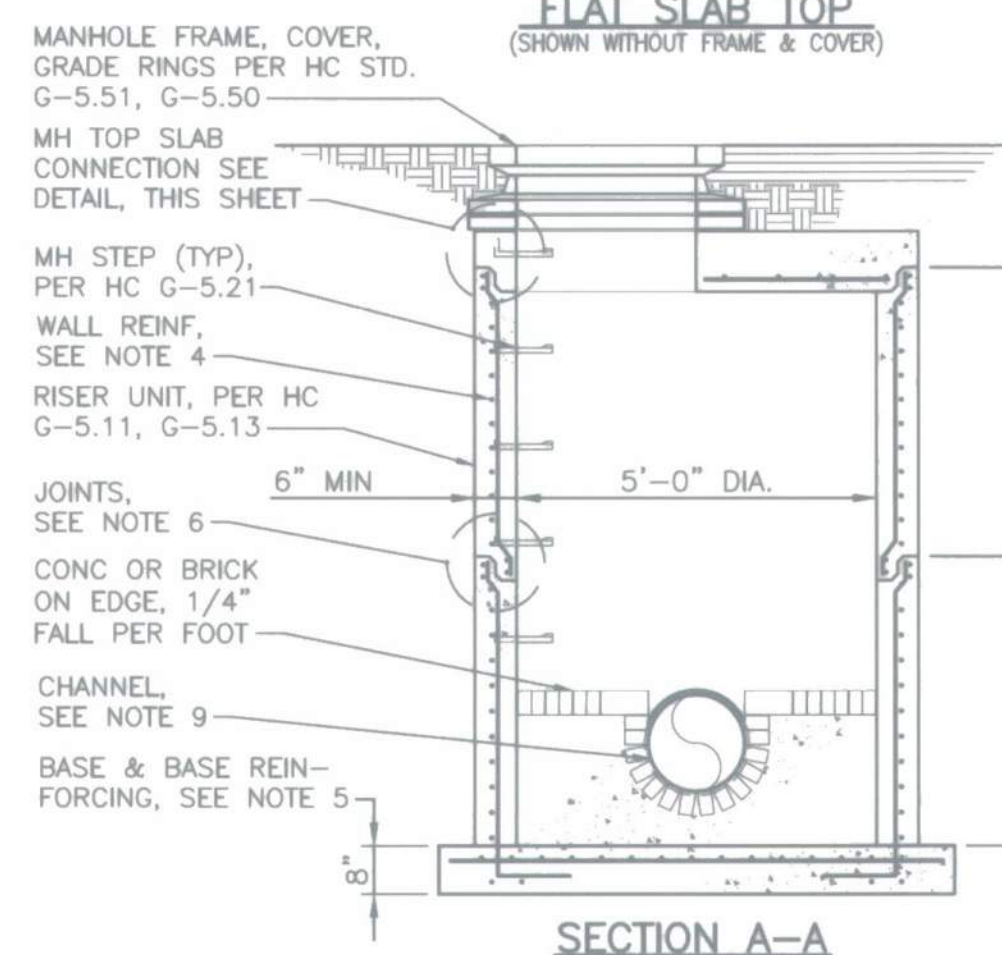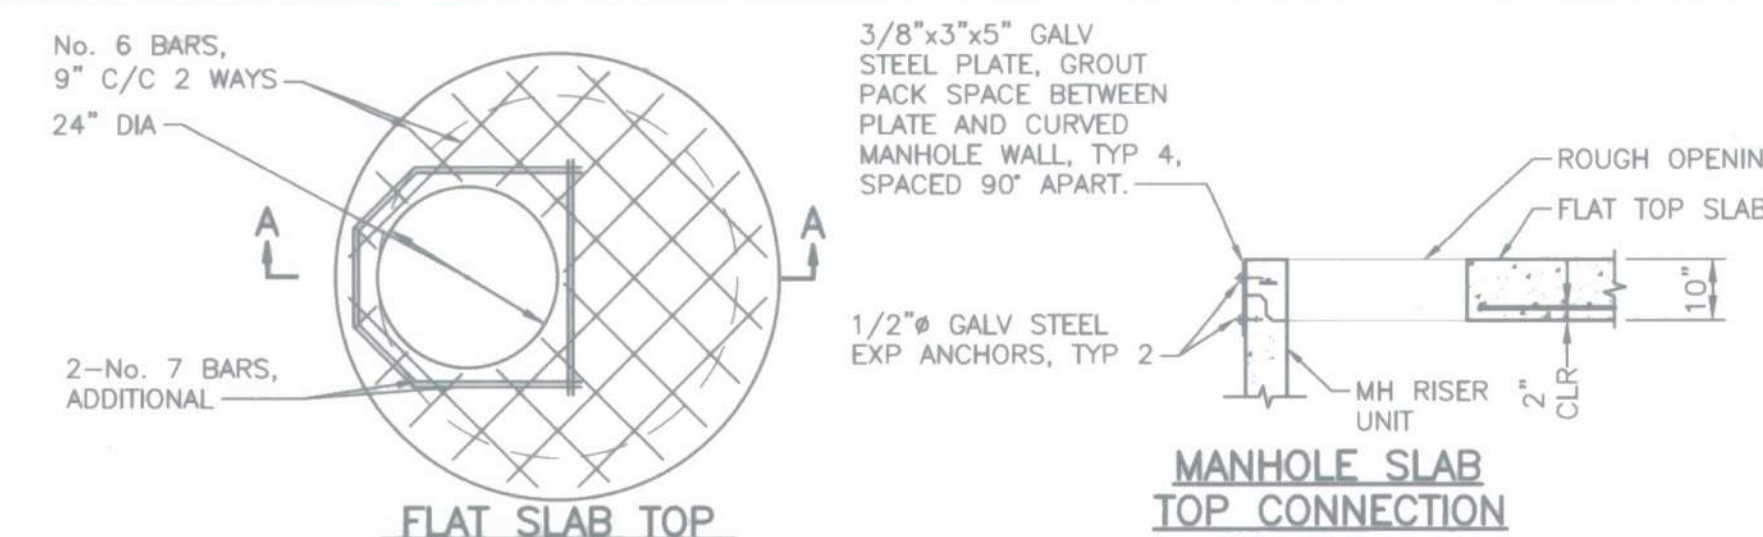


- NOTES:**
1. MANHOLES SHALL BE CONSTRUCTED IN ACCORDANCE WITH ASTM C-478 AND THE GENERAL NOTES APPLICABLE TO ALL PRECAST MANHOLES ON STANDARD DETAIL G-5.11.
 2. MH 127A WILL BE A DOGHOUSE MANHOLE WITH THE BASE CONSTRUCTED ACCORDING TO STANDARD DETAIL G-5.14 AND OTHERWISE IN ACCORDANCE WITH THE DETAILS AS SEEN ON THIS SHEET.
 3. CONCRETE SHALL BE MIX NO.6 (4500 PSI) AND AIR ENTRAINED (5% ±1%). CONCRETE SHALL HAVE A SLUMP OF 4" (±1").
 4. WALL REINFORCEMENT FOR BASE UNITS AND RISER UNITS SHALL BE REINFORCEMENT BARS OR WELDED WIRE FABRIC WITH A MINIMUM AREA OF 0.23 IN²/FT FOR THE 60" DIAMETER MANHOLES. WELDED WIRE FABRIC SHALL CONFORM TO ASTM A-1064. REINFORCEMENT BARS SHALL MEET ASTM A-615, GRADE 60.
 5. BASE REINFORCEMENT TO BE REINFORCEMENT BARS OR WELDED WIRE FABRIC WITH A MINIMUM AREA OF 0.23 IN²/FT. THE BASE SHALL BE CAST MONOLITHIC WITH THE BASE UNIT OR JOINTED PER MANUFACTURER'S DESIGN.
 6. THE MANUFACTURER SHALL FORM MALE AND FEMALE ENDS OF JOINTS USING THEIR OWN DESIGN. THE JOINTS SHALL BE SEALED BY THE CONTRACTOR AND MADE WATERTIGHT USING RUBBER O-RING GASKETS MEETING ASTM C-443.
 7. MINIMUM DISTANCE BETWEEN PIPE OPENINGS IN MANHOLE WALL SHALL BE 12 INCHES.
 8. LIFT HOLES OR LIFT EYES SHALL BE PROVIDED IN EACH SECTION FOR HANDLING.
 9. MIX NO. 6 PRECAST CONCRETE OR BRICK CHANNEL SHALL BE PROVIDED AND SHALL SLOPE TOWARD OUTLET AS DIRECTED BY THE ENGINEER.
 10. NO MORE THAN ONE 1' RISER SECTION MAY BE USED PER MANHOLE.
 11. MANHOLE INTERIOR LINER IS REQUIRED. REFER TO "SANITARY SEWER MANHOLES" SECTION OF THE SPECIAL PROVISIONS.

* DIMENSIONS TO BE CONFIRMED BY THE MANUFACTURER.


NOTE: "STANDARD DETAIL" REFERS TO DETAILS IN HOWARD COUNTY DESIGN MANUAL VOLUME IV - STANDARD SPECIFICATIONS AND DETAILS FOR CONSTRUCTION, LATEST EDITION.

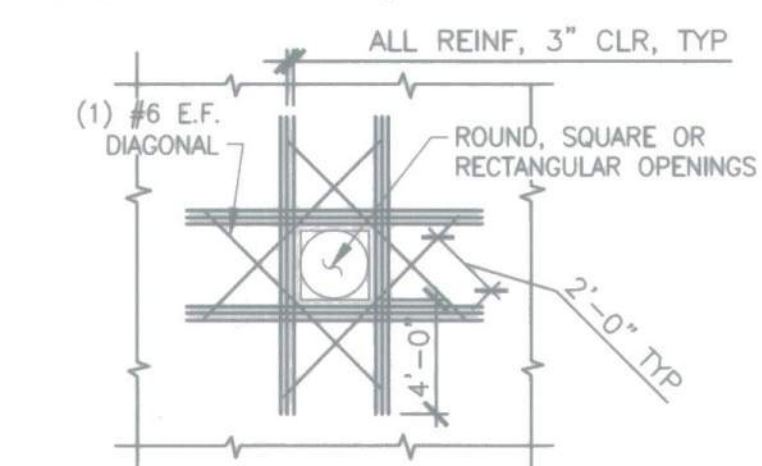

- NOTES --- REBAR OPENING DETAIL:**
1. PROVIDE ADDITIONAL REINFORCING, (MINIMUM OF ONE-HALF THE NUMBER OF PRINCIPAL REINFORCING, BARS BEING INTERRUPTED BY THE OPENING AT EACH FACE ON EACH SIDE).
 2. FOR OPENINGS LESS THAN 12" DIAMETER, NO ADDITIONAL REINFORCING IS REQUIRED PROVIDED NO REINFORCING IS INTERRUPTED BY THE OPENING.

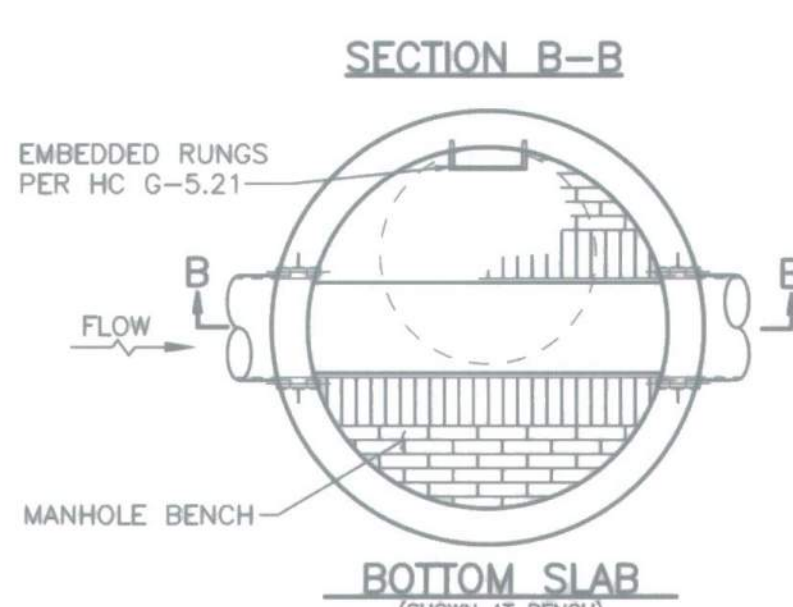

5'-0" DIAMETER PRECAST MANHOLE
NO SCALE

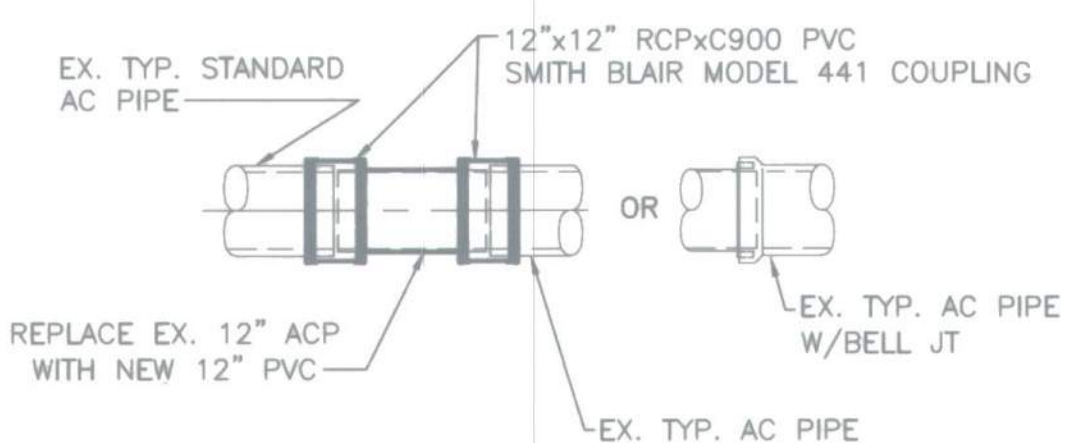


TYPICAL OPEN CUT POINT REPAIR DETAILS
NOT TO SCALE

ABBREVIATIONS

AB'D,ABAND	ABANDONED	P/L,R	PROPERTY LINE
C/L,Q	CENTERLINE	PVM,T	PAVEMENT
CO	CLEANOUT	RED,RDCR	REDUCER
CPLG	COUPLING	R/W,ROW	RIGHT-OF-WAY
DIA,#	DIAMETER	UG	UNDERGROUND
E,EL,ELEC	ELECTRIC	UP	UTILITY POLE
EOP	EDGE OF PAVEMENT	SAN	SANITARY
ESM,T	EASEMENT	SD	(STORM)DRAIN
EX	EXISTING	SF	SILT FENCE
FH	FIRE HYDRANT	SSF	SUPER SILT FENCE
FHT	FIRE HYDRANT TEE	T	TEE
FP	FLOOD PLAIN	TEL,PHN	TELEPHONE
G	GAS	TP	TREE PROTECTION
HORIZ,HZ	HORIZONTAL	TRAV	TRAVERSE
LOD	LIMIT-OF-DISTURBANCE	V	VALVE
LP	LIGHT POLE	VT,VERT	VERTICAL
MH	MANHOLE	VB	VEGETATION BUFFER
OH	OVERHEAD	W	WATER, WETLANDS
PED	PEDESTAL		

LEGEND

	EX. FENCE		EX. SPECIMEN TREE
	EX. STRUCTURES		100-YEAR FLOODPLAIN
	EX. FOOT PATH		EX. WETLAND BUFFER
	EX. GUARDRAIL		EX. VEGETATION BUFFER
	EX. PAVEMENT MARKINGS		LIMIT OF DISTURBANCE
	EX. EDGE OF PAVEMENT		SILT FENCE
	EX. CURB & GUTTER		SUPER SILT FENCE
	EX. EDGE DIRT, GRAVEL, MACADAM		TREE PROTECTION FENCE
	RIGHT-OF-WAY		WETLANDS
	PROPERTY BOUNDARY		
	ADJACENT PROPERTIES - SAME OWNER		EX. MARSH
	EX. TREELINE		HYDROGRAPHY, SURFACE FLOW
	FLOW		10 FOOT CONTOURS
	EX. SIGN		2 FOOT CONTOURS
	EX. TRAFFIC POLE		
	EX. UTILITY PEDESTAL		
	EX. RIPRAP		
	PROPOSED UTILITY EASEMENT		
	PROPOSED CONSTRUCTION EASEMENT		

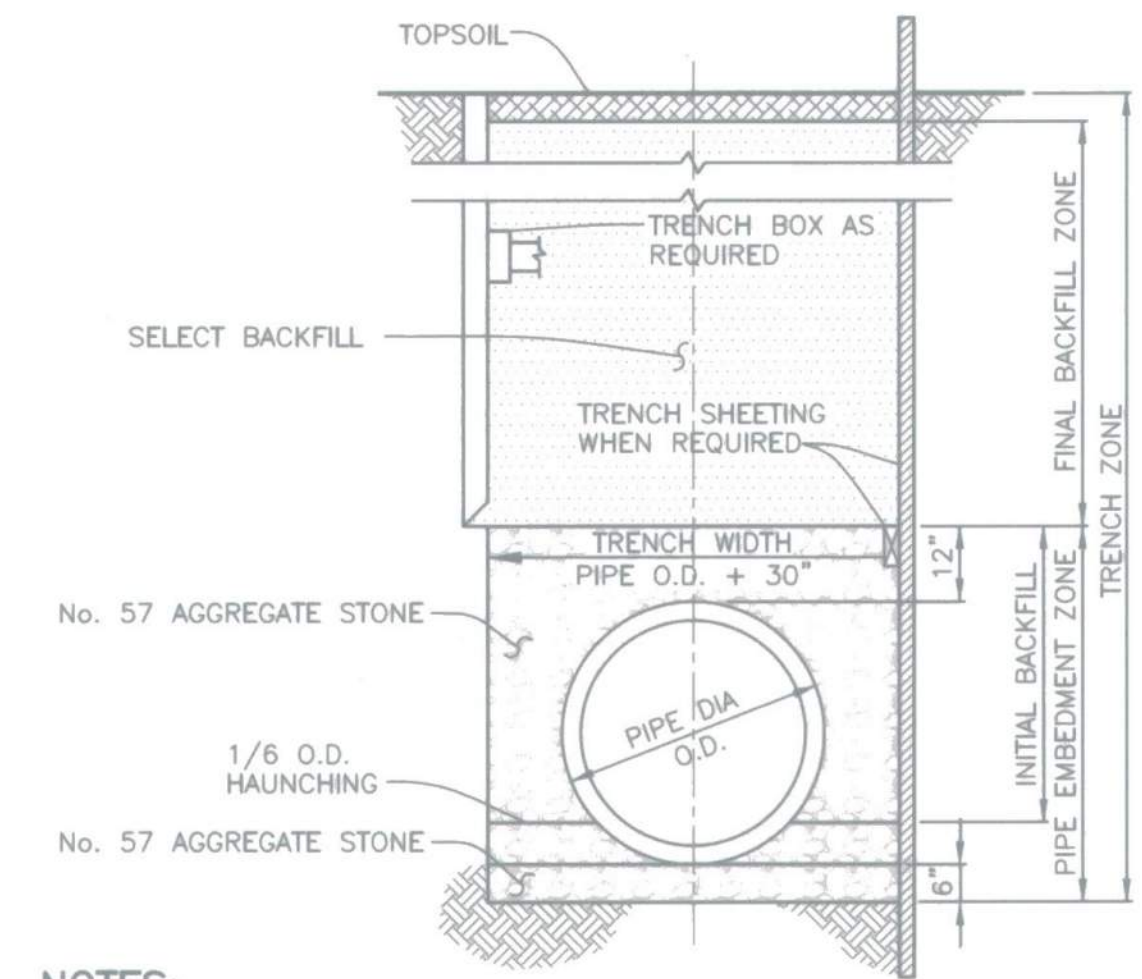

- NOTES:**
1. CONTRACTOR TO STRICTLY ADHERE TO SECTION 1000.03.05, "EXCAVATION AND SUBGRADE PREPARATION", OF THE STANDARD SPECIFICATIONS AND DETAILS OF CONSTRUCTION, VOLUME IV.
 2. TRENCH BACKFILL IN THE FINAL BACKFILL ZONE, FROM 12 INCHES ABOVE THE CROWN OF PIPE TO 6 INCHES BELOW THE FINAL GRADE, SHALL CONSIST OF SELECT BACKFILL.
 3. ALL TRENCHING IN ASPHALT ROADS SHALL BE RESTORED ACCORDING TO STANDARD DETAIL G-4.01 FOR ROADS WITH FLEXIBLE PAVEMENT.

AS-BUILT
DATE 12-22-2021

TRENCH DETAIL
NO SCALE

DEPARTMENT OF PUBLIC WORKS
HOWARD COUNTY, MARYLAND

Michael J. ... 1/12/2021
DIRECTOR OF PUBLIC WORKS DATE

Anthony ... 1/18/2021
CHIEF, BUREAU OF ENGINEERING DATE

... 1-11-21
CHIEF, BUREAU OF UTILITIES DATE

... 1/7/2021
CHIEF, UTILITY DESIGN DIVISION DATE

GMB
GEORGE, MILES & BUHR, LLC
ARCHITECTS & ENGINEERS
BALTIMORE • BALTICORE • SEAFORD
www.gmbnet.com






DES:	WMG				
DRN:	BRW				
CHK:	AWW				
DATE:	12/2020	BY:	NO.	REVISION	DATE

LEGEND, NOTES, AND DETAILS

600 SCALE MAP NO. 31 BLOCK NO. 4

BONNIE BRANCH
INTERCEPTOR SEWER IMPROVEMENTS
CONTRACT NO. 10-5034
2ND ELECTION DISTRICT
HOWARD COUNTY, MARYLAND


SCALE AS SHOWN
SHEET 02 OF 16

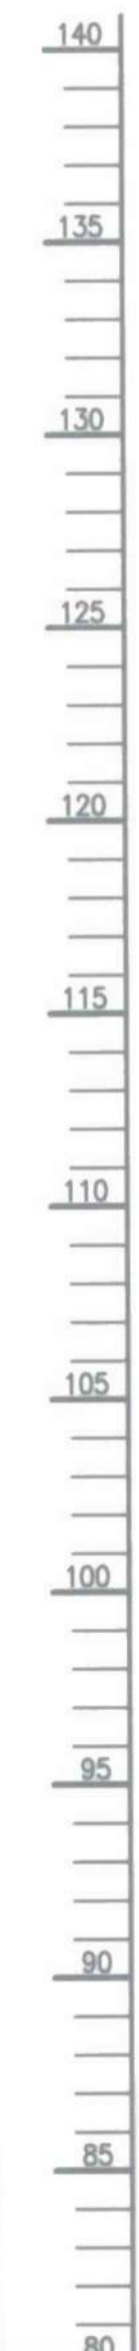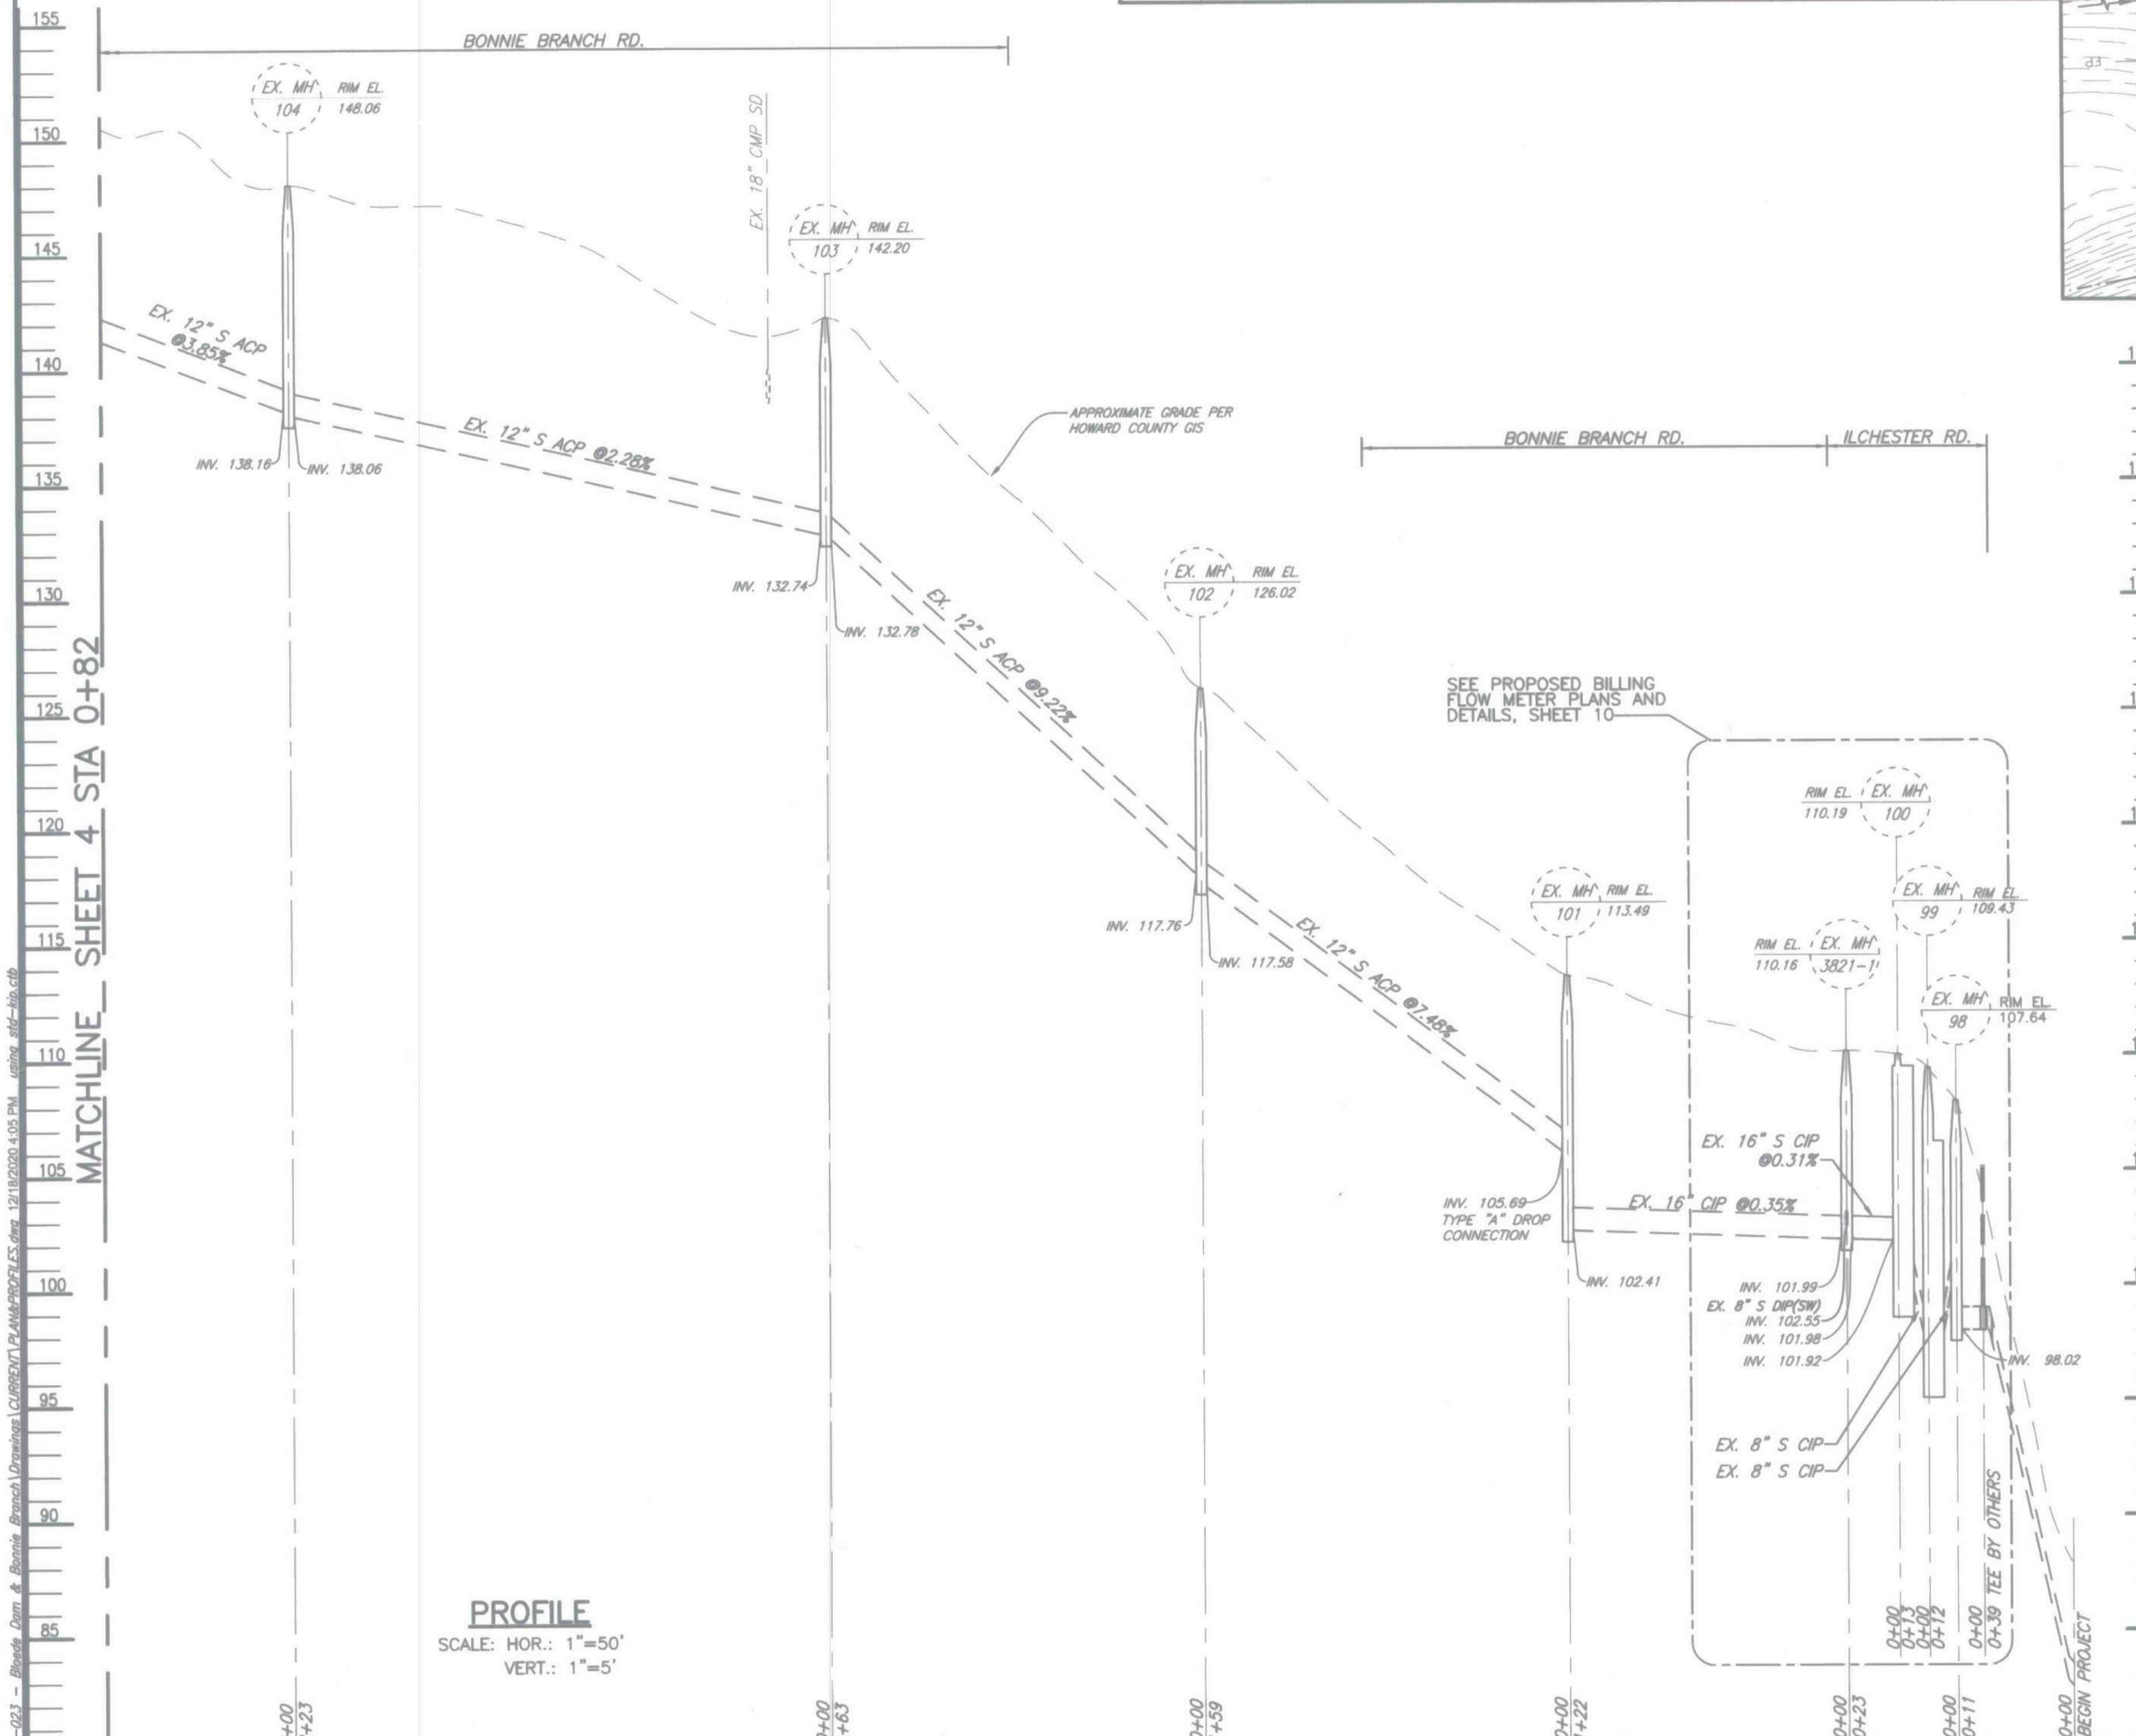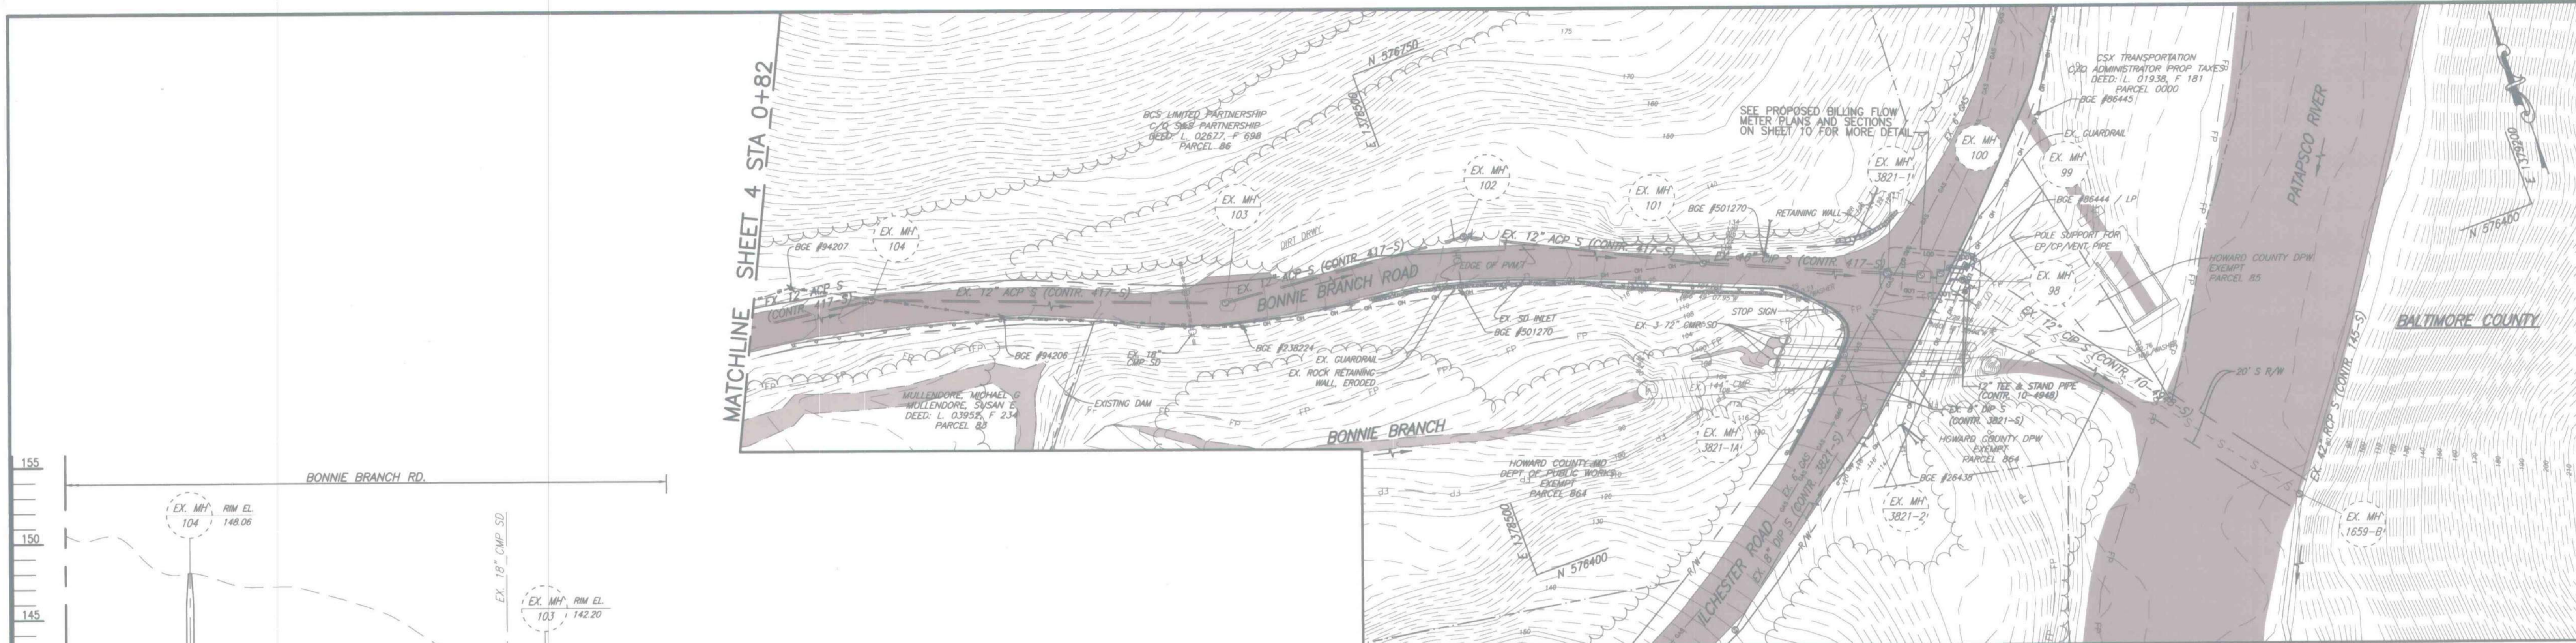

PLAN
SCALE: 1"=50'

NOTES:

- EXISTING MANHOLES TO BE REHABILITATED: 98, 3821-1, 101 THRU 104
- REFER TO STRUCTURE SCHEDULE SHEET 09 FOR INFORMATION ON ALL EXISTING AND PROPOSED STRUCTURES INCLUDING REHABILITATION OF EXISTING MANHOLES.
- INVERT ELEVATIONS AND PIPE INFORMATION BETWEEN MH 98 AND MH 3821-1 SHOWN ON SHEET 10.
- SEE SHEET 09 FOR TRAVERSE DETAILS.

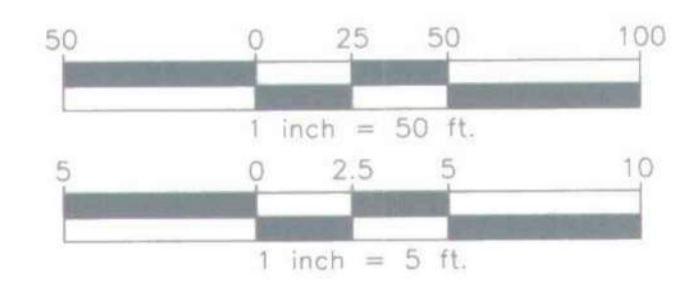

AS-BUILT
DATE 12-22-2021


DEPARTMENT OF PUBLIC WORKS
HOWARD COUNTY, MARYLAND

[Signature] 1/12/2021
DIRECTOR, PUBLIC WORKS DATE

[Signature] 1-8-2021
CHIEF, BUREAU OF ENGINEERING DATE

[Signature] 1-8-21
CHIEF, UTILITY DESIGN DIVISION DATE

GMB
GEORGE, MILES & BUHR, LLC
ARCHITECTS & ENGINEERS
SALISBURY • BALTIMORE • SEAFORD
www.gmbnet.com

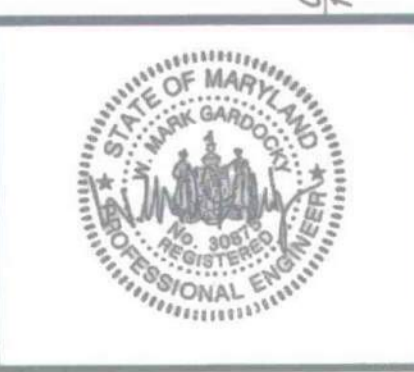

DES:	WMC				
DRN:	BRW				
CHK:	AWW				
DATE:	12/2020	BY:	NO.	REVISION	DATE


EXISTING
PLAN AND PROFILE

600 SCALE MAP NO. 31 BLOCK NO. 4


BONNIE BRANCH
INTERCEPTOR SEWER IMPROVEMENTS
CONTRACT NO. 10-5034
2ND ELECTION DISTRICT
HOWARD COUNTY, MARYLAND

SCALE AS SHOWN

SHEET 03 OF 16

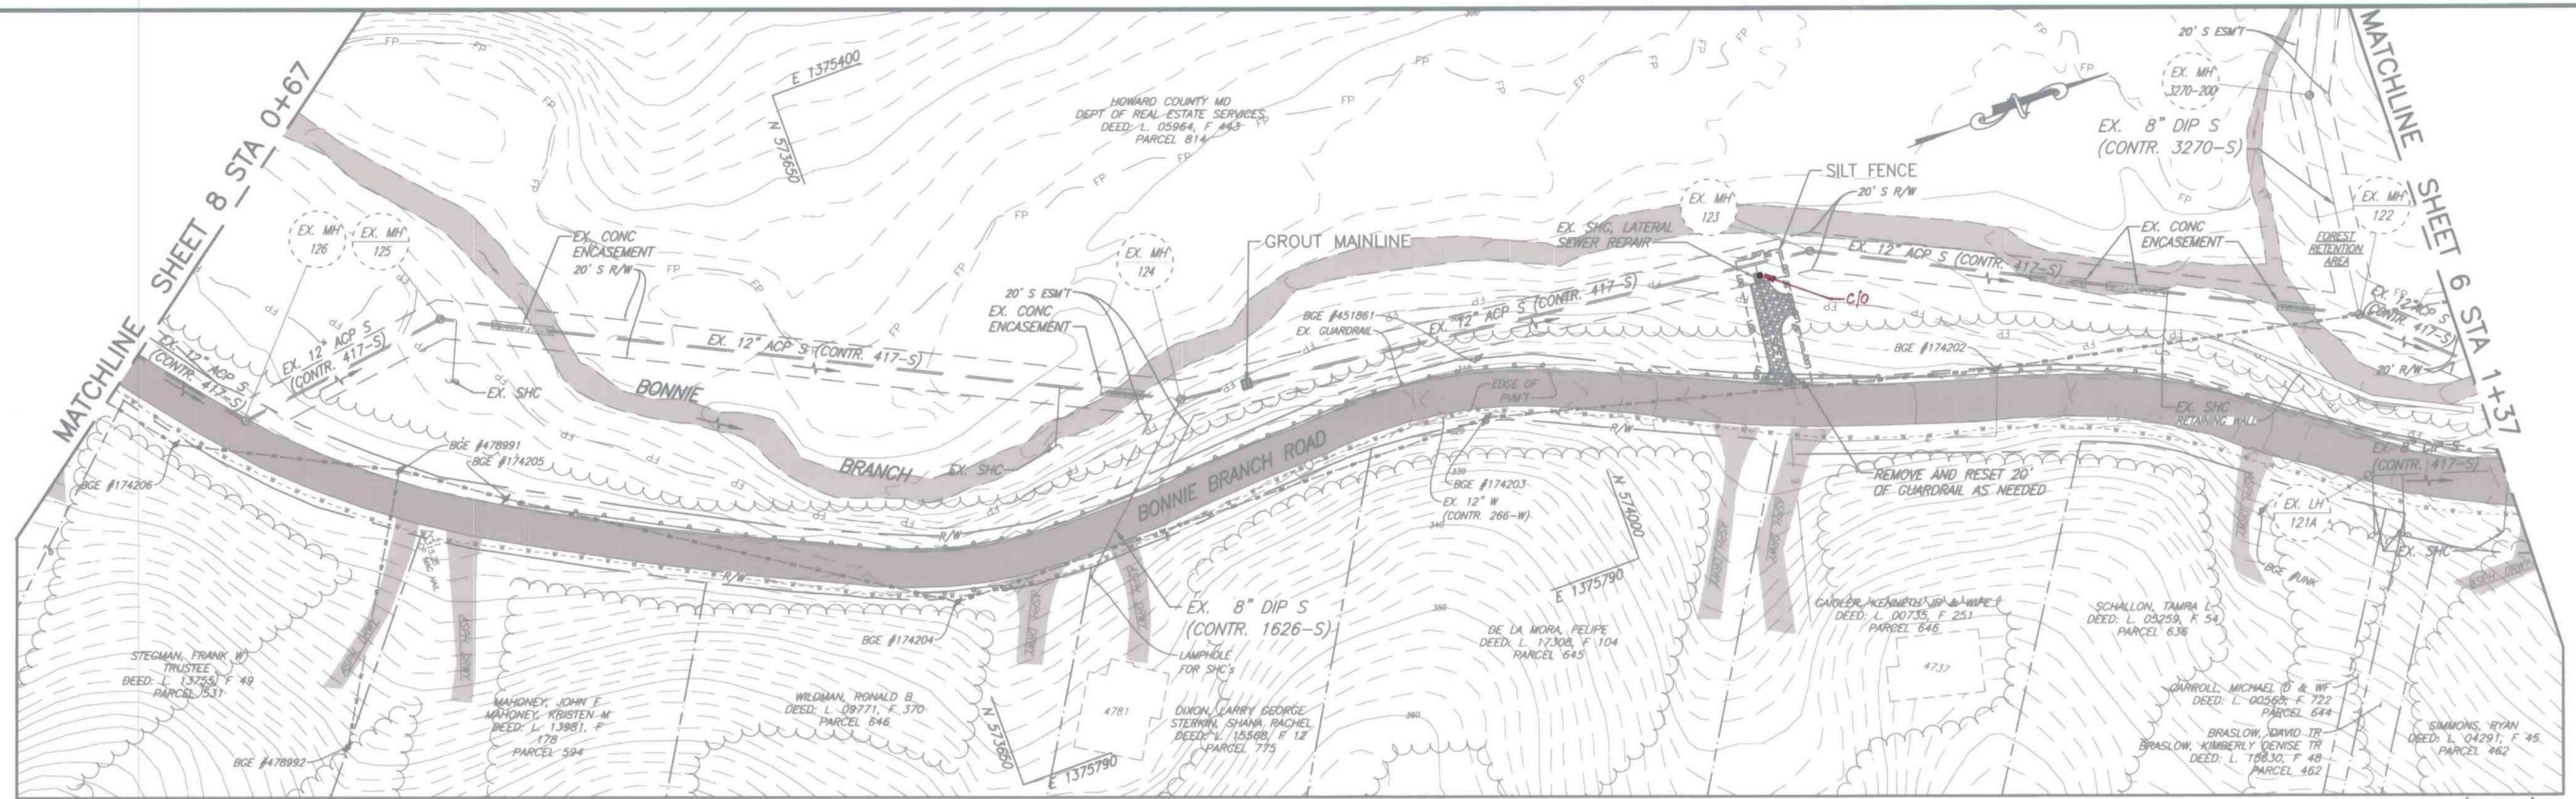


PLAN
SCALE: 1"=50'

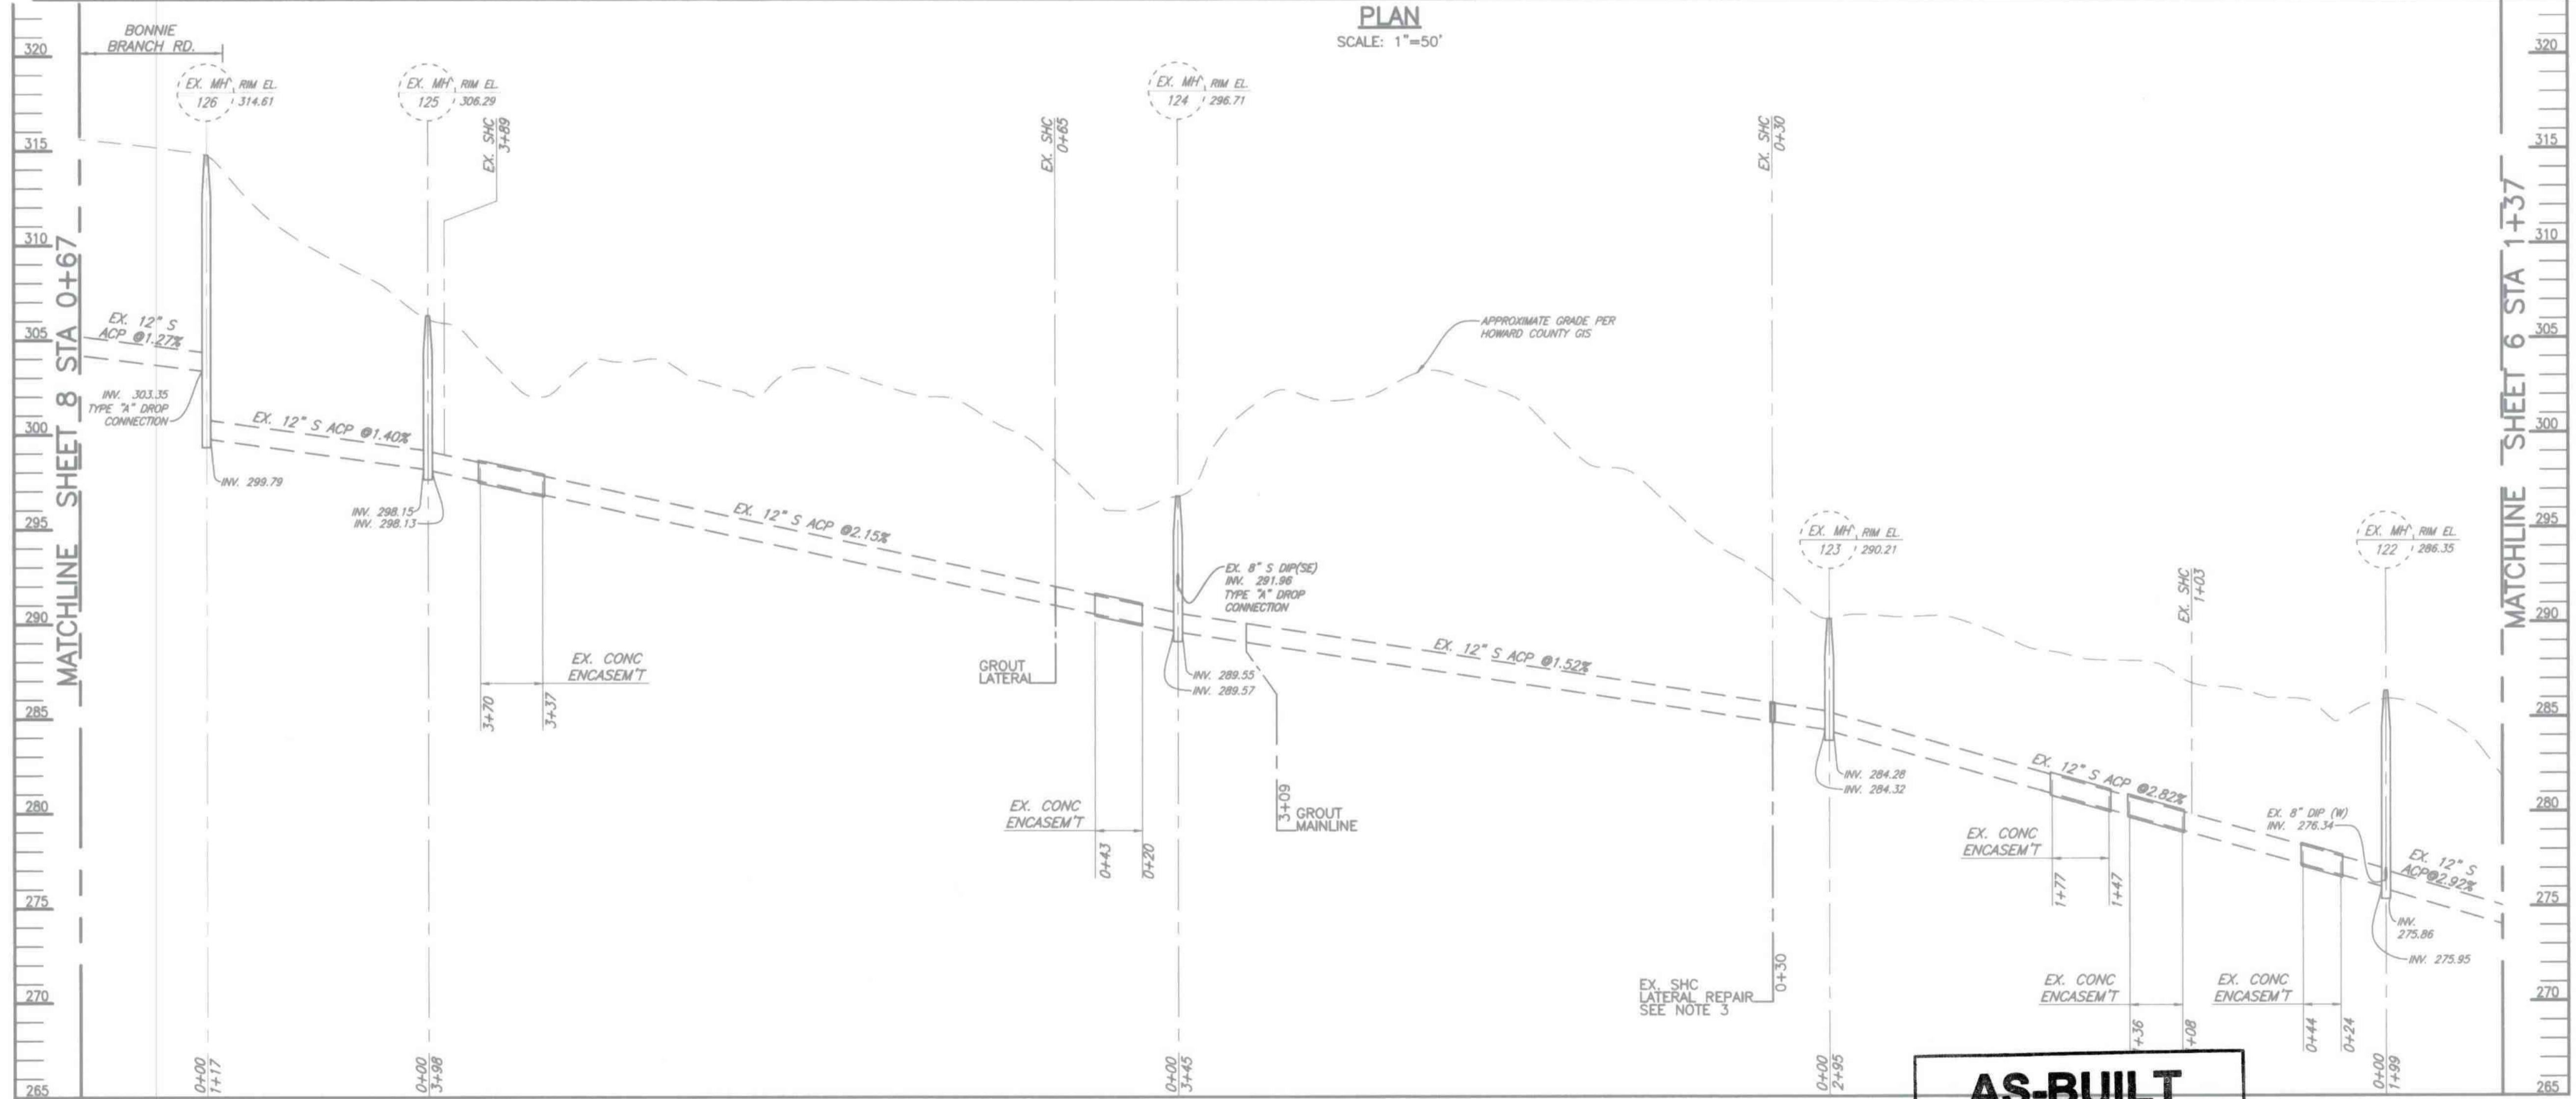

PROFILE
SCALE: HOR.: 1"=50'
VERT.: 1"=5'

- NOTES:**
- EXISTING MANHOLES TO BE REHABILITATED: 122 THRU 126
 - REFER TO STRUCTURE TABLE SHEET 09 FOR INFORMATION ON ALL EXISTING AND PROPOSED STRUCTURES INCLUDING REHABILITATION OF EXISTING MANHOLES.
 - CONTRACTOR SHALL CHECK AND COMPACT THE SUB-GRADE TO 6" MINIMUM AND FILL TRENCH TO 1'-0" ABOVE TOP OF PIPE WITH #57 STONE AND FILL THE REST OF THE WAY WITH SELECT BACKFILL.
 - STABILIZED CONSTRUCTION ENTRANCE PER MDE WMA DETAIL B-1.

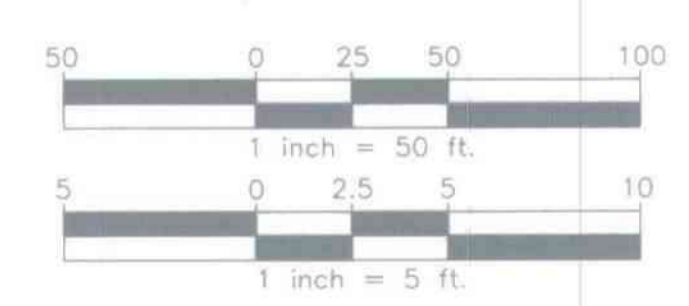



AS-BUILT
DATE 12-22-2021

12/22/2021 12:02:18 PM - Bonnie Branch Road Sewer Interceptor Improvements - 02 - Bonnie Branch Road Sewer Interceptor Improvements - 02 - Bonnie Branch Road Sewer Interceptor Improvements - 02 - Bonnie Branch Road Sewer Interceptor Improvements - 02

DEPARTMENT OF PUBLIC WORKS HOWARD COUNTY, MARYLAND		GMB GEORGE, MILES & BUHR, LLC ARCHITECTS & ENGINEERS SILVERBURY - BALTIMORE - SEAFORD www.gmbnet.com			
Director: <i>[Signature]</i> DATE: 1-8-2021	Chief, Bureau of Engineering: <i>[Signature]</i> DATE: 1-8-2021	Chief, Bureau of Utilities: <i>[Signature]</i> DATE: 1-8-2021	Chief, Utility Design Division: <i>[Signature]</i> DATE: 1-8-2021	DES: WMG DRN: BRW CHK: AWW DATE: 12/2020	BY: AMP NO.: AS-BUILT REVISION:


EXISTING PLAN AND PROFILE		600 SCALE MAP NO. 31	BLOCK NO. 4
----------------------------------	--	----------------------	-------------

BONNIE BRANCH INTERCEPTOR SEWER IMPROVEMENTS CONTRACT NO. 10-5034 2ND ELECTION DISTRICT HOWARD COUNTY, MARYLAND		SCALE AS SHOWN SHEET 07 OF 16
---	--	--------------------------------------

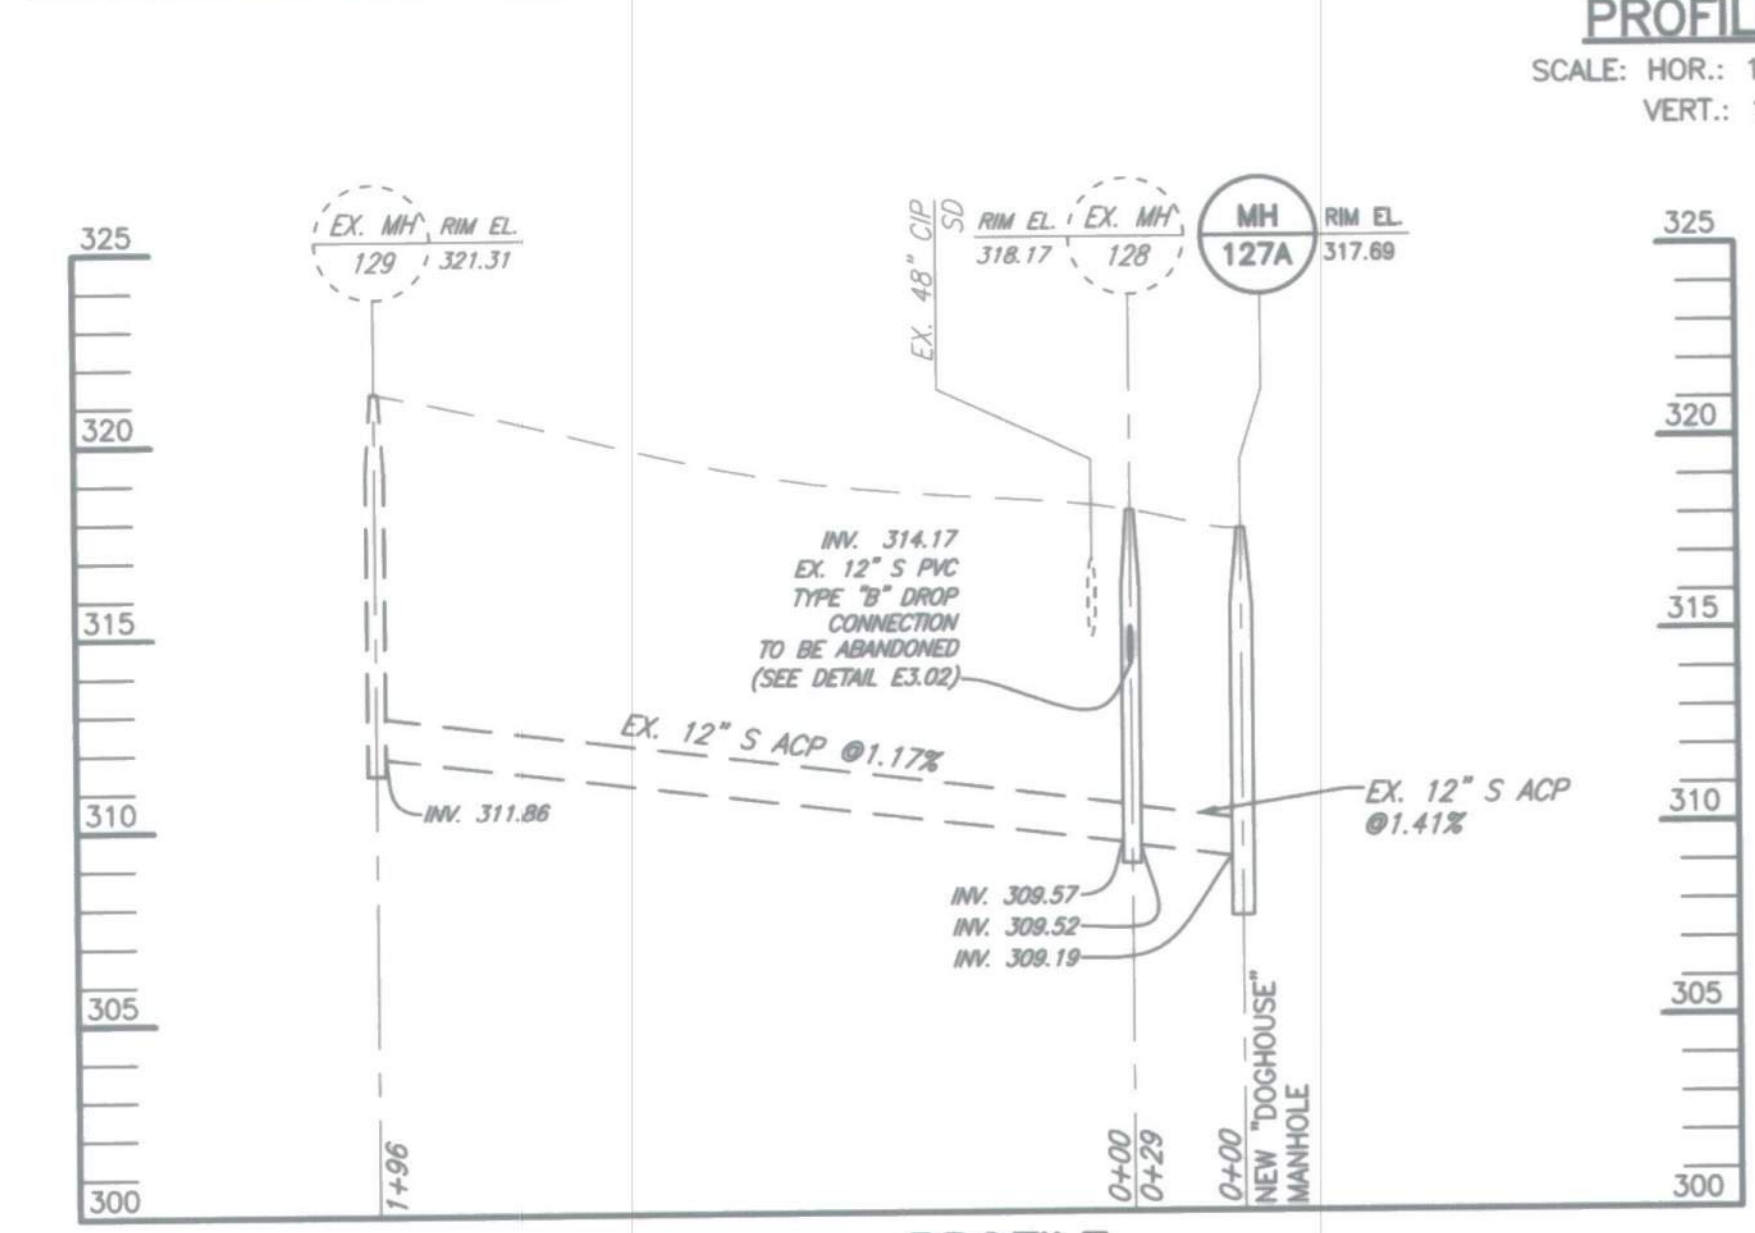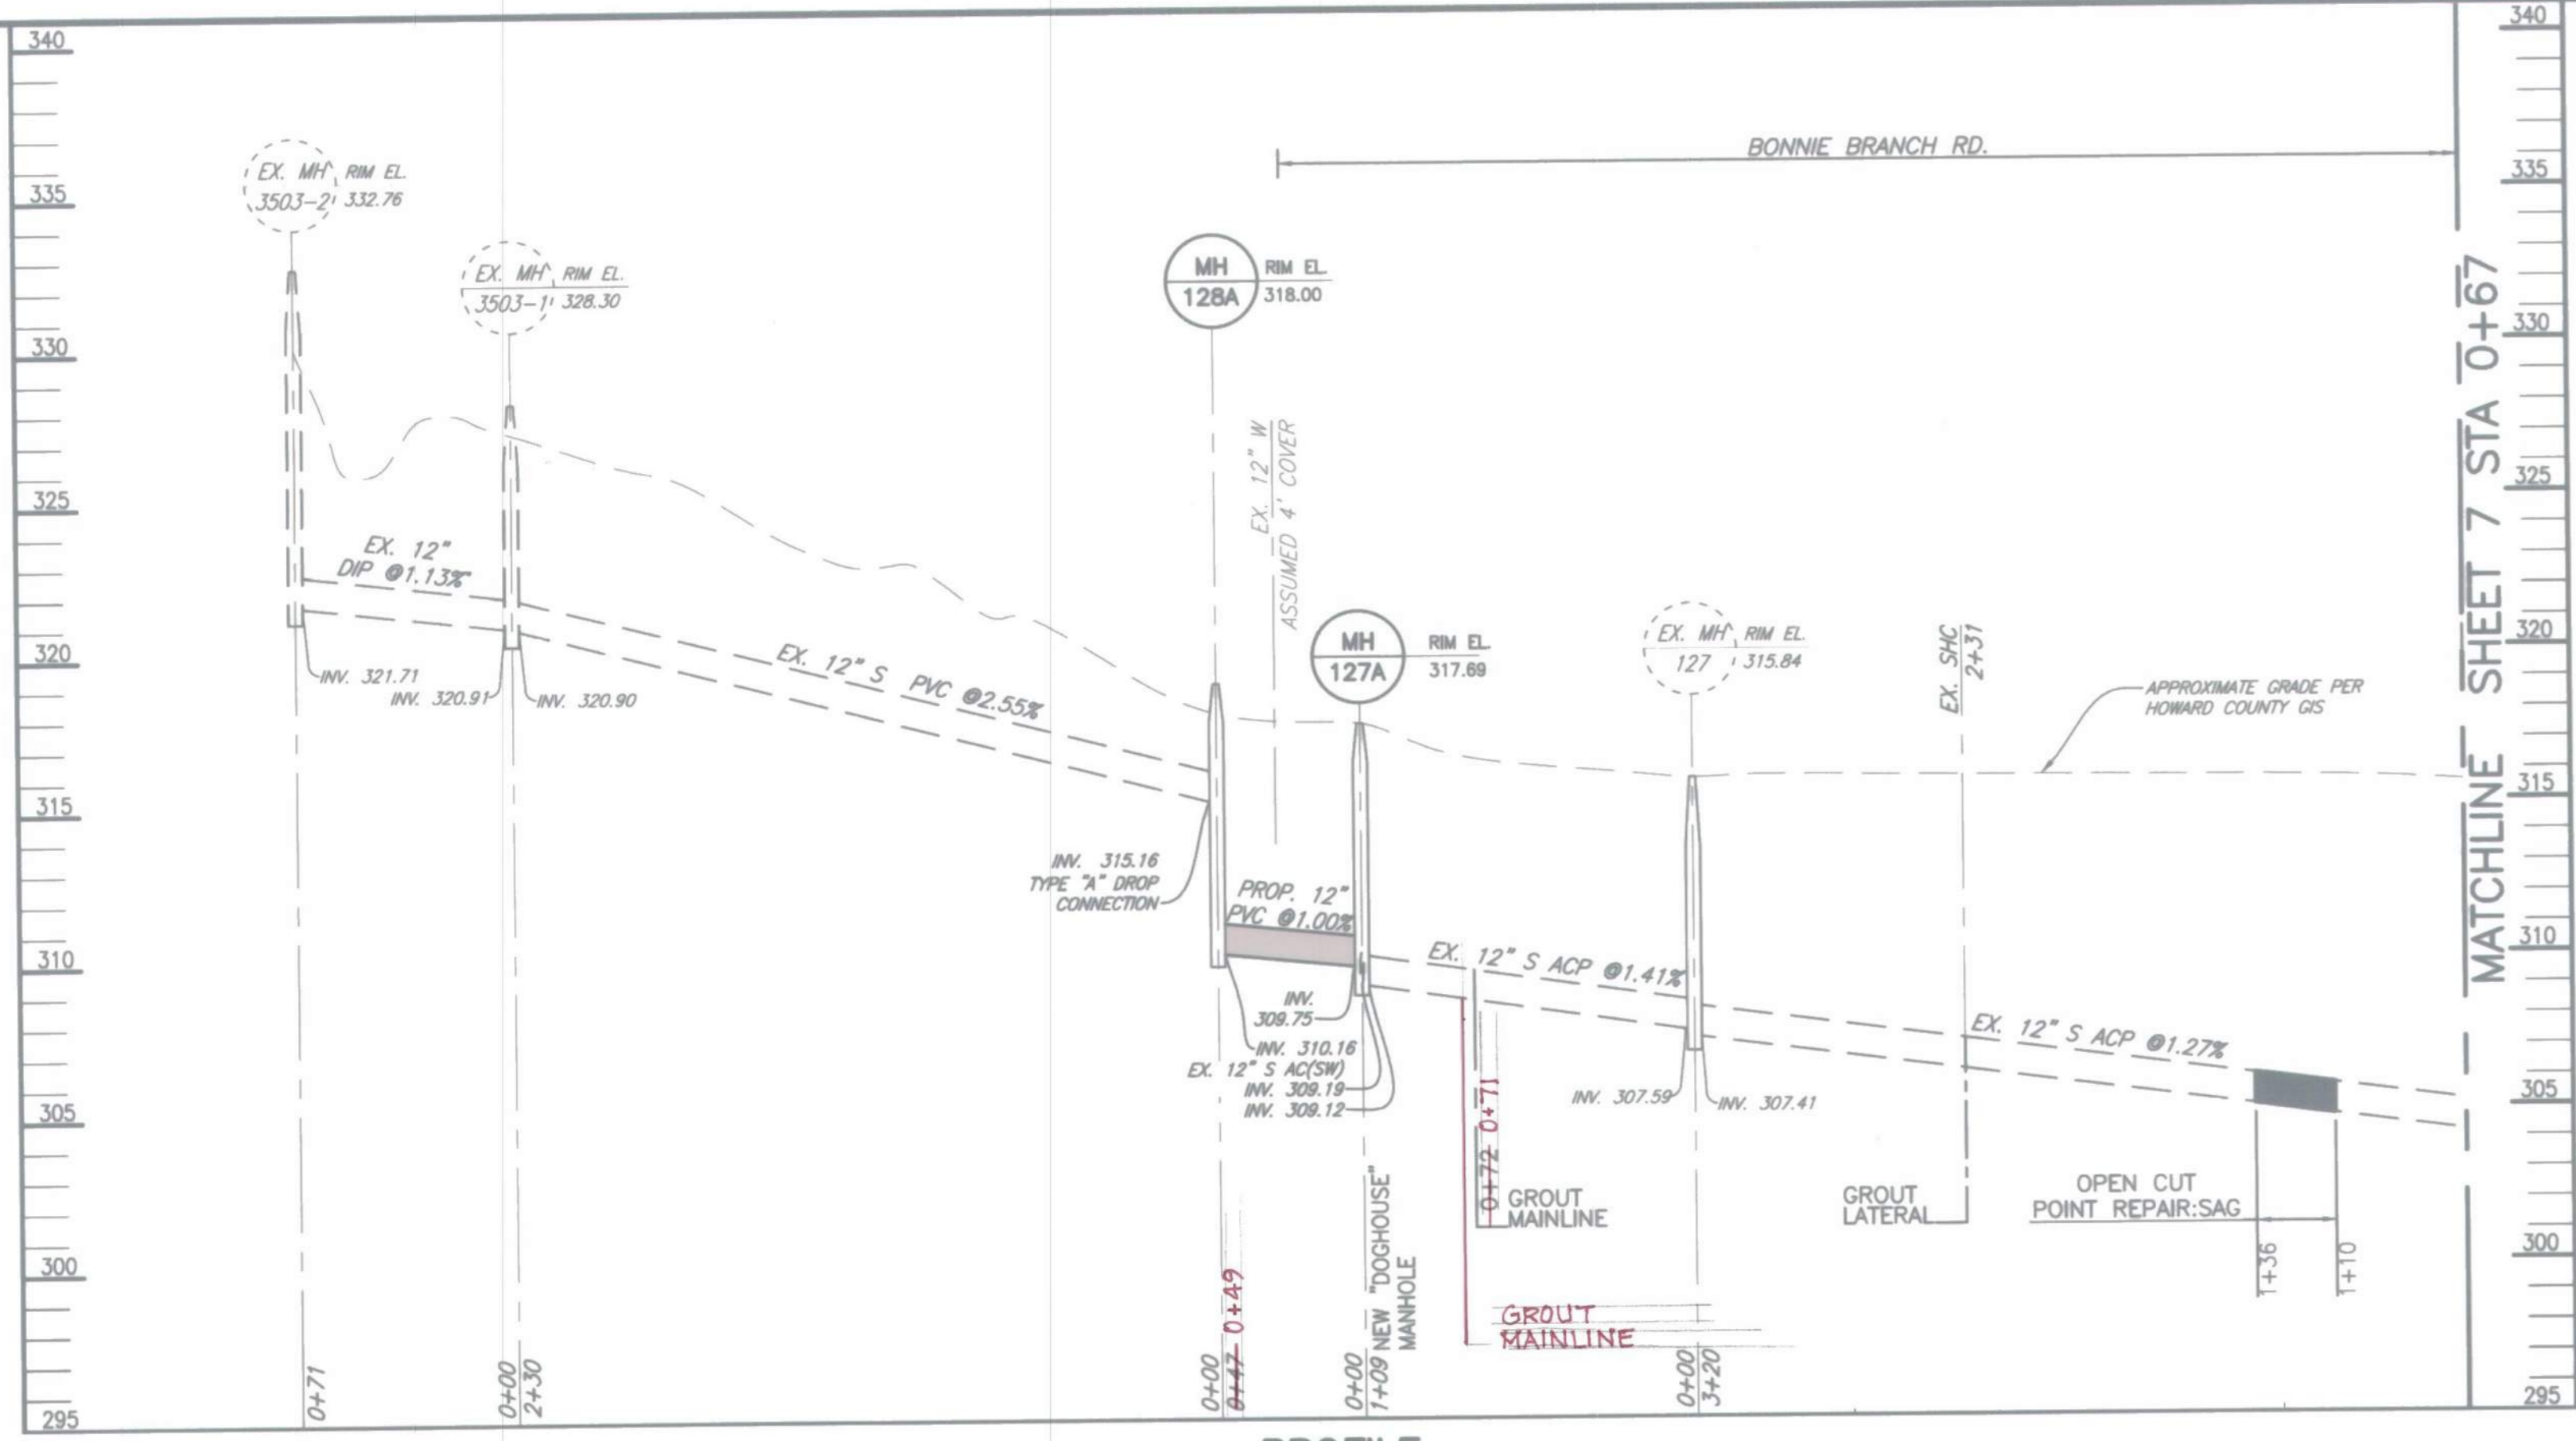


STAKEOUT					
No.	DISTANCE	BEARING	L-CURVE RADIUS	TANGENT	CHORD Brg. CHORD Lng.
1	14.3747	S00°22'50"W			
2	11.7005	N37°08'02"W			
3	8.7595	340.0000	4.3800	N54°46'26"E	8.7593
AREA	51.0507 sf				
POB	N 573020.7074		E 1376349.2016		

DETAIL PLAN
SCALE: 1"=20'

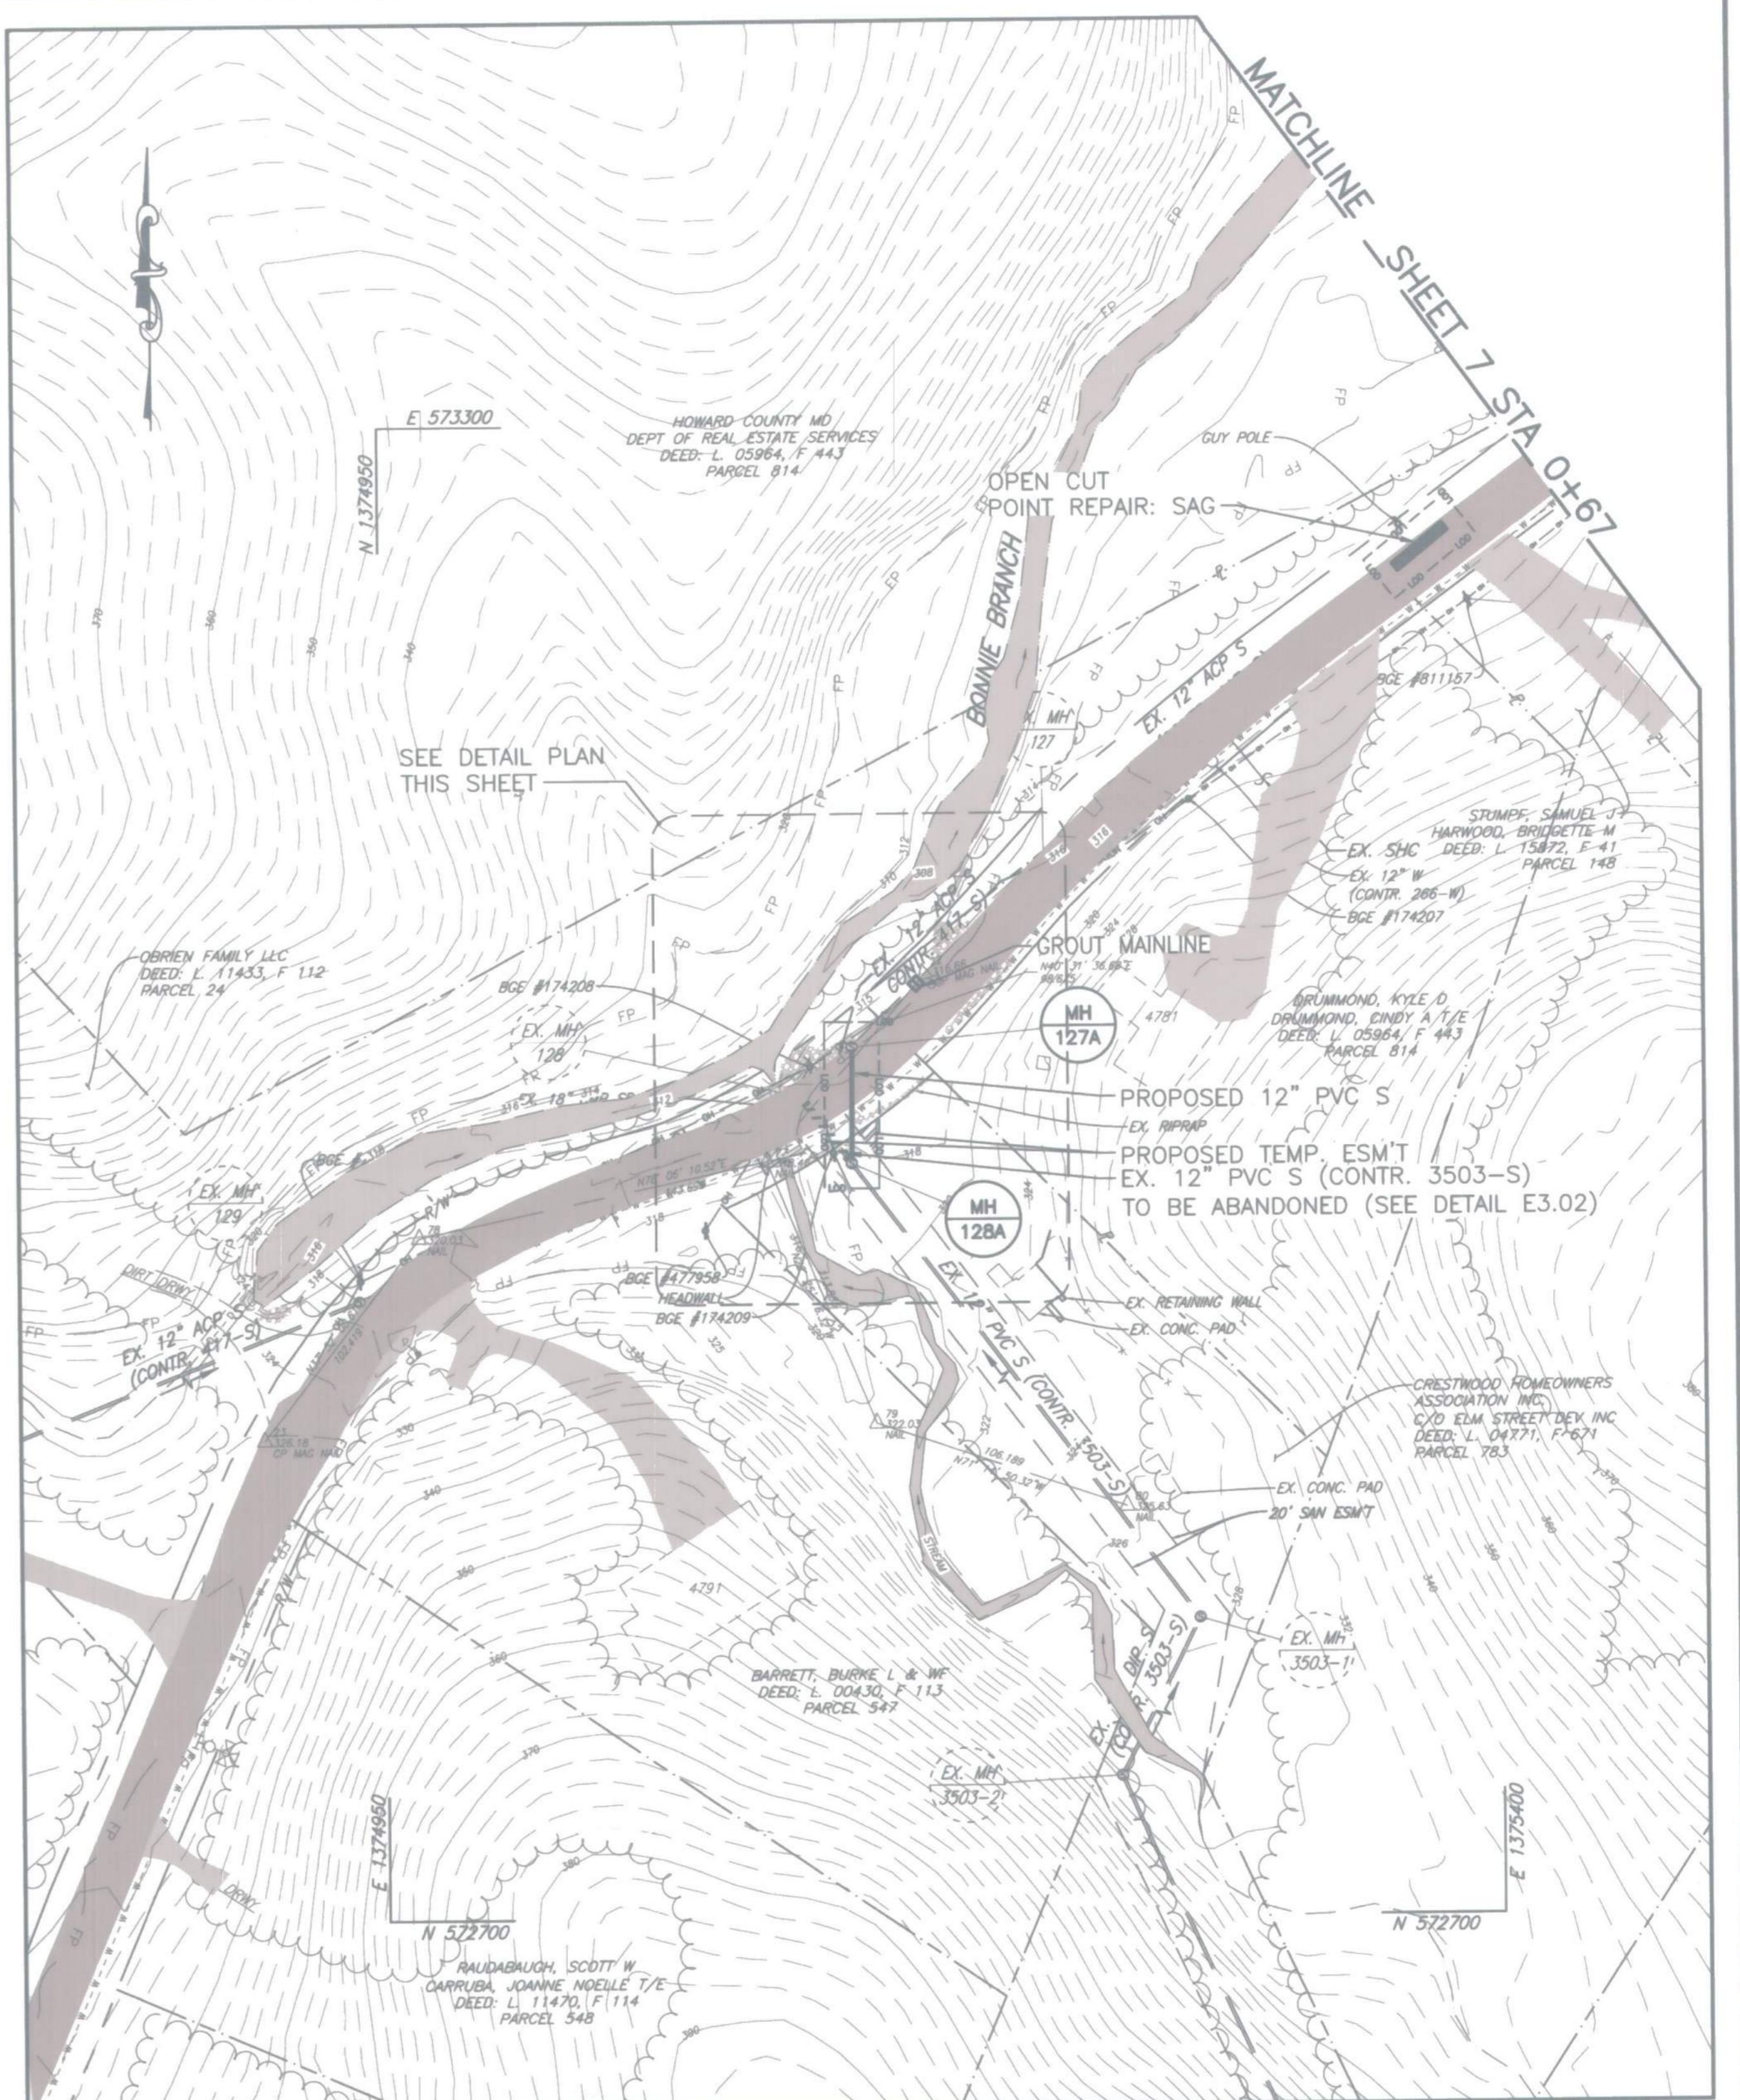

- NOTES:**
- EXISTING MANHOLES TO BE REHABILITATED: 127, 128
 - REFER TO STRUCTURE TABLE SHEET 09 FOR INFORMATION ON ALL EXISTING AND PROPOSED STRUCTURES INCLUDING REHABILITATION OF EXISTING MANHOLES.
 - CONTRACTOR SHALL CHECK AND COMPACT THE SUB-GRADE TO 6" MINIMUM AND FILL TRENCH TO 1'-0" ABOVE TOP OF PIPE WITH #57 STONE AND FILL THE REST OF THE WAY WITH SELECT BACKFILL.
 - SEE SHEET 09 FOR TRAVERSE DETAILS.
 - PIPE ABANDONMENT AT THE MANHOLE SHALL BE IN CONFORMANCE WITH STANDARD DETAIL E-3.02.
 - PROPOSED MANHOLE 127A SHALL BE A PRECAST DOGHOUSE MANHOLE WITH THE BASE OF THE MANHOLE CONSTRUCTED ACCORDING TO STANDARD DETAIL G-5.14 AND THE REST CONSTRUCTED ACCORDING TO THE 5'-0" DIAMETER PRECAST MANHOLE DETAIL ON SHEET 02.
 - PROPOSED MANHOLE 128A SHALL BE CONSTRUCTED ACCORDING TO THE 5'-0" DIAMETER PRECAST MANHOLE DETAIL ON SHEET 02.

AS-BUILT
DATE 12-22-2021

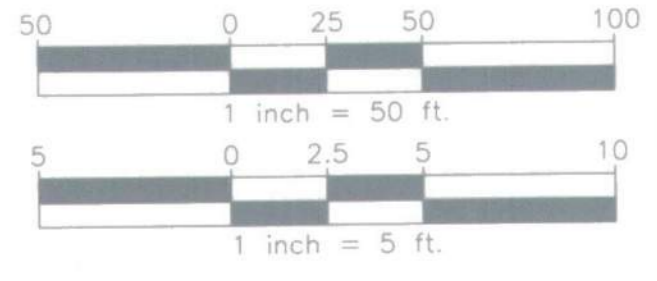


DEPARTMENT OF PUBLIC WORKS
HOWARD COUNTY, MARYLAND

[Signature] 1/2/2021
DIRECTOR, PUBLIC WORKS DATE

[Signature] 1-8-2021
CHIEF, BUREAU OF ENGINEERING DATE

[Signature] 1/7/2021
CHIEF, UTILITY DESIGN DIVISION DATE

GMB
GEORGE, MILES & BUHR, LLC
ARCHITECTS & ENGINEERS
BALTIMORE • BALTIMORE • SEAFORD
www.gmbnet.com

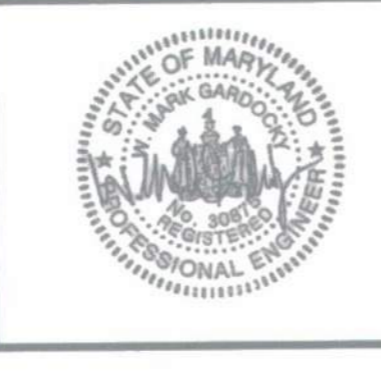


DES: WMG			
DRN: BRW			
CHK: AWW			
DATE: 12/2020	BY: AMP	NO.:	REVISION

EXISTING AND PROPOSED
PLAN AND PROFILE
AT MANHOLE 128

DATE: 600 SCALE MAP NO. 31 BLOCK NO. 4

BONNIE BRANCH
INTERCEPTOR SEWER IMPROVEMENTS
CONTRACT NO. 10-5034
2ND ELECTION DISTRICT
HOWARD COUNTY, MARYLAND


SCALE AS SHOWN
SHEET 08 OF 16

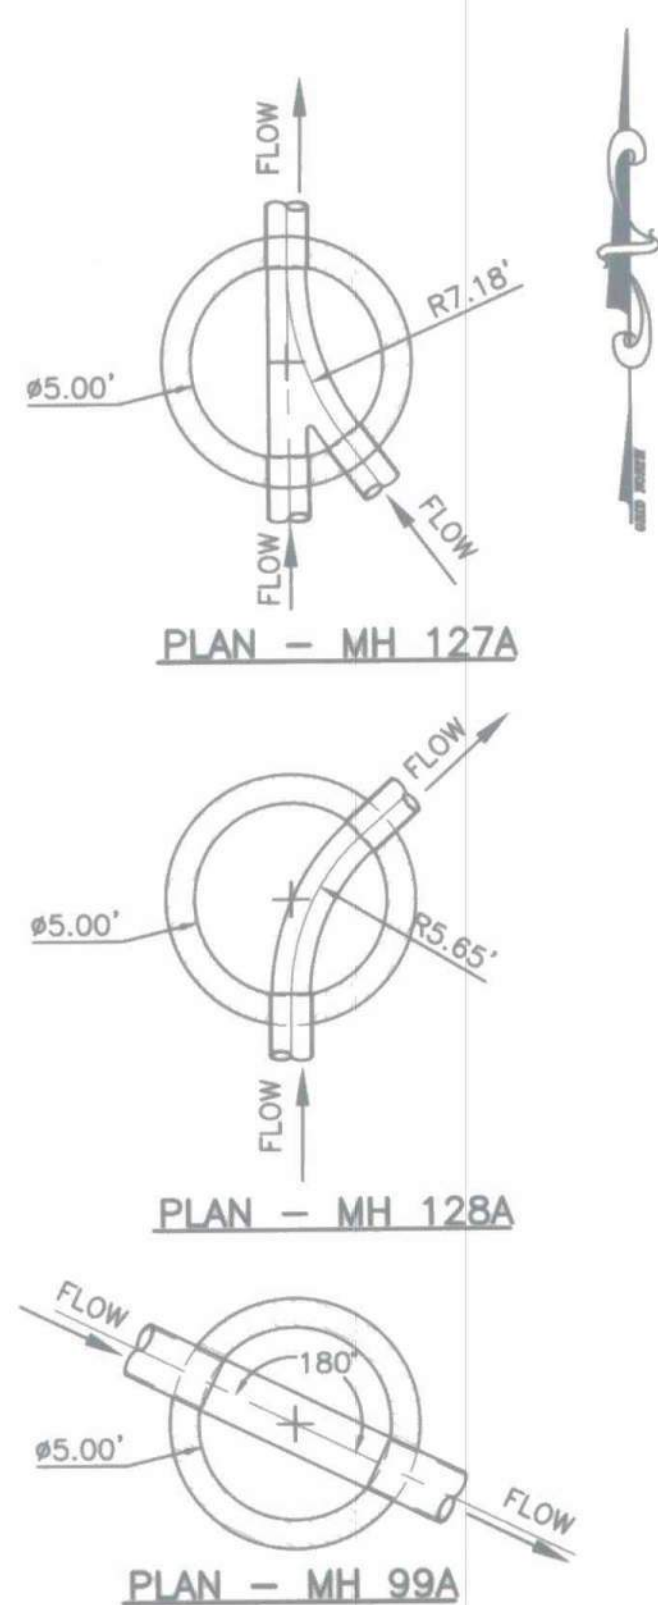

- NOTES:**
1. THE CENTERLINE OF ALL PIPES ENTERING A MANHOLE SHALL INTERSECT WITHIN 1"± OF THE LONGITUDINAL AXIS OF THE MANHOLE BARREL (CENTER).
 2. MANHOLE CHANNEL AND BENCH SHALL BE PRECAST OR FORMED USING SEWER BRICK (ASTM DESIGNATION C32-73, GRADE SM, SIZE NO. 1).
 3. CHANNEL SHALL PROVIDE SMOOTH HYDRAULIC TRANSITION BETWEEN PIPES.
 4. MINIMUM CENTERLINE CHANNEL RADIUS SHALL BE 2.5 x OUTLET PIPE DIAMETER.

MANHOLE CHANNEL CONFIGURATION DETAILS
SCALE: 1"=5'

TP No.	NORTHING	EASTING
BONNIE BRANCH ROAD + ILCHESTER ROAD, SHEET 03		
70	576401.10	1378918.57
75	576514.57	1378719.56
76	576555.60	1378623.76
SOUTH TRIBUTARY TO BONNIE BRANCH TO MH128, SHEET 08		
80	572394.59	1374319.93
79	572393.98	1374124.22
77	572156.64	1374127.97
ALONG BONNIE BRANCH ROAD AT MH128, SHEET 08		
78	572172.82	1374345.39
22	572611.04	1374344.02

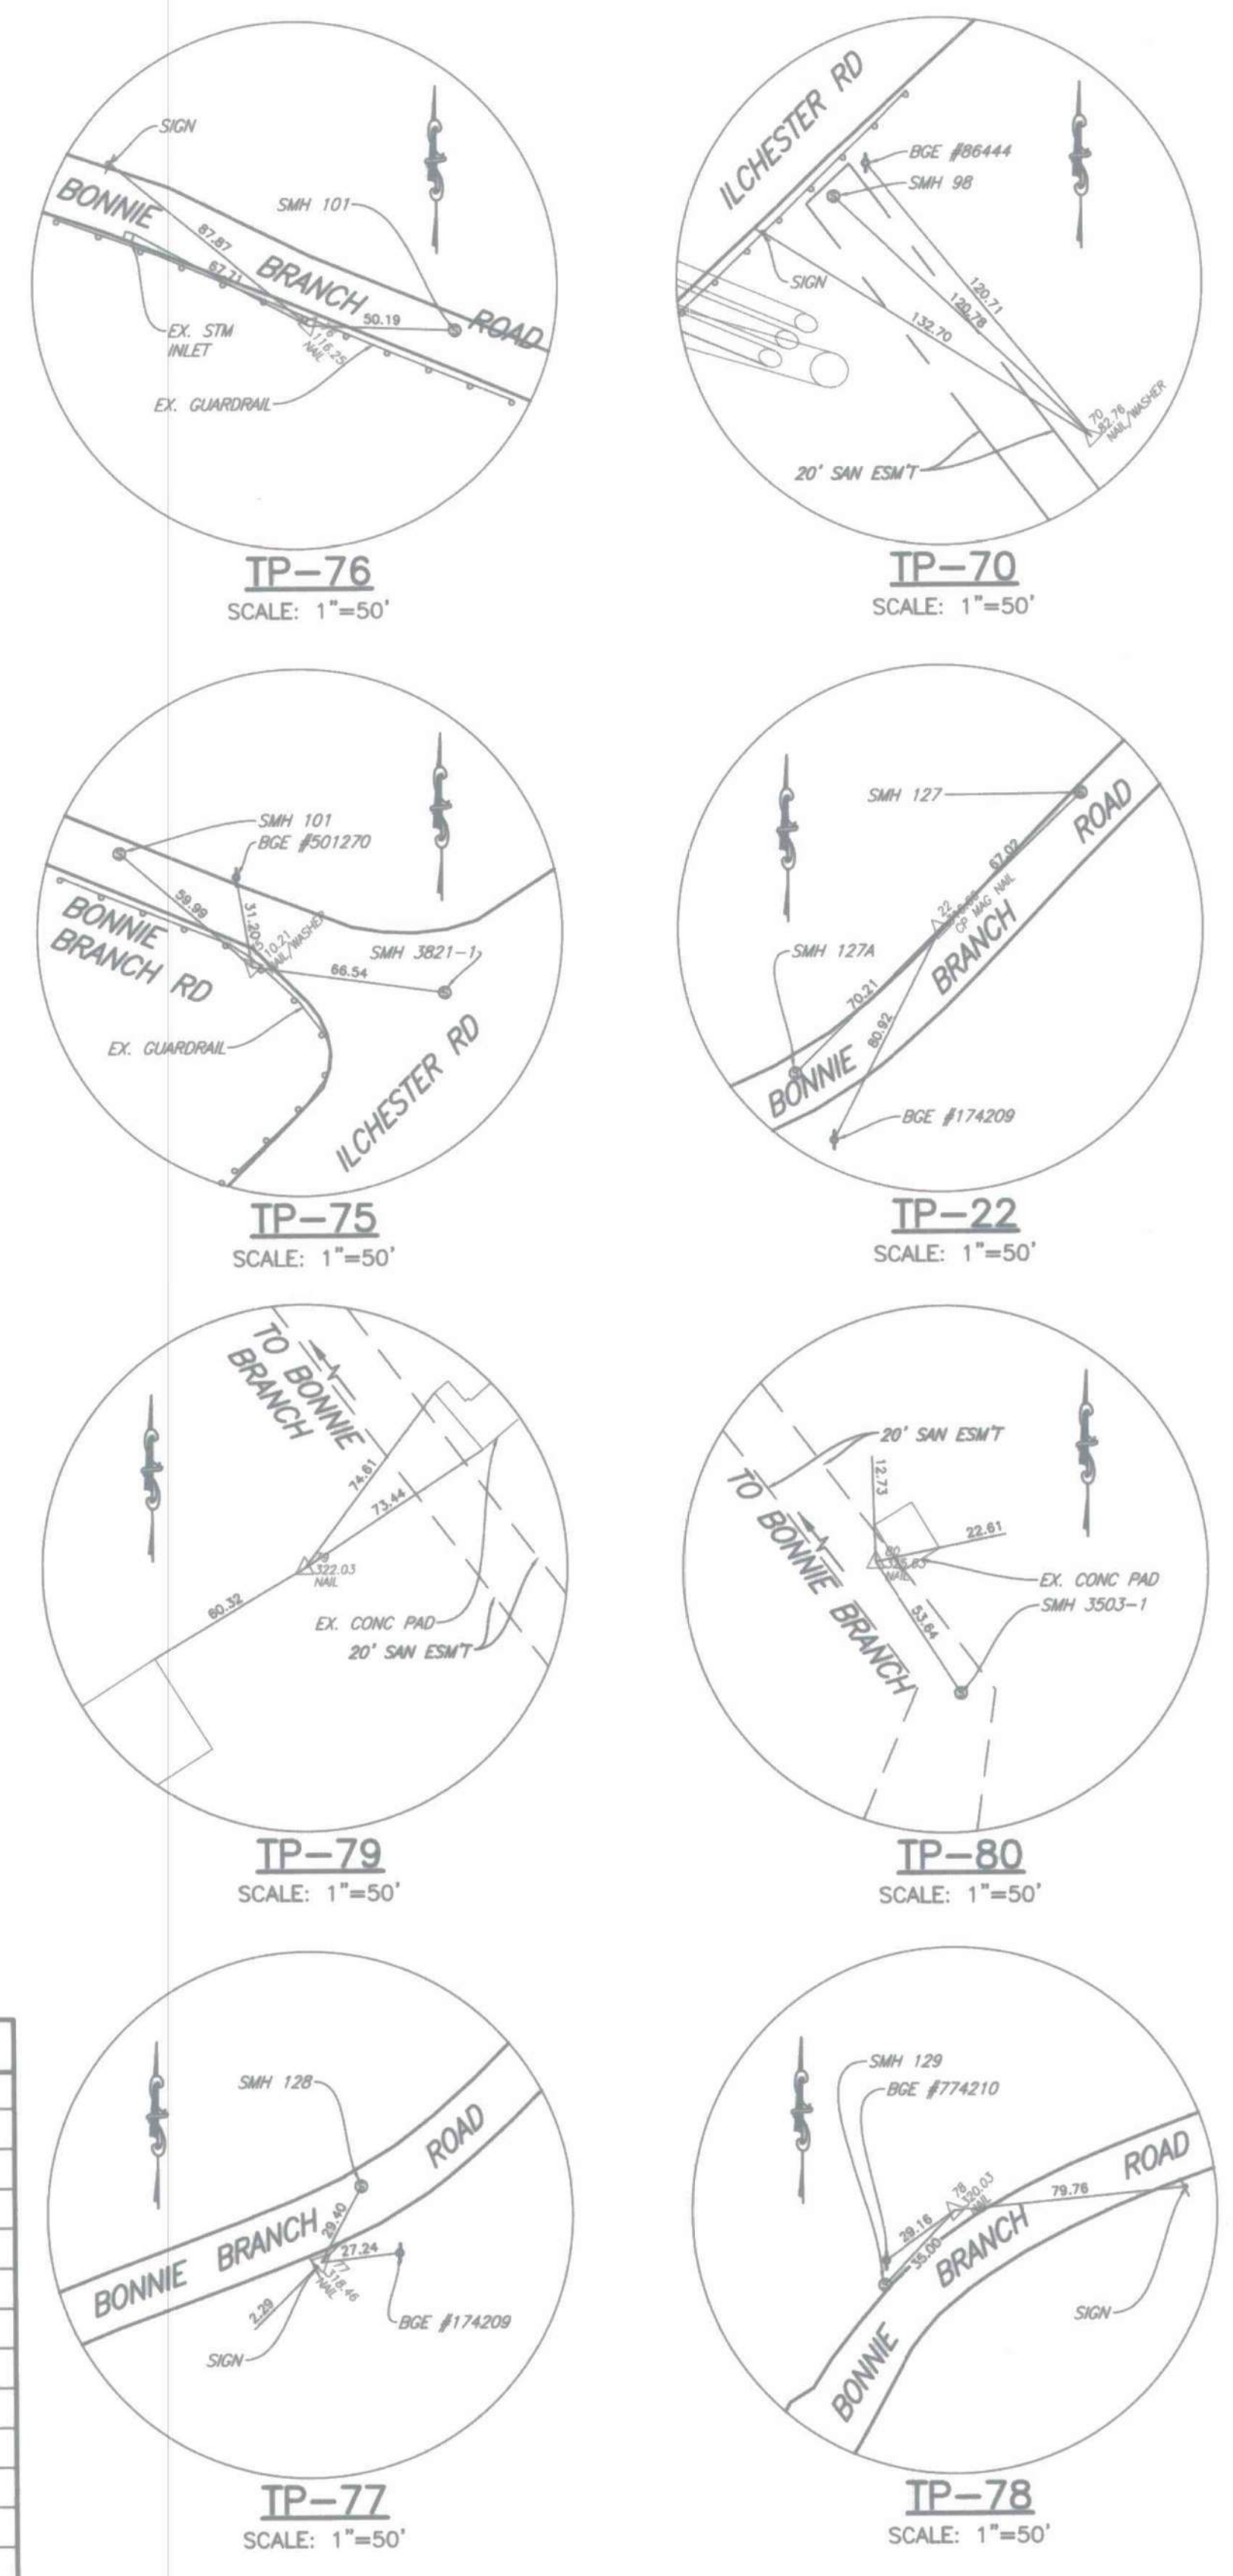


EXISTING MANHOLE SCHEDULE																			
Sheet Number	Contract	Manhole	Northing Coordinate	Easting Coordinate	Manhole Rim Elevation (ft)	Outgoing Invert Elevation (ft)	Incoming Invert Elevation (ft)	Secondary Incoming Inv. Elev. (ft)	Description of Secondary Incoming Line	Manhole Depth (ft)	Manhole Wall Dimension (ft)	Manhole Cover	Site	Manhole Grouting	Coat Base to 6 V.F. Epoxy-Polyurethane	Additional Coating Added (Vertical ft)	Replace Manhole Rungs	Install Manhole Insert	
3	417	98	576,484.83	1,378,831.09	107.64	98.02	98.27 101.21	-	-	9.62	4.00	Standard	Off-Road	-	Yes	3.62	8	1	
3	417	99	576,492.94	1,378,818.60	109.43	97.13	97.13	-	-	12.30	7.00 X 7.00	30-Inch Water-Tight	Pavement	-	N/A	N/A	N/A	N/A	
3	417	100	576,496.39	1,378,806.58	110.19	99.04	101.92	-	Outgoing Elevation from As-Built	11.15	5.00 X 7.00	Standard	Pavement	-	N/A	N/A	N/A	N/A	
3	3821	1	576,505.60	1,378,785.69	110.16	101.99	101.98	102.55	8-Inch Branch	8.17	4.00	Standard	Pavement	-	Yes	2.17	7	1	
3	417	101	576,553.59	1,378,673.84	113.49	102.41	105.69	-	-	11.08	4.00	Standard with Insert	Pavement	-	Yes	5.08	10	1	
3	417	102	576,625.07	1,378,531.81	126.02	117.58	117.76	-	-	8.44	4.00	Standard with Insert	Grass	Yes	Yes	2.44	7	1	
3	417	103	576,638.69	1,378,369.45	142.20	132.78	132.74	-	-	9.42	4.00	Standard with Insert	Pavement	-	Yes	3.42	8	1	
3	417	104	576,721.11	1,378,150.74	148.06	138.06	138.16	-	-	10.00	4.00	Standard with Insert	Pavement	-	Yes	4.00	9	1	
4	417	105	576,745.74	1,377,963.03	155.92	145.44	145.49	-	-	10.48	4.00	Standard with Insert	Pavement	-	Yes	4.48	9	1	
4	417	106	576,682.75	1,377,709.31	167.14	154.57	154.62	-	-	12.57	4.00	Standard with Insert	Pavement / Grass	Yes	Yes	6.57	12	1	
4	417	107	576,553.02	1,377,567.72	171.67	161.35	163.77	-	-	10.32	4.00	Standard with Insert	Pavement	-	Yes	4.32	9	1	
4	417	108	576,411.82	1,377,308.25	192.90	182.57	182.91	-	-	10.33	4.00	Standard	Off-Road Gutter	Yes	Yes	4.33	9	1	
4	417	109	576,309.15	1,377,252.28	200.28	190.05	190.09	-	-	10.23	4.00	Standard	Pavement (Edge)	-	Yes	4.23	9	1	
5	417	110	576,060.68	1,377,223.53	204.62	195.46	195.57	-	-	9.16	4.00	Standard with Insert	Pavement	Yes	Yes	3.16	8	1	
5	417	111	575,953.67	1,377,154.53	209.09	198.41	198.52	-	-	10.68	4.00	Standard	Pavement	Yes	Yes	4.68	10	1	
5	417	112	575,878.49	1,377,047.42	215.58	201.52	201.55	-	-	14.06	4.00	Standard with Insert	Off-Road	-	Yes	8.06	13	1	
5	417	113	575,677.96	1,376,853.75	225.69	212.99	217.55	212.95	Bottom of Mainline Drop Connection	12.70	4.00	Standard	Pavement	-	Yes	6.70	12	1	
5	417	114	575,349.67	1,376,738.78	239.21	229.46	230.66	-	-	9.75	4.00	Standard	Pavement	Yes	Yes	3.75	9	1	
6	417	115	575,272.88	1,376,518.45	249.49	238.54	238.69	-	-	10.95	4.00	Standard	Pavement	-	Yes	4.95	10	1	
6	417	116	575,261.46	1,376,297.35	255.65	248.18	248.24	248.70	8-Inch Branch	7.47	4.00	Standard, Bolted	Off-Road	Yes	Yes	1.47	6	1	
6	417	117	575,144.64	1,376,183.24	263.33	250.98	251.09	251.25 / 257.40	8-Inch Branch / 6-Inch Branch	12.35	4.00	Standard	Pavement	Yes	Yes	6.35	11	1	
6	417	118	575,014.56	1,376,065.14	266.97	253.94	253.95	-	-	13.03	4.00	Standard	Pavement	-	Yes	7.03	12	1	
6	417	119	574,852.91	1,375,846.12	274.13	261.25	261.37	-	-	12.88	4.00	Standard	Pavement	Yes	Yes	6.88	12	1	
6	417	120	574,706.53	1,375,873.30	280.84	265.57	265.71	-	-	15.27	4.00	Standard	Pavement (Edge)	Yes	Yes	9.27	14	1	
6	417	121	574,550.63	1,375,937.48	284.72	270.05	270.05	270.39 / 270.87	8-Inch / 6-Inch Branch	14.67	4.00	Standard	Pavement	Yes	Yes	8.67	14	1	
7	417	122	574,405.89	1,375,800.72	286.35	275.86	275.95	276.34	6-Inch Branch	10.49	4.00	Standard, Bolted	Off-Road	Yes	Yes	4.49	9	1	
7	417	123	574,141.96	1,375,667.93	290.21	284.28	284.32	-	-	5.93	4.00	Standard with Insert	Off-Road	-	Yes	0	5	1	
7	417	124	573,799.31	1,375,626.33	296.71	289.55	289.57	291.96	8-Inch Branch	7.16	4.00	Water-Tight	Off-Road	Yes	Yes	1.16	6	0	
7	417	125	573,442.40	1,375,450.82	306.29	298.13	298.15	-	-	8.16	4.00	Standard	Off-Road	Yes	Yes	2.16	7	1	
7	417	126	573,326.01	1,375,465.97	314.61	299.79	303.35	299.84	Bottom of Mainline Drop Connection	14.82	4.00	Standard	Pavement / Grass	-	Yes	8.82	14	1	
8	417	127	573,125.42	1,375,217.25	315.84	307.41	307.59	-	-	8.43	4.00	Standard	Pavement	-	Yes	2.43	8	1	
8	417	128	573,030.18	1,375,118.78	318.17	309.52	309.57	314.17 / 309.57	Bottom of Mainline Drop Connection / 10-Inch Branch	8.65	4.00	Standard	Pavement	-	Yes	2.65	8	1	
																Totals:	137.34	285	29

PROPOSED MANHOLE SCHEDULE																			
Sheet Number	Contract	Manhole	Northing Coordinate	Easting Coordinate	Manhole Rim Elevation (ft)	Outgoing Invert Elevation (ft)	Incoming Invert Elevation (ft)	Secondary Incoming Inv. Elev. (ft)	Description of Secondary Incoming Line	Manhole Depth (ft)	Manhole Wall Dimension (ft)	Manhole Cover	Site	Manhole Grouting	Coat Base to 6 V.F. Epoxy-Polyurethane	Additional Coating Added (Vertical ft)	Replace Manhole Rungs	Install Manhole Insert	
10	5034	99A	576,490.92	1,378,817.68	109.46	101.87 101.43	101.87 101.43	-	-	7.59	5.00	Standard	Pavement	-	Yes	1.59	N/A	1	
8	5034	127A	573,053.78	1,375,143.42	316.36	309.04	309.64	309.04	12-Inch from MH 128	7.32	5.00	Standard	Pavement	-	Yes	1.32	N/A	1	
8	5034	128A	572,997.77	1,375,143.04	318.21	310.16	315.21	310.17	Bottom of Mainline Drop Connection	8.05	5.00	Standard	Off-Road	-	Yes	2.05	N/A	1	
																Totals:	4.96	0	3


AS-BUILT
DATE 12-22-2021

DEPARTMENT OF PUBLIC WORKS HOWARD COUNTY, MARYLAND DIRECTOR OF PUBLIC WORKS CHIEF, BUREAU OF UTILITIES	 CHIEF, BUREAU OF ENGINEERING CHIEF, UTILITY DESIGN DIVISION	1-8-2021 DATE 1/7/2021 DATE	 GEORGE, MILES & BUHR, LLC ARCHITECTS & ENGINEERS SALISBURY • BALTIMORE • SEAFORD www.gmbnet.com	 STATE OF MARYLAND DEPARTMENT OF PUBLIC WORKS HOWARD COUNTY	DES: WMG DRN: BRW CHK: AWW DATE: 12/2020 BY: NO. REVISION DATE	STRUCTURE SCHEDULE 600 SCALE MAP NO. 31 BLOCK NO. 4	BONNIE BRANCH INTERCEPTOR SEWER IMPROVEMENTS CONTRACT NO. 10-5034 2ND ELECTION DISTRICT HOWARD COUNTY, MARYLAND	SCALE AS SHOWN SHEET 09 OF 16
---	--	--------------------------------------	--	--	--	--	---	----------------------------------

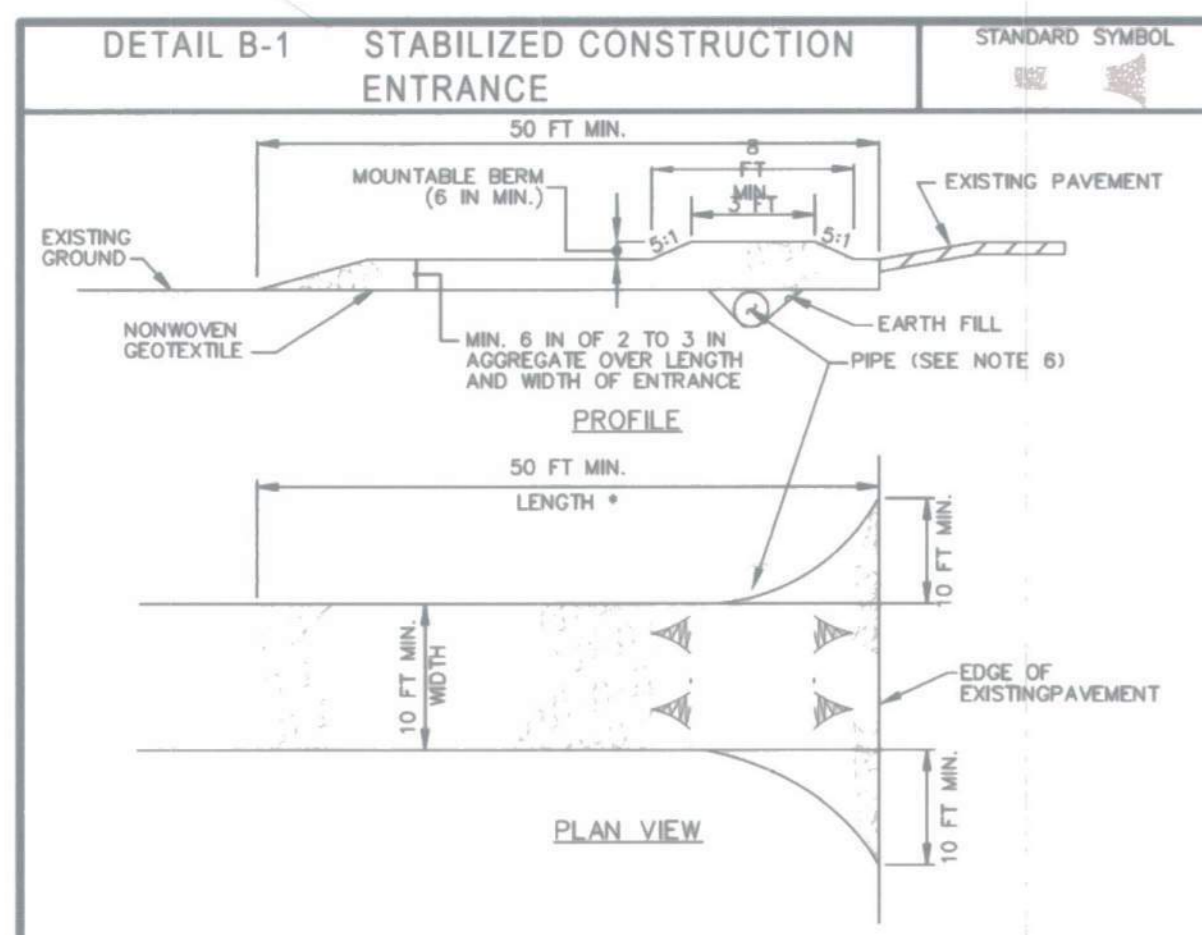


- CONSTRUCTION SPECIFICATIONS**
- PLACE STABILIZED CONSTRUCTION ENTRANCE IN ACCORDANCE WITH THE APPROVED PLAN. VEHICLES MUST TRAVEL OVER THE ENTIRE LENGTH OF THE SCE. USE MINIMUM LENGTH OF 50 FEET (10-30 FEET FOR SINGLE RESIDENCE LOT). USE MINIMUM WIDTH OF 10 FEET. FLARE SCE TO 10 FEET MINIMUM AT THE EXISTING ROAD TO PROVIDE A TURNING RADIUS.
 - PIPE ALL SURFACE WATER FLOWING TO OR DIVERTED TOWARD THE SCE UNDER THE ENTRANCE. MAINTAIN POSITIVE DRAINAGE. PROTECT PIPE INSTALLED THROUGH THE SCE WITH A MOUNTABLE BERM WITH 5:1 SLOPES AND A MINIMUM OF 12 INCHES OF STONE OVER THE PIPE. PROVIDE PIPE AS SPECIFIED ON APPROVED PLAN. WHEN THE SCE IS LOCATED AT A HIGH SPOT AND HAS NO DRAINAGE TO CONVEY, A PIPE IS NOT NECESSARY. A MOUNTABLE BERM IS REQUIRED WHEN SCE IS NOT LOCATED AT A HIGH SPOT.
 - PREPARE SUBGRADE AND PLACE NONWOVEN GEOTEXTILE, AS SPECIFIED IN SECTION H-1 MATERIALS.
 - PLACE CRUSHED AGGREGATE (2 TO 3 INCHES IN SIZE) OR EQUIVALENT RECYCLED CONCRETE (WITHOUT REBAR) AT LEAST 6 INCHES DEEP OVER THE LENGTH AND WIDTH OF THE SCE.
 - MAINTAIN ENTRANCE IN A CONDITION THAT MINIMIZES TRACKING OF SEDIMENT. ADD STONE OR MAKE OTHER REPAIRS AS CONDITIONS DEMAND TO MAINTAIN CLEAN SURFACE. MOUNTABLE BERM, AND SPECIFIED DIMENSIONS. IMMEDIATELY REMOVE STONE AND/OR SEDIMENT SPILLED, DROPPED, OR TRACKED ONTO ADJACENT ROADWAY BY VACUUMING, SCRAPING, AND/OR SWEEPING. WASHING ROADWAY TO REMOVE MUD TRACKED ONTO PAVEMENT IS NOT ACCEPTABLE UNLESS WASH WATER IS DIRECTED TO AN APPROVED SEDIMENT CONTROL PRACTICE.

MARYLAND STANDARDS AND SPECIFICATIONS FOR SOIL EROSION AND SEDIMENT CONTROL	
U.S. DEPARTMENT OF AGRICULTURE NATURAL RESOURCES CONSERVATION SERVICE	2011
MARYLAND DEPARTMENT OF ENVIRONMENT WATER MANAGEMENT ADMINISTRATION	

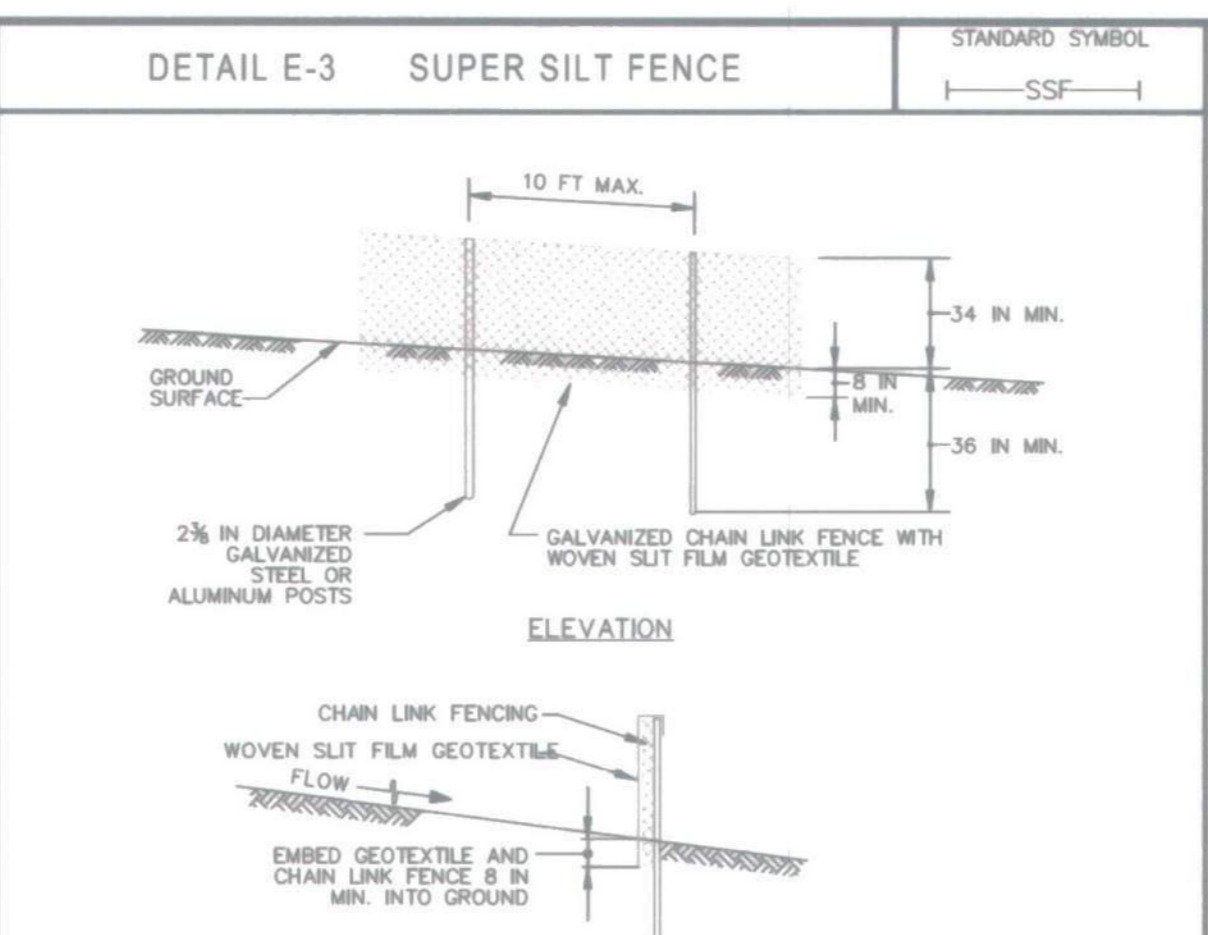


- CONSTRUCTION SPECIFICATIONS**
- INSTALL 2 1/2 INCH DIAMETER GALVANIZED STEEL POSTS OF 0.095 INCH WALL THICKNESS AND SIX FOOT LENGTH SPACED NO FURTHER THAN 10 FEET APART. DRIVE THE POSTS A MINIMUM OF 36 INCHES INTO THE GROUND.
 - FASTEN 9 GAUGE OR HEAVIER GALVANIZED CHAIN LINK FENCE (2 1/2 INCH MAXIMUM OPENING) 42 INCHES IN HEIGHT SECURELY TO THE FENCE POSTS WITH WIRE TIES OR RING RINGS.
 - FASTEN WOVEN SLIT FILM GEOTEXTILE AS SPECIFIED IN SECTION H-1 MATERIALS. SECURELY TO THE UPSLOPE SIDE OF CHAIN LINK FENCE WITH TIES SPACED EVERY 24 INCHES AT THE TOP AND MID SECTION. EMBED GEOTEXTILE AND CHAIN LINK FENCE A MINIMUM OF 8 INCHES INTO THE GROUND.
 - WHERE ENDS OF THE GEOTEXTILE COME TOGETHER, THE ENDS SHALL BE OVERLAPPED BY 6 INCHES, FOLDED, AND STAPLED TO PREVENT SEDIMENT BY PASS.
 - EXTEND BOTH ENDS OF THE SUPER SILT FENCE A MINIMUM OF FIVE HORIZONTAL FEET UPSLOPE AT 45 DEGREES TO THE MAIN FENCE ALIGNMENT TO PREVENT RUNOFF FROM GOING AROUND THE ENDS OF THE SUPER SILT FENCE.
 - PROVIDE MANUFACTURER CERTIFICATION TO THE INSPECTION/ENFORCEMENT AUTHORITY SHOWING THAT GEOTEXTILE USED MEETS THE REQUIREMENTS IN SECTION H-1 MATERIALS.
 - REMOVE ACCUMULATED SEDIMENT AND DEBRIS WHEN BULGES DEVELOP IN FENCE OR WHEN SEDIMENT REACHES 25% OF FENCE HEIGHT. REPLACE GEOTEXTILE IF TORN. IF UNDERMINING OCCURS, REINSTALL CHAIN LINK FENCING AND GEOTEXTILE.

MARYLAND STANDARDS AND SPECIFICATIONS FOR SOIL EROSION AND SEDIMENT CONTROL	
U.S. DEPARTMENT OF AGRICULTURE NATURAL RESOURCES CONSERVATION SERVICE	2011
MARYLAND DEPARTMENT OF ENVIRONMENT WATER MANAGEMENT ADMINISTRATION	

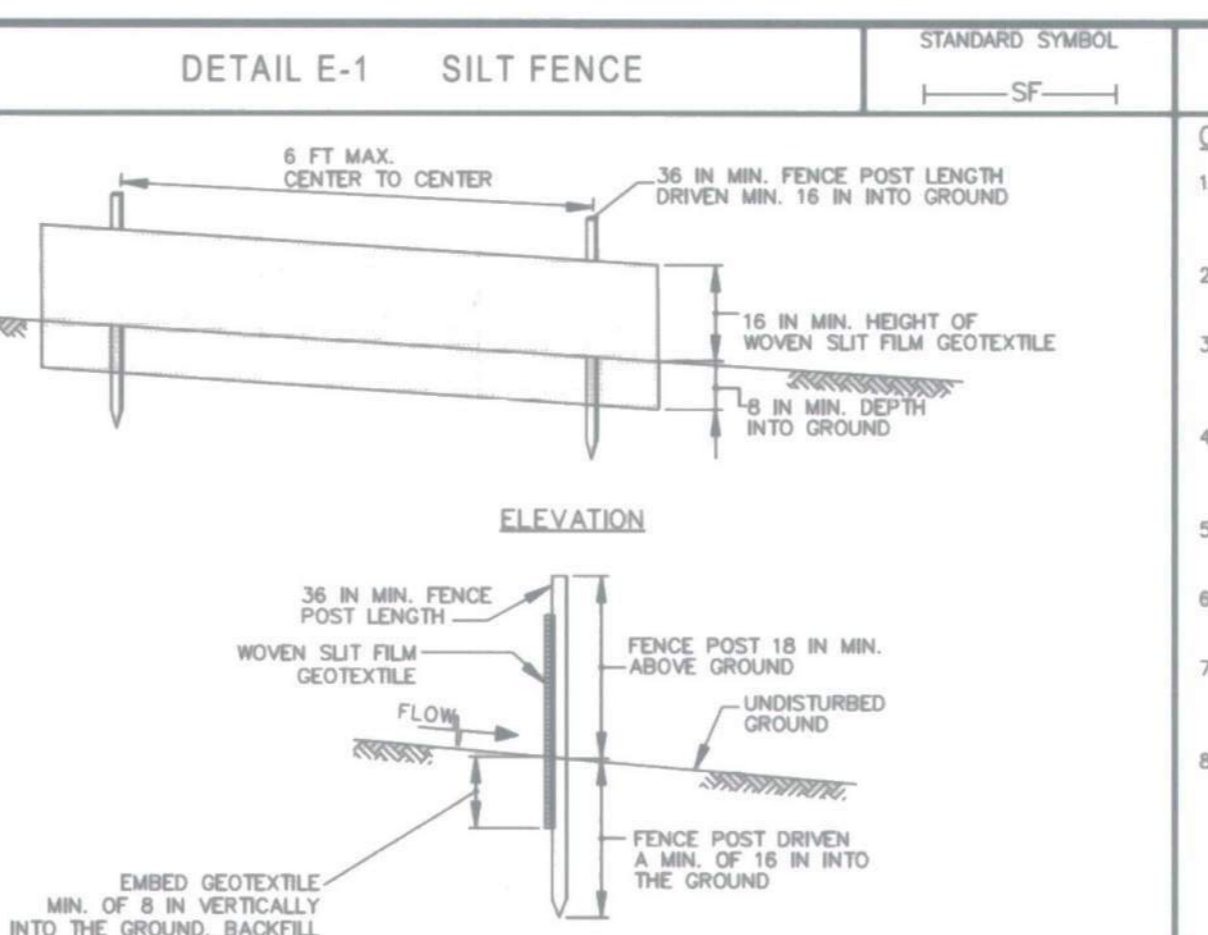


- CONSTRUCTION SPECIFICATIONS**
- USE WOOD POSTS 1 1/2 X 1 1/2 X 1/2 INCH (MINIMUM) SQUARE CUT OF SOUND QUALITY HARDWOOD, AS AN ALTERNATIVE TO WOODEN POST USE STANDARD "T" OR "U" SECTION STEEL POSTS WEIGHING NOT LESS THAN 1 POUND PER LINEAR FOOT.
 - USE 36 INCH MINIMUM POSTS DRIVEN 16 INCH MINIMUM INTO GROUND NO MORE THAN 6 FEET APART.
 - USE WOVEN SLIT FILM GEOTEXTILE AS SPECIFIED IN SECTION H-1 MATERIALS AND FASTEN GEOTEXTILE SECURELY TO UPSLOPE SIDE OF FENCE POSTS WITH WIRE TIES OR STAPLES AT TOP AND MID-SECTION.
 - PROVIDE MANUFACTURER CERTIFICATION TO THE AUTHORIZED REPRESENTATIVE OF THE INSPECTION/ENFORCEMENT AUTHORITY SHOWING THAT THE GEOTEXTILE USED MEETS THE REQUIREMENTS IN SECTION H-1 MATERIALS.
 - EMBED GEOTEXTILE A MINIMUM OF 8 INCHES VERTICALLY INTO THE GROUND. BACKFILL AND COMPACT THE SOIL ON BOTH SIDES OF FABRIC.
 - WHERE TWO SECTIONS OF GEOTEXTILE ADJOIN: OVERLAP, TWIST, AND STAPLE TO POST IN ACCORDANCE WITH THIS DETAIL.
 - EXTEND BOTH ENDS OF THE SILT FENCE A MINIMUM OF FIVE HORIZONTAL FEET UPSLOPE AT 45 DEGREES TO THE MAIN FENCE ALIGNMENT TO PREVENT RUNOFF FROM GOING AROUND THE ENDS OF THE SILT FENCE.
 - REMOVE ACCUMULATED SEDIMENT AND DEBRIS WHEN BULGES DEVELOP IN SILT FENCE OR WHEN SEDIMENT REACHES 25% OF FENCE HEIGHT. REPLACE GEOTEXTILE IF TORN. IF UNDERMINING OCCURS, REINSTALL FENCE.

MARYLAND STANDARDS AND SPECIFICATIONS FOR SOIL EROSION AND SEDIMENT CONTROL	
U.S. DEPARTMENT OF AGRICULTURE NATURAL RESOURCES CONSERVATION SERVICE	2011
MARYLAND DEPARTMENT OF ENVIRONMENT WATER MANAGEMENT ADMINISTRATION	

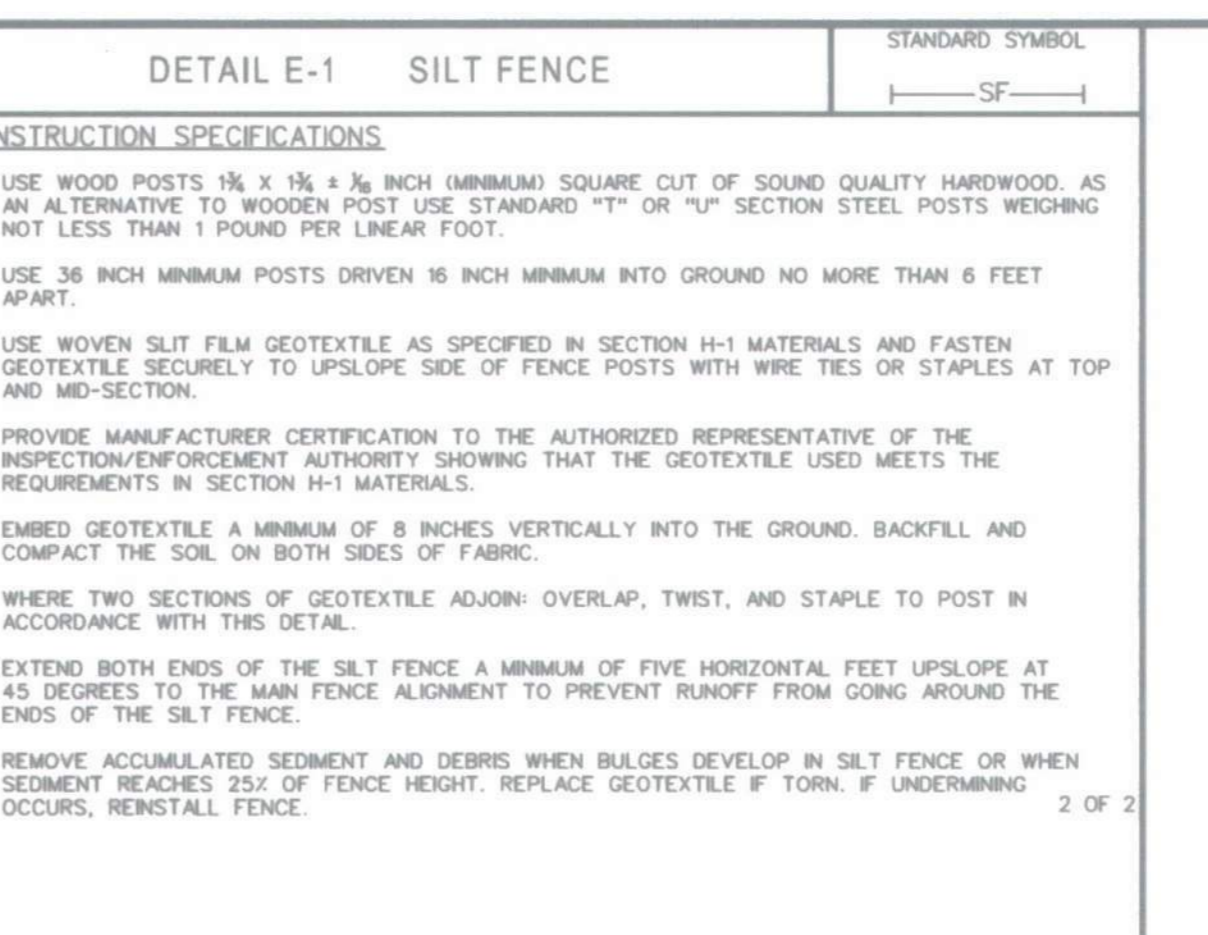


- CONSTRUCTION SPECIFICATIONS**
- USE WOOD POSTS 1 1/2 X 1 1/2 X 1/2 INCH (MINIMUM) SQUARE CUT OF SOUND QUALITY HARDWOOD, AS AN ALTERNATIVE TO WOODEN POST USE STANDARD "T" OR "U" SECTION STEEL POSTS WEIGHING NOT LESS THAN 1 POUND PER LINEAR FOOT.
 - USE 36 INCH MINIMUM POSTS DRIVEN 16 INCH MINIMUM INTO GROUND NO MORE THAN 6 FEET APART.
 - USE WOVEN SLIT FILM GEOTEXTILE AS SPECIFIED IN SECTION H-1 MATERIALS AND FASTEN GEOTEXTILE SECURELY TO UPSLOPE SIDE OF FENCE POSTS WITH WIRE TIES OR STAPLES AT TOP AND MID-SECTION.
 - PROVIDE MANUFACTURER CERTIFICATION TO THE AUTHORIZED REPRESENTATIVE OF THE INSPECTION/ENFORCEMENT AUTHORITY SHOWING THAT THE GEOTEXTILE USED MEETS THE REQUIREMENTS IN SECTION H-1 MATERIALS.
 - EMBED GEOTEXTILE A MINIMUM OF 8 INCHES VERTICALLY INTO THE GROUND. BACKFILL AND COMPACT THE SOIL ON BOTH SIDES OF FABRIC.
 - WHERE TWO SECTIONS OF GEOTEXTILE ADJOIN: OVERLAP, TWIST, AND STAPLE TO POST IN ACCORDANCE WITH THIS DETAIL.
 - EXTEND BOTH ENDS OF THE SILT FENCE A MINIMUM OF FIVE HORIZONTAL FEET UPSLOPE AT 45 DEGREES TO THE MAIN FENCE ALIGNMENT TO PREVENT RUNOFF FROM GOING AROUND THE ENDS OF THE SILT FENCE.
 - REMOVE ACCUMULATED SEDIMENT AND DEBRIS WHEN BULGES DEVELOP IN SILT FENCE OR WHEN SEDIMENT REACHES 25% OF FENCE HEIGHT. REPLACE GEOTEXTILE IF TORN. IF UNDERMINING OCCURS, REINSTALL FENCE.

MARYLAND STANDARDS AND SPECIFICATIONS FOR SOIL EROSION AND SEDIMENT CONTROL	
U.S. DEPARTMENT OF AGRICULTURE NATURAL RESOURCES CONSERVATION SERVICE	2011
MARYLAND DEPARTMENT OF ENVIRONMENT WATER MANAGEMENT ADMINISTRATION	

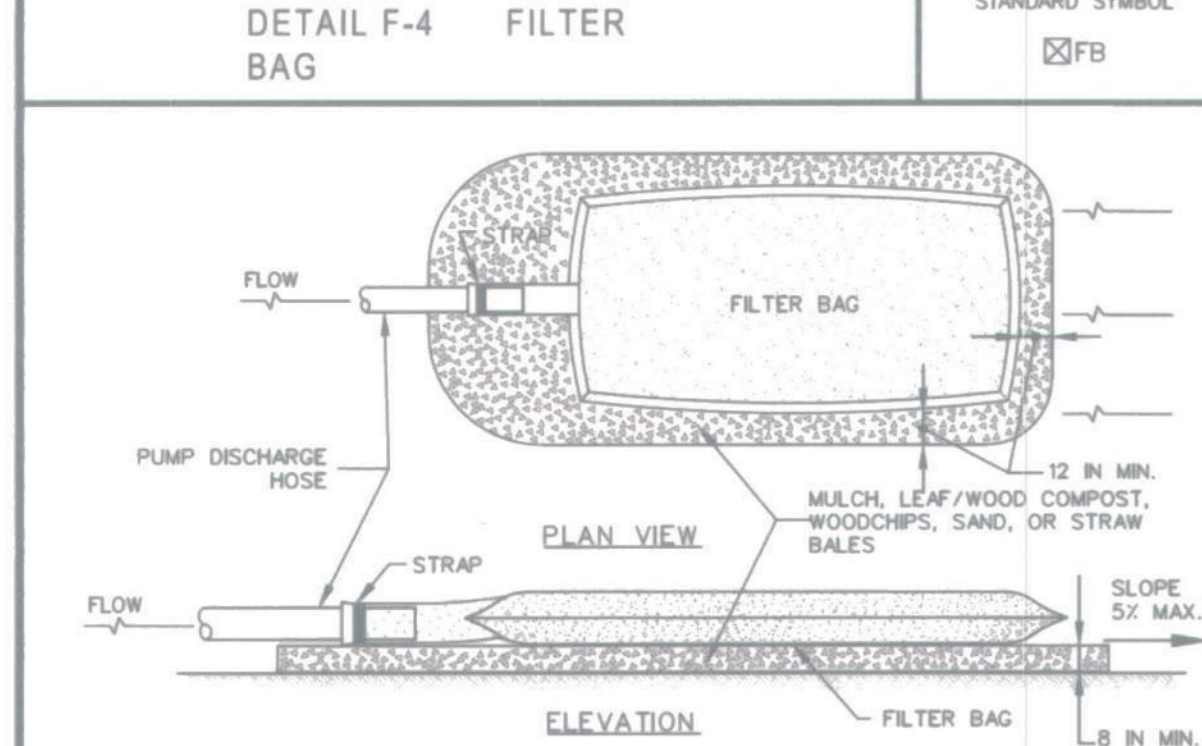


- CONSTRUCTION SPECIFICATIONS**
- TIGHTLY SEAL SLEEVE AROUND THE PUMP DISCHARGE HOSE WITH A STRAP OR SIMILAR DEVICE.
 - PLACE FILTER BAG ON SUITABLE BASE (E.G., MULCH, LEAF/WOOD COMPOST, WOODCHIPS, SAND, OR STRAW BALES) LOCATED ON A LEVEL OR 5% MAXIMUM SLOPING SURFACE. DISCHARGE TO A STABILIZED AREA. EXTEND BASE A MINIMUM OF 12 INCHES FROM EDGES OF BAG.
 - CONTROL PUMPING RATE TO PREVENT EXCESSIVE PRESSURE WITHIN THE FILTER BAG IN ACCORDANCE WITH THE MANUFACTURER RECOMMENDATIONS. AS THE BAG FILLS WITH SEDIMENT, REDUCE PUMPING RATE.
 - REMOVE AND PROPERLY DISPOSE OF FILTER BAG UPON COMPLETION OF PUMPING OPERATIONS OR AFTER BAG HAS REACHED CAPACITY, WHICHEVER OCCURS FIRST. SPREAD THE DEWATERED SEDIMENT FROM THE BAG IN AN APPROVED UPLAND AREA AND STABILIZE WITH SEED AND MULCH BY THE END OF THE WORK DAY. RESTORE THE SURFACE AREA BENEATH THE BAG TO ORIGINAL CONDITION UPON REMOVAL OF THE DEVICE.
 - USE NONWOVEN GEOTEXTILE WITH DOUBLE STITCHED SEAMS USING HIGH STRENGTH THREAD. SIZE SLEEVE TO ACCOMMODATE A MAXIMUM 4 INCH DIAMETER PUMP DISCHARGE HOSE. THE BAG MUST BE MANUFACTURED FROM A NONWOVEN GEOTEXTILE THAT MEETS OR EXCEEDS MINIMUM AVERAGE ROLL VALUES (MARV) FOR THE FOLLOWING:
- | | | |
|-----------------------------------|--------------------------|-------------|
| ORAB TENSILE | 250 LB | ASTM D-4632 |
| PUNCTURE | 150 LB | ASTM D-4833 |
| FLOW RATE | 70 GAL/MIN/FT | ASTM D-4491 |
| PERMITTIVITY (SEC ⁻²) | 1.2 SEC ⁻² | ASTM D-4491 |
| UV RESISTANCE | 70% STRENGTH @ 500 HOURS | ASTM D-4355 |
| APPARENT OPENING SIZE (AOS) | 0.15-0.18 MM | ASTM D-4751 |
| SEAM STRENGTH | 90% | ASTM D-4632 |
- REPLACE FILTER BAG IF BAG CLOSURE OR HAS RIPS, TEARS, OR PUNCTURES. DURING OPERATION KEEP CONNECTION BETWEEN PUMP HOSE AND FILTER BAG WATER TIGHT. REPLACE BEDDING IF IT BECOMES DISPLACED.

MARYLAND STANDARDS AND SPECIFICATIONS FOR SOIL EROSION AND SEDIMENT CONTROL	
U.S. DEPARTMENT OF AGRICULTURE NATURAL RESOURCES CONSERVATION SERVICE	2011
MARYLAND DEPARTMENT OF ENVIRONMENT WATER MANAGEMENT ADMINISTRATION	

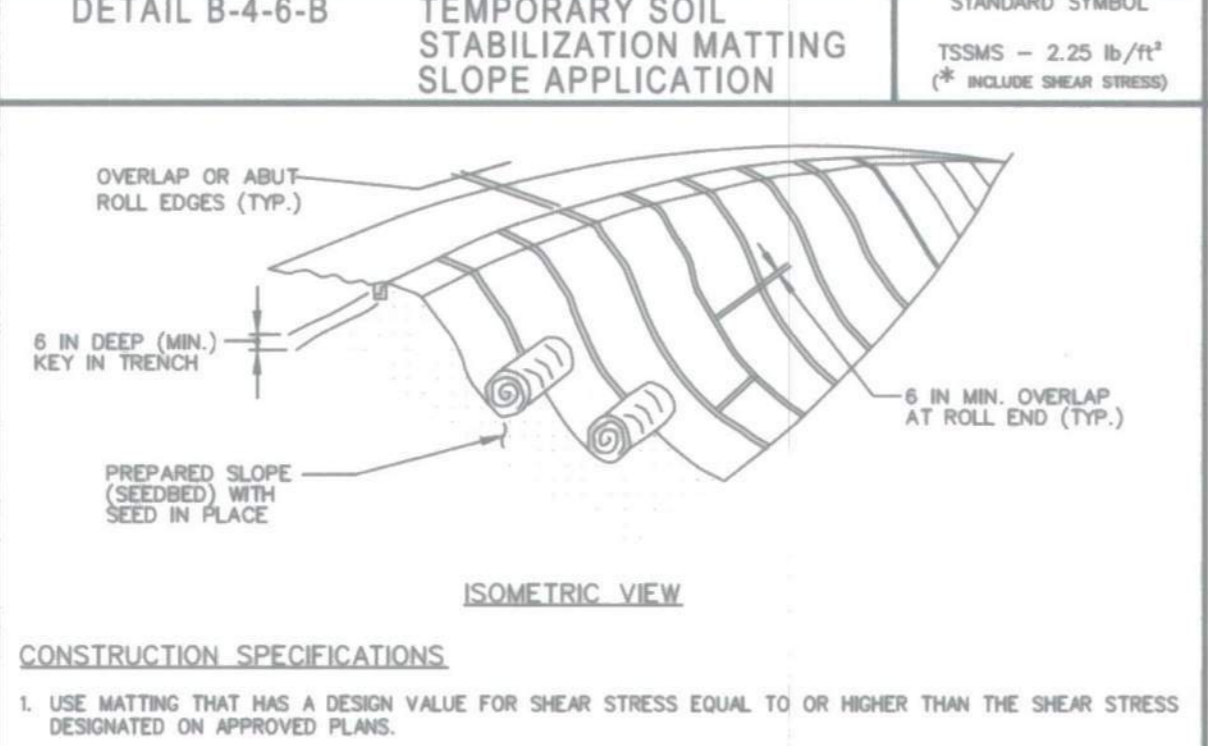

- CONSTRUCTION SPECIFICATIONS**
- USE MATTING THAT HAS A DESIGN VALUE FOR SHEAR STRESS EQUAL TO OR HIGHER THAN THE SHEAR STRESS DESIGNATED ON APPROVED PLANS.
 - USE TEMPORARY SOIL STABILIZATION MATTING MADE OF DEGRADABLE (LASTS 6 MONTHS MINIMUM NATURAL OR MAN-MADE FIBERS (MOSTLY ORGANIC). MAT MUST HAVE UNIFORM THICKNESS AND DISTRIBUTION OF FIBERS THROUGHOUT AND BE SMOLDER RESISTANT. CHEMICALS USED IN THE MAT MUST BE NON-LEACHING AND NON-TOXIC TO VEGETATION AND SEED GERMINATION AND NON-HARMFUL TO THE SOIL. IF PRESENT, NETTING MUST BE EXTRUDED PLASTIC WITH A MAXIMUM MESH OPENING OF 2x2 INCHES AND SUFFICIENTLY BONDED OR SEWN ON 2 INCH CENTERS ALONG LONGITUDINAL AXIS OF THE MATERIAL TO PREVENT SEPARATION OF THE NET FROM THE PARENT MATERIAL.
 - SECURE MATTING USING STEEL STAPLES, WOOD STAKES, OR BIODEGRADABLE EQUIVALENT. STAPLES MUST BE "U" OR "T" SHAPED STEEL WIRE HAVING A MINIMUM GAUGE OF NO. 11 AND NO. 8 RESPECTIVELY. "U" SHAPED STAPLES MUST AVERAGE 1 TO 1 1/2 INCHES WIDE AND BE A MINIMUM OF 6 INCHES LONG. "T" SHAPED STAPLES MUST HAVE A MINIMUM 8 INCH MAIN LEG, A MINIMUM 1 INCH SECONDARY LEG, AND A MINIMUM 4 INCH HEAD. WOOD STAKES MUST BE ROUGH-SAWN HARDWOOD, 12 TO 24 INCHES IN LENGTH, 1 1/2 INCH IN CROSS SECTION, AND WEDGE SHAPED AT THE BOTTOM.
 - PERFORM FINAL GRADING, TOPSOIL APPLICATION, SEEDBED PREPARATION, AND PERMANENT SEEDING IN ACCORDANCE WITH SPECIFICATIONS. PLACE MATTING WITHIN 48 HOURS OF COMPLETING SEEDING OPERATIONS UNLESS END OF WORKDAY STABILIZATION IS SPECIFIED ON THE APPROVED EROSION AND SEDIMENT CONTROL PLAN.
 - UNROLL MATTING DOWNSLOPE. LAY MAT SMOOTHLY AND FIRMLY UPON THE SEEDBED SURFACE. AVOID STRETCHING THE MATTING.
 - OVERLAP OR ABUT ROLL EDGES PER MANUFACTURER RECOMMENDATIONS. OVERLAP ROLL ENDS BY 6 INCHES MINIMUM, WITH THE UPSLOPE MAT OVERLAPPING ON TOP OF THE DOWNSLOPE MAT.
 - KEY IN THE UPSLOPE END OF MAT 6 INCHES (MINIMUM) BY DIGGING A TRENCH, REPLACING THE EXCAVATED MATERIAL, AND TAMPING TO SECURE THE MAT END IN THE KEY.
 - STAPLE/STAKE MAT IN A STAGGERED PATTERN ON 4 FOOT (MAXIMUM) CENTERS THROUGHOUT AND 2 FOOT (MAXIMUM) CENTERS ALONG SEAMS, JOINTS, AND ROLL ENDS.
 - ESTABLISH AND MAINTAIN VEGETATION SO THAT REQUIREMENTS FOR ADEQUATE VEGETATIVE ESTABLISHMENT ARE CONTINUOUSLY MET IN ACCORDANCE WITH SECTION B-4 VEGETATIVE STABILIZATION.

MARYLAND STANDARDS AND SPECIFICATIONS FOR SOIL EROSION AND SEDIMENT CONTROL	
U.S. DEPARTMENT OF AGRICULTURE NATURAL RESOURCES CONSERVATION SERVICE	2011
MARYLAND DEPARTMENT OF ENVIRONMENT WATER MANAGEMENT ADMINISTRATION	

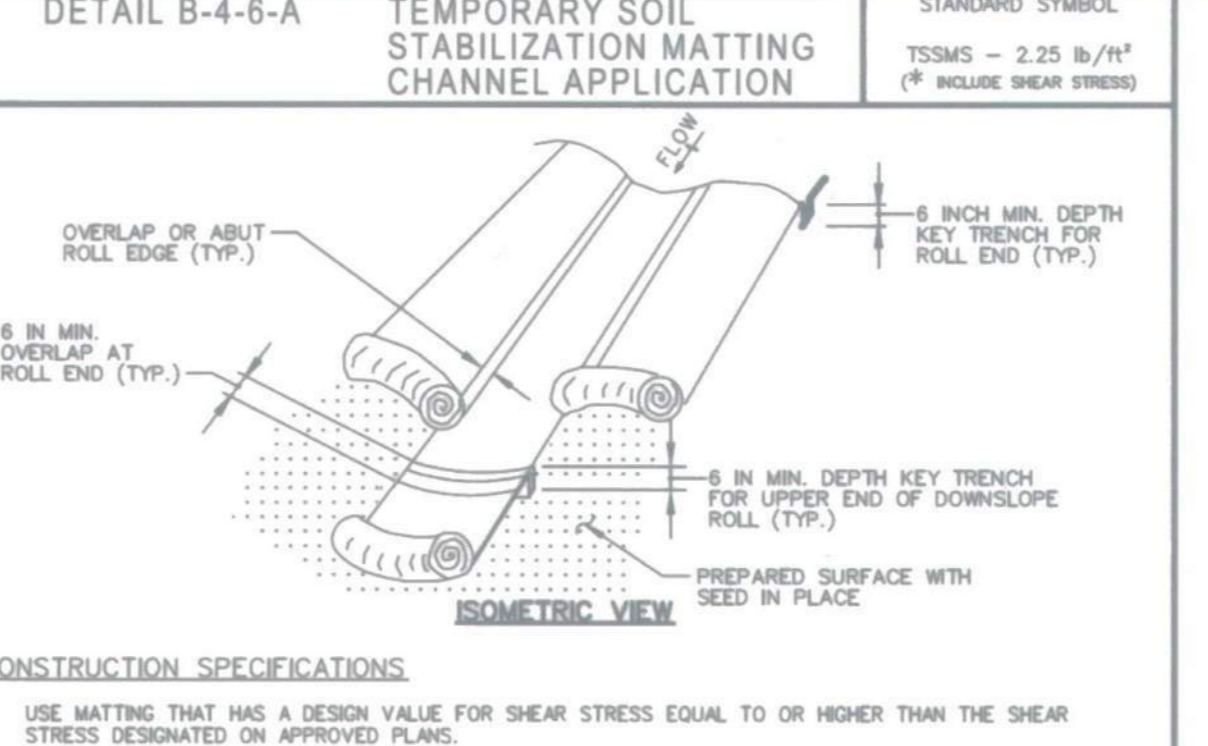

- CONSTRUCTION SPECIFICATIONS**
- USE MATTING THAT HAS A DESIGN VALUE FOR SHEAR STRESS EQUAL TO OR HIGHER THAN THE SHEAR STRESS DESIGNATED ON APPROVED PLANS.
 - USE TEMPORARY SOIL STABILIZATION MATTING MADE OF DEGRADABLE (LASTS 6 MONTHS MINIMUM NATURAL OR MAN-MADE FIBERS (MOSTLY ORGANIC). MAT MUST HAVE UNIFORM THICKNESS AND DISTRIBUTION OF FIBERS THROUGHOUT AND BE SMOLDER RESISTANT. CHEMICALS USED IN THE MAT MUST BE NON-LEACHING AND NON-TOXIC TO VEGETATION AND SEED GERMINATION AND NON-HARMFUL TO THE SOIL. IF PRESENT, NETTING MUST BE EXTRUDED PLASTIC WITH A MAXIMUM MESH OPENING OF 2x2 INCHES AND SUFFICIENTLY BONDED OR SEWN ON 2 INCH CENTERS ALONG LONGITUDINAL AXIS OF THE MATERIAL TO PREVENT SEPARATION OF THE NET FROM THE PARENT MATERIAL.
 - SECURE MATTING USING STEEL STAPLES, WOOD STAKES, OR BIODEGRADABLE EQUIVALENT. STAPLES MUST BE "U" OR "T" SHAPED STEEL WIRE HAVING A MINIMUM GAUGE OF NO. 11 AND NO. 8 RESPECTIVELY. "U" SHAPED STAPLES MUST AVERAGE 1 TO 1 1/2 INCHES WIDE AND BE A MINIMUM OF 6 INCHES LONG. "T" SHAPED STAPLES MUST HAVE A MINIMUM 8 INCH MAIN LEG, A MINIMUM 1 INCH SECONDARY LEG, AND A MINIMUM 4 INCH HEAD. WOOD STAKES MUST BE ROUGH-SAWN HARDWOOD, 12 TO 24 INCHES IN LENGTH, 1 1/2 INCH IN CROSS SECTION, AND WEDGE SHAPED AT THE BOTTOM.
 - PERFORM FINAL GRADING, TOPSOIL APPLICATION, SEEDBED PREPARATION, AND PERMANENT SEEDING IN ACCORDANCE WITH SPECIFICATIONS. PLACE MATTING WITHIN 48 HOURS OF COMPLETING SEEDING OPERATIONS UNLESS END OF WORKDAY STABILIZATION IS SPECIFIED ON THE APPROVED EROSION AND SEDIMENT CONTROL PLAN.
 - UNROLL MATTING IN DIRECTION OF WATER FLOW, CENTERING THE FIRST ROLL ON THE CHANNEL CENTERLINE. WORK FROM CENTER OF CHANNEL OUTWARD WHEN PLACING ROLLS. LAY MAT SMOOTHLY AND FIRMLY ON THE SEEDBED SURFACE. AVOID STRETCHING THE MATTING.
 - KEY-IN UPSTREAM END OF EACH MAT ROLL BY DIGGING A 6 INCH (MINIMUM) TRENCH AT THE UPSTREAM END OF THE MATTING, PLACING THE ROLL END IN THE TRENCH, STAPLING THE MAT IN PLACE, REPLACING THE EXCAVATED MATERIAL, AND TAMPING TO SECURE THE MAT END.
 - OVERLAP OR ABUT THE ROLL EDGES PER MANUFACTURER RECOMMENDATIONS. OVERLAP ROLL ENDS BY 6 INCHES (MINIMUM), WITH THE UPSLOPE MAT OVERLAPPING ON TOP OF THE NEXT DOWNSLOPE MAT.
 - STAPLE/STAKE MAT IN A STAGGERED PATTERN ON 4 FOOT (MAXIMUM) CENTERS THROUGHOUT AND 2 FOOT (MAXIMUM) CENTERS ALONG SEAMS, JOINTS, AND ROLL ENDS.
 - ESTABLISH AND MAINTAIN VEGETATION SO THAT REQUIREMENTS FOR ADEQUATE VEGETATIVE ESTABLISHMENT ARE CONTINUOUSLY MET IN ACCORDANCE WITH SECTION B-4 VEGETATIVE STABILIZATION.

MARYLAND STANDARDS AND SPECIFICATIONS FOR SOIL EROSION AND SEDIMENT CONTROL	
U.S. DEPARTMENT OF AGRICULTURE NATURAL RESOURCES CONSERVATION SERVICE	2011
MARYLAND DEPARTMENT OF ENVIRONMENT WATER MANAGEMENT ADMINISTRATION	

BEST MANAGEMENT PRACTICES FOR WORKING IN NONTIDAL WETLANDS, WETLAND BUFFERS, WATERWAYS, AND 100-YEAR FLOODPLAINS

- No excess fill, construction material, or debris shall be stockpiled or stored in nontidal wetlands, nontidal wetland buffers, waterways, or the 100-year floodplain.
- Place materials in a location and manner which does not adversely impact surface or subsurface water flow into or out of nontidal wetlands, nontidal wetland buffers, waterways, or the 100-year floodplain.
- Do not use the excavated material as backfill if it contains waste metal products, unsightly debris, toxic material, or any other deleterious substance. If additional backfill is required, use clean material free of waste metal products, unsightly debris, toxic material, or any other deleterious substance.
- Place heavy equipment on mats or suitably operate the equipment to prevent damage to nontidal wetlands, nontidal wetland buffers, waterways, or the 100-year floodplain.
- Repair and maintain any serviceable structure or fill so there is no permanent loss of nontidal wetlands, nontidal wetland buffers, or waterways, or permanent modification of the 100-year flood plain in excess of that lost under the originally authorized structure or fill.
- Rectify any nontidal wetlands, nontidal wetland buffers, waterways, or the 100-year flood plain temporarily impacted by any construction.
- All stabilization in the nontidal wetland and nontidal wetland buffer shall consist of the following species: annual ryegrass (Lolium multiflorum), millet (Setaria italica), barley (Hordeum sp.), oats (Avena sp.), and/or rye (Secale cereale). These species will allow for stabilization of the site while also allowing for the voluntary revegetation of natural wetland species. Other non-persistent vegetation may be acceptable, but must be approved by the nontidal wetlands and waterways division, Kentucky 31 fescue shall not be utilized in wetland or buffer areas. The area should be seeded and mulched to reduce erosion after construction activities have been completed.
- After installation has been completed, make post-construction grades and elevations the same as the original grades and elevations in temporarily impacted areas.
- To protect aquatic species, in-stream work is prohibited as determined by classification of the stream:
Use 1 waters: in-stream work shall not be conducted during the period of march 1 through June 15, inclusive, during any year.
- Stormwater runoff from impervious surfaces shall be controlled to prevent the washing of debris into the waterway.
- Culverts shall be constructed and any riprap placed so as not to obstruct the movement of the aquatic species, unless the purpose of the activity is to impound water.

SEQUENCE OF CONSTRUCTION

- EROSION AND SEDIMENT CONTROL SETUP - 5 DAYS
- (DAY 1) THE CONTRACTOR SHALL STAKE OUT THE LIMITS OF DISTURBANCE AS SHOWN ON THE PLANS AND OBTAIN GRADING PERMIT.
 - (DAY 1) NOTIFY MISS UTILITY (1-800-257-7777) AT LEAST 48 HOURS PRIOR TO BEGINNING WORK.
 - (DAY 2) THE CONTRACTOR SHALL CONDUCT A PRE-CONSTRUCTION MEETING ONSITE WITH THE SEDIMENT CONTROL INSPECTOR AND ENGINEER TO REVIEW THE LIMITS OF DISTURBANCE, STRUCTURE STAKEOUT, EROSION AND SEDIMENT CONTROL REQUIREMENTS, AND THE SEQUENCE OF CONSTRUCTION. THE PARTICIPANTS WILL ALSO VERIFY THE LOCATION OF ANY NECESSARY STAGING AREA AND FLAG ANY TREES WITHIN THE LIMITS OF DISTURBANCE WHICH WILL BE REMOVED FOR CONSTRUCTION ACCESS AND GRADING.
 - (DAY 3) THE CONTRACTOR SHALL INSTALL PERIMETER EROSION AND SEDIMENT CONTROL DEVICES AS SHOWN ON THE PLAN INCLUDING THE SILT FENCE.
 - (DAY 5) THE HOWARD COUNTY CONSTRUCTION INSPECTION DIVISION SHALL BE NOTIFIED UPON COMPLETION OF CONTROLS. UPON COMPLETION OF CONTROL INSTALLATION, AND WITH APPROVAL OF THE SEDIMENT CONTROL INSPECTOR, THE CONTRACTOR MAY BEGIN OPERATIONS. CONSTRUCTION SHALL BE DONE IN ACCORDANCE WITH THE SEQUENCE OF CONSTRUCTION AND GRADING PLANS, AND EROSION AND SEDIMENT CONTROL STANDARD DETAILS AND NOTES. WORK SHALL BE LIMITED TO THAT WHICH CAN BE BACKFILLED AND STABILIZED IN ONE DAY. SOIL STABILIZATION MATTING SHALL BE USED AS APPROPRIATE PER TABLE B.7:SOIL STABILIZATION ON SLOPES ON SHEET 13.
 - (DAY 85) FOLLOWING COMPLETION OF THE CONSTRUCTION, THE CONTRACTOR MAY REMOVE EROSION AND SEDIMENT CONTROL MEASURES UPON RECEIVING APPROVAL FROM THE SEDIMENT CONTROL INSPECTOR.
- CONSTRUCTION - 90 DAYS

DEPARTMENT OF PUBLIC WORKS
HOWARD COUNTY, MARYLAND

[Signature] 1/12/2021
DIRECTOR OF PUBLIC WORKS DATE

[Signature] 1-11-21
CHIEF, BUREAU OF UTILITIES DATE

[Signature] 1-8-2021
CHIEF, BUREAU OF ENGINEERING DATE

[Signature] 1/12/2021
CHIEF, UTILITY DESIGN DIVISION DATE

GMB
GEORGE, MILES & BUHR, LLC
ARCHITECTS & ENGINEERS
SALISBURY - BALTIMORE - SEAFORD
www.gmbnet.com



DES: WMG					
DRN: BRW					
CHK: AWW					
DATE: 12/2020	BY	NO.	REVISION	DATE	600 SCALE MAP NO. 31

EROSION AND SEDIMENT CONTROL DETAILS AND NOTES

BONNIE BRANCH
INTERCEPTOR SEWER IMPROVEMENTS
CONTRACT NO. 10-5034
2ND ELECTION DISTRICT
HOWARD COUNTY, MARYLAND

SCALE AS SHOWN

SHEET 12 OF 16

BONNIE BRANCH EMERGENCY SEWER PROTECTION & STREAM BANK STABILIZATION CAPITAL PROJECT S6282 CONTRACT NO. 10-5034 HOWARD COUNTY, MARYLAND

AS-BUILT
DATE 12/22/2021

SHEET INDEX		
SHEET #	DWG #	SHEET TITLE
17	TI-01	TITLE SHEET
18	GR-01	GRADING PLAN
19	DE-01	DETAILS
20	DE-02	MATERIAL SPECS
21	PR-01	PROFILE
22	ES-01	EROSION CONTROL PLAN
23	EN-01	EROSION CONTROL NOTES
24	EN-02	EROSION CONTROL NOTES
25	EN-03	EROSION CONTROL DETAILS
26	XS-01	CROSS-SECTION SHEET

DESIGN NARRATIVE

BONNIE BRANCH STABILIZATION IS AN EMERGENCY REPAIR PROJECT TO MITIGATE RISKS CAUSED BY THE EXPOSURE OF SANITARY SEWER MANHOLE 124. THE PRIMARY GOAL OF THE PROJECT IS TO REDUCE EROSION SURROUNDING THE EXPOSED MANHOLE BY SHIFTING THE THALWEG AWAY FROM THE RIGHT BANK AND ARMORING THE BANK. THE PROJECT SITE IS APPROXIMATELY 530 LF. THE SPECIFIC STABILIZATION ACTIONS TO BE TAKEN INCLUDE:

- CONSTRUCTING A BOULDER CLUSTER NESTLED IN THE RIGHT BANK IN THE UPSTREAM LIMITS TO DISSIPATE ENERGY DIRECTED TOWARDS THE RIGHT BANK.
- CONSTRUCTING BOULDER SLOPE STABILIZATION TO ARMOR THE RIGHT BANK.
- CONSTRUCTING BARB DEFLECTORS TO REDIRECT ENERGY AWAY FROM THE EXPOSED MANHOLE LOCATION.
- GRADING THE OPPOSING BANK TO PROVIDE SUFFICIENT CHANNEL CAPACITY.

NATURAL RESOURCE PROTECTION AND ENHANCEMENT

THE SPECIFIC SITE IS LOCATED ON PROPERTY OWNED BY HOWARD COUNTY, MARYLAND. THE SITE IS ACCESSIBLE DIRECTLY FROM BONNIE BRANCH ROAD. THE SITE IS BORDERED ON ALL SIDES BY DECIDUOUS FOREST SURROUNDED BY EXISTING SINGLE FAMILY RESIDENTIAL DEVELOPMENTS. THE EAST SIDE OF THE PROJECT SITE IS BORDERED BY BONNIE BRANCH ROAD. A NATURAL RESOURCES SURVEY WAS COMPLETED ON THE SITE. TREES GREATER THAN 12 INCHES WERE IDENTIFIED AND ASSESSED. 16 SPECIMEN TREES WERE IDENTIFIED DURING THE ASSESSMENT.

THIS PROJECT SEEKS TO PRESERVE NATURAL RESOURCES LOCATED ON AND ADJACENT TO THE PROJECT SITE. THEREFORE, THE PROJECT SCOPE HAS BEEN LIMITED TO WORK ALONG DEGRADED PORTIONS OF THE PROJECT REACH. SEVEN (7) TREES GREATER THAN 12" DBH ARE PROPOSED TO BE REMOVED. ONE (1) SPECIMEN TREE IS PROPOSED FOR REMOVAL. DISTURBANCE TO ON-SITE WETLANDS WILL BE AVOIDED. NATURAL RESOURCES WILL BE PROTECTED ALONG THE SITE'S PERIMETER WITH BLAZE ORANGE CONSTRUCTION SAFETY FENCING AS WELL AS SEDIMENT CONTROL FENCING (E.G. SUPER SILT FENCE) WHERE REQUIRED.

MAINTENANCE OF NATURAL FLOW PATTERNS

THIS PROJECT DOES NOT ALTER THE EXISTING CONDITION FLOW PATTERNS ALONG THE MAJORITY OF THE PROJECT REACH. MINOR CHANNEL PLANFORM ADJUSTMENTS ARE PROPOSED TO REDUCE STRESS ON THE OUTER BANK AND CREATE A STABLE CHANNEL ALIGNMENT.

REDUCTION OF IMPERVIOUS AREAS THROUGH BETTER SITE DESIGN

THIS PROJECT WILL NOT INCREASE IMPERVIOUS AREAS ON THE SITE.

INTEGRATION OF EROSION AND SEDIMENT CONTROLS INTO SWM STRATEGY

THE CONSTRUCTION APPROACH FOR THE PROJECT WAS DESIGNED TO BYPASS OF CLEAN WATER AROUND THE CONSTRUCTION AREA. SANDBAG DIVERSIONS AND PUMP AROUND PRACTICES WILL BE UTILIZED IN PHASES TO ALLOW FOR THE MAINTENANCE OF STREAM BASEFLOW. ALL DIRTY WATER WITHIN THE WORK AREA WILL BE PUMPED TO A FILTER BAG BEFORE DISCHARGING DOWNSTREAM OF THE WORK AREA. ALL DISTURBED AREAS NOT DRAINING TO AN APPROVED SEDIMENT CONTROL DEVICE MUST BE STABILIZED AT THE END OF EACH DAY. CONTRACTOR SHALL LIMIT WORK ACTIVITIES IN SUCH A MANNER THAT ALL DISTURBED AREAS CAN BE STABILIZED TO THE FINAL GRADE AT THE END OF EACH WORKING DAY. NO DISTURBED AREAS SHALL BE LEFT UN-STABILIZED OVERNIGHT UNLESS RUNOFF IS DIRECTED TO AN MDE APPROVED SEDIMENT CONTROL DEVICE. SUPER SILT FENCE IS PROPOSED AROUND ALL STOCKPILE AREAS AND ACCESS ROUTES. PERMANENT STABILIZATION MATTING AND SEED IS PROPOSED FOR ALL DISTURBED SLOPES FOR RAPID STABILIZATION.

IMPLEMENTATION OF ESD PLANNING TECHNIQUES AND PRACTICES

THE PROJECT OBJECTIVE IS STREAM BANK STABILIZATION AND UTILITY INFRASTRUCTURE PROTECTION. THEREFORE, ESD PLANNING TECHNIQUES AND PRACTICES ARE NOT RELEVANT TO THIS PROJECT.

REQUEST FOR DESIGN MANUAL AND WAIVER PETITION FOR ENVIRONMENTAL AND STORMWATER DESIGN NO WAIVERS ARE REQUESTED.

SUMMARY OF ENVIRONMENTAL IMPACTS

TREE REMOVAL (EA)	STREAM DISTURBANCE (LF)	WETLAND DISTURBANCE (SF)	WETLAND BUFFER DISTURBANCE (SF)	LIMIT OF DISTURBANCE (SF)	CUT (CY)	FILL (CY)	NET (CY)
7	530	0	1,786.8	29,496.5	143.3	117.9	25.4

Approvals/Permits*

Agency	Permit #	Date Applied	Date Approved
MDE/USACE Wetlands/Waterway Authorization	To be obtained	MARCH 16, 2021	
Howard Soil Conservation District	To be obtained		
Howard County DPZ Alternative Compliance	To be obtained		
MDE General Discharge Permit	To be obtained	MARCH 16, 2021	

*AS THIS IS AN EMERGENCY REPAIR PROJECT, AFTER - THE - FACT PERMITTING WILL BE ISSUED ON THE COMPLETION OF WORK. EMERGENCY AUTHORIZATION HAS BEEN OBTAINED FROM REGULATORY AGENCIES. AFTER - THE - FACT PERMITTING WILL BE APPLIED UPON THE COMPLETION OF THE EMERGENCY WORK.


DESIGN CERTIFICATE

I HEREBY CERTIFY THAT THIS PLAN HAS BEEN DESIGNED IN ACCORDANCE WITH THE CURRENT MARYLAND EROSION AND SEDIMENT CONTROL LAWS, REGULATIONS, AND STANDARDS. THAT IT REPRESENTS A PRACTICAL AND WORKABLE PLAN BASED ON MY PERSONAL KNOWLEDGE OF THE SITE AND THAT IT WAS PREPARED IN ACCORDANCE WITH THE REQUIREMENTS OF THE HOWARD SOIL CONSERVATION DISTRICT.

Brett M. Schrey
DESIGNERS SIGNATURE
5/24/2021
DATE
BRETT M. SCHREY
PRINTED NAME
MD REGISTRATION NO. 44931
P.E., R.L.S., OR R.L.A.

PROFESSIONAL CERTIFICATION

I HEREBY CERTIFY THAT THESE DOCUMENTS WERE PREPARED OR APPROVED BY ME, AND THAT I AM A DULY LICENSED PROFESSIONAL ENGINEER UNDER THE LAWS OF THE STATE OF MARYLAND.
LICENSE NO. 44931, EXPIRATION DATE: 12/22/2021

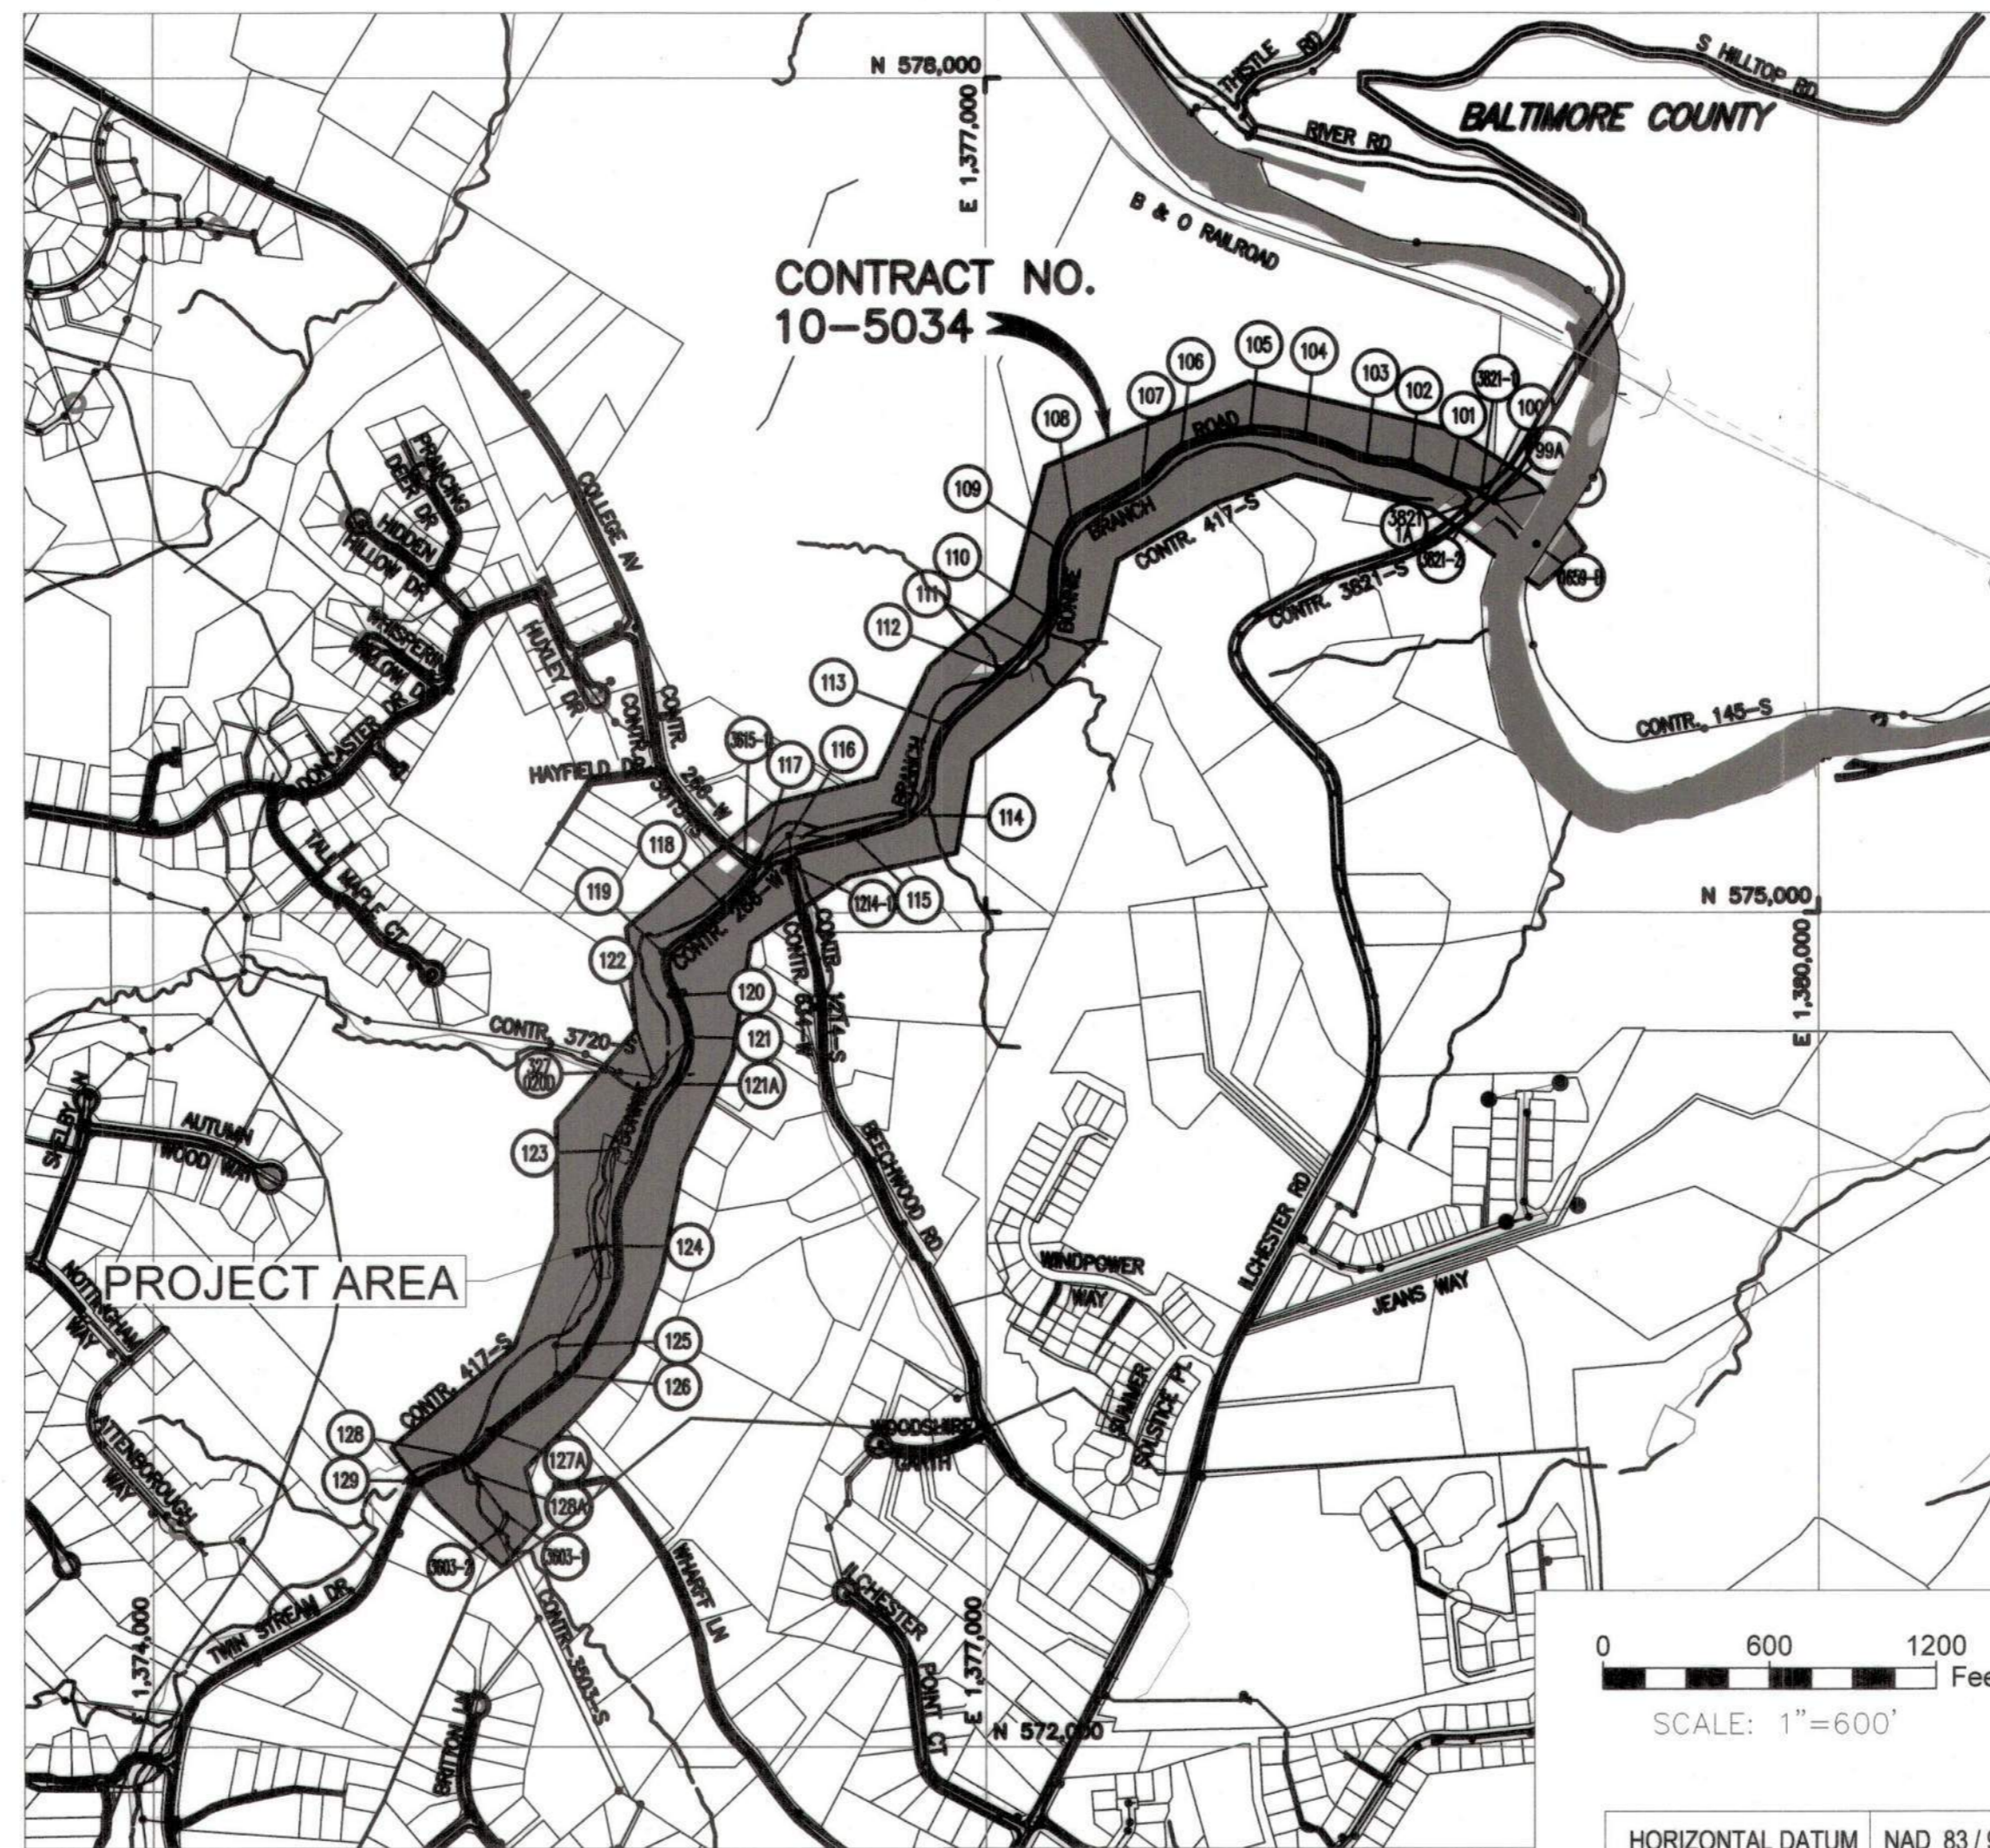

PROJECT NOTES

- EMERGENCY REPAIR AUTHORIZATION WAS APPROVED BY THE MARYLAND DEPARTMENT OF ENVIRONMENT (MDE) ON MARCH 16, 2021 AND THE US ARMY CORP OF ENGINEERS (USACE) ON MARCH 17TH. AFTER-THE-FACT PERMITTING WILL BE APPLIED FOR UPON COMPLETION OF WORK.
- PROJECT IMPACTS INCLUDE WORK IN A USE I STREAM. WORK MAY NOT BE CONDUCTED DURING THE PERIOD FROM MARCH 1 AND JUNE 15, INCLUSIVE OF ANY YEAR, WITHOUT SPECIAL APPROVAL THROUGH THE MARYLAND DEPARTMENT OF NATURAL RESOURCES.
- THE SITE IS LOCATED IN THE PATAPSCO RIVER LOWER NORTH BRANCH WATERSHED. THIS PORTION OF THE WATERSHED IS IMPAIRED BY BACTERIA (E. COLI), SULFATE, CHLORIDE, CADMIUM, ARSENIC, LEAD, COPPER, CHROMIUM, NICKEL, MERCURY, ZINC, CHLORDANE, CHANNELIZATION, PHOSPHORUS, NITROGEN, AND TOTAL SUSPENDED SOLIDS (TSS). THE RECEIVING WATERS ARE NOT CLASSIFIED UNDER TIER II HIGH QUALITY WATERS.
- THE PROJECT SITE IS LOCATED WITHIN A FEMA REGULATED FLOODPLAIN: FEMA FIRM PANEL NO 24027C0160D.
- SURVEY OF THIS SITE WAS PERFORMED BY C. C. JOHNSON & MALHOTRA, P.C. (CCJM) IN MARCH 2021.
- WETLANDS AND WATERS OF THE US WERE DELINEATED BY STANTEC IN MARCH 2021.
- A WAIVER PETITION FOR ALTERNATIVE COMPLIANCE SHALL BE SUBMITTED TO THE HOWARD COUNTY DEPARTMENT OF PLANNING AND ZONING FOR THIS PROJECT AFTER THE FACT.
- FOR STREAM CHANNEL WORK THE CONTRACTOR SHALL ONLY DISTURB THE LENGTH OF CHANNEL THAT CAN AND SHALL BE STABILIZED AT THE END OF EACH WORK DAY.
- THE DEPARTMENT OF PUBLIC WORKS HAS DETERMINED THAT THE DISTURBANCE OF WETLANDS, STREAMS, BUFFERS, AND STEEP SLOPES FOR THIS PROJECT ARE CONSIDERED ESSENTIAL OR NECESSARY IN ACCORDANCE WITH SECTION 16.115(c) OF THE SUBDIVISION AND LAND DEVELOPMENT REGULATIONS.
- THIS PLAN IS PREPARED IN ACCORDANCE WITH THE PROVISIONS OF SECTION 16.124 OF THE HOWARD COUNTY CODE AND THE LANDSCAPE MANUAL.
- OBSTRUCTIONS SHOWN ON THIS DRAWING ARE FOR THE CONVENIENCE OF THE CONTRACTOR ONLY AND DO NOT WARRANT OR GUARANTEE THE CORRECTNESS OR COMPLETENESS OF THE INFORMATION GIVEN. THE CONTRACTOR MUST VERIFY SUCH INFORMATION ON ITS OWN.
- SHOULD THE CONTRACTOR DISCOVER ANY DISCREPANCIES BETWEEN THE PLANS AND FIELD CONDITIONS, THE COUNTY SHOULD BE NOTIFIED IMMEDIATELY TO RESOLVE THE SITUATION. SHOULD THE CONTRACTOR MAKE FIELD CORRECTIONS OR ADJUSTMENTS WITHOUT NOTIFYING THE COUNTY, THEN THE CONTRACTOR ASSUMES ALL RESPONSIBILITY FOR THOSE CHANGES.
- ALL PIPE ELEVATIONS SHOWN ARE INVERT ELEVATIONS.
- THE CONTRACTOR IS SOLELY RESPONSIBLE FOR CONSTRUCTION MEANS, METHODS, TECHNIQUES, SEQUENCES, PROCEDURES, AND SAFETY PRECAUTIONS AND PROGRAMS.
- CONTRACTOR SHALL CONTINUOUSLY MONITOR WEATHER FORECASTS DURING WORK ACTIVITIES AND SCHEDULE WORK DURING FAVORABLE CONDITIONS.
- THE CONTRACTOR SHALL EXERCISE CARE IN ACTIVITIES INVOLVING EITHER CUT AND FILL OR GRADING IN THE VICINITY OF TREES THAT ARE TO REMAIN. ACTIVITIES NEAR TREES THAT ARE TO REMAIN SHALL BE DONE IN A MANNER THAT DOES NOT DISTURB THE CRITICAL ROOT ZONE OR WITHIN THE DRILLPIE OF THE TREES. ORANGE FENCING SHALL BE INSTALLED AROUND THE PERIMETER OF THE CRITICAL ROOT ZONE PRIOR TO CONSTRUCTION. THE LOCATION OF THE PROTECTIVE ORANGE FENCE SHALL BE APPROVED BY THE HOWARD COUNTY DEPARTMENT OF PUBLIC WORKS PRIOR TO CONSTRUCTION.
- CONTRACTOR SHALL NOT STORE EQUIPMENT, MATERIALS, AND/OR SUPPLIES BEYOND THE ORANGE FENCING SHOWN ON THE PLANS OR IN THE 100-YR FLOODPLAIN.
- UPON COMPLETION OF WORK BUT PRIOR TO DE-MOBILIZATION, THE CONTRACTOR SHALL REMOVE REMNANTS OF CONSTRUCTION MATERIAL FROM THE SITE. THE CONTRACTOR SHALL RESTORE ALL DISTURBED AREAS TO A CONDITION EQUAL TO OR BETTER THAN THE PRE-CONSTRUCTION CONDITIONS.
- PRIOR TO BEGINNING ANY CONSTRUCTION ACTIVITIES, PHOTOGRAPHS OF THE PROPOSED WORK AREA AND ACCESS SHALL BE TAKEN.
- ALL TREES TO BE REMOVED SHALL BE CUT AT THE BASE WITH A SAW AND NOT PUSHED OVER. TREE STUMPS OUTSIDE THE EMBANKMENT MAY BE LEFT IN PLACE, UNLESS OTHERWISE DIRECTED ON THE PLANS OR BY THE ENGINEER.
- THE CONTRACTOR SHALL USE EXTREME CAUTION WHEN EXITING THE PROJECT SITE AND PAY CLOSE ATTENTION TO TRAFFIC NEAR THE SITE.
- WORKING HOURS ARE 7 A.M. TO 5 P.M. MONDAY THROUGH FRIDAY. WITH ADVANCED PERMISSION FROM THE COUNTY, CONTRACTORS MAY WORK ON SATURDAY 9 A.M. TO 3 P.M. NO WORK IS ALLOWED ON SUNDAY.
- THE CONTRACTOR SHALL AVOID TRACKING HEAVY EQUIPMENT OVER CRITICAL ROOT ZONE OF SPECIMEN TREES. IF UNAVOIDABLE, LOAD MATS SHOULD BE USED WHEN TRACKING OVER CRITICAL ROOT ZONES AND WHILE TRACKING OVERTOP OF SANITARY SEWER LINES.
- NO STRUCTURE OR SUBDIVISIONS ARE PROPOSED; THEREFORE THIS PROJECT IS NOT REQUIRED TO MEET THE PROVISIONS OF SECTION 16.124 OF THE HOWARD COUNTY CODE AND LANDSCAPE MANUAL.

OWNERS/DEVELOPER'S CERTIFICATE

"I/WE HEREBY CERTIFY THAT ANY CLEARING, GRADING, CONSTRUCTION, OR DEVELOPMENT WILL BE DONE PURSUANT TO THIS APPROVED EROSION AND SEDIMENT CONTROL PLAN, INCLUDING INSPECTING AND MAINTAINING CONTROLS, AND THAT THE RESPONSIBLE PERSONNEL INVOLVED IN THAT CONSTRUCTION PROJECT WILL HAVE A CERTIFICATE OF TRAINING AT A MARYLAND DEPARTMENT OF THE ENVIRONMENT (MDE) APPROVED TRAINING PROGRAM FOR THE CONTROL OF EROSION AND SEDIMENT PRIOR TO BEGINNING THE PROJECT. I CERTIFY RIGHT-OF-ENTRY FOR PERIODIC ON-SITE EVALUATION BY HOWARD COUNTY, THE HOWARD SOIL CONSERVATION DISTRICT AND/OR MDE."

Silver Chai
SILVER CHAI, PE
2021-12-30
DATE

I:\05255-projects\102081\12603\03_dwg\102081_12603_03.dwg (1) - Title - Bonnie Branch.dwg 1/26/2022 11:34 AM using aut-ldp.cab

DEPARTMENT OF PUBLIC WORKS
HOWARD COUNTY, MARYLAND

4/18/22
4/14/22

DIRECTOR OF PUBLIC WORKS DATE
CHIEF, BUREAU OF UTILITIES DATE

CHIEF, BUREAU OF ENGINEERING DATE
CHIEF, UTILITY DESIGN DIVISION DATE

Stantec

The Contractor shall verify and be responsible for all dimensions. DO NOT scale the drawing - any errors or omissions shall be reported to Stantec without delay. The Copyrights to all designs and drawings are the property of Stantec. Reproduction or use for any purpose other than that authorized by Stantec is forbidden.

810 GLEN EAGLES CT.
SUITE 300
BALTIMORE, MD 21286
TEL. 410.583.6700
FAX. 410.583.6704
www.stantec.com




DES:	DRN:	CHK:	DATE:	BY:	NO.:	REVISION:	DATE:
AB	DD	RP	01/2022				

Bonnie Branch Emergency Sewer Protection & Stream Bank Stabilization at MH 124
TITLE SHEET
TI-01
600 SCALE MAP NO. 31 BLOCK NO. 4

**BONNIE BRANCH
INTERCEPTOR SEWER IMPROVEMENTS
CONTRACT NO. 10-5034
2ND ELECTION DISTRICT
HOWARD COUNTY, MARYLAND**

SCALE AS SHOWN
SHEET 17 OF 26

Maryland's Guidelines To Waterway Construction
DETAIL 1.2: PUMP-AROUND PRACTICE

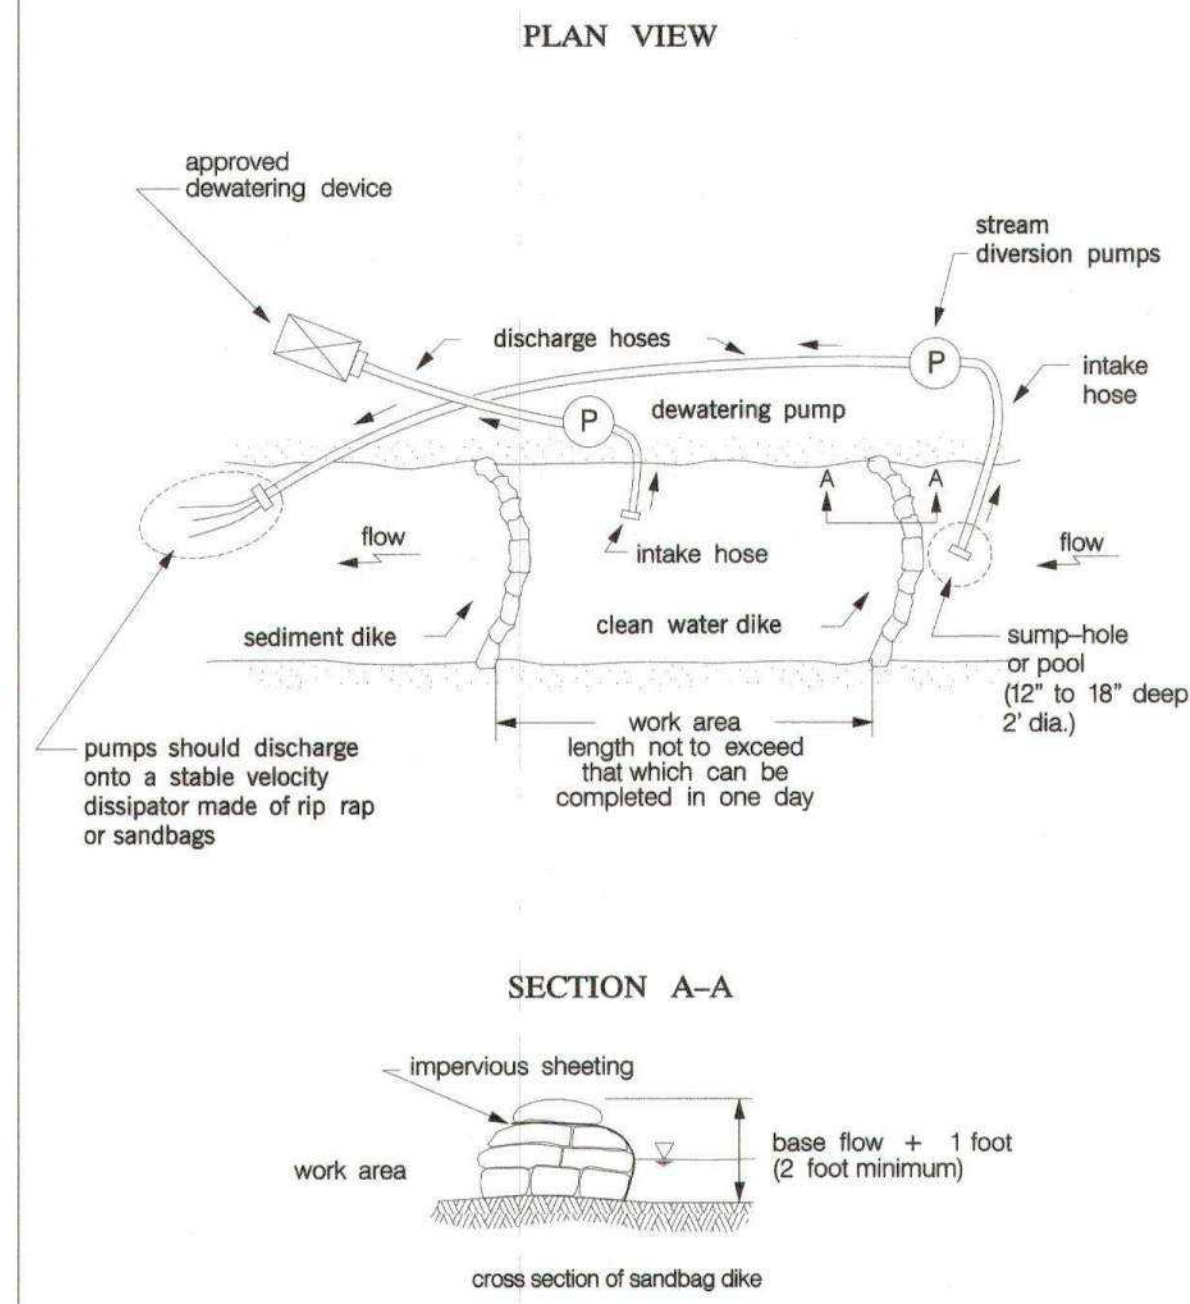

TEMPORARY INSTREAM CONSTRUCTION MEASURES
 REVISION NOVEMBER 2000
 MARYLAND DEPARTMENT OF THE ENVIRONMENT
 WATERWAY CONSTRUCTION GUIDELINES
 WATER MANAGEMENT ADMINISTRATION

MGWC 1.2: PUMP-AROUND PRACTICE

Temporary measure for dewatering in-channel construction sites

DESCRIPTION

The work should consist of installing a temporary pump around and supporting measures to divert flow around in-stream construction sites.

IMPLEMENTATION SEQUENCE

Sediment control measures, pump-around practices, and associated channel and bank construction should be completed in the following sequence (refer to Detail 1.2):

- Construction activities including the installation of erosion and sediment control measures should not begin until all necessary easements and/or right-of-ways have been acquired. All existing utilities should be marked in the field prior to construction. The contractor is responsible for any damage to existing utilities that may result from construction and should repair the damage at his/her own expense to the county's or utility company's satisfaction.
- The contractor should notify the Maryland Department of the Environment or WMA sediment control inspector at least 5 days before beginning construction. Additionally, the contractor should inform the local environmental protection and resource management inspection and enforcement division and the provider of local utilities a minimum of 48 hours before starting construction.
- The contractor should conduct a pre-construction meeting on site with the WMA sediment control inspector, the county project manager, and the engineer to review limits of disturbance, erosion and sediment control requirements, and the sequence of construction. The contractor should stake out all limits of disturbance prior to the pre-construction meeting so they may be reviewed. The participants will also designate the contractor's staging areas and flag all trees within the limit of disturbance which will be removed for construction access. Trees should not be removed within the limit of disturbance without approval from the WMA or local authority.
- Construction should not begin until all sediment and erosion control measures have been installed and approved by the engineer and the sediment control inspector. The contractor should stay within the limits of the disturbance as shown on the plans and minimize disturbance within the work area whenever possible.
- Upon installation of all sediment control measures and approval by the sediment control inspector and the local environmental protection and resource management inspection and enforcement division, the contractor should begin work at the upstream section and proceed downstream beginning with the establishment of stabilized construction entrances. In some cases, work may begin downstream if appropriate. The sequence of construction must be followed unless the contractor gets written approval for deviations from the WMA or local authority. The contractor should only begin work in an area which can be completed by the end of the day including grading adjacent to the channel. At the end of each work day, the work area must be stabilized and the pump around removed from the channel. Work should not be conducted in the channel during rain events.
- Sandbag dikes should be situated at the upstream and downstream ends of the work area as shown on the plans, and stream flow should be pumped around the work area. The pump should discharge onto a stable velocity dissipater made of riprap or sandbags.

TEMPORARY INSTREAM CONSTRUCTION MEASURES
 MARYLAND DEPARTMENT OF THE ENVIRONMENT
 WATERWAY CONSTRUCTION GUIDELINES
 REVISION NOVEMBER 2000


PAGE 1.2 - 1

MGWC 1.2: PUMP-AROUND PRACTICE


- Water from the work area should be pumped to a sediment filtering measure such as a dewatering basin, sediment bag, or other approved source. The measure should be located such that the water drains back into the channel below the downstream sandbag dike.
- Traversing a channel reach with equipment within the work area where no work is proposed should be avoided. If equipment has to traverse such a reach for access to another area, then timber mats or similar measures should be used to minimize disturbance to the channel. Temporary stream crossings should be used only when necessary and only where noted on the plans or specified. (See Section 4, Stream Crossings, Maryland Guidelines to Waterway Construction).
- All stream restoration measures should be installed as indicated by the plans and all banks graded in accordance with the grading plans and typical cross-sections. All grading must be stabilized at the end of each day with seed and mulch or seed and matting as specified on the plans.
- After an area is completed and stabilized, the clean water dike should be removed. After the first sediment flush, a new clean water dike should be established upstream from the old sediment dike. Finally, upon establishment of a new sediment dike below the old one, the old sediment dike should be removed.
- A pump around must be installed on any tributary or storm drain outfall which contributes baseflow to the work area. This should be accomplished by locating a sandbag dike at the downstream end of the tributary or storm drain outfall and pumping the stream flow around the work area. This water should discharge onto the same velocity dissipater used for the main stem pump around.
- If a tributary is to be restored, construction should take place on the tributary before work on the main stem reaches the tributary confluence. Construction in the tributary, including pump around practices, should follow the same sequence as for the main stem of the river or stream. When construction on the tributary is completed, work on the main stem should resume. Water from the tributary should continue to be pumped around the work area in the main stem.
- The contractor is responsible for providing access to and maintaining all erosion and sediment control devices until the sediment control inspector approves their removal.
- After construction, all disturbed areas should be regraded and revegetated as per the planting plan.

TEMPORARY INSTREAM CONSTRUCTION MEASURES
 MARYLAND DEPARTMENT OF THE ENVIRONMENT
 WATERWAY CONSTRUCTION GUIDELINES
 REVISION NOVEMBER 2000


PAGE 1.2 - 2

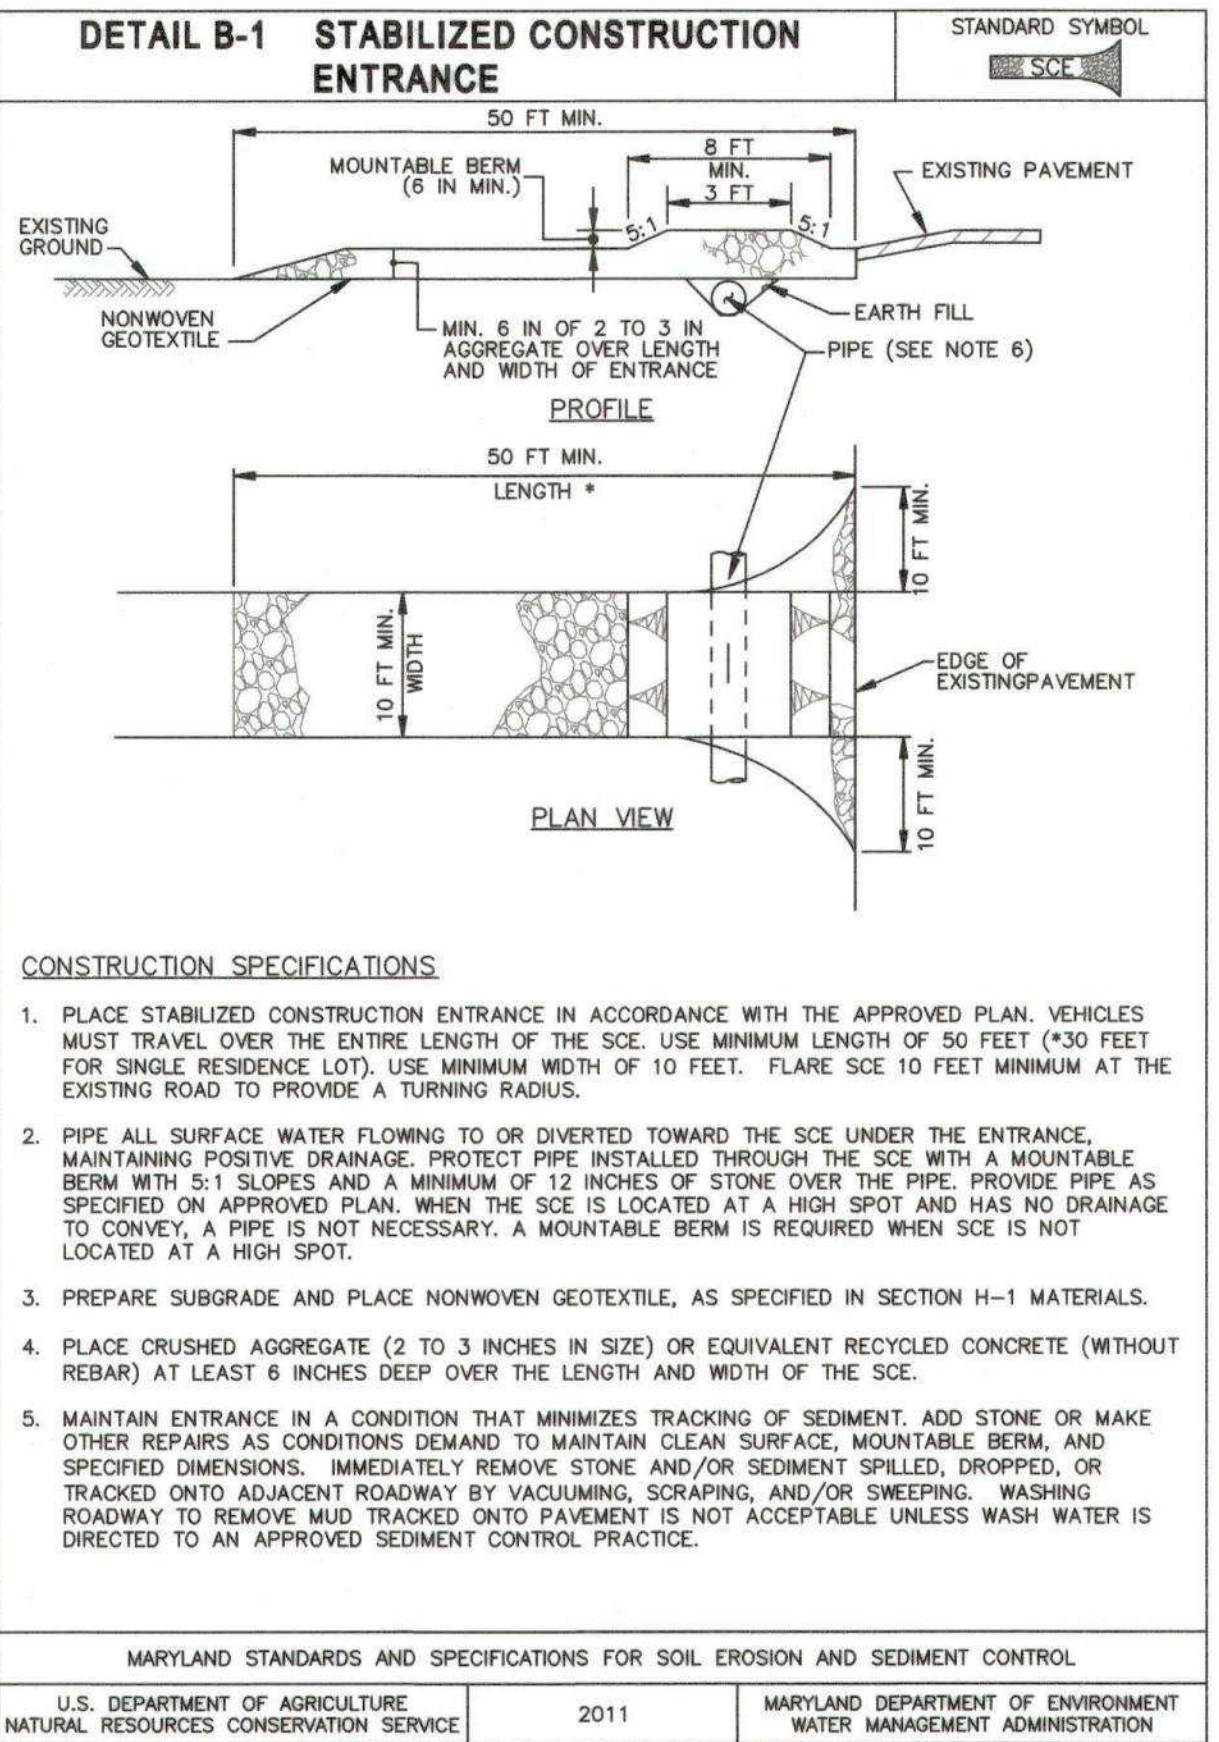


MARYLAND STANDARDS AND SPECIFICATIONS FOR SOIL EROSION AND SEDIMENT CONTROL
 U.S. DEPARTMENT OF AGRICULTURE
 NATURAL RESOURCES CONSERVATION SERVICE
 2011
 MARYLAND DEPARTMENT OF ENVIRONMENT
 WATER MANAGEMENT ADMINISTRATION
 B.2

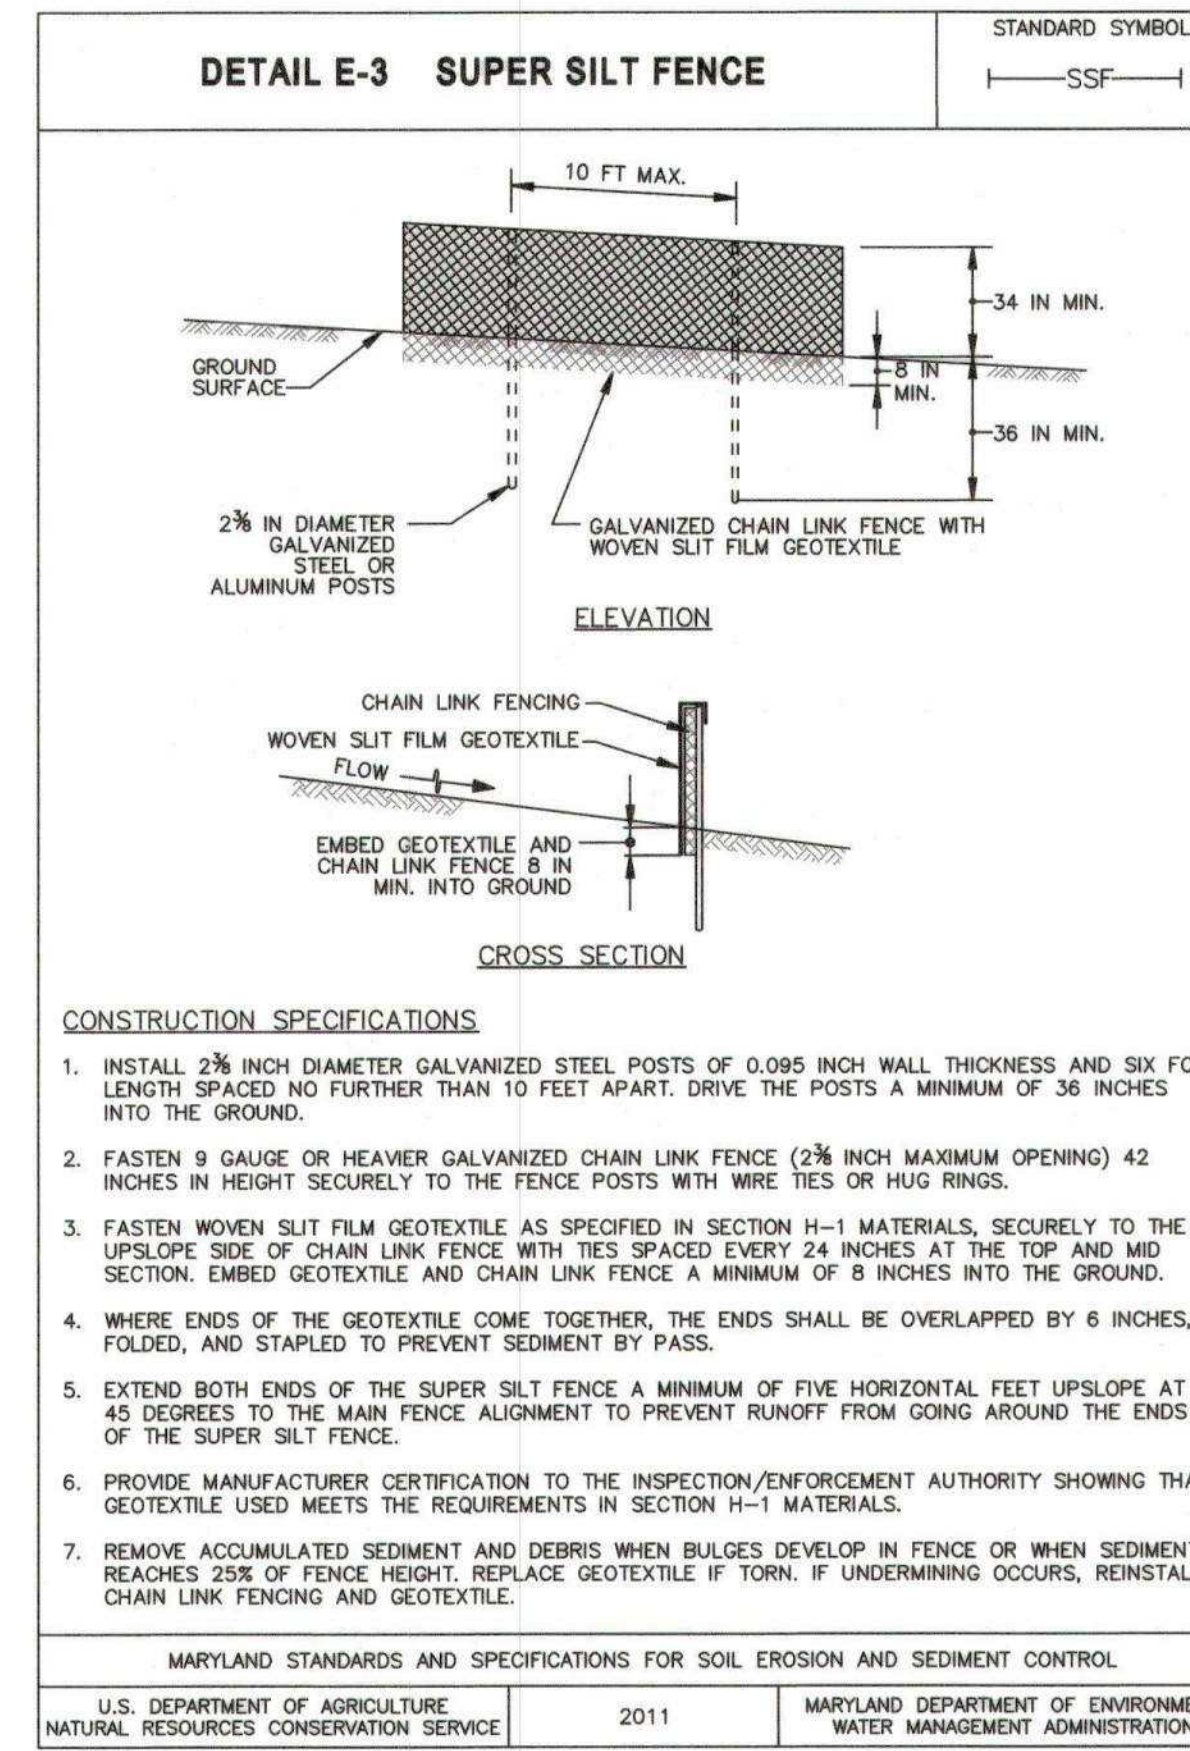


MARYLAND STANDARDS AND SPECIFICATIONS FOR SOIL EROSION AND SEDIMENT CONTROL
 U.S. DEPARTMENT OF AGRICULTURE
 NATURAL RESOURCES CONSERVATION SERVICE
 2011
 MARYLAND DEPARTMENT OF ENVIRONMENT
 WATER MANAGEMENT ADMINISTRATION
 E.7

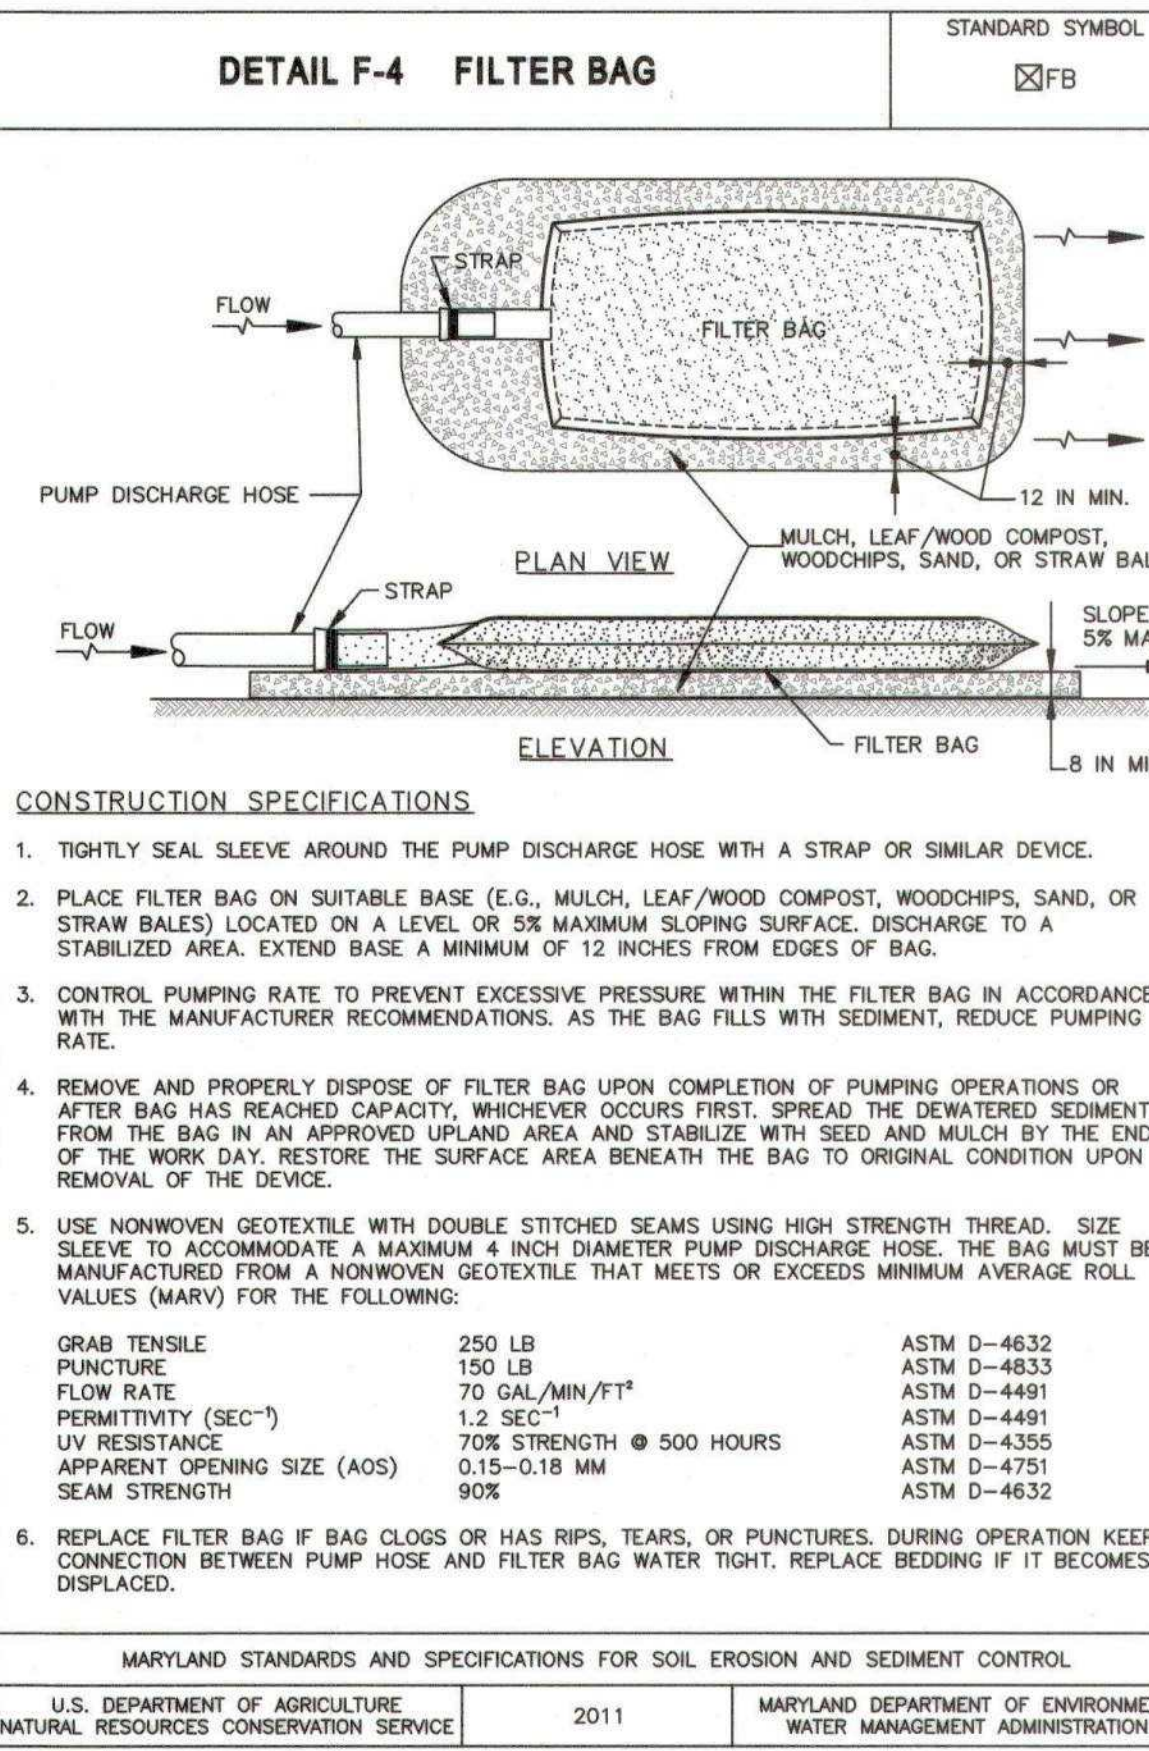

MARYLAND STANDARDS AND SPECIFICATIONS FOR SOIL EROSION AND SEDIMENT CONTROL
 U.S. DEPARTMENT OF AGRICULTURE
 NATURAL RESOURCES CONSERVATION SERVICE
 2011
 MARYLAND DEPARTMENT OF ENVIRONMENT
 WATER MANAGEMENT ADMINISTRATION
 F.9

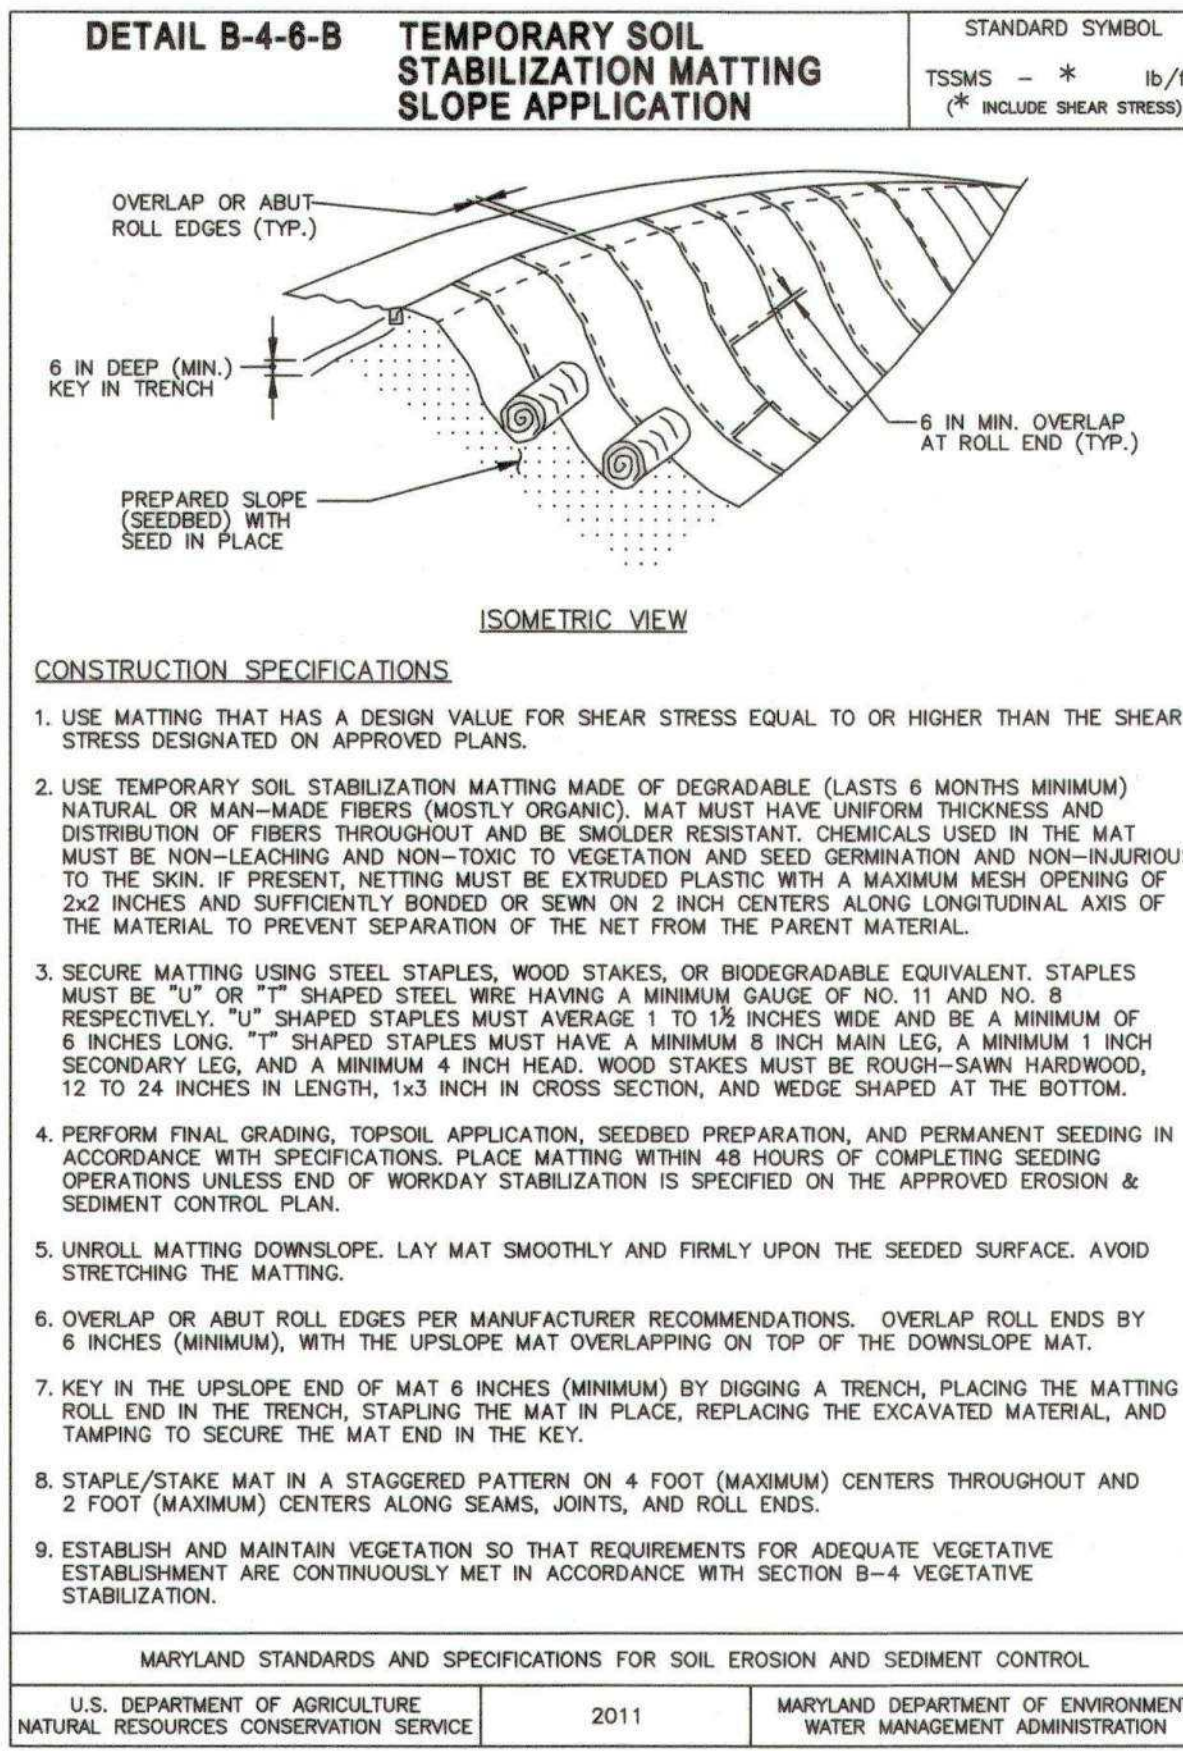

MARYLAND STANDARDS AND SPECIFICATIONS FOR SOIL EROSION AND SEDIMENT CONTROL
 U.S. DEPARTMENT OF AGRICULTURE
 NATURAL RESOURCES CONSERVATION SERVICE
 2011
 MARYLAND DEPARTMENT OF ENVIRONMENT
 WATER MANAGEMENT ADMINISTRATION
 B.39

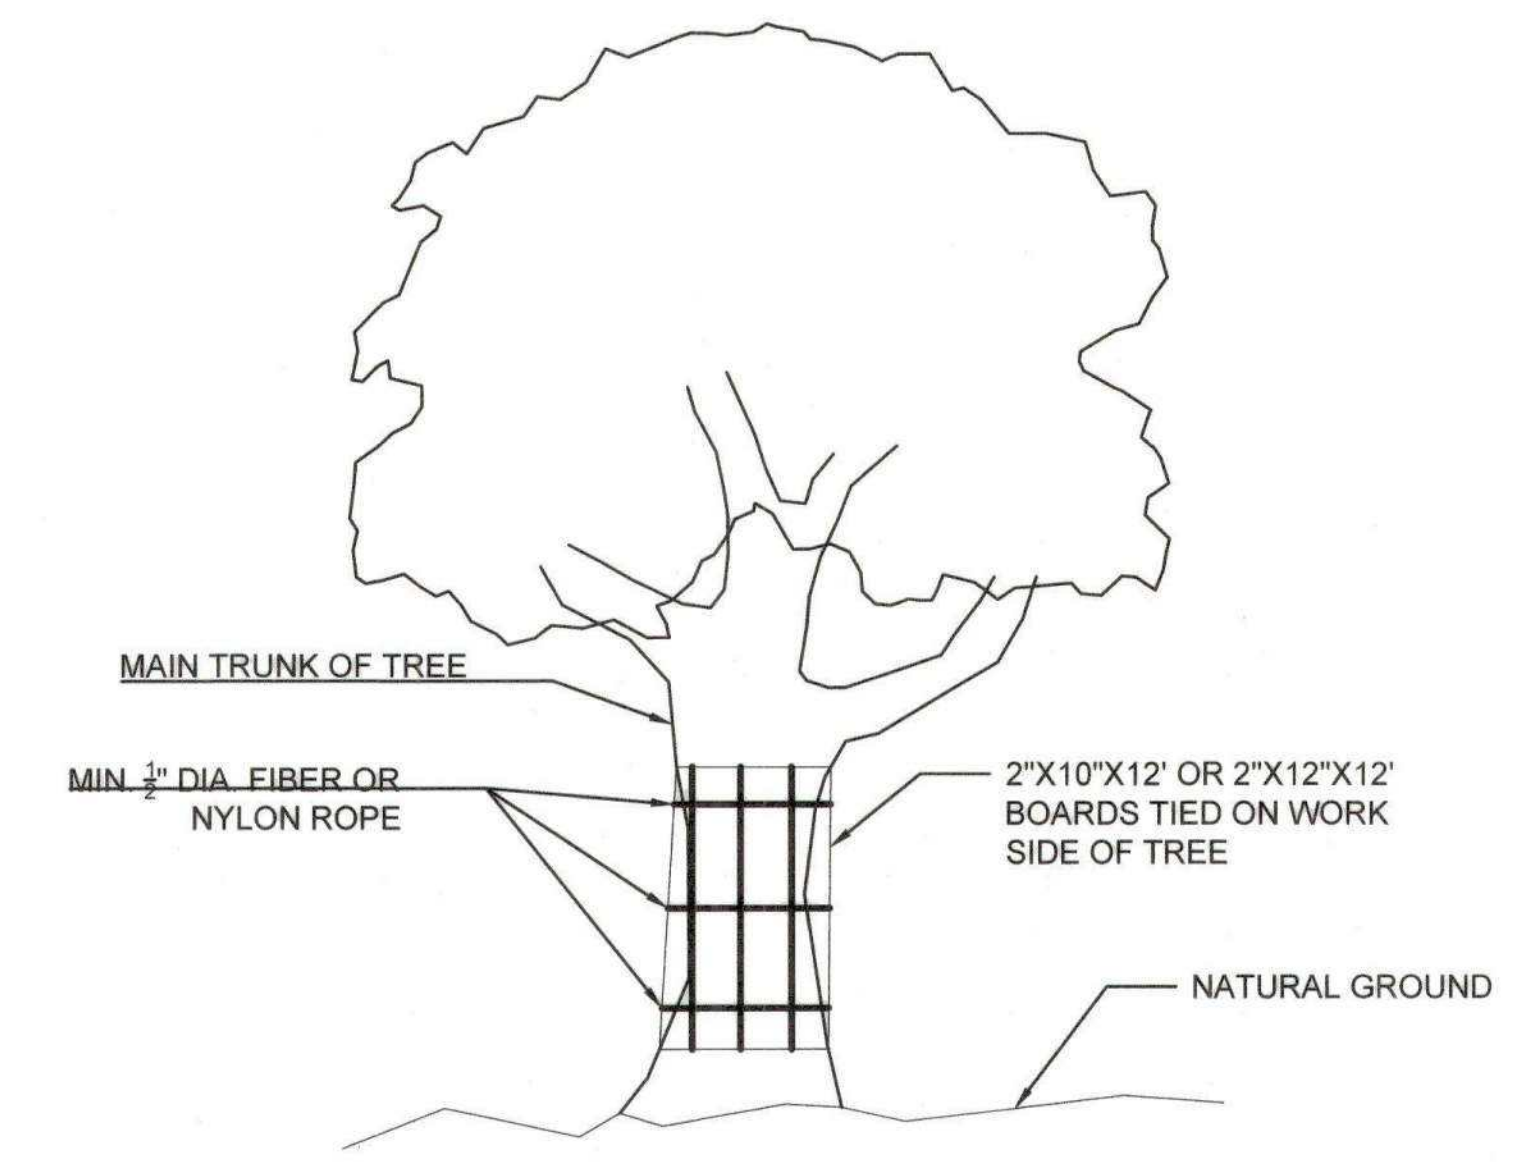

NOTES:
 1. TIE WITH 1/2" DIAMETER ROPE (FIBER OR NYLON), SUFFICIENT 2"x10"x12" OR 2"x12"x12" BOARDS AROUND MAIN TRUNK OF TREE TO PROTECT ALL AREAS EXPOSED TO CONSTRUCTION.

TREE PROTECTION PLANKING
 N.T.S.

AS-BUILT
 DATE 12/22/2021

DEPARTMENT OF PUBLIC WORKS
 HOWARD COUNTY, MARYLAND
 Director of Public Works: [Signature] 4/27/2022
 Chief, Bureau of Engineering: [Signature] 4-18-22
 Chief, Bureau of Utilities: [Signature] 4/21/22
 Chief, Utility Design Division: [Signature] 4/14/22

Stantec
 The Contractor shall verify and be responsible for all dimensions. DO NOT scale the drawing - any errors or omissions shall be reported to Stantec without delay. The Copyrights to all designs and drawings are the property of Stantec. Reproduction or use for any purpose other than that authorized by Stantec is forbidden.
 810 GLEN EAGLES CT,
 SUITE 300
 BALTIMORE, MD 21286
 TEL: 410.583.6700
 FAX: 410.583.6704
 www.stantec.com

DES:	AB				
DRN:	DD				
CHK:	RP				
DATE:	01/2022	BY	NO.	REVISION	DATE

Bonnie Branch Emergency Sewer Protection & Stream Bank Stabilization at MH 124
EROSION CONTROL DETAILS
 EN-03
 600 SCALE MAP NO. 31 BLOCK NO. 4

BONNIE BRANCH INTERCEPTOR SEWER IMPROVEMENTS
 CONTRACT NO. 10-5034
 2ND ELECTION DISTRICT
 HOWARD COUNTY, MARYLAND

SCALE AS SHOWN
 SHEET 25 OF 26

