
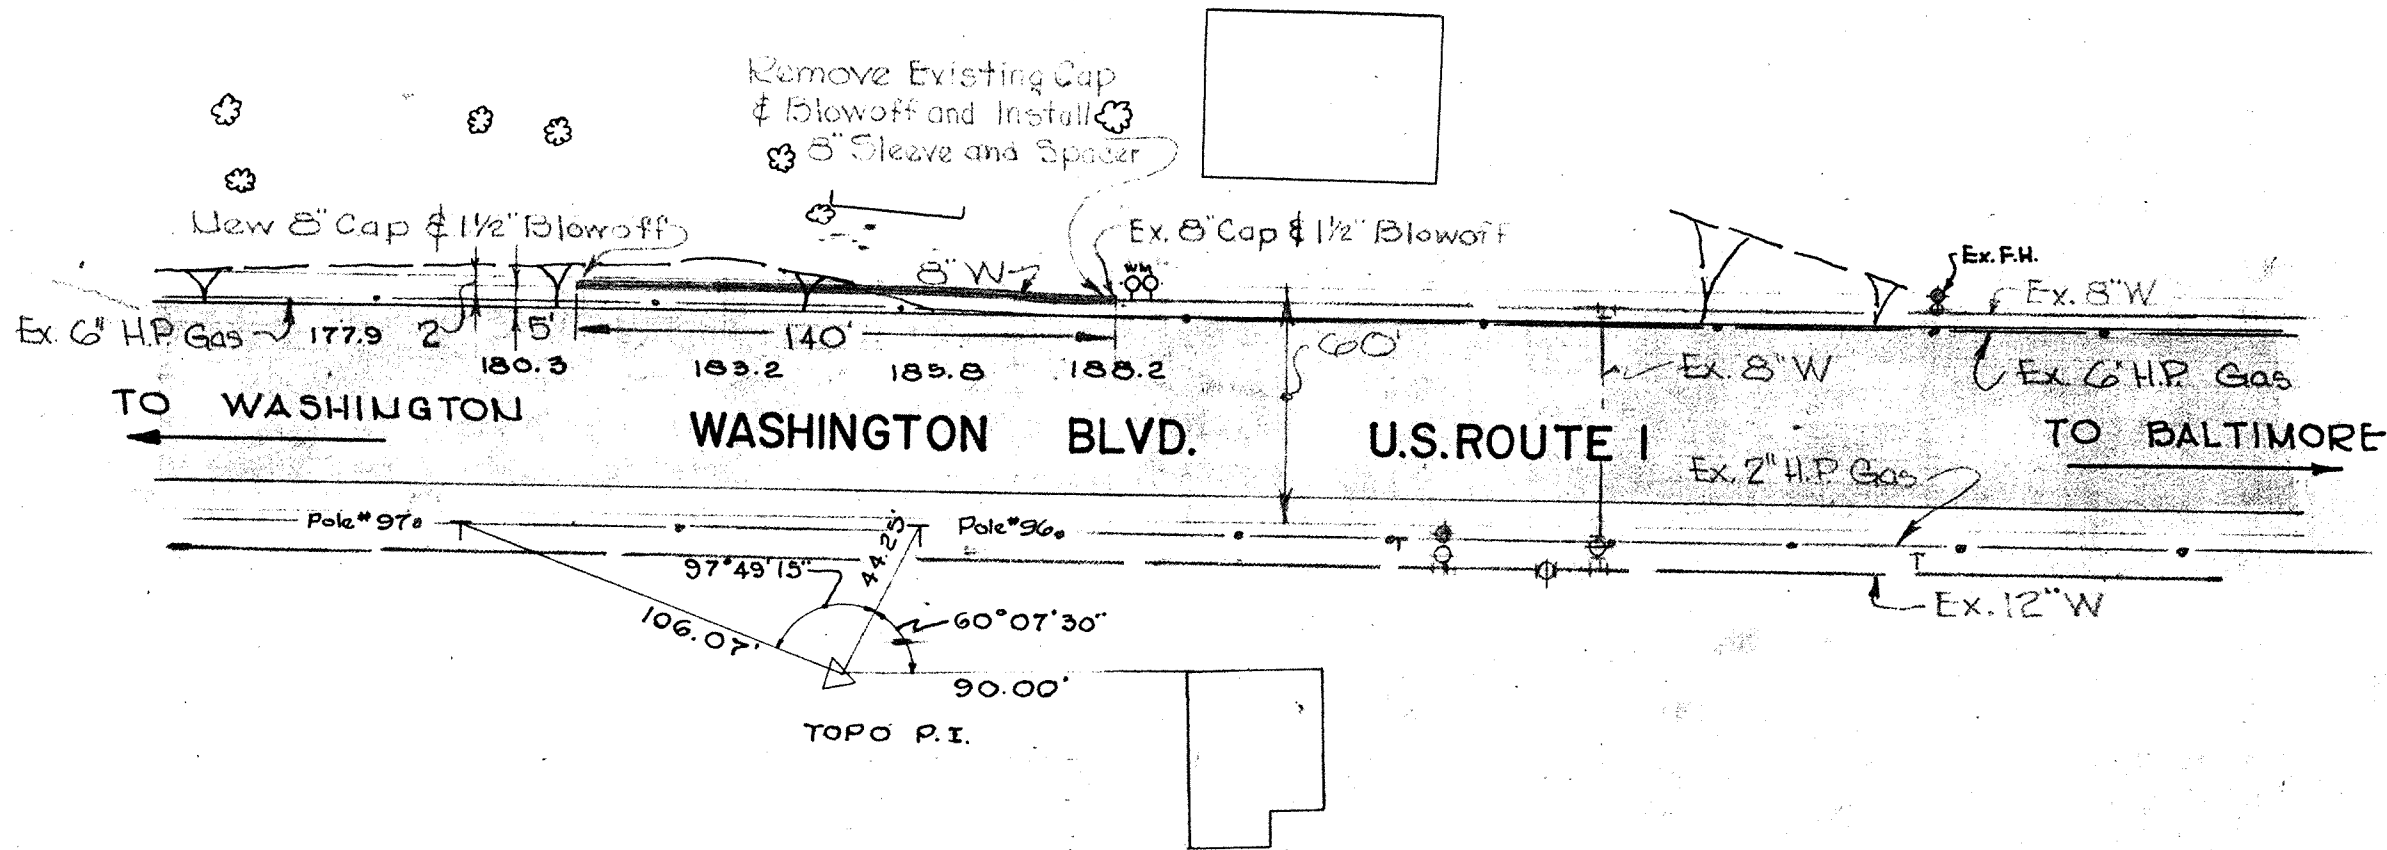


Contractor to make the connection to the existing 8" water main under the inspection of the Bureau of Water Supply of Baltimore City. Static Design Pressure at connection to existing 8" water main = 165 p.s.i. based upon Melvin Ave. Tank.

BILL OF MATERIALS		
NO.	DESCRIPTION	SIZE
1	Cap & Blowoff	8"
140	Class 22 C.I.P. t=0.41	8"

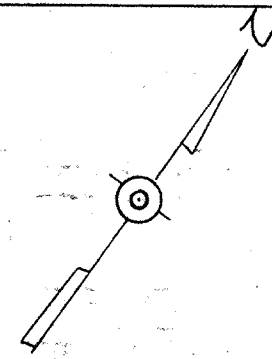

Note: Elevations shown are at North edge of paving. Water main to have a minimum of 4.0 ft. of cover.

2W

RIGHT OF WAY SECURED	
DATE	REFERENCE <u>State Road</u>
PERMIT REQUESTED <u>State Road</u>	
PERMIT NUMBER <u>97-871</u>	
GRADE ESTABLISHED	
PROFILE NUMBER	

DRAWN TRACED CHECKED EXAMINED	HOWARD COUNTY METROPOLITAN COMMISSION ELKRIDGE SUB-DISTRICT MARYLAND	APPROVED BY HOWARD COUNTY METROPOLITAN COMMISSION <u>June 19, 1956</u> DATE	APPROVED FOR CITY OF BALTIMORE <u>7-19-56</u> DATE	
	PREPARED BY WHITMAN REQUARDT & ASSOCIATES CONSULTING ENGINEERS BALTIMORE, MD.	PROPOSED 8" WATER MAIN IN WASHINGTON BLVD. FROM 570' EAST OF HUNT CLUB ROAD 140' EASTERLY	WATER ENGINEER <u>Howard Lechner</u>	DIR. PUBLIC WORKS <u>George A. Baxter</u>
	ELKRIDGE	MARYLAND	DRAWING NO. <u>4</u> OF <u>4</u>	SCALE <u>1"=50'</u>
	4286	AS BUILT	JO DATE FILE	