


LEGEND
 F.H. - FIRE HYDRANT
 V. - EXISTING VALVE

Revised according to Record Print
 DATE 7/19/50 BY THE WILSON T. BALLARD CO.

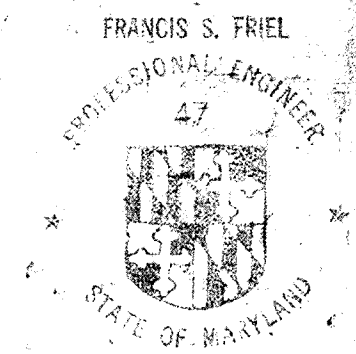

DRAWN: H.F.D. TRACED: H.F.D. CHECKED: J.S.G. EXAMINED	HOWARD COUNTY METROPOLITAN COMMISSION ELKRIDGE SUB-DISTRICT MARYLAND	APPROVED BY HOWARD COUNTY METROPOLITAN COMMISSION DATE _____ <i>[Signature]</i>	APPROVED FOR CITY OF BALTIMORE DATE 9-29-49 <i>[Signature]</i> WATER ENGINEER	KEY PLAN EXTENSION OF WATER SYSTEM IN ELKRIDGE SUB-DISTRICT OF HOWARD COUNTY METROPOLITAN DISTRICT ELKRIDGE MARYLAND	PREPARED BY ALBRIGHT & FRIEL, INC. CONSULTING ENGINEERS PHILADELPHIA, PA.	DRAWING NO. 1 OF 1	SCALE 1" = 500'	J.O. 47079 DATE: 1-28-49 FILE
----------------------------------------------------------------	-------------------------------------------------------------------------------	---------------------------------------------------------------------------------------	----------------------------------------------------------------------------------------	-------------------------------------------------------------------------------------------------------------------------------	------------------------------------------------------------------------------------	--------------------------	--------------------	-------------------------------------