

INDEX OF SHEETS

SHEET NO.	DESCRIPTION
1	TITLE SHEET
2	PLAN SHEET
3	WALL DRAINAGE PROFILE AND DETAILS SHEET
4	RCP SPILLWAY JOINT GROUTING DETAILS I
5	RCP SPILLWAY JOINT GROUTING DETAILS II
6	EROSION AND SEDIMENT CONTROL PLAN
7	EROSION AND SEDIMENT CONTROL DETAILS
8	EROSION AND SEDIMENT CONTROL NOTES

LEGEND

- EX. TREES
- EXIST. MAJOR CONTOUR
- EXIST. MINOR CONTOUR
- PROP. MAJOR CONTOUR
- PROP. MINOR CONTOUR
- EXIST. PROPERTY LINE
- WETLANDS
- ORANGE SAFETY FENCE
- LIMIT OF DISTURBANCE
- SILT FENCE
- RPS REMOVABLE PUMPING STATION
- DD SILT BAG DEWATERING DEVICE
- EXISTING FLOODPLAIN
- PROPOSED FLOODPLAIN
- EX. WATER LINE
- EX. SEWER LINE
- EX. MONITORING WELL
- PROPOSED MONITORING WELL

REMEDIAL REPAIRS COLUMBIA GATEWAY STORMWATER MANAGEMENT DAM

MD DAM # 79

HOWARD COUNTY, MARYLAND
DEPARTMENT OF PUBLIC WORKS
STORM WATER MANAGEMENT DIVISION


BENCHMARK DATA

TRAVERSE # 100
N 547416.521
E 1366115.778
E1. 330.622

TRAVERSE # 101
N 547982.702
E 1366517.162
E1. 319.189

TRAVERSE # 102
N 547829.585
E 1366523.319
E1. 319.023

TRAVERSE # 103
N 547756.363
E 1366590.451
E1. 290.851

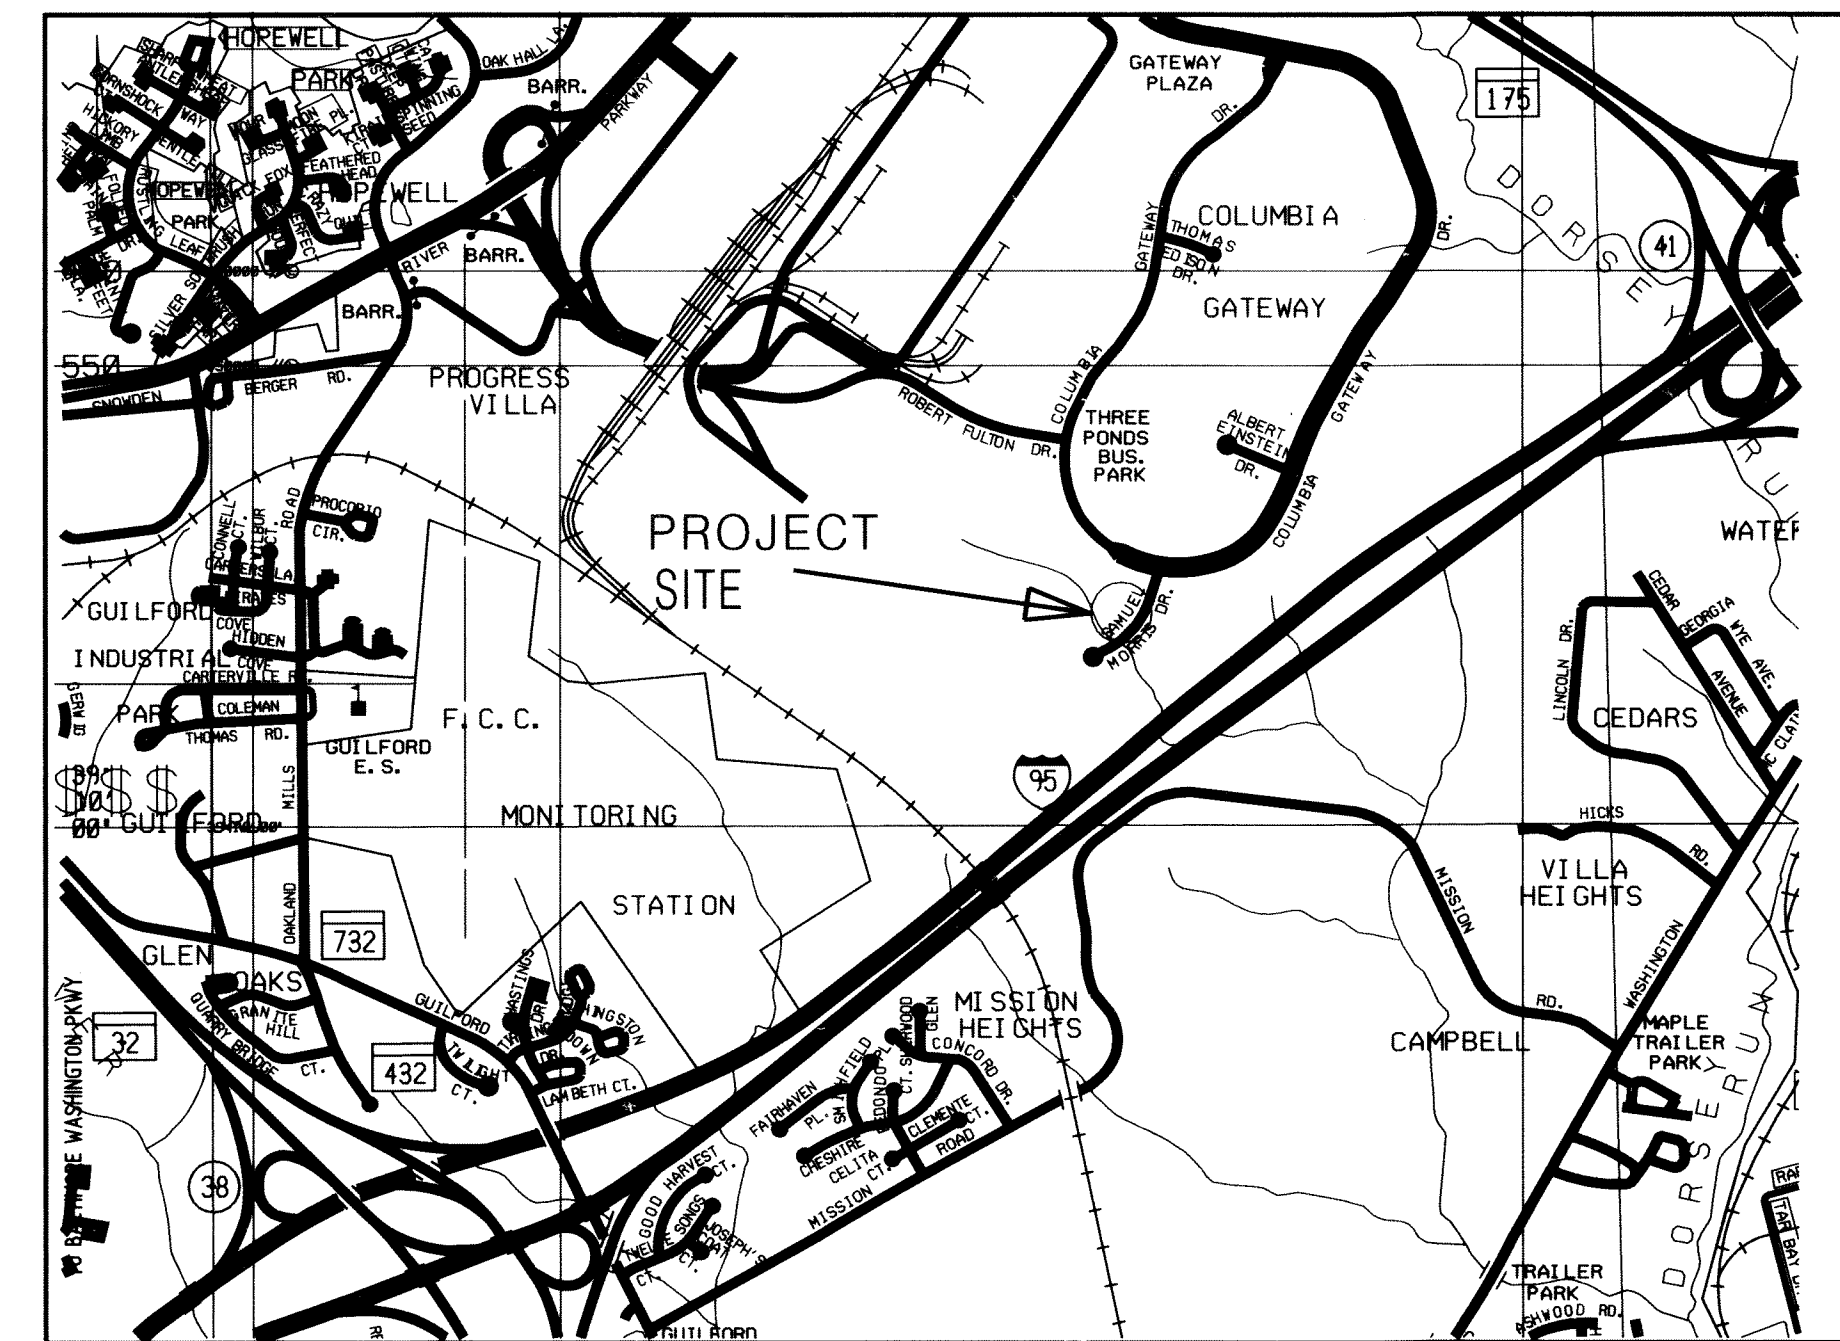

SITE VICINITY MAP
SCALE: 1" = 1500'

GENERAL NOTES



- THE PURPOSE OF THE REMEDIAL REPAIRS IS TO:
 - INSTALL AN UNDERDRAIN SYSTEM AT EACH OF THE EXISTING WINGWALLS (BY GENERAL CONTRACTOR/CONTRACTOR).
 - INSTALL TWO MONITORING WELLS, ONE EACH AT THE WINGWALLS (BY DRILLING SUB-CONTRACTOR).
 - GROUT SEAL EACH OF THE 17 JOINTS IN THE EXISTING 10-FT. DIA. RCP SPILLWAY AND THE HEADWALL/RCP INTERFACE JOINT (BY GROUTING SUB-CONTRACTOR).
- ALL WORK SHALL BE PERFORMED IN ACCORDANCE WITH HOWARD COUNTY STANDARDS, SPECIFICATIONS AND DETAILS FOR CONSTRUCTION.
- CALL MISS UTILITY AT 1-800-257-7777 5 DAYS PRIOR TO THE START OF WORK. THE CONTRACTOR AND GROUTING SUB-CONTRACTOR MUST NOTIFY ALL PUBLIC UTILITY COMPANIES WITH UNDERGROUND FACILITIES IN THE AREA OF PROPOSED EXCAVATION AND HAVE THOSE FACILITIES LOCATED BY THE UTILITY COMPANIES PRIOR TO COMMENCING EXCAVATION.
- ALL UTILITY COMPANIES SHALL BE NOTIFIED 24 HOURS IN ADVANCE OF CONSTRUCTION.
- APPROXIMATE LOCATION OF EXISTING UTILITIES ARE SHOWN. THE CONTRACTOR SHALL TAKE ALL NECESSARY PRECAUTIONS TO PROTECT THE EXISTING UTILITIES AND TO MAINTAIN UNINTERRUPTED SERVICE. ANY DAMAGE INCURRED DUE TO CONTRACTOR'S OPERATIONS SHALL BE REPAIRED AT CONTRACTOR'S EXPENSE.
- THE CONTRACTOR SHALL TEST PIT EXISTING UTILITIES WHERE DIRECTED BY THE ENGINEER A MINIMUM OF TWO WEEKS IN ADVANCE OF ANY CONSTRUCTION.
- WATERWAY CONSTRUCTION PERMIT WILL BE PROVIDED BY HOWARD COUNTY DPW.
- CONTRACTOR TO NOTIFY THE HOWARD COUNTY DEPARTMENT OF INSPECTIONS AND PERMITS AT LEAST 5 DAYS BEFORE STARTING WORK SHOWN OF THESE DRAWINGS. TELEPHONE NO. : 410-313-1880.
- ALL DISTURBED SLOPE AREAS TO BE STABILIZED AS SOON AS CONSTRUCTION WORK AND GRADING ARE COMPLETED.
- MAINTAINANCE OF TRAFFIC DURING CONSTRUCTION SHOULD BE IN ACCORDANCE WITH HOWARD COUNTY STANDARD DETAILS. TRAFFIC CONTROL DEVICES AND THEIR INSALLATION SHALL BE IN ACCORDANCE WITH THE MANUAL ON UNIFORM TRAFFIC CONTROL DEVICES, 1988 REVISED EDITION.
- SWM POND AS-BUILT SURVEY INFORMATION DATED OCTOBER 2006 WAS PROVIDED BY HOWARD COUNTY DEPARTMENT OF PUBLIC WORKS (DPW).
- THE MD DAM SAFETY DIVISION HAS CLASSIFIED THE DAM AS A HIGH HAZARD STRUCTURE DUE TO INCREASED FLOODING TO INTERSTATE 95.

AS-BUILT CERTIFICATION

I HEREBY CERTIFY THAT THE FACILITY SHOWN ON THIS PLAN WAS CONSTRUCTED AS SHOWN ON THE "AS-BUILT" PLAN AND MEETS THE APPROVED PLANS AND SPECIFICATIONS.

[Signature] PE NO. 33722
[Signature] DATE 12/14/2007

CERTIFY MEANS TO STATE OR DECLARE A PROFESSIONAL OPINION BASED UPON ONSITE INSPECTIONS AND MATERIAL TESTS WHICH ARE CONDUCTED DURING CONSTRUCTION. THE ONSITE INSPECTIONS AND MATERIAL TESTS ARE THOSE INSPECTIONS AND TESTS DEEMED SUFFICIENT AND APPROPRIATE BY COMMONLY ACCEPTED ENGINEERING STANDARDS. DOES NOT MEAN OR IMPLY A GAURANTEE BY THE ENGINEER NOR DOES AN ENGINEER'S CERTIFICATION RELIEVE ANY OTHER PARTY FROM MEETING REQUIREMENTS IMPOSED BY CONTRACT, EMPLOYMENT, OR OTHER MEANS, INCLUDING MEETING COMMONLY ACCEPTED INDUSTRY PRACTICES.

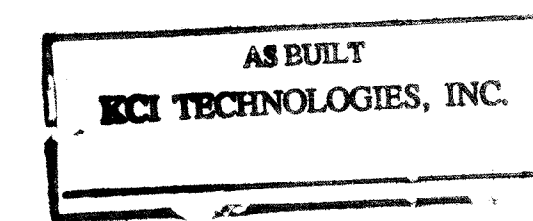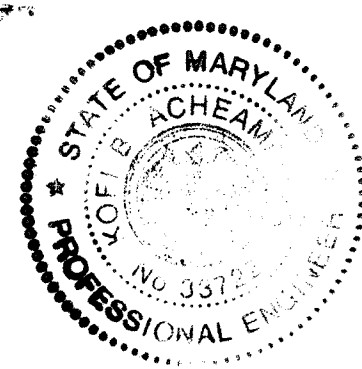

ENGINEER'S CERTIFICATION

"I CERTIFY THAT THIS PLAN FOR SEDIMENT AND EROSION CONTROL REPRESENTS A PRACTICAL AND WORKABLE PLAN BASED ON MY PERSONAL KNOWLEDGE OF THE SITE CONDITIONS AND THAT IT WAS PREPARED IN ACCORDANCE WITH THE STANDARDS AND SPECIFICATIONS FOR SOIL EROSION AND SEDIMENT CONTROL, DATED 1994."

[Signature] 8/9/07
 SIGNATURE OF ENGINEER (PRINT NAME BELOW SIGNATURE) DATE
 KOFI B. ACHEAMPONG

OWNER'S/DEVELOPER'S CERTIFICATE

"I/WE CERTIFY THAT ALL DEVELOPMENT AND CONSTRUCTION WILL BE DONE ACCORDING TO THIS PLAN OF DEVELOPMENT AND PLAN FOR SEDIMENT AND EROSION CONTROL, AND THAT ALL RESPONSIBLE PERSONNEL INVOLVED IN THE CONSTRUCTION PROJECT WILL HAVE A CERTIFICATE OF ATTENDANCE AT A DEPARTMENT OF NATURAL RESOURCES APPROVED TRAINING PROGRAM FOR THE CONTROL OF SEDIMENT AND EROSION BEFORE THE BEGINNING OF THE PROJECT. I ALSO AUTHORIZE PERIODIC ON-SITE INSPECTION BY THE HOWARD COUNTY SOIL CONSERVATION DISTRICT OR THEIR AUTHORIZED AGENTS AS ARE DEEMED NECESSARY."

[Signature] 8/7/07
 SIGNATURE OF DEVELOPER (PRINT NAME BELOW SIGNATURE) DATE
 Mark S. Richmond


DEPARTMENT OF PUBLIC WORKS
HOWARD COUNTY, MARYLAND

[Signature] DATE 8/7/07
 Evelyn S. Donlin
 CHIEF, BUREAU OF ENVIRONMENTAL SERVICES DATE
 Mark S. Richmond 8/7/07
 CHIEF, STORMWATER MANAGEMENT DIVISION DATE

KCI TECHNOLOGIES
 10 NORTH PARK DRIVE
 HUNT VALLEY, MD 21030
 PHONE: (410) 316-7800
 FAX: (410) 316-7817
 www.kci.com


NO.	REVISIONS DESCRIPTION	DATE

ENGINEERS
PLANNERS
SCIENTISTS
CONSTRUCTION MANAGERS
www.kci.com

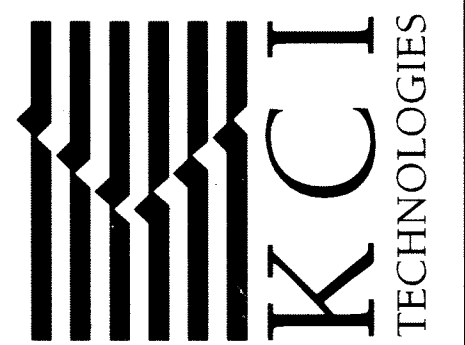



TITLE SHEET

COLUMBIA GATEWAY
STORM WATER
MANAGEMENT DAM
HOWARD COUNTY, MARYLAND
DEPARTMENT OF PUBLIC WORKS
STORM WATER MANAGEMENT DIVISION
6751 COLUMBIA GATEWAY DRIVE
COLUMBIA, MD 21046

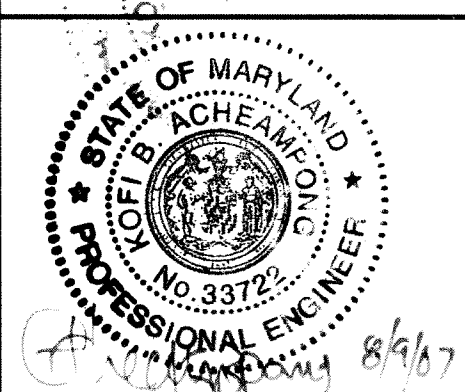

SCALE: NTS
 DATE: 08/7/2007
 KCI JOB NO.: 01-04322320
 DESIGNED BY: KBA
 DRAWN BY: MPP
 CHECKED BY: KBA

SHEET NO.
1 OF 8

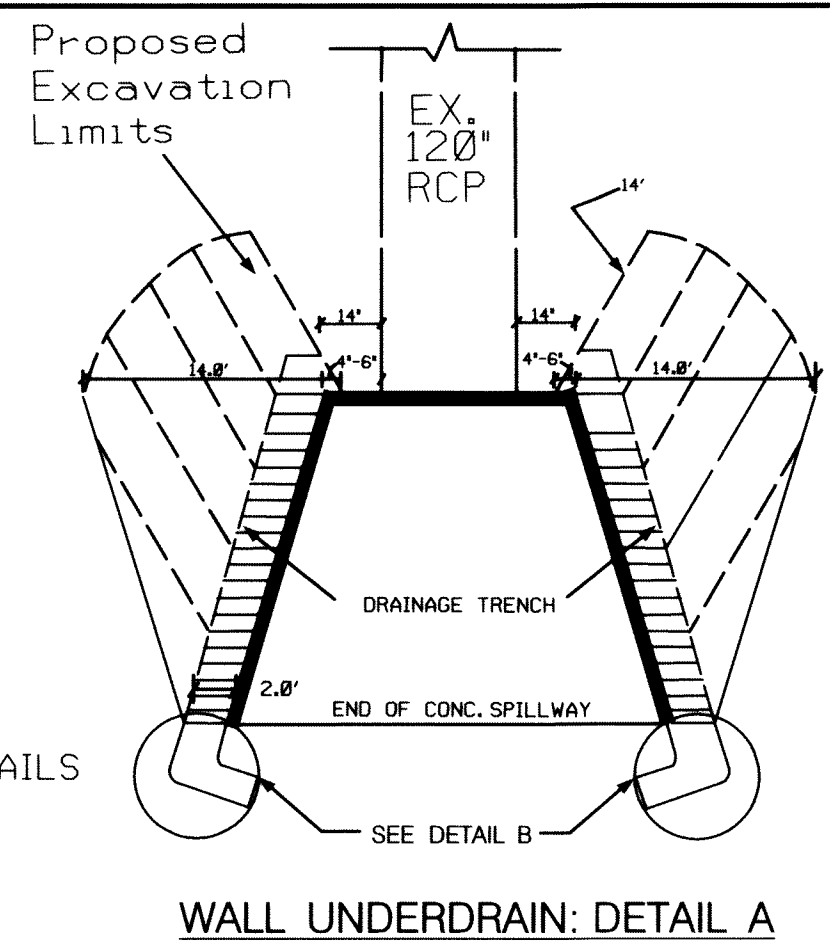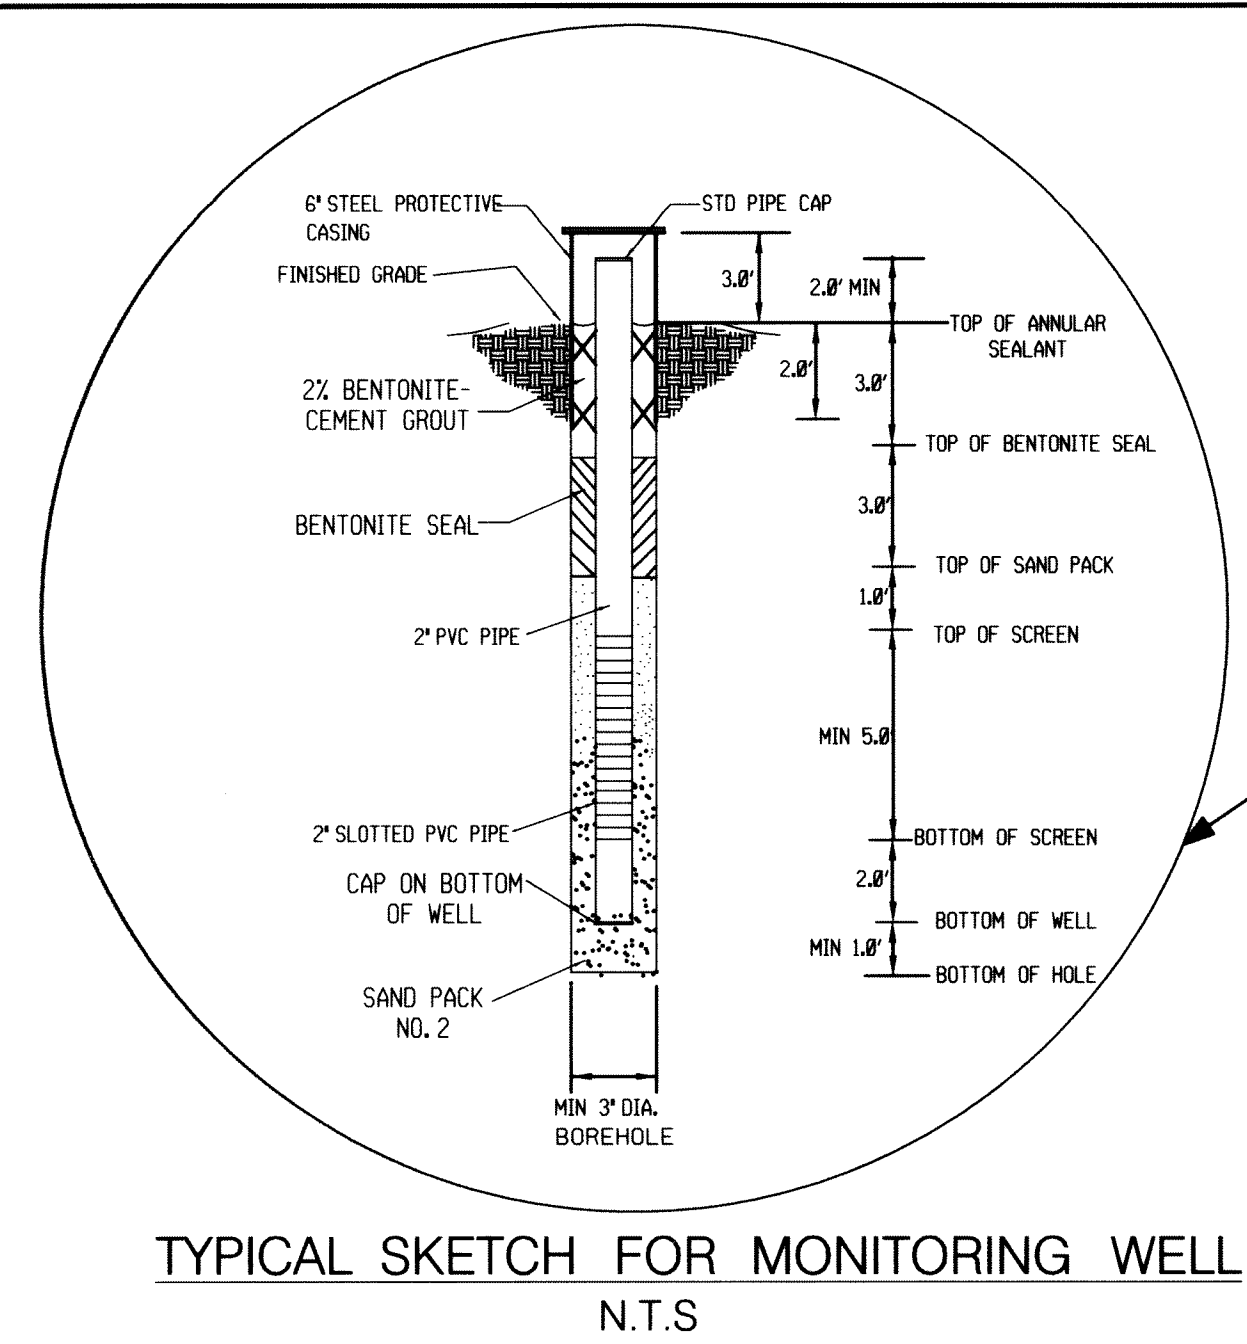

TYPICAL SKETCH FOR MONITORING WELL
N.T.S

WALL UNDERDRAIN: DETAIL A
N.T.S

KCI TECHNOLOGIES PROJECT Columbia Gateway Dam TEST BORING LOG B-4/PZ-4 SHEET 1 OF 1

DEPTH (FEET)	SOIL CLASSIFICATION AND REMARKS	ELECTRIC LOG	TYPE	DIAMETER (IN)	LOG NO.	DATE
0.0	FIN (Sampled as Moist. dense brown. fine to coarse SAND. trace to little SL. trace coarse trace rock (SM))			3.0		
1.0	Moist. medium dense, gray. Clayey fine to medium SAND. little gravel (SC)			3.0		
2.0	Moist. medium dense, gray. Clayey fine to medium SAND. trace gravel (SC)			3.0		
3.0	Moist. medium dense, gray. Clayey fine to medium SAND. trace gravel (SC)			3.0		
KCI TECHNOLOGIES PROJECT Columbia Gateway Dam TEST BORING LOG B-5/PZ-5 SHEET 1 OF 1

DEPTH (FEET)	SOIL CLASSIFICATION AND REMARKS	ELECTRIC LOG	TYPE	DIAMETER (IN)	LOG NO.	DATE
0.0	FIN (Sampled as Moist. dense brown. fine to coarse SAND. trace to little SL. trace coarse trace rock (SM))			3.0		
1.0	Moist. medium dense, gray. Clayey fine to medium SAND. little gravel (SC)			3.0		
2.0	Moist. medium dense, gray. Clayey fine to medium SAND. trace gravel (SC)			3.0		
3.0	Moist. medium dense, gray. Clayey fine to medium SAND. trace gravel (SC)			3.0		
BORING LOGS

KCI Well Construction Diagram

PROJECT: Columbia Gateway Dam
LOCATION: Howard County, MD
CLIENT: Howard County DPW
SURVEYED BY: AS CONSULTANTS
STATE PLUMB COORDINATE: N 547753.3 E 1366593.4
DATE STARTED: 9/19/07 DATE FINISHED: 9/20/07


ANNULAR SPACE DETAILS	ELEVATIONS DEPTHS (MSL) (BGSS)
TYPE OF SURFACE SEAL: Concrete	294.25 -3.8' TOP OF PROTECTIVE CASING
TYPE OF ANNUAL SEALANT: 2% Bentonite-Cement	294.07 -2.2' TOP OF RISER PIPE
INSTALLATION METHOD: Tremie Pipe	291.92 0.0' GROUND SURFACE
SETTING TIME: 24 hour	280.52 11.4' STATIC WATER LEVEL (AFTER COMPLETION)
TYPE OF BENTONITE SEAL: GRANULAR BELLED SLURRY (PILE ONE)	290.52 1.0' TOP OF BENTONITE SEAL
INSTALLATION METHOD: Manual	287.92 -4.0' TOP OF SANDPACK
SETTING TIME: 24 hour	286.92 -5.0' TOP OF SCREEN
TYPE OF SANDPACK: No. 2	276.92 15.0' BOTTOM OF SCREEN
INSTALLATION METHOD: Free Fall	276.92 15.0' BOTTOM OF WELL
TYPE OF BACKFILL MATERIAL: 2% Bentonite-Cement	273.92 18.0' BOTTOM OF BOREHOLE
INSTALLATION METHOD: Free Fall	

KCI Well Construction Diagram


PROJECT: Columbia Gateway Dam
LOCATION: Howard County, MD
CLIENT: Howard County DPW
SURVEYED BY: AS CONSULTANTS
STATE PLUMB COORDINATE: N 547797.2 E 1366618.7
DATE STARTED: 9/21/07 DATE FINISHED: 9/21/07

ANNULAR SPACE DETAILS	ELEVATIONS DEPTHS (MSL) (BGSS)
TYPE OF SURFACE SEAL: Concrete	296.46 -3.8' TOP OF PROTECTIVE CASING
TYPE OF ANNUAL SEALANT: 2% Bentonite-Cement	296.26 -3.3' TOP OF RISER PIPE
INSTALLATION METHOD: Tremie Pipe	291.93 0.0' GROUND SURFACE
SETTING TIME: 8 hour	280.33 11.8' STATIC WATER LEVEL (AFTER COMPLETION)
TYPE OF BENTONITE SEAL: GRANULAR BELLED SLURRY (PILE ONE)	290.93 1.0' TOP OF BENTONITE SEAL
INSTALLATION METHOD: Manual	287.93 -4.0' TOP OF SANDPACK
SETTING TIME: 8 hour	286.93 -5.0' TOP OF SCREEN
TYPE OF SANDPACK: No. 2	276.93 15.0' BOTTOM OF SCREEN
INSTALLATION METHOD: Free Fall	276.93 15.0' BOTTOM OF WELL
TYPE OF BACKFILL MATERIAL: 2% Bentonite-Cement	273.93 18.0' BOTTOM OF BOREHOLE
INSTALLATION METHOD: Free Fall	

MONITORING WELL LOGS

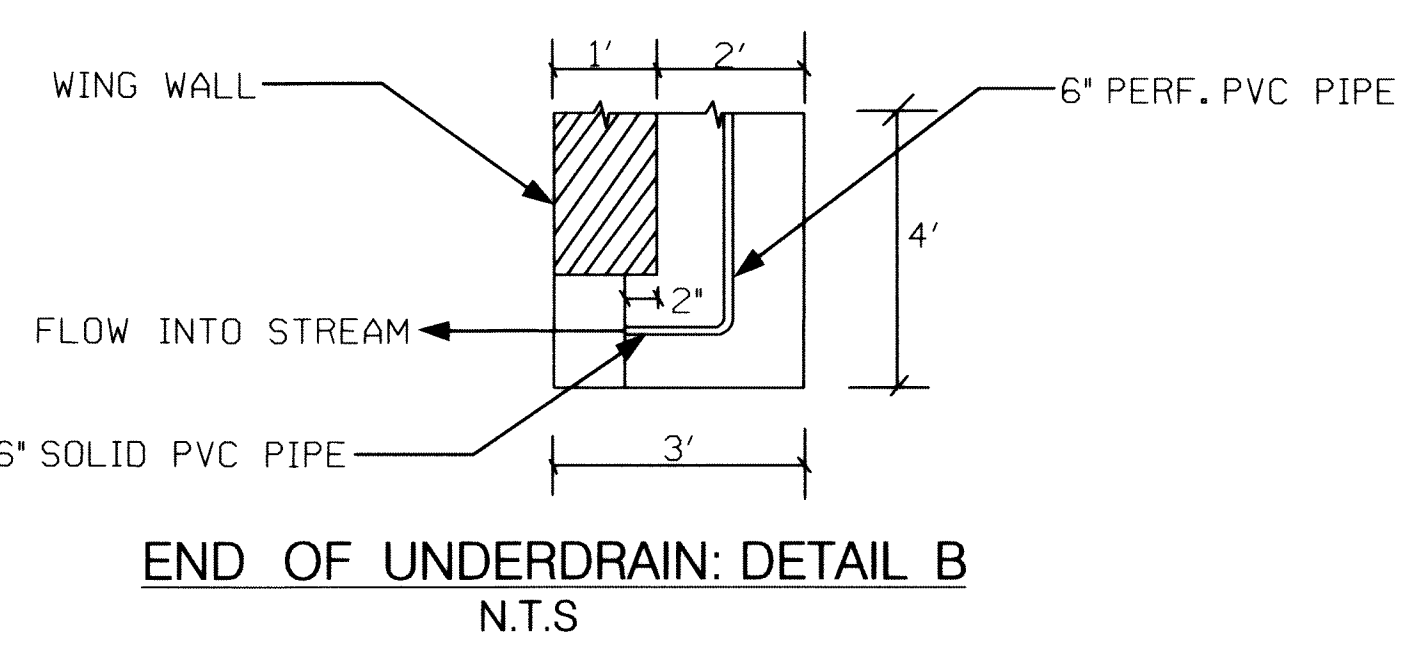

END OF UNDERDRAIN: DETAIL B
N.T.S

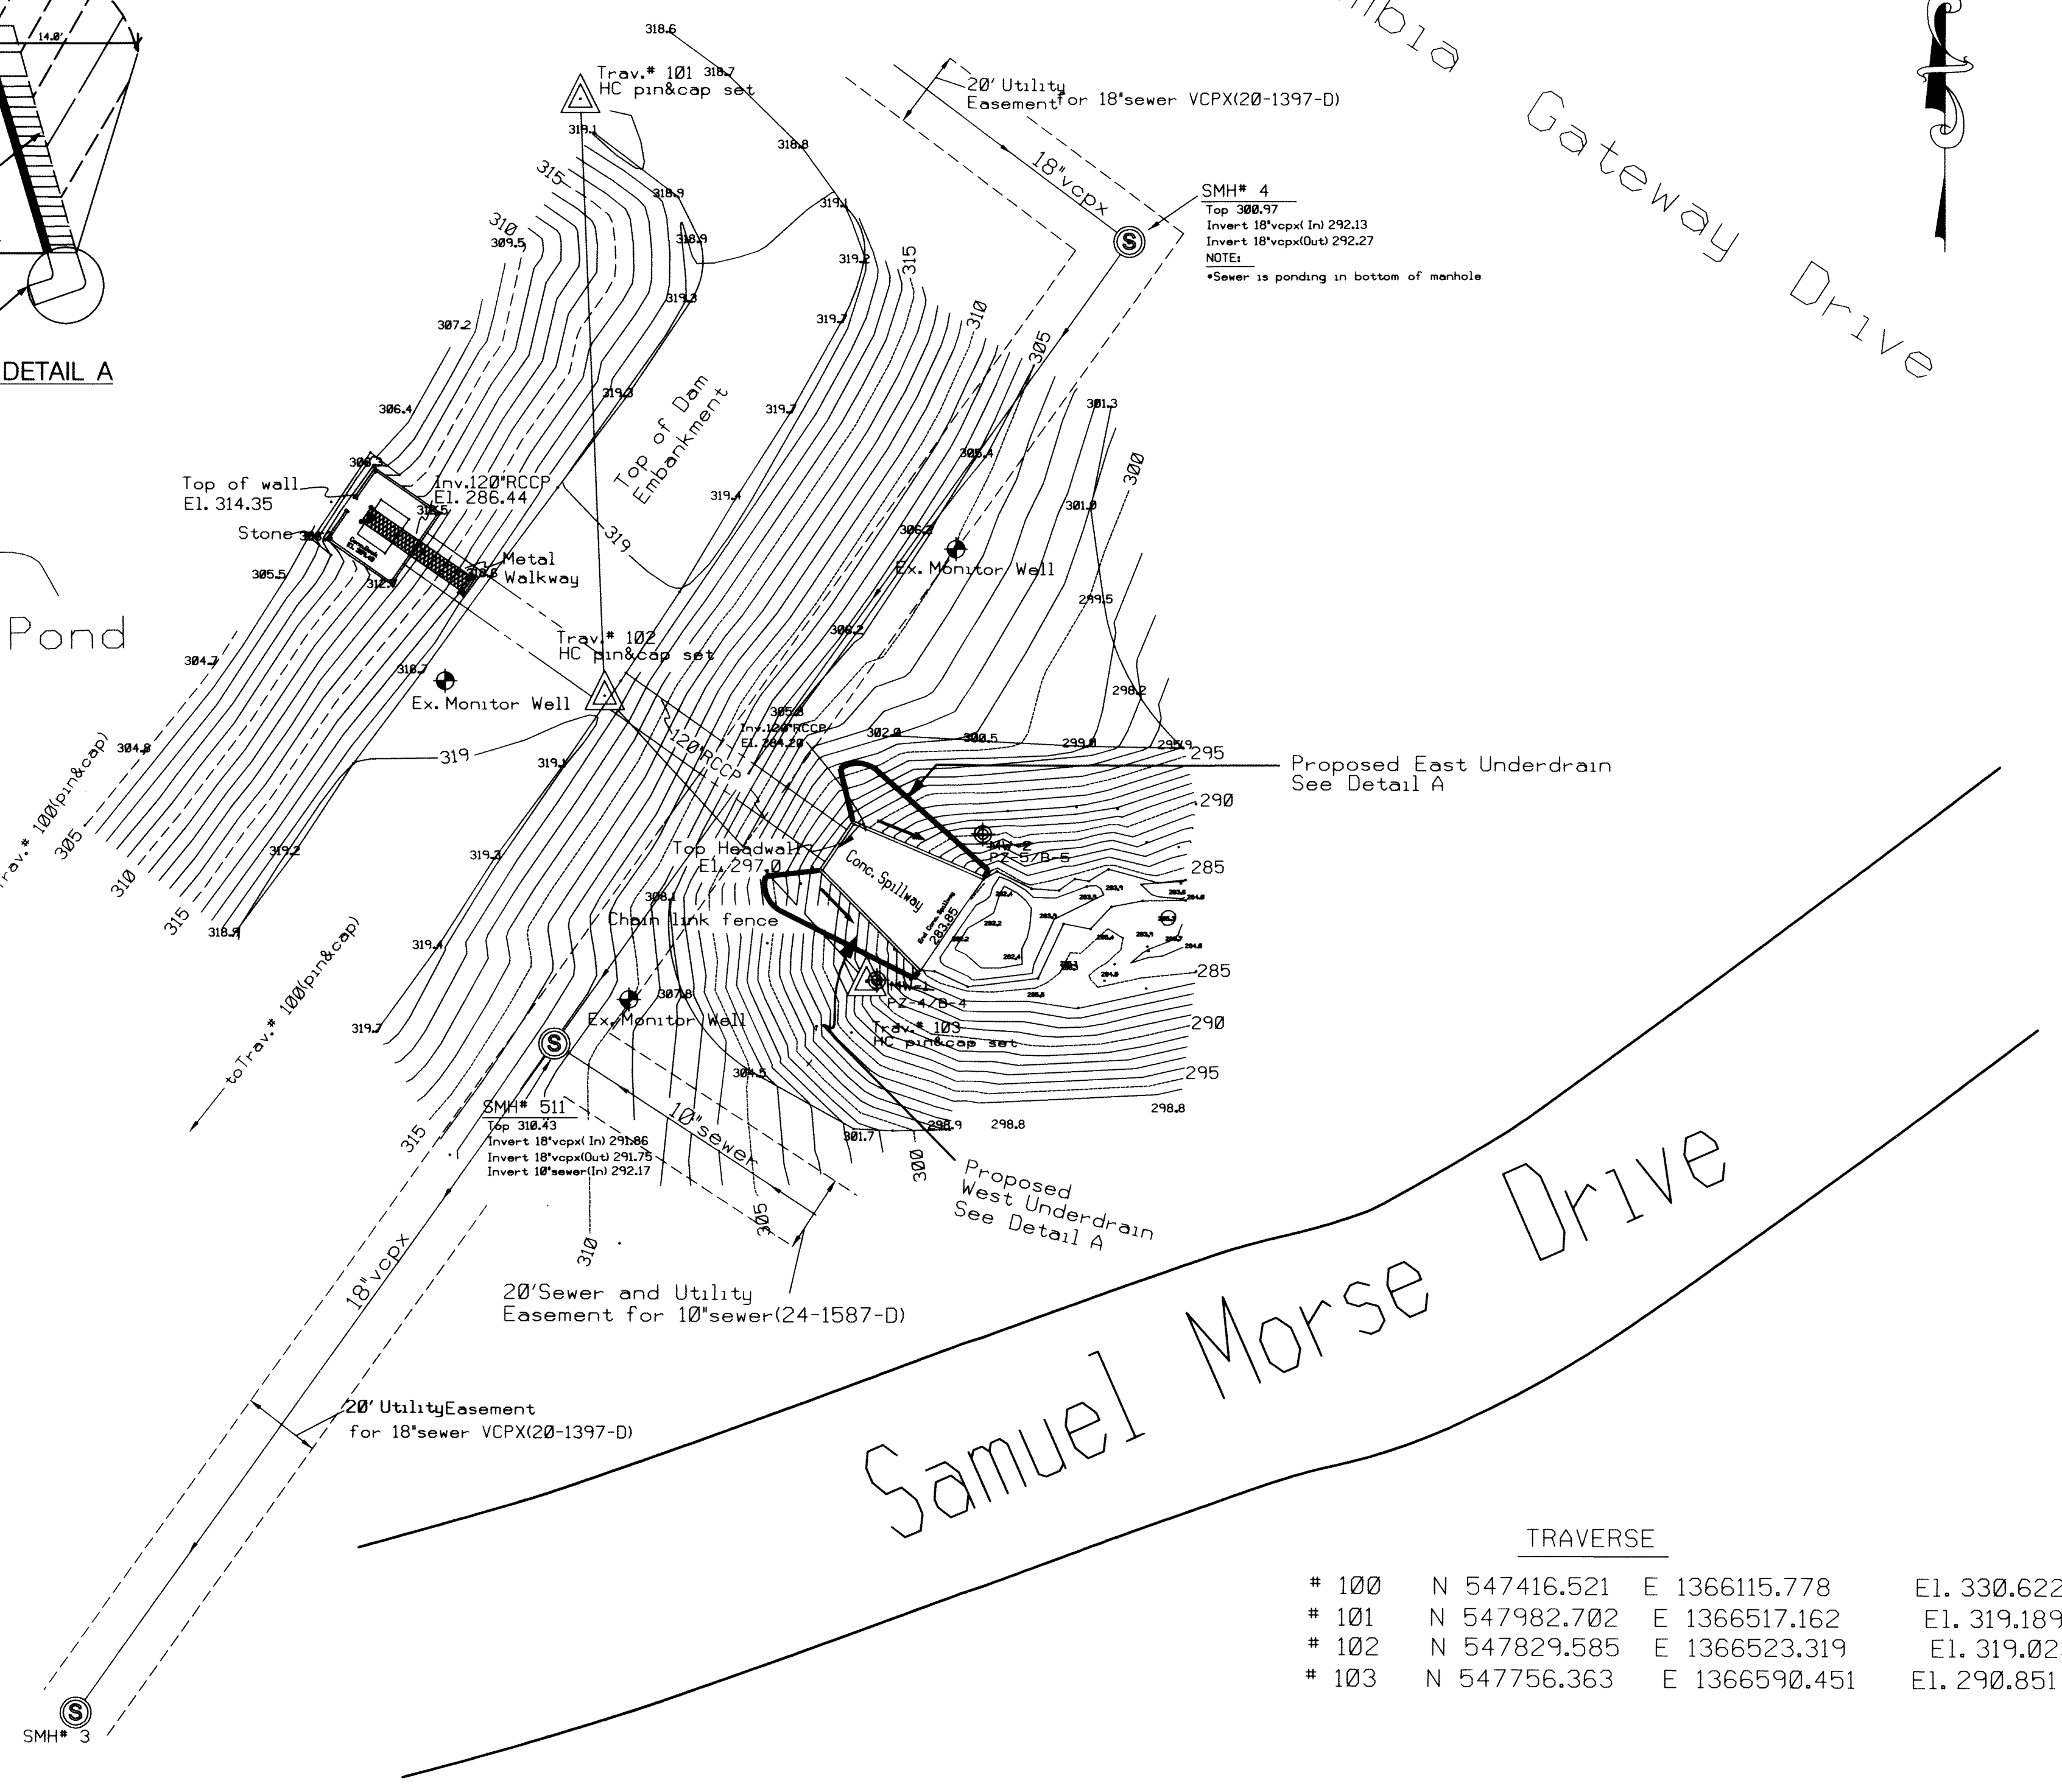

LEGEND

- WALL UNDERDRAIN
- DIRECTION OF FLOW IN UNDERDRAIN
- PZ-4/B-4 2007 MONITORING WELL LOCATION AND NO.
- EXISTING 2006 MONITORING WELL
- MW-1 PROPOSED MONITORING WELL

- NOTES:**
- COORDINATES AND ELEVATIONS SHOWN HEREON ARE BASED ON THE FOLLOWING DATUMS AND PROJECTIONS: HORIZONTAL: MARYLAND (GRID) NAD 83 (ADJ. 1991) VERTICAL: NAVD 88 U.S. SURVEY FEET
 - ORIGINAL BASE MAP PROVIDED VIA EMAIL BY THE HOWARD COUNTY DEPARTMENT OF PUBLIC WORKS (DPW) STORM WATER MANAGEMENT DIVISION, AND DATED OCTOBER 2006.
 - CONTRACTOR SHALL USE EXTREME CAUTION WHEN WORKING NEAR OR OVER THE EXISTING SANITARY SEWER LINES.
 - MONITORING WELLS SHALL BE INSTALLED TO A DEPTH OF 15 FEET, OR AS DIRECTED BY THE ENGINEER.

NO.	REVISIONS DESCRIPTION	DATE

ENGINEERS
PLANNERS
SCIENTISTS
CONSTRUCTION MANAGERS

www.kci.com


PLAN SHEET

COLUMBIA GATEWAY STORM WATER MANAGEMENT DAM
HOWARD COUNTY, MARYLAND
DEPARTMENT OF PUBLIC WORKS DIVISION
STORM WATER MANAGEMENT DIVISION
COLUMBIA GATEWAY DRIVE
COLUMBIA, MD 21046


AS BUILT
KCI TECHNOLOGIES, INC.

SCALE: 1"=30'
DATE: 12/14/2007
KCI JOB NO.: 01-04322320
DESIGNED BY: KBA
DRAWN BY: MPP
CHECKED BY: KBA
SHEET NO.: 2 OF 8


KCI FILE: m:\01999909.gmv\Proposals\Geotech\2006\Columbia Gateway

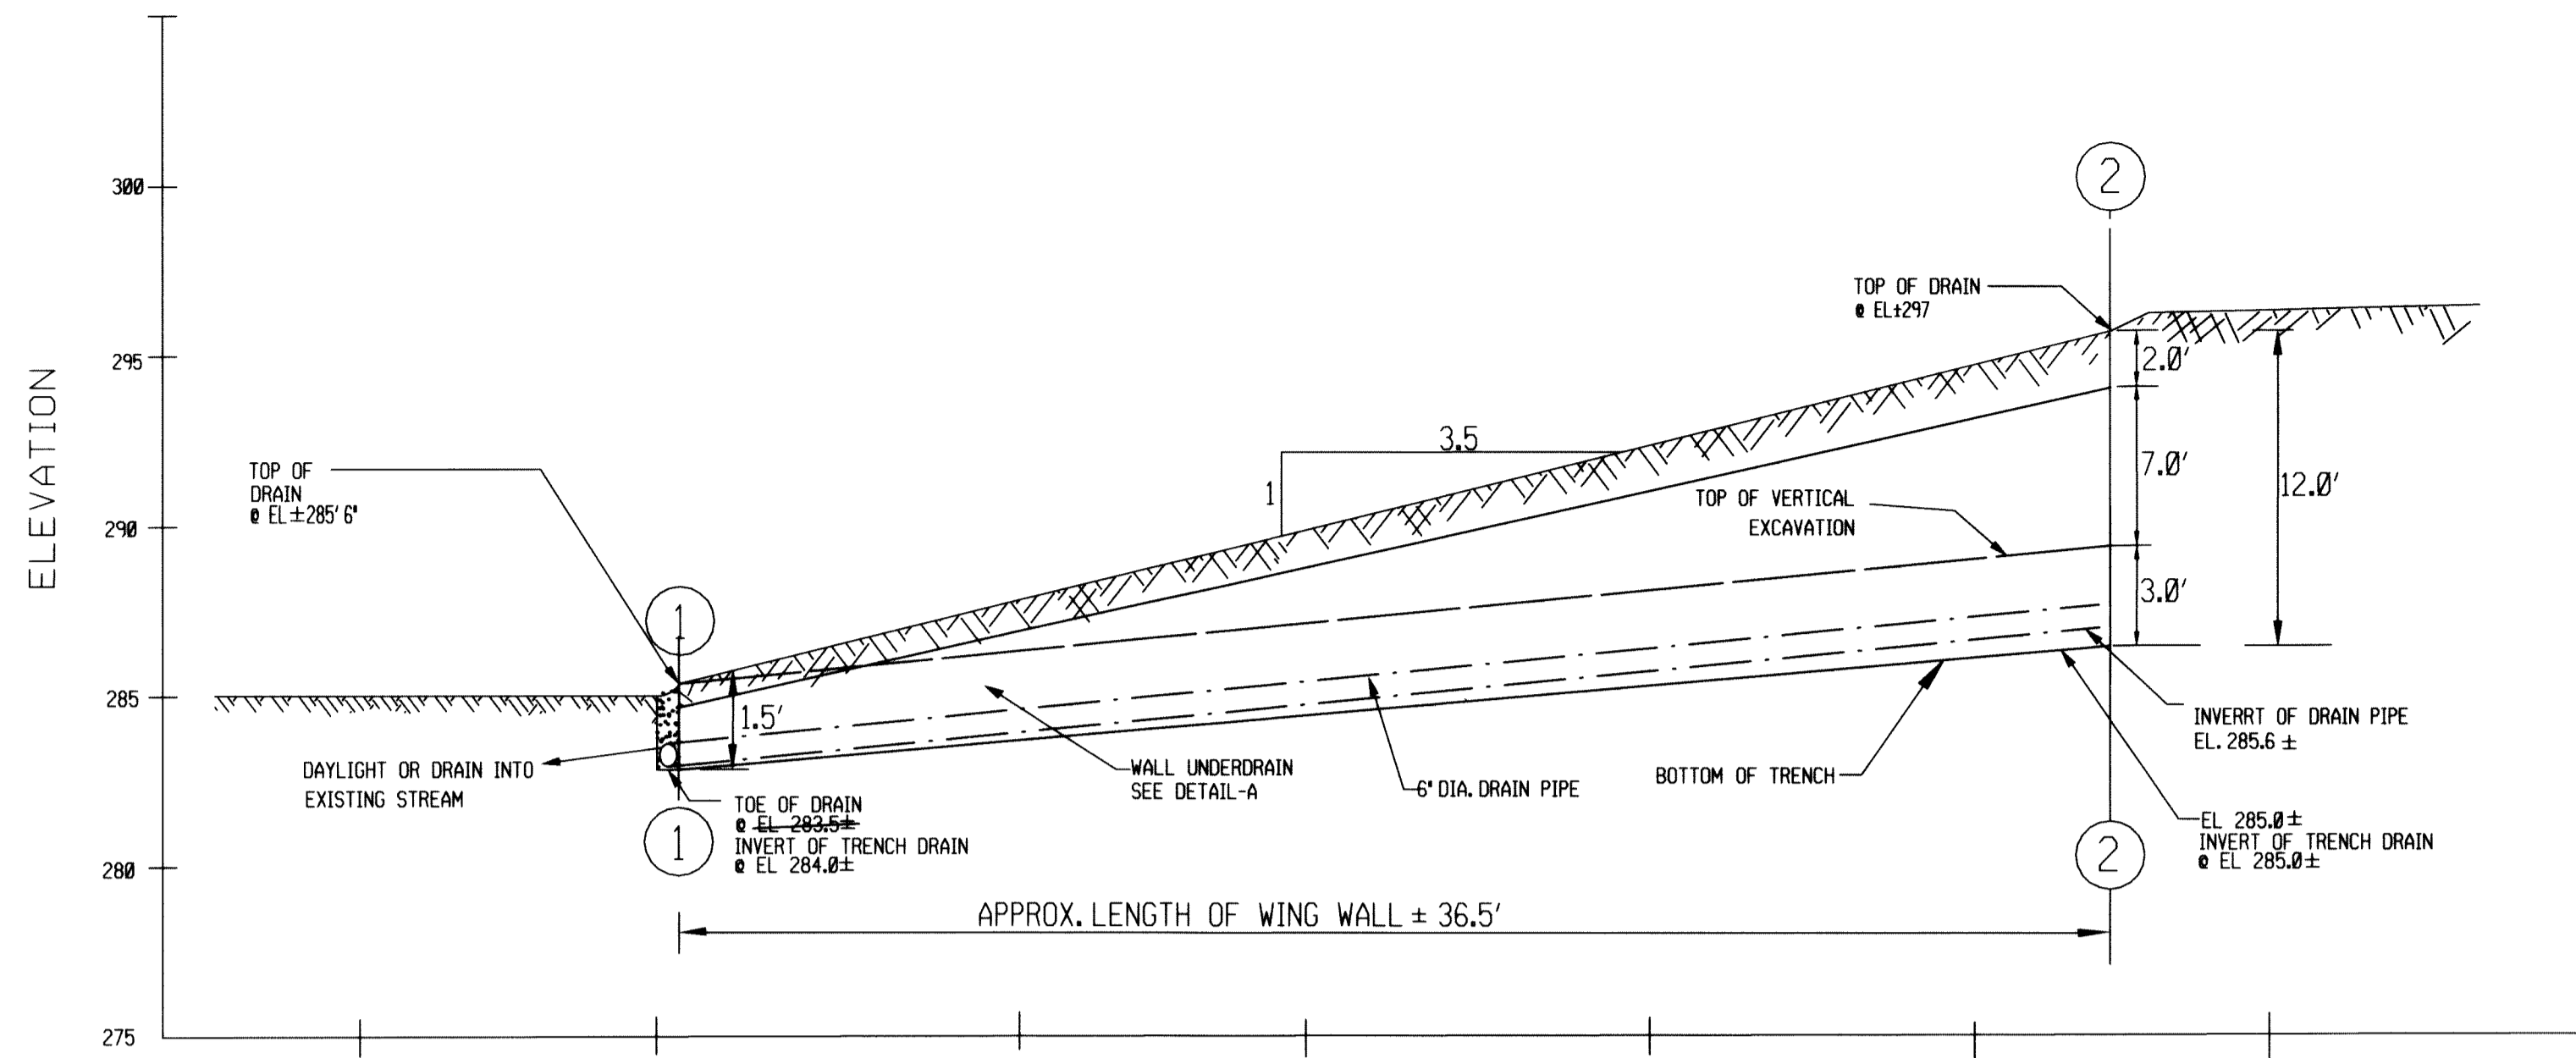

WEST WINGWALL DRAINAGE PROFILE
NOT TO SCALE

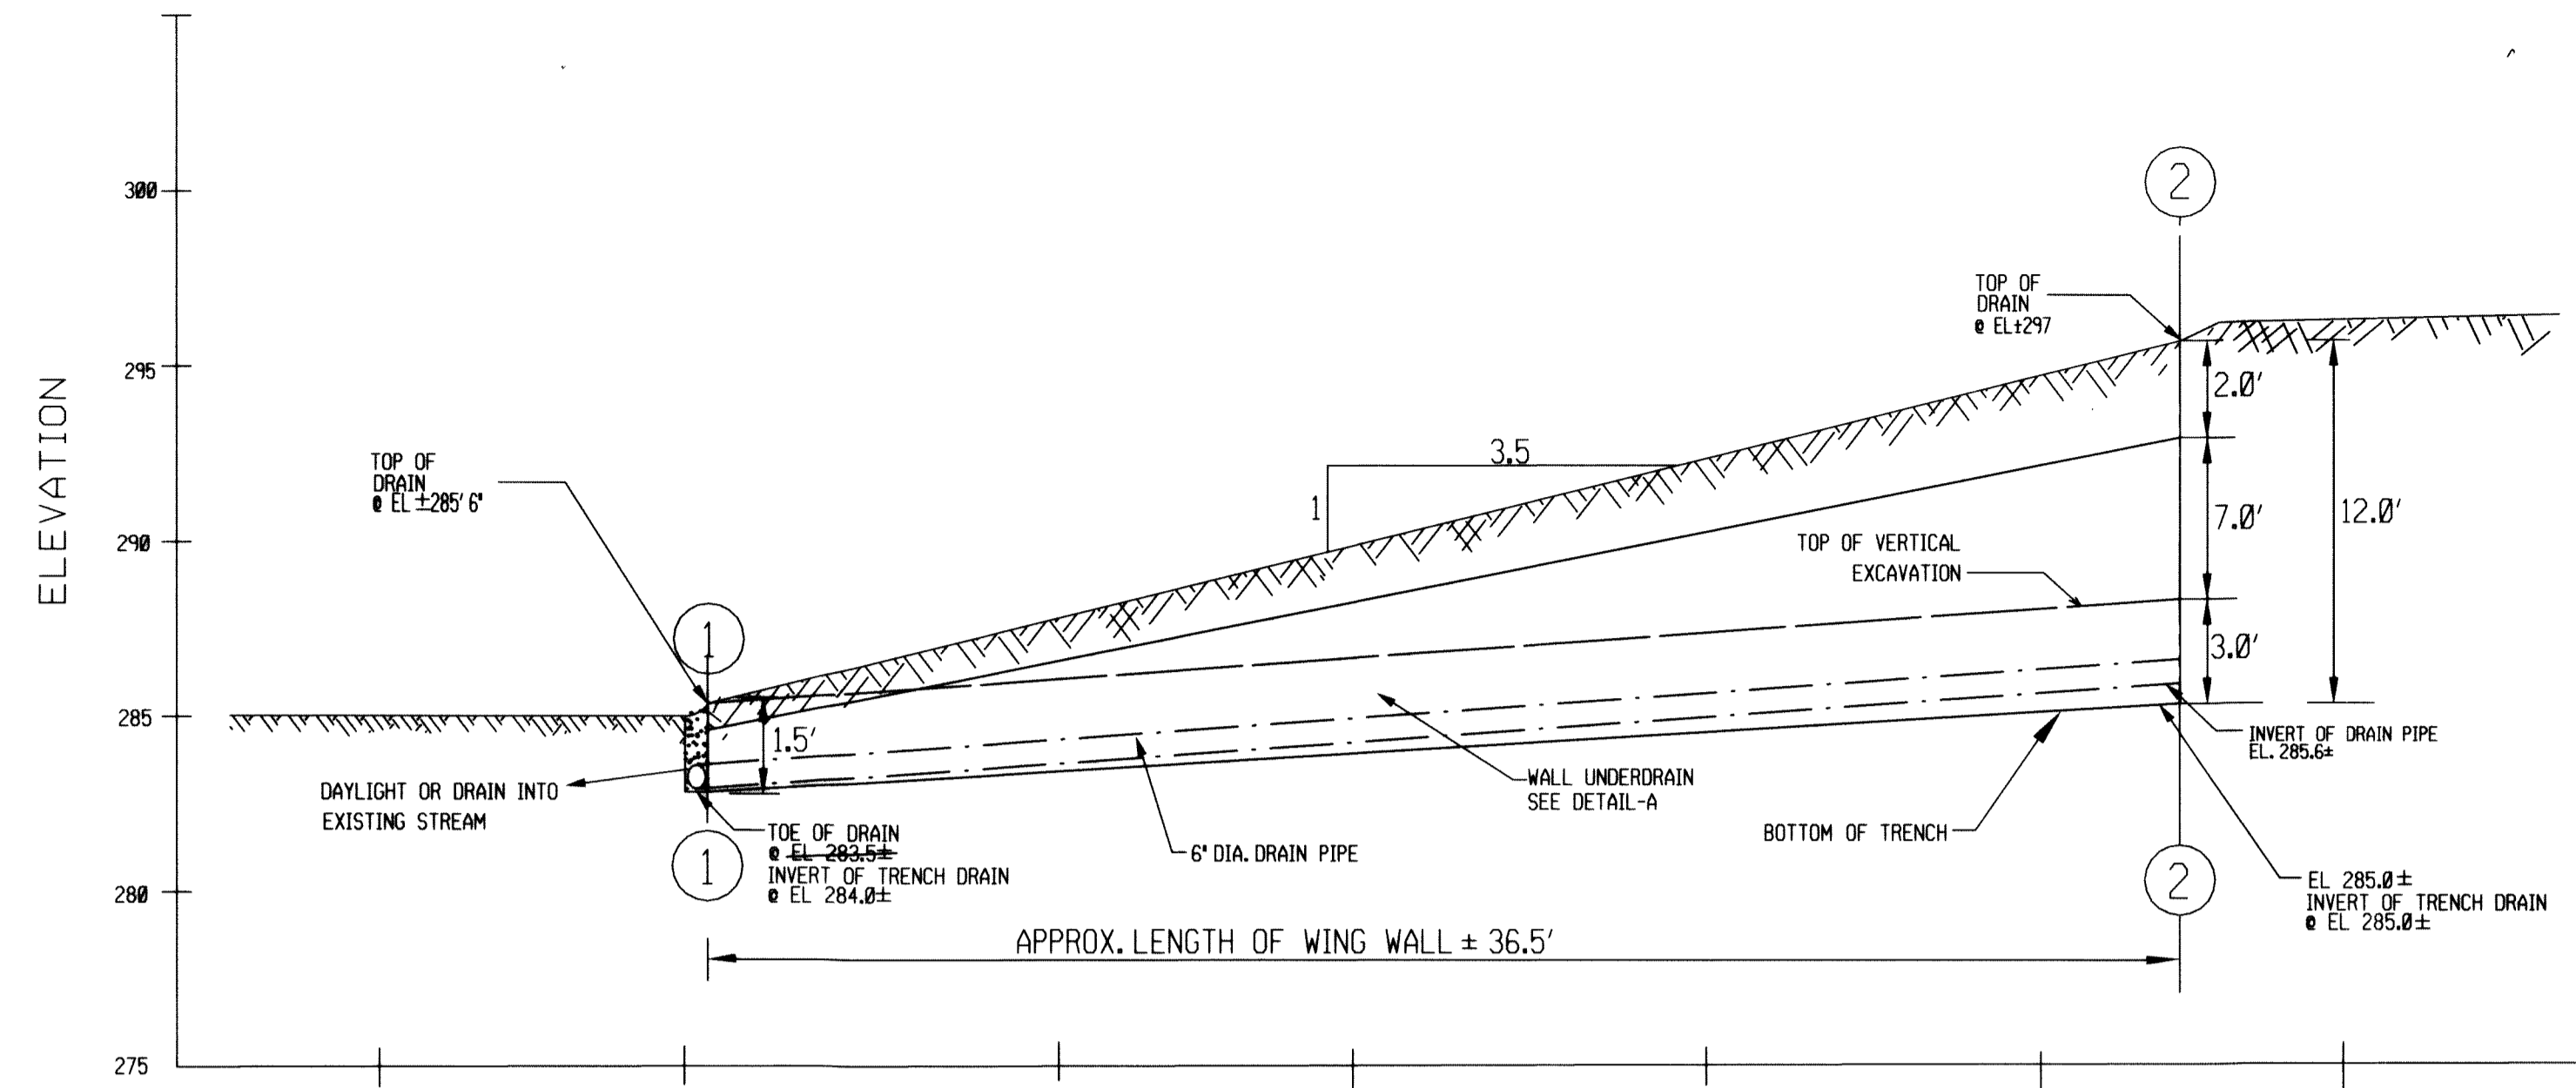

EAST WINGWALL DRAINAGE PROFILE
NOT TO SCALE

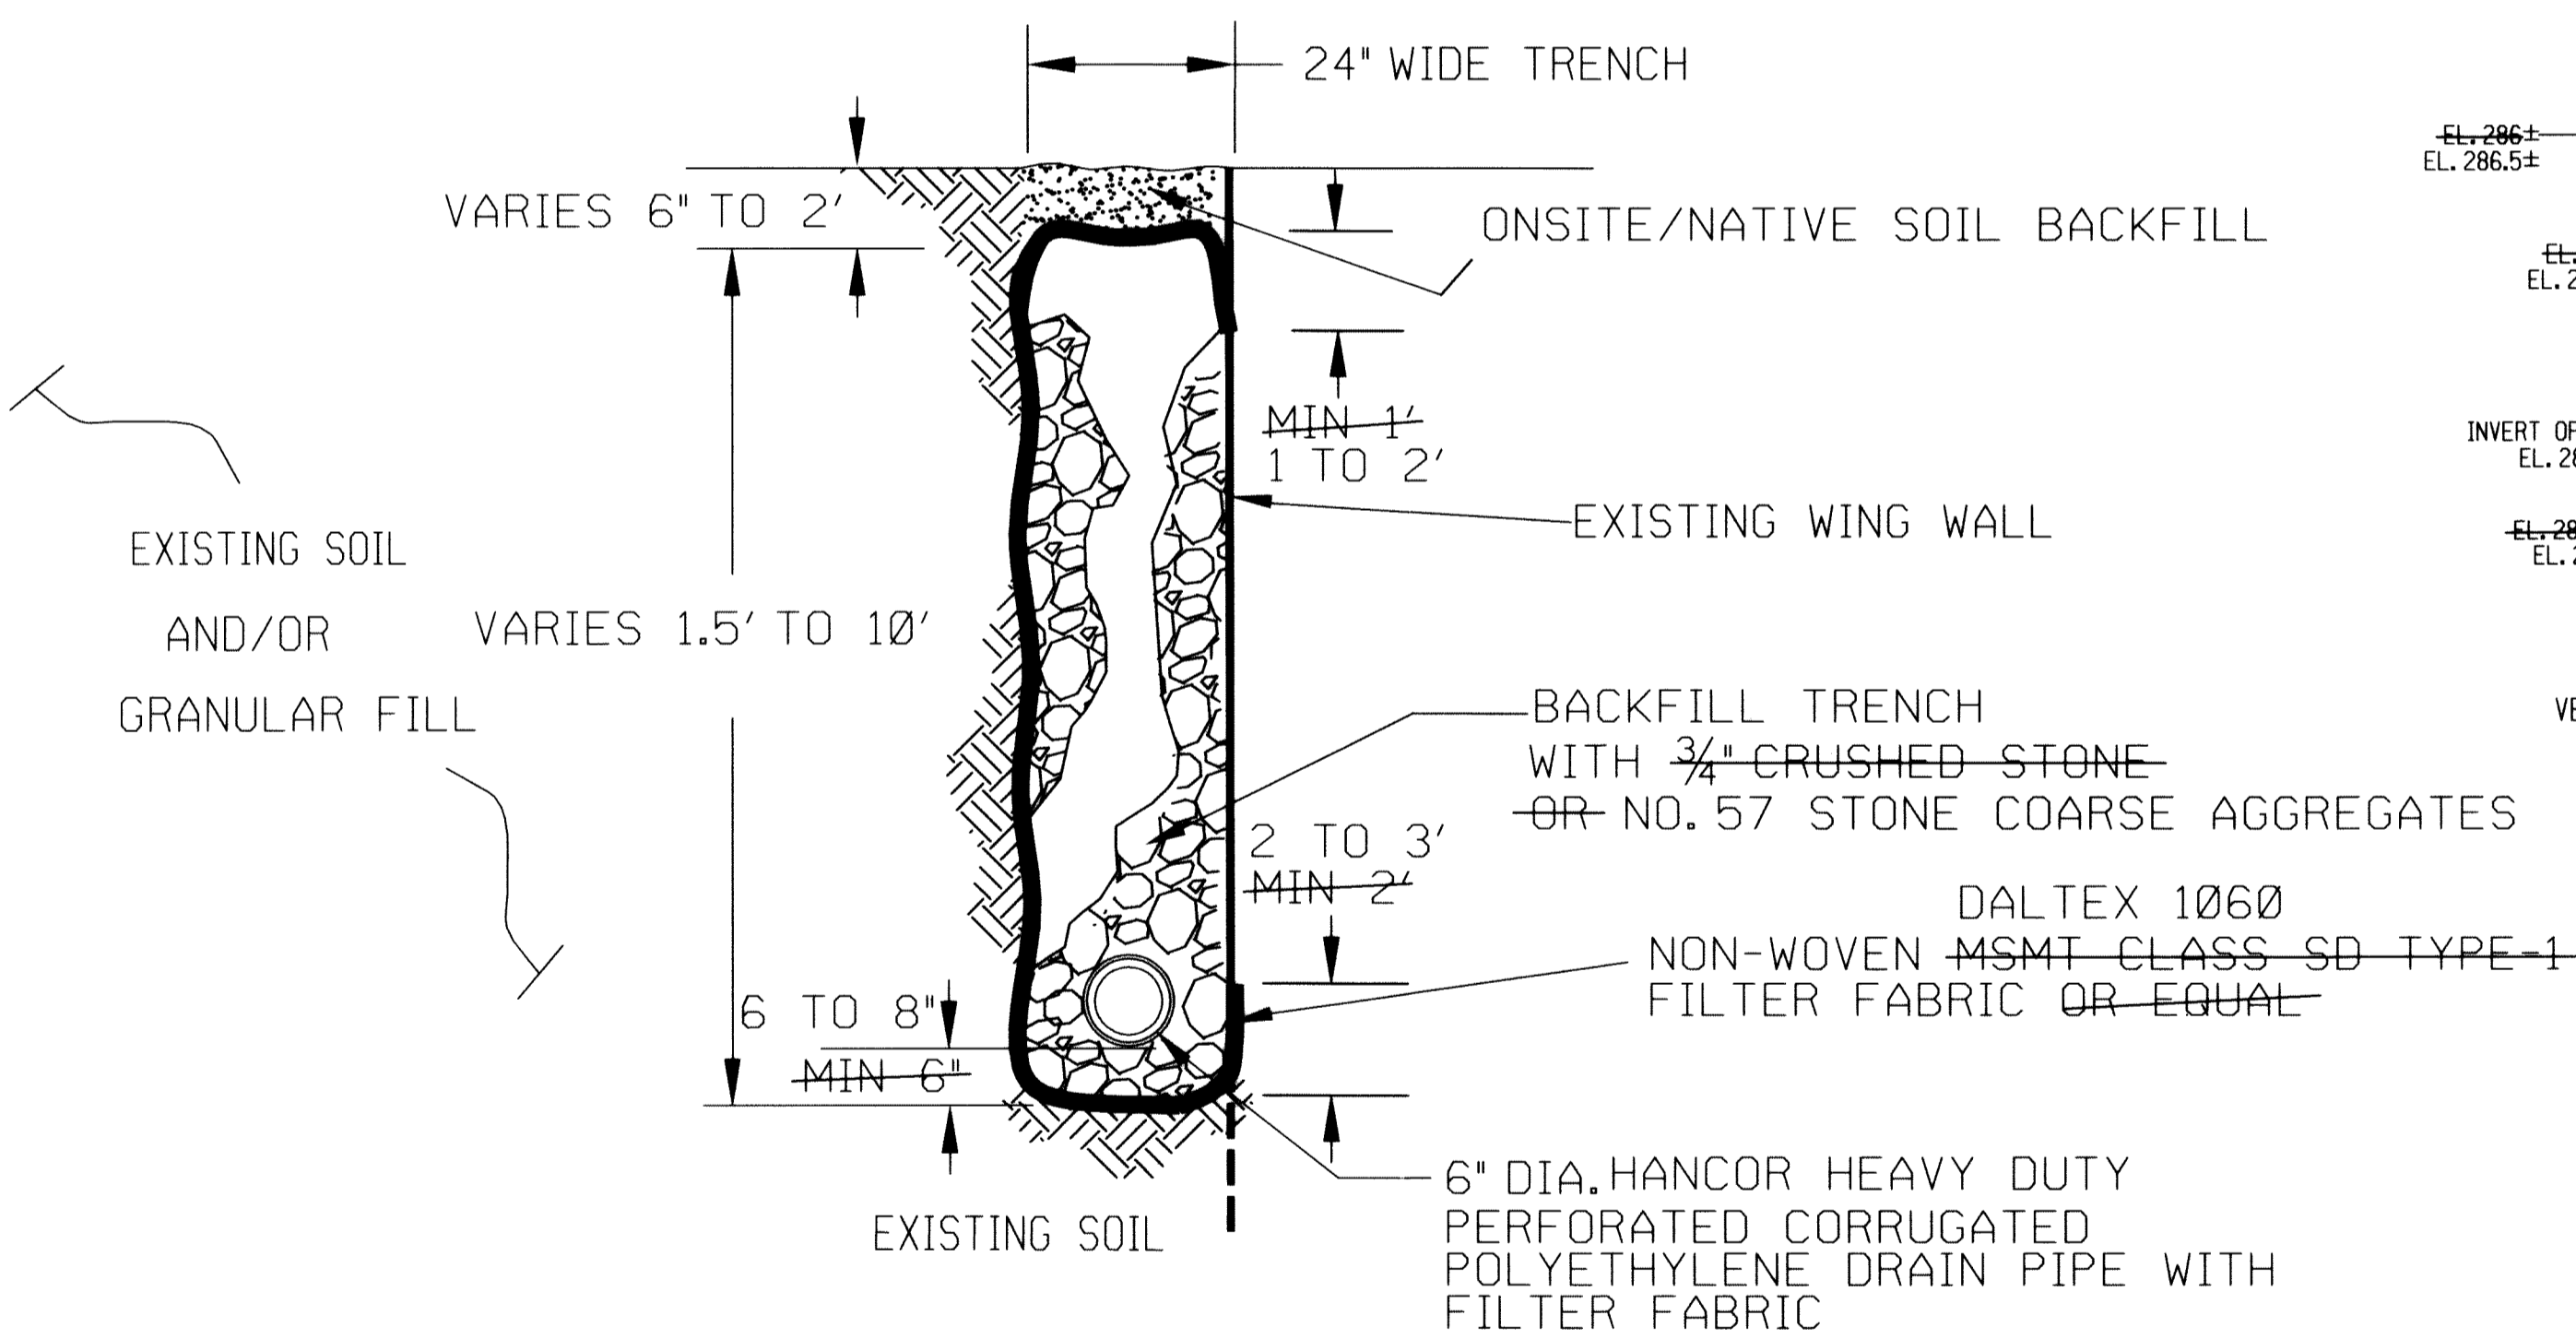

DETAIL A - STONE-FILLED UNDERDRAIN
NOT TO SCALE

UNDERDRAIN STONE
BACKFILL SPECIFICATIONS


SIEVE SIZE	NO. 57 PERCENT FINER BY WEIGHT
1 1/2 INCH	100
1 INCH	95 - 100
1/2 INCH	25 - 60
NO. 4	0 - 10
NO. 8	0 - 5

FINE SAND AGGREGATE
BACKFILL SPECIFICATIONS

SIEVE SIZE	MSMT FINE AGGREGATE/ (% FINER)	ASTM C-33 (% FINER)
3/8 INCH	100	100
NO. 4	95-100	95-100
NO. 8	-	80-100
NO. 16	45-85	50-85
NO. 30	-	25-85
NO. 50	10-30	5-30
NO. 100	0-10	0-10
NO. 200	-	≤ 3


NOTES:

- SEE SHEET 2 FOR PLAN LAYOUT OF PROPOSED WINGWALL DRAINAGE.
- EXISTING WINGWALL FOUNDATION DEPTHS AND ELEVATIONS ARE BASED ON AS-BUILT DRAWING (DATED MAY 1, 1970).
- NEAR VERTICAL EXCAVATION HEIGHT AT BASE OF TRENCH IS ABOUT 2.5 TO 3 FEET ALONG THE DRAIN.
- HORIZONTAL EXTENTS OF PROPOSED 1:1 SLOPED EXCAVATION VARIES FROM ABOUT 0' (AT TOE) TO 12' (AT TOP OF DRAIN).

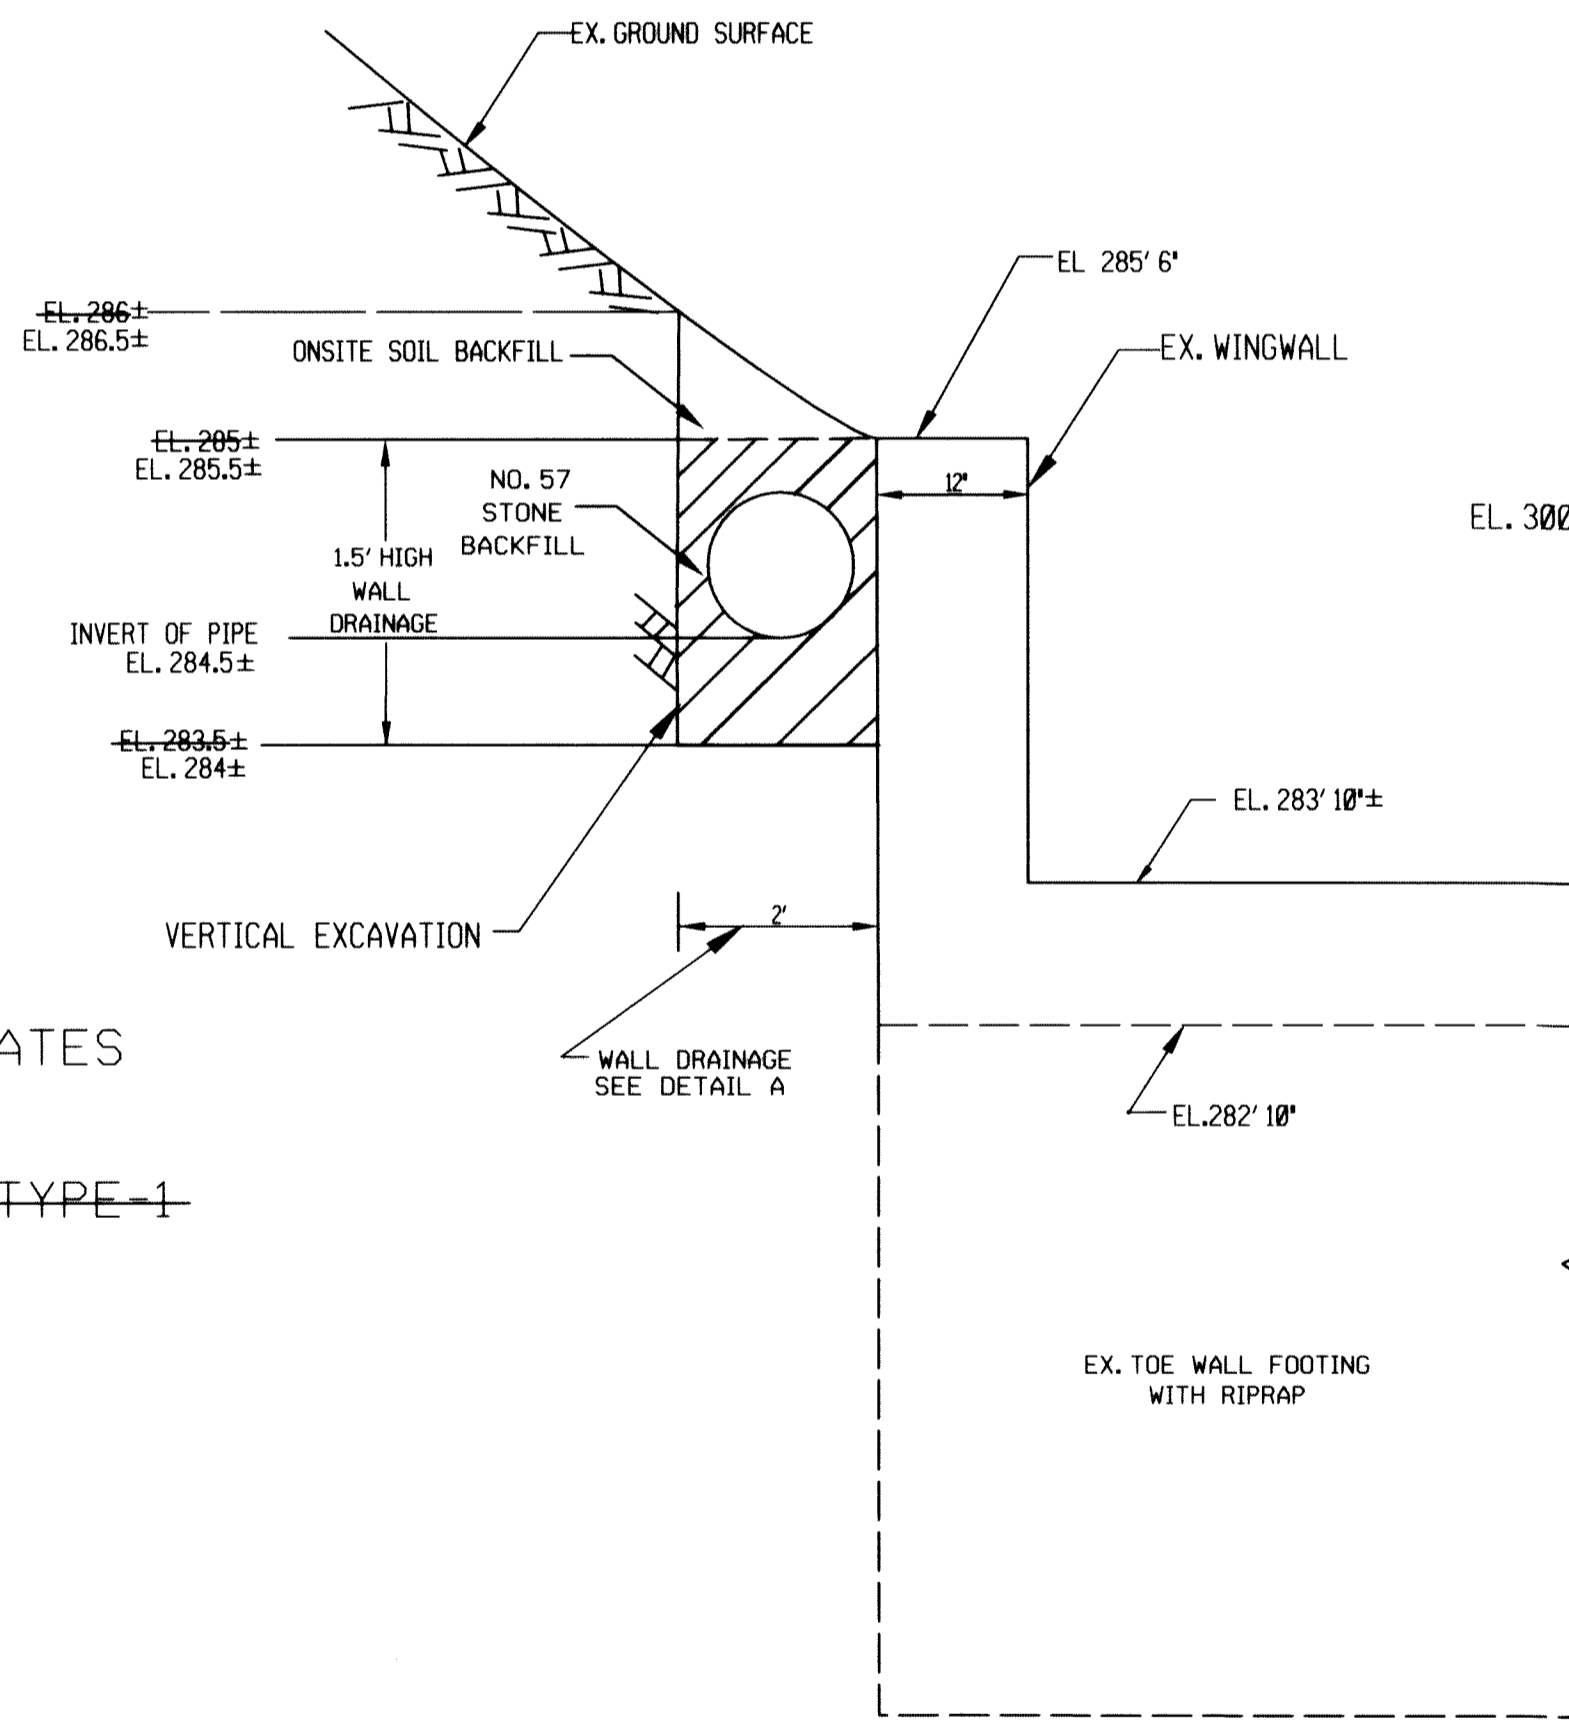

SECTION 1-1 (TYP.)
NOT TO SCALE

TOE OF WALL DRAIN (OUTLET)

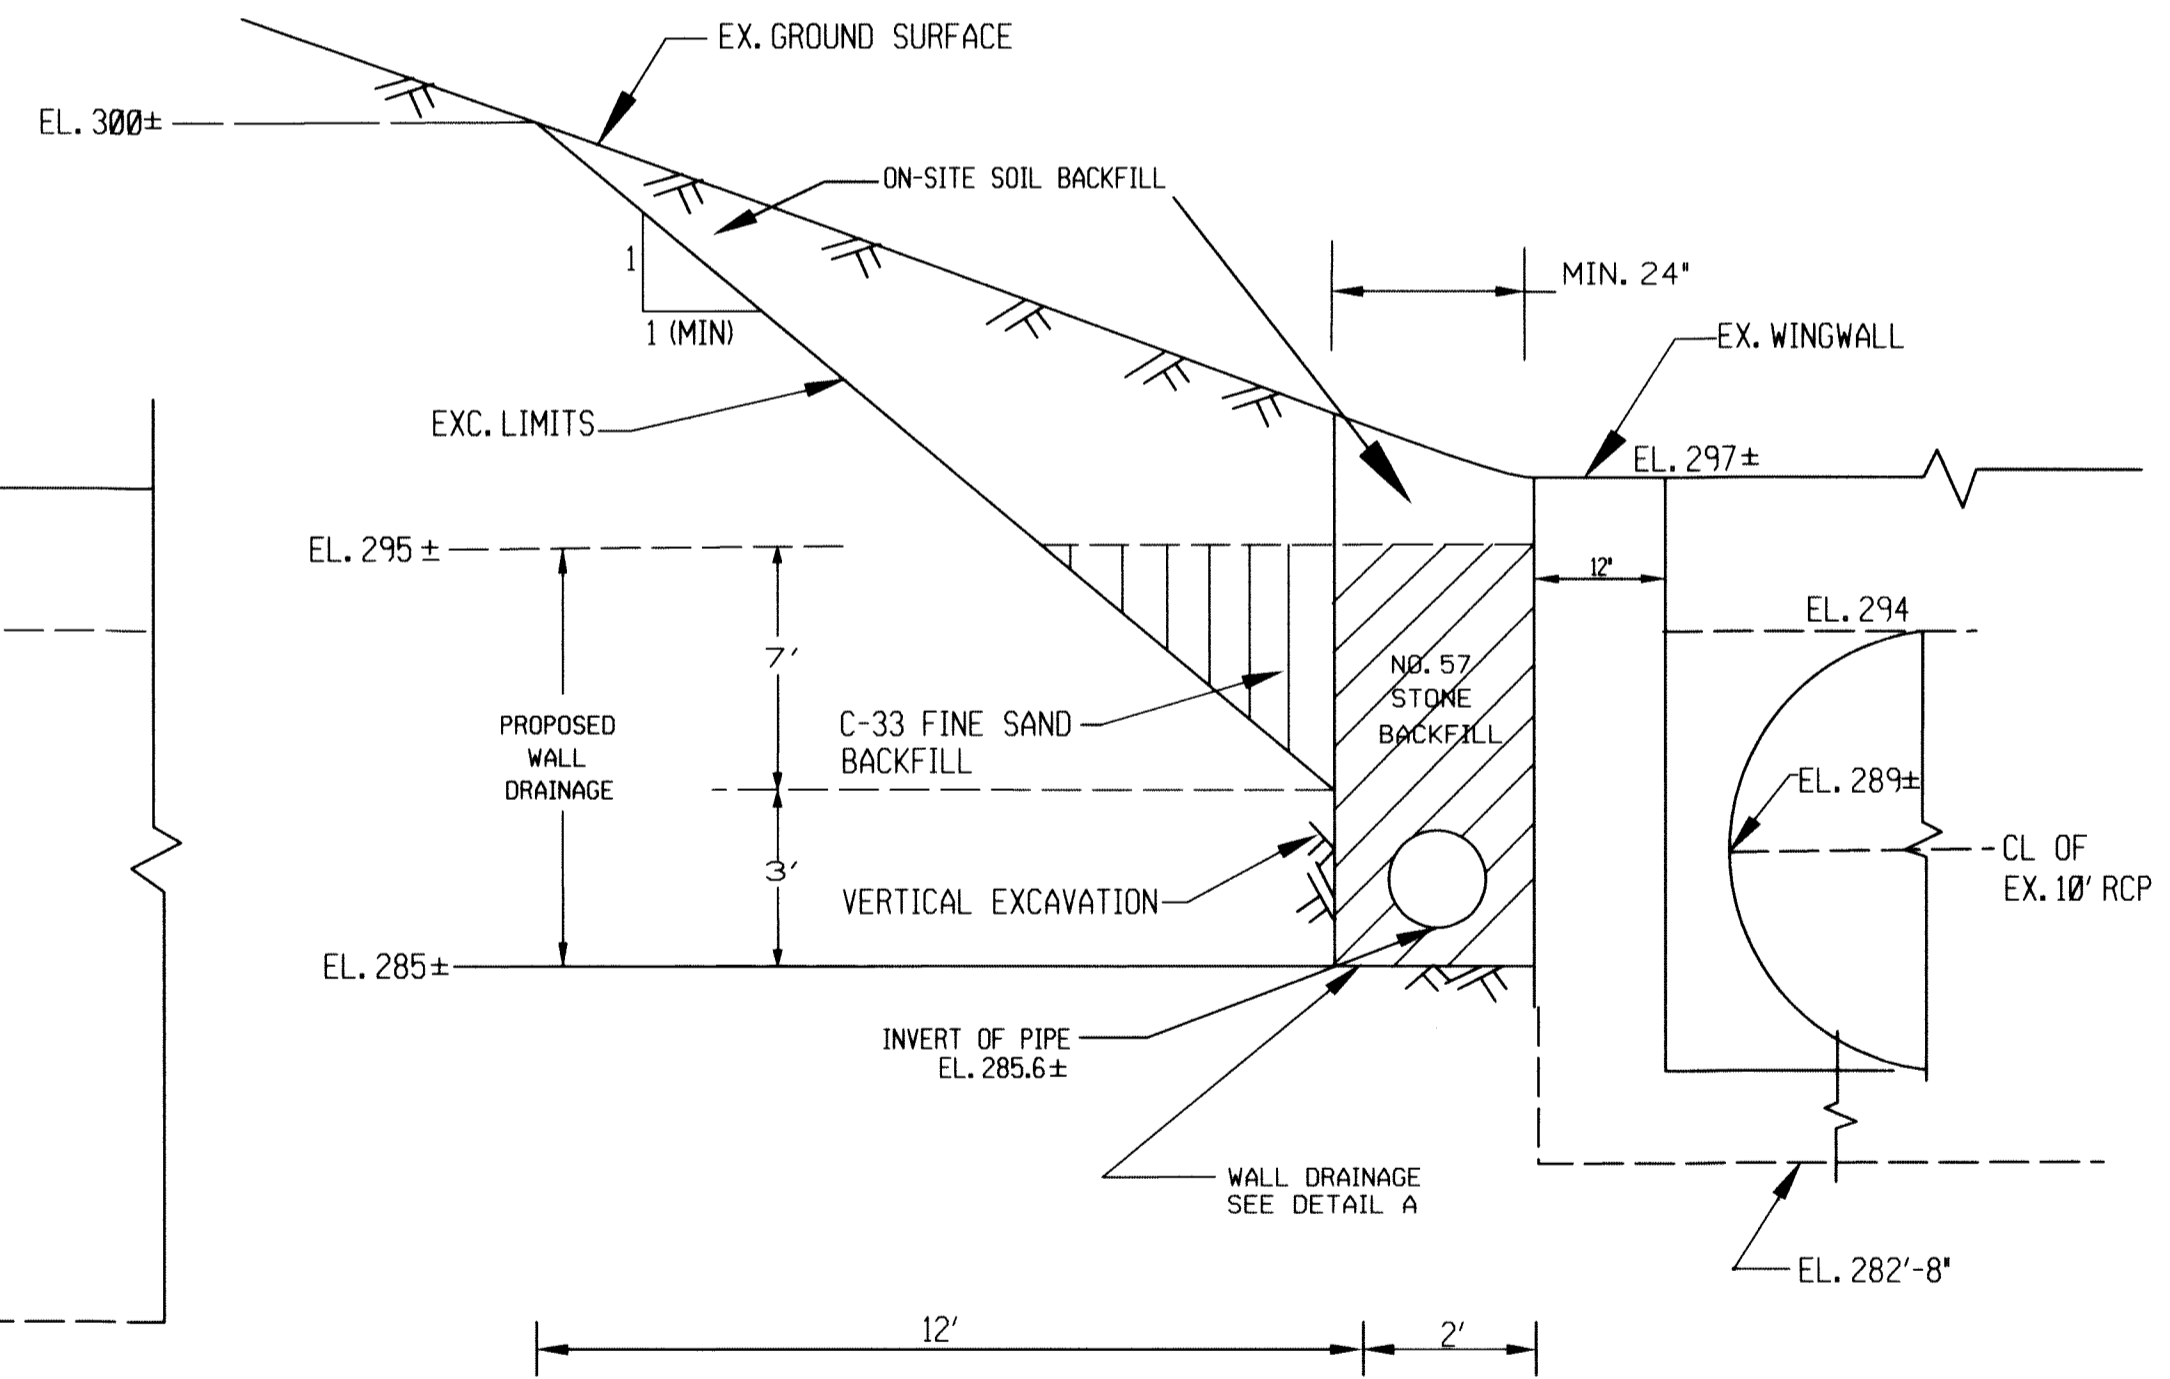

SECTION 2-2 (TYP.)
NOT TO SCALE

TOP OF WALL DRAIN (INLET)



NO.	REVISIONS DESCRIPTION	DATE

ENGINEERS
PLANNERS
SCIENTISTS
CONSTRUCTION MANAGERS

KCI TECHNOLOGIES

www.kci.com

WALL DRAINAGE SYSTEM PROFILE AND DETAIL SHEET

COLUMBIA GATEWAY STORM WATER MANAGEMENT DAM
HOWARD COUNTY, MARYLAND
DEPARTMENT OF PUBLIC WORKS
STORM WATER MANAGEMENT DIVISION
6751 COLUMBIA GATEWAY DRIVE
COLUMBIA, MD 21046


STATE OF MARYLAND PROFESSIONAL ENGINEER
No. 9372
KBA

SCALE: NTS

DATE: 12/14/2007

KCI JOB NO: 01-04322320

DESIGNED BY: KBA
DRAWN BY: MPP
CHECKED BY: KBA

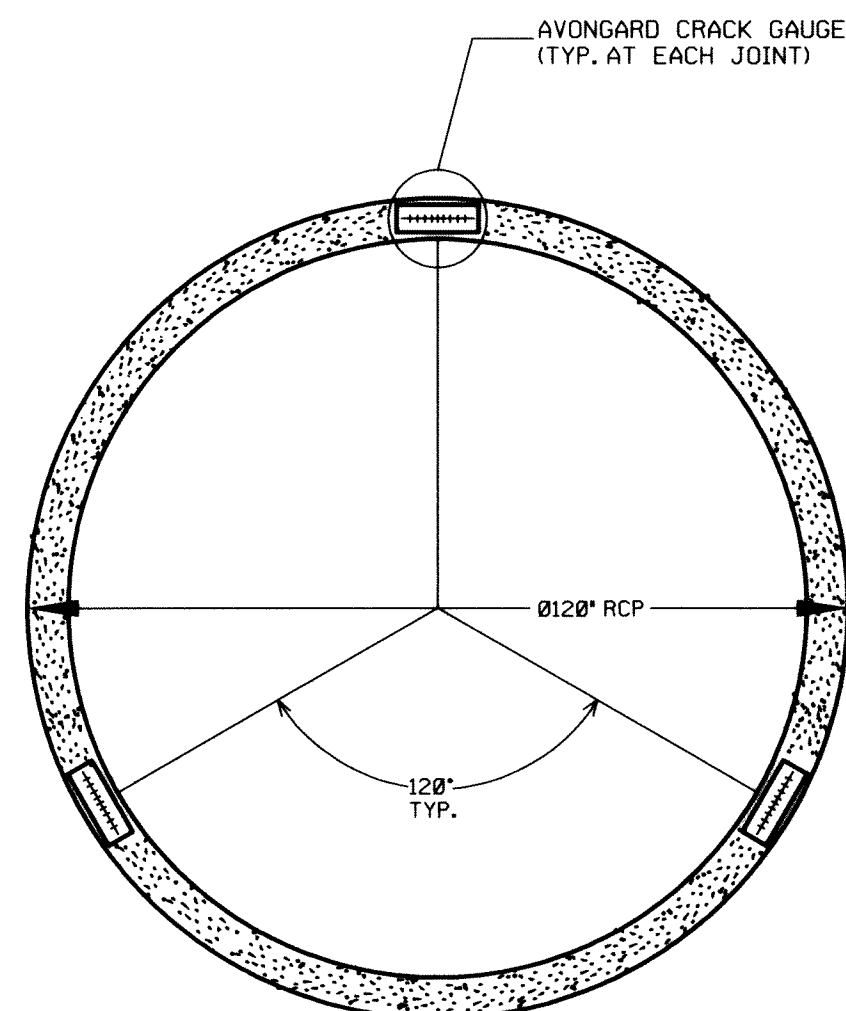


TYPICAL SECTION
NOT TO SCALE

MONITORING NOTES:

1. AVONGARD CRACK MONITORS TO BE INSTALLED AT EACH JOINT, INCLUDING HEADWALL, AS SHOWN, USING PLASTIC SCREW ANCHORS.
2. MEASUREMENTS TO BE READ AND RECORDED HOURLY WHILE INJECTING AT THAT JOINT. MONITORING MAY BE MOVED FROM ONE JOINT TO THE NEXT AS WORK PROCEEDS.

AS-BUILT REMEDIAL GROUTING OF EXISTING 10" DIAMETER REINFORCED CONCRETE PIPE (RCP) SPILLWAY JOINTS, RCP/HEADWALL & RCP/SEWER MAIN INTERFACES					
HEADWALL/RCP JOINT #	ESTIMATED GROUT VOLUME INTAKE GALLONS	DATE STARTED	DATE COMPLETED	TYPICAL JOINT GROUTING DETAILS (SHEET 5 OF 8)	REMARKS
Headwall & 1	10	10/5/2007	10/12/2007	See Details for Joint < 3'16"	Patched Headwall/RCP Interface
2	3.5	10/9/2007	10/11/2007	See Details for Joint > 1/2"	
3	2	10/9/2007	10/9/2007	See Details for Joint > 1/2"	
4	0.5	10/11/2007	10/11/2007	See Details for Joint < 3'16"	Water test determined that there was no cold joint Chipped concrete & patched, coated rebar
5	1	10/10/2007	10/11/2007	See Details for Joint < 3'16"	Narrow Joint Near Sanitary Sewer
6	1.5	10/9/2007	10/9/2007	See Details for Joint > 1/2"	
7	2	10/9/2007	10/9/2007	See Details for Joint > 1/2"	
8	2	10/9/2007	10/10/2007	See Details for Joint < 3'16"	
9	1	10/10/2007	10/10/2007	See Details for Joint < 3'16"	Narrow Joint, Drilled 6 holes for grouting
10	1.5	10/9/2007	10/9/2007	See Details for Joint > 1/2"	
11	2	10/9/2007	10/9/2007	See Details for Joint > 1/2"	
12	1.5	10/9/2007	10/9/2007	See Details for Joint > 1/2"	
13	2	10/9/2007	10/9/2007	See Details for Joint < 3'16"	Narrow Joint
14	2	10/8/2007	10/10/2007	See Details for Joint > 1/2"	
15	3	10/8/2007	10/8/2007	See Details for Joint > 1/2"	
16	3	10/8/2007	10/9/2007	See Details for Joint > 1/2"	
17	3	10/8/2007	10/9/2007	See Details for Joint > 1/2"	
Sewer Joints (Horizontal Joints)	1	10/11/2007	10/11/2007	See Details for Joint < 3'16"	Joint Under Existing Sewer Pipe Area
Sewer Joint (Two additional 1/2 Joints)	1.5	10/5/2007	10/5/2007	See Details for Joint < 3'16"	Located between RCP Joint Nos. 4 and 5

NOTES:
 1. SEE SHEET NO. 5 - RCP SPILLWAY JOINT GROUTING DETAILS II FOR ADDITIONAL REMEDIAL GROUTING INFORMATION
 2. GROUTING WAS INJECTED UNDER PRESSURE THROUGH PLASTIC INJECTO-TUBES AND/OR GROUT HOELS INSTALLED AROUND THE INSIDE PERIMETER OF EACH PIPE JOINT.
 3. THE GROUTING MATERIAL USED WAS A HYDRO-ACTIVE COMBI RESIN
 4. AVONGARD CRACK MONITORING GAUGES WERE INSTALLED ACROSS THE JOINTS DURING GROUT INJECTION WORK WITH NO WITH NO MOVEMENTS RECORDED AT EACH JOINT.

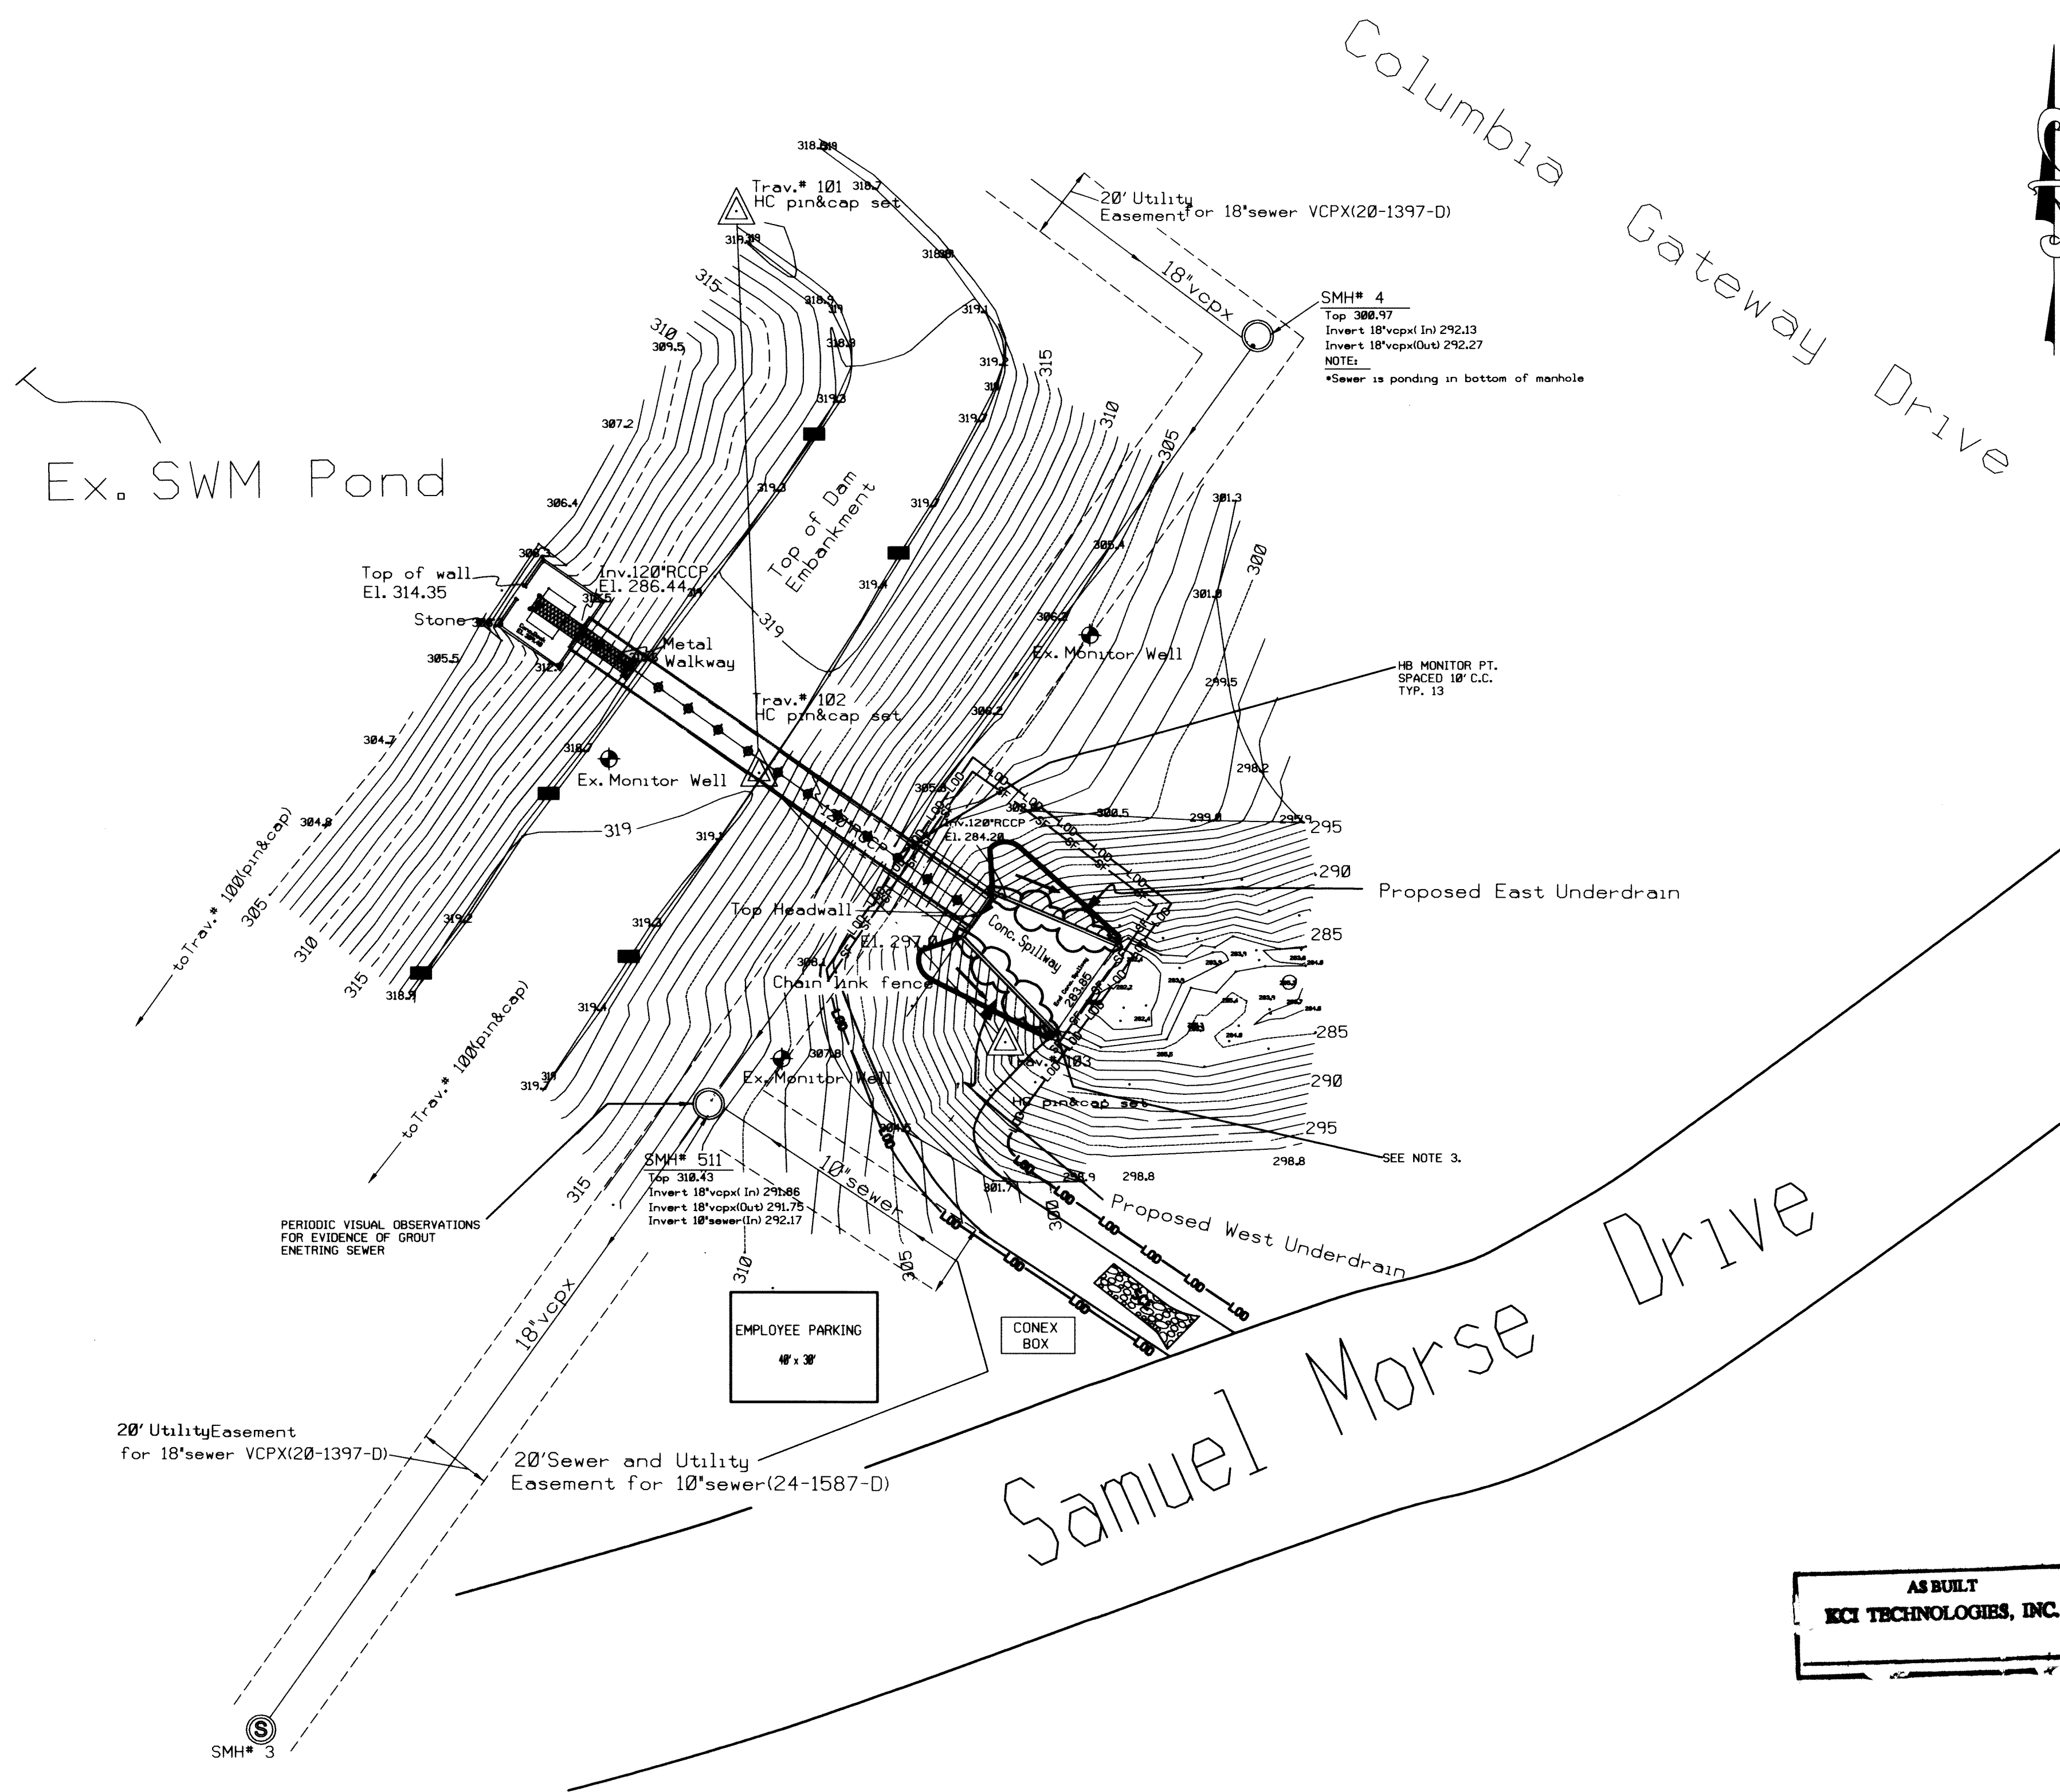

EXTERIOR MONITORING AND HAYWARD BAKER (HB) EQUIPMENT
LAYOUT PLAN WITH JOINT MONITORING DETAIL

SCALE: 1"=30'

NOTES:

1. CENTERLINE ELEVATIONS WILL BE SURVEYED WEEKLY DURING JOINT GROUTING.
2. SURVEY TO BE TIED TO BENCHMARK(S) PROVIDED BY KCI.
2. EXISTING CHAINLINK FENCE AT WINGWALLS TO BE REMOVED TEMPORARILY BY GENERAL CONTRACTOR TO ALLOW ACCESS INTO CONDUIT. TEMPORARY CONSTRUCTION FENCE TO BE CONSTRUCTED BY GENERAL CONTRACTOR.

HAYWARD BAKER
A KELLER COMPANY

NORTHEASTERN REGION
1875 MAYFIELD RD.
ODENTON, MD 21113
Ph: (410) 551-1980
Fax: (410) 551-8206

NO.	REVISIONS DESCRIPTION	DATE

ENGINEERS
PLANNERS
SCIENTISTS
CONSTRUCTION MANAGERS

KCI
TECHNOLOGIES www.kci.com

RCP SPILLWAY
JOINT GROUTING
DETAILS-I

COLUMBIA GATEWAY
STORM WATER
MANAGEMENT DAM


HOWARD COUNTY, MARYLAND
DEPARTMENT OF PUBLIC WORKS
STORM WATER MANAGEMENT DIVISION
6751 COLUMBIA GATEWAY DRIVE
COLUMBIA, MD 21046

AS BUILT
KCI TECHNOLOGIES, INC.

SCALE: AS SHOWN
DATE: 12/14/2007
KCIJOB NO.: 01-04322320
DESIGNED BY: KBA
DRAWN BY: MPP
CHECKED BY: KBA


SHEET NO:
4 OF 8

KCI FILE: m:\0199909\proposals\Geotech\2006\Columbia Gateway

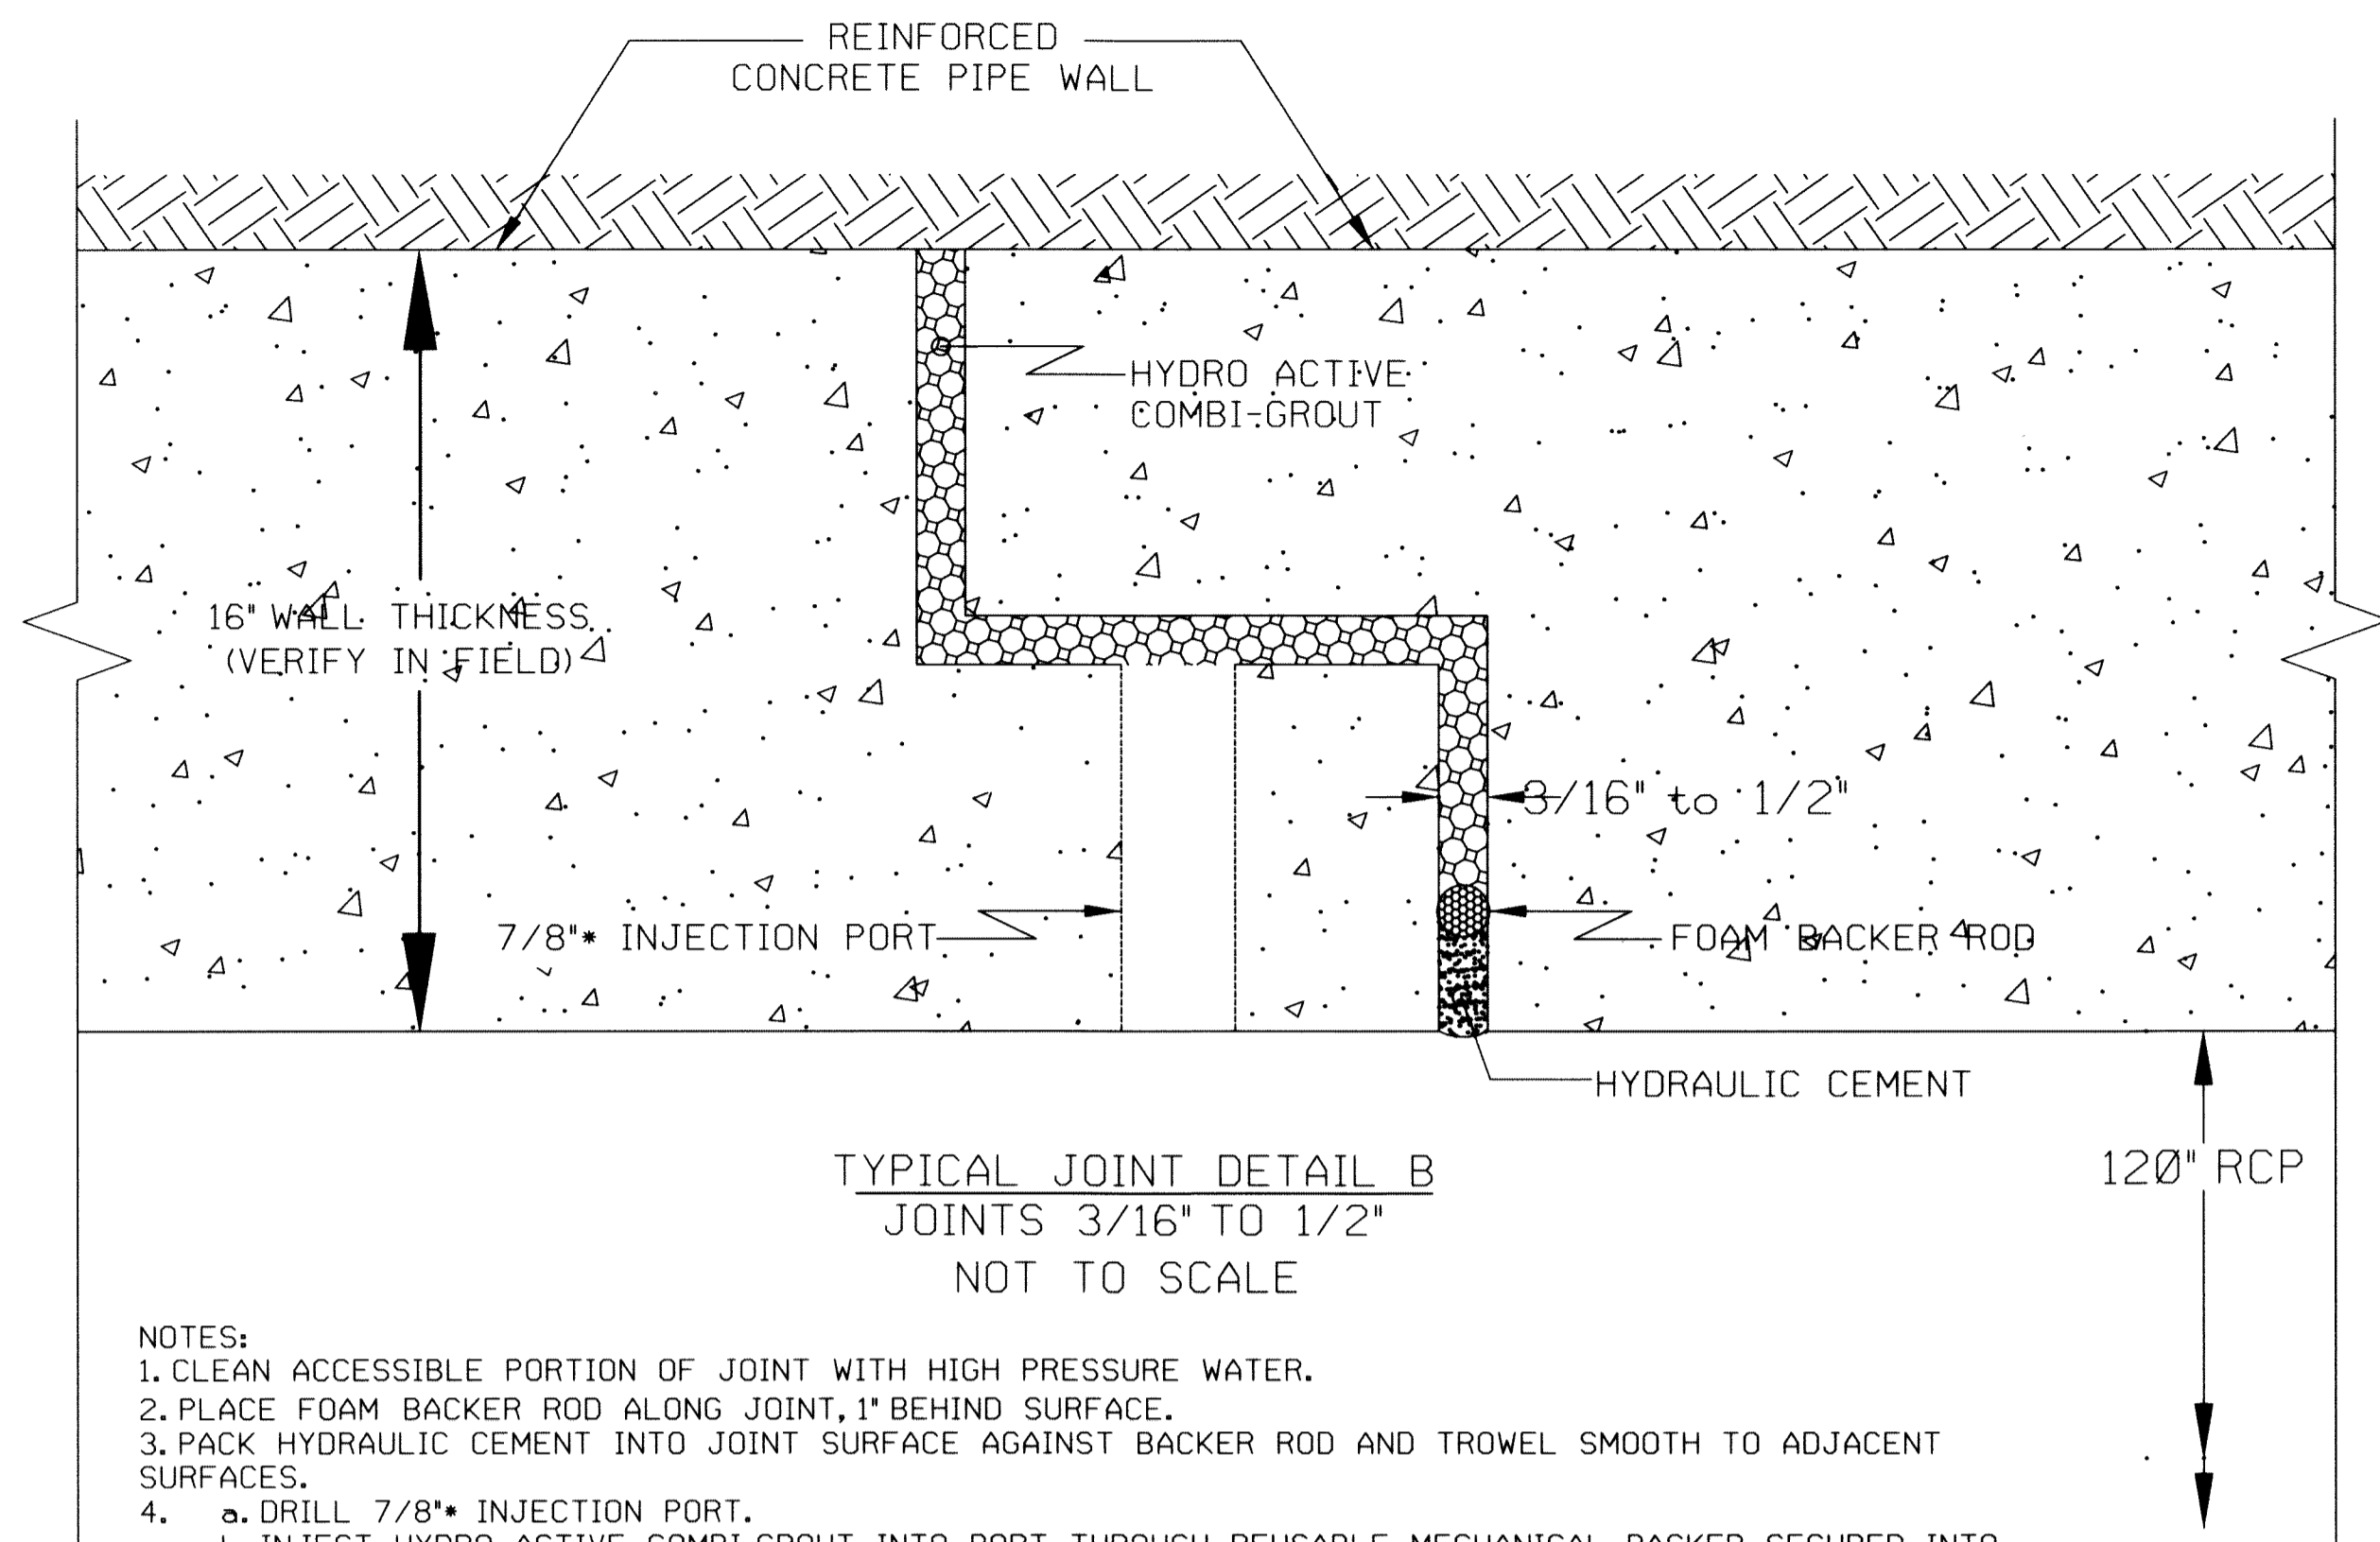


TYPICAL JOINT DETAIL B
JOINTS 3/16" TO 1/2"
NOT TO SCALE

- NOTES:
- CLEAN ACCESSIBLE PORTION OF JOINT WITH HIGH PRESSURE WATER.
 - PLACE FOAM BACKER ROD ALONG JOINT, 1" BEHIND SURFACE.
 - PACK HYDRAULIC CEMENT INTO JOINT SURFACE AGAINST BACKER ROD AND TROWEL SMOOTH TO ADJACENT SURFACES.
 - DRILL 7/8" INJECTION PORT.
 - INJECT HYDRO ACTIVE COMBI-GROUT INTO PORT THROUGH REUSABLE MECHANICAL PACKER SECURED INTO DRILLED HOLE.
 - OBSERVE APPARENT GROUT TRAVEL.
 - DRILL AND INJECT ADDITIONAL PORTS AS REQUIRED TO COMPLETE THE SEAL. PROGRESS FROM INVERT TO CROWN.
 - REMOVE GROUT PACKERS AND PATCH HOLES WITH HYDRAULIC CEMENT, FINISHED SMOOTH TO ADJACENT SURFACES.
 - SCRAPE OFF EXCESS HYDRO ACTIVE RESIN FROM PIPE SURFACES.
 - TOTAL NUMBER OF JOINTS TO BE TREATED IS 17, PLUS THE CIRCUMFRENENTIAL HEADWALL JOINT AND SEWER JOINTS (TWO ADDITIONAL JOINTS + HORIZONTAL JOINT). JOINT SIZE AND APPROPRIATE TREATMENT OPTION WILL BE DECIDED AFTER AWARD OF CONTRACT AND ESTABLISHMENT OF SAFE ACCESS INTO STRUCTURE.
 - LOCALIZED DEWATERING OF EACH JOINT INVERT WILL BE ACCOMPLISHED BY PLACING SAND BAGS ON BOTH SIDES OF THE JOINT, DEWATERING THE JOINT BY PUMP AND VACUUM AND BYPASSING PIPE FLOW ACROSS THE JOINT WITH A SUBMERSIBLE PUMP.

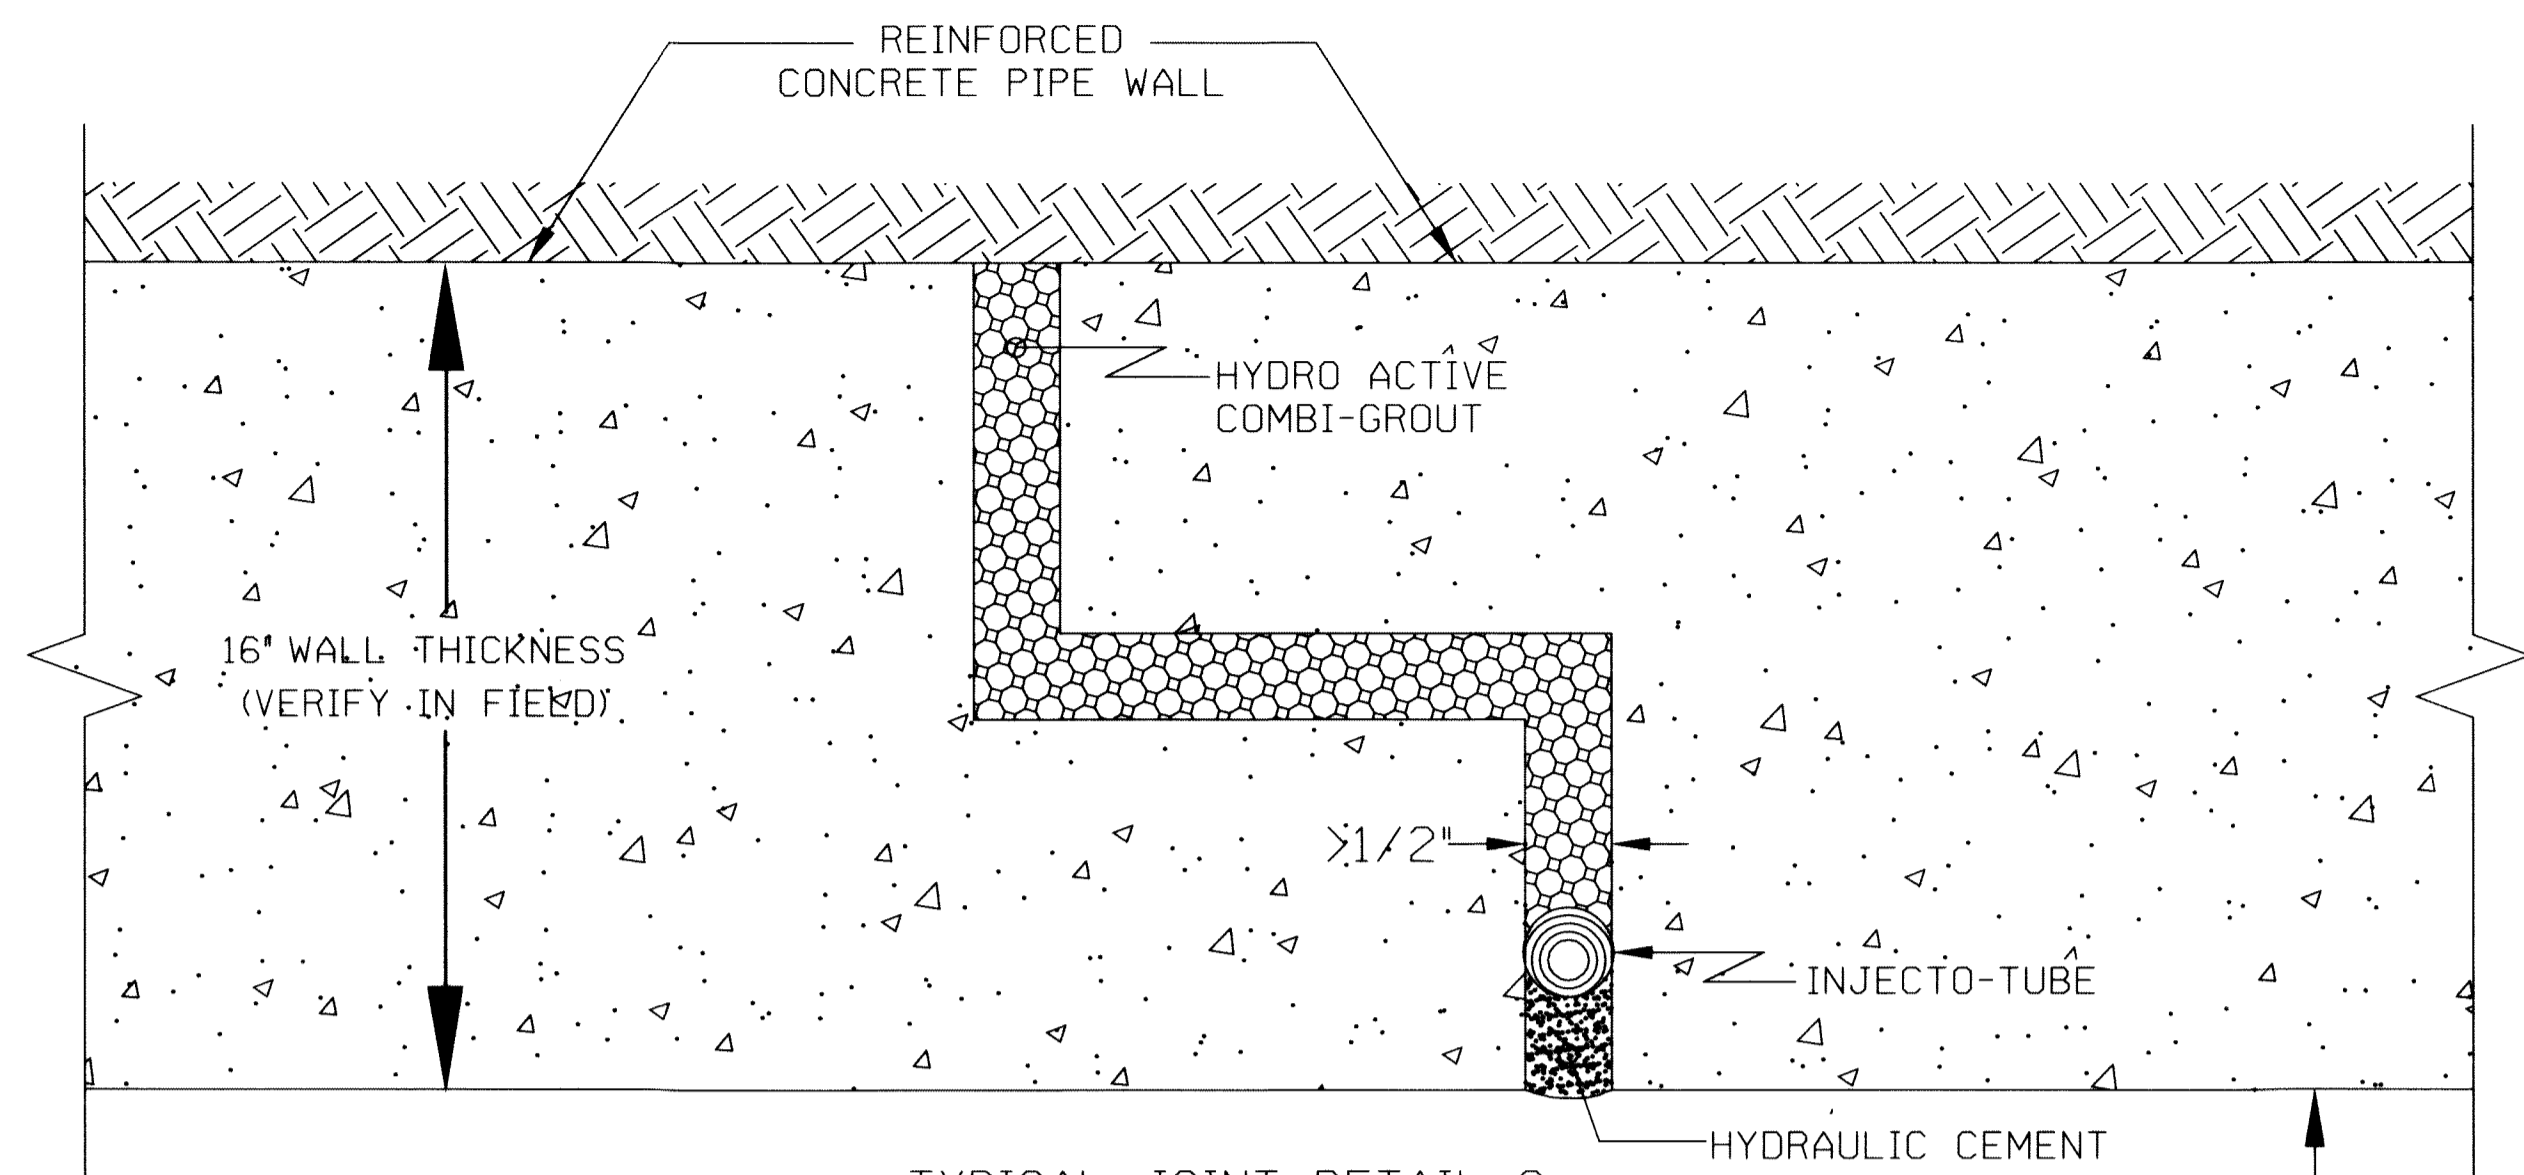


TYPICAL JOINT DETAIL C
JOINTS >1/2"
NOT TO SCALE

- NOTES:
- CLEAN ACCESSIBLE PORTION OF JOINT WITH HIGH PRESSURE WATER.
 - PLACE INJECTO-TUBE ALONG JOINT AT LEAST 1" BEHIND SURFACE, LEAVING AT LEAST 6 ENDS EQUALLY SPACED AROUND THE PIPE PERIMETER AND ACCESSIBLE AT THE PIPE SURFACE.
 - PACK HYDRAULIC CEMENT INTO JOINT SURFACE AGAINST INJECTO-TUBE AND SMOOTH TO ADJACENT SURFACES.
 - INJECT HYDRO ACTIVE COMBI-GROUT INTO INJECTO-TUBE UNTIL RESIN EXITS OPPOSITE END OF TUBE, THEN PLUG EXIT POINT AND PRESSURIZE TUBE.
 - REMOVE GROUT PORTS, CUT INJECTO-TUBE BEHIND SURFACE. PATCH HOLES WITH HYDRAULIC CEMENT, FINISHED SMOOTH TO ADJACENT SURFACES.
 - SCRAPE OFF EXCESS HYDRO ACTIVE RESIN FROM PIPE SURFACES.
 - TOTAL NUMBER OF JOINTS TO BE TREATED IS 17, PLUS THE CIRCUMFRENENTIAL HEADWALL JOINT AND SEWER JOINTS (TWO ADDITIONAL JOINTS + HORIZONTAL JOINT). JOINT SIZE AND APPROPRIATE TREATMENT OPTION WILL BE DECIDED AFTER AWARD OF CONTRACT AND ESTABLISHMENT OF SAFE ACCESS INTO STRUCTURE.
 - LOCALIZED DEWATERING OF EACH JOINT INVERT WILL BE ACCOMPLISHED BY PLACING SAND BAGS ON BOTH SIDES OF THE JOINT, DEWATERING THE JOINT BY PUMP AND VACUUM AND BYPASSING PIPE FLOW ACROSS THE JOINT WITH A SUBMERSIBLE PUMP.

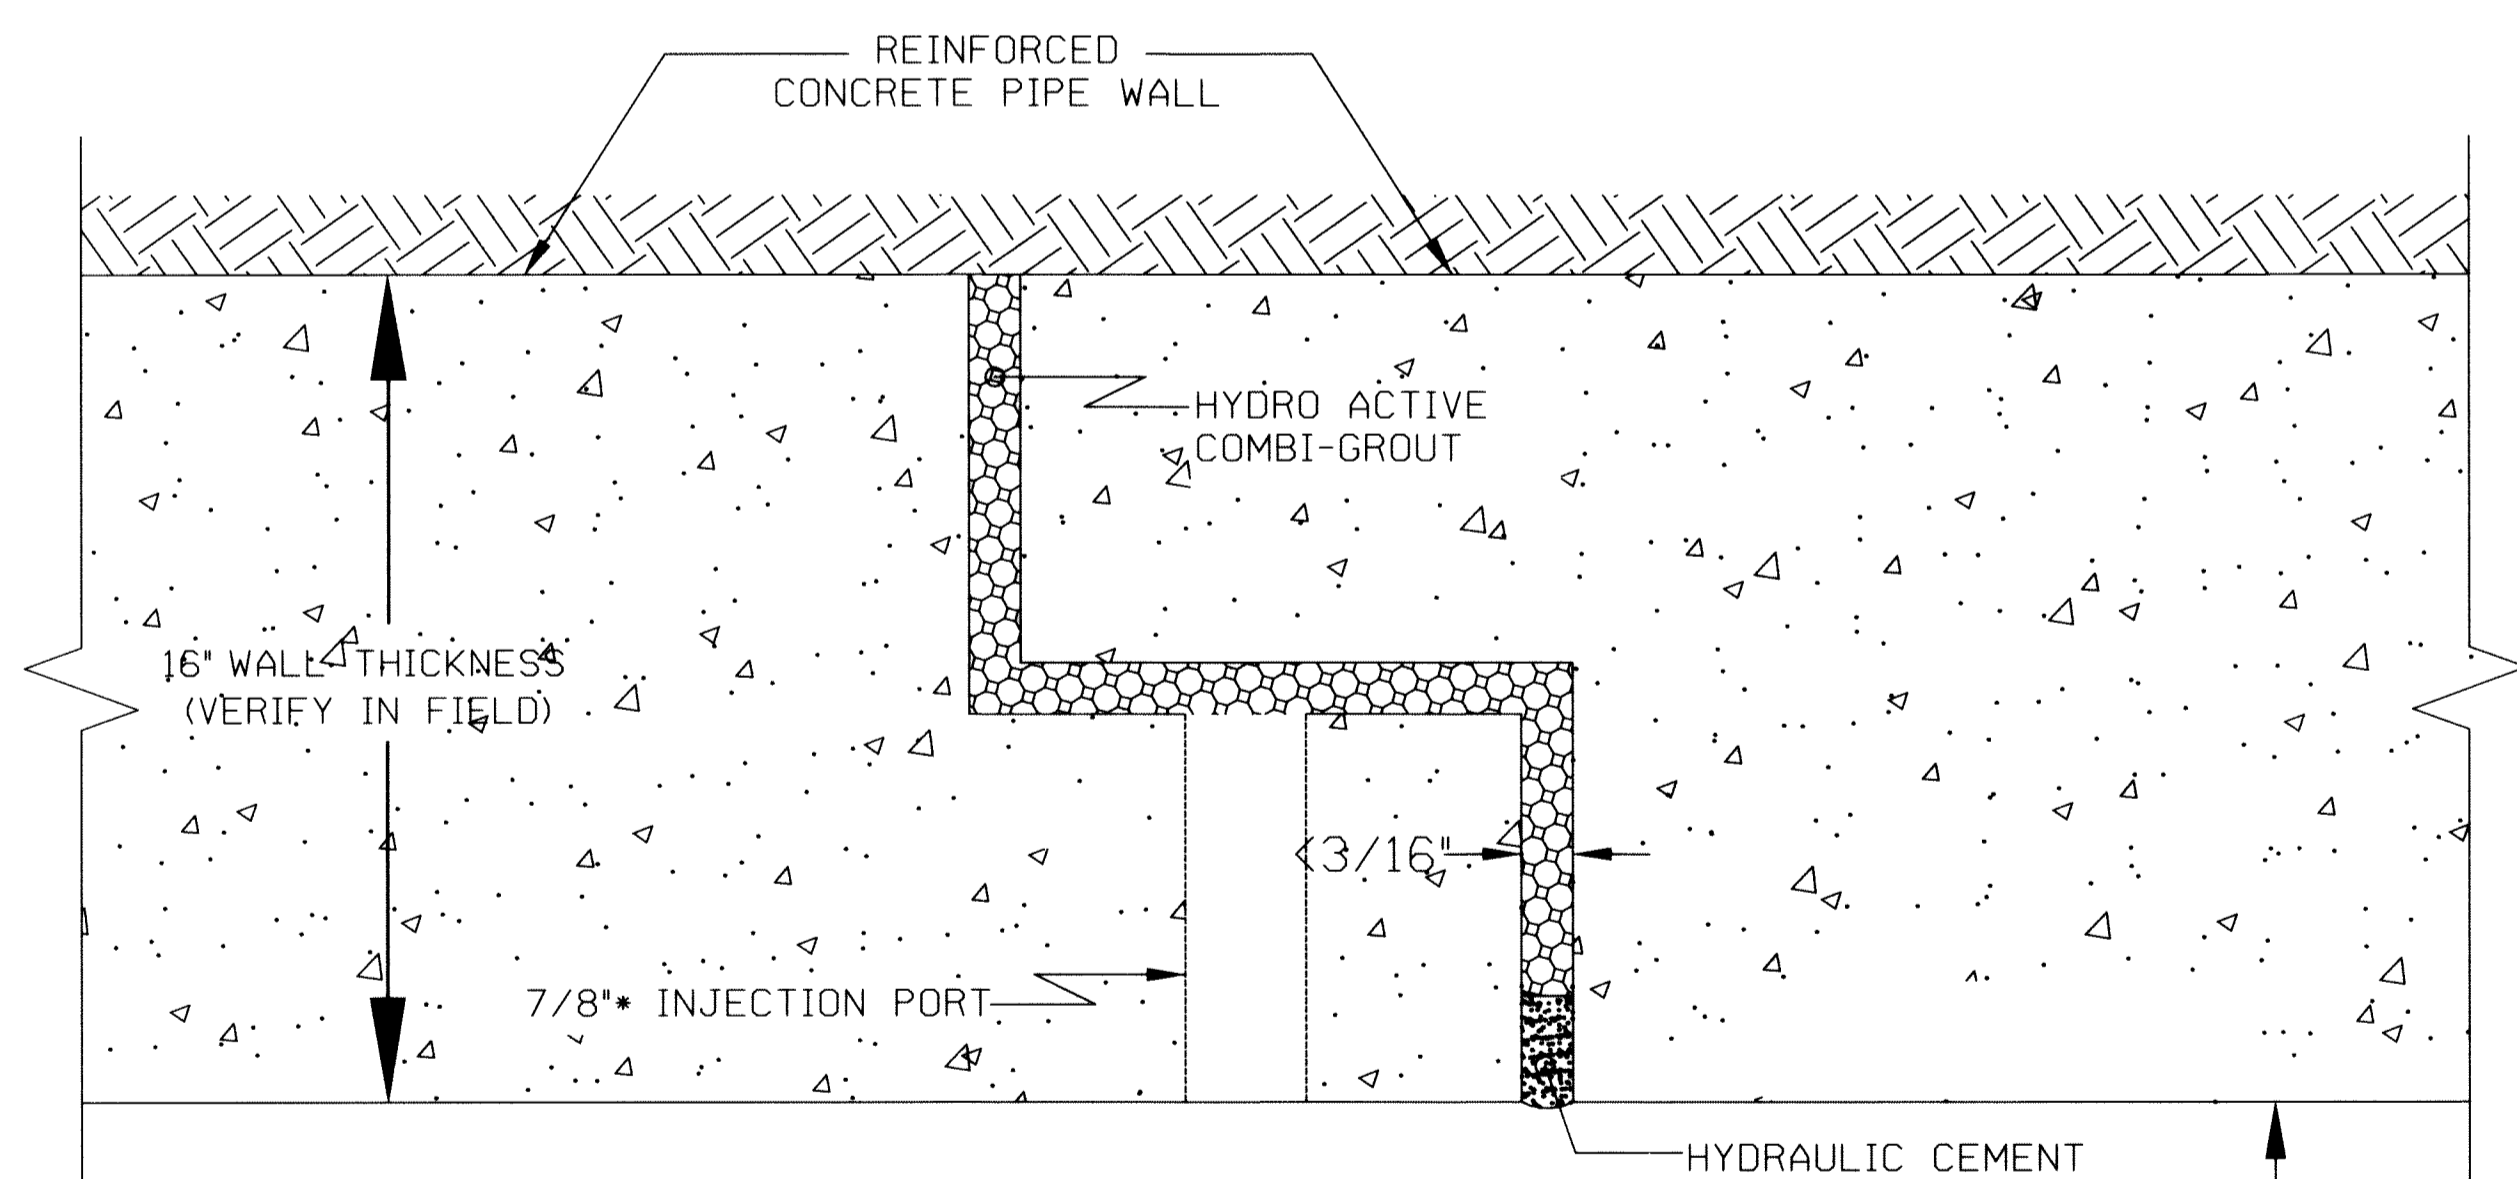

TYPICAL JOINT DETAIL A
JOINTS <3/16"
NOT TO SCALE


- NOTES:
- CLEAN ACCESSIBLE PORTION OF JOINT WITH HIGH PRESSURE WATER.
 - PACK HYDRAULIC CEMENT INTO JOINT SURFACE AND TROWEL SMOOTH TO ADJACENT SURFACES.
 - DRILL 7/8" INJECTION PORT.
 - INJECT HYDRO ACTIVE COMBI-GROUT INTO PORT THROUGH REUSABLE MECHANICAL PACKER SECURED INTO DRILLED HOLE.
 - OBSERVE APPARENT GROUT TRAVEL.
 - DRILL AND INJECT ADDITIONAL PORTS AS REQUIRED TO COMPLETE THE SEAL. PROGRESS FROM INVERT TO CROWN.
 - REMOVE GROUT PACKERS AND PATCH HOLES WITH HYDRAULIC CEMENT, FINISHED SMOOTH TO ADJACENT SURFACES.
 - SCRAPE OFF EXCESS HYDRO ACTIVE RESIN FROM PIPE SURFACES.
 - TOTAL NUMBER OF JOINTS TO BE TREATED IS 17, PLUS THE CIRCUMFRENENTIAL HEADWALL JOINT AND SEWER JOINTS (TWO ADDITIONAL JOINTS + HORIZONTAL JOINT). JOINT SIZE AND APPROPRIATE TREATMENT OPTION WILL BE DECIDED AFTER AWARD OF CONTRACT AND ESTABLISHMENT OF SAFE ACCESS INTO STRUCTURE.
 - LOCALIZED DEWATERING OF EACH JOINT INVERT WILL BE ACCOMPLISHED BY PLACING SAND BAGS ON BOTH SIDES OF THE JOINT, DEWATERING THE JOINT BY PUMP AND VACUUM AND BYPASSING PIPE FLOW ACROSS THE JOINT WITH A SUBMERSIBLE PUMP.

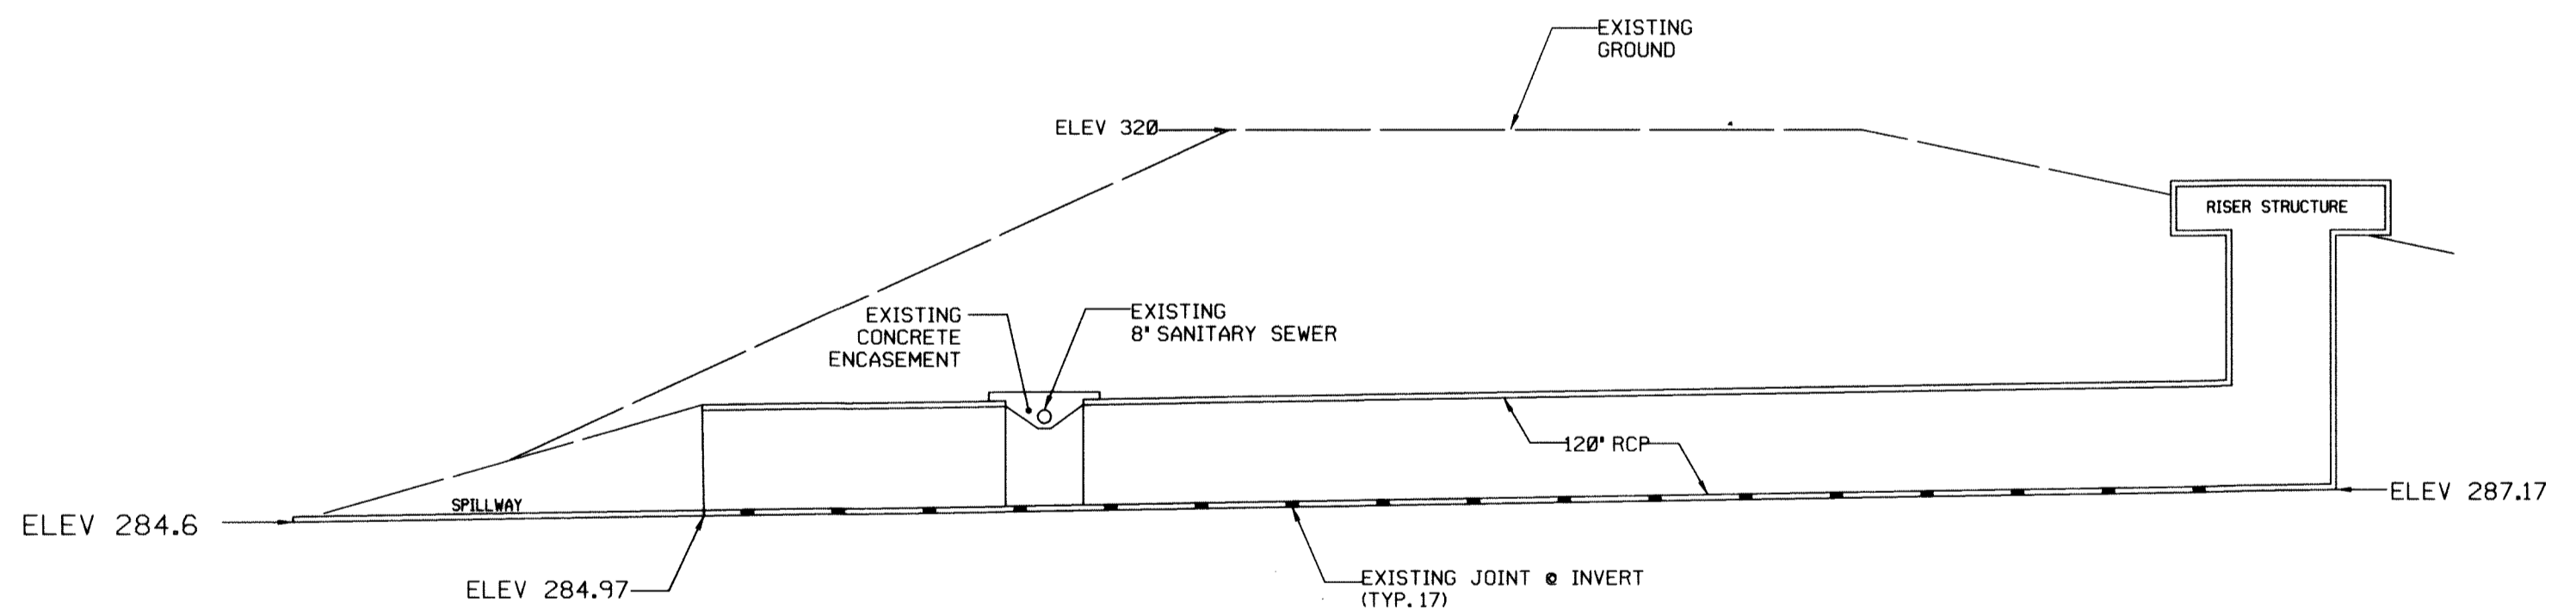

INVERT JOINT MONITORING PROFILE
NOT TO SCALE

NOTES:

- EXISTING PIPE JOINTS WILL BE MONITORED FOR VERTICAL DEFLECTION ON BOTH SIDES OF EACH JOINT AT THE INVERT.
- SURVEY CONTROL WILL BE ESTABLISHED BY KCI AT THE SPILLWAY AND RISER STRUCTURES FOR HB INVERT JOINT MONITORING.
- STRIP THE DETERIORATED PORTIONS OF THE CAST-IN-PLACE CONCRETE COLLAR NEAR EXISTING SANITARY SEWER LINE. APPLY GALVANIZED COATING TO EXPOSED REBAR AND PACK HYDRAULIC CEMENT WITHIN THE STRIPPED/ EXPOSED PORTIONS.

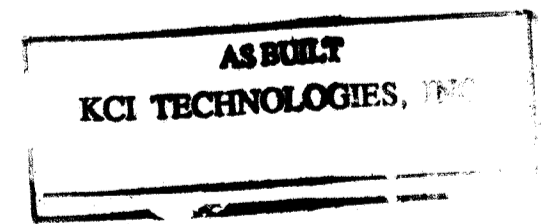

NO.	REVISIONS DESCRIPTION	DATE

ENGINEERS
PLANNERS
SCIENTISTS
CONSTRUCTION MANAGERS


KCI
TECHNOLOGIES

www.kci.com

RCP SPILLWAY
JOINT
GROUTING
DETAILS-II

COLUMBIA GATEWAY
STORM WATER
MANAGEMENT DAM
HOWARD COUNTY, MARYLAND

DEPARTMENT OF PUBLIC WORKS
5761 COLUMBIA GATEWAY DRIVE
COLUMBIA, MD 21046

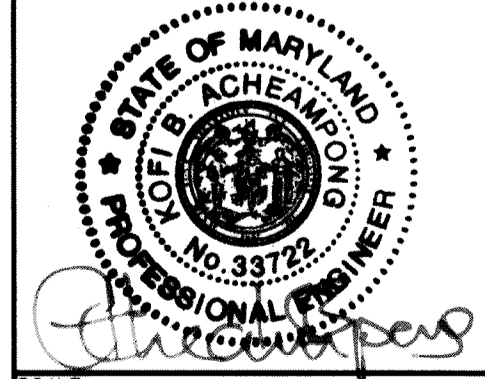

SCALE:	AS SHOWN
DATE:	12/14/2007
KCIJOB NO.:	01-04322320
DESIGNED BY:	KBA
DRAWN BY:	MPP
CHECKED BY:	KBA
SHEET NO.:	5 OF 8

HAYWARD BAKER
A HELLER COMPANY

NORTHEASTERN REGION
1875 MAYFIELD RD.
ODONTON, MD 21113
Ph: (410) 551-1980
Fax: (410) 551-8206

TRAVERSE

# 100	N 547416.521	E 1366115.778	El. 330.622
# 101	N 547982.702	E 1366517.162	El. 319.189
# 102	N 547829.585	E 1366523.319	El. 319.023
# 103	N 547756.363	E 1366590.451	El. 290.851

NOTES:


- Coordinates and elevations shown hereon are based on the following Datums and projections:
Horizontal: Maryland Grid/NAD83' (Adj.1991)
Vertical: NAVD88' U.S. Survey Feet
- Original Base Map Provided via email by the Howard County Department of Public Works (DPW) Storm Water Management Division, and dated October 2006

LEGEND

- LOD —— LIMIT OF DISTURBANCE
- SF —— SILT FENCE
- SCE STABILIZED CONSTRUCTION ENTRANCE
- DIRECTION OF FLOW IN UNDERDRAIN
- EXISTING 2006 MONITORING WELL
- PZ-4/B-4 2007 MONITORING WELL LOCATION AND NO.

SEQUENCE OF CONSTRUCTION

- THE CONTRACTOR SHALL NOTIFY "MISS UTILITY" AT 1-800-257-7777 AND THE HOWARD COUNTY DEPARTMENT OF PUBLIC WORKS/ BUREAU OF ENGINEERING/CONSTRUCTION INSPECTION DIVISION (410-313-1880) AT LEAST 5 DAYS PRIOR TO BEGINNING ANY WORK.
- CONTRACTOR AND THE GROUTING SPECIALTY CONTRACTOR SHALL COORDINATE AN ON-SITE PRE-CONSTRUCTION MEETING WHICH SHALL INCLUDE, BUT NOT BE LIMITED TO, THE COUNTY PROJECT MANAGER, THE ENGINEER, MDE DAM SAFETY AND A REPRESENTATIVE FROM HOWARD COUNTY CONSTRUCTION INSPECTION.
- CLEAR AND GRUB THOSE AREAS WITHIN THE LIMIT OF DISTURBANCE REQUIRED TO INSTALL STABILIZED CONSTRUCTION ENTRANCE.
- INSTALL SEDIMENT CONTROL MEASURES AS SHOWN ON THE EROSION AND SEDIMENT CONTROL PLAN.
- PERFORM INSTALLATION OF WALL DRAINAGE SYSTEM AS SHOWN ON THE DRAWINGS, INCLUDING EXCAVATION DEWATERING.
- INSTALL TWO MONITORING WELLS TO A DEPTH OF 15 FEET, ONE AT EACH WINGWALL LOCATIONS AS SHOWN ON THE DRAWINGS, OR AS DIRECTED BY THE ENGINEER.
- CONSTRUCTION WATER CONTROLS THROUGH THE RCP SPILLWAY
 - GROUTING SUB-CONTRACTOR SHALL COORDINATE WITH THE COUNTY AND MDE DAM SAFETY ON TEMPORARY CLOSING/OPENING OF THE SLUICE GATE AND DIVERT WATER FROM ENTERING THE SPILLWAY TO MAINTAIN RELATIVELY DRY WORK AREA WITHIN THE RCP FOR JOINT GROUTING WORK.
 - GROUTING SUB-CONTRACTOR SHALL PROVIDE ALTERNATE MEANS/METHODS INCLUDING SAND BAGS AND SUBMERSIBLE PUMPS TO TEMPORARILY CONTROL WATER FLOW THROUGH THE SPILLWAY DURING GROUTING WORK.
 - LOCALIZED PIPE JOINT DEWATERING CAN BE ACHIEVED BY USING SAND BAGS TO ISOLATE EACH JOINT AND USING SUBMERSIBLE PUMP TO DEWATER.
- PERFORM REMEDIAL GROUTING AT PIPE JOINTS INCLUDING GROUND/STRUCTURE MONITORING AS SHOWN ON DRAWINGS.
- PERMANENTLY STABILIZE ALL DISTURBED AREAS WITH TOPSOIL OR AS SPECIFIED ON THE PLAN. DEWATER ENTRAPPED AREA AS SHOWN ON THE PLANS. NO SEDIMENT-LADEN FLOW SHALL BE ALLOWED TO ENTER THE DOWNSTREAM CHANNEL.
- WHEN THE SITE IS STABILIZED AND WITH THE PERMISSION OF THE HOWARD COUNTY SEDIMENT CONTROL INSPECTOR, REMOVE SEDIMENT CONTROL DEVICES AND STABILIZE ANY AREAS DISTURBED BY THIS ACTIVITY.

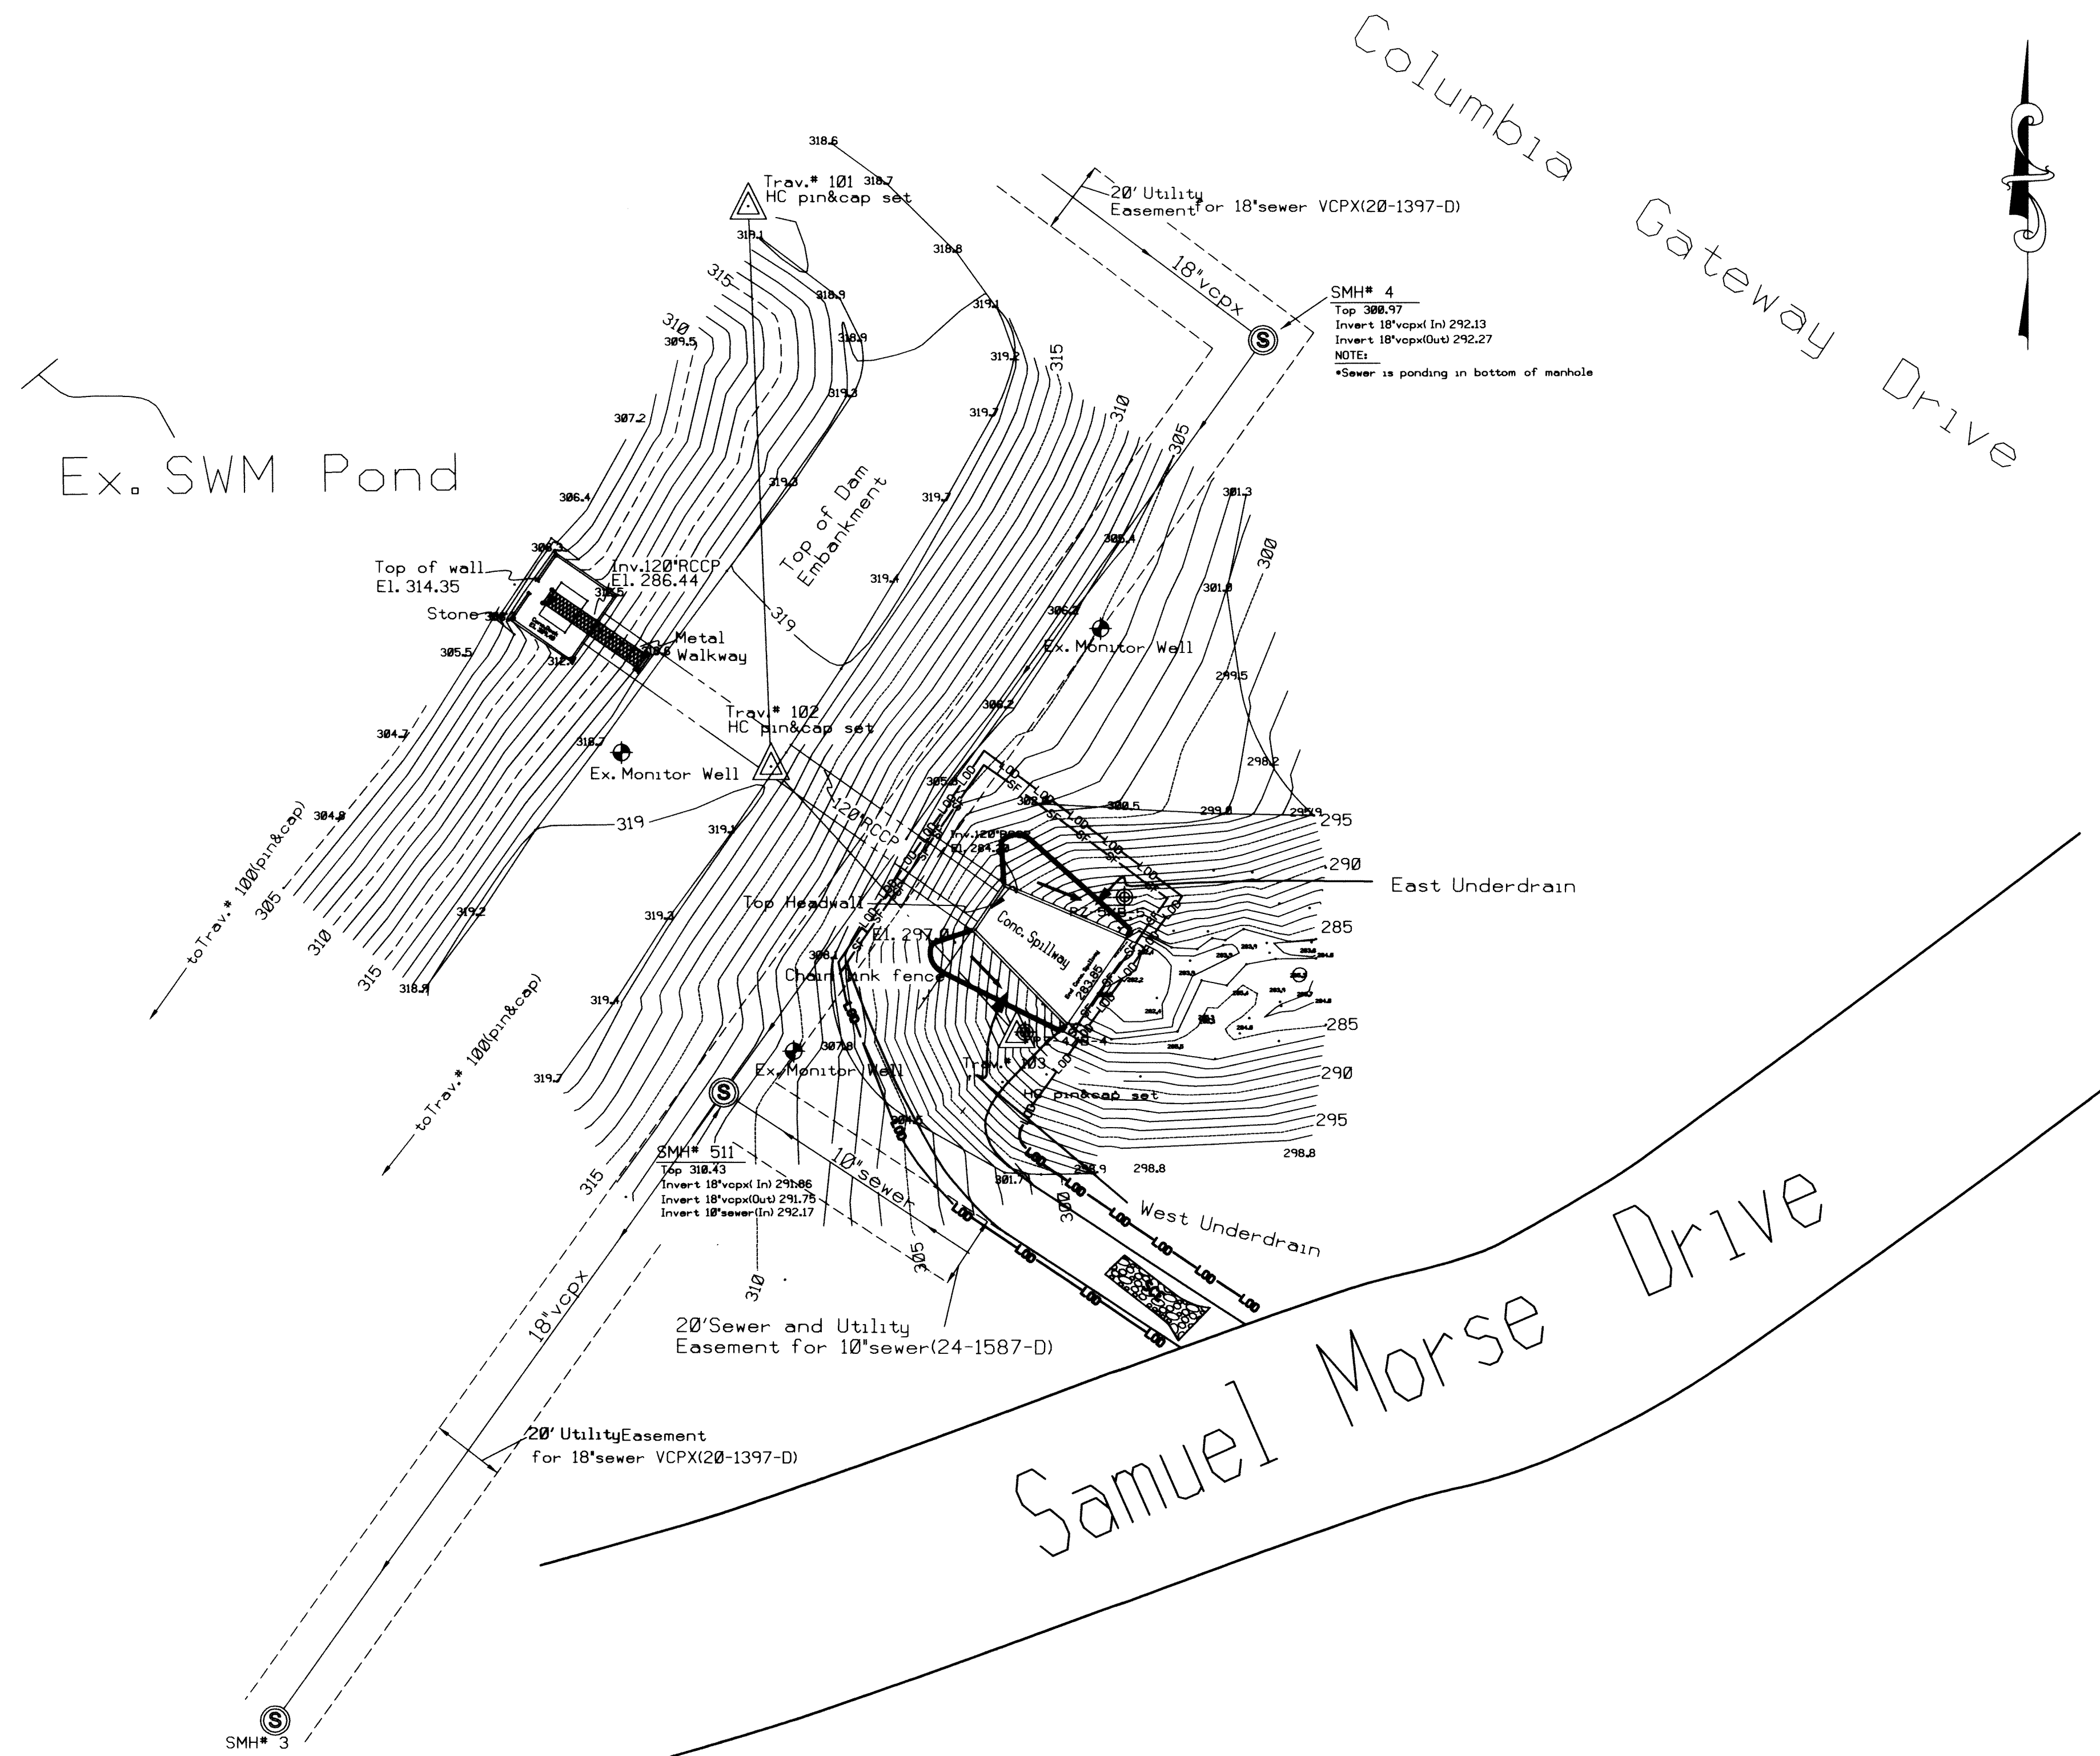

AS BUILT
KCI TECHNOLOGIES, INC.


NO.	REVISIONS DESCRIPTION	DATE

www.kci.com

CONSTRUCTION MANAGERS
SCIENTISTS
PLANNERS
ENGINEERS













EROSION AND SEDIMENT CONTROL PLAN

COLUMBIA GATEWAY STORM WATER MANAGEMENT DAM
HOWARD COUNTY, MARYLAND
DEPARTMENT OF PUBLIC WORKS
STORM WATER DIVISION
6755 COLUMBIA GATEWAY DRIVE
COLUMBIA, MD 21046

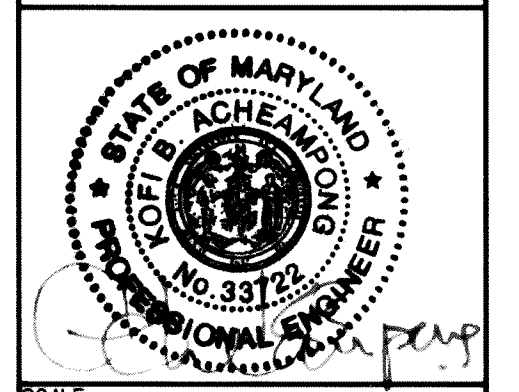

SCALE:	1"=30'
DATE:	12/15/2007
KCI JOB NO.:	01-04322320
DESIGNED BY:	KBA
DRAWN BY:	MPP
CHECKED BY:	KBA
SHEET NO.:	6 OF 8

KCI FILE: m:\0199909.gmv\Proposals\Geotech\2006\Columbia Gateway

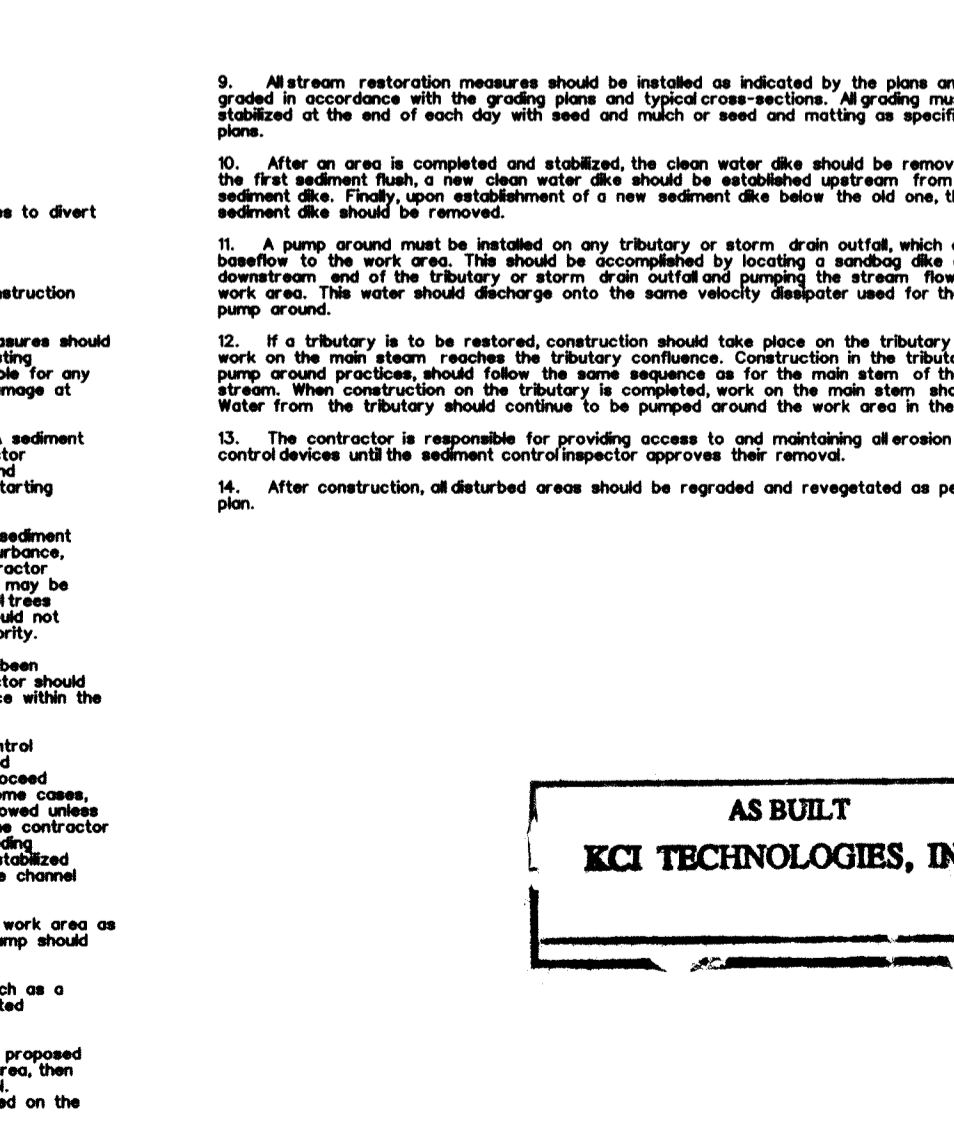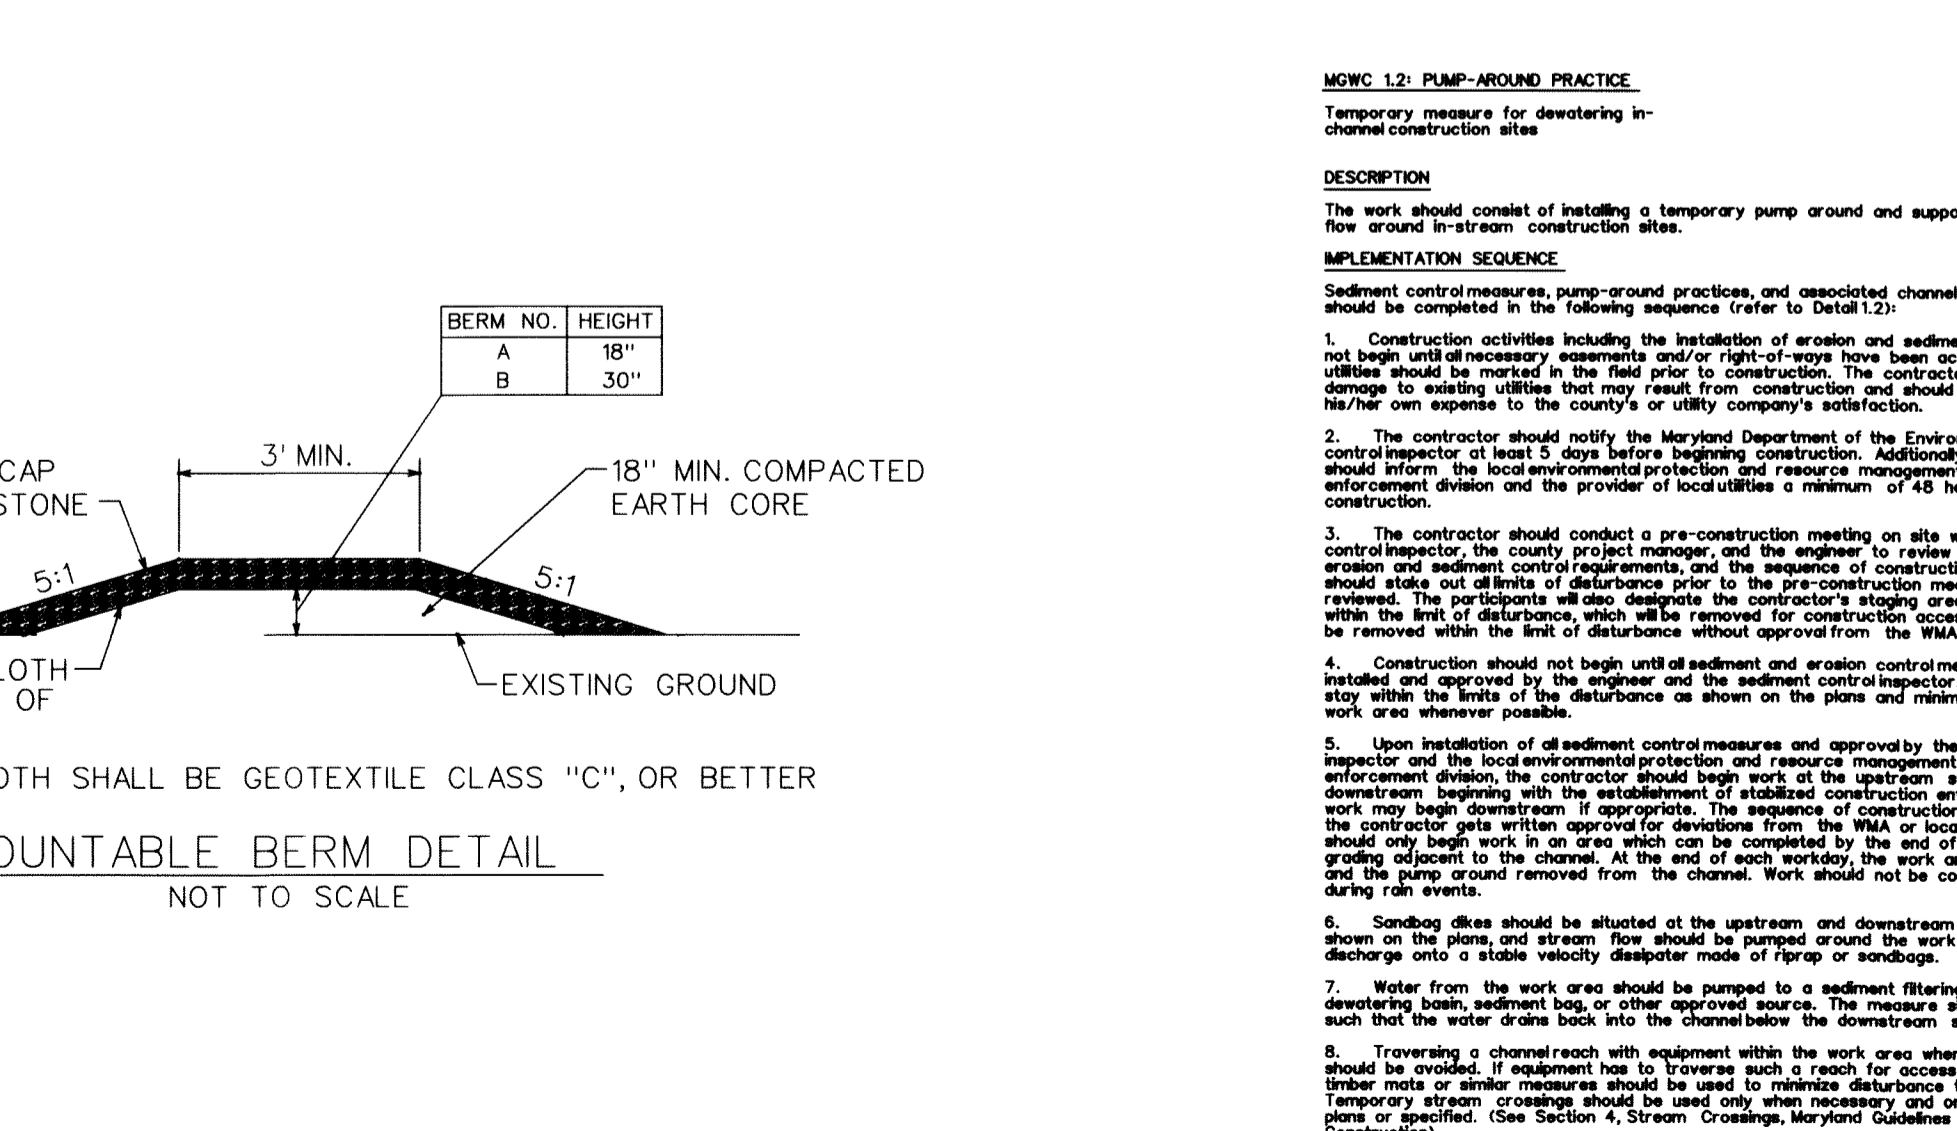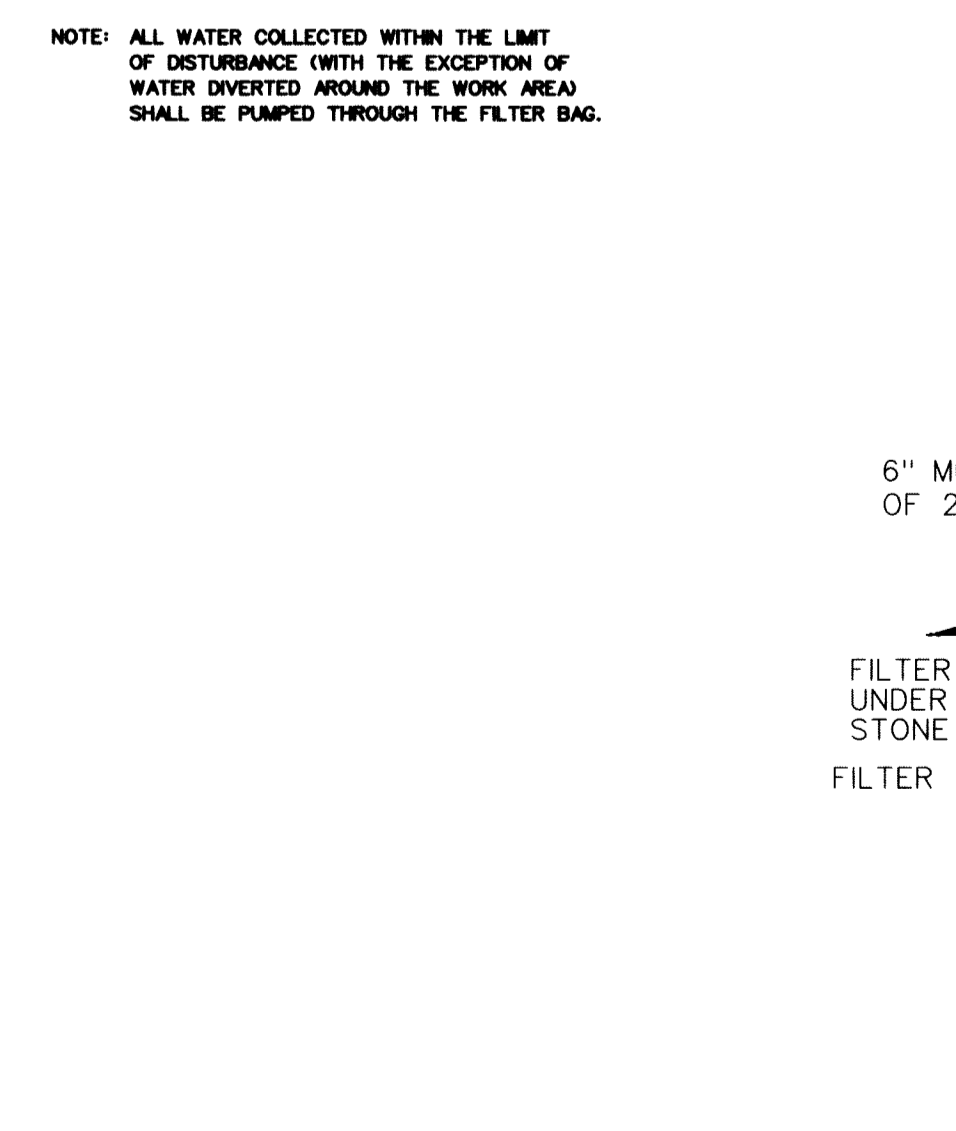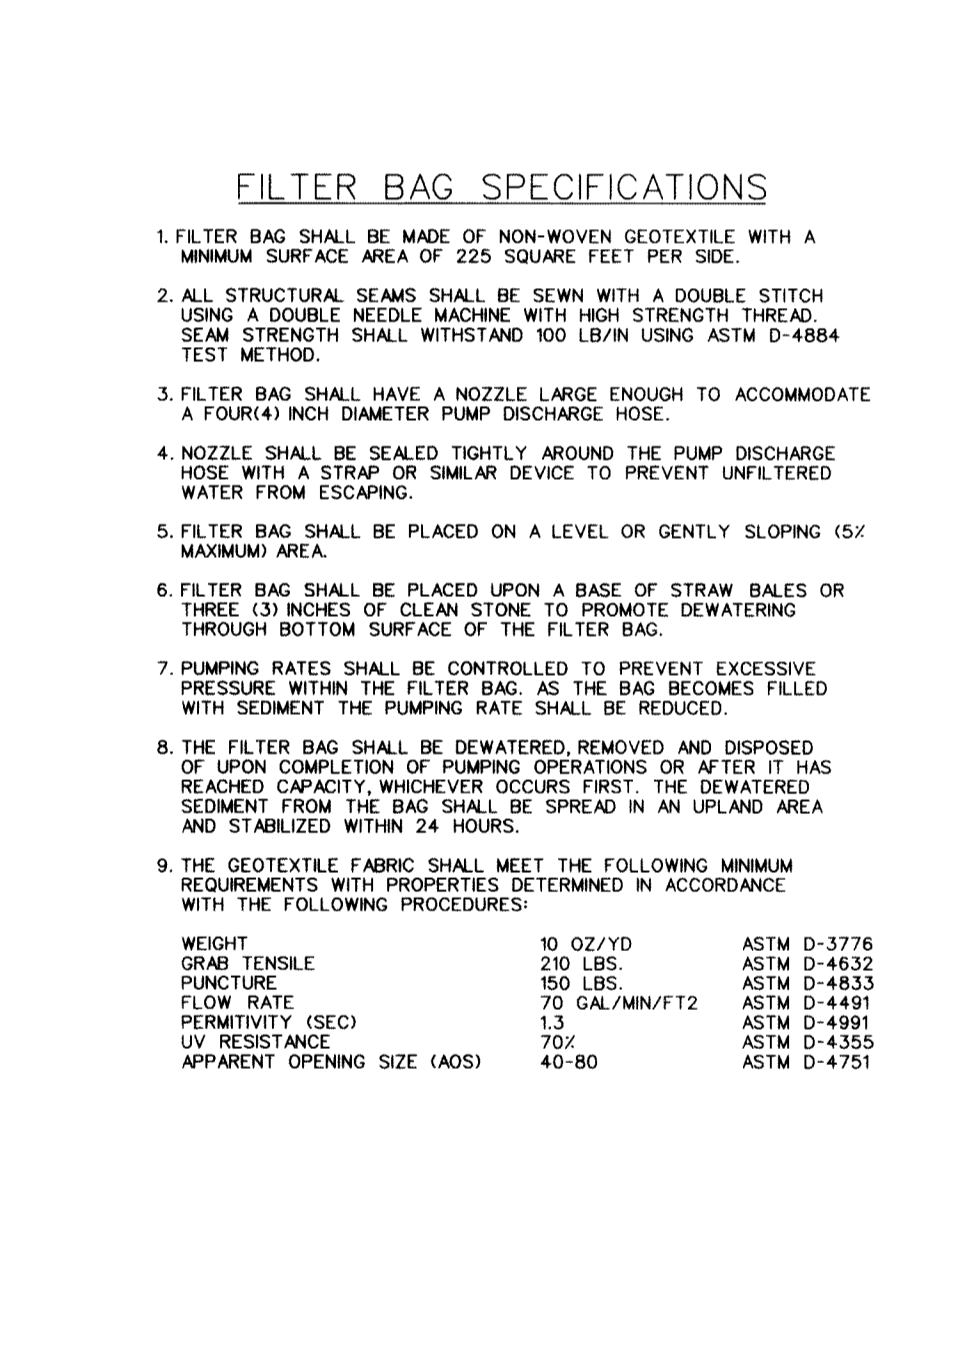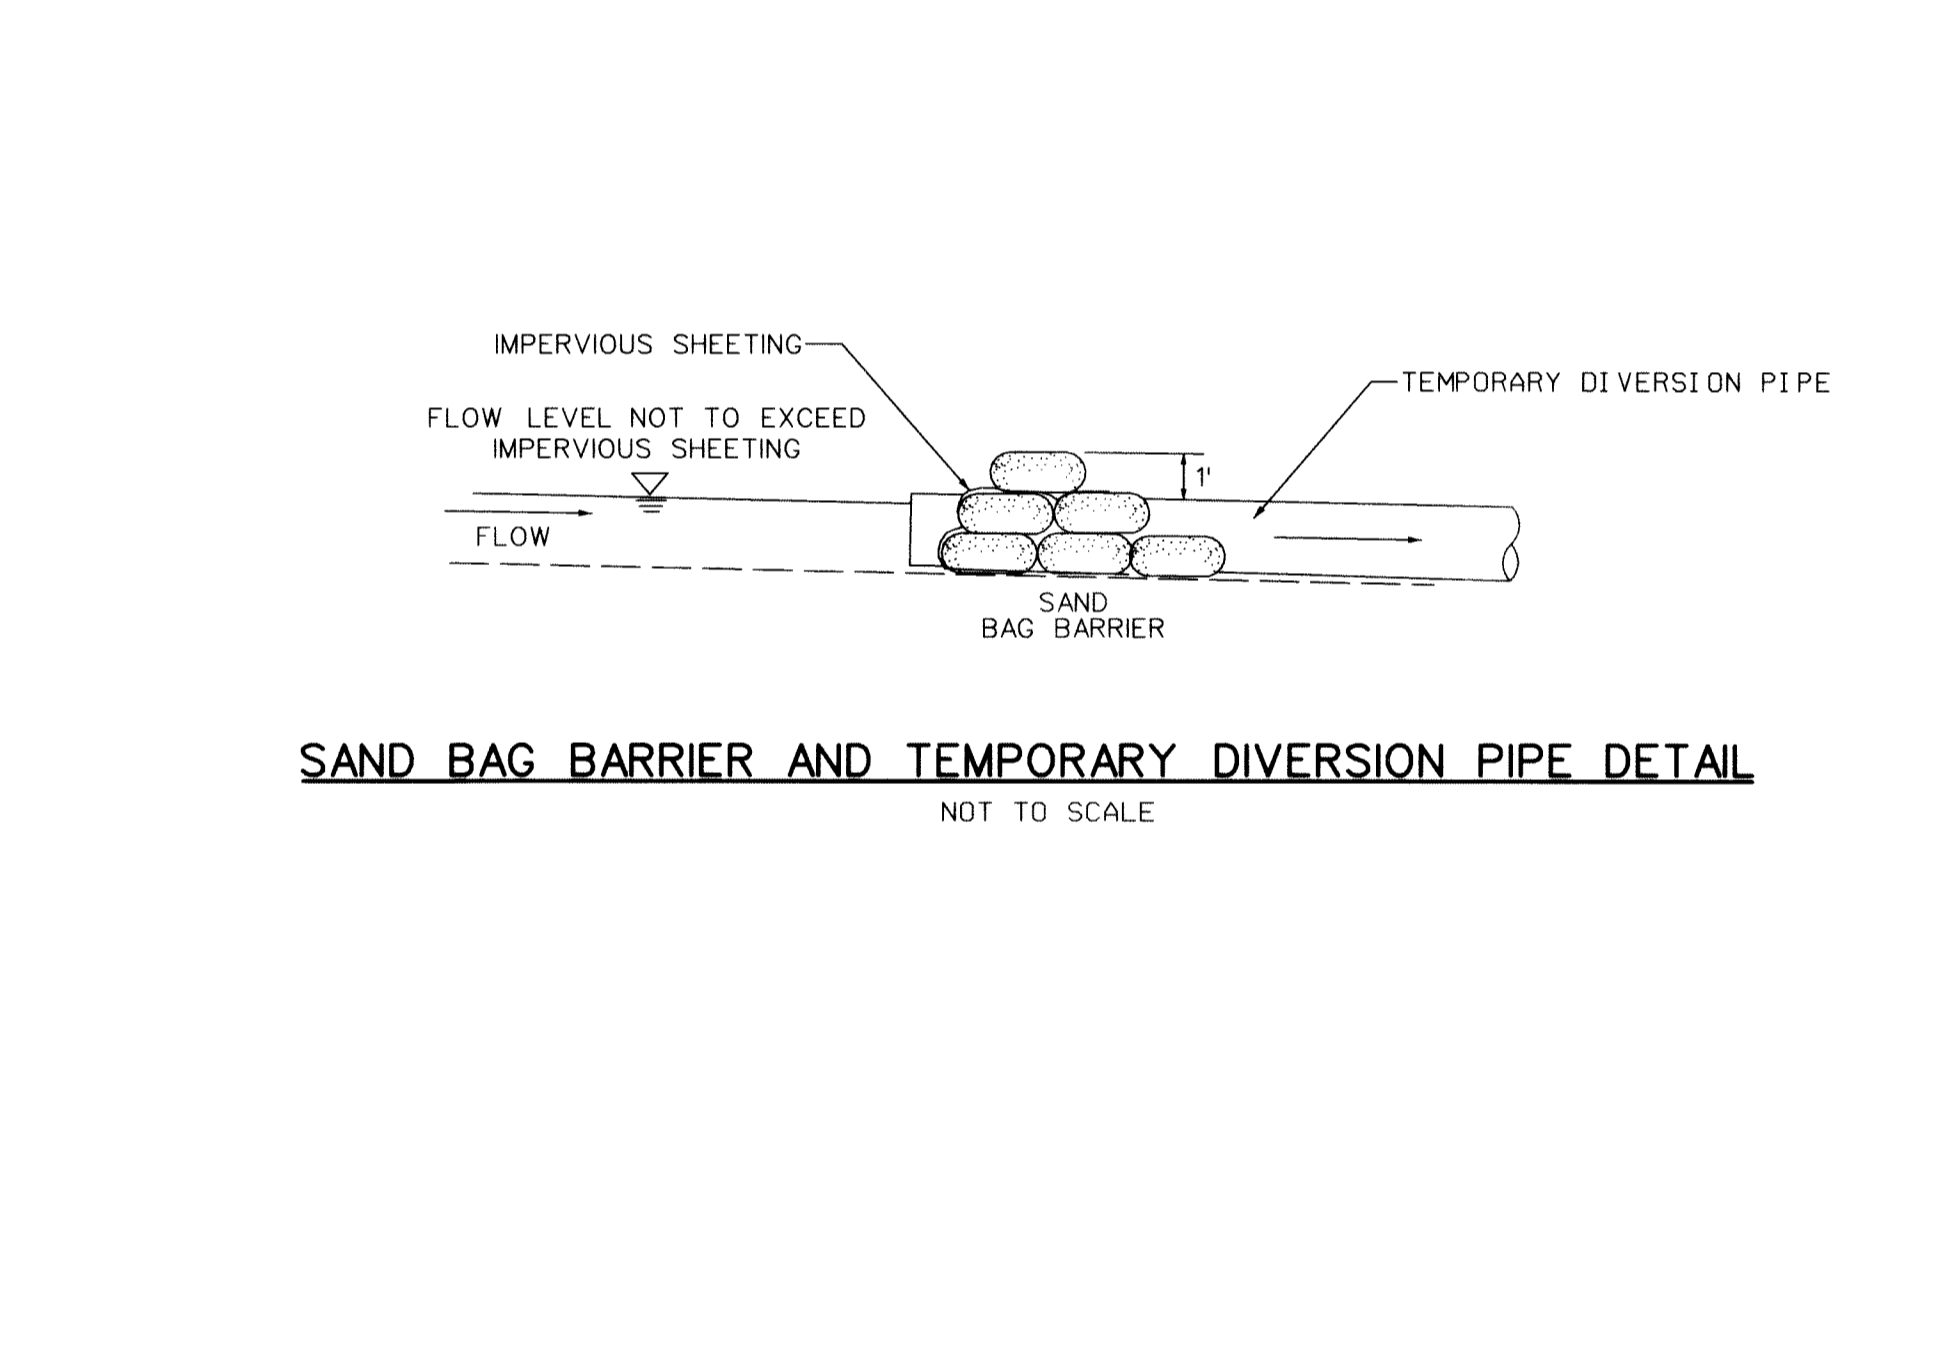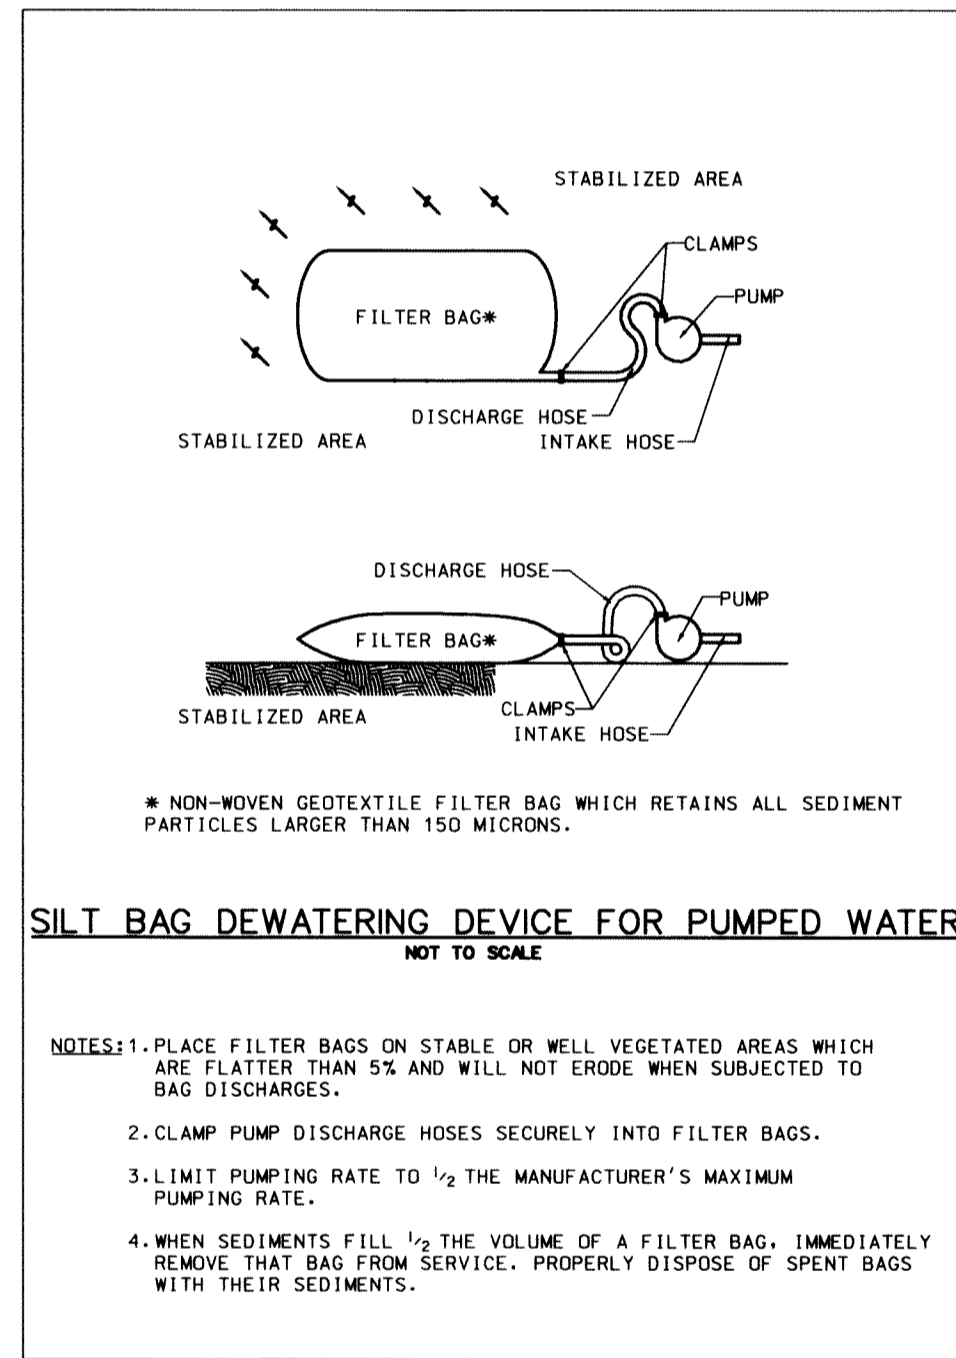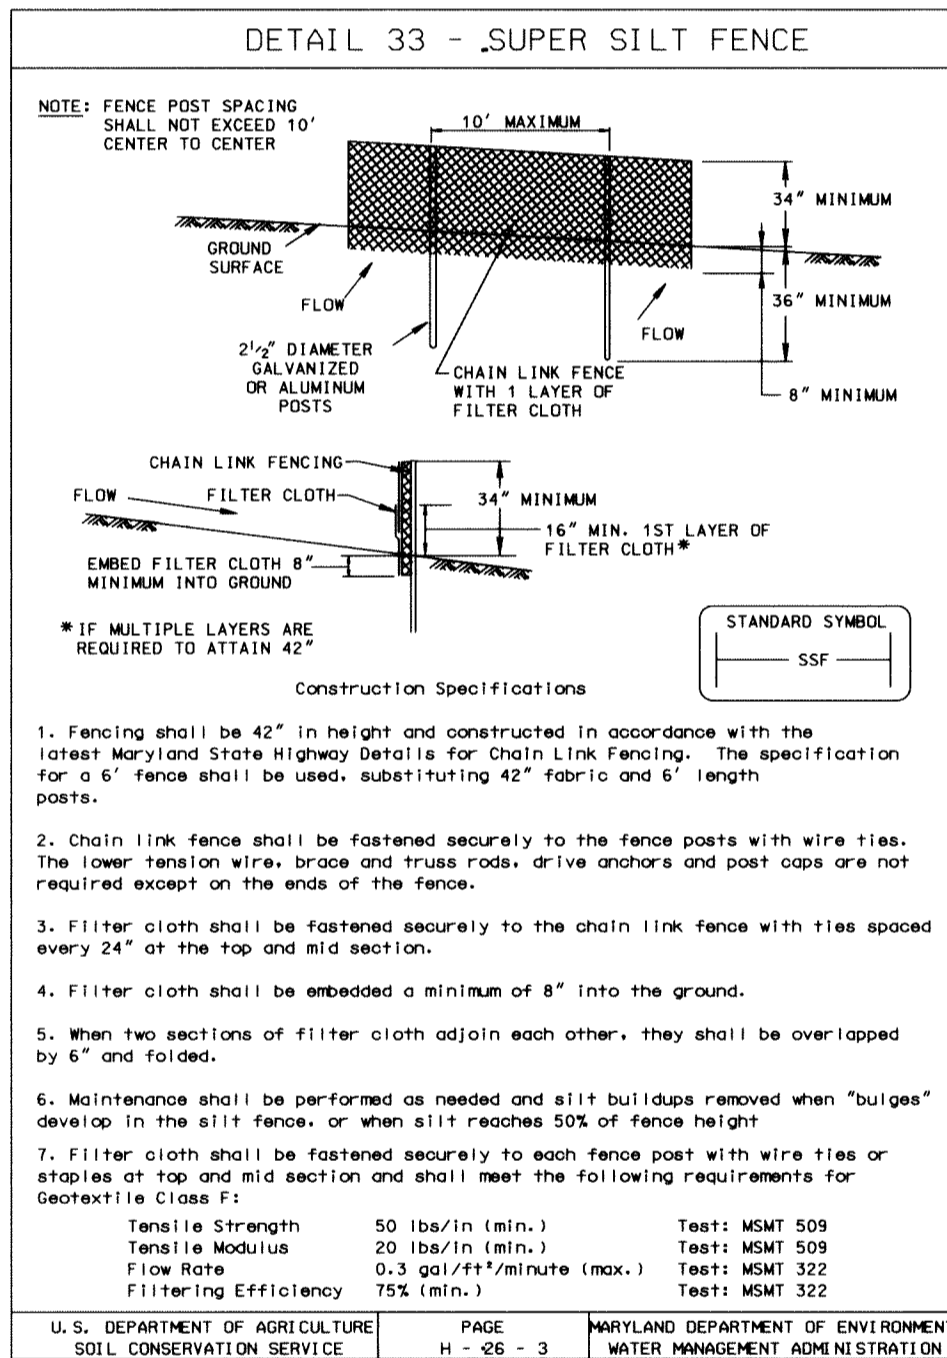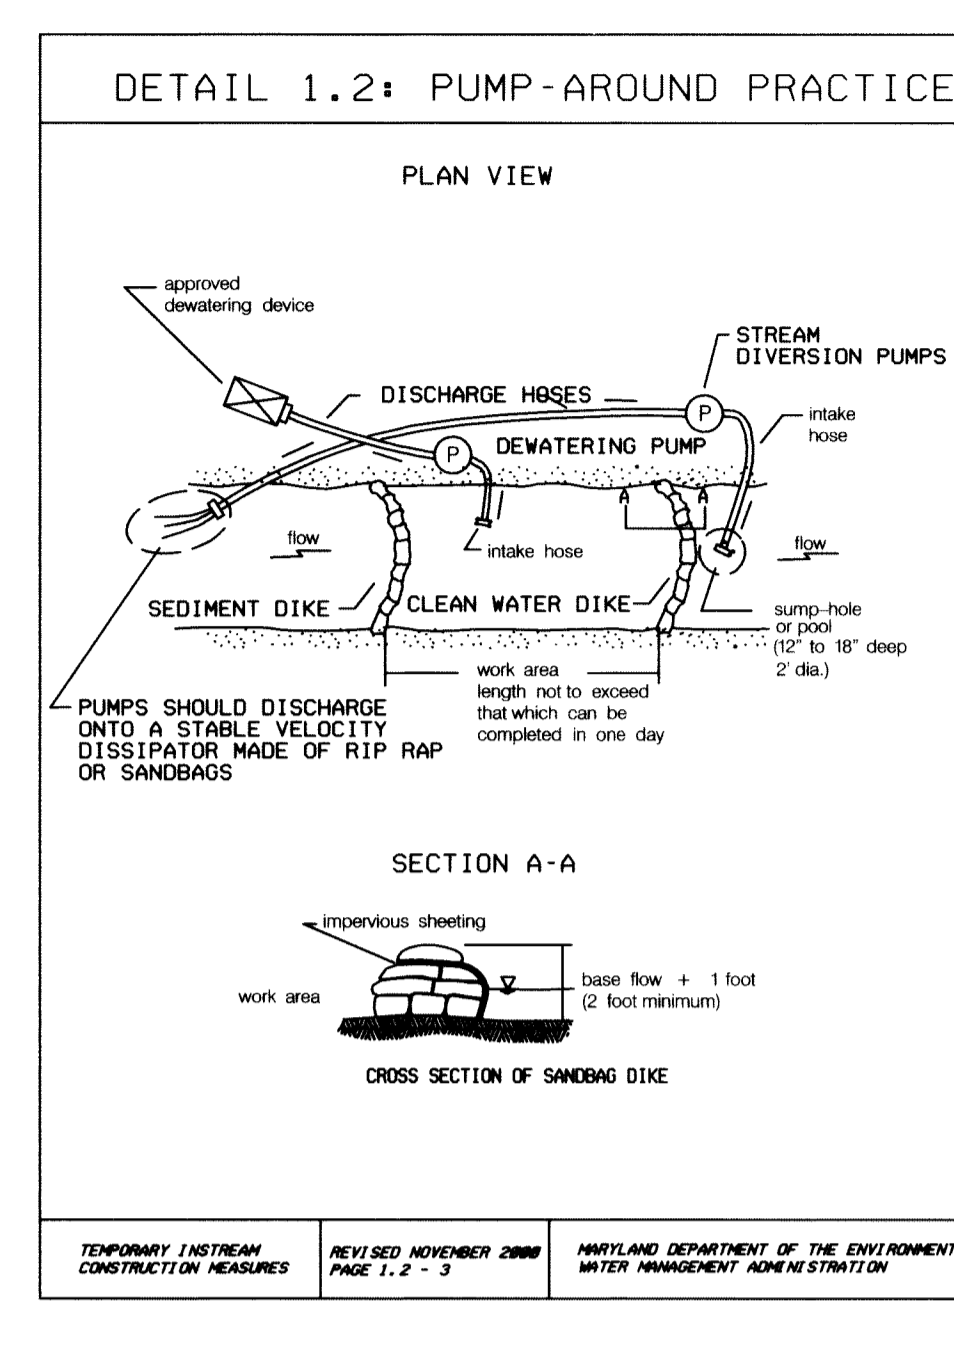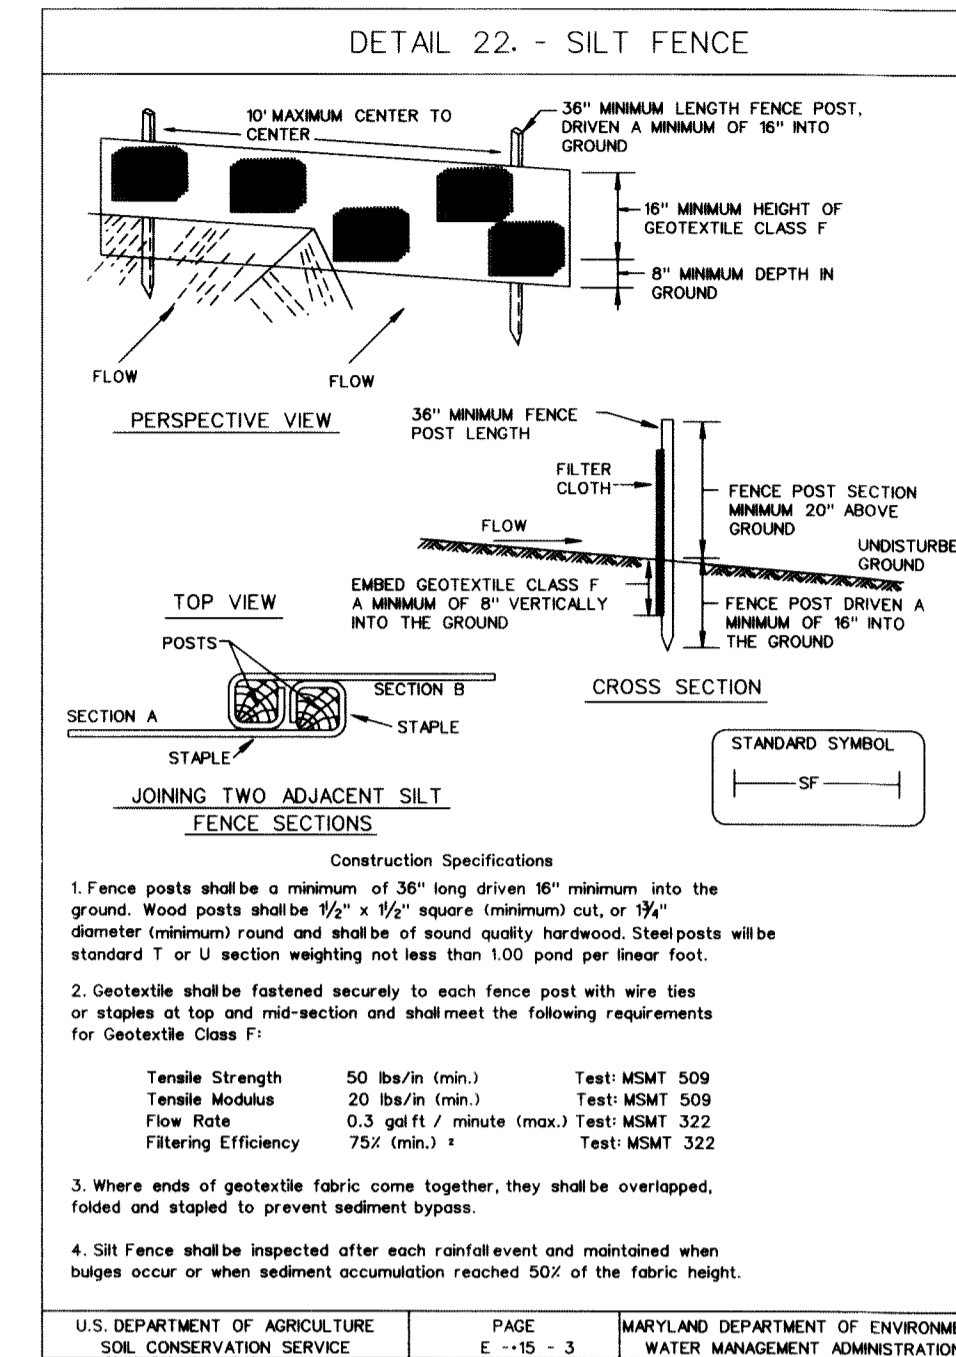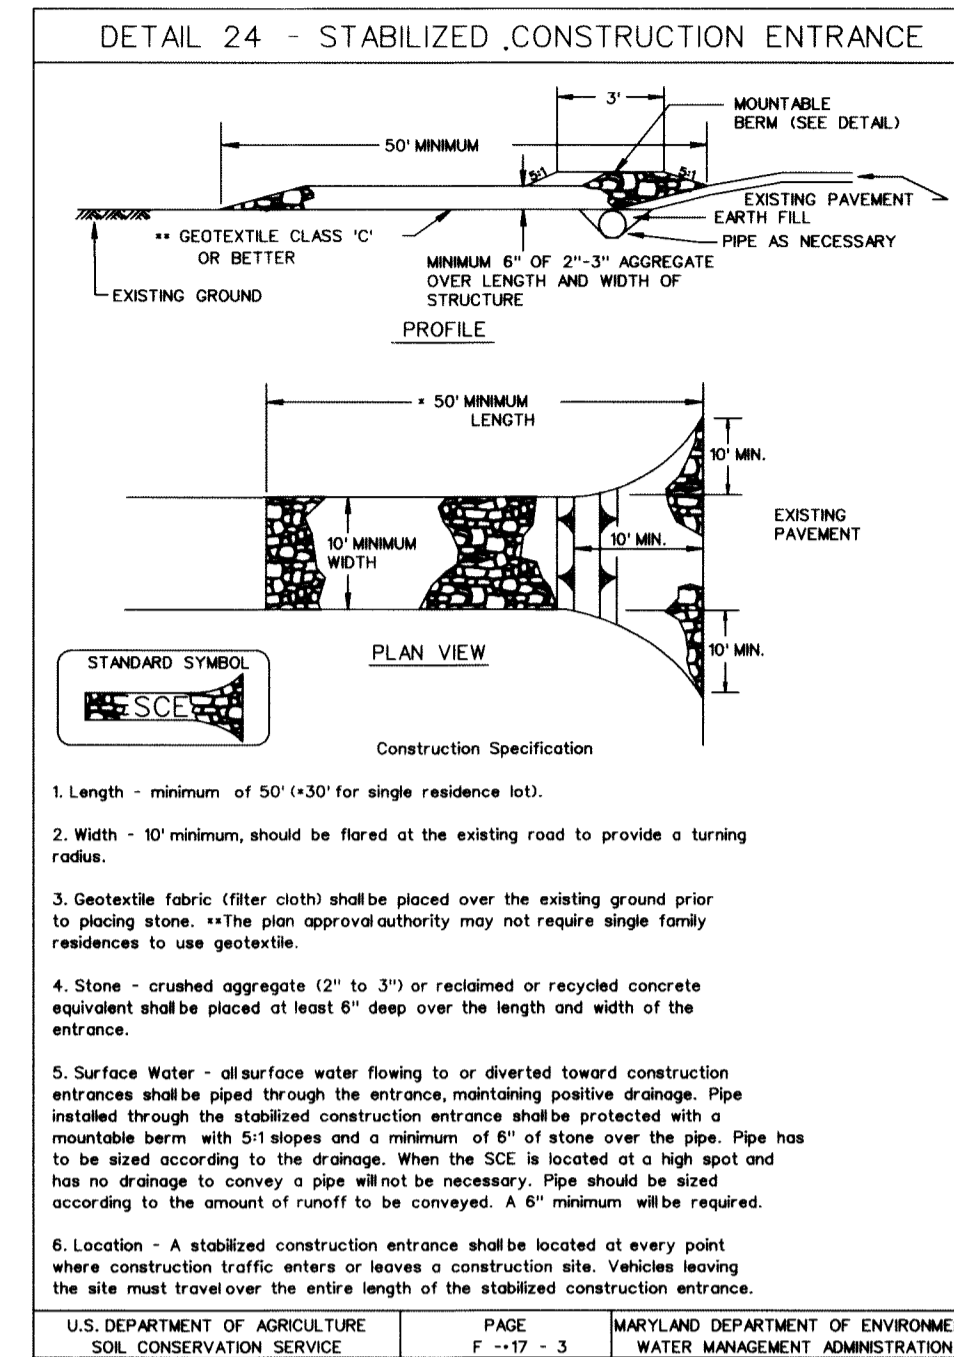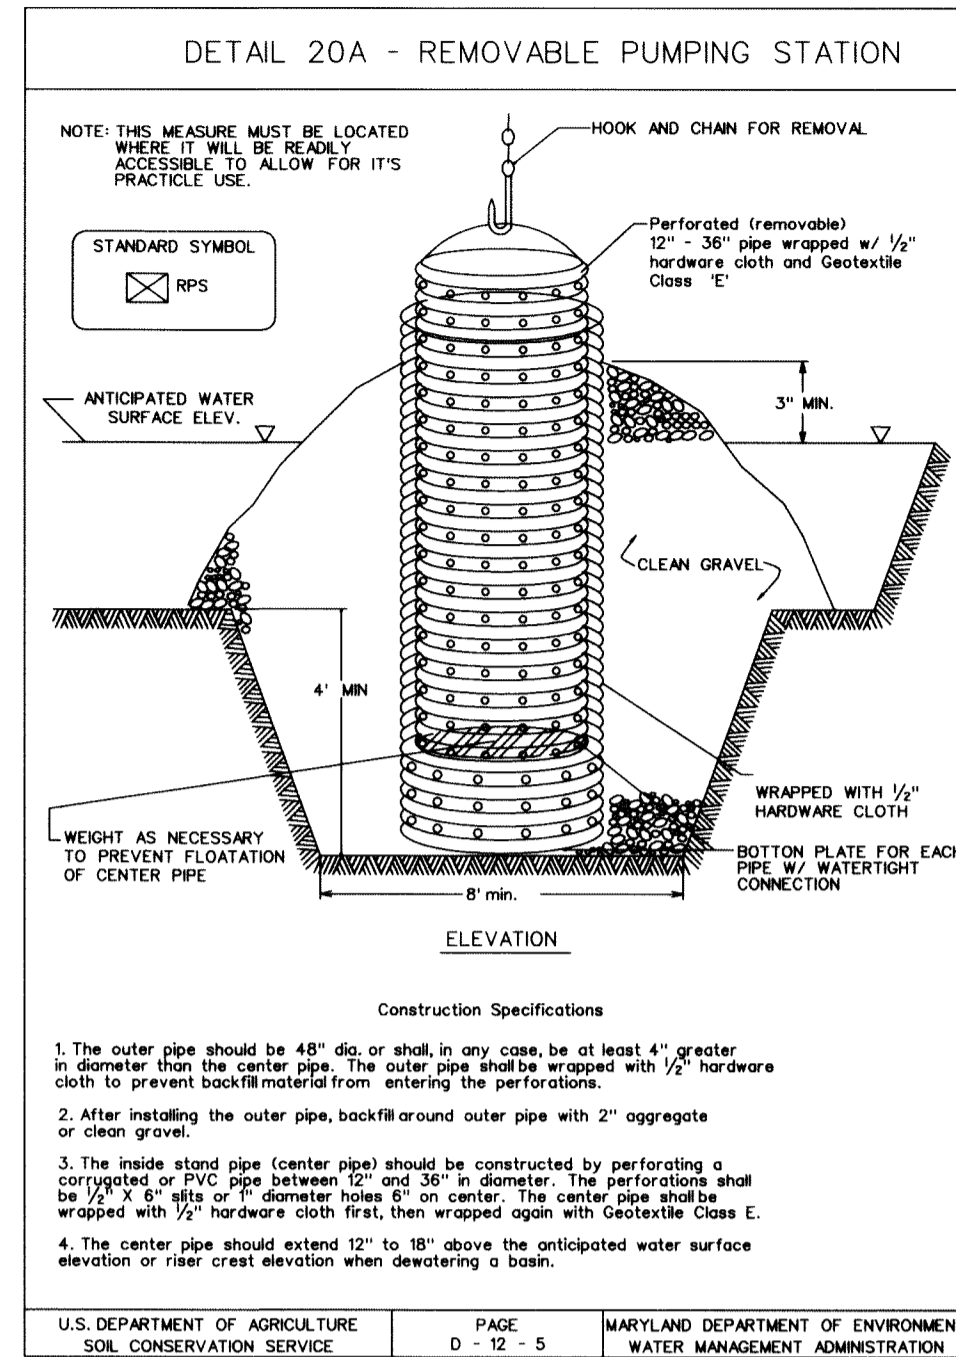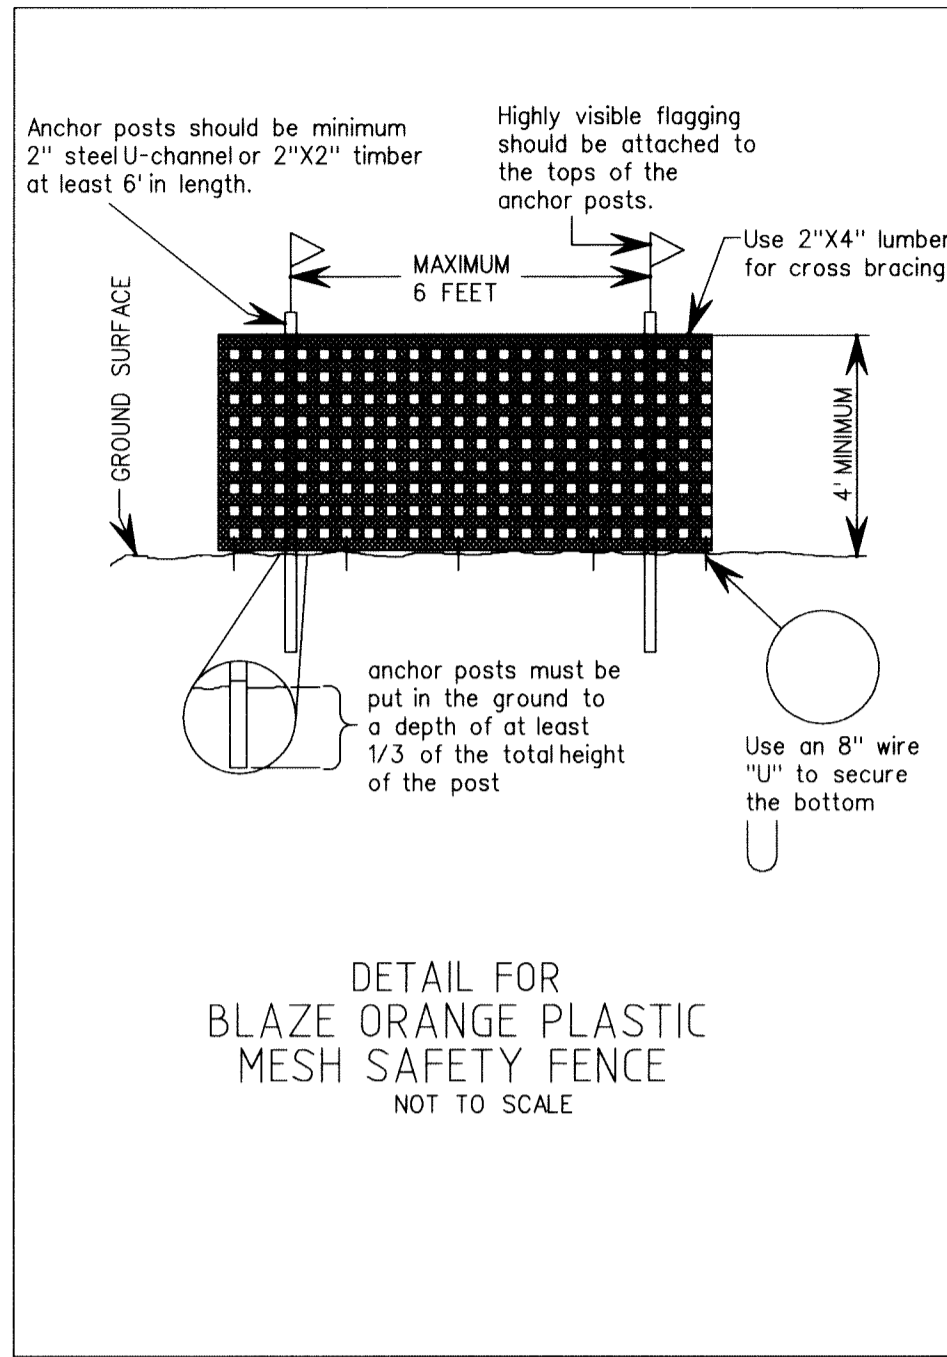

DATE	
NO.	
REVISIONS	
DESCRIPTION	

ENGINEERS
PLANNERS
SCIENTISTS
CONSTRUCTION MANAGERS

KCI TECHNOLOGIES
www.kci.com

COLUMBIA GATEWAY STORM WATER MANAGEMENT DAM
HOWARD COUNTY, MARYLAND
DEPARTMENT OF PUBLIC WORKS
6951 COLUMBIA GATEWAY DRIVE
COLUMBIA, MD 21046

SCALE: NTS
DATE: 12/14/2007
KCIJOB NO.: 01-0432320
DESIGNED BY: KBA
DRAWN BY: MPP
CHECKED BY: KBA
SHEET NO: 7 OF 8

NO.	REVISIONS DESCRIPTION	DATE

TEMPORARY VEGETATIVE STABILIZATION

A) SEEDBED PREPARATION:
LOOSEN UPPER THREE INCHES BY DISCING, RAKING OR OTHER ACCEPTABLE MEANS.

B) SOIL AMENDMENTS:
APPLY 600 LBS PER ACRE OF 10-10-10 FERTILIZER AND TWO TONS PER ACRE OF LIME.

C) SEEDING: *
FOR PERIODS OF MARCH 1 TO APRIL 30 AND AUGUST 15 TO NOVEMBER 15, SEED WITH 2.5 BU PER ACRE OF CEREAL RYE PLUS 30 LBS PER ACRE OF TALL FESCUE OR 5 LBS PER ACRE OF REDTOP OR 20 LBS PER ACRE OF PERENNIAL RYEGRASS.
FOR PERIOD OF MAY 1 TO AUGUST 14, SEED WITH 3 LBS PER ACRE OF WEEPING LOVEGRASS OR 40 LBS PER ACRE OF JAPANESE OR FOXTAIL MILLET.

FOR THE PERIOD OF NOVEMBER 16 TO FEBRUARY 28, PROTECT THE SITE BY APPLYING TWO TONS PER ACRE OF WELL ANCHORED STRAW MULCH AND SEED AS SOON AS POSSIBLE IN THE SPRING OR USE SOD.

D) MULCHING SPECIFICATIONS:
MULCH SHALL BE APPLIED TO ALL SEEDED AREAS IMMEDIATELY AFTER SEEDING.
APPLY 2 TONS PER ACRE OF STRAW OVER ALL SEEDED AREAS. IF A MULCH ANCHORING TOOL IS TO BE USED, THE RATE SHALL BE INCREASED TO 2.5 TONS PER ACRES.**
MULCH ANCHORING SHALL BE PERFORMED IMMEDIATELY FOLLOWING MULCH APPLICATION TO MINIMIZE LOSS BY WIND AND WATER. THE TYPE OF MULCH ANCHORING USED MUST COMPLY WITH THE 1994 MARYLAND STANDARD AND SPECIFICATIONS.

* IF OTHER SEED MIXES ARE TO BE SUBSTITUTED, THEY MUST COMPLY WITH THE 1994 MARYLAND STANDARD AND SPECIFICATIONS, CHAPTER 20, TABLE 25.
** IF A DIFFERENT TYPE OF MULCH IS TO BE USED, IT MUST COMPLY WITH THE 1994 MARYLAND STANDARD AND SPECIFICATION, CHAPTER 20.

PERMANENT VEGETATIVE STABILIZATION
ALL DISTURBED AREAS, WHICH ARE NOT TO BE PAVED, SHALL BE PERMANENTLY STABILIZED AS FOLLOWS:

A) SEEDBED PREPARATION:
LOOSEN UPPER THREE INCHES BY RAKING, DISCING, OR OTHER ACCEPTABLE MEANS AFTER SPREADING FOUR INCHES OF TOPSOIL.

B) SOIL AMENDMENTS:
APPLY 500 LBS PER ACRE OF 10-10-10 FERTILIZER AND TWO TONS PER ACRE OF LIME.

C) SEEDING: *
FOR PERIODS OF MARCH 1 TO MAY 15 AND AUGUST 15 TO OCTOBER 15, SEED WITH 125 LBS PER ACRE OF TALL FESCUE, 15 LBS PER ACRE OF PERENNIAL RYEGRASS, AND 10 LBS OF KENTUCKY BLUEGRASS.
FOR PERIOD OF MAY 16 TO AUGUST 14, SEED WITH 110 LBS PER ACRE OF TALL FESCUE AND 3 LBS PER ACRE OF WEEPING LOVEGRASS.
FOR PERIOD OF OCTOBER 16 TO FEBRUARY 28, PROTECT SITE BY: OPTIONS - 1) 2 TONS PER ACRE OF WELL ANCHORED STRAW MULCH AND SEED AS SOON AS POSSIBLE IN THE SPRING; 2) USE SOD; OR 3) SEED WITH 60 LBS PER ACRE OF TALL FESCUE AND MULCH WITH 2 TONS PER ACRE OF WELL ANCHORED STRAW.

NOTE: FOR QUICK COVER WITH TALL FESCUE, ADD 2 LBS OF SMALL GRAIN PER 1,000 SQ. FT.

D) MULCHING SPECIFICATIONS:
MULCH SHALL BE APPLIED TO ALL SEEDED AREAS IMMEDIATELY AFTER SEEDING.
APPLY 2 TONS PER ACRE OF STRAW OVER ALL SEEDED AREAS. IF A MULCH ANCHORING TOOL IS TO BE USED, THE RATE SHALL BE INCREASED TO 2.5 TONS PER ACRES.**
MULCH ANCHORING SHALL BE PERFORMED IMMEDIATELY FOLLOWING MULCH APPLICATION TO MINIMIZE LOSS BY WIND AND WATER. THE TYPE OF MULCH ANCHORING USED MUST COMPLY WITH THE 1994 MARYLAND STANDARD AND SPECIFICATIONS.

**HOWARD COUNTY CONSERVATION DISTRICT
STANDARD SEDIMENT CONTROL NOTES**

- A minimum of 48 hours notice must be given to the Howard County Department of Inspections, Licenses and Permits, Sediment Control Division prior to the start of any construction (313-1855).
- All vegetative and structural practices are to be installed according to the provisions of this plan and are to be in conformance with the most current MARYLAND STANDARDS AND SPECIFICATION FOR SOIL EROSION AND SEDIMENT CONTROL and revisions thereto.
- Following initial soil disturbance or re-disturbance, permanent or temporary stabilization shall be completed within: a) 7 calendar days for all perimeter sediment control structures, dikes, perimeter slopes and all slopes greater than 3:1, b) 14 days as to all other disturbed or graded areas on the project site.
- All sediment traps/basins shown must be fenced and warning signs posted around their perimeter in accordance with Vol 1, Chapter 12 of the HOWARD COUNTY DESIGN MANUAL, Storm Drainage.
- All disturbed areas must be stabilized within the time period specified above in accordance with the 1994 MARYLAND STANDARDS AND SPECIFICATION FOR SOIL EROSION AND SEDIMENT CONTROL for permanent seeding (Sec. 51), sod (Sec. 54), temporary seeding (Sec. 50) and mulching (Sec. 52). Temporary stabilization with mulch alone can only be done when recommended seeding dates do not allow for proper germination and establishment of grasses.
- All sediment control structures are to remain in place and are to be maintained in operative condition until permission for their removal has been obtained from the Howard County Sediment Control Inspector.
- Site Analysis:

Total Area of Site	0.60 Acres
Area Disturbed	0.10 Acres
Area to be roofed or paved	0 Acres
Area to be vegetatively stabilized	-- Acres
Total Cut	200 Cu. Yds.
Total Fill	200 Cu. Yds.
- Any sediment control practice which is disturbed by grading activity for placement of utilities must be repaired on the same day of disturbance.
- Additional sediment control must be provided, if deemed necessary by the Howard County Sediment Control Inspector.
- On all sites with disturbed areas in excess of 2 acres, approval of the inspection agency shall be requested upon completion of installation of perimeter erosion and sediment controls, but before proceeding with any other earth disturbance or grading. Other building or grading inspection approvals may not be authorized until this initial approval by the inspection agency is made.
- Trenches for the construction of utilities is limited to three pipe lengths or that which shall be back-filled and stabilized by the end of each work day, whichever is shorter.

21.0 STANDARD AND SPECIFICATIONS FOR TOPSOIL

Definition
Placement of topsoil over a prepared subsoil prior to establishment of permanent vegetation.

Purpose
To provide a suitable soil medium for vegetative growth. Soils of concern have low moisture content, low nutrient levels, low pH, materials toxic to plants, and/or unacceptable soil gradation.

Conditions Where Practice Applies

- This practice is limited to areas having 2:1 or flatter slopes where:
 - The texture of the exposed subsoil/parent material is not adequate to produce vegetative growth.
 - The soil material is so shallow that the rooting zone is not deep enough to support plants or furnish continuing supplies of moisture and plant nutrients.
 - The original soil to be vegetated contains material toxic to plant growth.
 - The soil is so acidic that treatment with limestone is not feasible.
- For the purpose of these Standards and Specifications, areas having slopes steeper than 2:1 require special consideration and design for adequate stabilization. Areas having slopes steeper than 2:1 shall have the appropriate stabilization shown on the plans.

Construction and Material Specifications

- Topsoil salvaged from the existing site may be used provided that it meets the standards as set forth in these specifications. Typically, the depth of topsoil to be salvaged for a given soil type can be found in the representative soil profile section in the Soil Survey published by USDA-SCS in cooperation with Maryland Agricultural Experimental Station.
- Topsoil Specifications - Soil to be used as topsoil must meet the following:
 - Topsoil shall be a loam, sandy loam, clay loam, silt loam, sandy clay loam, loamy sand. Other soils may be used if recommended by an agronomist or soil scientist and approved by the appropriate approval authority. Regardless, topsoil shall not be a mixture of contrasting textured subsoils and shall contain less than 5% by volume of cinders, subsoils, slag, coarse fragments, gravel, sticks, roots, trash, or other materials larger than 1 1/2" in diameter.
 - Topsoil must be free of plants or plant parts such as bermuda grass, quackgrass, Johnsongrass, nutsedge, poison ivy, thistle, or others as specified.
 - Where the subsoil is either highly acidic or composed of heavy clays, ground limestone shall be spread at the rate of 4-8 tons/acre (200-400 pounds per 1,000 square feet) prior to the placement of topsoil. Lime shall be distributed uniformly over designated areas and worked into the soil in conjunction with tillage operations as described in the following procedures.


- For sites having disturbed areas under 5 acres:
 - Place topsoil (if required) and apply soil amendments as specified in 20.0 Vegetative Stabilization - Section - - Vegetative Stabilization Methods and Materials.
- For sites having disturbed areas over 5 acres:
 - On soil meeting Topsoil specifications, obtain test results dictating fertilizer and lime amendments required to bring the soil into compliance with the following:
 - pH for topsoil shall be between 6.0 and 7.5. If the tested soil demonstrates a pH of less than 6.0, sufficient lime shall be prescribed to raise the pH to 6.5 or higher.
 - Organic content of topsoil shall be not less than 1.5 percent by weight.
 - Topsoil having soluble salt content greater than 500 parts per million shall not be used.
 - No sod or seed shall be placed on soil which has been treated with soil sterilants or chemicals used for weed control until sufficient time as elapsed (14 days min.) to permit dissipation of phyto-toxic materials.

Note: Topsoil substitutes or amendments, as recommended by a qualified agronomist or soil scientist and approved by the appropriate approval authority, may be used in lieu of natural topsoil.

- Place topsoil (if required) and apply soil amendments as specified in 20.0 Vegetative Stabilization - Section - -

V. Topsoil Application

- When topsoiling, maintain needed erosion and sediment control practices such as diversions, Grade Stabilization Structures, Earth Dikes, Slope Silt Fence and Sediment Traps and Basins.
- Grades on the areas to be topsoiled, which have been previously established, shall be maintained, albeit 4" - 8" higher in elevation.
- Topsoil shall be uniformly distributed in a 4" - 8" layer and lightly compacted to a minimum thickness of 4". Spreading shall be performed in such a manner that sodding or seeding can proceed with a minimum of additional soil preparation and tillage. Any irregularities in the surface resulting from topsoiling or other operations shall be corrected in order to prevent the formation of depressions or water pockets.
- Topsoil shall not be placed while the topsoil or subsoil is in a frozen or muddy condition, when the subsoil is excessively wet or in a condition that may otherwise be detrimental to proper grading and seedbed preparation.

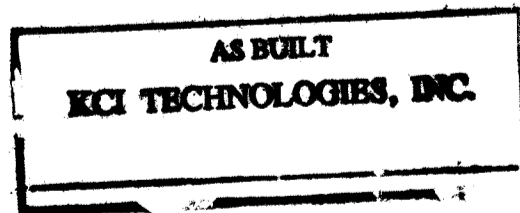

KCI TECHNOLOGIES
www.kci.com

**ENGINEERS
PLANNERS
SCIENTISTS
CONSTRUCTION MANAGERS**

EROSION AND SEDIMENT CONTROL NOTES

**COLUMBIA GATEWAY
STORM WATER
MANAGEMENT DAM**
HOWARD COUNTY, MARYLAND

DEPARTMENT OF PUBLIC WORKS
STORM WATER MANAGEMENT DIVISION
675 COLUMBIA AVE. 21046

**AS BUILT
KCI TECHNOLOGIES, INC.**

STATE OF MARYLAND
OFFICE OF PROFESSIONAL ENGINEERS
NO. 33712
PROFESSIONAL ENGINEER
[Signature]

SCALE:	NTS
DATE:	12/14/2007
KCI JOB NO.:	01-04322320
DESIGNED BY:	KBA
DRAWN BY:	MPP
CHECKED BY:	KBA
SHEET NO.:	8 OF 8