



**EMBANKMENT CENTERLINE CROSS SECTION A-A**  
SCALE: HOR. 1" = 10'  
VERT. 1" = 2'

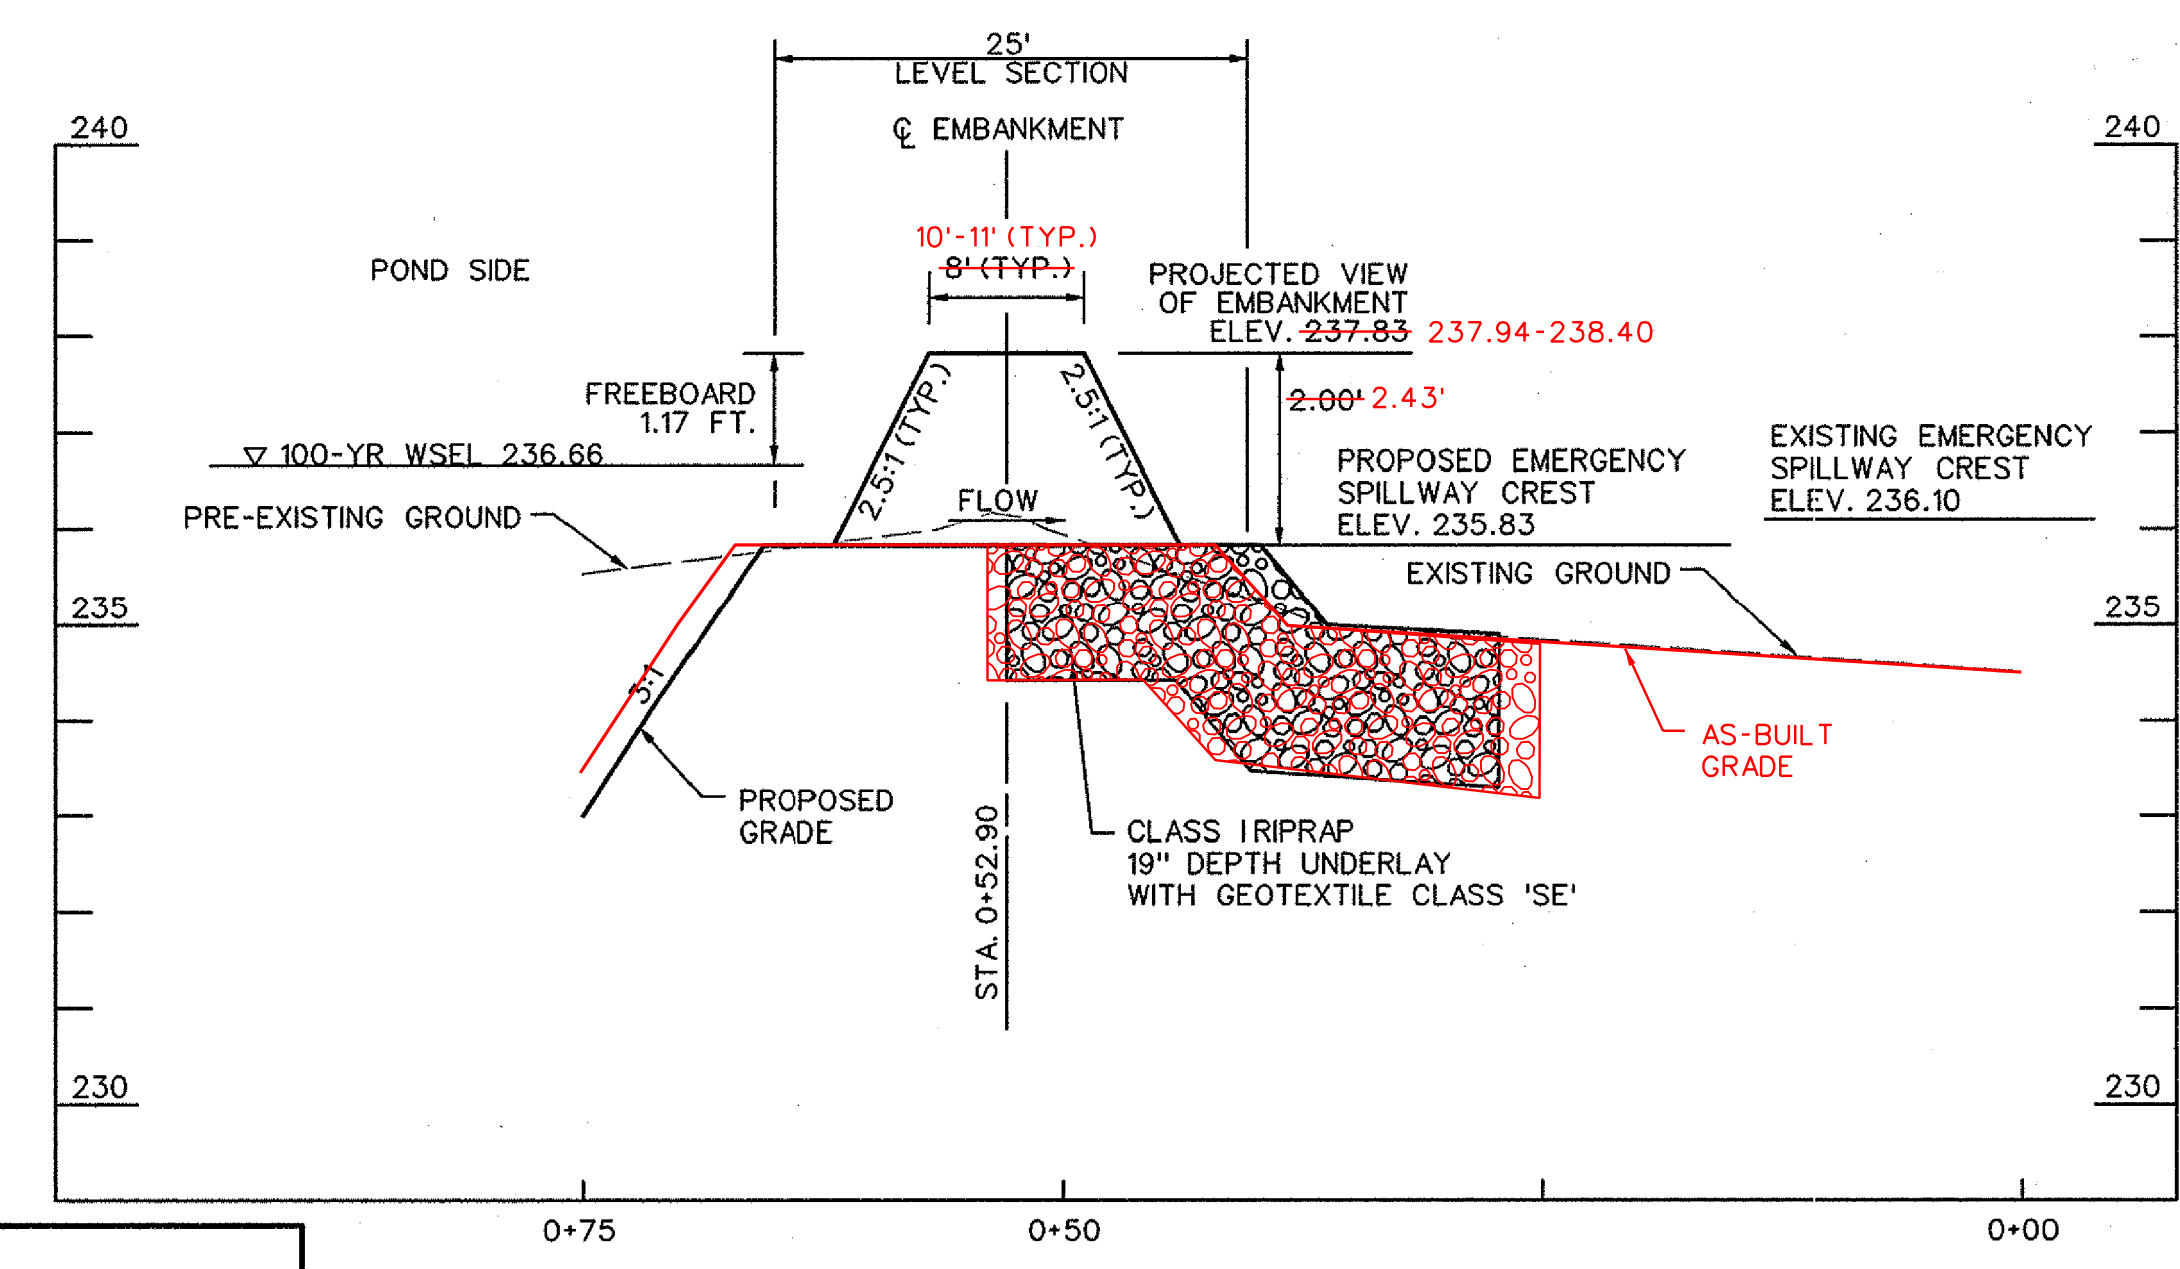

**EMERGENCY SPILLWAY PROFILE C-C**  
SCALE: HOR. 1" = 10'  
VERT. 1" = 2'

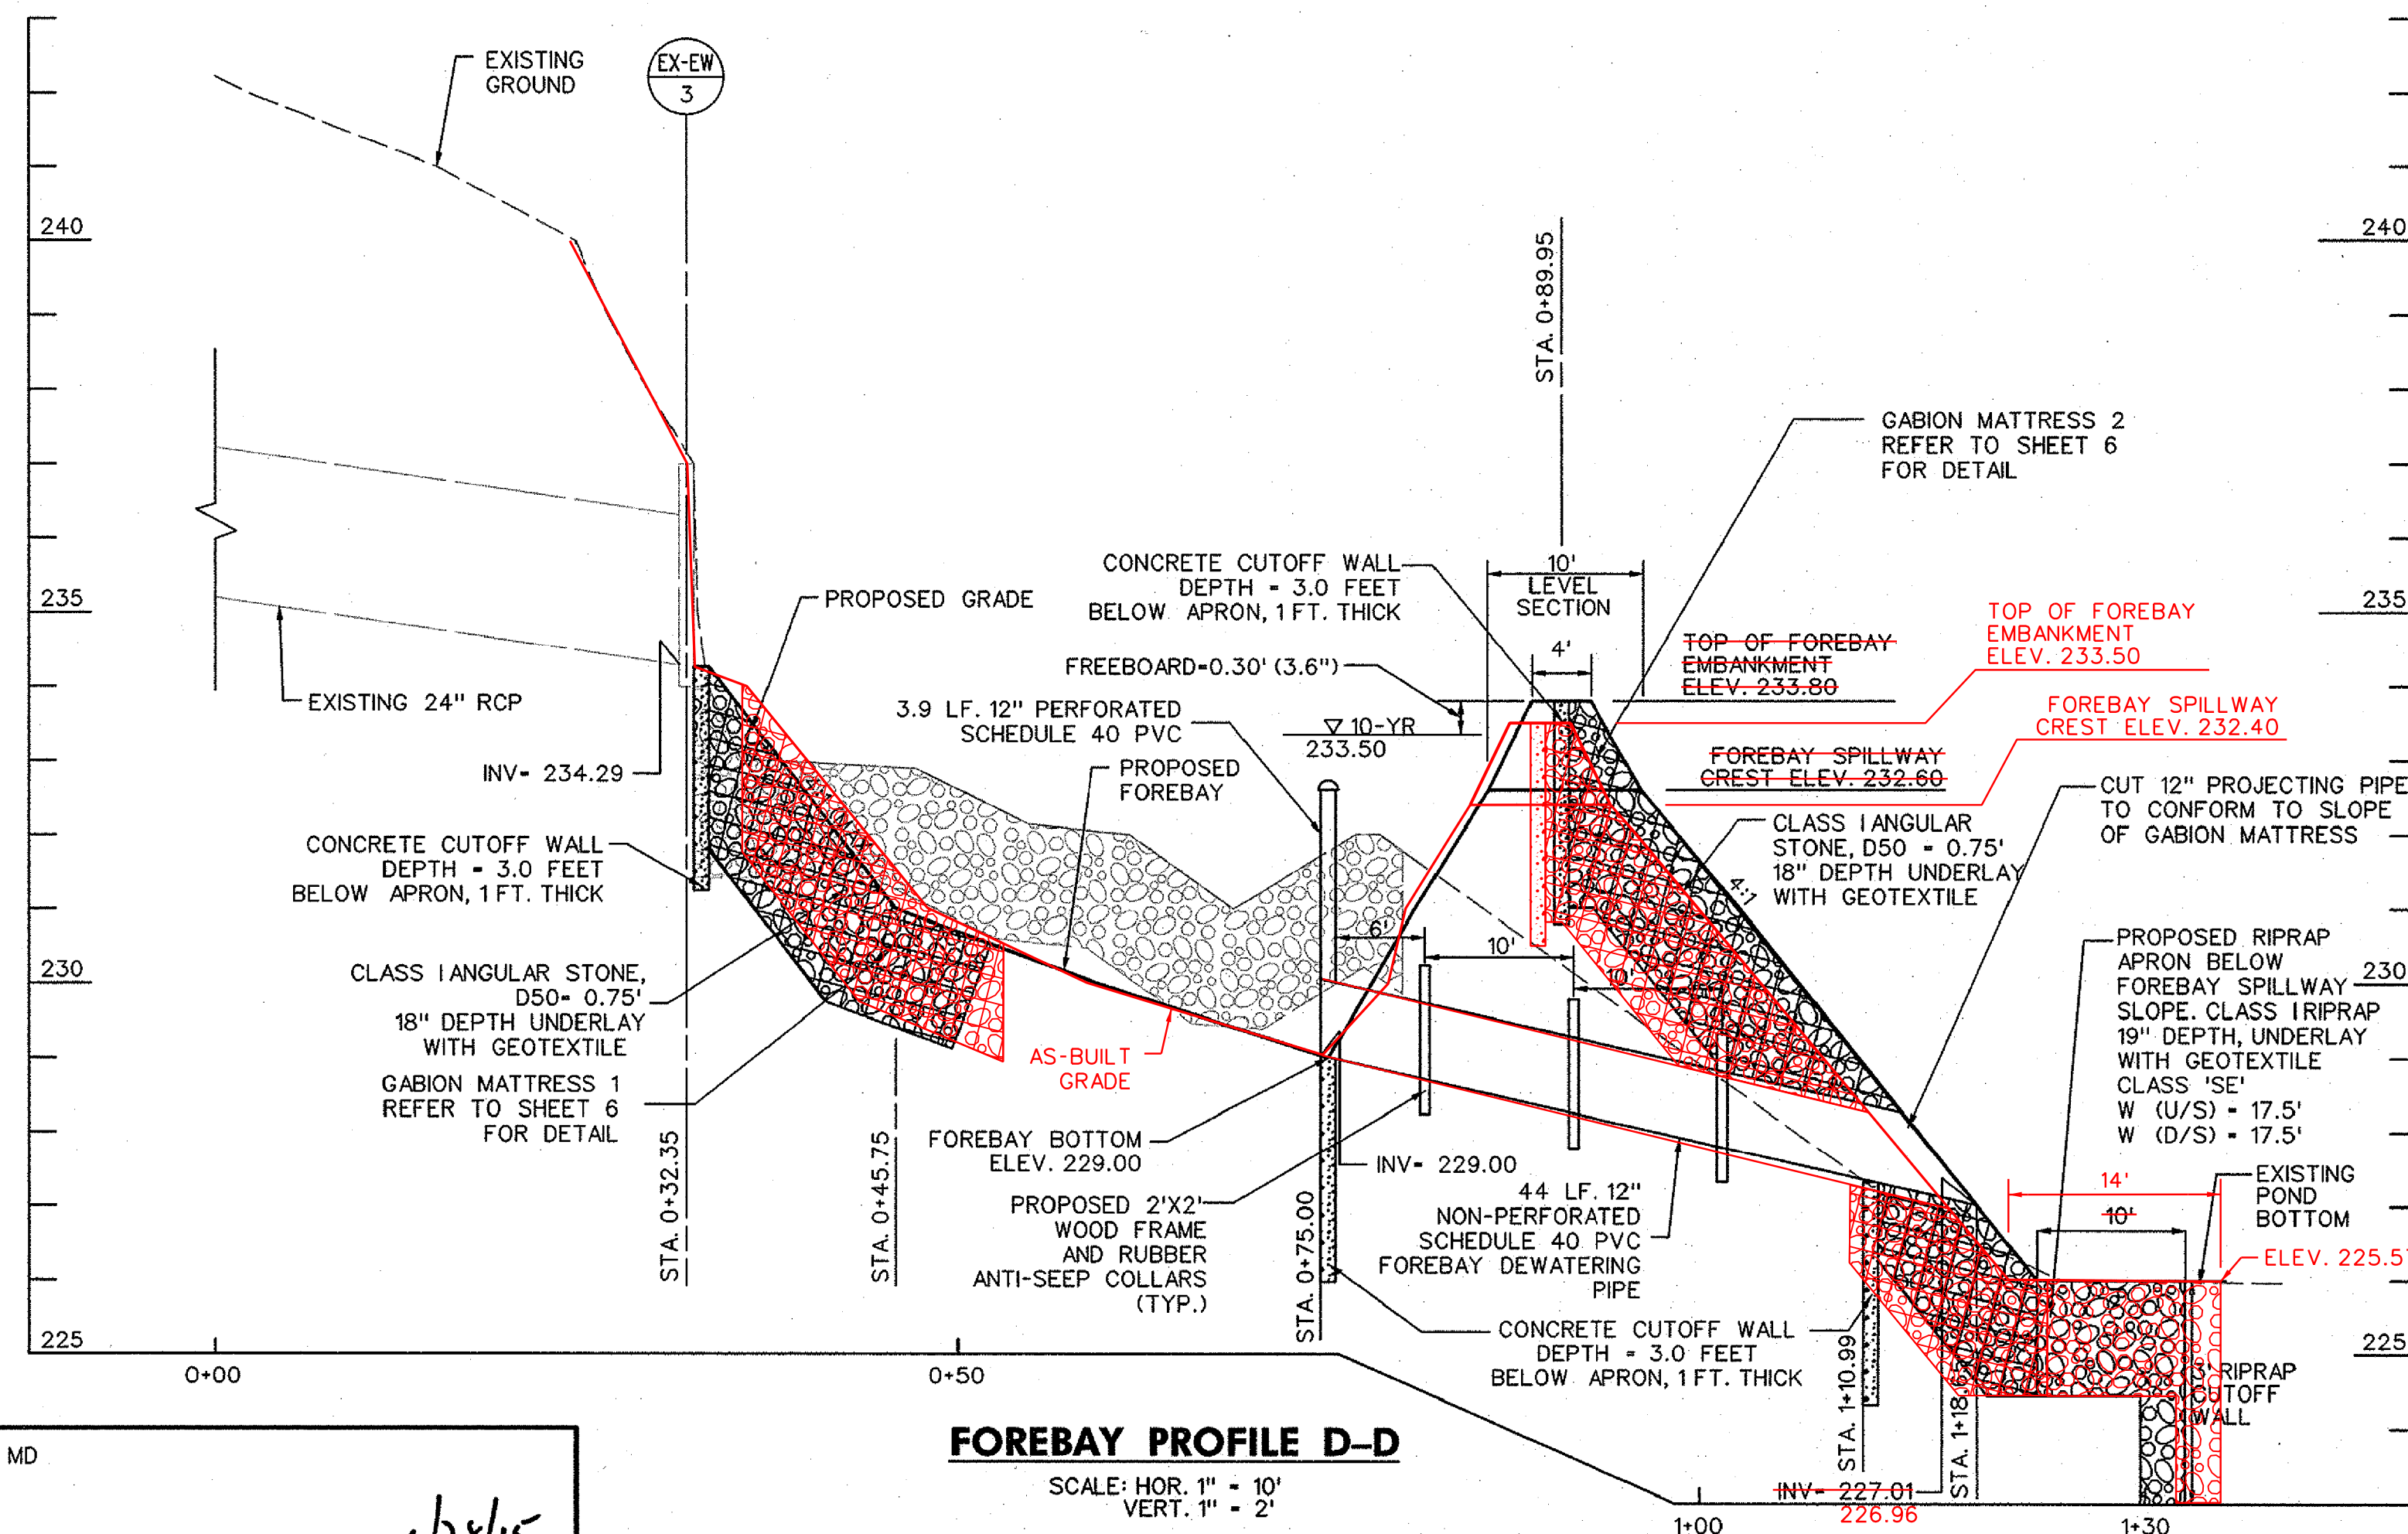

**FOREBAY PROFILE D-D**  
SCALE: HOR. 1" = 10'  
VERT. 1" = 2'

NO.	REVISIONS DESCRIPTION	DATE

936 RIDGEBROOK ROAD  
SPARKS, MARYLAND 21152  
TELEPHONE: (410) 316-7800  
FAX: (410) 316-7818  
WWW.KCI.COM



**NORTHGATE WOODS STORMWATER POND REPAIR**  
CAPITAL PROJECT D-1159  
HOWARD COUNTY DEPARTMENT OF PUBLIC WORKS  
STORMWATER MANAGEMENT DIVISION  
6751 COLUMBIA GATEWAY DRIVE  
COLUMBIA, MD 21046

**STORMWATER MANAGEMENT PROFILES AS-BUILT**

SCALE:	AS SHOWN
DATE:	APRIL 2014
KCI JOB NO.:	17133314.01
CAPITAL PROJECT NO.:	D-1159
PERMIT ISSUE:	
CONSTRUCTION ISSUE:	



PROFESSIONAL CERTIFICATION. I HEREBY CERTIFY THAT THESE DOCUMENTS WERE PREPARED OR APPROVED BY ME, RAYMOND J. KRAHE, PE, AND THAT I AM A DULY LICENSED PROFESSIONAL ENGINEER UNDER THE LAWS OF THE STATE OF MARYLAND, LICENSE NO. 28634. EXPIRATION DATE: 2015-03-26 2017-03-26

THIS DEVELOPMENT IS APPROVED FOR SOIL EROSION AND SEDIMENT CONTROL BY THE HOWARD SOIL CONSERVATION DISTRICT.  
*John R. Rolsten*  
DATE: 12/19/14

DEPARTMENT OF PUBLIC WORKS, HOWARD COUNTY, MD  
CHIEF, BUREAU OF ENVIRONMENTAL SERVICES  
*[Signature]*  
DATE: 1/28/15

AS-BUILT 12-01-2015





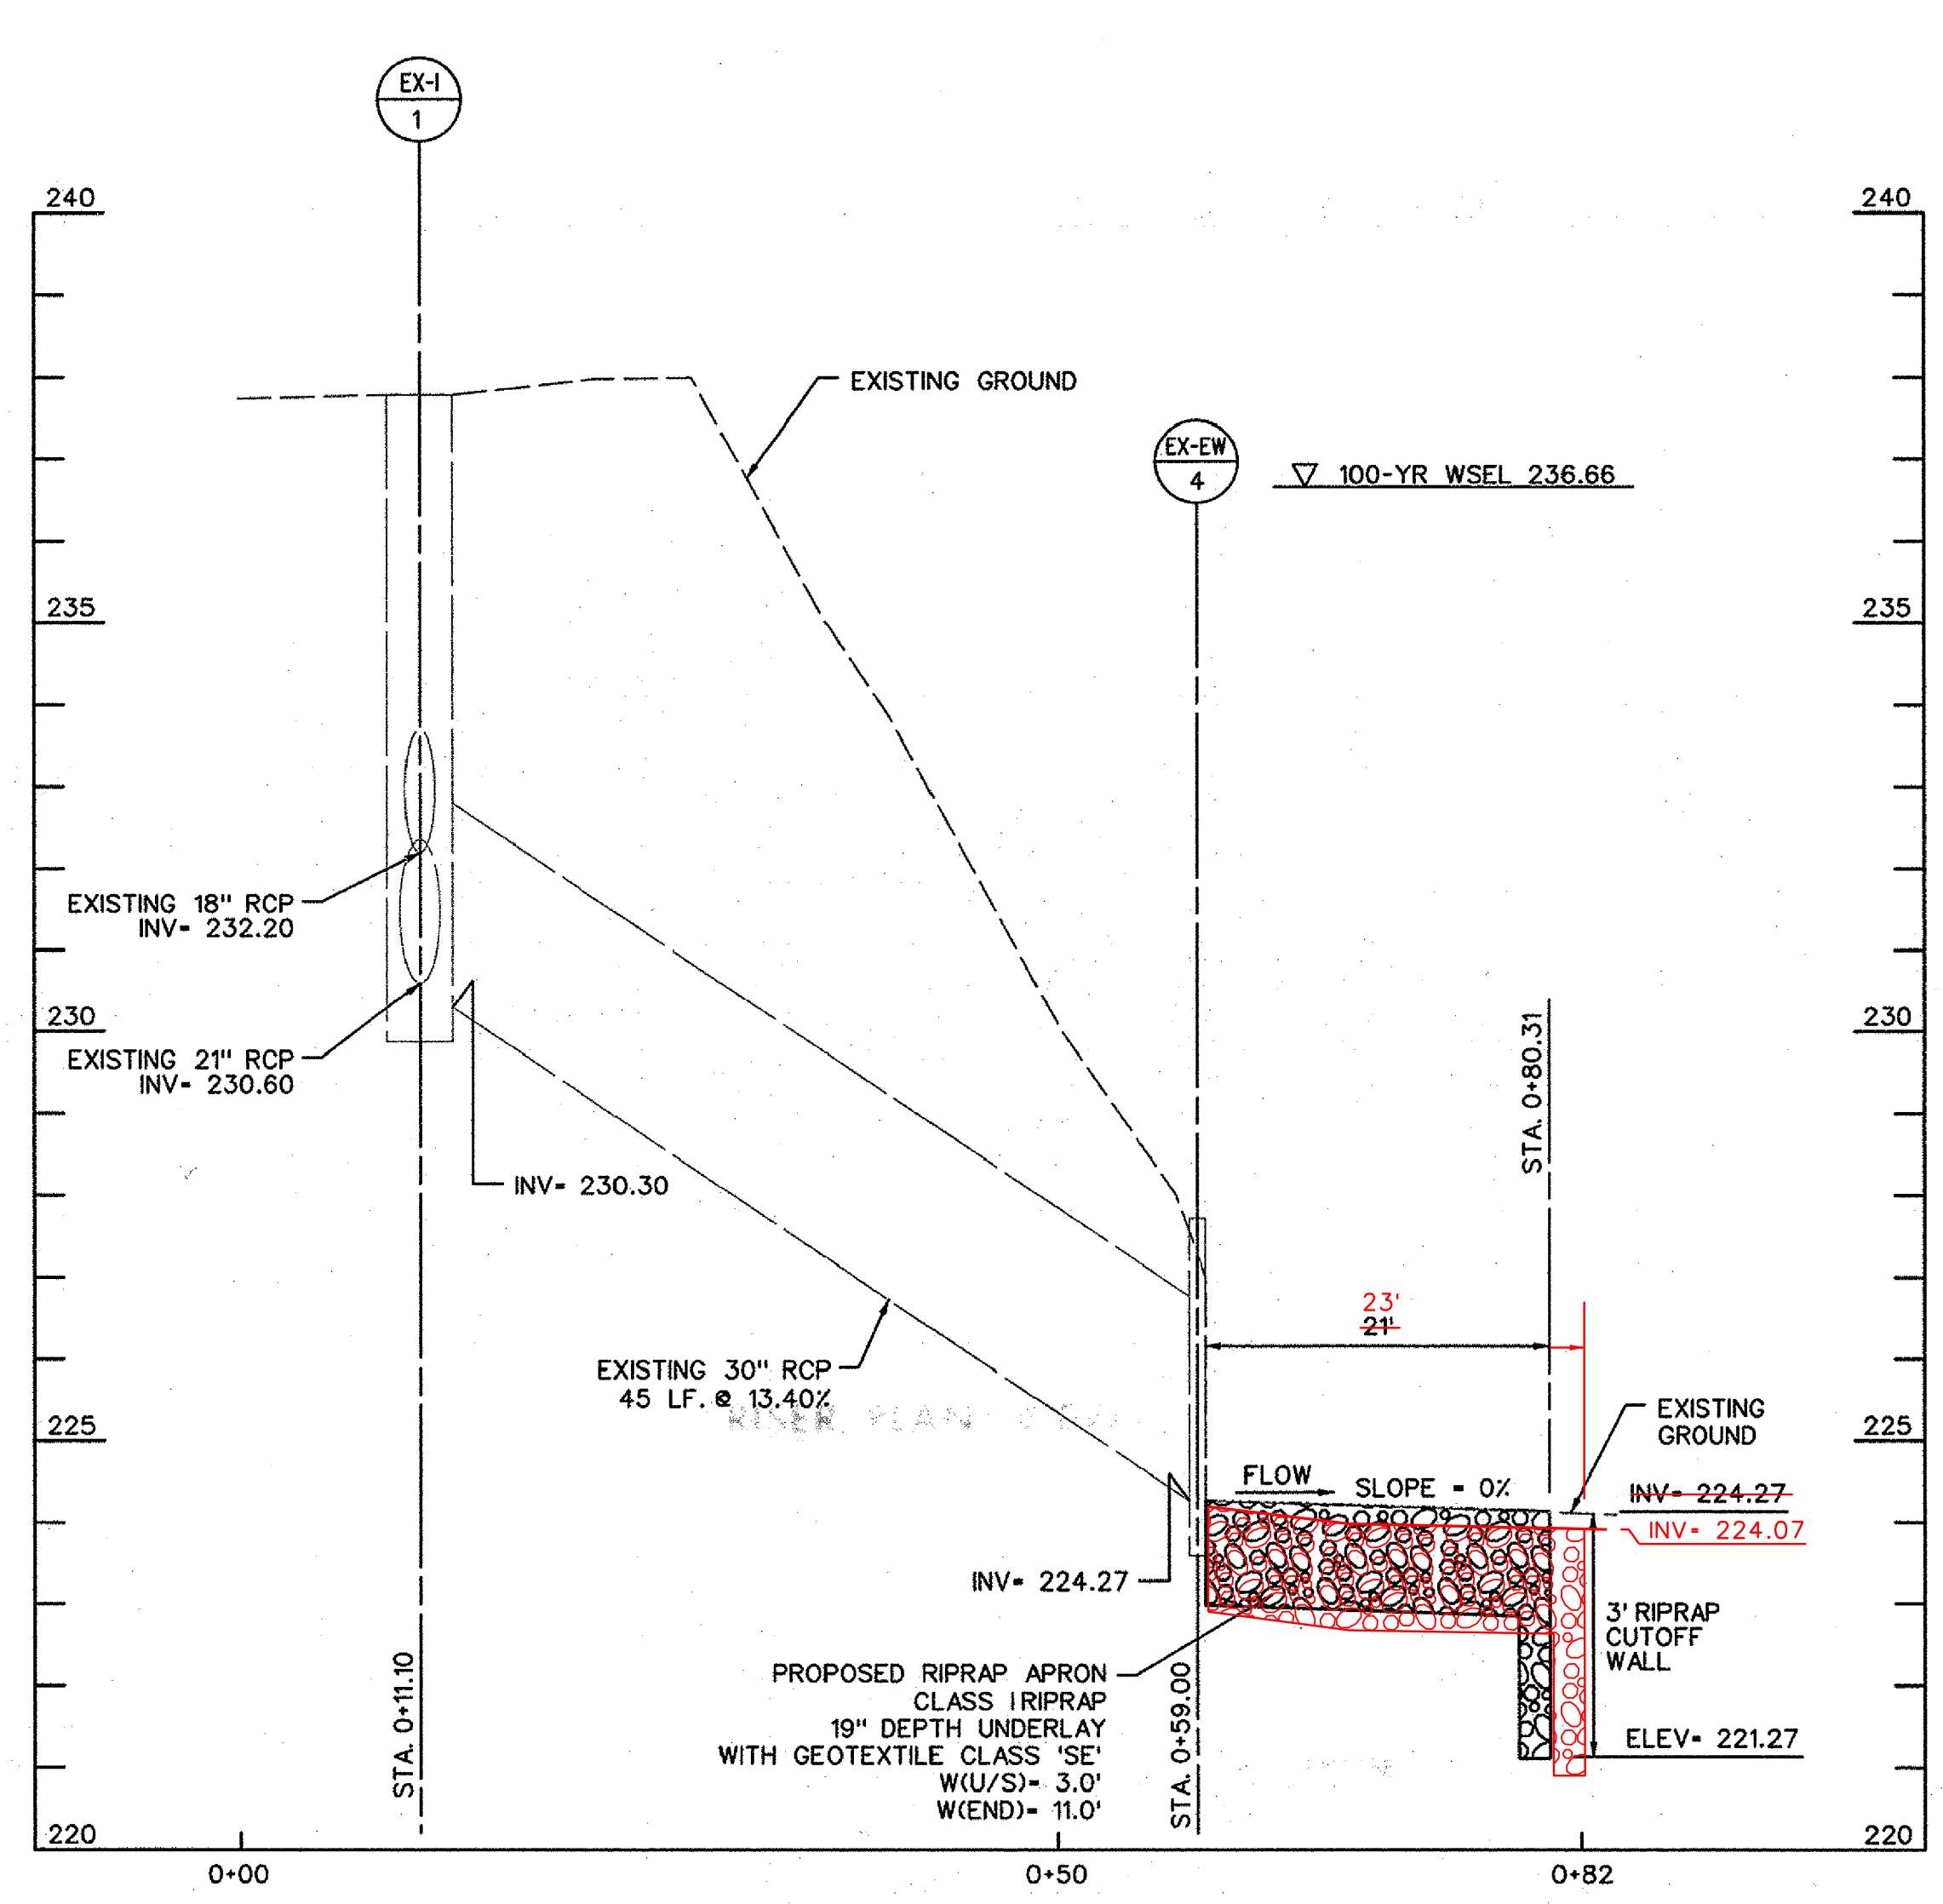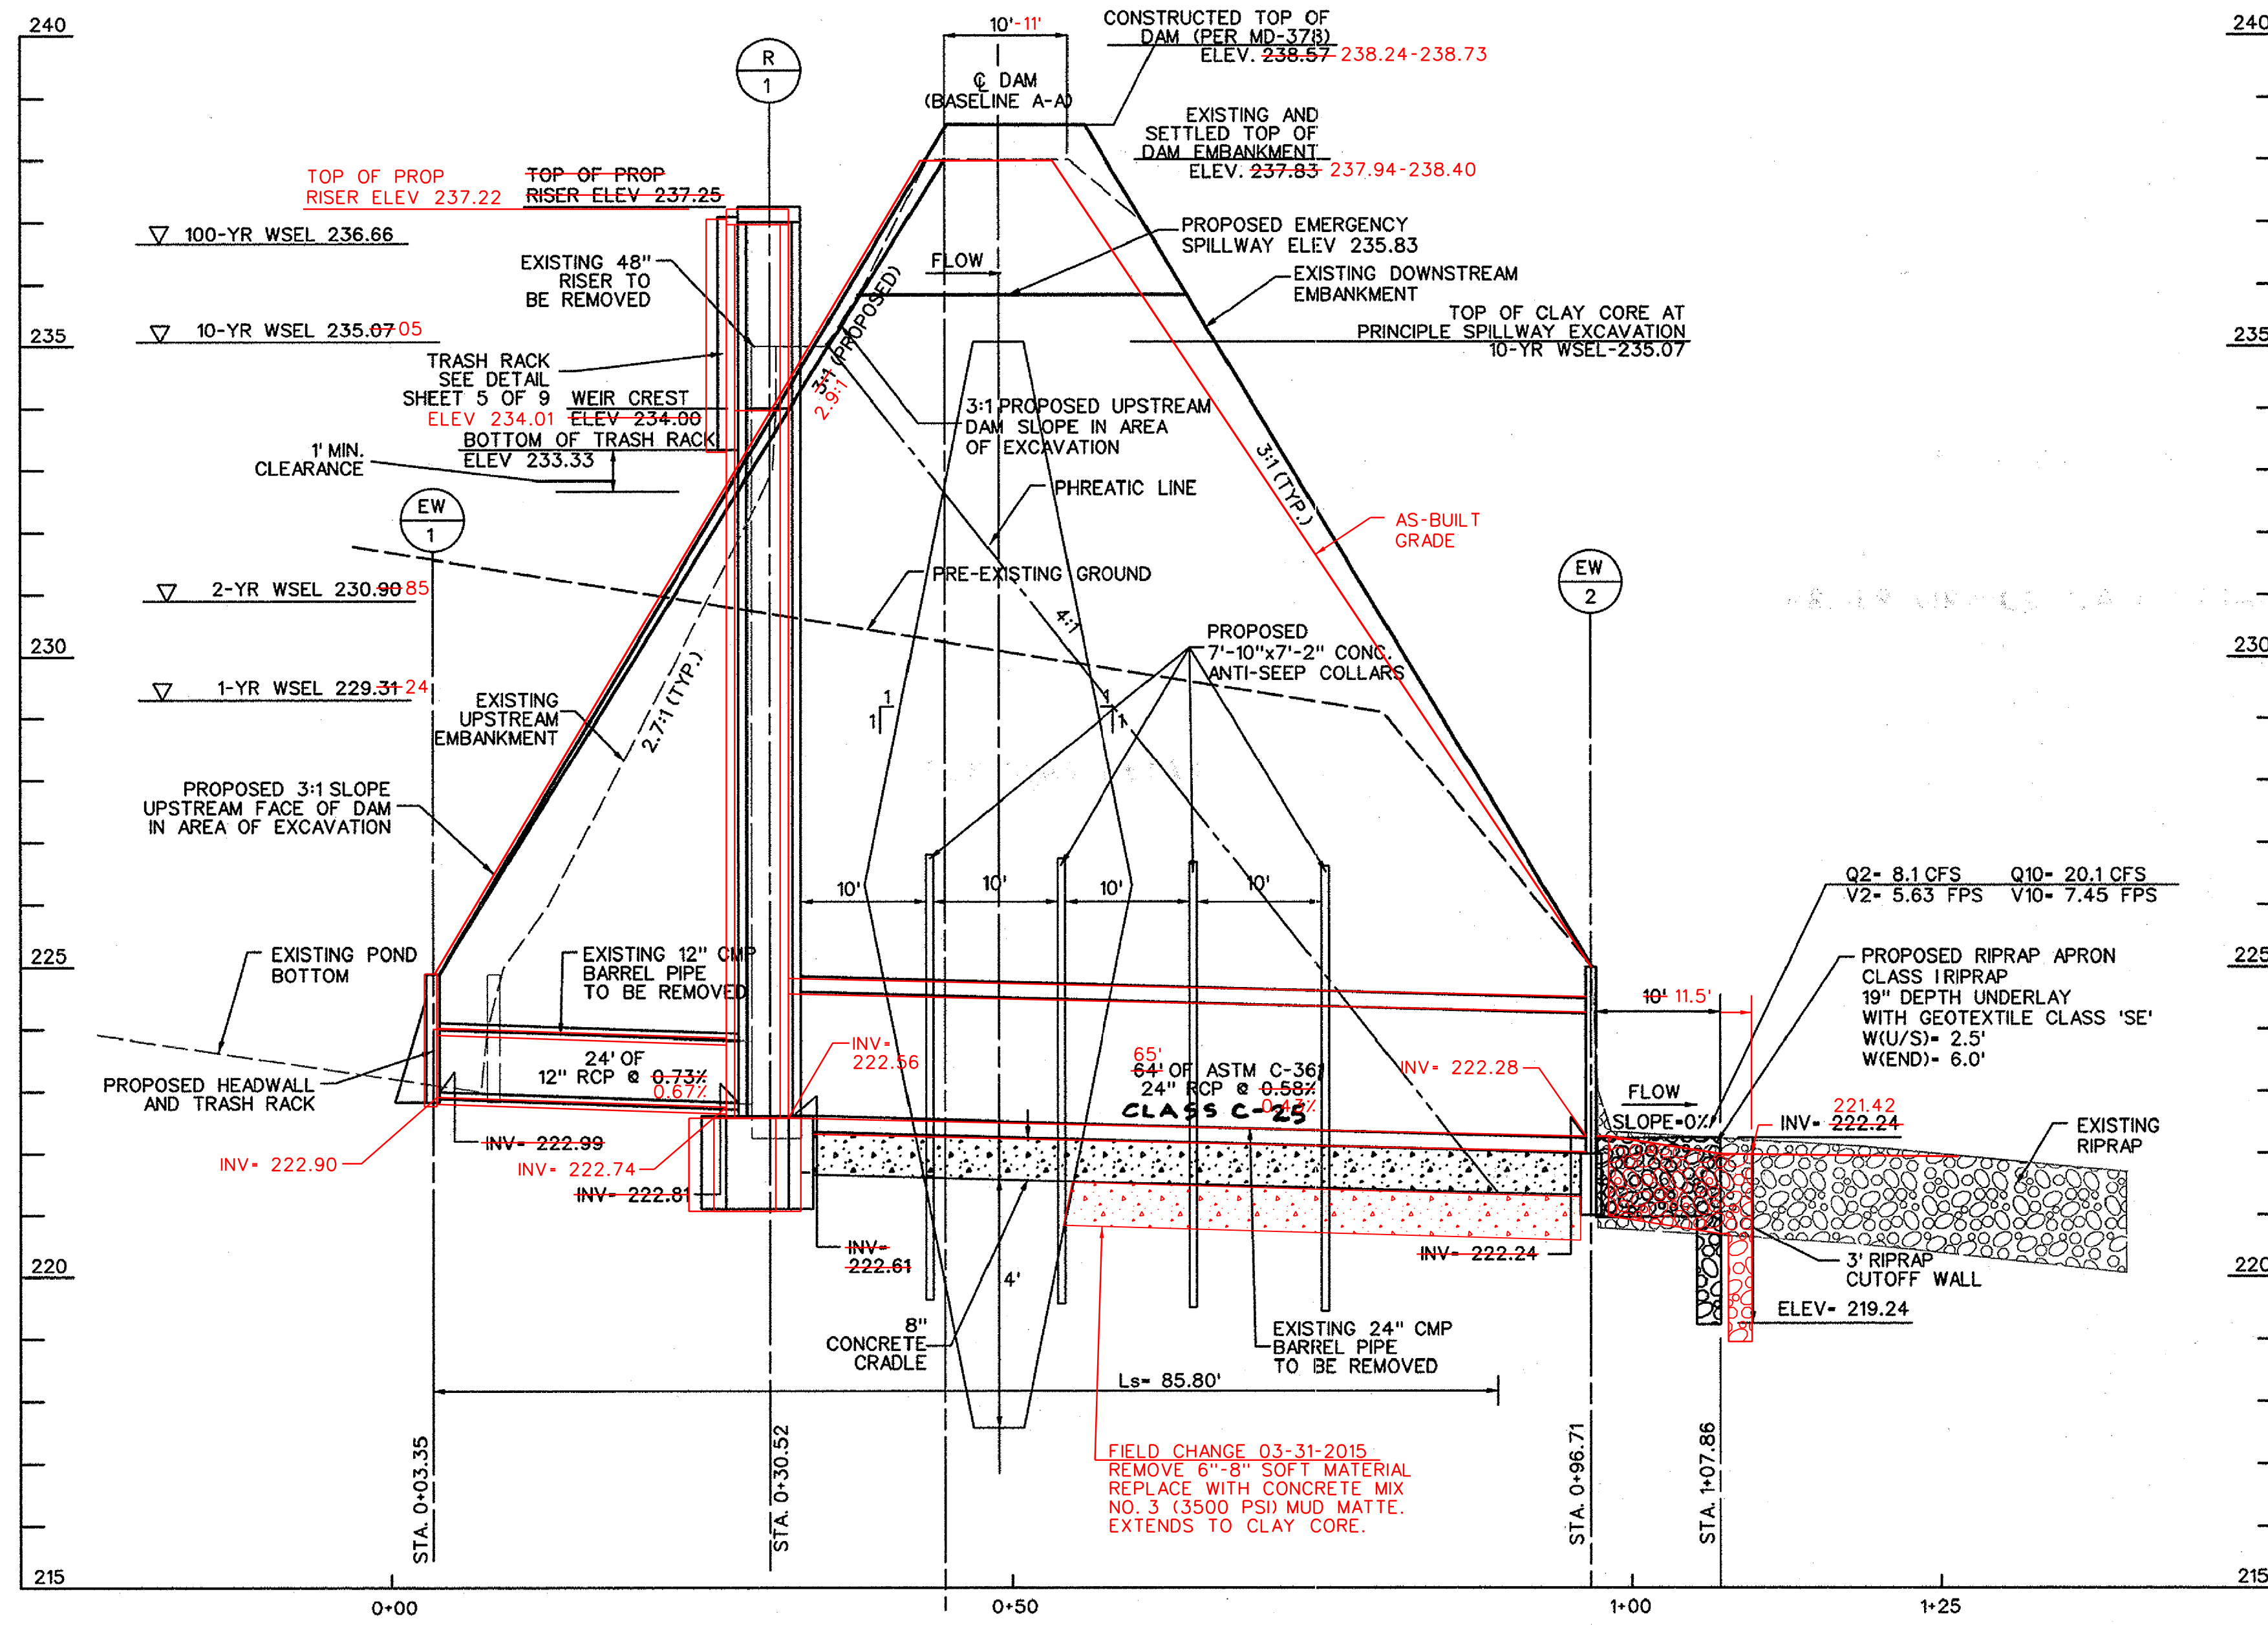

	DISCHARGE (CFS)	STORAGE (AC-FT) VOLUME	WATER SURFACE ELEVATION (FT)
1-YEAR	7.1	0.486 0.614	229.31-24
2-YEAR	8.1 8.0	0.774 0.937	230.00-85
10-YEAR	20.1 19.7	1.905 1.924	235.07-05
100-YEAR	73.3 74.1	2.497 2.530	236.66

ID	STANDARD	TOP ELEV.	INVERT IN	INVERT OUT
EW-1	TYPE 'C' ENDWALL D-5.21	224.73 224.71	222.90 222.99	222.90 222.99
R-1	CONCRETE RISER	237.22 237.25	222.74 222.81	222.56 222.61
EW-2	TYPE 'C' ENDWALL D-5.21	225.18 224.99	222.28 222.24	222.28 222.24

FROM	TO	SIZE	TYPE	INVERT IN	INVERT OUT	LENGTH
EW-1	R-1	12	ASTM 361 C-25	222.99	222.81	24.0'
R-1	EW-1	24	ASTM 361 C-25	222.61	222.24	65.0' @ 4.0'
				222.56	222.28	

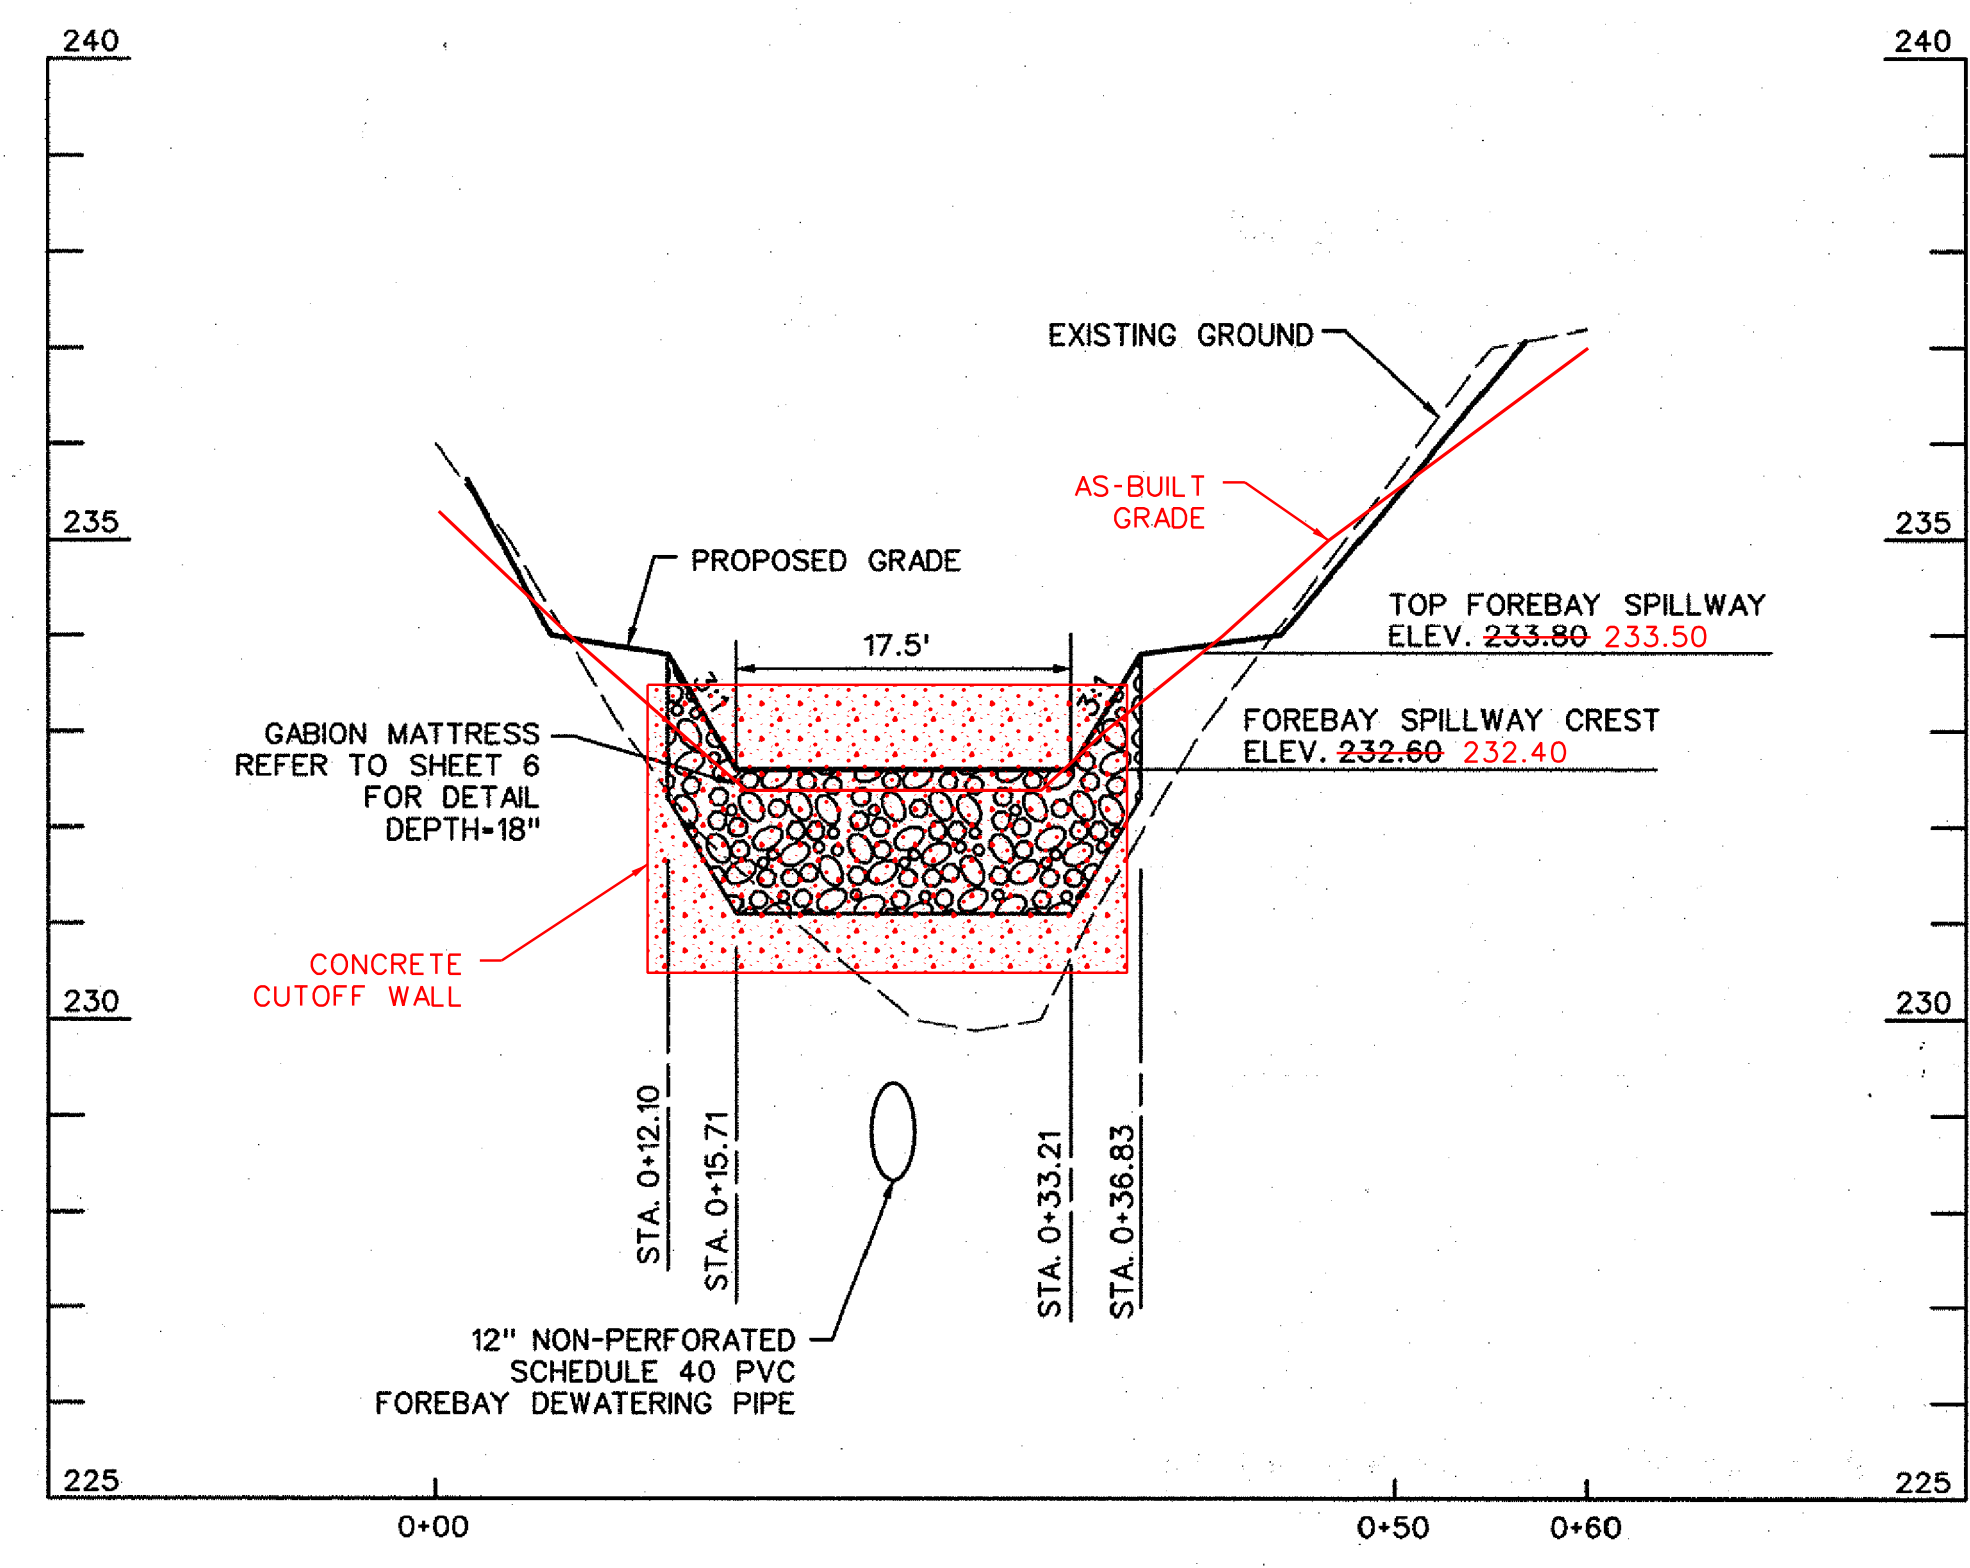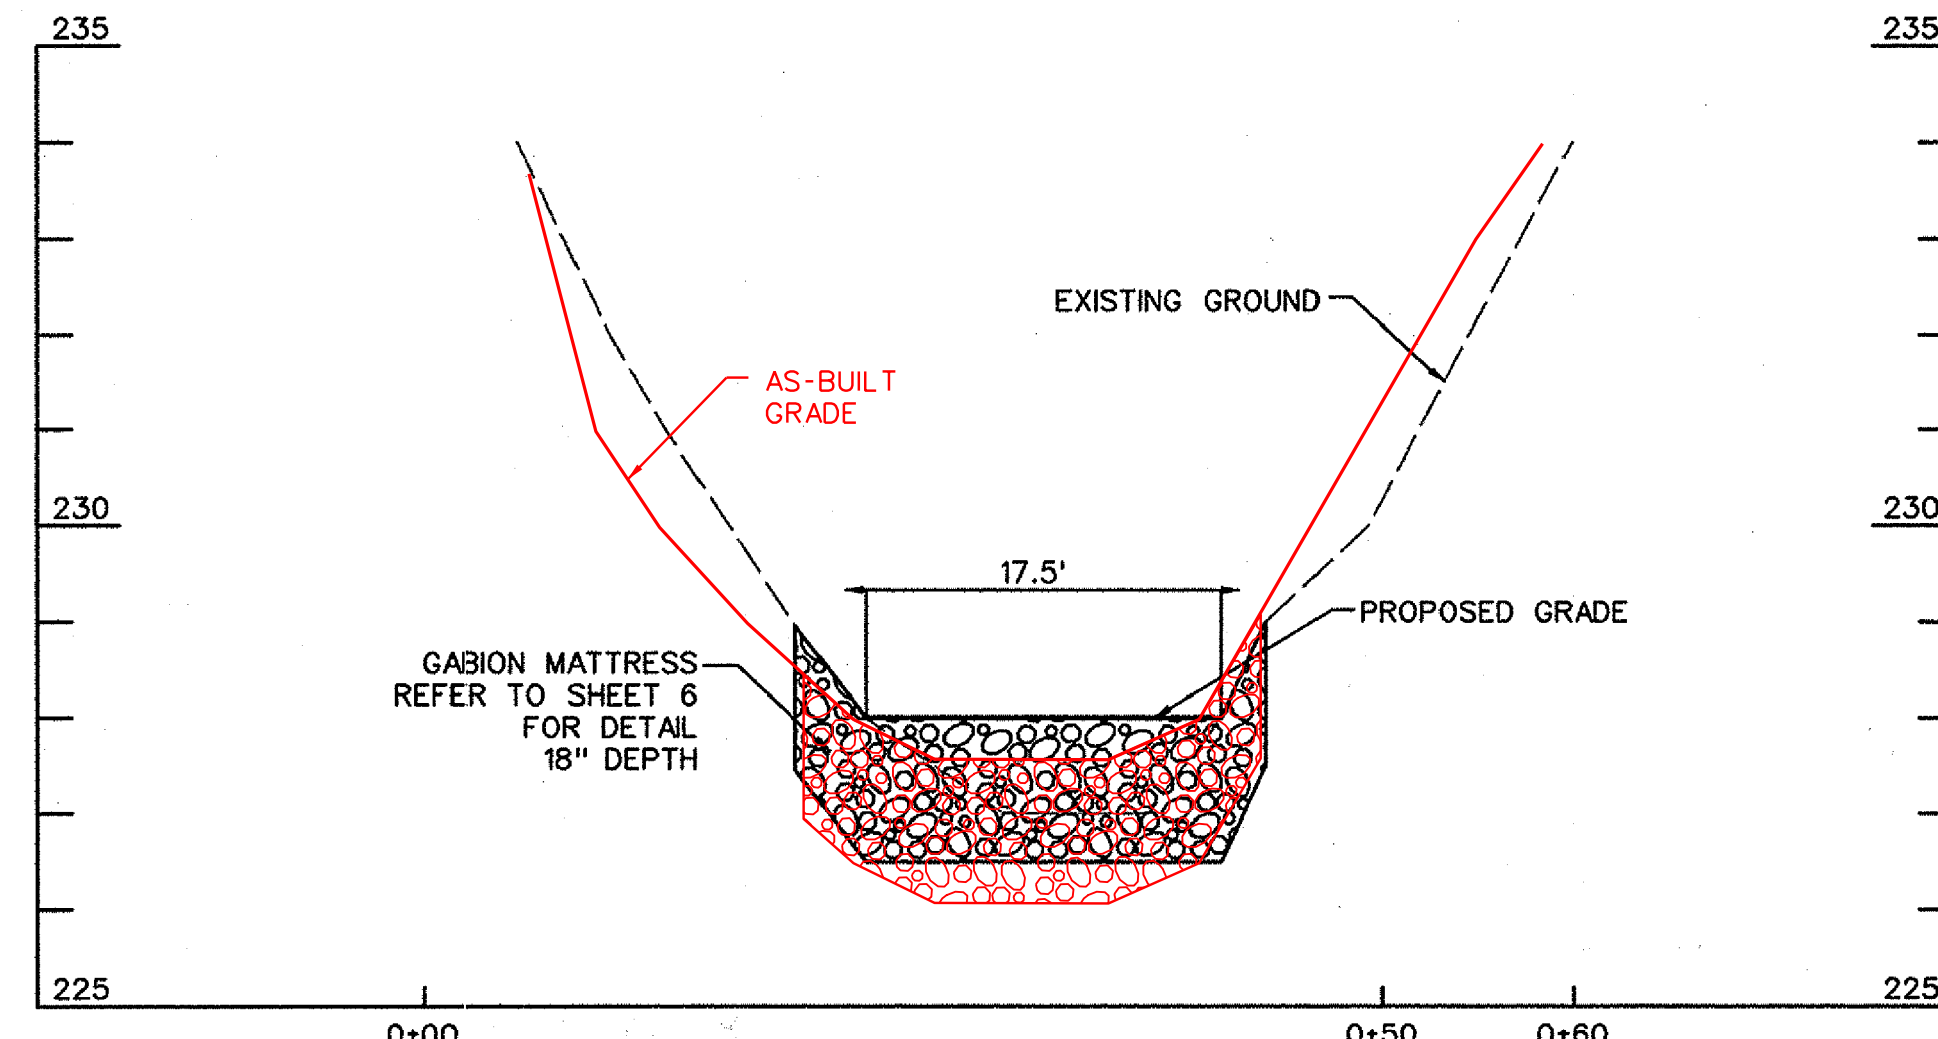

PROFESSIONAL CERTIFICATION, I HEREBY CERTIFY THAT THESE DOCUMENTS WERE PREPARED OR APPROVED BY ME, RAYMOND J. KRAHE, PE, AND THAT I AM A DULY LICENSED PROFESSIONAL ENGINEER UNDER THE LAWS OF THE STATE OF MARYLAND, LICENSE NO. 28634. EXPIRATION DATE: 2015-03-26 2017-03-26

THIS DEVELOPMENT IS APPROVED FOR SOIL EROSION AND SEDIMENT CONTROL BY THE HOWARD SOIL CONSERVATION DISTRICT.  
9/2/14  
DATE

DEPARTMENT OF PUBLIC WORKS, HOWARD COUNTY, MD  
M. D. R. [Signature]  
CHIEF, BUREAU OF ENVIRONMENTAL SERVICES  
1/28/15  
DATE

NO.	REVISIONS DESCRIPTION	DATE

936 RIDGEBROOK ROAD  
SPARKS, MARYLAND 21152  
TELEPHONE: (410) 316-7800  
FAX: (410) 316-7818  
WWW.KCI.COM



NORTHGATE WOODS  
STORMWATER POND REPAIR  
CAPITAL PROJECT D-1159  
HOWARD COUNTY DEPARTMENT OF PUBLIC WORKS  
STORMWATER MANAGEMENT DIVISION  
6751 COLUMBIA GATEWAY DRIVE  
COLUMBIA, MD 21046


STORMWATER MANAGEMENT PROFILES AS-BUILT

SCALE: AS SHOWN  
DATE: APRIL 2014  
KCI JOB NO.: 17133314.01  
CAPITAL PROJECT NO.: D-1159  
PERMIT ISSUE:  
CONSTRUCTION ISSUE:








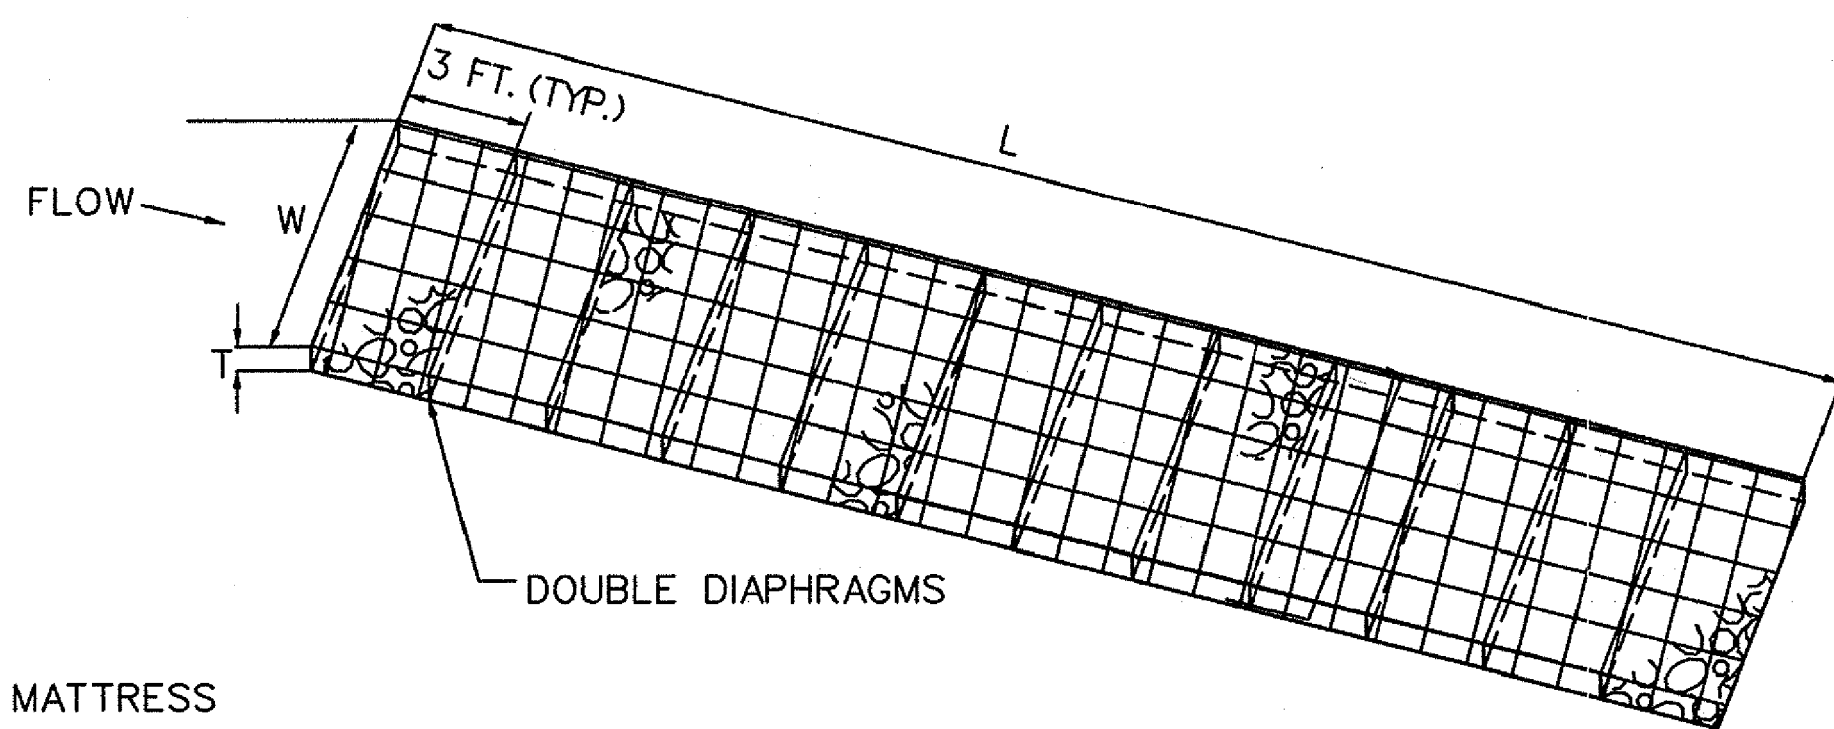


GABION MATTRESS

ID	L(FT.)	W(FT.)	T(FT.)
1	20.5	11.5	1.5
2	43.0	17.5	1.5


**GABION MATTRESS PLAN VIEW**  
NOT TO SCALE

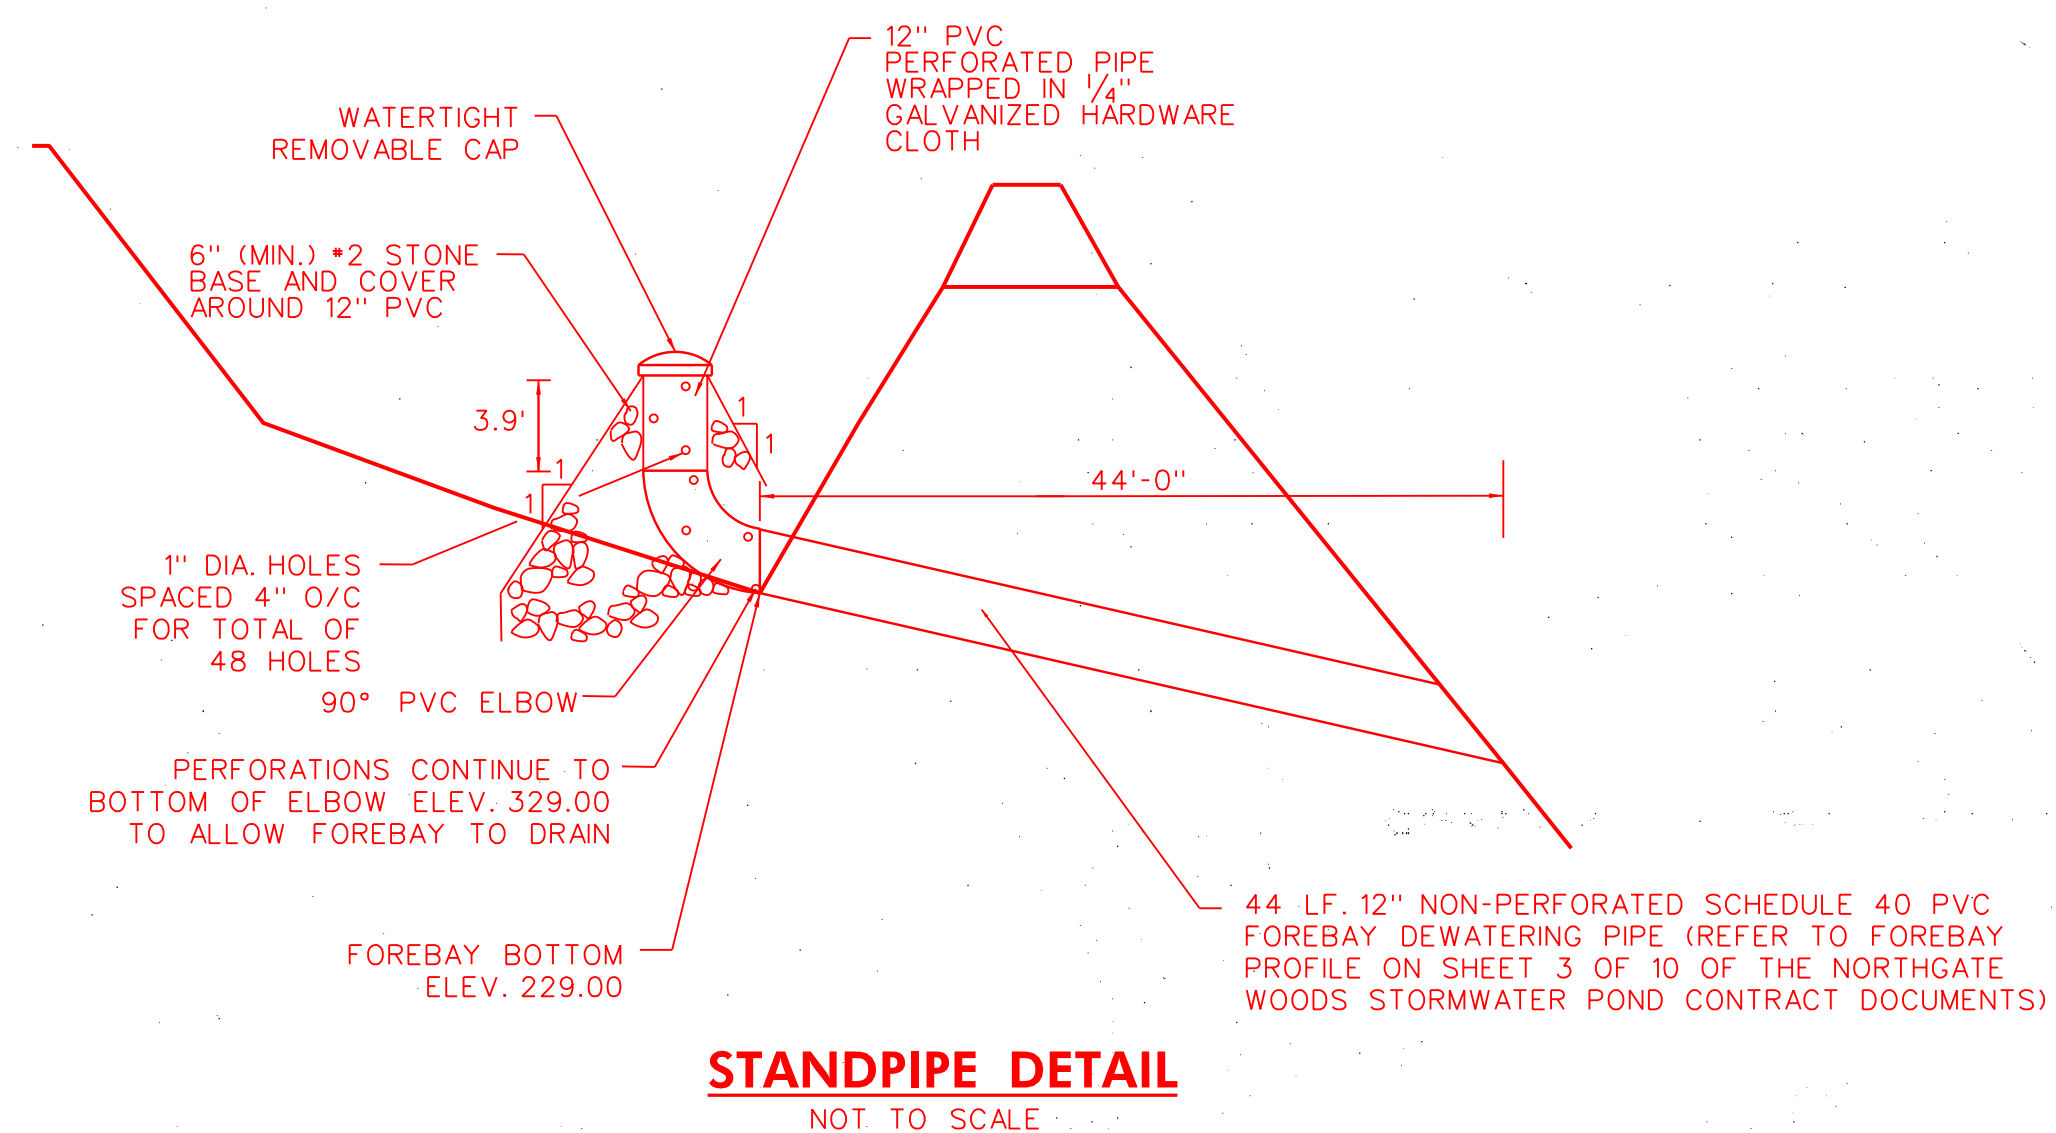

**STANDPIPE DETAIL**  
NOT TO SCALE

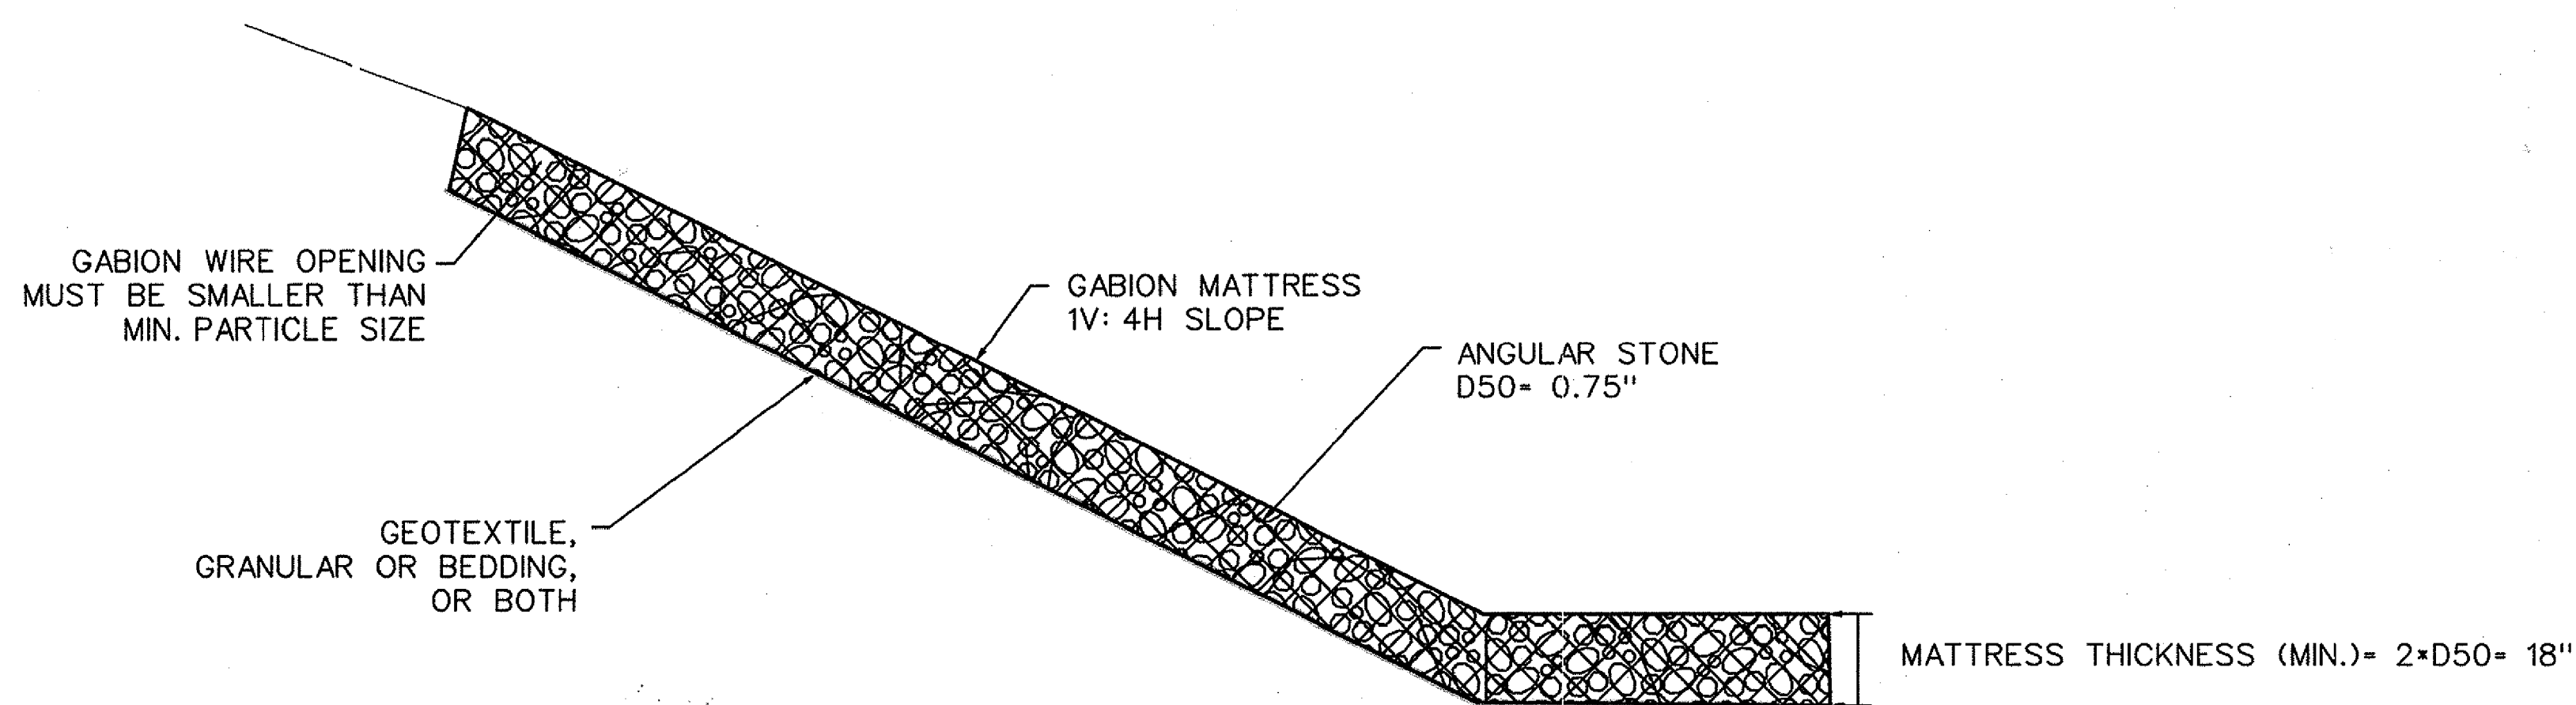

**GABION MATTRESS PROFILE VIEW**  
NOT TO SCALE

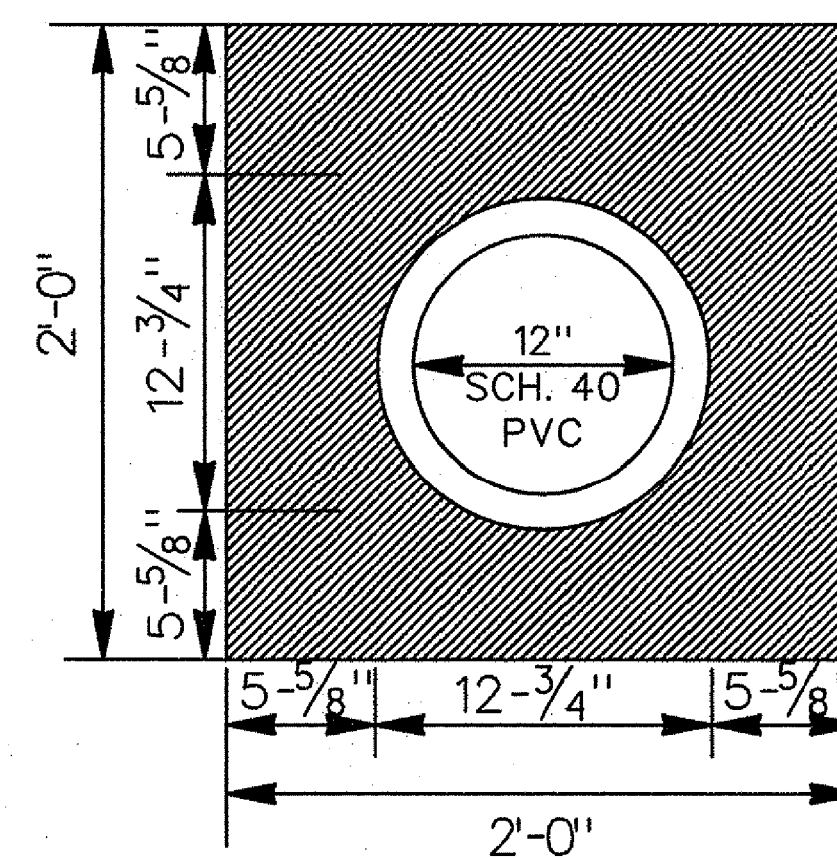

**WOOD FRAME AND RUBBER ANTI-SEEP COLLAR FOREBAY DEWATERING PIPE**  
NOT TO SCALE

NO.	REVISIONS DESCRIPTION	DATE

936 RIDGEBROOK ROAD  
SPARKS, MARYLAND 21152  
TELEPHONE: (410) 316-7800  
FAX: (410) 316-7818  
WWW.KCI.COM



NORTHGATE WOODS  
STORMWATER POND REPAIR  
CAPITAL PROJECT D-1159  
HOWARD COUNTY DEPARTMENT OF PUBLIC WORKS  
STORMWATER MANAGEMENT DIVISION  
6751 COLUMBIA GATEWAY DRIVE  
COLUMBIA, MD 21046

STORMWATER  
MANAGEMENT  
DETAILS-2  
AS-BUILT

SCALE:	AS SHOWN
DATE:	APRIL 2014
KCI JOB NO.:	17133314.01
CAPITAL PROJECT NO.:	D-1159
PERMIT ISSUE:	
CONSTRUCTION ISSUE:	

PROFESSIONAL CERTIFICATION. I HEREBY CERTIFY THAT THESE DOCUMENTS WERE PREPARED OR APPROVED BY ME, RAYMOND J. KRAHE, PE, AND THAT I AM A DULY LICENSED PROFESSIONAL ENGINEER UNDER THE LAWS OF THE STATE OF MARYLAND. LICENSE NO. 28634. EXPIRATION DATE: 2015-03-26 2017-03-26

THIS DEVELOPMENT IS APPROVED FOR SOIL EROSION AND SEDIMENT CONTROL BY THE HOWARD SOIL CONSERVATION DISTRICT.

John L. Rounton  
HOWARD SCD

9/9/14  
DATE

DEPARTMENT OF PUBLIC WORKS, HOWARD COUNTY, MD  
Michael D. ...  
CHIEF, BUREAU OF ENVIRONMENTAL SERVICES

1/28/15  
DATE

AS-BUILT 12-01-2015



STORMWATER MANAGEMENT CONSTRUCTION SPECIFICATIONS (MARYLAND CODE 378 POND -- JANUARY 2000)

THESE SPECIFICATIONS ARE APPROPRIATE TO ALL PONDS WITHIN THE SCOPE OF THE STANDARD FOR PRACTICE MD-378. ALL REFERENCES TO ASTM AND ASHTO SPECIFICATIONS APPLY TO THE MOST RECENT VERSION.

SITE PREPARATION

AREAS DESIGNATED FOR BORROW AREAS, EMBANKMENT, AND STRUCTURAL WORKS SHALL BE CLEARED, GRUBBED AND STRIPPED OF TOPSOIL. ALL TREES, VEGETATION, ROOTS AND OTHER OBSTRUCTIBLE MATERIAL SHALL BE REMOVED.

ALL CLEARED AND GRUBBED MATERIAL SHALL BE DISPOSED OF OUTSIDE AND BELOW THE LIMITS OF THE DAM AND RESERVOIR AS DIRECTED BY THE OWNER OR HIS REPRESENTATIVE.

EARTH FILL

MATERIAL - THE FILL MATERIAL SHALL BE TAKEN FROM APPROVED DESIGNATED BORROW AREAS. IT SHALL BE FREE OF ROOTS, STUMPS, WOOD, RUBBISH, STONES GREATER THAN 6" FROZEN OR OTHER OBSTRUCTIBLE MATERIALS.

PLACEMENT - AREAS ON WHICH FILL IS TO BE PLACED SHALL BE SCARIFIED PRIOR TO PLACEMENT OF FILL. FILL MATERIALS SHALL BE PLACED IN MAXIMUM 8" INCH THICK (BEFORE COMPACTION) LAYERS WHICH ARE TO BE CONTINUOUS OVER THE ENTIRE LENGTH OF THE FILL.

CONSTRUCTION - THE MOVEMENT OF THE HAULING AND SPREADING EQUIPMENT OVER THE FILL SHALL BE CONTROLLED TO PREVENT OVER-SETTLING OF THE FILL MATERIAL.

EMBAKMENT CORE - THE CORE SHALL BE PARALLEL TO THE CENTERLINE OF THE EMBANKMENT AS SHOWN ON THE PLANS. THE TOP WIDTH OF THE CORE SHALL BE A MINIMUM OF FOUR FEET.

STRUCTURE BACKFILL - BACKFILL ADJACENT TO PIPES OR STRUCTURES SHALL BE OF THE TYPE AND QUANTITY CONFORMING TO THAT SPECIFIED FOR THE ADJOINING FILL MATERIAL.

PIPE CONDUITS - ALL PIPES SHALL BE CIRCULAR IN CROSS SECTION. CORRUGATED METAL PIPE - ALL OF THE FOLLOWING CRITERIA SHALL APPLY FOR CORRUGATED METAL PIPE.

MATERIALS - (ALUMINUM COATED STEEL PIPE) - THIS PIPE AND ITS APPURTENANCES SHALL CONFORM TO THE REQUIREMENTS OF AASHTO SPECIFICATION ON M-274 WITH WATER TIGHT COUPLING BANDS OR FLANGES.

CONCRETE ANTI-SEEP COLLAR DETAIL - A cross-sectional diagram showing the details of a concrete anti-seep collar for a 24-inch RCP barrel pipe. It includes labels for reinforcement, mastic joint sealer, rubber gasket, and concrete cradle.

CARE OF WATER DURING CONSTRUCTION - ALL WORK ON PERMANENT STRUCTURES SHALL BE CARRIED OUT IN AREAS FREE FROM WATER. THE CONTRACTOR SHALL CONSTRUCT ANY TEMPORARY WEIRS, LEVEES, COFFERDAMS, DRAINAGE CHANNELS, AND STREAM DIVERSIONS NECESSARY TO PROTECT THE AREAS TO BE OCCUPIED BY THE PERMANENT WORKS.

STABILIZATION - ALL BORROW AREAS SHALL BE GRADED TO PROVIDE PROPER DRAINAGE AND LEFT IN A SLIGHTLY SLOPED CONDITION. ALL EXPOSED SURFACES OF THE EMBANKMENT, SPILLWAY, SOIL AND BORROW AREAS, AND STREAMS SHALL BE STABILIZED BY SEEDING, MOWING, FERTILIZING AND MULCHING.

EROSION AND SEDIMENT CONTROL - CONSTRUCTION OPERATIONS WILL BE CARRIED OUT IN SUCH A MANNER THAT EROSION WILL BE CONTROLLED AND WATER AND AIR POLLUTION MINIMIZED.

WOODY VEGETATION NOTE - TREES, SHRUBS, OR OTHER WOODY VEGETATION WILL NOT BE ALLOWED WITHIN A 25' RADIUS OF THE INLET AND THE POOL AREA, AND NOT ALLOWED ON, OR WITHIN 15' OF ANY PORTION OF THE EMBANKMENT.

CONTRACTOR'S AS-BUILT NOTE - AS-BUILT PLANS AND CERTIFICATION ARE REQUIRED FOR THIS STORM WATER MANAGEMENT FACILITY. THIS MUST BE PREPARED AND SEALED BY A REGISTERED PROFESSIONAL ENGINEER. AFTER FINAL ACCEPTANCE OF THE FACILITY, THE AS-BUILT PLANS AND CERTIFICATION WILL BE PREPARED BY THE ENGINEER FOR SUBMISSION TO HOWARD COUNTY.

CONTRACTOR'S AS-BUILT NOTE

AS-BUILT PLANS AND CERTIFICATION ARE REQUIRED FOR THIS STORM WATER MANAGEMENT FACILITY. THIS MUST BE PREPARED AND SEALED BY A REGISTERED PROFESSIONAL ENGINEER. AFTER FINAL ACCEPTANCE OF THE FACILITY, THE AS-BUILT PLANS AND CERTIFICATION WILL BE PREPARED BY THE ENGINEER FOR SUBMISSION TO HOWARD COUNTY.

TO PREPARE THE REQUIRED AS-BUILT PLANS AND CERTIFICATION, THE STORM WATER MANAGEMENT FACILITY MUST BE INSPECTED BY THE ENGINEER AT SPECIFIC STAGES DURING THE CONSTRUCTION AS REQUIRED BY THE CURRENT HOWARD COUNTY STORM WATER MANAGEMENT POLICY AND DESIGN MANUAL.

CONSTRUCTION NOTE

UNLESS OTHERWISE NOTED, ALL CONSTRUCTION AND WORKMANSHIP SHALL BE IN ACCORDANCE WITH:

HOWARD COUNTY DEPARTMENT OF PUBLIC WORKS STANDARD SPECIFICATIONS AND DETAILS FOR CONSTRUCTION.

MARYLAND DEPARTMENT OF TRANSPORTATION STATE HIGHWAY ADMINISTRATION, 2011 STANDARD SPECIFICATIONS FOR CONSTRUCTION AND MATERIAL.

OPERATION AND MAINTENANCE SCHEDULE

ROUTINE MAINTENANCE:


- 1. FACILITY SHALL BE INSPECTED ONCE EVERY THREE YEARS. INSPECTIONS SHALL BE PERFORMED DURING OR SHORTLY AFTER WET WEATHER TO DETERMINE IF THE POND IS FUNCTIONING PROPERLY.
2. TOP AND SIDE SLOPES OF THE EMBANKMENT SHALL BE MOWED A MINIMUM OF TWO (2) TIMES PER YEAR, ONCE IN JUNE AND ONCE IN SEPTEMBER. OTHER SIDE SLOPES AND MAINTENANCE ACCESS SHALL BE MOWED AS NEEDED.
3. DEBRIS AND LITTER SHALL BE REMOVED DURING REGULAR MOWING OPERATIONS AND AS NEEDED.
4. VISIBLE SIGNS OF EROSION IN THE POND AS WELL AS THE RIP-RAP SPILLWAY AND OUTLET AREAS SHALL BE REPAIRED AS SOON AS IT IS NOTICED.
5. PLANTINGS SHALL BE REPLACED AS NEEDED TO ENSURE A SIGNIFICANT NUMBER OF SHRUBS ARE PRESENT AND FULL HERBACEOUS COVERAGE EXISTS WITHIN THE FACILITY.

NON-ROUTINE MAINTENANCE:


- 1. STRUCTURAL COMPONENTS OF THE FACILITY SUCH AS THE EMBANKMENT, DEWATERING SYSTEM, AND OVERFLOWS SHALL BE REPAIRED UPON DETECTION OF ANY DAMAGE.

SEQUENCE OF CONSTRUCTION


- 1. NOTIFY HOWARD COUNTY DEPARTMENT OF PUBLIC WORKS, CONSTRUCTION INSPECTION DIVISION IN WRITING AND LEAST THREE (3) DAYS PRIOR TO DOING ANY WORK.
2. CONTRACTOR SHALL COORDINATE AN ONSITE PRE-CONSTRUCTION MEETING WHICH SHALL INCLUDE, BUT NOT BE LIMITED TO, THE COUNTY PROJECT MANAGER, THE ENGINEER, AND A REPRESENTATIVE FROM HOWARD COUNTY CONSTRUCTION INSPECTION. (1 DAY)
3. NOTIFY CERTIFYING ENGINEER 5 WORKING DAYS PRIOR TO BEGINNING STORMWATER MANAGEMENT CONSTRUCTION. (5 DAYS)
4. INSTALL THE PERIMETER SEDIMENT CONTROL MEASURES INCLUDING ORANGE CONSTRUCTION FENCE, SILT FENCE, SUMP PIT NEAR RISER, FILTER BAG, STABILIZED CONSTRUCTION ENTRANCE AND WOOD MATS FOR TEMPORARY ACCESS OVER THE EMERGENCY SPILLWAY ACCORDING TO APPROVED SEDIMENT CONTROL PLAN. INSTALL THE TEMPORARY PIPE FROM THE SUMP PIT TO THE FILTER BAG. (5 DAYS)
5. NOTIFY HOWARD COUNTY DEPARTMENT OF PUBLIC WORKS, CONSTRUCTION INSPECTION DIVISION UPON COMPLETION OF INSTALLATION. (1 DAY)
6. INSTALL SANDBAG DIVERSION AROUND RISER STRUCTURE. (1 DAY)
7. WITH 5 DAY CLEAR FORECAST, EXCAVATE THE EMBANKMENT AND STOCKPILE SOIL ON SITE AS SHOWN ON THE DETAIL AND PLAN. REMOVE THE EXISTING RISER, LOW FLOW PIPE TO RISER, AND BARREL PIPE. (5 DAYS)
8. CLEAR WOODY VEGETATION WITHIN THE 15 FOOT NO WOODY VEGETATION ZONE. ALL TREES SHALL BE CLEARED AND GRUBBED WITHIN 15 FEET OF THE TOE OF THE EMBANKMENT.
9. INSTALL THE PROPOSED CONCRETE BOX RISER, 12" RCP LOW FLOW PIPE TO RISER AND TRASH RACK, 24" RCP BARREL PIPE, ANTI-SEEP COLLARS, CLAY CORE, AND CONCRETE CRADLE IN THE EMBANKMENT TRENCH, THE FOREBAY AT THE SOUTHERLY POND INLET, AND THE WEST INLET APRON AND POND OUTLET APRON. (5 DAYS)
10. CONSTRUCT THE REMAINDER OF THE EMBANKMENT TO MATCH THE PROPOSED GRADING PLAN. (5 DAYS)
11. REMOVE WOOD MATS AND RE-GRADE AND INSTALL EMERGENCY SPILLWAY IMPROVEMENTS.
12. UPON COMPLETION AND WITH PERMISSION FROM THE SEDIMENT CONTROL INSPECTOR, REMOVE SEDIMENT CONTROL MEASURES, INCLUDING THE TEMPORARY STOCKPILE AREAS. (2 DAYS)
13. INSTALL PLANTINGS, MULCH, AND SEED ALL DISTURBED AREAS EXCEPT FOR THE PERIMETER SEDIMENT CONTROL MEASURES. (3 DAYS)
14. WITH PERMISSION OF SEDIMENT CONTROL INSPECTOR, REMOVE ALL SEDIMENT CONTROL MEASURES AND STABILIZE ANY AREAS DISTURBED BY THIS PROCESS. (2 DAYS)

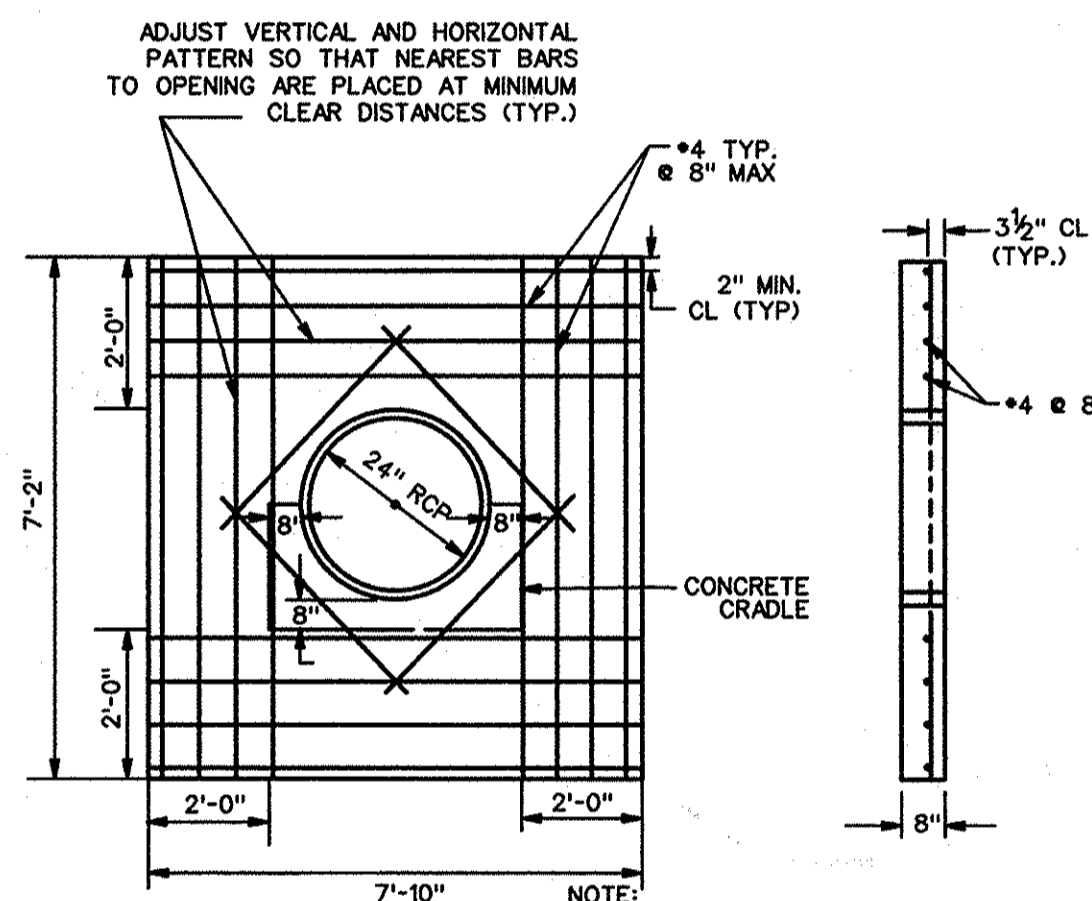


CONCRETE ANTI-SEEP COLLAR DETAIL
24" RCP BARREL PIPE
NOT TO SCALE

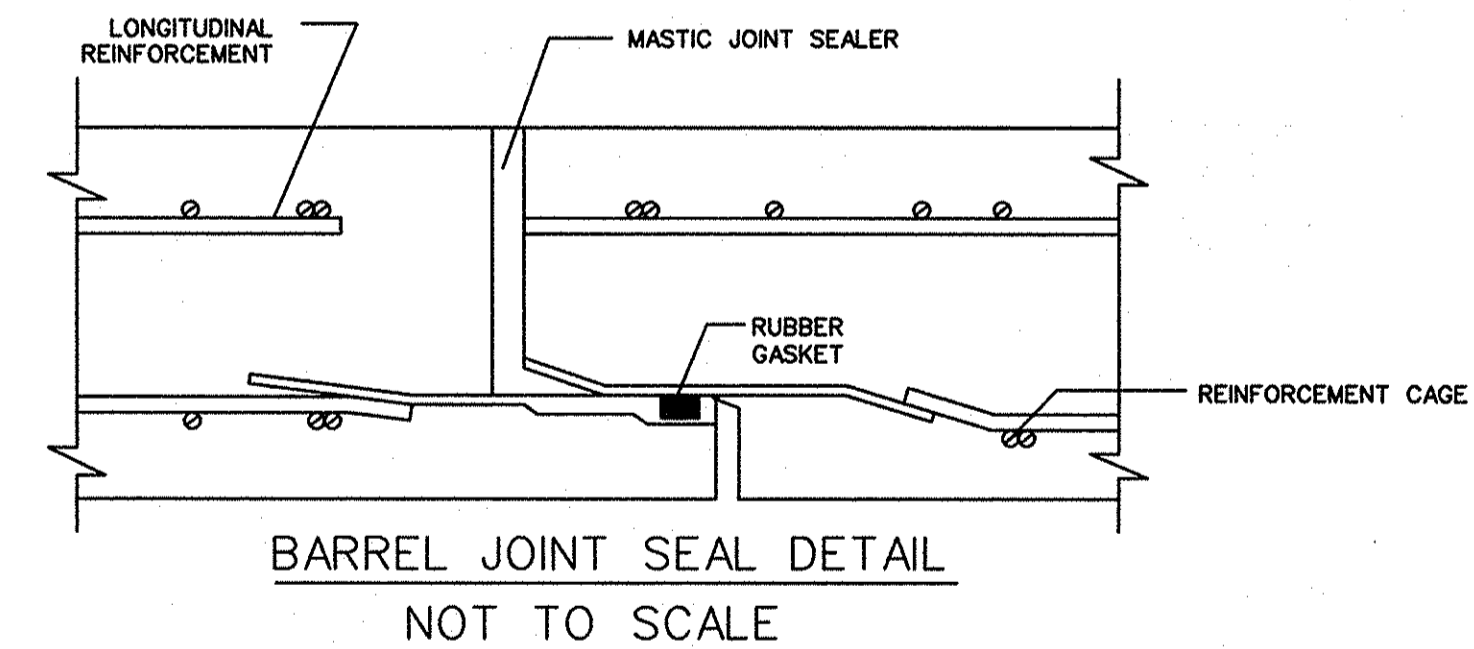


BARREL JOINT SEAL DETAIL
NOT TO SCALE

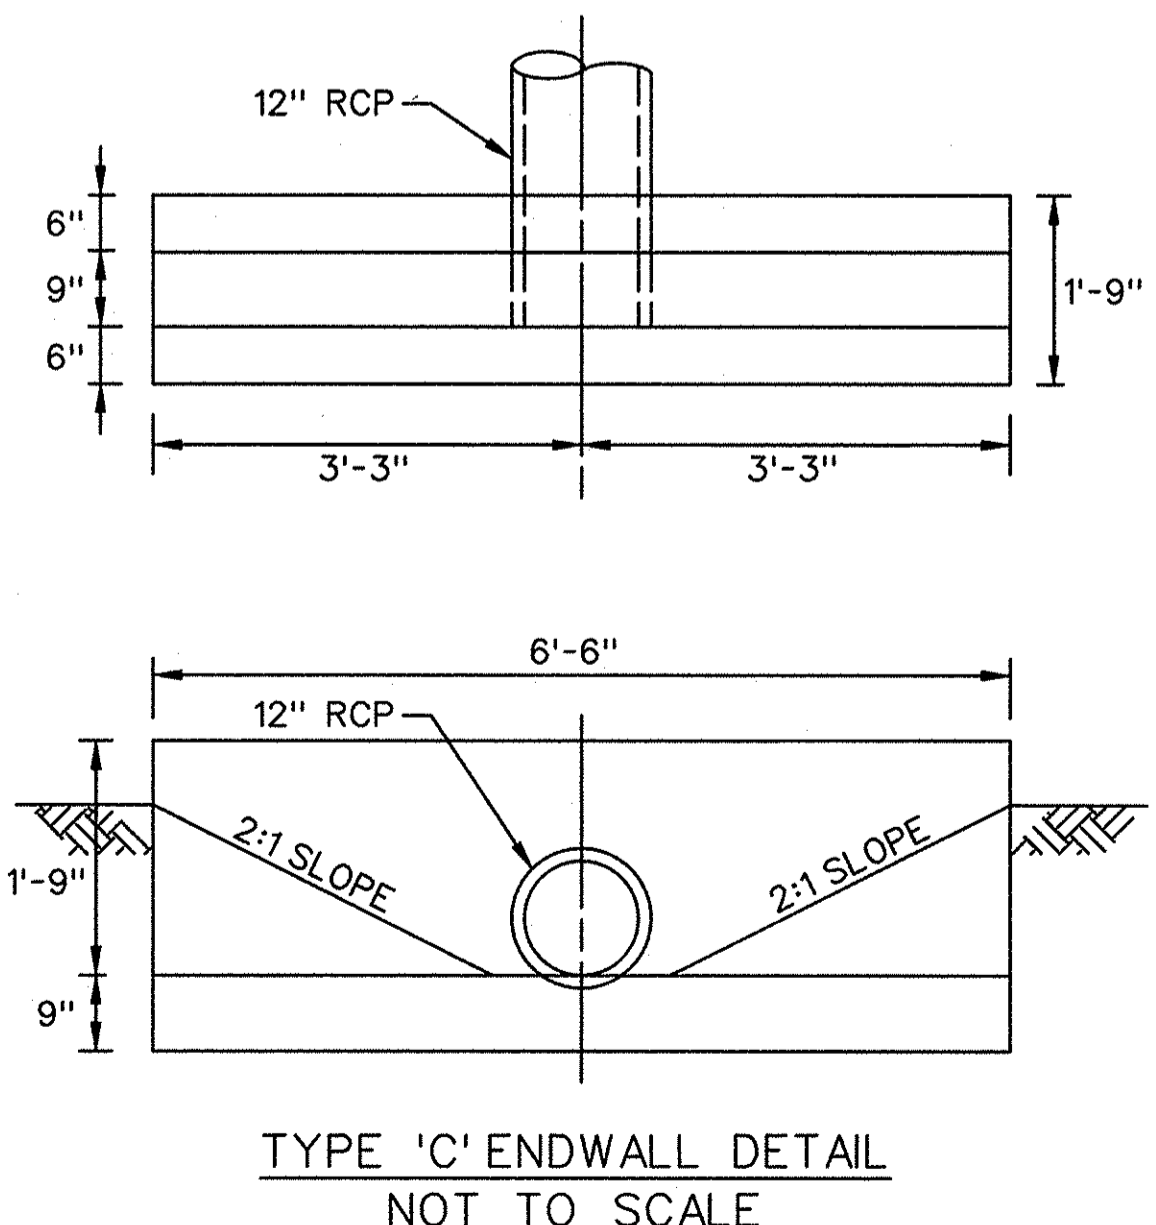

TYPE 'C' ENDWALL DETAIL
NOT TO SCALE

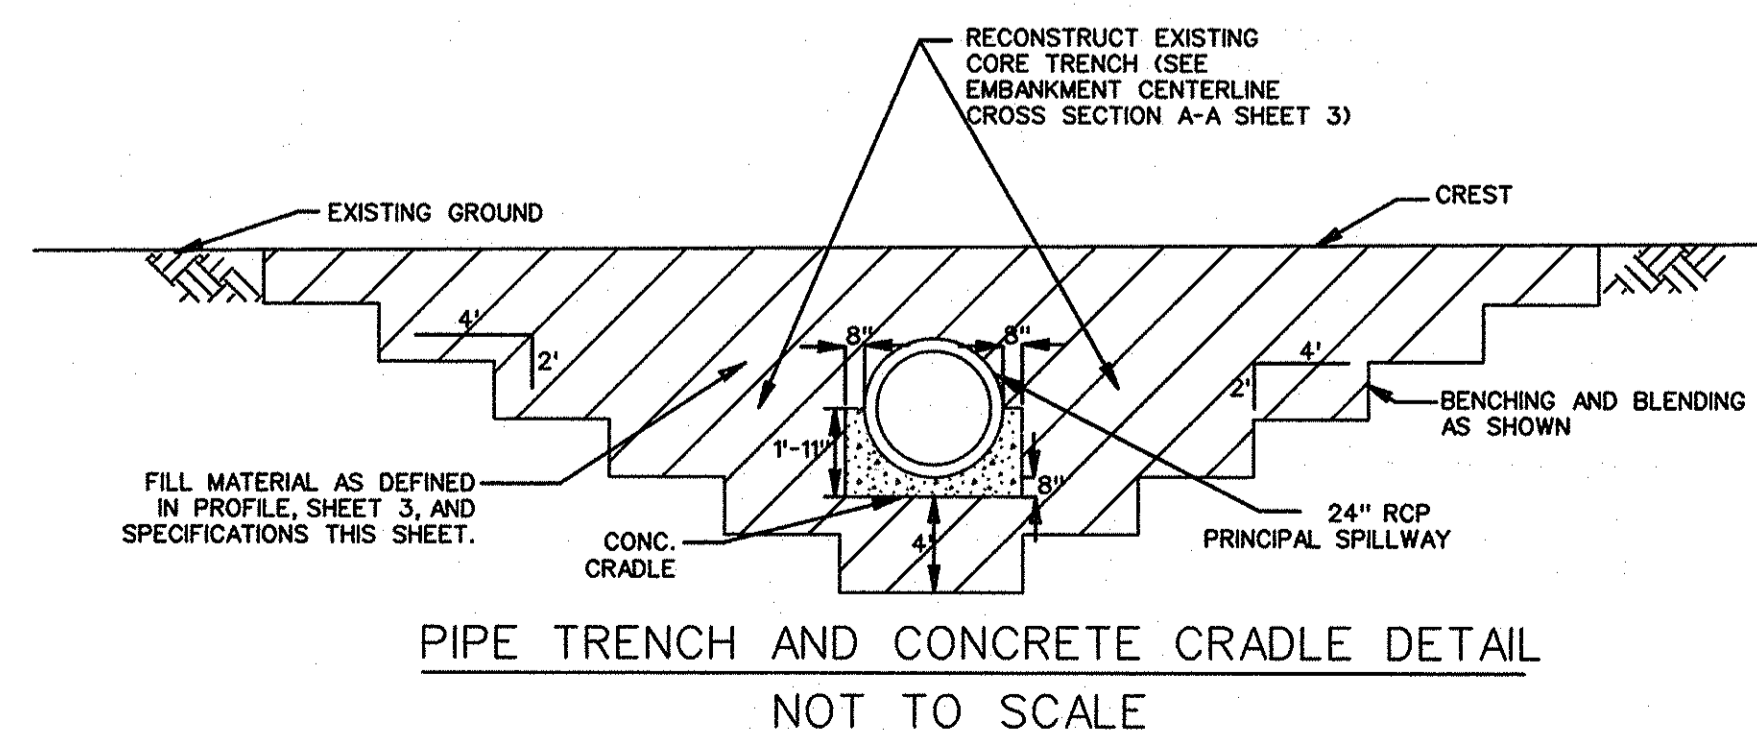

PIPE TRENCH AND CONCRETE CRADLE DETAIL
NOT TO SCALE

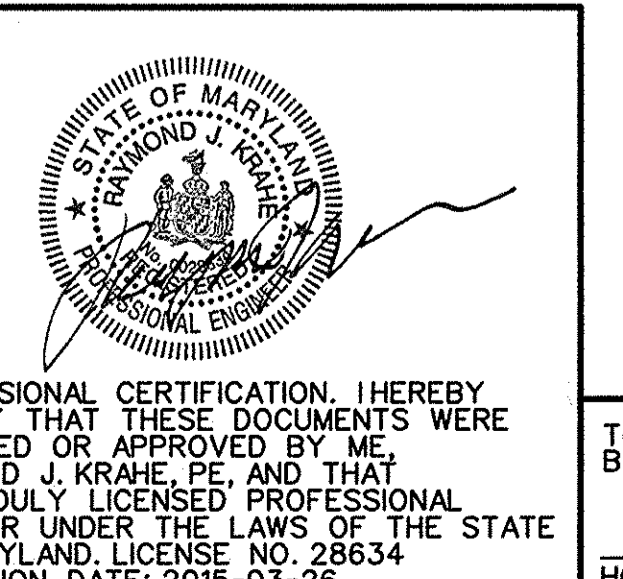


THIS DEVELOPMENT IS APPROVED FOR SOIL EROSION AND SEDIMENT CONTROL BY THE HOWARD SOIL CONSERVATION DISTRICT.
John R. K. [Signature]
HOWARD SCD

DEPARTMENT OF PUBLIC WORKS, HOWARD COUNTY, MD
9/2/14
[Signature]
DATE
1/28/15
DATE

Table with columns: NO., REVISIONS DESCRIPTION, DATE.

936 RIDGEBROOK ROAD
SPARKS, MARYLAND 21152
TELEPHONE: (410) 316-7800
Fax: (410) 316-7818
www.kci.com

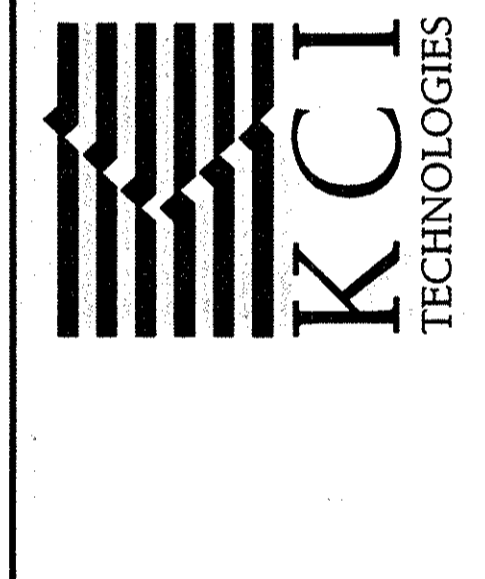

NORTHGATE WOODS
STORMWATER POND REPAIR
CAPITAL PROJECT D-1159
HOWARD COUNTY DEPARTMENT OF PUBLIC WORKS
STORMWATER MANAGEMENT DIVISION
6751 COLUMBIA GATEWAY DRIVE
COLUMBIA, MD 21046

STORMWATER MANAGEMENT NOTES & DETAILS





Table with project information: SCALE: N/A, DATE: APRIL 2014, KCI JOB NO.: 17133314.01, CAPITAL PROJECT NO.: D-1159, PERMIT ISSUE, CONSTRUCTION ISSUE, SHEET NO.: 7 OF 10.

VERTICAL SCALE: 1"=5'
HORIZONTAL SCALE: 1"=20'







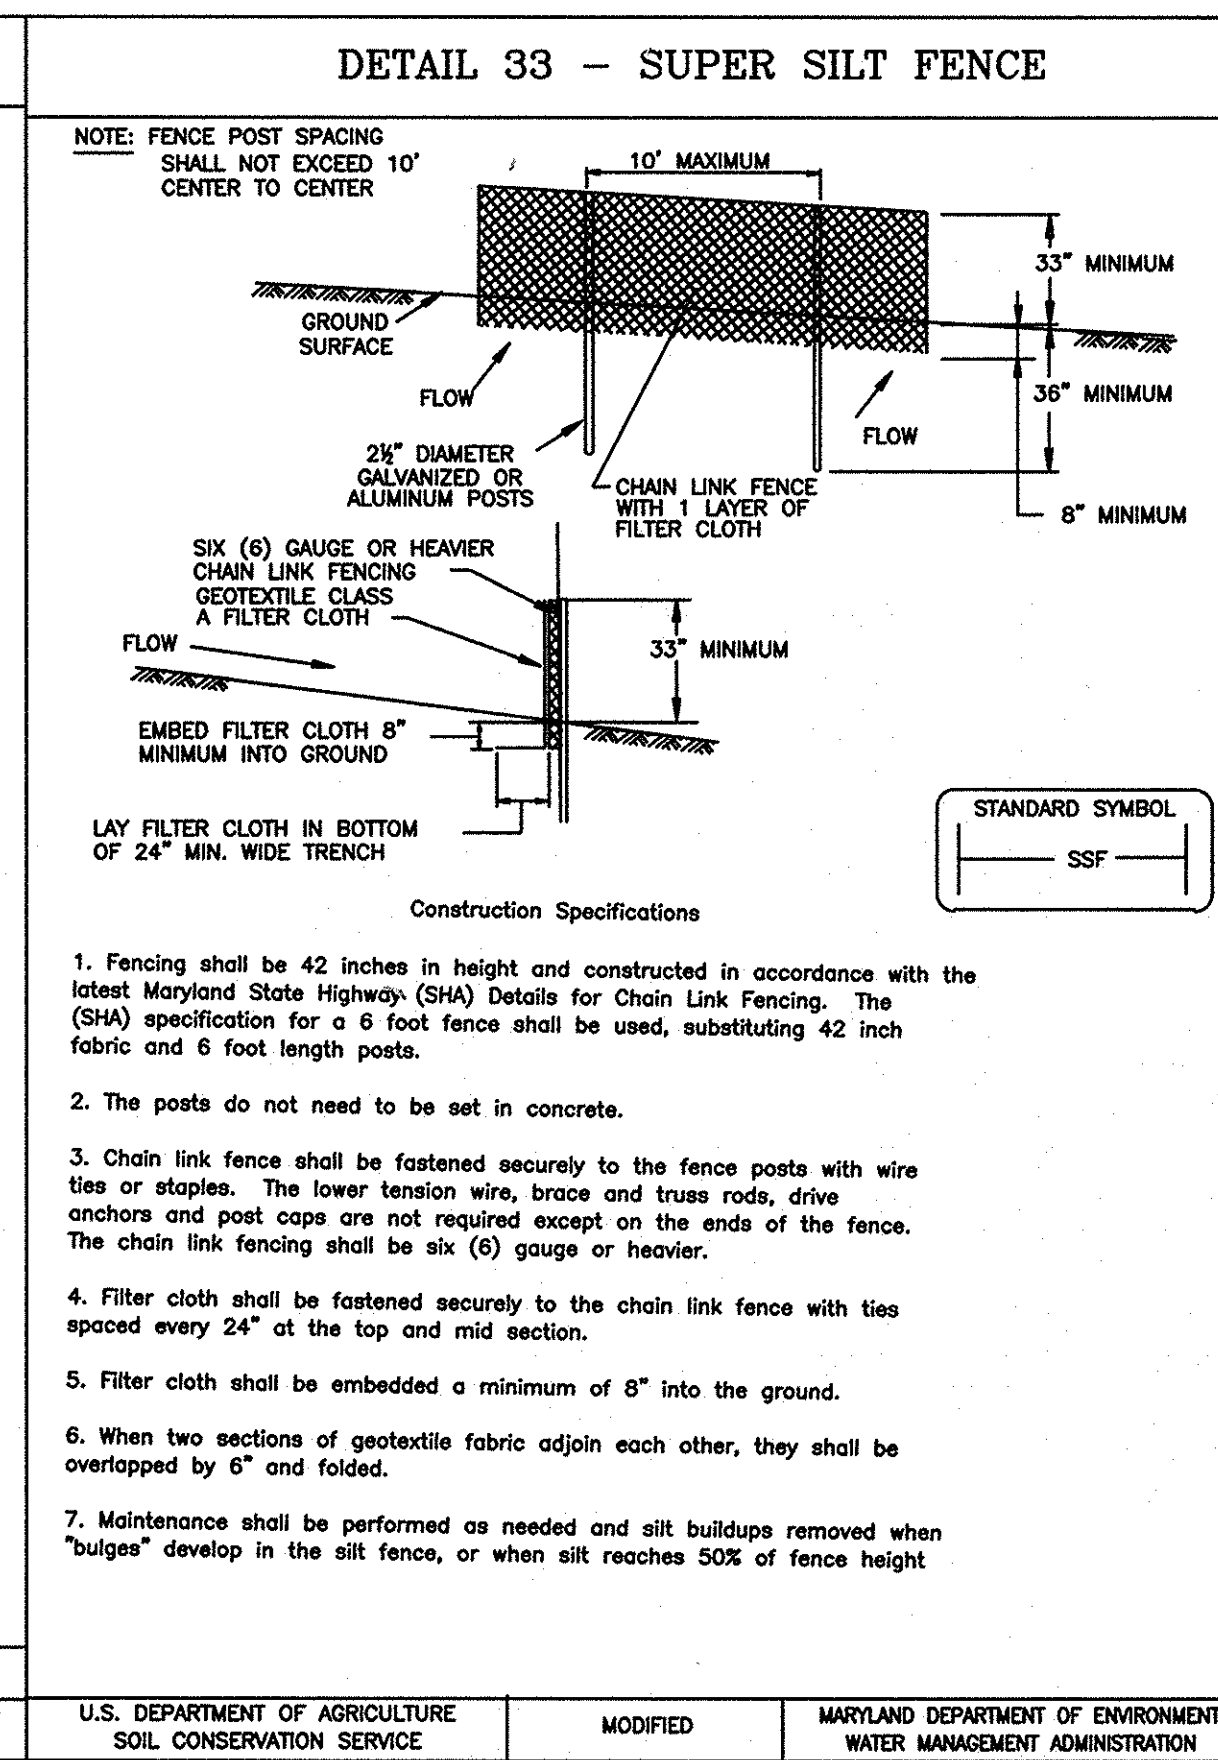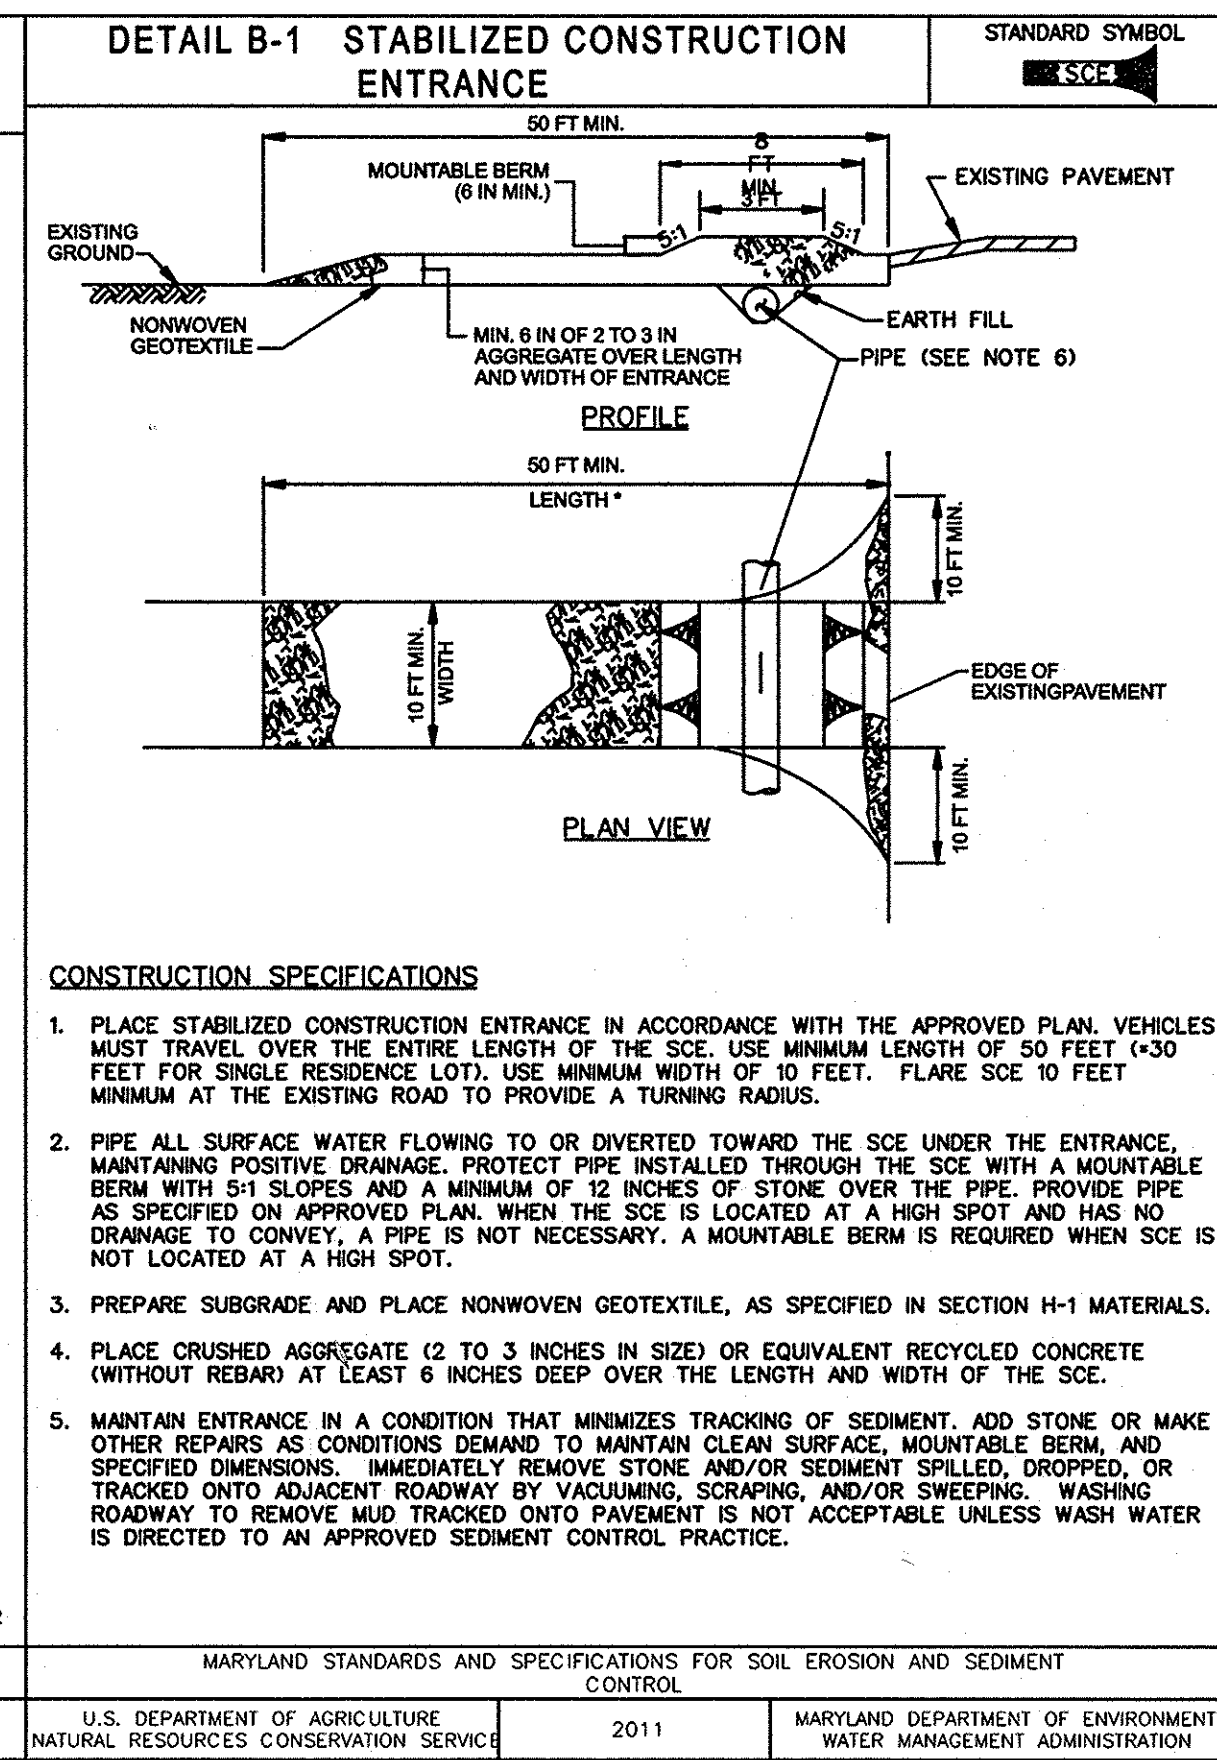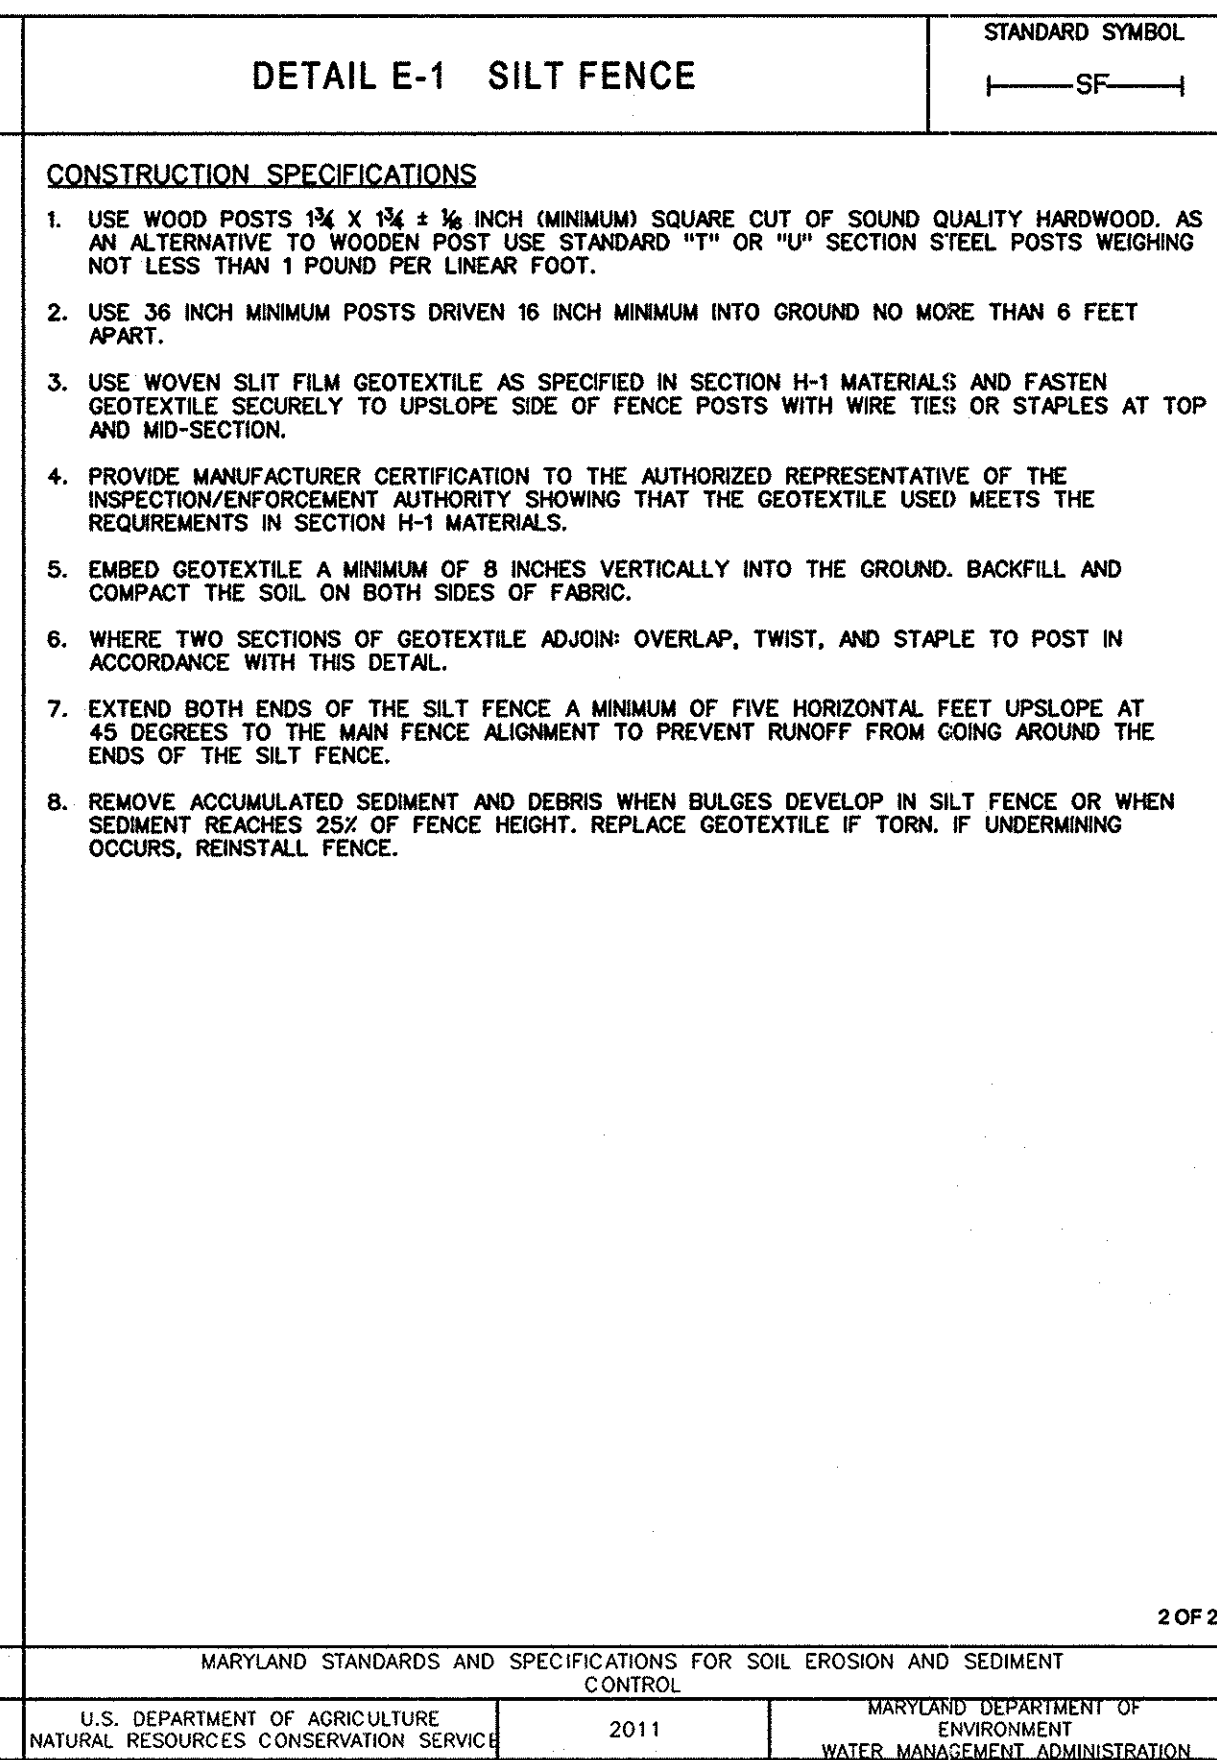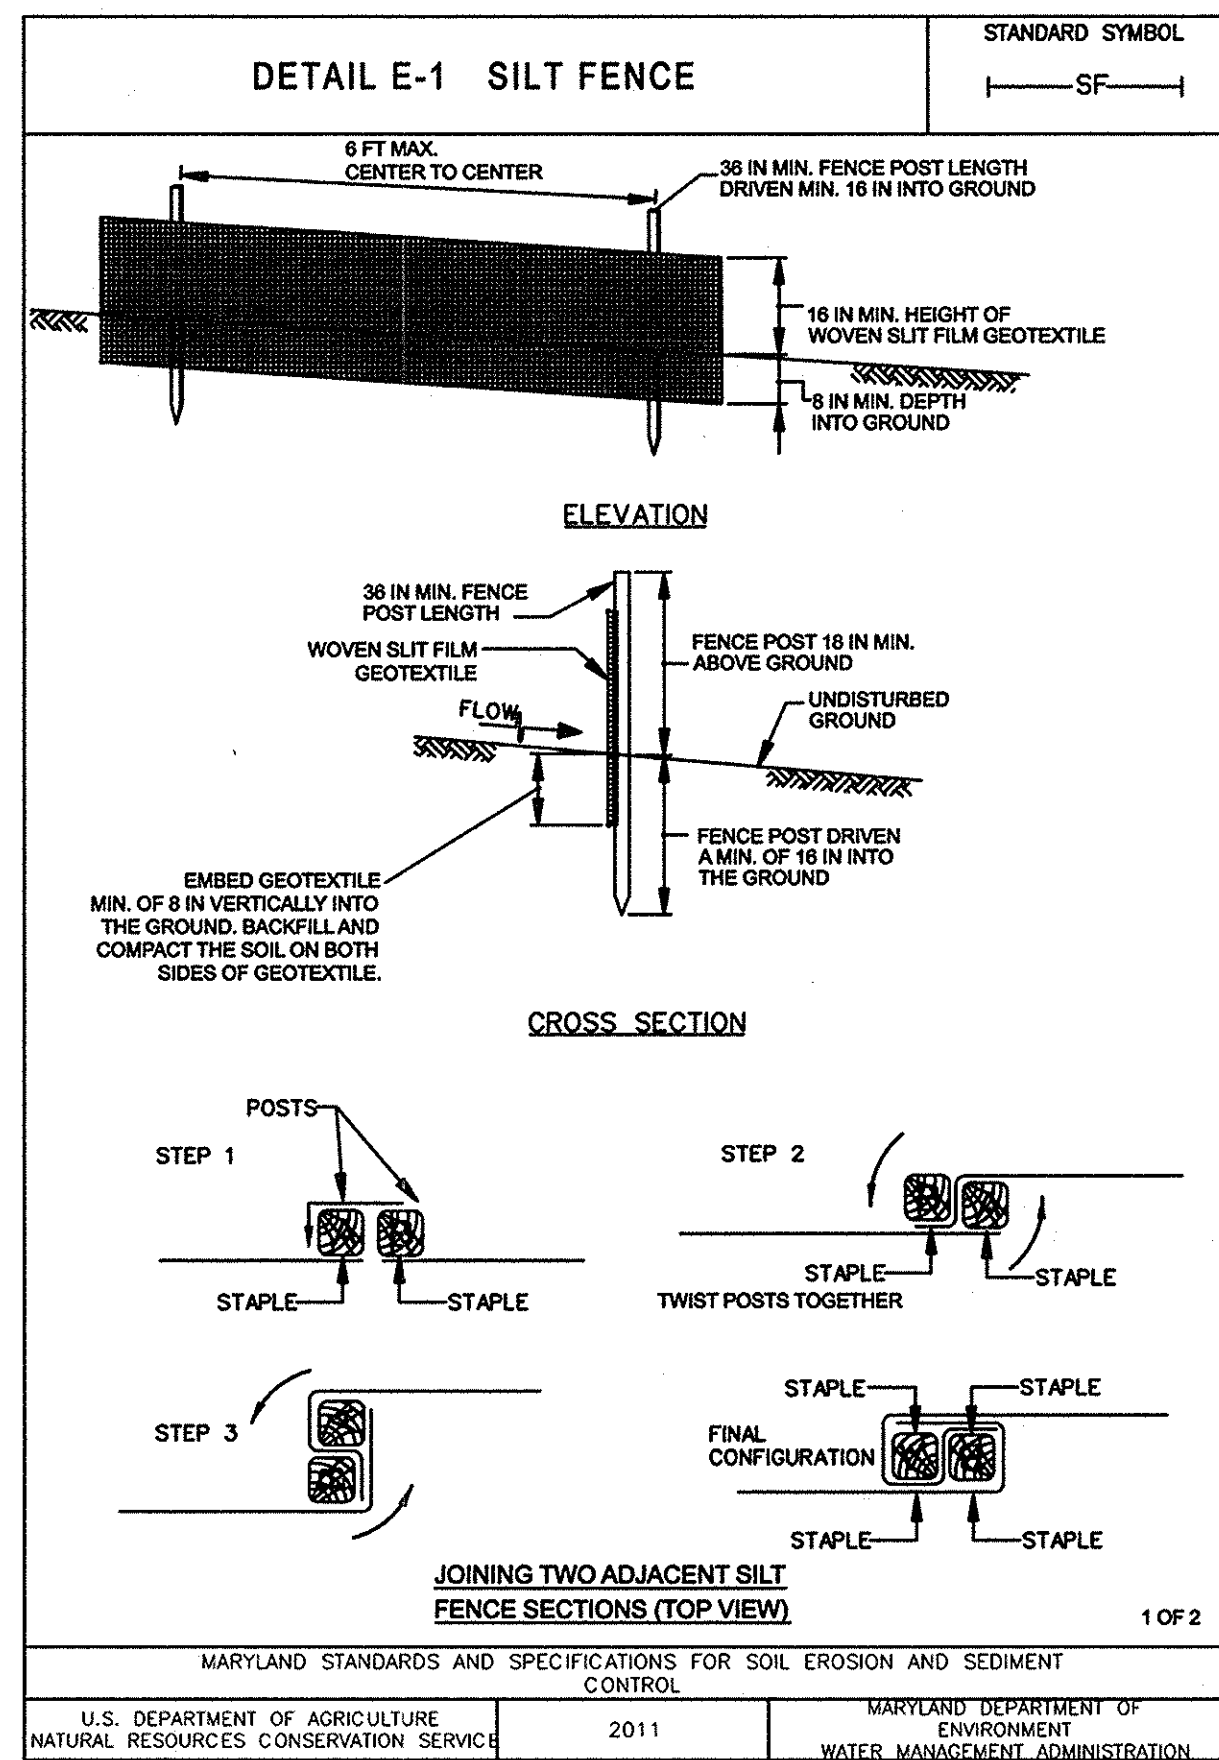






### SUPER SILT FENCE

**Design Criteria**

Slope	Slope Steepness	Slope Length (maximum)	Silt Fence Length (maximum)
0 - 10%	0 - 10:1	Unlimited	Unlimited
10 - 20%	10:1 - 5:1	200 feet	1,500 feet
20 - 33%	5:1 - 3:1	100 feet	1,000 feet
33 - 50%	3:1 - 2:1	100 feet	500 feet
50% +	2:1 +	50 feet	250 feet

PAGE H - 28 - 3A

MARYLAND DEPARTMENT OF ENVIRONMENT WATER MANAGEMENT ADMINISTRATION

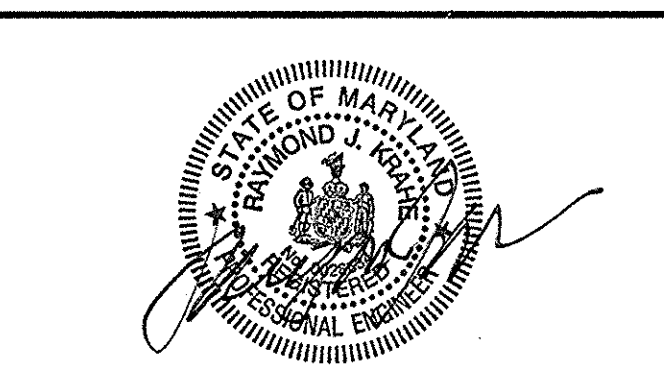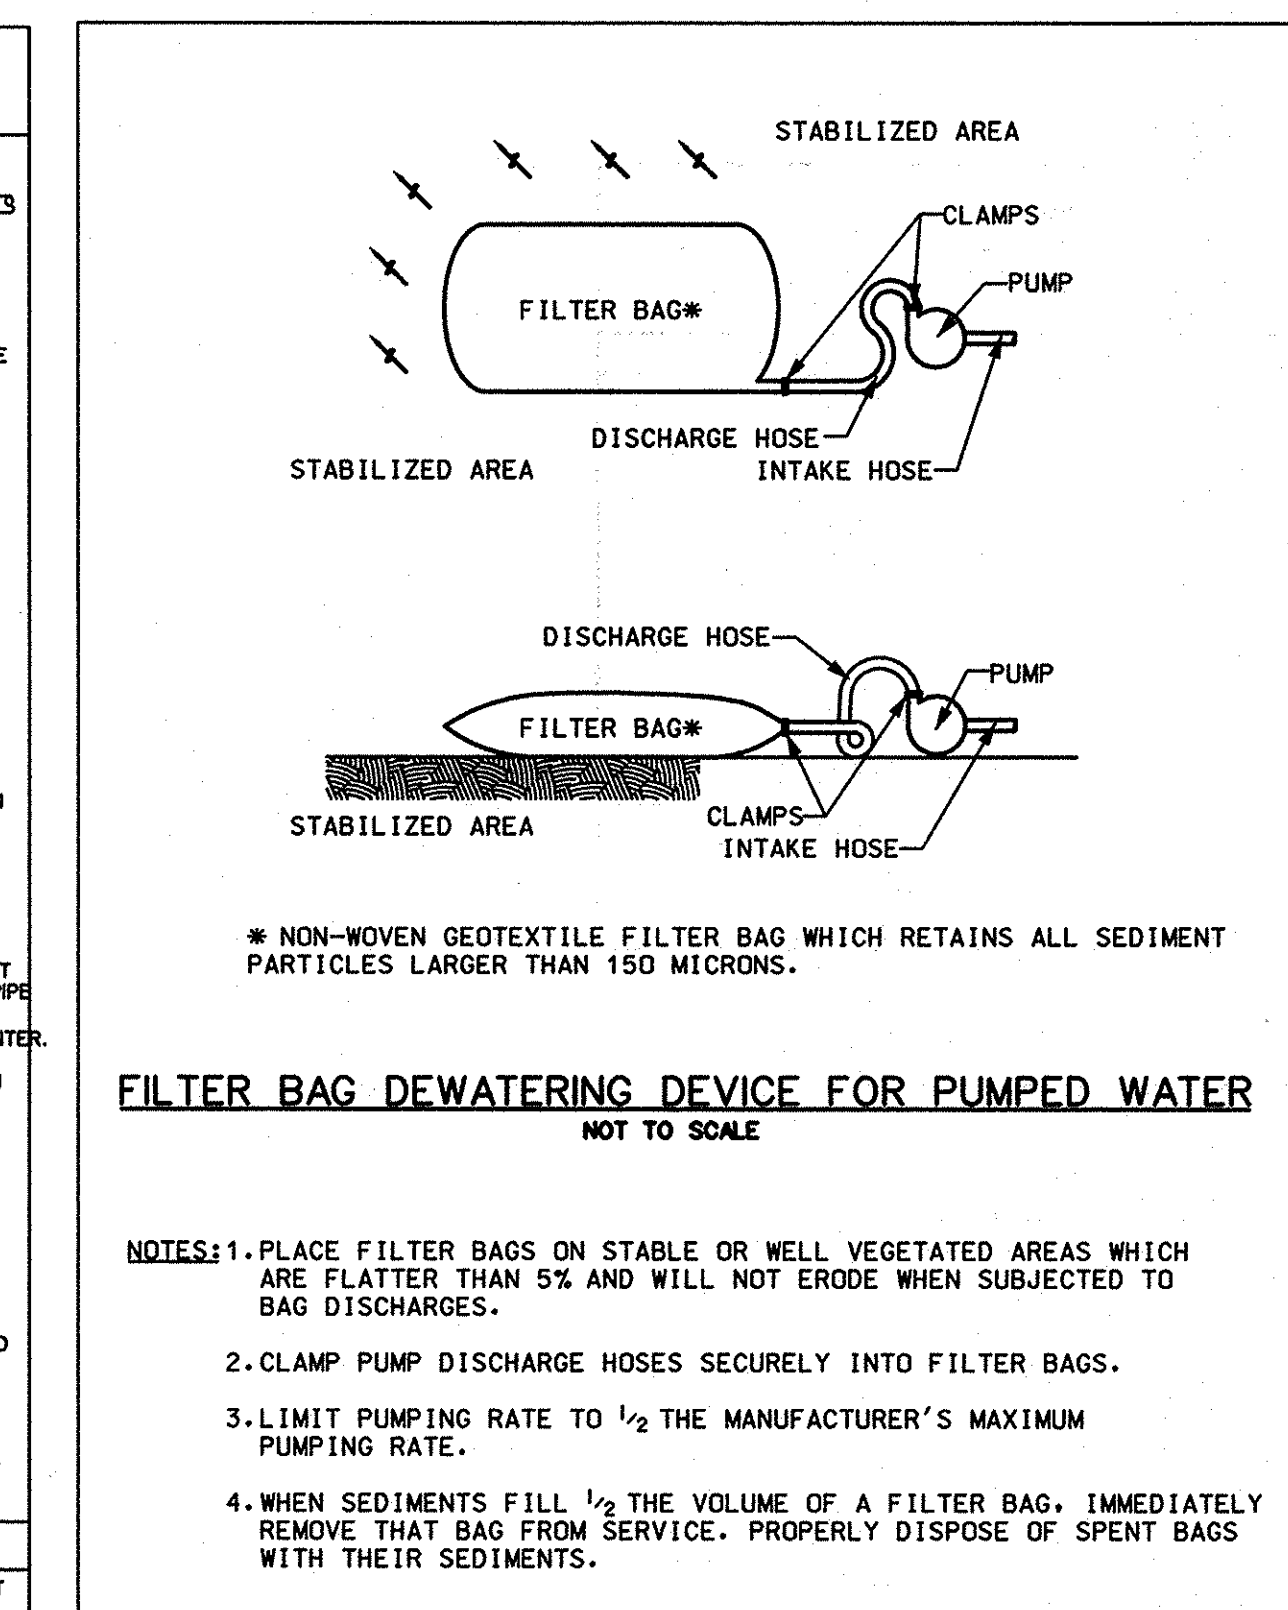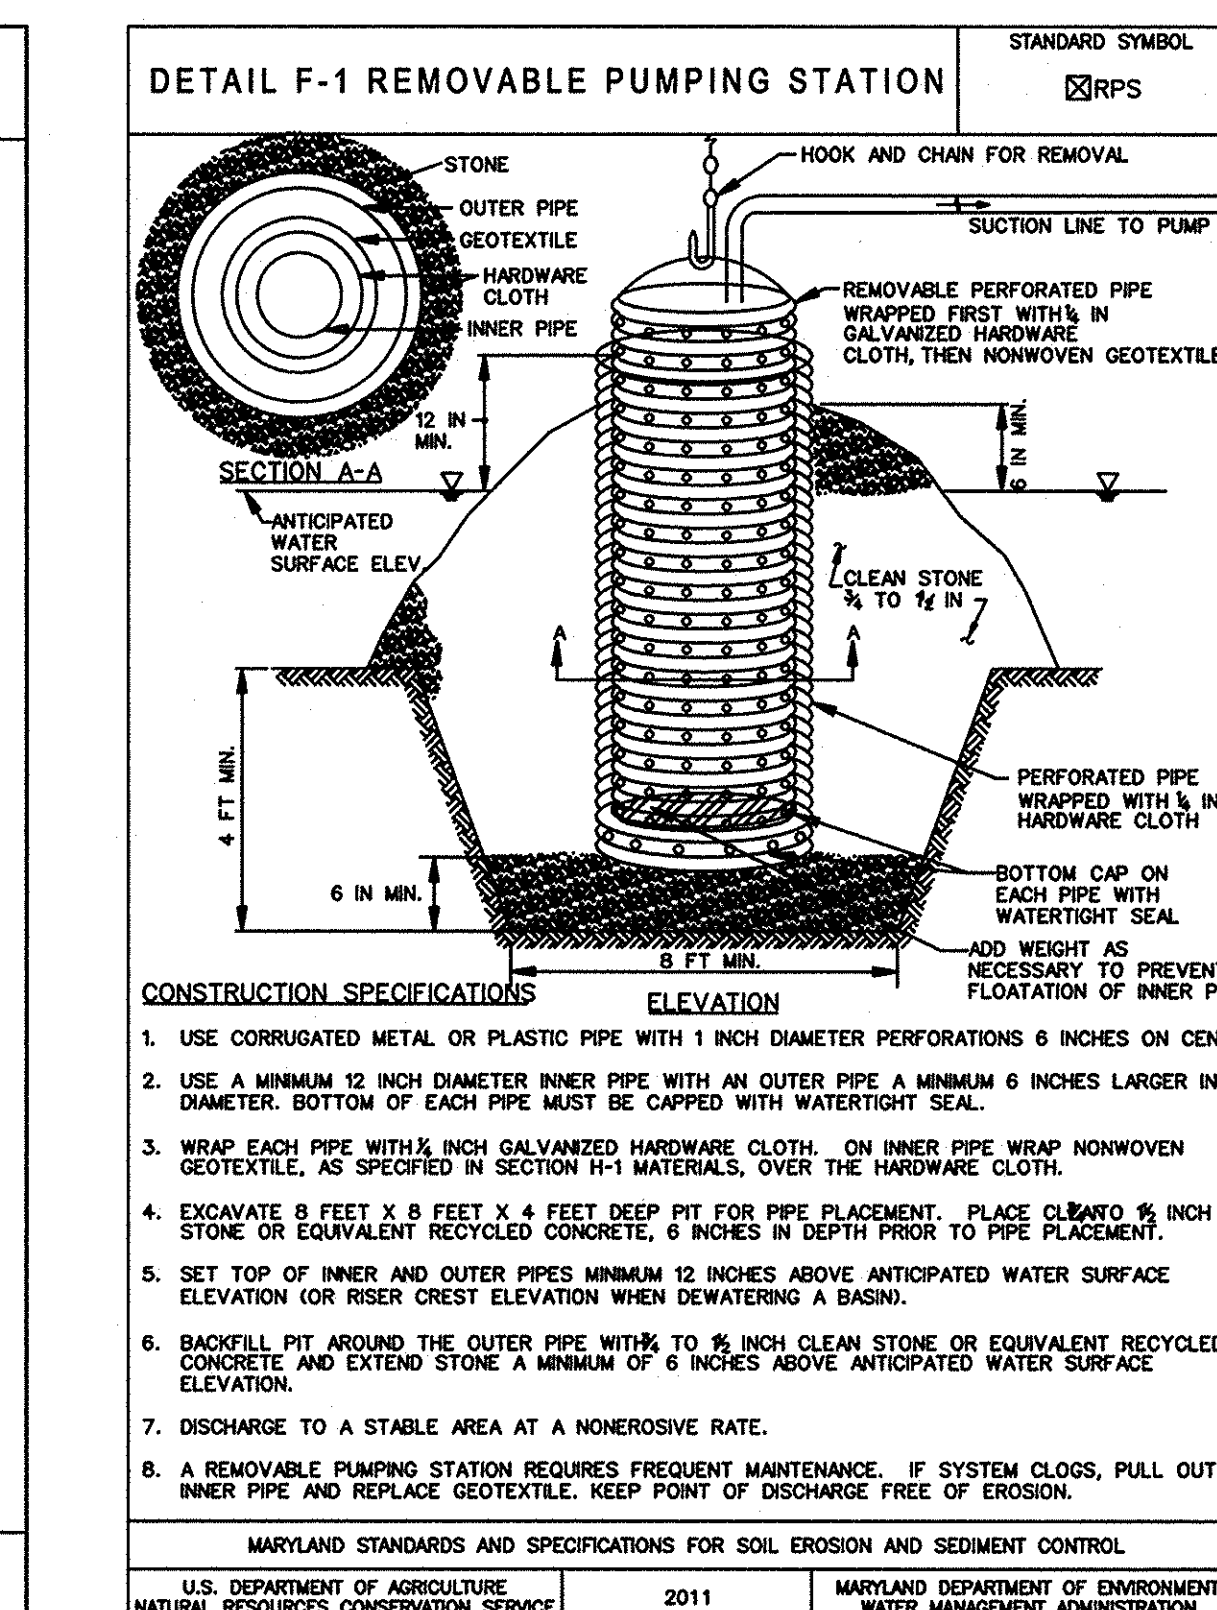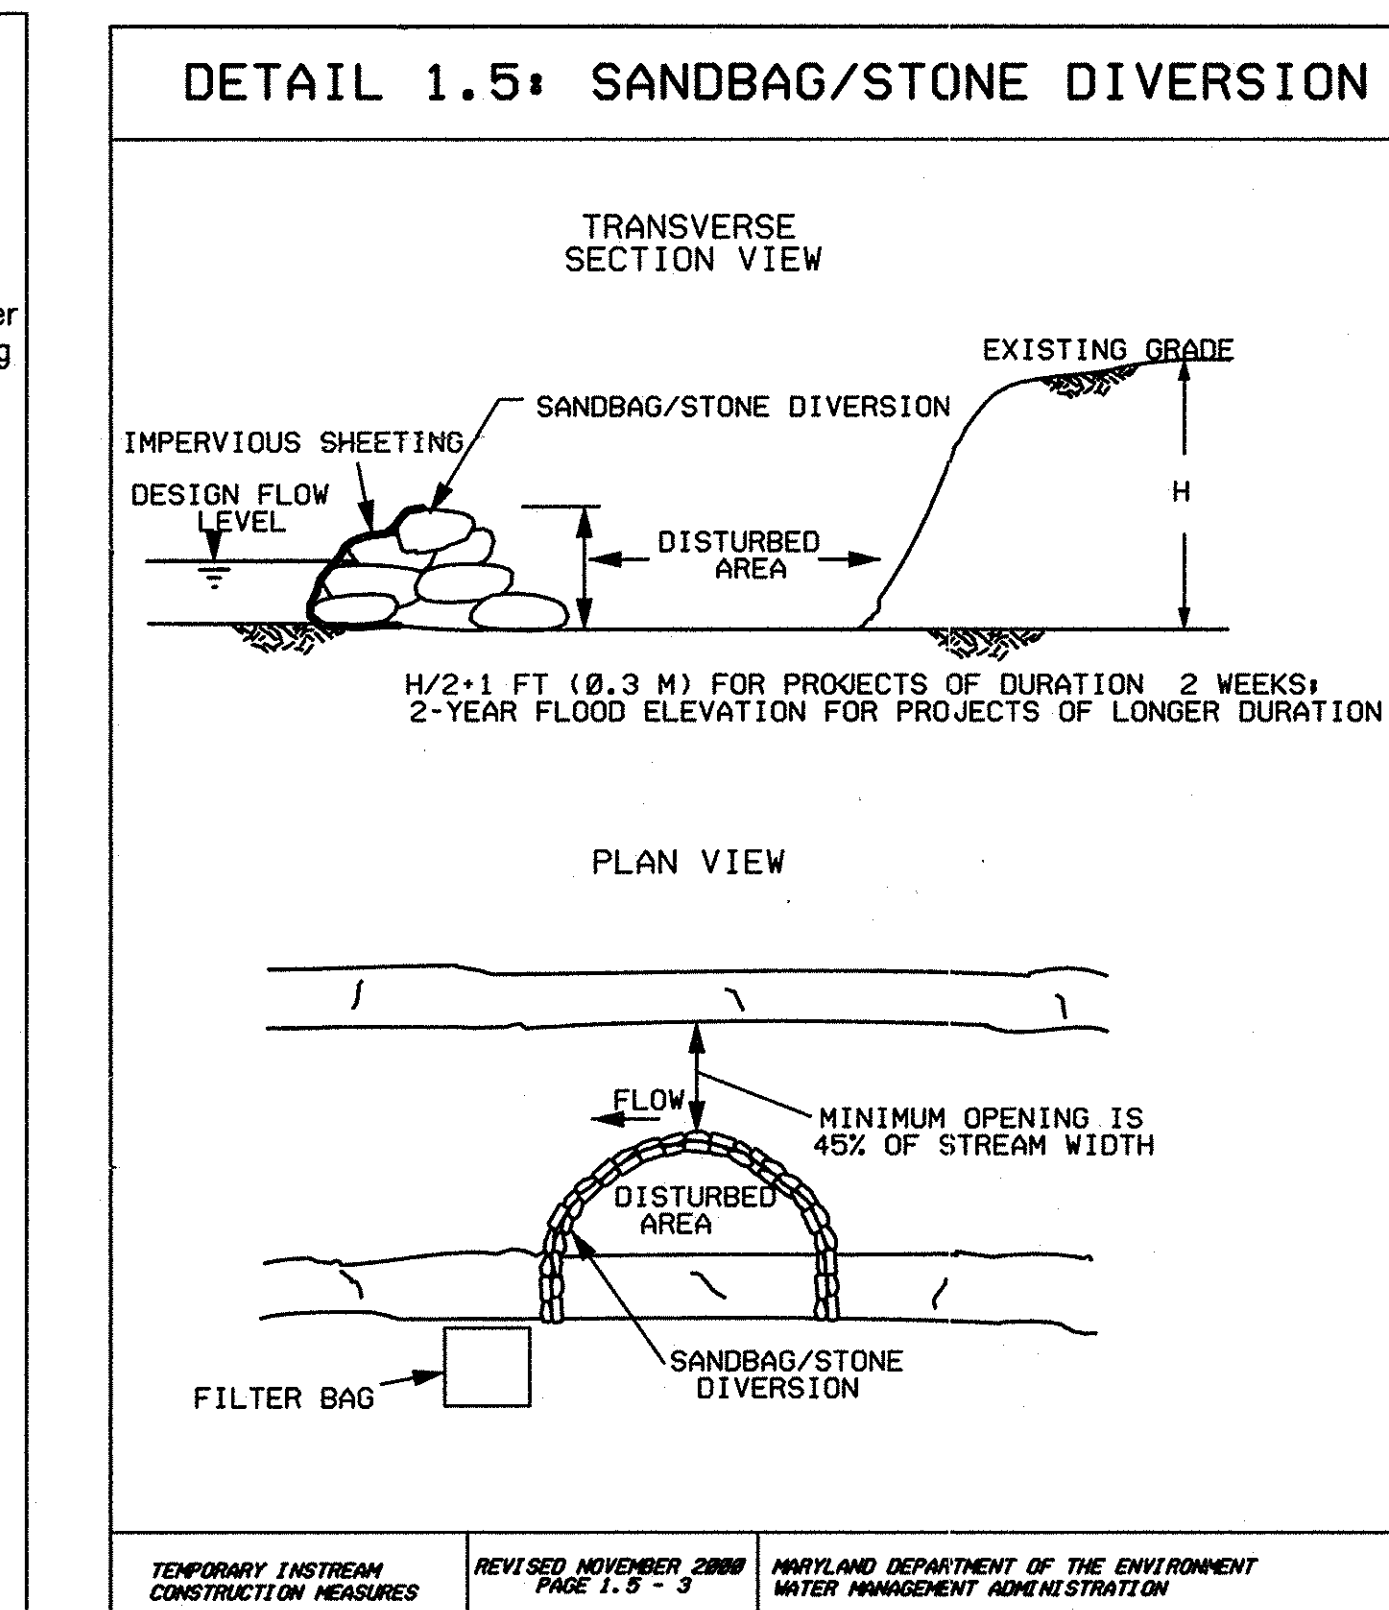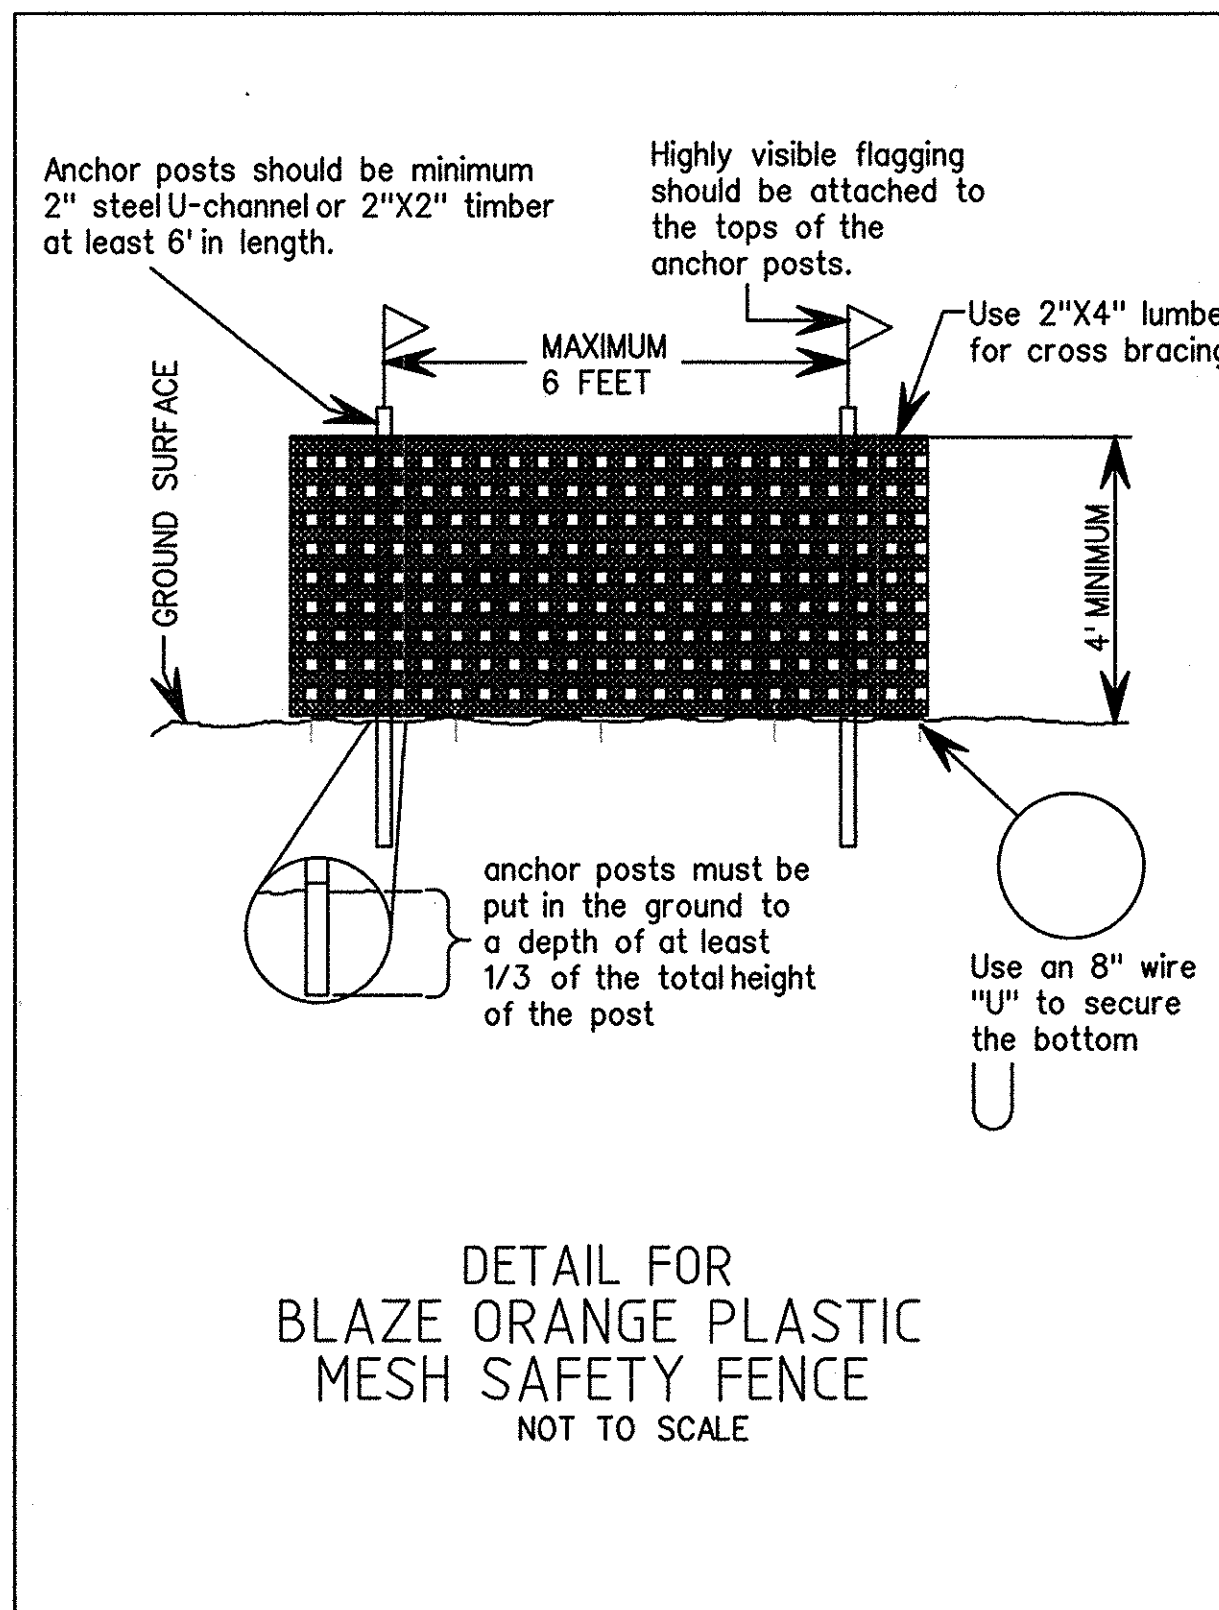

PROFESSIONAL CERTIFICATION. I HEREBY CERTIFY THAT THESE DOCUMENTS WERE PREPARED OR APPROVED BY ME, RAYMOND J. KRAHE, PE, AND THAT I AM A DULY LICENSED PROFESSIONAL ENGINEER UNDER THE LAWS OF THE STATE OF MARYLAND. LICENSE NO. 28634 EXPIRATION DATE: 2015-03-26

THIS DEVELOPMENT IS APPROVED FOR SOIL EROSION AND SEDIMENT CONTROL BY THE HOWARD SOIL CONSERVATION DISTRICT.

John K. Krahe, PE  
DATE: 9/9/14


DEPARTMENT OF PUBLIC WORKS, HOWARD COUNTY, MD

Michael P. ...  
DATE: 10/26/15

NO.	REVISIONS DESCRIPTION	DATE

KCI FILE: M-X 2013 \ 17133314.01

936 RIDGEBROOK ROAD  
SPARKS, MARYLAND 21152  
TELEPHONE: (410) 316-7800  
FAX: (410) 316-7818  
www.kci.com

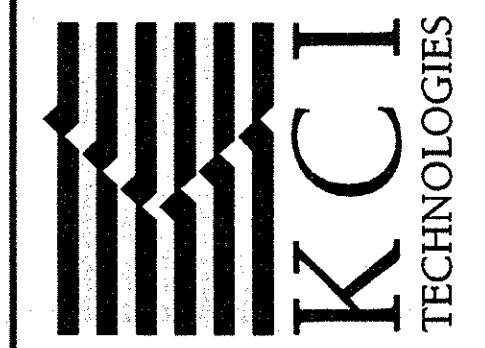

NORTHGATE WOODS  
STORMWATER POND REPAIR  
CAPITAL PROJECT D-1159  
HOWARD COUNTY DEPARTMENT OF PUBLIC WORKS  
STORMWATER MANAGEMENT DIVISION  
6751 COLUMBIA GATEWAY DRIVE  
COLUMBIA, MD 21046

EROSION & SEDIMENT CONTROL DETAILS

SCALE: AS SHOWN

DATE: APRIL 2014

KCI JOB NO.: 17133314.01

CAPITAL PROJECT NO.: D-1159

PERMIT ISSUE:

CONSTRUCTION ISSUE:



B-4-2 STANDARDS AND SPECIFICATIONS  
FOR  
SOIL PREPARATION, TOPSOILING, AND SOIL AMENDMENTS

**Definition**  
The process of preparing the soils to sustain adequate vegetative stabilization.

**Purpose**  
To provide a suitable soil medium for vegetative growth.

**Conditions Where Practice Applies**  
Where vegetative stabilization is to be established.

**Criteria**  
**A. Soil Preparation**

1. Temporary Stabilization
  - a. Seedbed preparation consists of loosening soil to a depth of 3 to 5 inches by means of suitable agricultural or construction equipment, such as disc harrows or chiselplows or rippers mounted on construction equipment. After the soils are loosened, it must not be rolled or dragged smooth but left in the roughened condition. Slopes 3:1 or flatter are to be tracked with ridges running parallel to the contour of the slope.
  - b. Apply fertilizer and lime as prescribed on the plans.
  - c. Incorporate lime and fertilizer into the top 3 to 5 inches of soil by disking or other suitable means.
2. Permanent Stabilization
  - a. A soil test is required for any earth disturbance of 5 acres or more. The minimum soil conditions required for permanent vegetative establishment are:
    - i. Soil pH between 6.0 and 7.0.
    - ii. Soluble salts less than 500 parts per million (ppm).
    - iii. Soil contains less than 40 percent clay but enough fine grained material (greater than 30 percent silt plus clay) to provide the capacity to hold a moderate amount of moisture. An exception: if lovegrass will be planted, then a sandy soil (less than 30 percent silt plus clay) would be acceptable.
    - iv. Soil contains 1.5 percent minimum organic matter by weight.
    - v. Soil contains sufficient pore space to permit adequate root penetration.
  - b. Application of amendments or topsoils is required if on-site soils do not meet the above conditions.
  - c. Graded areas must be maintained in a true and even grade as specified on the approved plan, then scarified or otherwise loosened to a depth of 3 to 5 inches.
  - d. Apply soil amendments as specified on the approved plan or as indicated by the results of a soil test.
  - e. Mix soil amendments into the top 3 to 5 inches of soil by disking or other suitable means. Rake lawn areas to smooth the surface, remove large objects like stones and branches, and ready the area for seed application. Loosen surface soil by dragging with a heavy chain or other equipment to roughen the surface where site conditions will not permit normal seedbed preparation. Track slopes 3:1 or flatter with tracked equipment leaving the soil in an irregular condition with ridges running parallel to the contour of the slope. Leave the top 1 to 3 inches of soil loose and friable. Seedbed loosening may be unnecessary on newly disturbed areas.

3. Topsoiling
  - a. Topsoils placed over prepared subsoil prior to establishment of permanent vegetation. The purpose is to provide a suitable soil medium for vegetative growth. Soils of concern have low moisture content, low nutrient levels, low pH, materials toxic to plants, and/or unacceptable soil gradation.
  2. Topsoil salvaged from an existing site may be used provided it meets the standards as set forth in these specifications. Typically, the depth of topsoil to be salvaged for a given soil type can be found in the representative soil profile section in the Soil Survey published by USDA-NRCS.
  3. Topsoiling is limited to areas having 2:1 or flatter slopes where:
    - a. The texture of the exposed subsoil/parent material is not adequate to produce vegetative growth.
    - b. The soil materials are so shallow that the rooting zone is not deep enough to support plants or furnish continuing supplies of moisture and plant nutrients.
    - c. The original soil to be vegetated contains material toxic to plant growth.
    - d. The soil is so acidic that treatment with limestone is not feasible.
  4. Areas having slopes steeper than 2:1 require special consideration and design.
  5. Topsoil Specifications: Soil to be used as topsoil must meet the following criteria:
    - a. Topsoil must be a loam, sandy loam, clay loam, silt loam, sandy clay loam, or loamy sand. Other soils may be used if recommended by an agronomist or soil scientist and approved by the appropriate approval authority. Topsoil must not be a mixture of contrasting textured subsoils and must contain less than 5 percent by volume of cinders, stones, slag, coarse fragments, gravel, sticks, roots, trash, or other materials larger than 1 1/2 inches in diameter.
    - b. Topsoil must be free of noxious plants or plant parts such as Bermuda grass, quack grass, Johnson grass, nut sedge, poison ivy, thistle, or others as specified.
    - c. Topsoil substitutes or amendments, as recommended by a qualified agronomist or soil scientist and approved by the appropriate approval authority, may be used in lieu of natural topsoil.
6. Topsoil Application
  - a. Erosion and sediment control practices must be maintained when applying topsoil.
  - b. Uniformly distribute topsoil in a 5 to 8 inch layer and lightly compact to a minimum thickness of 4 inches. Spreading is to be performed in such a manner that sodding or seeding can proceed with a minimum of additional soil preparation and tillage. Any irregularities in the surface resulting from topsoiling or other operations must be corrected in order to prevent the formation of depressions or water pockets.
  - c. Topsoil must not be placed if the topsoil or subsoils are in a frozen or muddy condition, when the subsoils excessively wet or in a condition that may otherwise be detrimental to proper grading and seedbed preparation.

7. Soil Amendments (Fertilizer and Lime Specifications)
  1. Soil tests must be performed to determine the exact ratios and application rates for both lime and fertilizer on sites having disturbed areas of 5 acres or more. Soil analysis may be performed by a recognized private or commercial laboratory. Soil samples taken for engineering purposes may also be used for chemical analyses.
  2. Fertilizers must be uniform in composition, free flowing and suitable for accurate application by appropriate equipment. Manure may be substituted for fertilizer with prior approval from the appropriate approval authority. Fertilizers must all be delivered to the site fully labeled according to the applicable laws and must bear the name, trade name or trademark and warranty of the producer.
  3. Lime materials must be ground limestone (hydrated or burnt lime may be substituted except when hydroseeding) which contains at least 50 percent total oxides (calcium oxide plus magnesium oxide). Limestone must be ground to such fineness that at least 50 percent will pass through a #100 mesh sieve and 98 to 100 percent will pass through a #20 mesh sieve.
  4. Lime and fertilizer are to be evenly distributed and incorporated into the top 3 to 5 inches of soil by disking or other suitable means.
  5. Where the subsoils are either highly acidic or composed of heavy clays, spread ground limestone at the rate of 4 to 8 tons/acre (200-400 pounds per 1,000 square feet) prior to the placement of topsoil.

B-4-5 STANDARDS AND SPECIFICATIONS

FOR PERMANENT STABILIZATION

**Definition**  
To stabilize disturbed soils with permanent vegetation.

**Purpose**  
To use long-lived perennial grasses and legumes to establish permanent ground cover on disturbed soils.

**Conditions Where Practice Applies**  
Exposed soils where ground cover is needed for 6 months or more.

- A. Seed Mixtures
  1. General Use
    - a. Select one or more of the species or mixtures listed in Table B.3 for the appropriate Plant Hardiness Zone (from Figure B.3) and based on the site condition or purpose found on Table B.3. Enter selected mixture(s), application rates, and seeding dates in the Permanent Seeding Summary. The Summary is to be placed on the plan.
    - b. Additional planting specifications for exceptional sites such as shorelines, stream banks, or dunes or for special purposes such as wildlife or aesthetic treatment may be found in USDA-NRCS Technical Field Office Guide, Section 342 - Critical Area Planting.
    - c. For sites having disturbed area over 5 acres, use and show the rates recommended by the soil testing agency.
    - d. For areas receiving low maintenance, apply urea form fertilizer (46-0-0) at 3 1/2 pounds per 1000 square feet (150 pounds per acre) at the time of seeding in addition to the soil amendments shown in the Permanent Seeding Summary.
  2. Turfgrass Mixtures
    - a. Areas where turfgrass may be desired include lawns, parks, playgrounds, and commercial sites which will receive a medium to high level of maintenance.
    - b. Select one or more of the species or mixtures listed below based on the site conditions or purpose. Enter selected mixture(s), application rates, and seeding dates in the Permanent Seeding Summary. The summary is to be placed on the plan.
      - i. Kentucky Bluegrass: Full Sun Mixture: For use in areas that receive intensive management. Irrigation required in the areas of central Maryland and Eastern Shore. Recommended Certified Kentucky Bluegrass Cultivars Seeding Rate: 1.5 to 2.0 pounds per 1000 square feet. Choose a minimum of three Kentucky bluegrass cultivars with each ranging from 10 to 35 percent of the total mixture by weight.
      - ii. Kentucky Bluegrass/Perennial Ryegrass: Full Sun Mixture: For use in full sun areas where rapid establishment is necessary and when turf will receive medium to intensive management. Certified Perennial Ryegrass Cultivars/Certified Kentucky Bluegrass Seeding Rate: 2 pounds mixture per 1000 square feet. Choose a minimum of three Kentucky bluegrass cultivars with each ranging from 10 to 35 percent of the total mixture by weight.
      - iii. Tall Fescue/Kentucky Bluegrass: Full Sun Mixture: For use in drought prone areas and/or for areas receiving low to medium management in full sun to medium shade. Recommended mixture includes: Certified Tall Fescue Cultivars 95 to 100 percent, Certified Kentucky Bluegrass Cultivars 9 to 5 percent. Seeding Rate: 5 to 8 pounds per 1000 square feet. One or more cultivars may be blended.
      - iv. Kentucky Bluegrass/Fine Fescue: Shade Mixture: For use in areas with shade in Bluegrass lawns. For establishment in high quality, intensively managed turf areas. Mixture includes: Certified Kentucky Bluegrass Cultivars 30 to 40 percent and Certified Fine Fescue and 60 to 70 percent. Seeding Rate: 1 1/2 to 3 pounds per 1000 square feet.

B-4-1 STANDARDS AND SPECIFICATIONS  
FOR INCREMENTAL STABILIZATION

- B. Incremental Stabilization - Fill Slopes
  1. Construct and stabilize fill slopes in increments not to exceed 15 feet in height. Prepare seedbed and apply seed and mulch on all slopes as the work progresses.
  2. Stabilize slopes immediately when the vertical height of a lift reaches 15 feet, or when the grading operation ceases as prescribed in the plans.
  3. At the end of each day, install temporary water conveyance practice(s), as necessary, to intercept surface runoff and convey it down the slope in a non-erosive manner.
  4. Construction sequence example (Refer to Figure B.2):
    - a. Construct and stabilize all temporary swales or dikes that will be used to divert runoff around the fill. Construct silt fence on low side of fill unless other methods shown on the plans address this area.
    - b. At the end of each day, install temporary water conveyance practice(s), as necessary, to intercept surface runoff and convey it down the slope in a non-erosive manner.
    - c. Place Phase 1 fill, prepare seedbed, and stabilize.
    - d. Place Phase 2 fill, prepare seedbed, and stabilize.
    - e. Place final phase fill, prepare seedbed, and stabilize. Overseed previously seeded areas as necessary.
5. Ideal Times of Seeding for Turf Grass Mixtures
 

Western MD:	March 15 to June 1, August 1 to October 1 (Hardiness Zones: 5b, 6a)
Central MD:	March 1 to May 15, August 15 to October 15 (Hardiness Zone: 6b)
Southern MD, Eastern Shore:	March 1 to May 15, August 15 to October 15 (Hardiness Zones: 7a, 7b)
6. Till areas to receive seed by disking or other approved methods to a depth of 2 to 4 inches, level and rake the area to prepare a proper seedbed. Remove stones and debris over 1/4 inch in diameter. The resulting seedbed must be in such condition that future mowing of grasses will pose no difficulty.
7. If soil moisture is deficient, supply new seedlings with adequate water for plant growth (1/4 to 1 inch every 3 to 4 days depending on soil texture) until they are firmly established. This is especially true when seedlings are made late in the planting season, in abnormally dry or hot seasons, or on adverse sites.

No.	Species	Application Rate (lb/ac)	Seeding Dates	Seeding Depths	Fertilizer Rate (10-20-20)			Lime Rate
					N	P <sub>2</sub> O <sub>5</sub>	K <sub>2</sub> O	
*10	ORCHARD GRASS	25	AUG. 1 to OCT. 15	1/4 - 1/2 in.	45 pounds per acre	90 lb/ac	90 lb/ac	2 tons/ac
	ORCHARD RED FESCUE	10	AUG. 1 to OCT. 15	1/4 - 1/2 in.	(1.0 lb/1000 sf)	(2.0 lb/1000 sf)	(2.0 lb/1000 sf)	(90 lb/1000 sf)
	RED TOP	1	AUG. 1 to OCT. 15	1/4 - 1/2 in.				
	ALSIKE CLOVER	3	AUG. 1 to OCT. 15	1/4 - 1/2 in.				
	WHITE CLOVER	3	AUG. 1 to OCT. 15	1/4 - 1/2 in.				

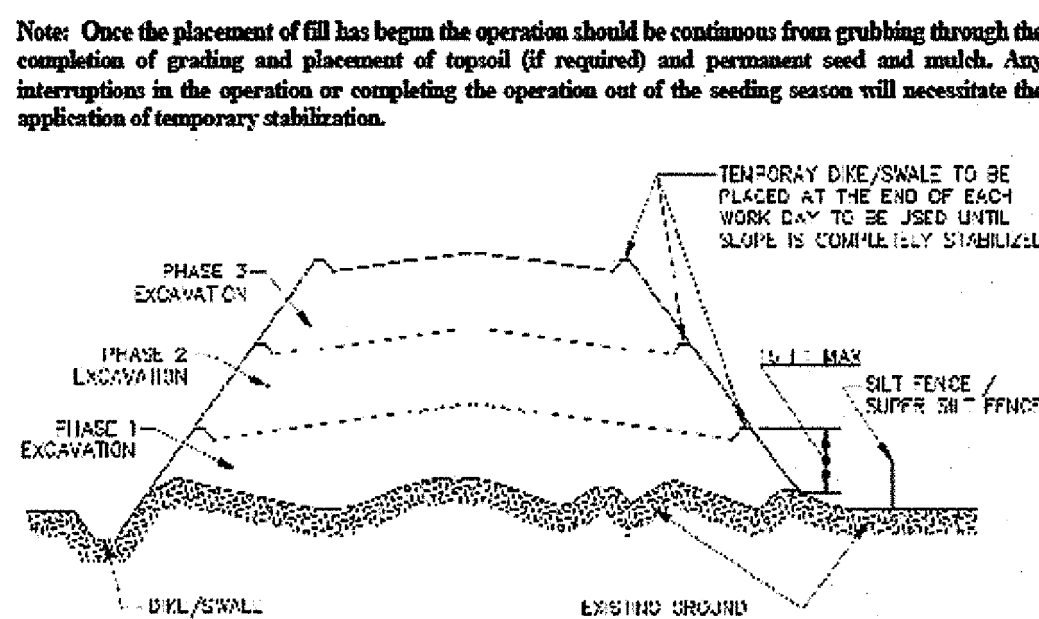


Figure B.2: Incremental Stabilization - Fill

B.11

B-4-4 STANDARDS AND SPECIFICATIONS

FOR TEMPORARY STABILIZATION

**Definition**  
To stabilize disturbed soils with vegetation for up to 6 months.

**Purpose**  
To use fast growing vegetation that provides cover on disturbed soils.

**Conditions Where Practice Applies**  
Exposed soils where ground cover is needed for a period of 6 months or less. For longer duration of time, permanent stabilization practices are required.

1. Select one or more of the species or seed mixtures listed in Table B.1 for the appropriate Plant Hardiness Zone (from Figure B.3), and enter them in the Temporary Seeding Summary below along with application rates, seeding dates and seeding depths. If this Summary is not put on the plan and completed, then Table B.1 plus fertilizer and lime rates must be put on the plan.
2. For sites having soil tests performed, use and show the recommended rates by the testing agency. Soil tests are not required for Temporary Seeding.
3. When stabilization is required outside of a seeding season, apply seed and mulch or straw mulch alone as prescribed in Section B-4-3.A.1.b and maintain until the next seeding season.

\*SELECTED Temporary Seeding Summary

No.	Species	Application Rate (lb/ac)	Seeding Dates	Seeding Depths	Fertilizer Rate (10-20-20)		Lime Rate
					N	P <sub>2</sub> O <sub>5</sub>	
	FOX TAIL MILLET	30	MAY 15 to JUL 31	1/2 in.	436 lb/ac	(10 lb/1000 sf)	2 tons/ac
						(90 lb/1000 sf)	

B.18

B-4-1 STANDARDS AND SPECIFICATIONS  
FOR INCREMENTAL STABILIZATION

- B. Incremental Stabilization - Fill Slopes
  1. Construct and stabilize fill slopes in increments not to exceed 15 feet in height. Prepare seedbed and apply seed and mulch on all slopes as the work progresses.
  2. Stabilize slopes immediately when the vertical height of a lift reaches 15 feet, or when the grading operation ceases as prescribed in the plans.
  3. At the end of each day, install temporary water conveyance practice(s), as necessary, to intercept surface runoff and convey it down the slope in a non-erosive manner.
  4. Construction sequence example (Refer to Figure B.2):
    - a. Construct and stabilize all temporary swales or dikes that will be used to divert runoff around the fill. Construct silt fence on low side of fill unless other methods shown on the plans address this area.
    - b. At the end of each day, install temporary water conveyance practice(s), as necessary, to intercept surface runoff and convey it down the slope in a non-erosive manner.
    - c. Place Phase 1 fill, prepare seedbed, and stabilize.
    - d. Place Phase 2 fill, prepare seedbed, and stabilize.
    - e. Place final phase fill, prepare seedbed, and stabilize. Overseed previously seeded areas as necessary.

**Note:** Once the placement of fill has begun the operation should be continuous from grubbing through the completion of grading and placement of topsoil (if required) and permanent seed and mulch. Any interruptions in the operation or completing the operation out of the seeding season will necessitate the application of temporary stabilization.

HOWARD COUNTY CONSERVATION DISTRICT  
STANDARD SEDIMENT CONTROL NOTES

1. A minimum of 48 hours notice must be given to the Howard County Department of Inspections, Licenses and Permits, Sediment Control Division prior to the start of any construction (315-1855).
2. All vegetative and structural practices are to be installed according to the provisions of this plan and are to be in conformance with the most current MARYLAND STANDARDS AND SPECIFICATIONS FOR SOIL EROSION AND SEDIMENT CONTROL and revisions thereto.
3. Following initial soil disturbance or re-disturbance, permanent or temporary stabilization shall be completed within: a) 3 calendar days for all perimeter sediment control structures, dikes, perimeter slopes and all slopes greater than 3:1; b) 7 days as to all other disturbed or graded areas on the project site.
4. All disturbed areas must be stabilized within the time period specified above in accordance with the 2011 MARYLAND STANDARDS AND SPECIFICATIONS FOR SOIL EROSION AND SEDIMENT CONTROL for permanent seeding (Sec. B-4-5), temporary seeding (Sec. B-4-4) and mulching (Sec. B-4-3). Temporary stabilization with mulch alone can only be done when recommended seeding dates do not allow for proper germination and establishment of grasses.
5. All sediment control structures are to remain in place and are to be maintained in operative condition until permission for their removal has been obtained from the Howard County Sediment Control Inspector.
6. Site Analysis:

NORTHGATE WOODS	
Total Area of Site	1.05 Acres
Area Disturbed	37,084 S.F./ 0.85 Acres
Area to be roofed or paved	0.0 Acres
Area to be vegetatively stabilized	37,084 S.F./ 0.85 Acres
Total Cut	0 Cu. Yds.
Total Fill	0 Cu. Yds.
Offsite waste/borrow area location and permit	To Be Determined*

7. Any sediment control practice that is disturbed by grading activity or placement of utilities must be repaired on the same day of disturbance. Additional sediment control must be provided, if deemed necessary by the Howard County Sediment Control Inspector.
9. On all sites with disturbed areas in excess of 2 acres, approval of the inspection agency shall be requested upon completion of installation of perimeter erosion and sediment controls, but before proceeding with any other earth disturbance or grading. Other building or grading inspection approvals may not be authorized until this initial approval by the inspection agency is made.
10. Trenches for the construction of utilities is limited to three pipe lengths or that which shall be back-filled and stabilized by the end of each workday, whichever is shorter.
11. Any changes or revisions to the sequence of construction must be reviewed and approved by the plan approval authority prior to proceeding with construction.
12. A project is to be sequenced so that grading activities begin on one grading unit (maximum acreage of 20 ac. per grading unit) at a time. Work may proceed to a subsequent grading unit when at least 50 percent of the disturbed area in the preceding grading unit has been stabilized and approved by the enforcement authority. Unless otherwise specified and approved by the approval authority, no more than 30 acres cumulatively may be disturbed at a given time.

\*USE SELECTED MIX ABOVE  
Table B.1: Temporary Seeding for Site Stabilization

Plant Species	Seeding Rate <sup>1/</sup>	Seeding Depth <sup>2/</sup>	Recommended Seeding Dates by Plant Hardiness Zone <sup>3/</sup>		
			5b and 6a	6b	7a and 7b
<b>Cool-Season Grasses:</b>					
Annual Ryegrass ( <i>Lolium perenne</i> ssp. multiflorum)	40	1.0	Mar 15 to May 31; Aug 1 to Sep 30	Mar 15 to Apr 30; Aug 15 to Nov 30	Feb 15 to Apr 30; Aug 15 to Nov 30
Barley ( <i>Hordeum vulgare</i> )	96	2.2	Mar 15 to May 31; Aug 1 to Sep 30	Mar 15 to Apr 30; Aug 15 to Nov 30	Feb 15 to Apr 30; Aug 15 to Nov 30
Oats ( <i>Avena sativa</i> )	72	1.7	Mar 15 to May 31; Aug 1 to Sep 30	Mar 15 to Apr 30; Aug 15 to Nov 30	Feb 15 to Apr 30; Aug 15 to Nov 30
Wheat ( <i>Triticum aestivum</i> )	120	2.8	Mar 15 to May 31; Aug 1 to Sep 30	Mar 15 to Apr 30; Aug 15 to Nov 30	Feb 15 to Apr 30; Aug 15 to Nov 30
Cereal Rye ( <i>Secale cereale</i> )	112	2.8	Mar 15 to May 31; Aug 1 to Oct 31	Mar 15 to Apr 30; Aug 15 to Dec 15	Feb 15 to Apr 30; Aug 15 to Dec 15
<b>Warm-Season Grasses:</b>					
Foxtail Millet ( <i>Setaria italica</i> )	30	0.7	Jun 1 to Jul 31	May 16 to Jul 31	May 1 to Aug 14
Pearl Millet ( <i>Pennisetum glaucum</i> )	20	0.5	Jun 1 to Jul 31	May 16 to Jul 31	May 1 to Aug 14

**NOTES:**  
1/ Seeding rates for the warm-season grasses are in pounds of Pure Live Seed (PLS). Actual planting rates shall be adjusted to reflect percent seed germination and purity, as tested. Adjustments are usually not needed for the cool-season grasses.  
Seeding rates listed above are for temporary seedings. When planted as a nurse crop with permanent seed mixes, use 1/3 of the seeding rate listed above for barley, oats, and wheat. For smaller-seeded grasses (annual ryegrass, pearl millet, foxtail millet), do not exceed more than 5% (by weight) of the overall permanent seeding mix. Cereal rye generally should not be used as a nurse crop, unless planting will occur in very late fall beyond the seeding dates for other temporary seedings. Cereal rye has allelopathic properties that inhibit the germination and growth of other plants. If it must be used as a nurse crop, seed at 1/5 of the rate listed above.  
Oats are the recommended nurse crop for warm-season grasses.  
2/ For sandy soils, plant seeds at twice the depth listed above.  
3/ The planting dates listed are averages for each Zone and may require adjustment to reflect local conditions, especially near the boundaries of the zone.

B.20

AS-BUILT 12-01-2015

THIS DEVELOPMENT IS APPROVED FOR SOIL EROSION AND SEDIMENT CONTROL BY THE HOWARD COUNTY CONSERVATION DISTRICT.

John K. Robertson  
HOWARD SCD

DEPARTMENT OF PUBLIC WORKS, HOWARD COUNTY, MD

12/9/14  
DATE  
M. H. D. L.  
CHIEF, BUREAU OF ENVIRONMENTAL SERVICES

12/8/15  
DATE




PROFESSIONAL CERTIFICATION: I HEREBY CERTIFY THAT THESE DOCUMENTS WERE PREPARED OR APPROVED BY ME, RAYMOND J. KRAHE, PE, AND THAT I AM A LICENSED PROFESSIONAL ENGINEER UNDER THE LAWS OF THE STATE OF MARYLAND. LICENSE NO. 28634. EXPIRATION DATE: 2015-03-26 2017-03-26

EROSION & SEDIMENT CONTROL NOTES  
AS-BUILT

SCALE: AS SHOWN  
DATE: APRIL 2014  
KCI JOB NO.: 17133314-01  
CAPITAL PROJECT NO.: D-1159  
PERMIT ISSUE:  
CONSTRUCTION ISSUE:

SHEET NO.: 10 OF 10

936 RIDGEBROOK ROAD  
SPARKS, MARYLAND 21152  
TELEPHONE: (410) 316-7800  
FAX: (410) 316-7818  
www.kci.com

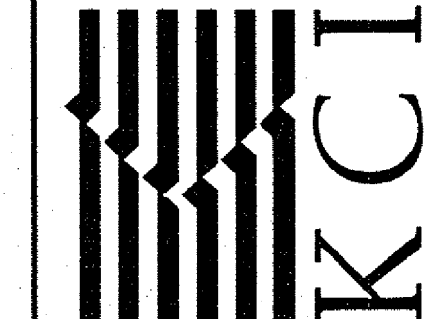

NORTHGATE WOODS  
STORMWATER POND REPAIR  
CAPITAL PROJECT D-1159  
HOWARD COUNTY DEPARTMENT OF PUBLIC WORKS  
STORMWATER MANAGEMENT DIVISION  
6781 COLUMBIA, GATEWAY DRIVE  
COLUMBIA, MD 21046

DATE  
REVISIONS DESCRIPTION  
NO.

KCI FILE: M - 2015 \ 17133314-01 \