ROADWAY AND STORM DRAINS
EMERSON
SECTION THREE AREA TWO
6th ELECTION DISTRICT
HOWARD COUNTY, MARYLAND

SHEET INDEX

NO	DESCRIPTION
1	TITLE SHEET
2	PLAN AND PROFILE OF UPPER SKY WAY
3	GRADING, SEDIMENT CONTROL PLAN AND DRAINAGE AREA MAP
4	GRADING AND SEDIMENT CONTROL PLAN
5	SEDIMENT CONTROL DETAILS
6	SEDIMENT CONTROL NOTES
7	STORMWATER MANAGEMENT DETAILS AND PROFILES
8	PROFILES AND DETAILS
9	LANDSCAPE PLAN
10	EXISTING CONDITIONS SWM DRAINAGE AREA MAP
11	PROPOSED CONDITIONS SWM DRAINAGE AREA MAP
12	SEDIMENT CONTROL DETAILS

GENERAL NOTES

1. ALL CONSTRUCTION SHALL BE IN ACCORDANCE WITH THE HOWARD COUNTY DESIGN MANUAL, VOL. IV "STANDARD SPECIFICATIONS AND DETAILS FOR CONSTRUCTION" PLUS MSHA STANDARDS AND SPECIFICATIONS, IF APPLICABLE.

2. THE CONTRACTOR SHALL NOTIFY THE DEPARTMENT OF PUBLIC WORKS/BUREAU OF ENGINEERING/CONSTRUCTION INSPECTION DIVISION AT (410) 313-1880 AT LEAST FIVE (5) WORKING DAYS PRIOR TO THE START OF WORK.

3. THE CONTRACTOR SHALL NOTIFY "MISS UTILITY" AT 1-800-257-7777 AY LEAST 48 HOURS PRIOR TO ANY EXCAVATION WORK BEING DONE.

4. TRAFFIC CONTROL DEVICES, MARKINGS, AND SIGNING SHALL BE IN ACCORDANCE WITH THE LATEST EDITION OF THE MANUAL ON UNIFORM TRAFFIC CONTROL DEVICES (MUTCD). ALL STREET AND REGULATORY SIGNS SHALL BE IN PLACE PRIOR TO THE PLACEMENT OF ANY ASPHALT.

5. STREET LIGHT PLACEMENT AND THE TYPE OF FIXTURE AND POLE SHALL BE IN ACCORDANCE WITH THE HOWARD COUNTY DESIGN MANUAL, VOLUME III (1993) AND AS MODIFIED BY "GUIDELINES FOR STREET LIGHTS IN RESIDENTIAL DEVELOPMENTS, (JANUARY 1998)." A MINIMUM SPACING OF 20' SHALL BE MAINTAINED BETWEEN ANY STREET LIGHT AND ANY TREE.

6. THE EXISTING TOPOGRAPHY IS TAKEN FROM AERIAL SURVEY MAPS WITH MAXIMUM TWO FOOT CONTOUR INTERVALS PREPARED BY AIR SURVEY CORP. FLOWN IN APRIL 1998.

7. THE COORDINATES SHOWN HEREON ARE BASED UPON THE HOWARD COUNTY GEODETIC CONTROL WHICH IS BASED UPON THE MARYLAND STATE PLANE COORDINATE SYSTEM. HOWARD COUNTY MONUMENT NOS. 47 E4 ALONG WITH 2 TRAVERSE POINTS WERE USED FOR THIS PROJECT.

8. WATER IS PUBLIC.

9. SEWER IS PUBLIC.

10. THE STORMWATER MANAGEMENT FOR THIS SITE WILL BE PROVIDED VIA THE GRASS CHANNEL CREDIT, AND A PUBLIC WET POND.

11. APPROXIMATE LOCATION OF EXISTING UTILITIES ARE SHOWN. THE CONTRACTOR SHALL TAKE ALL NECESSARY PRECAUTIONS TO PROTECT THE EXISTING UTILITIES AND MAINTAIN UNINTERRUPTED SERVICE. ANY DAMAGE INCURRED DUE TO CONTRACTOR'S OPERATION SHALL BE REPAIRED IMMEDIATELY AT THE CONTRACTOR'S EXPENSE. EXISTING UTILITIES ARE SHOWN BASED ON THE BEST AVAILABLE INFORMATION.

12. THE WETLANDS DELINEATION STUDY FOR THIS PROJECT WAS PREPARED BY DAFT McCUNE & WALKER, INC.

13. THE TRAFFIC STUDY FOR THIS PROJECT WAS PREPARED BY WELLS & ASSOCIATES DATED FEBRUARY 2000.

14. THE NOISE STUDY FOR THIS PROJECT WAS PREPARED BY CENTURY ENGINEERING DATED MARCH 1999.

15. THIS PROJECTS FALLS UNDER THE APPROVED AFPO STUDY OF S-99-12.

16. THE BOUNDARY SURVEY FOR THIS PROJECT WAS PREPARED BY DAFT, McCUNE & WALKER, INC. JULY 2000.

17. SUBJECT PROPERTY ZONED PEC-MXD-3 AND R-SC-MXD-3 PER ZONING BOARD CASE ZB-979-M.

18. ALL ELEVATIONS SHOWN ARE BASED ON THE U.S.C. AND G.S. MEAN SEA LEVEL DATUM, 1929.

19. SEE DEPARTMENT OF PLANNING AND ZONING FILE NO'S.: S-99-12, PB-339, ZB-979-M, P-02-22, PB-359.

20. THE CONTRACTOR SHALL TEST PIT EXISTING UTILITIES AT LEAST (5) DAYS BEFORE STARTING WORK SHOWN ON THESE DRAWINGS.

21. CONTRACTOR IS SOLELY RESPONSIBLE FOR CONSTRUCTION MEANS, METHODS, TECHNIQUES, SEQUENCES, PROCEDURES, AND SAFETY PRECAUTIONS AND PROGRAMS.

22. PIPE SHALL NOT BE INSTALLED BY THE CONTRACTOR UNTIL THE LENGTH CALLED FOR AT EACH STATION HAS BEEN APPROVED BY THE ENGINEER IN THE FIELD.

23. NO PIPE SHALL BE LAID UNTIL LINES OF EXCAVATION HAVE BEEN BROUGHT WITHIN 6" OF FINISHED GRADE.

24. ALL INLETS SHALL BE CONSTRUCTED IN ACCORDANCE WITH HOWARD COUNTY STANDARDS.

25. ALL PIPE ELEVATIONS SHOWN ARE INVERT ELEVATIONS.

26. STORM DRAIN TRENCHES WITHIN ROAD RIGHT OF WAY SHALL BE BACKFILLED AND COMPACTED IN ACCORDANCE WITH THE HOWARD COUNTY DESIGN MANUAL, VOLUME IV, i.e., STANDARD SPECIFICATIONS AND DETAILS FOR CONSTRUCTION, LATEST AMENDMENTS.

27. PROFILE STATIONS SHALL BE ADJUSTED AS NECESSARY TO CONFORM TO PLAN DIMENSIONS.

28. DESIGNED TRAFFIC SPEED IN ACCORDANCE WITH THE HOWARD COUNTY DESIGN MANUAL VOL. III. ALL 60' RIGHT OF WAYS 30 M.P.H.

29. ALL FILL AREAS WITHIN ROADWAY AND UNDER STRUCTURES TO BE COMPACTED TO A MINIMUM OF 95% COMPACTION OF AASHTO T180.

30. ALL STREET CURB RETURNS SHALL HAVE 35' RADII UNLESS OTHERWISE NOTED.

31. ALL STREET LIGHTS SHALL BE LOCATED BETWEEN 2'-0" AND 4'-0" BEHIND FACE OF CURB.

32. STREET TREES LOCATION, TYPE AND NUMBER OF TREES SHOWN ON THIS PLAN ARE TENTATIVE AND ARE USED FOR BOND PURPOSES ONLY. THE FINAL LOCATION AND VARIETY OF LOCATION AND VARIETY OF TREES MAY VARY TO ACCOMODATE FIELD CONDITIONS INCLUDING 20' CLEARANCE OF ANY STREET LIGHT AND SHALL BE IN ACCORDANCE WITH THE SUBDIVISION REGULATIONS AND THE LANDSCAPE MANUAL. BOND RELEASE IS CONTINGENT UPON SECTION 16.124 OF THE HOWARD COUNTY SUBDIVISION REGULATIONS, AS APPROVED BY THE DEPARTMENT OF PLANNING AND ZONING.

33. STREAM BUFFERS ARE DETERMINED BY LAND USE ADJOINING THE OPEN SPACE. EMPLOYMENT USE = 50' BUFFER FROM ANY STREAM. RESIDENTIAL USES= 50' BUFFER FOR INTERMITTENT STREAMS AND 75' BUFFER FOR PERENNIAL STREAMS.

34. THE 100-YEAR FLOODPLAIN FOR HAMMOND BRANCH WAS OBTAINED FROM THE HOWARD COUNTY FLOODPLAIN STUDY DATED NOV. 1980 REF. D-6-10-26 & AUG 1986 REF. D-1065. THE 100 YEAR FLOODPLAIN FOR THE REMAINING STREAMS ARE FROM THE FLOODPLAIN STUDY PREPARED BY DAFT McCUNE AND WALKER MARCH 2000.

35. DEVELOPMENT OF EMERSON SECTION 3, AREA 2 UNDER THE CURRENT FOREST CONSERVATION ACT INVOLVES THE CLEARING OF APPROXIMATELY 2.20 ACRES OF FOREST AND 0 ACRES OF RETENTION. WHEN CONSIDERED CUMULATIVELY WITH PREVIOUS PHASES OF THE PROJECT, NO REFORESTATION IS REQUIRED.

36. THERE ARE NO KNOWN CEMETARIES OR GRAVE SITES ON THIS PROPERTY.

37. SOIL MAP #33.

38. THE LIMITS OF ALL STREAMS AND WETLANDS SHOWN HEREON HAVE BEEN APPROVED BE THE US ARMY CORPS OF ENGINEERS WITH JURISDICTIONAL DETERMINATION # CENAB-OP-RMS00-61707-11, DATED APRIL 13, 2001.

39. THE WATER MANAGEMENT ADMINISTRATION INTENDS TO ISSUE A MODIFICATION OF AUTHORIZATION FOR THE PROPOSED WORK WITHIN THE FLOODPLAIN AND STREAM AREA. NON-TIDAL WETLANDS AND WATERWAYS PERMIT NO. 01-NT-0222/200164-079.

FOREST CONSERVATION GOALS AND OBJECTIVES

The goals and objectives of this Forest Conservation Plan are to identify forests to be cleared under Emerson 3, Section 2, and to evaluate the reforestation requirement generated by this clearing. Under this phase, approximately 2.20 + acres of forest will be cleared, and no retention is proposed. When evaluated cumulatively with previous phases of the Emerson project, no reforestation is required. Please note that the gross site acreage used for this phase's forest conservation calculations include 1.07 + acres for the proposed sanitary sewer extension, including 0.08 + acres of floodplain. This "off-site" area is included in the forest conservation calculations in order to account for forest clearing associated with the sewer extension, and it should be noted that this acreage is slightly higher than that identified on the plat for this phase.

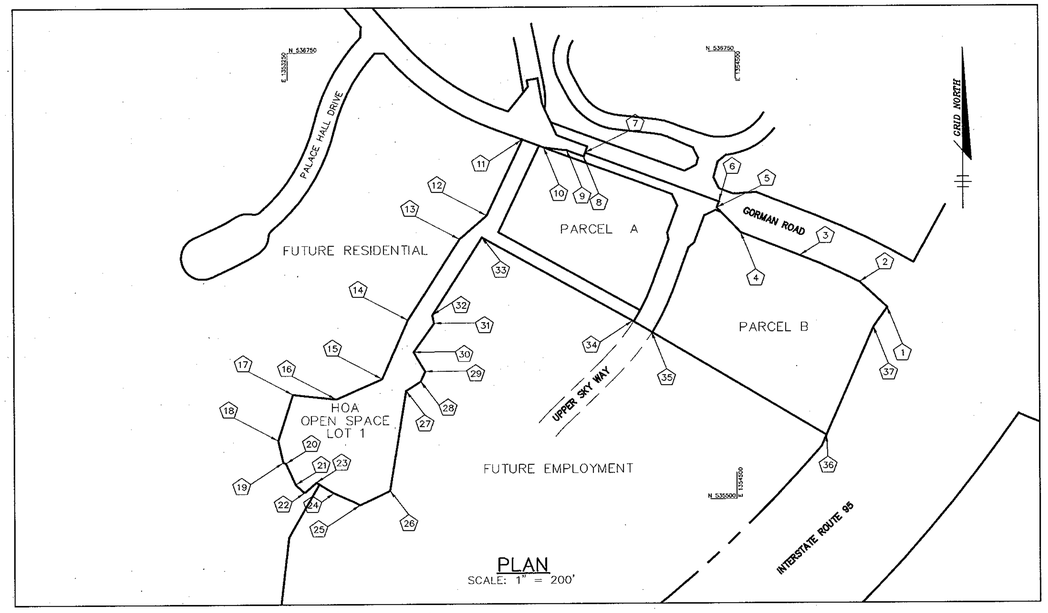

PLAN
SCALE: 1" = 200'

BENCHMARKS

TRAVERSE POINT 102
ELEVATION 346.19
N 536,499.165
E 1,353,974.017
LOCATED NEAR THE INTERSECTION OF GORMAN ROAD AND SKYLARK BLVD.

TRAVERSE POINT 1154
ELEVATION 347.45
N 536,018.069
E 1,355,129.333
LOCATED NEAR THE I-95 BRIDGE ALONG GORMAN ROAD

CONTROL STATION 47E4
ELEVATION 339.00
N 535,846.16
E 1,355,431.23
LOCATED NEAR THE I-95 BRIDGE ALONG GORMAN ROAD

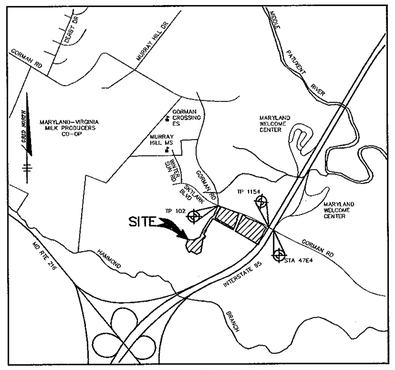

VICINITY MAP
SCALE: 1"=2000'

FOREST CONSERVATION CALCULATIONS

BASIC SITE DATA	ACRES (1/100)
GROSS SITE AREA	220.27
AREA WITHIN 100 YEAR FLOODPLAIN	21.27
AREA WITHIN AGRICULTURAL USE OR PRESERVATION PARCEL (IF APPLICABLE)	0.0
NET TRACT AREA	199.00
LAND USE CATEGORY	COMMERCIAL/INDUSTRIAL/OFFICE

INFORMATION FOR CALCULATIONS	
A. NET TRACT AREA	199.00
B. REFORESTATION THRESHOLD (15% x A)	29.85
C. AFFORESTATION MINIMUM (15% x A)	29.85
D. EXISTING FOREST ON NET TRACT AREA	87.50
E. FOREST AREAS TO BE CLEARED	41.67
F. FOREST AREAS TO BE RETAINED	45.83

REFORESTATION CALCULATIONS	
A. NET TRACT AREA	199.00
B. REFORESTATION THRESHOLD (15% x A)	29.85
C. EXISTING FOREST ON NET TRACT AREA	87.50
D. FOREST AREAS TO BE CLEARED	41.67
E. FOREST AREAS TO BE RETAINED	45.83
F. FOREST AREAS CLEARED ABOVE REFORESTATION THRESHOLD	41.67
G. FOREST AREAS CLEARED BELOW REFORESTATION THRESHOLD	0.00
H. FOREST AREAS RETAINED ABOVE REFORESTATION THRESHOLD	15.98

CLEARING ABOVE THE THRESHOLD ONLY

IF FOREST AREAS TO BE RETAINED ARE GREATER THAN THE REFORESTATION THRESHOLD (IF E IS GREATER THAN B), THE FOLLOWING CALCULATIONS APPLY:

REFORESTATION FOR CLEARING ABOVE THRESHOLD Fx1/4	10.42
REFORESTATION FOR CLEARING BELOW THRESHOLD Gx2	0.00
TOTAL REFORESTATION REQUIRED (Fx1/4) + (Gx2)	10.42
CREDIT FOR RETENTION ABOVE CONSERVATION THRESHOLD	15.98
REFORESTATION REQUIRED	0.00 ACRES
REFORESTATION PROVIDED	5.03 ACRES
TOTAL	5.03 ACRES

FOREST CONSERVATION TRACKING CHART

SECTION PHASE	GROSS AREA	FLOODPLAIN AREA	NET TRACT AREA	EX. FOREST AREA	FOREST * CLEARED	FOREST RETAINED	REFOR./AFFOR. REQUIRED	REFOR./AFFOR. PROVIDED	EXCESS REFOR./AFFOR.	FUTURE FOREST CLEARING	FUTURE REFOR./AFFOR.	COMMENTS
2/1A&1B	106.20	3.50	102.70	24.70	7.93	16.77	0.61	5.03	4.42	4.48	3.41	
2/2	118.90	3.50	115.40	24.80	8.03	16.77	2.95	5.03	2.08	3.28	3.41	SEE NOTE A
2/3	137.35	4.00	113.35	34.40	12.53	21.87	1.27	5.03	3.76	2.18	3.91	SEE NOTE B
3/1	206.85	21.19	185.66	85.30	39.47	45.83	0.00	5.03	5.03	2.18	3.91	
3/2	220.27	21.27	199.00	87.50	41.67	45.83	0.00	5.03	5.03	2.18	3.91	SEE NOTE C

TABULATIONS SHOWN ABOVE FOR EACH PHASE WILL REFLECT CUMULATIVE TOTALS FOR THIS PHASE AND ALL PREVIOUS PHASES.
THE FOREST CLEARED INCLUDES THE ACREAGE OF POSSIBLE FUTURE FOREST CLEARING.
A. 1.20 +/- ACRES OF FUTURE FOREST CLEARING SHOWN ON F-01-137 WAS CLEARED FOR SWM ON OPEN SPACE LOT 174.
B. 1.10 +/- ACRES OF FUTURE FOREST CLEARING SHOWN ON F-01-137 WAS CLEARED FOR SWM ON OPEN SPACE LOT 176.
C. GROSS AREA INCLUDES 1.07 +/- ACRES FOR SANITARY SEWER EXTENSION, AND CONTAINS 0.08 +/- ACRES OF FLOODPLAIN.

APPROVED : HOWARD COUNTY DEPARTMENT OF PUBLIC WORKS.
CHIEF, BUREAU OF HIGHWAYS — DATE 11-8-02

APPROVED : HOWARD COUNTY DEPARTMENT OF PLANNING AND ZONING.
CHIEF, DIVISION OF LAND DEVELOPMENT — DATE 11/20/02
CHIEF, DEVELOPMENT ENGINEERING DIVISION — DATE 11/14/02

DATE	NO.	REVISION

OWNER/DEVELOPER
THE HOWARD RESEARCH AND DEVELOPMENT CORPORATION
THE ROUSE BUILDING
10275 LITTLE PATUXENT PARKWAY
COLUMBIA, MARYLAND 21044
410-992-6000

PROJECT
EMERSON
SECTION THREE AREA TWO

AREA
TAX MAP 47 BLOCK 8 & 9
ZONED: PEC-MXD-3 PART OF PARCELS: 462 & 837
6th ELECTION DISTRICT HOWARD COUNTY, MARYLAND

TITLE
TITLE SHEET

Patton Harris Rust & Associates, pc
Engineers. Surveyors. Planners. Landscape Architects.
8818 Centre Park Drive
Columbia, MD 21045
T 410.997.8900
F 410.997.9282

10-18-02
DATE

STATE OF MARYLAND — CHRISTOPHER J. REID — No. 19949 — PROFESSIONAL ENGINEER

CHRISTOPHER J. REID #19949

DESIGNED BY : A.C.R
DRAWN BY : DAM
CHECKED BY : C.J.R.
PERMIT TRACKING NUMBER 01-NT-0222/200164079
DATE : OCTOBER 21, 2002
SCALE : AS SHOWN
DRAWING NO. 1 OF 12

F-02-178 C-RD1.DWG

J:\project\2245611-01Engr\Plans\FINALS\C-RD1.dwg, Layout1, 10/17/02 02:11:24 PM, HP750C(36).pc3, Arch D - 24 x 36 in. (landscape), 1:1

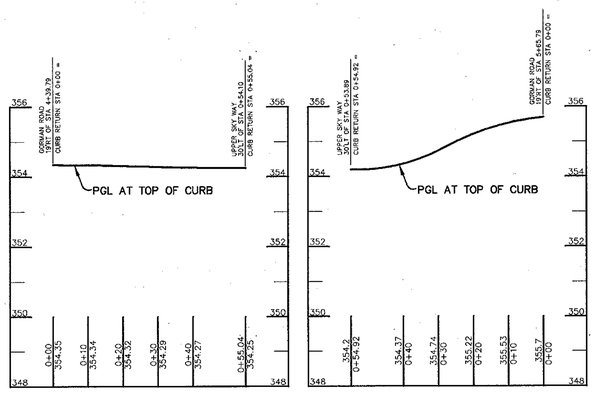

PROFILE
SCALE : HOR.-1"=20' VERT.-1"=2'

PROFILE
SCALE : HOR.-1"=20' VERT.-1"=2'

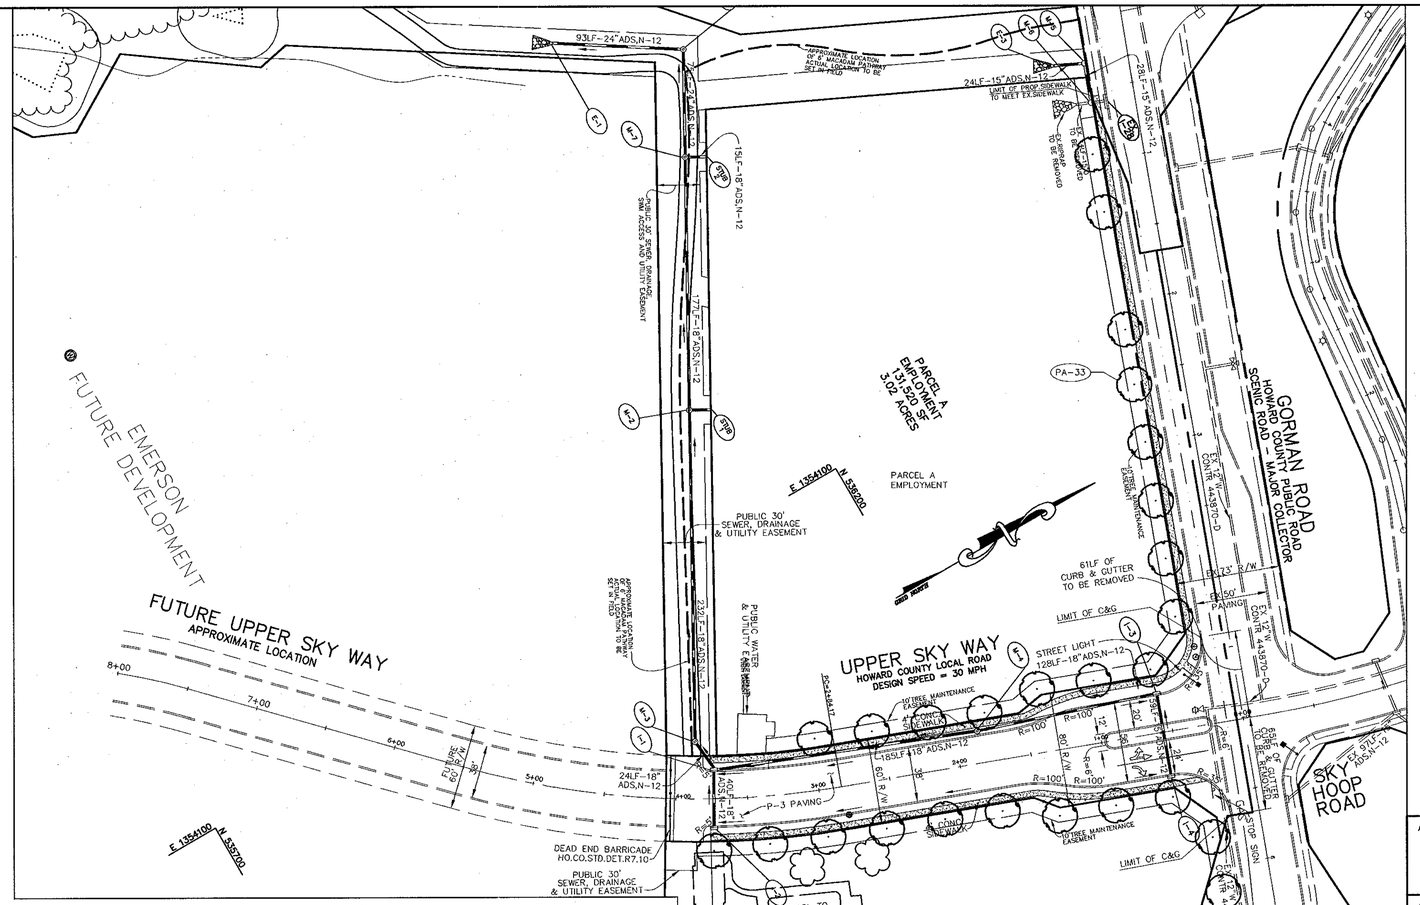

PLAN
SCALE: 1" = 50'

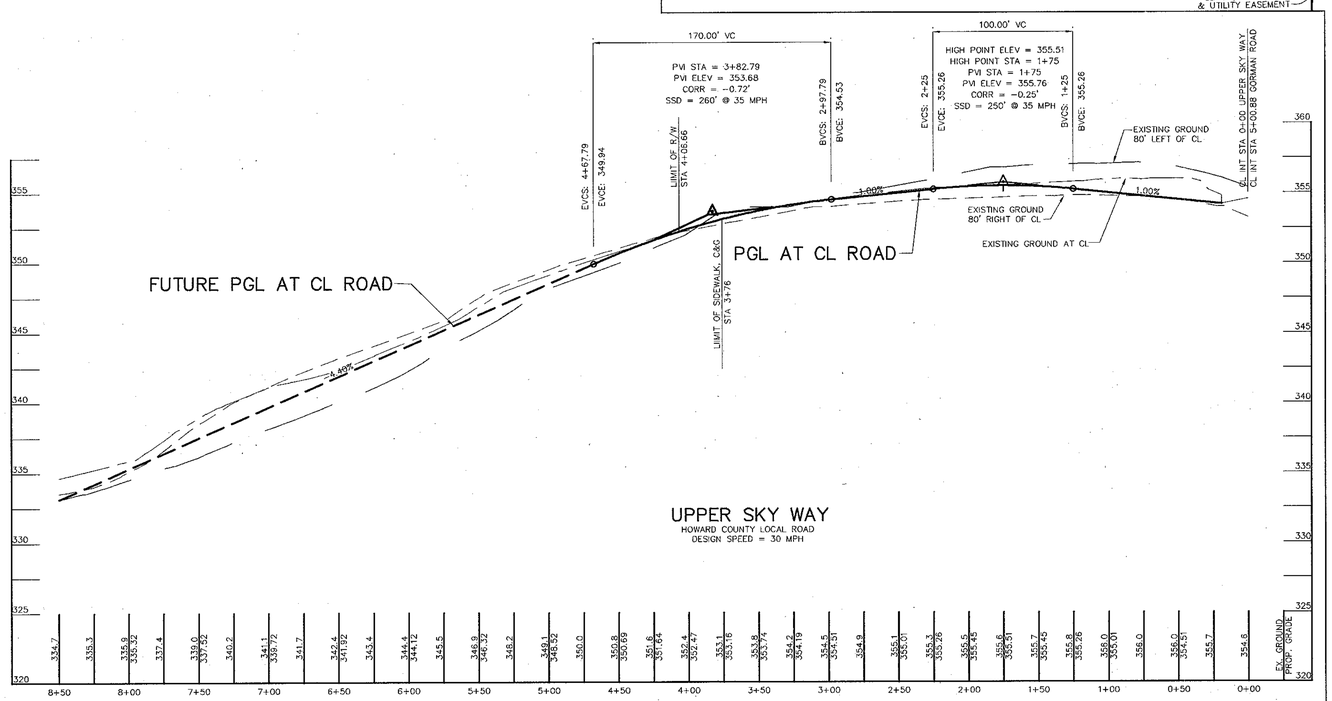

PROFILE
SCALE: HOR. 1" = 50' VERT. 1" = 5'

STREET TREE PLANT LIST

KEY	QTY	BOTANICAL AND COMMON NAME	SIZE	ROOT
PA	33	Platanus xacerifolia London Plane Tree	2-1/2" - 3"	B & B

CL CURVE DATA
FROM CL STA 2+84 TO STA 5+52
RADIUS = 600.0
LENGTH = 268.18
TANGENT = 136.37
DELTA = 25° 36'32"
CHORD = S 33° 14'56"W 265.95'

CURB TRANSITION DATA RIGHT
FROM CL STA 1+19 TO STA 1+51
RADIUS = 100.00'
LENGTH = 33.32'
TANGENT = 16.82'
DELTA = 19° 5'28"
CHORD = N 10°53'56"E 33.17'

CURB TRANSITION DATA RIGHT
FROM CL STA 1+51 TO 1+84
RADIUS = 100.00'
LENGTH = 33.32'
TANGENT = 16.82'
DELTA = 19° 5'28"
CHORD = N 10°53'56"E 33.17'

CURB TRANSITION DATA LEFT
FROM CL STA 1+19 TO STA 1+51
RADIUS = 100.00'
LENGTH = 33.32'
TANGENT = 16.82'
DELTA = 19° 5'28"
CHORD = S 29°59'29"W 33.17'

CURB TRANSITION DATA LEFT
FROM CL STA 1+51 TO 1+84
RADIUS = 100.00'
LENGTH = 33.32'
TANGENT = 16.82'
DELTA = 19° 5'28"
CHORD = S 29°59'24"W 33.17'

STREET LIGHT DATA
LOCATE 37' RIGHT OF CL STA 0+35 UPPER SKY WAY.
POLE HEIGHT = 30' LIGHT FIXTURE = 250w HPS
POLE TYPE = BRONZE ALUMINUM

APPROVED : HOWARD COUNTY DEPARTMENT OF PUBLIC WORKS.
CHIEF, BUREAU OF HIGHWAYS — DATE 11-8-02

APPROVED : HOWARD COUNTY DEPARTMENT OF PLANNING AND ZONING.
CHIEF, DIVISION OF LAND DEVELOPMENT — DATE 11/21/02
CHIEF, DEVELOPMENT ENGINEERING DIVISION — DATE 11/14/02

DATE	NO.	REVISION

OWNER/DEVELOPER
THE HOWARD RESEARCH AND DEVELOPMENT CORPORATION
THE ROUSE BUILDING
10275 LITTLE PATUXENT PARKWAY
COLUMBIA, MARYLAND 21044
410-992-6000

PROJECT
EMERSON
SECTION THREE AREA TWO

AREA
TAX MAP 47 BLOCK 8 & 9
ZONED: PEC-MXD-3 PART OF PARCELS: 462 & 837
6th ELECTION DISTRICT HOWARD COUNTY, MARYLAND

TITLE
PLAN AND PROFILE OF UPPER SKY WAY

Patton Harris Rust & Associates, pc
Engineers. Surveyors. Planners. Landscape Architects.
8818 Centre Park Drive
Columbia, MD 21045
T 410.997.8900
F 410.997.9282

10-19-02
DATE

STATE OF MARYLAND — CHRISTOPHER J. REID — No. 19949 — PROFESSIONAL ENGINEER

CHRISTOPHER J. REID #19949

DESIGNED BY : A.C.R
DRAWN BY : DAM
CHECKED BY : C.J.R.
PERMIT TRACKING NUMBER 01-NT-0222/200164079
DATE : OCTOBER 21, 2002
SCALE : AS SHOWN
DRAWING NO. 2 OF 12

F-02-178 C-RD2.DWG

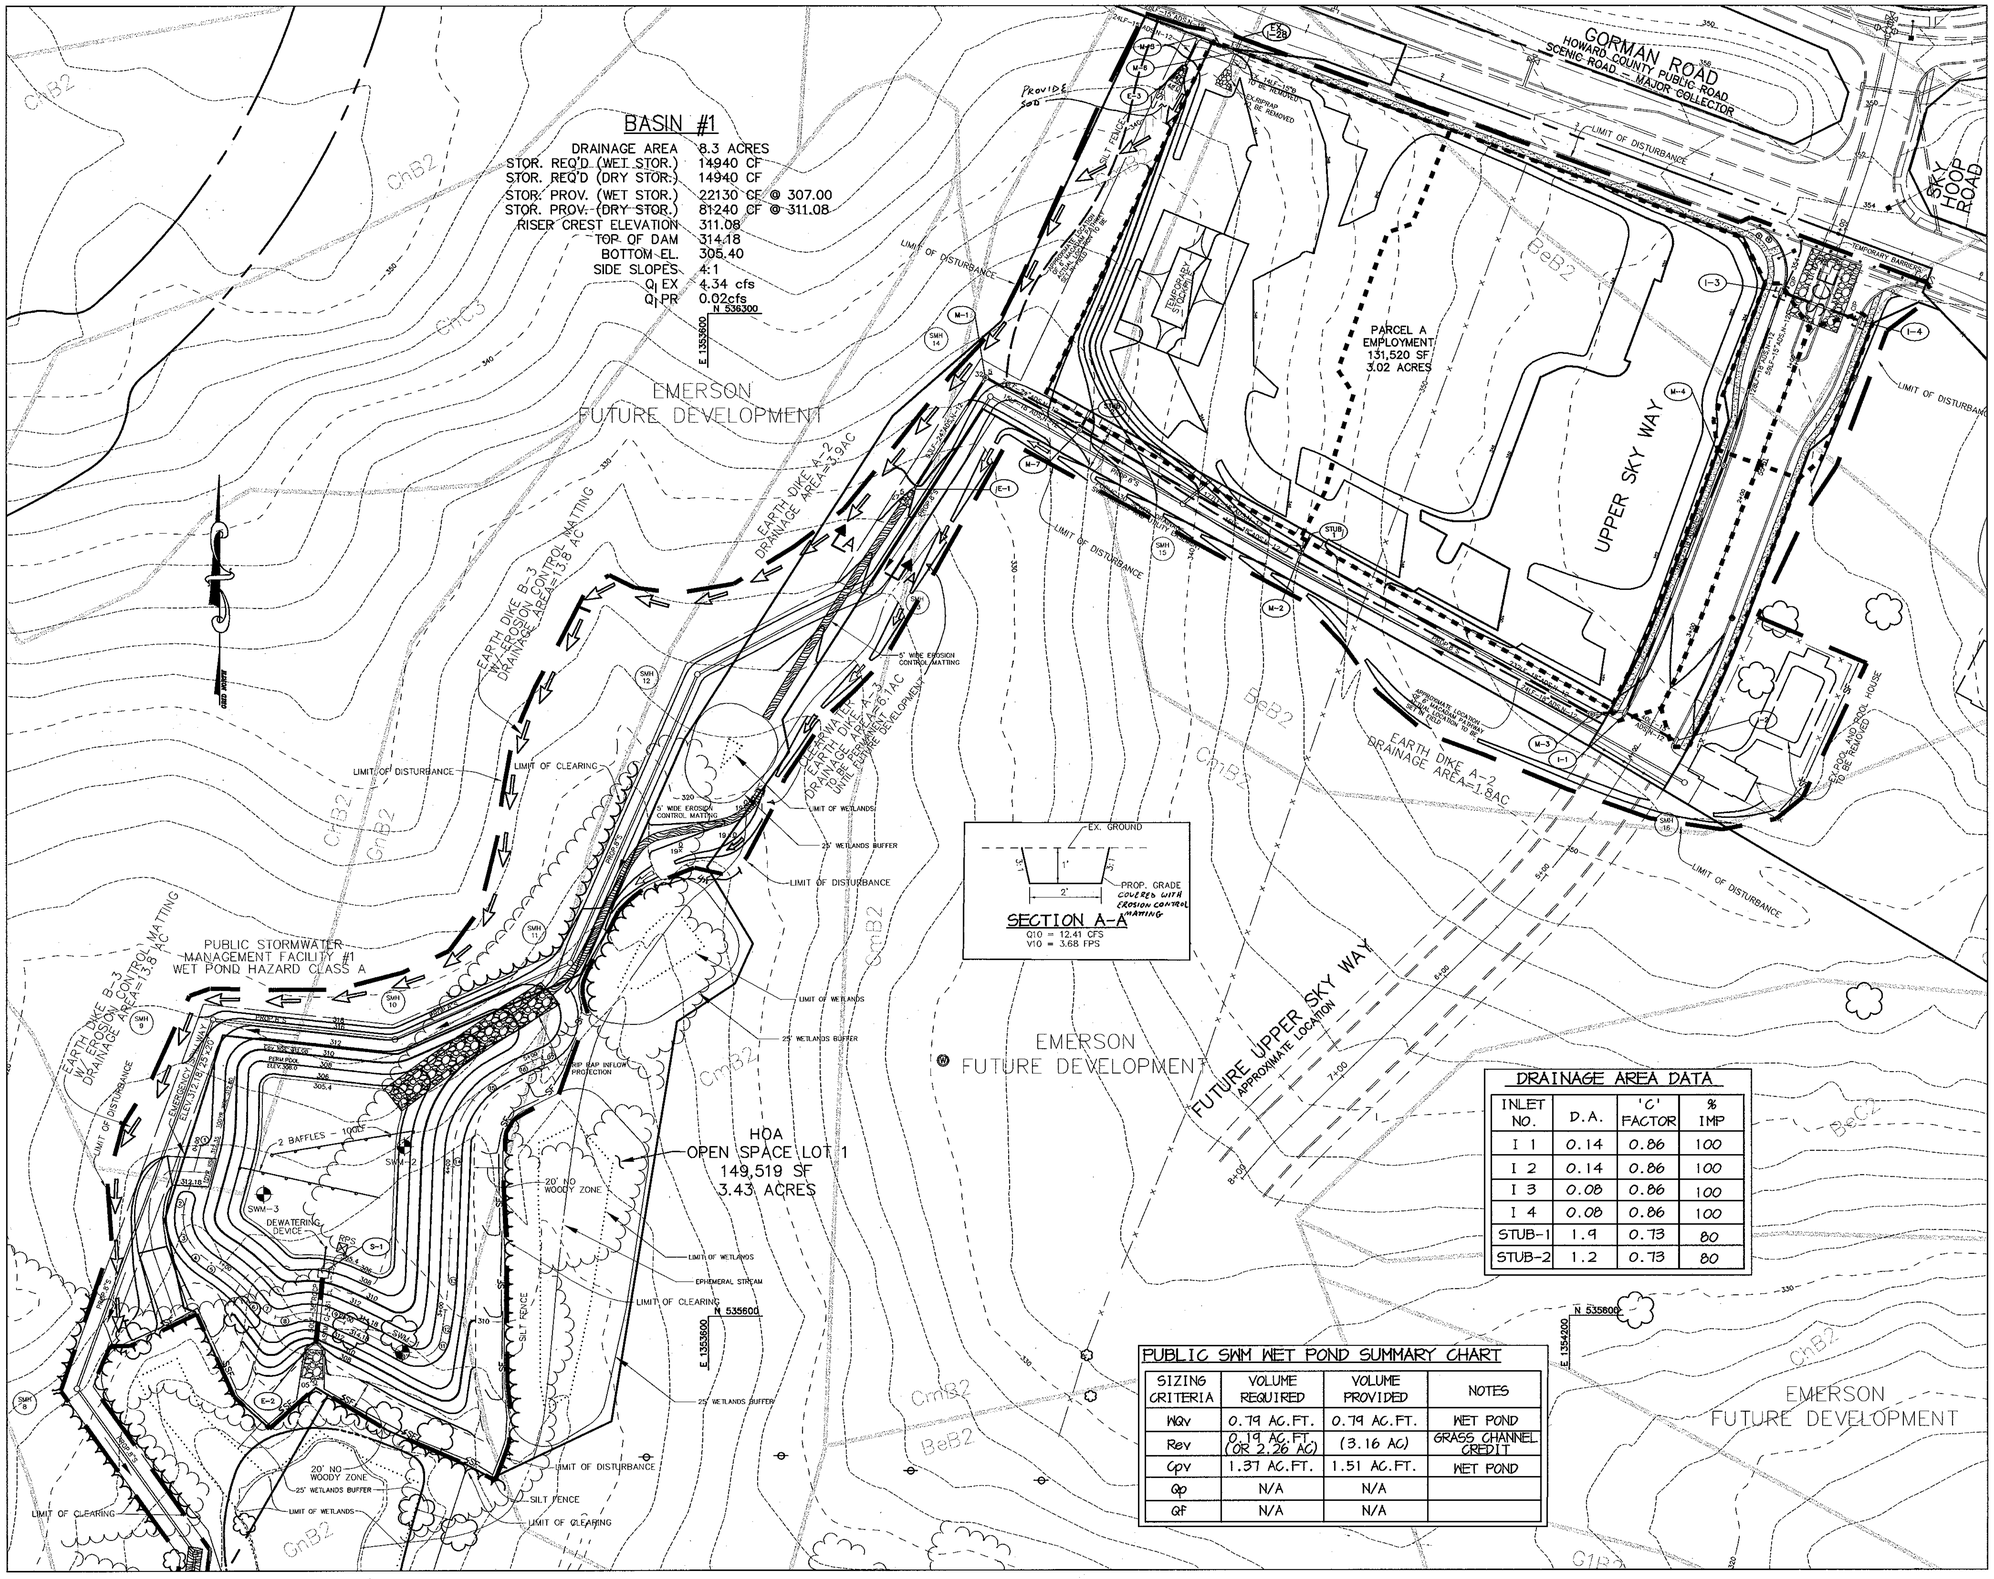

DAM CENTERLINE DATA

①	N 535719.74 E 1353246.46	⑨-⑩	R=518.61' L=54.98'
①-②	S 15°17'41"W 42.71'	⑩-⑪	R=15.98' L=24.77'
②-③	R=33.98' L=27.93'	⑪-⑫	R=11470.62' L=11.31'
③-④	R=36.43' L=11.48'	⑫-⑬	R=252.25' L=34.16'
④-⑤	R=76.76' L=8.83'	⑬-⑭	R=11417.31' L=85.75'
⑤-⑥	R=128.81' L=44.14'	⑭-⑮	R=63.05' L=60.67'
⑥-⑦	R=349.08' L=3.19'	⑮-⑯	R=154.21' L=26.13'
⑦-⑧	R=16.00' L=20.84'	⑯-⑰	N 66°24'46" E 10.87'
⑧-⑨	R=40.17' L=24.81'	⑰	N 535781.65 E 1353484.27

DRAINAGE AREA DATA

INLET NO.	D.A.	'C' FACTOR	% IMP
I 1	0.14	0.86	100
I 2	0.14	0.86	100
I 3	0.08	0.86	100
I 4	0.08	0.86	100
STUB-1	1.9	0.73	80
STUB-2	1.2	0.73	80

PUBLIC SWM WET POND SUMMARY CHART

SIZING CRITERIA	VOLUME REQUIRED	VOLUME PROVIDED	NOTES
WQv	0.79 AC.FT.	0.79 AC.FT.	WET POND
Rev	0.19 AC.FT. (OR 2.26 AC)	(3.16 AC)	GRASS CHANNEL CREDIT
Cpv	1.37 AC.FT.	1.51 AC.FT.	WET POND
Qp	N/A	N/A	
QF	N/A	N/A	

BY THE DEVELOPER :

I/WE CERTIFY THAT ALL DEVELOPMENT AND/OR CONSTRUCTION WILL BE DONE ACCORDING TO THESE PLANS, AND THAT ANY RESPONSIBLE PERSONNEL INVOLVED IN THE CONSTRUCTION PROJECT WILL HAVE A CERTIFICATE OF ATTENDANCE AT A DEPARTMENT OF THE ENVIRONMENT APPROVED TRAINING PROGRAM FOR THE CONTROL OF SEDIMENT AND EROSION BEFORE BEGINNING THE PROJECT. I SHALL ENGAGE A REGISTERED PROFESSIONAL ENGINEER TO SUPERVISE POND CONSTRUCTION AND PROVIDE THE HOWARD SOIL CONSERVATION DISTRICT WITH AN "AS-BUILT" PLAN OF THE POND WITHIN 30 DAYS OF COMPLETION. I ALSO AUTHORIZE PERIODIC ON-SITE INSPECTIONS BY THE HOWARD SOIL CONSERVATION DISTRICT.

DEVELOPER PAUL CAVANAUGH — DATE 10-18-02

BY THE ENGINEER :

I CERTIFY THAT THIS PLAN FOR POND CONSTRUCTION, EROSION AND SEDIMENT CONTROL REPRESENTS A PRACTICAL AND WORKABLE PLAN BASED ON MY PERSONAL KNOWLEDGE OF THE SITE CONDITIONS. THIS PLAN WAS PREPARED IN ACCORDANCE WITH THE REQUIREMENTS OF THE HOWARD SOIL CONSERVATION DISTRICT. I HAVE NOTIFIED THE DEVELOPER THAT HE/SHE MUST ENGAGE A REGISTERED PROFESSIONAL ENGINEER TO SUPERVISE POND CONSTRUCTION AND PROVIDE THE HOWARD SOIL CONSERVATION DISTRICT WITH AN "AS-BUILT" PLAN OF THE POND WITHIN 30 DAYS OF COMPLETION.

ENGINEER — DATE 10-18-02

THESE PLANS HAVE BEEN REVIEWED FOR THE HOWARD SOIL CONSERVATION DISTRICT AND MEET THE TECHNICAL REQUIREMENTS FOR SMALL POND CONSTRUCTION, SOIL EROSION AND SEDIMENT CONTROL.

NATURAL RESOURCES CONSERVATION SERVICE — DATE 10/30/02

THESE PLANS FOR SMALL POND CONSTRUCTION, SOIL EROSION AND SEDIMENT CONTROL MEET THE REQUIREMENTS OF THE HOWARD SOIL CONSERVATION DISTRICT.

HOWARD SOIL CONSERVATION DISTRICT — DATE 10/30/02

APPROVED : HOWARD COUNTY DEPARTMENT OF PUBLIC WORKS.

CHIEF, BUREAU OF HIGHWAYS — DATE 11-6-02

APPROVED : HOWARD COUNTY DEPARTMENT OF PLANNING AND ZONING.

CHIEF, DIVISION OF LAND DEVELOPMENT — DATE 11/21/02

CHIEF, DEVELOPMENT ENGINEERING DIVISION — DATE 11/14/02

DATE	NO.	REVISION

OWNER/DEVELOPER

THE HOWARD RESEARCH AND DEVELOPMENT CORPORATION
THE ROUSE BUILDING
10275 LITTLE PATUXENT PARKWAY
COLUMBIA, MARYLAND 21044
410-992-6000

PROJECT
EMERSON
SECTION THREE AREA TWO

AREA TAX MAP 47 BLOCK 8 & 9
ZONED: PEC-MXD-3 PART OF PARCELS: 462 & 837
6th ELECTION DISTRICT HOWARD COUNTY, MARYLAND

TITLE
GRADING, SEDIMENT CONTROL PLAN AND DRAINAGE AREA MAP

Patton Harris Rust & Associates, pc
Engineers. Surveyors. Planners. Landscape Architects.
8818 Centre Park Drive
Columbia, MD 21045
T 410.997.8900
F 410.997.9282

10-18-02
DATE

STATE OF MARYLAND — CHRISTOPHER J. REID — No. 19949 — PROFESSIONAL ENGINEER

CHRISTOPHER J. REID #19949

DESIGNED BY :	A.C.R
DRAWN BY :	DAM
CHECKED BY :	C.J.R.
PERMIT TRACKING NUMBER	01-NT-0222/200164079
DATE :	OCTOBER 21, 2002
SCALE :	1"=50'
DRAWING NO.	3 OF 12

F-02-178

C-RD3.DWG

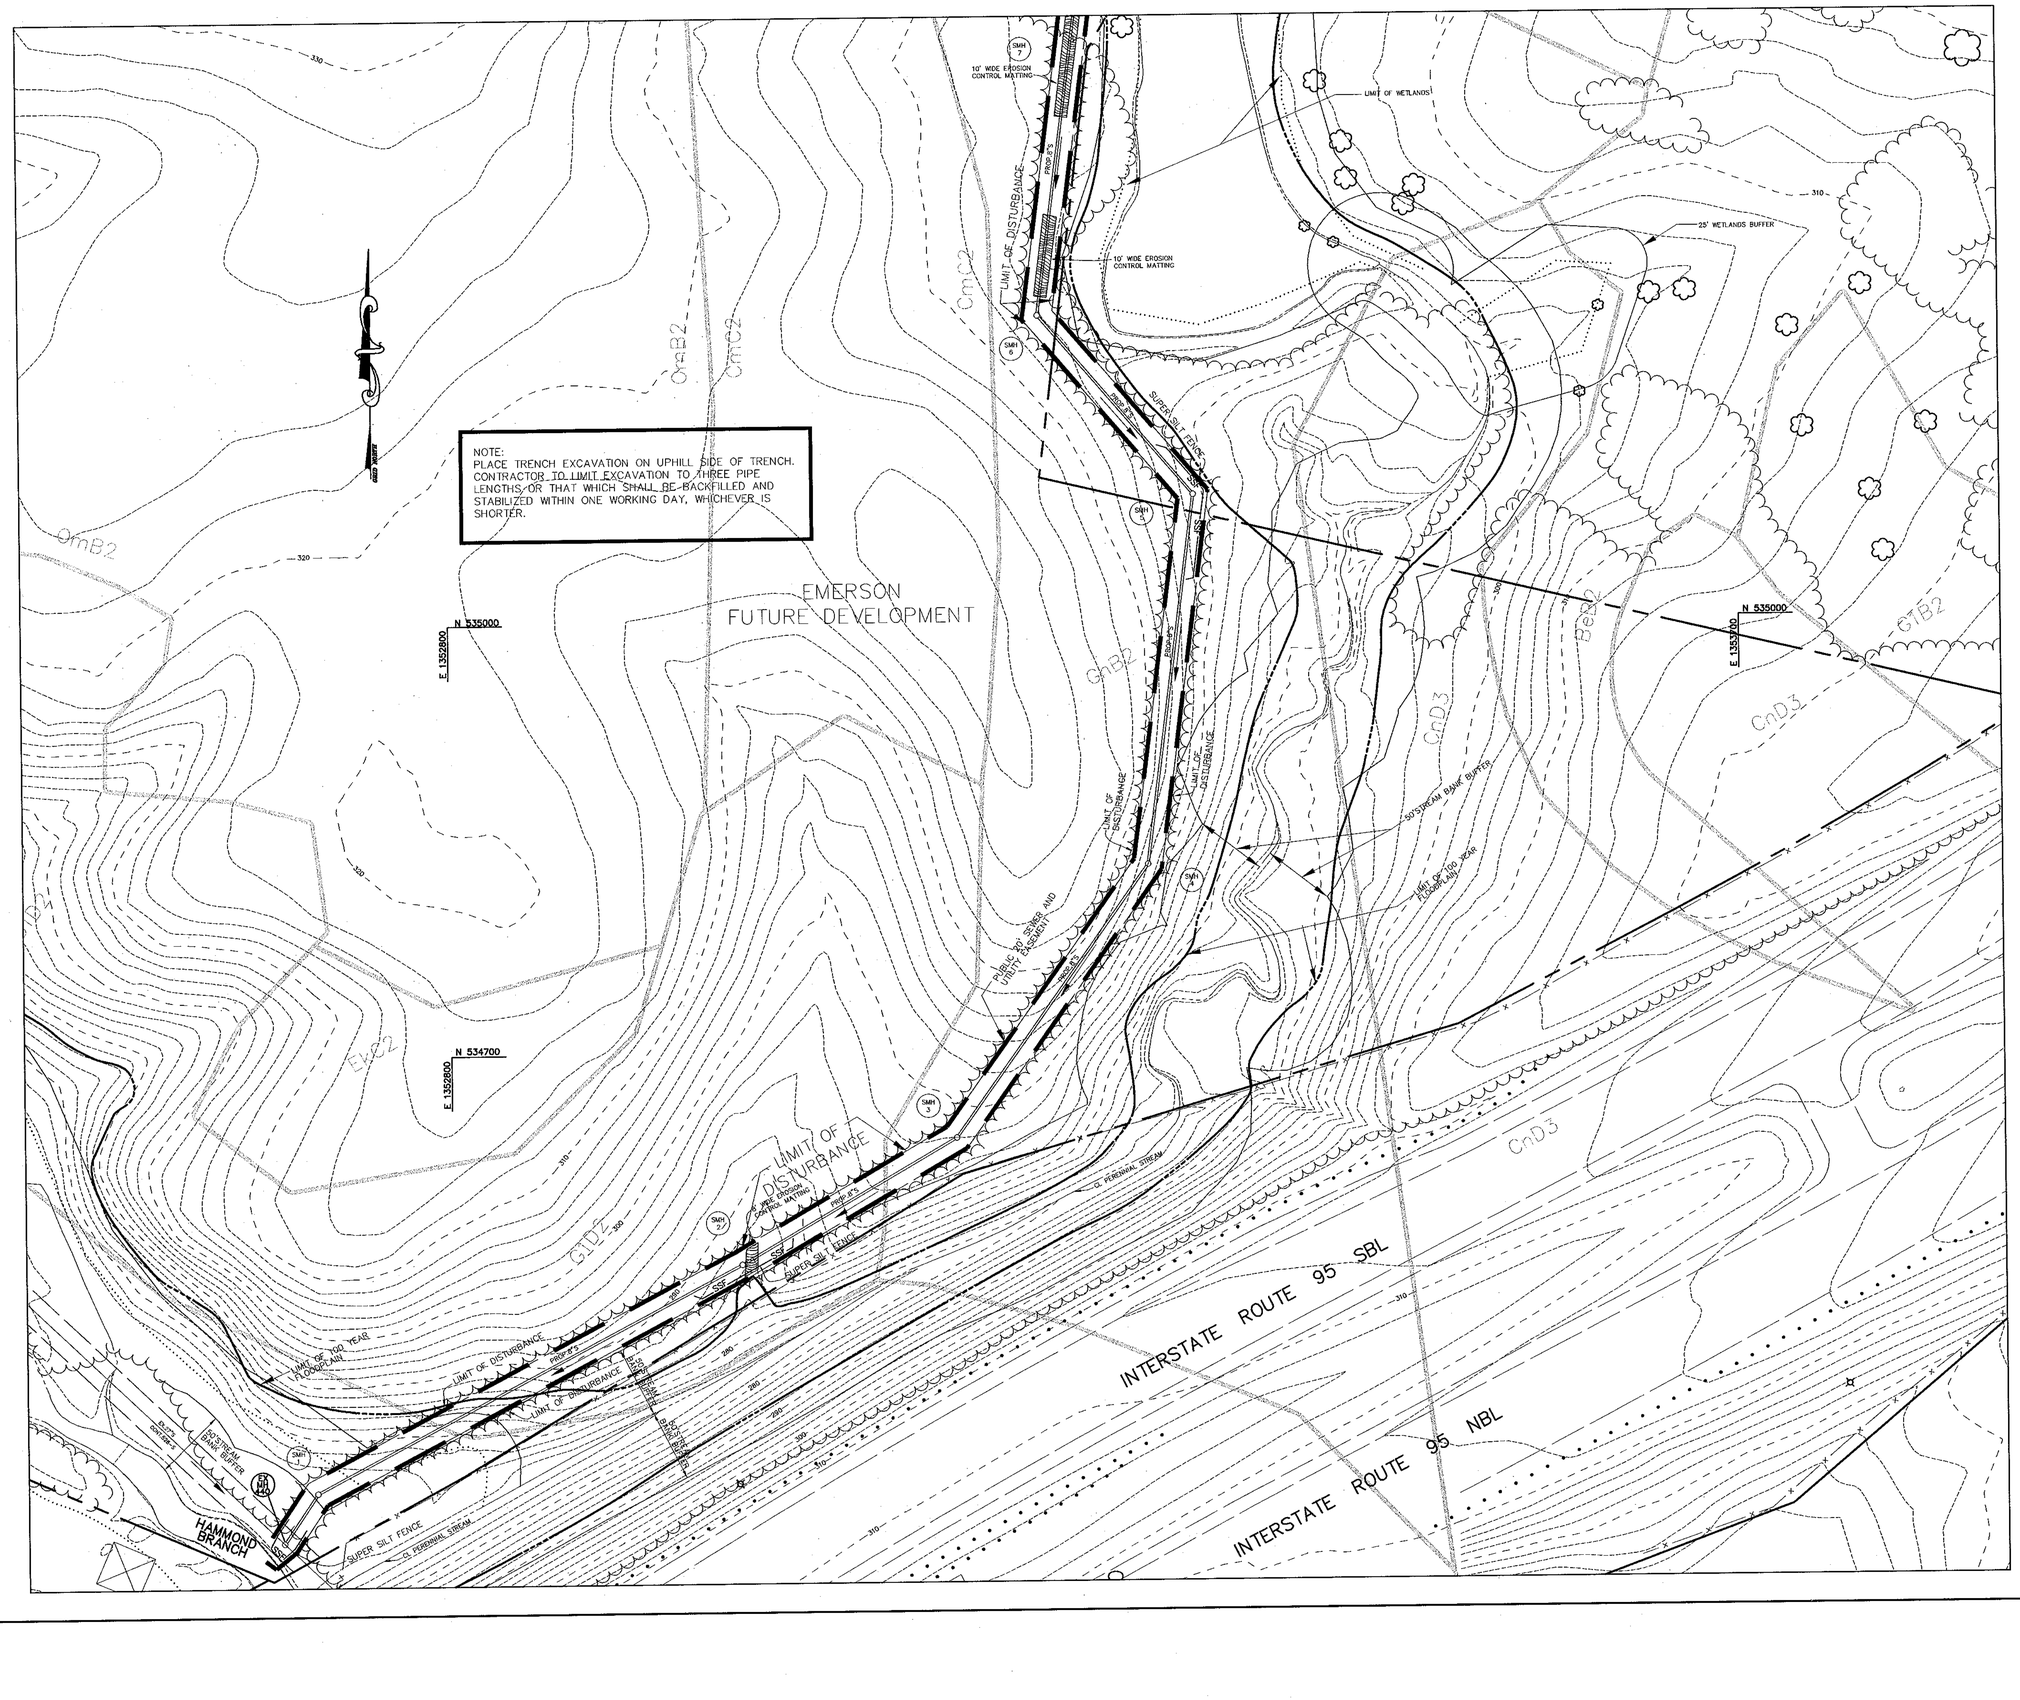

BY THE DEVELOPER :

I/WE CERTIFY THAT ALL DEVELOPMENT AND/OR CONSTRUCTION WILL BE DONE ACCORDING TO THESE PLANS, AND THAT ANY RESPONSIBLE PERSONNEL INVOLVED IN THE CONSTRUCTION PROJECT WILL HAVE A CERTIFICATE OF ATTENDANCE AT A DEPARTMENT OF THE ENVIRONMENT APPROVED TRAINING PROGRAM FOR THE CONTROL OF SEDIMENT AND EROSION BEFORE BEGINNING THE PROJECT. I SHALL ENGAGE A REGISTERED PROFESSIONAL ENGINEER TO SUPERVISE POND CONSTRUCTION AND PROVIDE THE HOWARD SOIL CONSERVATION DISTRICT WITH AN "AS-BUILT" PLAN OF THE POND WITHIN 30 DAYS OF COMPLETION. I ALSO AUTHORIZE PERIODIC ON-SITE INSPECTIONS BY THE HOWARD SOIL CONSERVATION DISTRICT.

DEVELOPER — DATE: 10.18.02
PAUL CAVANAUGH

BY THE ENGINEER :

I CERTIFY THAT THIS PLAN FOR POND CONSTRUCTION, EROSION AND SEDIMENT CONTROL REPRESENTS A PRACTICAL AND WORKABLE PLAN BASED ON MY PERSONAL KNOWLEDGE OF THE SITE CONDITIONS. THIS PLAN WAS PREPARED IN ACCORDANCE WITH THE REQUIREMENTS OF THE HOWARD SOIL CONSERVATION DISTRICT. I HAVE NOTIFIED THE DEVELOPER THAT HE/SHE MUST ENGAGE A REGISTERED PROFESSIONAL ENGINEER TO SUPERVISE POND CONSTRUCTION AND PROVIDE THE HOWARD SOIL CONSERVATION DISTRICT WITH AN "AS-BUILT" PLAN OF THE POND WITHIN 30 DAYS OF COMPLETION.

ENGINEER — DATE: 10.18.02

THESE PLANS HAVE BEEN REVIEWED FOR THE HOWARD SOIL CONSERVATION DISTRICT AND MEET THE TECHNICAL REQUIREMENTS FOR SMALL POND CONSTRUCTION, SOIL EROSION AND SEDIMENT CONTROL.

NATURAL RESOURCES CONSERVATION SERVICE — DATE: 10/30/02

THESE PLANS FOR SMALL POND CONSTRUCTION, SOIL EROSION AND SEDIMENT CONTROL MEET THE REQUIREMENTS OF THE HOWARD SOIL CONSERVATION DISTRICT.

HOWARD SOIL CONSERVATION DISTRICT — DATE: 10/30/02

APPROVED : HOWARD COUNTY DEPARTMENT OF PUBLIC WORKS.

CHIEF, BUREAU OF HIGHWAYS — DATE: 11-8-02

APPROVED : HOWARD COUNTY DEPARTMENT OF PLANNING AND ZONING.

CHIEF, DIVISION OF LAND DEVELOPMENT — DATE: 11/20/02

CHIEF, DEVELOPMENT ENGINEERING DIVISION — DATE: 11/14/02

DATE	NO.	REVISION

OWNER/DEVELOPER

THE HOWARD RESEARCH AND DEVELOPMENT CORPORATION
THE ROUSE BUILDING
10275 LITTLE PATUXENT PARKWAY
COLUMBIA, MARYLAND 21044
410-992-6000

PROJECT
EMERSON
SECTION THREE AREA TWO

AREA
TAX MAP 47 BLOCK 8 & 9
ZONED: PEC-MXD-3 PART OF PARCELS: 462 & 837
6th ELECTION DISTRICT HOWARD COUNTY, MARYLAND

TITLE
GRADING AND SEDIMENT CONTROL PLAN

Patton Harris Rust & Associates, pc
Engineers. Surveyors. Planners. Landscape Architects.
8818 Centre Park Drive
Columbia, MD 21045
T 410.997.8900
F 410.997.9282

10.18.02
DATE

STATE OF MARYLAND — CHRISTOPHER J. REID — NO. 19949 — PROFESSIONAL ENGINEER

CHRISTOPHER J. REID #19949

DESIGNED BY : A.C.R
DRAWN BY : DAM
CHECKED BY : C.J.R.
PERMIT TRACKING NUMBER 01-NT-0222/200164079
DATE : OCTOBER 21, 2002
SCALE : 1"=50'
DRAWING NO. 4 OF 12

F-02-178 C-RD4.DWG

J:\projects\2024561\01Engrg\Plans\FINALS\C-RD4.dwg, Layout1, 10/17/02 02:26:23 PM, HP750C(36).pc3, Arch D - 24 x 36 in. (landscape), 1:1

DETAIL 24 – STABILIZED CONSTRUCTION ENTRANCE

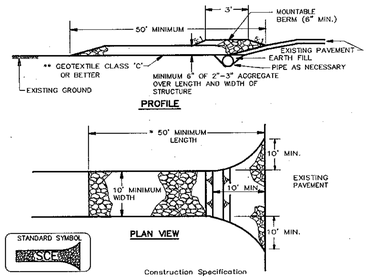

Construction Specification

1. Length – minimum of 50' (*30' for single residence lot).

2. Width – 10' minimum, should be flared at the existing road to provide a turning radius.

3. Geotextile fabric (filter cloth) shall be placed over the existing ground prior to placing stone. **The plan approval authority may not require single family residences to use geotextile.

4. Stone – crushed aggregate (2" to 3") or reclaimed or recycled concrete equivalent shall be placed at least 6" deep over the length and width of the entrance.

5. Surface Water – all surface water flowing to or diverted toward construction entrances shall be piped through the entrance, maintaining positive drainage. Pipe installed through the stabilized construction entrance shall be protected with a mountable berm with 5:1 slopes and a minimum of 6" of stone over the pipe. Pipe has to be sized according to the drainage. When the SCE is located at a high spot and has no drainage to convey a pipe will not be necessary. Pipe should be sized according to the amount of runoff to be conveyed. A 6" minimum will be required.

6. Location – A stabilized construction entrance shall be located at every point where construction traffic enters or leaves a construction site. Vehicles leaving the site must travel over the entire length of the stabilized construction entrance.

U.S. DEPARTMENT OF AGRICULTURE SOIL CONSERVATION SERVICE	PAGE F - 17 - 3	MARYLAND DEPARTMENT OF ENVIRONMENT WATER MANAGEMENT ADMINISTRATION

DETAIL 30 – EROSION CONTROL MATTING

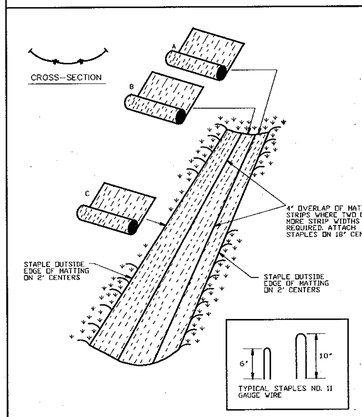

U.S. DEPARTMENT OF AGRICULTURE SOIL CONSERVATION SERVICE	PAGE G - 20 - 2	MARYLAND DEPARTMENT OF ENVIRONMENT WATER MANAGEMENT ADMINISTRATION

DETAIL 33 – SUPER SILT FENCE

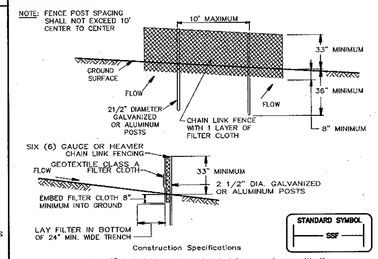

Construction Specifications

1. Fencing shall be 42" in height and constructed in accordance with the latest Maryland State Highway (SHA) Details for Chain Link Fencing. The SHA specifications for a 6 foot fence shall be used, substituting 42" fabric and 6 foot length posts.

2. The posts do not need to be set in concrete.

3. Chain link fence shall be fastened securely to the fence posts with wire ties or staples. The lower tension wire, brace and truss rods, drive anchors and post caps are not required except on the ends of the fence. The chain link fencing shall be six (6) gauge or heavier.

4. Filter cloth shall be fastened securely to the chain link fence with ties spaced every 24" at the top and mid section.

5. Filter cloth shall be embedded a minimum of 8" into the ground.

6. When two sections of geotextile fabric adjoin each other, they shall be overlapped by 6" and folded.

7. Maintenance shall be performed as needed and silt buildups removed when "bulges" develop in the silt fence, or when silt reaches 50% of fence height

U.S. DEPARTMENT OF AGRICULTURE SOIL CONSERVATION SERVICE	PAGE H - 26 - 3	MARYLAND DEPARTMENT OF ENVIRONMENT WATER MANAGEMENT ADMINISTRATION

STRUCTURE SCHEDULE

STRUCTURE	TYPE	LOCATION	INV. IN	INV. OUT	TOP	REMARKS
I-1	A-5 2.5'WIDE	N 536020.38 E 1354240.34	349.00 (18") 349.60 (15")	348.90 (18")	353.2	HOCO STD. DETAIL SD-4.40
I-2	A-5 2.5'WIDE	N 536001.53 E 1354273.34	–	350.00 (15")	353.2	HOCO STD. DETAIL SD-4.40
I-3	A-5 2.5'WIDE	N 536314.22 E 1354349.20	350.90 (15")	350.65 (18")	354.9	HOCO STD. DETAIL SD-4.40
I-4	A-5 2.5'WIDE	N 536294.83 E 1354401.74	–	351.25 (15")	354.9	HOCO STD. DETAIL SD-4.40
M-1	4'-0" DIA.	N 536255 E 1353793	328.10 (24")	328.00 (24")	332.5	HOCO STD. DETAIL G-5.11
M-2	4'-0" DIA.	N 536132 E 1354013	340.46 (18") 340.46 (18")	340.36 (18")	346.0	HOCO STD. DETAIL G-5.11
M-3	4'-0" DIA.	N 536019 E 1354215	348.78 (18")	348.68 (18")	352.8	HOCO STD. DETAIL G-5.11
M-4	4'-0" DIA.	N 536193 E 1354307	350.03 (18")	349.93 (18")	355.6	HOCO STD. DETAIL G-5.11
M-5	4'-0" DIA.	N 536491 E 1353942	342.20 (15")	342.10 (15")	346.0	HOCO STD. DETAIL G-5.11
M-6	4'-0" DIA.	N 536482 E 1353968	342.44 (15")	342.34 (15")	346.0	HOCO STD. DETAIL G-5.11
M-7	4'-0" DIA.	N 536218 E 1353859	331.68 (18") 331.68 (18")	331.18 (24")	335.0	HOCO STD. DETAIL G-5.11
E-1	24" ADS END SECTION	N 536176 E 1353742	327.50 (24")	–	–	HOCO STD. DETAIL SD-5.51
E-2	36" TYPE "A" HEADWALL	N 535580 E 1353326	305.00 (36")	–	–	HOCO STD. DETAIL SD-5.11
E-3	15"ADS END SECTION	N 536470 E 1353932	341.98 (15")	–	–	HOCO STD. DETAIL SD-5.51
S-1	MODIFIED STRUCTURE	N 535630 E 1353331	305.4 (8")	305.4 (36")	314.17	SEE SHEET 14

NOTES:
FOR END SECTIONS AND HEADWALLS THE LOCATION IS CENTER OF THROAT OPENING AT FACE OF STRUCTURE.
LOCATION OF INLETS AND MANHOLES IS AT CENTER OF TOP COVER; FOR "A" INLETS LOCATION IS GIVEN FOR CENTER OF THROAT OPENING AT FACE OF CURB;

PIPE SCHEDULE

PIPE LENGTH	SIZE	TYPE
104	15"	ADS, N-12
776	18"	ADS, N-12
168	24"	ADS, N-12
50	36"	RCCP

BY THE DEVELOPER :
I/WE CERTIFY THAT ALL DEVELOPMENT AND/OR CONSTRUCTION WILL BE DONE ACCORDING TO THESE PLANS, AND THAT ANY RESPONSIBLE PERSONNEL INVOLVED IN THE CONSTRUCTION PROJECT WILL HAVE A CERTIFICATE OF ATTENDANCE AT A DEPARTMENT OF THE ENVIRONMENT APPROVED TRAINING PROGRAM FOR THE CONTROL OF SEDIMENT AND EROSION BEFORE BEGINNING THE PROJECT. I SHALL ENGAGE A REGISTERED PROFESSIONAL ENGINEER TO SUPERVISE POND CONSTRUCTION AND PROVIDE THE HOWARD SOIL CONSERVATION DISTRICT WITH AN "AS-BUILT" PLAN OF THE POND WITHIN 30 DAYS OF COMPLETION. I ALSO AUTHORIZE PERIODIC ON-SITE INSPECTIONS BY THE HOWARD SOIL CONSERVATION DISTRICT.

DEVELOPER Paul Cavanaugh — DATE 10.18.02

BY THE ENGINEER :
I CERTIFY THAT THIS PLAN FOR POND CONSTRUCTION, EROSION AND SEDIMENT CONTROL REPRESENTS A PRACTICAL AND WORKABLE PLAN BASED ON MY PERSONAL KNOWLEDGE OF THE SITE CONDITIONS. THIS PLAN WAS PREPARED IN ACCORDANCE WITH THE REQUIREMENTS OF THE HOWARD SOIL CONSERVATION DISTRICT. I HAVE NOTIFIED THE DEVELOPER THAT HE/SHE MUST ENGAGE A REGISTERED PROFESSIONAL ENGINEER TO SUPERVISE POND CONSTRUCTION AND PROVIDE THE HOWARD SOIL CONSERVATION DISTRICT WITH AN "AS-BUILT" PLAN OF THE POND WITHIN 30 DAYS OF COMPLETION.

ENGINEER — DATE 10.18.02

THESE PLANS HAVE BEEN REVIEWED FOR THE HOWARD SOIL CONSERVATION DISTRICT AND MEET THE TECHNICAL REQUIREMENTS FOR SMALL POND CONSTRUCTION, SOIL EROSION AND SEDIMENT CONTROL.

NATURAL RESOURCES CONSERVATION SERVICE — DATE 10/30/02

THESE PLANS FOR SMALL POND CONSTRUCTION, SOIL EROSION AND SEDIMENT CONTROL MEET THE REQUIREMENTS OF THE HOWARD SOIL CONSERVATION DISTRICT.

HOWARD SOIL CONSERVATION DISTRICT — DATE 10/30/02

APPROVED : HOWARD COUNTY DEPARTMENT OF PUBLIC WORKS.

CHIEF, BUREAU OF HIGHWAYS — DATE 11-8-02

APPROVED : HOWARD COUNTY DEPARTMENT OF PLANNING AND ZONING.

CHIEF, DIVISION OF LAND DEVELOPMENT — DATE 11/20/02

CHIEF, DEVELOPMENT ENGINEERING DIVISION — DATE 11/14/02

DATE	NO.	REVISION

OWNER/DEVELOPER
THE HOWARD RESEARCH AND DEVELOPMENT CORPORATION
THE ROUSE BUILDING
10275 LITTLE PATUXENT PARKWAY
COLUMBIA, MARYLAND 21044
410-992-6000

PROJECT
EMERSON
SECTION THREE AREA TWO

AREA TAX MAP 47 BLOCK 8 & 9
ZONED: PEC-MXD-3 PART OF PARCELS: 462 & 837
6th ELECTION DISTRICT HOWARD COUNTY, MARYLAND

TITLE
SEDIMENT CONTROL DETAILS

Patton Harris Rust & Associates, pc
Engineers. Surveyors. Planners. Landscape Architects.
8818 Centre Park Drive
Columbia, MD 21045
T 410.997.8900
F 410.997.9282

10·18.02
DATE

STATE OF MARYLAND — CHRISTOPHER J. REID — No. 19949 — PROFESSIONAL ENGINEER

CHRISTOPHER J. REID #19949

DESIGNED BY :	A.C.R
DRAWN BY :	DAM
CHECKED BY :	C.J.R.
PERMIT TRACKING NUMBER	01-NT-0222/200164079
DATE :	OCTOBER 21, 2002
SCALE :	AS SHOWN
DRAWING NO.	5 OF 12

F-02-178 C-DETAILS1.DWG

DETAIL 22 – SILT FENCE

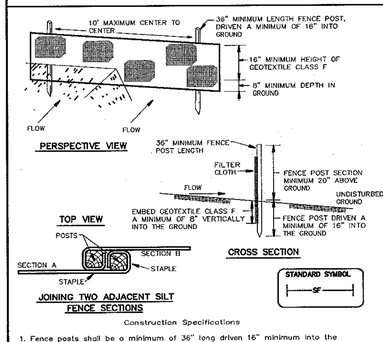

Construction Specifications

1. Fence posts shall be a minimum of 36" long driven 16" minimum into the ground. Wood posts shall be 11/2" x 11/2" square (minimum) cut, or 13/4" diameter (minimum) round and shall be of sound quality hardwood. Steel posts will be standard T or U section weighting not less than 1.00 pond per linear foot.

2. Geotextile shall be fastened securely to each fence post with wire ties or staples at top and mid-section and shall meet the following requirements for Geotextile Class F:

Tensile Strength	50 lbs/in (min.)	Test: MSMT 509
Tensile Modulus	20 lbs/in (min.)	Test: MSMT 509
Flow Rate	0.3 gal ft²/ minute (max.)	Test: MSMT 322
Filtering Efficiency	75% (min.)	Test: MSMT 322

3. Where ends of geotextile fabric come together, they shall be overlapped, folded and stapled to prevent sediment bypass.

4. Silt Fence shall be inspected after each rainfall event and maintained when bulges occur or when sediment accumulation reached 50% of the fabric height.

U.S. DEPARTMENT OF AGRICULTURE SOIL CONSERVATION SERVICE	PAGE E - 15 - 3	MARYLAND DEPARTMENT OF ENVIRONMENT WATER MANAGEMENT ADMINISTRATION

EROSION CONTROL MATTING

Construction Specifications

1. Key-in the matting by placing the top ends of the matting in a narrow trench, 6" in depth. Backfill the trench and tamp firmly to conform to the channel cross-section. Secure with a row of staples about 4" down slope from the trench. Spacing between staples is 6".

2. Staple the 4" overlap in the channel center using an 18" spacing between staples.

3. Before stapling the outer edges of the matting, make sure the matting is smooth and in firm contact with the soil.

4. Staples shall be placed 2' apart with 4 rows for each strip, 2 outer rows, and 2 alternating rows down the center.

5. Where one roll of matting ends and another begins, the end of the top strip shall overlap the upper end of the lower strip by 4", shiplap fashion. Reinforce the overlap with a double row of staples spaced 6" apart in a staggered pattern on either side.

6. The discharge end of the matting liner should be similarly secured with 2 double rows of staples.

Note: If flow will enter from the edge of the matting then the area effected by the flow must be keyed-in.

U.S. DEPARTMENT OF AGRICULTURE SOIL CONSERVATION SERVICE	PAGE G - 22 - 2A	MARYLAND DEPARTMENT OF ENVIRONMENT WATER MANAGEMENT ADMINISTRATION

30.0 – DUST CONTROL

DEFINITION

CONTROLLING DUST BLOWING AND MOVEMENT ON CONSTRUCTION SITES AND ROADS.

PURPOSE

TO PREVENT BLOWING AND MOVEMENT OF DUST FROM EXPOSED SOIL SURFACES, REDUCE ON AND OFF-SITE DAMAGE, HEALTH HAZARDS, AND IMPROVE TRAFFIC SAFETY.

CONDITIONS WHERE PRACTICE APPLIES

THIS PRACTICE IS APPLICABLE TO AREAS SUBJECT TO DUST BLOWING AND MOVEMENT WHERE ON OFF-SITE DAMAGE IS LIKELY WITHOUT TREATMENT.

SPECIFICATIONS

TEMPORARY METHODS

1. MULCHES – SEE STANDARDS FOR VEGETATIVE STABILIZATION WITH MULCHES ONLY. MULCH SHOULD BE CRIMPED OR TACKED TO PREVENT BLOWING.

2. VEGATATIVE COVER – SEE STANDARDS FOR TEMPORARY VEGETATIVE COVER.

3. TILLAGE – TO ROUGHEN SURFACE AND BRING CLODS TO THE SURFACE. THIS IS AN EMERGENCY MEASURE WHICH SHOULD BE USED BEFORE SOIL BLOWING STARTS. BEGIN PLOWING ON WINDWARD SIDE OF SITE. CHISEL-TYPE PLOWS SPACED ABOUT 12" APART, SPRING-TOOTHED HARROWS, AND SIMILAR PLOWS ARE EXAMPLES OF EQUIPMENT WHICH MAY PRODUCE THE DESIRED EFFECT.

4. IRRIGATION – THIS IS GENERALLY DONE AS AN EMERGENCY TREATMENT. SITE IS SPRINKLED WITH WATER UNTIL THE SURFACE IS MOIST. REPEAT AS NEEDED. AT NO TIME SHOULD THE SITE BE IRRIGATED TO THE POINT THAT RUNOFF BEGINS TO FLOW.

5. BARRIERS – SOLID BOARD FENCES, SILT FENCES, SNOW FENCES, BURLAP FENCES, STRAW BALES, AND SIMILAR MATERIAL CAN BE USED TO CONTROL AIR CURRENTS AND SOIL BLOWING. BARRIERS PLACED AT RIGHT ANGLES TO PREVAILING CURRENTS AT INTERVALS OF ABOUT 10 TIMES THEIR HEIGHT ARE EFFECTIVE IN CONTROLLING SOIL BLOWING.

6. CALCIUM CHLORIDE – APPLY AT RATES THAT WILL KEEP SURFACE MOIST. MAY NEED RETREATMENT.

PERMANENT METHODS

1. PERMANENT VEGETATION – SEE STANDARDS FOR PERMANENT VEGETATIVE COVER. AND PERMANENT STABILIZATION WITH SOD. EXISTING TREES OR LARGE SHRUBS MAY AFFORD VALUABLE PROTECTION IF LEFT IN PLACE.

2. TOPSOILING – COVERING WITH LESS EROSIVE SOIL MATERIALS. SEE STANDARDS FOR TOPSOILING.

3. STONE – COVER SURFACE WITH CRUSHED STONE OR COARSE GRAVEL.

REFERENCES

1. AGRICULTURE HANDBOOK 346. WIND EROSION FORCES IN THE UNITED STATES AND THEIR USE'S IN PREDICTING SOIL LOSS.

2. AGRICULTURE INFORMATION BULLETIN 354. HOW TO CONTROL WIND EROSION, USDA-ARS.

U.S. DEPARTMENT OF AGRICULTURE SOIL CONSERVATION SERVICE	PAGE H - 30 - 1	MARYLAND DEPARTMENT OF ENVIRONMENT WATER MANAGEMENT ADMINISTRATION

SILT FENCE TYPICAL DETAIL OVER HEADWALLS

SCALE: NO SCALE

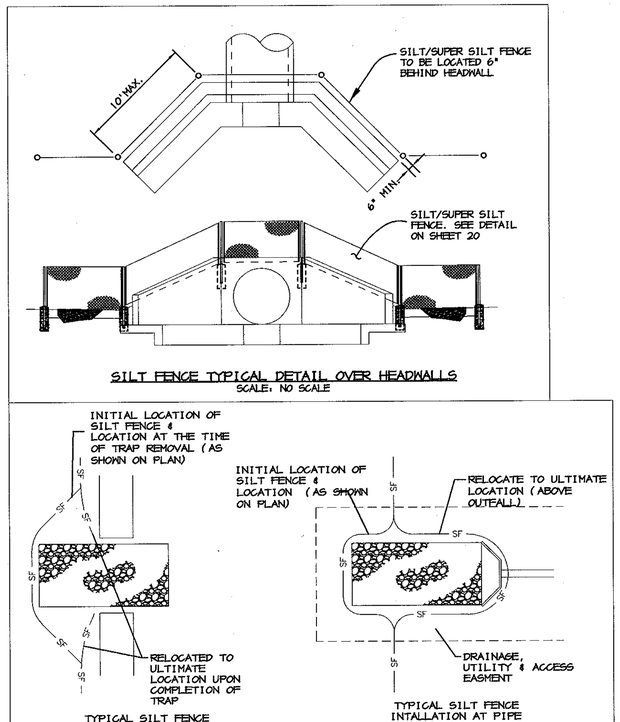

SILT FENCE OUTFALL PROTECTION

SCALE: NO SCALE

DETAIL 1 – EARTH DIKE

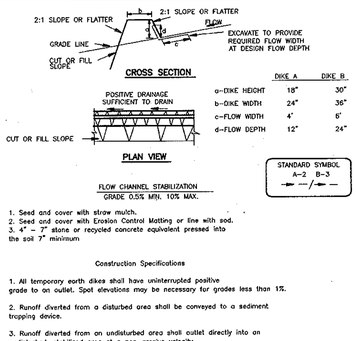

	DIKE A	DIKE B
a-DIKE HEIGHT	18"	30"
b-DIKE WIDTH	24"	36"
c-FLOW WIDTH	4'	6'
d-FLOW DEPTH	12"	24"

FLOW CHANNEL STABILIZATION
GRADE 0.5% MIN. 10% MAX.

1. Seed and cover with straw mulch.
2. Seed and cover with Erosion Control Matting or line with sod.
3. 4" – 7" stone or recycled concrete equivalent pressed into the soil 7" minimum

Construction Specifications

1. All temporary earth dikes shall have uninterrupted positive grade to an outlet. Spot elevations may be necessary for grades less than 1%.

2. Runoff diverted from a disturbed area shall be conveyed to a sediment trapping device.

3. Runoff diverted from an undisturbed area shall outlet directly into an undisturbed, stabilized area at a non-erosive velocity.

4. All trees, brush, stumps, obstructions, and other objectional material shall be removed and disposed of so as not to interfere with the proper functioning of the dike.

5. The dike shall be excavated or shaped to line, grade and cross section as required to meet the criteria specified herein and be free of bank projections or other irregularities which will impede normal flow.

6. Fill shall be compacted by earth moving equipment.

7. All earth removed and not needed for construction shall be placed so that it will not interfere with the functioning of the dike.

8. Inspection and maintenance must be provided periodically and after each rain event.

U.S. DEPARTMENT OF AGRICULTURE SOIL CONSERVATION SERVICE	PAGE A - 1 - 6	MARYLAND DEPARTMENT OF ENVIRONMENT WATER MANAGEMENT ADMINISTRATION

DETAIL 23C – CURB INLET PROTECTION

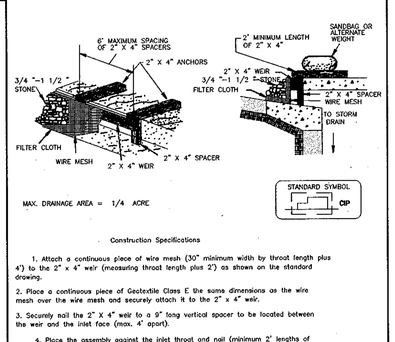

MAX. DRAINAGE AREA = 1/4 ACRE

Construction Specifications

1. Attach a continuous piece of wire mesh (30" minimum width by throat length plus 4') to the 2" x 4" weir (measuring throat length plus 2') as shown on the standard drawing.

2. Place a continuous piece of Geotextile Class E the same dimensions as the wire mesh over the wire mesh and securely attach it to the 2" x 4" weir.

3. Securely nail the 2" X 4" weir to a 9" long vertical spacer to be located between the weir and the inlet face (max. 4' apart).

4. Place the assembly against the inlet throat and nail (minimum 2" lengths of 2" x 4" to the top of the weir at spacer locations). These 2" x 4" anchors shall extend across the inlet top and be held in place by sandbags or alternate weight.

5. The assembly shall be placed so that the end spacers are a minimum 1' beyond both ends of the throat opening.

6. Form the 1/2 " x 1/2 " wire mesh and the geotextile fabric to the concrete gutter and against the face of the curb on both sides of the inlet. Place clean 3/4 " x 1 1/2 " stone over the wire mesh and geotextile in such a manner to prevent water from entering the inlet under or around the geotextile.

7. This type of protection must be inspected frequently and the filter cloth and stone replaced when clogged with sediment.

8. Assure that storm flow does not bypass the inlet by installing a temporary earth or asphalt dike to direct the flow to the inlet.

U.S. DEPARTMENT OF AGRICULTURE SOIL CONSERVATION SERVICE	PAGE E - 16 - 5B	MARYLAND DEPARTMENT OF ENVIRONMENT WATER MANAGEMENT ADMINISTRATION

DETAIL 5 – RIP-RAP INFLOW PROTECTION

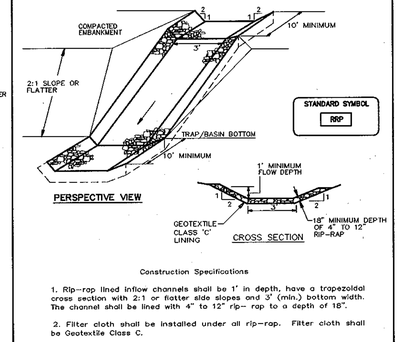

Construction Specifications

1. Rip-rap lined inflow channels shall be 1' in depth, have a trapezoidal cross section with 2:1 or flatter side slopes and 3' (min.) bottom width. The channel shall be lined with 4" to 12" rip- rap to a depth of 18".

2. Filter cloth shall be installed under all rip-rap. Filter cloth shall be Geotextile Class C.

3. Entrance and exit sections shall be installed as shown on the detail section.

4. Rip-rap used for the lining may be recycled for permanent outlet protection if the basin is to be converted to a stormwater management facility.

5. Gabion Inflow Protection may be used in lieu of Rip-rap Inflow Protection.

6. Rip-rap should blend into existing ground.

7. Rip-rap Inflow Protection shall be used where the slope is between 4:1 and 10:1, for slopes flatter than 10:1 use Earth Dike or Temporary Swale lining criteria.

U.S. DEPARTMENT OF AGRICULTURE SOIL CONSERVATION SERVICE	PAGE B - 6 - 2	MARYLAND DEPARTMENT OF ENVIRONMENT WATER MANAGEMENT ADMINISTRATION

RIPRAP TO BE EMBEDDED IN PROPOSED TRANSITION SECTION

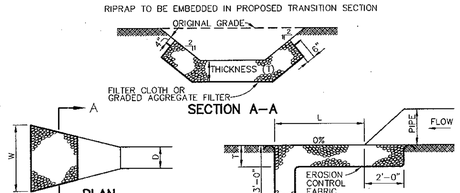

NOTE: Q_{10}, V & DEPTH CALCULATED AT END OF RIPRAP OUTLET CHANNEL.

STRUCTURE	MEDIAN STONE DIA.	LENGTH (L)	WIDTH (W)	THICKNESS (T)	Q_{10}	V_P	DEPTH
E-1	9.5" CL 1	12'	10'	19"	12.41	5.8	1.30
E-2	9.5" CL 1	12'	10'	19"	51.92	9.48	2.13
E-3	9.5" CL 1	12'	10'	19"	3.51	4.1	0.83

RIPRAP OUTLET PROTECTION DETAIL

NO SCALE

CONSTRUCTION SPECIFICATIONS

1. THE SUBGRADE FOR THE FILTER, RIP-RAP, OR GABION SHALL BE PREPARED TO THE REQUIRED LINES AND GRADES. ANY FILL REQUIRED IN THE SUBGRADE SHALL BE COMPACTED TO A DENSITY OF APPROXIMATELY THAT OF THE SURROUNDING UNDISTURBED MATERIAL.

2. THE ROCK OR GRAVEL SHALL CONFORM TO THE SPECIFIED GRADING LIMITS WHEN INSTALLED RESPECTIVELY IN THE RIP-RAP OR FILTER.

3. GEOTEXTILE CLASS C OR BETTER SHALL BE PROTECTED FROM PUNCHING, CUTTING, OR TEARING. ANY DAMAGE OTHER THAN AN OCCASIONAL SMALL HOLE SHALL BE REPAIRED BY PLACING ANOTHER PIECE OF GEOTEXTILE FABRIC OVER THE DAMAGED WHE THER FOR REPAIRS OR FOR JOINING TWO PIECES OF GEOTEXTILE FABRIC SHALL BE A MINIMUM OF ONE FOOT.

4. STONE FOR THE RIP-RAP OR GABION OUTLETS MAY BE PLACED BY EQUIPMENT. THEY SHALL BE CONSTRUCTED TO THE FULL COURSE THICKNESS IN ONE OPERATION AND AND IN SUCH A MANNER AS TO AVOID DISPLACEMENT OF UNDERLYING MATERIALS. THE STONE FOR RIP-RAP OR GABION OUTLETS SHALL BE DELIVERED AND PLACED IN A MANNER THAT WILL ENSURE THAT IT IS REASONABLY HOMOGENOUS WITH THE SMALLER STONES AND SPALLS FILLING THE VOIDS BETWEEN THE LARGER STONES. RIP-RAP SHALL BE PLACED IN A MANNER TO PREVENT DAMANGE TO THE FILTER BLANKET OR GEOTEXTILE FABRIC.HAND PLACEMENT WILL BE REQUIRED TO THE EXTENT NECESSARY TO PREVENT DAMAGE TO THE PERMANENT WORKS.

5. THE STONE SHALL BE PLACED SO THAT IT BLENDS IN WITH THE EXISTING GROUND.IF THE STONE IS PLACED TOO HIGH THEN THE FLOW WILL BE FORCED OUT OF THE CHANNEL AND SCOUR ADJACENT TO THE STONE WILL OCCUR.

P:\project\22456\1-DiEng\Plans\FINAL\SC-DETAILS1.dwg, Layout1, 10/17/02 02:30:17 PM, HP7500C(36) pc3, Arch D - 24 x 36 in. (landscape), 1:1

MD-378 STANDARDS AND SPECIFICATIONS

SPECIFICATIONS

These specifications are appropriate to all ponds within the scope of the Standard for practice MD-378. All references to ASTM and AASHTO specifications apply to the most recent version.

SITE PREPARATION

Areas designated for borrow areas, embankment, and structural works shall be cleared, grubbed and stripped of topsoil. All trees, vegetation, roots and other objectionable material shall be removed. Channel banks and sharp breaks shall be sloped to no steeper than 1:1. All trees shall be cleared and grubbed within 15 feet of the toe of the embankment.

Areas to be covered by the reservoir will be cleared of all trees, brush, logs, fences, rubbish and other objectionable material unless otherwise designated on the plans. Trees, brush and stumps shall be cut approximately level with the ground surface. For dry stormwater management ponds, a minimum of a 25 foot radius around the inlet structure shall be cleared.

All cleared and grubbed material shall be disposed of outside and below the limits of the dam and reservoir as directed by the owner or his representative. When specified, a sufficient quantity of topsoil will be stockpiled in a suitable location for use on the embankment and other designated areas.

EARTH FILL

Material - The fill material shall be taken from approved designated borrow areas. It shall be free of roots, stumps, wood, rubbish, stones greater than 6", frozen or other objectionable materials. Fill material for the center of the embankment, and cut off trench shall conform to Unified Soil Classification GC, SC, CH, or CL and must have at least 30% passing the #200 sieve. Consideration may be given to the use of other materials in the embankment if designed by a geotechnical engineer. Such special designs must have construction supervised by a geotechnical engineer.

Placement - Areas on which fill is to be placed shall be scarified prior to placement of fill. Fill materials shall be placed in maximum 8-inch thick (before compaction) layers which are to be continuous over the entire length of the fill. The most permeable borrow material shall be placed in the downstream portions of the embankment. The principal spillway must be installed concurrently with fill placement and not excavated into the embankment.

Compaction - The movement of the hauling and spreading equipment over the fill shall be controlled so that the entire surface of each lift shall be traversed by not less than one tread track of the equipment or compaction shall be achieved by a minimum of four complete passes of a sheepsfoot, rubber tire or vibratory roller. Fill material shall contain sufficient moisture such that the required degree of compaction will be obtained with the equipment used. The fill material shall contain sufficient moisture so that if formed into a ball it will not crumble yet not be so wet that water can be squeezed out.

When required by the reviewing agency the required minimum density shall not be less than 95% of maximum dry density with a moisture content within +/- 2% of the optimum. Each layer of fill shall be compacted as necessary to obtain that density, and is to be certified by the Engineer at the time of construction. All compaction is to be determined by AASHTO Method T-99 (Standard Proctor).

Cutoff Trench - The cutoff trench shall be excavated into impervious material along or parallel to the centerline of the embankment as shown on the plans. The bottom width of the trench shall be governed by the equipment used for excavation, with the minimum width being four feet. The cutoff trench shall be at least four feet below existing grade or as shown on the plans. The side slopes of the trench shall be 1 to 1 or flatter. The backfill shall compacted with construction equipment, rollers, or hand tampers to assure maximum density and maximum permeability.

Embankment Core - The core shall be parallel to the centerline of the embankment as shown on the plans. The top width of the core shall be a minimum of four feet. The height shall extend up to at least the 10 year water elevation or as shown on the plans. The side slopes shall be 1 to 1 or flatter. The core shall be compacted with construction equipment, rollers, or hand tampers to assure maximum density and minimum permeability. In addition, the core shall be placed concurrently with the outer shell of the embankment.

STRUCTURE BACKFILL

Backfill adjacent to pipes or structures shall be of the type and quality conforming to that specified for the adjoining fill material. The fill shall be placed in horizontal layers not to exceed four inches in thickness and compacted by hand tampers or other manually directed compaction equipment. The material needs to fill completely all spaces under and adjacent to the pipe. At no time during the backfilling operation shall driven equipment be allowed to operate closer than four feet, measured horizontally, to any part of a structure. Under no circumstances shall equipment be driven over any part of a concrete structure or pipe, unless there is a compacted fill of 24" or greater over the structure or pipe.

Structure backfill may be flowable fill meeting the requirements of Maryland Department of Transportation, State Highway Administration Standard Specifications for Construction and Materials, Section 313 as modified. The mixture shall have a 100-200 psi; 28 day unconfined compressive strength. The flowable fill shall have a minimum pH of 4.0 and a minimum resistivity of 2000 ohm-cm. Material shall be placed such that a minimum of 6" (measured perpendicular to the pipe) of flowable fill shall be under (bedding), over and, on the sides of the pipe. It only needs to extend up to the spring line for rigid conduits. Average slump of the fill shall be 7" to assure flowability of the material. Adequate measures shall be taken (sand bags, etc.) to prevent floating the pipe. When using flowable fill, all metal pipe shall be bituminous coated. Any adjoining soil fill shall be placed in horizontal layers not to exceed four inched in thickness and compacted by hand tampers or other manually directed compaction equipment. The material shall completely fill all voids adjacent to the flowable fill zone. At no time during the backfilling operation shall driven equipment be allowed to operate closer than four feet, measured horizontally, to any part of a structure. Under no circumstances shall equipment be driven over any part of a structure or pipe unless there is a compacted fill of 24" or greater over the structure or pipe. Backfill material outside the structural backfill (flowable fill) zone shall be of the type and quality conforming to that specified for the core of the embankment or other embankment materials.

PIPE CONDUITS

All pipes shall be circular in cross section.

Corrugated Metal Pipe - All of the following criteria shall apply for corrugated metal pipe:

1. Materials - (Polymer Coated Steel pipe) - Steel pipes with polymeric coatings shall have a minimum coating thickness of 0.01 inch (10mil) on both sides of the pipe. This pipe and its appurtenances shall conform to the requirements of AASHTO Specifications M-245 & M-246 with watertight coupling bands or flanges.

   Materials - (Aluminum Coated Steel Pipe) - This pipe and its appurtenances shall conform to the requirements of AASHTO Specifications M-274 with watertight coupling bands or flanges. Aluminum Coated Steel Pipe, when used with flowable fill or when soil and/or water conditions warrant the need for increased durability, shall be fully bituminous coated per requirements of AASHTO Specification M-190 Type A. Any aluminum coating damaged or otherwise removed shall be replaced with cold applied bituminous coating compound. Aluminum surfaces that are to be in contact with concrete shall be painted with one coat of zinc chromate primer or two coats of asphalt.

   Materials - (Aluminum Pipe) - This pipe and its appurtenances shall conform to to the requirements of AASHTO Specifications M-190 or M-211 with watertight coupling bands or flanges. Aluminum Pipe, when used with flowable fill or when soil and/or water conditions warrant the need for increased durability, shall be fully bituminous coated per requirements of AASHTO Specification M-190 Type A. Aluminum surfaces that are to be in contact with concrete shall be painted with one coat of zinc chromate primer or two coats of asphalt. Hot dip galvanized bolts not be used for connections. the pH of the surrounding soils shall be between 4 and 9.

2. Coupling bands, anti-seep collars, and sections, etc., must be composed of the same material and coted as the pipe. Metals must be insulated from dissimilar materials with use of rubber or plastic insulating materials at at least 24 mils in thickness.

3. Connections - All connections with pipes must be completely watertight. The drain pipe or barrel connection to the riser shall be welded all around when the pipe and riser are metal. Anti-seep collars shall be connected to the pipe in such a manner as to be completely watertight. Dimple bands are not considered to be watertight.

   All connections shall use a rubber or neoprene gasket when joining pipe sections. The end of each pipe shall be re-rolled an adequate number of corrugations to accommodate the band width. The following type connections are acceptable for pipes less than 24" in diameter; Flanges on both ends of the pipe with a circular 3/8 inch closed cell neoprene gasket, prepunched to the flange bolt circle, sandwiched between adjacent flanges; a 12 inch wide standard lap type band with 12 inch wide by 3/8 inch thick closed cell circular neoprene gasket; and a 12 inch wide hugger type band with o-ring gaskets having a minimum diameter of 1/2 inch greater than the corrugation depth. Pipes 24 inches in diameter and larger shall be connected by a 24 inch long annular corrugated band using a minimum of 4 (four) rods and lugs, 2 on each connecting pipe ends. A 24 inch wide by 3/8 inch thick closed cell circular neoprene gasket will be installed with 12 inch on the end of each pipe. Flanged joints with 3/8 inch closed cell gaskets the full width of the flange is also acceptable.

   Helically corrugated pipe shall have either continuously welded seams or have lock seams with internal caulking or a neoprene bead.

4. Bedding - The pipe shall be firmly and uniformly bedded throughout its entire length. Where rock or soft, spongy or other unstable soil is encountered, all such material shall be removed and replaced with suitable earth compacted to provide adequate support.

5. Backfilling shall conform to "Structure Backfill."

6. Other details (anti-seep collars, valves, etc.) shall be as shown on the drawings.

Reinforced Concrete Pipe - All of the following criteria shall apply for reinforced concrete pipe:

1. Materials - Reinforced concrete pipe shall have bell and spigot joints with rubber gaskets and shall equal or exceed ASTM Designation C-361.

2. Bedding - All reinforced concrete pipe conduits shall be laid in a concrete bedding/cradle for their entire length. This bedding/cradle shall consist of high slump concrete placed under the pipe and up the side of the pipe at least 50% of its outside diameter with a minimum thickness of 6 inches. Where a concrete cradle is not needed for structural reasons, flowable fill may be used as described in the "Structure Backfill" section of this standard. Gravel bedding is not permitted.

3. Laying pipe - Bell and spigot pipe shall be placed with the bell and upstream. Joints shall be made in accordance with recommendations of the manufacturer of the material. After the joints are sealed for the entire line, the bedding shall be placed so that all spaces under the pipe are filled. Care shall be exercised to prevent any deviation from the original line and grade of the pipe. The first joint must be located within 4 feet from the riser.

4. Backfilling shall conform to "Structure Backfill."

5. Other details (anti-seep collars, valves, etc.) shall be as shown on the drawings.

Plastic Pipe - The following criteria shall apply for pipe:

1. Materials - PVC pipe shall be PVC-1120 or PVC-1220 conforming to ASTM D-1785 or ASTM D-2241. Corrugated High Density Polyethylene (HDPE) pipe, couplings and fittings shall conform to the following: 4 - 10 inch pipe shall meet the requirements of AASHTO M252 Type S, and 12" through 24" shall meet the requirements of AASHTO M294 Type S.

2. Joints and connections to anti-seep collars shall be completely watertight.

3. Bedding - The pipe shall be firmly and uniformly bedded throughout its entire length. Where rock or soft, spongy or other unstable soil is encountered, all such material shall be removed and replaced with suitable earth compacted to provide adequate support.

4. Backfilling shall conform to Structure "Backfill".

5. Other details (anti-seep collars, valves, etc.) shall be as shown on the drawings.

CONCRETE

Concrete shall meet the requirements of Maryland Department of Transportation, State Highway Administration Standard Specifications for Construction and Materials, Section 414, Mix No. 3.

ROCK RIPRAP

Rock riprap shall meet the requirements of Maryland Department of Transportation, State Highway Administration Standard Specifications for Construction and Materials, Section 311.

Geotextile shall be placed under all riprap and shall meet the requirements of Maryland Department of Transportation, State Highway Administration Standard Specifications for Construction and Materials, Section 421.04, Class C.

CARE OF WATER DURING CONSTRUCTION

All work on permanent structures shall be carried out in areas free from water. The Contractor shall construct and maintain all temporary dikes, levees, cofferdams, drainage channels, and stream diversions necessary to protect the areas to be occupied by the permanent works. The contractor shall also furnish, install, operate, and maintain all necessary pumping and other equipment required for removal of water from the various parts of the work and for maintaining the excavations, foundation, and other parts of the work free from water as required or directed by the engineer for constructing each part of the work. After having served their purpose, all temporary protective works shall be removed or leveled and graded to the extent required to prevent obstruction in any degree whatsoever of the flow of water to the spillway or outlet works and so as not to interfere in any way with the operation or maintenance of the structure. Stream diversions shall be maintained until the full flow can be passed through the permanent works. The removal of water from the required excavation and the foundation shall be accomplished in a manner and to the extent that will maintain stability of the excavated slopes and bottom of required excavations and will allow satisfactory performance of all construction operations. During the placing and compacting of material in required excavations, the water level at the locations being refilled shall be maintained below the bottom of the excavation at such locations which may require draining the water to sumps from which the water shall be pumped.

STABILIZATION

All borrow areas shall be graded to provide proper drainage and left in a slightly condition. All exposed surfaces of the embankment, spillway, spoil and borrow areas, and berms shall be stabilized by seeding, liming, fertilizing and mulching in accordance with the Natural Resources Conservation Service Standards and Specifications for Critical Area Planting (MD-342) or as shown on the accompanying drawings.

EROSION AND SEDIMENT CONTROL

Construction operations will be carried out in such a manner that erosion will be controlled and water and air pollution minimized. State and local laws concerning pollution abatement will be followed. Construction plans shall detail erosion and sediment control measures.

Refer to the 1994 MARYLAND STANDARDS AND SPECIFICATIONS FOR SOIL EROSION AND SEDIMENT CONTROL for rate and methods not covered.

TEMPORARY SEEDING NOTES

Apply to graded or cleared areas likely to be redisturbed where a short-term vegetative cover is needed.

Seedbed Preparation - Loosen upper three inches of soil by raking, discing or other acceptable means before seeding, if not previously loosened.

Soil Amendments - Apply 600 lbs. per acre 10-10-10 fertilizer (14 lbs. per 1000 sq.ft.)

Seeding - For periods March 1 thru April 30 and from August 15 thru November 15, seed with 2-1/2 bushels per acre of annual rye (5.2 lbs. per 1000 sq.ft.). For the period May 1 thru August 14, seed with 3 lbs. per acre of weeping lovegrass (0.07 lbs. per 1000 sq.ft.). For the period November 16 thru February 28, protect site by applying 2 tons per acre of well anchored straw mulch and seed as soon as possible in the spring, or use sod.

Mulching - Apply 1-1/2 to 2 tons per acre (70 to 90 lbs. per 1000 sq.ft.) of unrotted small grain straw immediately after seeding. Anchor mulch immediately after application using mulch anchoring tool or 218 gal. per acre (5 gal. per 1000 sq.ft.) of emulsified asphalt on flat areas. On slopes, 8 ft. or higher, use 341 gal. per acre (8 gal. per 1000 sq.ft.) for anchoring.

Refer to the 1994 MARYLAND STANDARDS AND SPECIFICATIONS FOR SOIL EROSION AND SEDIMENT CONTROL for rate and methods not covered.

PERMANENT SEEDING NOTES

Apply to graded or cleared areas not subject to immediate further disturbance where a perennial long-lived vegetative cover is needed.

Seedbed Preparation - Loosen upper three inches of soil by raking, discing or other acceptable means before seeding, if not previously loosened.

Soil Amendments - In lieu of soil test recommendations, use one of the following schedules:

1) Preferred - Apply 2 tons per acre dolomitic limestone (92 lbs. per 1000 sq.ft.) and 600 lbs. per acre 10-10-10 fertilizer (14 lbs. per 1000 sq.ft.) before seeding. Harrow or disc into upper three inches of soil. At time of seeding, apply 400 lbs. per acre 30-0-0 ureaform fertilizer (9 lbs. per 1000 sq.ft.).

2) Acceptable - Apply 3 tons per acre dolomitic limestone (92 lbs. per 1000 sq.ft.) and 1000 lbs. per acre 10-10-10 fertilizer (23 lbs. per 1000 sq.ft.) before seeding. Harrow or disc into upper three inches of soil.

Seeding - For the period March 1 thru April 30 and from August 1 thru October 15, seed with 60 lbs. per acre (1.4 lbs. per 1000 sq.ft.) of Kentucky 31 Tall Fescue. For the period May 1 thru July 31, seed with 60 lbs. Kentucky 31 Tall Fescue per acre and 2 lbs. per acre (0.05 lbs. per 1000 sq.ft.) of weeping lovegrass. During the period October 16 thru February 28, protect site by one of the following options:

1) 2 tons per acre of well-anchored mulch straw and seed as soon as possible in the spring.

2) Use sod.

3) Seed with 60 lbs. per acre Kentucky 31 Tall Fescue and mulch with 2 tons per acre well anchored straw.

Mulching - Apply 1-1/2 to 2 tons per acre (70 to 90 lbs. per 1000 sq.ft.) of unrotted small grain straw immediately after seeding. Anchor mulch immediately after application using mulch anchoring tool or 218 gal. per acre (5 gal. per 1000 sq.ft.) of emulsified asphalt on flat areas. On slopes, 8 ft. or higher, use 341 gal. per acre (8 gal. per 1000 sq.ft.) for anchoring.

Maintenance - Inspect all seeded areas and make needed repairs, replacements and reseedings.

OPERATION, MAINTENANCE AND INSPECTION

INSPECTION OF THE POND SHOWN HEREON SHALL BE PERFORMED AT LEAST ONCE ANNUALLY, IN ACCORDANCE WITH THE CHECKLIST AND REQUIREMENTS CONTAINED WITHIN USDA, SCS "STANDARDS AND SPECIFICATION FOR PONDS" (MD378). THE POND OWNER AND ANY HEIRS, SUCCESSORS, OR ASSIGNS SHALL BE RESPONSIBLE FOR THE SAFETY OF THE POND AND THE CONTINUED OPERATION, SURVEILLANCE, INSPECTION, AND MAINTENANCE THEREOF. THE POND OWNER SHALL PROMPTLY NOTIFY THE SOIL CONSERVATION DISTRICT OF ANY UNUSUAL OBSERVATIONS THAT MAY BE INDICATIONS OF DISTRESS SUCH AS EXCESSIVE SEEPAGE, TURBID SEEPAGE, SLIDING OR SLUMPING.

21.0 STANDARD AND SPECIFICATIONS FOR TOPSOIL

Definition

Placement of topsoil over a prepared subsoil prior to establishment of permanent vegetation.

Purpose

To provide a suitable soil medium for vegetative growth. Soils of concern have low moisture content, low nutrient levels, low pH, materials toxic to plants, and/or unacceptable soil gradation.

Conditions Where Practice Applies

I. This practice is limited to areas having 2:1 or flatter slopes where:
   a. The texture of the exposed subsoil/parent material is not adequate to produce vegetative growth.
   b. The soil material is so shallow that the rooting zone is not deep enough to support plants or furnish continuing supplies of moisture and plant nutrients.
   c. The original soil to be vegetated contains material toxic to plant growth.
   d. The soil is so acidic that treatment with limestone is not feasible.

II. For the purpose of these Standards and Specifications, areas having slopes steeper than 2:1 require special consideration and design for adequate stabilization. Areas having slopes steeper than 2:1 shall have the appropriate stabilization shown on the plans.

Construction and Material Specifications

I. Topsoil salvaged from the existing site may be used provided that it meets the standards as set forth in these specifications. Typically, the depth of topsoil to be salvaged for a given soil type can be found in the representative soil profile section in the Soil Survey published by USDA-SCS in cooperation with Maryland Agricultural Experimentation Station.

II. Topsoil Specifications - Soil to be used as topsoil must meet the following:

   1. Topsoil shall be a loam, sandy loam, clay loam, silt loam, sandy clay loam, loamy sand. Other soils may be used if recommended by an agronomist or soil scientist and approved by the appropriate approval authority. Regardless, topsoil shall not be a mixture of contrasting textured subsoils. Less than 5% by volume of cinders, stones, slag, coarse fragments, gravel, sticks, roots, trash, or other materials larger than 1½" in diameter.

   II. Topsoil must be free of plants or plant parts such as bermuda grass, quackgrass, Johnsongrass, nutsedge, poison ivy, thistle, or others as specified.

   III. Where subsoil is either highly acidic or composed of heavy clays, ground limestone shall be spread at the rate of 4-8 tons/acre (200-400 pounds per 1,000 square feet) prior to the placement of topsoil. Lime shall be distributed uniformly over designated areas and worked into the soil in conjunction with tillage operations as described in the following procedures.

II. For sites having disturbed areas under 5 acres:

   I. Place topsoil (if required) and apply soil amendments as specified in 20.0 Vegetative Stabilization - Section I - Vegetative Stabilization Methods and Materials.

III. For sites having disturbed areas over 5 acres:

   I. On soil meeting Topsoil specifications, obtain test results dictating fertilizer and lime amendments required to bring the soil into compliance with the following:
      a. pH for topsoil shall be between 6.0 and 7.5. If the tested soil demonstrates a pH of less than 6.0, sufficient lime shall be prescribed to raise the pH to 6.5 or higher.
      b. Organic content of topsoil shall be not less than 1.5 percent by weight.
      c. Topsoil having soluble salt content greater than 500 parts per million shall not be used.


   II. Place topsoil (if required) and apply soil amendments as specified in 20.0 Vegetative Stabilization - Section I - Vegetative Stabilization Methods and Materials.

V. Topsoil Application

   I. When topsoiling, maintain needed erosion and sediment control practices such as diversions, Grade Stabilization Structures, Earth Dikes, Slope Silt Fence and Sediment Traps and Basins.

   II. Grades on the areas to be topsoiled, which have been previously established, shall be maintained, albeit 4" - 8" higher in elevation.

   III. Topsoil shall be uniformly distributed in a 4" - 8" layer and lightly compacted to a minimum thickness of 4". Spreading shall be performed in such a manner that sodding or seeding can proceed with a minimum of additional soil preparation and tillage. Any irregularities in the surface resulting from topsoiling or other operations shall be corrected in order to prevent the formation of depressions or water pockets.

   IV. Topsoil shall not be placed while the topsoil or subsoil is in a frozen or muddy condition, when the subsoil is excessively wet or in a condition that may otherwise be detrimental to proper grading and seedbed preparation.

VI. Alternative for Permanent Seeding - Instead of applying the full amounts of lime and commercial fertilizer, composted sludge and amendments may be applied as specified below:

   I. Composted Sludge Material for use as a soil conditioner for sites having disturbed areas over 5 acres shall be tested to prescribe amendments and for site having disturbed areas under 5 acres shall conform to the following requirements:
      a. Composted sludge shall be supplied by, or originate from, a person or persons that are permitted (at the time of acquisition of the compost) by the Maryland Department of the Environment under COMAR 26.04.06.
      b. Composted sludge shall contain at least 1 percent nitrogen, 1.5 percent phosphorus, and 0.2 percent potassium and have a pH of 7.0 to 8.0. If compost does not meet these requirements, the appropriate corrections must be added to meet the requirements prior to use.
      c. Composted sludge shall be applied at a rate of 1 ton/1,000 square feet.
      d. Composted sludge shall be applied with a potassium fertilizer applied at the rate of 4 lb/1,000 square feet, and 1/3 the normal lime application rate.

References: Guideline Specifications, Soil Preparation and Sodding. MD-VA, Pub. #1, Cooperative Extension Service, University of Maryland and Virginia Polytechnic Institutes. Revised 1973.

GEOTECHNICAL RECOMMENDATIONS

EARTHWORK OPERATIONS

THE NATURAL MOISTURE CONTENT OF THE FILL MATERIALS ON SITE WAS GENERALLY ABOVE THE OPTIMUM MOISTURE CONTENT. BASED ON THESE CONDITIONS, SIGNIFICANT DRYING OF THE SOIL BY DISCING AND AERATION OR OTHER MEANS OF MANIPULATION CAN BE ANTICIPATED DURING THE EARTHWORK PROCESS. THE MICACEOUS COMPONENT OF THE ON-SITE SOILS MAKES IT SUSCEPTIBLE TO LOSS OF STRENGTH UPON EXPOSURE TO FREE WATER. THEREFORE, IT WOULD BE PRUDENT TO SCHEDULE CLEARING AND GRUBBING, STRIPPING, AND EARTHWORK OPERATIONS FOR THE WARMER, DRYER PERIODS OF THE YEAR IF POSSIBLE SO THAT CONSTRUCTION SCHEDULES WILL NOT BE DELAYED DUE TO INCLEMENT WEATHER.

ALL FILL PLACED FOR THE EMBANKMENT, UTILITY BACKFILL, OR ANY OTHER LOCATION REQUIRING STABLE SUPPORT OR MINIMAL SETTLEMENT SHALL BE CONSTRUCTED AS CONTROLLED COMPACTED FILL. CONTROLLED COMPACTED FILL AND FOUNDATION EXCAVATIONS SHALL MEET THE FOLLOWING REQUIREMENTS:

A) WITHIN THE DESCRIBED CONSTRUCTION AREAS, STRIP THE VEGETATION, TOPSOIL, AND ANY ORGANIC, CONTAMINATED, OR OTHERWISE UNSUITABLE MATERIALS TO EXPOSE CLEAN SOILS. THE SUBJECT AREA SHALL ENCOMPASS THE SWM POND AND EXTEND OUTWARD FROM THE EDGES A MINIMUM OF 5 FEET PLUS 1 ADDITIONAL FOOT HORIZONTALLY FOR EVERY FOOT OF NEW FILL TO BE PLACED, OR CUT TO BE EXCAVATED.

B) PROOFROLL THE STRIPPED SOIL SURFACE WITH A FULLY LOADED, TANDEM-AXLE DUMP TRUCK, OR OTHER APPROVED EQUIPMENT, UNDER THE OBSERVATION OF A GEOTECHNICAL ENGINEER OR HIGHLY QUALIFIED SENIOR LEVEL SOILS TECHNICIAN, TO VERIFY AND ESTABLISH A UNIFORM, DENSE AND STABLE CONDITION. ANY SOFT, YIELDING, ORGANIC, CONTAMINATED, OR OTHERWISE UNACCEPTABLE SPOTS DETECTED SHALL BE OVEREXCAVATED AND REPLACED WITH CONTROLLED COMPACTED FILL.

C) ANY MATERIAL USED FOR CONTROLLED FILL SHALL BE INSPECTED AND APPROVED FOR USE BY A GEOTECHNICAL ENGINEER OR QUALIFIED SOILS TECHNICIAN PRIOR TO USE ON THE SITE. ALL FILL SHALL BE FREE FROM TOPSOIL, BOULDERS, COBBLES, ROOTS, ORGANIC MATTER, AND DEBRIS. PRELIMINARY APPROVAL OF THE BORROW MATERIAL SHALL NOT CONSTITUTE GENERAL ACCEPTANCE OF ALL MATERIALS IN THE DEPOSIT OR SOURCE OF SUPPLY, AND THE ACCEPTANCE SHALL BE SUBJECT TO FIELD TESTS TAKEN AT THE DISCRETION OF THE GEOTECHNICAL ENGINEER OR QUALIFIED SOILS TECHNICIAN.

D) COMPACTED FILL SHOULD BE PLACED IN HORIZONTAL, SUCCESSIVE, UNIFORM LAYERS HAVING A MAXIMUM UNCOMPACTED LIFT THICKNESS OF 8 INCHES. EACH LIFT SHOULD BE COMPACTED UNIFORMLY TO A MINIMUM OF 95 PERCENT OF THE STANDARD PROCTOR MAXIMUM DRY DENSITY AS DETERMINED BY AASHTO T-99 (ASTM D-698). THE MOISTURE CONTENT OF THE MATERIALS SHALL BE MAINTAINED WITHIN 3% OF THE OPTIMUM MOISTURE CONTENT IN ORDER TO ATTAIN THE REQUIRED DEGREE OF COMPACTION. EACH LIFT SHOULD BE UNIFORMLY AND EVENLY BLADE MIXED DURING SPREADING TO ENSURE UNIFORMITY OF THE MATERIAL IN EACH LAYER. IF THE WORK DETERIORATES PRIOR TO PLACEMENT OF THE NEXT LIFT, THE LAYER SHALL BE RECOMPACTED AND RESHAPED ACCORDINGLY.

E) SUCCESSIVE LIFTS OF COMPACTED FILL SHALL NOT BE PLACED UNTIL THE LAYER UNDER CONSTRUCTION HAS BEEN COMPACTED TO THE REQUIRED DENSITY AS MEASURED BY A GEOTECHNICAL ENGINEER OR QUALIFIED SOILS TECHNICIAN. SUCCESSIVE RUNS OF EQUIPMENT SHALL BE STAGGERED OVER THE WIDTH OF EACH LAYER.

F) WHERE FILLS ARE TO BE PLACED ON SLOPES, THE ORIGINAL GROUND SHOULD BE DEEPLY SCARIFIED OR WHERE SLOPES ARE STEEPER THAN 5:1 THE SLOPE SHOULD BE STEPPED OR BENCHED, WHEN CONSIDERED NECESSARY BY THE ENGINEER, IN ORDER THAT THE PLACEMENT OF FILL MAY BE ACCOMPLISHED IN HORIZONTAL LIFTS.

IT IS NOTED THAT THIS METHODOLOGY IS RECOMMENDED BOTH AS PREPARATION FOR AREAS TO RECEIVE NEW FILL, AS WELL AS, LOCATIONS WHERE CUT IS REQUIRED TO ESTABLISH THE PROPOSED GRADES SUCH AS FOUNDATION EXCAVATIONS. IN CUT AREAS, THE PROOFROLLING AND SELECTIVE UNDERCUTTING SHALL BE ACCOMPLISHED AFTER EXCAVATION DOWN TO THE PROPOSED GRADES HAS BEEN COMPLETED.

STANDARD SEDIMENT CONTROL NOTES

1. A MINIMUM OF 48 HOURS NOTICE MUST BE GIVEN TO THE HOWARD COUNTY DEPARTMENT OF INSPECTIONS, LICENSES AND PERMITS, SEDIMENT CONTROL DIVISION PRIOR TO THE START OF ANY CONSTRUCTION (313-1855).
2. ALL VEGETATIVE AND STRUCTURAL PRACTICES ARE TO BE INSTALLED ACCORDING TO THE PROVISIONS OF THIS PLAN AND ARE TO BE IN CONFORMANCE WITH THE 1994 MARYLAND STANDARDS AND SPECIFICATIONS FOR SOIL EROSION AND SEDIMENT CONTROL AND REVISIONS THERETO.
3. FOLLOWING INITIAL SOIL DISTURBANCE OR RE-DISTURBANCE, PERMANENT OR TEMPORARY STABILIZATION SHALL BE COMPLETED WITHIN: A) 7 CALENDAR DAYS FOR ALL PERIMETER SEDIMENT CONTROL STRUCTURES, DIKES, PERIMETER SLOPES, AND ALL SLOPES STEEPER THAN 3:1, B) 14 DAYS AS TO ALL OTHER DISTURBED OR GRADED AREAS ON THE PROJECT SITE.
4. ALL SEDIMENT TRAPS/BASINS SHOWN MUST BE FENCED AND WARNING SIGNS POSTED AROUND THE PERIMETER IN ACCORDANCE WITH VOL. 1, CHAPTER 7, OF THE HOWARD COUNTY DESIGN MANUAL, STORM DRAINAGE.
5. ALL DISTURBED AREAS MUST BE STABILIZED WITHIN THE TIME PERIOD SPECIFIED ABOVE IN ACCORDANCE WITH THE 1994 MARYLAND STANDARDS AND SPECIFICATIONS FOR SOIL EROSION AND SEDIMENT CONTROL FOR PERMANENT SEEDING, SOD, TEMPORARY SEEDING, AND MULCHING (SEC. 6.) TEMPORARY STABILIZATION WITH MULCH ALONE SHALL ONLY BE DONE WHEN RECOMMENDED SEEDING DATES DO NOT ALLOW FOR PROPER GERMINATION AND ESTABLISHED OF GRASSES.
6. ALL SEDIMENT CONTROL STRUCTURES ARE TO REMAIN IN PLACE AND ARE TO BE MAINTAINED IN OPERATIVE CONDITION UNTIL PERMISSION FOR THEIR REMOVAL HAS BEEN OBTAINED FROM THE HOWARD COUNTY SEDIMENT CONTROL INSPECTOR.
7. SITE ANALYSIS:

TOTAL AREA OF SITE	12.35 ACRES
AREA DISTURBED	7.4 ACRES
AREA TO BE ROOFED OR PAVED	0.4 ACRES
AREA TO BE VEGETATIVELY STABILIZED	7.0 ACRES
TOTAL CUT	11400 CU. YARDS
TOTAL FILL	4800 CU. YARDS

   OFFSITE WASTE AREA LOCATION TO HAVE ACTIVE GRADING PERMIT.

8. ANY SEDIMENT CONTROL PRACTICE WHICH IS DISTURBED BY GRADING ACTIVITY FOR PLACEMENT OF UTILITIES MUST BE REPAIRED ON THE SAME DAY OF DISTURBANCE.
9. ADDITIONAL SEDIMENT CONTROLS MUST BE PROVIDED, IF DEEMED NECESSARY BY THE HOWARD COUNTY SEDIMENT CONTROL INSPECTOR.
10. ON ALL SITES WITH DISTURBED AREAS IN EXCESS OF 2 ACRES, APPROVAL OF THE INSPECTION AGENCY SHALL BE REQUESTED UPON COMPLETION OF INSTALLATION OF PERIMETER EROSION AND SEDIMENT CONTROLS, BUT BEFORE PROCEEDING WITH ANY OTHER EARTH DISTURBANCE OR GRADING. OTHER BUILDING OR GRADING INSPECTION APPROVALS MAY NOT BE AUTHORIZED UNTIL THIS INITIAL APPROVAL BY THE INSPECTION AGENCY IS MADE.
11. TRENCHES FOR THE CONSTRUCTION OF UTILITIES IS LIMITED TO THREE PIPE LENGTHS OR THAT WHICH SHALL BE BACK-FILLED AND STABILIZED WITHIN ONE WORKING DAY, WHICHEVER IS SHORTER.
12. SITE GRADING WILL BEGIN ONLY AFTER ALL PERIMETER SEDIMENT CONTROL MEASURES HAVE BEEN INSTALLED AND ARE IN A FUNCTIONING CONDITION.
13. SEDIMENT WILL BE REMOVED FROM TRAPS WHEN ITS DEPTH REACHES CLEAN OUT ELEVATION SHOWN ON THE PLANS.
14. CUT AND FILL QUANTITIES PROVIDED UNDER SITE ANALYSIS DO NOT REPRESENT BID QUANTITIES. THESE QUANTITIES DO NOT DISTINGUISH BETWEEN TOPSOIL, STRUCTURAL FILL OR EMBANKMENT MATERIAL, NOR DO THEY REFLECT CONSIDERATION OF UNSUITABLE OR REMOVAL OF UNSUITABLE MATERIAL. THE CONTRACTOR SHALL FAMILIARIZE HIMSELF WITH SITE CONDITIONS WHICH MAY AFFECT THE WORK.

SEQUENCE OF CONSTRUCTION

1. OBTAIN GRADING PERMIT AND NOTIFY MARYLAND DEPARTMENT OF ENVIRONMENTAL NONTIDAL WETLANDS AND WATERWAYS INSPECTORS AND COMPLIANCE SECTIONS AT 410-631-3510 AT LEAST FIVE (5) DAYS IN ADVANCE OF BEGINNING ANY SANITARY SEWER WORK IN STREAMS, 100-YR FLOOD PLAIN, NONTIDAL WETLANDS, AND WETLAND BUFFERS (FROM EX MH-440 TO SMH-2).
2. CLEAR AND GRUB FOR SEDIMENT AND EROSION CONTROL MEASURES OR DEVICES ONLY WITH THE SEDIMENT CONTROL INSPECTOR'S PERMISSION FOR CONSTRUCTION OF SEWER FROM EX MH-440 TO SMH-2. (* - SEE BELOW) (1 WEEK)
3. INSTALL STABILIZED CONSTRUCTION ENTRANCE, EARTH DIKES, SILT FENCE, TREE PROTECTION FENCE AND SEDIMENT BASIN NO. 1. (5 WEEKS)
4. RELOCATE DRAIN AT GORMAN ROAD BEFORE GRADING PARCEL A. PERFORM ROUGH GRADING OF PARCEL A AND INSTALL STORM DRAINS, SEWER AND WATER. (8 WEEKS)
5. INSTALL CURB AND GUTTER AND PAVE ROADWAYS. (3 WEEKS)
6. APPLY TOPSOIL AND STABILIZE DISTURBED AREAS IN ACCORDANCE WITH PERMANENT SEEDING NOTES. (2 WEEKS)
7. PERFORM LANDSCAPING, LIGHTING AND SIDEWALKS. (1 WEEKS)
8. UPON PERMISSION OF COUNTY SEDIMENT CONTROL INSPECTOR, REMOVE ALL REMAINING SEDIMENT CONTROL DEVICES AND CONVERT SEDIMENT BASIN TO PERMANENT STORM WATER MANAGEMENT FACILITY. CONVERT FACILITY IN THE FOLLOWING STEPS:
   A. CLEAN STORM DRAIN INLETS AND FLUSH OUT PIPES. (3 DAYS)
   B. PUMP OUT STANDING WATER IN BASIN USING PUMPING STATION. (2 DAYS)
   C. REMOVE TEMPORARY DEWATERING DEVICE AND PLYWOOD. (1 DAY)
   D. INSTALL 4" STEEL ELBOW. (1 DAY)
   E. REMOVE ACCUMULATED SEDIMENT (2 DAYS)
   F. STABILIZE REMAINING DISTURBED AREAS IN ACCORDANCE WITH PERMANENT SEEDING NOTES. (3 DAYS)

   *REFER TO "CONDITIONS AND MANAGEMENT PRACTICES FOR WORKING IN NONTIDAL WETLANDS AND BUFFERS" (SEE BELOW)

"Conditions and Management Practices for Working In Nontidal Wetlands and Buffers"

a) Remove excavated material, construction material or debris to an upland disposal area outside of any waterway, floodplain, nontidal wetland, or buffer;

b) If backfill is obtained, use clean material free of waste metal products, unsightly debris, toxic material, or any other deleterious substance.

c) Place materials in a location and manner which does not adversely impact surface or subsurface water flow into or out of the nontidal wetland;

d) Maintain the hydrologic regime of nontidal wetlands outside the limits of disturbance.

e) Rectify any nontidal wetlands and buffers temporarily impacted by the permitted activity. All stabilization in the wetland and buffer shall be of the following recommended species: Annual Ryegrass (Lolium multiflorum), Millet (Setaria italica), Oats (Uniola sp.), and/or Rye (Secale cereale). Other non-persistent vegetation may be

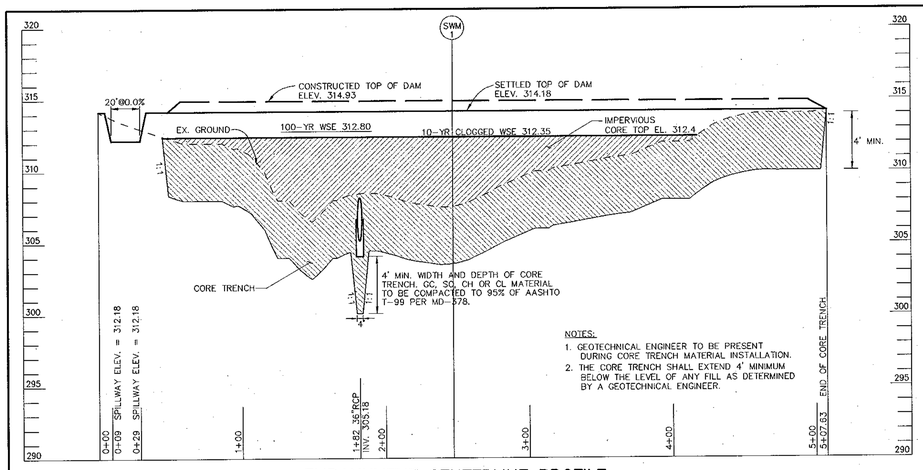

NOTES:
1. GEOTECHNICAL ENGINEER TO BE PRESENT DURING CORE TRENCH MATERIAL INSTALLATION.
2. THE CORE TRENCH SHALL EXTEND 4' MINIMUM BELOW THE LEVEL OF ANY FILL AS DETERMINED BY A GEOTECHNICAL ENGINEER.

EMBANKMENT CENTERLINE PROFILE

SCALE : HOR.-1"=50' VERT.-1"=5'

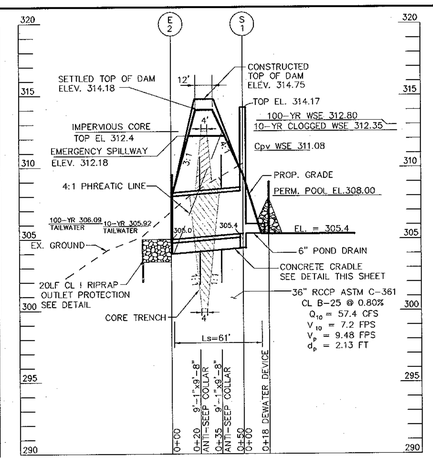

PRINCIPAL SPILLWAY PROFILE

SCALE : HOR.-1"=50' VERT.-1"=5'

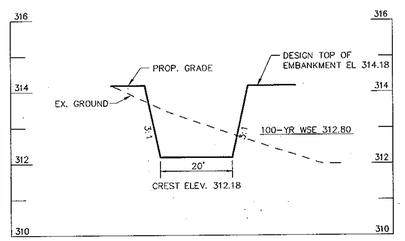

SECTION THRU EMERGENCY SPILLWAY

SCALE : HOR.-1"=20' VERT.-1"=2'

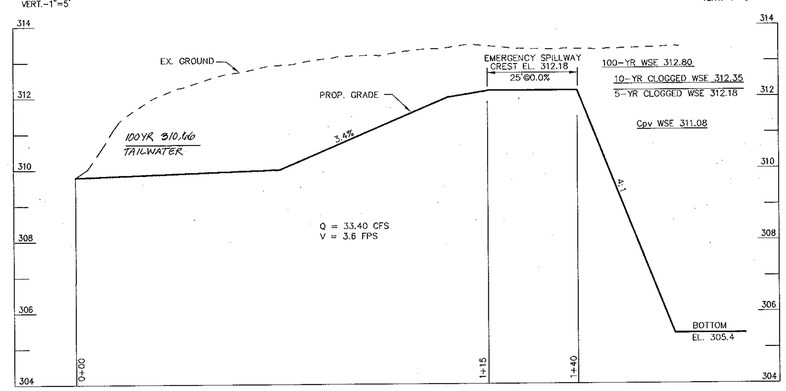

PROFILE THRU EMERGENCY SPILLWAY

SCALE : HOR.-1"=20' VERT.-1"=2'

OPERATION AND MAINTENANCE SCHEDULE OF PUBLICLY OWNED AND MAINTAINED STORMWATER MANAGEMENT FACILITY WET POND

ROUTINE MAINTENANCE

1. Facility shall be inspected anually and after major storms. Inspections should be performed during wet weather to determine if the pond is functioning properly.
2. Top and side slopes of the embankment shall be mowed a minimum of two (2) times a year, once in June and once in September. Other side slopes, the bottom of the pond, and maintenance access should be mowed as needed.
3. Debris and litter next to the outlet structure shall be removed during regular mowing operations and as needed.
4. Visible signs of erosion in the pond as well as riprap outlet area shall be repaired as soon as it is noticed.

NON-ROUTINE MAINTENANCE

1. Structural components of the pond such as the dam, the riser, and the pipes shall be repaired upon the the detection of any damage. The components should be inspected during routine maintenance operations.
2. Sediment should be removed when its accumulation significantly reduces the design storage, interfere with the function of the riser, when deemed necessary for aesthetic reasons, or when deemed necessary by the Howard County's Department of Public Works.

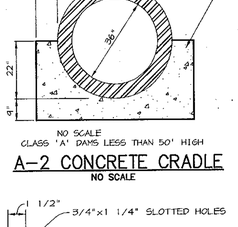

NO SCALE
CLASS 'A' DAMS LESS THAN 50' HIGH

A-2 CONCRETE CRADLE

NO SCALE

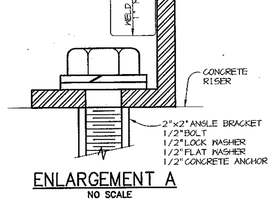

ENLARGEMENT A

NO SCALE

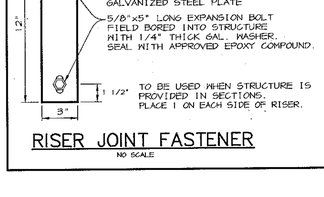

TO BE USED WHEN STRUCTURE IS PROVIDED IN SECTIONS. PLACE 1 ON EACH SIDE OF RISER.

RISER JOINT FASTENER

NO SCALE

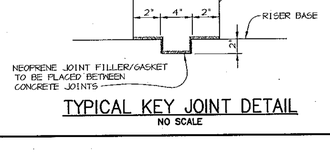

TYPICAL KEY JOINT DETAIL

NO SCALE

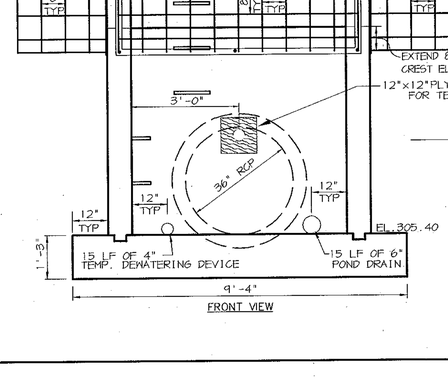

FRONT VIEW

TOP EL. 314.17
TOP OF WEIR EL. 313.50
100 YR WSE 312.80
10 YR CLOGGED WSE 312.35

6'-0" WEIR FRONT ONLY	4'-6" WEIR BOTH SIDES
EL. 311.08	EL. 311.08

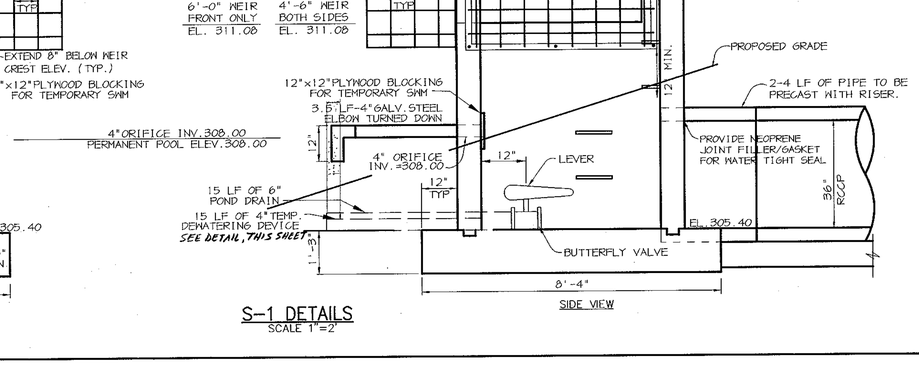

SIDE VIEW

S-1 DETAILS

SCALE 1"=2'

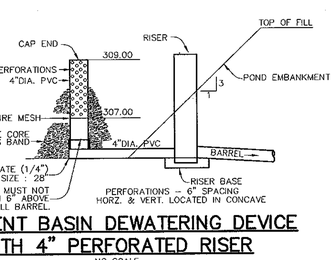

SEDIMENT BASIN DEWATERING DEVICE WITH 4" PERFORATED RISER

NO SCALE

1. PERFORATIONS ON THE DRAW-DOWN DEVICE MAY NOT EXTEND INTO THE WET STORAGE.
2. THE TOTAL AREA OF THE PERFORATIONS MUST BE GREATER THAN 2 TIMES THE AREA OF THE INTERNAL ORFICE.
3. THE PERFORATED PORTION OF THE DRAW-DOWN DEVICE SHALL BE WRAPPED WITH 1/2" HARDWARE CLOTH AND GEOTEXTILE FABRIC. THE GEOTEXTILE FABRIC SHALL MEET THE SPECIFICATIONS FOR GEOTEXTILE CLASS E.
4. PROVIDED SUPPORT OF DRAW-DOWN DEVICE TO PREVENT SAGGING AND FLOATATION. AN ACCEPTABLE PREVENTATIVE MEASURE IS TO STAKE BOTH SIDES OF DRAW-DOWN DEVICE WITH 1" STEEL ANGLE, OR 1" BY 4" SQUARE OR 2" ROUND WOODEN POSTS SET 3' MINIMUM INTO THE GROUND THEN JOINING THEM TO THE DEVICE BY WRAPPING WITH 12 GAUGE MINIMUM WIRE.

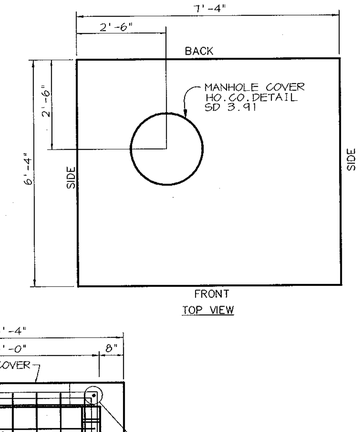

FRONT
TOP VIEW

0' – 0.3'	TOPSOIL
0.3' – 2.0'	GRAY AND BROWN MOIST SILT & CLAY, SOME SAND (ML)
2.0' – 5.5'	BROWN MOIST SAND, SOME SILT, LITTLE GRAVEL (SM)
5.5' – 13.0'	BROWN MOIST MICACEOUS SAND, SOME SILT (SM)
13.0' – 13.7'	GRAY MOIST SNAD, SOME SILT, TRACE ROCK FRAGMENTS (SM) (DECOMPOSED ROCK)

BORING SWM-1

NO SCALE

0' – 0.2'	TOPSOIL
0.2' – 4.0'	BROWN MOIST CLAYEY SILT, SOME SAND (ML)
4.0' – 6.0'	BROWN MOIST MICACEOUS CLAYEY SILT AND SAND (ML)
6.0' – 13.5'	BROWN MOIST MICACEOUS SAND, SOME CLAYEY SILT (SM)
13.5' – 18.5'	BLACK & WHITE MOIST MICACEOUS SAND, LITTLE SILT (SM) (DECOMPOSED ROCK)
18.5' – 18.9'	BROWN WET MICACEOUS SAND, SOME SILT (SM) (DECOMPOSED ROCK)

BORING SWM-2

NO SCALE

0' – 0.7'	TOPSOIL
0.7' – 6.0'	BROWN MOIST CLAYEY SILT AND SAND (ML)
6.0' – 8.0	GRAY MOIST MICACEOUS SAND, LITTLE SILT (SM)
8.0 – 14.9'	BROWN MOIST MICACEOUS SAND AND ROCK FRAGMENTS, TRACE SILT (SP-SM) (DECOMPOSED ROCK)

BORING SWM-3

NO SCALE

RISER STRUCTURE NOTES FOR S-1

1. RISER TO BE PRECAST. SHOP DRAWINGS FOR THIS CONCRETE STRUCTURE SHALL MEET THE MINIMUM ASTM REQUIREMENTS FOR PRECAST STRUCTURES.A SHOP DRAWING SHALL BE SUBMITTED TO THE ENSINEER PRIOR TO FABRICATION AND SHALL BE SIGNED AND SEALED BY A MARYLAND REGISTERED PROFESSIONAL ENGINEER.
2. CONCRETE SHALL BE MSHA MIX NO. 3 (fc=3,500 psi MINIMUM)
3. REFER TO HOWARD COUNTY STD. 6-5.21 FOR MANHOLE STEP DETAILS.
4. RISER JOINTS SHALL BE WATERTIGHT USING NEOPRENE GASKETS.
5. ALL PIPE CONNECTIONS SHALL PROVIDE RUBBER GASKET FOR WATERTIGHTNESS.
6. RISER SHALL BE PLACED ON A FURMLY COMPACTED SUBGRADE AND SHALL BE APPROVED BY A GEOTECHNICAL ENGINEER.
7. A 6" BUTTERFLY VALVE SHALL BE CONNECTED TO THE RISER WALL WITH ALL-THREADED ROD AND A FLANGE JOINT.

REMOVABLE TRASH RACK NOTES:

1. STEEL TO CONFORM TO ASTM A-36. #5 BARS TO BE SMOOTH. SEE DETAIL FOR SPACINGS.
2. ALL REBAR TO BE WELDED AT ALL INTERSECTIONS.
3. ALL BENDS TO BE 2" RADIUS. 2" x 2" ANGLE IRON AND 1/2" DIAMETER ANCHOR BOLTS TO BE USED FOR TRASH RACK FRAME.
4. GALVANIZE TRASH RACK AFTER FABRICATION AND PAINT BATTLESHIP GRAY.

RISER REINFORCEMENT NOTES:

REINFORCING TO BE #7 DEFORMED BARS @ 6" C/C, 2 WAYS, WITH 2" COVER IN TOP SLAB

REINFORCING TO BE #4 DEFORMED BARS @ 6" C/C, 2 WAYS WITH 2" COVER IN WALLS AND BOTTOM SLAB.

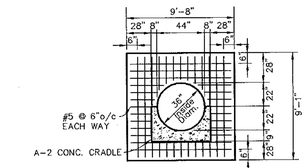

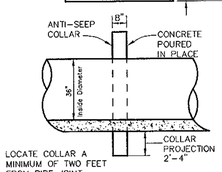

NOTES: 1. LOCATE COLLAR A MINIMUM OF TWO FEET FROM PIPE JOINT.

NOTES: 2. COLLAR/PIPE CONNECTION SHALL BE WATERTIGHT.

CONCRETE ANTI-SEEP COLLAR SWMF #1

NO SCALE

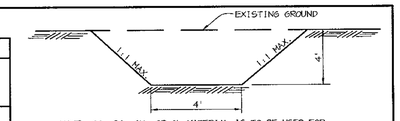

NOTE: GC, SC, CH, OR CL MATERIAL IS TO BE USED FOR CORE TRENCH. IF UNSUITABLE MATERIAL EXISTS ON SITE, ACCEPTABLE MATERIAL WILL NEED TO BE TRUCKED TO SITE.

CORE TRENCH DETAIL

NO SCALE

BY THE DEVELOPER :

I/WE CERTIFY THAT ALL DEVELOPMENT AND/OR CONSTRUCTION WILL BE DONE ACCORDING TO THESE PLANS, AND THAT ANY RESPONSIBLE PERSONNEL INVOLVED IN THE CONSTRUCTION PROJECT WILL HAVE A CERTIFICATE OF ATTENDANCE AT A DEPARTMENT OF THE ENVIRONMENT APPROVED TRAINING PROGRAM FOR THE CONTROL OF SEDIMENT AND EROSION BEFORE BEGINNING THE PROJECT. I SHALL ENGAGE A REGISTERED PROFESSIONAL ENGINEER TO SUPERVISE POND CONSTRUCTION AND PROVIDE THE HOWARD SOIL CONSERVATION DISTRICT WITH AN "AS-BUILT" PLAN OF THE POND WITHIN 30 DAYS OF COMPLETION. I ALSO AUTHORIZE PERIODIC ON-SITE INSPECTIONS BY THE HOWARD SOIL CONSERVATION DISTRICT.

DEVELOPER — DATE 10.18.02
PAUL CAVANAUGH

BY THE ENGINEER :

I CERTIFY THAT THIS PLAN FOR POND CONSTRUCTION, EROSION AND SEDIMENT CONTROL REPRESENTS A PRACTICAL AND WORKABLE PLAN BASED ON MY PERSONAL KNOWLEDGE OF THE SITE CONDITIONS. THIS PLAN WAS PREPARED IN ACCORDANCE WITH THE REQUIREMENTS OF THE HOWARD SOIL CONSERVATION DISTRICT. I HAVE NOTIFIED THE DEVELOPER THAT HE/SHE MUST ENGAGE A REGISTERED PROFESSIONAL ENGINEER TO SUPERVISE POND CONSTRUCTION AND PROVIDE THE HOWARD SOIL CONSERVATION DISTRICT WITH AN "AS-BUILT" PLAN OF THE POND WITHIN 30 DAYS OF COMPLETION.

ENGINEER — DATE 10.18.02

THESE PLANS HAVE BEEN REVIEWED FOR THE HOWARD SOIL CONSERVATION DISTRICT AND MEET THE TECHNICAL REQUIREMENTS FOR SMALL POND CONSTRUCTION, SOIL EROSION AND SEDIMENT CONTROL.

NATURAL RESOURCES CONSERVATION SERVICE — DATE 10/30/02

THESE PLANS FOR SMALL POND CONSTRUCTION, SOIL EROSION AND SEDIMENT CONTROL MEET THE REQUIREMENTS OF THE HOWARD SOIL CONSERVATION DISTRICT.

HOWARD SOIL CONSERVATION DISTRICT — DATE 10/30/02

APPROVED : HOWARD COUNTY DEPARTMENT OF PUBLIC WORKS.

CHIEF, BUREAU OF HIGHWAYS — DATE 11-9-02

APPROVED : HOWARD COUNTY DEPARTMENT OF PLANNING AND ZONING.

CHIEF, DIVISION OF LAND DEVELOPMENT — DATE 11/20/02

CHIEF, DEVELOPMENT ENGINEERING DIVISION — DATE 11/14/02

DATE	NO.	REVISION

OWNER/DEVELOPER

THE HOWARD RESEARCH AND DEVELOPMENT CORPORATION
THE ROUSE BUILDING
10275 LITTLE PATUXENT PARKWAY
COLUMBIA, MARYLAND 21044
410-992-6000

PROJECT
EMERSON
SECTION THREE AREA TWO

AREA — TAX MAP 47 BLOCK 8 & 9
ZONED: PEC-MXD-3 PART OF PARCELS: 462 & 837
6th ELECTION DISTRICT HOWARD COUNTY, MARYLAND

TITLE
STORMWATER MANAGEMENT DETAILS AND PROFILES

Patton Harris Rust & Associates,pc
Engineers. Surveyors. Planners. Landscape Architects.
8818 Centre Park Drive
Columbia, MD 21045
T 410.997.8900
F 410.997.9282

10.18.02 DATE

STATE OF MARYLAND — CHRISTOPHER J. REID — No. 19949 — PROFESSIONAL ENGINEER

CHRISTOPHER J. REID #19949

DESIGNED BY :	A.C.R
DRAWN BY :	DAM
CHECKED BY :	C.J.R.
PERMIT TRACKING NUMBER	01-NT-0222/200164079
DATE :	OCTOBER 21, 2002
SCALE :	AS SHOWN
DRAWING NO.	7 OF 12

F-02-178 C-DETAILS3.DWG

P:\project\2245611-01Eng\Plans\FINALS\C-DETAILS3.dwg, Layout1, 10/17/02 02:36:09 PM, HP750C(36).pc3, Arch D - 24 x 36 in. (landscape), 1:1

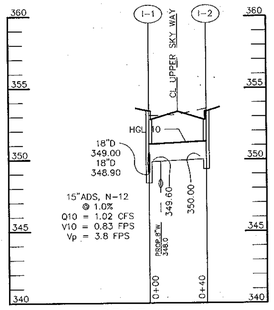

PROFILE

SCALE :
HOR.-1"=50'
VERT.-1"=5'

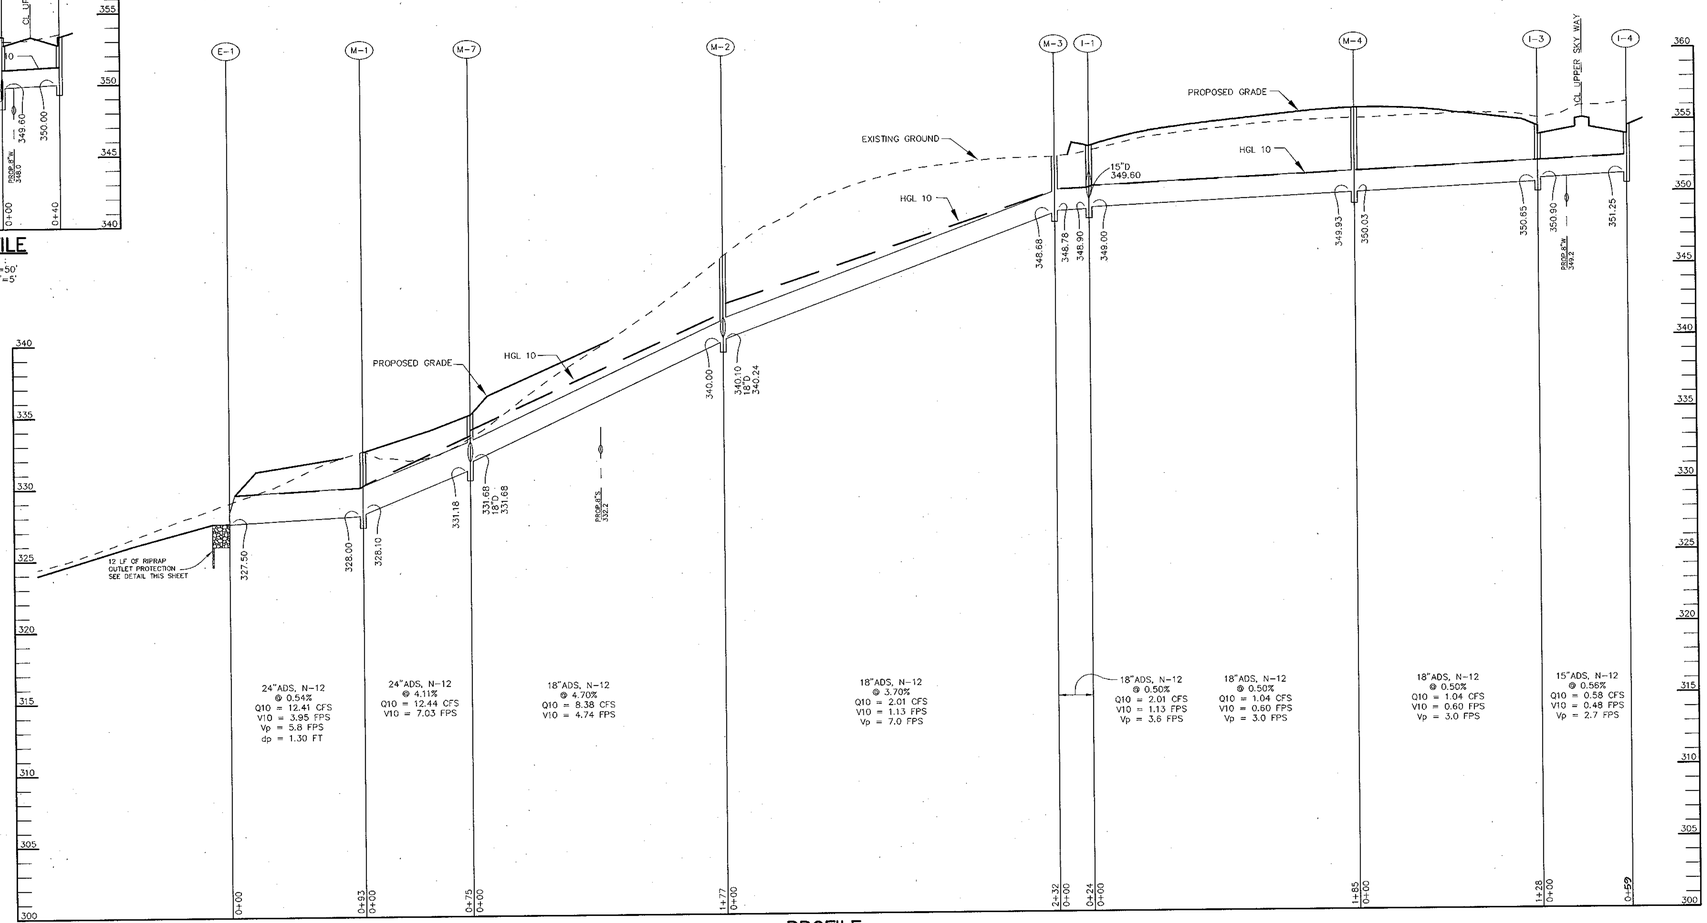

PROFILE

SCALE :
HOR.-1"=50'
VERT.-1"=5'

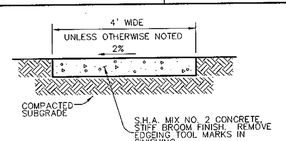

NOTES :
PROVIDE LATITUDINAL EXPANSION JOINTS AT 15' O.C. (MAX.)
PROVIDE CONTRACTION (DUMMY) JOINT AT 5' O.C. INTERVALS
BETWEEN EXPANSION JOINTS. SIDEWALK TO BE SCRIBED IN
5' MAX. SQUARES.

SIDEWALK DETAIL

NO SCALE

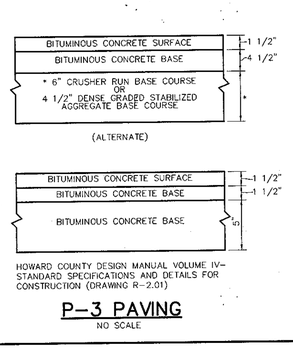

HOWARD COUNTY DESIGN MANUAL VOLUME IV-
STANDARD SPECIFICATIONS AND DETAILS FOR
CONSTRUCTION (DRAWING R-2.01)

P-3 PAVING

NO SCALE

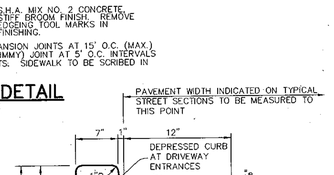

HOWARD COUNTY DESIGN MANUAL, VOLUME IV,
STANDARD SPECIFICATIONS AND DETAILS FOR
CONSTRUCTION (DRAWING R-3.01).

* GUTTER PAN AT THE MEDIAN EDGE OF INTERMEDIATE
ARTERIALS OR THE HIGH SIDE OF SUPERELEVATED
SECTIONS SHALL BE SLOPED AT THE SAME RATE
AS THE PAVEMENT.

STANDARD 7" COMBINATION CURB AND GUTTER

NO SCALE

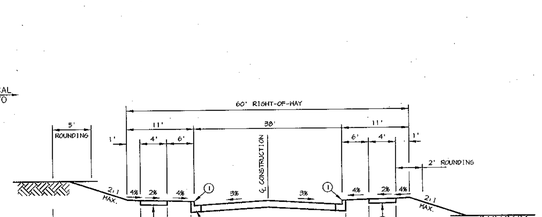

CLOSED SECTION

1. PROFILE GRADE LINE (PAL), SEE DESIGN MANUAL.
2. TYPE OF CURB VARIES (BITUMINOUS CURB OR MOD. CONB. CURB & GUTTER OR STANDARD CONB. CURB & GUTTER - SEE DESIGN MANUAL).
3. 4" CONCRETE SIDEWALK AS REQUIRED BY SUBDIVISION REGULATIONS.
4. INDICATES 2" TOPSOIL, SEED AND MULCH.
5. GUARDRAIL WHERE REQUIRED BY THE DESIGN MANUAL.
6. DITCH CROSS SECTION SLOPE MAY BE FLATTENED TO PROVIDE A SWALE AT OR NEAR THE CREST OF VERTICAL CURVES WHERE QUANTITY OF SWALE FLOW IS SMALL, AS APPROVED BY DPW.

TYPICAL SECTION LOCAL ROAD

NO SCALE

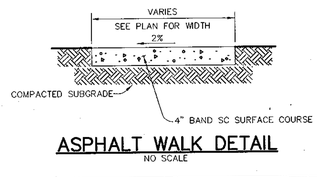

ASPHALT WALK DETAIL

NO SCALE

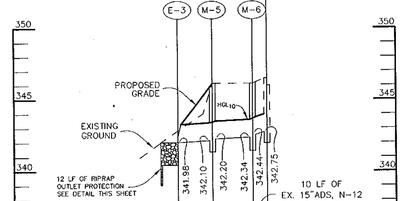

PROFILE

SCALE :
HOR.-1"=50'
VERT.-1"=5'

APPROVED : HOWARD COUNTY DEPARTMENT OF PUBLIC WORKS.

CHIEF, BUREAU OF HIGHWAYS — DATE 11-8-02

APPROVED : HOWARD COUNTY DEPARTMENT OF PLANNING AND ZONING.

CHIEF, DIVISION OF LAND DEVELOPMENT — DATE 11/20/02

CHIEF, DEVELOPMENT ENGINEERING DIVISION — DATE 11/14/02

DATE	NO.	REVISION

OWNER/DEVELOPER

THE HOWARD RESEARCH AND DEVELOPMENT CORPORATION
THE ROUSE BUILDING
10275 LITTLE PATUXENT PARKWAY
COLUMBIA, MARYLAND 21044
410-992-6000

PROJECT

EMERSON
SECTION THREE AREA TWO

AREA TAX MAP 47 BLOCK 8 & 9
ZONED: PEC-MXD-3 PART OF PARCELS: 462 & 837
6th ELECTION DISTRICT HOWARD COUNTY, MARYLAND

TITLE

PROFILES AND DETAILS

Patton Harris Rust & Associates, pc
Engineers. Surveyors. Planners. Landscape Architects.
8818 Centre Park Drive
Columbia, MD 21045
T 410.997.8900
F 410.997.9282

10.18.02
DATE

CHRISTOPHER J. REID #19949

DESIGNED BY :	A.C.R
DRAWN BY :	DAM
CHECKED BY :	C.J.R.
PERMIT TRACKING NUMBER	01-NT-0222/200164079
DATE :	OCTOBER 21, 2002
SCALE :	AS SHOWN
DRAWING NO.	8 OF 12

F-02-178 C-DETAILS4.DWG

z:\project\2245\11.0\Eng\Plans\FINALS\C-DETAILS4.dwg, Layout1, 10/17/02 02:45:44 PM, HP750C(36).pc3, Arch D - 24 x 36 in. (landscape), 1:1

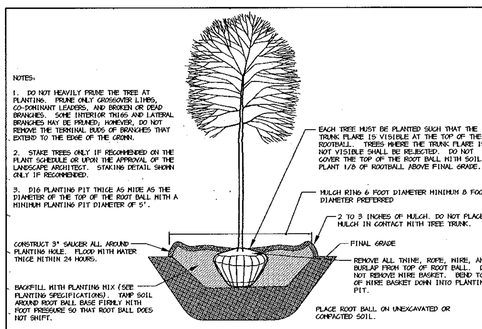

NOTES:

1. DO NOT HEAVILY PRUNE THE TREE AT PLANTING. PRUNE ONLY CROSSOVER LIMBS, CO-DOMINANT LEADERS, AND BROKEN OR DEAD BRANCHES. SOME INTERIOR TWIGS AND LATERAL BRANCHES MAY BE PRUNED; HOWEVER, DO NOT REMOVE THE TERMINAL BUDS OF BRANCHES THAT EXTEND TO THE EDGE OF THE CROWN.

2. STAKE TREES ONLY IF RECOMMENDED ON THE PLANT SCHEDULE OR UPON THE APPROVAL OF THE LANDSCAPE ARCHITECT. STAKING DETAIL SHOWN ONLY IF RECOMMENDED.

3. DIG PLANTING PIT TWICE AS WIDE AS THE DIAMETER OF THE TOP OF THE ROOT BALL WITH A MINIMUM PLANTING PIT DIAMETER OF 5'.

DECIDUOUS B&B TREE PLANTING DETAIL

NOT TO SCALE

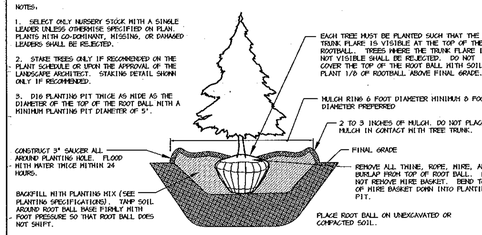

NOTES:

1. SELECT ONLY NURSERY STOCK WITH A SINGLE LEADER UNLESS OTHERWISE SPECIFIED ON PLAN. PLANTS WITH CO-DOMINANT, MISSING, OR DAMAGED LEADERS SHALL BE REJECTED.

2. STAKE TREES ONLY IF RECOMMENDED ON THE PLANT SCHEDULE OR UPON THE APPROVAL OF THE LANDSCAPE ARCHITECT. STAKING DETAIL SHOWN ONLY IF RECOMMENDED.

3. DIG PLANTING PIT TWICE AS WIDE AS THE DIAMETER OF THE TOP OF THE ROOT BALL WITH A MINIMUM PLANTING PIT DIAMETER OF 5'.

EVERGREEN B&B TREE PLANTING DETAIL

NOT TO SCALE

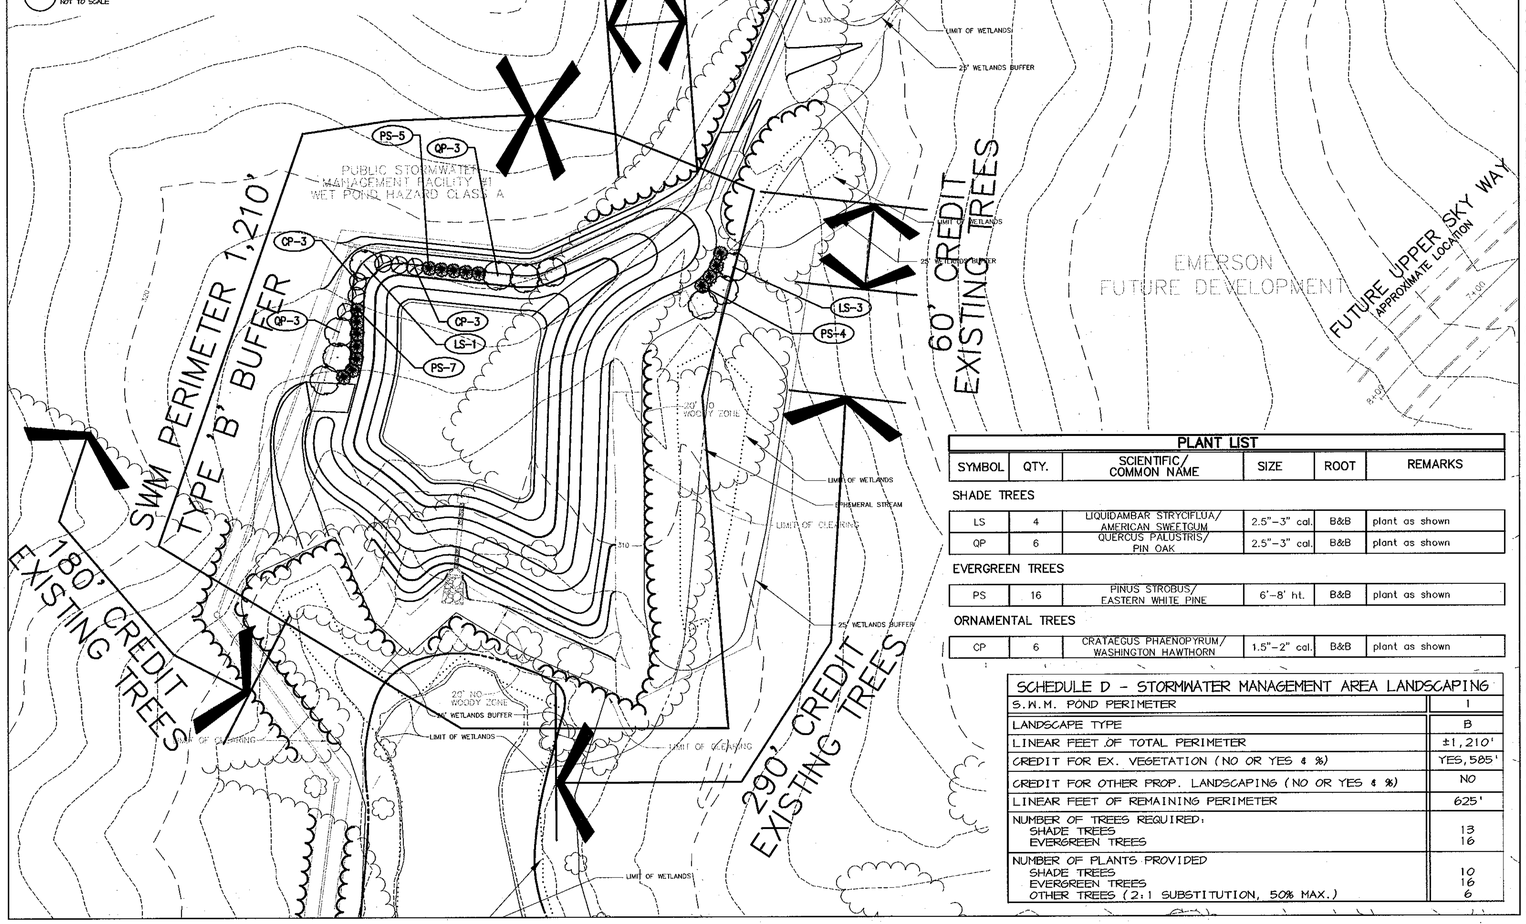

PLANT LIST

SYMBOL	QTY.	SCIENTIFIC/ COMMON NAME	SIZE	ROOT	REMARKS
SHADE TREES					
LS	4	LIQUIDAMBAR STRYCIFLUA/ AMERICAN SWEETGUM	2.5"-3" cal.	B&B	plant as shown
QP	6	QUERCUS PALUSTRIS/ PIN OAK	2.5"-3" cal.	B&B	plant as shown
EVERGREEN TREES					
PS	16	PINUS STROBUS/ EASTERN WHITE PINE	6'-8' ht.	B&B	plant as shown
ORNAMENTAL TREES					
CP	6	CRATAEGUS PHAENOPYRUM/ WASHINGTON HAWTHORN	1.5"-2" cal.	B&B	plant as shown

SCHEDULE D - STORMWATER MANAGEMENT AREA LANDSCAPING	
S.W.M. POND PERIMETER	1
LANDSCAPE TYPE	B
LINEAR FEET OF TOTAL PERIMETER	±1,210'
CREDIT FOR EX. VEGETATION (NO OR YES & %)	YES,585'
CREDIT FOR OTHER PROP. LANDSCAPING (NO OR YES & %)	NO
LINEAR FEET OF REMAINING PERIMETER	625'
NUMBER OF TREES REQUIRED: SHADE TREES / EVERGREEN TREES	13 / 16
NUMBER OF PLANTS PROVIDED SHADE TREES / EVERGREEN TREES / OTHER TREES (2:1 SUBSTITUTION, 50% MAX.)	10 / 16 / 6

GENERAL NOTES:

1) THIS PLAN HAS BEEN PREPARED IN ACCORDANCE WITH THE PROVISIONS OF SECTION 16.124 OF THE HOWARD COUNTY CODE AND THE LANDSCAPE MANUAL.
2) FINANCIAL SURETY FOR THE REQUIRED LANDSCAPING MUST BE POSTED AS PART OF THE DEVELOPER'S AGREEMENT IN THE AMOUNT OF $ 6,300.00
   10 SHADE TREES @ $300 = $3,000.00
   6 ORNAMENTAL TREES @ $150 = $900.00
   16 EVERGREEN TREES @ $150 = $2,400.00
3) THIS PLAN IS FOR LANDSCAPING PURPOSES ONLY.
4) CONTRACTOR IS SOLELY RESPONSIBLE FOR CONSTRUCTION MEANS, METHODS, TECHNIQUES, SEQUENCES, PROCEDURES, AND SAFETY PRECAUTIONS AND PROGRAMS.
5) ALL MATERIAL SELECTED SHALL BE EQUAL TO OR BETTER THAN THE REQUIREMENTS OF THE "USA STANDARD FOR NURSERY STOCK", LATEST EDITION, AS PUBLISHED BY THE AMERICAN ASSOCIATION OF NURSERYMEN.
6) ALL MATERIAL SHALL BE PLANTED IN ACCORDANCE WITH THE MINIMUM STANDARDS CITED IN THE LATEST EDITION OF "LANDSCAPE SPECIFICATION GUIDELINES" PUBLISHED BY THE LANDSCAPE CONTRACTORS ASSOCIATION.
7) AT THE TIME OF INSTALLMENT, ALL SHRUBS AND OTHER PLANTINGS SHALL BE OF THE PROPER HEIGHT AND/OR SPREAD REQUIREMENTS IN ACCORDANCE WITH THIS PLAN AND THE HOWARD COUNTY LANDSCAPE MANUAL.
8) NO SUBSTITUTIONS OR RELOCATION OF PLANTS MAY BE MADE WITHOUT PRIOR APPROVAL FROM THE DEPARTMENT OF PLANNING AND ZONING OF HOWARD COUNTY. ANY DEVIATION FROM THIS LANDSCAPE PLAN MAY RESULT IN A REQUIREMENT FOR SUBMITTAL OF AN OFFICIAL "REDLINE REVISION" TO THE SITE DEVELOPMENT PLAN(S) AND/OR DENIAL IN THE RELEASE OF LANDSCAPE SURETY.
9) LANDSCAPING FOR PARCELS A & B IS DEFERRED UNTIL SITE PLAN STAGE.

PLANTING SPECIFICATIONS

1. Plants, related material, and operations shall meet the detailed description, as given on the plans and as described herein. Where discrepancies exist between Standards & Guidelines referenced within these specifications and the Howard County Landscape Manual, the latter takes precedence.

2. All plant material, unless otherwise specified, that is not nursery grown, uniformly branched, does not have a vigorous root system, and does not conform to the most recent edition of the American Association of Nurserymen (AAN) Standards will be rejected. Plant material that is not healthy, vigorous, free from defects, decay, disfiguring roots, sunscald injuries, abrasions of the bark, plant disease, insect pest eggs, borers and all forms of insect infestations or objectionable disfigurements will be rejected. Plant material that is weak or which has been cut back from larger grades to meet specified requirements will be rejected. Trees with forked leaders will be rejected. All B & B plants shall be freshly dug; no healed-in plants or plants from cold storage will be accepted.

3. Unless otherwise specified, all general conditions, planting operations, details and planting specifications shall conform to the most recent edition of the "Landscape Specification Guidelines by the Landscape Contractors Association of MD, DC, & VA", (hereinafter "Landscape Guidelines") approved by the Landscape Contractors Association of Metropolitan Washington and the Potomac Chapter of the American Society of Landscape Architects.

4. Contractor shall guarantee all plant material for a period of one year after date of acceptance in accordance with the appropriate section on the Landscape Guidelines. Contractor's attention is directed to the maintenance requirements found within the one year specifications including watering and replacement of specified plant material.

5. Contractor shall be responsible for notifying all relevant and appropriate utility companies, utility contractors, and "Miss Utility" a minimum of 48 hours prior to the beginning of any work. Contractor may make minor adjustments in spacing and location of plant material to avoid conflicts with utilities. Major changes will require the approval of the landscape architect. Damage to existing structure and utilities shall be repaired at the expense of the Contractor.

6. Protection of existing vegetation to remain shall be accomplished via the temporary installation of 4 foot high snow fence at the drip line, see detail.

7. Contractor is responsible for installing all material in the proper planting season for each plant type. All planting is to be completed within growing season of completion of site construction. Do not plant Pinus strobus or XCupressocyparis leylandii between November 15 and March 15. Landscape plants are not to be installed before site is graded to final grade.

8. Contractor to regrade, fine grade, sod, hydroseed and straw mulch all areas disturbed by their work.

9. Bid shall be based on actual site conditions. No extra payment shall be made for work arising from actual site conditions differing from those indicated on drawings and specifications.

10. Plant quantities are provided for the convenience of the contractor only. If discrepancies exist between quantities shown on plan and those shown on the plant list, the quantities on the plan take precedence. Where discrepancies on the plan exist between the symbols and the callout leader, the number of symbols take precedence.

11. All shrubs and groundcover areas shall be planted in continuous planting beds, prepared as specified, unless otherwise indicated on plans. (See Specification 13). Beds to be mulched with minimum 2" and maximum 3" of composted, double-shredded hardwood mulch throughout.

12. Positive drainage shall be maintained on planting beds (minimum 2 percent slope).

13. Bed preparation shall be as follows: Till into a minimum depth of 6" 1 yard of Compro or Leafgro per 200 SF of planting bed, and 1 yard of topsoil per 100 SF of bed. Add 3 lbs of standard 5-10-5 fertilizer per cubic yard of planting mix and till. Ericaceous plants (Azaleas, Rhododendrons, etc.): top dress after planting with iron sulfate or comparable product according to package directions. Taxus baccata 'Repandens' (English weeping yews): Top dress after planting with 1/4 to 1/2 cup lime each.

14. Planting mix: For trees not in a prepared bed, mix 50% Compro or Leafgro with 50% soil from tree hole to use as backfill, see tree planting detail.

15. Weed & insect control: Incorporate a pre-emergent herbicide into the planting bed following recommended rates on the label. For tree planting, apply a pre-emergent on top of soil and root ball before mulching. Caution: For areas to be planted with a ground cover, be sure to carefully check the chemical used to assure its adaptability to the specific groundcover to be treated. Maintain the mulch weed-free for the extent of the warranty period. Under no circumstances is a pesticide containing chlorpyrifos to be used as a means of pest control.

16. Water: All plant material planted shall be watered thoroughly the day of planting. All plant material not yet planted shall be properly protected from drying out until planted. At a minimum, water unplanted plant material daily and as necessary to avoid dessication.

17. Pruning: Do not heavily prune trees and shrubs at planting. Prune only broken, dead, or diseased branches.

18. All areas within contract limits disturbed during or prior to construction not designated to receive plants and mulch shall be fine graded, grass seed planted, and covered with straw mulch.

DEVELOPER'S/BUILDER'S CERTIFICATE:

I/WE CERTIFY THAT THE LANDSCAPING SHOWN ON THIS PLAN WILL BE DONE ACCORDING TO THE PLAN, SECTION 16.124 OF THE HOWARD COUNTY CODE AND THE HOWARD COUNTY LANDSCAPE MANUAL. I/WE FURTHER CERTIFY THAT UPON COMPLETION, A CERTIFICATION OF LANDSCAPE INSTALLATION, ACCOMPANIED BY AN EXECUTED ONE YEAR GUARANTEE OF PLANT MATERIALS, WILL BE SUBMITTED TO THE DEPARTMENT OF PLANNING AND ZONING.

SIGNATURE — DATE 10.18.02

Paul Cavanaugh

PLANTING LEGEND

PROP. SHADE TREE	
PROP. ORNAMENTAL TREE	
PROP. EVERGREEN TREE	
PROP. TREELINE	
EXISTING SHADE TREE	
EXISTING TREELINE	

APPROVED : HOWARD COUNTY DEPARTMENT OF PUBLIC WORKS.

CHIEF, BUREAU OF HIGHWAYS — DATE 11-8-02

APPROVED : HOWARD COUNTY DEPARTMENT OF PLANNING AND ZONING.

CHIEF, DIVISION OF LAND DEVELOPMENT — DATE 11/13/02

CHIEF, DEVELOPMENT ENGINEERING DIVISION — DATE 11/14/02

DATE	NO.	REVISION

OWNER/DEVELOPER

THE HOWARD RESEARCH AND DEVELOPMENT CORPORATION
THE ROUSE BUILDING
10275 LITTLE PATUXENT PARKWAY
COLUMBIA, MARYLAND 21044
410-992-6000

PROJECT

EMERSON
SECTION THREE AREA TWO

AREA TAX MAP 47 BLOCK 8 & 9
ZONED: PEC-MXD-3 PART OF PARCELS: 462 & 837
6th ELECTION DISTRICT HOWARD COUNTY, MARYLAND

TITLE

LANDSCAPE PLAN

Patton Harris Rust & Associates, pc
Engineers. Surveyors. Planners. Landscape Architects.
8818 Centre Park Drive
Columbia, MD 21045
T 410.997.8900
F 410.997.9282

10.18.02
DATE

STATE OF MARYLAND 830 DAVID T. DOWS PROFESSIONAL ENGINEER

DAVID T. DOWS #830

DESIGNED BY :	DMD
DRAWN BY :	DMD
CHECKED BY :	DTD
PERMIT TRACKING NUMBER	01-NT-0222/200164079
DATE :	OCTOBER 21, 2002
SCALE :	1" = 50'
DRAWING NO.	9 OF 12

F-02-178

L200LND.dwg

BY THE DEVELOPER :

I/WE CERTIFY THAT ALL DEVELOPMENT AND/OR CONSTRUCTION WILL BE DONE ACCORDING TO THESE PLANS, AND THAT ANY RESPONSIBLE PERSONNEL INVOLVED IN THE CONSTRUCTION PROJECT WILL HAVE A CERTIFICATE OF ATTENDANCE AT A DEPARTMENT OF THE ENVIRONMENT APPROVED TRAINING PROGRAM FOR THE CONTROL OF SEDIMENT AND EROSION BEFORE BEGINNING THE PROJECT. I SHALL ENGAGE A REGISTERED PROFESSIONAL ENGINEER TO SUPERVISE POND CONSTRUCTION AND PROVIDE THE HOWARD SOIL CONSERVATION DISTRICT WITH AN "AS-BUILT" PLAN OF THE POND WITHIN 30 DAYS OF COMPLETION. I ALSO AUTHORIZE PERIODIC ON-SITE INSPECTIONS BY THE HOWARD SOIL CONSERVATION DISTRICT.

DEVELOPER Paul Cavanaugh — DATE 10.18.02

BY THE ENGINEER :

I CERTIFY THAT THIS PLAN FOR POND CONSTRUCTION, EROSION AND SEDIMENT CONTROL REPRESENTS A PRACTICAL AND WORKABLE PLAN BASED ON MY PERSONAL KNOWLEDGE OF THE SITE CONDITIONS. THIS PLAN WAS PREPARED IN ACCORDANCE WITH THE REQUIREMENTS OF THE HOWARD SOIL CONSERVATION DISTRICT. I HAVE NOTIFIED THE DEVELOPER THAT HE/SHE MUST ENGAGE A REGISTERED PROFESSIONAL ENGINEER TO SUPERVISE POND CONSTRUCTION AND PROVIDE THE HOWARD SOIL CONSERVATION DISTRICT WITH AN "AS-BUILT" PLAN OF THE POND WITHIN 30 DAYS OF COMPLETION.

ENGINEER — DATE 10.18.02

THESE PLANS HAVE BEEN REVIEWED FOR THE HOWARD SOIL CONSERVATION DISTRICT AND MEET THE TECHNICAL REQUIREMENTS FOR SMALL POND CONSTRUCTION, SOIL EROSION AND SEDIMENT CONTROL.

NATURAL RESOURCES CONSERVATION SERVICE — DATE

THESE PLANS FOR SMALL POND CONSTRUCTION, SOIL EROSION AND SEDIMENT CONTROL MEET THE REQUIREMENTS OF THE HOWARD SOIL CONSERVATION DISTRICT.

HOWARD SOIL CONSERVATION DISTRICT — DATE

APPROVED : HOWARD COUNTY DEPARTMENT OF PUBLIC WORKS.

CHIEF, BUREAU OF HIGHWAYS — DATE 11-8-02

APPROVED : HOWARD COUNTY DEPARTMENT OF PLANNING AND ZONING.

CHIEF, DIVISION OF LAND DEVELOPMENT — DATE 11/20/02

CHIEF, DEVELOPMENT ENGINEERING DIVISION — DATE 11/14/02

DATE	NO.	REVISION

OWNER/DEVELOPER

THE HOWARD RESEARCH AND DEVELOPMENT CORPORATION
THE ROUSE BUILDING
10275 LITTLE PATUXENT PARKWAY
COLUMBIA, MARYLAND 21044
410-992-6000

PROJECT

EMERSON
SECTION THREE AREA TWO

AREA
TAX MAP 47 BLOCK 8 & 9
ZONED: PEC-MXD-3 PART OF PARCELS: 462 & 837
6th ELECTION DISTRICT HOWARD COUNTY, MARYLAND

TITLE

EXISTING CONDITIONS SWM DRAINAGE AREA MAP

Patton Harris Rust & Associates, pc
Engineers. Surveyors. Planners. Landscape Architects.
8818 Centre Park Drive
Columbia, MD 21045
T 410.997.8900
F 410.997.9282

10.18.02
DATE

STATE OF MARYLAND — CHRISTOPHER J. REID — No. 19949 — PROFESSIONAL ENGINEER

CHRISTOPHER J. REID #19949

DESIGNED BY :	A.C.R
DRAWN BY :	DAM
CHECKED BY :	C.J.R.
PERMIT TRACKING NUMBER	01-NT-0222/200164079
DATE :	OCTOBER 21, 2002
SCALE :	1" = 100'
DRAWING NO.	10 OF 12

F-02-178

C-410XDA.DWG

P:\project\224561-01Eng\Plans\FINALS\C-410XDA.dwg, CP410XDA, 10/17/02 02:58:55 PM, HP750C(36).pc3, Arch D - 24 x 36 in. (landscape), 1:1

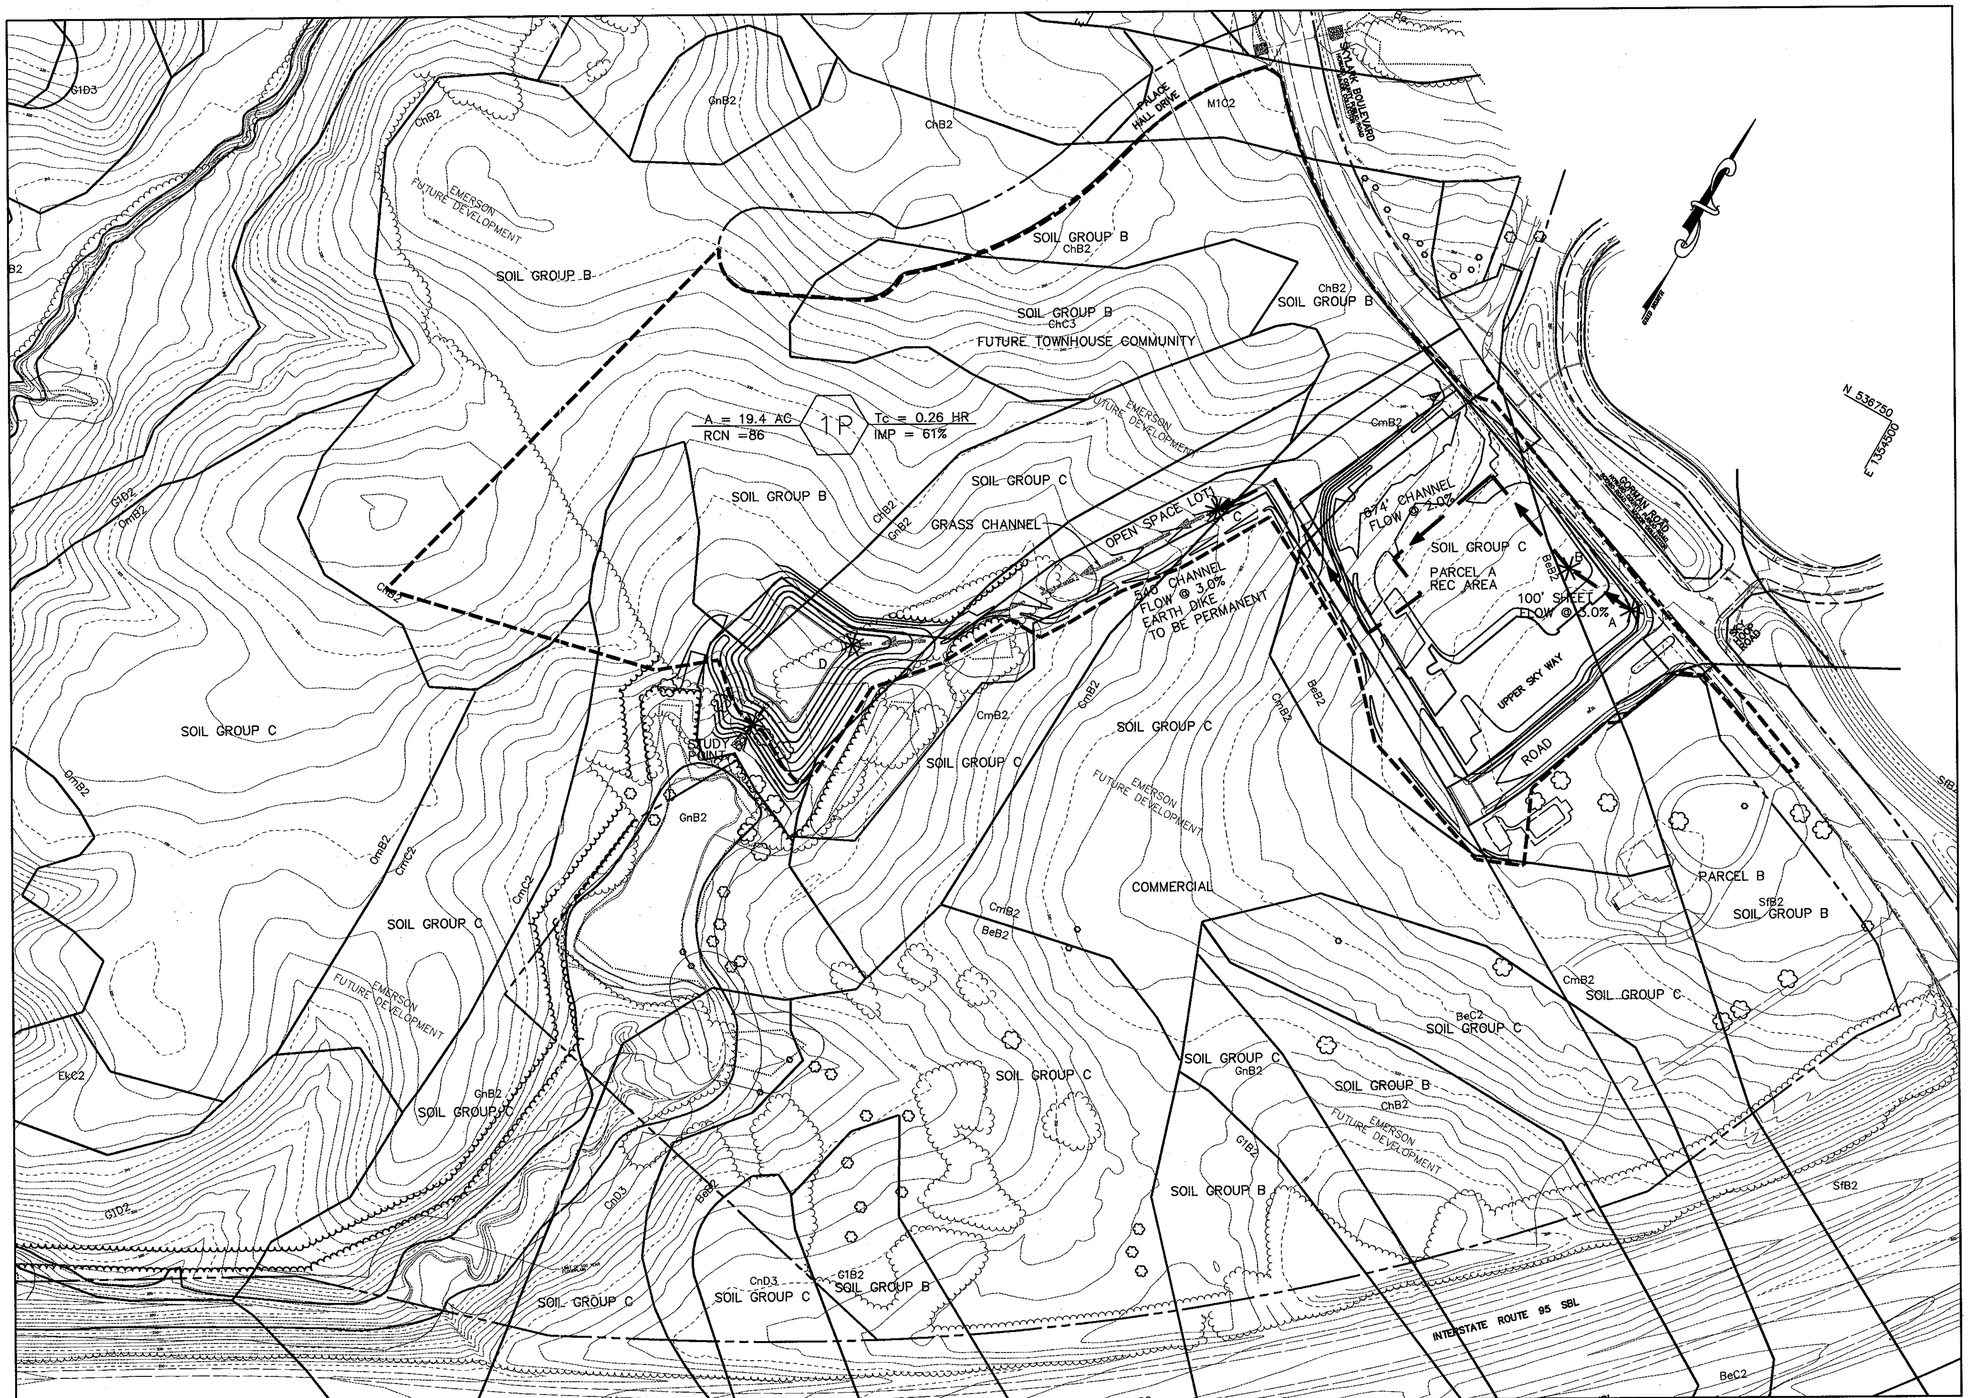

BY THE DEVELOPER :

I/WE CERTIFY THAT ALL DEVELOPMENT AND/OR CONSTRUCTION WILL BE DONE ACCORDING TO THESE PLANS, AND THAT ANY RESPONSIBLE PERSONNEL INVOLVED IN THE CONSTRUCTION PROJECT WILL HAVE A CERTIFICATE OF ATTENDANCE AT A DEPARTMENT OF THE ENVIRONMENT APPROVED TRAINING PROGRAM FOR THE CONTROL OF SEDIMENT AND EROSION BEFORE BEGINNING THE PROJECT. I SHALL ENGAGE A REGISTERED PROFESSIONAL ENGINEER TO SUPERVISE POND CONSTRUCTION AND PROVIDE THE HOWARD SOIL CONSERVATION DISTRICT WITH AN "AS-BUILT" PLAN OF THE POND WITHIN 30 DAYS OF COMPLETION. I ALSO AUTHORIZE PERIODIC ON-SITE INSPECTIONS BY THE HOWARD SOIL CONSERVATION DISTRICT.

DEVELOPER — DATE 10.18.02

Paul Cavanaugh

BY THE ENGINEER :

I CERTIFY THAT THIS PLAN FOR POND CONSTRUCTION, EROSION AND SEDIMENT CONTROL REPRESENTS A PRACTICAL AND WORKABLE PLAN BASED ON MY PERSONAL KNOWLEDGE OF THE SITE CONDITIONS. THIS PLAN WAS PREPARED IN ACCORDANCE WITH THE REQUIREMENTS OF THE HOWARD SOIL CONSERVATION DISTRICT. I HAVE NOTIFIED THE DEVELOPER THAT HE/SHE MUST ENGAGE A REGISTERED PROFESSIONAL ENGINEER TO SUPERVISE POND CONSTRUCTION AND PROVIDE THE HOWARD SOIL CONSERVATION DISTRICT WITH AN "AS-BUILT" PLAN OF THE POND WITHIN 30 DAYS OF COMPLETION.

ENGINEER — DATE 10.18.02

THESE PLANS HAVE BEEN REVIEWED FOR THE HOWARD SOIL CONSERVATION DISTRICT AND MEET THE TECHNICAL REQUIREMENTS FOR SMALL POND CONSTRUCTION, SOIL EROSION AND SEDIMENT CONTROL.

NATURAL RESOURCES CONSERVATION SERVICE — DATE 10/30/02

THESE PLANS FOR SMALL POND CONSTRUCTION, SOIL EROSION AND SEDIMENT CONTROL MEET THE REQUIREMENTS OF THE HOWARD SOIL CONSERVATION DISTRICT.

HOWARD SOIL CONSERVATION DISTRICT — DATE 10/30/02

APPROVED : HOWARD COUNTY DEPARTMENT OF PUBLIC WORKS.

CHIEF, BUREAU OF HIGHWAYS — DATE 11-8-02

APPROVED : HOWARD COUNTY DEPARTMENT OF PLANNING AND ZONING.

CHIEF, DIVISION OF LAND DEVELOPMENT — DATE 11/21/02

CHIEF, DEVELOPMENT ENGINEERING DIVISION — DATE 11/14/02

DATE	NO.	REVISION

OWNER/DEVELOPER

THE HOWARD RESEARCH AND DEVELOPMENT CORPORATION
THE ROUSE BUILDING
10275 LITTLE PATUXENT PARKWAY
COLUMBIA, MARYLAND 21044
410-992-6000

PROJECT
EMERSON
SECTION THREE AREA TWO

AREA — TAX MAP 47 — BLOCK 8 & 9
ZONED: PEC-MXD-3 — PART OF PARCELS: 462 & 837
6th ELECTION DISTRICT — HOWARD COUNTY, MARYLAND

TITLE
PROPOSED CONDITIONS SWM DRAINAGE AREA MAP

Patton Harris Rust & Associates, pc
Engineers. Surveyors. Planners. Landscape Architects.
8818 Centre Park Drive
Columbia, MD 21045
T 410.997.8900
F 410.997.9282

10-18-02
DATE

STATE OF MARYLAND — CHRISTOPHER J. REID — No. 19949 — REGISTERED PROFESSIONAL ENGINEER

CHRISTOPHER J. REID #19949

DESIGNED BY :	A.C.R
DRAWN BY :	DAM
CHECKED BY :	C.J.R.
PERMIT TRACKING NUMBER	01-NT-0222/200164079
DATE :	OCTOBER 21, 2002
SCALE :	1" = 100'
DRAWING NO.	11 OF 12

F-02-178

C-410PDA.DWG

z:\project\224561-01\Engr\Plans\FINALS\C-410PDA.dwg, CP410PDA, 10/17/02 03:01:44 PM, HP750C(36).pc3, Arch D - 24 x 36 in. (landscape), 1:1

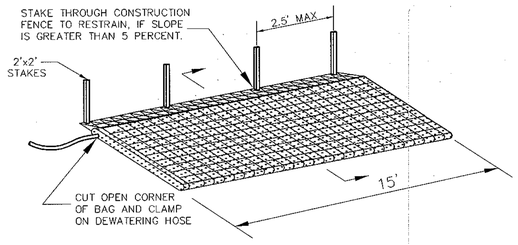

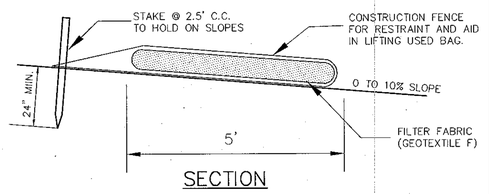

SECTION

NOTES:

1. FILTER BAG SHALL BE PLACED ON A SLOPING OR LEVEL WELL GRADED VEGETATED SITE SUCH THAT WATER WILL FLOW AWAY FROM DEVICE AND ANY WORK AREA.
2. WIDTH AND LENGTH SHALL BE AS SHOWN.
3. THE FILTER BAG MUST BE STAKED IN PLACE AND SECURED TO THE PUMP DISCHARGE LINE.
4. FILTER BAG SHALL NOT BE USED FOR DISCHARGE FLOWS GREATER THAN 300 GPM.
5. DEVICE SHALL BE REMOVED AND DISPOSED OF AFTER BAG IS FILLED WITH SEDIMENT. SEDIMENT FROM BAG SHALL BE SPREAD IN AN UPLAND AREA.
6. FILTER FABRIC SHALL MEET THE FOLLOWING REQUIREMENTS FOR GEOTEXTILE CLASS F;

TENSILE STRENGTH	50 LBS/IN (MIN.)	TEST: MSMT 509
TENSILE MODULUS	20 LBS/IN (MIN.)	TEST: MSMT 509
FLOW RATE	0.3 GAL/FT^2/MINUTE (MAX.)	TEST: MSMT 322
FILTER EFFICIENCY	75% (MIN.)	TEST: MSMT 322

FILTER BAG

TEMPORARY EROSION CONTROL MEASURE (FB)

DRAWN BY: K.C.B.
CHECKED BY:
SCALE: NONE
FB

DETAIL 18 – SEDIMENT BASIN BAFFLES

PLAN VIEWS

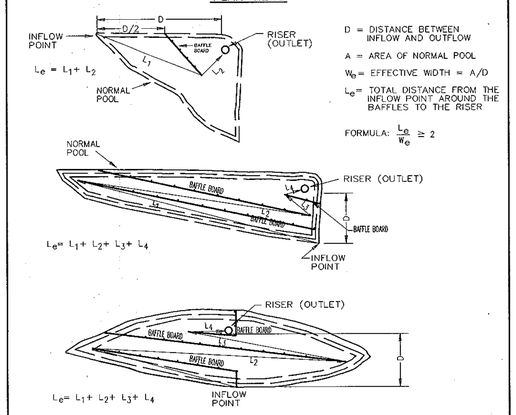

D = DISTANCE BETWEEN INFLOW AND OUTFLOW

A = AREA OF NORMAL POOL

W_e = EFFECTIVE WIDTH = A/D

L_e = TOTAL DISTANCE FROM THE INFLOW POINT AROUND THE BAFFLES TO THE RISER

FORMULA: $\frac{L_e}{W_e} \geq 2$

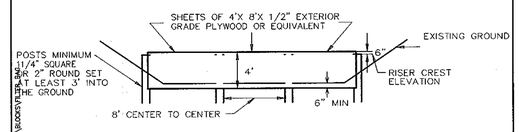

BAFFLE DETAIL

C:\PROJECT\WORK\DETAILS\

U.S. DEPARTMENT OF AGRICULTURE SOIL CONSERVATION SERVICE	PAGE C – 19 – 28	MARYLAND DEPARTMENT OF ENVIRONMENT WATER MANAGEMENT ADMINISTRATION

DETAIL 20A – REMOVABLE PUMPING STATION

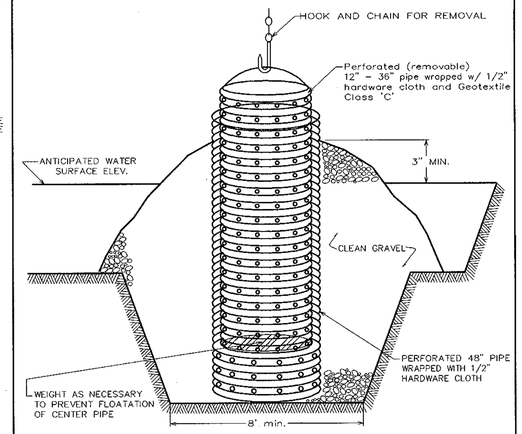

ELEVATION

Construction Specifications

1. The outer pipe should be 48" dia. or shall, in any case, be at least 4" greater in diameter than the center pipe. The outer pipe shall be wrapped with 1/2" hardware cloth to prevent backfill material from entering the perforations.
2. After installing the outer pipe, backfill around outer pipe with 2" aggregate or clean gravel.
3. The inside stand pipe (center pipe) should be constructed by perforating a corrugated or PVC pipe between 12" and 36" in. diameter. The perforations shall be 1/2" X 6" slits or 1" diameter holes 6" on center. The center pipe shall be wrapped with 1/2" hardware cloth first, then wrapped again with Geotextile Class C.
4. The center pipe should extend 12" to 18" above the anticipated water surface elevation or riser crest elevation when dewatering a basin.

U.S. DEPARTMENT OF AGRICULTURE SOIL CONSERVATION SERVICE	PAGE D – 12 – 4	MARYLAND DEPARTMENT OF ENVIRONMENT WATER MANAGEMENT ADMINISTRATION

BEST MANAGEMENT PRACTICES FOR WORKING IN NONTIDAL WETLANDS, WETLAND BUFFERS, WATERWAYS, AND 100-YEAR FLOODPLAINS

1) NO EXCESS FILL, CONSTRUCTION MATERIAL, OR DEBRIS SHALL E STOCKPILED OR STORED IN NONTIDAL WETLANDS, NONTIDAL WETLAND BUFFERS, WATERWAYS, OR THE 100-YEAR FLOODPLAIN.

2) PLACE MATERIALS IN A LOCATION AND MANNER THAT DOES NOT ADVERSELY IMPACT SURFACE OR SUBSURFACE WATER FLOW INTO OR OUT OF NONTIDAL WETLANDS, NONTIDAL WETLAND BUFFERS, WATERWAYS, OR THE 100-YEAR FLOODPLAIN.

3) DO NOT USE THE EXCAVATED MATERIAL AS BACKFILL IF IT CONTAINS WASTE METAL PRODUCTS, UNSIGHTLY DEBRIS, TOXIC MATERIAL, OR ANY OTHER DELETERIOUS SUBSTANCE. IF ADDITIONAL BACKFILL IS REQUIRED, USE CLEAN MATERIAL FREE OF WASTE METAL PRODUCTS, UNSIGHTLY DEBRIS, TOXIC MATERIAL, OR ANY OTHER DELETERIOUS SUBSTANCE.

4) PLACE HEAVY EQUIPMENT ON MATS OR SUITABLY OPERATE THE EQUIPMENT TO PREVENT DAMAGE TO NONTIDAL WETLANDS, NONTIDAL WETLAND BUFFERS, WATERWAYS, OR THE 100-YEAR FLOODPLAIN.

5) REPAIR AND MAINTAIN ANY SERVICEABLE STRUCTURE OR FILL SO THERE IS NO PERMANENT LOSS OF NONTIDAL WETLANDS, NONTIDAL WETLAND BUFFERS, OR WATERWAYS, OR PERMANENT MODIFICATION OF THE 100-YEAR FLOODPLAIN IN EXCESS OF THAT LOST UNDER THE ORIGINALLY AUTHORIZED STRUCTURE OR FILL.

6) RECTIFY ANY NONTIDAL WETLANDS, WETLAND BUFFERS, WATERWAYS, OR 100-YEAR FLOODPLAIN TEMPORARILY IMPACTED BY ANY CONSTRUCTION.

7) ALL STABILIZATION IN THE NONTIDAL WETLAND AND NONTIDAL WETLAND BUFFER SHALL CONSIST OF THE FOLLOWING SPECIES: ANNUAL RYEGRASS (LOLIUM MULTIFLORUM), MILLET (SETARIA ITALICA), BARLEY (HORDEUM SP.), OATS (UNIOLA SP.), AND/OR RYE (SECALE CEREALE). THESE SPECIES WILL ALLOW FOR THE STABILIZATION OF THE SITE WHILE ALSO ALLOWING FOR THE VOLUNTARY REVEGETATION OF NATURAL WETLAND SPECIES. OTHER NON-PERSISTENT VEGETATION MAY BE ACCEPTABLE, BUT MUST BE APPROVED BY THE NONTIDAL WETLANDS AND WATERWAYS DIVISION. KENTUCKY 31 FESCUE SHALL NOT BE UTILIZED IN WETLAND OR BUFFER AREAS. THE AREA SHOULD E SEEDED AND MULCHED TO REDUCE EROSION AFTER CONSTRUCTION ACTIVITIES HAVE BEEN COMPLETED.

8) AFTER INSTALLATION HAS BEEN COMPLETED, MAKE POST-CONSTRUCTION GRADES AND ELEVATIONS THE SAME AS THE ORIGINAL GRADES AND ELEVATIONS IN TEMPORARILY IMPACTED AREAS.

9) TO PROTECT AQUATIC SPECIES, IN-STREAM WORK IS PROHIBITED AS DETERMINED BY THE CLASSIFICATION OF THE STREAM:

USE I WATERS: IN-STREAM WORK SHALL NOT BE CONDUCTED DURING THE PERIOD MARCH 1 THROUGH JUNE 15, INCLUSIVE, DURING ANY YEAR.

10) STORMWATER RUNOFF FROM IMPERVIOUS SURFACES SHALL BE CONTROLLED TO PREVENT THE WASHING OF DEBRIS INTO THE WATERWAY.

11) CULVERTS SHALL BE CONSTRUCTED AND ANY RIPRAP PLACED SO AS NOT TO OBSTRUCT THE MOVEMENT OF AQUATIC SPECIES, UNLESS THE PURPOSE OF THE ACTIVITY IS TO IMPOUND WATER.

BY THE DEVELOPER :
I/WE CERTIFY THAT ALL DEVELOPMENT AND/OR CONSTRUCTION WILL BE DONE ACCORDING TO THESE PLANS, AND THAT ANY RESPONSIBLE PERSONNEL INVOLVED IN THE CONSTRUCTION PROJECT WILL HAVE A CERTIFICATE OF ATTENDANCE AT A DEPARTMENT OF THE ENVIRONMENT APPROVED TRAINING PROGRAM FOR THE CONTROL OF SEDIMENT AND EROSION BEFORE BEGINNING THE PROJECT. I SHALL ENGAGE A REGISTERED PROFESSIONAL ENGINEER TO SUPERVISE POND CONSTRUCTION AND PROVIDE THE HOWARD SOIL CONSERVATION DISTRICT WITH AN "AS-BUILT" PLAN OF THE POND WITHIN 30 DAYS OF COMPLETION. I ALSO AUTHORIZE PERIODIC ON-SITE INSPECTIONS BY THE HOWARD SOIL CONSERVATION DISTRICT.

DEVELOPER — DATE 10.18.02
Paul Cavanaugh

BY THE ENGINEER :
I CERTIFY THAT THIS PLAN FOR POND CONSTRUCTION, EROSION AND SEDIMENT CONTROL REPRESENTS A PRACTICAL AND WORKABLE PLAN BASED ON MY PERSONAL KNOWLEDGE OF THE SITE CONDITIONS. THIS PLAN WAS PREPARED IN ACCORDANCE WITH THE REQUIREMENTS OF THE HOWARD SOIL CONSERVATION DISTRICT. I HAVE NOTIFIED THE DEVELOPER THAT HE/SHE MUST ENGAGE A REGISTERED PROFESSIONAL ENGINEER TO SUPERVISE POND CONSTRUCTION AND PROVIDE THE HOWARD SOIL CONSERVATION DISTRICT WITH AN "AS-BUILT" PLAN OF THE POND WITHIN 30 DAYS OF COMPLETION.

ENGINEER — DATE 10.18.02

THESE PLANS HAVE BEEN REVIEWED FOR THE HOWARD SOIL CONSERVATION DISTRICT AND MEET THE TECHNICAL REQUIREMENTS FOR SMALL POND CONSTRUCTION, SOIL EROSION AND SEDIMENT CONTROL.

NATURAL RESOURCES CONSERVATION SERVICE — DATE 10/30/02

THESE PLANS FOR SMALL POND CONSTRUCTION, SOIL EROSION AND SEDIMENT CONTROL MEET THE REQUIREMENTS OF THE HOWARD SOIL CONSERVATION DISTRICT.

HOWARD SOIL CONSERVATION DISTRICT — DATE 10/30/02

APPROVED : HOWARD COUNTY DEPARTMENT OF PUBLIC WORKS.

CHIEF, BUREAU OF HIGHWAYS — DATE 11-8-02

APPROVED : HOWARD COUNTY DEPARTMENT OF PLANNING AND ZONING.

CHIEF, DIVISION OF LAND DEVELOPMENT — DATE 11/21/02

CHIEF, DEVELOPMENT ENGINEERING DIVISION — DATE 11/14/02

DATE	NO.	REVISION

OWNER/DEVELOPER
THE HOWARD RESEARCH AND DEVELOPMENT CORPORATION
THE ROUSE BUILDING
10275 LITTLE PATUXENT PARKWAY
COLUMBIA, MARYLAND 21044
410-992-6000

PROJECT
EMERSON
SECTION THREE AREA TWO

AREA
TAX MAP 47 BLOCK 8 & 9
ZONED: PEC-MXD-3 PART OF PARCELS: 462 & 837
6th ELECTION DISTRICT HOWARD COUNTY, MARYLAND

TITLE
SEDIMENT CONTROL DETAILS

Patton Harris Rust & Associates, pc
Engineers. Surveyors. Planners. Landscape Architects.
8818 Centre Park Drive
Columbia, MD 21045
T 410.997.8900
F 410.997.9282

10.18.02
DATE

STATE OF MARYLAND — CHRISTOPHER J. REID — No. 19949 — PROFESSIONAL ENGINEER

CHRISTOPHER J. REID #19949

DESIGNED BY :	A.C.R
DRAWN BY :	DAM
CHECKED BY :	C.J.R.
PERMIT TRACKING NUMBER	01-NT-0222/200164079
DATE :	OCTOBER 21, 2002
SCALE :	AS SHOWN
DRAWING NO.	12 OF 12

F-02-178 C-DETAILS5.DWG

J:\project\2245611-0\Engr\Plans\FINALS\C-DETAILS5.dwg, Layout1, 10/17/02 03:09:17 PM, HP750C(35).pc3, Arch D -24 x 36 in. (landscape), 1:1

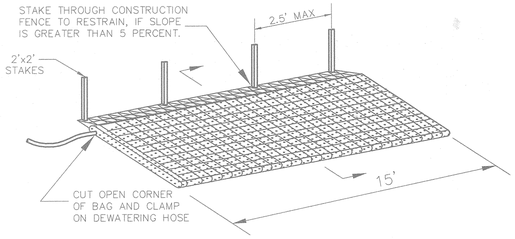

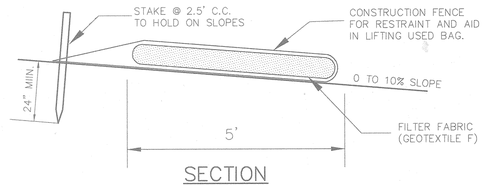

SECTION

NOTES:

1. FILTER BAG SHALL BE PLACED ON A SLOPING OR LEVEL WELL GRADED VEGETATED SITE SUCH THAT WATER WILL FLOW AWAY FROM DEVICE AND ANY WORK AREA.
2. WIDTH AND LENGTH SHALL BE AS SHOWN.
3. THE FILTER BAG MUST BE STAKED IN PLACE AND SECURED TO THE PUMP DISCHARGE LINE.
4. FILTER BAG SHALL NOT BE USED FOR DISCHARGE FLOWS GREATER THAN 300 GPM.
5. DEVICE SHALL BE REMOVED AND DISPOSED OF AFTER BAG IS FILLED WITH SEDIMENT. SEDIMENT FROM BAG SHALL BE SPREAD IN AN UPLAND AREA.
6. FILTER FABRIC SHALL MEET THE FOLLOWING REQUIREMENTS FOR GEOTEXTILE CLASS F;

TENSILE STRENGTH	50 LBS/IN (MIN.)	TEST: MSMT 509
TENSILE MODULUS	20 LBS/IN (MIN.)	TEST: MSMT 509
FLOW RATE	0.3 GAL/FT²/MINUTE (MAX.)	TEST: MSMT 322
FILTER EFFICIENCY	70% (MIN.)	TEST: MSMT 322

FILTER BAG

TEMPORARY EROSION CONTROL MEASURE (FB)

DRAWN BY: K.C.B.
CHECKED BY:
SCALE: NONE
FB

DETAIL 18 – SEDIMENT BASIN BAFFLES

PLAN VIEWS

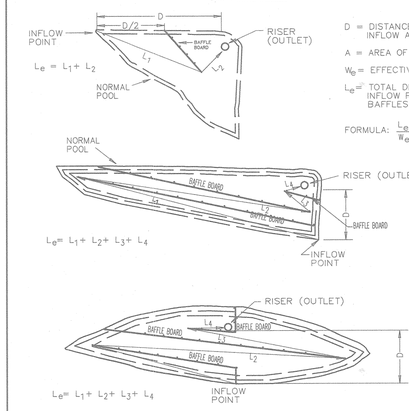

D = DISTANCE BETWEEN INFLOW AND OUTFLOW

A = AREA OF NORMAL POOL

W_e = EFFECTIVE WIDTH = A/D

L_e = TOTAL DISTANCE FROM THE INFLOW POINT AROUND THE BAFFLES TO THE RISER

FORMULA: $\frac{L_e}{W_e} \geq 2$

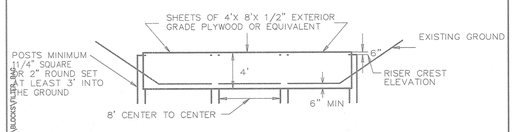

BAFFLE DETAIL

F:\PROJECT\MDOT\BLDGS\FILTER.DWG

U.S. DEPARTMENT OF AGRICULTURE SOIL CONSERVATION SERVICE	PAGE C – 10 – 28	MARYLAND DEPARTMENT OF ENVIRONMENT WATER MANAGEMENT ADMINISTRATION

DETAIL 20A – REMOVABLE PUMPING STATION

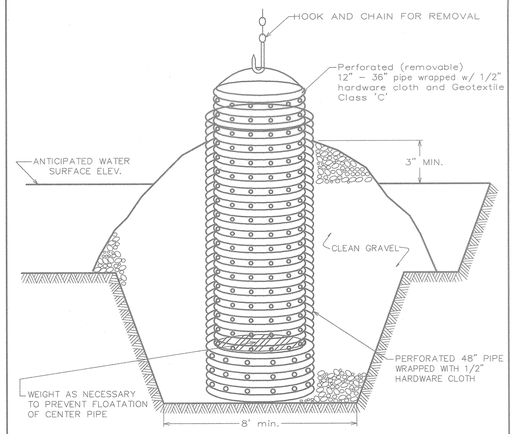

ELEVATION

Construction Specifications

1. The outer pipe should be 48" dia. or shall, in any case, be at least 4" greater in diameter than the center pipe. The outer pipe shall be wrapped with 1/2" hardware cloth to prevent backfill material from entering the perforations.

2. After installing the outer pipe, backfill around outer pipe with 2" aggregate or clean gravel.

3. The inside stand pipe (center pipe) should be constructed by perforating a corrugated or PVC pipe between 12" and 36" in diameter. The perforations shall be 1/2" X 6" slits or 1" diameter holes 6" on center. The center pipe shall be wrapped with 1/2" hardware cloth first, then wrapped again with Geotextile Class C.

4. The center pipe should extend 12" to 18" above the anticipated water surface elevation or riser crest elevation when dewatering a basin.

U.S. DEPARTMENT OF AGRICULTURE SOIL CONSERVATION SERVICE	PAGE D – 12 – 4	MARYLAND DEPARTMENT OF ENVIRONMENT WATER MANAGEMENT ADMINISTRATION

BEST MANAGEMENT PRACTICES FOR WORKING IN NONTIDAL WETLANDS, WETLAND BUFFERS, WATERWAYS, AND 100-YEAR FLOODPLAINS

1) NO EXCESS FILL, CONSTRUCTION MATERIAL, OR DEBRIS SHALL E STOCKPILED OR STORED IN NONTIDAL WETLANDS, NONTIDAL WETLAND BUFFERS, WATERWAYS, OR THE 100-YEAR FLOODPLAIN.

2) PLACE MATERIALS IN A LOCATION AND MANNER THAT DOES NOT ADVERSELY IMPACT SURFACE OR SUBSURFACE WATER FLOW INTO OR OUT OF NONTIDAL WETLANDS, NONTIDAL WETLAND BUFFERS, WATERWAYS, OR THE 100-YEAR FLOODPLAIN.

3) DO NOT USE THE EXCAVATED MATERIAL AS BACKFILL IF IT CONTAINS WASTE METAL PRODUCTS, UNSIGHTLY DEBRIS, TOXIC MATERIAL, OR ANY OTHER DELETERIOUS SUBSTANCE. IF ADDITIONAL BACKFILL IS REQUIRED, USE CLEAN MATERIAL FREE OF WASTE METAL PRODUCTS, UNSIGHTLY DEBRIS, TOXIC MATERIAL, OR ANY OTHER DELETERIOUS SUBSTANCE.

4) PLACE HEAVY EQUIPMENT ON MATS OR SUITABLY OPERATE THE EQUIPMENT TO PREVENT DAMAGE TO NONTIDAL WETLANDS, NONTIDAL WETLAND BUFFERS, WATERWAYS, OR THE 100-YEAR FLOODPLAIN.

5) REPAIR AND MAINTAIN ANY SERVICEABLE STRUCTURE OR FILL SO THERE IS NO PERMANENT LOSS OF NONTIDAL WETLANDS, NONTIDAL WETLAND BUFFERS, OR WATERWAYS, OR PERMANENT MODIFICATION OF THE 100-YEAR FLOODPLAIN IN EXCESS OF THAT LOST UNDER THE ORIGINALLY AUTHORIZED STRUCTURE OR FILL.

6) RECTIFY ANY NONTIDAL WETLANDS, WETLAND BUFFERS, WATERWAYS, OR 100-YEAR FLOODPLAIN TEMPORARILY IMPACTED BY ANY CONSTRUCTION.

7) ALL STABILIZATION IN THE NONTIDAL WETLAND AND NONTIDAL WETLAND BUFFER SHALL CONSIST OF THE FOLLOWING SPECIES: ANNUAL RYEGRASS (LOLIUM MULTIFLORUM), MILLET (SETARIA ITALICA), BARLEY (HORDEUM SP.), OATS (UNIOLA SP.), AND/OR RYE (SECALE CEREALE). THESE SPECIES WILL ALLOW FOR THE STABILIZATION OF THE SITE WHILE ALSO ALLOWING FOR THE VOLUNTARY REVEGETATION OF NATURAL WETLAND SPECIES. OTHER NON-PERSISTENT VEGETATION MAY BE ACCEPTABLE, BUT MUST BE APPROVED BY THE NONTIDAL WETLANDS AND WATERWAYS DIVISION. KENTUCKY 31 FESCUE SHALL NOT BE UTILIZED IN WETLAND OR BUFFER AREAS. THE AREA SHOULD E SEEDED AND MULCHED TO REDUCE EROSION AFTER CONSTRUCTION ACTIVITIES HAVE BEEN COMPLETED.

8) AFTER INSTALLATION HAS BEEN COMPLETED, MAKE POST-CONSTRUCTION GRADES AND ELEVATIONS THE SAME AS THE ORIGINAL GRADES AND ELEVATIONS IN TEMPORARILY IMPACTED AREAS.

9) TO PROTECT AQUATIC SPECIES, IN-STREAM WORK IS PROHIBITED AS DETERMINED BY THE CLASSIFICATION OF THE STREAM:

USE I WATERS: IN-STREAM WORK SHALL NOT BE CONDUCTED DURING THE PERIOD MARCH 1 THROUGH JUNE 15, INCLUSIVE, DURING ANY YEAR.

10) STORMWATER RUNOFF FROM IMPERVIOUS SURFACES SHALL BE CONTROLLED TO PREVENT THE WASHING OF DEBRIS INTO THE WATERWAY.

11) CULVERTS SHALL BE CONSTRUCTED AND ANY RIPRAP PLACED SO AS NOT TO OBSTRUCT THE MOVEMENT OF AQUATIC SPECIES, UNLESS THE PURPOSE OF THE ACTIVITY IS TO IMPOUND WATER.

BY THE DEVELOPER :

I/WE CERTIFY THAT ALL DEVELOPMENT AND/OR CONSTRUCTION WILL BE DONE ACCORDING TO THESE PLANS, AND THAT ANY RESPONSIBLE PERSONNEL INVOLVED IN THE CONSTRUCTION PROJECT WILL HAVE A CERTIFICATE OF ATTENDANCE AT A DEPARTMENT OF THE ENVIRONMENT APPROVED TRAINING PROGRAM FOR THE CONTROL OF SEDIMENT AND EROSION BEFORE BEGINNING THE PROJECT. I SHALL ENGAGE A REGISTERED PROFESSIONAL ENGINEER TO SUPERVISE POND CONSTRUCTION AND PROVIDE THE HOWARD SOIL CONSERVATION DISTRICT WITH AN "AS-BUILT" PLAN OF THE POND WITHIN 30 DAYS OF COMPLETION. I ALSO AUTHORIZE PERIODIC ON-SITE INSPECTIONS BY THE HOWARD SOIL CONSERVATION DISTRICT.

DEVELOPER Paul Carmaugh — DATE 10.18.02

BY THE ENGINEER :

I CERTIFY THAT THIS PLAN FOR POND CONSTRUCTION, EROSION AND SEDIMENT CONTROL REPRESENTS A PRACTICAL AND WORKABLE PLAN BASED ON MY PERSONAL KNOWLEDGE OF THE SITE CONDITIONS. THIS PLAN WAS PREPARED IN ACCORDANCE WITH THE REQUIREMENTS OF THE HOWARD SOIL CONSERVATION DISTRICT. I HAVE NOTIFIED THE DEVELOPER THAT HE/SHE MUST ENGAGE A REGISTERED PROFESSIONAL ENGINEER TO SUPERVISE POND CONSTRUCTION AND PROVIDE THE HOWARD SOIL CONSERVATION DISTRICT WITH AN "AS-BUILT" PLAN OF THE POND WITHIN 30 DAYS OF COMPLETION.

ENGINEER — DATE 10.18.02

THESE PLANS HAVE BEEN REVIEWED FOR THE HOWARD SOIL CONSERVATION DISTRICT AND MEET THE TECHNICAL REQUIREMENTS FOR SMALL POND CONSTRUCTION, SOIL EROSION AND SEDIMENT CONTROL.

NATURAL RESOURCES CONSERVATION SERVICE — DATE 10/30/02

THESE PLANS FOR SMALL POND CONSTRUCTION, SOIL EROSION AND SEDIMENT CONTROL MEET THE REQUIREMENTS OF THE HOWARD SOIL CONSERVATION DISTRICT.

HOWARD SOIL CONSERVATION DISTRICT — DATE 10/30/02

APPROVED : HOWARD COUNTY DEPARTMENT OF PUBLIC WORKS.

CHIEF, BUREAU OF HIGHWAYS — DATE 11-8-02

APPROVED : HOWARD COUNTY DEPARTMENT OF PLANNING AND ZONING.

CHIEF, DIVISION OF LAND DEVELOPMENT — DATE 11/20/02

CHIEF, DEVELOPMENT ENGINEERING DIVISION — DATE 12/14/02

DATE	NO.	REVISION

OWNER/DEVELOPER

THE HOWARD RESEARCH AND DEVELOPMENT CORPORATION
THE ROUSE BUILDING
10275 LITTLE PATUXENT PARKWAY
COLUMBIA, MARYLAND 21044
410-992-6000

PROJECT

EMERSON

SECTION THREE AREA TWO

AREA TAX MAP 47 BLOCK 8 & 9
ZONED: PEC-MXD-3 PART OF PARCELS: 462 & 837
6th ELECTION DISTRICT HOWARD COUNTY, MARYLAND

TITLE

SEDIMENT CONTROL DETAILS

Patton Harris Rust & Associates, pc
Engineers. Surveyors. Planners. Landscape Architects.
8818 Centre Park Drive
Columbia, MD 21045
T 410.997.8900
F 410.997.9282

10.18.02
DATE

STATE OF MARYLAND — CHRISTOPHER J. REID — No. 19949 — PROFESSIONAL ENGINEER

CHRISTOPHER J. REID #19949

DESIGNED BY : A.C.R
DRAWN BY : DAM
CHECKED BY : C.J.R.
PERMIT TRACKING NUMBER 01-NT-0222/200164079
DATE : OCTOBER 21, 2002
SCALE : AS SHOWN
DRAWING NO. 12 OF 12

F-02-178 C-DETAILS5.DWG

>:\project\224561-0\Engr\Plans\FINALS\C-DETAILS5.dwg, Layout1, 10/17/02 03:09:17 PM, HP750C(36).pc3, Arch D - 24 x 36 In. (landscape), 1:1

BY THE DEVELOPER :

I/WE CERTIFY THAT ALL DEVELOPMENT AND/OR CONSTRUCTION WILL BE DONE ACCORDING TO THESE PLANS, AND THAT ANY RESPONSIBLE PERSONNEL INVOLVED IN THE CONSTRUCTION PROJECT WILL HAVE A CERTIFICATE OF ATTENDANCE AT A DEPARTMENT OF THE ENVIRONMENT APPROVED TRAINING PROGRAM FOR THE CONTROL OF SEDIMENT AND EROSION BEFORE BEGINNING THE PROJECT. I SHALL ENGAGE A REGISTERED PROFESSIONAL ENGINEER TO SUPERVISE POND CONSTRUCTION AND PROVIDE THE HOWARD SOIL CONSERVATION DISTRICT WITH AN "AS-BUILT" PLAN OF THE POND WITHIN 30 DAYS OF COMPLETION. I ALSO AUTHORIZE PERIODIC ON-SITE INSPECTIONS BY THE HOWARD SOIL CONSERVATION DISTRICT.

DEVELOPER Paul Cavanaugh — DATE 10.18.02

BY THE ENGINEER :

I CERTIFY THAT THIS PLAN FOR POND CONSTRUCTION, EROSION AND SEDIMENT CONTROL REPRESENTS A PRACTICAL AND WORKABLE PLAN BASED ON MY PERSONAL KNOWLEDGE OF THE SITE CONDITIONS. THIS PLAN WAS PREPARED IN ACCORDANCE WITH THE REQUIREMENTS OF THE HOWARD SOIL CONSERVATION DISTRICT. I HAVE NOTIFIED THE DEVELOPER THAT HE/SHE MUST ENGAGE A REGISTERED PROFESSIONAL ENGINEER TO SUPERVISE POND CONSTRUCTION AND PROVIDE THE HOWARD SOIL CONSERVATION DISTRICT WITH AN "AS-BUILT" PLAN OF THE POND WITHIN 30 DAYS OF COMPLETION.

ENGINEER — DATE 10.18.02

THESE PLANS HAVE BEEN REVIEWED FOR THE HOWARD SOIL CONSERVATION DISTRICT AND MEET THE TECHNICAL REQUIREMENTS FOR SMALL POND CONSTRUCTION, SOIL EROSION AND SEDIMENT CONTROL.

NATURAL RESOURCES CONSERVATION SERVICE — DATE 10/30/02

THESE PLANS FOR SMALL POND CONSTRUCTION, SOIL EROSION AND SEDIMENT CONTROL MEET THE REQUIREMENTS OF THE HOWARD SOIL CONSERVATION DISTRICT.

HOWARD SOIL CONSERVATION DISTRICT — DATE 10/30/02

APPROVED : HOWARD COUNTY DEPARTMENT OF PUBLIC WORKS.

CHIEF, BUREAU OF HIGHWAYS — DATE 11-8-02

APPROVED : HOWARD COUNTY DEPARTMENT OF PLANNING AND ZONING.

CHIEF, DIVISION OF LAND DEVELOPMENT — DATE 11/20/02

CHIEF, DEVELOPMENT ENGINEERING DIVISION — DATE 11/14/02

DATE	NO.	REVISION

OWNER/DEVELOPER

THE HOWARD RESEARCH AND DEVELOPMENT CORPORATION
THE ROUSE BUILDING
10275 LITTLE PATUXENT PARKWAY
COLUMBIA, MARYLAND 21044
410-992-6000

PROJECT

EMERSON
SECTION THREE AREA TWO

AREA
TAX MAP 47 BLOCK 8 & 9
ZONED: PEC-MXD-3 PART OF PARCELS: 462 & 837
6th ELECTION DISTRICT HOWARD COUNTY, MARYLAND

TITLE

PROPOSED CONDITIONS SWM DRAINAGE AREA MAP

Patton Harris Rust & Associates, pc
Engineers. Surveyors. Planners. Landscape Architects.
8818 Centre Park Drive
Columbia, MD 21045
T 410.997.8900
F 410.997.9282

10.18.02
DATE

STATE OF MARYLAND — CHRISTOPHER J. REID — No. 19949 — PROFESSIONAL ENGINEER

CHRISTOPHER J. REID #19949

DESIGNED BY :	A.C.R
DRAWN BY :	DAM
CHECKED BY :	C.J.R.
PERMIT TRACKING NUMBER	01-NT-0222/200164079
DATE :	OCTOBER 21, 2002
SCALE :	1" = 100'
DRAWING NO.	11 OF 12

F-02-178

C-410PDA.DWG

P:\project\22456\1-DiEngr\Plans\FINALS\C-410PDA.dwg, CP410PDA, 10/17/02 03:01:44 PM, HP750C(36).pc3, Arch D 24 x 36 in. (landscape), 1:1

BY THE DEVELOPER :

I/WE CERTIFY THAT ALL DEVELOPMENT AND/OR CONSTRUCTION WILL BE DONE ACCORDING TO THESE PLANS, AND THAT ANY RESPONSIBLE PERSONNEL INVOLVED IN THE CONSTRUCTION PROJECT WILL HAVE A CERTIFICATE OF ATTENDANCE AT A DEPARTMENT OF THE ENVIRONMENT APPROVED TRAINING PROGRAM FOR THE CONTROL OF SEDIMENT AND EROSION BEFORE BEGINNING THE PROJECT. I SHALL ENGAGE A REGISTERED PROFESSIONAL ENGINEER TO SUPERVISE POND CONSTRUCTION AND PROVIDE THE HOWARD SOIL CONSERVATION DISTRICT WITH AN "AS-BUILT" PLAN OF THE POND WITHIN 30 DAYS OF COMPLETION. I ALSO AUTHORIZE PERIODIC ON-SITE INSPECTIONS BY THE HOWARD SOIL CONSERVATION DISTRICT.

DEVELOPER — DATE 10.18.02

Paul Cavanaugh

BY THE ENGINEER :

I CERTIFY THAT THIS PLAN FOR POND CONSTRUCTION, EROSION AND SEDIMENT CONTROL REPRESENTS A PRACTICAL AND WORKABLE PLAN BASED ON MY PERSONAL KNOWLEDGE OF THE SITE CONDITIONS. THIS PLAN WAS PREPARED IN ACCORDANCE WITH THE REQUIREMENTS OF THE HOWARD SOIL CONSERVATION DISTRICT. I HAVE NOTIFIED THE DEVELOPER THAT HE/SHE MUST ENGAGE A REGISTERED PROFESSIONAL ENGINEER TO SUPERVISE POND CONSTRUCTION AND PROVIDE THE HOWARD SOIL CONSERVATION DISTRICT WITH AN "AS-BUILT" PLAN OF THE POND WITHIN 30 DAYS OF COMPLETION.

ENGINEER — DATE 10.18.02

THESE PLANS HAVE BEEN REVIEWED FOR THE HOWARD SOIL CONSERVATION DISTRICT AND MEET THE TECHNICAL REQUIREMENTS FOR SMALL POND CONSTRUCTION, SOIL EROSION AND SEDIMENT CONTROL.

NATURAL RESOURCES CONSERVATION SERVICE — DATE

THESE PLANS FOR SMALL POND CONSTRUCTION, SOIL EROSION AND SEDIMENT CONTROL MEET THE REQUIREMENTS OF THE HOWARD SOIL CONSERVATION DISTRICT.

HOWARD SOIL CONSERVATION DISTRICT — DATE

APPROVED : HOWARD COUNTY DEPARTMENT OF PUBLIC WORKS.

CHIEF, BUREAU OF HIGHWAYS — DATE 11-8-02

APPROVED : HOWARD COUNTY DEPARTMENT OF PLANNING AND ZONING.

CHIEF, DIVISION OF LAND DEVELOPMENT — DATE 11/20/02

CHIEF, DEVELOPMENT ENGINEERING DIVISION — DATE 11/14/02

DATE	NO.	REVISION

OWNER/DEVELOPER

THE HOWARD RESEARCH AND DEVELOPMENT CORPORATION
THE ROUSE BUILDING
10275 LITTLE PATUXENT PARKWAY
COLUMBIA, MARYLAND 21044
410-992-6000

PROJECT

EMERSON
SECTION THREE AREA TWO

AREA

TAX MAP 47 — BLOCK 8 & 9
ZONED: PEC-MXD-3 — PART OF PARCELS: 462 & 837
6th ELECTION DISTRICT — HOWARD COUNTY, MARYLAND

TITLE

EXISTING CONDITIONS SWM DRAINAGE AREA MAP

Patton Harris Rust & Associates, pc
Engineers. Surveyors. Planners. Landscape Architects.
8818 Centre Park Drive
Columbia, MD 21045
T 410.997.8900
F 410.997.9282

10.18.02
DATE

STATE OF MARYLAND — CHRISTOPHER J. REID — No. 19949 — REGISTERED PROFESSIONAL ENGINEER

CHRISTOPHER J. REID #19949

DESIGNED BY :	A.C.R
DRAWN BY :	DAM
CHECKED BY :	C.J.R.
PERMIT TRACKING NUMBER	01-NT-0222/200164079
DATE :	OCTOBER 21, 2002
SCALE :	1" = 100'
DRAWING NO.	10 OF 12

F-02-178

C-410XDA.DWG

S:\project\224561-0\Engr\Plans\FINALS\C-410XDA.dwg, CP410XDA, 10/17/02 02:58:55 PM, HP750C(36).pc3, Arch D - 24 x 36 in. (landscape), 1:1

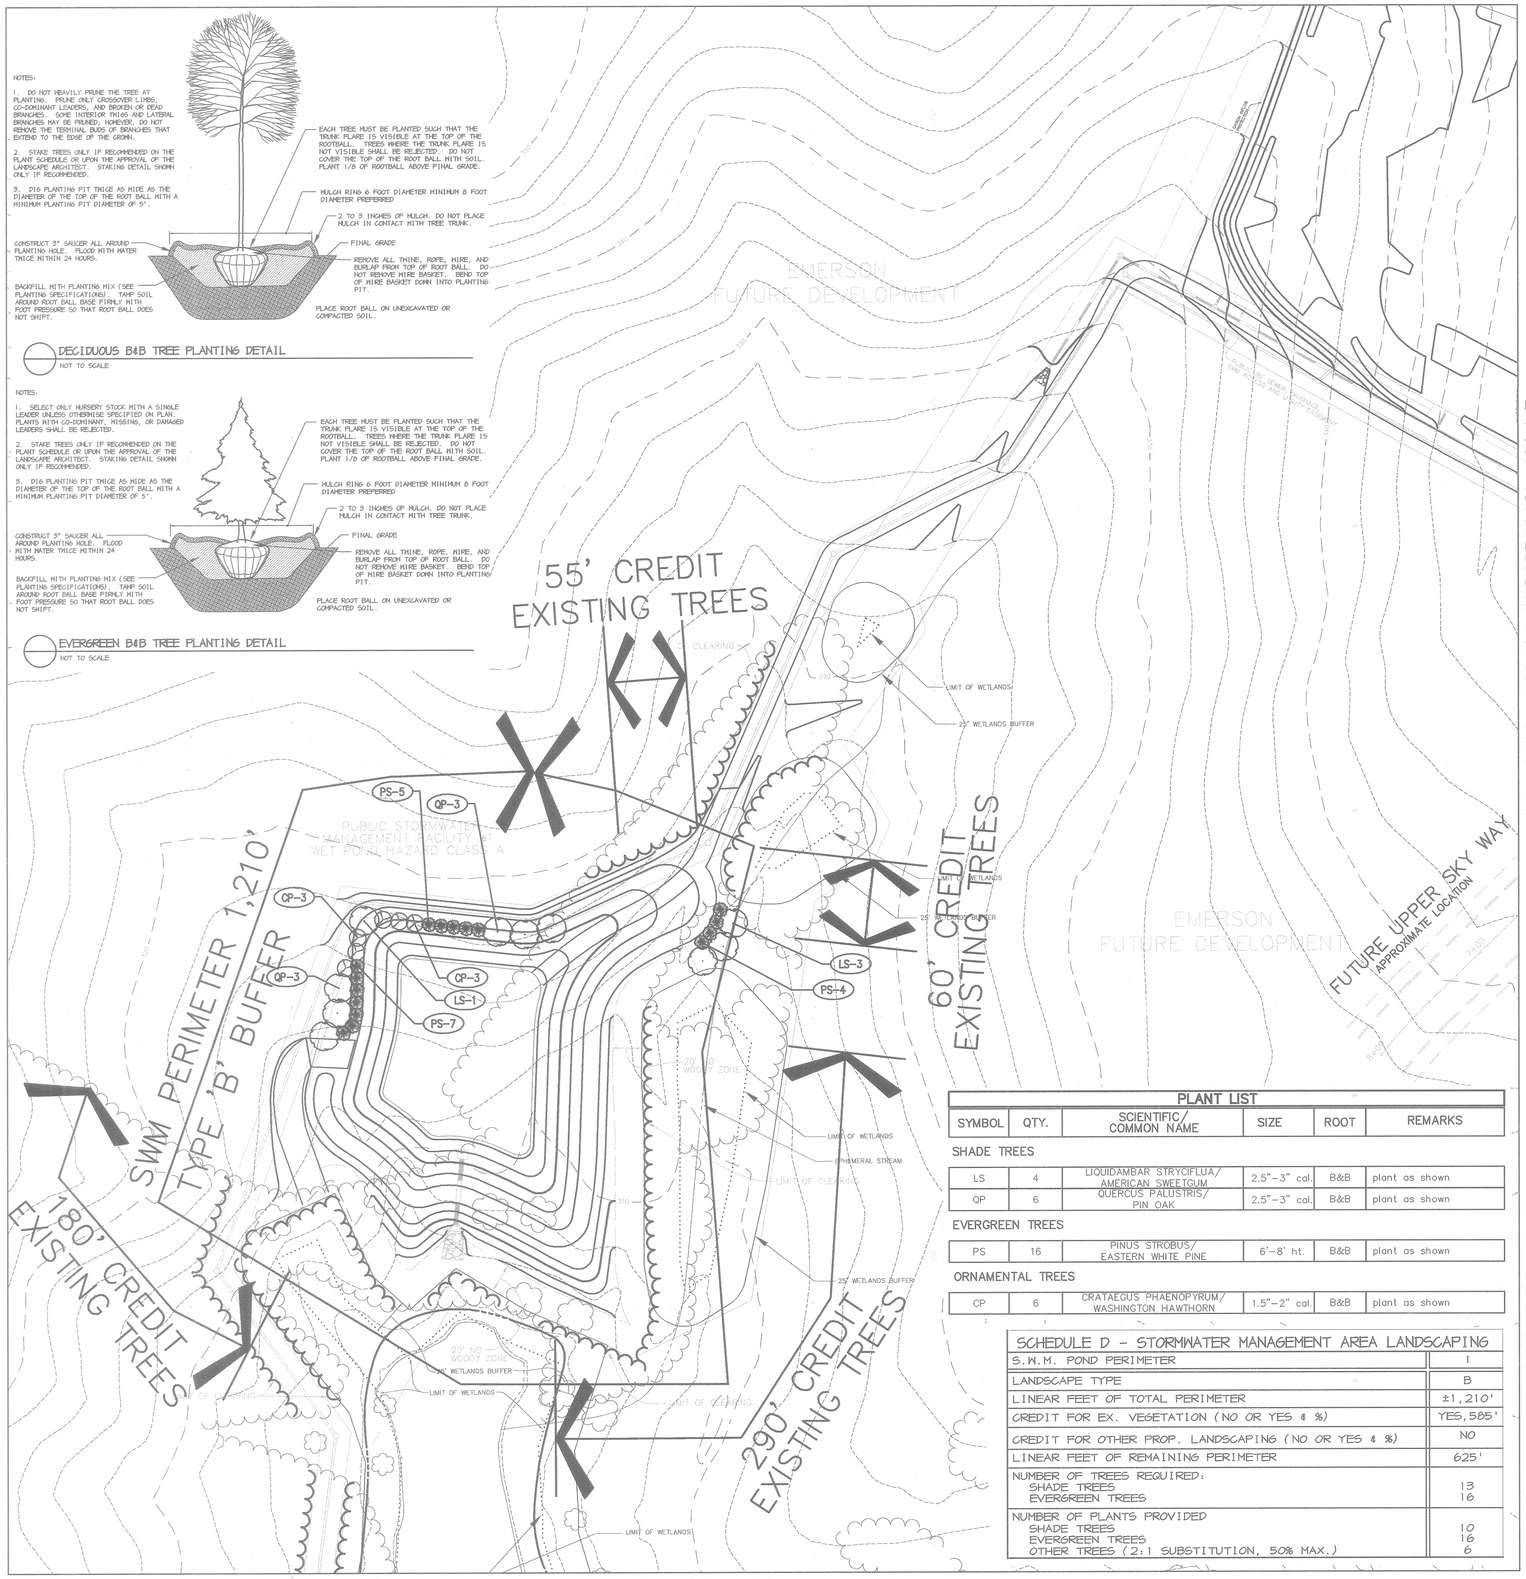

NOTES:

1. DO NOT HEAVILY PRUNE THE TREE AT PLANTING. PRUNE ONLY CROSSOVER LIMBS, CO-DOMINANT LEADERS, AND BROKEN OR DEAD BRANCHES. SOME INTERIOR TWIGS AND LATERAL BRANCHES MAY BE PRUNED; HOWEVER, DO NOT REMOVE THE TERMINAL BUDS OF BRANCHES THAT EXTEND TO THE EDGE OF THE CROWN.

2. STAKE TREES ONLY IF RECOMMENDED ON THE PLANT SCHEDULE OR UPON THE APPROVAL OF THE LANDSCAPE ARCHITECT. STAKING DETAIL SHOWN ONLY IF RECOMMENDED.

3. DIG PLANTING PIT TWICE AS WIDE AS THE DIAMETER OF THE TOP OF THE ROOT BALL WITH A MINIMUM PLANTING PIT DIAMETER OF 5'.

EACH TREE MUST BE PLANTED SUCH THAT THE TRUNK FLARE IS VISIBLE AT THE TOP OF THE ROOTBALL. TREES WHERE THE TRUNK FLARE IS NOT VISIBLE SHALL BE REJECTED. DO NOT COVER THE TOP OF THE ROOT BALL WITH SOIL. PLANT 1/8 OF ROOTBALL ABOVE FINAL GRADE.

MULCH RING 6 FOOT DIAMETER MINIMUM 8 FOOT DIAMETER PREFERRED

2 TO 3 INCHES OF MULCH. DO NOT PLACE MULCH IN CONTACT WITH TREE TRUNK.

FINAL GRADE

CONSTRUCT 3" SAUCER ALL AROUND PLANTING HOLE. FLOOD WITH WATER TWICE WITHIN 24 HOURS.

REMOVE ALL TWINE, ROPE, WIRE, AND BURLAP FROM TOP OF ROOT BALL. DO NOT REMOVE WIRE BASKET. BEND TOP OF WIRE BASKET DOWN INTO PLANTING PIT.

BACKFILL WITH PLANTING MIX (SEE PLANTING SPECIFICATIONS). TAMP SOIL AROUND ROOT BALL BASE FIRMLY WITH FOOT PRESSURE SO THAT ROOT BALL DOES NOT SHIFT.

PLACE ROOT BALL ON UNEXCAVATED OR COMPACTED SOIL.

DECIDUOUS B&B TREE PLANTING DETAIL

NOT TO SCALE

NOTES:

1. SELECT ONLY NURSERY STOCK WITH A SINGLE LEADER UNLESS OTHERWISE SPECIFIED ON PLAN. PLANTS WITH CO-DOMINANT, MISSING, OR DAMAGED LEADERS SHALL BE REJECTED.

2. STAKE TREES ONLY IF RECOMMENDED ON THE PLANT SCHEDULE OR UPON THE APPROVAL OF THE LANDSCAPE ARCHITECT. STAKING DETAIL SHOWN ONLY IF RECOMMENDED.

3. DIG PLANTING PIT TWICE AS WIDE AS THE DIAMETER OF THE TOP OF THE ROOT BALL WITH A MINIMUM PLANTING PIT DIAMETER OF 5'.

EACH TREE MUST BE PLANTED SUCH THAT THE TRUNK FLARE IS VISIBLE AT THE TOP OF THE ROOTBALL. TREES WHERE THE TRUNK FLARE IS NOT VISIBLE SHALL BE REJECTED. DO NOT COVER THE TOP OF THE ROOT BALL WITH SOIL. PLANT 1/8 OF ROOTBALL ABOVE FINAL GRADE.

MULCH RING 6 FOOT DIAMETER MINIMUM 8 FOOT DIAMETER PREFERRED

2 TO 3 INCHES OF MULCH. DO NOT PLACE MULCH IN CONTACT WITH TREE TRUNK.

FINAL GRADE

CONSTRUCT 3" SAUCER ALL AROUND PLANTING HOLE. FLOOD WITH WATER TWICE WITHIN 24 HOURS.

REMOVE ALL TWINE, ROPE, WIRE, AND BURLAP FROM TOP OF ROOT BALL. DO NOT REMOVE WIRE BASKET. BEND TOP OF WIRE BASKET DOWN INTO PLANTING PIT.

BACKFILL WITH PLANTING MIX (SEE PLANTING SPECIFICATIONS). TAMP SOIL AROUND ROOT BALL BASE FIRMLY WITH FOOT PRESSURE SO THAT ROOT BALL DOES NOT SHIFT.

PLACE ROOT BALL ON UNEXCAVATED OR COMPACTED SOIL.

EVERGREEN B&B TREE PLANTING DETAIL

NOT TO SCALE

PLANT LIST

SYMBOL	QTY.	SCIENTIFIC/ COMMON NAME	SIZE	ROOT	REMARKS
SHADE TREES					
LS	4	LIQUIDAMBAR STRYCIFLUA/ AMERICAN SWEETGUM	2.5"-3" cal.	B&B	plant as shown
QP	6	QUERCUS PALUSTRIS/ PIN OAK	2.5"-3" cal.	B&B	plant as shown
EVERGREEN TREES					
PS	16	PINUS STROBUS/ EASTERN WHITE PINE	6'-8' ht.	B&B	plant as shown
ORNAMENTAL TREES					
CP	6	CRATAEGUS PHAENOPYRUM/ WASHINGTON HAWTHORN	1.5"-2" cal.	B&B	plant as shown

SCHEDULE D - STORMWATER MANAGEMENT AREA LANDSCAPING

S.W.M. POND PERIMETER	1
LANDSCAPE TYPE	B
LINEAR FEET OF TOTAL PERIMETER	±1,210'
CREDIT FOR EX. VEGETATION (NO OR YES & %)	YES,585'
CREDIT FOR OTHER PROP. LANDSCAPING (NO OR YES & %)	NO
LINEAR FEET OF REMAINING PERIMETER	625'
NUMBER OF TREES REQUIRED: SHADE TREES EVERGREEN TREES	13 16
NUMBER OF PLANTS PROVIDED SHADE TREES EVERGREEN TREES OTHER TREES (2:1 SUBSTITUTION, 50% MAX.)	10 16 6

GENERAL NOTES:

1) THIS PLAN HAS BEEN PREPARED IN ACCORDANCE WITH THE PROVISIONS OF SECTION 16.124 OF THE HOWARD COUNTY CODE AND THE LANDSCAPE MANUAL.

2) FINANCIAL SURETY FOR THE REQUIRED LANDSCAPING MUST BE POSTED AS PART OF THE DEVELOPER'S AGREEMENT IN THE AMOUNT OF $6,300.00
10 SHADE TREES @ $300 = $3,000.00
6 ORNAMENTAL TREES @ $150 = $400.00
16 EVERGREEN TREES @ $150 = $2,400.00

3) THIS PLAN IS FOR LANDSCAPING PURPOSES ONLY.

4) CONTRACTOR IS SOLELY RESPONSIBLE FOR CONSTRUCTION MEANS, METHODS, TECHNIQUES, SEQUENCES, PROCEDURES, AND SAFETY PRECAUTIONS AND PROGRAMS.

5) ALL MATERIAL SELECTED SHALL BE EQUAL TO OR BETTER THAN THE REQUIREMENTS OF THE "USA STANDARD FOR NURSERY STOCK", LATEST EDITION, AS PUBLISHED BY THE AMERICAN ASSOCIATION OF NURSERYMEN.

6) ALL MATERIAL SHALL BE PLANTED IN ACCORDANCE WITH THE MINIMUM STANDARDS CITED IN THE LATEST EDITION OF "LANDSCAPE SPECIFICATION GUIDELINES" PUBLISHED BY THE LANDSCAPE CONTRACTORS ASSOCIATION.

7) AT THE TIME OF INSTALLMENT, ALL SHRUBS AND OTHER PLANTINGS SHALL BE OF THE PROPER HEIGHT AND/OR SPREAD REQUIREMENTS IN ACCORDANCE WITH THIS PLAN AND THE HOWARD COUNTY LANDSCAPE MANUAL.

8) NO SUBSTITUTIONS OR RELOCATION OF PLANTS MAY BE MADE WITHOUT PRIOR APPROVAL FROM THE DEPARTMENT OF PLANNING AND ZONING OF HOWARD COUNTY. ANY DEVIATION FROM THIS LANDSCAPE PLAN MAY RESULT IN A REQUIREMENT FOR SUBMITTAL OF AN OFFICIAL "REDLINE REVISION" TO THE SITE DEVELOPMENT PLAN(S) AND/OR DENIAL IN THE RELEASE OF LANDSCAPE SURETY.

9) LANDSCAPING FOR PARCELS A & B IS DEFERRED UNTIL SITE PLAN STAGE.

PLANTING SPECIFICATIONS

1. Plants, related material, and operations shall meet the detailed description, as given on the plans and as described herein. Where discrepancies exist between Standards & Guidelines referenced within these specifications and the Howard County Landscape Manual, the latter takes precedence.

2. All plant material, unless otherwise specified, that is not nursery grown, uniformly branched, does not have a vigorous root system, and does not conform to the most recent edition of the American Association of Nurserymen (AAN) Standards will be rejected. Plant material that is not healthy, vigorous, free from defects, decay, disfiguring roots, sunscald injuries, abrasions of the bark, plant disease, insect pest eggs, borers and all forms of insect infestations or objectionable disfigurements will be rejected. Plant material that is weak or which has been cut back from larger grades to meet specified requirements will be rejected. Trees with forked leaders will be rejected. All B & B plants shall be freshly dug; no healed-in plants or plants from cold storage will be accepted.

3. Unless otherwise specified, all general conditions, planting operations, details and planting specifications shall conform to the most recent edition of the "Landscape Specification Guidelines by the Landscape Contractors Association of MD, DC, & VA", (hereinafter "Landscape Guidelines") approved by the Landscape Contractors Association of Metropolitan Washington and the Potomac Chapter of the American Society of Landscape Architects.

4. Contractor shall guarantee all plant material for a period of one year after date of acceptance in accordance with the appropriate section on the Landscape Guidelines. Contractor's attention is directed to the maintenance requirements found within the one year specifications including watering and replacement of specified plant material.

5. Contractor shall be responsible for notifying all relevant and appropriate utility companies, utility contractors, and "Miss Utility" a minimum of 48 hours prior to the beginning of any work. Contractor may make minor adjustments in spacing and location of plant material to avoid conflicts with utilities. Major changes will require the approval of the landscape architect. Damage to existing structure and utilities shall be repaired at the expense of the Contractor.

6. Protection of existing vegetation to remain shall be accomplished via the temporary installation of 4 foot high snow fence at the drip line, see detail.

7. Contractor is responsible for installing all material in the proper planting season for each plant type. All planting is to be completed within growing season of completion of site construction. Do not plant Pinus strobus or XCupressocyparis leylandii between November 15 and March 15. Landscape plants are not to be installed before site is graded to final grade.

8. Contractor to regrade, fine grade, sod, hydroseed and straw mulch all areas disturbed by their work.

9. Bid shall be based on actual site conditions. No extra payment shall be made for work arising from actual site conditions differing from those indicated on drawings and specifications.

10. Plant quantities are provided for the convenience of the contractor only. If discrepancies exist between quantities shown on plan and those shown on the plant list, the quantities on the plan take precedence. Where discrepancies on the plan exist between the symbols and the callout leader, the number of symbols take precedence.

11. All shrubs and groundcover areas shall be planted in continuous planting beds, prepared as specified, unless otherwise indicated on plans. (See Specification 13). Beds to be mulched with minimum 2" and maximum 3" of composted, double-shredded hardwood mulch throughout.

12. Positive drainage shall be maintained on planting beds (minimum 2 percent slope).

13. Bed preparation shall be as follows: Till into a minimum depth of 6" 1 yard of Compro or Leafgro per 200 SF of planting bed, and 1 yard of topsoil per 100 SF of bed. Add 3 lbs of standard 5-10-5 fertilizer per cubic yard of planting mix and till. Ericaceous plants (Azaleas, Rhododendrons, etc.): top dress after planting with iron sulfate or comparable product according to package directions. Taxus baccata 'Repandens' (English weeping yews): Top dress after planting with 1/4 to 1/2 cup lime each.

14. Planting mix: For trees not in a prepared bed, mix 50% Compro or Leafgro with 50% soil from tree hole to use as backfill, see tree planting detail.

15. Weed & insect control: Incorporate a pre-emergent herbicide into the planting bed following recommended rates on the label. For tree planting, apply a pre-emergent on top of soil and root ball before mulching. Caution: For areas to be planted with a ground cover, be sure to carefully check the chemical used to assure its adaptability to the specific groundcover to be treated. Maintain the mulch weed-free for the extent of the warranty period. Under no circumstances is a pesticide containing chlorpyrifos to be used as a means of pest control.

16. Water: All plant material planted shall be watered thoroughly the day of planting. All plant material not yet planted shall be properly protected from drying out until planted. At a minimum, water unplanted plant material daily and as necessary to avoid dessication.

17. Pruning: Do not heavily prune trees and shrubs at planting. Prune only broken, dead, or diseased branches.

18. All areas within contract limits disturbed during or prior to construction not designated to receive plants and mulch shall be fine graded, grass seed planted, and covered with straw mulch.

DEVELOPER'S/BUILDER'S CERTIFICATE:

I/WE CERTIFY THAT THE LANDSCAPING SHOWN ON THIS PLAN WILL BE DONE ACCORDING TO THE PLAN, SECTION 16.124 OF THE HOWARD COUNTY CODE AND THE HOWARD COUNTY LANDSCAPE MANUAL. I/WE FURTHER CERTIFY THAT UPON COMPLETION, A CERTIFICATION OF LANDSCAPE INSTALLATION, ACCOMPANIED BY AN EXECUTED ONE YEAR GUARANTEE OF PLANT MATERIALS, WILL BE SUBMITTED TO THE DEPARTMENT OF PLANNING AND ZONING.

SIGNATURE — DATE 10.18.02

Paul Cavanaugh

PLANTING LEGEND

PROP. SHADE TREE	
PROP. ORNAMENTAL TREE	
PROP. EVERGREEN TREE	
PROP. TREELINE	
EXISTING SHADE TREE	
EXISTING TREELINE	

APPROVED : HOWARD COUNTY DEPARTMENT OF PUBLIC WORKS.

CHIEF, BUREAU OF HIGHWAYS — DATE 11-8-02

APPROVED : HOWARD COUNTY DEPARTMENT OF PLANNING AND ZONING.

CHIEF, DIVISION OF LAND DEVELOPMENT — DATE 11/21/02

CHIEF, DEVELOPMENT ENGINEERING DIVISION — DATE 11/14/02

DATE	NO.	REVISION

OWNER/DEVELOPER

THE HOWARD RESEARCH AND DEVELOPMENT CORPORATION
THE ROUSE BUILDING
10275 LITTLE PATUXENT PARKWAY
COLUMBIA, MARYLAND 21044
410-992-6000

PROJECT

EMERSON
SECTION THREE AREA TWO

AREA
TAX MAP 47 BLOCK 8 & 9
ZONED: PEC-MXD-3 PART OF PARCELS: 462 & 837
6th ELECTION DISTRICT HOWARD COUNTY, MARYLAND

TITLE

LANDSCAPE PLAN

Patton Harris Rust & Associates, pc
Engineers. Surveyors. Planners. Landscape Architects.
8818 Centre Park Drive
Columbia, MD 21045
T 410.997.8900
F 410.997.9282

10.18.02
DATE

STATE OF MARYLAND 830 DAVID T. DOWS PROFESSIONAL ENGINEER

DAVID T. DOWS #830

DESIGNED BY :	DMD
DRAWN BY :	DMD
CHECKED BY :	DTD
PERMIT TRACKING NUMBER	01-NT-0222/200164079
DATE :	OCTOBER 21, 2002
SCALE :	1" = 50'
DRAWING NO.	9 OF 12

F-02-178

L200LND.dwg

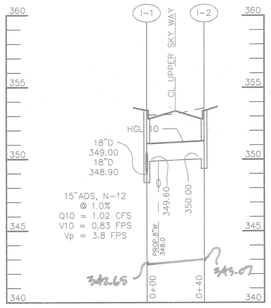

PROFILE

SCALE :
HOR.-1"=50'
VERT.-1"=5'

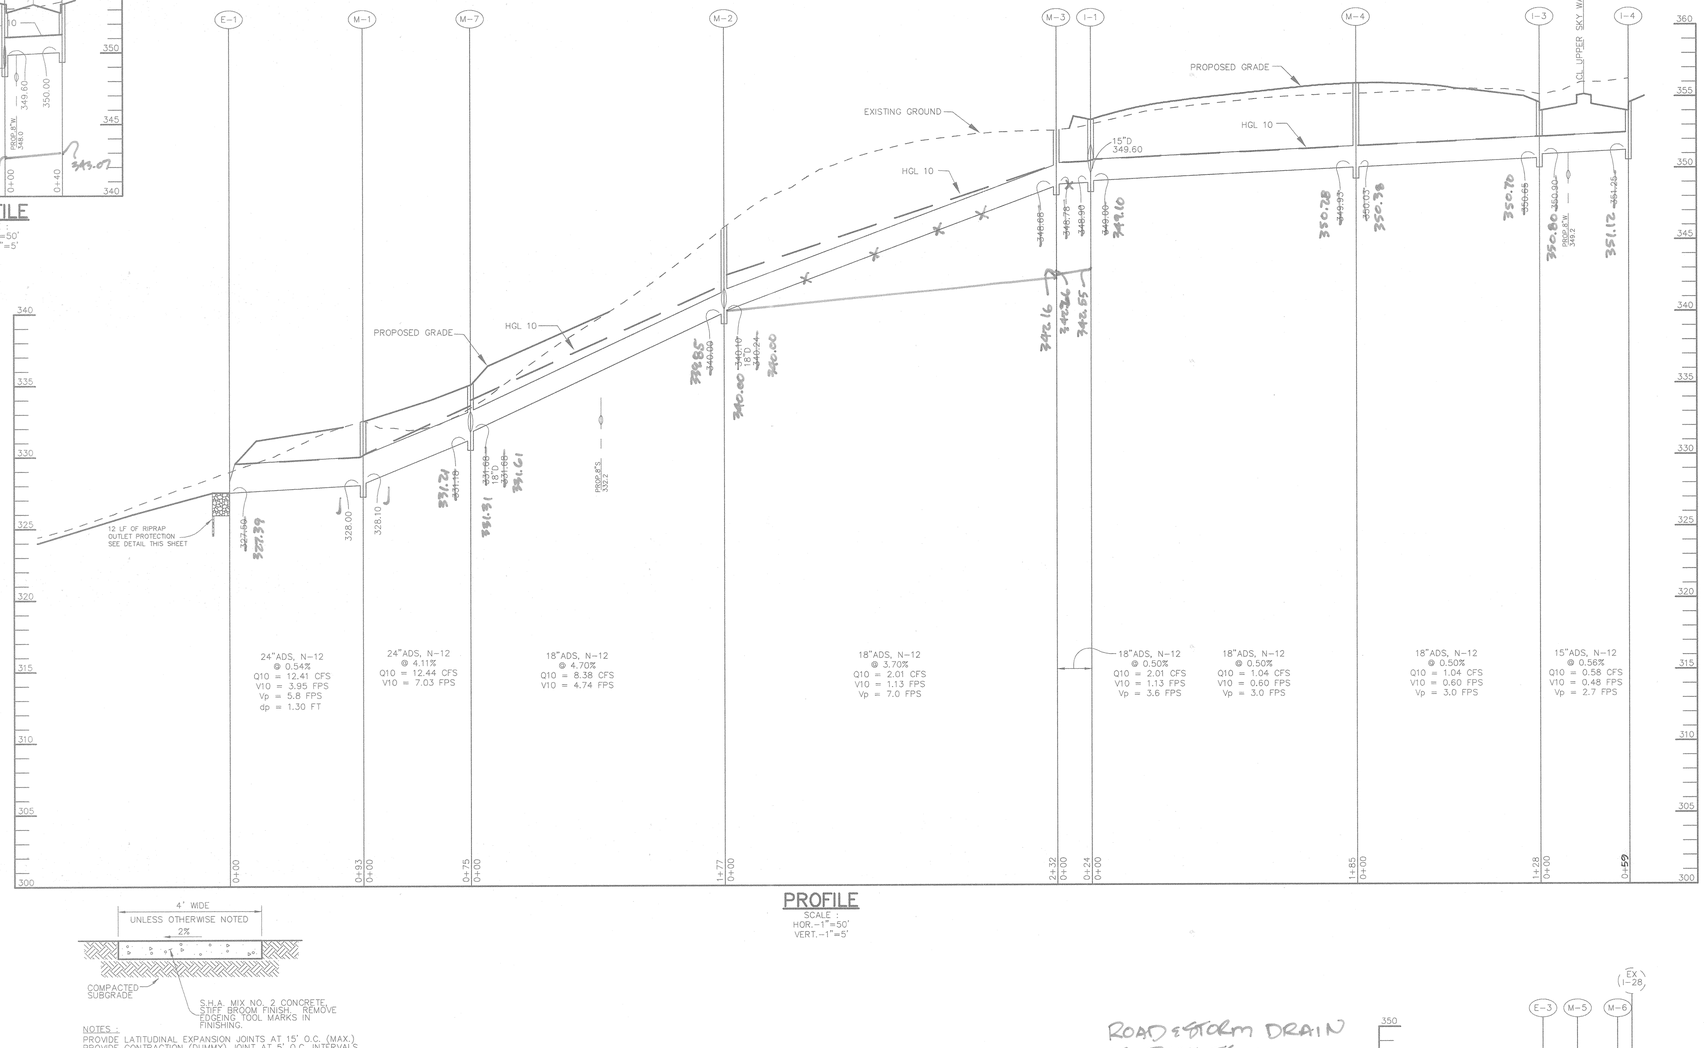

PROFILE

SCALE :
HOR.-1"=50'
VERT.-1"=5'

NOTES :
PROVIDE LATITUDINAL EXPANSION JOINTS AT 15' O.C. (MAX.)
PROVIDE CONTRACTION (DUMMY) JOINT AT 5' O.C. INTERVALS BETWEEN EXPANSION JOINTS. SIDEWALK TO BE SCRIBED IN 5' MAX. SQUARES.

SIDEWALK DETAIL

NO SCALE

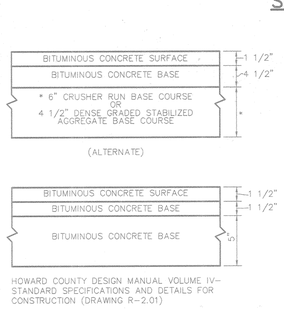

HOWARD COUNTY DESIGN MANUAL VOLUME IV-STANDARD SPECIFICATIONS AND DETAILS FOR CONSTRUCTION (DRAWING R-2.01)

P-3 PAVING

NO SCALE

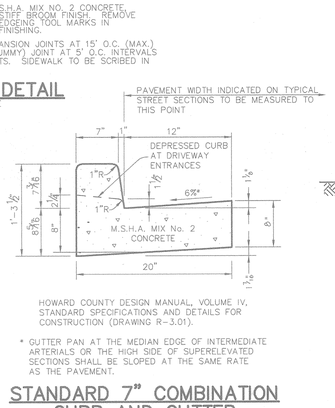

HOWARD COUNTY DESIGN MANUAL, VOLUME IV, STANDARD SPECIFICATIONS AND DETAILS FOR CONSTRUCTION (DRAWING R-3.01).

* GUTTER PAN AT THE MEDIAN EDGE OF INTERMEDIATE ARTERIALS OR THE HIGH SIDE OF SUPERELEVATED SECTIONS SHALL BE SLOPED AT THE SAME RATE AS THE PAVEMENT.

STANDARD 7" COMBINATION CURB AND GUTTER

NO SCALE

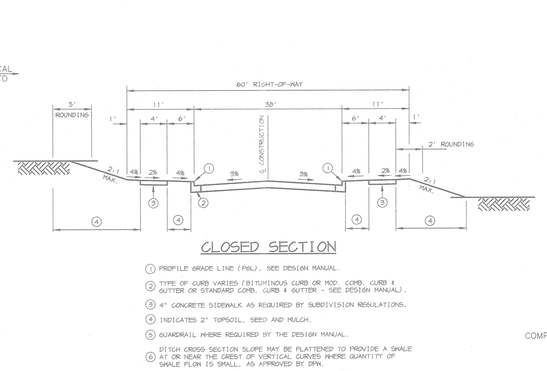

CLOSED SECTION

1. PROFILE GRADE LINE (P&L), SEE DESIGN MANUAL.
2. TYPE OF CURB VARIES (BITUMINOUS CURB OR MOD. COMB. CURB & GUTTER OR STANDARD COMB. CURB & GUTTER - SEE DESIGN MANUAL).
3. 4' CONCRETE SIDEWALK AS REQUIRED BY SUBDIVISION REGULATIONS.
4. INDICATES 2" TOPSOIL, SEED AND MULCH.
5. GUARDRAIL WHERE REQUIRED BY THE DESIGN MANUAL.
6. DITCH CROSS SECTION SLOPE MAY BE FLATTENED TO PROVIDE A SWALE AT OR NEAR THE CREST OF VERTICAL CURVES WHERE QUANTITY OF SWALE FLOW IS SMALL, AS APPROVED BY DPW.

TYPICAL SECTION LOCAL ROAD

NO SCALE

ROAD & STORM DRAIN
AS-BUILTS
G. SCOTT SHANABERGER
PROF. L.S. # 10

STATE OF MARYLAND
G. SCOTT SHANABERGER
No. 10243
PROFESSIONAL LAND SURVEYOR

SHANABERGER & LANE
8726 TOWN & COUNTRY BLVD.
SUITE 201
ELLICOTT CITY, MARYLAND 21043

ASPHALT WALK DETAIL

NO SCALE

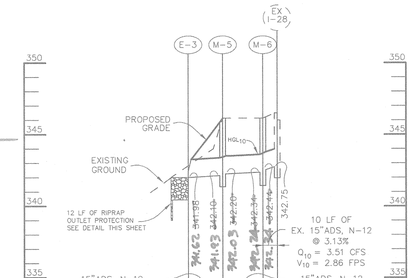

PROFILE

SCALE :
HOR.-1"=50'
VERT.-1"=5'

APPROVED : HOWARD COUNTY DEPARTMENT OF PUBLIC WORKS.

CHIEF, BUREAU OF HIGHWAYS — DATE 11-8-02

APPROVED : HOWARD COUNTY DEPARTMENT OF PLANNING AND ZONING.

CHIEF, DIVISION OF LAND DEVELOPMENT — DATE 11/20/02

CHIEF, DEVELOPMENT ENGINEERING DIVISION — DATE 11/14/02

DATE	NO.	REVISION

OWNER/DEVELOPER

THE HOWARD RESEARCH AND DEVELOPMENT CORPORATION
THE ROUSE BUILDING
10275 LITTLE PATUXENT PARKWAY
COLUMBIA, MARYLAND 21044
410-992-6000

PROJECT

EMERSON
SECTION THREE AREA TWO

AREA — TAX MAP 47 — BLOCK 8 & 9
ZONED: PEC-MXD-3 — PART OF PARCELS: 462 & 837
6th ELECTION DISTRICT — HOWARD COUNTY, MARYLAND

TITLE

PROFILES AND DETAILS

Patton Harris Rust & Associates, pc
Engineers. Surveyors. Planners. Landscape Architects.
8818 Centre Park Drive
Columbia, MD 21045
T 410.997.8900
F 410.997.9282

10.18.02
DATE

STATE OF MARYLAND — CHRISTOPHER J. REID — No. 19949 — PROFESSIONAL ENGINEER

CHRISTOPHER J. REID #19949

DESIGNED BY :	A.C.R
DRAWN BY :	DAM
CHECKED BY :	C.J.R.
PERMIT TRACKING NUMBER	01-NT-0222/200164079
DATE :	OCTOBER 21, 2002
SCALE :	AS SHOWN
DRAWING NO.	8 OF 12

F-02-178 C-DETAILS4.DWG

S:\project\2245611-DEngr\Plans\FINALS\C-DETAILS4.dwg, Layout1, 10/17/02 02:45:44 PM, HP750C(36).pc3, Arch D - 24 x 36 in. (landscape), 1:1

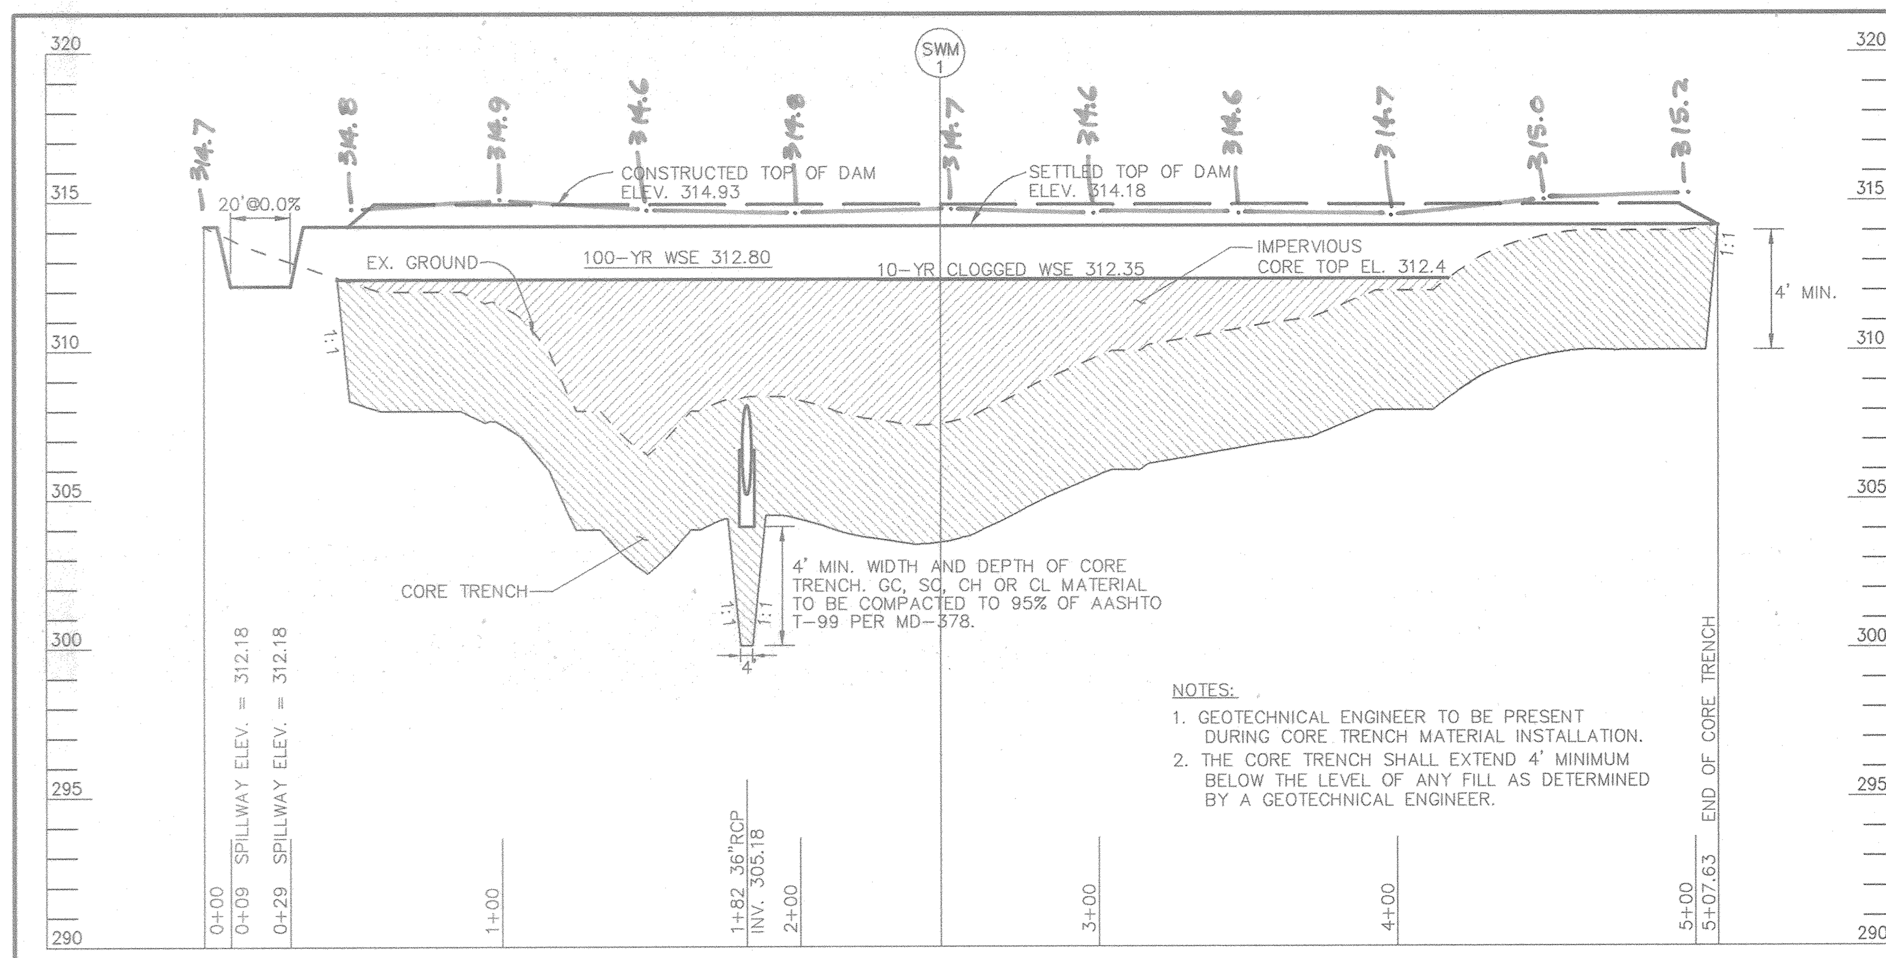

EMBANKMENT CENTERLINE PROFILE

SCALE :
HOR.-1"=50'
VERT.-1"=5'

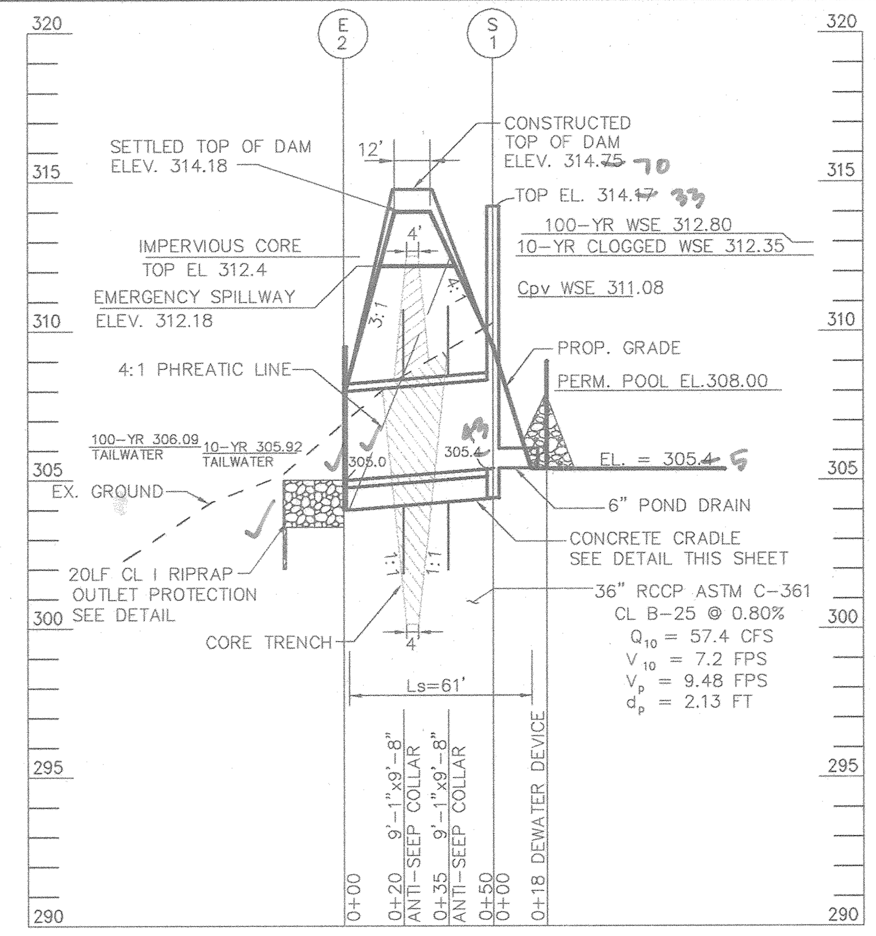

PRINCIPAL SPILLWAY PROFILE

SCALE :
HOR.-1"=50'
VERT.-1"=5'

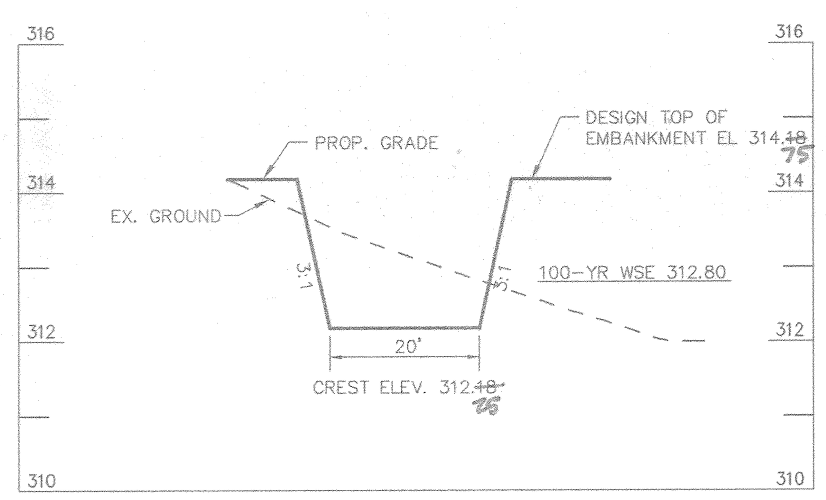

SECTION THRU EMERGENCY SPILLWAY

SCALE :
HOR.-1"=20'
VERT.-1"=2'

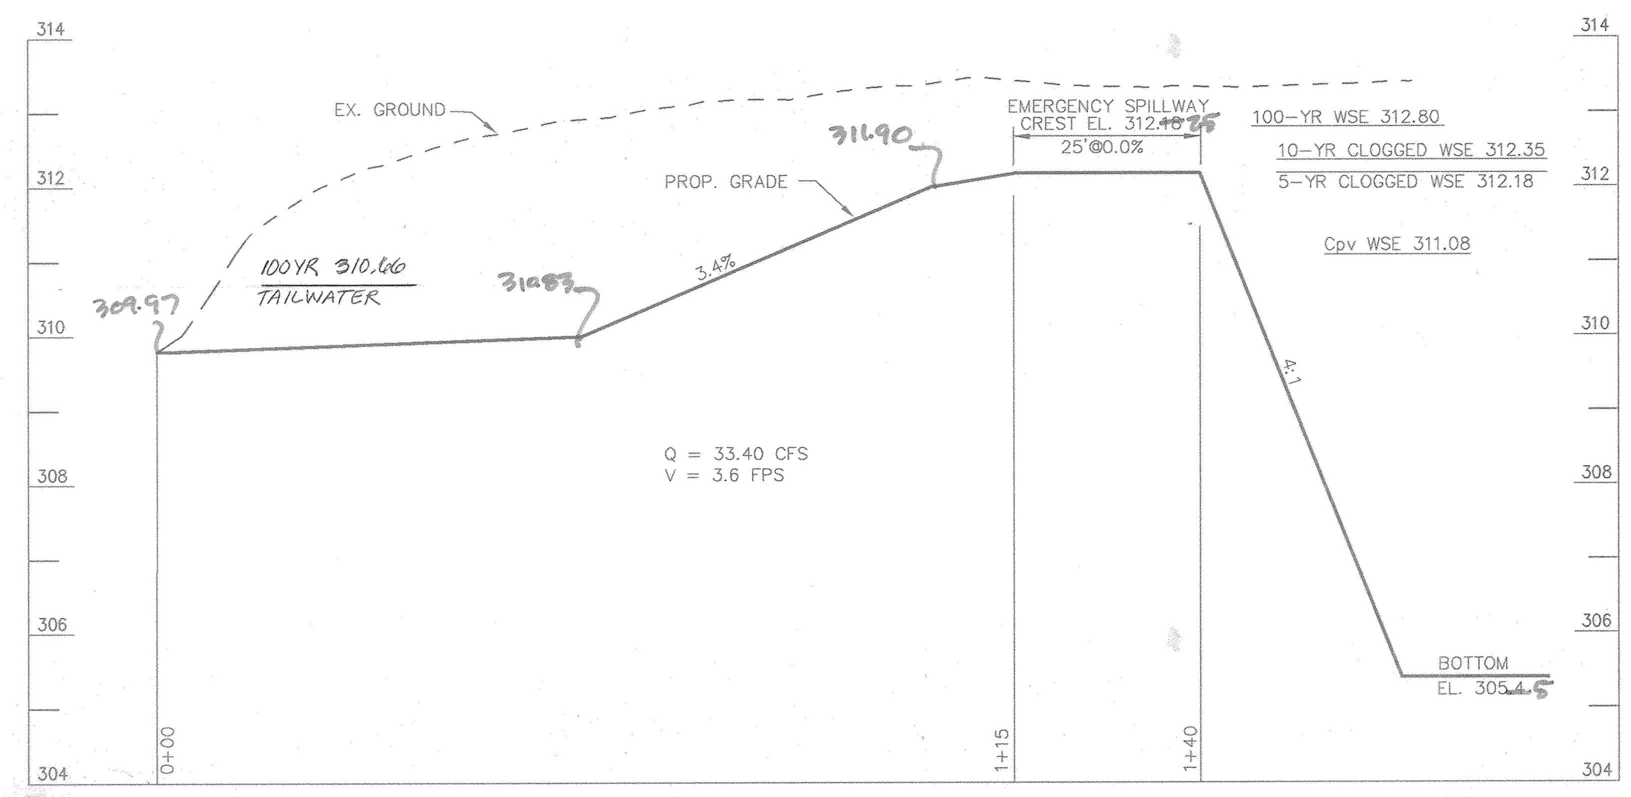

PROFILE THRU EMERGENCY SPILLWAY

SCALE :
HOR.-1"=20'
VERT.-1"=2'

OPERATION AND MAINTENANCE SCHEDULE OF PUBLICLY OWNED AND MAINTAINED STORMWATER MANAGEMENT FACILITY WET POND

ROUTINE MAINTENANCE

1. Facility shall be inspected anually and after major storms. Inspections should be performed during wet weather to determine if the pond is functioning properly.
2. Top and side slopes of the embankment shall be mowed a minimum of two (2) times a year, once in June and once in September. Other side slopes, the bottom of the pond, and maintenance access should be mowed as needed.
3. Debris and litter next to the outlet structure shall be removed during regular mowing operations and as needed.
4. Visible signs of erosion in the pond as well as riprap outlet area shall be repaired as soon as it is noticed.

NON-ROUTINE MAINTENANCE

1. Structural components of the pond such as the dam, the riser, and the pipes shall be repaired upon the the detection of any damage. The components should be inspected during routine maintenance operations.
2. Sediment should be removed when its accumulation significantly reduces the design storage, interfere with the function of the riser, when deemed necessary for aesthetic reasons, or when deemed necessary by the Howard County's Department of Public Works.

SHANABERGER & LANE
8726 TOWN & COUNTRY BLVD.
SUITE 201
ELLICOTT CITY, MARYLAND 21043

ROAD & STORM DRAIN AS-BUILT
G. SCOTT SHANABERGER
PROF. L.S. # 108[illegible]
DATE

0'	TOPSOIL
0.3'	GRAY AND BROWN MOIST SILT & CLAY, SOME SAND (ML)
2.0'	BROWN MOIST SAND, SOME SILT, LITTLE GRAVEL (SM)
5.5'	BROWN MOIST MICACEOUS SAND, SOME SILT (SM)
13.0'	GRAY MOIST SNAD, SOME SILT, TRACE ROCK FRAGMENTS (SM) (DECOMPOSED ROCK)
13.7'	

BORING SWM-1

NO SCALE

0'	TOPSOIL
0.2'	BROWN MOIST CLAYEY SILT, SOME SAND (ML)
4.0'	BROWN MOIST MICACEOUS CLAYEY SILT AND SAND (ML)
6.0'	BROWN MOIST MICACEOUS SAND, SOME CLAYEY SILT (SM)
13.5'	BLACK & WHITE MOIST MICACEOUS SAND, LITTLE SILT (SM) (DECOMPOSED ROCK)
18.5'	BROWN WET MICACEOUS SAND, SOME SILT (SM) (DECOMPOSED ROCK)
18.9'	

BORING SWM-2

NO SCALE

0'	TOPSOIL
0.7'	BROWN MOIST CLAYEY SILT AND SAND (ML)
6.0'	GRAY MOIST MICACEOUS SAND, LITTLE SILT (SM)
8.0'	BROWN MOIST MICACEOUS SAND AND ROCK FRAGMENTS, TRACE SILT (SP-SM) (DECOMPOSED ROCK)
14.9'	

BORING SWM-3

NO SCALE

RISER STRUCTURE NOTES FOR S-1

1. RISER TO BE PRECAST. SHOP DRAWINGS FOR THIS CONCRETE STRUCTURE SHALL MEET THE MINIMUM ASTM REQUIREMENTS FOR PRECAST STRUCTURES. A SHOP DRAWING SHALL BE SUBMITTED TO THE ENGINEER PRIOR TO FABRICATION AND SHALL BE SIGNED AND SEALED BY A MARYLAND REGISTERED PROFESSIONAL ENGINEER.
2. CONCRETE SHALL BE MSHA MIX NO. 3 (fc=3,500 psi MINIMUM)
3. REFER TO HOWARD COUNTY STD. G-5.21 FOR MANHOLE STEP DETAILS.
4. RISER JOINTS SHALL BE WATERTIGHT USING NEOPRENE GASKETS.
5. ALL PIPE CONNECTIONS SHALL PROVIDE RUBBER GASKET FOR WATERTIGHTNESS.
6. RISER SHALL BE PLACED ON A FIRMLY COMPACTED SUBGRADE AND SHALL BE APPROVED BY A GEOTECHNICAL ENGINEER.
7. A 6" BUTTERFLY VALVE SHALL BE CONNECTED TO THE RISER WALL WITH ALL-THREADED ROD AND A FLANGE JOINT.

REMOVABLE TRASH RACK NOTES:

1. STEEL TO CONFORM TO ASTM A-36. #5 BARS TO BE SMOOTH. SEE DETAIL FOR SPACING.
2. ALL REBAR TO BE WELDED AT ALL INTERSECTIONS.
3. ALL BENDS TO BE 2" RADIUS. 2" x 2" ANGLE IRON AND 1/2" DIAMETER ANCHOR BOLTS TO BE USED FOR TRASH RACK FRAME.
4. GALVANIZE TRASH RACK AFTER FABRICATION AND PAINT BATTLESHIP GRAY.

RISER REINFORCEMENT NOTES:

REINFORCING TO BE #7 DEFORMED BARS @ 6" C/C, 2 WAYS, WITH 2" COVER IN TOP SLAB

REINFORCING TO BE #4 DEFORMED BARS @ 6" C/C, 2 WAYS WITH 2" COVER IN WALLS AND BOTTOM SLAB.

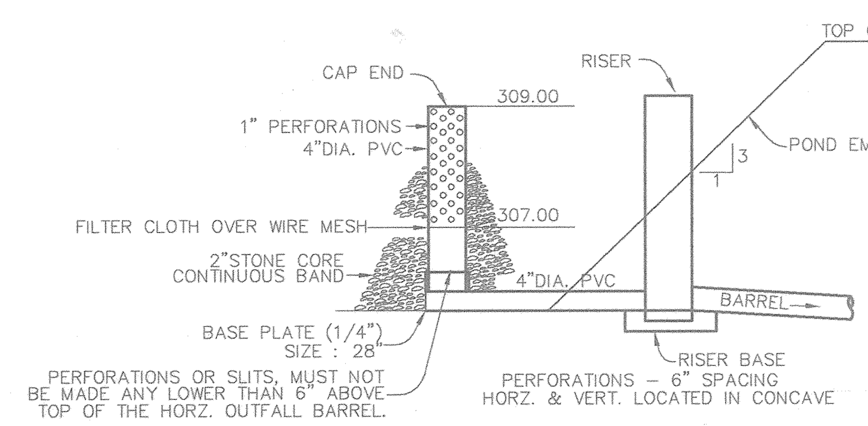

SEDIMENT BASIN DEWATERING DEVICE WITH 4" PERFORATED RISER

NO SCALE

1. PERFORATIONS ON THE DRAW-DOWN DEVICE MAY NOT EXTEND INTO THE WET STORAGE.
2. THE TOTAL AREA OF THE PERFORATIONS MUST BE GREATER THAN 2 TIMES THE AREA OF THE INTERNAL ORIFICE.
3. THE PERFORATED PORTION OF THE DRAW-DOWN DEVICE SHALL BE WRAPPED WITH 1/2" HARDWARE CLOTH AND GEOTEXTILE FABRIC. THE GEOTEXTILE FABRIC SHALL MEET THE SPECIFICATIONS FOR GEOTEXTILE CLASS E.
4. PROVIDED SUPPORT OF DRAW-DOWN DEVICE TO PREVENT SAGGING AND FLOATATION. AN ACCEPTABLE PREVENTATIVE MEASURE IS TO STAKE BOTH SIDES OF DRAW-DOWN DEVICE WITH 1" STEEL ANGLE, OR 1' BY 4" SQUARE OR 2" ROUND WOODEN POSTS SET 3' MINIMUM INTO THE GROUND THEN JOINING THEM TO THE DEVICE BY WRAPPING WITH 12 GAUGE MINIMUM WIRE.

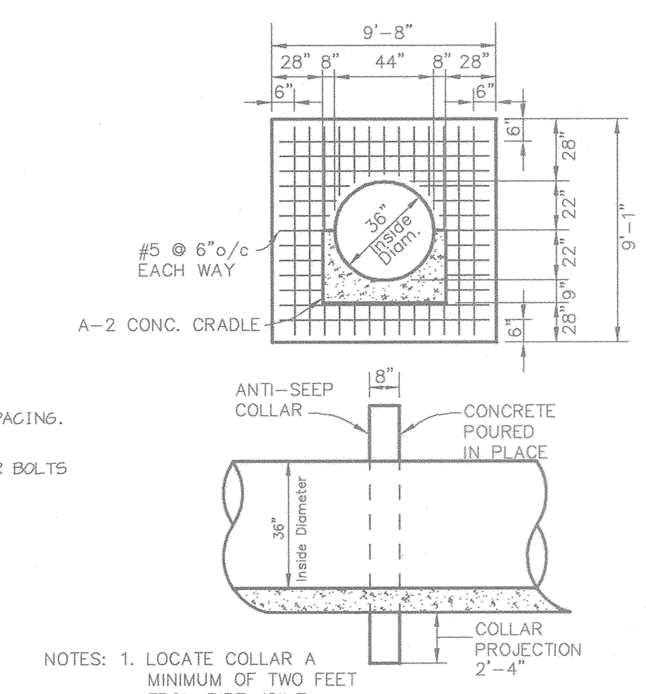

NOTES: 1. LOCATE COLLAR A MINIMUM OF TWO FEET FROM PIPE JOINT.

NOTES: 2. COLLAR/PIPE CONNECTION SHALL BE WATERTIGHT.

CONCRETE ANTI-SEEP COLLAR SWMF #1

NO SCALE

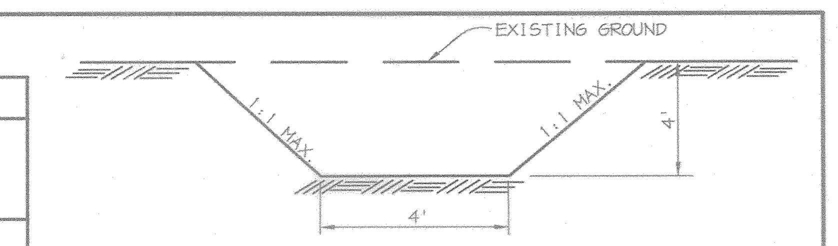

NOTE: GC, SC, CH, OR CL MATERIAL IS TO BE USED FOR CORE TRENCH. IF UNSUITABLE MATERIAL EXISTS ON SITE, ACCEPTABLE MATERIAL WILL NEED TO BE TRUCKED TO SITE.

CORE TRENCH DETAIL

NO SCALE

BY THE DEVELOPER :

I/WE CERTIFY THAT ALL DEVELOPMENT AND/OR CONSTRUCTION WILL BE DONE ACCORDING TO THESE PLANS, AND THAT ANY RESPONSIBLE PERSONNEL INVOLVED IN THE CONSTRUCTION PROJECT WILL HAVE A CERTIFICATE OF ATTENDANCE AT A DEPARTMENT OF THE ENVIRONMENT APPROVED TRAINING PROGRAM FOR THE CONTROL OF SEDIMENT AND EROSION BEFORE BEGINNING THE PROJECT. I SHALL ENGAGE A REGISTERED PROFESSIONAL ENGINEER TO SUPERVISE POND CONSTRUCTION AND PROVIDE THE HOWARD SOIL CONSERVATION DISTRICT WITH AN "AS-BUILT" PLAN OF THE POND WITHIN 30 DAYS OF COMPLETION. I ALSO AUTHORIZE PERIODIC ON-SITE INSPECTIONS BY THE HOWARD SOIL CONSERVATION DISTRICT.

DEVELOPER — PAUL CAVANAUGH — DATE 10.18.02

BY THE ENGINEER :

I CERTIFY THAT THIS PLAN FOR POND CONSTRUCTION, EROSION AND SEDIMENT CONTROL REPRESENTS A PRACTICAL AND WORKABLE PLAN BASED ON MY PERSONAL KNOWLEDGE OF THE SITE CONDITIONS. THIS PLAN WAS PREPARED IN ACCORDANCE WITH THE REQUIREMENTS OF THE HOWARD SOIL CONSERVATION DISTRICT. I HAVE NOTIFIED THE DEVELOPER THAT HE/SHE MUST ENGAGE A REGISTERED PROFESSIONAL ENGINEER TO SUPERVISE POND CONSTRUCTION AND PROVIDE THE HOWARD SOIL CONSERVATION DISTRICT WITH AN "AS-BUILT" PLAN OF THE POND WITHIN 30 DAYS OF COMPLETION.

ENGINEER — DATE 10.18.02

THESE PLANS HAVE BEEN REVIEWED FOR THE HOWARD SOIL CONSERVATION DISTRICT AND MEET THE TECHNICAL REQUIREMENTS FOR SMALL POND CONSTRUCTION, SOIL EROSION AND SEDIMENT CONTROL.

NATURAL RESOURCES CONSERVATION SERVICE — DATE 10/30/02

THESE PLANS FOR SMALL POND CONSTRUCTION, SOIL EROSION AND SEDIMENT CONTROL MEET THE REQUIREMENTS OF THE HOWARD SOIL CONSERVATION DISTRICT.

HOWARD SOIL CONSERVATION DISTRICT — DATE 10/30/02

APPROVED : HOWARD COUNTY DEPARTMENT OF PUBLIC WORKS.

CHIEF, BUREAU OF HIGHWAYS — DATE 11-8-02

APPROVED : HOWARD COUNTY DEPARTMENT OF PLANNING AND ZONING.

CHIEF, DIVISION OF LAND DEVELOPMENT — DATE 11/20/02

CHIEF, DEVELOPMENT ENGINEERING DIVISION — DATE 11/14/02

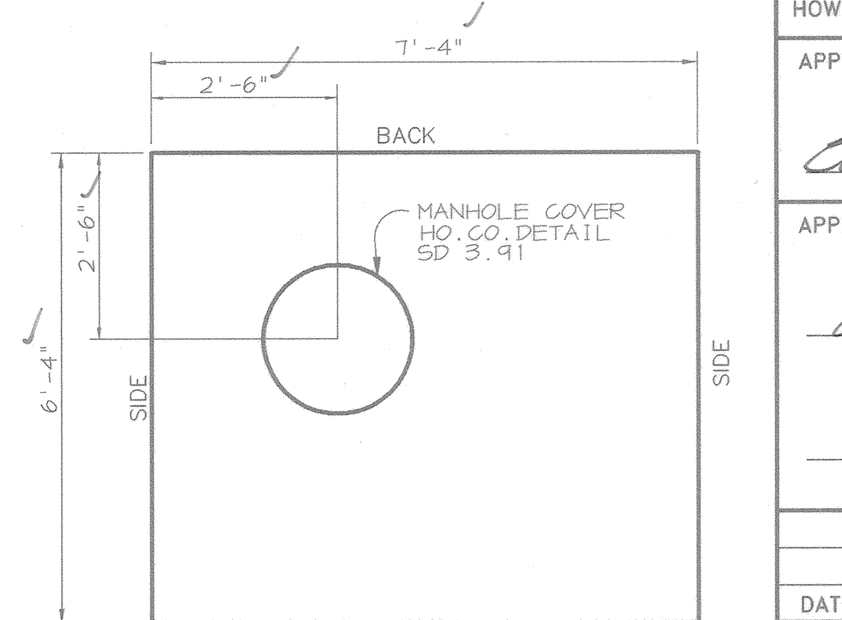

TOP VIEW

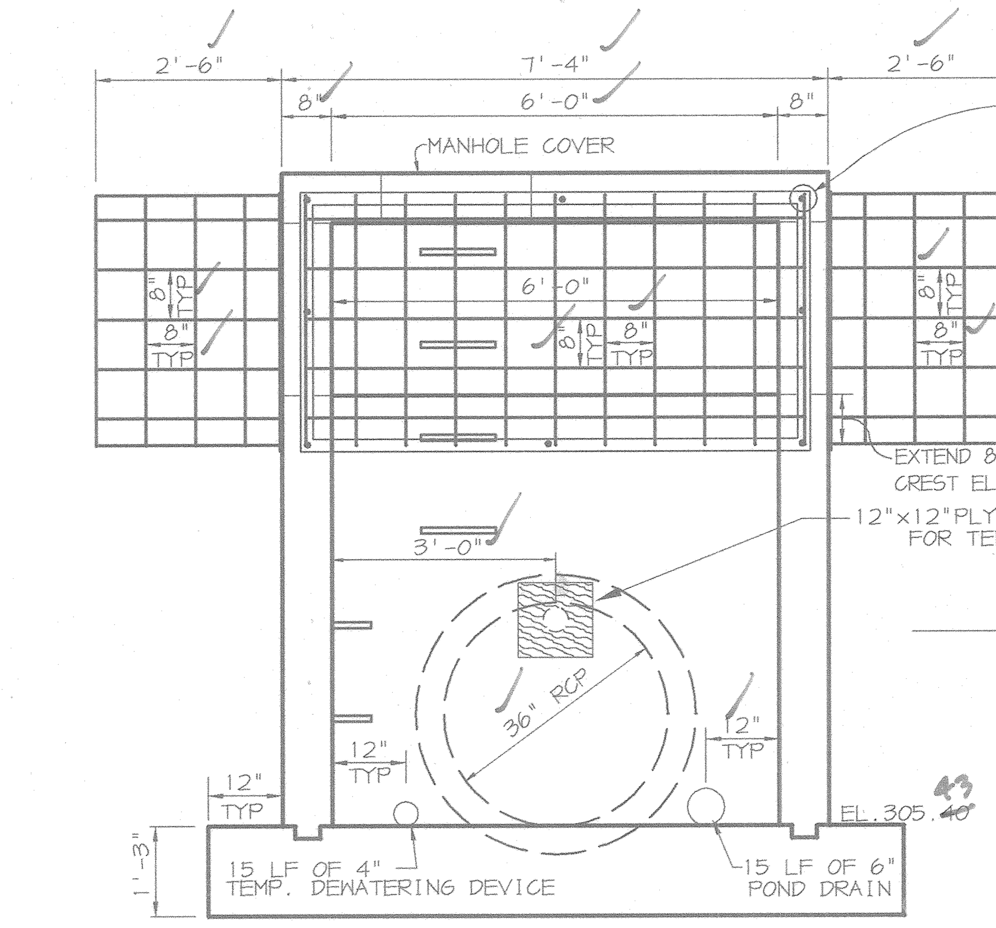

FRONT VIEW

TOP EL. 314.17 33

TOP OF WEIR EL. 313.50

100 YR WSE 312.80

10 YR CLOGGED WSE 312.35

6'-0" WEIR FRONT ONLY	4'-6" WEIR BOTH SIDES
EL. 311.08	EL. 311.08

4"ORIFICE INV.308.00
PERMANENT POOL ELEV.308.00

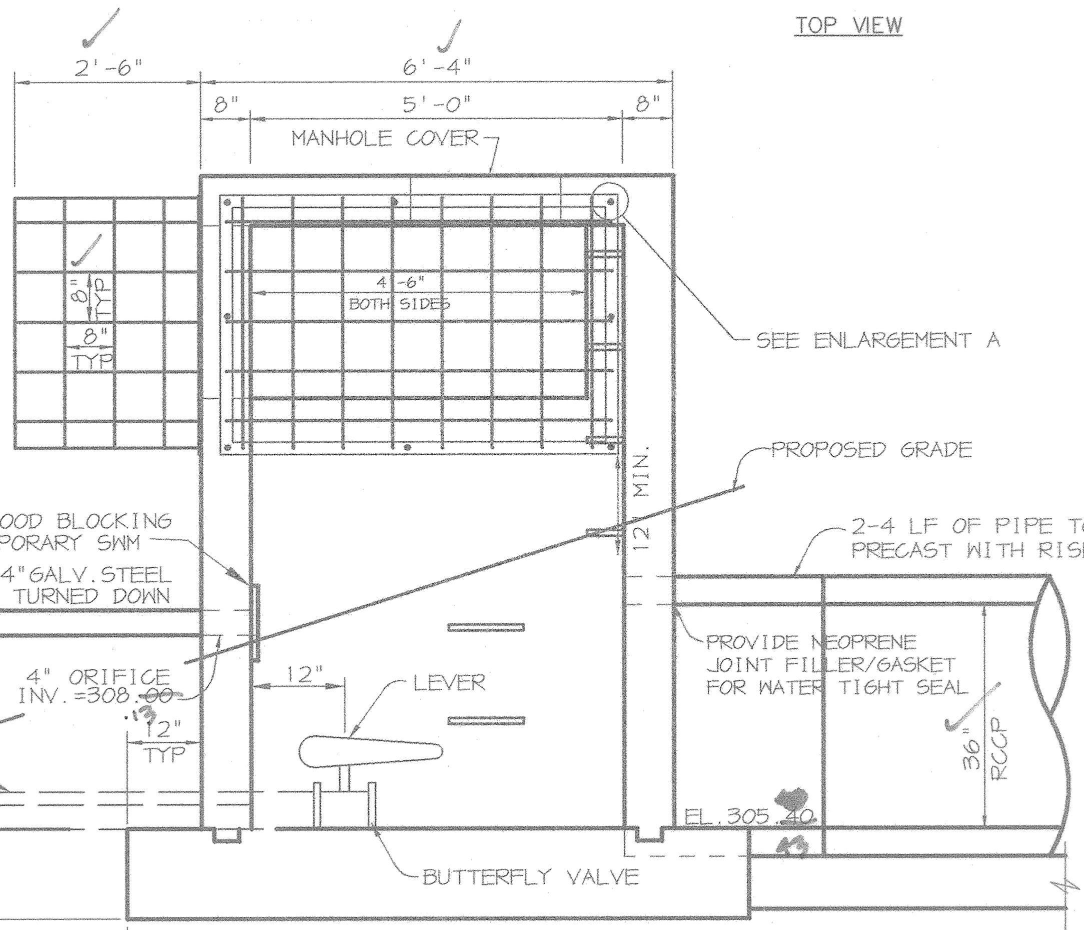

SIDE VIEW

S-1 DETAILS

SCALE 1"=2'

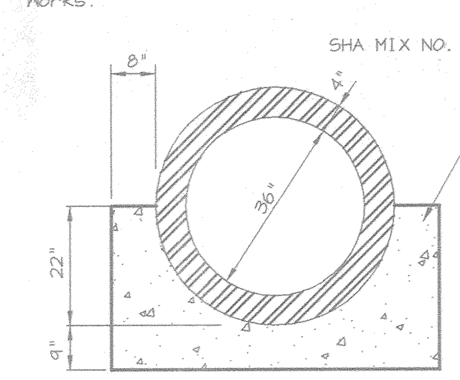

NO SCALE
CLASS 'A' DAMS LESS THAN 50' HIGH

A-2 CONCRETE CRADLE

NO SCALE

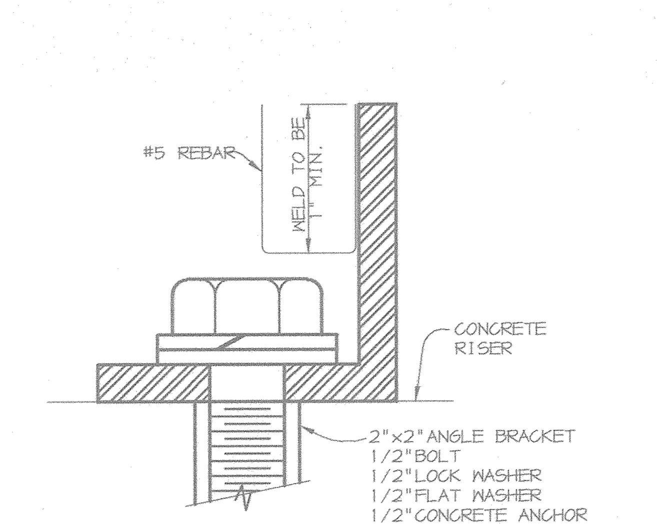

ENLARGEMENT A

NO SCALE

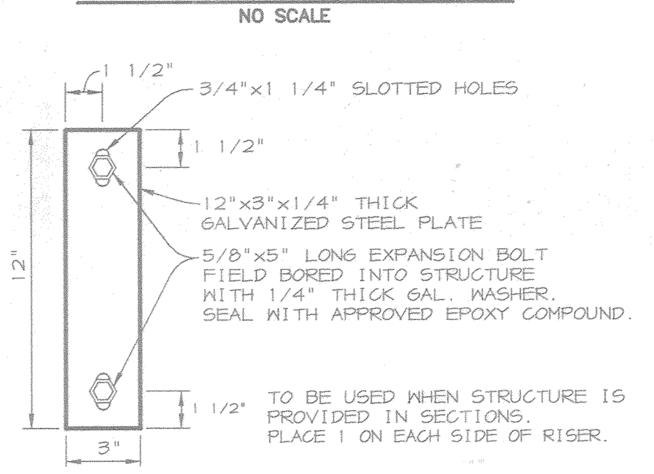

RISER JOINT FASTENER

NO SCALE

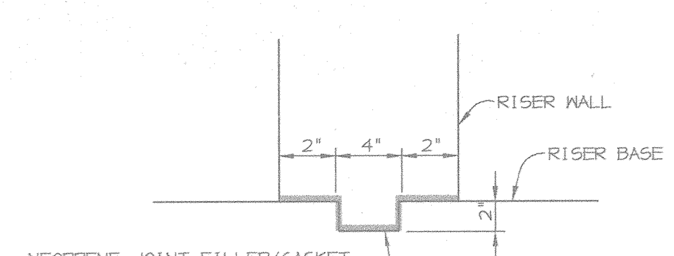

TYPICAL KEY JOINT DETAIL

NO SCALE

DATE	NO.	REVISION

OWNER/DEVELOPER

THE HOWARD RESEARCH AND DEVELOPMENT CORPORATION
THE ROUSE BUILDING
10275 LITTLE PATUXENT PARKWAY
COLUMBIA, MARYLAND 21044
410-992-6000

PROJECT

EMERSON
SECTION THREE AREA TWO

AREA
TAX MAP 47 BLOCK 8 & 9
ZONED: PEC-MXD-3 PART OF PARCELS: 462 & 837
6th ELECTION DISTRICT HOWARD COUNTY, MARYLAND

TITLE

STORMWATER MANAGEMENT DETAILS AND PROFILES

Patton Harris Rust & Associates,pc
Engineers. Surveyors. Planners. Landscape Architects.
PHR+A
8818 Centre Park Drive
Columbia, MD 21045
T 410.997.8900
F 410.997.9282

10.18.02
DATE

CHRISTOPHER J. REID #19949

DESIGNED BY : A.C.R
DRAWN BY : DAM
CHECKED BY : C.J.R.
PERMIT TRACKING NUMBER 01-NT-0222/200164079
DATE : OCTOBER 21, 2002
SCALE : AS SHOWN
DRAWING NO. 7 OF 12

F-02-178 C-DETAILS3.DWG

P:\project\224561-0\Engr\Plans\FINALS\C-DETAILS3.dwg, Layout1, 10/17/02 02:36:09 PM, HP750C(36).pc3, Arch D - 24 x 36 in. (landscape), 1:1

MD-378 STANDARDS AND SPECIFICATIONS

SPECIFICATIONS

These specifications are appropriate to all ponds within the scope of the Standard for practice MD-378. All references to ASTM and AASHTO specifications apply to the most recent version.

SITE PREPARATION

Areas designated for borrow areas, embankment, and structural works shall be cleared, grubbed and stripped of topsoil. All trees, vegetation, roots and other objectionable material shall be removed. Channel banks and sharp breaks shall be sloped to no steeper than 1:1. All trees shall be cleared and grubbed within 15 feet of the toe of the embankment.

Areas to be covered by the reservoir will be cleared of all trees, brush, logs, fences, rubbish and other objectionable material unless otherwise designated on the plans. Trees, brush and stumps shall be cut approximately level with the ground surface. For dry stormwater management ponds, a minimum of a 25 foot radius around the inlet structure shall be cleared.

All cleared and grubbed material shall be disposed of outside and below the limits of the dam and reservoir as directed by the owner or his representative. When specified, a sufficient quantity of topsoil will be stockpiled in a suitable location for use on the embankment and other designated areas.

EARTH FILL

Material - The fill material shall be taken from approved designated borrow areas. It shall be free of roots, stumps, wood, rubbish, stones greater than 6", frozen or other objectionable materials. Fill material for the center of the embankment, and cut off trench shall conform to Unified Soil Classification GC, SC, CH, or CL and must have at least 30% passing the #200 sieve. Consideration may be given to the use of other materials in the embankment if designed by a geotechnical engineer. Such special designs must have construction supervised by a geotechnical engineer.

Placement - Areas on which fill is to be placed shall be scarified prior to placement of fill. Fill materials shall be placed in nearly uniform 8-inch thick (before compaction) layers which are to be continuous over the entire length of the fill. The most permeable borrow material shall be placed in the downstream portions of the embankment. The principal spillway must be installed concurrently with fill placement and not excavated into the embankment.

Compaction - The movement of the hauling and spreading equipment over the fill shall be controlled so that the entire surface of each lift shall be traversed by not less than one tread track of the equipment or compaction shall be achieved by a minimum of four complete passes of a sheepsfoot, rubber tire or vibratory roller. Fill material shall contain sufficient moisture such that the required degree of compaction will be obtained with the equipment used. The fill material shall contain sufficient moisture so that if formed into a ball it will not crumble yet not be so wet that water can be squeezed out.

When required by the reviewing agency the minimum required density shall not be less than 95% of maximum dry density with a moisture content within +/- 2% of the optimum. Each layer of fill shall be compacted to assure maximum stability, density, and is to be certified by the Engineer at the time of construction. All compaction is to be determined by AASHTO Method T-99 (Standard Proctor).

Cutoff Trench - The cutoff trench shall be excavated into impervious material along or parallel to the centerline of the embankment as shown on the plans. The bottom width of the trench shall be governed by the equipment used for excavation, with the minimum width being four feet. The depth shall be at least four feet below existing grade or as shown on the plans. The side slopes of the trench shall be 1 to 1 or flatter. The backfill shall compacted with construction equipment, rollers, or hand tampers to assure maximum density and maximum permeability.

Embankment Core - The core shall be parallel to the centerline of the embankment as shown on the plans. The top width of the core shall be a minimum of four feet. The height shall extend up to at least the 10 year water elevation or as shown on the plans. The side slopes shall be 1 to 1 or flatter. The core shall be compacted with construction equipment, rollers, or hand tampers to assure maximum density and minimum permeability. In addition, the core shall be placed concurrently with the outer shell of the embankment.

STRUCTURE BACKFILL

Backfill adjacent to pipes or structures shall be of the type and quality conforming to that specified for the adjoining fill material. The fill shall be placed in horizontal layers not to exceed four inches in thickness and compacted by hand tampers or other manually directed compaction equipment. The material needs to fill completely all spaces under and adjacent to the pipe. At no time during the backfilling operation shall driven equipment be allowed to operate closer than four feet, measured horizontally, to any part of a structure. Under no circumstances shall equipment be driven over any part of a concrete structure or pipe, unless there is a compacted fill of 24" or greater over the structure or pipe.

Structure backfill may be Flowable Fill meeting the requirements of Maryland Department of Transportation, State Highway Administration Standard Specifications for Construction and Materials, Section 313 as modified. The flowable fill shall have a minimum pH of 4.0 and a minimum resistivity of 2000 ohm-cm. Material shall be placed such that a minimum of 6" (measured perpendicular to the pipe) of flowable Fill shall be under (bedding), over and, on the sides of the pipe. It only needs to extend up to the spring line for rigid conduits. Average slump of the Fill shall be 7" to assure flowability of the material. Adequate measures shall be taken (sand bags, etc.) to prevent floating the pipe. When using Flowable Fill, all metal pipe shall be bituminous coated. Any adjoining soil Fill shall be placed in horizontal layers not to exceed four inches in thickness and compacted by hand tampers or other manually directed compaction equipment. The material shall completely fill all voids adjacent to the Flowable Fill zone. At no time during the backfilling operation shall driven equipment be allowed to operate closer than four feet, measured horizontally, to any part of a structure. Under no circumstances shall equipment be driven over any part of a structure or pipe unless there is a compacted Fill of 24" or greater over the structure or pipe. Backfill material outside the structural backfill (Flowable Fill) zone shall be of the type and quality conforming to that specified for the core of the embankment or other embankment materials.

PIPE CONDUITS

All pipes shall be circular in cross section.

Corrugated Metal Pipe - All of the following criteria shall apply for corrugated metal pipe:

1. Materials - (Polymer Coated steel pipe) - Steel pipes with polymeric coatings shall have a minimum coating thickness of 0.01 inch (10mil) on both sides of the pipe. This pipe and its appurtenances shall conform to the requirements of AASHTO Specifications M-245 & M-246 with watertight coupling bands or flanges.

   Materials - (Aluminum Coated Steel Pipe) - This pipe and its appurtenances shall conform to the requirements of AASHTO Specifications M-274 with watertight coupling bands or flanges. Aluminum Coated Steel Pipe, when used with Flowable Fill or when soil and/or water conditions warrant the need for increased durability, shall be fully bituminous coated per requirements of AASHTO Specification M-190 Type A. Any aluminum coating damaged or otherwise removed shall be replaced with cold applied bituminous coating compound. Aluminum surfaces that are to be in contact with concrete shall be painted with one coat of zinc chromate primer or two coats of asphalt.

   Materials - (Aluminum Pipe) - This pipe and its appurtenances shall conform to the requirements of AASHTO Specifications M-196 or M-211 with watertight coupling bands or flanges. Aluminum Pipe, when used with Flowable Fill or when soil and/or water conditions warrant the need for increased durability, shall be fully bituminous coated per requirements of AASHTO Specification M-190 Type A. Aluminum surfaces that are to be in contact with concrete shall be painted with one coat of zinc chromate primer or two coats of asphalt. Hot dip galvanized bolts not be used for connections. The pH of the surrounding soils shall be between 4 and 9.

2. Coupling bands, anti-seep collars, end sections, etc., must be composed of the same material and coted as the pipe. Metals must be insulated from dissimilar materials with use of rubber or plastic insulating materials at at least 24 mils in thickness.

3. Connections - All connections with pipes must be completely watertight. The drain pipe or barrel connection to the riser shall be welded all around when the pipe and riser are metal. Anti-seep collars shall be connected to the pipe in such a manner as to be completely watertight. Dimple bands are not considered to be watertight.

   All connections shall use a rubber or neoprene gasket when joining pipe sections. The end of each pipe shall be re-rolled an adequate number of corrugations to accommodate the band width. The following type connections are acceptable for pipes less than 24" in diameter. Flanges on both ends of the pipe with a circular 3/8 inch closed cell neoprene gasket, prepunched to the flange bolt circle, sandwiched between adjacent flanges; a 12 inch wide standard lap type band with 12 inch wide by 3/8 inch thick closed cell circular neoprene gasket; and a 12 inch wide hugger type band with o-ring gaskets having a minimum diameter of 1/2 inch greater than the corrugation depth. Pipes 24 inches in diameter and larger shall be connected by a 24 inch long annular corrugated band using a minimum of 4 (four) rods and lugs, 2 on each connecting pipe ends. A 24 inch wide by 3/8 inch thick closed cell circular neoprene gasket will be installed with 12 inch on the end of each pipe. Flanged joints with 3/8 inch closed cell gaskets the full width of the flange is also acceptable.

   Helically corrugated pipe shall have either continuously welded seams or have lock seams with internal caulking or a neoprene bead.

4. Bedding - The pipe shall be firmly and uniformly bedded throughout its entire length. Where rock or soft, spongy or other unstable soil is encountered, all such material shall be removed and replaced with suitable earth compacted to provide adequate support.

5. Backfilling shall conform to "Structure Backfill.".

6. Other details (anti-seep collars, valves, etc.) shall be as shown on the drawings.

Reinforced Concrete Pipe - All of the following criteria shall apply for reinforced concrete pipe:

1. Materials - Reinforced concrete pipe shall have bell and spigot joints with rubber gaskets and shall equal or exceed ASTM Designation C-361.

2. Bedding - All reinforced concrete pipe conduits shall be laid in a concrete bedding/cradle for their entire length. This bedding/cradle shall consist of high slump concrete placed under the pipe and up the side of the pipe at least 50% of its outside diameter with a minimum thickness of 6 inches. Where a concrete cradle is not needed for structural reasons, Flowable Fill may be used as described in the "Structure Backfill" section of this standard. Gravel bedding is not permitted.

3. Laying pipe - Bell and spigot pipe shall be placed with the bell end upstream. Joints shall be made in accordance with recommendations of the manufacturer of the material. After the joints are sealed for the entire line, the bedding shall be placed so that all spaces under the pipe are filled. Care shall be exercised to prevent any deviation from the original line and grade of the pipe. The first joint must be located within 4 feet from the riser.

4. Backfilling shall conform to "Structure Backfill.".

5. Other details (anti-seep collars, valves, etc.) shall be as shown on the drawings.

Plastic Pipe - The following criteria shall apply for pipe:

1. Materials - PVC pipe shall be PVC-1120 or PVC-1220 conforming to ASTM D-1785 or ASTM D-2241. Corrugated High Density Polyethylene (HDPE) pipe, couplings and fittings shall conform to the following: 4 - 10 inch pipe shall meet the requirements of AASHTO M252 Type S, and 12" through 24" shall meet the requirements of AASHTO M294 Type S.

2. Joints and connections to anti-seep collars shall be completely watertight.

3. Bedding - The pipe shall be firmly and uniformly bedded throughout its entire length. Where rock or soft, spongy or other unstable soil is encountered, all such material shall be removed and replaced with suitable earth compacted to provide adequate support.

4. Backfilling shall conform to Structure "Backfill".

5. Other details (anti-seep collars, valves, etc.) shall be as shown on the drawings.

CONCRETE

Concrete shall meet the requirements of Maryland Department of Transportation, State Highway Administration Standard Specifications for Construction and Materials, Section 414, Mix No. 3.

ROCK RIPRAP

Rock riprap shall meet the requirements of Maryland Department of Transportation, State Highway Administration Standard Specifications for Construction, and Materials, Section 311.

Geotextile shall be placed under all riprap and shall meet the requirements of Maryland Department of Transportation, State Highway Administration Standard Specifications for Construction and Materials, Section 921.09, Class C.

CARE OF WATER DURING CONSTRUCTION

All work on permanent structures shall be carried out in areas free from water. The Contractor shall construct and maintain all temporary dikes, levees, cofferdams, drainage channels, and stream diversions necessary to protect the areas to be occupied by the permanent works. The contractor shall also furnish, install, operate, and maintain all necessary pumping and other equipment required for removal of water from the various parts of the work and for maintaining the excavations, foundation, and other parts of the work free from water as required or directed by the engineer for constructing each part of the work. After having served their purpose, all temporary protective works shall be removed or leveled and graded to the extent required to prevent obstruction in any degree whatsoever of the flow of water to the spillway or outlet works and so as not to interfere in any way with the operation or maintenance of the structure. Stream diversions shall be maintained until the full flow can be passed through the permanent works. The removal of water from the required excavation and the foundation shall be accomplished in a manner and to the extent that will maintain stability of the excavated slopes and bottom of required excavations and will allow satisfactory performance of all construction operations. During the placing and compacting of material in required excavations, the water level at the locations being refilled shall be maintained below the bottom of the excavation at such locations which may require draining the water to sumps from which the water shall be pumped.

STABILIZATION

All borrow areas shall be graded to provide proper drainage and left in a slightly condition. All exposed surfaces of the embankment, spillway, spoil and borrow areas, and berms shall be stabilized by seeding, liming, fertilizing and mulching in accordance with the Natural Resources Conservation Service Standards and Specifications for Critical Area Planting (MD-342) or as shown on the accompanying drawings.

EROSION AND SEDIMENT CONTROL

Construction operations will be carried out in such a manner that erosion will be controlled and water and air pollution minimized. State and local laws concerning pollution abatement will be followed. Construction plans shall detail erosion and sediment control measures.

Refer to the 1994 MARYLAND STANDARDS AND SPECIFICATIONS FOR SOIL EROSION AND SEDIMENT CONTROL for rate and methods not covered.

TEMPORARY SEEDING NOTES

Apply to graded or cleared areas likely to be redisturbed where a short-term vegetative cover is needed.

Seedbed Preparation : Loosen upper three inches of soil by raking, discing or other acceptable means before seeding, if not previously loosened.

Soil Amendments : Apply 600 lbs. per acre 10-10-10 fertilizer (14 lbs. per 1000 sq.ft.).

Seeding : For periods March 1 thru April 30 and from August 15 thru November 15, seed with 2-1/2 bushels per acre of annual rye (3.2 lbs. per 1000 sq.ft.). For the period May 1 thru August 14, seed with 3 lbs. per acre of weeping lovegrass (0.07 lbs. per 1000 sq.ft.). For the period November 16 thru February 28, protect site by applying 2 tons per acre of well anchored straw mulch and seed as soon as possible in the spring, or use sod.

Mulching : Apply 1-1/2 to 2 tons per acre (70 to 90 lbs. per 1000 sq.ft.) of unrotted small grain straw immediately after seeding. Anchor mulch immediately after application using mulch anchoring tool or 218 gal. per acre (5 gal. per 1000 sq.ft.) of emulsified asphalt on flat areas. On slopes, 8 ft. or higher, use 347 gal. per acre (8 gal. per 1000 sq.ft.) for anchoring.

Refer to the 1994 MARYLAND STANDARDS AND SPECIFICATIONS FOR SOIL EROSION AND SEDIMENT CONTROL for rate and methods not covered.

PERMANENT SEEDING NOTES

Apply to graded or cleared areas not subject to immediate further disturbance where a permanent long-lived vegetative cover is needed.

Seedbed Preparation : Loosen upper three inches of soil by raking, discing or other acceptable means before seeding, if not previously loosened.

Soil Amendments : In lieu of soil test recommendations, use one of the following schedules :

1) Preferred - Apply 2 tons per acre dolomitic limestone (92 lbs. per 1000 sq.ft.) and 600 lbs. per acre 10-10-10 fertilizer (14 lbs. per 1000 sq.ft.) before seeding. Harrow or disc into upper three inches of soil. At time of seeding, apply 400 lbs. per acre 30-0-0 ureaform fertilizer (9 lbs. per 1000 sq.ft.).

2) Acceptable - Apply 2 tons per acre dolomitic limestone (92 lbs. per 1000 sq.ft.) and 1000 lbs. per acre 10-10-10 fertilizer (23 lbs. per 1000 sq.ft.) before seeding. Harrow or disc into upper three inches of soil.

Seeding : For the period March 1 thru April 30 and from August 1 thru October 15, seed with 60 lbs. per acre (1.4 lbs. per 1000 sq.ft.) of Kentucky 31 Tall Fescue. For the period May 1 thru July 31, seed with 60 lbs. Kentucky 31 Tall Fescue per acre and 2 lbs. per acre (0.05 lbs. per 1000 sq.ft.) of weeping lovegrass. During the period October 16 thru February 28, protect site by one of the following options :

1) 2 tons per acre of well-anchored mulch straw and seed as soon as possible in the spring.

2) Use sod.

3) Seed with 60 lbs. per acre Kentucky 31 Tall Fescue and mulch with 2 tons per acre well anchored straw.

Mulching : Apply 1-1/2 to 2 tons per acre (70 to 90 lbs. per 1000 sq.ft.) of unrotted small grain straw immediately after seeding. Anchor mulch immediately after application using mulch anchoring tool or 218 gal. per acre (5 gal. per 1000 sq.ft.) of emulsified asphalt on flat areas. On slopes, 8 ft. or higher, use 347 gal. per acre (8 gal. per 1000 sq.ft.) for anchoring.

Maintenance : Inspect all seeded areas and make needed repairs, replacements and reseedings.

OPERATION, MAINTENANCE AND INSPECTION

INSPECTION OF THE POND SHOWN HEREON SHALL BE PERFORMED AT LEAST ONCE ANNUALLY, IN ACCORDANCE WITH THE CHECKLIST AND REQUIREMENTS CONTAINED WITHIN USDA, SCS "STANDARDS AND SPECIFICATION FOR PONDS" (MD378). THE POND OWNER AND ANY HEIRS, SUCCESSORS, OR ASSIGNS SHALL BE RESPONSIBLE FOR THE SAFETY OF THE POND AND THE CONTINUED OPERATION, SURVEILLANCE, INSPECTION, AND MAINTENANCE THEREOF. THE POND OWNER SHALL PROMPTLY NOTIFY THE SOIL CONSERVATION DISTRICT OF ANY UNUSUAL OBSERVATIONS THAT MAY BE INDICATIONS OF DISTRESS SUCH AS EXCESSIVE SEEPAGE, TURBID SEEPAGE, SLIDING OR SLUMPING.

21.0 STANDARD AND SPECIFICATIONS FOR TOPSOIL

Definition

Placement of topsoil over a prepared subsoil prior to establishment of permanent vegetation.

Purpose

To provide a suitable soil medium for vegetative growth. Soils of concern have low moisture content, low nutrient levels, low pH, materials toxic to plants, and/or unacceptable soil gradation.

Conditions Where Practice Applies

I. This practice is limited to areas having 2:1 or flatter slopes where:
   a. The texture of the exposed subsoil/parent material is not adequate to produce vegetative growth.
   b. The soil material is so shallow that the rooting zone is not deep enough to support plants or furnish continuing supplies of moisture and plant nutrients.
   c. The original soil to be vegetated contains material toxic to plant growth.
   d. The soil is so acidic that treatment with limestone is not feasible.

II. For the purpose of these Standards and Specifications, areas having slopes steeper than 2:1 require special consideration and design for adequate stabilization. Areas having slopes steeper than 2:1 shall have the appropriate stabilization shown on the plans.

Construction and Material Specifications

I. Topsoil salvaged from the existing site may be used provided that it meets the standards as set forth in these specifications. Typically, the depth of topsoil to be salvaged for a given soil type can be found in the representative soil profile section in the Soil Survey published by USDA-SCS in cooperation with Maryland Agricultural Experimentation Station.

II. Topsoil Specifications - Soil to be used as topsoil must meet the following:

   i. Topsoil shall be a loam, sandy loam, clay loam, silt loam, sandy clay loam, loamy sand. Other soils may be used if recommended by an agronomist or soil scientist and approved by the appropriate approval authority. Regardless, topsoil shall not be a mixture of contrasting textured subsoils and shall contain not less than 5% by volume of cinders, stones, slag, coarse fragments, gravel, sticks, roots, trash, or other materials larger than 1½" in diameter.

   ii. Topsoil must be free of plants or plant parts such as bermuda grass, quackgrass, Johnsongrass, nutsedge, poison ivy, thistle, or others as specified.

   iii. Where subsoil is either highly acidic or composed of heavy clays, ground limestone shall be spread at the rate of 4-8 tons/acre (200-400 pounds per 1,000 square feet) prior to the placement of topsoil. Lime shall be distributed uniformly over designated areas and worked into the soil in conjunction with tillage operations as described in the following procedures.

II. For sites having disturbed areas under 5 acres:
   i. Place topsoil (if required) and apply soil amendments as specified in 20.0 Vegetative Stabilization - Section I - Vegetative Stabilization Methods and Materials.

III. For sites having disturbed areas over 5 acres:

   i. On soil meeting Topsoil specifications, obtain test results dictating fertilizer and lime amendments required to bring the soil into compliance with the following:
      a. pH for topsoil shall be between 6.0 and 7.5. If the tested soil demonstrates a pH of less than 6.0, sufficient lime shall be prescribed to raise the pH to 6.5 or higher.
      b. Organic content of topsoil shall be not less than 1.5 percent by weight.
      c. Topsoil having soluble salt content greater than 500 parts per million shall not be used.
      d. No sod or seed shall be placed on soil which has been treated with soil sterilants or chemicals held for weed control until sufficient time has elapsed (14 days min.) to permit dissipation of phyto-toxic materials.

Note: Topsoil substitutes to amendments, as recommended by a qualified agronomist or soil scientist and approved by the appropriate approval authority may be used in lieu of natural topsoil.

   ii. Place topsoil (if required) and apply soil amendments as specified in 20.0 Vegetative Stabilization - Section I - Vegetative Stabilization Methods and Materials.

V. Topsoil Application

   i. When topsoiling, maintain needed erosion and sediment control practices such as diversions, Grade Stabilization Structures, Earth Dikes, Slope Silt Fence and Sediment Traps and Basins.

   ii. Grades on the areas to be topsoiled, which have been previously established, shall be maintained, albeit 4" - 8" higher in elevation.

   iii. Topsoil shall be uniformly distributed in a 4" - 8" layer and lightly compacted to a minimum thickness of 4". Spreading shall be performed in such a manner that sodding or seeding can proceed with a minimum of additional soil preparation and tillage. Any irregularities in the surface resulting from topsoiling or other operations shall be corrected in order to prevent the formation of depressions or water pockets.

   iv. Topsoil shall not be placed while the topsoil or subsoil is in a frozen or muddy condition, when the subsoil is excessively wet or in a condition that may otherwise be detrimental to proper grading and seedbed preparation.

VI. Alternative for Permanent Seeding - Instead of applying the full amounts of lime and commercial fertilizer, composted sludge and amendments may be applied as specified below:

   i. Composted Sludge Material for use as a soil conditioner for sites having disturbed areas over 5 acres shall be tested to prescribe amendments and for site having disturbed areas under 5 acres shall conform to the following requirements:
      a. Composted sludge shall be supplied by, or originate from, a person or persons that are permitted (at the time of acquisition of the compost) by the Maryland Department of the Environment under COMAR 26.04.06.
      b. Composted sludge shall contain at least 1 percent nitrogen, 1.5 percent phosphorus, and 0.2 percent potassium and have a pH of 7.0 to 8.0. If compost does not meet these requirements, the appropriate constituents must be added to meet the requirements prior to use.
      c. Composted sludge shall be applied at a rate of 1 ton/1,000 square feet.
      d. Composted sludge shall be amended with a potassium fertilizer applied at the rate of 4 lb/1,000 square feet, and 1/3 the normal lime application rate.

References: Guideline Specifications, Soil Preparation and Sodding. MD-VA, Pub. #1, Cooperative Extension Service, University of Maryland and Virginia Polytechnic Institutes. Revised 1973.

GEOTECHNICAL RECOMMENDATIONS

EARTHWORK OPERATIONS

THE NATURAL MOISTURE CONTENT OF THE FILL MATERIALS ON SITE WAS GENERALLY ABOVE THE OPTIMUM MOISTURE CONTENT. BASED ON THESE CONDITIONS, SIGNIFICANT DRYING OF THE SOIL BY DISCING AND AERATION OR OTHER MEANS OF MANIPULATION CAN BE ANTICIPATED DURING THE EARTHWORK PROCESS. THE MICACEOUS COMPONENT OF THE ON-SITE SOILS MAKES IT SUSCEPTIBLE TO LOSS OF STRENGTH UPON EXPOSURE TO FREE WATER. THEREFORE, IT WOULD BE PRUDENT TO SCHEDULE CLEARING AND GRUBBING, STRIPPING, AND EARTHWORK OPERATIONS FOR THE WARMER, DRYER PERIODS OF THE YEAR IF POSSIBLE SO THAT CONSTRUCTION SCHEDULES WILL NOT BE DELAYED DUE TO INCLEMENT WEATHER.

ALL FILL PLACED FOR THE EMBANKMENT, UTILITY BACKFILL, OR ANY OTHER LOCATION REQUIRING STABLE SUPPORT OR MINIMAL SETTLEMENT SHALL BE CONSTRUCTED AS CONTROLLED COMPACTED FILL. CONTROLLED COMPACTED FILL AND FOUNDATION EXCAVATIONS SHALL MEET THE FOLLOWING REQUIREMENTS:

A) WITHIN THE DESCRIBED CONSTRUCTION AREAS, STRIP THE VEGETATION, TOPSOIL, AND ANY ORGANIC, CONTAMINATED, OR OTHERWISE UNSUITABLE MATERIALS TO EXPOSE CLEAN SOILS. THE SUBJECT AREA SHALL ENCOMPASS THE SWM POND AND EXTEND OUTWARD FROM THE EDGES A MINIMUM OF 5 FEET PLUS 1 ADDITIONAL FOOT HORIZONTALLY FOR EVERY FOOT OF NEW FILL TO BE PLACED, OR CUT TO BE EXCAVATED.

B) PROOFROLL THE STRIPPED SOIL SURFACE WITH A FULLY LOADED, TANDEM-AXLE DUMP TRUCK, OR OTHER APPROVED EQUIPMENT, UNDER THE OBSERVATION OF A GEOTECHNICAL ENGINEER OR HIGHLY QUALIFIED SENIOR LEVEL SOILS TECHNICIAN, TO VERIFY AND ESTABLISH A UNIFORM, DENSE AND STABLE CONDITION. ANY SOFT, YIELDING, ORGANIC, CONTAMINATED, OR OTHERWISE UNACCEPTABLE SPOTS DETECTED SHALL BE OVEREXCAVATED AND REPLACED WITH CONTROLLED COMPACTED FILL.

C) ANY MATERIAL USED FOR CONTROLLED FILL SHALL BE INSPECTED AND APPROVED FOR USE BY A GEOTECHNICAL ENGINEER OR QUALIFIED SOILS TECHNICIAN PRIOR TO USE ON THE SITE. ALL FILL SHALL BE FREE FROM TOPSOIL, BOULDERS, COBBLES, ROOTS, ORGANIC MATTER, AND DEBRIS. PRELIMINARY APPROVAL OF THE BORROW MATERIAL SHALL NOT CONSTITUTE GENERAL ACCEPTANCE OF ALL MATERIALS IN THE DEPOSIT OR SOURCE OF SUPPLY, AND THE ACCEPTANCE SHALL BE SUBJECT TO FIELD TESTS TAKEN AT THE DISCRETION OF THE GEOTECHNICAL ENGINEER OR QUALIFIED SOILS TECHNICIAN.

D) COMPACTED FILL SHOULD BE PLACED IN HORIZONTAL, SUCCESSIVE, UNIFORM LAYERS HAVING A MAXIMUM UNCOMPACTED LIFT THICKNESS OF 8 INCHES. EACH LIFT SHOULD BE COMPACTED UNIFORMLY TO A MINIMUM OF 95 PERCENT OF THE STANDARD PROCTOR MAXIMUM DRY DENSITY AS DETERMINED BY AASHTO T-99 (ASTM D-698). THE MOISTURE CONTENT OF THE MATERIALS SHALL BE MAINTAINED WITHIN 3% OF THE OPTIMUM MOISTURE CONTENT IN ORDER TO ATTAIN THE REQUIRED DEGREE OF COMPACTION. EACH LIFT SHOULD BE UNIFORMLY AND EVENLY BLADE MIXED DURING SPREADING TO ENSURE UNIFORMITY OF THE MATERIAL IN EACH LAYER. IF THE WORK DETERIORATES PRIOR TO PLACEMENT OF THE NEXT LIFT, THE LAYER SHALL BE RECOMPACTED AND RESHAPED ACCORDINGLY.

E) SUCCESSIVE LIFTS OF COMPATCED FILL SHALL NOT BE PLACED UNTIL THE LAYER UNDER CONSTRUCTION HAS BEEN COMPACTED TO THE REQUIRED DENSITY AS MEASURED BY A GEOTECHNICAL ENGINEER OR QUALIFIED SOILS TECHNICIAN. SUCCESSIVE RUNS OF EQUIPMENT SHALL BE STAGGERED OVER THE WIDTH OF EACH LAYER.

F) WHERE FILLS ARE TO BE PLACED ON SLOPES, THE ORIGINAL GROUND SHOULD BE DEEPLY SCARIFIED OR WHERE SLOPES ARE STEEPER THAN 5:1 THE SLOPE SHOULD BE STEPPED OR BENCHED, WHEN CONSIDERED NECESSARY BY THE ENGINEER, IN ORDER THAT THE PLACEMENT OF FILL MAY BE ACCOMPLISHED IN HORIZONTAL LIFTS.

IT IS NOTED THAT THIS METHODOLOGY IS RECOMMENDED BOTH AS PREPARATION FOR AREAS TO RECEIVE NEW FILL, AS WELL AS, LOCATIONS WHERE CUT IS REQUIRED TO ESTABLISH THE PROPOSED GRADES SUCH AS FOUNDATION EXCAVATIONS. IN CUT AREAS, THE PROOFROLLING AND SELECTIVE UNDERCUTTING SHALL BE ACCOMPLISHED AFTER EXCAVATION DOWN TO THE PROPOSED GRADES HAS BEEN COMPLETED.

STANDARD SEDIMENT CONTROL NOTES

1. A MINIMUM OF 48 HOURS NOTICE MUST BE GIVEN TO THE HOWARD COUNTY DEPARTMENT OF INSPECTIONS, LICENSES AND PERMITS, SEDIMENT CONTROL DIVISION PRIOR TO THE START OF ANY CONSTRUCTION (313-1855).
2. ALL VEGETATIVE AND STRUCTURAL PRACTICES ARE TO BE INSTALLED ACCORDING TO THE PROVISIONS OF THIS PLAN AND ARE TO BE IN CONFORMANCE WITH THE 1994 MARYLAND STANDARDS AND SPECIFICATIONS FOR SOIL EROSION AND SEDIMENT CONTROL AND REVISIONS THERETO.
3. FOLLOWING INITIAL SOIL DISTURBANCE OR RE-DISTURBANCE, PERMANENT OR TEMPORARY STABILIZATION SHALL BE COMPLETED WITHIN: A) 7 CALENDAR DAYS FOR ALL PERIMETER SEDIMENT CONTROL STRUCTURES, DIKES, PERIMETER SLOPES, AND ALL SLOPES STEEPER THAN 3:1, B) 14 DAYS AS TO ALL OTHER DISTURBED OR GRADED AREAS ON THE PROJECT SITE.
4. ALL SEDIMENT TRAPS/BASINS SHOWN MUST BE FENCED AND WARNING SIGNS POSTED AROUND THE PERIMETER IN ACCORDANCE WITH VOL. 1, CHAPTER 7, OF THE HOWARD COUNTY DESIGN MANUAL, STORM DRAINAGE.
5. ALL DISTURBED AREAS MUST BE STABILIZED WITHIN THE TIME PERIOD SPECIFIED ABOVE IN ACCORDANCE WITH THE 1994 MARYLAND STANDARDS AND SPECIFICATIONS FOR SOIL EROSION AND SEDIMENT CONTROL FOR PERMANENT SEEDING, SOD, TEMPORARY SEEDING, AND MULCHING (SEC. 16.). TEMPORARY STABILIZATION WITH MULCH ALONE SHALL ONLY BE DONE WHEN RECOMMENDED SEEDING DATES DO NOT ALLOW FOR PROPER GERMINATION AND ESTABLISHED OF GRASSES.
6. ALL SEDIMENT CONTROL STRUCTURES ARE TO REMAIN IN PLACE AND ARE TO BE MAINTAINED IN OPERATIVE CONDITION UNTIL PERMISSION FOR THEIR REMOVAL HAS BEEN OBTAINED FROM THE HOWARD COUNTY SEDIMENT CONTROL INSPECTOR.
7. SITE ANALYSIS:

TOTAL AREA OF SITE	12.35 ACRES
AREA DISTURBED	7.4 ACRES
AREA TO BE ROOFED OR PAVED	0.4 ACRES
AREA TO BE VEGETATIVELY STABILIZED	7.0 ACRES
TOTAL CUT	11400 CU. YARDS
TOTAL FILL	4900 CU. YARDS

OFFSITE WASTE AREA LOCATION TO HAVE ACTIVE GRADING PERMIT.

8. ANY SEDIMENT CONTROL PRACTICE WHICH IS DISTURBED BY GRADING ACTIVITY FOR PLACEMENT OF UTILITIES MUST BE REPAIRED ON THE SAME DAY OF DISTURBANCE.
9. ADDITIONAL SEDIMENT CONTROLS MUST BE PROVIDED, IF DEEMED NECESSARY BY THE HOWARD COUNTY SEDIMENT CONTROL INSPECTOR.
10. ON ALL SITES WITH DISTURBED AREAS IN EXCESS OF 2 ACRES, APPROVAL OF THE INSPECTION AGENCY SHALL BE REQUESTED UPON COMPLETION OF INSTALLATION OF PERIMETER EROSION AND SEDIMENT CONTROLS, BUT BEFORE PROCEEDING WITH ANY OTHER EARTH DISTURBANCE OR GRADING. OTHER BUILDING OR GRADING INSPECTION APPROVALS MAY NOT BE AUTHORIZED UNTIL THIS INITIAL APPROVAL BY THE INSPECTION AGENCY IS MADE.
11. TRENCHES FOR THE CONSTRUCTION OF UTILITIES IS LIMITED TO THREE PIPE LENGTHS OR THAT WHICH SHALL BE BACK-FILLED AND STABILIZED WITHIN ONE WORKING DAY, WHICHEVER IS SHORTER.
12. SITE GRADING WILL BEGIN ONLY AFTER ALL PERIMETER SEDIMENT CONTROL MEASURES HAVE BEEN INSTALLED AND ARE IN A FUNCTIONING CONDITION.
13. SEDIMENT WILL BE REMOVED FROM TRAPS WHEN ITS DEPTH REACHES CLEAN OUT ELEVATION SHOWN ON THE PLANS.
14. CUT AND FILL QUANTITIES PROVIDED UNDER SITE ANALYSIS DO NOT REPRESENT BID QUANTITIES. THESE QUANTITIES DO NOT DISTINGUISH BETWEEN TOPSOIL, STRUCTURAL FILL OR EMBANKMENT MATERIAL, NOR DO THEY REFLECT CONSIDERATION OF UNDERCUTTING OR REMOVAL OF UNSUITABLE MATERIAL. THE CONTRACTOR SHALL FAMILIARIZE HIMSELF WITH SITE CONDITIONS WHICH MAY AFFECT THE WORK.

SEQUENCE OF CONSTRUCTION

1. OBTAIN GRADING PERMIT AND NOTIFY MARYLAND DEPARTMENT OF ENVIRONMENTAL NONTIDAL WETLANDS AND WATERWAYS INSPECTIONS AND COMPLIANCE SECTIONS AT 410-631-3510 AT LEAST FIVE (5) DAYS IN ADVANCE OF BEGINNING ANY SANITARY SEWER WORK IN STREAMS, 100-YR FLOOD PLAIN, NONTIDAL WETLANDS, AND WETLAND BUFFERS (FROM EX MH-440 TO SMH-2).
2. CLEAR AND GRUB FOR SEDIMENT AND EROSION CONTROL MEASURES OR DEVICES ONLY WITH THE SEDIMENT CONTROL INSPECTOR'S PERMISSION FOR CONSTRUCTION OF SEWER FROM EX MH-440 TO SMH-2. (* - SEE BELOW) (1 WEEK)
3. INSTALL STABILIZED CONSTRUCTION ENTRANCE, EARTH DIKES, SILT FENCE, TREE PROTECTION FENCE AND SEDIMENT BASIN NO. 1. (5 WEEKS)
4. RELOCATE DRAIN AT GORMAN ROAD BEFORE GRADING PARCEL A. PERFORM ROUGH GRADING OF PARCEL A AND INSTALL STORM DRAINS, SEWER AND WATER. (8 WEEKS)
5. INSTALL CURB AND GUTTER AND PAVE ROADWAYS. (3 WEEKS)
6. APPLY TOPSOIL AND STABILIZE DISTURBED AREAS IN ACCORDANCE WITH PERMANENT SEEDING NOTES. (2 WEEKS)
7. PERFORM LANDSCAPING, LIGHTING AND SIDEWALKS. (1 WEEK)
8. UPON PERMISSION OF COUNTY SEDIMENT CONTROL INSPECTOR, REMOVE ALL REMAINING SEDIMENT CONTROL DEVICES AND CONVERT SEDIMENT BASIN TO PERMANENT STORM WATER MANAGEMENT FACILITY. CONVERT FACILITY IN THE FOLLOWING STEPS:
   A. CLEAN STORM DRAIN INLETS AND FLUSH OUT PIPES. (3 DAYS)
   B. PUMP OUT STANDING WATER IN BASIN USING PUMPING STATION. (2 DAYS)
   C. REMOVE TEMPORARY DEWATERING DEVICE AND PLYWOOD. (1 DAY)
   D. INSTALL 4" STEEL ELBOW. (1 DAY)
   E. REMOVE ACCUMULATED SEDIMENT (2 DAYS)
   F. STABILIZE REMAINING DISTURBED AREAS IN ACCORDANCE WITH PERMANENT SEEDING NOTES. (3 DAYS)

*REFER TO "CONDITIONS AND MANAGEMENT PRACTICES FOR WORKING IN NONTIDAL WETLANDS AND BUFFERS" (SEE BELOW)

"Conditions and Management Practices for Working In Nontidal Wetlands and Buffers"

a) Remove excavated material, construction material or debris to an upland disposal area outside of any waterway, floodplain, nontidal wetland, or buffer;

b) If backfill is obtained, use clean material free of waste metal products, unsightly debris, toxic material, or any other deleterious substance.

c) Place materials in a location and manner which does not adversely impact surface or subsurface water flow into or out of the nontidal wetland;

d) Maintain the hydrologic regime of nontidal wetlands outside the limits of disturbance.

e) Rectify any nontidal wetlands and buffers temporarily impacted by the permitted activity. All stabilization in the wetland and buffer shall be of the following recommended species: Annual Ryegrass (Lolium multiflorum), Millet (Setaria italica), Oats (Uniola sp.). and/or Rye (Secale cereale). Other non-persistent vegetation may be acceptable, but must be appro

DETAIL 24 - STABILIZED CONSTRUCTION ENTRANCE

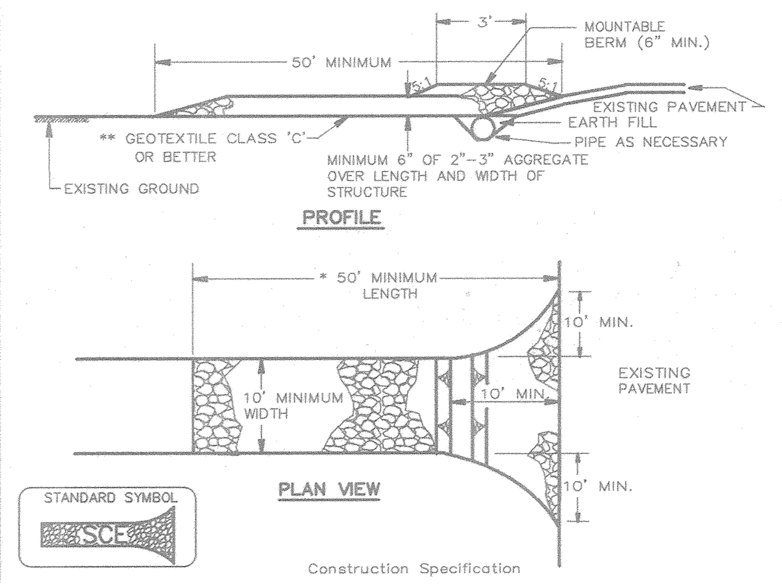

Construction Specification

1. Length – minimum of 50' (*30' for single residence lot).

2. Width – 10' minimum, should be flared at the existing road to provide a turning radius.

3. Geotextile fabric (filter cloth) shall be placed over the existing ground prior to placing stone. **The plan approval authority may not require single family residences to use geotextile.

4. Stone – crushed aggregate (2" to 3") or reclaimed or recycled concrete equivalent shall be placed at least 6" deep over the length and width of the entrance.

5. Surface Water – all surface water flowing to or diverted toward construction entrances shall be piped through the entrance, maintaining positive drainage. Pipe installed through the stabilized construction entrance shall be protected with a mountable berm with 5:1 slopes and a minimum of 6" of stone over the pipe. Pipe has to be sized according to the drainage. When the SCE is located at a high spot and has no drainage to convey a pipe will not be necessary. Pipe should be sized according to the amount of runoff to be conveyed. A 6" minimum will be required.

6. Location – A stabilized construction entrance shall be located at every point where construction traffic enters or leaves a construction site. Vehicles leaving the site must travel over the entire length of the stabilized construction entrance.

U.S. DEPARTMENT OF AGRICULTURE SOIL CONSERVATION SERVICE	PAGE F - 17 - 3	MARYLAND DEPARTMENT OF ENVIRONMENT WATER MANAGEMENT ADMINISTRATION

DETAIL 30 - EROSION CONTROL MATTING

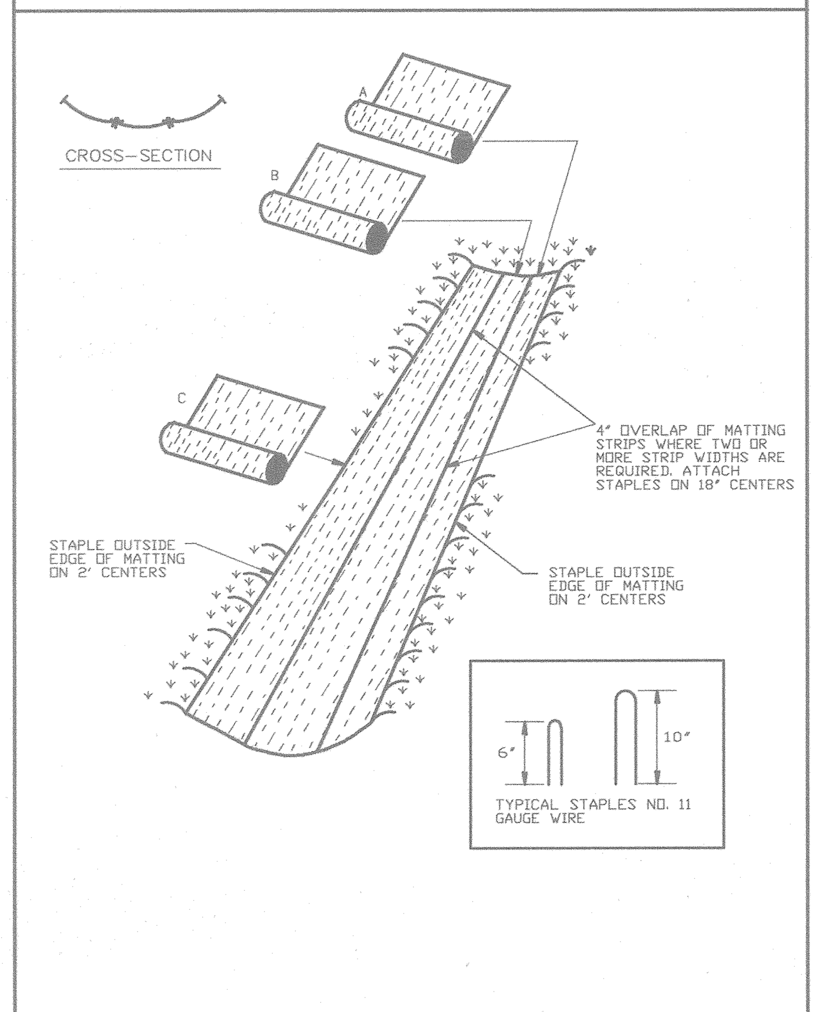

U.S. DEPARTMENT OF AGRICULTURE SOIL CONSERVATION SERVICE	PAGE G - 22 - 2	MARYLAND DEPARTMENT OF ENVIRONMENT WATER MANAGEMENT ADMINISTRATION

DETAIL 33 - SUPER SILT FENCE

NOTE: FENCE POST SPACING SHALL NOT EXCEED 10' CENTER TO CENTER

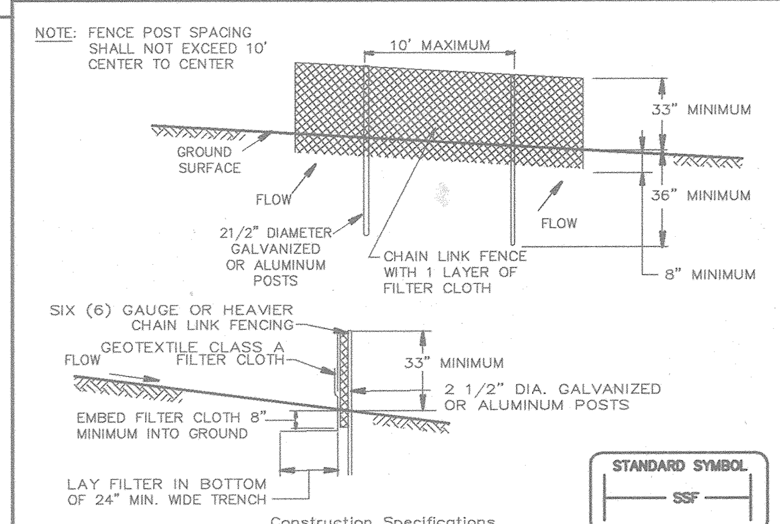

Construction Specifications

1. Fencing shall be 42" in height and constructed in accordance with the latest Maryland State Highway (SHA) Details for Chain Link Fencing. The SHA specifications for a 6 foot fence shall be used, substituting 42" fabric and 6 foot length posts.

2. The posts do not need to be set in concrete.

3. Chain link fence shall be fastened securely to the fence posts with wire ties or staples. The lower tension wire, brace and truss rods, drive anchors and post caps are not required except on the ends of the fence. The chain link fencing shall be six (6) gauge or heavier.

4. Filter cloth shall be fastened securely to the chain link fence with ties spaced every 24" at the top and mid section.

5. Filter cloth shall be embedded a minimum of 8" into the ground.

6. When two sections of geotextile fabric adjoin each other, they shall be overlapped by 6" and folded.

7. Maintenance shall be performed as needed and silt buildups removed when "bulges" develop in the silt fence, or when silt reaches 50% of fence height

U.S. DEPARTMENT OF AGRICULTURE SOIL CONSERVATION SERVICE	PAGE H - 26 - 3	MARYLAND DEPARTMENT OF ENVIRONMENT WATER MANAGEMENT ADMINISTRATION

DETAIL 22 - SILT FENCE

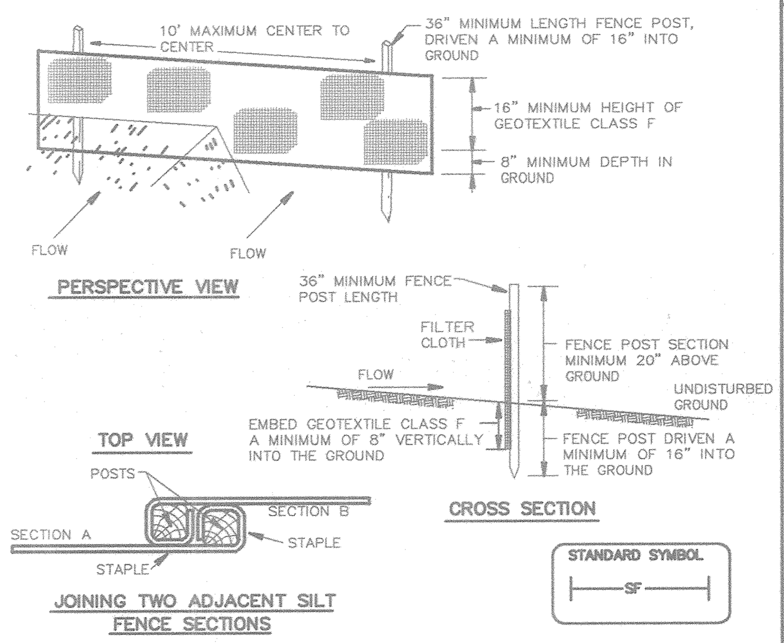

Construction Specifications

1. Fence posts shall be a minimum of 36" long driven 16" minimum into the ground. Wood posts shall be 11/2" x 11/2" square (minimum) cut, or 13/4" diameter (minimum) round and shall be of sound quality hardwood. Steel posts will be standard T or U section weighting not less than 1.00 pond per linear foot.

2. Geotextile shall be fastened securely to each fence post with wire ties or staples at top and mid-section and shall meet the following requirements for Geotextile Class F:

Tensile Strength	50 lbs/in (min.)	Test: MSMT 509
Tensile Modulus	20 lbs/in (min.)	Test: MSMT 509
Flow Rate	0.3 gal ft ^{2}/ minute (max.)	Test: MSMT 322
Filtering Efficiency	75% (min.)	Test: MSMT 322

3. Where ends of geotextile fabric come together, they shall be overlapped, folded and stapled to prevent sediment bypass.

4. Silt Fence shall be inspected after each rainfall event and maintained when bulges occur or when sediment accumulation reached 50% of the fabric height.

U.S. DEPARTMENT OF AGRICULTURE SOIL CONSERVATION SERVICE	PAGE E - 15 - 3	MARYLAND DEPARTMENT OF ENVIRONMENT WATER MANAGEMENT ADMINISTRATION

EROSION CONTROL MATTING

Construction Specifications

1. Key-in the matting by placing the top ends of the matting in a narrow trench, 6" in depth. Backfill the trench and tamp firmly to conform to the channel cross-section. Secure with a row of staples about 4" down slope from the trench. Spacing between staples is 6".

2. Staple the 4" overlap in the channel center using an 18" spacing between staples.

3. Before stapling the outer edges of the matting, make sure the matting is smooth and in firm contact with the soil.

4. Staples shall be placed 2' apart with 4 rows for each strip, 2 outer rows, and 2 alternating rows down the center.

5. Where one roll of matting ends and another begins, the end of the top strip shall overlap the upper end of the lower strip by 4", shiplap fashion. Reinforce the overlap with a double row of staples spaced 6" apart in a staggered pattern on either side.

6. The discharge end of the matting liner should be similarly secured with 2 double rows of staples.

Note: If flow will enter from the edge of the matting then the area effected by the flow must be keyed-in.

U.S. DEPARTMENT OF AGRICULTURE SOIL CONSERVATION SERVICE	PAGE G - 22 - 2A	MARYLAND DEPARTMENT OF ENVIRONMENT WATER MANAGEMENT ADMINISTRATION

30.0 - DUST CONTROL

DEFINITION

CONTROLLING DUST BLOWING AND MOVEMENT ON CONSTRUCTION SITES AND ROADS.

PURPOSE

TO PREVENT BLOWING AND MOVEMENT OF DUST FROM EXPOSED SOIL SURFACES, REDUCE ON AND OFF-SITE DAMAGE, HEALTH HAZARDS, AND IMPROVE TRAFFIC SAFETY.

CONDITIONS WHERE PRACTICE APPLIES

THIS PRACTICE IS APPLICABLE TO AREAS SUBJECT TO DUST BLOWING AND MOVEMENT WHERE ON OFF-SITE DAMAGE IS LIKELY WITHOUT TREATMENT.

SPECIFICATIONS

TEMPORARY METHODS

1. MULCHES – SEE STANDARDS FOR VEGETATIVE STABILIZATION WITH MULCHES ONLY. MULCH SHOULD BE CRIMPED OR TACKED TO PREVENT BLOWING.
2. VEGATATIVE COVER – SEE STANDARDS FOR TEMPORARY VEGETATIVE COVER.
3. TILLAGE – TO ROUGHEN SURFACE AND BRING CLODS TO THE SURFACE. THIS IS AN EMERGENCY MEASURE WHICH SHOULD BE USED BEFORE SOIL BLOWING STARTS. BEGIN PLOWING ON WINDWARD SIDE OF SITE. CHISEL-TYPE PLOWS SPACED ABOUT 12" APART, SPRING-TOOTHED HARROWS, AND SIMILIAR PLOWS ARE EXAMPLES OF EQUIPMENT WHICH MAY PRODUCE THE DESIRED EFFECT.
4. IRRIGATION – THIS IS GENERALLY DONE AS AN EMERGENGY TREATMENT. SITE IS SPRINKLED WITH WATER UNTIL THE SURFACE IS MOIST. REPEAT AS NEEDED. AT NO TIME SHOULD THE SITE BE IRRIGATED TO THE POINT THAT RUNOFF BEGINS TO FLOW.
5. BARRIERS – SOLID BOARD FENCES, SILT FENCES, SNOW FENCES, BURLAP FENCES, STRAW BALES, AND SIMILIAR MATERIAL CAN BE USED TO CONTROL AIR CURRENTS AND SOIL BLOWING. BARRIERS PLACED AT RIGHT ANGLES TO PREVAILING CURRENTS AT INTERVALS OF ABOUT 10 TIMES THEIR HEIGHT ARE EFFECTIVE IN CONTROLLING SOIL BLOWING.
6. CALCIUM CHLORIDE – APPLY AT RATES THAT WILL KEEP SURFACE MOIST. MAY NEED RETREATMENT.

PERMANENT METHODS

1. PERMANENT VEGETATION – SEE STANDARDS FOR PERMANENT VEGETATIVE COVER, AND PERMANENT STABILIZATION WITH SOD. EXISTING TREES OR LARGE SHRUBS MAY AFFORD VALUABLE PROTECTION IF LEFT IN PLACE.
2. TOPSOILING – COVERING WITH LESS EROSIVE SOIL MATERIALS. SEE STANDARDS FOR TOPSOILING.
3. STONE – COVER SURFACE WITH CRUSHED STONE OR COARSE GRAVEL.

REFERENCES

1. AGRICULTURE HANDBOOK 346. WIND EROSION FORCES IN THE UNITED STATES AND THEIR USES IN PREDICTING SOIL LOSS.
2. AGRICULTURE INFORMATION BULLETIN 354. HOW TO CONTROL WIND EROSION, USDA-ARS.

U.S. DEPARTMENT OF AGRICULTURE SOIL CONSERVATION SERVICE	PAGE H - 30 - 1	MARYLAND DEPARTMENT OF ENVIRONMENT WATER MANAGEMENT ADMINISTRATION

DETAIL 1 - EARTH DIKE

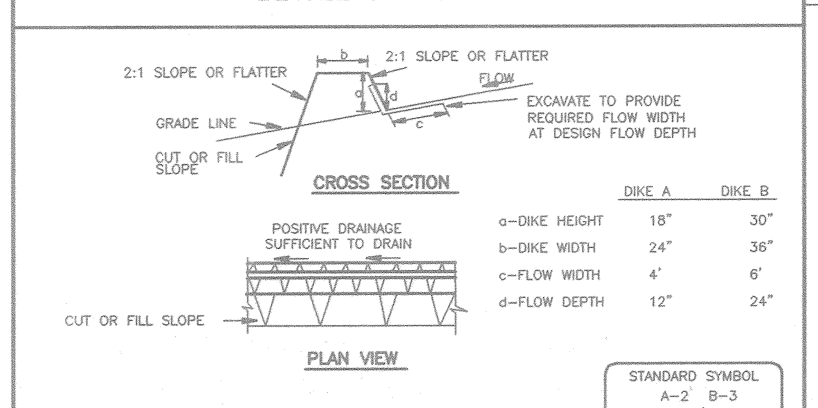

	DIKE A	DIKE B
a-DIKE HEIGHT	18"	30"
b-DIKE WIDTH	24"	36"
c-FLOW WIDTH	4'	6'
d-FLOW DEPTH	12"	24"

FLOW CHANNEL STABILIZATION
GRADE 0.5% MIN. 10% MAX.

1. Seed and cover with straw mulch.
2. Seed and cover with Erosion Control Matting or line with sod.
3. 4" – 7" stone or recycled concrete equivalent pressed into the soil 7" minimum

Construction Specifications

1. All temporary earth dikes shall have uninterrupted positive grade to an outlet. Spot elevations may be necessary for grades less than 1%.

2. Runoff diverted from a disturbed area shall be conveyed to a sediment trapping device.

3. Runoff diverted from an undisturbed area shall outlet directly into an undisturbed, stabilized area at a non-erosive velocity.

4. All trees, brush, stumps, obstructions, and other objectional material shall be removed and disposed of so as not to interfere with the proper functioning of the dike.

5. The dike shall be excavated or shaped to line, grade and cross section as required to meet the criteria specified herein and be free of bank projections or other irregularities which will impede normal flow.

6. Fill shall be compacted by earth moving equipment.

7. All earth removed and not needed for construction shall be placed so that it will not interfere with the functioning of the dike.

8. Inspection and maintenance must be provided periodically and after each rain event.

U.S. DEPARTMENT OF AGRICULTURE SOIL CONSERVATION SERVICE	PAGE A - 1 - 6	MARYLAND DEPARTMENT OF ENVIRONMENT WATER MANAGEMENT ADMINISTRATION

DETAIL 23C - CURB INLET PROTECTION

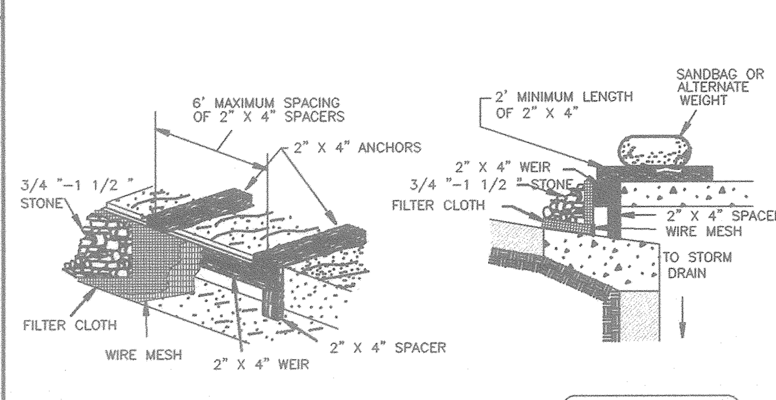

MAX. DRAINAGE AREA = 1/4 ACRE

Construction Specifications

1. Attach a continuous piece of wire mesh (30" minimum width by throat length plus 4') to the 2" x 4" weir (measuring throat length plus 2') as shown on the standard drawing.

2. Place a continuous piece of Geotextile Class E the same dimensions as the wire mesh over the wire mesh and securely attach it to the 2" x 4" weir.

3. Securely nail the 2" X 4" weir to a 9" long vertical spacer to be located between the weir and the inlet face (max. 4' apart).

4. Place the assembly against the inlet throat and nail (minimum 2' lengths of 2" x 4" to the top of the weir at spacer locations). These 2" x 4" anchors shall extend across the inlet top and be held in place by sandbags or alternate weight.

5. The assembly shall be placed so that the end spacers are a minimum 1' beyond both ends of the throat opening.

6. Form the 1/2 " x 1/2 " wire mesh and the geotextile fabric to the concrete gutter and against the face of the curb on both sides of the inlet. Place clean 3/4 " x 1 1/2 " stone over the wire mesh and geotextile in such a manner to prevent water from entering the inlet under or around the geotextile.

7. This type of protection must be inspected frequently and the filter cloth and stone replaced when clogged with sediment.

8. Assure that storm flow does not bypass the inlet by installing a temporary earth or asphalt dike to direct the flow to the inlet.

U.S. DEPARTMENT OF AGRICULTURE SOIL CONSERVATION SERVICE	PAGE E - 16 - 5B	MARYLAND DEPARTMENT OF ENVIRONMENT WATER MANAGEMENT ADMINISTRATION

DETAIL 5 - RIP-RAP INFLOW PROTECTION

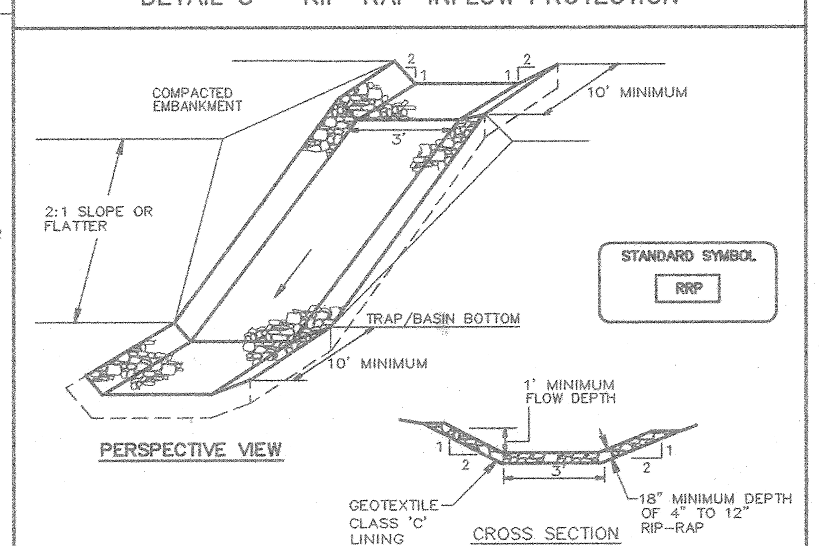

Construction Specifications

1. Rip-rap lined inflow channels shall be 1' in depth, have a trapezoidal cross section with 2:1 or flatter side slopes and 3' (min.) bottom width. The channel shall be lined with 4" to 12" rip- rap to a depth of 18".

2. Filter cloth shall be installed under all rip-rap. Filter cloth shall be Geotextile Class C.

3. Entrance and exit sections shall be installed as shown on the detail section.

4. Rip-rap used for the lining may be recycled for permanent outlet protection if the basin is to be converted to a stormwater management facility.

5. Gabion Inflow Protection may be used in lieu of Rip-rap Inflow Protection.

6. Rip-rap should blend into existing ground.

7. Rip-rap Inflow Protection shall be used where the slope is between 4:1 and 10:1, for slopes flatter than 10:1 use Earth Dike or Temporary Swale lining criteria.

U.S. DEPARTMENT OF AGRICULTURE SOIL CONSERVATION SERVICE	PAGE B - 6 - 2	MARYLAND DEPARTMENT OF ENVIRONMENT WATER MANAGEMENT ADMINISTRATION

STRUCTURE SCHEDULE

STRUCTURE	TYPE	LOCATION	INV. IN	INV. OUT	TOP	REMARKS
I-1	A-5 2.5'WIDE	N 536020.38 E 1354240.34	349.00 (18") 349.60 (15")	348.90 (18")	353.2	HOCO STD. DETAIL SD-4.40
I-2	A-5 2.5'WIDE	N 536001.53 E 1354273.34	–	350.00 (15")	353.2	HOCO STD. DETAIL SD-4.40
I-3	A-5 2.5'WIDE	N 536314.22 E 1354349.20	350.90 (15")	350.65 (18")	354.9	HOCO STD. DETAIL SD-4.40
I-4	A-5 2.5'WIDE	N 536294.83 E 1354401.74	–	351.25 (15")	354.9	HOCO STD. DETAIL SD-4.40
M-1	4'-0" DIA.	N 536258 E 1353793	328.10 (24")	328.00 (24")	332.5	HOCO STD. DETAIL G-5.11
M-2	4'-0" DIA.	N 536132 E 1354013	340.46 (18") 340.46 (18")	340.36 (18")	346.0	HOCO STD. DETAIL G-5.11
M-3	4'-0" DIA.	N 536019 E 1354218	348.78 (18")	348.68 (18")	352.8	HOCO STD. DETAIL G-5.11
M-4	4'-0" DIA.	N 536193 E 1354307	350.03 (18")	349.93 (18")	355.6	HOCO STD. DETAIL G-5.11
M-5	4'-0" DIA.	N 536491 E 1353942	342.20 (15")	342.10 (15")	346.0	HOCO STD. DETAIL G-5.11
M-6	4'-0" DIA.	N 536482 E 1353968	342.44 (15")	342.34 (15")	346.0	HOCO STD. DETAIL G-5.11
M-7	4'-0" DIA.	N 536218 E 1353858	331.68 (18") 331.68 (18")	331.18 (24")	335.0	HOCO STD. DETAIL G-5.11
E-1	24" ADS END SECTION	N 536176 E 1353742	327.50 (24")	–	–	HOCO STD. DETAIL SD-5.51
E-2	36" TYPE 'A' HEADWALL	N 535580 E 1353326	305.00 (36")	–	–	HOCO STD. DETAIL SD-5.11
E-3	15"ADS END SECTION	N 536470 E 1353932	341.98 (15")	–	–	HOCO STD. DETAIL SD-5.51
S-1	MODIFIED STRUCTURE	N 535630 E 1353331	305.4 (8")	305.4 (36")	314.17	SEE SHEET 14

NOTES:
FOR END SECTIONS AND HEADWALLS THE LOCATION IS CENTER OF THROAT OPENING AT FACE OF STRUCTURE.
LOCATION OF INLETS AND MANHOLES IS AT CENTER OF TOP COVER; FOR "A" INLETS LOCATION IS GIVEN FOR CENTER OF THROAT OPENING AT FACE OF CURB;

PIPE SCHEDULE

PIPE LENGTH	SIZE	TYPE
104	15"	ADS, N-12
776	18"	ADS, N-12
168	24"	ADS, N-12
50	36"	RCCP

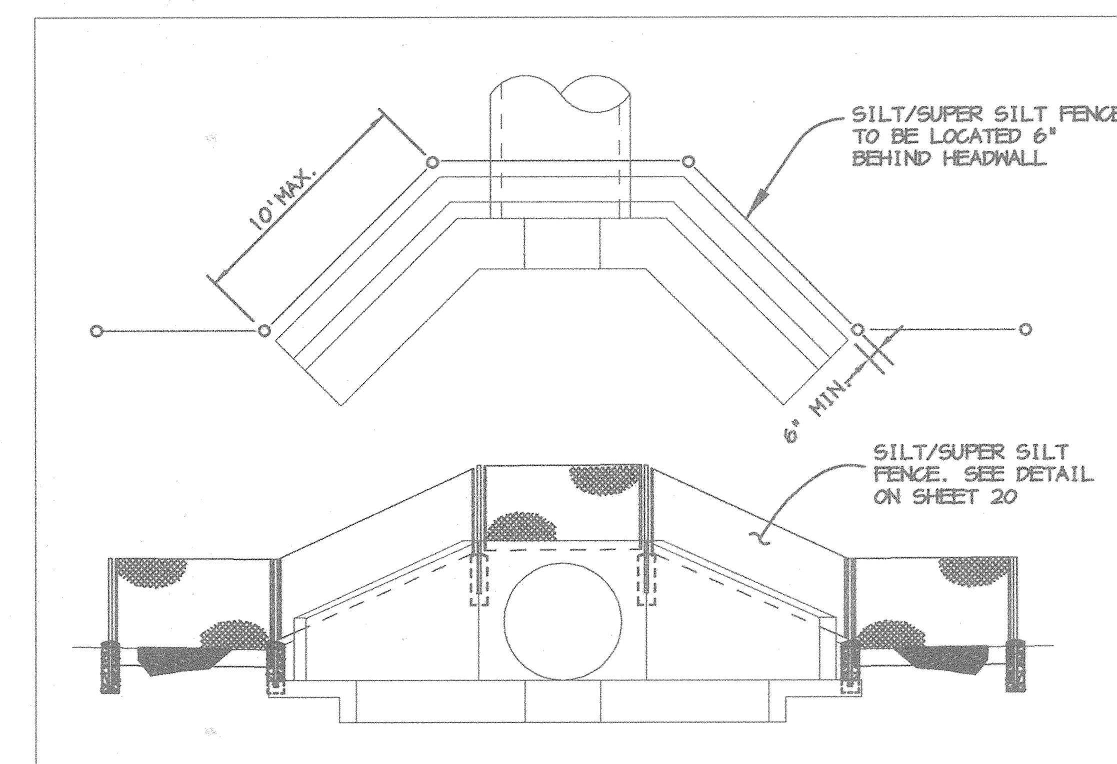

SILT FENCE TYPICAL DETAIL OVER HEADWALLS
SCALE: NO SCALE

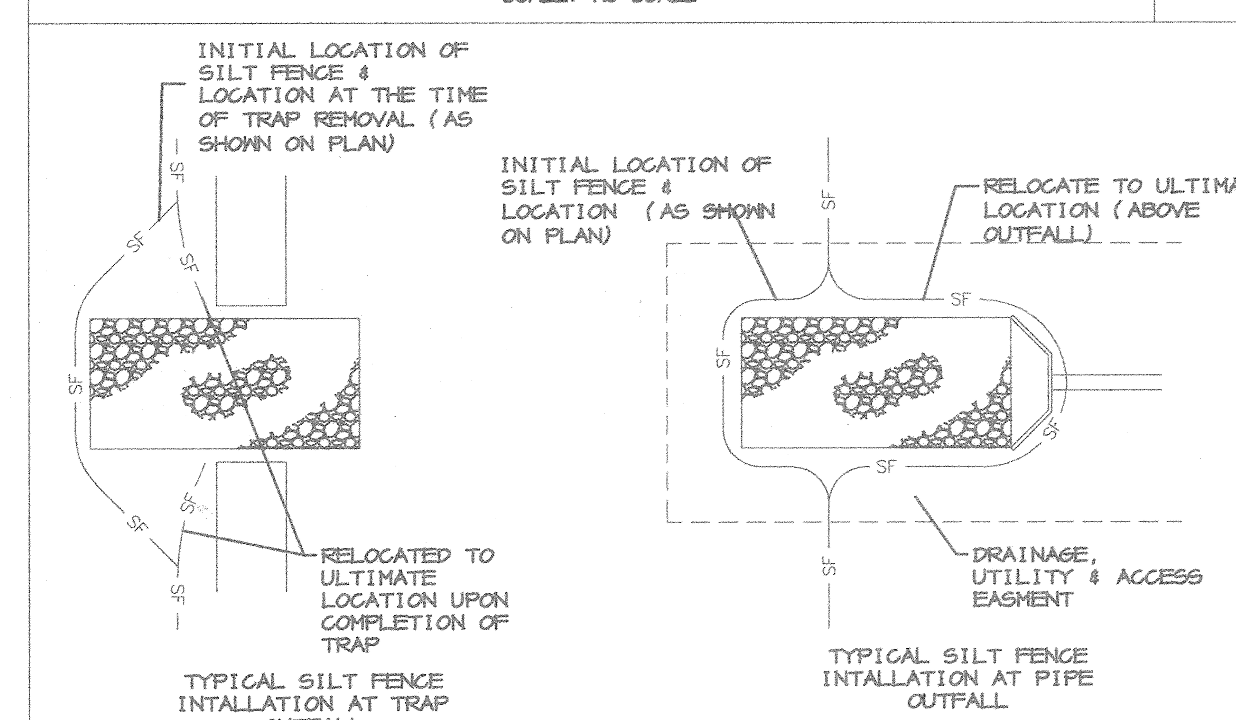

SILT FENCE OUTFALL PROTECTION
SCALE: NO SCALE

ROAD ... AS-BUILT ... G. SCOTT ... PROF. L.S. # ...

SHANABERGER & LANE
8726 TOWN & COUNTRY BLVD.
SUITE 201
ELLICOTT CITY, MARYLAND 21043

RIPRAP TO BE EMBEDDED IN PROPOSED TRANSITION SECTION

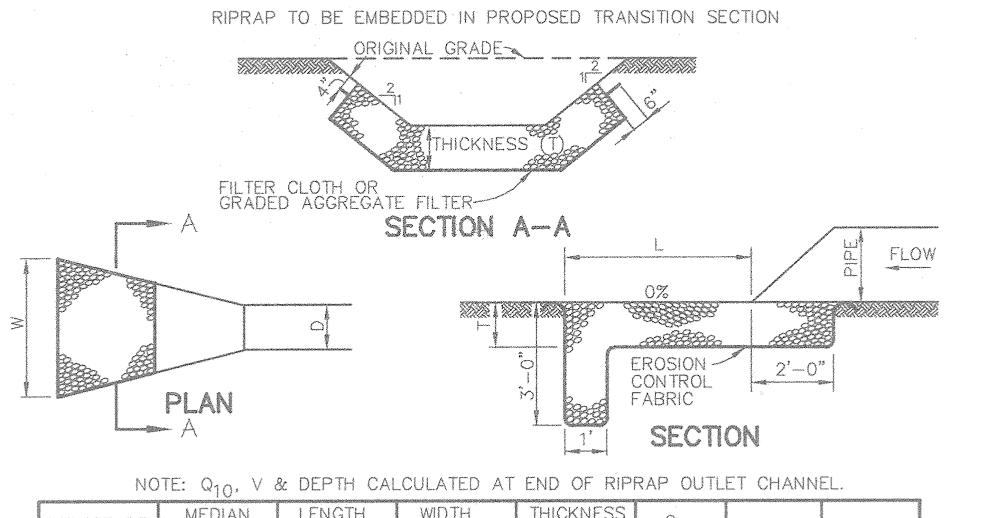

NOTE: Q_{10}, V & DEPTH CALCULATED AT END OF RIPRAP OUTLET CHANNEL.

STRUCTURE	MEDIAN STONE DIA.	LENGTH (L)	WIDTH (W)	THICKNESS (T)	Q_{10}	V_P	DEPTH
E-1	9.5" CL 1	12'	10'	19"	12.41	5.8	1.30
E-2	9.5" CL 1	12'	10'	19"	51.92	9.48	2.13
E-3	9.5" CL 1	12'	10'	19"	3.51	4.1	0.83

RIPRAP OUTLET PROTECTION DETAIL

NO SCALE

CONSTRUCTION SPECIFICATIONS

1. THE SUBGRADE FOR THE FILTER, RIP-RAP, OR GABION SHALL BE PREPARED TO THE REQUIRED LINES AND GRADES. ANY FILL REQUIRED IN THE SUBGRADE SHALL BE COMPACTED TO A DENSITY OF APPROXIMATELY THAT OF THE SURROUNDING UNDISTURBED MATERIAL.

2. THE ROCK OR GRAVEL SHALL CONFORM TO THE SPECIFIED GRADING LIMITS WHEN INSTALLED RESPECTIVELY IN THE RIP-RAP OR FILTER.

3. GEOTEXTILE CLASS C OR BETTER SHALL BE PROTECTED FROM PUNCHING, CUTTING, OR TEARING. ANY DAMAGE OTHER THAN AN OCCASIONAL SMALL HOLE SHALL BE REPAIRED BY PLACING ANOTHER PIECE OF GEOTEXTILE FABRIC OVER THE DAMAGED WHETHER FOR REPAIRS OR FOR JOINING TWO PIECES OF GEOTEXTILE FABRIC SHALL BE A MINIMUM OF ONE FOOT.

4. STONE FOR THE RIP-RAP OR GABION OUTLETS MAY BE PLACED BY EQUIPMENT. THEY SHALL BE CONSTRUCTED TO THE FULL COURSE THICKNESS IN ONE OPERATION AND AND IN SUCH A MANNER AS TO AVOID DISPLACEMENT OF UNDERLYING MATERIALS. THE STONE FOR RIP-RAP OR GABION OUTLETS SHALL BE DELIVERED AND PLACED IN A MANNER THAT WILL ENSURE THAT IT IS REASONABLY HOMOGENOUS WITH THE SMALLER STONES AND SPALLS FILLING THE VOIDS BETWEEN THE LARGER STONES. RIP-RAP SHALL BE PLACED IN A MANNER TO PREVENT DAMANGE TO THE FILTER BLANKET OR GEOTEXTILE FABRIC.HAND PLACEMENT WILL BE REQUIRED TO THE EXTENT NECESSARY TO PREVENT DAMAGE TO THE PERMANENT WORKS.

5. THE STONE SHALL BE PLACED SO THAT IT BLENDS IN WITH THE EXISTING GROUND.IF THE STONE IS PLACED TOO HIGH THEN THE FLOW WILL BE FORCED OUT OF THE CHANNEL AND SCOUR ADJACENT TO THE STONE WILL OCCUR.

BY THE DEVELOPER :

I/WE CERTIFY THAT ALL DEVELOPMENT AND/OR CONSTRUCTION WILL BE DONE ACCORDING TO THESE PLANS, AND THAT ANY RESPONSIBLE PERSONNEL INVOLVED IN THE CONSTRUCTION PROJECT WILL HAVE A CERTIFICATE OF ATTENDANCE AT A DEPARTMENT OF THE ENVIRONMENT APPROVED TRAINING PROGRAM FOR THE CONTROL OF SEDIMENT AND EROSION BEFORE BEGINNING THE PROJECT. I SHALL ENGAGE A REGISTERED PROFESSIONAL ENGINEER TO SUPERVISE POND CONSTRUCTION AND PROVIDE THE HOWARD SOIL CONSERVATION DISTRICT WITH AN "AS-BUILT" PLAN OF THE POND WITHIN 30 DAYS OF COMPLETION. I ALSO AUTHORIZE PERIODIC ON-SITE INSPECTIONS BY THE HOWARD SOIL CONSERVATION DISTRICT.

DEVELOPER Paul Cavanaugh — DATE 10.18.02

BY THE ENGINEER :

I CERTIFY THAT THIS PLAN FOR POND CONSTRUCTION, EROSION AND SEDIMENT CONTROL REPRESENTS A PRACTICAL AND WORKABLE PLAN BASED ON MY PERSONAL KNOWLEDGE OF THE SITE CONDITIONS. THIS PLAN WAS PREPARED IN ACCORDANCE WITH THE REQUIREMENTS OF THE HOWARD SOIL CONSERVATION DISTRICT. I HAVE NOTIFIED THE DEVELOPER THAT HE/SHE MUST ENGAGE A REGISTERED PROFESSIONAL ENGINEER TO SUPERVISE POND CONSTRUCTION AND PROVIDE THE HOWARD SOIL CONSERVATION DISTRICT WITH AN "AS-BUILT" PLAN OF THE POND WITHIN 30 DAYS OF COMPLETION.

ENGINEER — DATE 10.18.02

THESE PLANS HAVE BEEN REVIEWED FOR THE HOWARD SOIL CONSERVATION DISTRICT AND MEET THE TECHNICAL REQUIREMENTS FOR SMALL POND CONSTRUCTION, SOIL EROSION AND SEDIMENT CONTROL.

NATURAL RESOURCES CONSERVATION SERVICE — DATE 10/30/02

THESE PLANS FOR SMALL POND CONSTRUCTION, SOIL EROSION AND SEDIMENT CONTROL MEET THE REQUIREMENTS OF THE HOWARD SOIL CONSERVATION DISTRICT.

HOWARD SOIL CONSERVATION DISTRICT — DATE 10/30/02

APPROVED : HOWARD COUNTY DEPARTMENT OF PUBLIC WORKS.

CHIEF, BUREAU OF HIGHWAYS — DATE 11-8-02

APPROVED : HOWARD COUNTY DEPARTMENT OF PLANNING AND ZONING.

CHIEF, DIVISION OF LAND DEVELOPMENT — DATE 11/20/02

CHIEF, DEVELOPMENT ENGINEERING DIVISION — DATE 11/14/02

DATE	NO.	REVISION

OWNER/DEVELOPER

THE HOWARD RESEARCH AND DEVELOPMENT CORPORATION
THE ROUSE BUILDING
10275 LITTLE PATUXENT PARKWAY
COLUMBIA, MARYLAND 21044
410-992-6000

PROJECT
EMERSON
SECTION THREE AREA TWO

AREA
TAX MAP 47 BLOCK 8 & 9
ZONED: PEC-MXD-3 PART OF PARCELS: 462 & 837
6th ELECTION DISTRICT HOWARD COUNTY, MARYLAND

TITLE
SEDIMENT CONTROL DETAILS

Patton Harris Rust & Associates,pc
Engineers. Surveyors. Planners. Landscape Architects.
8818 Centre Park Drive
Columbia, MD 21045
T 410.997.8900
F 410.997.9282

DATE 10.18.02

CHRISTOPHER J. REID #19949

DESIGNED BY :	A.C.R
DRAWN BY :	DAM
CHECKED BY :	C.J.R.
PERMIT TRACKING NUMBER	01-NT-0222/200164079
DATE :	OCTOBER 21, 2002
SCALE :	AS SHOWN
DRAWING NO.	5 OF 12

F-02-178 C-DETAILS1.DWG

P:\project\224561-0\Engr\Plans\FINALS\C-DETAILS1.dwg, Layout1, 10/17/02 02:30:17 PM, HP750C(36).pc3, Arch D - 24 x 36 in. (landscape), 1:1

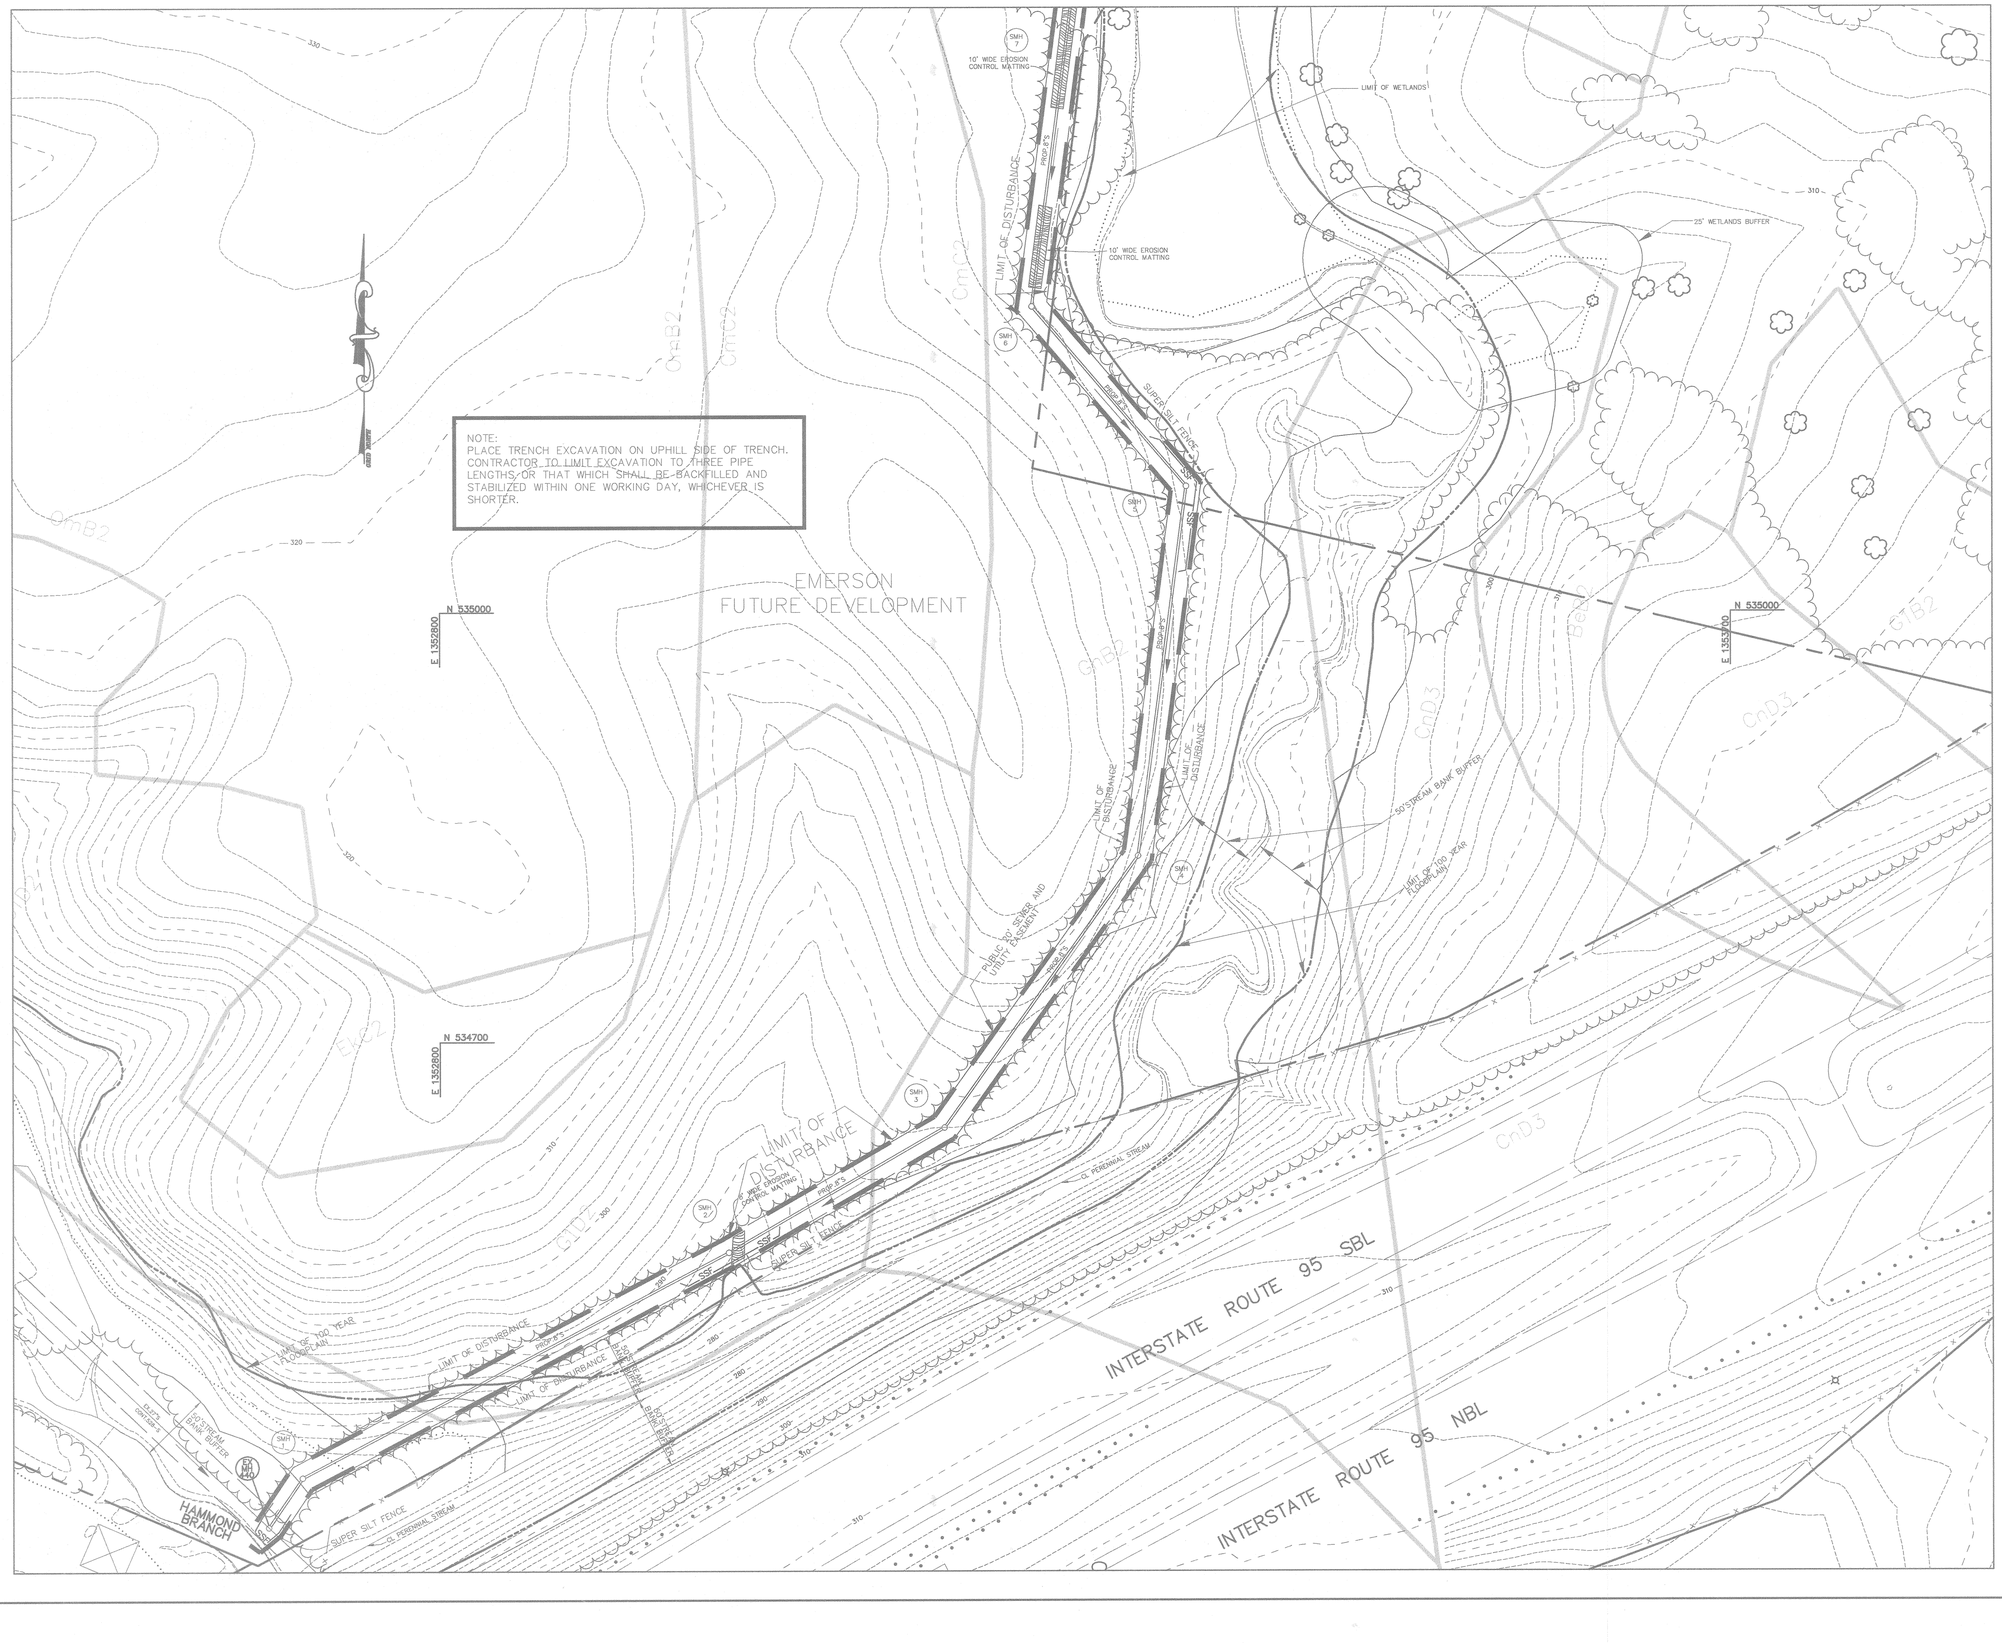

BY THE DEVELOPER :

I/WE CERTIFY THAT ALL DEVELOPMENT AND/OR CONSTRUCTION WILL BE DONE ACCORDING TO THESE PLANS, AND THAT ANY RESPONSIBLE PERSONNEL INVOLVED IN THE CONSTRUCTION PROJECT WILL HAVE A CERTIFICATE OF ATTENDANCE AT A DEPARTMENT OF THE ENVIRONMENT APPROVED TRAINING PROGRAM FOR THE CONTROL OF SEDIMENT AND EROSION BEFORE BEGINNING THE PROJECT. I SHALL ENGAGE A REGISTERED PROFESSIONAL ENGINEER TO SUPERVISE POND CONSTRUCTION AND PROVIDE THE HOWARD SOIL CONSERVATION DISTRICT WITH AN "AS-BUILT" PLAN OF THE POND WITHIN 30 DAYS OF COMPLETION. I ALSO AUTHORIZE PERIODIC ON-SITE INSPECTIONS BY THE HOWARD SOIL CONSERVATION DISTRICT.

DEVELOPER — DATE 10.18.02

PAUL CAVANAUGH

BY THE ENGINEER :

I CERTIFY THAT THIS PLAN FOR POND CONSTRUCTION, EROSION AND SEDIMENT CONTROL REPRESENTS A PRACTICAL AND WORKABLE PLAN BASED ON MY PERSONAL KNOWLEDGE OF THE SITE CONDITIONS. THIS PLAN WAS PREPARED IN ACCORDANCE WITH THE REQUIREMENTS OF THE HOWARD SOIL CONSERVATION DISTRICT. I HAVE NOTIFIED THE DEVELOPER THAT HE/SHE MUST ENGAGE A REGISTERED PROFESSIONAL ENGINEER TO SUPERVISE POND CONSTRUCTION AND PROVIDE THE HOWARD SOIL CONSERVATION DISTRICT WITH AN "AS-BUILT" PLAN OF THE POND WITHIN 30 DAYS OF COMPLETION.

ENGINEER — DATE 10.18.02

THESE PLANS HAVE BEEN REVIEWED FOR THE HOWARD SOIL CONSERVATION DISTRICT AND MEET THE TECHNICAL REQUIREMENTS FOR SMALL POND CONSTRUCTION, SOIL EROSION AND SEDIMENT CONTROL.

NATURAL RESOURCES CONSERVATION SERVICE — DATE 10/30/02

THESE PLANS FOR SMALL POND CONSTRUCTION, SOIL EROSION AND SEDIMENT CONTROL MEET THE REQUIREMENTS OF THE HOWARD SOIL CONSERVATION DISTRICT.

HOWARD SOIL CONSERVATION DISTRICT — DATE 10/30/02

APPROVED : HOWARD COUNTY DEPARTMENT OF PUBLIC WORKS.

CHIEF, BUREAU OF HIGHWAYS MKS — DATE 11-8-02

APPROVED : HOWARD COUNTY DEPARTMENT OF PLANNING AND ZONING.

CHIEF, DIVISION OF LAND DEVELOPMENT — DATE 11/20/02

CHIEF, DEVELOPMENT ENGINEERING DIVISION MK — DATE 11/14/02

DATE	NO.	REVISION

OWNER/DEVELOPER

THE HOWARD RESEARCH AND DEVELOPMENT CORPORATION
THE ROUSE BUILDING
10275 LITTLE PATUXENT PARKWAY
COLUMBIA, MARYLAND 21044
410-992-6000

PROJECT
EMERSON
SECTION THREE AREA TWO

AREA
TAX MAP 47 BLOCK 8 & 9
ZONED: PEC-MXD-3 PART OF PARCELS: 462 & 837
6th ELECTION DISTRICT HOWARD COUNTY, MARYLAND

TITLE
GRADING AND SEDIMENT CONTROL PLAN

Patton Harris Rust & Associates, pc
Engineers. Surveyors. Planners. Landscape Architects.
8818 Centre Park Drive
Columbia, MD 21045
T 410.997.8900
F 410.997.9282

10.18.02
DATE

STATE OF MARYLAND — CHRISTOPHER J. REID — No. 19949 — PROFESSIONAL ENGINEER

CHRISTOPHER J. REID #19949

DESIGNED BY :	A.C.R
DRAWN BY :	DAM
CHECKED BY :	C.J.R.
PERMIT TRACKING NUMBER	01-NT-0222/200164079
DATE :	OCTOBER 21, 2002
SCALE :	1"=50'
DRAWING NO.	4 OF 12

F-02-178

C-RD4.DWG

J:\project\224561.0\Engr\Plans\FINAL\SIC-RD4.dwg, Layout1, 10/17/02 02:26:23 PM, HP750C(36).pc3 Arch D 24 x 36 in (landscape), 1:1

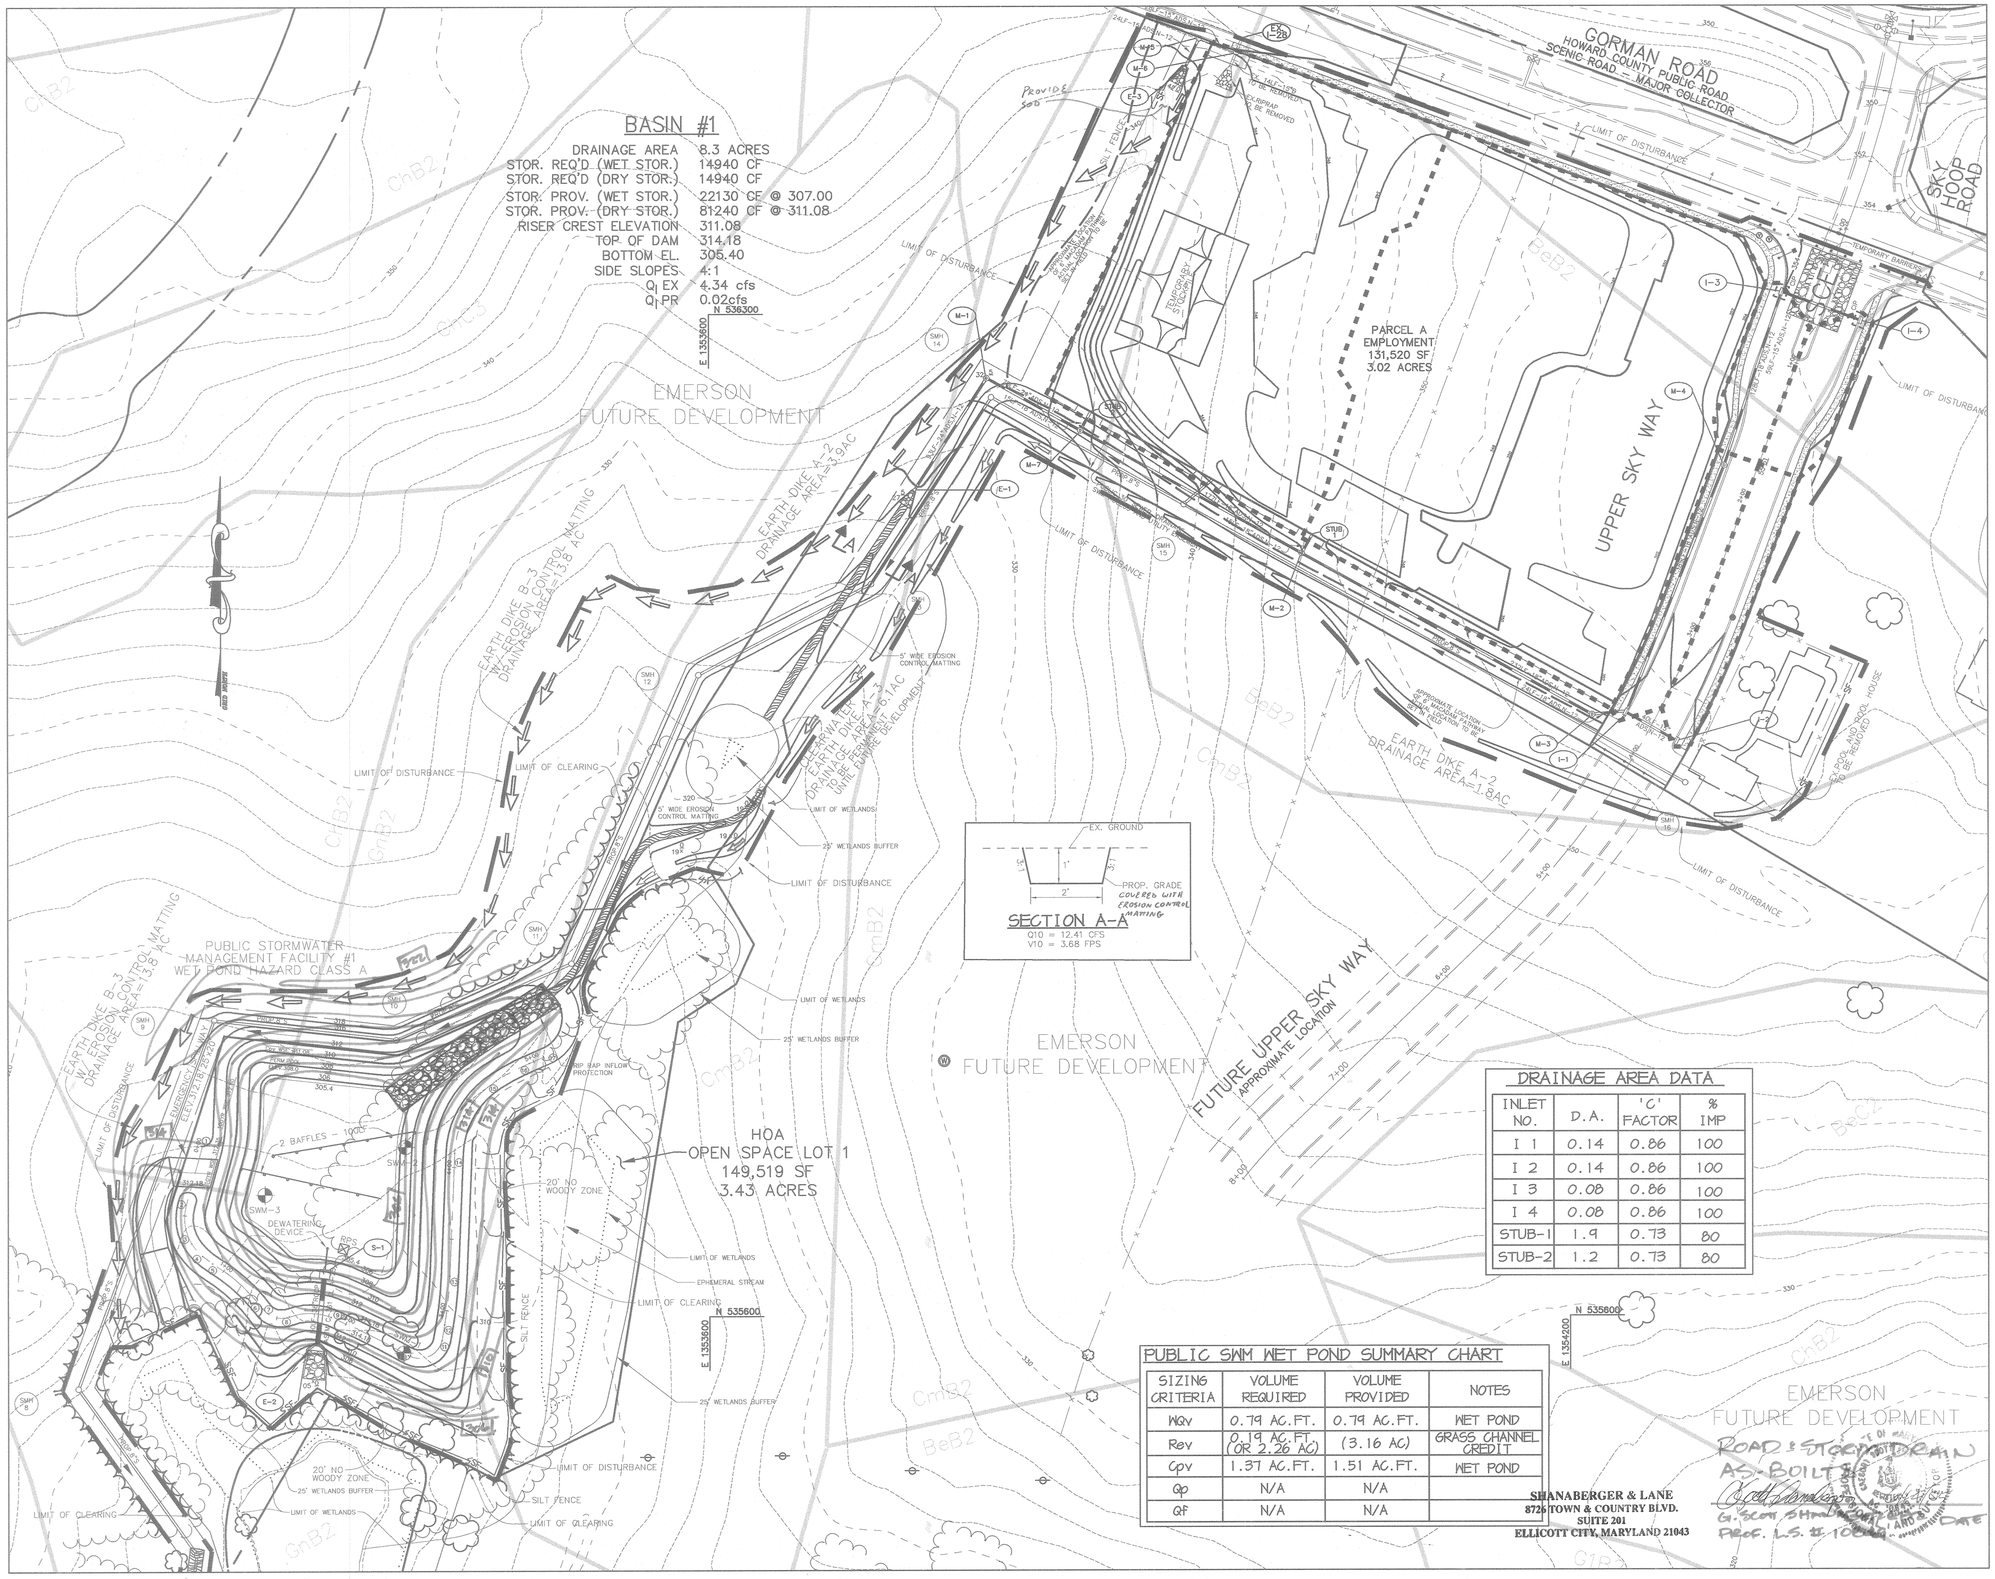

BASIN #1

DRAINAGE AREA	8.3 ACRES
STOR. REQ'D (WET STOR.)	14940 CF
STOR. REQ'D (DRY STOR.)	14940 CF
STOR. PROV. (WET STOR.)	22130 CF @ 307.00
STOR. PROV. (DRY STOR.)	81240 CF @ 311.08
RISER CREST ELEVATION	311.08
TOP OF DAM	314.18
BOTTOM EL.	305.40
SIDE SLOPES	4:1
Q_1 EX	4.34 cfs
Q_1 PR	0.02cfs

DAM CENTERLINE DATA

1	N 535719.79 E 1353246.46	9-10	R=518.61' L=54.98'
1-2	S 15°17'41"W 42.71'	10-11	R=15.98' L=24.77'
2-3	R=33.98' L=27.93'	11-12	R=11470.62' L=11.31'
3-4	R=36.43' L=11.48'	12-13	R=252.25' L=34.16'
4-5	R=76.76' L=8.83'	13-14	R=81417.31' L=85.75'
5-6	R=128.81' L=44.14'	14-15	R=63.05' L=60.67'
6-7	R=349.06' L=3.19'	15-16	R=159.21' L=26.13'
7-8	R=16.00' L=20.84'	16-17	N 66°24'46" E 10.87'
8-9	R=40.17' L=24.81'	17	N 535781.65 E 1353484.27

DRAINAGE AREA DATA

INLET NO.	D.A.	'C' FACTOR	% IMP
I 1	0.14	0.86	100
I 2	0.14	0.86	100
I 3	0.08	0.86	100
I 4	0.08	0.86	100
STUB-1	1.9	0.73	80
STUB-2	1.2	0.73	80

PUBLIC SWM WET POND SUMMARY CHART

SIZING CRITERIA	VOLUME REQUIRED	VOLUME PROVIDED	NOTES
WQv	0.79 AC.FT.	0.79 AC.FT.	WET POND
Rev	0.19 AC.FT. (OR 2.26 AC)	(3.16 AC)	GRASS CHANNEL CREDIT
Cpv	1.37 AC.FT.	1.51 AC.FT.	WET POND
Qp	N/A	N/A	
QF	N/A	N/A	

SHANABERGER & LANE
8726 TOWN & COUNTRY BLVD.
SUITE 201
ELLICOTT CITY, MARYLAND 21043

BY THE DEVELOPER :

I/WE CERTIFY THAT ALL DEVELOPMENT AND/OR CONSTRUCTION WILL BE DONE ACCORDING TO THESE PLANS, AND THAT ANY RESPONSIBLE PERSONNEL INVOLVED IN THE CONSTRUCTION PROJECT WILL HAVE A CERTIFICATE OF ATTENDANCE AT A DEPARTMENT OF THE ENVIRONMENT APPROVED TRAINING PROGRAM FOR THE CONTROL OF SEDIMENT AND EROSION BEFORE BEGINNING THE PROJECT. I SHALL ENGAGE A REGISTERED PROFESSIONAL ENGINEER TO SUPERVISE POND CONSTRUCTION AND PROVIDE THE HOWARD SOIL CONSERVATION DISTRICT WITH AN "AS-BUILT" PLAN OF THE POND WITHIN 30 DAYS OF COMPLETION. I ALSO AUTHORIZE PERIODIC ON-SITE INSPECTIONS BY THE HOWARD SOIL CONSERVATION DISTRICT.

DEVELOPER — DATE 10-18-02
PAUL CAVANAUGH

BY THE ENGINEER :

I CERTIFY THAT THIS PLAN FOR POND CONSTRUCTION, EROSION AND SEDIMENT CONTROL REPRESENTS A PRACTICAL AND WORKABLE PLAN BASED ON MY PERSONAL KNOWLEDGE OF THE SITE CONDITIONS. THIS PLAN WAS PREPARED IN ACCORDANCE WITH THE REQUIREMENTS OF THE HOWARD SOIL CONSERVATION DISTRICT. I HAVE NOTIFIED THE DEVELOPER THAT HE/SHE MUST ENGAGE A REGISTERED PROFESSIONAL ENGINEER TO SUPERVISE POND CONSTRUCTION AND PROVIDE THE HOWARD SOIL CONSERVATION DISTRICT WITH AN "AS-BUILT" PLAN OF THE POND WITHIN 30 DAYS OF COMPLETION.

ENGINEER — DATE 10-18-02

THESE PLANS HAVE BEEN REVIEWED FOR THE HOWARD SOIL CONSERVATION DISTRICT AND MEET THE TECHNICAL REQUIREMENTS FOR SMALL POND CONSTRUCTION, SOIL EROSION AND SEDIMENT CONTROL.

NATURAL RESOURCES CONSERVATION SERVICE — DATE 10/30/02

THESE PLANS FOR SMALL POND CONSTRUCTION, SOIL EROSION AND SEDIMENT CONTROL MEET THE REQUIREMENTS OF THE HOWARD SOIL CONSERVATION DISTRICT.

HOWARD SOIL CONSERVATION DISTRICT — DATE 10/30/02

APPROVED : HOWARD COUNTY DEPARTMENT OF PUBLIC WORKS.

CHIEF, BUREAU OF HIGHWAYS — DATE 11-6-02

APPROVED : HOWARD COUNTY DEPARTMENT OF PLANNING AND ZONING.

CHIEF, DIVISION OF LAND DEVELOPMENT — DATE 11/21/02

CHIEF, DEVELOPMENT ENGINEERING DIVISION — DATE 11/14/02

DATE	NO.	REVISION

OWNER/DEVELOPER

THE HOWARD RESEARCH AND DEVELOPMENT CORPORATION
THE ROUSE BUILDING
10275 LITTLE PATUXENT PARKWAY
COLUMBIA, MARYLAND 21044
410-992-6000

PROJECT
EMERSON
SECTION THREE AREA TWO

AREA
TAX MAP 47 BLOCK 8 & 9
ZONED: PEC-MXD-3 PART OF PARCELS: 462 & 837
6th ELECTION DISTRICT HOWARD COUNTY, MARYLAND

TITLE
GRADING, SEDIMENT CONTROL PLAN AND DRAINAGE AREA MAP

Patton Harris Rust & Associates, pc
Engineers. Surveyors. Planners. Landscape Architects.
8818 Centre Park Drive
Columbia, MD 21045
T 410.997.8900
F 410.997.9282

10-18-02
DATE

STATE OF MARYLAND — CHRISTOPHER J. REID — No. 19949 — PROFESSIONAL ENGINEER

CHRISTOPHER J. REID #19949

DESIGNED BY :	A.C.R
DRAWN BY :	DAM
CHECKED BY :	C.J.R.
PERMIT TRACKING NUMBER	01-NT-0222/200164079
DATE :	OCTOBER 21, 2002
SCALE :	1"=50'
DRAWING NO.	3 OF 12

F-02-178 C-RD3.DWG

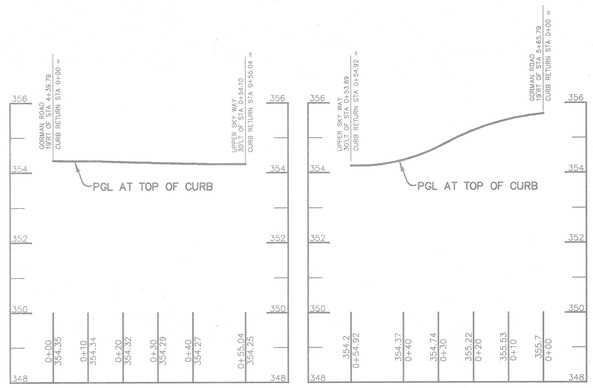

PROFILE
SCALE : HOR.-1"=20' VERT.-1"=2'

PROFILE
SCALE : HOR.-1"=20' VERT.-1"=2'

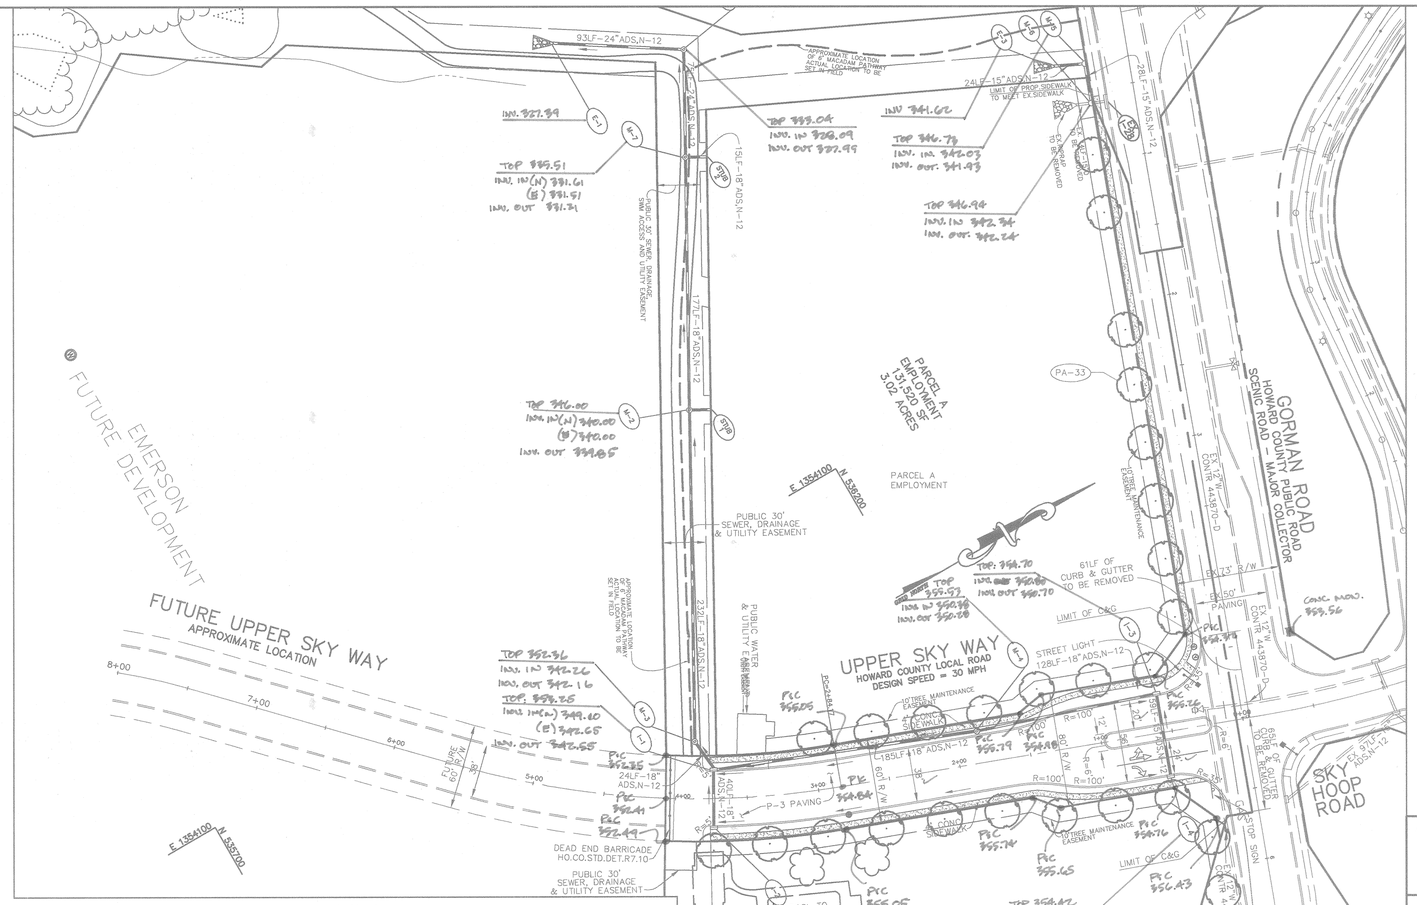

PLAN
SCALE: 1" = 50'

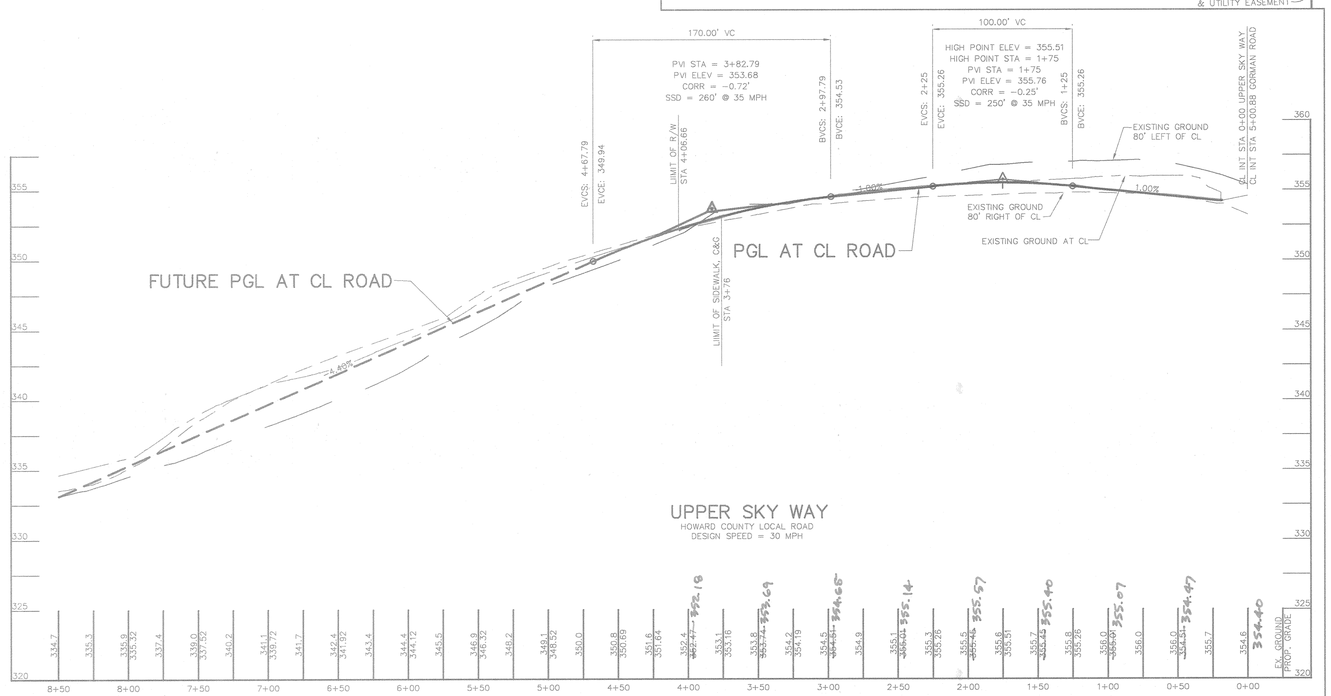

PROFILE
SCALE: HOR. 1" = 50' VERT. 1" = 5'

SHANABERGER & LANE
8726 TOWN & COUNTRY BLVD.
SUITE 201
ELLICOTT CITY, MARYLAND 21043

ROAD & STORM DRAIN AS-BUILTS
G. SCOTT SHANABERGER
PROF. L.S. #10849

STREET TREE PLANT LIST

KEY	QTY	BOTANICAL AND COMMON NAME	SIZE	ROOT
PA	33	Platanus xaceriflolia London Plane Tree	2-1/2" - 3"	B & B

CL CURVE DATA

FROM CL STA 2+84 TO STA 5+52
RADIUS = 600.0
LENGTH = 268.18
TANGENT = 136.37
DELTA = 25° 36'32"
CHORD = S 33° 14'56"W 265.95'

CURB TRANSITION DATA RIGHT

FROM CL STA 1+19 TO STA 1+51
RADIUS = 100.00'
LENGTH = 33.32'
TANGENT = 16.82'
DELTA = 19° 5'28"
CHORD = N 10°53'56"E 33.17'

CURB TRANSITION DATA RIGHT

FROM CL STA 1+51 TO 1+84
RADIUS = 100.00'
LENGTH = 33.32'
TANGENT = 16.82'
DELTA = 19° 5'28"
CHORD = N 10°53'56"E 33.17'

CURB TRANSITION DATA LEFT

FROM CL STA 1+19 TO STA 1+51
RADIUS = 100.00'
LENGTH = 33.32'
TANGENT = 16.82'
DELTA = 19° 5'28"
CHORD = S 29°59'29"W 33.17'

CURB TRANSITION DATA LEFT

FROM CL STA 1+51 TO 1+84
RADIUS = 100.00'
LENGTH = 33.32'
TANGENT = 16.82'
DELTA = 19° 5'28"
CHORD = S 29°59'24"W 33.17'

STREET LIGHT DATA

LOCATE 37' RIGHT OF CL STA 0+35 UPPER SKY WAY.
POLE HEIGHT = 30' LIGHT FIXTURE = 250w HPS
POLE TYPE = BRONZE ALUMINUM

APPROVED : HOWARD COUNTY DEPARTMENT OF PUBLIC WORKS.
CHIEF, BUREAU OF HIGHWAYS — DATE 11-8-02

APPROVED : HOWARD COUNTY DEPARTMENT OF PLANNING AND ZONING.
CHIEF, DIVISION OF LAND DEVELOPMENT — DATE 11/20/02
CHIEF, DEVELOPMENT ENGINEERING DIVISION — DATE 11/14/02

DATE	NO.	REVISION

OWNER/DEVELOPER
THE HOWARD RESEARCH AND DEVELOPMENT CORPORATION
THE ROUSE BUILDING
10275 LITTLE PATUXENT PARKWAY
COLUMBIA, MARYLAND 21044
410-992-6000

PROJECT
EMERSON
SECTION THREE AREA TWO

AREA
TAX MAP 47 BLOCK 8 & 9
ZONED: PEC-MXD-3 PART OF PARCELS: 462 & 837
6th ELECTION DISTRICT HOWARD COUNTY, MARYLAND

TITLE
PLAN AND PROFILE OF UPPER SKY WAY

Patton Harris Rust & Associates, pc
Engineers. Surveyors. Planners. Landscape Architects.
8818 Centre Park Drive
Columbia, MD 21045
T 410.997.8900
F 410.997.9282

10-19-02
DATE

CHRISTOPHER J. REID #19949

DESIGNED BY :	A.C.R
DRAWN BY :	DAM
CHECKED BY :	C.J.R.
PERMIT TRACKING NUMBER	01-NT-0222/200164079
DATE :	OCTOBER 21, 2002
SCALE :	AS SHOWN
DRAWING NO.	2 OF 12

F-02-178 C-RD2.DWG

ROADWAY AND STORM DRAINS
EMERSON
SECTION THREE AREA TWO
6th ELECTION DISTRICT
HOWARD COUNTY, MARYLAND

SHEET INDEX

NO	DESCRIPTION
1	TITLE SHEET
2	PLAN AND PROFILE OF UPPER SKY WAY
3	GRADING, SEDIMENT CONTROL PLAN AND DRAINAGE AREA MAP
4	GRADING AND SEDIMENT CONTROL PLAN
5	SEDIMENT CONTROL DETAILS
6	SEDIMENT CONTROL NOTES
7	STORMWATER MANAGEMENT DETAILS AND PROFILES
8	PROFILES AND DETAILS
9	LANDSCAPE PLAN
10	EXISTING CONDITIONS SWM DRAINAGE AREA MAP
11	PROPOSED CONDITIONS SWM DRAINAGE AREA MAP
12	SEDIMENT CONTROL DETAILS

BENCHMARKS

TRAVERSE POINT 102
ELEVATION 346.19
N 536,499.165
E 1,353,974.017
LOCATED NEAR THE INTERSECTION OF GORMAN ROAD AND SKYLARK BLVD.

TRAVERSE POINT 1154
ELEVATION 347.45
N 536,018.069
E 1,355,129.333
LOCATED NEAR THE I-95 BRIDGE ALONG GORMAN ROAD

CONTROL STATION 47E4
ELEVATION 339.00
N 535,846.16
E 1,355,431.23
LOCATED NEAR THE I-95 BRIDGE ALONG GORMAN ROAD

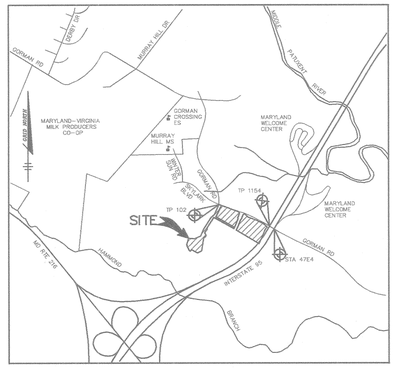

VICINITY MAP
SCALE: 1"=2000'

GENERAL NOTES

1. ALL CONSTRUCTION SHALL BE IN ACCORDANCE WITH THE HOWARD COUNTY DESIGN MANUAL, VOL. IV "STANDARD SPECIFICATIONS AND DETAILS FOR CONSTRUCTION" PLUS MSHA STANDARDS AND SPECIFICATIONS, IF APPLICABLE.

2. THE CONTRACTOR SHALL NOTIFY THE DEPARTMENT OF PUBLIC WORKS/BUREAU OF ENGINEERING/CONSTRUCTION INSPECTION DIVISION AT (410) 313-1880 AT LEAST FIVE (5) WORKING DAYS PRIOR TO THE START OF WORK.

3. THE CONTRACTOR SHALL NOTIFY "MISS UTILITY" AT 1-800-257-7777 AY LEAST 48 HOURS PRIOR TO ANY EXCAVATION WORK BEING DONE.

4. TRAFFIC CONTROL DEVICES, MARKINGS, AND SIGNING SHALL BE IN ACCORDANCE WITH THE LATEST EDITION OF THE MANUAL ON UNIFORM TRAFFIC CONTROL DEVICES (MUTCD). ALL STREET AND REGULATORY SIGNS SHALL BE IN PLACE PRIOR TO THE PLACEMENT OF ANY ASPHALT.

5. STREET LIGHT PLACEMENT AND THE TYPE OF FIXTURE AND POLE SHALL BE IN ACCORDANCE WITH THE HOWARD COUNTY DESIGN MANUAL, VOLUME III (1993) AND AS MODIFIED BY "GUIDELINES FOR STREET LIGHTS IN RESIDENTIAL DEVELOPMENTS, (JANUARY 1998)." A MINIMUM SPACING OF 20' SHALL BE MAINTAINED BETWEEN ANY STREET LIGHT AND ANY TREE.

6. THE EXISTING TOPOGRAPHY IS TAKEN FROM AERIAL SURVEY MAPS WITH MAXIMUM TWO FOOT CONTOUR INTERVALS PREPARED BY AIR SURVEY CORP. FLOWN IN APRIL 1998.

7. THE COORDINATES SHOWN HEREON ARE BASED UPON THE HOWARD COUNTY GEODETIC CONTROL WHICH IS BASED UPON THE MARYLAND STATE PLANE COORDINATE SYSTEM. HOWARD COUNTY MONUMENT NOS. 47 E4 ALONG WITH 2 TRAVERSE POINTS WERE USED FOR THIS PROJECT.

8. WATER IS PUBLIC.

9. SEWER IS PUBLIC.

10. THE STORMWATER MANAGEMENT FOR THIS SITE WILL BE PROVIDED VIA THE GRASS CHANNEL CREDIT, AND A PUBLIC WET POND.

11. APPROXIMATE LOCATION OF EXISTING UTILITIES ARE SHOWN. THE CONTRACTOR SHALL TAKE ALL NECESSARY PRECAUTIONS TO PROTECT THE EXISTING UTILITIES AND MAINTAIN UNINTERRUPTED SERVICE. ANY DAMAGE INCURRED DUE TO CONTRACTOR'S OPERATION SHALL BE REPAIRED IMMEDIATELY AT THE CONTRACTOR'S EXPENSE. EXISTING UTILITIES ARE SHOWN BASED ON THE BEST AVAILABLE INFORMATION.

12. THE WETLANDS DELINEATION STUDY FOR THIS PROJECT WAS PREPARED BY DAFT McCUNE & WALKER, INC.

13. THE TRAFFIC STUDY FOR THIS PROJECT WAS PREPARED BY WELLS & ASSOCIATES DATED FEBRUARY 2000.

14. THE NOISE STUDY FOR THIS PROJECT WAS PREPARED BY CENTURY ENGINEERING DATED MARCH 1999.

15. THIS PROJECTS FALLS UNDER THE APPROVED AFPO STUDY OF S-99-12.

16. THE BOUNDARY SURVEY FOR THIS PROJECT WAS PREPARED BY DAFT, McCUNE & WALKER, INC. JULY 2000.

17. SUBJECT PROPERTY ZONED PEC-MXD-3 AND R-SC-MXD-3 PER ZONING BOARD CASE ZB-979-M.

18. ALL ELEVATIONS SHOWN ARE BASED ON THE U.S.C. AND G.S. MEAN SEA LEVEL DATUM, 1929.

19. SEE DEPARTMENT OF PLANNING AND ZONING FILE NO'S.: S-99-12, PB-339, ZB-979-M, P-02-22, PB-359.

20. THE CONTRACTOR SHALL TEST PIT EXISTING UTILITIES AT LEAST (5) DAYS BEFORE STARTING WORK SHOWN ON THESE DRAWINGS.

21. CONTRACTOR IS SOLELY RESPONSIBLE FOR CONSTRUCTION MEANS, METHODS, TECHNIQUES, SEQUENCES, PROCEDURES, AND SAFETY PRECAUTIONS AND PROGRAMS.

22. PIPE SHALL NOT BE INSTALLED BY THE CONTRACTOR UNTIL THE LENGTH CALLED FOR AT EACH STATION HAS BEEN APPROVED BY THE ENGINEER IN THE FIELD.

23. NO PIPE SHALL BE LAID UNTIL LINES OF EXCAVATION HAVE BEEN BROUGHT WITHIN 6" OF FINISHED GRADE.

24. ALL INLETS SHALL BE CONSTRUCTED IN ACCORDANCE WITH HOWARD COUNTY STANDARDS.

25. ALL PIPE ELEVATIONS SHOWN ARE INVERT ELEVATIONS.

26. STORM DRAIN TRENCHES WITHIN ROAD RIGHT OF WAY SHALL BE BACKFILLED AND COMPACTED IN ACCORDANCE WITH THE HOWARD COUNTY DESIGN MANUAL, VOLUME IV, i.e., STANDARD SPECIFICATIONS AND DETAILS FOR CONSTRUCTION, LATEST AMENDMENTS.

27. PROFILE STATIONS SHALL BE ADJUSTED AS NECESSARY TO CONFORM TO PLAN DIMENSIONS.

28. DESIGNED TRAFFIC SPEED IN ACCORDANCE WITH THE HOWARD COUNTY DESIGN MANUAL VOL. III. ALL 60' RIGHT OF WAYS 30 M.P.H.

29. ALL FILL AREAS WITHIN ROADWAY AND UNDER STRUCTURES TO BE COMPACTED TO A MINIMUM OF 95% COMPACTION OF AASHTO T180.

30. ALL STREET CURB RETURNS SHALL HAVE 35' RADII UNLESS OTHERWISE NOTED.

31. ALL STREET LIGHTS SHALL BE LOCATED BETWEEN 2'-0" AND 4'-0" BEHIND FACE OF CURB.

32. STREET TREES LOCATION, TYPE AND NUMBER OF TREES SHOWN ON THIS PLAN ARE TENTATIVE AND ARE USED FOR BOND PURPOSES ONLY. THE FINAL LOCATION AND VARIETY OF LOCATION AND VARIETY OF TREES MAY VARY TO ACCOMODATE FIELD CONDITIONS INCLUDING 20' CLEARANCE OF ANY STREET LIGHT AND SHALL BE IN ACCORDANCE WITH THE SUBDIVISION REGULATIONS AND THE LANDSCAPE MANUAL. BOND RELEASE IS CONTINGENT UPON SECTION 16.124 OF THE HOWARD COUNTY SUBDIVISION REGULATIONS, AS APPROVED BY THE DEPARTMENT OF PLANNING AND ZONING.

33. STREAM BUFFERS ARE DETERMINED BY LAND USE ADJOINING THE OPEN SPACE. EMPLOYMENT USE = 50' BUFFER FROM ANY STREAM. RESIDENTIAL USES= 50' BUFFER FOR INTERMITTENT STREAMS AND 75' BUFFER FOR PERENNIAL STREAMS.

34. THE 100-YEAR FLOODPLAIN FOR HAMMOND BRANCH WAS OBTAINED FROM THE HOWARD COUNTY FLOODPLAIN STUDY DATED NOV. 1980 REF. D-6-10-26 & AUG 1986 REF. D-1065. THE 100 YEAR FLOODPLAIN FOR THE REMAINING STREAMS ARE FROM THE FLOODPLAIN STUDY PREPARED BY DAFT McCUNE AND WALKER MARCH 2000.

35. DEVELOPMENT OF EMERSON SECTION 3, AREA 2 UNDER THE CURRENT FOREST CONSERVATION ACT INVOLVES THE CLEARING OF APPROXIMATELY 2.20 ACRES OF FOREST AND 0 ACRES OF RETENTION. WHEN CONSIDERED CUMULATIVELY WITH PREVIOUS PHASES OF THE PROJECT, NO REFORESTATION IS REQUIRED.

36. THERE ARE NO KNOWN CEMETARIES OR GRAVE SITES ON THIS PROPERTY.

37. SOIL MAP #33.

38. THE LIMITS OF ALL STREAMS AND WETLANDS SHOWN HEREON HAVE BEEN APPROVED BE THE US ARMY CORPS OF ENGINEERS WITH JURISDICTIONAL DETERMINATION # CENAB-OP-RMS00-61707-11, DATED APRIL 13, 2001.

39. THE WATER MANAGEMENT ADMINISTRATION INTENDS TO ISSUE A MODIFICATION OF AUTHORIZATION FOR THE PROPOSED WORK WITHIN THE FLOODPLAIN AND STREAM AREA. NON-TIDAL WETLANDS AND WATERWAYS PERMIT NO. 01-NT-0222/200164-079.

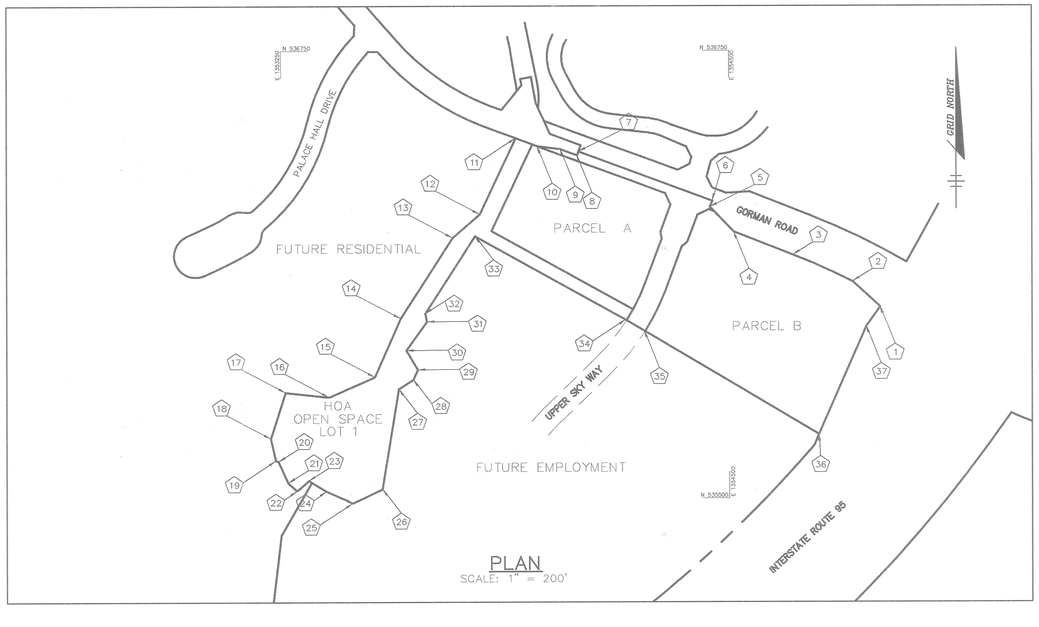

PLAN
SCALE: 1" = 200'

FOREST CONSERVATION CALCULATIONS

BASIC SITE DATA	ACRES (1/100)
GROSS SITE AREA	220.27
AREA WITHIN 100 YEAR FLOODPLAIN	21.27
AREA WITHIN AGRICULTURAL USE OR PRESERVATION PARCEL (IF APPLICABLE)	0.0
NET TRACT AREA	199.00
LAND USE CATEGORY	COMMERCIAL/INDUSTRIAL/OFFICE

INFORMATION FOR CALCULATIONS	
A. NET TRACT AREA	199.00
B. REFORESTATION THRESHOLD (15% x A)	29.85
C. AFFORESTATION MINIMUM (15% x A)	29.85
D. EXISTING FOREST ON NET TRACT AREA	87.50
E. FOREST AREAS TO BE CLEARED	41.67
F. FOREST AREAS TO BE RETAINED	45.83

REFORESTATION CALCULATIONS	
A. NET TRACT AREA	199.00
B. REFORESTATION THRESHOLD (15% x A)	29.85
C. EXISTING FOREST ON NET TRACT AREA	87.50
D. FOREST AREAS TO BE CLEARED	41.67
E. FOREST AREAS TO BE RETAINED	45.83
F. FOREST AREAS CLEARED ABOVE REFORESTATION THRESHOLD	41.67
G. FOREST AREAS CLEARED BELOW REFORESTATION THRESHOLD	0.00
H. FOREST AREAS RETAINED ABOVE REFORESTATION THRESHOLD	15.98

CLEARING ABOVE THE THRESHOLD ONLY

IF FOREST AREAS TO BE RETAINED ARE GREATER THAN THE REFORESTATION THRESHOLD (IF E IS GREATER THAN B), THE FOLLOWING CALCULATIONS APPLY:

REFORESTATION FOR CLEARING ABOVE THRESHOLD Fx1/4	10.42
REFORESTATION FOR CLEARING BELOW THRESHOLD Gx2	0.00
TOTAL REFORESTATION REQUIRED (Fx1/4) + (Gx2)	10.42
CREDIT FOR RETENTION ABOVE CONSERVATION THRESHOLD	15.98
REFORESTATION REQUIRED	0.00 ACRES
REFORESTATION PROVIDED	5.03 ACRES
TOTAL	5.03 ACRES

FOREST CONSERVATION TRACKING CHART

SECTION PHASE	GROSS AREA	FLOODPLAIN AREA	NET TRACT AREA	EX. FOREST AREA	FOREST * CLEARED	FOREST RETAINED	REFOR./AFFOR. REQUIRED	REFOR./AFFOR. PROVIDED	EXCESS REFOR./AFFOR.	FUTURE FOREST CLEARING	FUTURE REFOR./AFFOR.	COMMENTS
2/1A&1B	106.20	3.50	102.70	24.70	7.93	16.77	0.61	5.03	4.42	4.48	3.41	
2/2	118.90	3.50	115.40	24.80	8.03	16.77	2.95	5.03	2.08	3.28	3.41	SEE NOTE A
2/3	137.35	4.00	113.35	34.40	12.53	21.87	1.27	5.03	3.76	2.18	3.91	SEE NOTE B
3/1	206.85	21.19	185.66	85.30	39.47	45.83	0.00	5.03	5.03	2.18	3.91	
3/2	220.27	21.27	199.00	87.50	41.67	45.83	0.00	5.03	5.03	2.18	3.91	SEE NOTE C

TABULATIONS SHOWN ABOVE FOR EACH PHASE WILL REFLECT CUMULATIVE TOTALS FOR THIS PHASE AND ALL PREVIOUS PHASES.
THE FOREST CLEARED INCLUDES THE ACREAGE OF POSSIBLE FUTURE FOREST CLEARING.
A. 1.20 +/- ACRES OF FUTURE FOREST CLEARING SHOWN ON F-01-137 WAS CLEARED FOR SWM ON OPEN SPACE LOT 174.
B. 1.10 +/- ACRES OF FUTURE FOREST CLEARING SHOWN ON F-01-137 WAS CLEARED FOR SWM ON OPEN SPACE LOT 176.
C. GROSS AREA INCLUDES 1.07 +/- ACRES FOR SANITARY SEWER EXTENSION, AND CONTAINS 0.08 +/- ACRES OF FLOODPLAIN.

FOREST CONSERVATION GOALS AND OBJECTIVES

The goals and objectives of this Forest Conservation Plan are to identify forests to be cleared under Emerson 3, Section 2, and to evaluate the reforestation requirement generated by this clearing. Under this phase, approximately 2.20 + acres of forest will be cleared, and no retention is proposed. When evaluated cumulatively with previous phases of the Emerson project, no reforestation is required. Please note that the gross site acreage used for this phase's forest conservation calculations include 1.07 + acres for the proposed sanitary sewer extension, including 0.08 + acres of floodplain. This "off-site" area is included in the forest conservation calculations in order to account for forest clearing associated with the sewer extension, and it should be noted that this acreage is slightly higher than that identified on the plat for this phase.

ROAD & STORM DRAIN AS-BUILT
G. SCOTT SHANABERGER PROF. L.S. # 10849 DATE
STATE OF MARYLAND GEORGE SCOTT SHANABERGER No. 10849 PROFESSIONAL LAND SURVEYOR

SHANABERGER & LANE
8726 TOWN & COUNTRY BLVD.
SUITE 201
ELLICOTT CITY, MARYLAND 21043

APPROVED : HOWARD COUNTY DEPARTMENT OF PUBLIC WORKS.
CHIEF, BUREAU OF HIGHWAYS — DATE 11-8-02

APPROVED : HOWARD COUNTY DEPARTMENT OF PLANNING AND ZONING.
CHIEF, DIVISION OF LAND DEVELOPMENT — DATE 11/20/02
CHIEF, DEVELOPMENT ENGINEERING DIVISION — DATE 11/14/02

DATE	NO.	REVISION

OWNER/DEVELOPER
THE HOWARD RESEARCH AND DEVELOPMENT CORPORATION
THE ROUSE BUILDING
10275 LITTLE PATUXENT PARKWAY
COLUMBIA, MARYLAND 21044
410-992-6000

PROJECT
EMERSON
SECTION THREE AREA TWO

AREA TAX MAP 47 BLOCK 8 & 9
ZONED: PEC-MXD-3 PART OF PARCELS: 462 & 837
6th ELECTION DISTRICT HOWARD COUNTY, MARYLAND

TITLE
TITLE SHEET

Patton Harris Rust & Associates, pc
Engineers. Surveyors. Planners. Landscape Architects.
8818 Centre Park Drive
Columbia, MD 21045
T 410.997.8900
F 410.997.9282

10-18-02
DATE
STATE OF MARYLAND CHRISTOPHER J. REID No. 19949 PROFESSIONAL ENGINEER
CHRISTOPHER J. REID #19949

DESIGNED BY : A.C.R
DRAWN BY : DAM
CHECKED BY : C.J.R.
PERMIT TRACKING NUMBER 01-NT-0222/200164079
DATE : OCTOBER 21, 2002
SCALE : AS SHOWN
DRAWING NO. 1 OF 12

F-02-178 C-RD1.DWG

J:\project\224561.0\Engr\Plans\FINALS\C-RD1.dwg, Layout1, 10/17/02 02:11:24 PM, HP750C(36).pc3, Arch D - 24 x 36 in. (landscape), 1:1