FY18-DRAINAGE IMPROVEMENTS UNDER CAPITAL PROJECT D-1124 TO STABILIZE ERODED CHANNEL

GENERAL NOTES:

1.) For details of paving section see drwg. D-2, page 57 of the Howard County Road Building Code and Standard Specifications.
2.) For details of type "K" Inlet see drwg. D-94, page 149 of the above Specifications.
3.) For details of type "C" Endwall see drwg. D-52, page 107 of the above Specifications.
4.) For details of Paved Side Swales see drwg. D-38, page 93 of the above Specifications.
5.) For details of Standard Manhole see drwg. D-103, page 158 of the above Specifications.

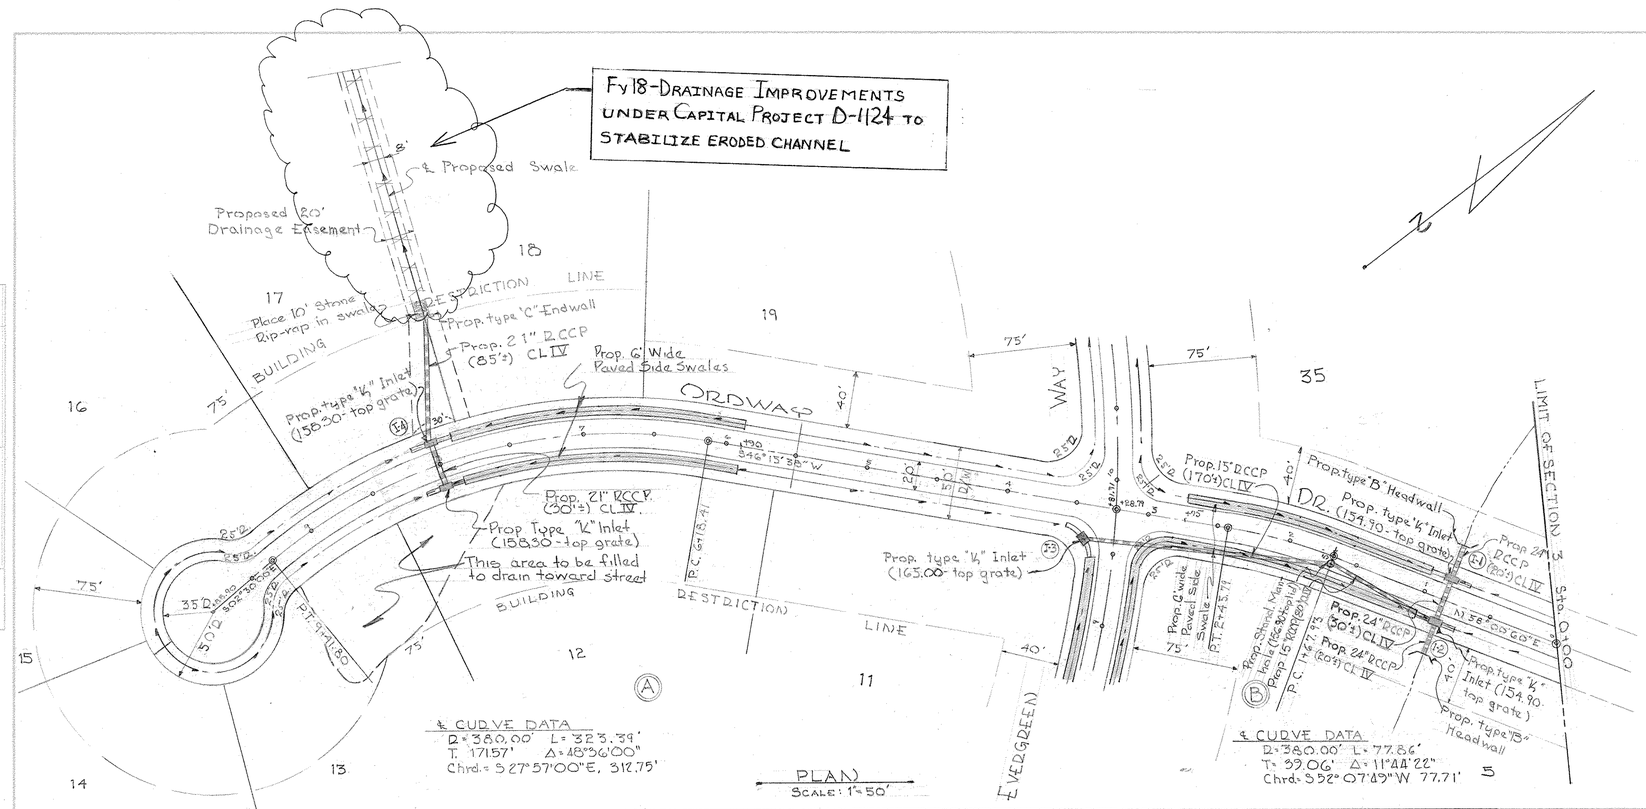

APPROVED
PLANNING COMMISSION
OF HOWARD COUNTY

PURDUM & JESCAKE
ENGINEER & LAND SURVEYOR
24 PARK AVE.
ELLICOTT CITY, MD.

29 Aug. 1966
Date

Reg. No. 2551

OWNER & DEVELOPER
CARWELL, INC.
CHAMHAM ROAD
ELLICOTT CITY, MARYLAND

APPROVED: HOWARD CO. PLANNING COMM.
J. H. Clawson 9-28-66
Senior Engineer Date

APPROVED: HOWARD CO. ROADS DEPT.
Reginald S. Mill 9-27-66
Roads Superintendent Date

APPROVED: HOWARD CO. METRO. COMM.
W. O. Talbert 9-29-66
Chief Engineer Date

PLAN-PROFILE-ORDWAY DRIVE & "GREEN (-) ENGE"

SECTION 3
3RD ELECT. DIST. - HOWARD CO., MD.
22 SEPT. 1966 SCALE: AS SHOWN
SHEET 1 of 2

PROFILE SCALE:
HOR: 1" = 50'
VERT: 1" = 5'-0"

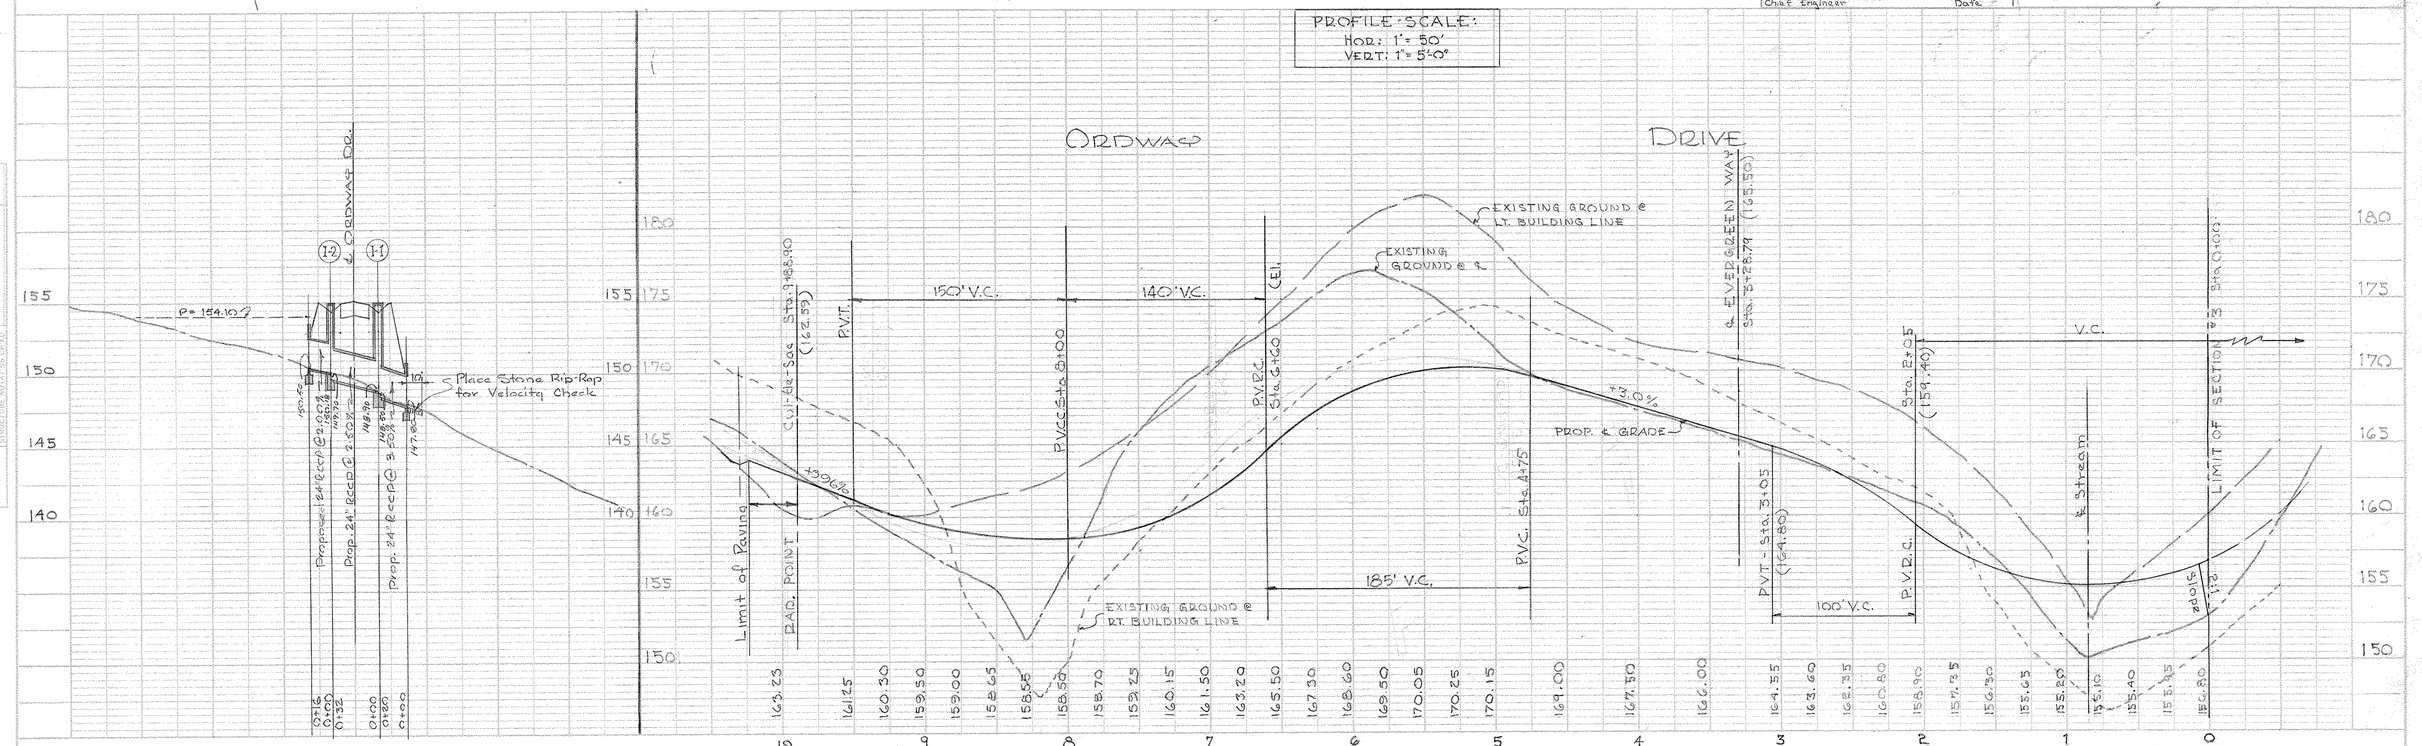

PLATE 1 — PLAN — PROFILE
MADE AND PRINTED IN U.S.A.
CHARLES BRUDING COMPANY

#1122

F-66-35

6

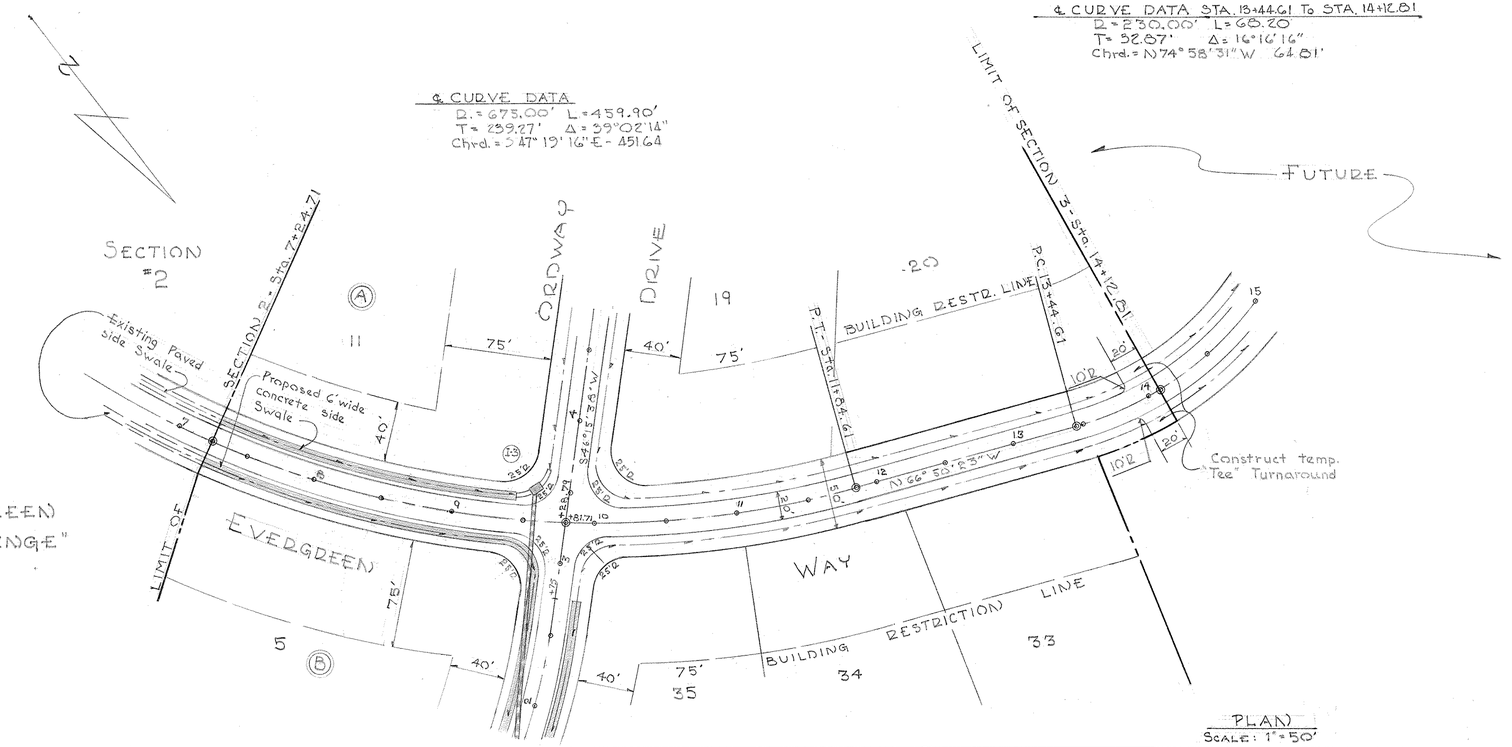

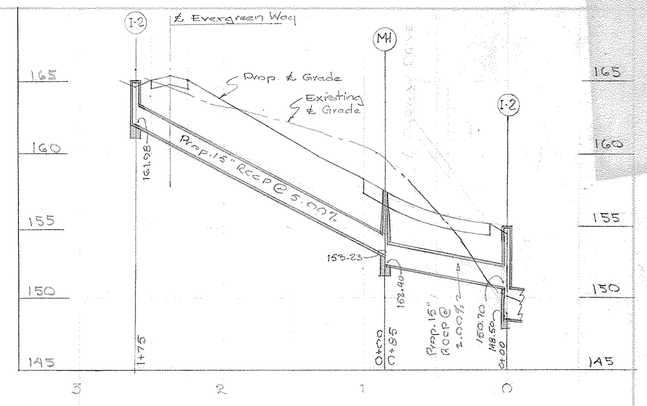

APPROVED
PLANNING COMMISSION
OF HOWARD COUNTY

29 AUGUST 1966
Date

PURDUM & JESCAKE
ENGINEER & LAND SURVEYOR
24 PARK AVE.
ELLICOTT CITY, MD.
Reg. No. 2351

OWNER & DEVELOPER
CADWELL, INC.
CHAMHAM ROAD
ELLICOTT CITY, MARYLAND

APPROVED: HOWARD CO. PLANNING COMM.
Senior Engineer — 9-28-66 Date

APPROVED: HOWARD CO. ROADS DEPT.
Roads Superintendent — 9-27-66 Date

APPROVED: HOWARD CO. METRO. COMM.
Chief Engineer — 9-29-66 Date

PLAN-PROFILE-EVERGREEN WAY
"GREEN HENGE"
SECTION 3

3RD ELECT. DIST. ~ HOWARD CO., MD.
29 AUG. 1966 SCALE: AS SHOWN
22 SEPT. 1966 SHEET 2 of 2

PLAN
SCALE: 1"=50'

PROFILE SCALE:
HOR.: 1"=50'
VERT: 1"=5'-0"

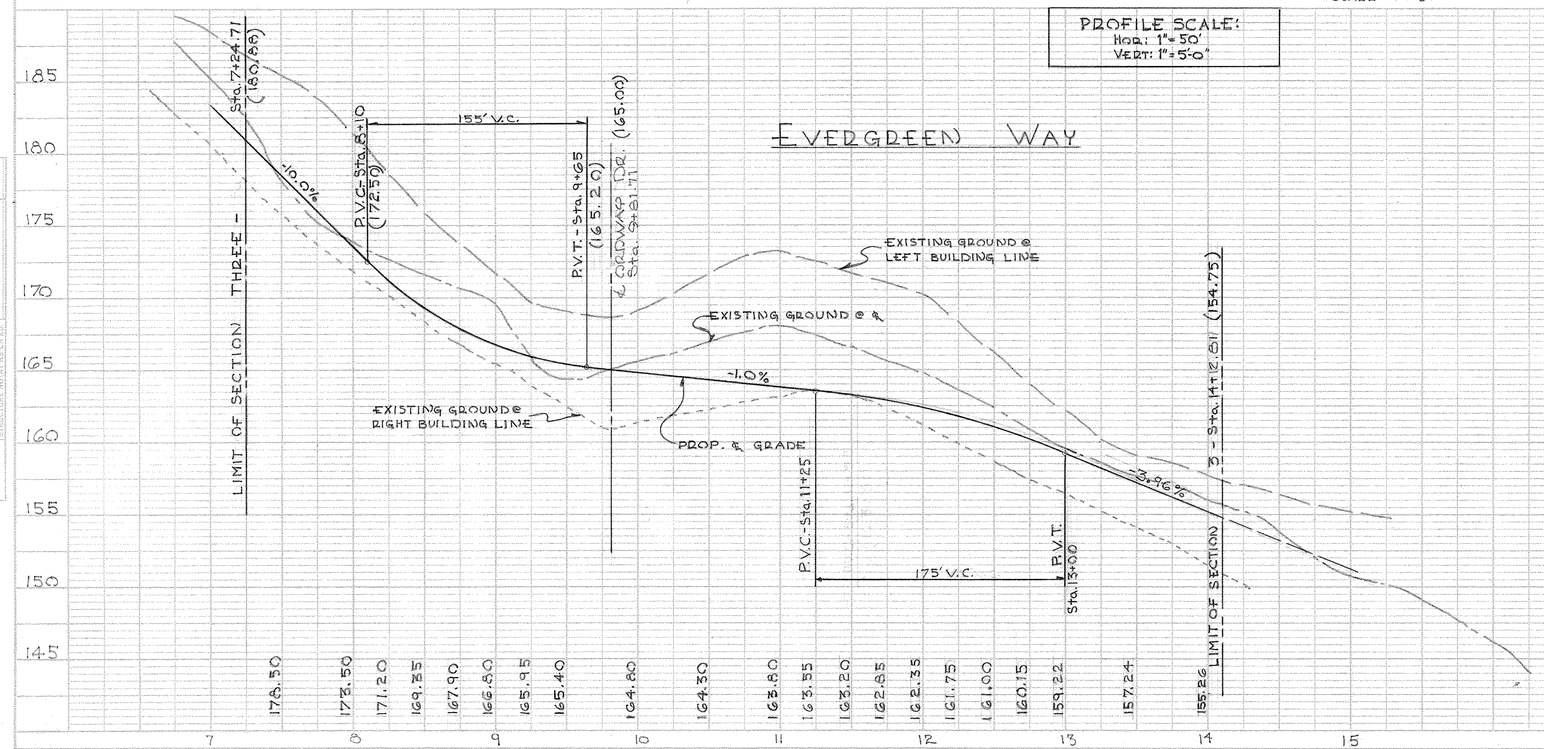

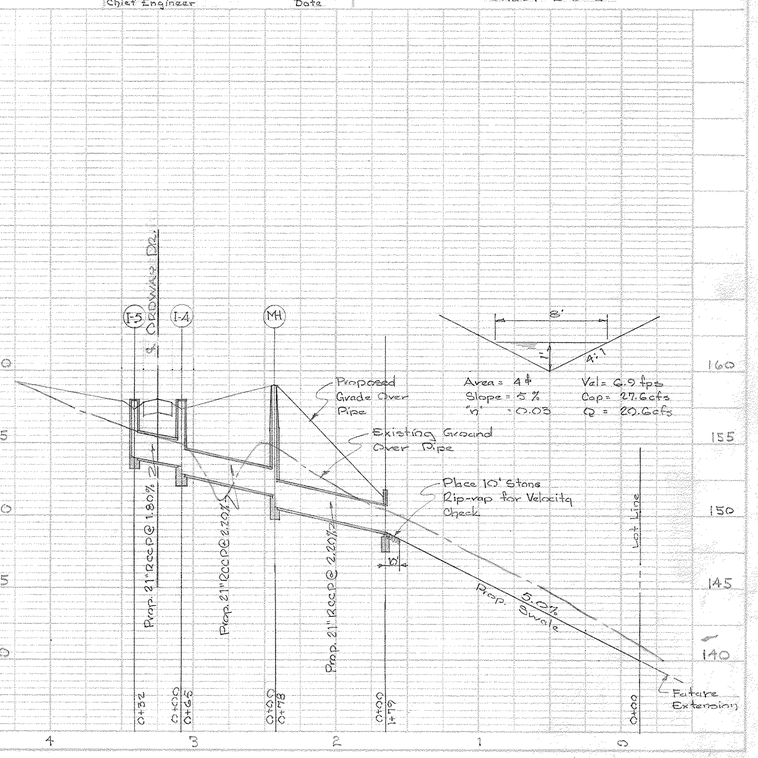

#122

PLATE 1—PLAN—PROFILE
MADE AND PRINTED IN U.S.A.
CHARLES BRUNING COMPANY

F-66-35