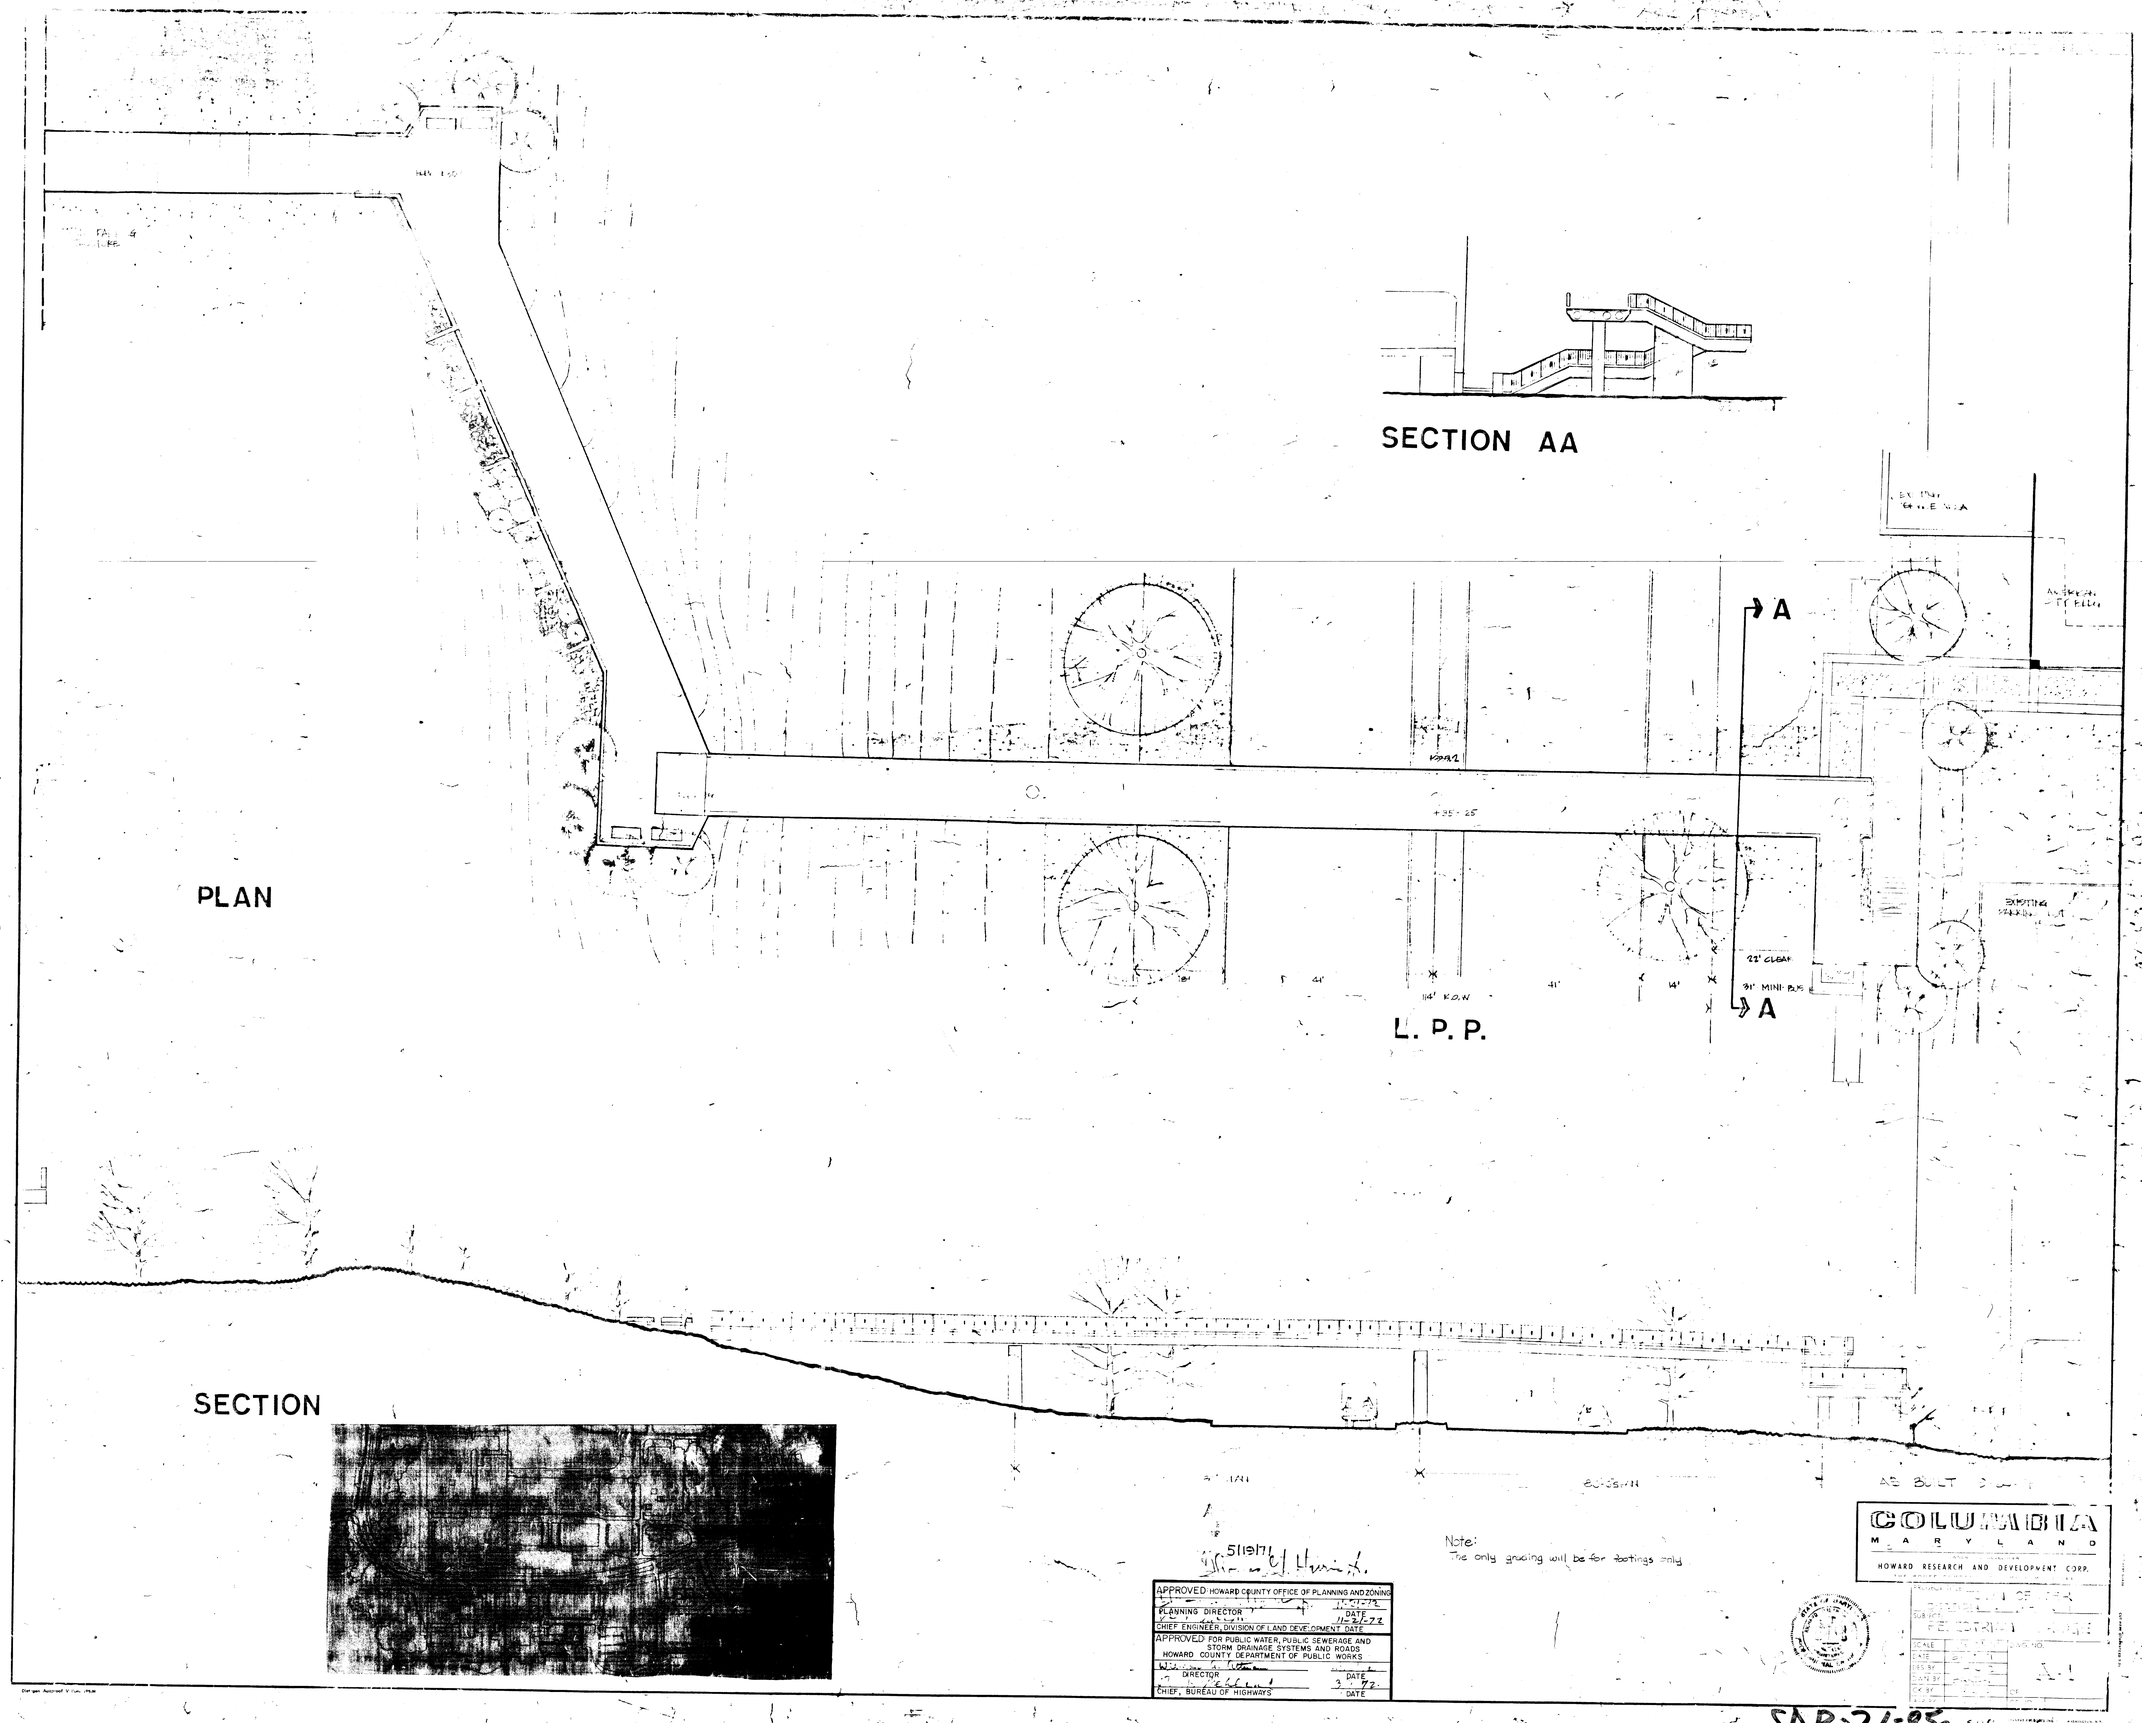
SECTION AA
PLAN
A
A
L. P. P.
SECTION
AS BUILT
Note:
The only grading will be for footings only
5/19/71
APPROVED HOWARD COUNTY OFFICE OF PLANNING AND ZONING
PLANNING DIRECTOR
DATE
11-21-72
CHIEF ENGINEER, DIVISION OF LAND DEVELOPMENT DATE
APPROVED FOR PUBLIC WATER, PUBLIC SEWERAGE AND STORM DRAINAGE SYSTEMS AND ROADS
HOWARD COUNTY DEPARTMENT OF PUBLIC WORKS
DIRECTOR
DATE
CHIEF, BUREAU OF HIGHWAYS
DATE
COLUMBIA
MARYLAND
HOWARD RESEARCH AND DEVELOPMENT CORP.
SDP-71-85c