PARCEL "A", BLOCK "A", SECT. I
GREATER BALTIMORE
CONSOLIDATED WHOLESALE
FOOD MARKET AUTHORITY
PLAT BOOK 22, FOLIO 12

Ex. "S" Comb Inlet To Be Reconstructed As "S" Grate Inlet

Road Classification for Rappahannock Ave is Local Industrial
Req. inlt spacing = 250'
Provided = 247'

RAPPAHANNOCK AVENUE

ASSATEAGUE DRIVE

Prop. 10" Water Service (by Permit Appl.) for crossings See Sheet 2

Ex. Bit. Conc. Curb To Be Removed

Prop. 10" Detector Check

Prop. 1½" Meter

Prop. conc. cfg.

Ex. conc. cfg.

Ex. 8" San.

Ex. 12" W.

Ex. 8" Gas

Ex. 24" S.D.

Ex. 42" S.D.

Ex. 54" S.D.

Ex. 27" S.D.

Ex. 21" S.D.

Ex. 15" S.D.

Ex. 8" Stub

Ex. 30" S.D.

Ex. 12" S.D.

Prop. 12" S.D.

Prop. 10" Fire Service

Prop. 6" Domestic

End of Prop. Bit. Curb

Prop. bit. curb

50' Minimum Building Setback Line

Limit of Paving 5%

Limit Of Paving

Conc. Loading Pad 3%

Office #234

(Visitor) 7 Parking Spcs.

LANDSCAPING AREA

GUARD POST (TYP.) 2' FROM EACH CORNER OF TANK 4" Ø PIPE FILLED WITH CONCRETE 4' HIGH

PROP. 6,000 GAL. DIESEL FUEL TANK (10'-1" H IGH)

Conc. Loading Pad

Proposed Mezzanine Level Addition

Bit. Paving to be removed 5,576 sq. ft.

SEE HANDICAPPED RAMP DETAIL THIS SHEET

Proposed Mezzanine Level Addition

EX. BLDG #2 SLAB ELEV. 239.17

PROP. HANDRAIL

EX. CURB

VARIES

SECTION A-A

AREA 'A'
15 EMPLOYEES
HDCP P.S. REQUIRED-1
HDCP P.S. PROVIDED-1

Bldg. #1 Slab ± 239.17

Bldg. #2 Slab ± 239.17

Loading Ramp

Loading Ramp

Curve #1
Curve Data
Dc = 14°00'00"
R = 410.27'
Δ = 6°28'59"
L = 46.423'
T = 23.236'
Ch = 46.398'

Curve #12
Curve Data
Dc = 14°00'00"
R = 410.27'
Δ = 10°03'34"
L = 72.03'
T = 36.11'
Ch = 71.94'

Prop. Rail & Prop. 3½" E/W

Fut. Bldg.

Fut. Bldg.

PARCEL "C", BLOCK "A", SECT. II
GREATER BALTIMORE
CONSOLIDATED WHOLESALE
FOOD MARKET AUTHORITY
PLAT BOOK 22 FOLIO 17

Future 36" x 22" CMPA

Future headwall

Future headwall

℄ Swale

PERIMETER 2

PERIMETER 3

PERIMETER 4

Min. Building Setback Line

Ex. 8" Storm Drain

Ex. 24" S.D.

Ex. 12" W.

Ex. 8" Gas

Ex. 21" S.D.

Ex. 12" S.D.

Ex. 8" San.

Ex. 30" S.D.

Ex. 24" S.D.

Ex. 12" W.

Ex. 8" San.

Ex. 12" S.D.

Ex. 8" Gas

Ex. 24" S.D.

Ex. 12" W.

Ex. 8" Storm Drain

Ex. 18" S.D.

Ex. 8" Storm Drain

Ex. 24" S.D.

Ex. 12" W

SITE DATA

Total Area Of Tract		11.01 Ac.
Existing Zoning		M-2
Total Floor Area	(2 Bldgs)	249,232 sq.ft. 5
Tax Map No.		43
Total Parking Spaces Provided Including		
Customer & Visitor Parking		7
Employee Parking @ 2 empl./space	(40 employees)	87
Total Sales Area		0
ADT Peak Hour		8 a.m.
ADT Employees		10 trips
ADT Trucks		40 trips

4 STC 1200
PRECAST CONCRETE STORMCEPTOR

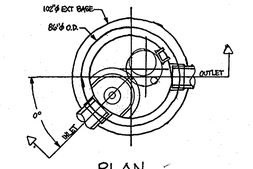

PLAN
(FRAME AND COVER NOT SHOWN FOR CLARITY)

GENERAL NOTES

1. STORMCEPTOR SECTIONS SHALL CONFORM TO ASTM C 478, PROFILE GASKETED JOINTS CONFORMING TO ASTM C 443.
2. MANHOLE STEPS PROVIDED ABOVE. INSERT @ 12" O.C. AND SHALL BE COPOLYMER POLYPROPYLENE PLASTIC ENCAPSULATED GR. 60 STEEL.
3. MINIMUM CONCRETE STRENGTH f'_c= 4,000 PSI MINIMUM STEEL STRENGTH f_y= 60,000 PSI
4. REINFORCEMENT DESIGN SHALL MEET ASTM C 478.
5. FLEXIBLE PIPE CONNECTORS SHALL MEET ASTM C 923.
6. HANDLING:
   A. ALL RISERS SHALL HAVE 2 EA. 1 1/2"ø HOLES FOR LIFTING @ 1/3 WAY DOWN FROM SPIGOT.
   B. ALL LG. DIAM. BASE SECTIONS FLATTOPS, AND REDUCERS TO HAVE LIFT HOOKS.
7. DESIGNED FOR AASHTO H-20 LOADING.
8. FIBERGLASS STORMCEPTOR INSERT REFERENCE DRAWING # CA-0229-01

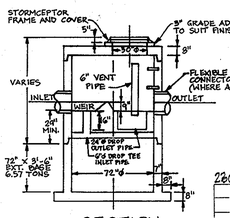

SECTION

SCHEDULE A
PERIMETER LANDSCAPE EDGE 4

CATEGORY	ADJ. TO ROADWAYS	
Perimeter/Frontage Designation	1 E	2 E
Landscape Type		
Linear Feet of Roadway Frontage/Perimeter	214	200
Credit for Existing Vegetation (Yes, No, Linear Feet Describe below if needed)	No	No
Credit for Wall, Fence or Berm (Yes, No, Linear Feet Describe below if needed)	Yes 180*	No
Number of Plants Required		
Shade Trees	1:40	1:40 5
Evergreen Trees	1:4	1:4 50
Ornamental Trees		
Number of Plants Provided		
Shade Trees	1	5
Evergreen Trees	-	-
Other Trees (2:1 Substitution)	-	-
Shrubs (10:1 Substitution)	7	50
Describe Plant Substitution Credits Below if needed)		

* Minimum 3' elevation difference in location shown on plan for full shrub credit.

Zachary V. Fisch 5/23/04 (FSH Associates) 6/29/04 5

HOWARD SOIL CONSERVATION DISTRICT

This development plan is approved for soil erosion and sediment control by the Howard Soil Conservation District

Approved: Robert W. Zuchmann 6/20/73
Howard Soil Conservation District Date

Reviewed For Howard S.C.D. Name
and meets technical requirements.
Charles E. Nell Jr. 6/20/73
Signature U.S. Soil Conservation Service Date

APPROVED: For Public Water And Public Sewerage Systems, Howard Co. Health Dept.
County Health Officer 6/29/73 Date

APPROVED: Howard Co. Office Planning & Zoning
Thomas H. Harris, Jr. 6-29-73
Planning Director Date
Chief, Div. Of Land Dev. 6/29/73 Date

APPROVED: For Public Water, Public Sewerage And Storm Drainage Systems And Roads. Howard Co. Department Of Public Works.
William D. Ritter 6-26-73
Director Date
W O Gilbert 6-26-73
Chief, Bureau Of Highways Date

INLET SCHEDULE				
NO.	TYPE	Q = cfs.	INV. OUT	TOP ELEV.
I-1	"S" combination *	4.4	230.4	238.0
I-2	double "S" combination*	7.6	226.86	231.7
I-3	"	0.5	224.19	228.3
I-4	"	2.1	222.65	226.3
I-5	double "S" combination *	7.1 (Present) 10.1(Ultimate)	221.41	229.2 (Present) 230.5 (Ultimate)
I-6	double throat "K" *	35.4	217.75	231.0
I-7	"S" Combination*	4.8	230.24	235.43
4 I-8	Single "S"*	4.8	232.24	237.65
I-9	Single "S"*	2.2	232.98	236.90

depressed

* See Ha.Co. Details

MANHOLE SCHEDULE				
NO.	TYPE	SIZE	INV. OUT	TOP ELEV.
M-1	"B"	48"	218.32	230.5
M-2	"B"	48"	221.01	228.4
M-3	"B"	48"	223.05	228.4
4 SC-1	Stormceptor	STC-1200	231.46	239.97

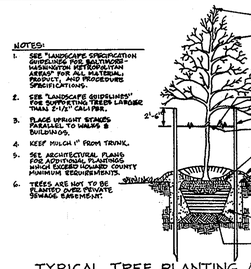

TYPICAL TREE PLANTING AND STAKING 4
DECIDUOUS TREES UP TO 2-1/2" CALIPER NOT TO SCALE

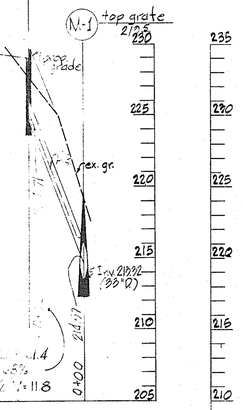

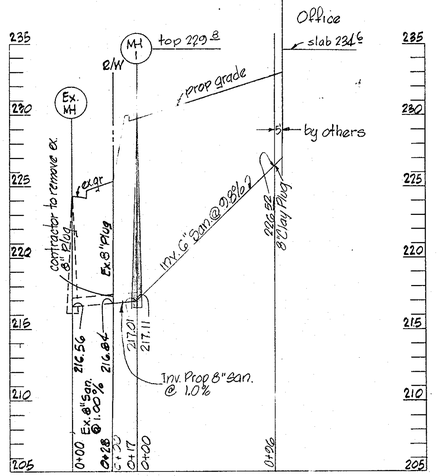

SANITARY PROFILES
SCALE: HORIZ.- 1"= 50'
VERT.- 1"= 5'

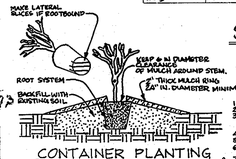

PLANTING PROCEDURE FOR CONTAINER GROWN PLANTS
1. Remove nursery container by cutting or inverting the container. Place plant in pit so that top of root ball is even with or slightly above finished grade when plant settles. Remove any additional soil from top of root ball to expose the original grade when plant is set. Make adjustments as necessary to set plant with existing grade.
2. Planting hole to be 2-3 times the diameter of the container.
3. Loosen fertilizer tablet, backfill 2/3 of the root ball and water.
4. After water percolates, backfill hole to top of root ball and gently tamp soil to firm contact with plant.
5. Apply mulch ring around plant keeping a 2" clearance from stem.

CONTAINER PLANTING 4
NOT TO SCALE

LANDSCAPE SCHEDULE				
KEY	QUAN.	BOTANICAL NAME	SIZE	NOTE
AR	9	Acer rubrum (Shade Trees) 'October Glory Red Maple'	2 1/2"-3" Cal.	B & B
IG	27	Ilex glabra 'Compacta' Compact Inkberry	2 1/2'-3' Ht.	Cont.
ND	30	Nandina domestica Heavenly Bamboo	2'-2 1/2' Ht.	Cont.

NOTES:
1. At the time of plant installation, all shrubs and trees listed and approved on the Landscape Plan shall comply with the proper height requirements in accordance with the Howard County Landscape Manual. In addition, no substitutions or relocations of the required plantings may be made without prior review and approval from the Department of Planning and Zoning. Any deviation from the approved Landscape Plan may result in denial or delay in the release of Landscape Surety until such time as all required materials are planted and/or revision are made to the applicable plans.
2. Financial Surety for the required parking lot internal landscaping shall be posted as part of the Developer's Agreement in the amount of $900.00 (3 shade trees @ $300.00 each).

Charles E. Fiske
Professional Engineer
5048 MAY 15, 1973
Reg.No. Date

4 SCHEDULE B
PARKING LOT INTERNAL LANDSCAPING

Number of Parking Spaces	67
Number of Trees Required (1 per 20 spaces)	3
Number of Trees Provided	
Shade Trees	3
Other Trees (2:1 Substitution)	-

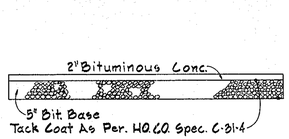

ONSITE PAV. SECT.
No Scale

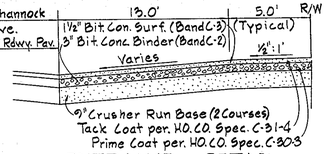

ENTRANCE DETAIL
No Scale

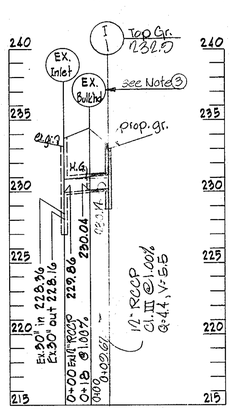

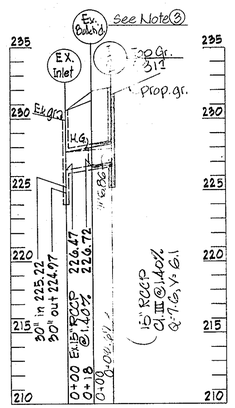

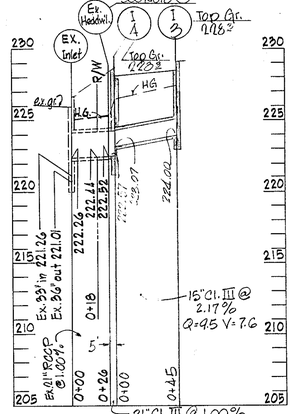

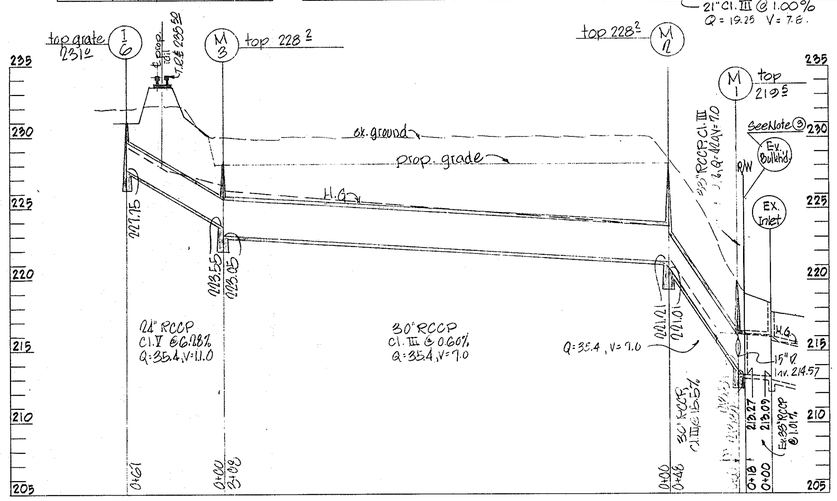

STORM DRAIN PROFILES
SCALE: HORIZ.- 1"=50'
VERT.- 1"=5'

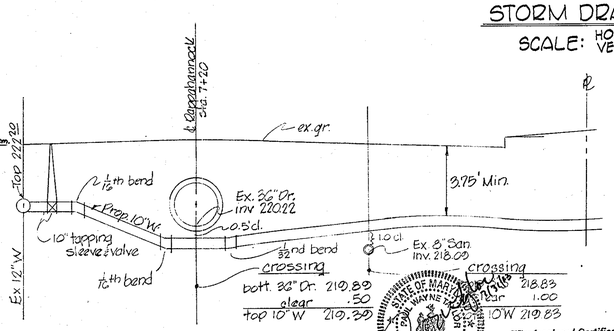

SUGGESTED
10" WATER CROSSINGS STA. 7+20
(no scale)

No.	REVISION
4 FSH	Added 67 parking spaces, stormdrain, stormceptor and landscaping. 05-28-04.
3 FSH	Added 2 Mezzanine Level additions 06-02-04

No.	REVISION
4 GWS	SEE SHT 3 OF 3 FOR PLANS & DETAILS

"Professional Certification. I hereby certify that these documents were prepared or approved by me, and that I am a duly licensed professional engineer under the laws of the State of Maryland, License No.# 13741 Expiration Date: 12-08-13"
GEORGE WILLIAM STEPHENS, JR.
AND ASSOCIATES, INC.
303 ALLEGHENY AVE.-TOWSON, MD, 21204

OPERATION AND MAINTENANCE SCHEDULE FOR STORMCEPTOR WATER QUALITY STRUCTURE

A. The Stormceptor Water Quality structure shall be periodically inspected and cleaned to maintain operation and function. The owner shall inspect the Stormceptor unit yearly at a minimum, utilizing the Stormceptor inspection/monitoring form. Inspections shall be done by using a clear Plexiglass tube ("sludge/judge") to extract a water column sample. When the sediment depths exceed the level specified in table 6 of the Stormceptor Technical Manual, the unit must be cleaned.
B. The Stormceptor water quality structure shall be checked and cleaned immediately after petroleum spills. The owner shall contact the appropriate regulatory agencies.
C. The maintenance of the Stormceptor unit shall be done using a vacuum truck which will remove the the water, sediment, debris, floating hydrocarbons and other materials in the unit. Proper cleaning and disposal of the removed materials and liquid must be followed by the owner.
D. The inlet and outlet pipes shall be checked for any obstructions at least once every six months. If obstructions are found the owner shall have them removed. Structural parts of the Stormceptor unit shall be repaired as needed.

The owner shall retain and make the Stormceptor inspection/Monitoring Forms available to the County officials upon their request.

4 STORMCEPTOR ORDER INFORMATION

STORMCEPTOR MODEL.....1200
STRUCTURE.....SC-1
TOP ELEVATION.....239.97
INLET PIPE INVERT.....231.56
OUTLET PIPE INVERT.....231.46
PIPE SIZE.....18" HDPE

NOTE:
SEE DRAINAGE AREA MAP FOR CONTRIBUTING IMPERVIOUS AREA TO STORMCEPTOR.
AREAS: ..... 0.64 Acres

GENERAL NOTES

1) All disturbed areas to be seeded in conjunction with the Howard Soil Conservation District and in accordance with the approved Soil Erosion & Sediment Control Plan for this subject site.
2) All slopes disturbed during utility construction shall be sodded and pegged immediately upon completion of work.
3) Contractor to remove existing bulkheads & headwalls before Tying into existing storm Drains.
4) All R.R. Construction to be done in accordance with B&O C & O. Standards.
5) Subgrade Cross-slope on railroad embankment shall have a 3" Crown in the center.

Precast Concrete Stormceptor® Order Request Form
(TO BE INCLUDED ON SWM PLAN BY DESIGNER)

CONTRACTOR INFORMATION
Name
Address
City
State
Zip Code
Contact
Phone
Fax

OWNER INFORMATION
Name Lancaster Foods
Phone 410.799.0010
Fax 410.799.0023

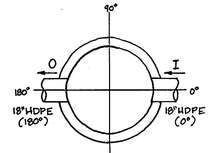

Please draw orientation of inlet and outlet pipes on diagram along with the pipe inside diameter (in), and invert elevation (ft). Clearly mark inlet pipes with an "I" and outlet pipes with an "O". Please provide the inlet/outlet pipe angle in degrees.

IMPERVIOUS DRAINAGE AREA FOR THIS UNIT 0.64 Ac.

Stormceptor® Model			
STC			
900	☐	3600	☐
1200	■	4800	☐
1800	☐	6000	☐
2400	☐	7200	☐
			CUSTOM

Insert Size: SINGLE INLET DISC ■; MULTIPLE INLET DISC ☐

Manhole Number	SC-1
Top Elevation (ft)	239.97
Inlet Pipe Invert (ft)	231.56
Outlet Pipe Invert (ft)	231.46
Pipe Type	HDPE
Inlet Pipe Inside Diameter (ID)	18"
Inlet Pipe Outside Diameter (OD)	
Outlet Pipe Inside Diameter (ID)	18"
Outlet Pipe Outside Diameter (OD)	

Project Name Lancaster Foods
Approximate time frame of delivery (weeks)
Delivery Address: Street 7895 Rappahannock Ave.
City: Jessup State: Maryland Zip Code: 20794
Designer Company FSH Associates
Designer Contact Zach Fisch Phone 410.750.2251 Fax 410.750.7250

PLEASE FILL OUT COMPLETELY AND FAX TO: CSR® Hydro Conduit
ATTN: ED O'MALLEY FAX: (703)922-3659, PHONE: (703)313-6389
FOR TECHNICAL ASSISTANCE PLEASE CALL MIKE BARG, PHONE (703)313-6399

4

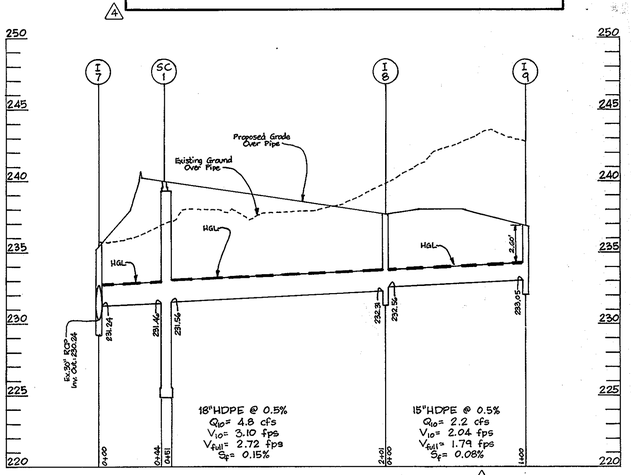

STORM DRAIN PROFILE 4
SCALE: Hor.: 1"=50'
Vert.: 1"=5'

APPROVED
DIVISION OF LAND DEVELOPMENT AND TRANSPORTATION PLANNING
HOWARD COUNTY, MARYLAND
DATE

SITE DEVELOPMENT PLAN
Parcel "A & B" Plat Book 24, Folio 17 Sec 2 Block "A"

DISTRIBUTION CENTERS, INC.

Howard Co., Md. Election Dist. No. 6
Scale: As Shown May 15, 1973

4
43
20F2

SDP 73-93

UTILITY LEGEND

CATV BOX		STORM DRAIN CLEANOUT	
CATV HANDBOX		STORM DRAIN DOWNSPOUT	
CATV PEDESTAL		STORM DRAIN MANHOLE	
ELECTRIC BOX		TELEPHONE BOX	
ELECTRIC HANDBOX		TELEPHONE HANDBOX	
ELECTRIC PEDESTAL		TELEPHONE MANHOLE	
ELECTRIC MANHOLE		TELEPHONE PEDESTAL	
ELECTRIC SWITCHGEAR		CALL BOX	
ELECTRIC TRANSFORMER		CARD READER	
STREET LIGHT		UNKNOWN MANHOLE	
LANDSCAPE LIGHT		UNKNOWN CLEANOUT	
TRAFFIC CONTROL HANDBOX		UTILITY POLE	
FIBER OPTIC BOX		VENT PIPE	
FIBER OPTIC HANDBOX		FIRE HYDRANT	
FIBER OPTIC MANHOLE		WATER MANHOLE	
FILL CAP		WATER METER	
FUEL TANK MANHOLE		WATER VALVE	
GAS MANHOLE		WATER WELL	
GAS METER		IRRIGATION CONTROL VALVE	
GAS VALVE	ABAND	ABANDONED UTILITY	
MONITORING WELL	CMP	CORRUGATED METAL PIPE	
SANITARY CLEANOUT	EOI	END OF ELECTRONIC INFORMATION	
SANITARY MANHOLE	NAU	NO ASSOCIATED UTILITY DETECTED	
STEAM MANHOLE	NFL	NOT FIELD LOCATABLE	

CW CHILLED WATER LINE (QL-B)
CW CHILLED WATER LINE (QL-C OR QL-D)
TV CABLE TV LINE (QL-B)
TV CABLE TV LINE (QL-C OR QL-D)
E ELECTRIC LINE (QL-B)
E ELECTRIC LINE (QL-C OR QL-D)
FO FIBER OPTIC LINE (QL-B)
FO FIBER OPTIC LINE (QL-C OR QL-D)
G GAS LINE (QL-B)
G GAS LINE (QL-C OR QL-D)
HW HOT WATER LINE (QL-B)
HW HOT WATER LINE (QL-C OR QL-D)
SS SANITARY SEWER LINE (QL-B)
SS SANITARY SEWER LINE (QL-C OR QL-D)
SD STORM DRAIN LINE (QL-B)
SD STORM DRAIN LINE (QL-C OR QL-D)
ST STEAM LINE (QL-B)
ST STEAM LINE (QL-C OR QL-D)
T TELECOMMUNICATIONS LINE (QL-B)
T TELECOMMUNICATIONS LINE (QL-C OR QL-D)
UK UNKNOWN DETECTED UTILITY/ CONDUCTOR (QL-B)
W WATER LINE (QL-B)
W WATER LINE (QL-C OR QL-D)

NAU

UTILITY DESIGNATING NOTES

- UTILITY DEPICTIONS CONFORM TO CI/ ASCE STANDARD 38-02.
- UTILITY QUALITY LEVELS DEFINED AS FOLLOWS"
  - QUALITY LEVEL "D" (QL-D) INFORMATION COMES SOLELY FROM EXISTING UTILITY RECORDS.
  - QUALITY LEVEL "C" (QL-C) INVOLVES SURVEYING VISIBLE ABOVEGROUND UTILITY FACILITIES, SUCH AS MANHOLES, VALVE BOXES, POSTS, ETC., AND CORRELATING THIS INFORMATION WITH EXISTING UTILITY RECORDS.
  - QUALITY LEVEL "B" (QL-B) – DESIGNATING INVOLVES THE USE OF SURFACE GEOPHYSICAL TECHNIQUES TO DETERMINE THE EXISTENCE AND APPROXIMATE HORIZONTAL POSITION OF UNDERGROUND UTILITIES.
  - QUALITY LEVEL "A" (QL-A) – LOCATING INVOLVES THE USE OF NONDESTRUCTIVE DIGGING EQUIPMENT AT CRITICAL POINTS TO DETERMINE THE PRECISE HORIZONTAL AND VERTICAL POSITION OF UNDERGROUND UTILITIES, AS WELL AS THE TYPE, SIZE, CONDITION, MATERIAL, AND OTHER CHARACTERISTICS.
- THE SUBSURFACE UTILITIES DEPICTED HEREON AT QUALITY LEVEL "B" REPRESENT THE REMOTELY SENSED INDICATION OF THE SUBSURFACE UTILITY. UTILITY PIPE SIZES AND CONFIGURATIONS HAVE BEEN TAKEN FROM RECORD DRAWINGS AND ACCESSIBLE FIELD EVIDENCE. THE ACTUAL LOCATION, SIZE AND EXTENT OF ALL SUBSURFACE UTILITIES MUST BE DETERMINED THROUGH TEST HOLE OR OTHER QUALITY LEVEL "A" INVESTIGATION METHODS.
- AN EFFORT HAS BEEN MADE TO DEPICT UTILITIES AT QL "B". SOME UTILITIES ARE SHOWN AT QL "C" OR QL "D" AS NECESSARY.
- ALL GRAVITY SYSTEMS REPRESENTED AT QUALITY LEVEL "C" (QL-C) UNLESS OTHERWISE INDICATED.
- UTILITY SURFACE FEATURES, E.G. VALVES, MANHOLES AND VAULTS, ARE SHOWN SYMBOLICALLY AND THEIR SIZE AND SHAPE ARE SCHEMATIC AND NOT TO SCALE. EXCEPT AS SPECIFICALLY STATED HEREON, SUBSURFACE CONDITIONS SUCH AS SIZE AND ORIENTATION OF ANY ASSOCIATED STRUCTURE HAVE NOT BEEN DETERMINED. ACTUAL DIMENSIONS AND POSITIONS MUST BE DETERMINED THROUGH ADDITIONAL SUBSURFACE UTILITY INVESTIGATION.
- THE UNDERGROUND UTILITY LOCATIONS SHOWN HEREON REPRESENT A PROFESSIONAL OPINION AND INTERPRETATION BASED ON RECORD INDICATIONS AND FIELD EVIDENCE INCLUDING THE USE OF ELECTRONIC UTILITY DETECTION EQUIPMENT. THE RESULTS OF THIS UTILITY INVESTIGATION MAY BE AFFECTED BY THE AVAILABILITY OF UTILITY RECORD INFORMATION AND A VARIETY OF EXISTING SITE CONDITIONS. SITE CONDITIONS THAT MAY AFFECT THE RELIABILITY OF DETECTED UTILITY LOCATIONS INCLUDE SOIL CONTENT, DEPTH OF UTILITY, DENSITY OF UTILITY CLUSTERS, AND ELECTROMAGNETIC CHARACTERISTICS OF THE TARGET UTILITIES.
- AUTOCAD REFERENCE FILES USED IN THIS DRAWING: "11424topo2013.dwg" & "11424cogo.dwg" PROVIDED BY GEORGE WILLIAM STEPHENS, JR. AND ASSOCIATES, INC. FOR BASE MAP/ PLANIMETRIC FEATURES.

SURVEY REFERENCE NOTES

ALL HORIZONTAL SURVEY DATA CONTAINED IN UTILITY MAPPING FILE "11424_SDP73-93_9-20-13_Sht3.dwg" ARE REFERENCED TO TRAVERSE POINTS PROVIDED BY GEORGE WILLIAM STEPHENS, JR. AND ASSOCIATES, INC., INCLUDING:

POINT#	NORTHING	EASTING	DESCRIPTION
1	544020.37	1374204.65	PIN & CAP
2	543884.45	1373633.38	PIN & CAP

2 CONSTRUCT NEW DOMESTIC WATER SERVICE. WORK TO BE PERFORMED UNDER "ADO" PLAN BY OWNER.

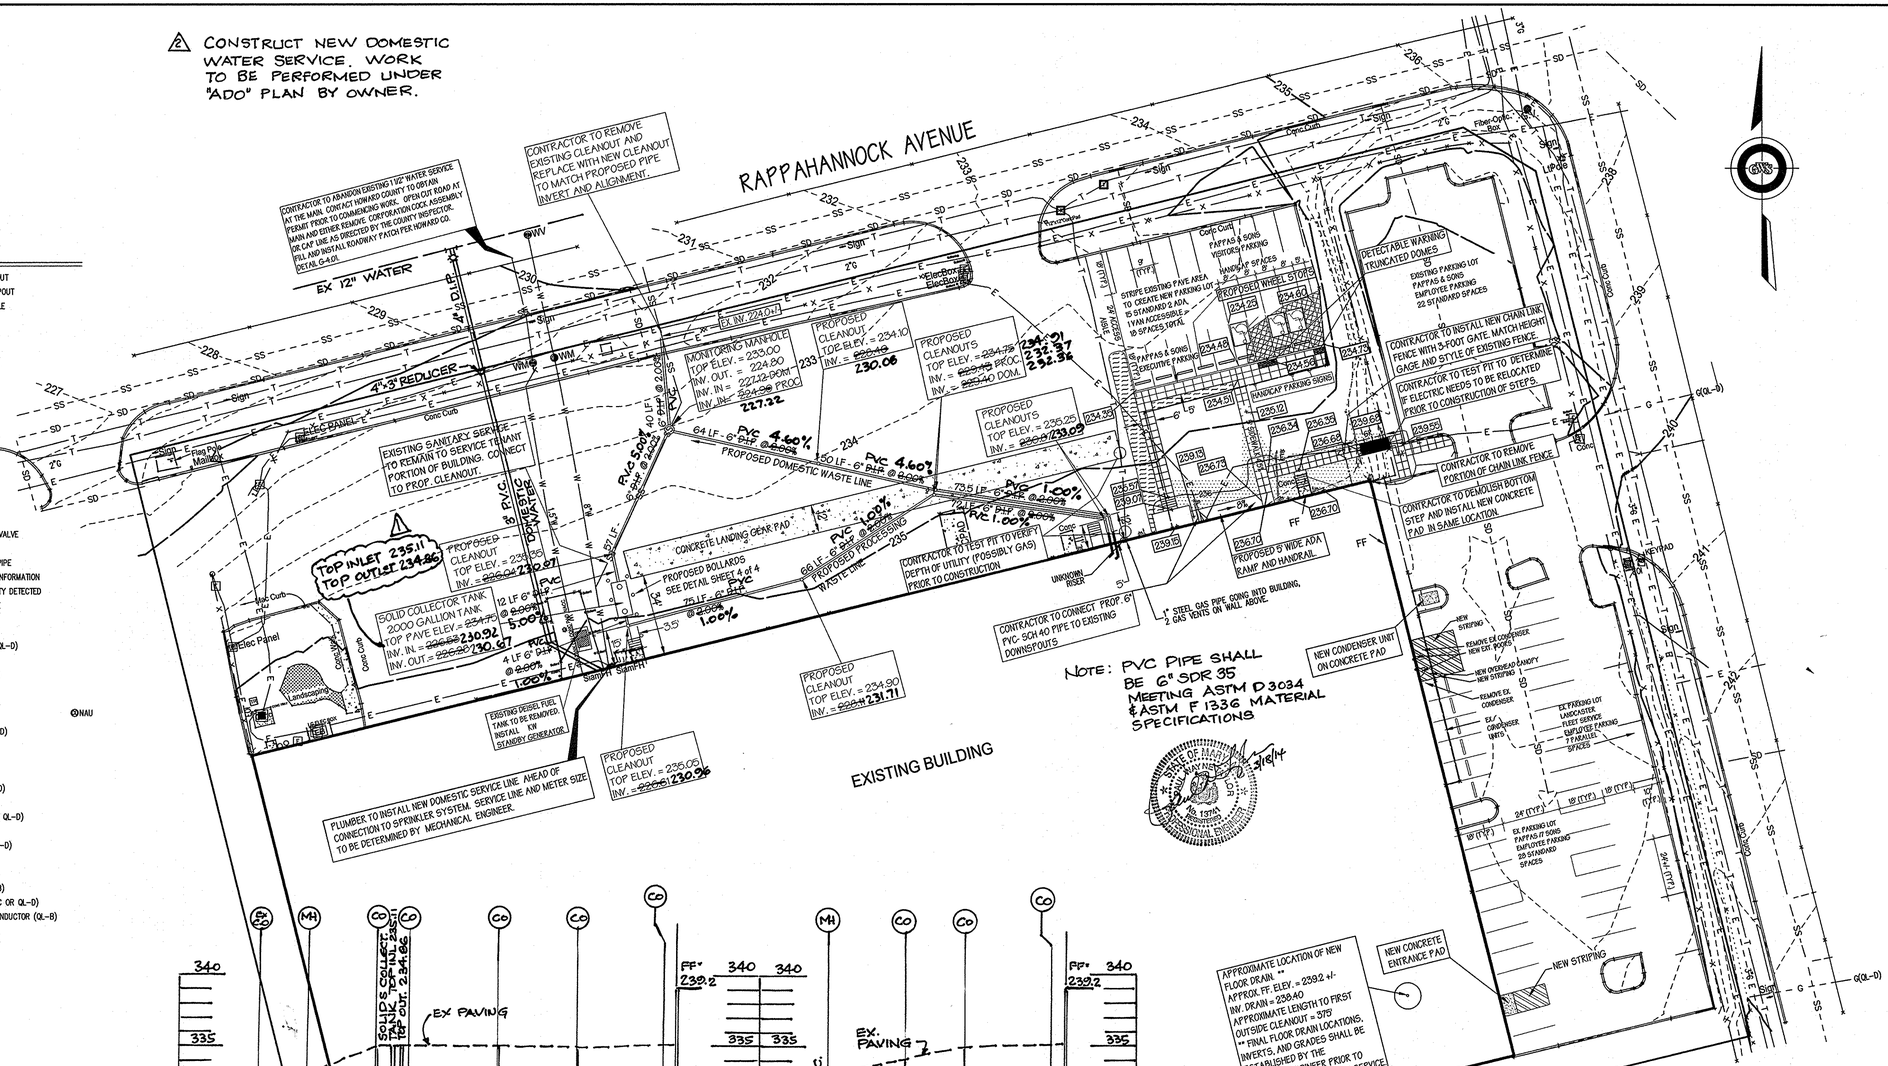

PLAN
SCALE 1" = 30'

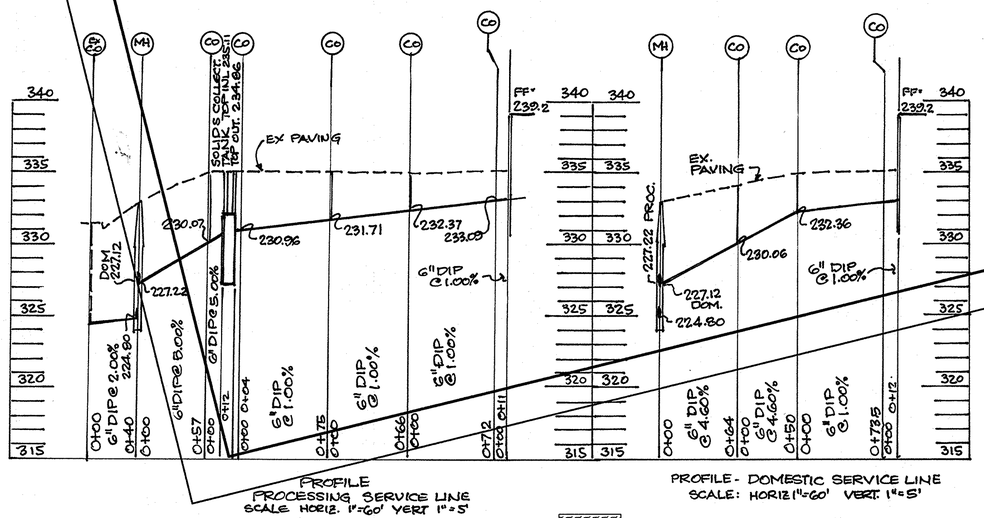

PROFILE
PROCESSING SERVICE LINE
SCALE HORIZ. 1"=60' VERT 1"=5'

PROFILE - DOMESTIC SERVICE LINE
SCALE: HORIZ 1"=60' VERT 1"=5'

REMOVE EXISTING PAVEMENT. FILL AND INSTALL 2" TOPSOIL SEED & MULCH

AREA TO BE FILLED AND INSTALL 2" TOPSOIL SEED & MULCH TO MEET PROPOSED SIDEWALK.

CONTRACTOR TO REPAVE HATCHED AREA TO MEET SPOT ELEVATIONS.

CONTRACTOR TO CUT OUT EXISTING MACADAM AND BASE AND INSTALL NEW CONCRETE LANDING-GEAR PAD.

PAVEMENT PATCHING NOTES:

1. AT THE OWNER'S REQUEST, THE CONTRACTOR MAY BE ASK TO PROVIDE ADDITIONAL CUT AND PATCHING OF SELECTED AREAS IN THE PARKING LOT AND LOADING AREA WHERE PAVEMENT IS FAILING. THE CONTRACTOR SHALL BE PAID ON A SQUARE YARD UNIT PRICE BASIS FOR CUTTING EXISTING MATERIAL, REMOVING FROM SITE, AND PATCHING IN ACCORDANCE WITH THE "UTILITY TRENCH ROADWAY PATCH" DETAIL G-4.01 AS SHOWN ON SHEET 4 OF 4. OWNER'S REPRESENTATIVE AND CONTRACTOR SHALL MARK, MEASURE AND DETERMINE QUANTITY PRIOR TO THIS WORK BEING PERFORMED.

2. PATCH AND PAVING AS THE RESULT OF INSTALLATION OF THE PROPOSED SEWER LINES SHALL BE CONSIDERED INCIDENTAL TO THE CONSTRUCTION OF THE SEWER AND INCLUDED IN THE PRICE OF THE SEWER LINE CONSTRUCTION.

"PROFESSION CERTIFICATION: I HEREBY CERTIFY THAT THESE DOCUMENTS WERE PREPARED OR APPROVED BY ME, AND THAT I AM A DULY LICENSED PROFESSIONAL ENGINEER UNDER THE LAWS OF THE STATE OF MARYLAND, LICENSE # 13741 EXPIRATION DATE 12-08-2015

10/1/14 ⚠ REV. SAN. SEWER SERVICE PIPE GRADES 2-24-14 PWT

4-26-14 ⚠ ADD NEW DOMESTIC WATER SERVICE 4-26-14 PWT

BEFORE YOU DIG CALL "811" MISS UTILITY ONE CALL BEFORE YOU DIG 811 Know what's below. Call before you dig.

APPROVED: HOWARD COUNTY DEPARTMENT OF PLANNING AND ZONNING

DIRECTOR — DATE 10/17/13

CHIEF, DIV. OF LAND DEVELOPMENT — DATE 10/10/13

CHIEF, DIV. OF ~~ENGINEERING~~ DEVELOPMENT — DATE 10/9/13

BALODEMAS ARCHITECTS CHARTERED
4301 Connecticut Ave NW
Suite 149
Washington, DC 20008
202-363-4820
Fax 4821

CIVIL ENGINEER:
George W. Stephens, Jr. & Associates, Inc.
4692 Millennium Drive
Suite 100
Belcamp, Maryland 21017
410-297-2340
Fax 2345

MECH/ELEC ENGINEER:
CS Consulting Engineers, Inc.
CS Consulting Engineers, Inc.
1300 Piccard Drive
Suite 104
Rockville, MD 20850
301-977-7644
Fax 7643

STRUCTURAL ENGINEER:
MCCE 1200 ARCHITECTURAL ENGINEERS, PLLC
210 N Lee Street
Suite 210
Alexandria, VA 22314
703-350-4151

OWNER:
PETE PAPPAS & SONS, INC.
1401 Okie St NE
Washington, DC 20002
202-526-2929
www.petepappasinc.com

PROJECT:
RENOVATION
7825A
RAPPAHANNOCK AVE
JESSUP, MD 20794

DRAWING:

SEAL:
9/20/13

Professional Certification:
I certify that these documents were prepared or approved by me, and that I am a duly licensed architect under the laws of the State of Maryland, license number 13741, expiration date 12/08/13.

JULY 31, 2013

DWG. No.
SDP 73-93
SHEET 3 OF 4

© 2013 BALODEMAS ARCHITECTS CHTD.

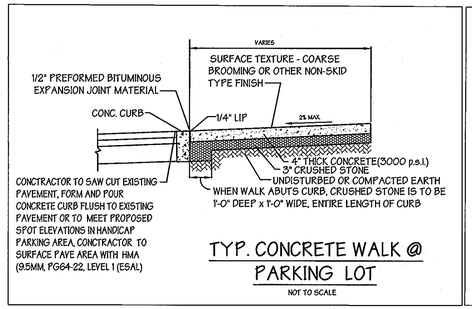

TYP. CONCRETE WALK @ PARKING LOT

NOT TO SCALE

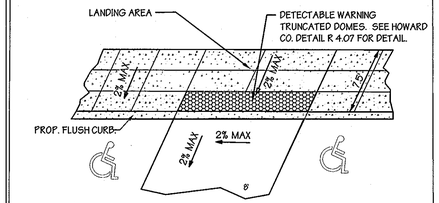

HANDICAP RAMP DETAIL

NOT TO SCALE

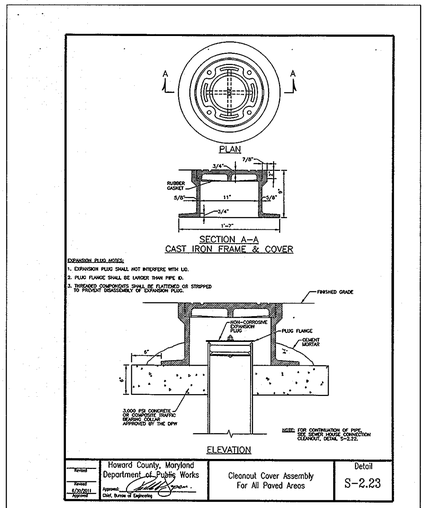

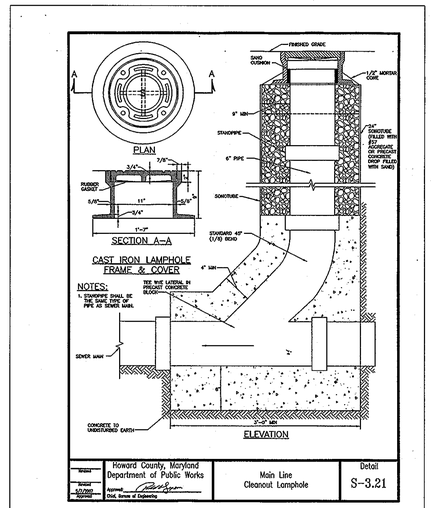

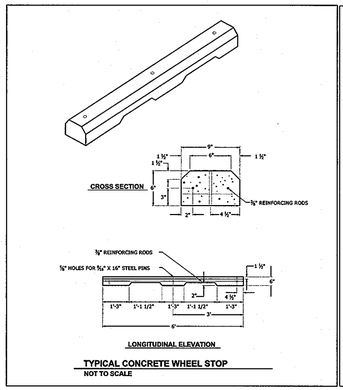

TYPICAL CONCRETE WHEEL STOP

NOT TO SCALE

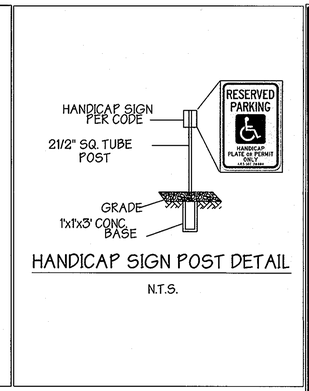

HANDICAP SIGN POST DETAIL

N.T.S.

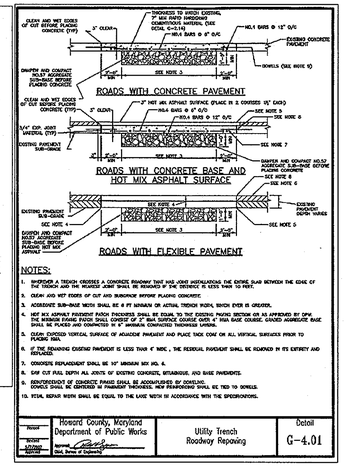

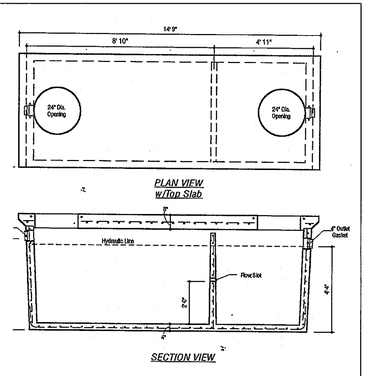

N.DATA & GENERAL NOTES:
NORM STRENGTH 7C = 4,000 p.s.i. @ 28 days. Density = 150 pcf.
MORT - Portland Type VII per ASTM C 150-92.
REINFORCING & STIRRUPS per ASTM C 920-84 & C 494-92.
All design per AASHTO M-170, Grade 60, Concrete. Min. 1-1/2" cover.
Slab design for HS-20 standard for HS-20 loading.
Slab should be both ways reinforced.
Allow 3'-0" earth cover over top slab.

2000 GALLON TANK HEAVY DUTY RATED SOLID COLLECTOR

* OWNER MAY REQUIRE CONCRETE TO BE A HIGH EARLY STRENGTH CONCRETE BE SUBSTITUPED IN ORDER TO MAINTAIN WAREHOUSE OPERATIONS.

CONCTRACTOR TO FORM AND POUR CONCRETE PAD FLUSH TO EXISTING PAVEMENT. IF NOT ABLE TO FORM SMOOTH CONTINUOUS GRADE THE MEET EXISTING PAVEMENT ELEVATION, CONTRACTOR TO SURFACE PAVE AREA WITH HMA (9.5MM, PG64-22, LEVEL 1 (ESAL)

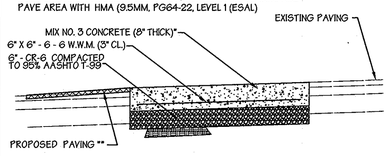

CONCRETE LANDING GEAR PAD DETAIL

NOT TO SCALE

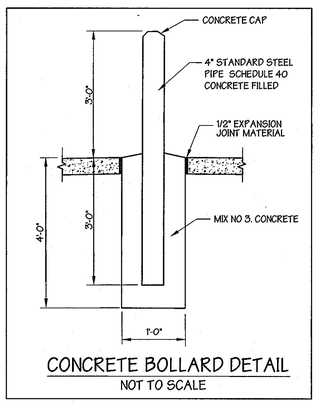

CONCRETE BOLLARD DETAIL

NOT TO SCALE

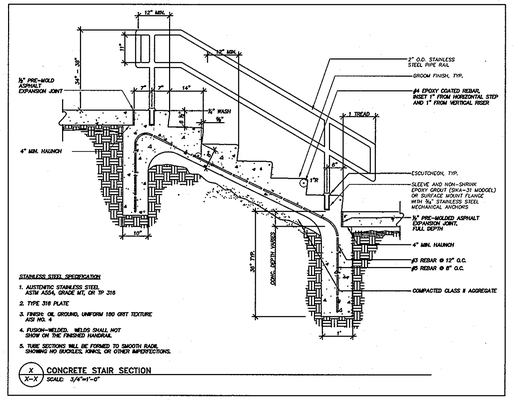

BEFORE YOU DIG CALL "811"
MISS UTILITY
DIG SAFE. DIG RIGHT. DIG BEFORE YOU DIG
811
Know what's below. Call before you dig.

APPROVED: HOWARD COUNTY DEPARTMENT OF PLANNING AND ZONNING

DIRECTOR — DATE 10/7/13

CHIEF, DIV. OF LAND DEVELOPMENT — DATE 10/9/13

CHIEF, DIV. OF ~~ENGINEERING~~ DEVELOPMENT ENGR. — DATE 10/9/13

BALODEMAS ARCHITECTS
CHARTERED
4301 Connecticut Ave NW
Suite 149
Washington, DC 20008
202-363-4820
Fax 4821

CIVIL ENGINEER:
George W. Stephens, Jr. & Associates, Inc.
4692 Millennium Drive
Suite 100
Belcamp, Maryland 21017
410-297-2340
Fax 2345

MECH/ELEC ENGINEER:
CS Consulting Engineers, Inc.
CS Consulting Engineers, Inc.
1300 Piccard Drive
Suite 104
Rockville, MD 20850
301-977-7644
Fax 7643

STRUCTURAL ENGINEER:
MCCE1200 ARCHITECTURAL ENGINEERS, PLLC
210 N Lee Street
Suite 210
Alexandria, VA 22314
703-350-4151

OWNER:
PETE PAPPAS & SONS, INC.
1401 Okie St NE
Washington, DC 20002
202-526-2929
www.petepappasinc.com

PROJECT:
RENOVATION
7825A
RAPPAHANNOCK AVE
JESSUP, MD 20794

DRAWING:

SEAL:
9/20/13

Professional Certification:
I certify that these documents were prepared or approved by me, and that I am a duly licensed architect under the laws of the State of Maryland, license number 13741, expiration date 12/08/13.

JULY 31, 2013

DWG. No.

SDP 73-93
SHEET 4 OF 4

© 2013 BALODEMAS ARCHITECTS CHTD.