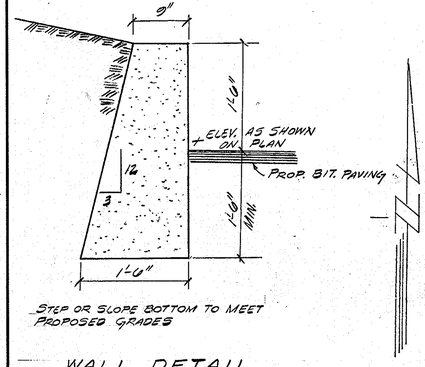

STEP OR SLOPE BOTTOM TO MEET PROPOSED GRADES

WALL DETAIL

SCALE: 1"=1'-0"

STATE OF MARYLAND — KENNETH W. MESSERSMAN — No. 21342 — REGISTERED PROFESSIONAL ENGINEER

6-10-04 — ADDED 1½" WATER HOUSE CONNECTION / SERVICE TO SITE.

FOR REDLINE REVISION #3
PREPARED BY BOHLER ENGINEERING, P.C.

GENERAL NOTES

1. CONTRACTOR TO NOTIFY THE UTILITY COMPANIES AT LEAST THREE (3) DAYS BEFORE STARTING WORK SHOWN ON THESE PLANS.
2. INSTALLATION OF TRAFFIC CONTROL DEVICES, MARKING, AND SIGNING SHALL BE IN ACCORDANCE WITH THE MANUAL OF UNIFORM TRAFFIC CONTROL DEVICES. 1971 EDITION.
3. ALL REINFORCED CONCRETE SHALL HAVE A MINIMUM 28 DAYS STRENGTH OF 3500 PSI.
4. ALL DISTURBED SLOPE AREA TO BE STABILIZED AS SOON AS GRADING IS COMPLETED.
5. ANY DAMAGE TO PUBLIC RIGHT-OF-WAYS OR PAVING WILL BE CORRECTED AT THE DEVELOPER'S EXPENSE.

Parking Required: (3) (4)

A. Gasoline Service Station with service bays = 3 spaces
B. Three (3) spaces per service bay = 18 spaces
C. Two (2) spaces per 1,000 sf of Convenience Store floor area = 4.5 spaces ≈ 5 spaces
Total Required: TWENTY-SIX (26)

Parking Provided:
THIRTY (30) spaces including two (2) Handicap spaces

VILLAGE OF OWEN BROWN — SECTION I — AREA I — RESUBDIVISION OF PARCEL E-4 — P. 3472 (EXIST. TOWNHOUSES)

VILLAGE OF OWEN BROWN
LOT 1-A OPEN SPACE

N 492800 E 843500

Prop. Trash enclosure

NEW TYPE "B" LIGHT POLE AND FOUNDATION

S 89° 18' 28" W 271.28'

8'-0" 10'-0" TRASH ENCLOSURE

8" REINF. CONCRETE TRASH PAD


3 SPACES @ 10' EA = 30'

2 HANDICAPPED PARKING SPACES

PROP. 36'-0" x 30'-1" BLDG. ADDITION 1,085 sf FF=328.50

REMOVE EXISTING LIGHT POLE & REPLACE W/ NEW TYPE "B"

REMOVE EXISTING LIGHT POLE & REPLACE W/ NEW TYPE "B"

8' REINF. CONC. PAD

REDUCE HEIGHT OF WALL TO MEET TOP OF CURB ELEV. = 330.58

T.W.=331.70 T.C.=330.70

T.C.=328.0

T.C.=328.5

T.C.=327.80

T.C.=327.75

T.C.=327.5

T.C.=326.5

T.C.=-0.5

T.C.=-1.5

MOBIL OIL CORPORATION STANDARD "GS" SIGNAGE

REF #	REFERENCE	LOCATION	AREA PER FACE (S.F.)	QTY.	TOT. AREA (S.F.)	COMMENTS
	FREESTANDING SIGNAGE					
1	MOBIL MONUMENT ID SIGN	ALONG CRADLEROCK WAY	23.80	1 SIDE	23.80	ILLUMINATED
2	MOBIL MONUMENT PRICE SIGN	ALONG CRADLEROCK WAY	19.80	1 SIDE	19.80	ILLUMINATED
3	EX. MOBIL MONUMENT ID SIGN	ALONG ACCESS ROAD	28.66	1 SIDE	28.66	ILLUMINATED
	** SUB-TOTAL **				**52.46**	
	** BUILDING MOUNTED SIGNAGE ** FOR MOBIL GS BUILDING					
4	EX. 4' DIA. PEGASUS DISK	RIGHT SIDE OF BUILDING	12.56	1	12.56	ILLUMINATED
5	SNAP-LOCK SIGNS	FRONT OF BUILDING	8.0	2	16.0	NON-ILLUMINATED
	** SUB-TOTAL **				**28.56**	
6	FOR CANOPY "MOBIL" CANOPY LEGEND	CANOPY FASCIA	17.0	2	34.0	ILLUMINATED
	** SUB-TOTAL **				**34.0**	

GRAND TOTAL 115.02 < 201 S.F. (MAX. ALLOWED)

COMPUTATIONS/REQUIREMENTS PER "HOWARD COUNTY, MARYLAND - 'THE SIGN CODE' SUBTITLE 5"
PRICE SIGN NOT COMPUTED INTO MAXIMUM ALLOWABLE SIGN AREA (SECT. 3.501.C.2.C)

TOTAL SIGN AREA = 2 SQ. FT. / 1 LINEAL FOOT OF BUILDING FRONTAGE = 84' × 2 = 168 SQ. FT.
1 SQ. FT. / 1 LINEAL FOOT OF BUILDING (SIDE) FRONTAGE = 33' × 1 = 33 SQ. FT.
(SECT. 3.501.C.2.C) 201 SQ. FT. TOTAL SIGN AREA ALLOWED

FREESTANDING SIGN MAX AREA ALLOWED: 1 SQ. FT. FOR EACH 1FT. THE SIGN IS SET BACK FROM THE ROAD RIGHT-OF-WAY, = FRONT = 24' × 1' = 24 SQ. FT. MAX. ALLOWED
23.8 SQ. FT. PROPOSED SIGN AREA (INCLUDE IN TOTAL SIGN AREA ALLOWED)

THE MAXIMUM ALLOWABLE AREA FOR A FREESTANDING SIGN SHALL BE 1 SQUARE FOOT FOR EACH 1 FOOT THE SIGN IS SET BACK FROM THE ROAD RIGHT-OF-WAY.

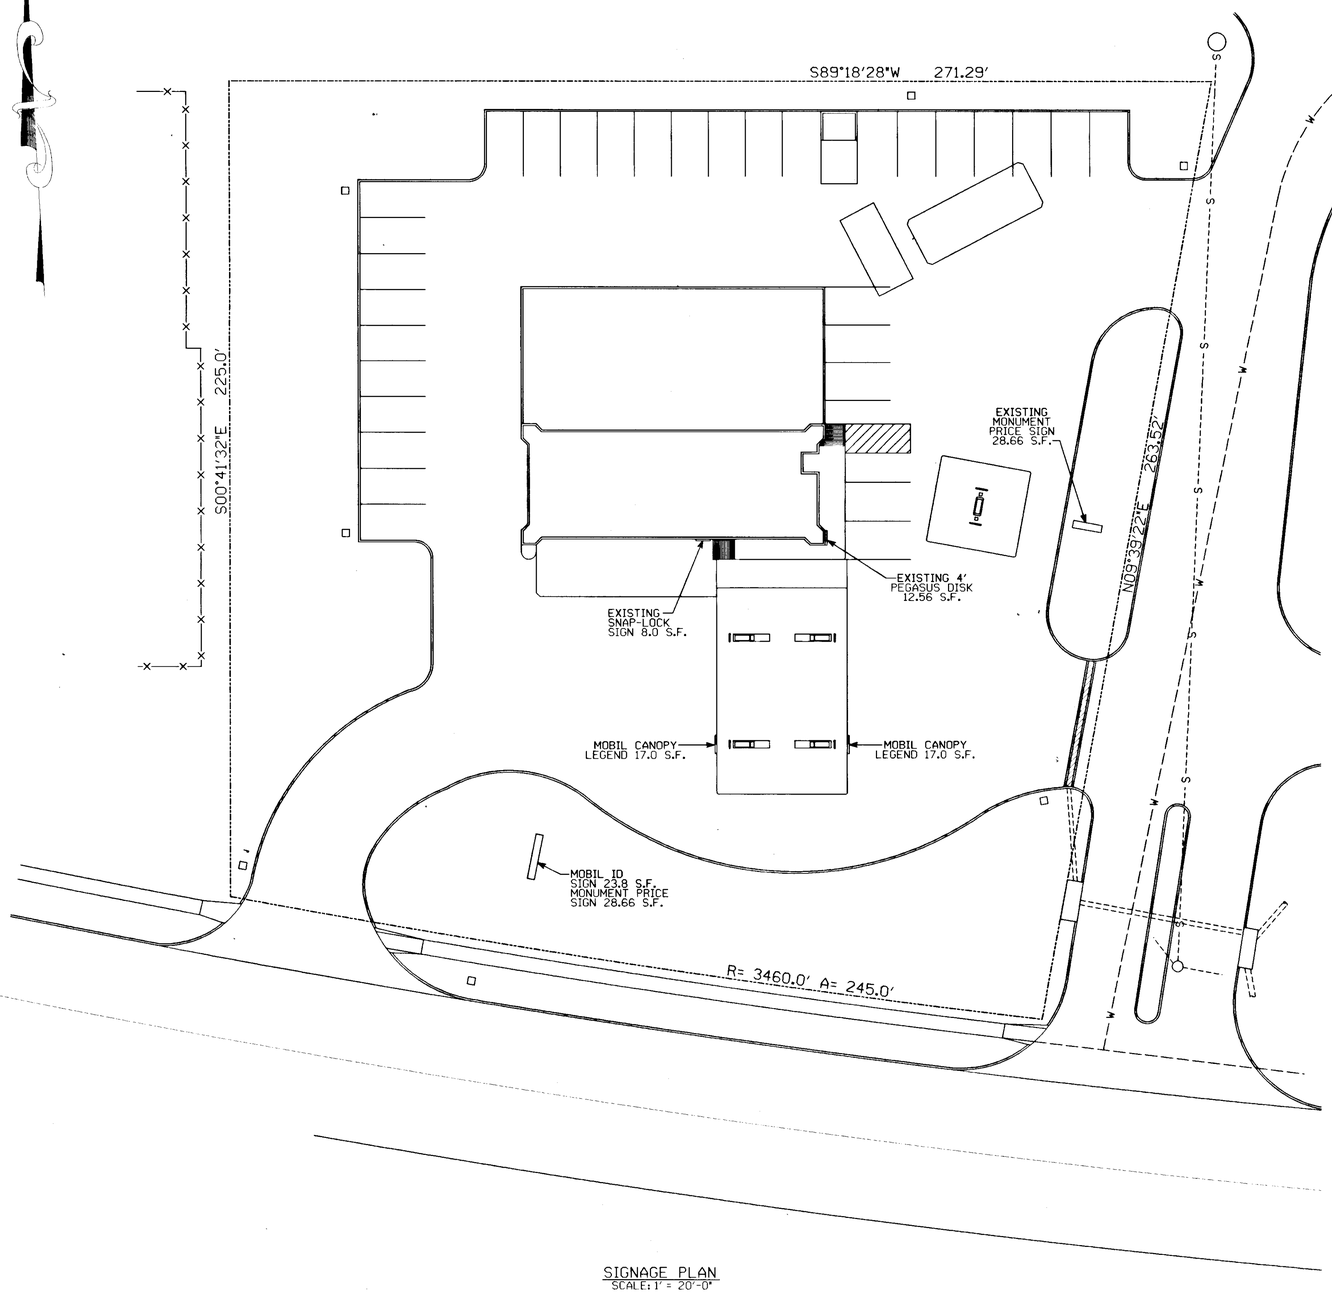

SIGNAGE PLAN
SCALE: 1" = 20'-0"

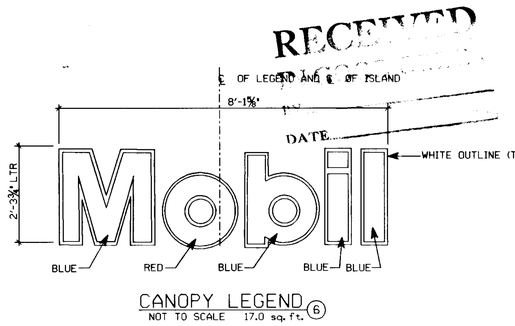

CANOPY LEGEND ⑥
NOT TO SCALE 17.0 sq. ft.

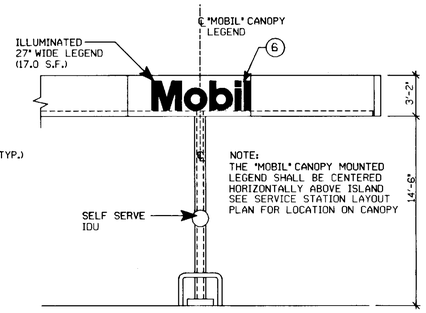

CANOPY
FRONT ELEVATION
SCALE: NO SCALE

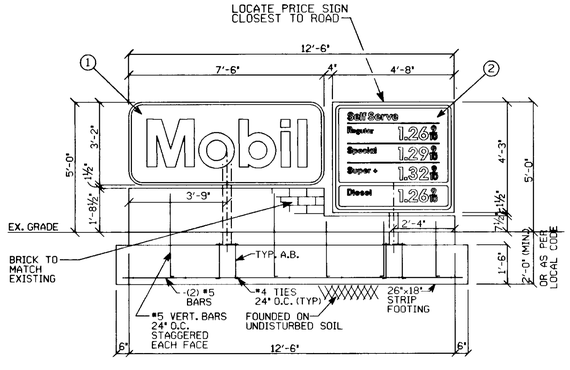

MONUMENT SIGN
SCALE: ⅜" = 1'-0"
① 7'-6" ID SIGN = 23.8 S.F./SIDE
② TYPE "B" PRICE SIGN = 19.8 S.F./SIDE

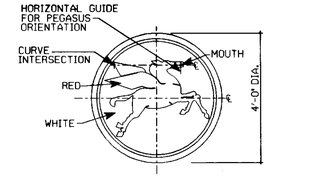

EXISTING 4' PEGASUS DISK ③
NOT TO SCALE 12.56 sq. ft.

RECEIVED

STATE OF MARYLAND — MARK S. STIRES No. 18987 — REGISTERED PROFESSIONAL ENGINEER

SUPPLEMENTAL DRAWING TO SDP 78-78C
AMMENDED 01/95 MARK S. STIRES

MARK S. STIRES P.E.
PROFESSIONAL ENGINEER
MARYLAND LICENSE No. 18987

EASTERN CONSULTING INC.
•CIVIL & CONSULTING ENGINEERS •PROJECT MANAGERS
•ENVIRONMENTAL & SITE PLAN •PERMIT EXPEDITORS

EASTERN CONSULTING INC.
15 Douglas Court
Sterling, Va. 20166
PHONE:(703) 904-8350 FAX:(703) 904-8358

MOBIL SERVICE STATION
7248 CRADLEROCK WAY
COLUMBIA, MARYLAND

Proj. No. S93028
SS# 16-J9Q

DRAWING NUMBER S93028SG
SHEET NUMBER 1A of 4

REV | NO | REVISIONS | DATE | BY | CHKD

THIS DRAWING AND ALL INFORMATION THEREON IS THE PROPERTY OF MOBIL OIL CORP. AND SHALL NOT BE COPIED OR USED EXCEPT FOR THE PURPOSE FOR WHICH IT IS EXPRESSLY FURNISHED. THE DRAWING AND ALL COPIES THEREOF MADE BY ANY PARTY SHALL BE RETURNED TO THE OWNER ON DEMAND.

DRAWN KPF
CHECKED BJ
SCALE AS NOTED
DATE 11/28/94

PROPOSED SIGNAGE PLAN & ELEVATIONS

Mobil Oil Corporation
U.S. Marketing & Refining Division Engineering Department
Marketing Operations
Fairfax, Virginia 22037

DESIGN FILE NAME: S93028SG.DGN;2

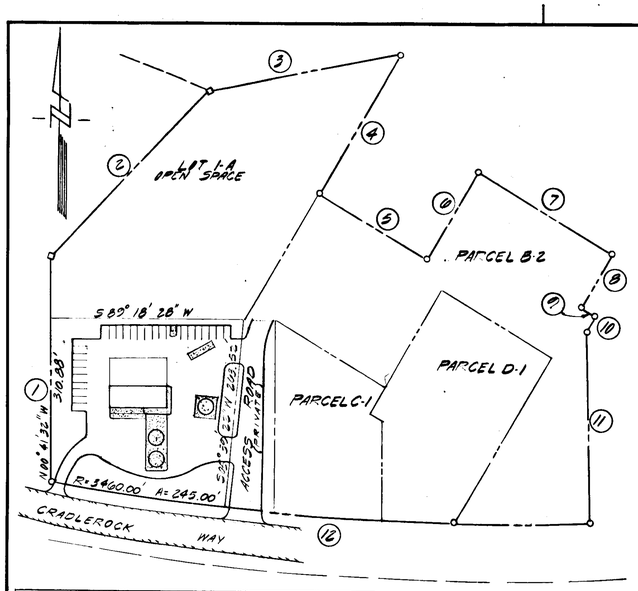

PROPERTY OUTLINE

SCALE: 1" = 100'

PROPERTY BOUNDARY OUTLINE			
1	N 0° 41' 32" W 318.88	7	N 59° 29' 23" W 220.90
2	N 43° 34' 11" E 318.52	8	S 30° 30' 37" W 85.00
3	N 79° 04' 10" E 272.88	9	S 59° 29' 23" E 20.00
4	S 30° 30' 37" W 223.20	10	S 30° 30' 37" W 23.85
5	N 59° 29' 23" W 175.00	11	S 02° 50' 05" E 226.15
6	S 30° 30' 37" W 140.00	12	R=3400.00 A=701.27

STRUCTURE SCHEDULE						
NO	TYPE	ELEVATION LOWER	ELEVATION UPPER	REMARKS	INV. IN	INV. OUT
I-1	A-10 W = 2'-0"	322.24	322.46	HOWARD CO. STD DWG. U-4-A PG. 119-A	316.14	315.64
I-2	A-10 W = 2'-0"	322.24	322.46	HOWARD CO. STD. DWG. U-4-A PG. 119-A	319.90	318.60
I-3	SPECIAL STRUCTURE	324.00		SEE DETAIL THIS SHEET	323.33	322.67

PIPE SCHEDULE		
SIZE	TYPE	LENGTH
12"	R.C.P. CL-III	27'
15"	R.C.P. CL-II	45'
18"	R.C.P. CL-II	33'

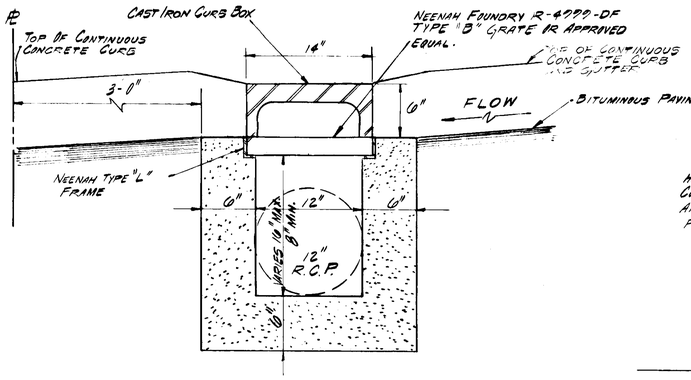

SECTION "A"-"A"

SCALE: 1½" = 1'-0"

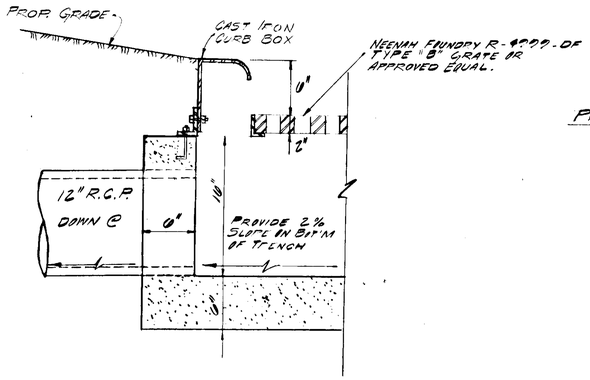

SECTION "B"-"B"

SCALE: 1½" = 1'-0"

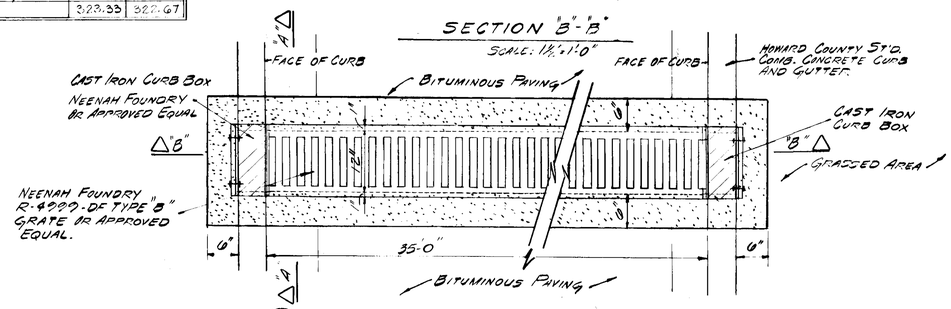

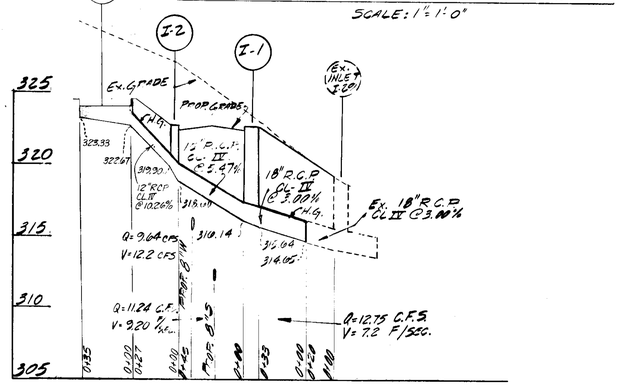

PLAN VIEW STRUCTURE I-3

SCALE: 1" = 1'-0"

STORM DRAIN PROFILE

SCALE: 1" = 5' VERT.
1" = 50' HORIZ.

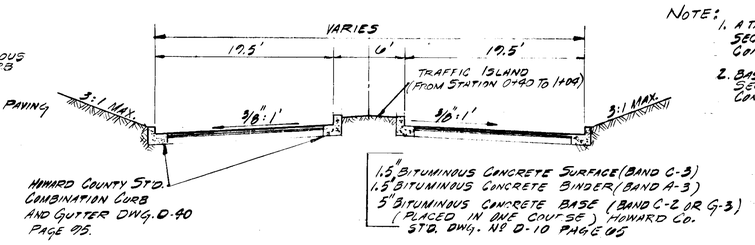

TYPICAL SECTION PRIVATE ACCESS ROAD

NO SCALE

NOTE:

1. A TACK COAT IS REQUIRED IN ACCORDANCE WITH SECTION C-31-4 OF THE HOWARD COUNTY ROAD CONSTRUCTION CODE AND SPECIFICATIONS.
2. BASE WILL BE PRIMED IN ACCORDANCE WITH SECTION C-30-3 OF THE HOWARD COUNTY ROAD CONSTRUCTION CODE AND SPECIFICATIONS.

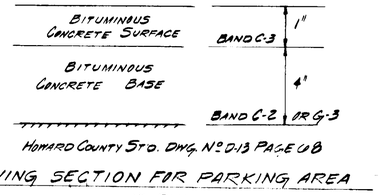

HOWARD COUNTY STD. DWG. NO. D-13 PAGE 98

PAVING SECTION FOR PARKING AREA

NO SCALE

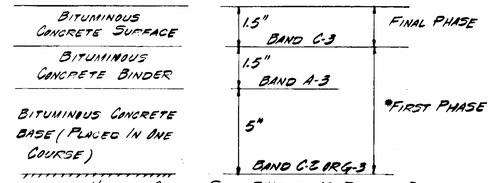

HOWARD COUNTY STD DWG. D-10 PAGE 95

PAVING SECTION FOR PRIVATE ACCESS ROAD APRON

NO SCALE

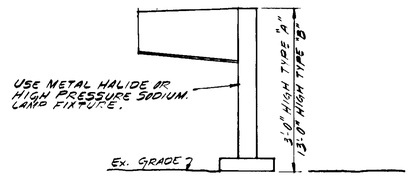

TYPICAL LIGHTING DETAIL

NO SCALE

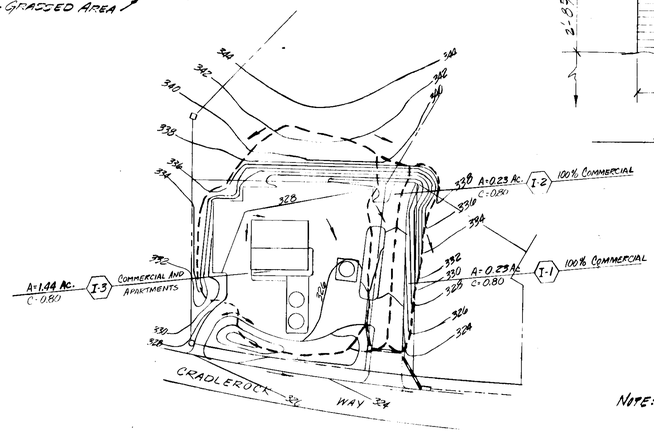

DRAINAGE AREA MAP

SCALE: 1" = 100'

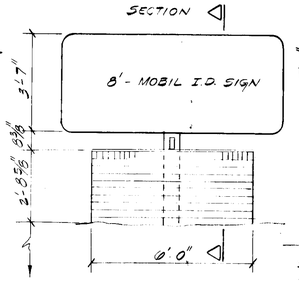

ELEVATION

3/8" = 1'-0"

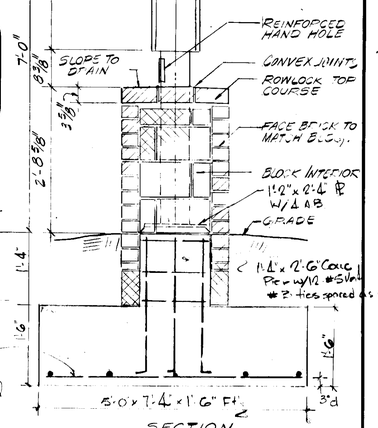

NOTE: ALL CONSTRUCTION SHALL BE IN ACCORDANCE WITH THE HOWARD COUNTY ROAD CONSTRUCTION CODE AND STANDARD SPECIFICATIONS.

APPROVED FOR PUBLIC WATER AND PUBLIC SEWERAGE SYSTEMS HOWARD COUNTY HEALTH DEPARTMENT.

COUNTY HEALTH OFFICER — 6-5-78 DATE

APPROVED HOWARD COUNTY OFFICE OF PLANNING AND ZONING

PLANNING DIRECTOR — 6-7-78 DATE

CHIEF, DIVISION OF LAND DEVELOPMENT — 6-6-78 DATE

APPROVED FOR PUBLIC WATER AND PUBLIC SEWERAGE STORM DRAINAGE SYSTEMS AND PUBLIC ROADS HOWARD COUNTY DEPARTMENT OF PUBLIC WORKS.

DIRECTOR — 6/1/78 DATE

CHIEF BUREAU OF ENGINEERING — 6-1-78 DATE

THIS DRAWING IS THE PROPERTY OF MOBIL OIL CORPORATION. IT CONTAINS INFORMATION REGARDED AS CONFIDENTIAL BY MOBIL OIL. THIS DRAWING AND THE INFORMATION THEREON IS NOT TO BE USED OR DISCLOSED TO OTHERS EXCEPT WITH WRITTEN MOBIL OIL AUTHORIZATION. THIS DRAWING IS NOT TO BE REPRODUCED OR COPIED WITHOUT PERMISSION AND IS TO BE RETURNED TO MOBIL OIL WITH ANY COPIES (PARTIAL OR COMPLETE) ON DEMAND.

N41042

8" = FULL SCALE

NO.	REVISIONS	DATE	BY	CHKD.	MF
	APPROVED PLANNING BOARD OF HOWARD COUNTY DATE 4-26-78				

MACRIS - FOWLER ASSOCIATES
CIVIL - STRUCTURAL ENGINEERS SURVEYORS, PLANNERS
27 W. JEFFERSON ST. ROCKVILLE MD. 20850
(301) 340-8705 (301) 762-3858

Mobil Oil Corporation
NORTH AMERICAN DIVISION
EASTERN REGION
VALLEY FORGE, PA 19482

SITE DEVELOPMENT PLAN
VILLAGE OF OWEN BROWN
SECTION-1 AREA-3 PARCEL A-1 PLAT 5978
6TH ELECTION DISTRICT
COLUMBIA, MARYLAND

DRAWN	DRAWING NUMBER	REV.
CHECKED J.C.G.		
SCALE AS NOTED	SHEET NUMBER	
DATE NOV. 77	2 OF 4	

SDP-78-78c

Soil Erosion and Sediment Control Notes

1) ALL SOIL EROSION AND SEDIMENT CONTROL MEASURES SHALL BE CONSTRUCTED PRIOR TO ANY GRADING OF THE SITE.
2) ALL SEDIMENT CONTROL MEASURES ARE TO REMAIN IN PLACE UNTIL PERMISSION FOR THEIR REMOVAL HAS BEEN OBTAINED FROM THE BUREAU OF INSPECTIONS AND PERMITS, PHONE 992-2455.
3) NOTIFY THE HOWARD SOIL CONSERVATION DISTRICT AT LEAST 24 HOURS BEFORE STARTING ANY WORK, PHONE 465-3180.
4) CONTINUED INSPECTION AND MAINTENANCE WILL BE THE RESPONSIBILITY OF THE DEVELOPER.
5) ALL SEDIMENT CONTROL MEASURES SHALL CONFORM TO THE STD'S AND SPEC'S IN "URBANIZING AREAS" AND AS SHOWN AND DETAILED ON THIS PLAN.
6) SEED OR SOD ALL EXPOSED SOIL IN GRASS AREAS WITHIN 72 HRS. OF GRADING TO FINISHED GRADE IN ACCORDANCE WITH H.S.C.D. STANDARDS AND SPECIFICATIONS AND THESE NOTES. LAY BASE COURSE IN PAVED AREAS OR PROTECT WITH BITUMINOUS MULCH OR OTHER METHODS APPROVED BY THE ENGINEER WITHIN 72 HOURS OF FINE GRADING.
7) TEMPORARY SEEDING

GROUND LIMESTONE	- 3500 LBS/AC. WORK INTO TOP 3" OF SOIL
FERTILIZER	- 1300 LBS/AC. 10-10-10
MULCH	- 3000 LBS/AC. STRAW (WHEAT PREFERRED)
SEED	- 40 LBS/AC. RYE GRASS
BINDER	- ASPHALT SPRAY OF MULCH @ RATE OF 1 GAL. PER 1000 SQ. FT.
ALTERNATE	- HYDROSEED FERTILIZER, SEED AND MULCH

8) PERMANENT SEEDING
GROUND LIMESTONE - 2000 LBS./AC. WORK INTO TOP 3" OF SOIL
FERTILIZER - 1300 LBS/AC 10-10-10
SEED - 90% KENTUCKY 31 TALL FESCUE
5% RYE GRASS
5% MERION BLUEGRASS
SEEDING RATE - 150 LBS/Ac.
BINDER - HYDROSEED FERTILIZER, SEED. USE STRAW MULCH WITH ASPHALT BINDER
9) FOR ALL SLOPES STEEPER THAN 3:1 USE CROWN VETCH @ 15 LBS/AC. AND KENTUCKY 31 @ 40LBS/AC.

Sodding Notes

1) APPLY 10-10-10 FERTILIZER @ 1000 LBS/AC. (25LBS/1000 SQ. FT.)
2) APPLY GROUND AGRICULTURAL LIMESTONE @ 2000 LBS/AC. 50LBS/1000 SQ. FT.
3) INCORPORATE BOTH LIME AND FERTILIZER INTO SOIL BY DISCING. TIRM UP AFTER INCORPORATION.
4) LAY SOD TO A TIGHT FIT ROLL TO ENSURE CONTACT WITH UNDER LYING SOIL. WATER AS NECESSARY FOR FIRST TWO WEEKS (IN SUMMER) TO ENSURE ESTABLISHMENT.

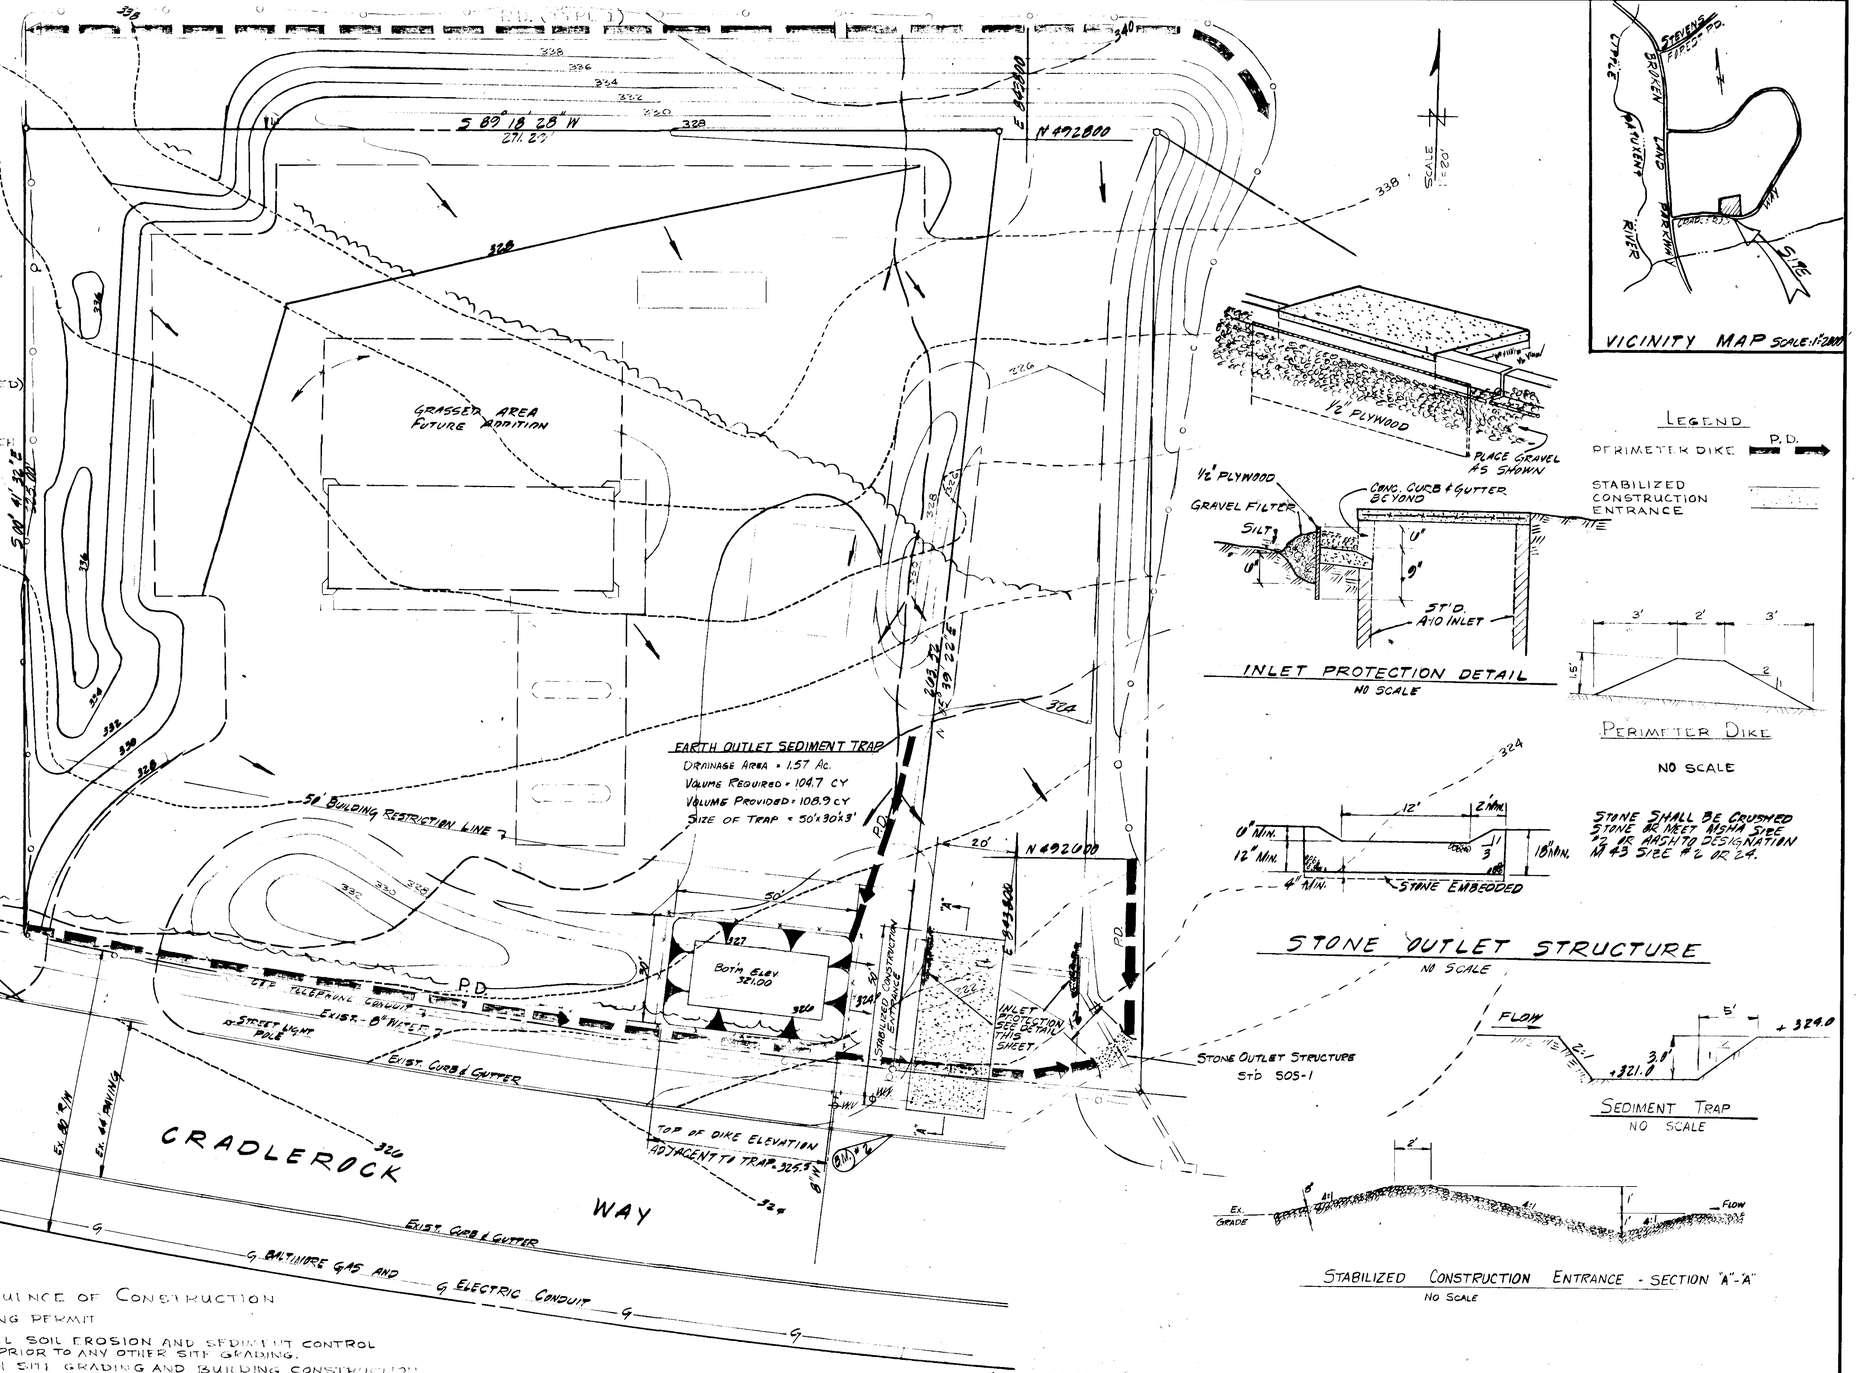

VICINITY MAP SCALE: 1" = 2000'

INLET PROTECTION DETAIL
NO SCALE

Legend

PERIMETER DIKE P.D.
STABILIZED CONSTRUCTION ENTRANCE

PERIMETER DIKE
NO SCALE

STONE SHALL BE CRUSHED STONE OR MEET MSHA SIZE #2 OR AASHTO DESIGNATION M 43 SIZE #2 OR 24.

STONE OUTLET STRUCTURE
NO SCALE

SEDIMENT TRAP
NO SCALE

STABILIZED CONSTRUCTION ENTRANCE - SECTION "A"-"A"
No Scale

Sequence of Construction

1) OBTAIN GRADING PERMIT
2) CONSTRUCT ALL SOIL EROSION AND SEDIMENT CONTROL STRUCTURES PRIOR TO ANY OTHER SITE GRADING.
3) PROCEED WITH SITE GRADING AND BUILDING CONSTRUCTION
4) AS VARIOUS AREAS ARE BROUGHT TO FINAL GRADE, PLACE TOP SOIL, SEED/SOD GRASSED AREAS AND PAVE PARKING AREAS, ALL IN CONFORMANCE WITH THESE PLANS AND THE SOIL EROSION AND SEDIMENT CONTROL NOTES.
5) UPON COMPLETION OF FINE GRADING AND STABILIZATION OF SITE, ALL SEDIMENT CONTROL STRUCTURES SHALL BE REMOVED.
6) AT THE END OF TWO DAYS, WHERE AN UNFINISHED STORM DRAIN SHALL BE BLOCKED WITH PLYWOOD OR OTHER APPROVED MATERIAL.

Engineer's Certification

"I CERTIFY THAT THIS PLAN FOR EROSION AND SEDIMENT CONTROL REPRESENTS A PRACTICAL AND WORKABLE PLAN BASED ON MY PERSONAL KNOWLEDGE OF THE SITE CONDITIONS AND THAT IT WAS PREPARED IN ACCORDANCE WITH THE REQUIREMENTS OF THE HOWARD SOIL CONSERVATION DISTRICT."

J.C.W. for
SIGNATURE OF ENGINEER — 1-31-78 DATE

Developer's Certification

"I CERTIFY THAT ALL DEVELOPMENT AND/OR CONSTRUCTION WILL BE DONE IN ACCORDANCE WITH THIS PLAN OF DEVELOPMENT AND PLAN FOR EROSION AND SEDIMENT CONTROL AND I ALSO AUTHORIZE PERIODIC ON-SITE INSPECTION BY HOWARD SOIL CONSERVATION DISTRICT OR THEIR AUTHORIZED AGENTS, AS ARE DEEMED NECESSARY. ANY DEVIATION FROM THIS PLAN WILL NOT BE MADE UNLESS AUTHORIZED BY THE HOWARD SOIL CONSERVATION DISTRICT."

Roger P. Lemon
SIGNATURE OF DEVELOPER — 03/31/78 DATE

NOTE: STORM WATER MANAGEMENT FOR THIS SITE IS CONTROLLED BY EXISTING LAKE ELKHORN.

THESE PLANS HAVE BEEN REVIEWED FOR THE HOWARD SOIL CONSERVATION DISTRICT AND MEET THE TECHNICAL REQUIREMENTS

C. Wayne Ray — 5-23-78
SIGNATURE, U.S. SOIL CONSERVATION SERVICE — DATE

THIS DEVELOPMENT PLAN IS APPROVED FOR SOIL EROSION AND SEDIMENT CONTROL BY THE HOWARD SOIL CONSERVATION DISTRICT.

APPROVED Wm. Ford — 5-24-78
SIGNATURE, HOWARD S.C.D. — DATE

APPROVED FOR PUBLIC WATER AND PUBLIC SEWERAGE SYSTEMS HOWARD COUNTY HEALTH DEPARTMENT.

Joseph Bowers — 6-5-78
COUNTY HEALTH OFFICER — DATE

APPROVED HOWARD COUNTY OFFICE OF PLANNING AND ZONING.

Thomas H. Harris — 6-7-78
PLANNING DIRECTOR — DATE

John W. Mumaham — 6-6-78
CHIEF, DIVISION OF LAND DEVELOPMENT — DATE

APPROVED FOR PUBLIC WATER AND PUBLIC SEWERAGE, STORM DRAINAGE SYSTEMS AND PUBLIC ROADS, HOWARD COUNTY DEPARTMENT OF PUBLIC WORKS.

Richard E. Lauderberger — 6/1/78
DIRECTOR — DATE

W. O. Talbert — 6-1-78
CHIEF, BUREAU OF ENGINEERING — DATE

THIS DRAWING IS THE PROPERTY OF MOBIL OIL CORPORATION. IT CONTAINS INFORMATION REGARDED AS CONFIDENTIAL BY MOBIL OIL. THIS DRAWING AND THE INFORMATION THEREON IS NOT TO BE USED OR DISCLOSED TO OTHERS EXCEPT WITH WRITTEN MOBIL OIL AUTHORIZATION. THIS DRAWING IS NOT TO BE REPRODUCED OR COPIED WITHOUT PERMISSION AND IS TO BE RETURNED TO MOBIL OIL WITH ANY COPIES (PARTIAL OR COMPLETE) ON DEMAND.

NO.	REVISIONS	DATE	BY	CHKD.	MF

APPROVED
PLANNING BOARD OF HOWARD COUNTY
DATE 4-26-78

Mobil Oil Corporation
NORTH AMERICAN DIVISION
EASTERN REGION
VALLEY FORGE, PA 19482

S. & E. C. IN AND SEDIMENT CONTROL
VILLAGE OF OWEN BROWN
SECTION 1 AREA 3 PARCEL A-1 PLAT 3718
6TH ELECTION DISTRICT
COLUMBIA, MARYLAND

MACRIS - FOWLER ASSOCIATES
CIVIL-STRUCTURAL ENGINEERS; SURVEYORS; PLANNERS
27 W. JEFFERSON ST. ROCKVILLE, MD. 20850
(301) 340-8705 (301) 762-3858

DRAWN D.G. | CHECKED J.C.G. | SCALE 1" = 20' | DATE NOV 77
DRAWING NUMBER | REV.
SHEET NUMBER 3 OF 4

SDP-78-78c

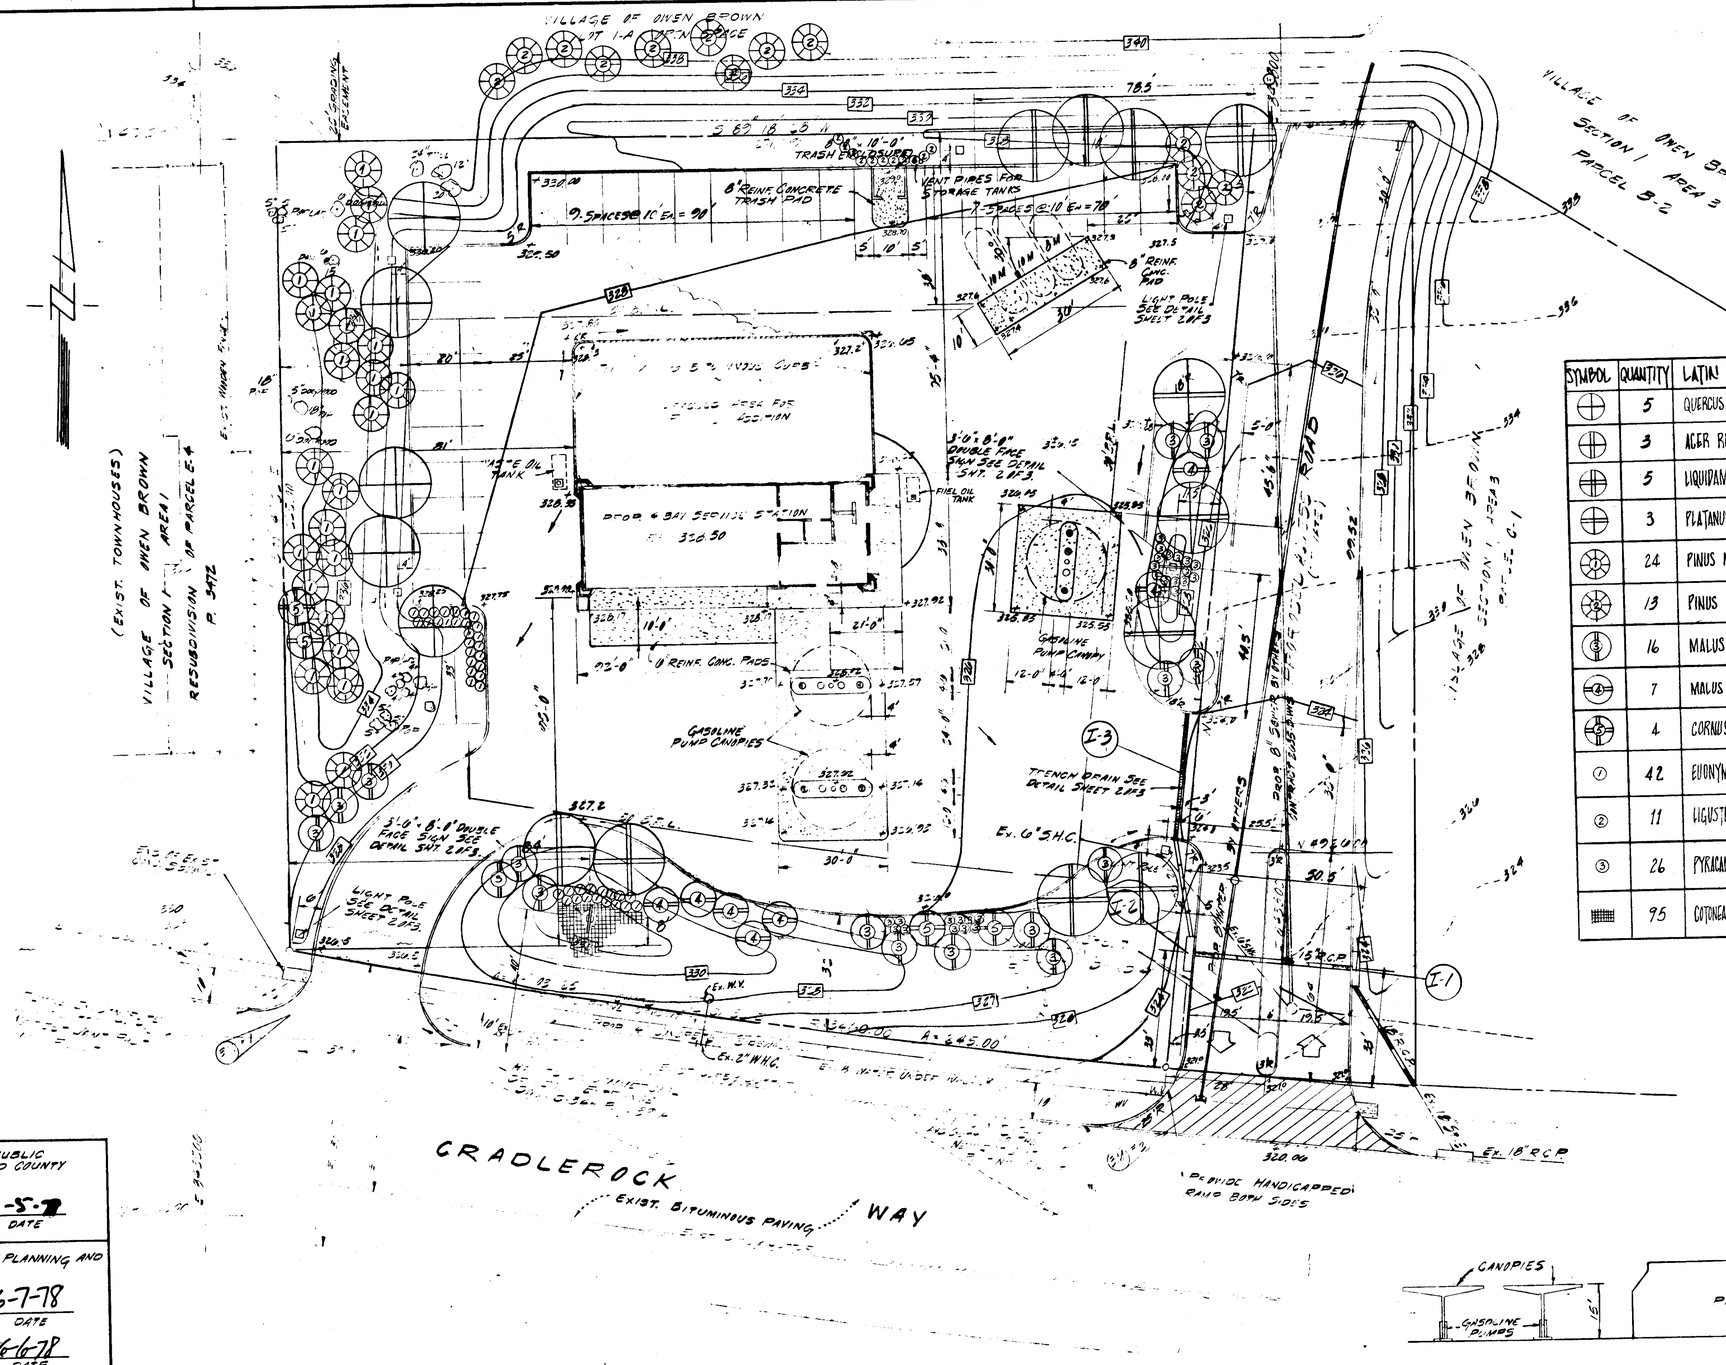

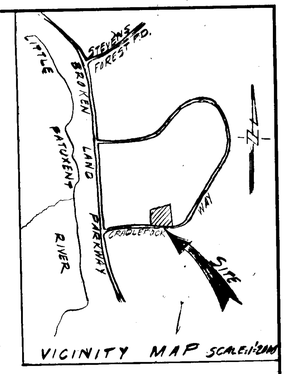

SYMBOL	QUANTITY	LATIN NAME	COMMON NAME	REMARKS
⊕	5	QUERCUS PALUSTRIS	PIN OAK	2¾"-3" MIN CALIP., 12'-14' MIN HIGH, FULL HEADS, B/B, WRAPPED TRUNK
⊕	3	ACER RUBRUM	RED MAPLE	2½"-3" MIN. C. AL., 12'-14' MIN HIGH, FULL HEADS, B/B, WRAPPED TRUNK
⊕	5	LIQUIDAMBAR STYRACIFLUS	SWEET GUM	2½"-3" MIN CAL 12'-14' MIN HIGH, FULL HEAD, B/B WRAPPED
⊕	3	PLATANUS ORIENTALIS	LONDON PLANETREE	2½"-3" MIN. CAL, 12'-14' MIN HIGH, FULL HEAD, B/B, WRAPPED TRUNK
⊕	24	PINUS NIGRA	AUSTRIAN PINE	2½" MIN. CAL, 6'-8' MIN. HIGH, WELL BRANCHED, B/B
⊕	13	PINUS STROBUS	WHITE PINE	2½" MIN. CAL., 6'-8' MIN. HIGH, WELL BRANCHED, B/B
⊕	16	MALUS ARNOLDIANA	ARNOLD CRABAPPLE	2½" MIN. CAL, 8'-10' MIN. HIGH, WELL BRANCHED, B/B WRAPPED TRUNK
⊕	7	MALUS VAR. SNOWCLOUD	SNOWCLOUD CRABAPPLE	2½" MIN. CAL, 8'-10' MIN. HIGH, WELL BRANCHED, B/B, WRAPPED TRUNK
⊕	4	CORNUS FLORIDA	FLOWERING DOGWOOD	2½" MIN. CAL, 8'-10' MIN. HIGH, WELL BRANCHED, B/B WRAPPED TRUNK
①	42	EUONYMUS ALATUS COMPACTUS	DWARF WINGED EUONYMUS	24"-30", B/B OR POTTED, WELL BRANCHED, COMPACT, 3' O.C.
②	11	LIGUSTRUM LUCIDUM	WAXLEAF PRIVET	36"-48", B/B, WELL BRANCHED, 3' O. C.
③	26	PYRACANTHA COCCINEA LOWBOY	PYRACAN	24"-30", B/B OR POTTED 3' O.C.
▦	95	COTONEASTER RAMMERI SCOUSHOMEN	COTONEASTER	18"-24", POTTED, 2' O.C.

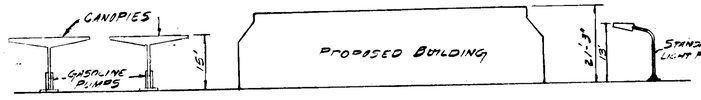

BUILDING PROFILE
SCALE: 1"=20'

LANDSCAPE PLAN
SCALE: 1"=20'

APPROVED FOR PUBLIC WATER AND PUBLIC SEWERAGE SYSTEMS HOWARD COUNTY HEALTH DEPARTMENT.
COUNTY HEALTH OFFICER — DATE 6-5-78

APPROVED HOWARD COUNTY OFFICE OF PLANNING AND ZONING
PLANNING DIRECTOR — DATE 6-7-78
CHIEF DIVISION OF LAND DEVELOPMENT — DATE 6-6-78

APPROVED FOR PUBLIC WATER AND PUBLIC SEWERAGE STORM DRAINAGE SYSTEMS AND PUBLIC ROADS HOWARD COUNTY DEPARTMENT OF PUBLIC WORKS.
DIRECTOR — DATE 6/1/78
CHIEF BUREAU OF ENGINEERING — DATE 6-1-78

THIS DRAWING IS THE PROPERTY OF MOBIL OIL CORPORATION. IT CONTAINS INFORMATION REGARDED AS CONFIDENTIAL BY MOBIL OIL. THIS DRAWING AND THE INFORMATION THEREON IS NOT TO BE USED OR DISCLOSED TO OTHERS EXCEPT WITH WRITTEN MOBIL OIL AUTHORIZATION. THIS DRAWING IS NOT TO BE REPRODUCED OR COPIED WITHOUT PERMISSION AND IS TO BE RETURNED TO MOBIL OIL WITH ANY COPIES (PARTIAL OR COMPLETE) ON DEMAND.

STATE OF MARYLAND — DONALD L. MACRIS — No. 4049 — REGISTERED PROFESSIONAL ENGINEER

TOPOGRAPHIC SURVEY WAS FURNISHED BY MOBIL OIL CORPORATION

land plan associates
landscape architects urban planners
(301) 997 0810
SUITE 719, AMERICAN CITY BLDG., COLUMBIA, MD 21044

MACRIS - FOWLER ASSOCIATES
CIVIL - STRUCTURAL ENGINEERS; SURVEYORS; PLANNERS
27 W. JEFFERSON ST. ROCKVILLE, MD. 20850
(301) 340-8705 (301) 762-3858

SHEET TOTAL 1 OF 1

NO.	REVISIONS	DATE	BY	CHKD.	MF

APPROVED
PLANNING BOARD OF HOWARD COUNTY
DATE 4-26-78

Mobil Oil Corporation
NORTH AMERICAN DIVISION
EASTERN REGION
VALLEY FORGE, PA 19482

SITE DEVELOPMENT PLAN
VILLAGE OF OWEN BROWN
SECTION-1 AREA 3 PARCELS A-1, B-2 PLAT 3718
6TH ELECTION DISTRICT
COLUMBIA MARYLAND

DRAWN —
CHECKED —
SCALE 1"=20'
DATE NOV. 77
DRAWING NUMBER —
REV.
SHEET NUMBER 4 OF 4

SDP-78-78c

8"= FULL SCALE

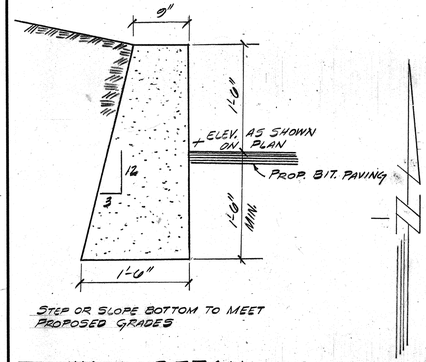

STEP OR SLOPE BOTTOM TO MEET PROPOSED GRADES

WALL DETAIL

SCALE: 1"=1'-0"

STATE OF MARYLAND — ROBERT V. VOLKMER — No. 21342 — REGISTERED PROFESSIONAL ENGINEER

6-10-94 - ADDED 1½" WATER HOUSE CONNECTION / SERVICE TO SITE.

FOR REDLINE REVISION #3
PREPARED BY BOHLER ENGINEERING, P.C.

GENERAL NOTES

1. CONTRACTOR TO NOTIFY THE UTILITY COMPANIES AT LEAST THREE (3) DAYS BEFORE STARTING WORK SHOWN ON THESE PLANS.
2. INSTALLATION OF TRAFFIC CONTROL DEVICES, MARKING, AND SIGNING SHALL BE IN ACCORDANCE WITH THE MANUAL OF UNIFORM TRAFFIC CONTROL DEVICES 1971 EDITION.
3. ALL REINFORCED CONCRETE SHALL HAVE A MINIMUM 28 DAYS STRENGTH OF 3500 PSI.
4. ALL DISTURBED SLOPE AREA TO BE STABILIZED AS SOON AS GRADING IS COMPLETED.
5. ANY DAMAGE TO PUBLIC RIGHT-OF-WAYS OR PAVING WILL BE CORRECTED AT THE DEVELOPERS EXPENSE.

Parking Required:

A. Gasoline Service Station with service bays and a carwash = 4 spaces
B. Three (3) spaces per service bay = 12 spaces
C. Two (2) spaces per 1,000 sq. of retail floor area = 4 spaces
Total Required: Twenty (20) spaces

Parking Provided:

Twenty (20) spaces including two (2) Handicap spaces

APPROVED FOR PUBLIC WATER AND PUBLIC SEWERAGE SYSTEMS HOWARD COUNTY HEALTH DEPARTMENT.
COUNTY HEALTH OFFICER — 6-5-78 DATE

APPROVED HOWARD COUNTY OFFICE OF PLANNING AND ZONING.
PLANNING DIRECTOR — 6-7-78 DATE
CHIEF DIVISION OF LAND DEVELOPMENT — 6-6-78 DATE

APPROVED FOR PUBLIC WATER AND PUBLIC SEWERAGE STORM DRAINAGE SYSTEMS AND PUBLIC ROADS HOWARD COUNTY DEPARTMENT OF PUBLIC WORKS.
DIRECTOR — 6/1/78 DATE
CHIEF BUREAU OF ENGINEERING — 6-1-78 DATE

THIS DRAWING IS THE PROPERTY OF MOBIL OIL CORPORATION. IT CONTAINS INFORMATION REGARDED AS CONFIDENTIAL BY MOBIL OIL. THIS DRAWING AND THE INFORMATION THEREON IS NOT TO BE USED OR DISCLOSED TO OTHERS EXCEPT WITH WRITTEN MOBIL OIL AUTHORIZATION. THIS DRAWING IS NOT TO BE REPRODUCED OR COPIED WITHOUT PERMISSION AND IS TO BE RETURNED TO MOBIL OIL WITH ANY COPIES (PARTIAL OR COMPLETE) ON DEMAND.

N41043

BENCH MARK SCHEDULE

B.M. #1 X CUT ON CONCRETE CURB ELEV. = 320.05
B.M. #2 X CUT ON CONCRETE CURB ELEV. = 321.08

For redline revision No. 2
Prepared by Bohler Engineering, P.C.

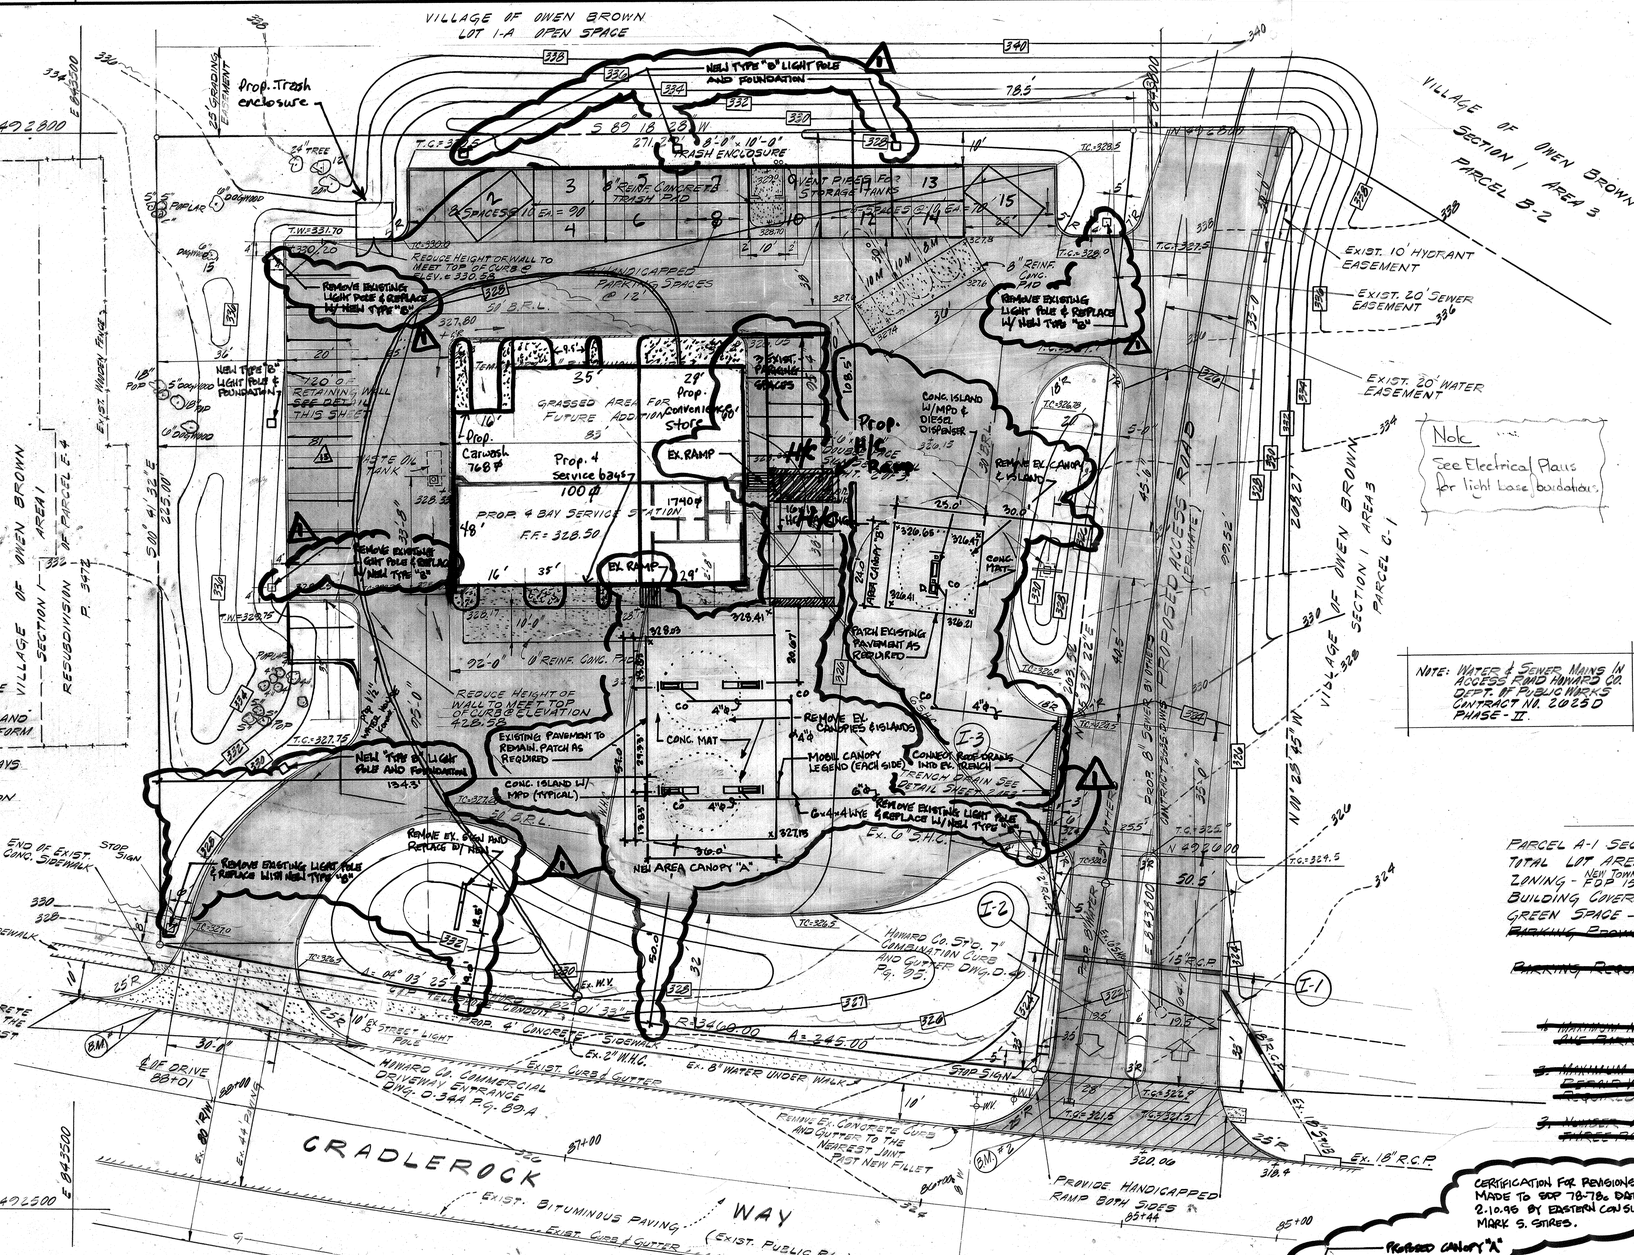
VILLAGE OF OWEN BROWN LOT 1-A OPEN SPACE
N 492,800 E 843,500
Prop. Trash enclosure
NEW TYPE "B" LIGHT POLE AND FOUNDATION
S 89° 18' 28" W 271.20'
8'-0" x 10'-0" TRASH ENCLOSURE
24" TREE
6" DOGWOOD
5" POPLAR
9" TREE
T.C.=330.0
T.W.=331.70
T.C.=332.0
REDUCE HEIGHT OF WALL TO MEET TOP OF CURB @ ELEV. = 330.58
HANDICAPPED PARKING SPACES @ 12'
REMOVE EXISTING LIGHT POLE & REPLACE W/ NEW TYPE "B"
720 L.F. RETAINING WALL SEE DETAIL THIS SHEET
NEW TYPE "B" LIGHT POLE & FOUNDATION
WASTE OIL TANK
Prop. Carwash 768 ☐'
Prop. 4 Service bays 100 ☐'
PROP. 4 BAY SERVICE STATION F.F. = 328.50
17'40 ☐'
EX. RAMP
GRASSED AREA FOR FUTURE ADDITION
29' Prop. Convenience Store
Prop. BIG Sign
CONG. ISLAND W/MPD & DIESEL DISPENSER
REMOVE EX. CANOPY & ISLAND
CONC. MAT.
PATCH EXISTING PAVEMENT AS REQUIRED
REDUCE HEIGHT OF CURB TO MEET TOP OF CURB @ ELEVATION 328.58
EXISTING PAVEMENT TO REMAIN, PATCH AS REQUIRED
CONG. ISLAND W/ MPD (TYPICAL)
REMOVE EX. CANOPIES & ISLANDS
MOBIL CANOPY LEGEND (EACH SIDE)
CONNECT ROOF DRAINS INTO EX. TRENCH DRAIN SEE DETAIL SHEET 2 OF 3
REMOVE EXISTING LIGHT POLE & REPLACE W/ NEW TYPE "B"
Ex. G.S.H.C.
NEW AREA CANOPY "A"
REMOVE EX. SIGN AND REPLACE BY NEW
REMOVE EXISTING LIGHT POLE & REPLACE WITH NEW TYPE "B"
NEW TYPE "B" LIGHT POLE AND FOUNDATION
END OF EXIST. CONC. SIDEWALK
STOP SIGN
Ex. CONC. SIDEWALK
REMOVE EX. CURB & GUTTER TO THE NEAREST JOINT PAST NEW FILLET
10' EX. STREET LIGHT POLE
PROP. 4' CONCRETE SIDEWALK
Ex. 2" W.M.G.
Ex. 8" WATER UNDER WALK
HOWARD CO. COMMERCIAL DRIVEWAY ENTRANCE DWG. 0.34A P.G. 89.A
EXIST. CURB & GUTTER
REMOVE EX. CONCRETE CURB AND GUTTER TO THE NEAREST JOINT PAST NEW FILLET
PROVIDE HANDICAPPED RAMP BOTH SIDES
CRADLEROCK WAY (EXIST. PUBLIC R/W)
EXIST. BITUMINOUS PAVING
EXIST. CURB & GUTTER
BALTIMORE GAS AND ELECTRIC CONDUIT
EX. 60' R/W
EX. 44' PAVING
L OF DRIVE 88+01
87+00
85+00
85+44
Ex. 18" R.C.P.

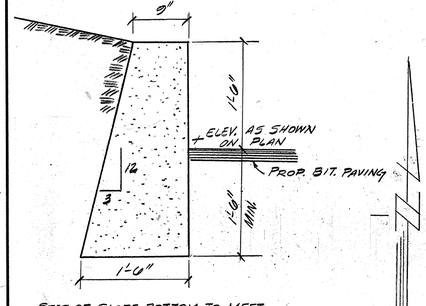

STEP OR SLOPE BOTTOM TO MEET PROPOSED GRADES

WALL DETAIL

SCALE: 1"=1'-0"

STATE OF MARYLAND — HENRY J. VOLLMER — No. 21342 — REGISTERED PROFESSIONAL ENGINEER

6-10-04 - ADDED 1½" WATER HOUSE CONNECTION / SERVICE TO SITE.

FOR REDLINE REVISION #3
PREPARED BY BOHLER ENGINEERING, P.C.

GENERAL NOTES

1. CONTRACTOR TO NOTIFY THE UTILITY COMPANIES AT LEAST THREE (3) DAYS BEFORE STARTING WORK SHOWN ON THESE PLANS.
2. INSTALLATION OF TRAFFIC CONTROL DEVICES, MARKING, AND SIGNING SHALL BE IN ACCORDANCE WITH THE MANUAL OF UNIFORM TRAFFIC CONTROL DEVICES 1971 EDITION.
3. ALL REINFORCED CONCRETE SHALL HAVE A MINIMUM 28 DAYS STRENGTH OF 3500 PSI.
4. ALL DISTURBED SLOPE AREA TO BE STABILIZED AS SOON AS GRADING IS COMPLETED.
5. ANY DAMAGE TO PUBLIC RIGHT-OF-WAYS OR PAVING WILL BE CORRECTED AT THE DEVELOPERS EXPENSE.

Parking Required:

A. Gasoline Service Station with service bays and a carwash = 4 spaces
B. Three (3) spaces per service bay = 12 spaces
C. Two (2) spaces per 1,000 sq. ft. of retail floor area = 4 spaces
Total Required: Twenty (20) spaces

Parking Provided:

Twenty (20) spaces including two (2) Handicap Spaces

APPROVED FOR PUBLIC WATER AND PUBLIC SEWERAGE SYSTEMS HOWARD COUNTY HEALTH DEPARTMENT.
COUNTY HEALTH OFFICER — 6-5-78 DATE

APPROVED HOWARD COUNTY OFFICE OF PLANNING AND ZONING.
PLANNING DIRECTOR — 6-7-78 DATE
CHIEF DIVISION OF LAND DEVELOPMENT — 6-6-78 DATE

APPROVED FOR PUBLIC WATER AND PUBLIC SEWERAGE STORM DRAINAGE SYSTEMS AND PUBLIC ROADS HOWARD COUNTY DEPARTMENT OF PUBLIC WORKS.
DIRECTOR — 6/1/78 DATE
CHIEF BUREAU OF ENGINEERING — 6-1-78 DATE

THIS DRAWING IS THE PROPERTY OF MOBIL OIL CORPORATION. IT CONTAINS INFORMATION REGARDED AS CONFIDENTIAL BY MOBIL OIL. THIS DRAWING AND THE INFORMATION THEREON IS NOT TO BE USED OR DISCLOSED TO OTHERS EXCEPT WITH WRITTEN MOBIL OIL AUTHORIZATION. THIS DRAWING IS NOT TO BE REPRODUCED OR COPIED WITHOUT PERMISSION AND IS TO BE RETURNED TO MOBIL OIL WITH ANY COPIES (PARTIAL OR COMPLETE) ON DEMAND.

N41043

6"= FULL SCALE

BENCH MARK SCHEDULE

B.M. #1 X CUT ON CONCRETE CURB ELEV. = 320.05
B.M. #2 X CUT ON CONCRETE CURB ELEV. = 321.08

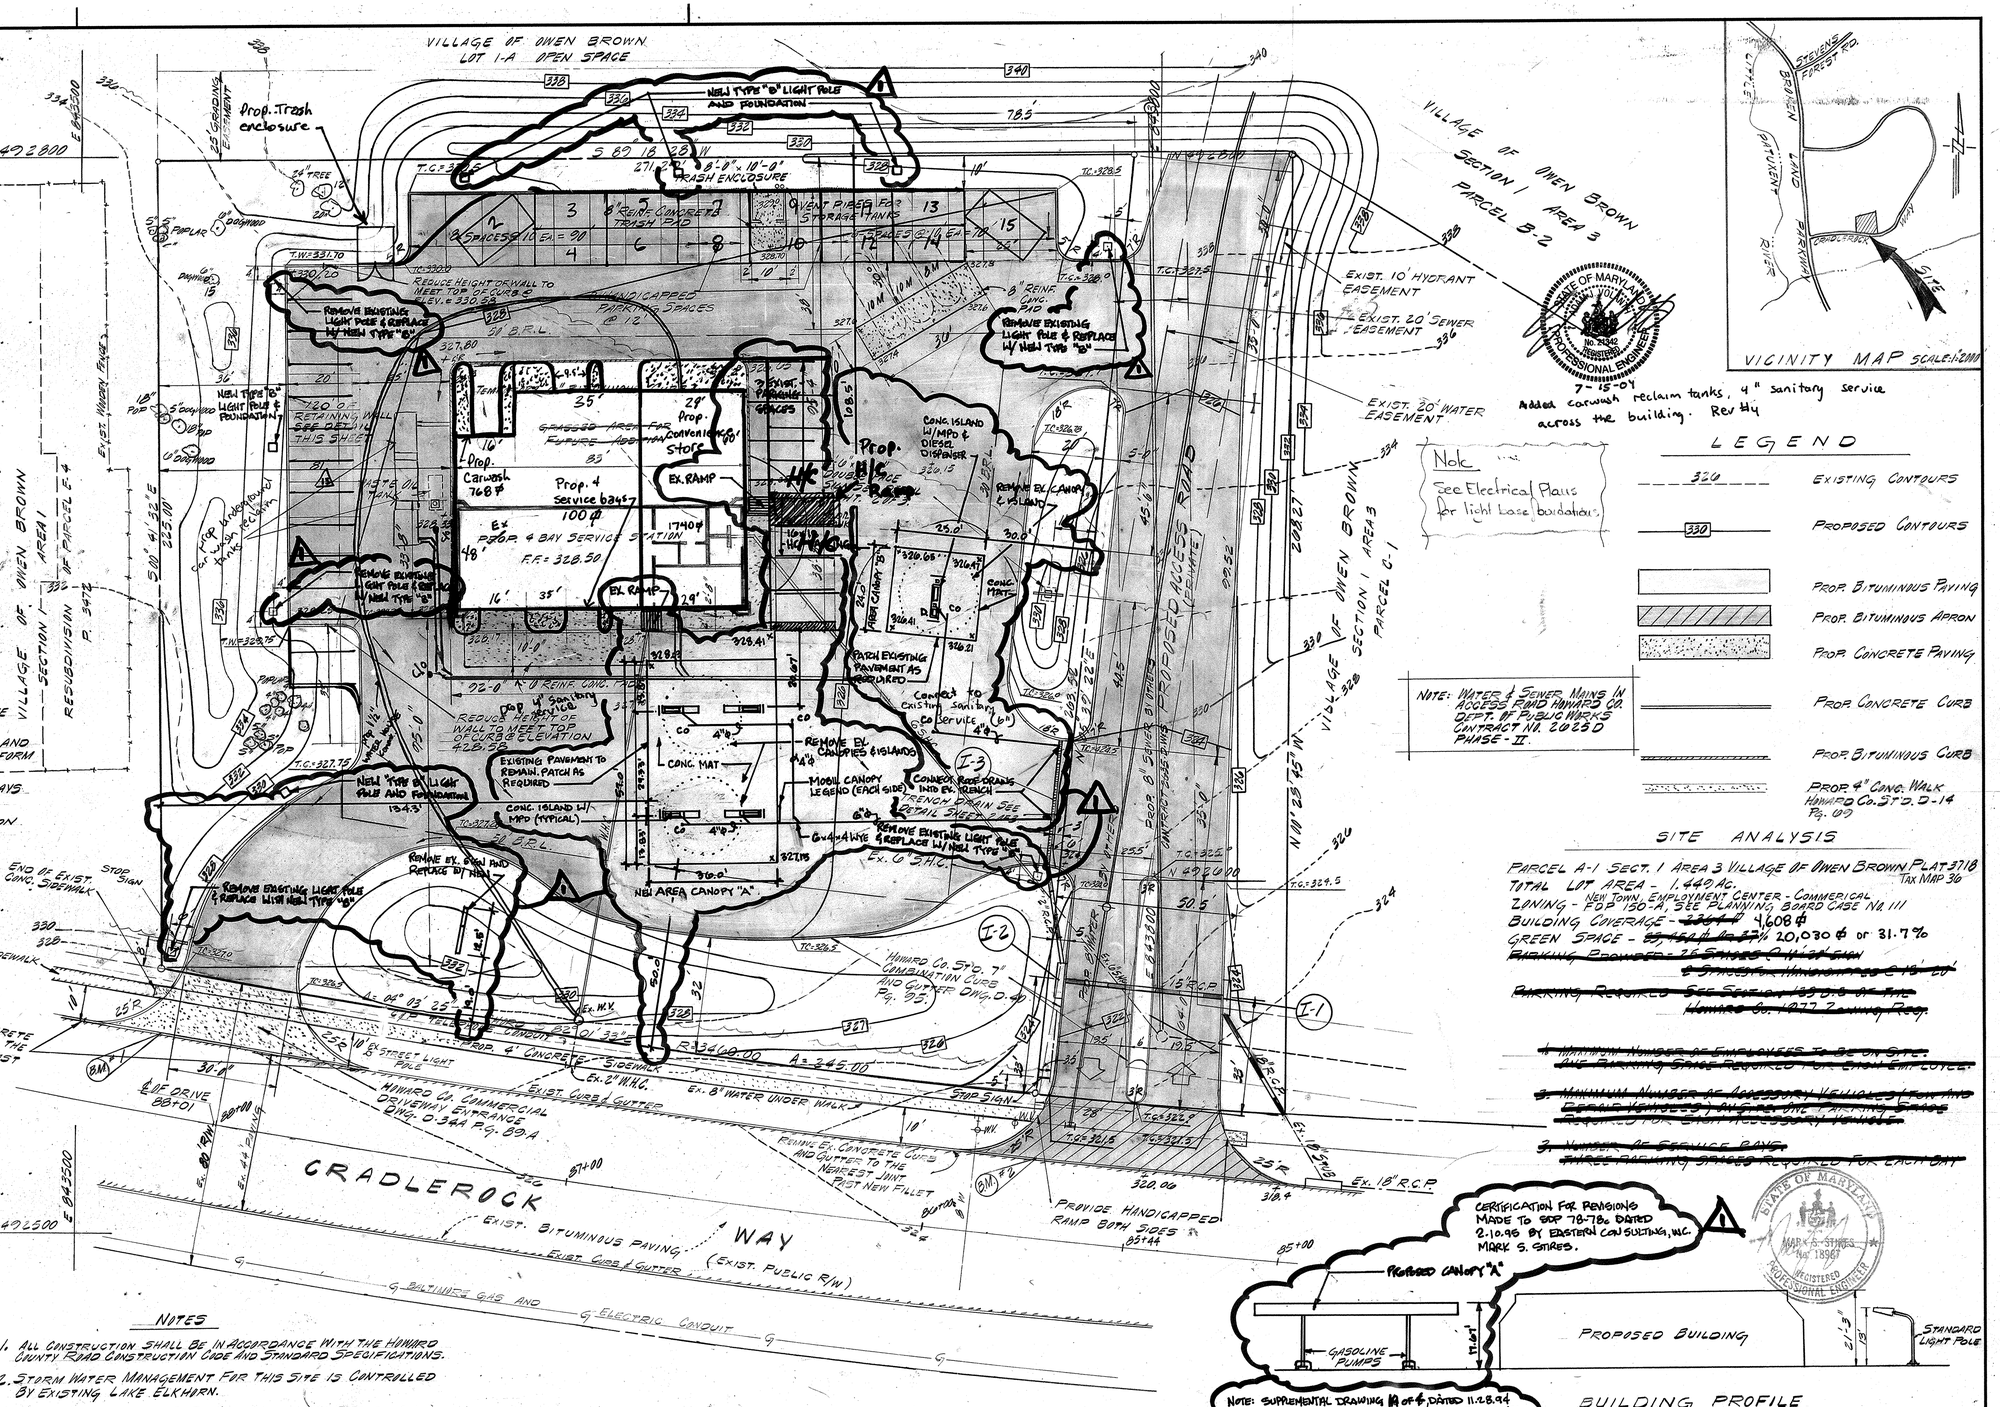
VILLAGE OF OWEN BROWN
LOT 1-A OPEN SPACE
Prop. Trash enclosure
NEW TYPE "B" LIGHT POLE AND FOUNDATION
N 492800 E 843500
S 89° 18' 28" W 271.28'
8'-0" x 10'-0" TRASH ENCLOSURE
Prop. Concrete Trash Pad
VENT PIPES FOR STORAGE TANKS
REMOVE EXISTING LIGHT POLE & REPLACE W/ NEW TYPE "B"
HANDICAPPED PARKING SPACES @ 12'
NEW TYPE "B" LIGHT POLE & FOUNDATION
720 L.F. RETAINING WALL SEE DETAIL THIS SHEET
Prop. Convenience Store 29'
Prop. Carwash 768 ☐'
Prop. 4 Service bays 100 ☐'
EX. P.B.R. 4 BAY SERVICE STATION F.F.: 328.50
1740 ☐'
EX. RAMP
GRADES
CONG. ISLAND W/MPD & DIESEL DISPENSER
REMOVE EX. CANOPY & ISLAND
Prop. 4" Sanitary Service
REMOVE EX. CANOPIES & ISLANDS
CONC. MAT
MOBIL CANOPY LEGEND (EACH SIDE)
CONNECT ROOF DRAINS INTO EX. FRENCH DRAIN SEE DETAIL SHEET 2 OF 3
CONC. ISLAND W/ MPD (TYPICAL)
REMOVE EX. SIGN AND REPLACE W/ NEW
REMOVE EXISTING LIGHT POLE & REPLACE WITH NEW TYPE "B"
NEW AREA CANOPY "A"
REMOVE EXISTING LIGHT POLE & REPLACE W/ NEW TYPE "B"
Ex. 6" S.M.C.
EXIST. BITUMINOUS PAVING
EXIST. CURB & GUTTER
REDUCE HEIGHT OF WALL TO MEET TOP OF CURB ELEVATION 328.38
EXISTING PAVEMENT TO REMAIN. PATCH AS REQUIRED
PATCH EXISTING PAVEMENT AS REQUIRED
Connect to Existing Sanitary Service (6")
Ex. Cong. Sidewalk
REMOVE EX. CONCRETE CURB & GUTTER TO THE NEAREST JOINT PAST NEW FILLET
Howard Co. Std. 7" Combination Curb and Gutter Dwg. D.4
Howard Co. Std. 4" Concrete Sidewalk
Ex. 2" W.H.C.
Howard Co. Commercial Driveway Entrance Dwg. D.34A Pg. 89.A
Ex. 8" WATER UNDER WALK
REMOVE EX. CONCRETE CURB AND GUTTER TO THE NEAREST JOINT PAST NEW FILLET
PROVIDE HANDICAPPED RAMP BOTH SIDES
CRADLEROCK WAY
(EXIST. PUBLIC R/W)
EXIST. BITUMINOUS PAVING
EXIST. CURB & GUTTER
BALTIMORE GAS AND ELECTRIC CONDUIT
PROP. 8" SEWER & MANHOLE (APPROX. PLACE)
PROPOSED ACCESS ROAD (PRIVATE)
VILLAGE OF OWEN BROWN SECTION 1 AREA 3 PARCEL C-1
N 11° 25' 45" W 208.27'
VILLAGE OF OWEN BROWN SECTION 1 — AREA 1 RESUBDIVISION OF PARCEL E-4 P. 3472
(EXIST. TOWNHOUSES)
EXIST. 10' HYDRANT EASEMENT
EXIST. 20' SEWER EASEMENT
EXIST. 20' WATER EASEMENT
VILLAGE OF OWEN BROWN SECTION 1 AREA 3 PARCEL B-2
I-1
I-2
I-3
R=3460.00 A=245.00
Ex. 18" R.C.P.
Ex. 10" S.M.C.

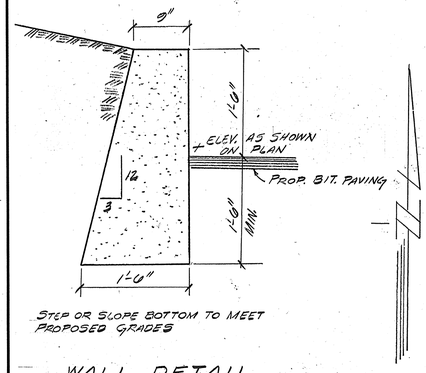

STEP OR SLOPE BOTTOM TO MEET PROPOSED GRADES

WALL DETAIL

SCALE: 1"=1'-0"

STATE OF MARYLAND — ANTHONY VOLANTE — No. 21342 — REGISTERED PROFESSIONAL ENGINEER

6-10-04 - ADDED 1½" WATER HOUSE CONNECTION / SERVICE TO SITE.

FOR REDLINE REVISION #3
PREPARED BY BOHLER ENGINEERING, P.C.

GENERAL NOTES

1. CONTRACTOR TO NOTIFY THE UTILITY COMPANIES AT LEAST THREE (3) DAYS BEFORE STARTING WORK SHOWN ON THESE PLANS.
2. INSTALLATION OF TRAFFIC CONTROL DEVICES, MARKING, AND SIGNING SHALL BE IN ACCORDANCE WITH THE MANUAL OF UNIFORM TRAFFIC CONTROL DEVICES 1971 EDITION.
3. ALL REINFORCED CONCRETE SHALL HAVE A MINIMUM 28 DAYS STRENGTH OF 3500 PSI.
4. ALL DISTURBED SLOPE AREA TO BE STABILIZED AS SOON AS GRADING IS COMPLETED.
5. ANY DAMAGE TO PUBLIC RIGHT-OF-WAYS OR PAVING WILL BE CORRECTED AT THE DEVELOPERS EXPENSE.

Parking Required: (5)

A. Gasoline Service Station with service bays
=3 Spaces
B. Three (3) spaces per service bay = 9 spaces
C. Two (2) spaces per 1,000 sq of Convenience Store floor area = 4.5 spaces ≈ 5 Spaces
Total Required: Seventeen (17)

Parking Provided:

Twenty (20) spaces including two (2) Handicap spaces

APPROVED FOR PUBLIC WATER AND PUBLIC SEWERAGE SYSTEMS HOWARD COUNTY HEALTH DEPARTMENT.
COUNTY HEALTH OFFICER — 6-5-78 DATE

APPROVED HOWARD COUNTY OFFICE OF PLANNING AND ZONING.
PLANNING DIRECTOR — 6-7-78 DATE
CHIEF DIVISION OF LAND DEVELOPMENT — 6-6-78 DATE

APPROVED FOR PUBLIC WATER AND PUBLIC SEWERAGE STORM DRAINAGE SYSTEMS AND PUBLIC ROADS HOWARD COUNTY DEPARTMENT OF PUBLIC WORKS.
DIRECTOR — 6/1/78 DATE
CHIEF BUREAU OF ENGINEERING — 6-1-78 DATE

6"= FULL SCALE

THIS DRAWING IS THE PROPERTY OF MOBIL OIL CORPORATION. IT CONTAINS INFORMATION REGARDED AS CONFIDENTIAL BY MOBIL OIL. THIS DRAWING AND THE INFORMATION THEREON IS NOT TO BE USED OR DISCLOSED TO OTHERS EXCEPT WITH WRITTEN MOBIL OIL AUTHORIZATION. THIS DRAWING IS NOT TO BE REPRODUCED OR COPIED WITHOUT PERMISSION AND IS TO BE RETURNED TO MOBIL OIL WITH ANY COPIES (PARTIAL OR COMPLETE) ON DEMAND.

N41043

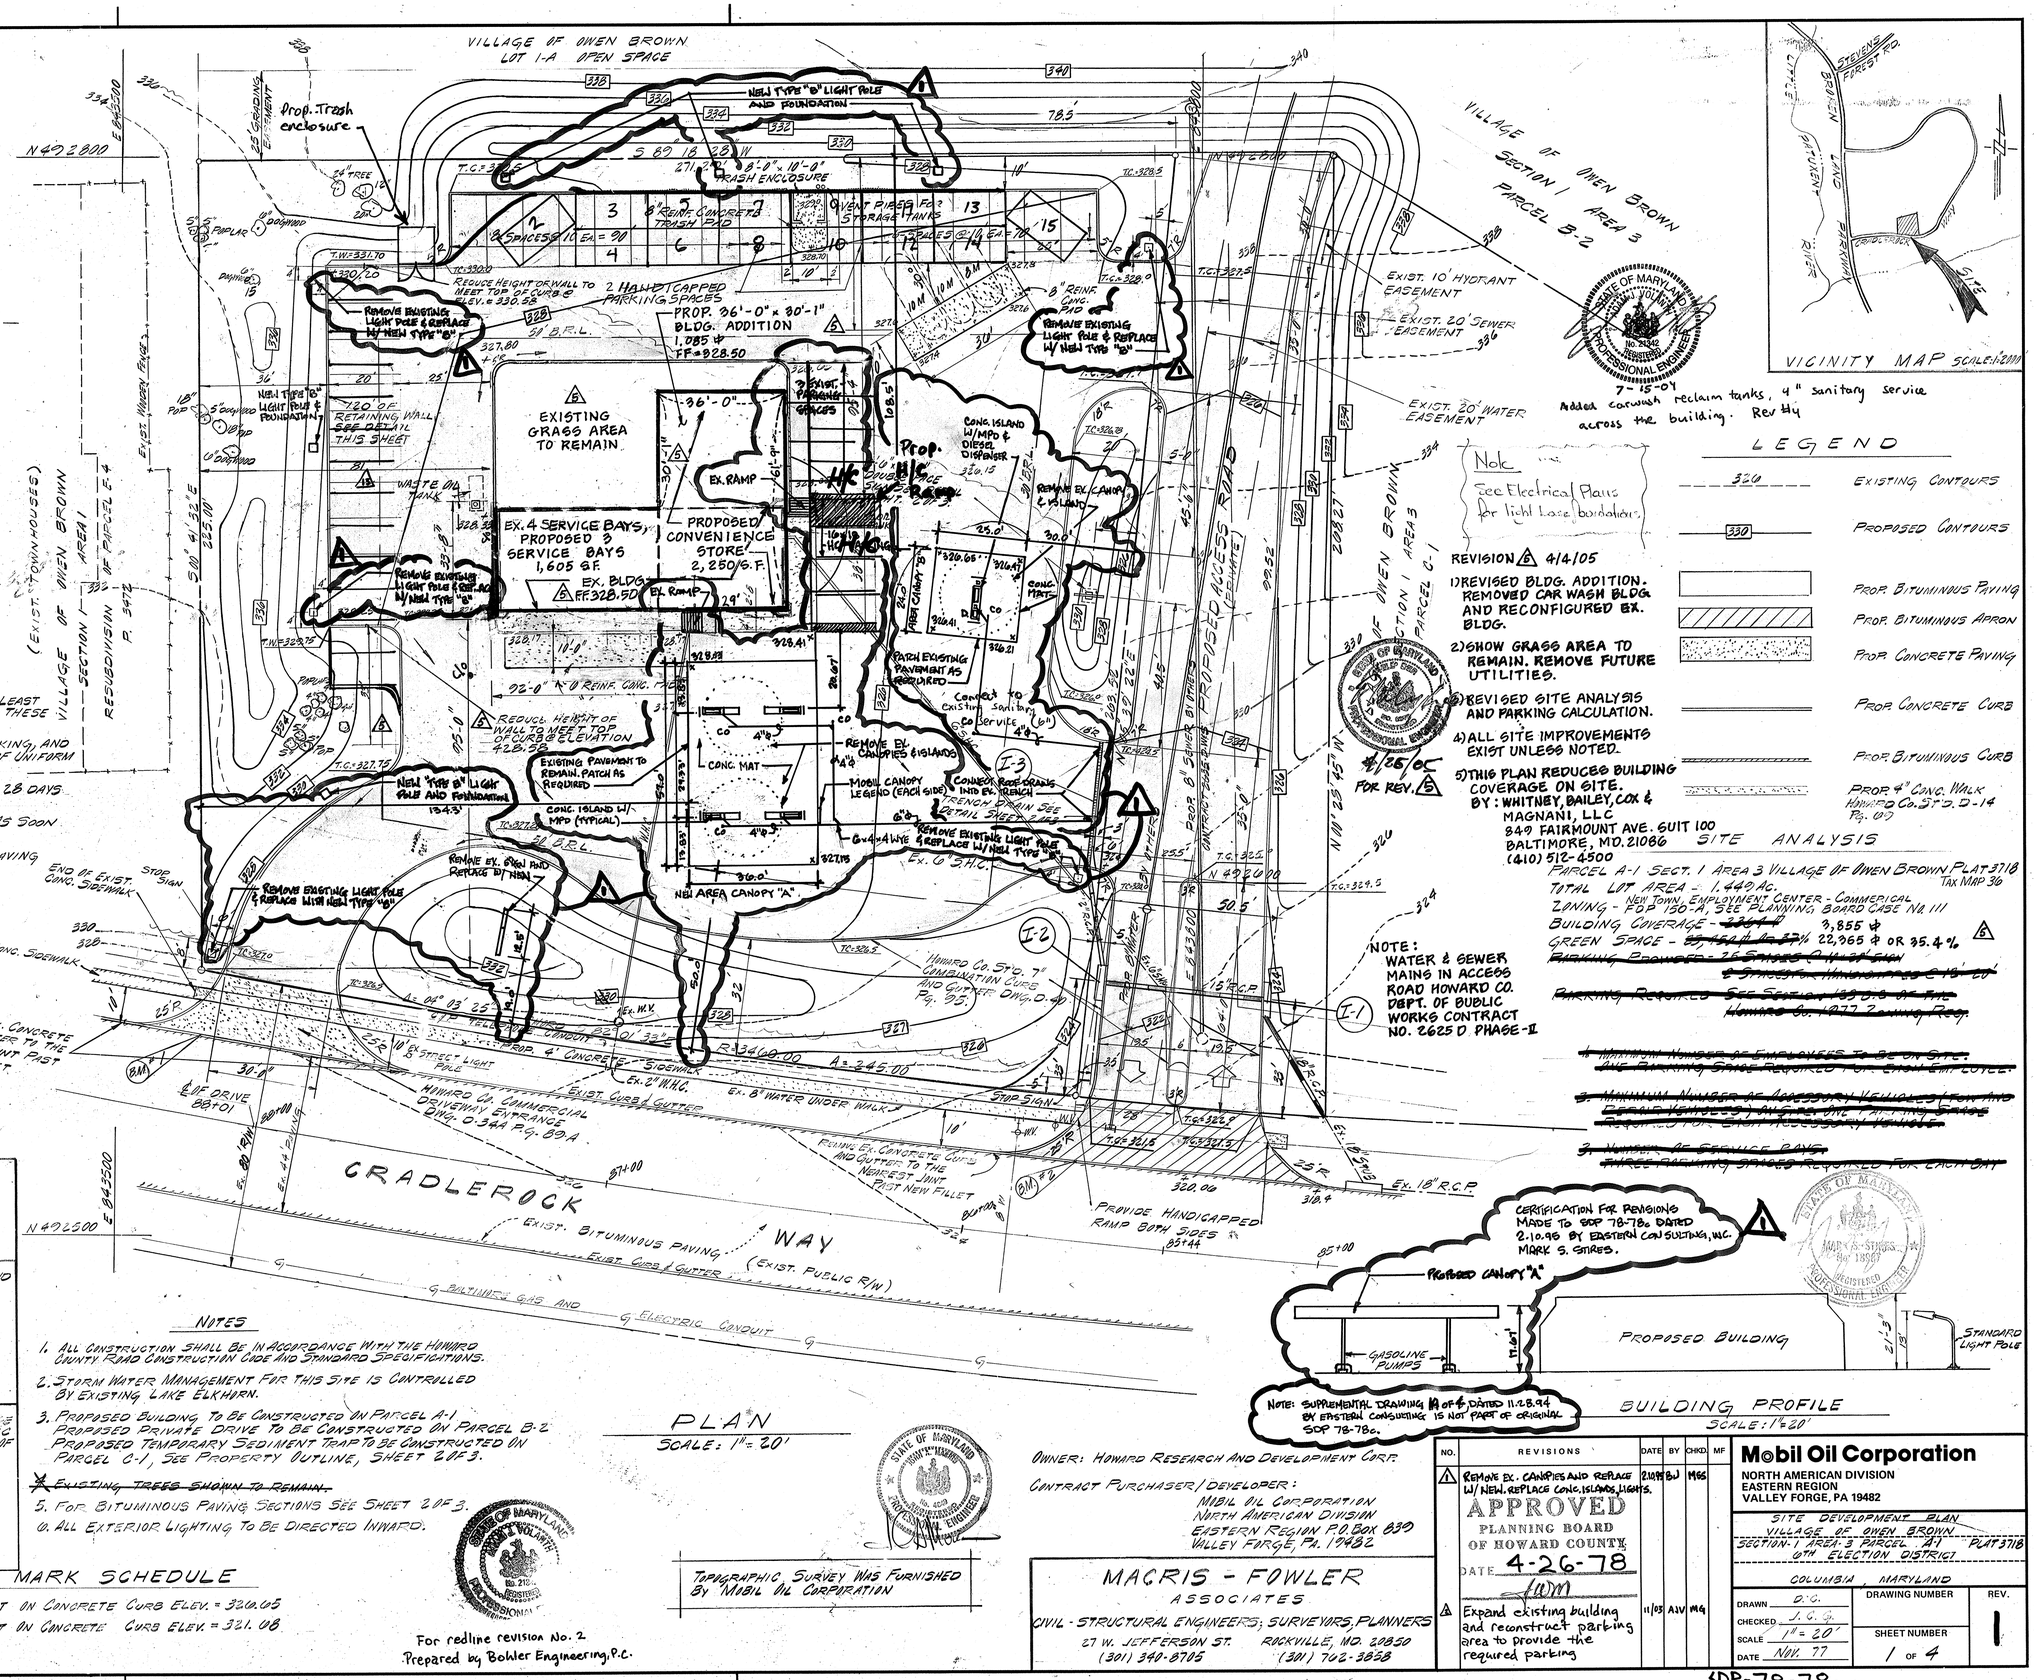
VILLAGE OF OWEN BROWN
LOT 1-A OPEN SPACE
N 49 28 00
E 84 35 00
Prop. Trash enclosure
22' GRADING EASEMENT
54" TREE
S 89° 18' 28" W
271.25'
8'-0" x 10'-0" TRASH ENCLOSURE
NEW TYPE "B" LIGHT POLE AND FOUNDATION
8" REINF. CONCRETE TRASH PAD
3 SPACES @ 10' EA. = 30'
6 SPACES @ 14' EA. = 84'
T.C.=330.20
T.W.=331.70
REDUCE HEIGHT OF WALL TO MEET TOP OF CURB @ ELEV.= 330.52
2 HANDICAPPED PARKING SPACES
PROP. 36'-0" x 80'-1" BLDG. ADDITION 1,085 ☐' FF=328.50
REMOVE EXISTING LIGHT POLE & REPLACE W/ NEW TYPE "B"
5' B.R.L.
720' OF RETAINING WALL SEE DETAIL THIS SHEET
EXISTING GRASS AREA TO REMAIN
EX. 4 SERVICE BAYS, PROPOSED 3 SERVICE BAYS 1,605 G.F.
EX. BLDG. FF.328.50
PROPOSED CONVENIENCE STORE 2,250/G.F.
EX. RAMP
WASTE OIL TANK
REMOVE EXISTING LIGHT POLE & CONC. PAD W/ NEW TYPE "B"
92'-0" R 'D' REINF. CONC. PAVING
REDUCE HEIGHT OF WALL TO MEET TOP OF CURB ELEVATION 328.58
EXISTING PAVEMENT TO REMAIN. PATCH AS REQUIRED
CONC. ISLAND W/ MPD (TYPICAL)
CONC. MAT
REMOVE EX. CANOPIES & ISLANDS
MOBIL CANOPY LEGEND (EACH SIDE)
NEW AREA CANOPY "A"
NEW TYPE "B" LIGHT POLE AND FOUNDATION
REMOVE EXISTING LIGHT POLE & REPLACE WITH NEW TYPE "B"
REMOVE EX. SIGN PAD REPLACE BY NEW
Ex. G.S.H.C.
Ex. G.S.H.C. (I-3)
CONNECT ROOF DRAINS INTO EX. TRENCH DRAIN SEE DETAIL SHEET
REMOVE EXISTING LIGHT POLE & REPLACE W/ NEW TYPE "B"
PATCH EXISTING PAVEMENT AS REQUIRED
Connect to Existing Sanitary Service (6")
Prop. 8" Sewer by others
N 49 22 00
E 84 35 00
