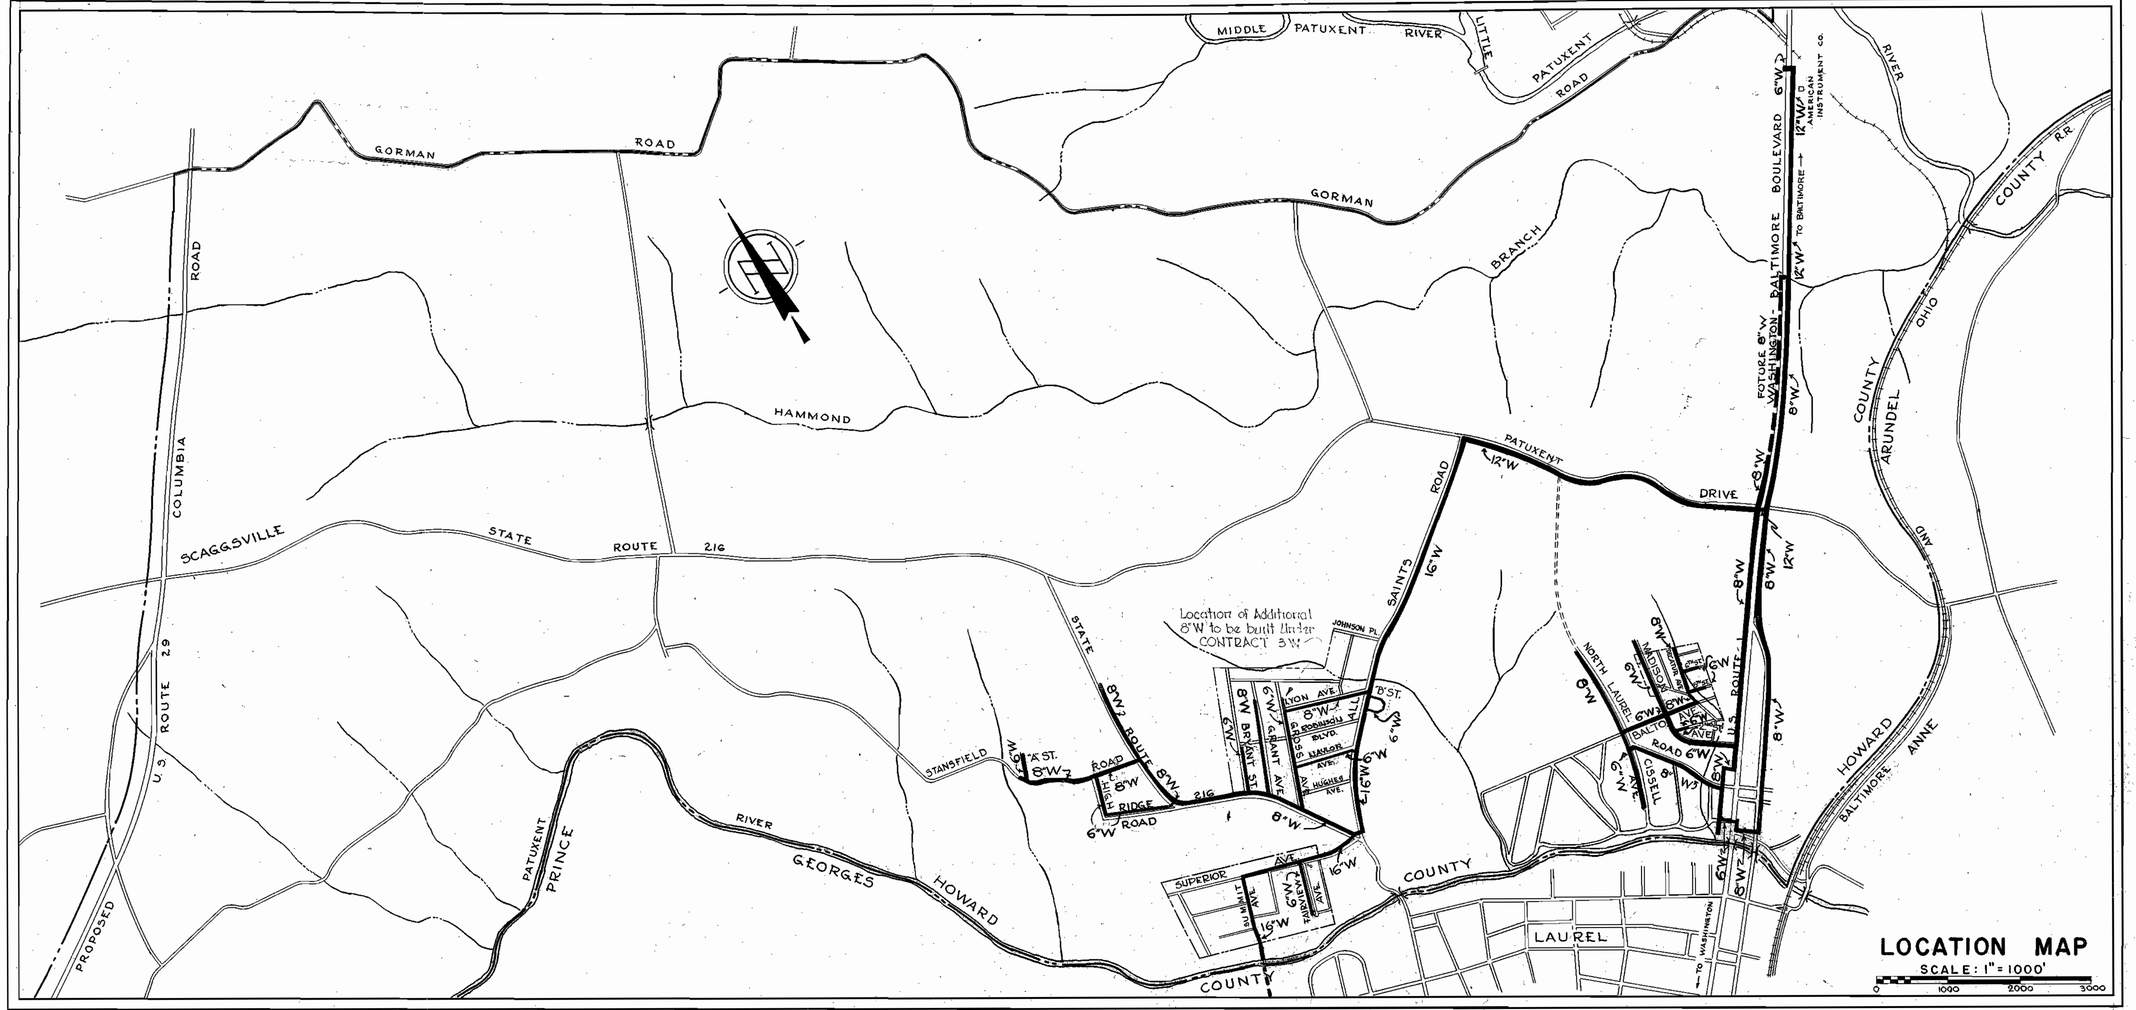

CONTRACT 1W
WATER MAIN EXTENSIONS
HOWARD COUNTY METROPOLITAN COMMISSION
PATUXENT SUB-DISTRICT, MARYLAND

WHITMAN, REQUARDT & ASSOCIATES ENGINEERS 1304 ST. PAUL ST. BALTIMORE, MARYLAND	HOWARD COUNTY METROPOLITAN COMMISSION PATUXENT SUB - DISTRICT MARYLAND	APPROVED BY HOWARD COUNTY METROPOLITAN COMMISSION March 28, 1955 DATE COMMISSIONERS	APPROVED BY WASHINGTON SUBURBAN SANITARY COMMISSION MARCH 29, 1955 DATE Harry P. Shaw CHIEF ENGINEER	LOCATION MAP OF WATER MAIN EXTENSIONS	DRAWING NO. 1 OF 25	SCALE AS SHOWN	55208 Y

4205-2

AS BUILT

W.S. 1-1

...L TRACING CLOTH—D. K. ELLIOTT CO., PGH., PA.

4205-2

B.M. 2163 Elev. 153.189
USC&GS Marker N3-1933 about 350' N.E. of B&O station at S. end of bridge in top of E. end of the south backwall.

INDEX		
	SHEET No.	
STREET NAME	PLAN	PROFILE
BALTO.- WASH. BLVD	2 - 6	17 - 19
PATUXENT DRIVE	7	19
NORTH LAUREL RD.	3 14	17, 20
CISSEL AVE.	14	20
ALL SAINTS RD.	8 - 10	21
STATE ROUTE 216	10 - 12	22
HIGH RIDGE RD.	12, 13	23
BRYANT AVE.	11	23
GROSS AVE.	11	23
GRANT AVE.	11	23
ROBINSON BLVD.	9, 11	23
STANSFIELD RD.	13	23
"A" STREET (DONHARDT)	13	22
MADISON AVE.	15	24
FAIRVIEW AVE.	10	24
BALTIMORE AVE.	14, 15	24
SUPERIOR AVE.	10, 16	24
"B" STREET	8, 9	20
2ND STREET	15	24
3RD STREET	6, 15	24
SUMMIT AVE.	16	25
5TH STREET	6	25
6TH STREET	6	25
DECATUR AVE.	6	25

Pl. 3+03.71
36"C.I.P.
12"RCCP
12" RCCP
24"C.I.P.
24"RCCP
B. & O. RAILROAD
ANNE ARUNDEL COUNTY
HOWARD COUNTY
Pl. 5+25.67
Pl. 8+68.30
Pl. 11+16.45
Profile on Sheet No 17
78,000N 48,000E
78,500N 47,500E
78,500N 48,250E
U.S. 1
BALTIMORE BLVD.
WASHINGTON
Paving
8"H.P.G.
4"H.P.G.
14"H.P.G.
PROPERTY OF MARYLAND STATE FAIR INC.
PROPERTY OF JOSEPH D. HARDING
PROPERTY OF C. C. TALBOTT
PROPERTY OF E. S. GILLAN
PROPERTY OF J. H. INGRAM Jr.
END OF CONTRACT
12' Construction Strip
12' Right of Way
Valencia Motel
15 Cabins
PROPERTY OF R. R. MILINER
Office
Garage
9 Cabins
Cabins Overhead
CISSEL AVE.
Septic Tank
Pl. 2+12.49
Pl. 5+38.40
Pl. 4+13.91
Pl. 1+87.12
Strap F.H. to 8"x6"T. See detail on W.S.S.C. dwg. 5/1464-Y
Match Line "A-A" See Sheet No. 3
Contract 1W

GENERAL NOTES

1. Approximate location of existing mains are shown. The Contractor shall take all necessary precautions to protect the existing mains and services and maintain uninterrupted supply. Any damage incurred shall be repaired immediately.
2. All pipe elevations shown are invert ℄ elevations.
3. For all standard details see standards bound in specifications.
4. The Contractor shall locate existing utilities a minimum of two weeks in advance of construction operations in vicinity of utilites.
5. Before digging, pipe pushing or doing other work near Telephone Cables call collect, at any time, Lexington 9-9900 - Ext. 553, 554 or 555 Baltimore, Maryland.
6. The location of all valves, fittings etc. have been located in plan and dimensions shall be strictly adhered to unless otherwise directed by the Engineer in writing. Profile stationing may have to be adjusted to adhere to plan dimensions.
7. All fittings shall be anchored or buttressed as required. See details bound in specifications.
8. Clear all poles by a 2'-0" min.
9. All tops of Frost Casings on Fire Hydrants to be set 0.25' above edge of paving or as directed by Engineer in the field.
10. All Fire Hydrants to be a min. of 1' clear of property line except where shown to be in private property, or as otherwise noted.
11. *All 2"W. to be Copper "Type K". All 6"&8"W. to be Class 22. All 12"W. to be Class 23. All 16"W. to be Class 25. Use concrete to block all fittings larger than 2". See W.S.S.C. std. detail dwgs. 4G714-L, 4G715-L, 4926D-L & 5486G-L. Blocking buttresses to be altered, wherever required, to provide space for existing utilities. For blocking details of 8"16B.H&V. & 12"-16B.H&V. See special details on Sheet of 16.*

WHITMAN, REQUARDT & ASSOCIATES
ENGINEERS
1304 ST. PAUL ST.
BALTIMORE, MARYLAND

HOWARD COUNTY METROPOLITAN COMMISSION
PATUXENT SUB-DISTRICT
MARYLAND

APPROVED BY HOWARD COUNTY METROPOLITAN COMMISSION
March 28, 1955 DATE
Floyd S. Mowen, Roger D. Gaynor COMMISSIONERS

APPROVED BY WASHINGTON SUBURBAN SANITARY COMMISSION
MARCH 10, 1955 DATE
Harry B. Shaw CHIEF ENGINEER

PLAN OF
WATER MAIN EXTENSIONS

DRAWING NO. 2 OF 25

SCALE 1"=50'

55209
Y
SSNE16-2 SHEET 1
ANNE 16-2 ADDITION

AS BUILT

4205-2

W S 1/2

IMPERIAL TRACING CLOTH—D. K. ELLIOTT CO., PGH., PA.

Match Line "V-V" See Sheet No.14

DECATUR PLACE

PROPERTY OF LEAKE S. MEADOR

PROPERTY OF E. S. GILLAN

PROPERTY OF MECOLLINS ET. AL.

PROPERTY OF J. H. INGRAM & LENA M.

PROPERTY OF MARTHA E. COOK

PROPERTY OF G. R. STANSFIELD

PROPERTY OF M. E. COLLINS ET. AL

PROPERTY OF J. R. LYNCH

PROPERTY OF J. H. INGRAM

PROPERTY OF F. R. BALDWIN

PROPERTY OF A. B. CLOKEY

PROPERTY OF R. R. MILNER

N. LAUREL ROAD

WASHINGTON-BALTIMORE BLVD. U.S. 1

To Washington

To Baltimore

MADISON AVE.

DECATUR AVENUE

For Madison Avenue See Sheet 15

PROPERTY OF ALEXANDER LEAKAN

3 Cabins

Sunoco Gas Station

Macadam Parking Lot

Aliens Restaurant

4" Drain Tile

Cranes Trailer Park Office

Gulf Sign

Macadam Parking Lot

Laurel Park Grill

5 Cabins

PROPERTY OF GEORGE MILLER ET. AL.

PROPERTY OF J. V. HOWARD ET. AL.

PROPERTY OF W. J. WATTS

PROPERTY OF J. R. CRANE

PROPERTY OF JOSEPH HAYES

3 Cabins 3 Garages

Office for Crescent Drive

PROPERTY OF ARTHUR D. FRANCIS ET. AL.

PROPERTY OF LILLIAN A. BLANCHE

END OF CONTRACT

See W.S.S.C. std. detail dwg. 49269-L

Plug Cross and Tap

PROPERTY OF G. CONSTATINI

Strap F.H. to 8"x6"T. See W.S.S.C. dwg 51464-Y

Valencia De Luxe 10 Cabins

Mobil Gas Station

Cabin

Match Line "A-A" See Sheet No. 2

Match Line "B-B" See Sheet No. 4

Profiles on Sheets No. 17, 18, 20 & 24

Contract 1W

WHITMAN, REQUARDT & ASSOCIATES ENGINEERS 1304 ST. PAUL ST. BALTIMORE, MARYLAND	HOWARD COUNTY METROPOLITAN COMMISSION PATUXENT SUB-DISTRICT MARYLAND	APPROVED BY HOWARD COUNTY METROPOLITAN COMMISSION March 28, 1955 DATE — COMMISSIONERS	APPROVED BY WASHINGTON SUBURBAN SANITARY COMMISSION MARCH 19, 1955 DATE — CHIEF ENGINEER	PLAN OF WATER MAIN EXTENSIONS	DRAWING NO. 3 OF 25	SCALE 1"=50'

55210 Y

40NE17, 40NE27, 41NE17-3

AS BUILT

4205-E

WS 1/3

PROPERTY OF ALEXANDER LEAKAN

PROPERTY OF CHARLES E. ANDERSON

PROPERTY OF FRANK & ELEANOR SCOVITCH

PROPERTY OF ANDREW SCOVITCH

W.R.&A. B.M.#2 Elev. 203.492
Nail & Cap in 30" Oak on W. side of U.S. 1 opposite station 31+80±.

Macadam Parking Lot

Souvenir Shop

Kilroys Bar

Esso Station

Cities Service Station

PROPERTY OF GEORGE MILLER ET. AL.

Match Line "B-B" See Sheet No. 3

Match Line "C-C" See This Sheet

WASHINGTON - BALTIMORE BLVD. U.S. 1

To Washington

To Baltimore

Ex. 30" D

Ex. 20" D

P.I. 12+02.26

P.I. 21+25.15

P.I. 29+81.04

P.I. 35+13.30

P.I. 43+52.41

15"x10" CMP Arch

6" Tile and gravel drain

4" Drain Tile

4" H.P.G.

8" H.P.G.

8" W

8"x6"T

10' R/W

4'-0" F.H.

6" V

5" V

Strap F.H. to 8"x6"T. See W.S.S.C. dwg. 5/464-Y

30" G.I.P. Beneath Gutter

6'-6" F.H.

15" R.C.P.

18" G.I.P.

Bill Board

Texas Barbecue Rest.

T Cabins

Profiles on Sheets No. 17 & 18

A 49,250 E
B 80,500 N

A 49,250 E
B 82,250 N

A 49,750 E
B 82,900 N

A 50,250 E
B 82,500 N

Concrete

4'-0"

8" Ground

DETAIL OF CONCRETE BASE AROUND F.H.
Scale: 3/4"=1'-0"

W.R.&A. B.M.#1 Elev. 181.75
Nail & Cap in Pole # 213085 opposite station 19+20±.

Laurel Motel 8 Cabins

PROPERTY OF JOHN SCOVITCH

PROPOSED ROAD

Horse Shoe Motor Court

Ice Cream Stand

Pint-Del Motel

4 Cabins

Turf Motor Court

PROPERTY OF ALBERT L. DALTON

Shell Station

Match Line "C-C" See This Sheet

Match Line "D-D" See Sheet No. 5

Fence Post

Conc. Post

Sign Post

T Sign Post

Manor House Rest.

Macadam Parking Lot

Outriders Diner

PROPERTY OF WILLIAM L. MAYHUGH

Protect F.H. with concrete base. See detail above.

W.R.&A. B.M.#3 Elev. 233.392
Nail & Cap in 24" White Oak 40± E. of station 38+50.

Contract 1W

WHITMAN, REQUARDT & ASSOCIATES ENGINEERS 1304 ST. PAUL ST. BALTIMORE, MARYLAND	HOWARD COUNTY METROPOLITAN COMMISSION PATUXENT SUB-DISTRICT MARYLAND	APPROVED BY HOWARD COUNTY METROPOLITAN COMMISSION March 28, 1955 DATE — COMMISSIONERS	APPROVED BY WASHINGTON SUBURBAN SANITARY COMMISSION MARCH 10, 1955 DATE — CHIEF ENGINEER	PLAN OF WATER MAIN EXTENSIONS	DRAWING NO. 4 OF 25	SCALE 1"=50'	55211 Y 41NE11-1,2,3 42NE11-4

AS BUILT

4205-2

W S 1/4

Match Line "H-H" See Sheet No.7

Match Line "D-D" See Sheet No.4

PATUXENT DRIVE

12"W 8"V 12"x12"C 8"W 12"x8"R 12"x8"R 12"V 12"W

MH 608

California Inn

PROPERTY OF CHARLES H. & GLADYS LAMPARTER

PROPERTY OF ERIC M. & ALBERTA C. GREDINGER

Laurel Veterinary

Emerson's Market

3 Cabins 3 Cabins 3 Cabins

50.750 E 83.250 N

Allen's Motel

END OF CONTRACT

WASHINGTON - BALTIMORE BLVD. U.S. 1

Curb Curb

8"H.P.G. 4"H.P.G.

8"W 8"V 8"x6"T 8"V 6"V 4"-0" F.H. 10'R/W

37339' 8"W 3 Gas Boxes 266.61' 8"W

P.I. Ch 11.72

Gas Valve Vaults

Sign Post

Pristers Mobile Home Park

G.&E. Power Station

45' 38.0' 3'G.

LIMIT OF PART "A"

LIMIT OF PART "B"

Edge of Woods

51.250 E 83.500 N

Match Line "E-E" See This Sheet

Profiles on Sheets No. 18 & 19

50.750 E 82.500 N

51.500 E 84.250 N

51.500 E 83.750 N

Hi-Way Auto Wreckers

WASHINGTON, BALTIMORE, BLVD. U.S. 1

8"V/8"B.V&H. 8"x6"T 4"H.P.G. Curb 8"W 4'-6" F.H. 10'R/W 45' 31' 22' 15' 12' Const Strip Right of Way 12' Const Strip Right of Way 20' 4'-2" F.H. 10'R/W P.I. 23+44.05 8"W 8"V 8"x6"T 4"H.P.G. Curb 8"W 6"V 4'-0" F.H. 10'R/W

11 Cabins Casa Le Grande

Sinclair Service Station

52.000 E 84.500 N

PROPERTY OF WALTER S. & LEDA E. LE COMPTE

PROPERTY OF CLARENCE T. & ROSIE W. REELEY

Match Line "F-F" See Sheet No.6

W.R.&A. B.M. "4A" Elev. 181.493
Cut in top of conc. parapet wall on W. end of wall. South side of U.S.1 approximately 7' right of station 18+85±.

Contract 1W

WHITMAN, REQUARDT & ASSOCIATES ENGINEERS 1304 ST. PAUL ST. BALTIMORE, MARYLAND	HOWARD COUNTY METROPOLITAN COMMISSION PATUXENT SUB-DISTRICT MARYLAND	APPROVED BY HOWARD COUNTY METROPOLITAN COMMISSION March 28, 1955 DATE — COMMISSIONERS	APPROVED BY WASHINGTON SUBURBAN SANITARY COMMISSION MARCH 19, 1955 DATE — CHIEF ENGINEER	PLAN OF WATER MAIN EXTENSIONS	DRAWING NO. 5 OF 25	SCALE 1"=50'

552.12 Y

4205-2

AS BUILT

Match Line "F-F" See Sheet No. 5

Match Line "G-G" See This Sheet

52,000 E 85,000 N

WASHINGTON - BALTIMORE BLVD. U.S. 1

8" H.P.G.

12"x8"R 12"-⅛B.V&H 4.6' 8"V 4"H.P.G. 25.0' 19' Pl. 32+39.22 12"-⅛B.V&H 12"-⅛B.V&H 12"x6"T 12"W 4.0'F.H. 10'R/W 6"V Curb 7' 8"W 8"x6"T 5'x6"T 10'R/W 10' 4' 5' 6' 10' 20' Right of Way Right of Way 12" Const. strip

PROPERTY OF CLARENCE T. & ROSIE W. REELEY

PROPERTY OF LEOPOLD FREEMAN & WILLIAM H. REYNOLDS

Edge of Woods 63' Silt Board

Entrance to Laurel Race Track

4"H.P.G. 6"V 4'0"F.H. 10'R/W 12"x6"T 12"W Curb

W.R.&A. B.M. #48 Elev. 152.555
"Cut in top of S.W. wing wall of culvert on S. side of U.S. 1 approximately 9' right of station 31+60±."

ADDITIONS APPROVED: MAY 23, 1956 DATE Harry P. Shaw CHIEF ENGINEER

WATER TO SERVE LAUREL RACEWAY

53,250 E 87,000 N

Laurel Elev. 182±

20'x20' R/W 6"Plug 7' Meter Vault By Others 8"H.P.G. 6"W 21.8' 2 6"V 12"P 12.3' 12"P 22' 2.3'

Match Line "G-G" See This Sheet

WASHINGTON - BALTIMORE BLVD. U.S. 1

8" H.P.G. 7' 12"x6"T 4"H.P.G. 12"W 10'R/W 6"V 4'0"F.H. 7.0' Pl. 48+78.47 16.0' 7' 2" Air Valve Manhole 12"W 6"V 6"V 4'0"F.H. 6"P 10'R/W 10.5' 41.7' 12"x6"T 12"V 15.2' 15.0' Pl. 55+14.97 4"H.P.G. 12"W 2

PROPERTY OF LEOPOLD FREEMAN WILLIAM H. REYNOLDS

48,000 E 81,000 N

W.R.&A. B.M. #4C Elev. 187.537
Nail & Cap in N. side of pole #G.F.E. 309229 on S. side U.S. #1 approximately 10' right of station 49+85±.

ADDITION APPROVED: JAN. 18 1956 Harry P. Shaw CHIEF ENGINEER

PROPERTY OF AMERICAN INSTRUMENT COMPANY

Profiles on Sheets No. 19, 24 & 25

Match Line "A-A" See sheet No. 15

53,000 E 86,000 N

FOURTH STREET

AVENUE

NOT AS BUILT

TO BE BUILT UNDER CONTRACT GW

145.99' Ex. 18"D 8"V 8"W 18" 8"x6"T 8"W 6"V 5'0"F.H. 8" Plug 6" Plug 56.10' 2.3' 111.67 76.54' 125.32' SEVENTH STREET

Pl. 18+23.00 8"x6"T 8"W 22' 23' Ex. 18" C.M.P. 111.67 Pl. 11+22.13+0.00

THIRD STREET DECATUR 102.29 8"W 8"V 6"x4"B 6"V 5'0"F.H. 100.77' 6"V 18" 8"x6"T 8"W 8"V 8"W 8"x6"B 6"V 6"x4"B 8"P 8"x6"T 22' 141.33 148.3 129.20 Pl. 5+02.70 129.20 Ex. 30"D 558.6 CC 77' 5.6' 56' 60' 50' 50' 50

Match Line "H-H" See sheet No. 5

PATUXENT

WATSON DEVELOPMENT

(WHISKEY BOTTOM ROAD)

W.R. & A. B.M.#5
Nail in pole #306005 on W. side Patuxent Drive approximately 35' W. of station 59+20.
Elev. 267.690

PROPERTY OF CHARLES H. & GLADYS LAMPARTER

W.R. & A. B.M.#4
Nail & Cap in second pole on right side of Patuxent Dr. from U.S. 1 opposite station 51+05.
Elev. 237.195

PROPERTY OF REBECCA E. RUDKIN
5.15 A

PROPERTY OF WM. O. SKEELS ET AL
8.0 A

DRIVE

Profile on Sheet No. 19

PROPERTY OF EDWARD E. & MARIE C. KENNEDY

PROPERTY OF EZEKIEL R. & MARY E. MOXLEY

PROPERTY OF EDWARD E. & MARIE C. KENNEDY and PAUL E.J. & REGENE M. LEPORE

PROPERTY OF AUSTIN L. TUSING & w.f.

PROPERTY OF EDWARD E. & MARIE C. KENNEDY and PAUL E.J. & REGENE M. LEPORE

PROPERTY OF WM. WALTER & MARY D. SCHMIDT

Strap F.H. to 12"x6"T See W.S.S.C. dwg. 51464-Y.

(WHISKEY BOTTOM ROAD)

DRIVE

Match Line "I-I" See this sheet

Match Line "J-J" See this sheet

PATUXENT ESTATES

PROPERTY OF LEE R. STANTON & AUDREY STANTON

PROPERTY OF WILLIAM WILSON SOUTHARD Sr.

2" Air Valve Manhole

Match Line "K-K" See Sheet No. 8

WHITMAN, REQUARDT & ASSOCIATES ENGINEERS 1304 ST. PAUL ST. BALTIMORE, MARYLAND	HOWARD COUNTY METROPOLITAN COMMISSION PATUXENT SUB-DISTRICT MARYLAND	APPROVED BY HOWARD COUNTY METROPOLITAN COMMISSION March 28, 1955 DATE — COMMISSIONERS	APPROVED BY WASHINGTON SUBURBAN SANITARY COMMISSION MARCH 19, 1955 DATE — CHIEF ENGINEER	PLAN OF WATER MAIN EXTENSIONS	DRAWING NO. 7 OF 25	SCALE 1"=50'

Contract 1W

55214 Y

42.NE.17-1,2,4 43.NW.1-3,4 42.NW.1-3

AS BUILT

4205-2

PERIAL TRACING CLOTH—B. K. ELLIOTT CO., PGH., PA.

W.R.&A. B.M.#8 Elev. 259.458
Nail & Cap in pole on S.E. side of All Saints Rd. approximately 9' left of station 101+25±.

PROPERTY OF WILLIAM WILSON SOUTHARD Sr.

ALL SAINTS ROAD

Match Line "K-K" See Sheet No. 7

PATUXENT DRIVE

Match Line "L-L" See this sheet

Match Line "L-L" See this sheet

47,000E 85,250N

Ex. 12" R.C.C.P. To be replaced if disturbed

10' R/W 40'

12" R.C.C.P.

6'-0" F.H.

14" VALVE & 16"X14" REDUCER REMOVED BY HOWARD COUNTY

12"W

16"W

16"G.I.P.

16"x14"R

14"P

14"V

16"x6"T

6"V

3" 2' 3' 3'

W.R.&A. B.M.#7 Elev. 294.954
Nail & Cap in pole at N.W. corner of Patuxent Dr. & All Saints Rd.

PROPERTY OF WILLIAM WILSON SOUTHARD Jr.

Profiles on Sheets No. 19, 20 & 21

47,250E 85,750N

16"G.I.P.

ALL SAINTS ROAD

Match Line "L-L" See this sheet

Match Line "M-M" See this sheet

10' R/W 4'-6" F.H. 6"V

16"W

45,750E 84,250N

14"V 16"x14"R

12"G.I.P.

P.I. 116+84.01

120

W.R.&A. B.M.#9 Elev. 257.260
Nail & Cap in pole #15 on S.W. side of All Saints Rd. approximately 20' right of station 112+60±.

45,250E 84,000N

Match Line "M-M" See this sheet

W.R.&A. B.M.#11 Elev. 222.799
Steel bar in center top of property monument approximately 11.5' left of station 132+06±.

45,250E 83,750N

Match Line "M-M" See this sheet

Match Line "N-N" See Sh. No. 9

10' R/W 6'V 5'-0" F.H. 16"x6"T

ALL SAINTS

16"x14"R 21.3

16"W

P.I. 123+41.97

P.I. 126+37.20

46' G.I.P.

"B" STREET

Ex. 12" R.C.C.P. Replaced if disturbed

6"W

15' G.I.P.

P.I. 132+20.75

PROPERTY OF HIGH RIDGE PARK Co. JOHNSON PLACE

390	389	388	292	291	290	289	288	287	286	285	284	283	282	281	280	279	275	274	273	272

W.R.&A. B.M.#10 Elev. 242.209
Nail & Cap in pole #11 on S.W. side of All Saints Rd. approximately 15' right of station 120+85±.

44,250E 83,250N

LYON AVENUE

Match Line "N-N" See Sheet No. 9

Contract 1W

WHITMAN, REQUARDT & ASSOCIATES ENGINEERS 1304 ST. PAUL ST. BALTIMORE, MARYLAND	HOWARD COUNTY METROPOLITAN COMMISSION PATUXENT SUB-DISTRICT MARYLAND	APPROVED BY HOWARD COUNTY METROPOLITAN COMMISSION March 28, 1955 DATE — COMMISSIONERS	APPROVED BY WASHINGTON SUBURBAN SANITARY COMMISSION MARCH 10, 1955 DATE — CHIEF ENGINEER	PLAN OF WATER MAIN EXTENSIONS	DRAWING NO. 8 OF 25	SCALE 1"=50'	55215 Y

4205-2

AS BUILT

IMPERIAL TRACING CLOTH—E. K. ELLIOTT CO., PGH., PA.

W.R.&A. B.M.#12 Elev. 250.772
Nail & Cap in pole # 306045 at intersection of All Saints Rd. & Robinson Blvd.

43,750 E
82,250 N

Profiles on Sheets No. 20, 21 & 23

Match Line "N-N" See Sheet No 8

Match Line "O-O" See Sheet No 10

ALL SAINTS ROAD

16"W

10' R/W

4'6" F.H.

6"V

16"x6"T

6" C.C.P.

15" C.I.P.

199.98'

139.72 CC

2" Air Valve Manhole

P.I. 144+24.60

P.I. 144+70.73

57'

PROPERTY OF JAMES WHEATLEY

44,000 E
83,000 N

PROPERTY OF WILLIAM L. BROOKS & wf. 234

PROPERTY OF EDMOND J. FENWICK & wf. 232

PROPERTY OF ARTIE BROWN

Robinson Blvd. By Plat Recorded Jan 1921

Naylor Ave. By Plat Recorded Jan 1921

NAYLOR AVE.

PROPERTY OF CHURCH OF GOD IN CHRIST

PROPERTY OF JAMES M. BROWN

HUGHS AVE.

43,250 E
83,000 N

"B" STREET

6"W

6"x45°B

6"x6"T

4'6" F.H.

Match Line "N-N" See Sh. No. 8

43,250 E
83,000 N

188 PROPERTY OF INEZ ROYER

187 PROPERTY OF MILLIE E. KUYKENDELL

AVE "T"

Match Line "P-P" See Sheet No. 11

Adjustable roadway valve box

6"C.I. nipple 12" lg.

16"x6" Standard Blow-off Branch

6"x6" Tee

6" Gate Valve

See Harness Detail Sh. 16

Inv. 153.05

Inv. 153.4

6'-0"

Provide standard blocking and anchorage as required.

6"-45° C.I. Bend B&S.

6" C.I.P. Inv. 153.0

3'-0" min

12"

½" ϕ bars 12" c.c. both ways

Class B Conc.

Brass Cleanout Plug

2'-0"

Carry concrete to firm ground

DETAIL OF HEADWALL FOR BLOW-OFF

ELEVATION
Scale: ½"=1'-0"

24" or as directed by Engineer in the field

Headwall

6" Plug

6"x6" Tee

6" Gate Valve

16" C.I.P.

16"x6" Standard Blow-off Branch

6'-0" Way of

15' Right

PLAN

DETAIL OF BLOW-OFF

Scale: 1/4"=1'-0"

Contract IW

WHITMAN, REQUARDT & ASSOCIATES ENGINEERS 1304 ST. PAUL ST. BALTIMORE, MARYLAND	HOWARD COUNTY METROPOLITAN COMMISSION PATUXENT SUB-DISTRICT MARYLAND	APPROVED BY HOWARD COUNTY METROPOLITAN COMMISSION March 28, 1955 DATE — COMMISSIONERS	APPROVED BY WASHINGTON SUBURBAN SANITARY COMMISSION MARCH 12, 1955 DATE — Harry B. Shaw CHIEF ENGINEER	PLAN OF WATER MAIN EXTENSIONS	DRAWING NO. 9 OF 25	SCALE 1"=50'

55216
Y
JANE 15-1
JANE 15-34

4205-2

AS BUILT

W S 1/9

IMPERIAL TRACING CLOTH—S. K. ELLIOTT CO., PHILA., PA.

W.R.&A. B.M.#14 Elev. 193.517
Nail & Cap in pole 65'± E. of P.I. 153+55.32
on S. side of Route 216 at All Saints Rd.

W.R.&A. B.M.#13
Nail & Cap in pole opposite
149+85±.

W.R.&A. B.M. 14-A Elev. 243.63
Nail & Cap in pole #175808 at intersection
Fairview Ave. & Gravel Rd.

Profiles on Sheets No. 21, 22, & 24

① Revised alignment thru Property of C.R. Miles - June 8, 1955

Contract IW

WHITMAN, REQUARDT & ASSOCIATES ENGINEERS 1304 ST. PAUL ST. BALTIMORE, MARYLAND	HOWARD COUNTY METROPOLITAN COMMISSION PATUXENT SUB-DISTRICT MARYLAND	APPROVED BY HOWARD COUNTY METROPOLITAN COMMISSION March 28, 1955 DATE COMMISSIONERS	APPROVED BY WASHINGTON SUBURBAN SANITARY COMMISSION MARCH 10, 1955 DATE Harry B. Shaw CHIEF ENGINEER	PLAN OF WATER MAIN EXTENSIONS	DRAWING NO. 10 OF 25	SCALE 1"=50'	552.17 Y 4INE15-1

4205-2

AS BUILT

WS 1/10

IMPERIAL TRACING CLOTH—E. K. ELLIOTT CO., PGH., PA.

Match Line "R-R" See Sheet No. 12

Profiles on Sheets No. 22 & 23

W.R. & A. B.M.#15 Elev. 254.985
Nail & Cap in pole #8 on N. side Route 216
approximately 25' left of station 162+50±.

W.R. & A. B.M.#17 Elev. 265.451
Nail & Cap in pole #307402 approximately
18' N. of station 168+90±.

W.R. & A. B.M.#16 Elev. 265.694
Nail & Cap in pole #7 approximately
10' S. of station 8+95±.

PROPERTY OF FRANK G. & WM. R.H. BRYANT
PROPERTY OF GRACE M. MILES
PROPERTY OF HARRY G. BRADY & WF.
PROPERTY OF DON E. & BARBARA A. KRAMER
PROPERTY OF FLOYD M. JR. & ERMENE D. LILLY
PROPERTY OF VERNON E. & VELMA A. GOODMAN
PROPERTY OF EVERETT C. & ANNEBELLE D. LATLIEF
PROPERTY OF JOHN C. HOFFMAN JR. & WF.
PROPERTY OF HIGH RIDGE PARK CO.
PROPERTY OF EARL J. & LUCILLE E. TUCKER
PROPERTY OF ROY G. GRAFT & WF.
PROPERTY OF RICHARD CASTLE
PROPERTY OF DAVID HILLEGASS & WF.
PROPERTY OF RAYMOND N. & JULIA MOORE
PROPERTY OF CHAS E. & EVELYN M. BASS
PROPERTY OF LESTER A. & MARY L. TAYMAN
PROPERTY OF JAMES A. & WHITING
PROPERTY OF ROBT. C. WHITING
PROPERTY OF JAMES E. WELLS & WF.
PROPERTY OF WM. L. HARDING & WF.
PROPERTY OF MELVIN HENRY & REBA ELLA RENN
PROPERTY OF LEE & LEVERA BROWN
PROPERTY OF FINNER SMITH & WF.
PROPERTY OF SAMUEL H. GRIMES & WF.
PROPERTY OF ENGENE E. STULTZMAN & WF.

Macadam
AVENUE
DEDICATED STREET
GRANT
GROSS
HUGHES AVENUE
NAYLOR AVE.
ROUTE 216
STATE
Robinson Blvd.

Match Line "Q-Q" See Sheet No. 10
Match Line "P-P" See Sheet No. 9
See this sheet

Contract IW

WHITMAN, REQUARDT & ASSOCIATES ENGINEERS 1304 ST. PAUL ST. BALTIMORE, MARYLAND	HOWARD COUNTY METROPOLITAN COMMISSION PATUXENT SUB-DISTRICT MARYLAND	APPROVED BY HOWARD COUNTY METROPOLITAN COMMISSION March 28, 1955 DATE Roy C. Moore, Roger D. Carpenter, COMMISSIONERS	APPROVED BY WASHINGTON SUBURBAN SANITARY COMMISSION MARCH 10, 1955 DATE Harry P. Shaw, CHIEF ENGINEER	PLAN OF WATER MAIN EXTENSIONS	DRAWING NO. 11 OF 25	SCALE 1"=50'

55218 Y
41NE15-1
42NE15-3

42.05-2

AS BUILT

WS 1/11

IMPERIAL TRACING CLOTH—R. K. ELLIOTT CO., PGH., PA.

PLAN

Scale 1" = 50'

ADDITIONS APPROVED: SEPT. 16, 1957
Harry B. Shaw
CHIEF ENGINEER

83,750N 43,250E

83,250N 44,500E

LYON AVE.

WEEKS AVE.

ALL SAINTS ROAD

GROSS AVE.

"150' ADDITION TO BE BUILT UNDER CONTRACT 3W"

Connect to Ex. 8"W

Ex. 6" Plug

P.I. 7+42.06

P.I. 9+11.06

P.I. 19+32.22 = P.O.T. 13+27.55

P.I. 13+29.75

Fav. Str. 17+28

7'-0" F.H.

4'-6" F.H.

5'-4" F.H.

DEDICATED STREET

DEDICATED STREET

Paving

Robinson Blvd.

See Sheet 8 for continuation of 16" Water Main

See Sheet 11 for continuation of 6" Water Main

PROFILE

Scale
H - 1" = 100'
V - 1" = 10'

GROSS AVENUE

℄ Dedicated St. = 3+74 ℄ Gross Ave.

℄ LYON AVE. = 3+29 ℄ GROSS AVE.

Ground over Water 5-10-55
P.I. El. = 264.08
P.O.C. El. = 258.33

℄ Grade

Prop. Grade by WR&A

370%

300%

850%

10+35 300' VC
P.I. El. = 250.07
P.O.C. El. = 252.58

150' Addition.
To be built under Contract 3W

PROFILE

Scale
H - 1" = 100'
V - 1" = 10'

LYON AVENUE

℄ Gross Ave. = 0+00 ℄ Lyon Ave.

1+69.23 100' VC
P.I. El. 257.59
P.O.C. El. 257.40

1.00%

Proposed Grade by Vinton D. Cockey
Ground over Water 5-10-55

2.50%

℄ Grade

7+19.23 200' VC
P.I. El. 243.85
P.O.C. El. 242.33

8.57%

℄ Wacke Ave. = 8+43 ℄ Lyon Ave

11+93± ℄ All Saints Rd. = ℄ Lyon Ave.

42" D Proposed by others

10+00 100' VC
P.I. El. 219.78
P.O.C. El. 220.60

2.00%

Revised 9/11/57
Contract 1W

WHITMAN, REQUARDT & ASSOCIATES ENGINEERS 1304 ST. PAUL ST. BALTIMORE, MARYLAND	HOWARD COUNTY METROPOLITAN COMMISSION PATUXENT SUB-DISTRICT MARYLAND	APPROVED BY HOWARD COUNTY METROPOLITAN COMMISSION DATE _____ COMMISSIONERS	APPROVED BY WASHINGTON SUBURBAN SANITARY COMMISSION May 31, 1955 DATE Harry B. Shaw CHIEF ENGINEER	PLAN AND PROFILE OF WATER MAIN EXTENSIONS	DRAWING NO. 11A OF 25	SCALE AS SHOWN	55218-A Y 42NE15-1,2

AS BUILT

WS 1/11A

IMPERIAL TRACING CLOTH—B. K. ELLIOTT CO., PGH., PA.

FUTURE LOW ZONE

FUTURE HIGH ZONE

82,750N 41,750E

HIGH RIDGE ROAD

Match Line "R-R" See Sheet No. 11

STATE ROUTE 216

Future Division Valve

12"G.I.P.

8"W

8"V

6"V

8"x6"T

4'-6"F.H.

4'-0"F.H.

5'-0"F.H.

18"G.I.P.

12"G.I.P.-Zn

6"x6"T

6"W

6"Iron Pipe

P.I. 176+54.71

P.I. 180+59.77 = 0+00

P.I. 16+42.06

P.I. 19+78.70

P.I. 2+66.55

P.I. 15+25.38

P.I. 20+44.13

75.2±

80.0±

82.6

110.5±

78.7±

52.6

51'

45'

4.5'

10'

2'

3'

W.R.&A. B.M.#18 Elev. 316.938
+ Cut in top of S. end of culvert wall 150± N. of intersection of Route 216 & High Ridge Rd.

Profiles on Sheets No. 22 & 23

Clear all poles by 2'-0" Min.

83,750N 41,790E

W.R.&A. B.M.#22 Elev. 303.399
Nail & Cap in pole #315256 approximately 30' left of station 15+70±.

84,500N 41,000E

84,250N 41,250E

83,250N 41,250E

83,750N 41,000E

W.R.&A. B.M.#21 Elev. 320.422
Nail & Cap in pole #158874 at intersection of Stansfield Rd. & Route 216 approximately 20' left of station 9+20±.

STANSFIELD ROAD

Match Line "T-T" See this sheet

Match Line "T-T" See Sheet No. 13

Contract IW

N

WHITMAN, REQUARDT & ASSOCIATES ENGINEERS 1304 ST. PAUL ST. BALTIMORE, MARYLAND	HOWARD COUNTY METROPOLITAN COMMISSION PATUXENT SUB-DISTRICT MARYLAND	APPROVED BY HOWARD COUNTY METROPOLITAN COMMISSION March 28, 1955 DATE COMMISSIONERS	APPROVED BY WASHINGTON SUBURBAN SANITARY COMMISSION MARCH 10, 1955 DATE CHIEF ENGINEER	PLAN OF WATER MAIN EXTENSIONS	DRAWING NO. 12 OF 25	SCALE 1"=50'

55219 Y

42NE14-2,4
43NE14-2,4

AS BUILT

4205-2

WS 1/12

IMPERIAL TRACING CLOTH—B. K. ELLIOTT CO., PGH., PA.

W.R.&A. B.M.#19 Elev. 314.584
Nail & Cap in base of 30" Red Oak approximately 12' N. of station 191+25±.

W.R.&A. B.M.#20B Elev. 317.792
Nail & Cap in Transmission Line Pole G.&E. #148307 approximately 100' N. of P.I. 12+05.21.

HIGH RIDGE ROAD

STANSFIELD ROAD

(DOMHARDT) "A" STREET

Match Line "T-T" See Sheet No. 12

Match Line "U-U" See This Sheet

Profiles on Sheets No. 22 & 23

W.R.&A. B.M.#20 Elev. 294.180
Nail & Cap in pole at intersection of High Ridge Rd. & Stansfield Rd.

W.R.&A. B.M.#20A Elev. 277.470
Nail & Cap in C.&P. pole #5 approximately 400± N.W. of High Ridge Rd. on E. side of Stansfield Rd.

Strap F.H. to 8"x6"T. See detail on W.S.S.C. dwg. 51464-Y.

WHITMAN, REQUARDT & ASSOCIATES ENGINEERS 1304 ST. PAUL ST. BALTIMORE, MARYLAND	HOWARD COUNTY METROPOLITAN COMMISSION PATUXENT SUB-DISTRICT MARYLAND	APPROVED BY HOWARD COUNTY METROPOLITAN COMMISSION March 28, 1955 DATE — COMMISSIONERS	APPROVED BY WASHINGTON SUBURBAN SANITARY COMMISSION MARCH 19, 1955 DATE — CHIEF ENGINEER	PLAN OF WATER MAIN EXTENSIONS	DRAWING NO. 13 OF 25	SCALE 1"=50'	55220 Y

Contract 1W

4205-2

AS BUILT

WS 1/13

W.R.&A. B.M.#30 Elev. 170.163
Nail & Cap in 10" Pine on W. side N. Laurel Rd. approximately 300' N. of U.S.#1, 25'± left of station 8+00.

W.R.&A. B.M.#31 Elev. 169.586
Nail & Cap in 18" Ash on E. side N. Laurel Rd. 25'± right of station 12+50±.

W.R.&A. B.M.#32 Elev. 189.668
Nail & Cap in G.&E. pole# 191331 on E. side N. Laurel Rd. approximately 125' S. of Cissel Ave. 20'± right of station 18+75±.

W.R.&A. B.M.#33 Elev. 232.179
Nail & Cap in pole# 198181 on W. side N. Laurel Rd. 15'± left of station 29+50±.

W.R.&A. B.M.#34 Elev. 255.254
Nail & Cap in pole on W. side of N. Laurel Rd. approximately 175'± N. of end of macadam.

Profiles on Sheets No. 20 & 24

NORTH LAUREL ROAD

WHITMAN, REQUARDT & ASSOCIATES ENGINEERS 1304 ST. PAUL ST. BALTIMORE, MARYLAND	HOWARD COUNTY METROPOLITAN COMMISSION PATUXENT SUB-DISTRICT MARYLAND	APPROVED BY HOWARD COUNTY METROPOLITAN COMMISSION March 28, 1955 DATE — COMMISSIONERS	APPROVED BY WASHINGTON SUBURBAN SANITARY COMMISSION March 19, 1955 DATE — CHIEF ENGINEER	PLAN OF WATER MAIN EXTENSIONS	DRAWING NO. 14 OF 25	SCALE 1"=50'	55221 Y

Contract 1W

AS BUILT

4205-2

41 1/4 SW

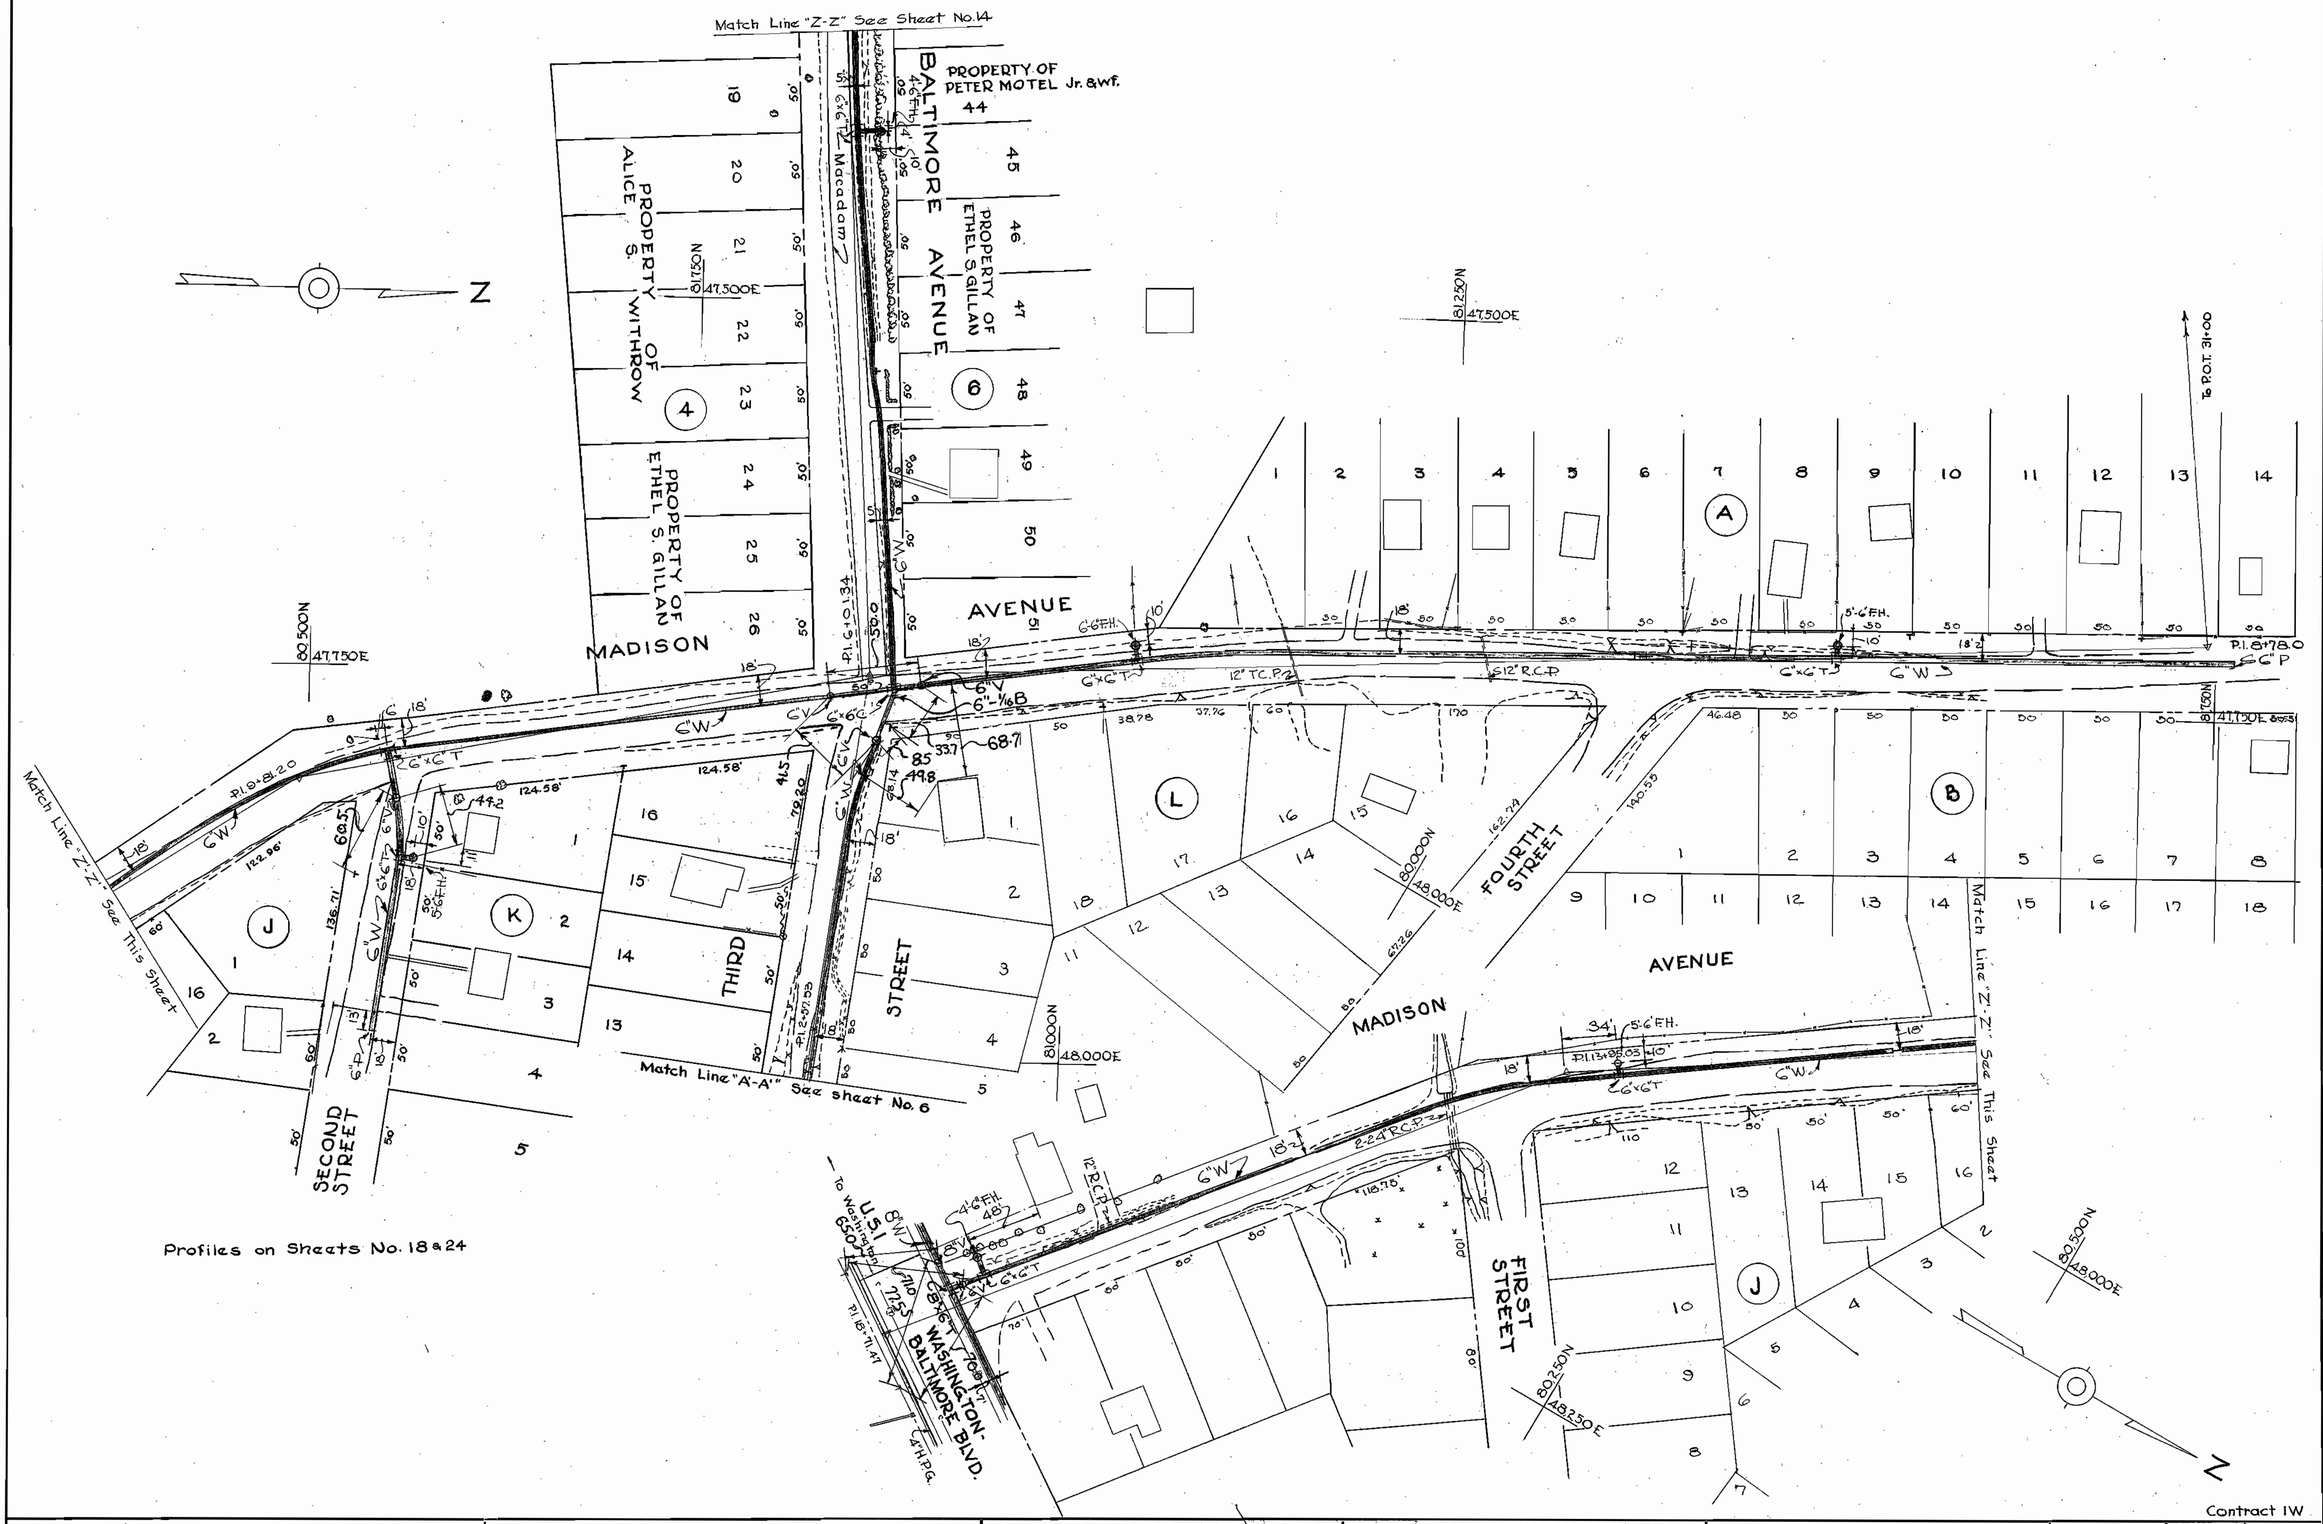

WHITMAN, REQUARDT & ASSOCIATES ENGINEERS 1304 ST. PAUL ST. BALTIMORE, MARYLAND	HOWARD COUNTY METROPOLITAN COMMISSION PATUXENT SUB - DISTRICT MARYLAND	APPROVED BY HOWARD COUNTY METROPOLITAN COMMISSION March 28, 1955 DATE COMMISSIONER'S	APPROVED BY WASHINGTON SUBURBAN SANITARY COMMISSION MARCH 10, 1955 DATE CHIEF ENGINEER	PLAN OF WATER MAIN EXTENSIONS	DRAWING NO. 15 OF 25	SCALE 1"=50'

Contract IW

55222 Y

4205-2

AS BUILT

W S 1/15

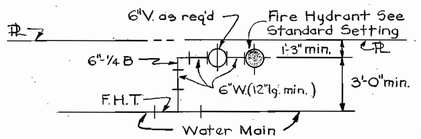

SCHEMATIC OF F. H. LEAD

No Scale

To be used only when directed by Engineer in the field.

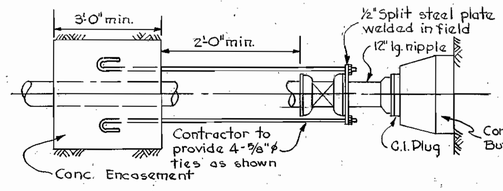

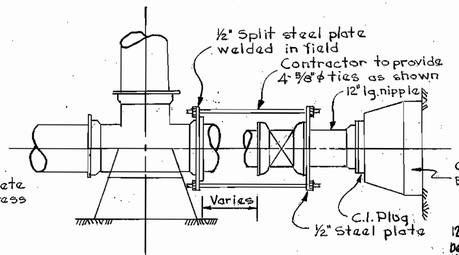

TYPICAL HARNESS DETAILS

FOR FUTURE WATER EXTENSIONS

No Scale

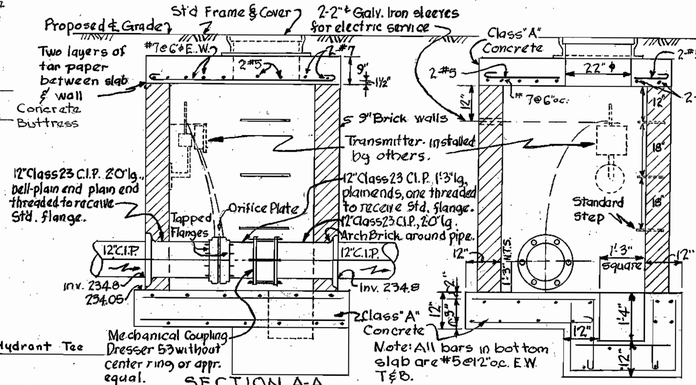

SECTION A-A

SECTION B-B

Match Line "Y-Y" See sheet No. 10

42,000E
80,850N

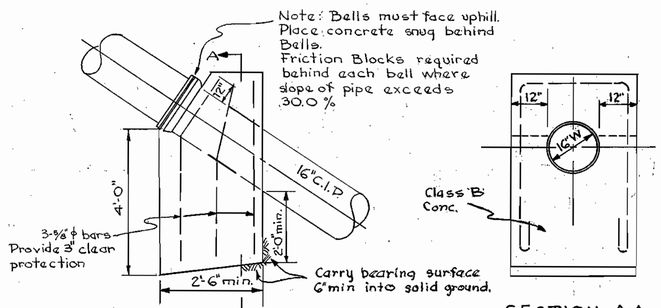

DETAIL OF ANCHOR BLOCK

Scale: ½"=1'-0

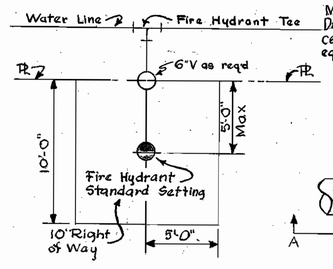

SCHEMATIC OF F.H. SET IN PRIVATE PROPERTY

No Scale

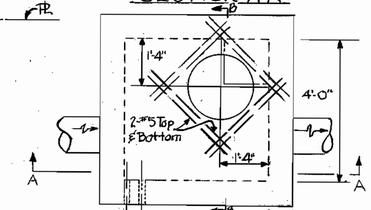

PLAN

Size	Reinf. Bars	A	B	C
8"	2-½" ϕ	2'-4"	2'-0"	9"
12"	2-½" ϕ	3'-0"	2'-0"	12"

Embed bars 30 diameters. Paint exposed bars with two coats of approved bituminous paint

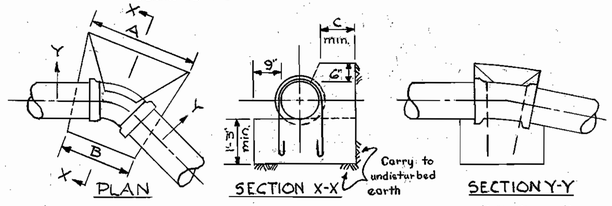

ANCHORAGE FOR ⅛ BENDS "H & V"

No Scale

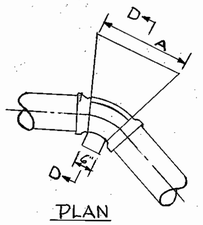

METER VAULT

Scale ½"=1'-0"

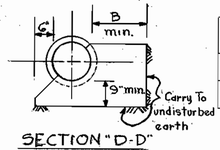

Size	A	B
8"	2'-0"	12"
12"	2'-6"	1'-6"

BUTTRESS FOR ⅛ BENDS "H & V"

No Scale

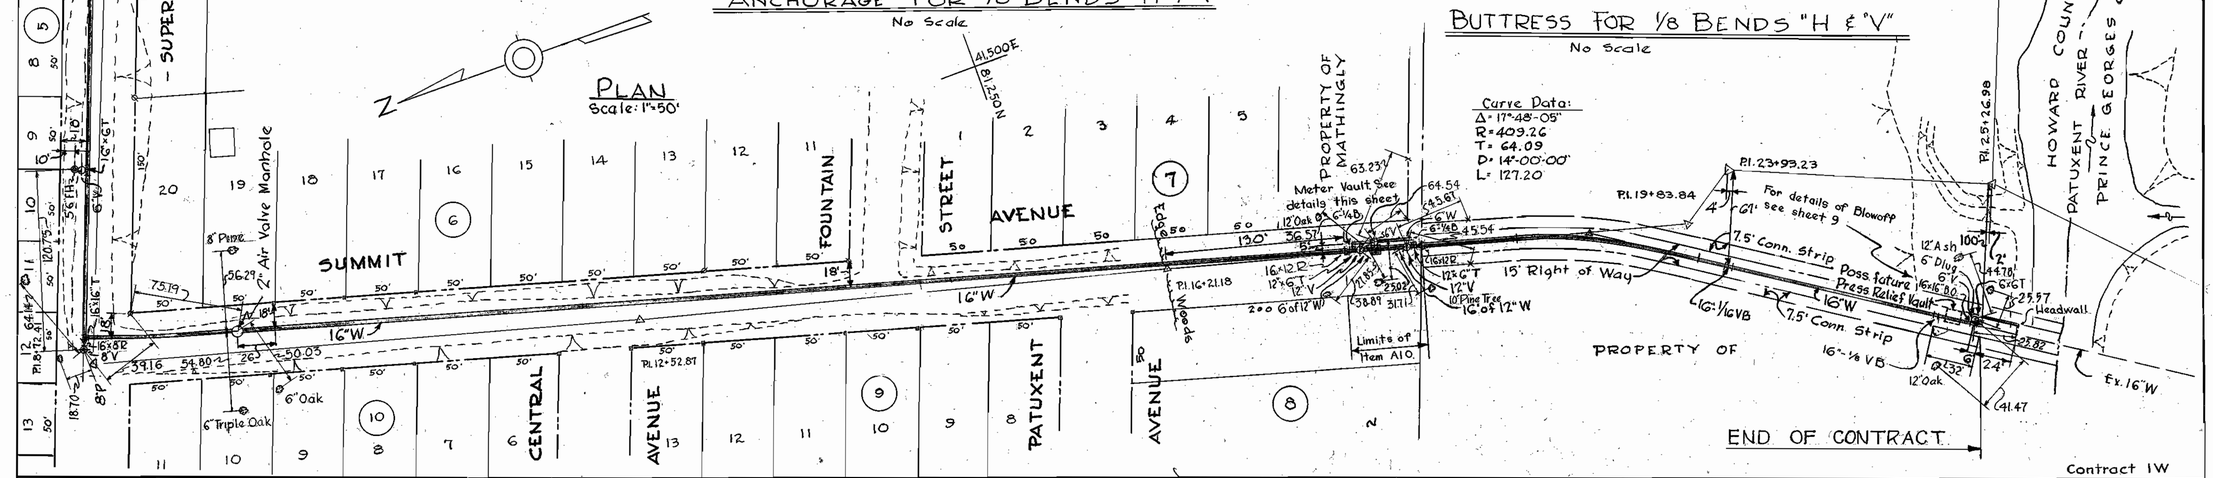

PLAN

Scale: 1"=50'

Contract 1W

WHITMAN, REQUARDT & ASSOCIATES ENGINEERS 1304 ST. PAUL ST. BALTIMORE, MARYLAND	HOWARD COUNTY METROPOLITAN COMMISSION PATUXENT SUB-DISTRICT MARYLAND	APPROVED BY HOWARD COUNTY MET. COMMISSION. March 28, 1955 DATE. COMMISSIONERS	APPROVED BY WASHINGTON SUBURBAN SANITARY COMMISSION MARCH 10, 1955 DATE. CHIEF ENGINEER	PLAN OF WATER MAIN EXTENSIONS	DRAWING NO. 16 OF 25	SCALE AS SHOWN

55223Y
Y
41N13-E4
41N15-1

AS BUILT

WS 1/16

IMPERIAL TRACING CLOTH—D. K. ELLIOTT CO., PGH., PA.

WASHINGTON - BALTIMORE BLVD. (Northbound)

Plan Sheet No.2 | Plan Sheet No. 3 | Plan Sheet No. 4

Edge of paving

℄ N. Laurel Rd.

8"W

18"G.I.P.

30"R.C.C.P.

8"S

15"R.C.C.P.

20"G.I.P.

30"G.I.P.

Match Line "1-1" See this sheet

WASHINGTON - BALTIMORE BLVD. (Northbound)

Plan Sheet No. 4

Edge of paving

Match Line "1-1" See this sheet

Plan Sheet No.2 | Plan Sheet No. 3

℄ Wash.-Balto. Blvd (Northbound)

Property of Maryland State Fair Inc.

℄ Wash.-Balto. Blvd (Southbound) = 0+00 ℄ Cissel Ave.

Cissel Ave. Proposed

Ground over Water

Proposed Grade of Cissel Ave. by W.R. & A.

200%

8"W

0+50 100' V.C. P.I.El. 146.35 P.O.C. 146.60

℄ N. Laurel Rd

℄ Wash.-Balto. Blvd

Plan Sheet No.3

N. LAUREL ROAD

℄ Wash.-Balto. Blvd (North bound)

0+50 50' V.C. P.I.El. 159.20 P.O.C. 159.02

0+50 50' V.C. P.I.El. 159.20 P.O.C. 159.23

Proposed Grade by W.R. & A.

℄ Paving 0.50%

Ground over Water

3.00%

2"W

6"W

8"W

18"R.C.C.P.

Plan Sheet No.2

℄ Cissel Ave. (Proposed)

Ground over Water

6"W

Contract 1W

WHITMAN, REQUARDT & ASSOCIATES ENGINEERS 1304 ST. PAUL ST. BALTIMORE, MARYLAND	HOWARD COUNTY METROPOLITAN COMMISSION PATUXENT SUB-DISTRICT MARYLAND	APPROVED BY HOWARD COUNTY METROPOLITAN COMMISSION March 28, 1955 DATE — COMMISSIONERS	APPROVED BY WASHINGTON SUBURBAN SANITARY COMMISSION MARCH 19, 1955 DATE — CHIEF ENGINEER	PROFILES OF WATER MAIN EXTENSIONS	DRAWING NO. 17 OF 25	SCALE H-1"=100' V-1"=10'

55224 Y

AS BUILT

4205-2

11/1 SM

IMPERIAL TRACING CLOTH—B. K. ELLIOTT CO., PGH., PA.

Plan Sheet No. 3

Plan Sheet No. 4

WASHINGTON - BALTIMORE BLVD.
(Southbound & Northbound)

℄ Madison Ave.

Edge of paving (South bound)

8"W

Edge of paving (South bound)

Northbound

Southbound

8"W

Edge of paving (North & South)

Match Line "2-2" See this sheet

0+25 F.H.T. 0+50 172.9 1+00 172.7 1+50 172.5 2+00 172.3 2+50 171.9 3+00 171.3 3+50 170.7 4+00 170.2 4+50 169.2 5+00 167.9 5+50 166.5 6+00 165.0 6+50 163.7 7+00 162.7 7+50 161.9 8+00 161.3 8+18 161.3 ℄24"C.I.P. 8+42 F.H.T. 9+00 162.0 9+50 163.2 10+00 164.7 10+50 166.5 11+00 168.4 11+50 170.9 12+00 173.1 F.H.T. 12+50 174.9 13+00 176.1 13+50 177.3 14+00 178.2 14+50 178.8 15+00 179.3 15+30 179.6 15+39 8"V 15+46 F.H.T. 16+00 180.3 16+50 180.7 17+00 181.4 17+43 181.0 ℄20"CMP. ℄30" Conc. Pipe 18+00 184.1 18+50 186.2 19+00 188.5 19+50 191.1 F.H.T. 20+00 193.6 20+50 196.4 21+00 199.2 21+50 202.0 22+00 204.8 22+50 207.5 23+00 210.3 23+50 212.9 24+00 215.0 24+50 216.6 25+00 218.2 25+50 219.4 25+13 F.H.T. 26+00 220.2 26+50 221.5 27+00 223.2 27+17 8"V 27+44 F.H.T. 27+50 225.3 28+00 226.9 28+00 227.6 F.H.T. 33+00 209.2 33+50 211.7 34+00 214.0 34+50 215.9 35+00 217.5 35+50 218.8 36+00 219.9 36+50 220.8 37+00 222.4 37+50 224.3

240 230 220 210 200 190 180 170 160 150

Plan Sheet No. 5

Match Line "2-2" See this sheet

Plan Sheet No. 4

WASHINGTON - BALTIMORE BLVD.
(Southbound & Northbound)

P.I. El. 251.7

Edge of paving (North & South)

4.4%

4.4%

℄ Patuxent Dr. (Left) (Southbound)

℄ Patuxent Dr. (Right) (Northbound)

18" R.C.P.

8"W

Northbound

Southbound

Edge of paving (North bound)

PART "A" PART "B"

Ground over Water

Match Line "3-3" See sheet No. 19

38+50 226.9 39+00 230.9 39+50 232.8 40+00 235.0 40+50 237.3 41+00 239.4 41+50 241.1 42+00 242.2 42+50 243.0 42+78 F.H.T. 43+00 243.0 43+50 242.6 44+00 241.5 44+50 240.0 45+00 238. 45+50 236.0 46+00 233.9 46+50 231.4 47+00 8"V 47+06 12"x8"R 226.1 47+13 47+51 8"V 47+84 F.H.T. 48+00 229.2 48+50 230.1 49+00 230.3 49+50 230.4 50+00 230.3 50+50 230.1 51+00 229.5 51+50 228.4 52+00 227.0 52+50 225.5 53+00 223.9 53+15 F.H.T. 53+50 221.4 54+00 219.2 54+50 217.0 55+00 214.9 55+50 212.8 56+00 210.7 56+50 209.1 57+00 207.2 57+50 205.0 58+00 202.9 58+04 F.H.T. 59+00 198.8 59+50 196.8 60+00 194.8 60+50 192.7 61+00 190.5 61+50 188.2 62+00 186.1 62+50 184.0 63+00 182.1 63+11 F.H.T. 63+50 180.4 64+00 178.8 64+50 177.8 65+00 176.9 65+50 176.6 65+60 8'-8"W/H 176.5 66+20 8'-8"W/H 166.0

250 240 230 220 210 200 190 180 170 160

Contract 1W

WHITMAN, REQUARDT & ASSOCIATES ENGINEERS 1304 ST. PAUL ST. BALTIMORE, MARYLAND	HOWARD COUNTY METROPOLITAN COMMISSION PATUXENT SUB-DISTRICT MARYLAND	APPROVED BY HOWARD COUNTY METROPOLITAN COMMISSION March 28, 1955 DATE Greg C. Moser Walter A. Haynes COMMISSIONERS	APPROVED BY WASHINGTON SUBURBAN SANITARY COMMISSION MARCH 19, 1955 DATE Harry B. Shaw CHIEF ENGINEER	PROFILES OF WATER MAIN EXTENSIONS	DRAWING NO. 18 OF 25 SCALE H-1"=100' V-1"=10'	5522.5Y Y

4205-2

AS BUILT

WS 1/18

IMPERIAL TRACING CLOTH—B. K. ELLIOTT CO., PGH., PA.

Plan Sheet No. 5

Plan Sheet No. 6

WASHINGTON - BALTIMORE BLVD. (North Bound)

Match Line "3-3" See sheet No. 18

Ground over Water

Bottom of bank 10' East

67+26 8"W/8"V/H.

67+00 8"W/8"V/H 166.0

67+26 Ah.

67+48 Bk=

8"W

Edge of paving

72+86 F.H.T.

Ground over water

79+78 12"W/8"V/H 148.1

79+75 Bk=

79+76 Ah.

12"W

83+16 F.H.T.

Entrance to Laurel Race Track

Edge of paving

12"W

85+28 F.H.T.

93+73 F.H.T.

Match Line "4-4" See this sheet

Plan Sheet No. 6

WASHINGTON - BALTIMORE BLVD.

Edge of paving

12"W

Match Line "4-4" See this sheet

2" Air Valve MH 96+00 - 183.5

Plan Sheet No. 6

WASH-BALTO. BLVD. (North.)

℄ Drive

Edge of Paving

Ground over Water

12"W

99+04 Bk = 0+00 Ah.

SERVICE TO RACE TRACK

6" H.P.G.

℄ Conduit & Paving

6" H.P.G.

2 Meter Vault By Others

6"W

Plan. Sheet No. 7

PATUXENT DRIVE

9+52 400' V.C. P.I.El. 270.90 P.O.C. 266.92

Proposed Grade by W.R. & A.

1.85%

℄ Grade

18"x10" Arc

14+58 ΔH

14+58 Bk=

14+56 Ah.

16+26 400' V.C. P.I.El. 259.43 P.O.C. 262.31

20+05 200' V.C. P.I.El. 280.79 P.O.C. 279.73

1.65%

27+82 200' V.C. P.I.El. 293.61 P.O.C. 293.05

Match Line "5-5" See this sheet

℄ Washington - Baltimore Blvd.

0+50 100' V.C. P.I.El. 234.20 P.O.C. 234.45

1.0%

2+85 200' V.C. P.I.El. 236.55 P.O.C. 237.22

4.1%

Ground over water

6.1%

6+08 100' V.C. P.I.El. 249.90 P.O.C. 250.15

12"W

8"W

PATUXENT DRIVE

Plan Sheet No. 7

Match Line "5-5" See this sheet

Proposed Grade by W.R. & A.

0.60%

Ground over water

34+82 400' V.C. P.I.El. 289.41 P.O.C. 291.61

34+09 Bk = 34+24 Ah.

℄ Grade

3.80%

40+20 400' V.C. P.I.El. 309.85 P.O.C. 306.20

3.50%

Plan Sheet No. 8

℄ All Saints Road = 44+42 ℄ Patuxent Drive

2" Air Valve MH 40+50 - 301.2

12"W

16"W

[2] 12" Main & 6" Service added 5-15-56

ADDITIONS APPROVED: MAY 23, 1956 DATE
Harry B. Shaw CHIEF ENGINEER

WATER TO SERVE LAUREL RACEWAY

Contract 1W

WHITMAN, REQUARDT & ASSOCIATES ENGINEERS 1304 ST. PAUL ST. BALTIMORE, MARYLAND	HOWARD COUNTY METROPOLITAN COMMISSION PATUXENT SUB-DISTRICT MARYLAND	APPROVED BY HOWARD COUNTY METROPOLITAN COMMISSION March 28, 1955 DATE — COMMISSIONERS	APPROVED BY WASHINGTON SUBURBAN SANITARY COMMISSION MARCH 19, 1955 DATE — Harry B. Shaw CHIEF ENGINEER	PROFILES OF WATER MAIN EXTENSIONS	DRAWING NO. 19 OF 25	SCALE H-1"=100' V-1"=10'	55226 Y

4205-2

AS BUILT

WS 1/19

IMPERIAL TRAGING CLOTH—S. K. ELLIOTT CO., PGH., PA.

CISSEL AVENUE — Plan Sheet No. 14 — NORTH LAUREL ROAD

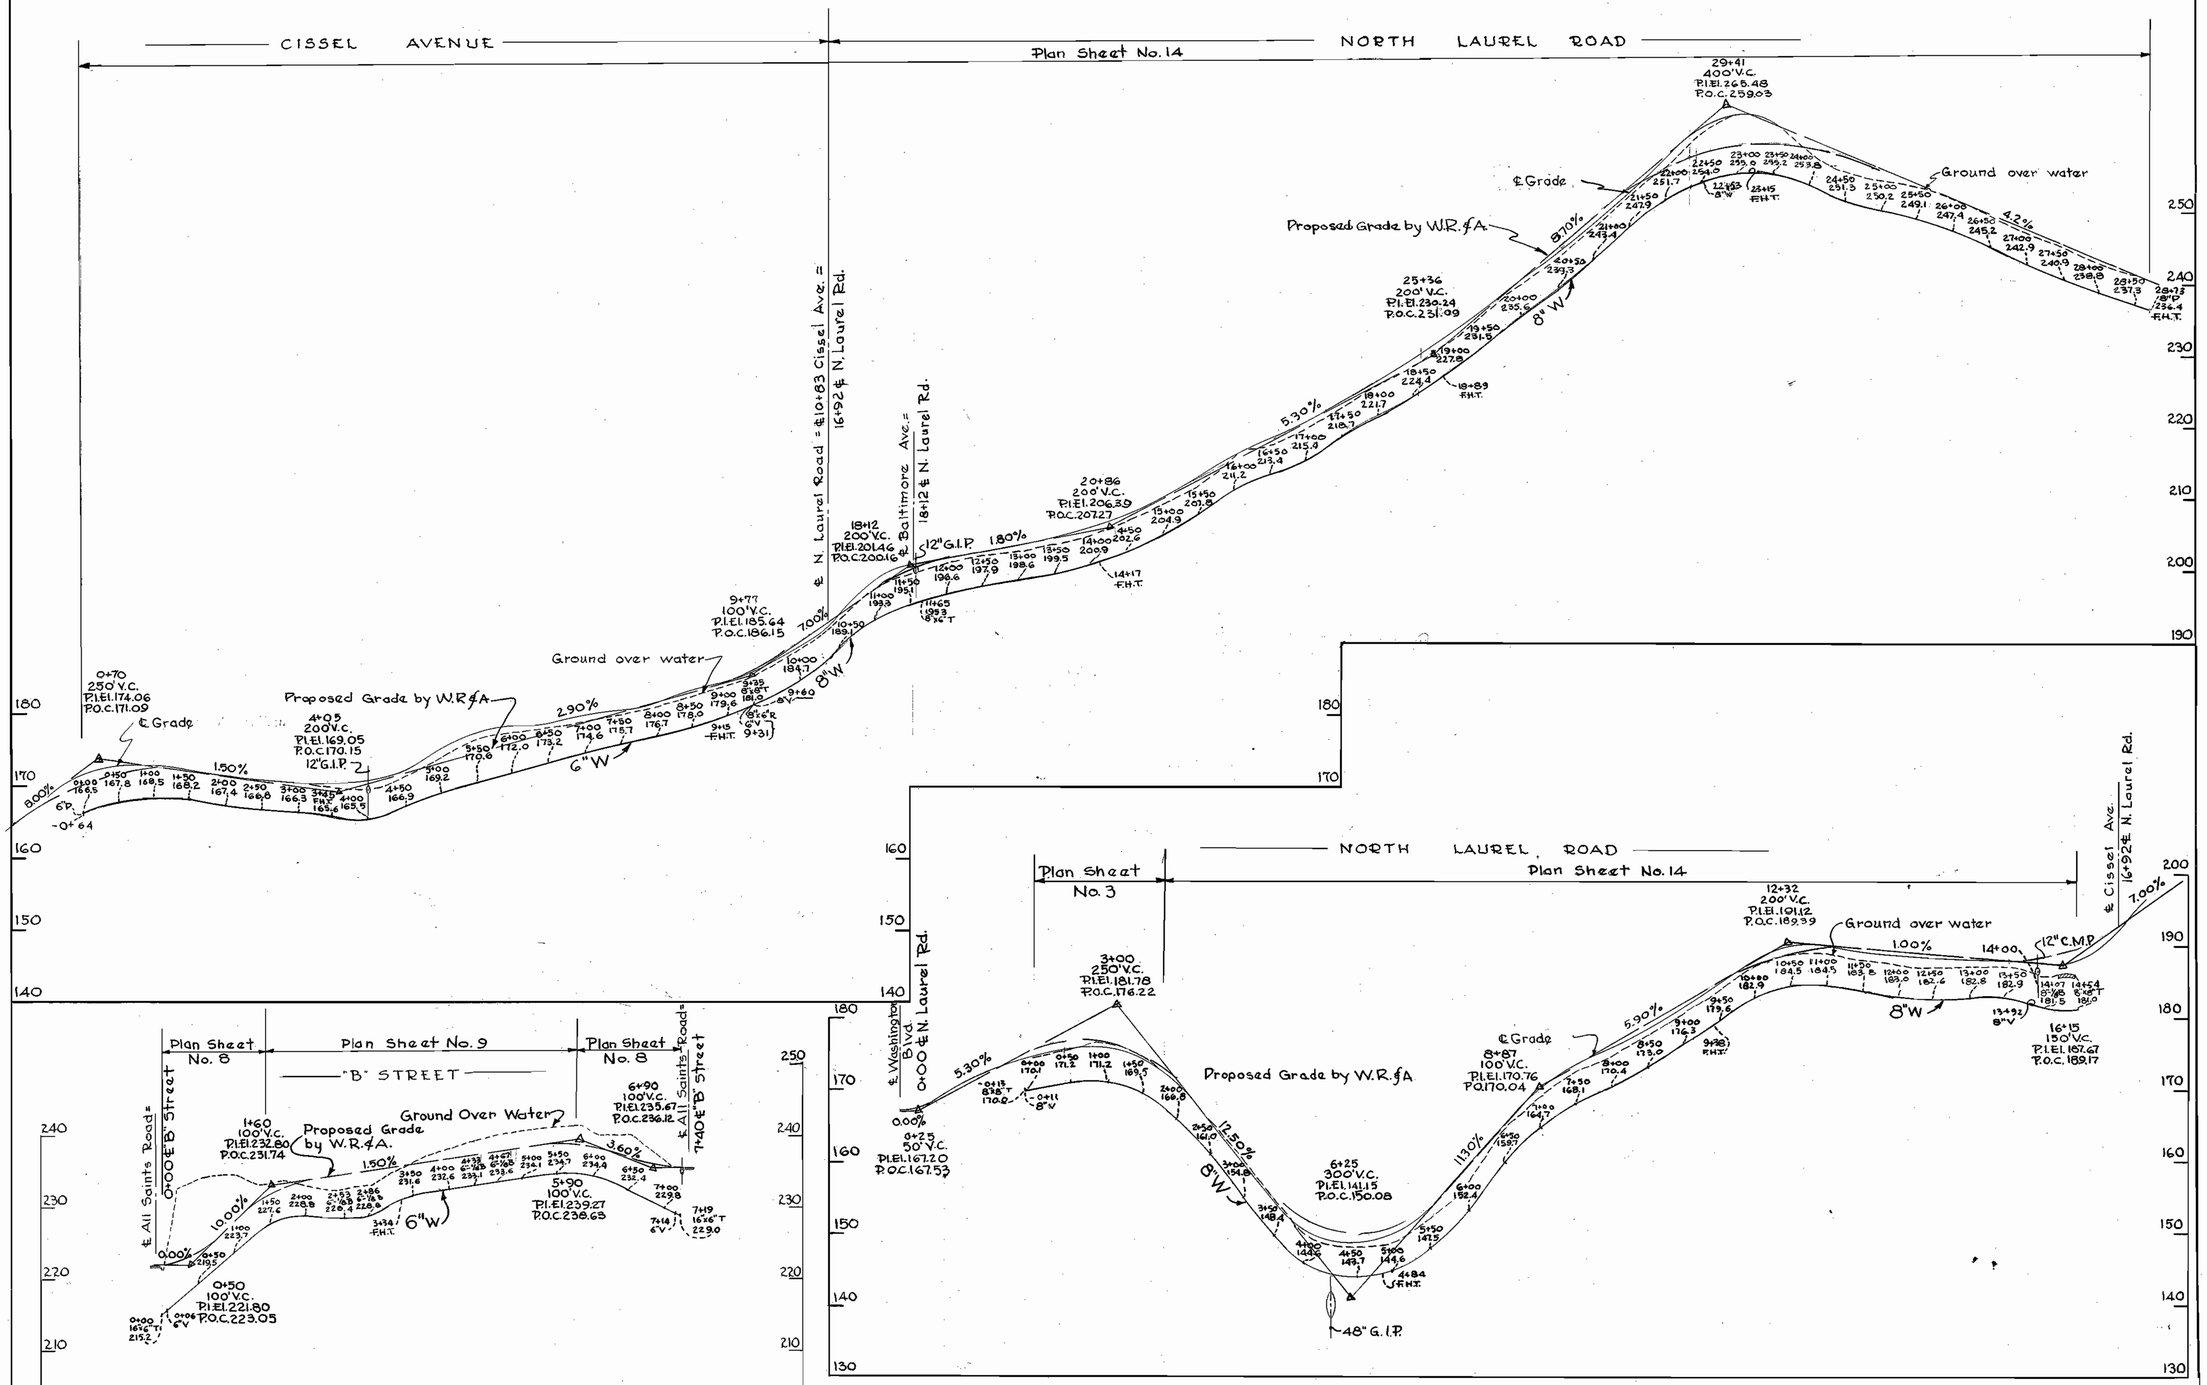

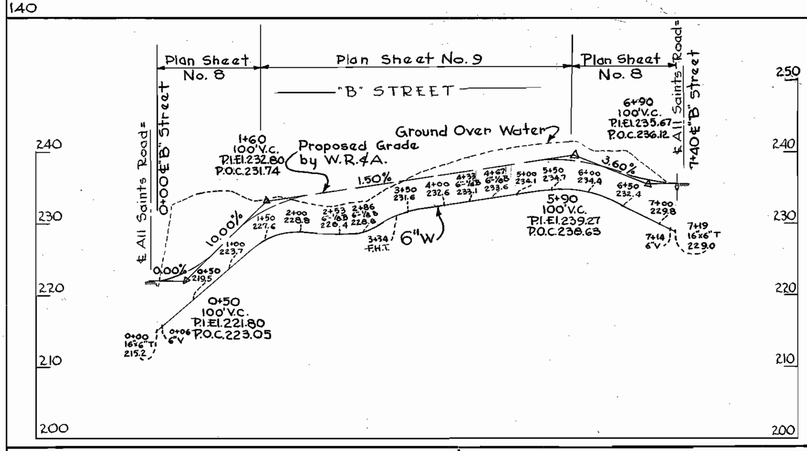

Contract IW

WHITMAN, REQUARDT & ASSOCIATES ENGINEERS 1304 ST. PAUL ST. BALTIMORE, MARYLAND	HOWARD COUNTY METROPOLITAN COMMISSION PATUXENT SUB - DISTRICT MARYLAND	APPROVED BY HOWARD COUNTY METROPOLITAN COMMISSION March 28, 1955 DATE COMMISSIONER'S	APPROVED BY WASHINGTON SUBURBAN SANITARY COMMISSION MARCH 19, 1955 DATE CHIEF ENGINEER	PROFILES OF WATER MAIN EXTENSIONS	DRAWING NO. 20 OF 25	SCALE H-1"=100' V-1"=10'

55227 Y

AS BUILT

WS 1/20

IMPERIAL TRACING CLOTH—B. K. ELLIOTT CO., PGH., PA.

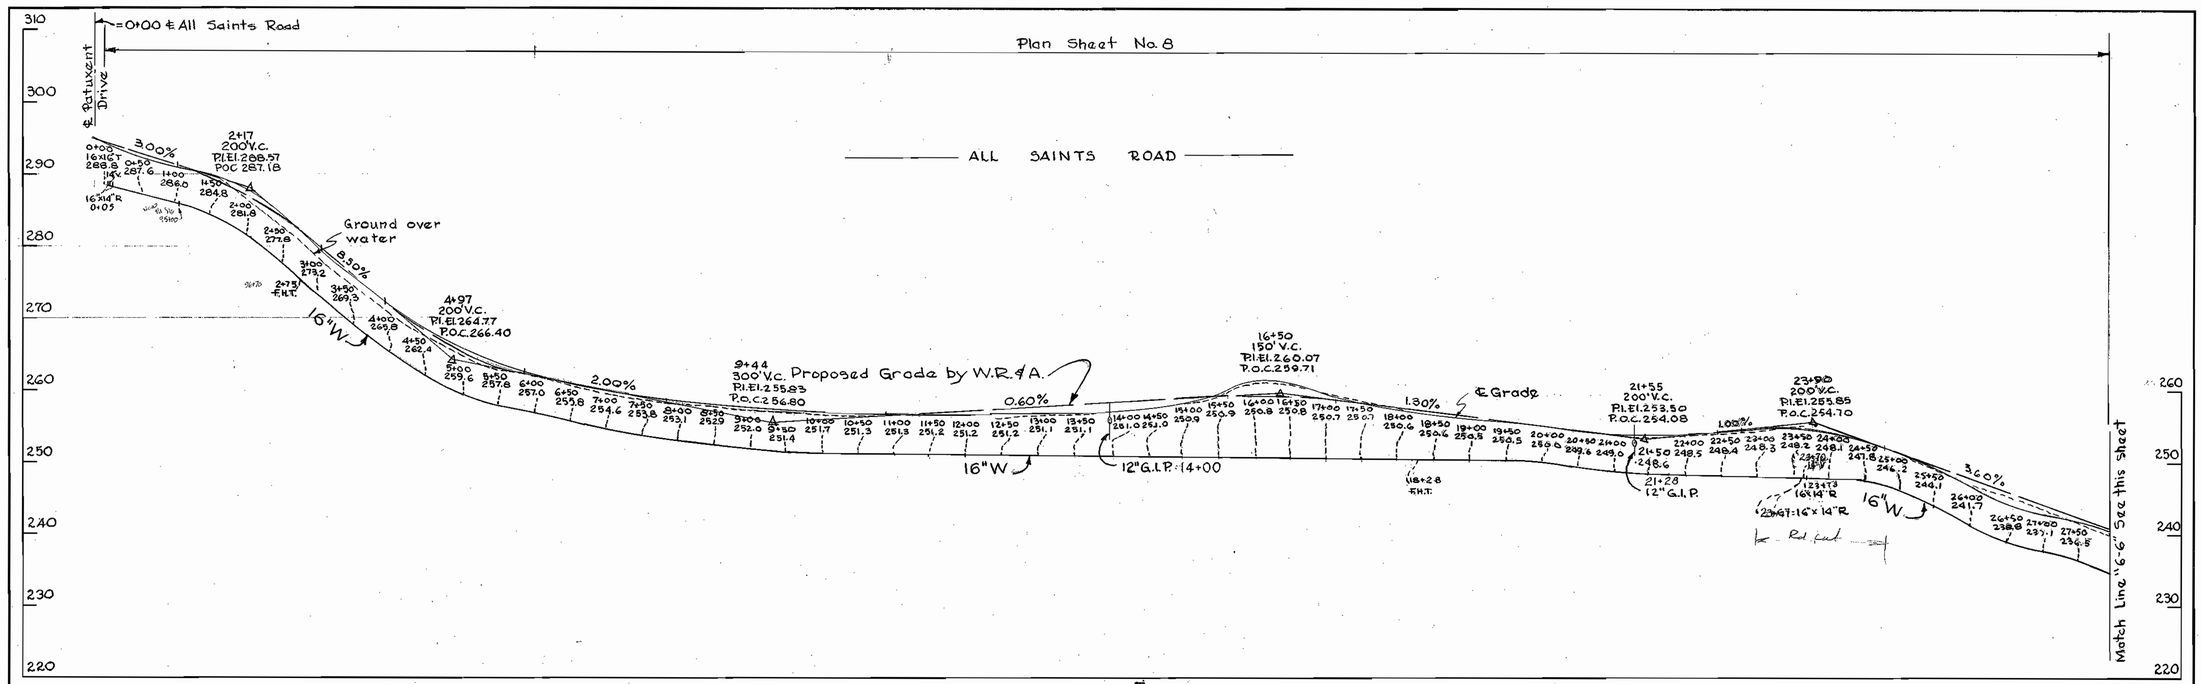

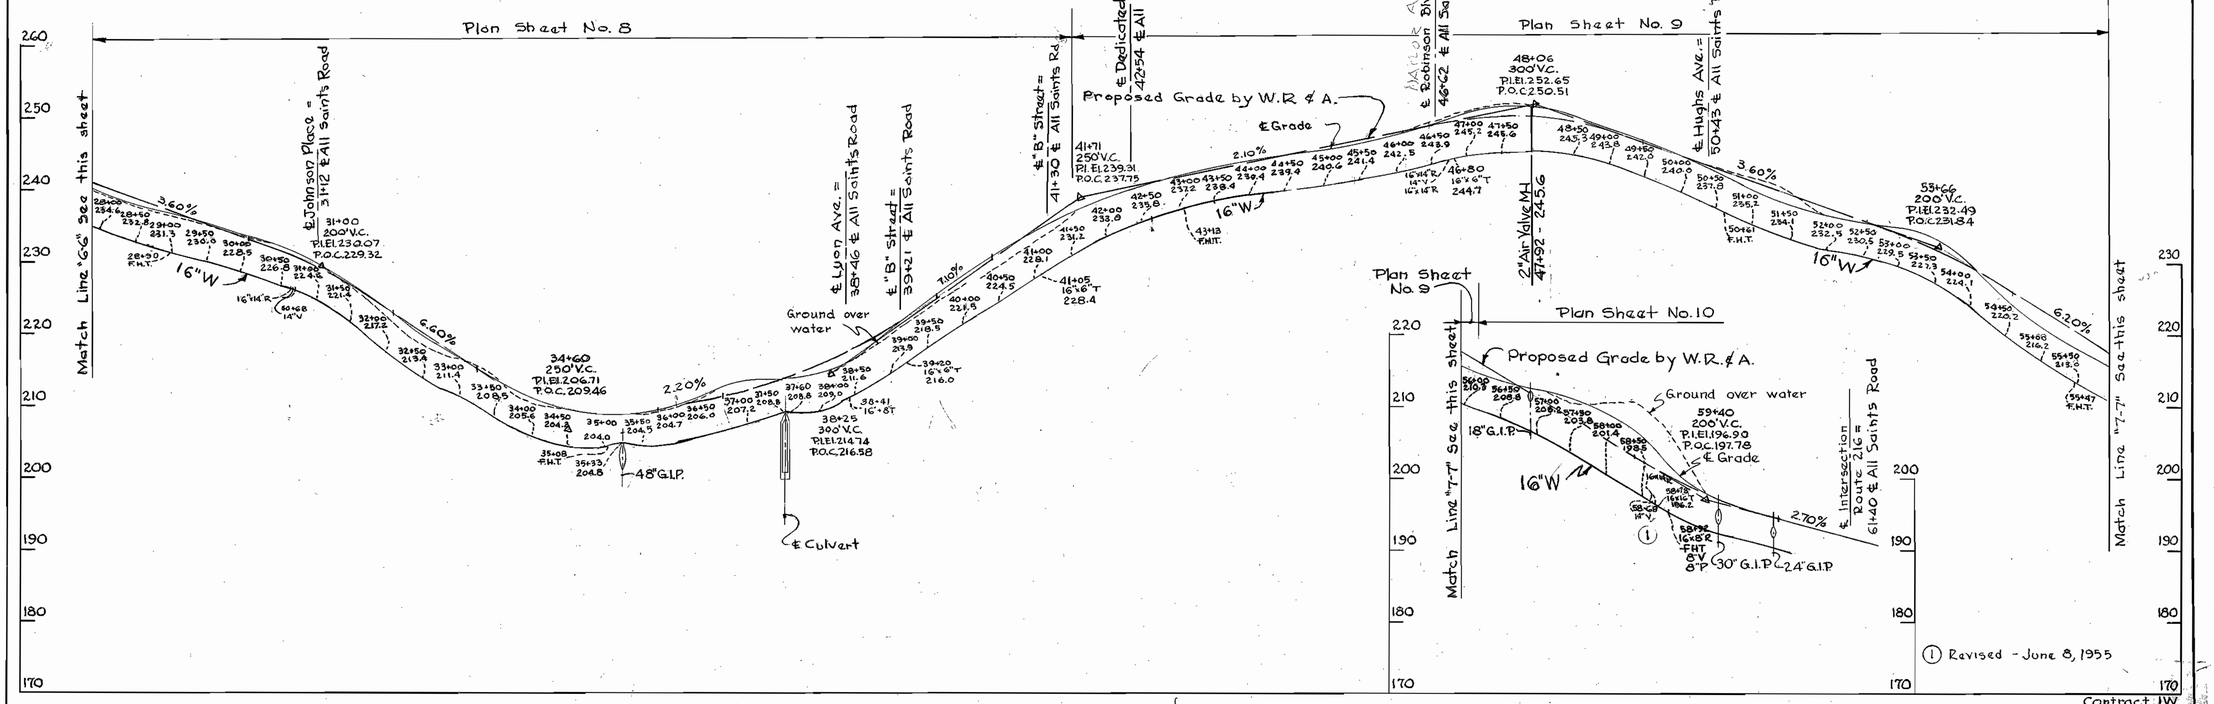

① Revised - June 8, 1955

WHITMAN, REQUARDT & ASSOCIATES ENGINEERS 1304 ST. PAUL ST. BALTIMORE, MARYLAND	HOWARD COUNTY METROPOLITAN COMMISSION PATUXENT SUB-DISTRICT MARYLAND	APPROVED BY HOWARD COUNTY METROPOLITAN COMMISSION March 28, 1955 DATE COMMISSIONER'S	APPROVED BY WASHINGTON SUBURBAN SANITARY COMMISSION MARCH 19, 1955 DATE CHIEF ENGINEER	PROFILES OF WATER MAIN EXTENSIONS	DRAWING NO. 21 OF 25 SCALE H-1"=100' V-1"=10' 55228 Y

Contract IW

AS BUILT

WS 1/21

IMPERIAL TRACING CLOTH—D. K. ELLIOTT CO., PGH., PA.

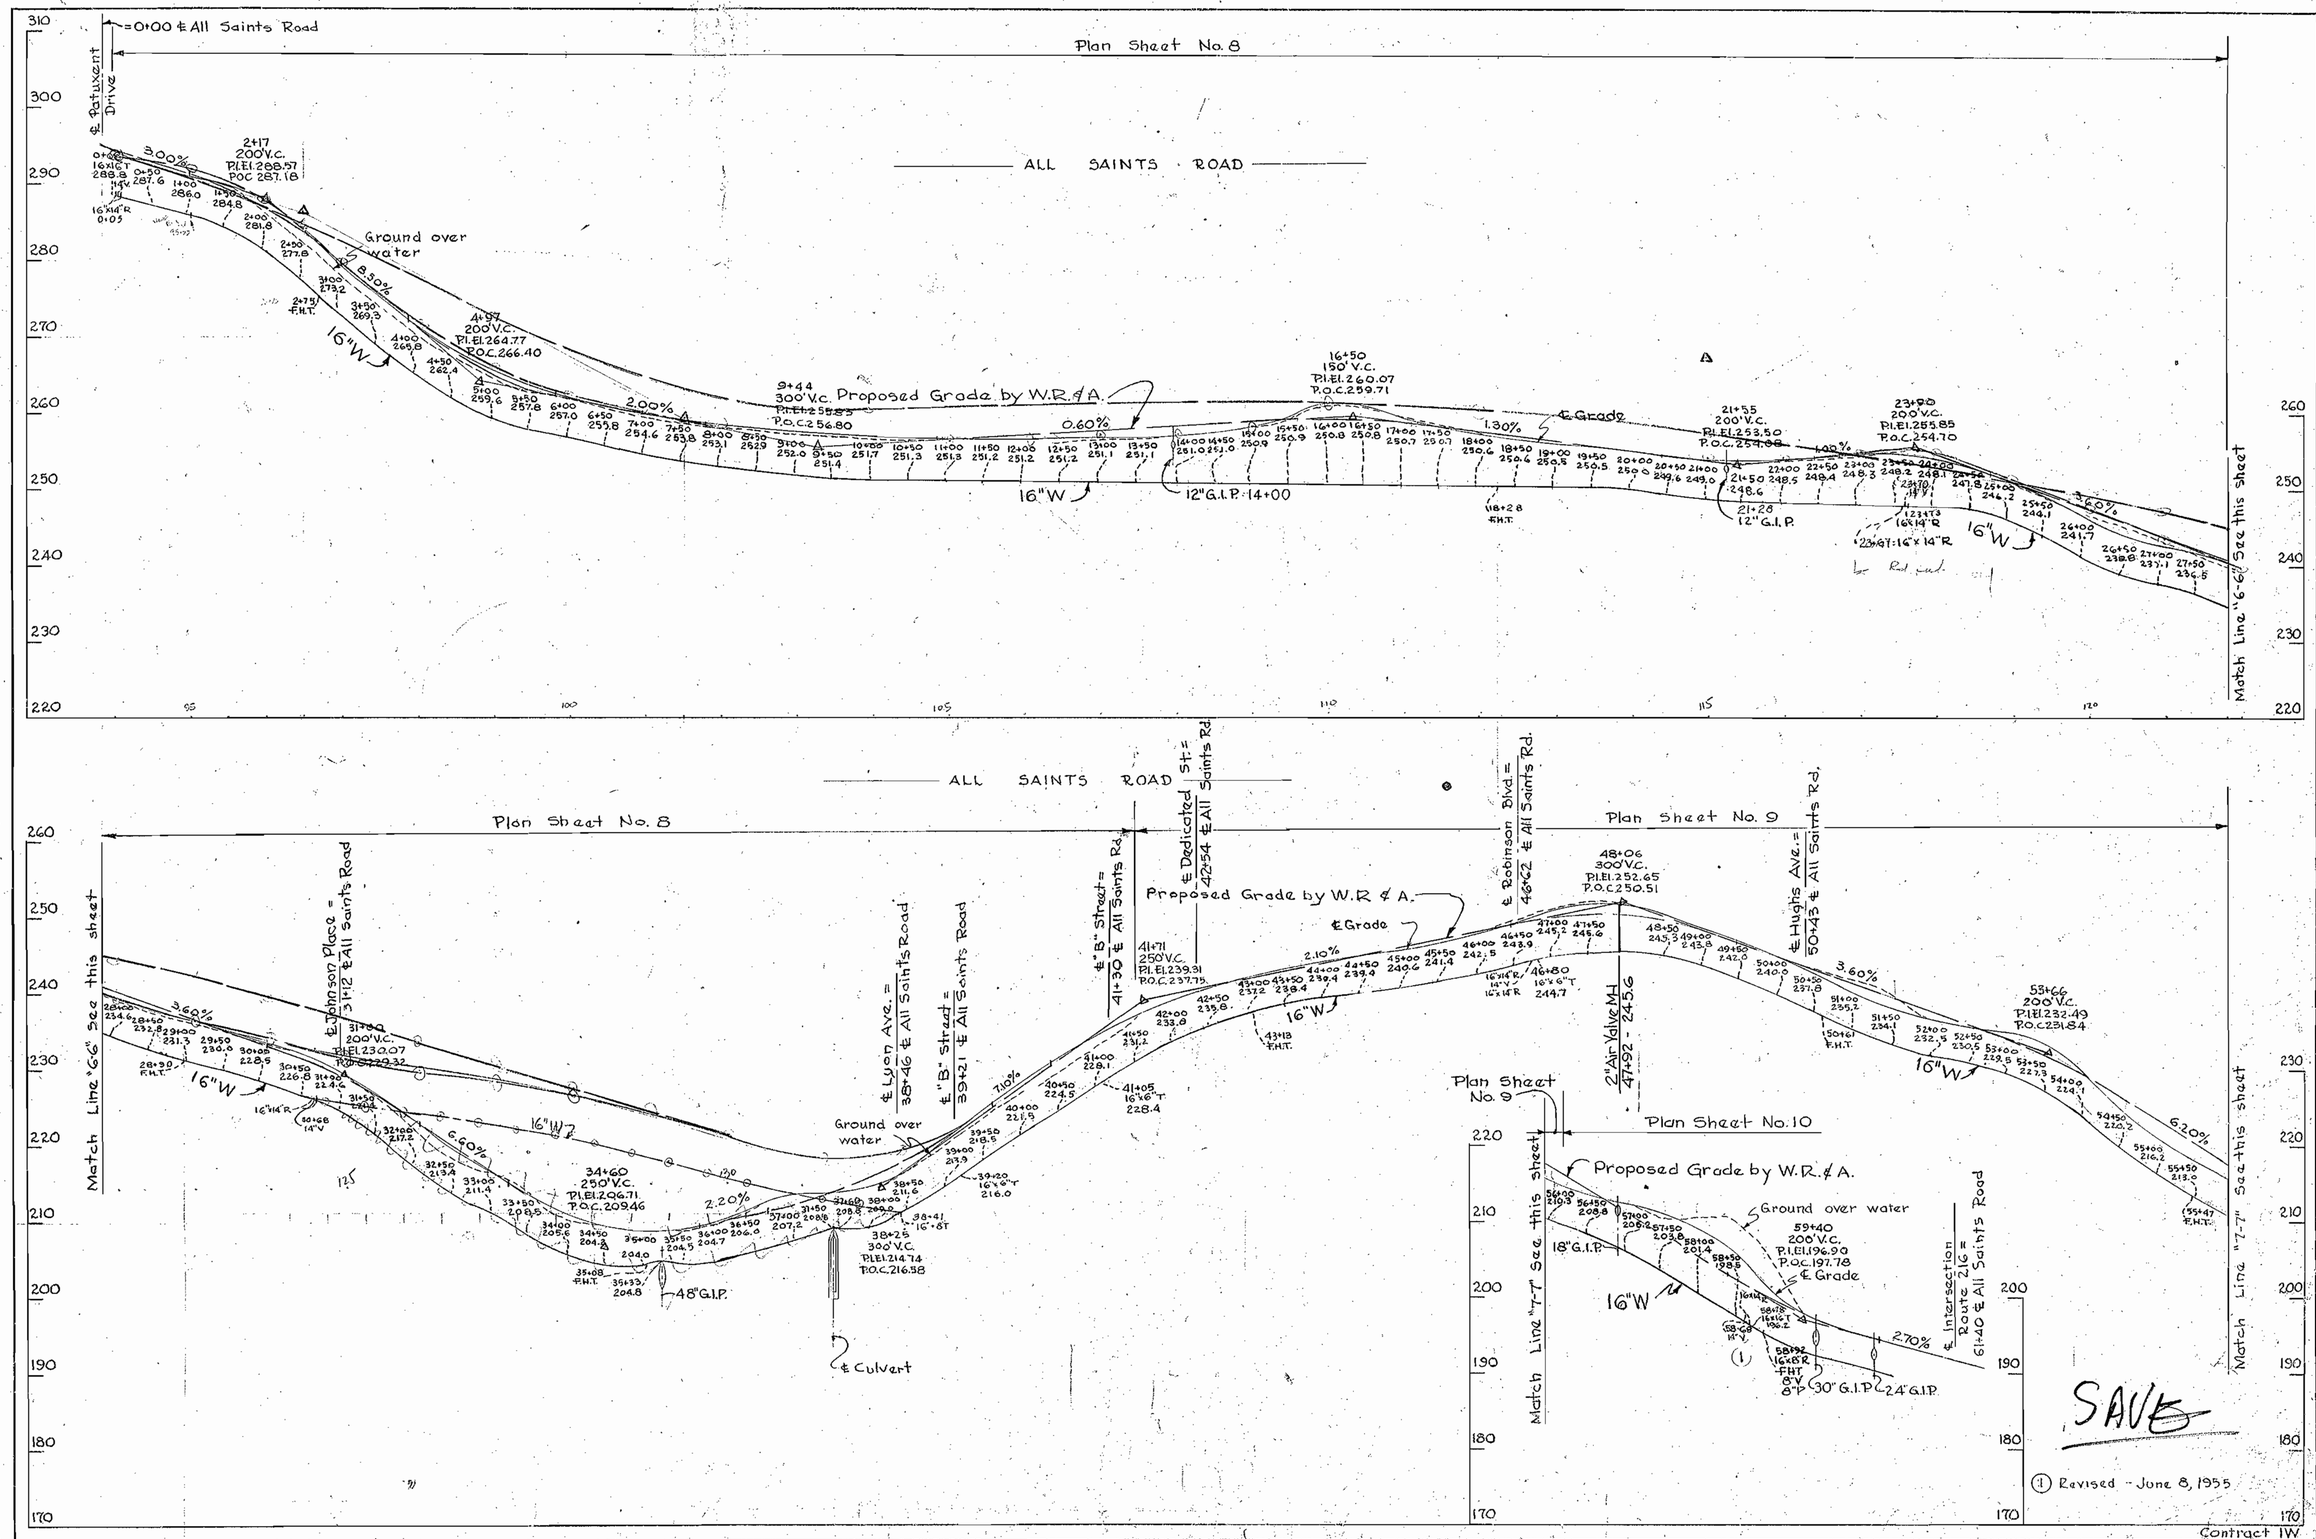

WHITMAN, REQUARDT & ASSOCIATES ENGINEERS 1304 ST. PAUL ST. BALTIMORE, MARYLAND	HOWARD COUNTY METROPOLITAN COMMISSION PATUXENT SUB-DISTRICT MARYLAND	APPROVED BY HOWARD COUNTY METROPOLITAN COMMISSION March 28, 1955 DATE — Chairman; Secretary; Member	APPROVED BY WASHINGTON SUBURBAN SANITARY COMMISSION MARCH 19, 1955 DATE — Harry P. Shaw CHIEF ENGINEER	PROFILES OF WATER MAIN EXTENSIONS	DRAWING NO. 21 OF 25	SCALE H-1"=100' V-1"=10'

552.28 Y

WS 1/21A

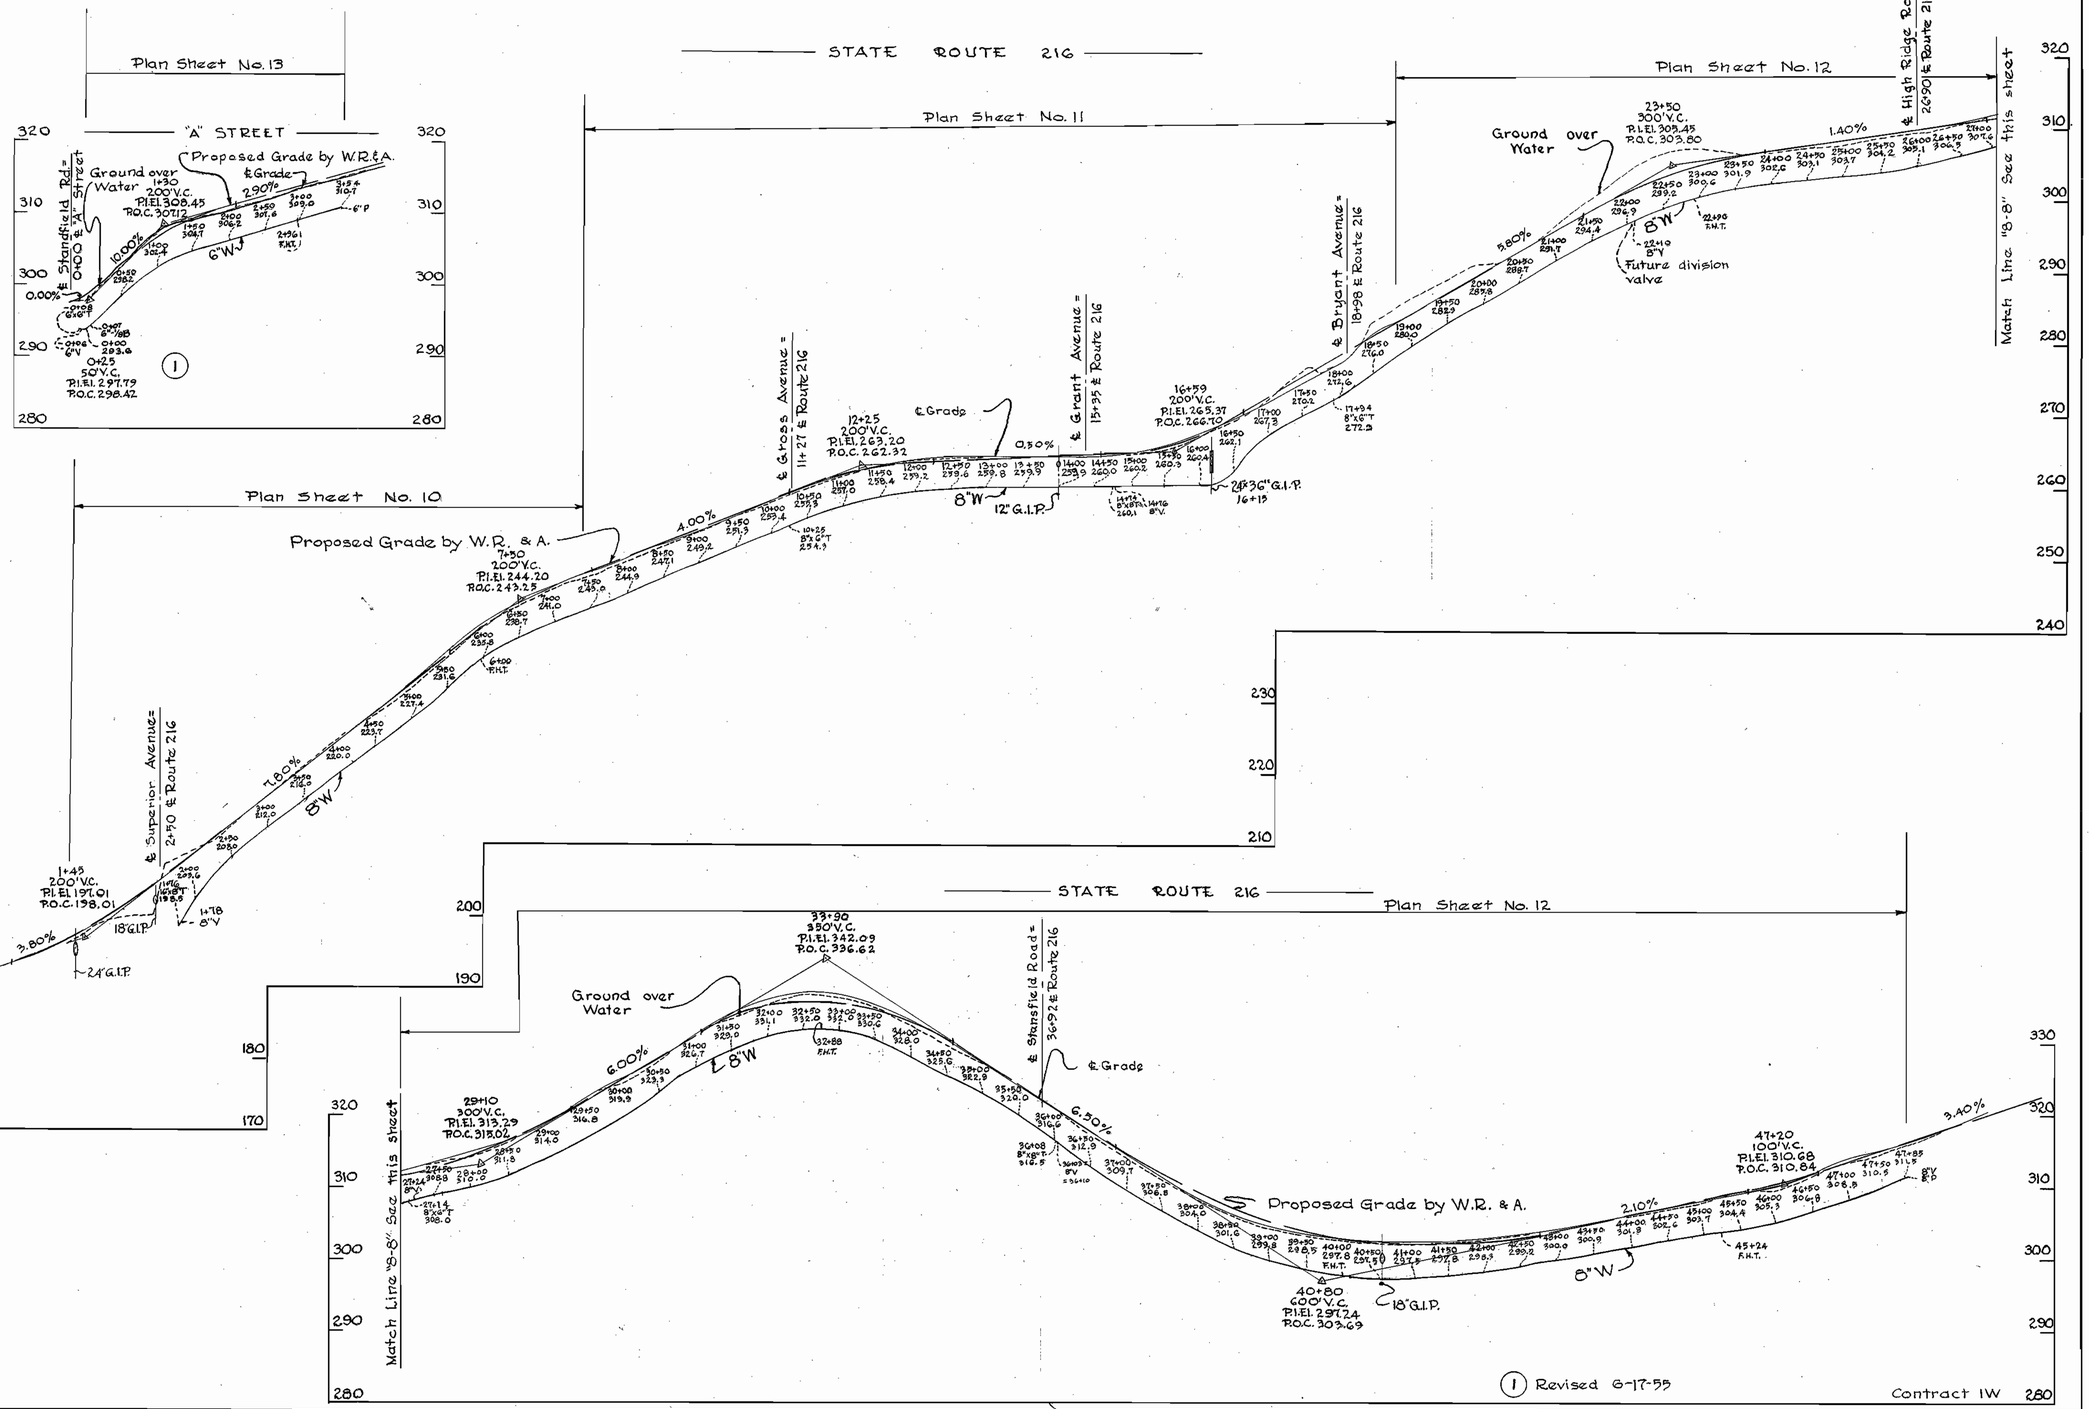

(1) Revised 6-17-55

WHITMAN, REQUARDT & ASSOCIATES ENGINEERS 1304 ST. PAUL ST. BALTIMORE, MARYLAND	HOWARD COUNTY METROPOLITAN COMMISSION PATUXENT SUB - DISTRICT MARYLAND	APPROVED BY HOWARD COUNTY METROPOLITAN COMMISSION March 28, 1955 DATE COMMISSIONERS	APPROVED BY WASHINGTON SUBURBAN SANITARY COMMISSION MARCH 12, 1955 DATE CHIEF ENGINEER	PROFILES OF WATER MAIN EXTENSIONS	DRAWING NO. 22 OF 25	SCALE H-1"=100' V-1"=10'

55229 Y

4205-2

AS BUILT

WS 1/22

PERFAIL TRACING CLOTH—D. K. ELLIOTT CO., PGH., PA.

HIGH RIDGE ROAD

Plan Sheet No. 12 — Plan Sheet No. 13

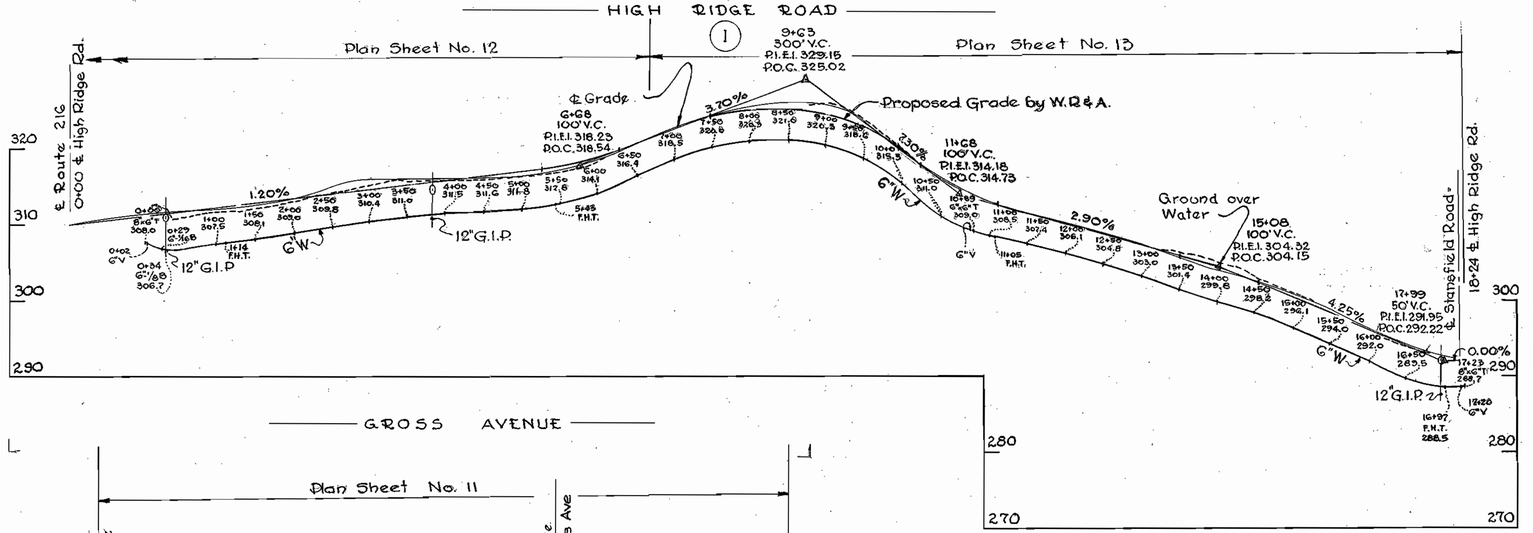

BRYANT AVENUE

Plan Sheet No. 11

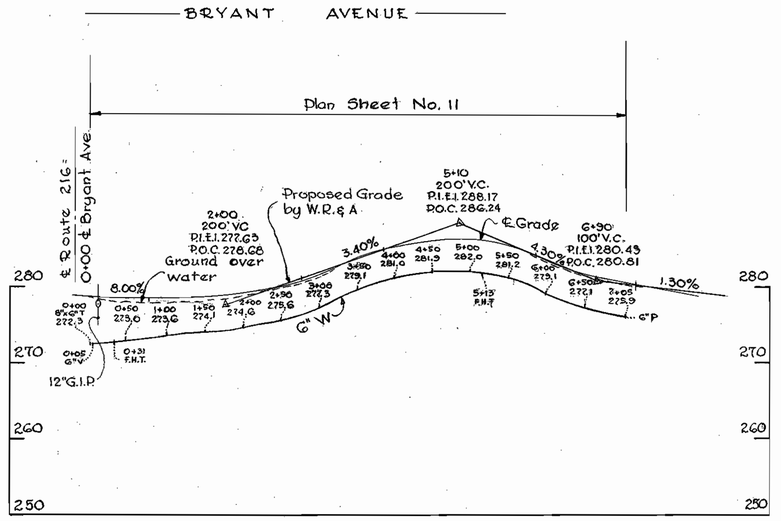

GROSS AVENUE

Plan Sheet No. 11

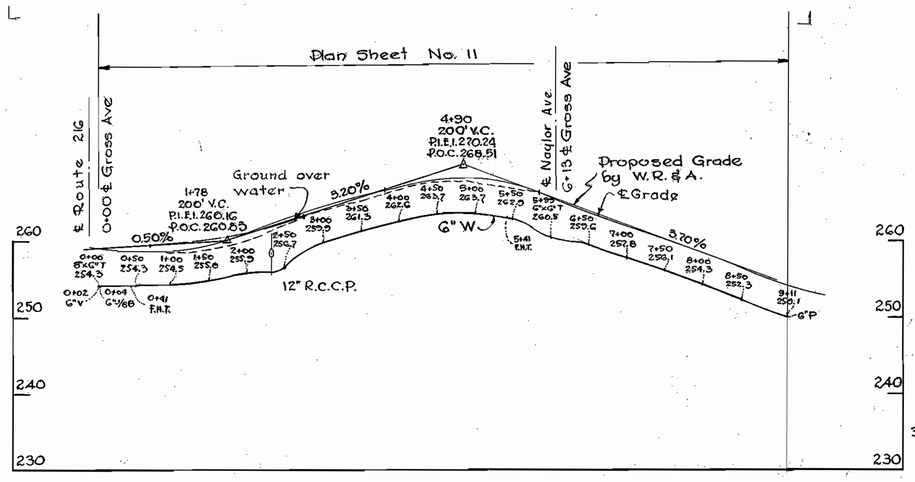

GRANT AVENUE

Plan Sheet No. 11

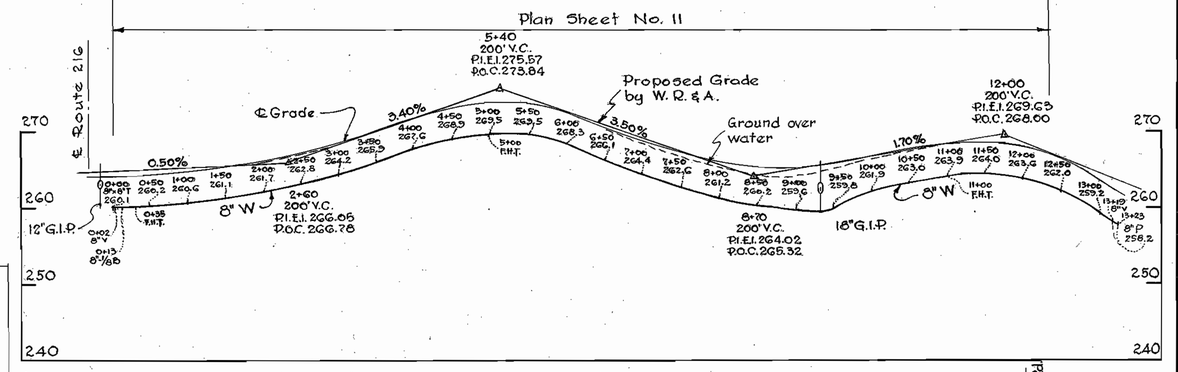

NAYLOR AVENUE

Plan Sheet No. 9 — Plan Sheet No. 11

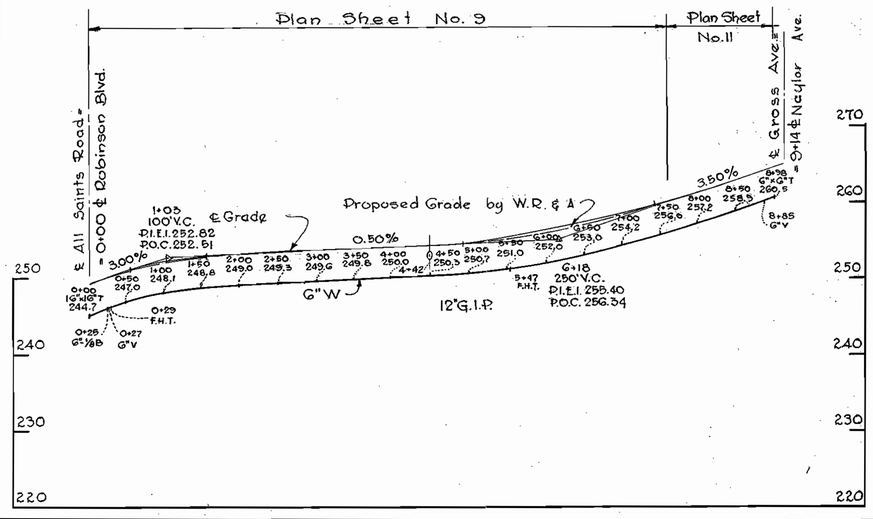

STANSFIELD ROAD

Plan Sheet No. 12 — Plan Sheet No. 13

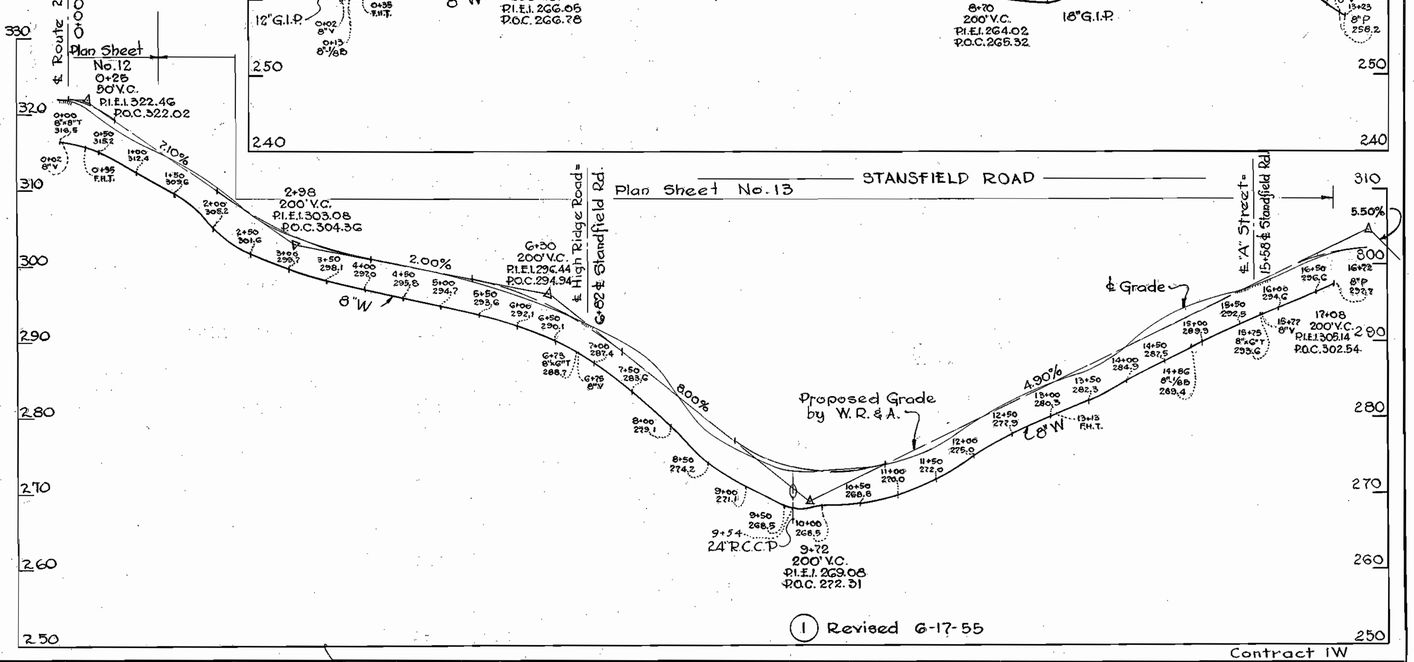

(1) Revised 6-17-55

Contract 1W

WHITMAN, REQUARDT & ASSOCIATES ENGINEERS 1304 ST. PAUL ST. BALTIMORE, MARYLAND	HOWARD COUNTY METROPOLITAN COMMISSION PATUXENT SUB - DISTRICT MARYLAND	APPROVED BY HOWARD COUNTY METROPOLITAN COMMISSION March 28 1955 DATE Roy C. Moore, Walter N. Kaynor COMMISSIONERS	APPROVED BY WASHINGTON SUBURBAN SANITARY COMMISSION MARCH 19 1955 DATE Harry L. Shaw CHIEF ENGINEER	PROFILES OF WATER MAIN EXTENSIONS	DRAWING NO. 23 OF 25	SCALE H-1"=100' V-1"=10'

55230 Y

4205-2

AS BUILT

WS 1/23

PERIAL TRACING CLOTH—B. K. ELLIOTT CO., PGH., PA.

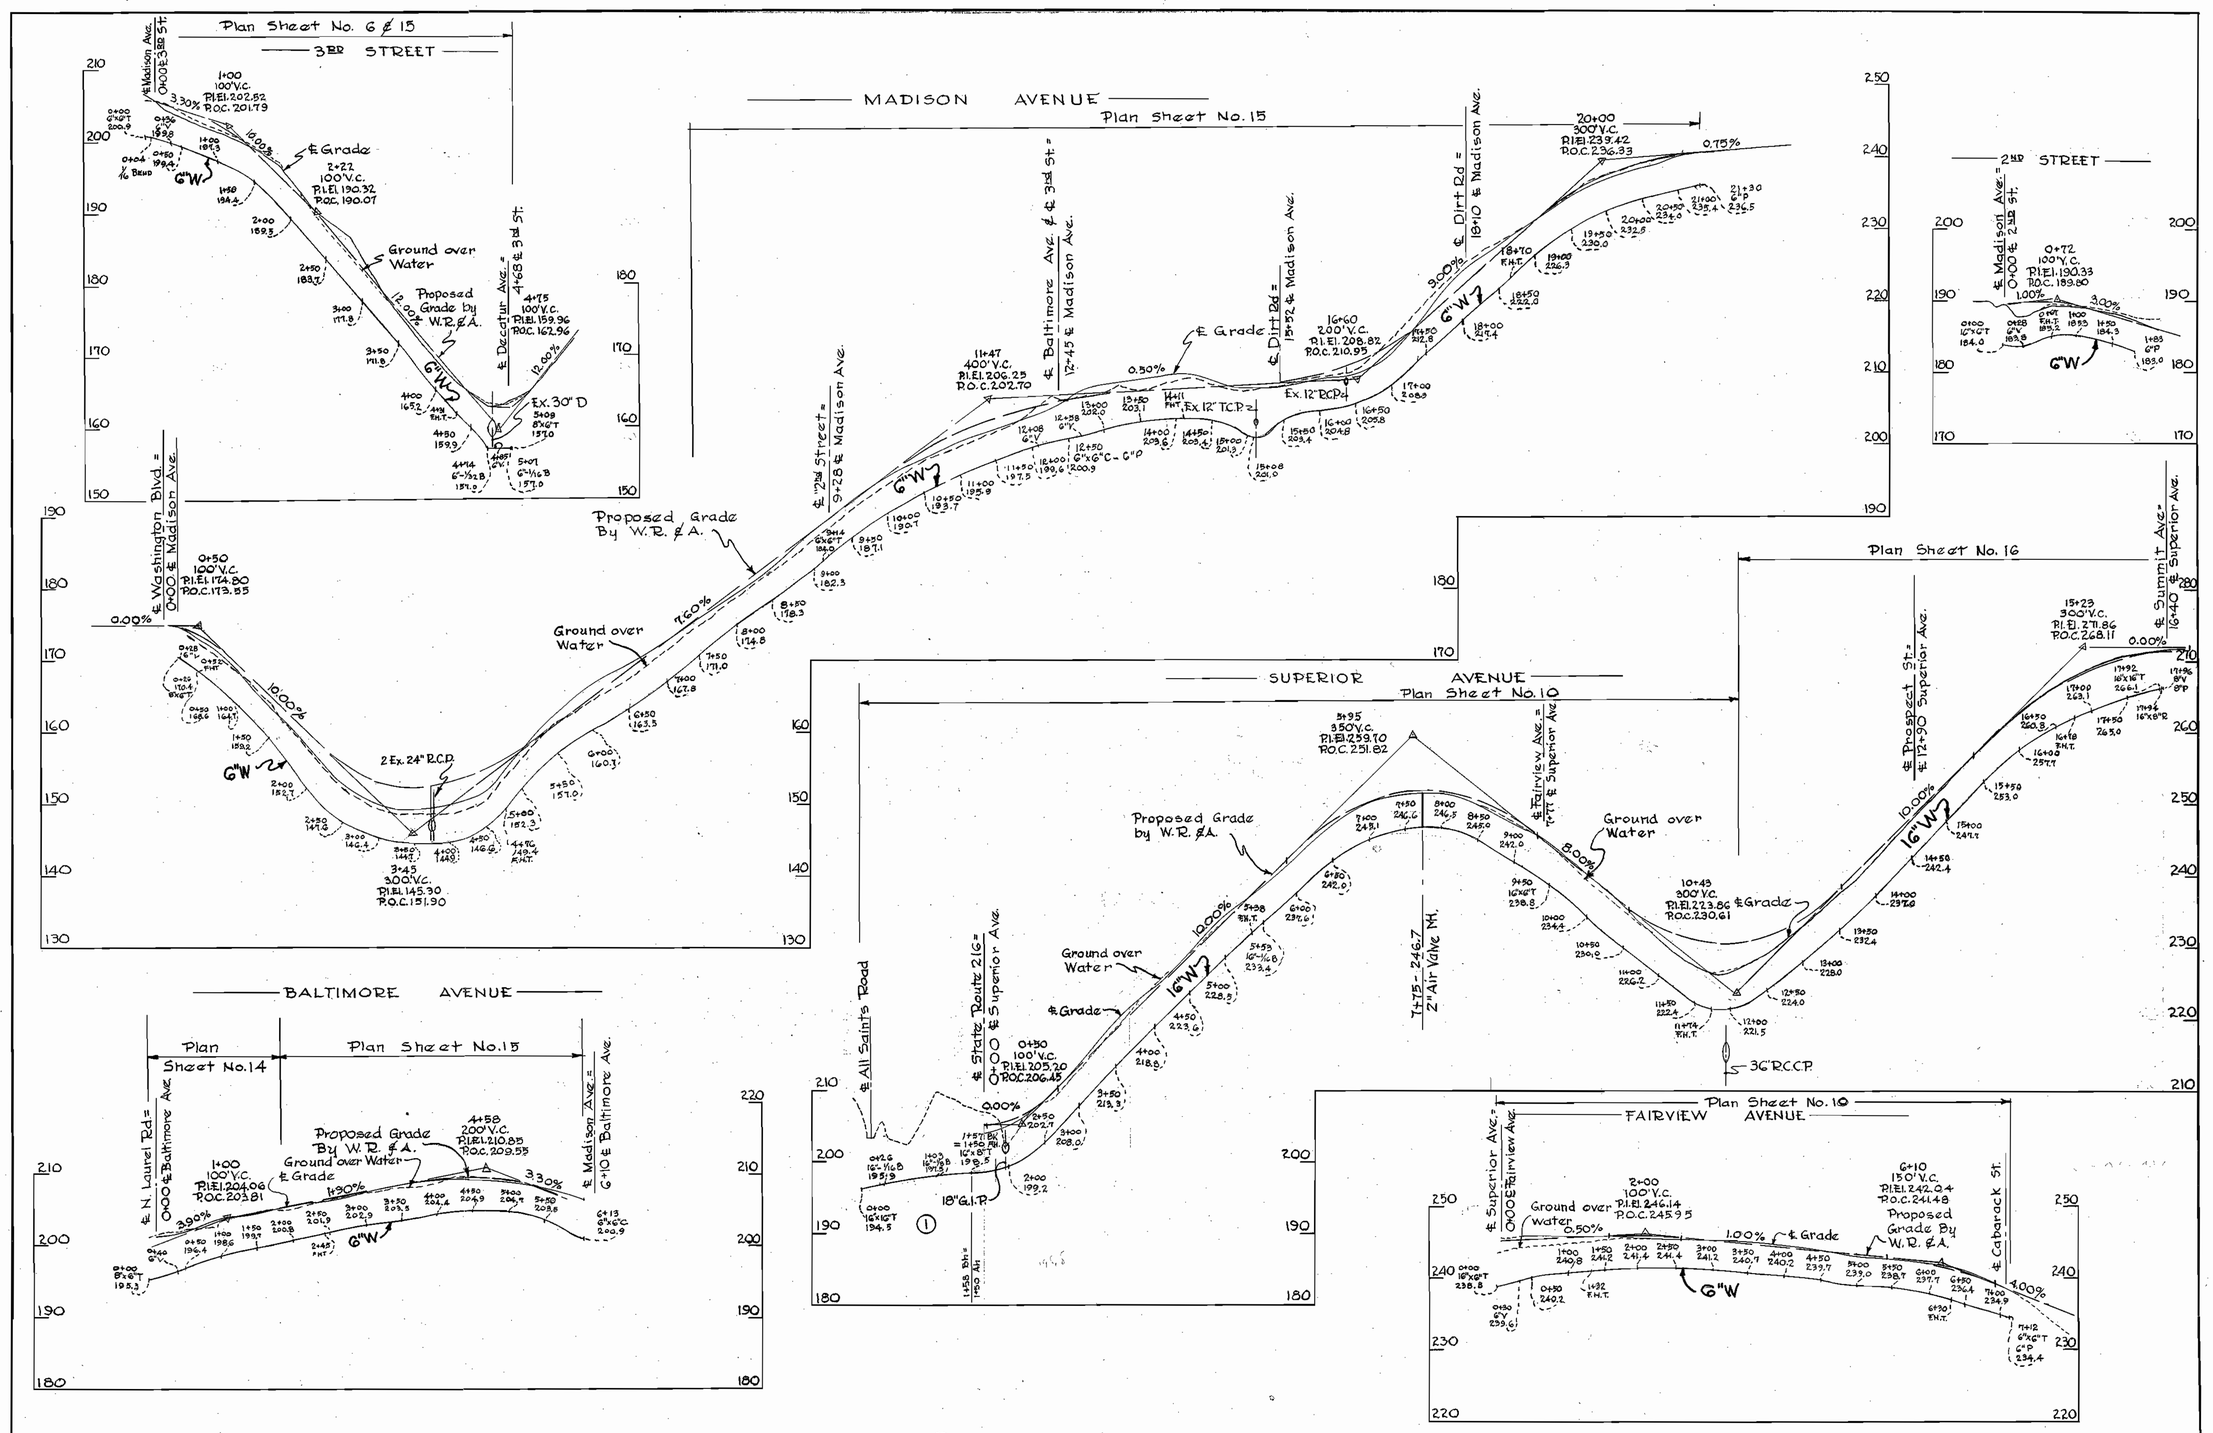

WHITMAN, REQUARDT & ASSOCIATES ENGINEERS 1304 ST. PAUL ST. BALTIMORE, MARYLAND	HOWARD COUNTY METROPOLITAN COMMISSION PATUXENT SUB-DISTRICT MARYLAND	APPROVED BY HOWARD COUNTY METROPOLITAN COMMISSION March 28, 1955 DATE — COMMISSIONER	APPROVED BY WASHINGTON SUBURBAN SANITARY COMMISSION MARCH 19, 1955 DATE — Harry P. Shaw CHIEF ENGINEER	PROFILES OF WATER MAIN EXTENSIONS	DRAWING NO. 24 OF 25 — SCALE H-1"=100' V-1"=10' — 55231 Y

① Revised - June 8, 1955

4205-2

WS 1-24

AS BUILT

IMPERIAL TRACING CLOTH—B. K. ELLIOTT CO., PGH., PA.

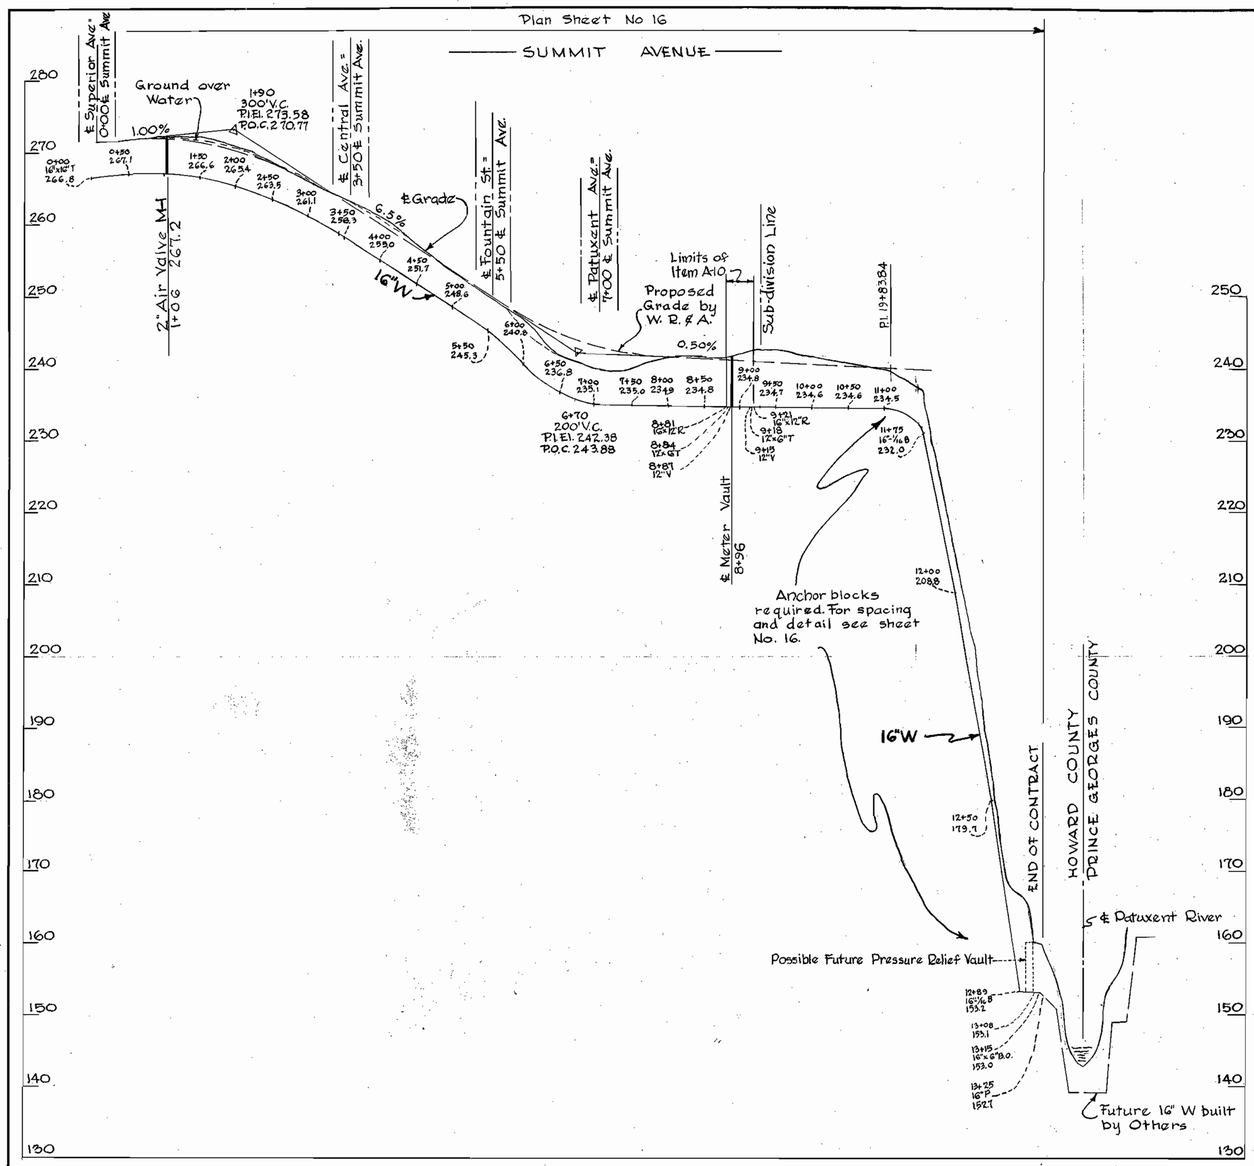

① Revised November 15, 1955

Contract 1W

WHITMAN, REQUARDT & ASSOCIATES ENGINEERS 1304 ST. PAUL ST. BALTIMORE, MARYLAND	HOWARD COUNTY METROPOLITAN COMMISSION PATUXENT SUB-DISTRICT MARYLAND	APPROVED BY HOWARD COUNTY METROPOLITAN COMMISSION March 28, 1955 DATE COMMISSIONERS	APPROVED BY WASHINGTON SUBURBAN SANITARY COMMISSION MARCH 19, 1955 DATE Harry P. Shaw CHIEF ENGINEER	PROFILES OF WATER MAIN EXTENSIONS	DRAWING NO. 25 OF 25	SCALE H-1"=100' V-1"=10'

55232 Y

AS BUILT

W S 1/25

PERMA TRACING CLOTH—K. E. ELLIOTT CO., PGH., PA.