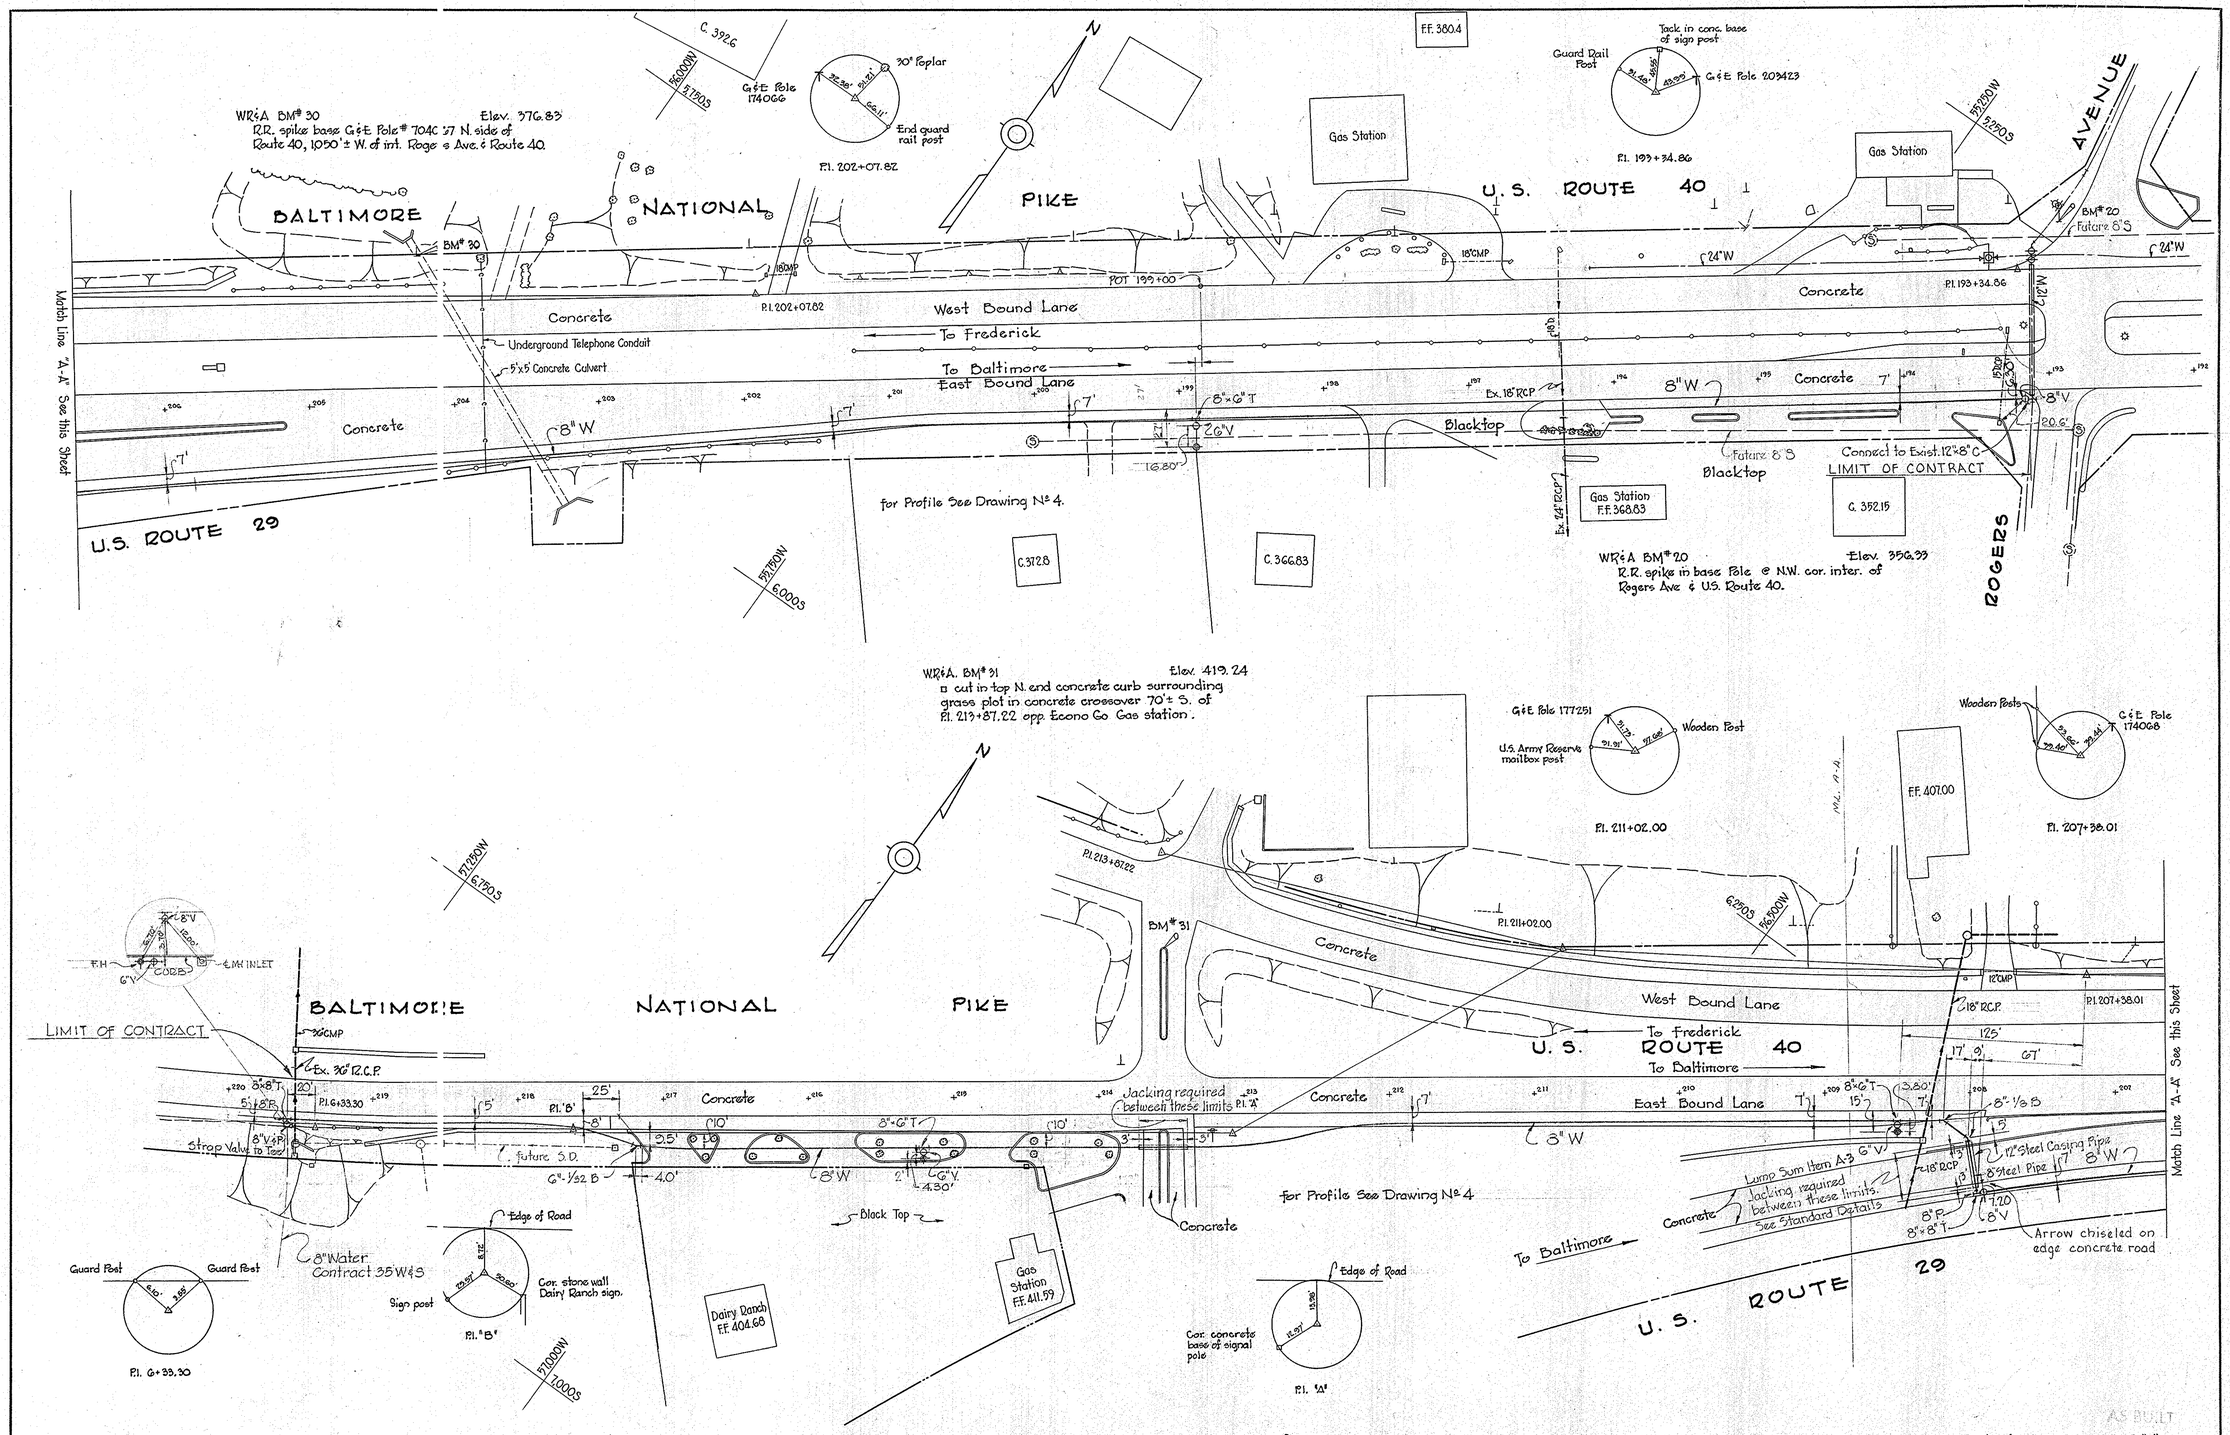

WHITMAN, REQUARDT & ASSOCIATES ENGINEERS 1304 ST. PAUL ST. BALTIMORE, MARYLAND	HOWARD COUNTY METROPOLITAN COMMISSION JAN. 30, 1961 DATE — CHIEF ENGINEER	CONTRACT NO. 27-W	PLAN OF WATER MAIN EXTENSIONS	ELLICOTT CITY SUB-DISTRICT	DRAWING NO. 1 OF 5	SCALE 1" = 50'

W. O. 4917-2

F.B. 2551, 2125 2121

JAN 30, 1961

ELLIOTT CO., PITTSBURGH REORDER A-39070

WS 27 W/1