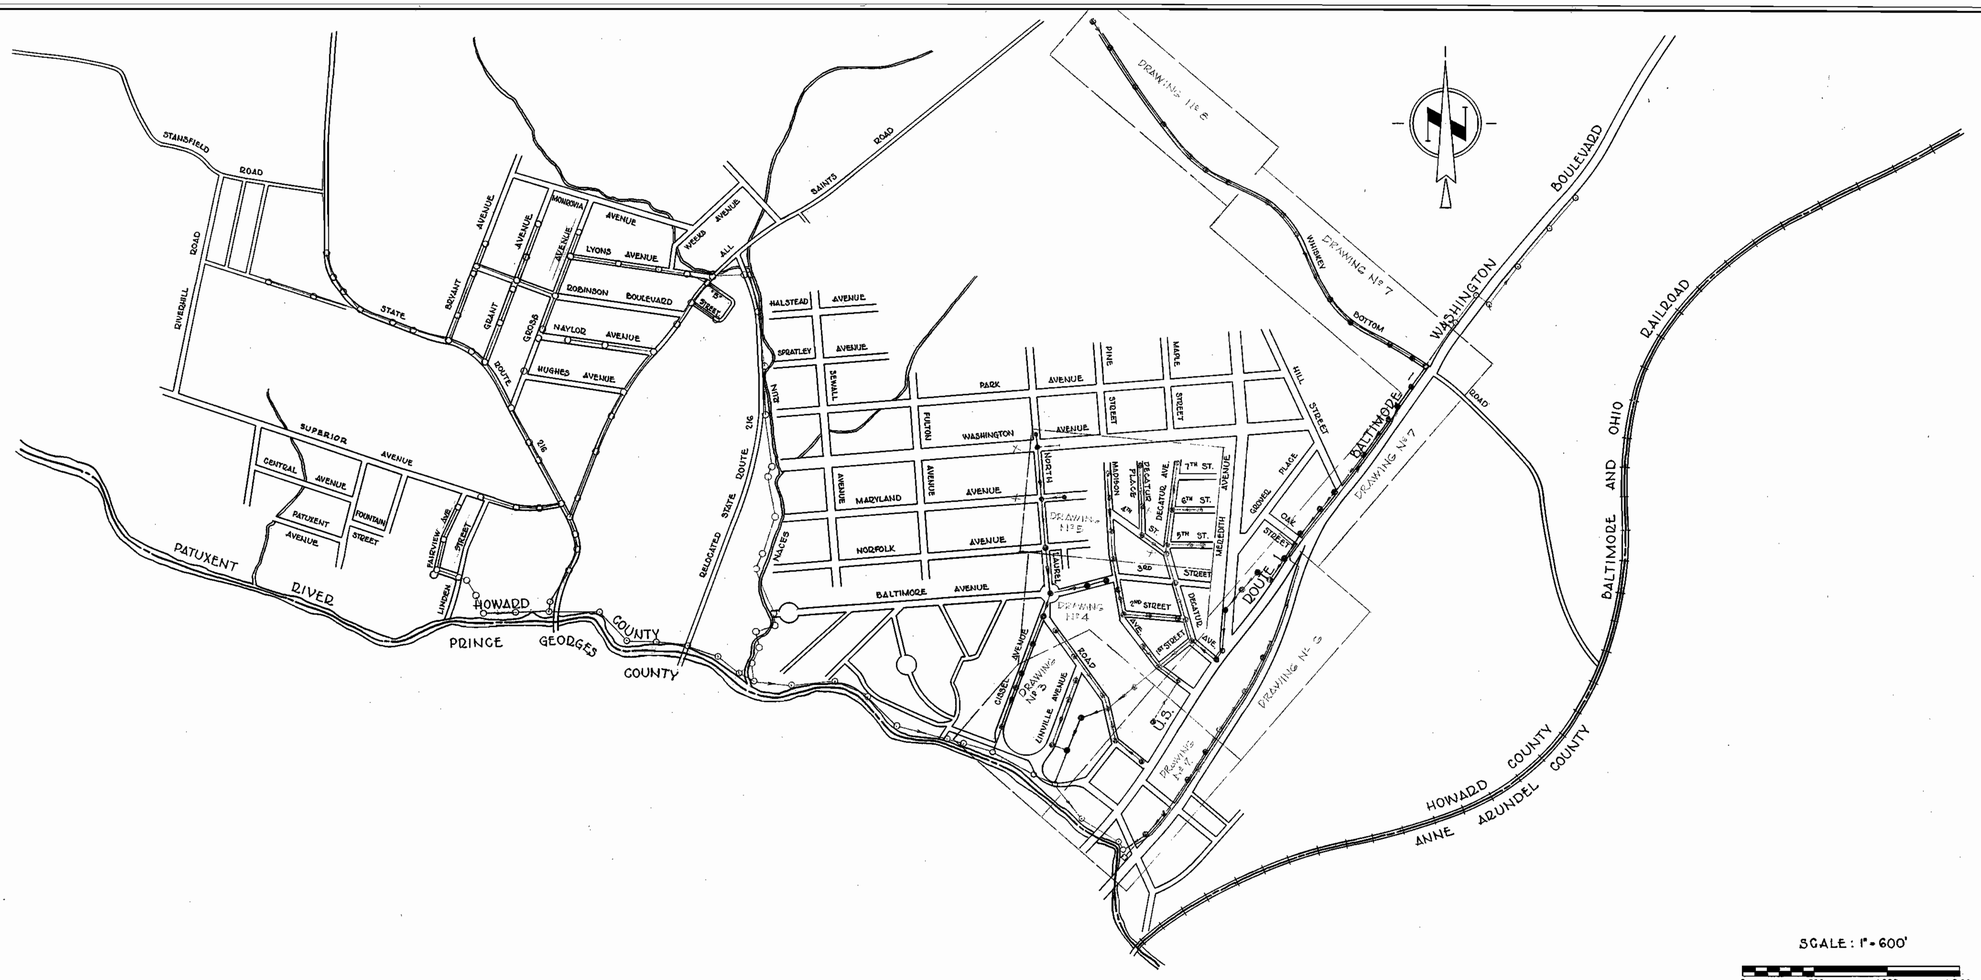

CONTRACT 29-S

SEWER MAIN EXTENSIONS

HOWARD COUNTY METROPOLITAN COMMISSION

PATUXENT SUB-DISTRICT

Contract No 29-S

WHITMAN, REQUARDT & ASSOCIATES ENGINEERS 1304 ST. PAUL ST. BALTIMORE, MARYLAND	HOWARD COUNTY METROPOLITAN COMMISSION March 3, 1961 (DATE) Carl W. Meyer (CHIEF ENGINEER)	CONTRACT NO. 29-S	LOCATION MAP	PATUXENT SUB-DISTRICT	DRAWING NO. 1 OF 12 / SCALE AS SHOWN

W.O. 4955-2

14 DEC. 65 AS BUILT

WS 29-S/1

ELLIOTT CO., PITTSBURGH REORDER A-28070

Match Line "B-B" See Drawing Nº 3

Match Line "B-B" See Drawing Nº 3

W.R&A. BM# 30 Elev. 170.16
Nail and cap in 10" pine on W. side of North Laurel Road approx. 300' N. of U.S.#1, 25'± Left of Sta. 8+00.

W.R&A. BM# 30

PROFILE SCHEDULE	
North Laurel Road	Drawing Nº 11
U.S. Route#1 (Northbound lane)	Drawing Nº 9
Sewer "A"	Drawing Nº 10
Sewer "B"	Drawing Nº 10

DECATUR PLACE

NORTH LAUREL AVENUE

NORTH LAUREL ROAD

CISSEL

COLUMBIA STREET

HOWARD COUNTY
PRINCE GEORGES COUNTY
PATUXENT RIVER

BALTIMORE WASHINGTON BLVD.

U.S. ROUTE 1

PROPERTY OF SOUTHERN PROPERTIES, INC. (16)

PROPERTY OF LAUREL DEVEL. CO., INC. (1)

PROPERTY OF CLUB 2203, INC. (1)

PROPERTY OF SOUTHERN PROPERTIES, INCORPORATED (16)

PROPERTY OF CHARLES C. & IDA V. TALBOTT (1)

PROPERTY OF JOHN E. & BARBARA J. MUNSON (9)

PROPERTY OF ARCHIE B. & ROSETTA CLOKEY (8)

PROPERTY OF ROBERT B. & LOUISE MILES (10)

PROPERTY OF D. RICE & IDA E. MILINER (9)

PROPERTY OF GEORGE M. & BARBARA J. PALMER (10)

PROPERTY OF MARYLAND STATE FAIR INCORPORATED (14) (15)

PROPERTY OF D. RICE & IDA E. MILINER (15)

PROPERTY OF ANNA E. HOWARD (13)

PROPERTY OF WILLIAM J. & MABEL C. WATTS (13)

PROPERTY OF M & S HOTEL (12)

PROPERTY OF JOHN D. & ETHEL N. CRANE (12)

PROPERTY OF LENORE ALIANO

NORTH LAUREL

SEWER "A"

SEWER "B"

10' Construction Strip
20' Right of Way

FUTURE SEWER NOT INCLUDED IN THIS CONTRACT

Encase in Concrete Sta 0+21 to 0+54

Connect to MH to be built under Contract 42S-5

18"S to be built under Contract 42S-5

Pumping Station and appurtenances to be built under Contract 42S-5

SEWAGE PUMPING STATION

LIMIT OF CONTRACT

Connect 12"W to Ex. 8"W

Connect 12"FM to 8"S

Ex. 8"W

Ex. 8"HPG

Ex. 8"S

Ex. 8"FM

Ex. 18" RCP

Ex. 24" RCP

Ex. 30" RCP

Ex. 18" GIP

Ex. 4" HPG

Ex. 2" HPG

Ex. 4" H.P.G.

Ex. 12"FM

Ex. 8"W?

Ex. 8"S?

Ex. 6"S?

Ex. 6"W

Ex. 8"W?

Ex. 8"S?

Ex. 8"W

Ex. 8"S

Ex. 8"W

Ex. 8"S

Ex. 8"S?

Ex. 8"W

Ex. 8"S

Ex. 8"W

Ex. 8"S

Ex. 8"W

Ex. 8"S

PROFILE SCHEDULE	
Cissel Avenue	Drawing Nº 11
North Laurel Road	Drawing Nº 11
Linville Avenue	Drawing Nº 12
First Street Outfall	Drawing Nº 12

Match Line "C-C" See Drawing Nº 4

Match Line "B-B" See Drawing Nº 2

Match Line "B-B" See Drawing Nº 2

Match Line "E-E" See Drawing Nº 4

Contract Nº 29-S

WHITMAN, REQUARDT & ASSOCIATES ENGINEERS 1304 ST. PAUL ST. BALTIMORE, MARYLAND	HOWARD COUNTY METROPOLITAN COMMISSION March 3, 1961 (DATE) Carl W. Meyer (CHIEF ENGINEER)	CONTRACT NO. 29-S	PLAN OF SEWER MAINS	PATUXENT SUB-DISTRICT	DRAWING NO. 3 OF 12	SCALE 1"=50'

W. O. 4955-2

14 DEC. 65 AS BUILT

WS 29S/3

ELLIOTT CO., PITTSBURGH REORDER A-39070

Match Line " D - D " See Drawing Nº 5

Match Line " G - G " See Drawing Nº 5

NORTH LAUREL ROAD

BALTIMORE AVENUE

CISSEL AVENUE

LAUREL AVENUE

MADISON STREET

DECATUR AVENUE

THIRD STREET

SECOND STREET

FIRST STREET

BRUNK'S ADDITION TO NORTH LAUREL PARK

PROPERTY OF ARCHIE & ROSETTA CLOKEY

PROPERTY OF GEORGE M. & BARBARA J. PALMER

PROPERTY OF R. RICE & IDA E. MILINER

Ruins Foundation

Trailers

Shed

Garage

Foundation

Match Line " C - C " See Drawing Nº 3

Match Line " E - E " See Drawing Nº 3

Match Line " F - F " See Drawing Nº 6

WR&A BM# 32 Elev. 189.67
Nail & Cap in G&E pole # 191331 on E. side N. Laurel Rd. approximately 125' S. of Cissel Ave. 20' right of Sta. 18+75 ±.

PROFILE SCHEDULE	
First Street	Drawing Nº 10
Second Street	Drawing Nº 9
Baltimore Avenue	Drawing Nº 11
Cissel Avenue	Drawing Nº 11
North Laurel Road	Drawing Nº 11
Decatur Avenue	Drawing Nº 12
Madison Avenue	Drawing Nº 12
First Street Outfall	Drawing Nº 12

WHITMAN, REQUARDT & ASSOCIATES
ENGINEERS
1304 ST. PAUL ST.
BALTIMORE, MARYLAND

HOWARD COUNTY METROPOLITAN COMMISSION
March 3, 1961 — Carl W. Meyer, CHIEF ENGINEER

CONTRACT NO. 29-S

PLAN OF SEWER MAINS

PATUXENT SUB-DISTRICT

DRAWING NO. 4 OF 12

SCALE 1" = 50'

41 NE 16-4
41 NE 17-3

Contract Nº 29-S

W. O. 4955-2

14 DEC 65 AS BUILT

WS 29-S/4

ELLIOTT CO., PITTSBURGH REORDER A-39070

WR&A BM # 34 Elev. 255.25
Nail & Cap in pole on W. side of N. Laurel Road
Approximately 175± N. end of macadam.

WR&A BM # 33 Elev. 232.18
Nail & Cap in pole # 198181 on W. side N. Laurel Road 15'± left of Station 29+50±.

WR&A BM # 50 Elev. 230.99
Roadside flange bolt of fire hydrant W. side Madison Ave. 100'± N. of Fourth Street.

PROFILE SCHEDULE	
Washington Avenue -	Drawing № 11
Maryland Avenue -	Drawing № 11
North Laurel Road	Drawing № 11
Madison Avenue	Drawing № 12
Decatur Place -	Drawing № 9
Fourth Street -	Drawing № 9
Sixth Street	Drawing № 10
Fifth Street	Drawing № 12
Decatur Avenue	Drawing № 12

Match Line "D - D" See Drawing № 4

Match Line "G-G" See Drawing № 4

WHITMAN, REQUARDT & ASSOCIATES ENGINEERS 1304 ST. PAUL ST. BALTIMORE, MARYLAND	HOWARD COUNTY METROPOLITAN COMMISSION March 3, 1961 (DATE) Carl W. Mayer (CHIEF ENGINEER)	CONTRACT NO. 29-S	PLAN OF SEWER MAINS	PATUXENT SUB-DISTRICT	DRAWING NO. 5 OF 12	SCALE 1"=50'

Contract № 29-S

W. O. 4955-2

14 DEC. 65 AS BUILT

FD. 2573, 1550

41 NE 16-E
41 NE 17-1

WS 29-S/5

ELLIOTT CO., PITTSBURGH REORDER A-39070

PROFILE SCHEDULE	
Balta.-Wash. Blvd. (South Bound Lane)	Drawing N° 10
Balta.-Wash. Blvd. (North Bound Lane)	Drawing N° 9
Decatur Avenue	Drawing N° 12
Madison Avenue	Drawing N° 12
Sewer "C" & Meredith Avenue	Drawing N° 10

Match Line " F - F " See Drawing N° 4

Match Line "H-H" See Drawing N° 2

Match Line "I-I" See Drawing N° 7

Match Line "N-N" See Drawing N° G-A

PROPERTY OF GEORGE M. & BARBARA J. PALMER

MADISON AVE.

BRUNK'S ADDITION TO NORTH LAUREL PARK

DECATUR AVENUE

MEREDITH AVENUE

PROPERTY OF JOHN CARROL MORRIS, INC.

PROPERTY OF THE COUNTY COMMISSIONERS OF HOWARD COUNTY

10' Construction Strip

SEWER "C"

PROPERTY OF LEON & IRENE SCOVITCH

NORTH LAUREL PARK

PROPERTY OF BILLY L. & BILLIE J. HURST

PROPERTY OF CHARLES E. & MARIAN H. ANDERSON

20' Right of Way

12' Right of Way

Strap Fire Hydrant to be

Concrete

Ex 4"G

Ex 8"W

Ex 8" H.P.G.

Ex. Telephone Conduit

Buttress not to be disturbed

20' Construction Strip

BALTIMORE - WASHINGTON BLVD. (South Bound Lane)

U. S. ROUTE 1

PROPERTY OF KASS-BERGER, INC

U.S. ROUTE 1

DAVIS AVENUE

Ex 8" H.P.G.

Construction Joints

Ex 30"GIP

12"FM

Ex 18"GIP

BM#1

WR&A BM#1 Elev. 181.75
Nail & Cap in pole # 213085 opposite station 19+20 ±.

PROPERTY OF GEORGE & GEORGE E. MILLER

PROPERTY OF LILLIAN A. EARP

PROPERTY OF S & M CORPORATION

5 Cabins

House Trailer

10' Construction Strip

18' Right of Way

WASHINGTON BLVD. (North Bound Lane)

Ex 12"FM

Ex 20"GIP

Ex 18"GIP

Ex 8"W

Ex 8" H.P.G.

Pl. 18+71.47

Pl. 21+25.15

F.F. 179.24

F.F. 171.09 N.C.

F.F. 170.60

F.F. 175.90 N.C.

F.F. 183.05

F.F. 202.28 C. 199.46

F.F. 182.47 N.C.

F.F. 183.06

F.F. 181.22 N.C.

F.F. 181.26 N.C.

F.F. 184.53 N.C.

F.F. 188.86 N.C.

F.F. 196.25 N.C.

F.F. 199.93 N.C.

C. 169.02

C. 168.44

C. 177.58

C. 169.32

N 43000E 72,730N

GENERAL NOTES

1. Approximate location of existing mains are shown. The Contractor shall take all necessary precautions to protect the existing mains and services and maintain uninterrupted supply. Any damage incurred shall be repaired immediately.
2. All pipe elevations shown are invert ⓔ elevations.
3. The Contractor shall locate existing utilities a minimum of two weeks in advance of construction operations in vicinity of utilities.
4. For all standard details see Standards bound in the Specifications.
5. Build all manholes to existing ground or paving unless otherwise noted.
6. 12" F.M. to be class 23 C.I.P. unless otherwise noted; block all fittings with concrete.
7. 1½" W. to be copper Type 'K' and to have a minimum of 3½' cover unless otherwise noted.
8. Before digging pipe, pushing or doing other work near Telephone Cables call collect any time Lexington 9-9900 Ext. 553, 554 or 555, Baltimore, Maryland.
9. Clear all poles by 2'-0" minimum or tunnel as required.
10. Cost for removing and replacing of guard rails shall be included in the unit price bid for excavation and backfill for water mains.
11. All sewers shall be V.C.P.X., C.S.P.X. or Asbestos Cement Class 2400 unless otherwise noted.

N°	Date	Revision
2	1-28-65	Right of Way added
1	8-25-64	8" Sewer extended

Contract N° 29-S

WHITMAN, REQUARDT & ASSOCIATES
ENGINEERS
1304 ST. PAUL ST.
BALTIMORE, MARYLAND

HOWARD COUNTY METROPOLITAN COMMISSION
March 3, 1961 DATE
CHIEF ENGINEER

CONTRACT NO. 29-S

PLAN OF SEWER MAINS

PATUXENT SUB - DISTRICT

DRAWING NO. 6 OF 12

SCALE 1"=50'

Y
40 NE 17-1
41 NE 17-3

4955-2

14 SEPT., 1966 AS BUILT

FB 1590

WS 29S/6

ELLIOTT CO., PITTSBURGH REORDER A-33464

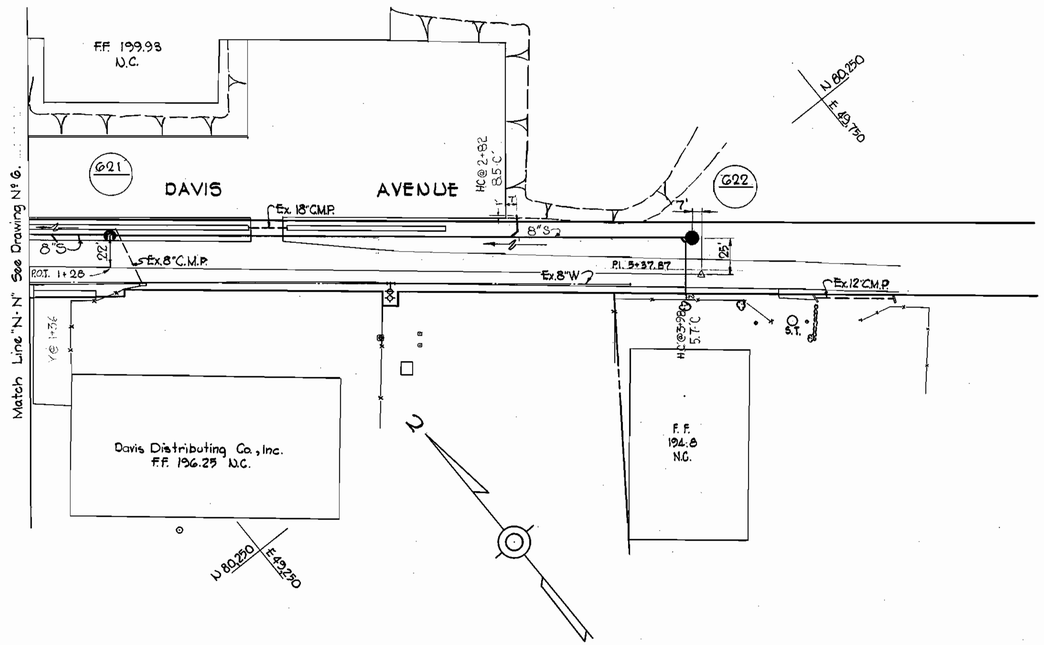

PLAN
Scale: 1"=50'

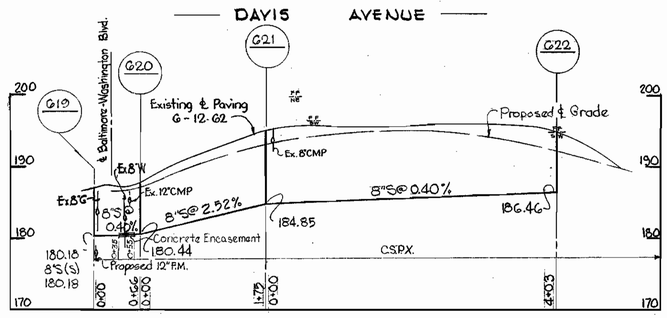

PROFILE
Scale: H: 1"=100'
V: 1"=10'

WHITMAN, REQUARDT & ASSOCIATES ENGINEERS 1304 ST. PAUL ST. BALTIMORE, MARYLAND	HOWARD COUNTY METROPOLITAN COMMISSION August 26, 1964 (DATE) W. O. Howe (CHIEF ENGINEER)	CONTRACT NO. 29-S	PLAN AND PROFILE OF SEWER MAINS	PATUXENT SUB - DISTRICT	DRAWING NO. 6-A OF 12	SCALE AS SHOWN 41 NE 17-3,4

W. O. 4055-2

14 DEC. 1965 FB. 1413 AS BUILT

WS 29S16-A

ELLIOTT CO., PGH., PA. REORDER A-26874

PROFILE SCHEDULE	
Baltimore-Washington Blvd.	Drawing No 10
Whiskey Bottom Road	Drawing No 8

WR&A BM.#2
Nail & tin top in 30" Oak on W. side of U.S. 1 opposite station 31+80 ±.
Elev. 203.49

WR&A BM#3
Nail & Cap in 24" White Oak 40'± E. of station 38+50.
Elev. 233.99

WR&A BM#4
Nail & Cap in second pole on right side of Patuxent Drive from U.S#1 opposite Station 51+05.
Elev. 237.20

WR&A BM#5
Nail in pole # 306005 on W. side Station 59+70.
Elev. 267.69

Note:
Strapping of fire hydrants shall be included in the unit price bid for furnishing and laying sewer. See Standard Detail W-G.

Note:
Cost for relocating light poles to be included in unit price for furnishing and laying sewer.

Cellars not served.

No.	Date	Revision
4	5-14-76	ADDED 85' S.H.C. ACROSS U.S. RT. 1

WHITMAN, REQUARDT & ASSOCIATES
ENGINEERS
1304 ST. PAUL ST.
BALTIMORE, MARYLAND

HOWARD COUNTY METROPOLITAN COMMISSION
March 3, 1961 — DATE
Carl W. Mayer — CHIEF ENGINEER

CONTRACT NO. 29-S

PLAN OF SEWER MAINS

PATUXENT SUB-DISTRICT

DRAWING NO. 7 OF 12

SCALE 1"=50'

Y

41 NE 17-1,2
42 NE 17-4
F.D. 1960

Contract No 29-S

14 DEC 1965 - AS BUILT

4955-2

WS 29S/7

ILLIOTT CO., PITTSBURGH REORDER A-33484-1

WS 295/8

Match Line "M-M" See This Drawing

84,750 N 48,250 E

F.F. 290.35

C 287.65

C 285.27

C 288.60

C 286.60

C 278.50

Guy Pole # 314 G09

Pl. 75+06.44

84,250 N 48,500 E

Match Line "L-L" See Drawing No. 7

G14 G13 G12 G11 G10

8"S Ex. 3" HPG Ex. 12"W Ex. 12"x 24" CMP 16' Ex. 12"x 18" GIP

POT 80+00 POT 81+00 POT 83+63 POT 174+72

Blacktop ROAD

WHISKEY BOTTOM

For Profile See This Drawing

PLAN
Scale: 1"=50'

C 295.55

C 286.28

G07 G06 G05 G04 G03 G02 111G

WHISKEY BOTTOM ROAD

Proposed & Grade by WR&A

Existing & Grade

Ex. 10"x 18" GIP Ex. 12"W

12" Wall El. 255.0

12" Wall - El. 252.2

8"S @ 5.25% 8"S @ 0.40% 8"S @ 4.46% 8"S @ 2.48% 8"S @ 1.59%

252.52 250.88 250.00 248.99 231.07 225.59

223.33 12"S (SW) 223.00 15"S (NE) 222.79 Built Under Cont. 50-S

CSPX Low Cradle CSPX only

T. 15200 Dec. 1479 Inc. 1445

Match Line "A-A" See This Drawing

Match Line "A-A" See This Drawing

Baltimore-Washington Blvd.

314G16 # 193111 10" twin gum

Pl. 89+42.95

F.F. 304.88 F.F. 301.43 F.F. 305.65 F.F. 305.73 N.C.

C. 299.05

85,250 N 47,200 E

G16 G15

For Profile See This Drawing

WHISKEY BOTTOM ROAD

Ex. 3" HPG Ex. 12"W Ex. 10"x 18" GIP

8"S Blacktop

78.6' 51.5' 90° C @ 3.78%

Match Line "M-M" See This Drawing

G16 G15 G14 G13 G12 G11 G10 G09 G08

8"S @ 0.40% 8"S @ 3.38% 8"S @ 0.40% 8"S @ 0.40% 8"S @ 0.59% 8"S @ 1.24% 8"S @ 9.28%

275.51 274.40 281.47 279.87 278.48 277.89 276.55 275.55 271.05 261.81

Existing & Grade Proposed & Grade by WR&A

Ex. 12"x 24" GIP Ex. 12"W

12" Wall - El. 280.1

CSPX

PART "A"

PROFILE
Scale: H: 1"=100' V: 1"=10'

WHITMAN, REQUARDT & ASSOCIATES
ENGINEERS
1304 ST. PAUL ST.
BALTIMORE, MARYLAND

HOWARD COUNTY METROPOLITAN COMMISSION
March 3, 1961 — DATE
Carl W. Meyer — CHIEF ENGINEER

CONTRACT NO. 29-S

PLAN AND PROFILES OF SEWER MAINS

PATUXENT SUB-DISTRICT

DRAWING NO. 8 OF 12

SCALE AS SHOWN

Y

43 NE 17-3
43 NE 18-4

Contract No. 29-S

14 DEC, 1905 AS BUILT

4055-2

PROPERTY OF MARYLAND STATE FAIR, INC.

PROPERTY OF R. RICE & IDA. E. MILINER

PROPERTY OF ANNA E. HOWARD

PROPERTY OF WILLIAM J. & MABEL C. WATTS

PROPERTY OF JOHN R. & ETHEL N. CRANE

PROPERTY OF M&S HOTEL

PROPERTY OF S&M. CORP.

PROPERTY OF LILLIAN A. BARP

PROPERTY OF GEORGE & GEORGE E. MILLER

PROPERTY OF KASS-BERGER, INC.

BALTIMORE WASHINGTON BLVD. (North Bound Lane)

For Plan See Drawings Nº 2&6

U.S. ROUTE 1

Concrete Drive

Macadam Drive

Ex. 30"GIP

Ex. 8"W

12"F.M.

Existing Ground Over Fence, Main & Sewer

Existing Ground Over Sewer

Exist. & Paving

Ex. 8"S

Ex. 18"RCP

Ex. 30"RCP

Ex. 15"RCP

Ex. 6"S(W) 152.9

8"S @ 0.68%

8"S @ 2.49%

8"S @ 5.03%

8"S @ 2.01%

8"S @ 2.43%

8"S @ 2.00%

12"F.M. 8"S @ 1.20%

146.07

148.42

155.26

160.76

168.76

175.22

180.18 8"S(E) 180.18

133.13

190.07

1+08 DHC T-1+67.8

1+77 DHC T-1+67.2

CSPX

PARTS "A & B"

CONTRACT 48-S

LIMIT OF CONTRACT

For continuation of force main profile, see Drawing No. 10

Nº	Date	Revision
1	8-25-64	8" Sewer extended.

FOURTH STREET

for Plan See Drawing Nº 5

E. Madison Avenue

-2.00%

-11.30%

STA 3+25
V.C. 100'
P.V.I. 183.50
P.O.C. 184.88

Proposed ℄ Grade By W.R. & A.

583

℄ Decatur Place

571

℄ Decatur Avenue

Exist. ℄ Grade

-6.36%

Ex. 42"CMP

8"S @ 4.84%

168.32 8"S (N) 168.32

157.38 8"S (N&S) 157.38

CSPX

PART "A"

SECOND STREET

for Plan See Drawing Nº 4

577

576

E. Madison Ave.

Proposed ℄ Grade By W.R. & A.

STA 2+35
V.C. 150'
P.V.I. 185.44
P.O.C. 183.75

-3.00%

Ex. 8"W

8"S @ 1.86%

179.27 8"S (N) 179.27

176.02

Exist. ℄ Grade

STA 4+80
V.C. 100'
P.V.I. 156.04
P.O.C. 157.73

-10.00%

8"S @ 11.63%

575

℄ Decatur Ave.

503

2-36"CMP

8"S @

1.00%

147.40

146.84 8"S (N&S) 146.84

CSPX

PART "A"

DECATUR PLACE

for Plan See Drawing Nº 5

585

Exist. ℄ Grade

+3.70%

584

STA 2+50
V.C. 200'
P.V.I. 208.58
P.O.C. 206.50

STA 0+62
V.C. 100'
P.V.I. 186.02
P.O.C. 186.65

211.13

8"S @ 4.08%

195.91

Proposed ℄ Grade By W.R. & A.

-12.00%

℄ Fourth Street

583

8"S @ 11.52%

-2.00%

168.32 8"S (SE) 168.32

CSPX

PART "A"

Contract Nº 29-S

WHITMAN, REQUARDT & ASSOCIATES ENGINEERS 1304 ST. PAUL ST. BALTIMORE, MARYLAND	HOWARD COUNTY METROPOLITAN COMMISSION March 3, 1961 DATE — Carl W. Mayer CHIEF ENGINEER	CONTRACT NO. 29-S
PROFILES OF SEWER MAINS	PATUXENT SUB-DISTRICT	DRAWING NO. 9 OF 12
SCALE H-1"=100' V-1"=10'		

W. O. 4055-2

14 DEC. 1965 AS BUILT

WS 295/9

ELLIOTT CO., PITTSBURGH REORDER A-39070

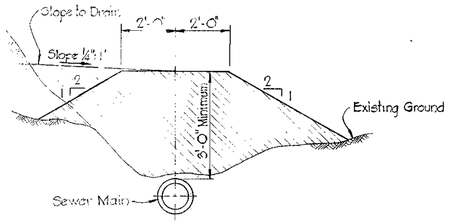

TYPICAL FILL DETAIL

No Scale

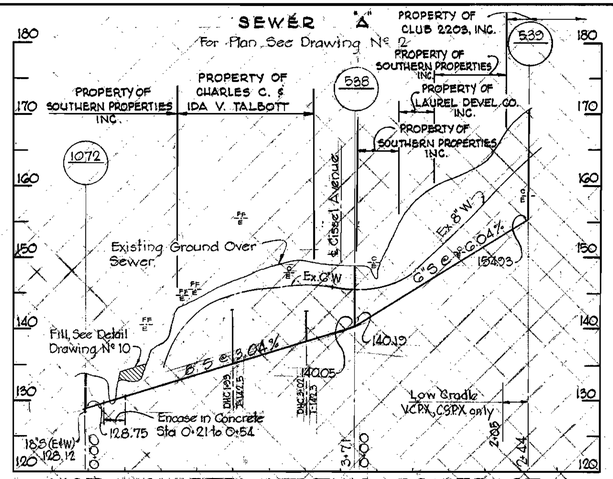

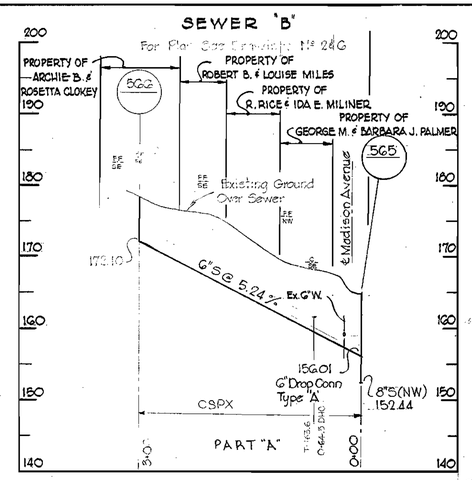

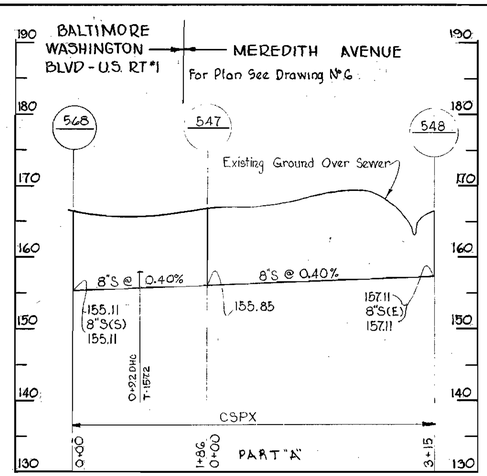

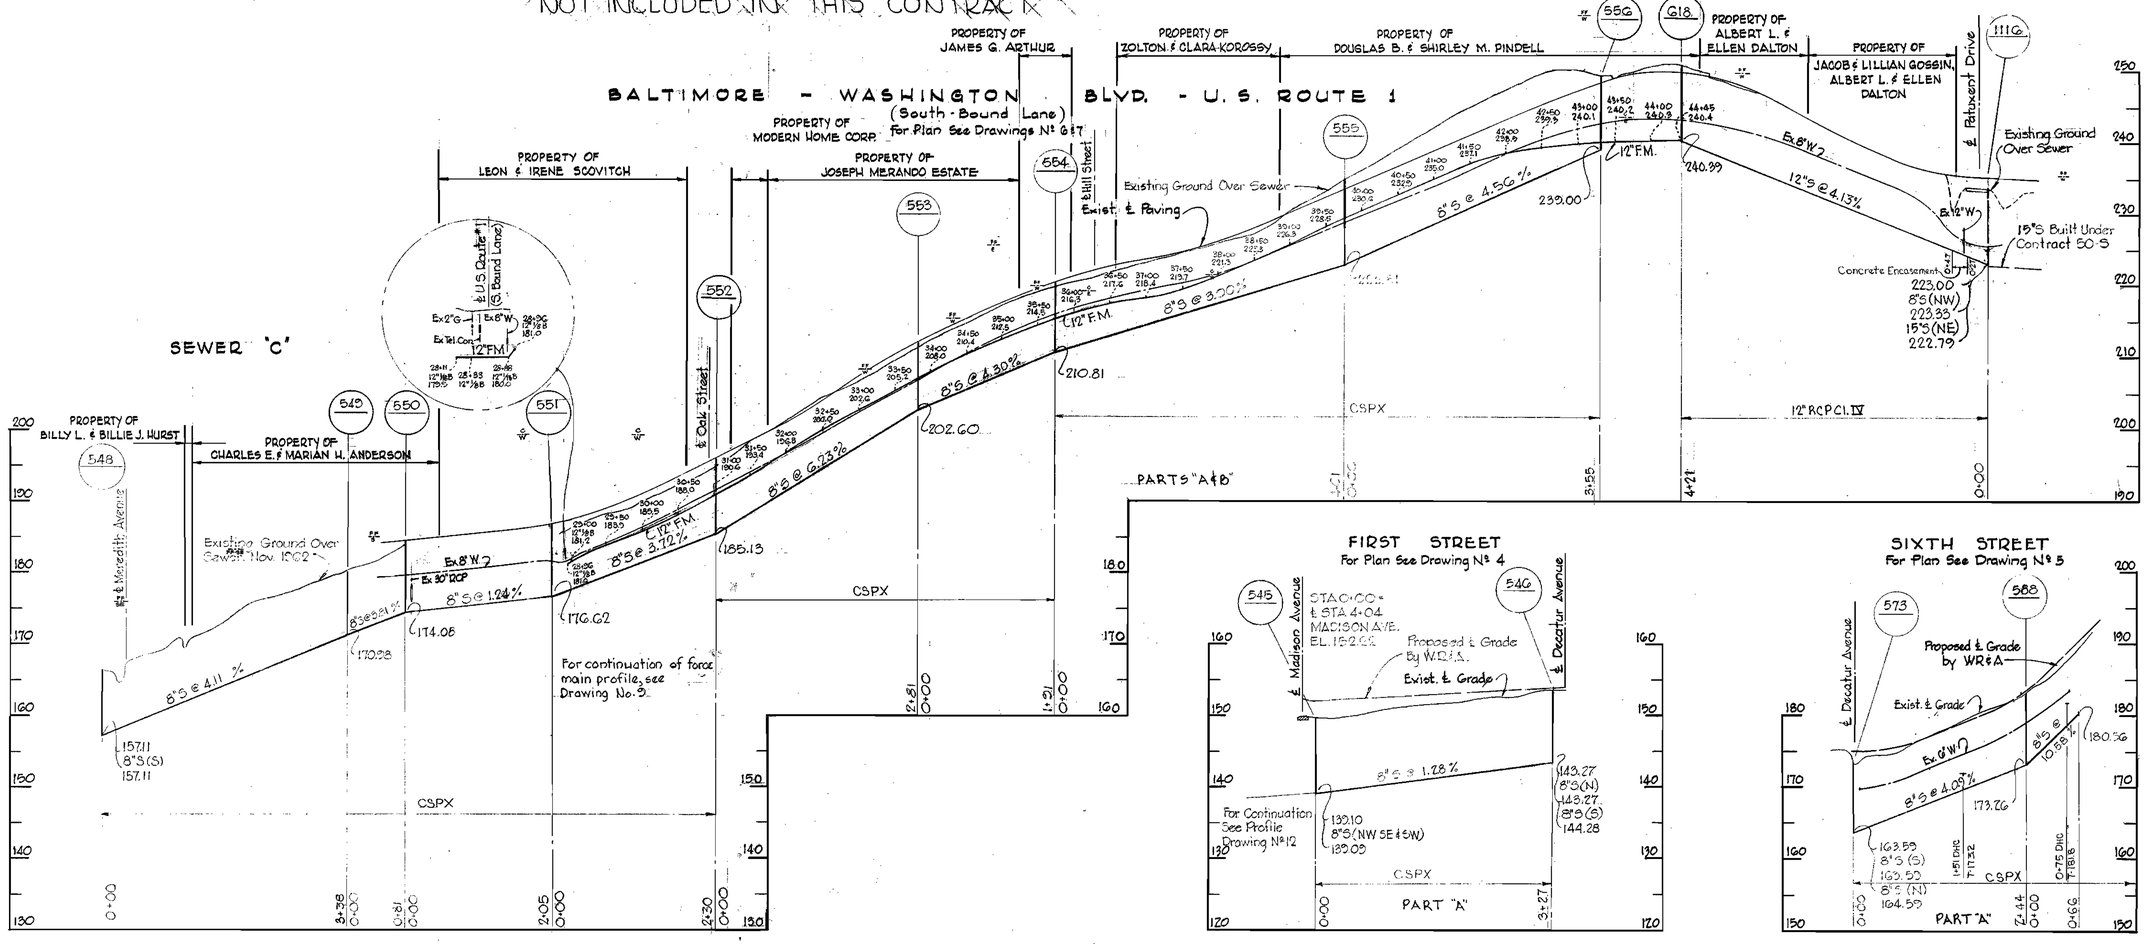

WHITMAN, REQUARDT & ASSOCIATES ENGINEERS 1304 ST. PAUL ST. BALTIMORE, MARYLAND	HOWARD COUNTY METROPOLITAN COMMISSION March 3, 1961 (DATE) Carl W. Mayer (CHIEF ENGINEER)	CONTRACT NO. 29-S	PROFILES OF SEWER MAINS	PATUXENT SUB-DISTRICT	DRAWING NO. 10 OF 12	SCALE H-1"=100' V-1"=10'

Contract Nº 29-S

W. O. 4955-2

14 DEC 65 AS BUILT

WS 29S/10

ELLIOTT CO., PITTSBURGH REORDER A-29070

NORTH LAUREL ROAD
For Plan See Drawings Nº 2, 3, & 4

MARYLAND AVENUE
For Plan See Drawing Nº 5

WASHINGTON AVENUE
For Plan See Drawing Nº 5

NORTH LAUREL ROAD
for Plan See Drawings Nº 4 & 5

CISSEL AVENUE
for Plan See Drawings Nº 3 & 4

for Plan See Drawing Nº 4
BALTIMORE AVENUE

PROPERTY OF SOUTHERN PROPERTIES INC.

PROPERTY OF JOHN E. & BARBARA J. MUNSON

PROPERTY OF ELLA W. DAVIS

WHITMAN, REQUARDT & ASSOCIATES ENGINEERS 1304 ST. PAUL ST. BALTIMORE, MARYLAND	HOWARD COUNTY METROPOLITAN COMMISSION March 3, 1961 (DATE) Carl W. Meyer (CHIEF ENGINEER)	CONTRACT NO. 29-S	PROFILES OF SEWER MAINS	PATUXENT SUB-DISTRICT	DRAWING NO. 11 OF 12 SCALE H-1"=100' V-1"=10'

Contract Nº 29-S

W. O. 4955-2

14 DEC. 65 AS BUILT

WS 29-S/11

ELLIOTT CO., PITTSBURGH REORDER A-39070

MADISON AVENUE
For Plan See Drawings Nº 4, 5 & 6

FIRST STREET OUTFALL
For Plan See Drawings Nº 3 & 4

PROPERTY OF SOUTHERN PROPERTIES INC. | PROPERTY OF SOUTHERN PROPERTIES INC. | PROPERTY OF JOHN E. & BARBARA J. MUNSON | PROPERTY OF ELLA W. DAVIS | PROPERTY OF ARCHIE B. & ROBETTA CLOKEY

1073 · 540 · 541 · 542 · 543 · 544 · 545

℄ Gissel Ave. · ℄ North Laurel Road · ℄ Madison Avenue

Fill, See Detail Drawing Nº 10

Existing Ground Over Sewer, December 1962

8"S @ 0.40% · 8"S @ 0.40% · 8"S @ 1.50% · 8"S @ 0.64% · 8"S @ 0.64%

MH to be built under Contr. 49-S

129.26 · 18"S (NW&E) 128.56 · 130.06 · 131.31 8"S(W) 131.31 · 132.39 · 135.95 8"S(SE) 135.95 8"S(NW) 135.92 · 137.51 · 139.03 8"S(NW&SE) 139.03 8"S(NE) 139.10

CSPX

PART "A"

0+00 · 2+00 · 3+14 · 2+10 · 2+29 · 2+45 · 2+46

For Continuation See Profile Drawing Nº 10

FIFTH STREET
for Plan See Drawing Nº 5

587 · 586 · 572

℄ Decatur Avenue

Proposed ℄ Grade by W.R.&A.

Exist. ℄ Grade

Ex. G"W

8"S @ 0.63% · 8"S @ 12.86%

169.71 · 167.89

DMC 0+14 T=186.2

158.13 8"S (N&S) 158.13

CSPX

PART "A"

0+00 · 1+92 · 3+00 · 4+00

DECATUR AVENUE
For Plan See Drawings Nº 4, 5 & 6

574 · 573 · 572 · 571 · 570 · 569 · 568 · 567 · 566 · 565 · 545

℄ Seventh Avenue · ℄ Sixth Avenue · ℄ Fifth Avenue · ℄ Fourth Avenue · ℄ Third Avenue · ℄ Second Avenue · ℄ First Avenue · ℄ First Street · ℄ Washington Blvd.

Exist ℄ Grade · ℄ Ex. 24" RCP · ℄ Ex. 18" CMP · Ex. 8"W · ℄ Ex. 24" RCP · Proposed Grade By W.R.&A.

8"S @ 2.12% · 8"S @ 1.84% · 8"S @ 0.80% · 8"S @ 1.76% · 8"S @ 1.96% · 8"S @ 7.91% · 8"S @ 5.29%

172.69 · 164.59 · 163.59 8"S (E) 163.59 · 158.13 8"S (E) 156.13 · 157.38 8"S (NW) 157.38 · 153.07 · 146.84 8"S (W) 146.84 · 143.27 8"S(W) 143.27 · 144.28 · 156.50 · 6"S(SW) 156.01 · 152.44 · 132.00 8"S(SW) 132.00 8"S(NE) 133.10

CSPX

PART "A"

0+00 · 2+96 · 0+00 · 0+91 · 0+00 · 2+50 · 0+00 · 3+16 · 0+00 · 1+80 · 0+00 · 0+22 · 0+52 · 2+20 · 0+00 · 0+00 · 2+52

STA 2+50 1+50' V.C. P.V.I. 152.75 P.O.C. 154.42

Sta. 0+75 100' V.C. P.V.I. 145.00 P.O.C. 144.87

Sta. 0+00 ℄ Sta. 17+93 U.S. Route 1 ℄ El. = 166.5

+1.3% · -2.0% · 70°

Proposed Grade By W.R.&A.

Existing Ground Over Sewer

8"S @ 4.34% · 155.11 8"S(SW) 155.11 · Encase in Conc.

LINVILLE AVENUE
For Plan See Drawing Nº 3

PROPERTY OF SOUTHERN PROPERTIES INC.

541 · 557 · 558 · 559

℄ North Laurel Rd.

Proposed Grade By W.R.&A. · Exist. ℄ Grade · Existing Ground Over Sewer · Ex. G"W · ℄ Ex. 8"W

8"S @ 3.08% · 8"S @ 2.56% · 6"SDR @ 5.45%

154.02 · 163.82 · 165.96 · 170.31 · 131.31 8"S(N&S) 131.31

DMC 0+97.5 T=160.1 · DMC 1+14 T=161.6 · DMC 2+22 T=163.9 · DMC 0+74 T=171.4

PART "A"

1+47 · 0+00 · 3+86 · 0+00 · 1+70

Contract Nº 29-S

WHITMAN, REQUARDT & ASSOCIATES ENGINEERS 1304 ST. PAUL ST. BALTIMORE, MARYLAND	HOWARD COUNTY METROPOLITAN COMMISSION March 3, 1961 (DATE) Carl W. Mayer (CHIEF ENGINEER)	CONTRACT NO. 29-S	PROFILES OF SEWER MAINS	PATUXENT SUB - DISTRICT	DRAWING NO. 12 OF 12	SCALE H-1"=100' V-1"=10'

W. O. 4955-2

14 DEC 65 AS BUILT

WS 29-S/12

ELLIOTT CO., PITTSBURGH REORDER A-33070