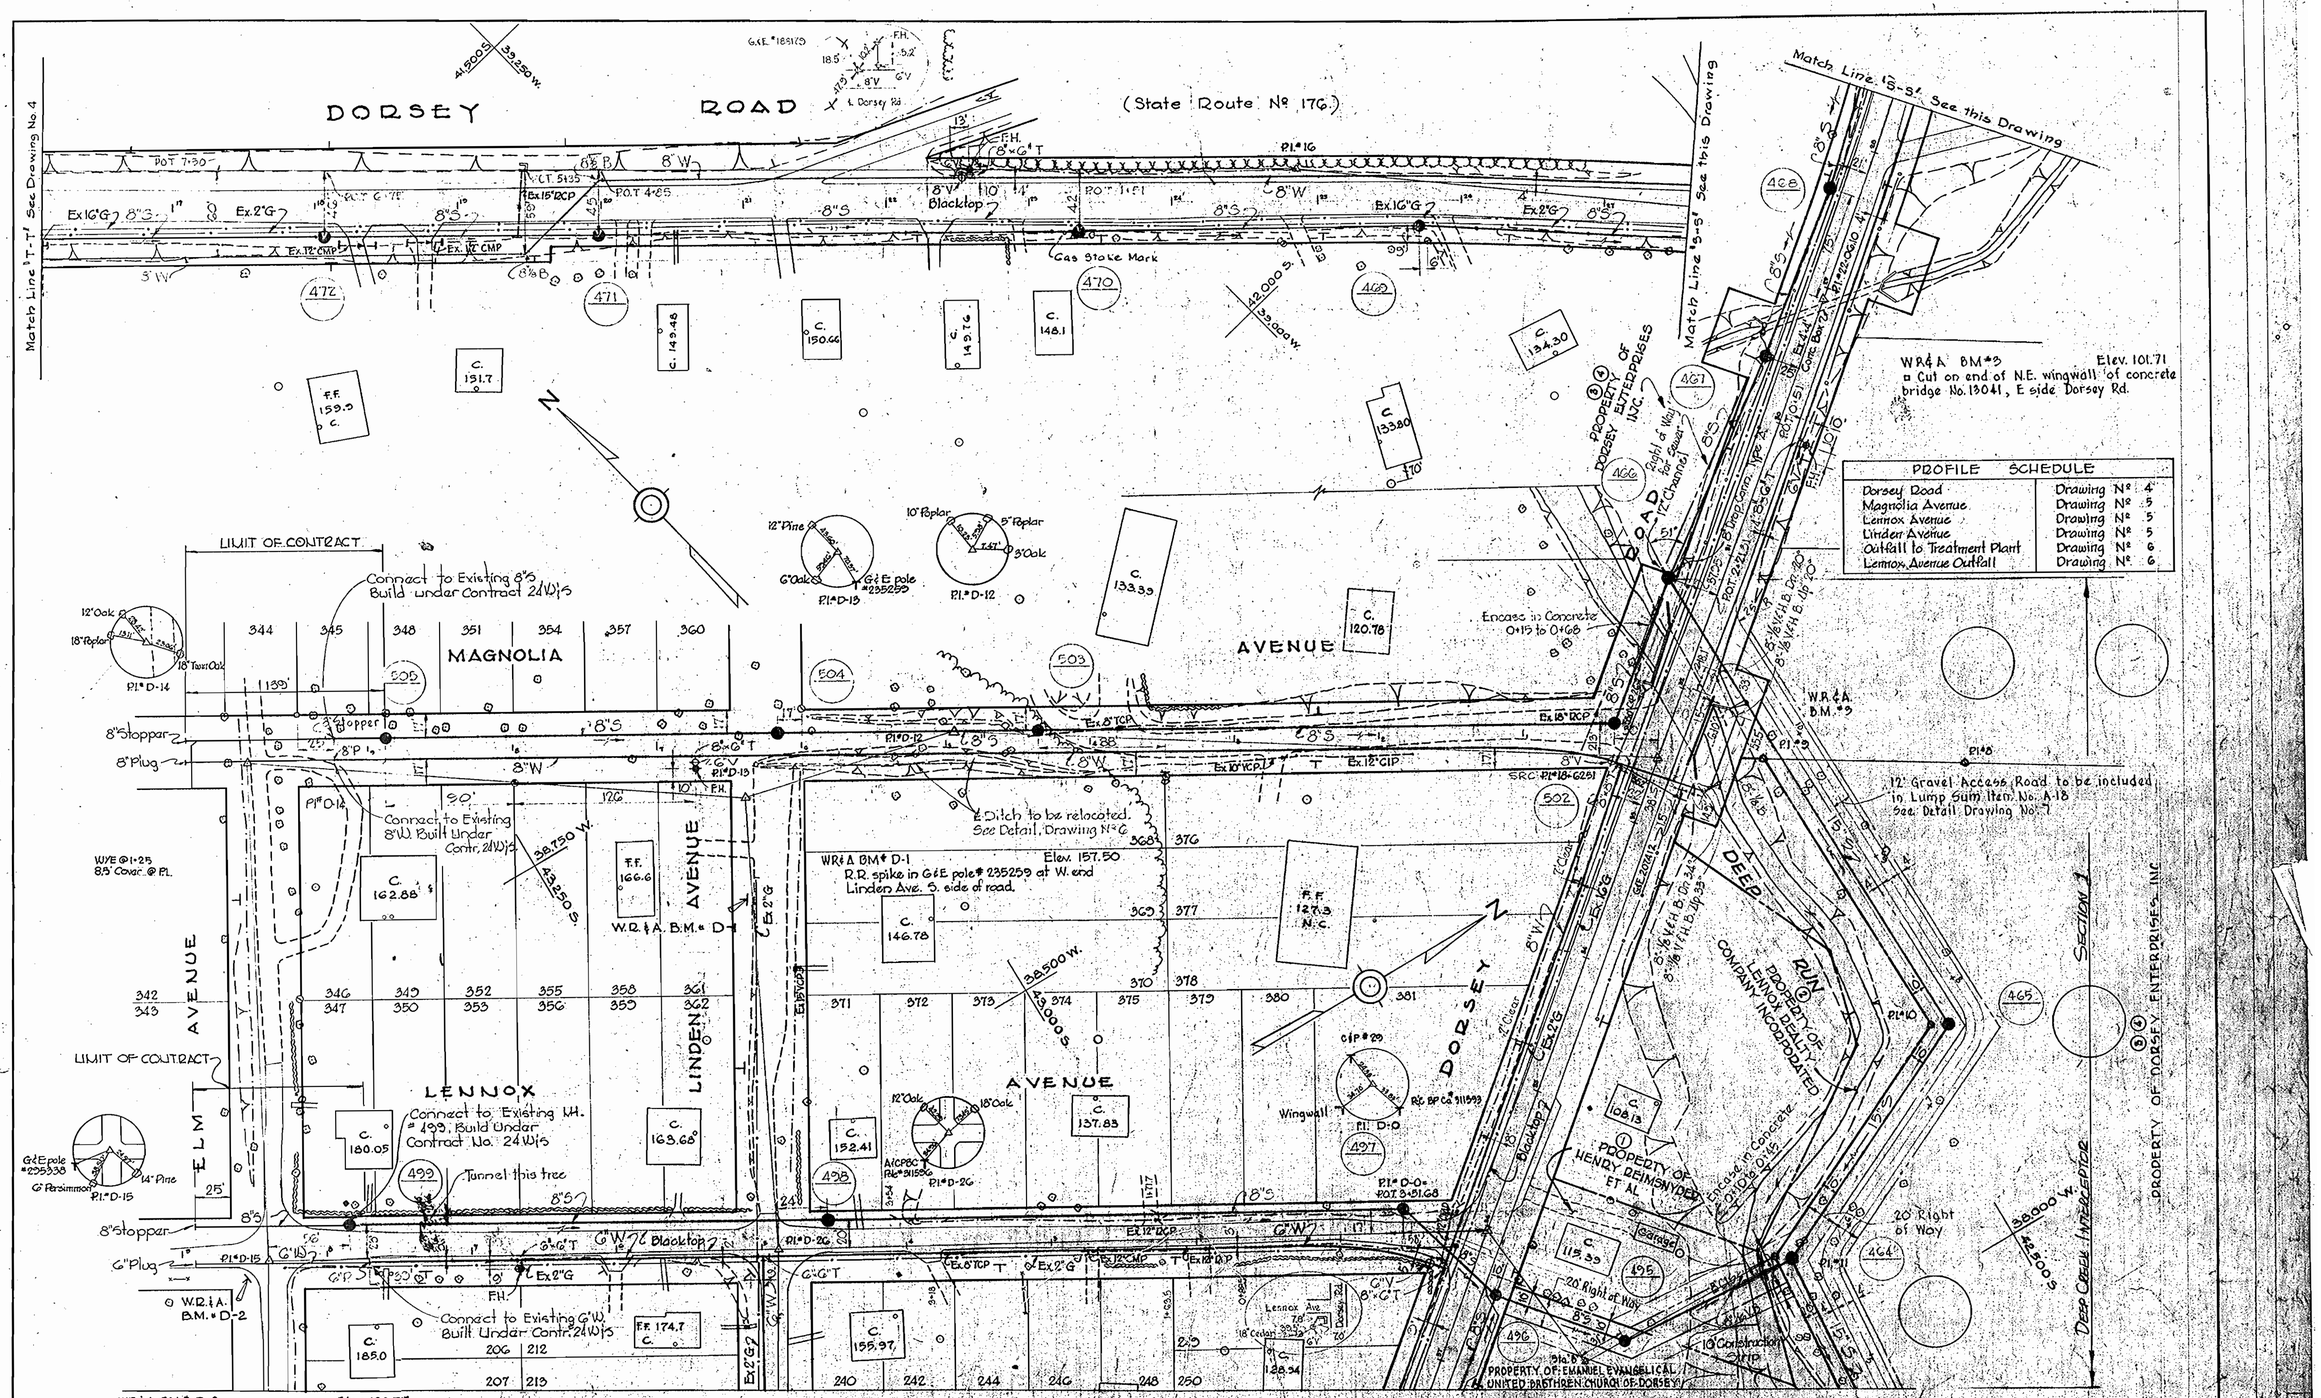

PROFILE SCHEDULE	
Dorsey Road	Drawing Nº 4
Magnolia Avenue	Drawing Nº 5
Lennox Avenue	Drawing Nº 5
Linden Avenue	Drawing Nº 5
Outfall to Treatment Plant	Drawing Nº 6
Lennox Avenue Outfall	Drawing Nº 6

WHITMAN, REQUARDT & ASSOCIATES
ENGINEERS
1304 ST. PAUL ST.
BALTIMORE, MARYLAND

HOWARD COUNTY METROPOLITAN COMMISSION
March 24, 1961 — DATE
CHIEF ENGINEER

CONTRACT NO. 335W/S

PLAN OF WATER & SEWER MAINS

DORSEY SUB-DISTRICT

DRAWING NO. — OF 12

SCALE 1" = 50'

W. O. 4918-2

AS BUILT Aug. 31, 1971

335 W-S/1

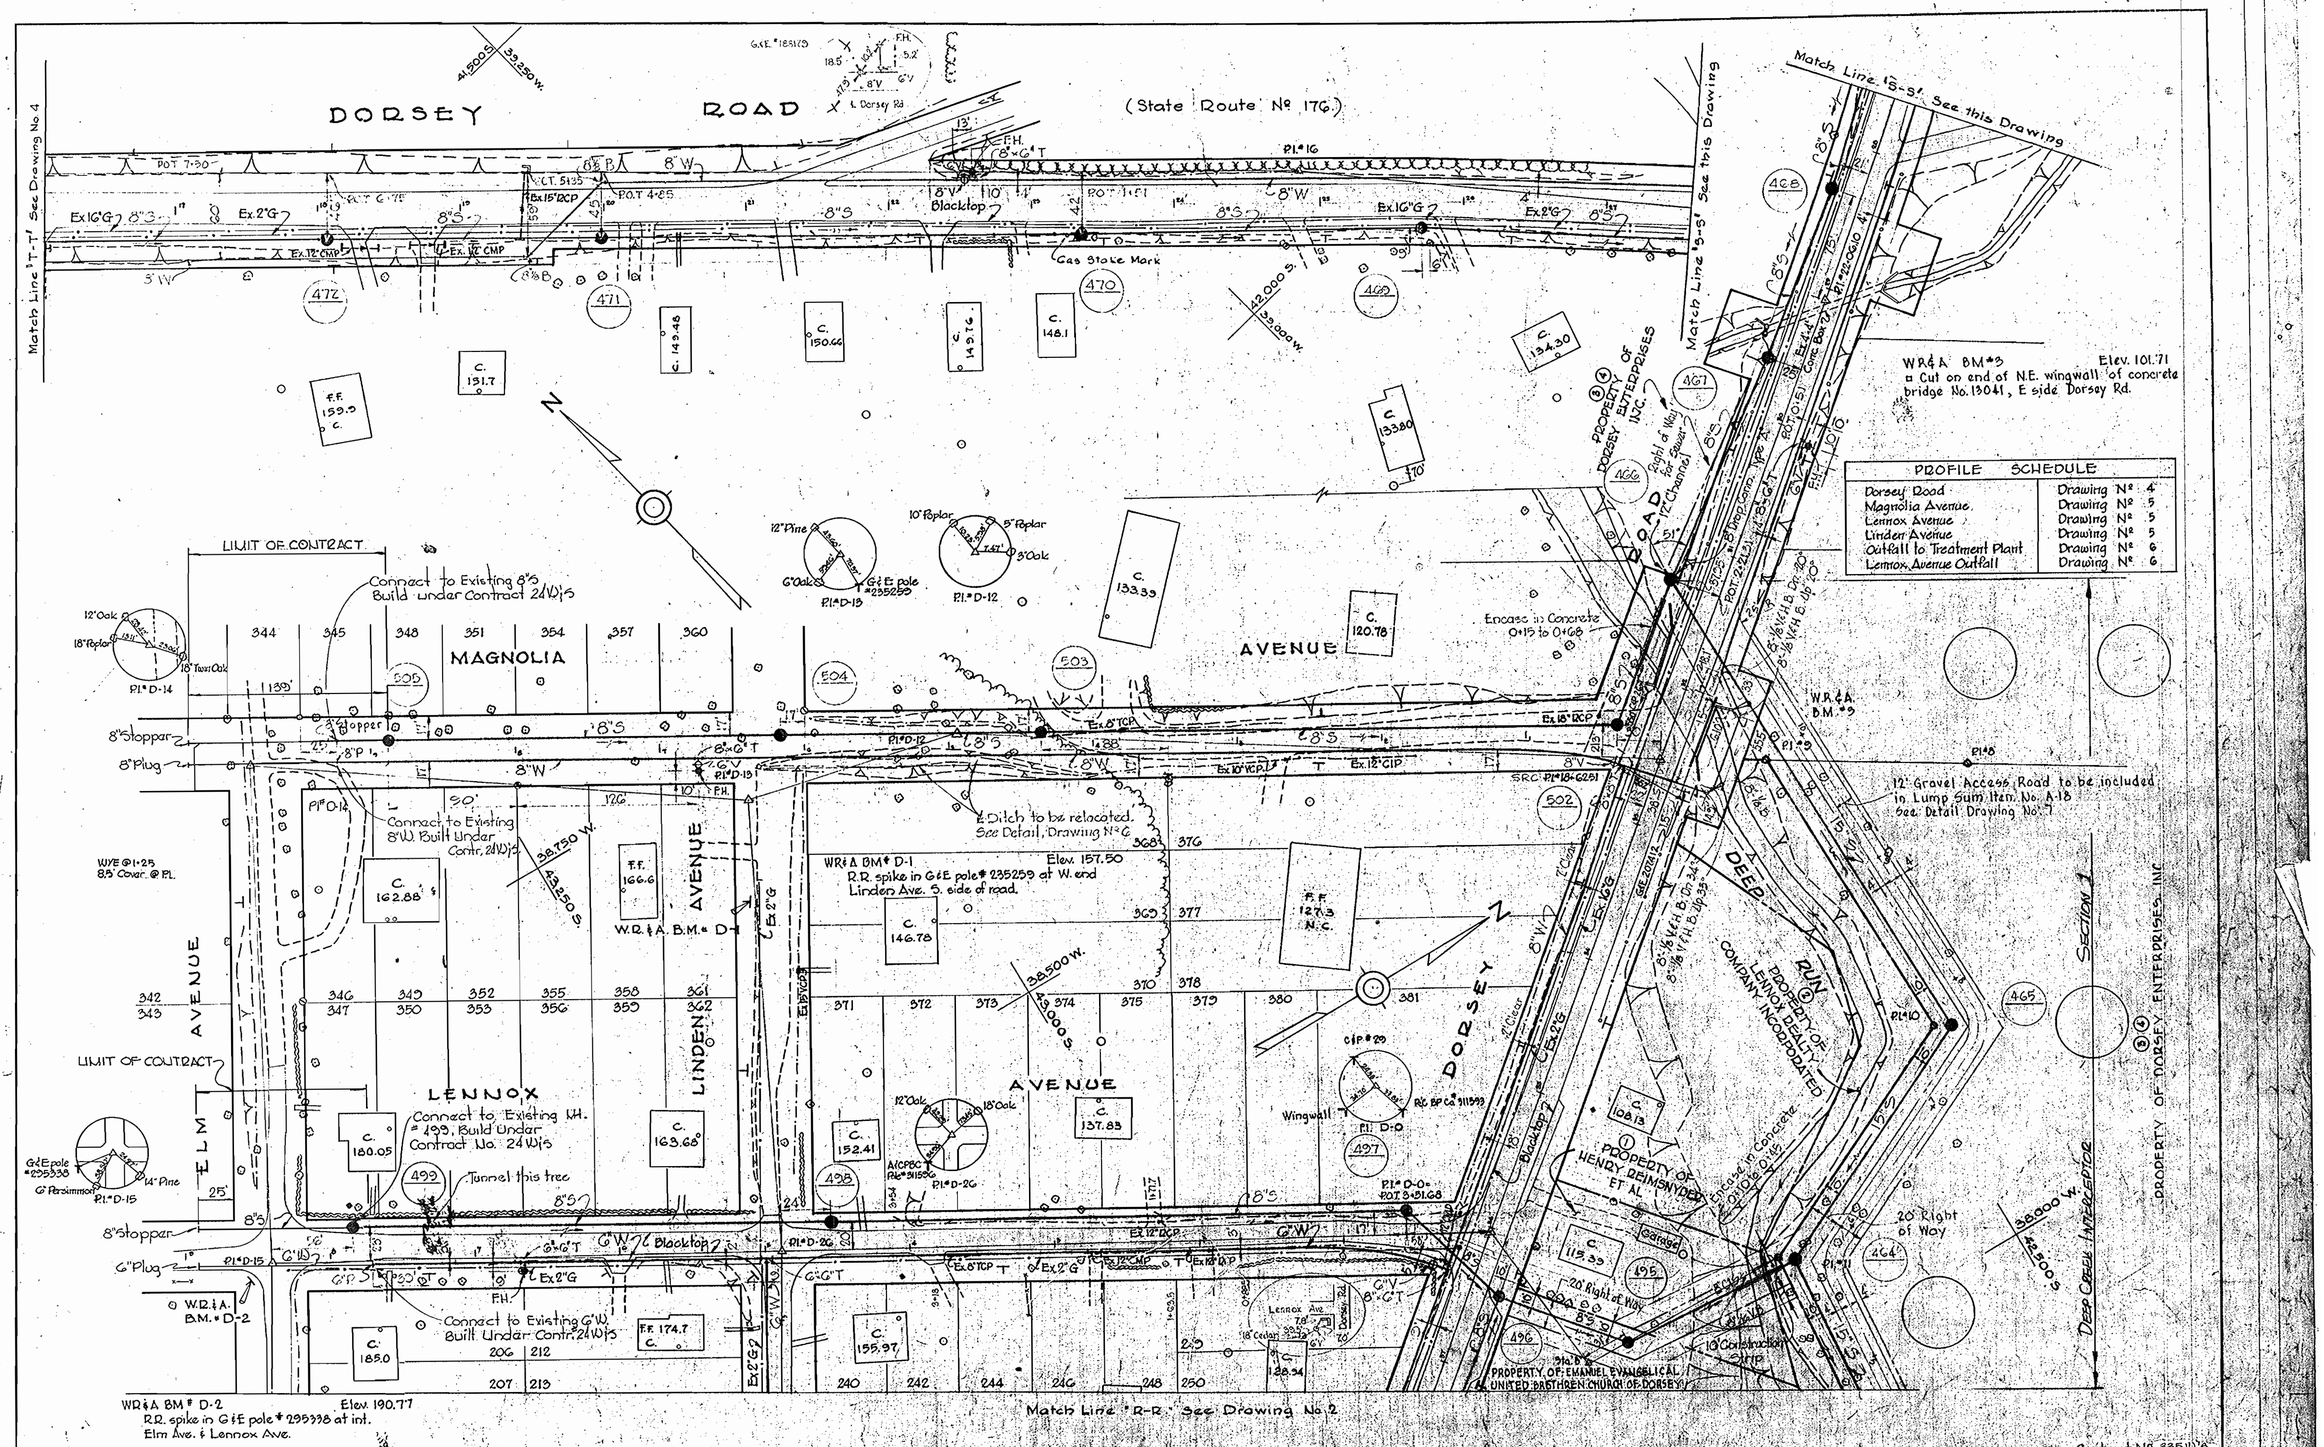

PROFILE SCHEDULE	
Dorsey Road	Drawing Nº 4
Magnolia Avenue	Drawing Nº 5
Lennox Avenue	Drawing Nº 5
Linden Avenue	Drawing Nº 5
Outfall to Treatment Plant	Drawing Nº 6
Lennox Avenue Outfall	Drawing Nº 6

WHITMAN, REQUARDT & ASSOCIATES ENGINEERS 1304 ST. PAUL ST. BALTIMORE, MARYLAND	HOWARD COUNTY METROPOLITAN COMMISSION March 24, 1961 DATE — Carl W. Rieger CHIEF ENGINEER	CONTRACT NO. 335W/S	PLAN OF WATER & SEWER MAINS	DORSEY SUB-DISTRICT	DRAWING NO. 1 OF 12 — SCALE 1" = 50'

W. O. 4918-2

335 W-S/1