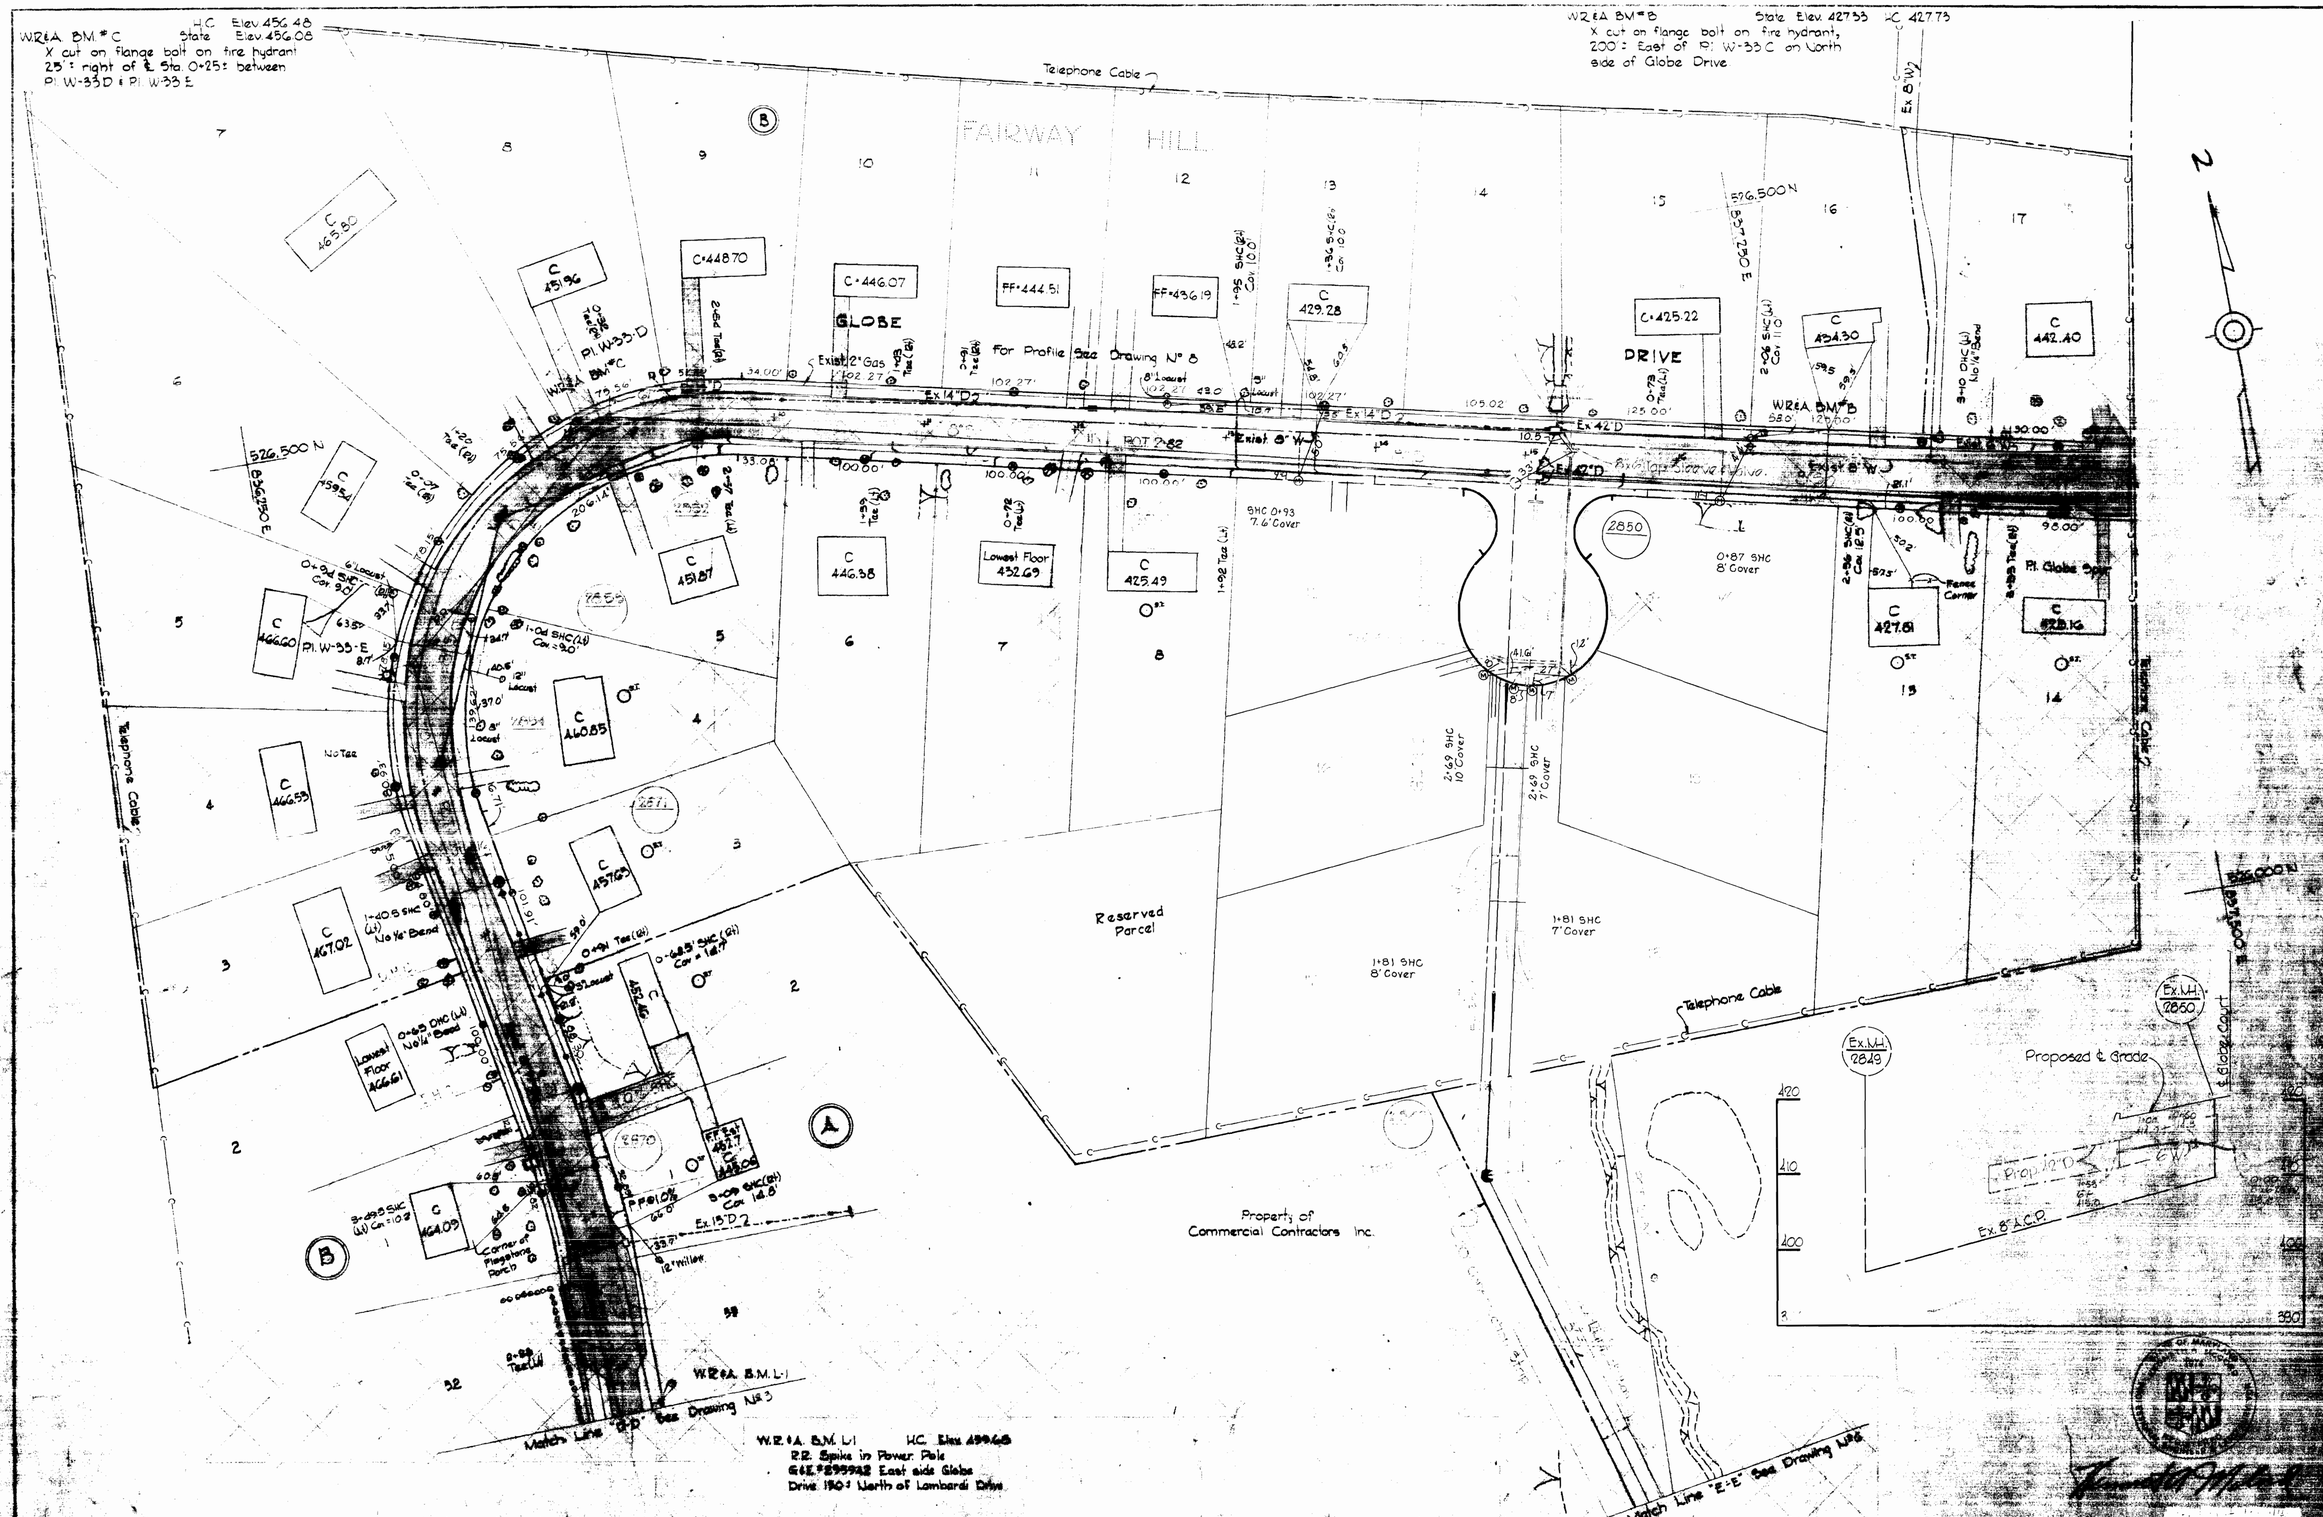

WHITMAN, REQUARDT & ASSOCIATES ENGINEERS 1304 ST. PAUL ST. BALTIMORE, MARYLAND	HOWARD COUNTY METROPOLITAN COMMISSION 6-8-68 DATE W. O. Fallert CHIEF ENGINEER	CONTRACT NO.	PLAN OF SEWER MAINS	CLAYBURN HILLS, PINE ORCHARD, FAIRWAY HILLS ELECTION DISTRICT-ELLICOTT CITY NO. 2	DRAWING NO.	SCALE

W.O. 5899-2