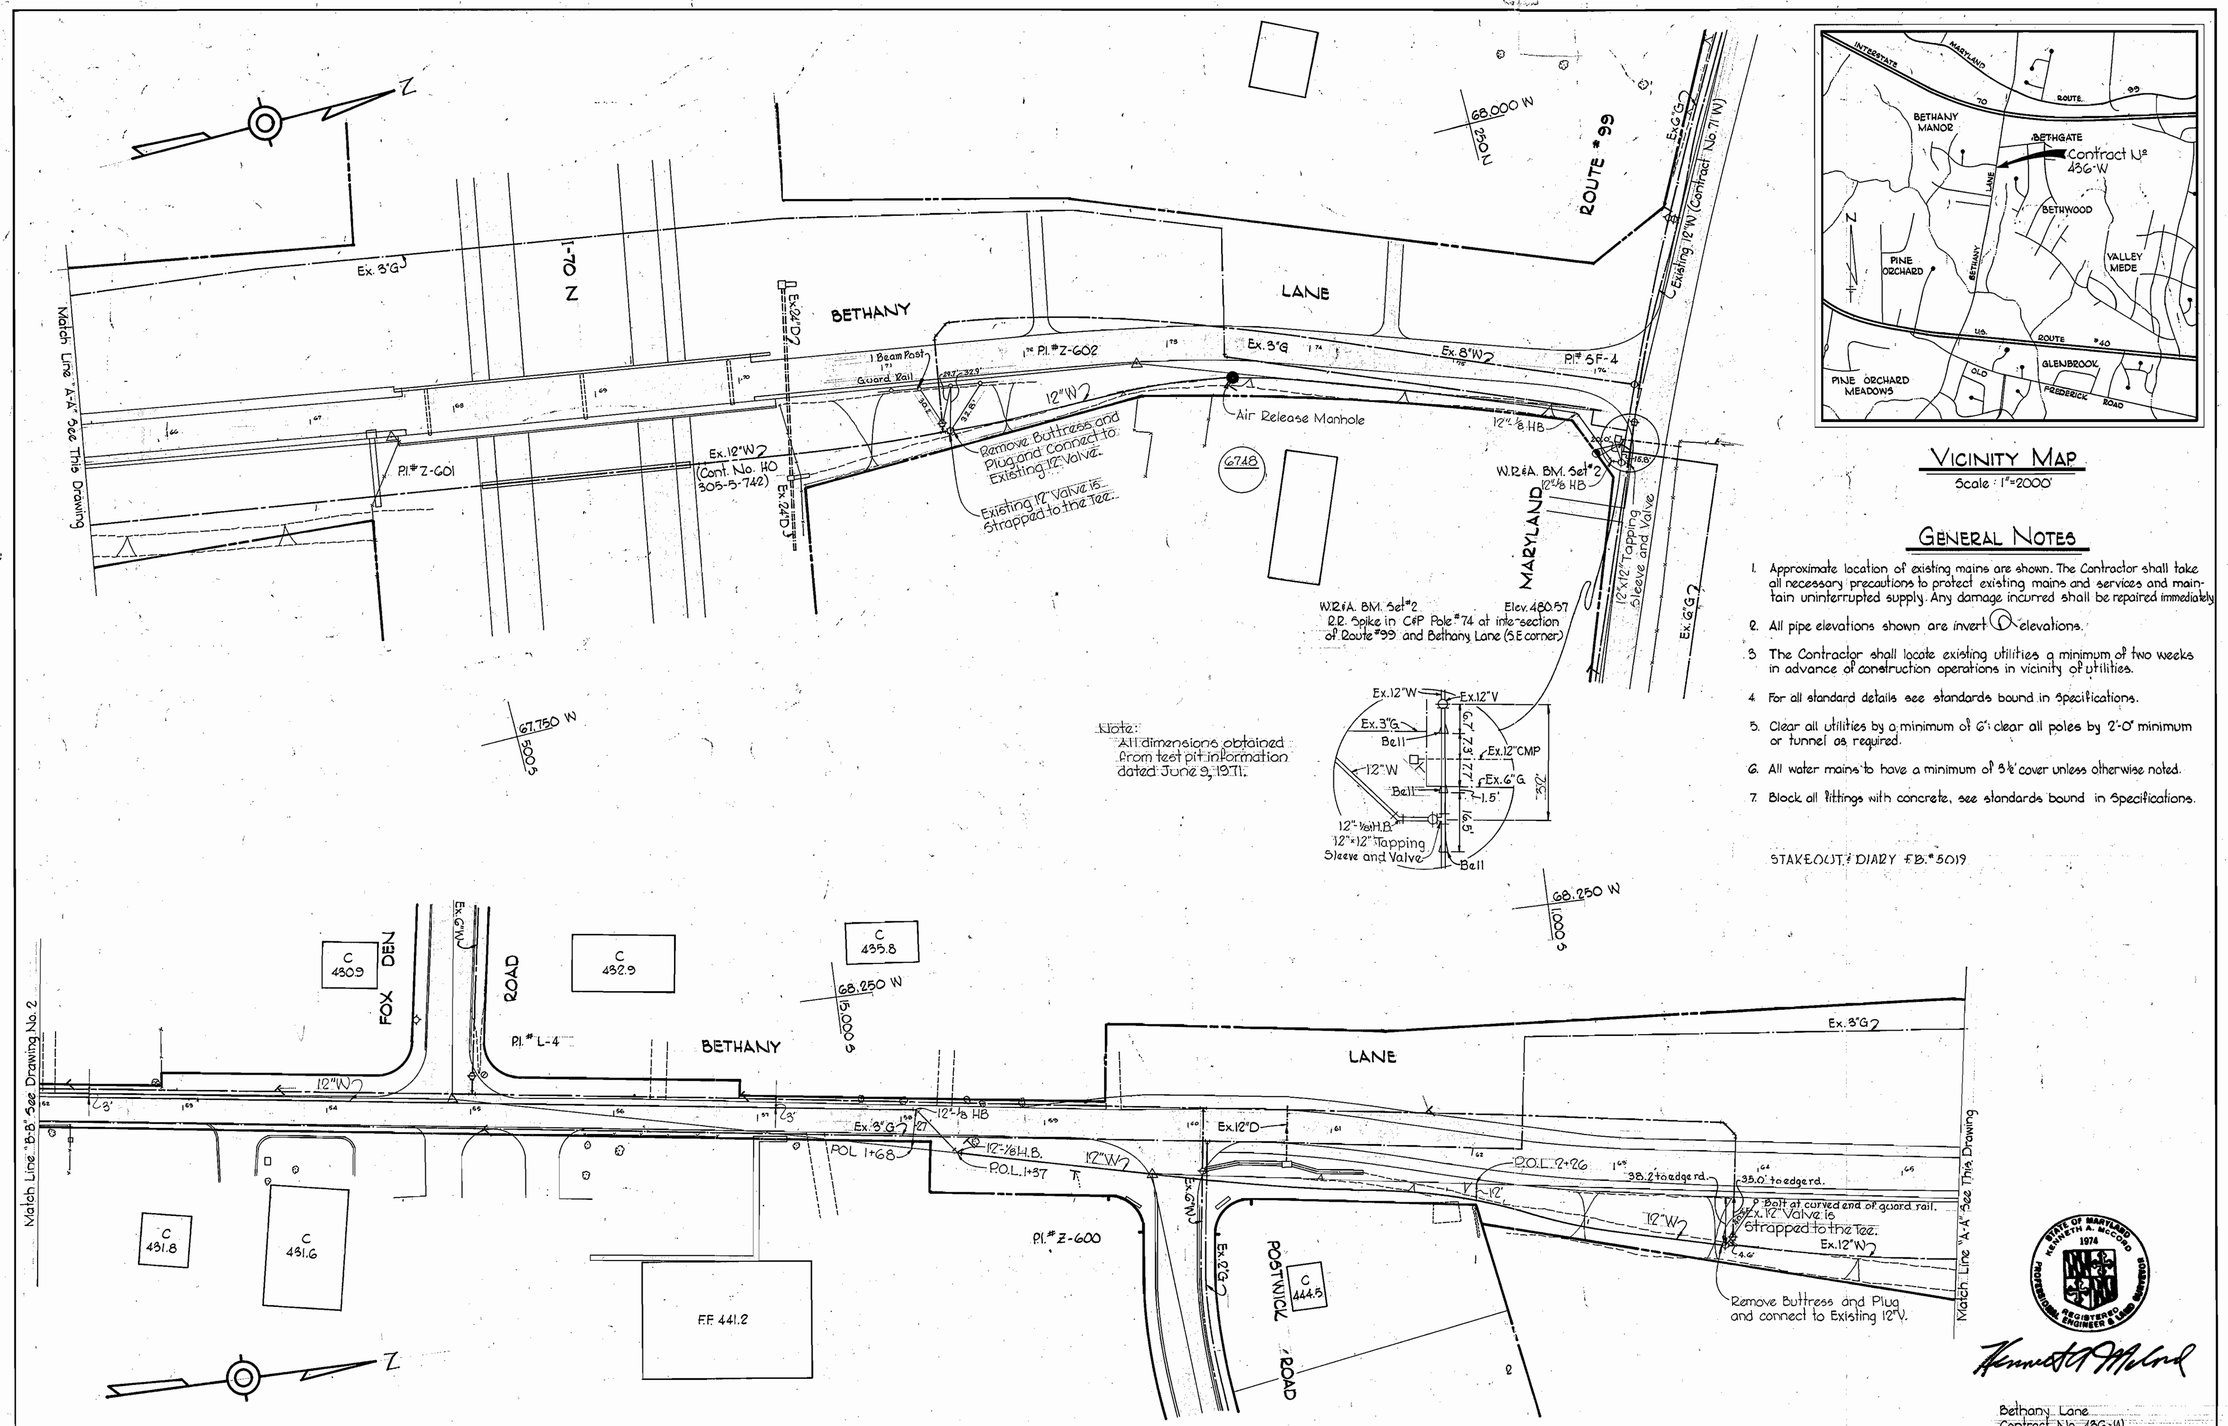

VICINITY MAP

Scale: 1"=2000'

GENERAL NOTES

1. Approximate location of existing mains are shown. The Contractor shall take all necessary precautions to protect existing mains and services and maintain uninterrupted supply. Any damage incurred shall be repaired immediately.
2. All pipe elevations shown are invert ⓘ elevations.
3. The Contractor shall locate existing utilities a minimum of two weeks in advance of construction operations in vicinity of utilities.
4. For all standard details see standards bound in Specifications.
5. Clear all utilities by a minimum of 6" clear all poles by 2'-0" minimum or tunnel as required.
6. All water mains to have a minimum of 3½' cover unless otherwise noted.
7. Block all fittings with concrete, see standards bound in Specifications.

STAKEOUT: DIARY F.B.# 5019

STATE OF MARYLAND
KENNETH A. McCORD
1974
PROFESSIONAL REGISTERED ENGINEER & LAND SURVEYOR

Kenneth A. McCord

Bethany Lane
Contract No. 436-W

WHITMAN, REQUARDT & ASSOCIATES ENGINEERS 1304 ST. PAUL ST. BALTIMORE, MARYLAND	DEPARTMENT OF PUBLIC WORKS HOWARD COUNTY, MARYLAND 6-11-71 DATE — W O Fulbert CHIEF -BUREAU OF WATER AND SEWER	CONTRACT NO. 436-W	PLAN OF WATER MAINS	ELECTION DISTRICT ELLICOTT CITY NO. 2	DRAWING NO. 1 OF 5	SCALE 1"=50'

W. O. 6508

F.B.# 4960, 4984
AS BUILT 21 OCTOBER 1971

2 SW 46
1 SW 46
1 NW 46

WS 436-W/1

BRUNING 44-510 14/12

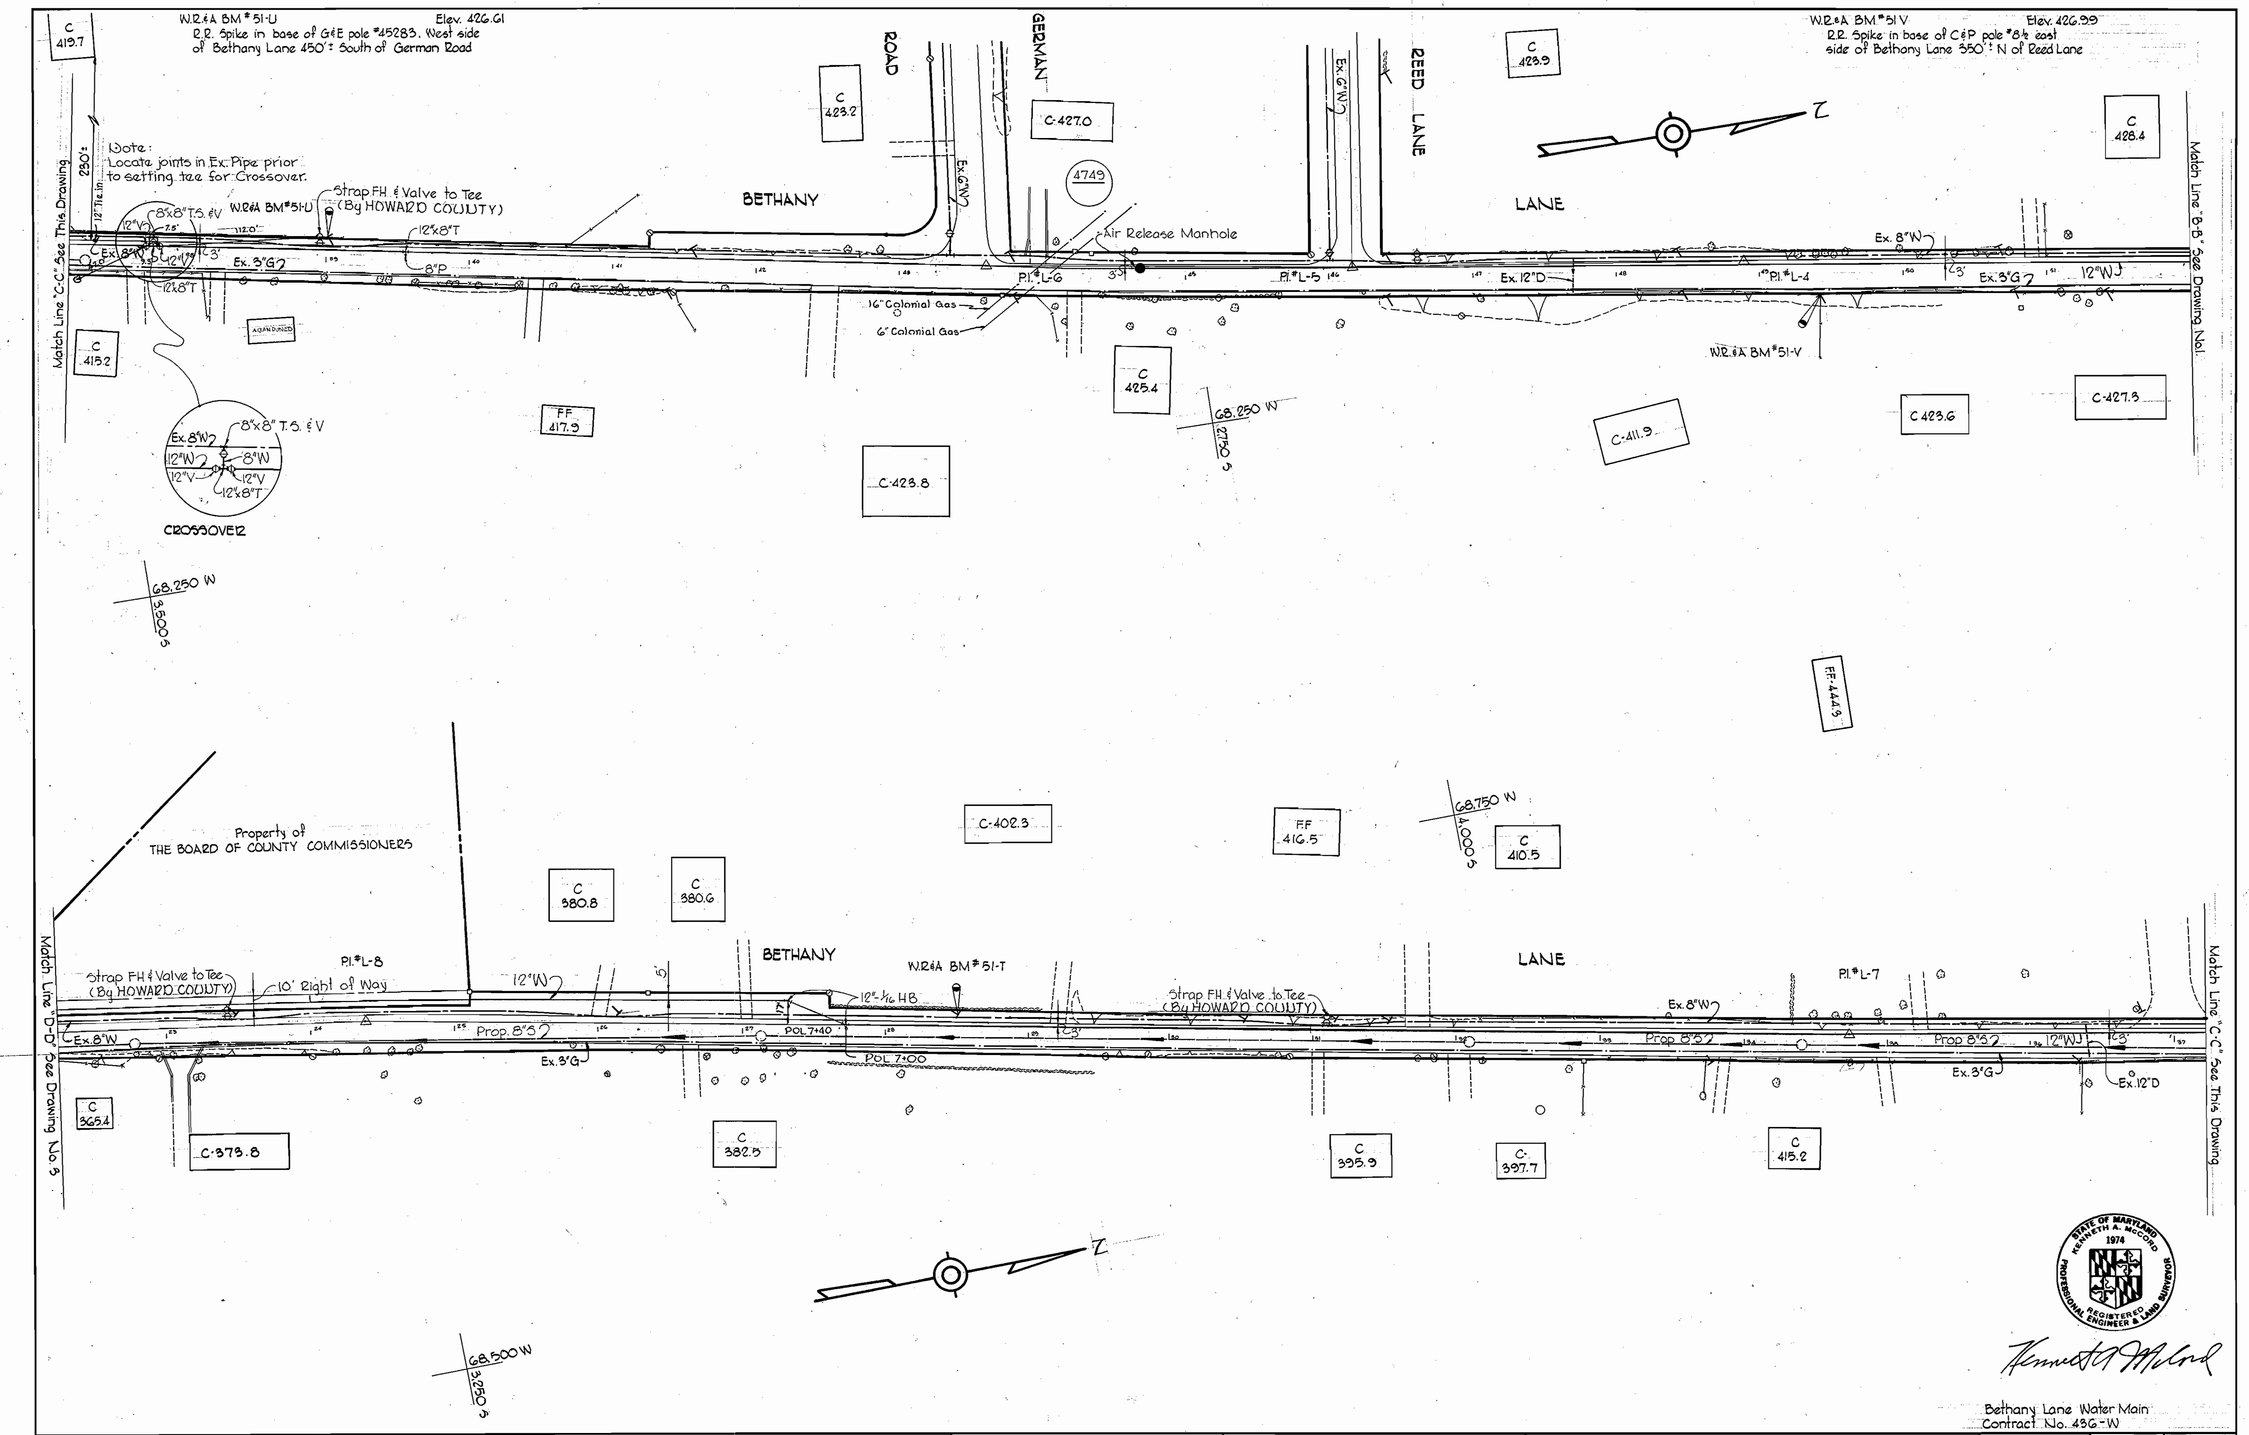

WHITMAN, REQUARDT & ASSOCIATES ENGINEERS 1304 ST. PAUL ST. BALTIMORE, MARYLAND	DEPARTMENT OF PUBLIC WORKS HOWARD COUNTY, MARYLAND 6-11-71 DATE — CHIEF-BUREAU OF WATER AND SEWER	CONTRACT NO. 436-W	PLAN OF WATER MAINS	ELECTION DISTRICT ELLICOTT CITY NO. 2	DRAWING NO. 2 OF 5	SCALE 1"=50'

W.O. 6508-2

F.B. #1960, 4984

AS BUILT 21 OCTOBER 1971

WS 436-W/2

DRUNING 44-510 14778

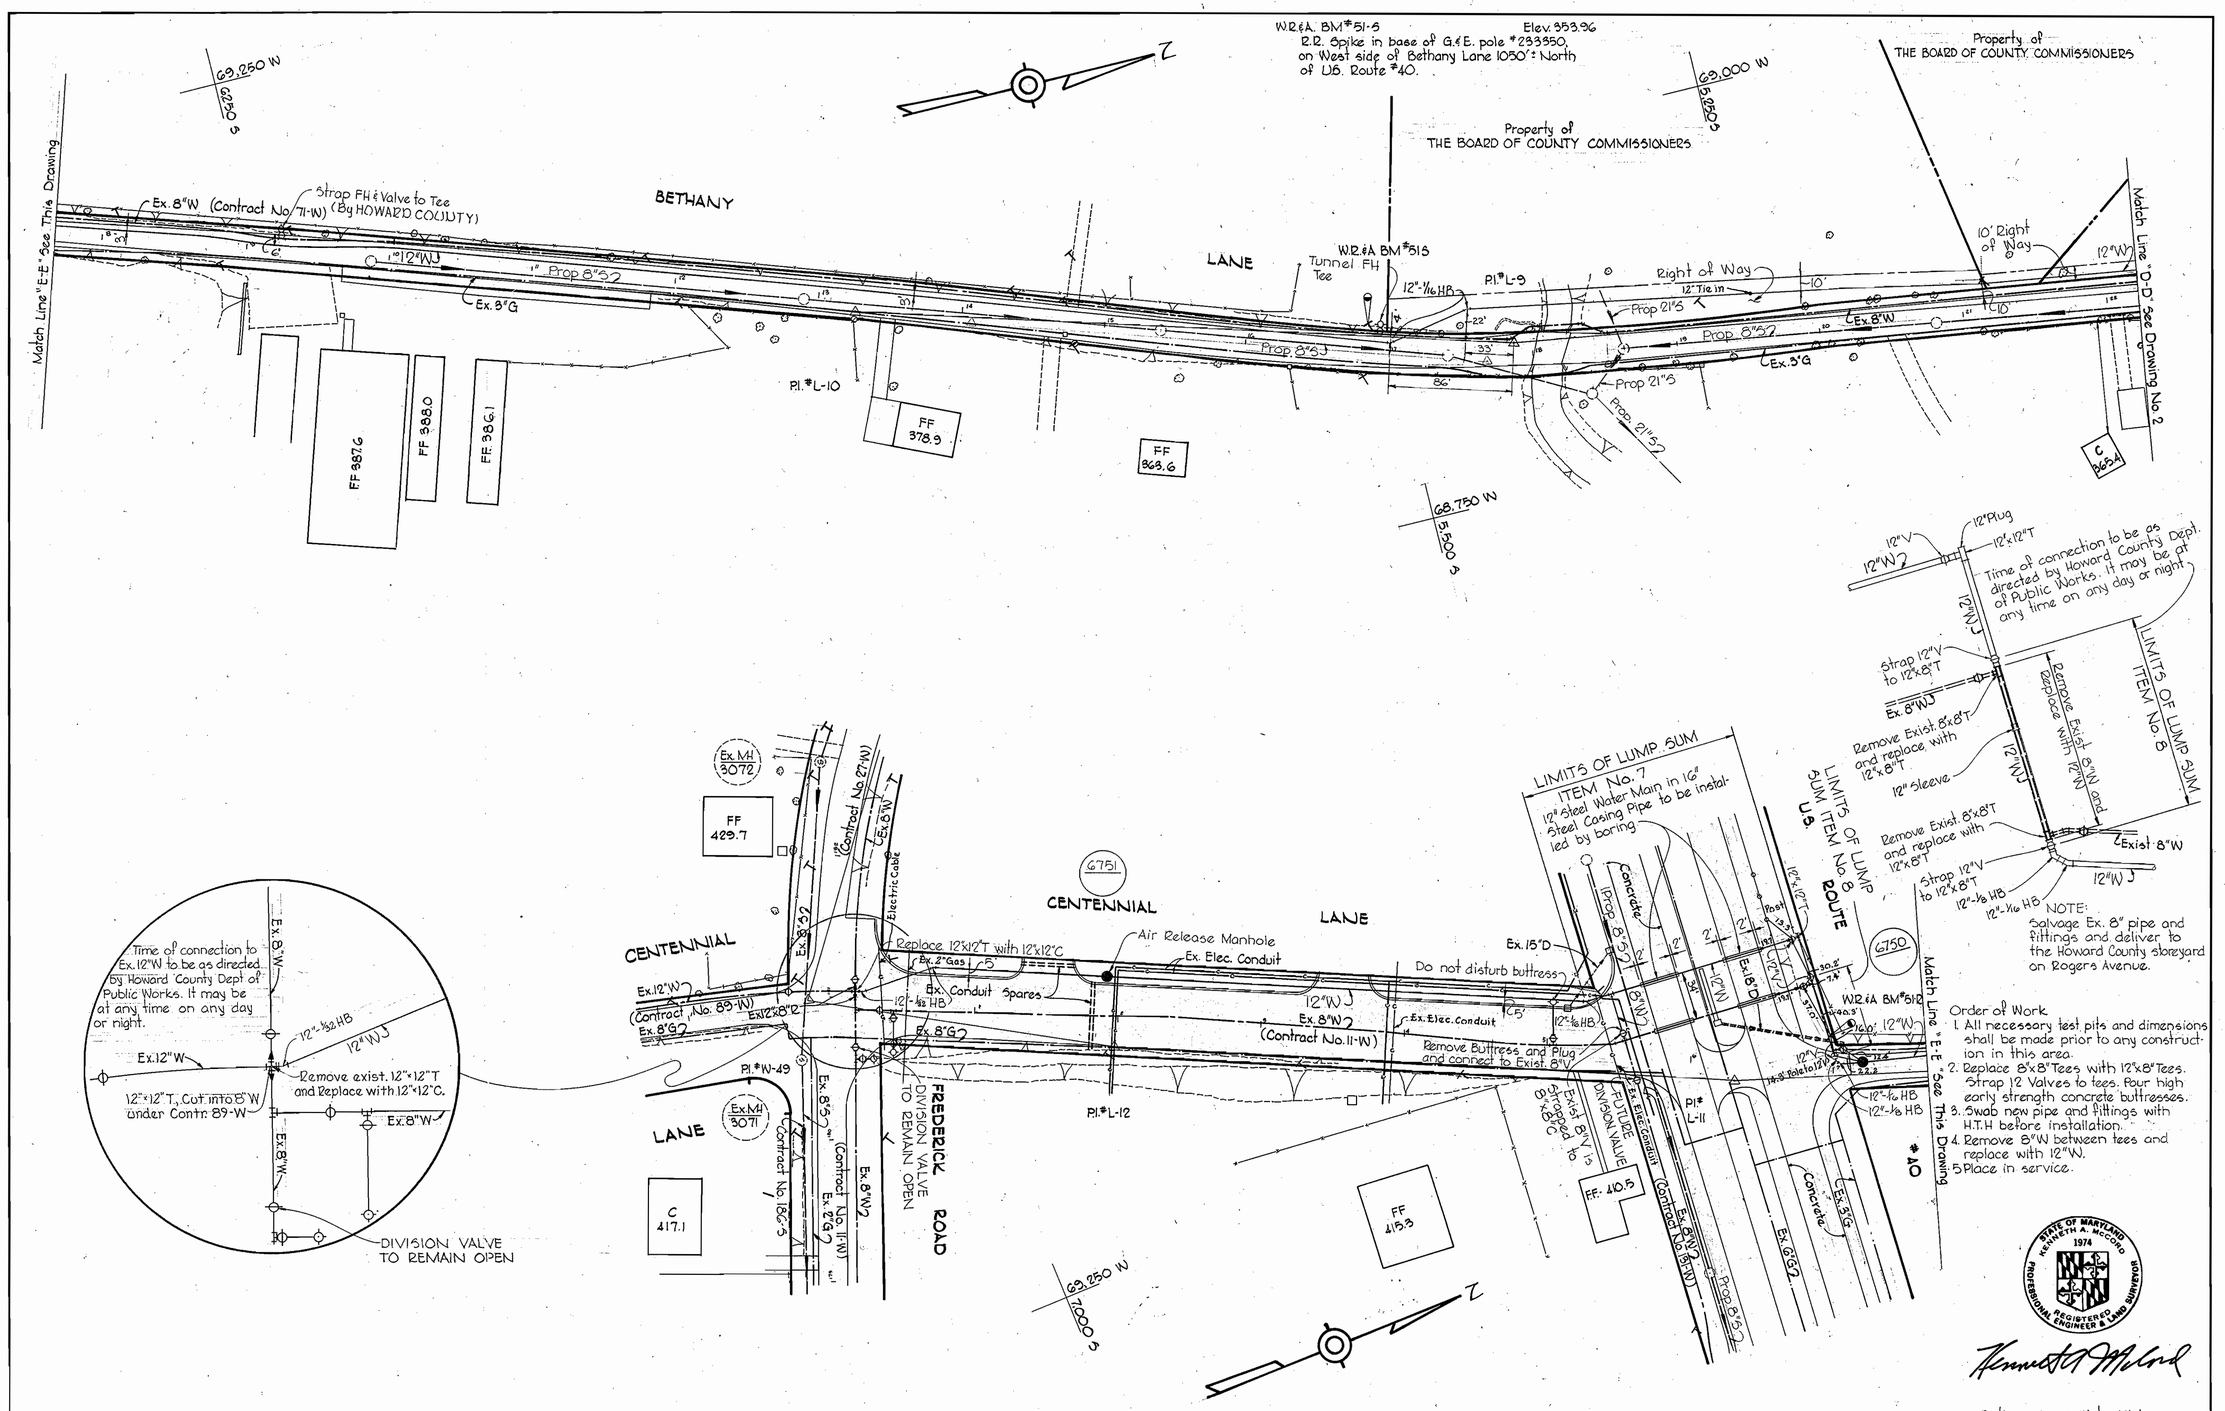

WHITMAN, REQUARDT & ASSOCIATES ENGINEERS 1304 ST. PAUL ST. BALTIMORE, MARYLAND	DEPARTMENT OF PUBLIC WORKS HOWARD COUNTY, MARYLAND 6-11-71 DATE W O Lubert CHIEF - BUREAU OF WATER AND SEWER	CONTRACT NO. 436-W	PLAN OF WATER MAINS	ELECTION DISTRICT ELLICOTT CITY NO. 2	DRAWING NO. 3 OF 5	SCALE 1"=50'	6SW46 6SW47 7SW47 8SW47

W.O. 6508

FB#3827

AS BUILT 21 OCTOBER 1971

WS 436-W/3

BRUNING 44-510 14778

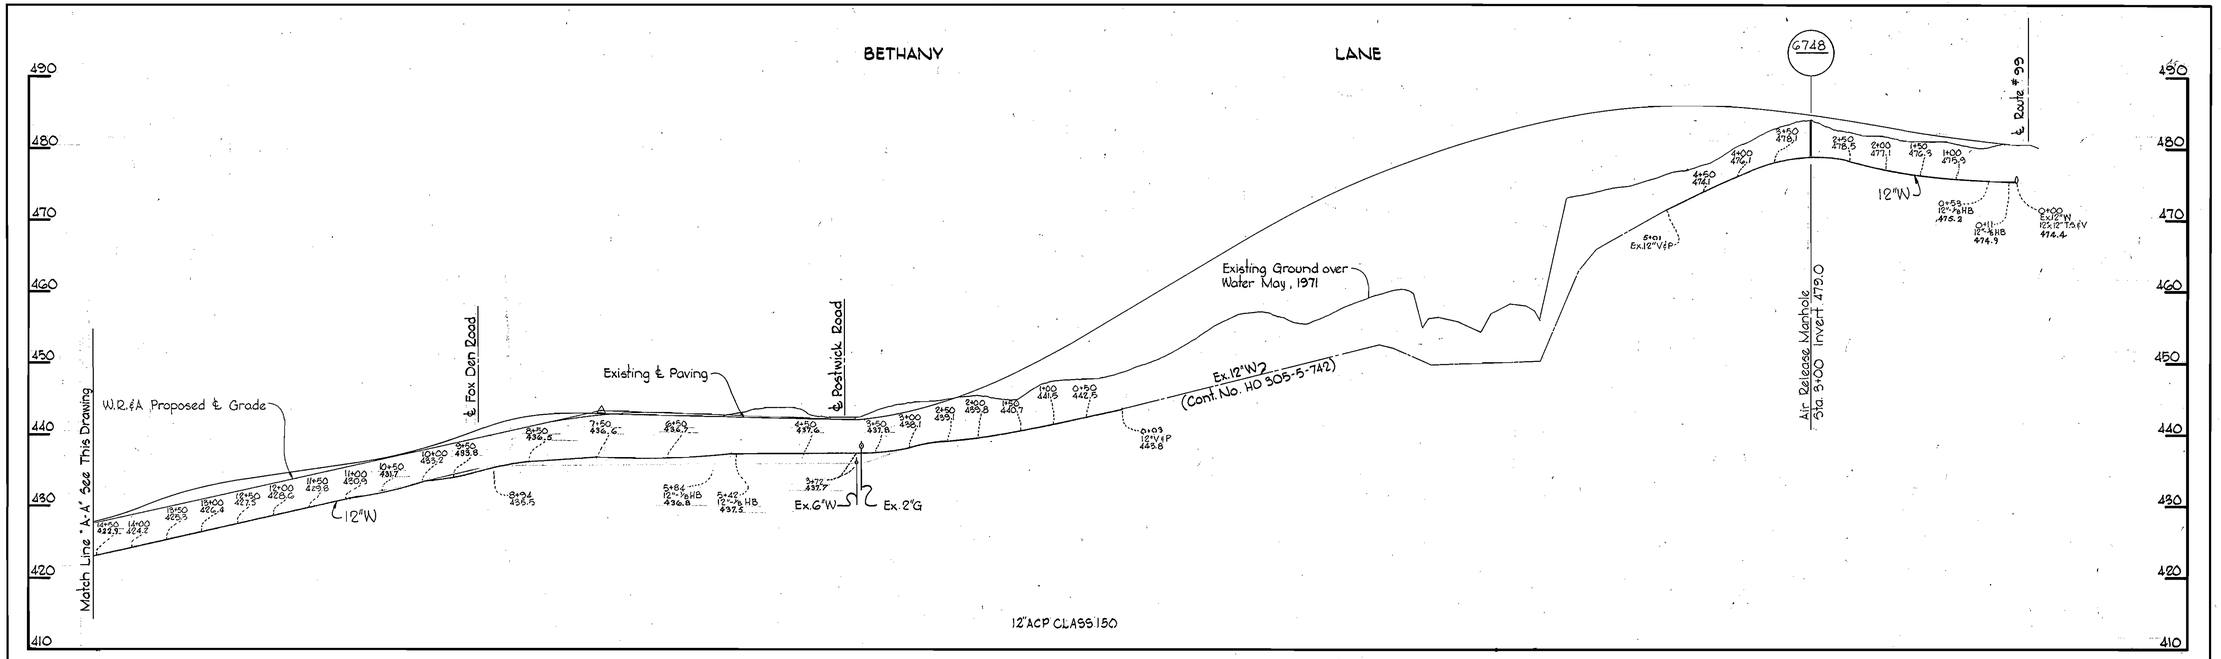

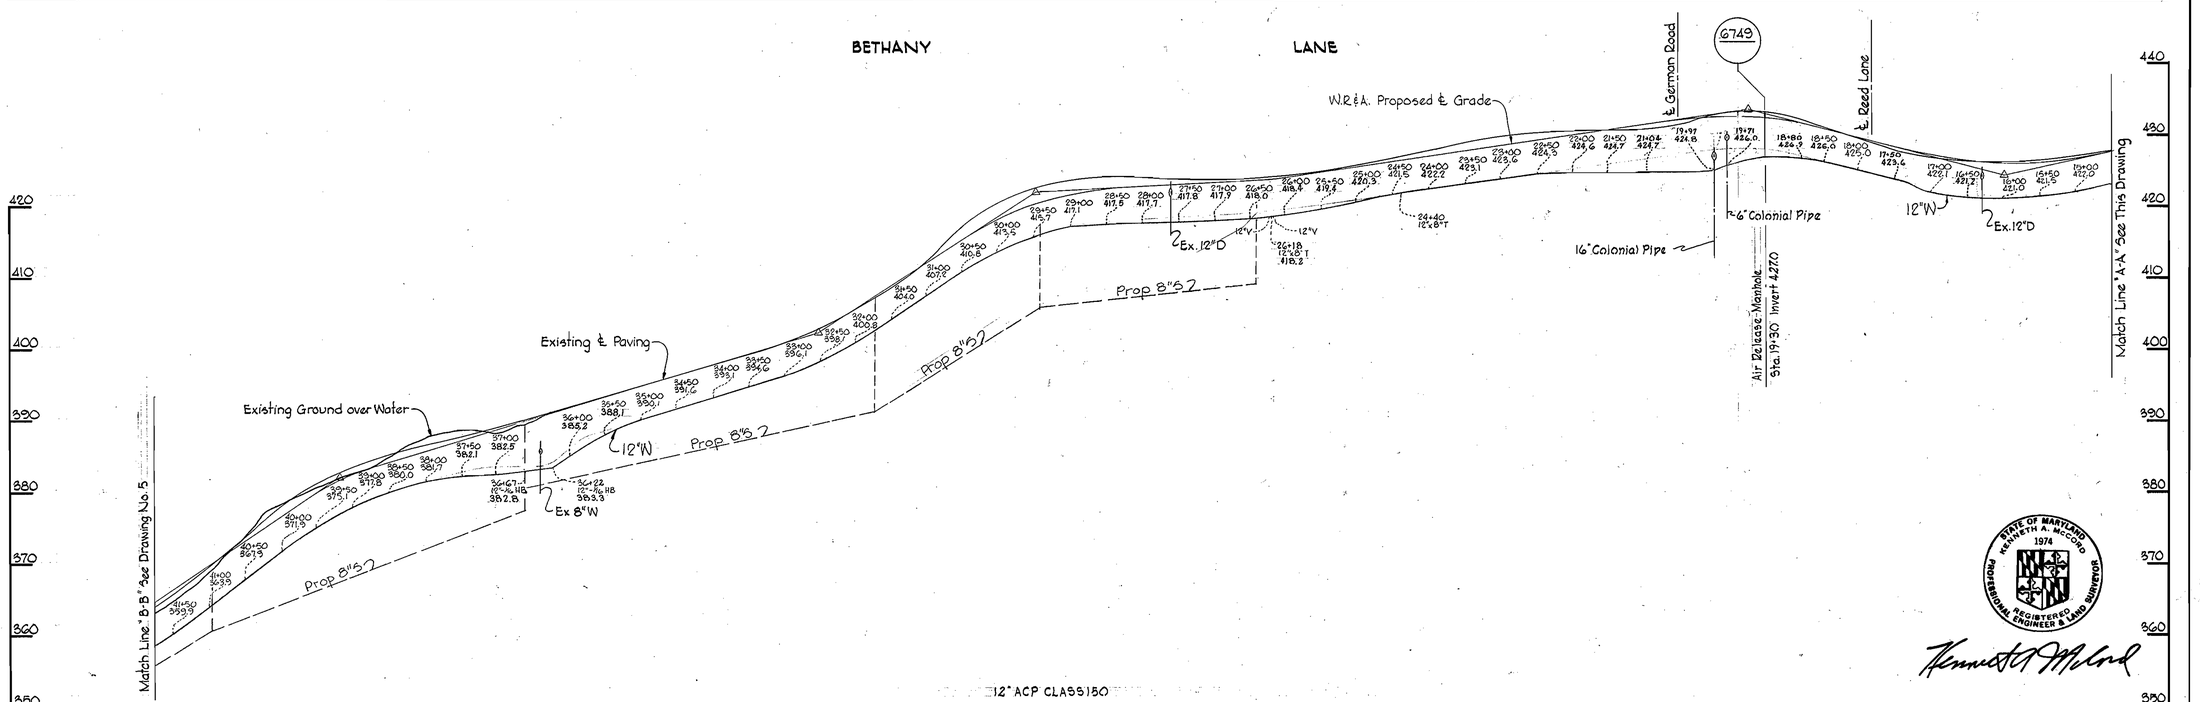

Bethany Lane Water Main
Contract No. 436-W

WHITMAN, REQUARDT & ASSOCIATES ENGINEERS 1304 ST. PAUL ST. BALTIMORE, MARYLAND	DEPARTMENT OF PUBLIC WORKS HOWARD COUNTY, MARYLAND 6-11-71 DATE — CHIEF-BUREAU OF WATER AND SEWER	CONTRACT NO. 436-W	PROFILES OF WATER MAINS	ELECTION DISTRICT ELLICOTT CITY NO. 2	DRAWING NO. 4 OF 5	SCALE H:1"=100' V:1"=10'

W. O. 6508-2

AS BUILT 21 OCTOBER 1971

WS 436-W/4

BRUNING 44-510 14778

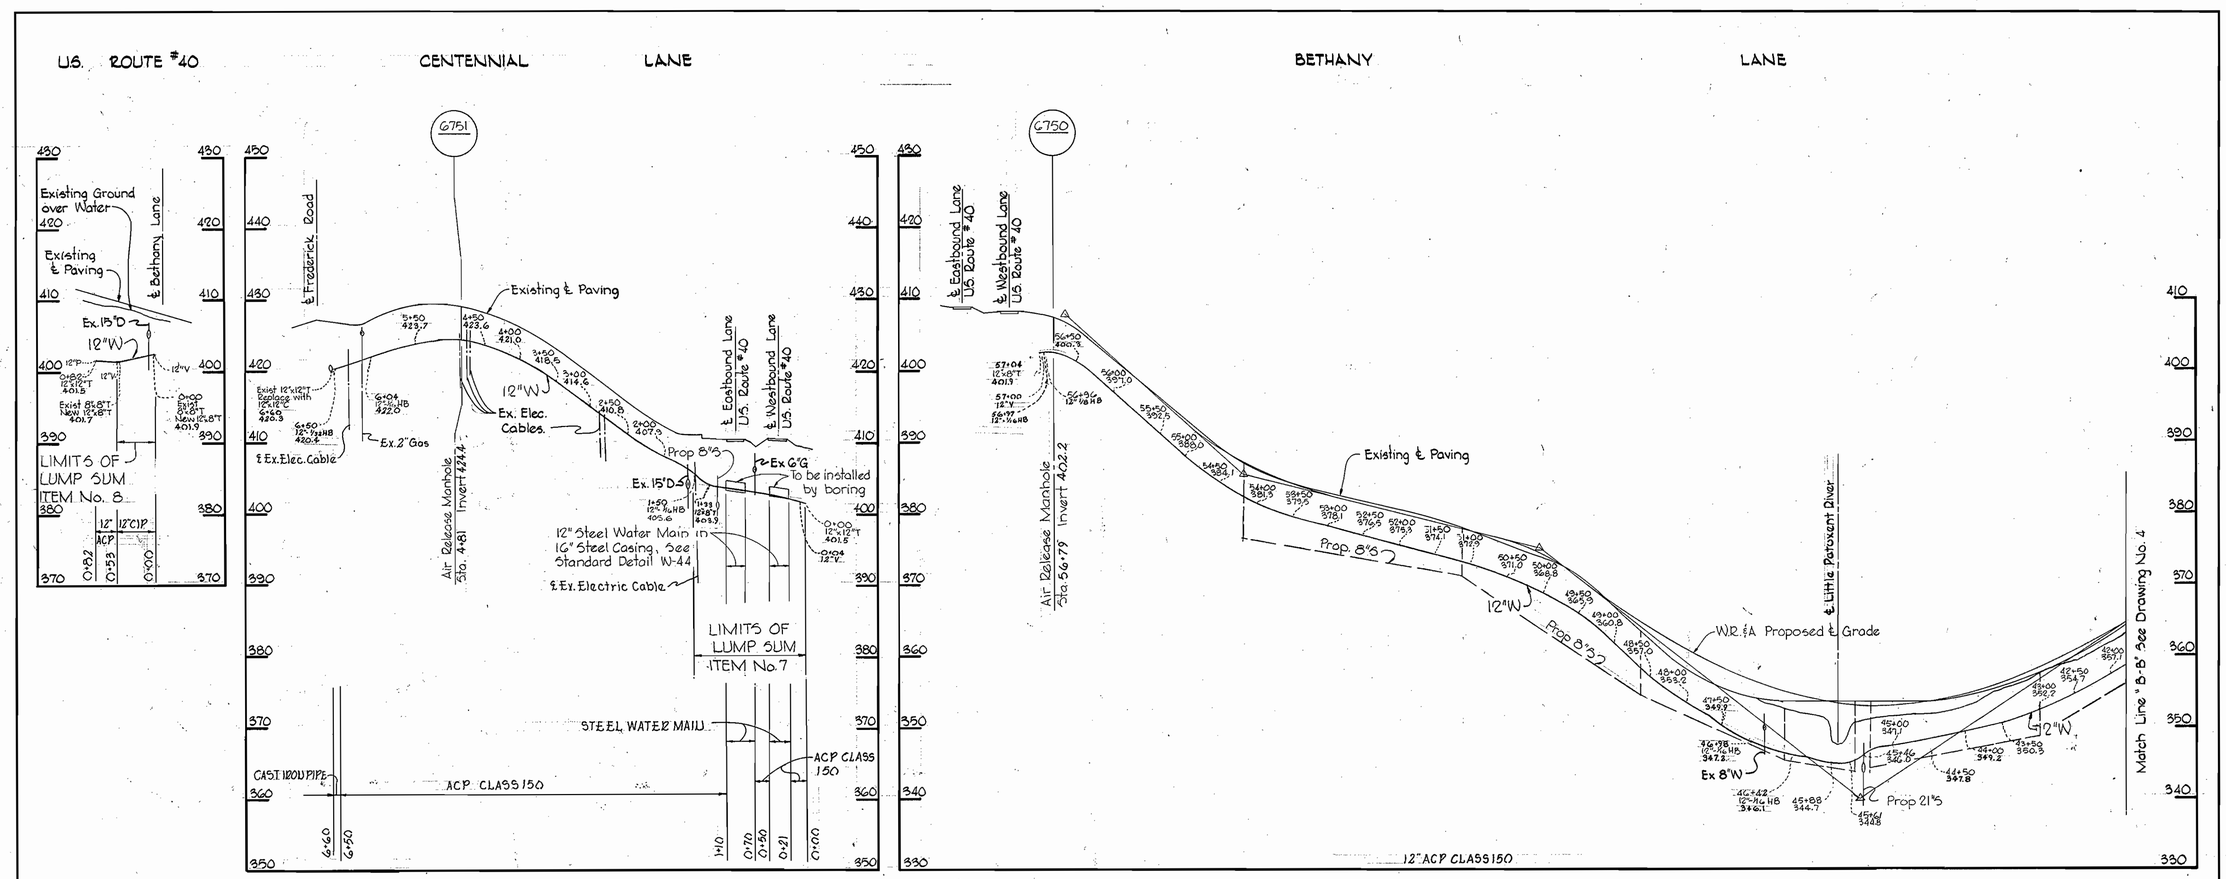

Bethany Lane Water Main
Contract No. 436-W

WHITMAN, REQUARDT & ASSOCIATES ENGINEERS 1304 ST. PAUL ST. BALTIMORE, MARYLAND	DEPARTMENT OF PUBLIC WORKS HOWARD COUNTY, MARYLAND 6-11-71 DATE W O Filbert CHIEF - BUREAU OF WATER AND SEWER	CONTRACT NO. 436-W	PROFILES OF WATER MAINS	ELECTION DISTRICT ELLICOTT CITY NO. 2	DRAWING NO. 5 OF 5	SCALE H: 1" = 100' V: 1" = 10'

W. O. 6508-2

AS BUILT 21 OCTOBER 1971

WS 436-W/S

BRUNING 44510 14778