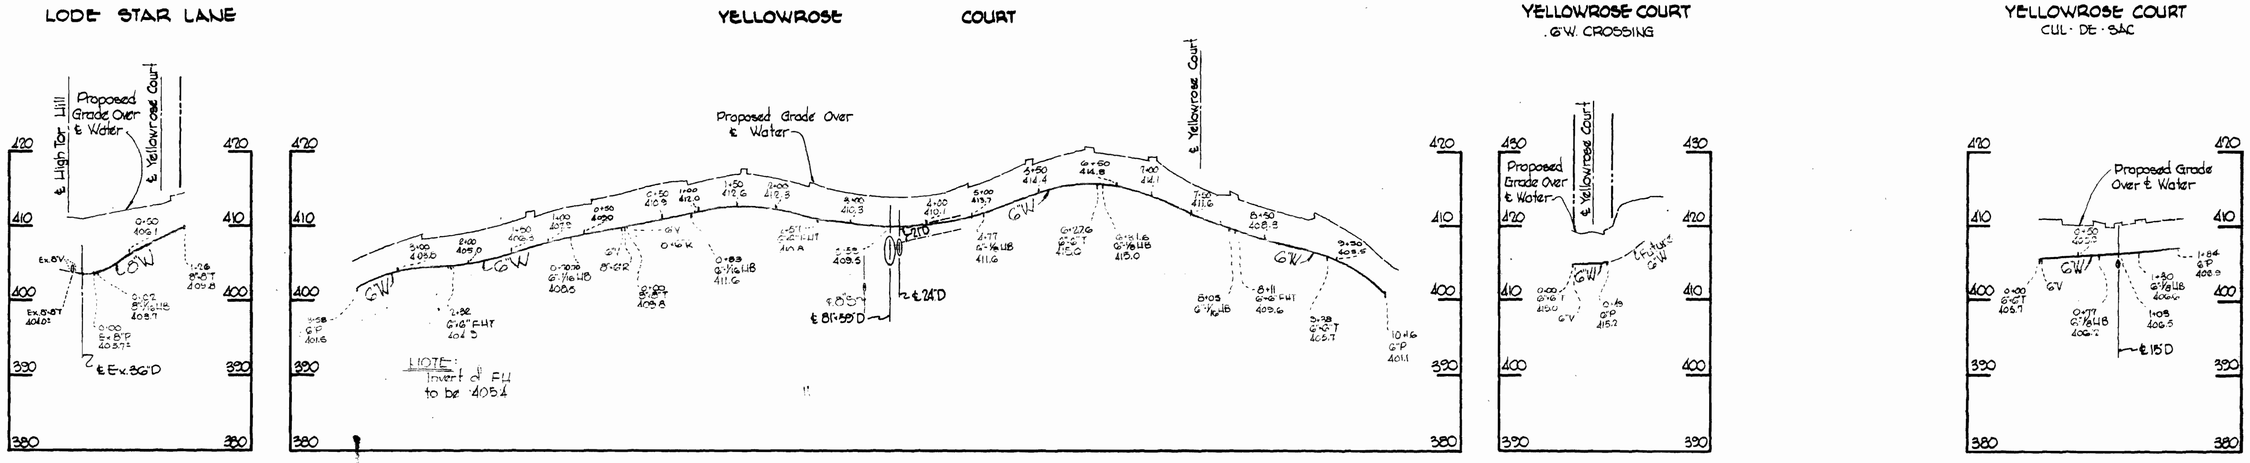

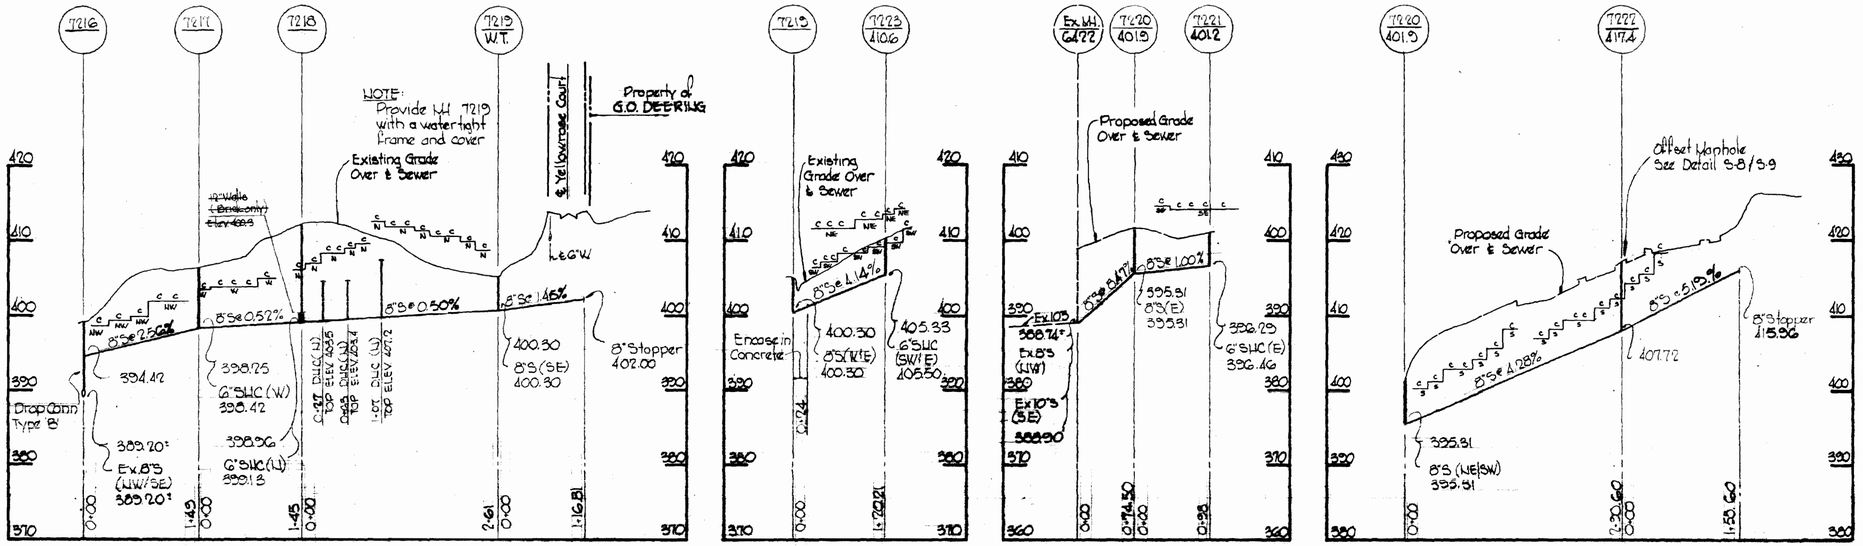

Village of Longreach
Parcel "L"
Section 1, Areal
Contract No. C-7519 W&S

WHITMAN, REQUARDT & ASSOCIATES ENGINEERS 1304 ST. PAUL ST. BALTIMORE, MARYLAND	DEPARTMENT OF PUBLIC WORKS HOWARD COUNTY, MARYLAND 2-22-73 DATE — CHIEF-BUREAU OF ENGINEERING	CONTRACT NO. C-7519 W&S	PROFILES OF WATER AND SEWER MAINS	COLUMBIA VILLAGE OF LONGREACH ELECTION DISTRICT GUILFORD NO. 6	DRAWING NO. 2 OF 2	SCALE H: 1" = 100' V: 1" = 10'

W. O. 6022-2

MARCH 11, 1974 AS BUILT

WS 519-W&S/2

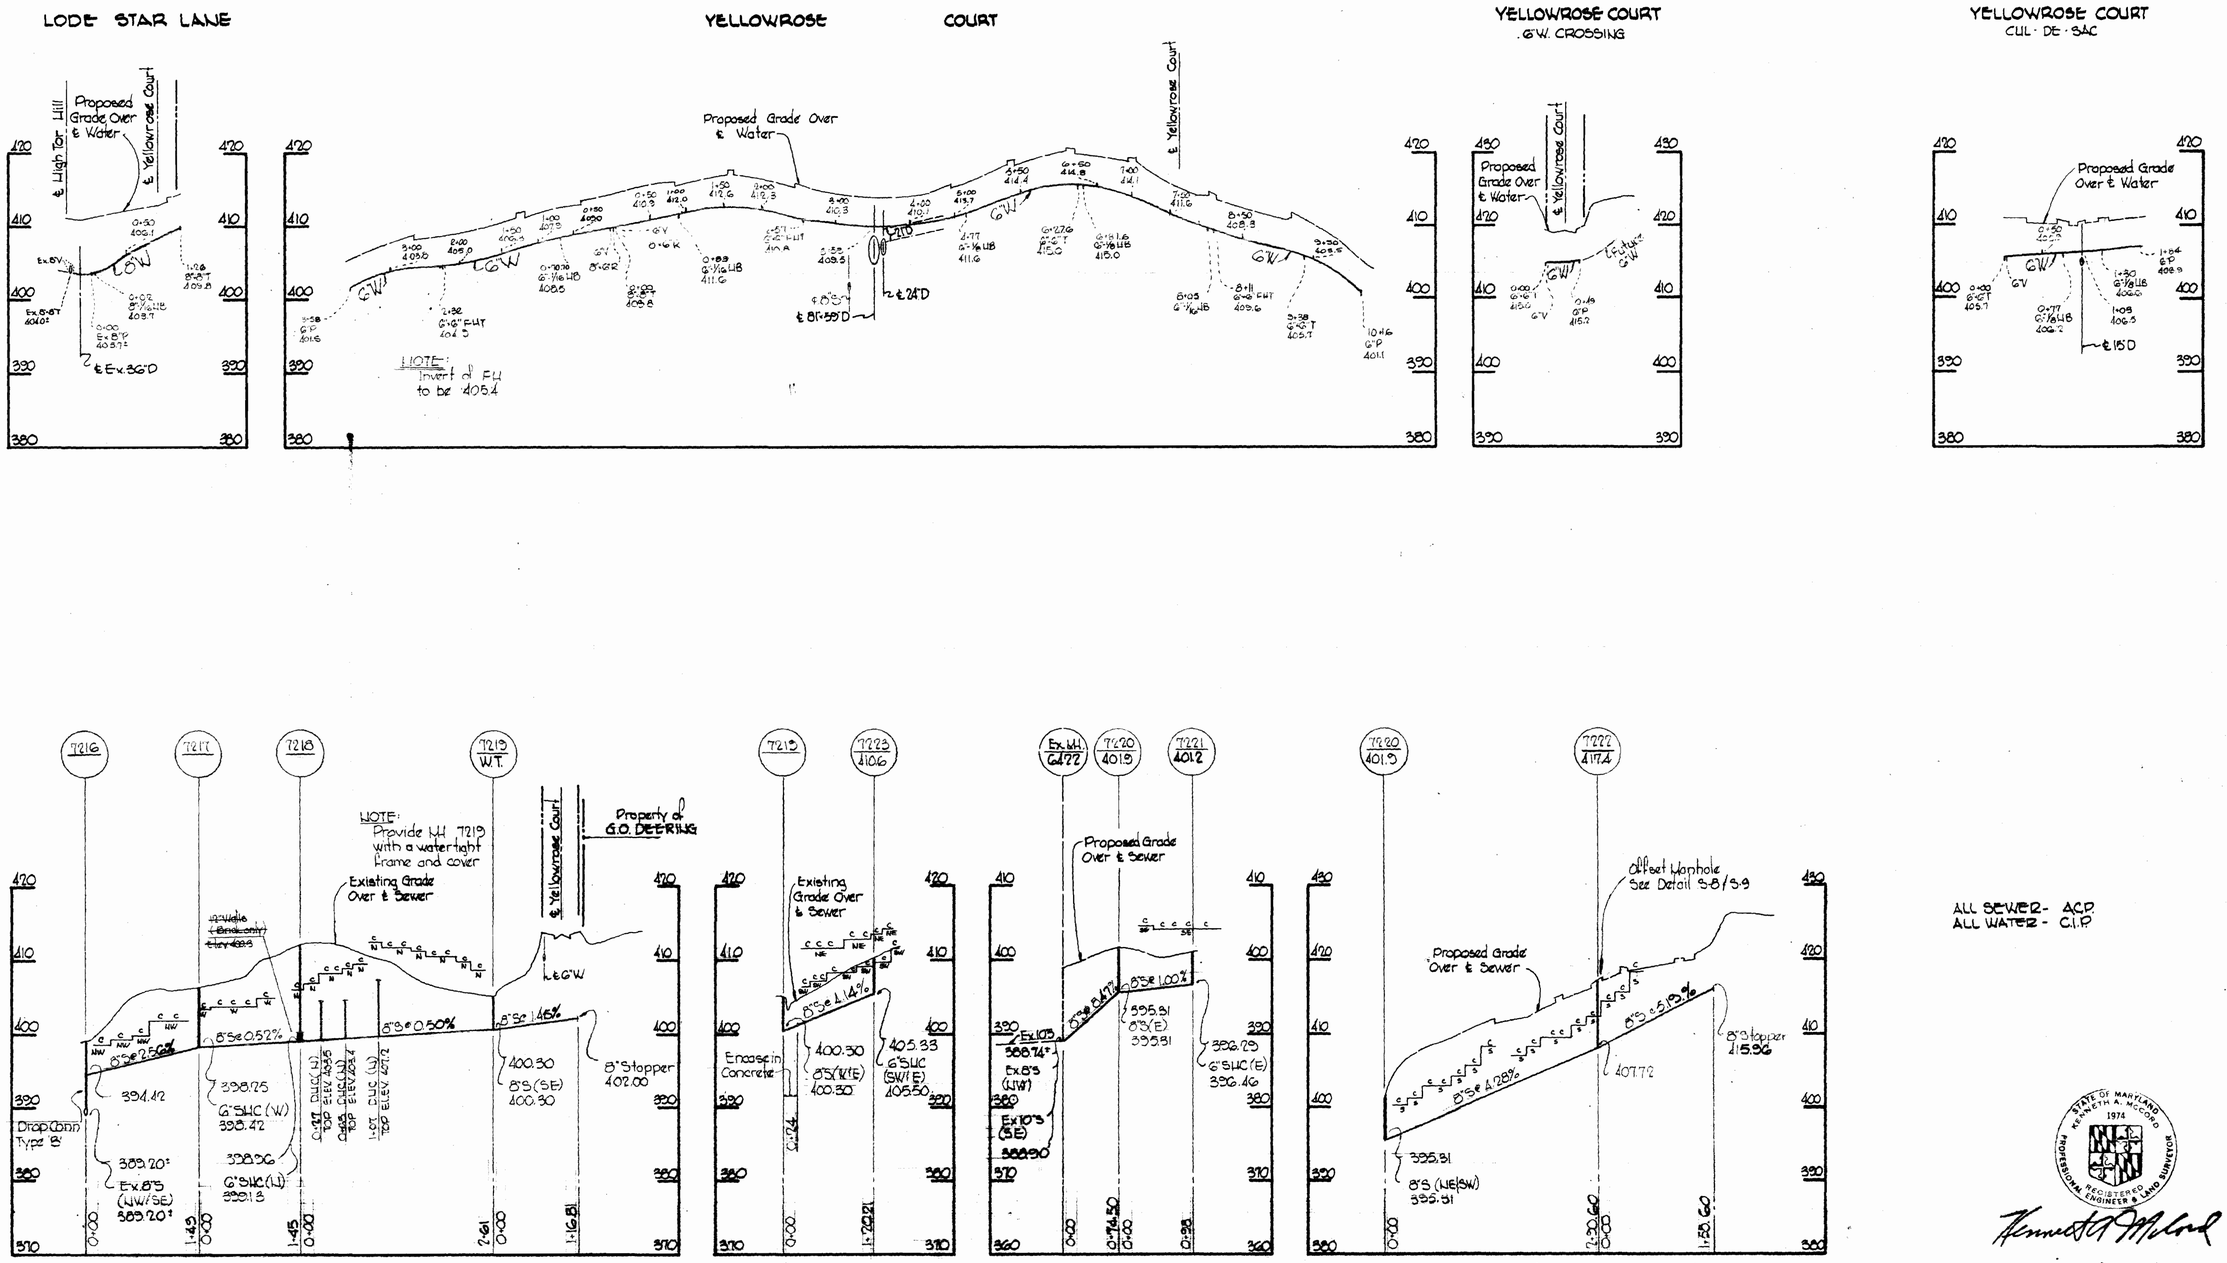

WHITMAN, REQUARDT & ASSOCIATES ENGINEERS 1304 ST. PAUL ST. BALTIMORE, MARYLAND	DEPARTMENT OF PUBLIC WORKS HOWARD COUNTY, MARYLAND 2-22-73 DATE W O Filbert CHIEF-BUREAU OF ENGINEERING	CONTRACT NO. C-2519 W&S	PROFILES OF WATER AND SEWER MAINS	COLUMBIA VILLAGE OF LONGREACH ELECTION DISTRICT GUILFORD NO. 6	DRAWING NO. 2 OF 2	SCALE H: 1" = 100' V: 1" = 10'

W. O. 6023-2

MARCH 11, 1974 AS BUILT

WS 519-W&S/2