GENERAL NOTES

1. APPROXIMATE LOCATION OF EXISTING MAINS ARE SHOWN. THE CONTRACTOR SHALL TAKE ALL NECESSARY PRECAUTIONS TO PROTECT EXISTING MAINS AND SERVICES AND MAINTAIN UNINTERRUPTED SUPPLY. ANY DAMAGE INCURRED SHALL BE REPAIRED IMMEDIATELY.
2. ALL PIPE ELEVATIONS SHOWN ARE INVERT ELEVATIONS.
3. THE CONTRACTOR SHALL LOCATE EXISTING UTILITIES A MINIMUM OF TWO WEEKS IN ADVANCE OF CONSTRUCTION OPERATIONS IN VICINITY OF UTILITIES.
4. THE CONTRACTOR SHALL NOTIFY THE FOLLOWING UTILITIES OR AGENCIES AT LEAST FIVE DAYS BEFORE STARTING WORK SHOWN ON THESE PLANS:

   BALTIMORE GAS AND ELECTRIC COMPANY - UNDERGROUND ELECTRIC
   DISTRIBUTION ENGINEERING
   DAMAGE CONTROL 234-5691
   UNDERGROUND GAS DISTRIBUTION
   ENGINEERING 234-5621

   CHESAPEAKE AND POTOMAC TELEPHONE COMPANY 393-3648.
   MISS. UTILITY - 1 - 559-0100
5. FOR ALL STANDARD DETAILS SEE STANDARDS BOUND IN SPECIFICATIONS.
6. ALL HORIZONTAL AND VERTICAL CONTROLS ARE BASED ON MARYLAND STATE DATUM.
7. CLEAR ALL UTILITIES BY A MINIMUM OF 6".
8. BLOCK ALL FITTINGS WITH CONCRETE, SEE STANDARDS BOUND IN SPECIFICATIONS.
9. ALL WATER MAINS SHALL HAVE A MINIMUM OF 3½' COVER.
10. ALL WATER MAINS SHALL BE C.I.P., D.I.P. OR A.C.P. UNLESS OTHERWISE NOTED.
11. ALL VALVES SHALL BE STRAPPED TO TEES WHERE APPLICABLE IN ACCORDANCE WITH THE STANDARD DETAILS.
12. ALL FIRE HYDRANTS SHALL BE STRAPPED AND BUTTRESSED IN ACCORDANCE WITH THE STANDARD DETAILS. SOIL AROUND THE HYDRANTS SHALL BE COMPACTED IN ACCORDANCE WITH SECTION 5-15 OF THE STANDARD SPECIFICATIONS.
13. PAYMENT FOR STRAPPING FIRE HYDRANTS AND VALVES WILL BE INCLUDED IN UNIT PRICE BID FOR FURNISHING AND LAYING WATER MAINS.
14. BURY LINE ELEVATIONS ON FIRE HYDRANTS SHALL BE SET TO THE ELEVATION SHOWN ON THE DRAWINGS.
15. ALL W.H.C.'S SHALL BE 3/4" DIAMETER UNLESS OTHERWISE NOTED.
16. WATER SERVICES SHALL BE FOR INSIDE METER SETTINGS.
17. ALL SEWER MAINS SHALL BE C.S.P.X., V.C.P.X. OR A.C.P. CLASS 2400 UNLESS OTHERWISE NOTED.
18. ALL MANHOLES SHALL BE 4'-0" INSIDE DIAMETER.
19. THE CONTRACTOR SHALL PROVIDE A JOINT IN ALL SEWER MAINS WITHIN 2'-0" OF EXTERIOR MANHOLE WALLS.
20. MANHOLES SHOWN WITH 12" WALLS ARE FOR BRICK MANHOLES ONLY.
21. TREES ARE TO BE PROTECTED FROM DAMAGE TO MAXIMUM EXTENT. TREES LOCATED WITHIN THE CONSTRUCTION STRIP ARE NOT TO BE REMOVED OR DAMAGED BY THE CONTRACTOR.

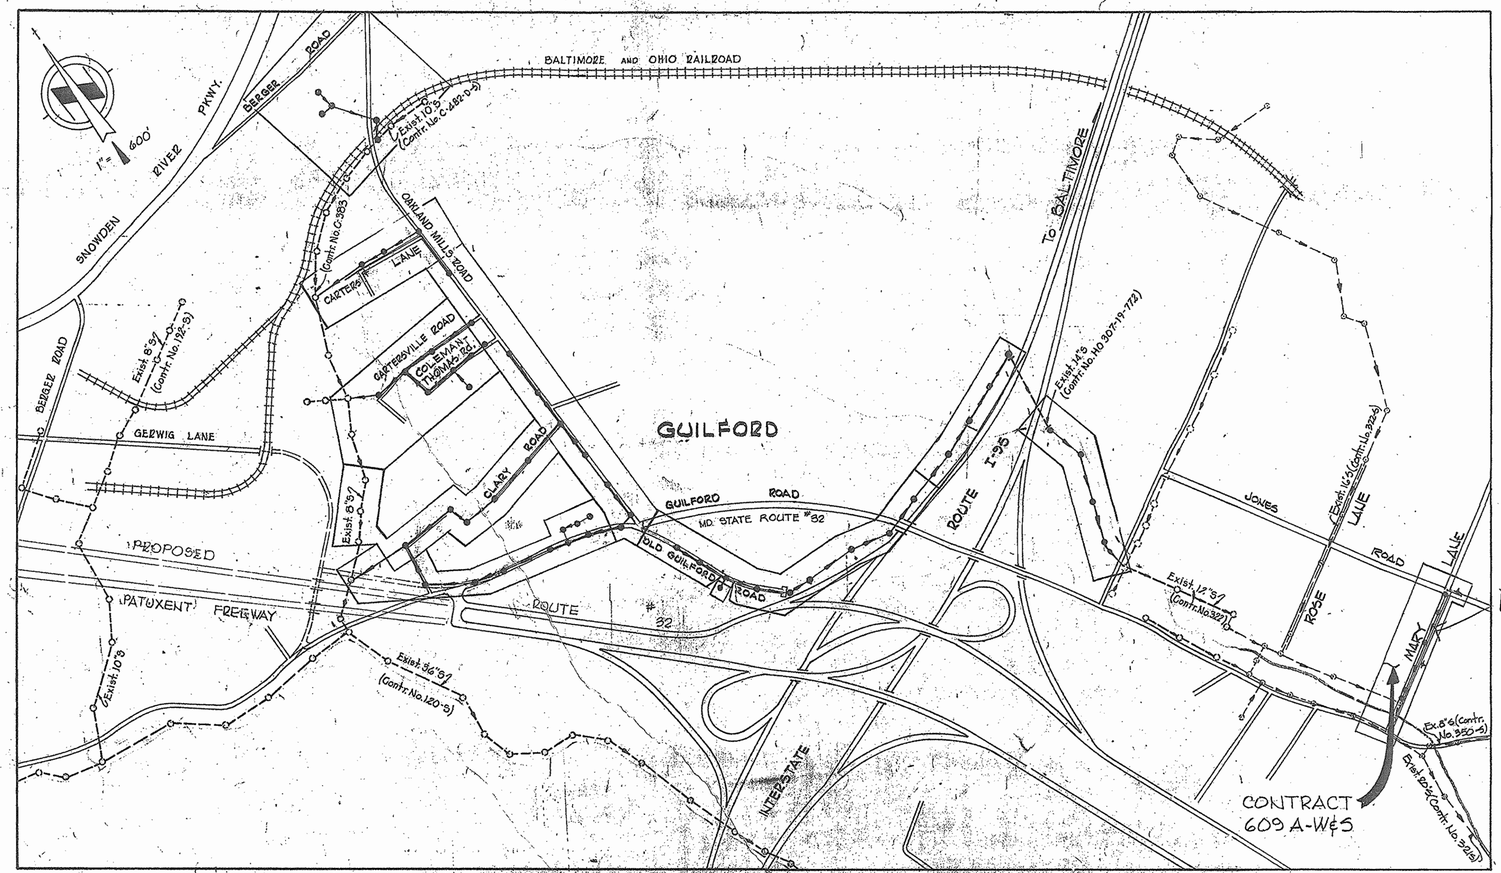

Draw 2

42 and
Tx 47
2-B03

4.36 0000

CONTRACT NO. 609 A-W & S
MARY LANE
WATER AND SEWER EXTENSIONS
HOWARD COUNTY, MARYLAND
DEPARTMENT OF PUBLIC WORKS

QUANTITIES		
ITEM	DESIGN	AS BUILT
8" Sewer (A.C.P.)	380 LF	384 LF
8" Water (D.I.P.)	1,300 LF	1,302 LF
Fire Hydrants	2	2

AS-BUILT
Diary & Stakeout
FB# 6313

STATE OF MARYLAND
KENNETH A. McCARTY
No. 10873
PROFESSIONAL ENGINEER
CHIEF, BUREAU OF ENGINEERING & DIRECTOR

Kenneth A. McCarty

Mary Lane
Project Nos. W-7-8095 & S-6-6079
Contract No. 609A-W&S

WHITMAN, REQUARDT & ASSOCIATES ENGINEERS 1304 ST. PAUL ST. BALTIMORE, MARYLAND	DEPARTMENT OF PUBLIC WORKS HOWARD COUNTY, MARYLAND	CONTRACT NO. 609 A-W&S PROJECT NO. S-6-6079 W-7-8095	LOCATION MAP	ELECTION DISTRICT GUILFORD NO. 6	DRAWING NO. 1 OF 2	SCALE 1" = 600'
	P.J. Rizzo Jr. 4-21-77 DIRECTOR OF PUBLIC WORKS — DATE; W.O. Gilbert 4-21-77 CHIEF BUREAU OF ENGINEERING — DATE					

W.O. 6800-2

~~DECEMBER 28, 1978~~
As-Built FEBRUARY 21, 1980

BEARING 44510 18592