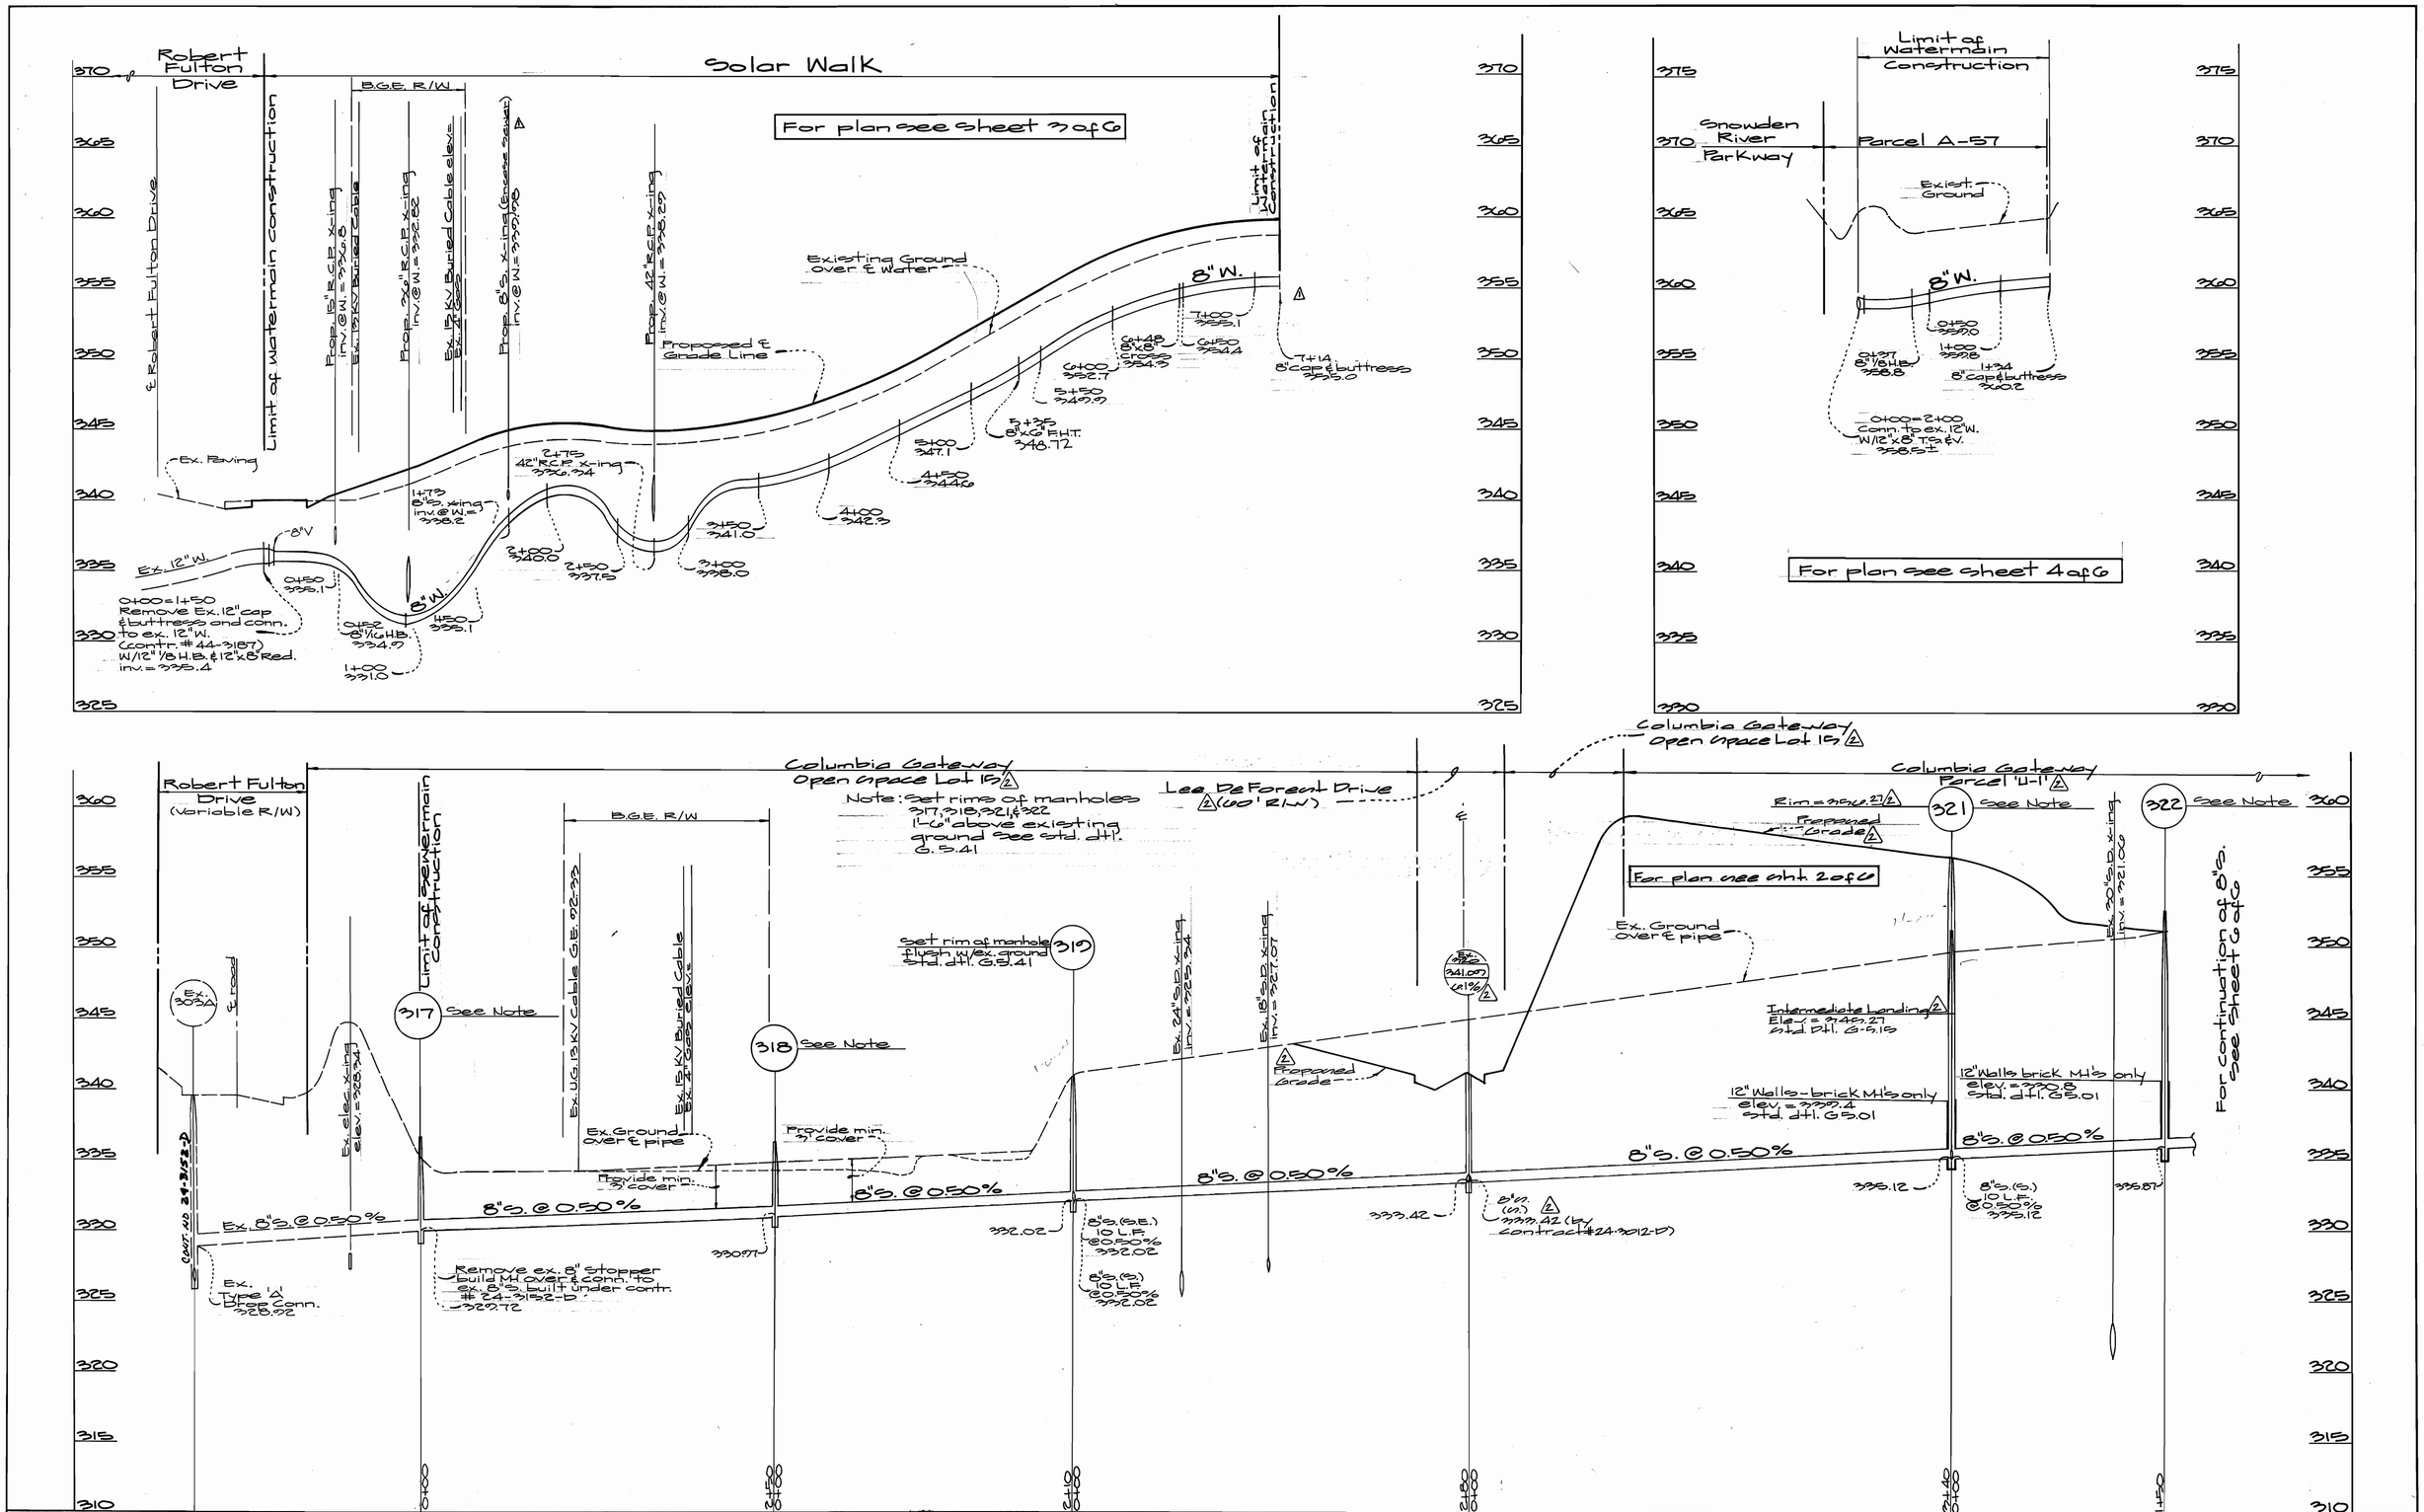

3406 WS/5 G.C.C., par. A-51-A-59

Department of Public Works Howard County, Maryland	Department of Planning & Zoning Howard County, Maryland	GLW Gutschick Little & Weber, P.A. ENGINEERS, PLANNERS, SURVEYORS			Water & Sewer Profiles	Gateway Commerce Center	SCALE AS SHOWN
Michael A. Gunnarville for RMB 7-17-95	7/25/95	3909 NATIONAL DRIVE · SUITE 250 · BURTONSVILLE OFFICE PARK BURTONSVILLE, MD. 20866 (301) 421-4024	DES: W.S.J.		Profile Scales: 1"=50' Horz. 1"=5' Vert.	Parcels A-51 thru A-59 (A Resubdivision of Parcel A-49)	SHEET 5 OF 6
Chief, Bureau of Utilities Date	Chief, Development Engineering Division Date		DRN: W.S.J.			Sixth Election District - Howard County, Maryland	
			CHK:			Contract No: 24-3406 D	
			DATE: April, 1995		600' SCALE MAP NO. 42 BLOCK NO.		

BY	NO.	REVISION	DATE
WSJ	2	Rev. Rims MH 320 & 321 & Ground over	2/07/00
KP	1	Corrected Profile (End of Solar Walk) / Encasement Note	10/24/95