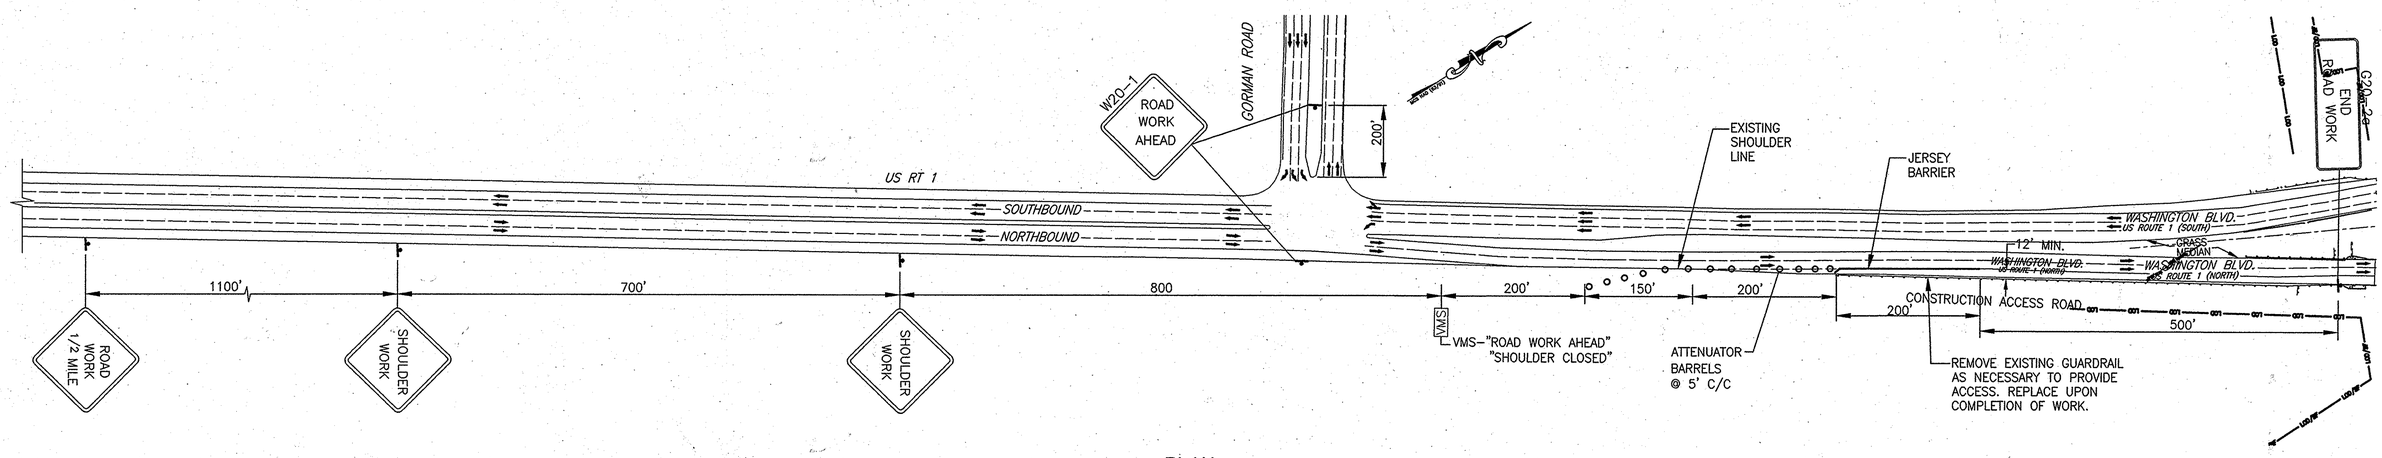

PLAN

1"=100'

NOTES:

1.) ALL SIGNS SHALL COMPLY WITH MUTCD STANDARDS.

2.) ALL WORK SHALL COMPLY WITH THE PERMIT REQUIREMENTS INCLUDED IN THE SPECIAL PROVISIONS.

3.) CONTRACTOR TO COORDINATE INSTALLATION USE AND REMOVAL OF THE ACCESS ROAD W/ THE CONTRACTOR CONSTRUCTING CONTRACT #20-4531. COMPENSATION WILL NOT BE GIVEN TO THE CONTRACTOR FOR DELAYS, INCONVIENCES OR DAMAGE SUSTAINED DUE TO LACK OF COORDINATION BETWEEN CONTRACTORS.

LEGEND

- TEMPORARY SIGN FOR TRAFFIC CONTROL
- DIRECTION OF TRAFFIC
- VMS MESSAGE BOARD
- BARRELS
- TEMPORARY JERSEY BARRIER
- GUARD RAIL

PROFESSIONAL CERTIFICATION

I HEREBY CERTIFY THAT THESE DOCUMENTS WERE PREPARED OR APPROVED BY ME, AND THAT I AM A DULY LICENSED PROFESSIONAL ENGINEER UNDER THE LAWS OF THE STATE OF MARYLAND.

LICENSE NO. 8146 EXPIRATION DATE: 10/8/11

AS-BUILT

DEPARTMENT OF PUBLIC WORKS
HOWARD COUNTY, MARYLAND

DIRECTOR OF PUBLIC WORKS — DATE 12/12/08
CHIEF, BUREAU OF ENGINEERING — DATE 12/12/08
CHIEF, BUREAU OF UTILITIES — DATE 12/12/08
CHIEF, UTILITY DESIGN DIVISION — DATE 12/11/08

Patton Harris Rust & Associates, Inc.
Engineers. Surveyors. Planners. Landscape Architects.
8818 Centre Park Drive
Columbia, MD 21045
T 410.997.8900
F 410.997.9282

STATE OF MARYLAND — JOHN A. BOSANKO — NO. 8146 — REGISTERED PROFESSIONAL ENGINEER
12/8/11

DES: C.H.
DRN: K.L.B.
CHK: G.C.L.
DECEMBER, 2008

BY	NO.	REVISION	DATE
			12/10

MAINTENANCE OF TRAFFIC
U.S. ROUTE 1

600' SCALE MAP 47 | BLOCK 10, 16, 17, & 18

LITTLE PATUXENT
PARALLEL INTERCEPTOR SEWER
CAPITAL PROJECT S-6175
CONTRACT NO. 20-4532
1ST ELECTION DISTRICT
HOWARD COUNTY, MARYLAND

SCALE AS SHOWN

SHEET 25 OF 27

J:\proj\act\47941-0\Env\Plans\Contract 2\AS-BUILT\25-AS-BUILT-Temporary Traffic Control Plan.dwg, 7/20/2011 3:45:21 PM, TD5500.pc3