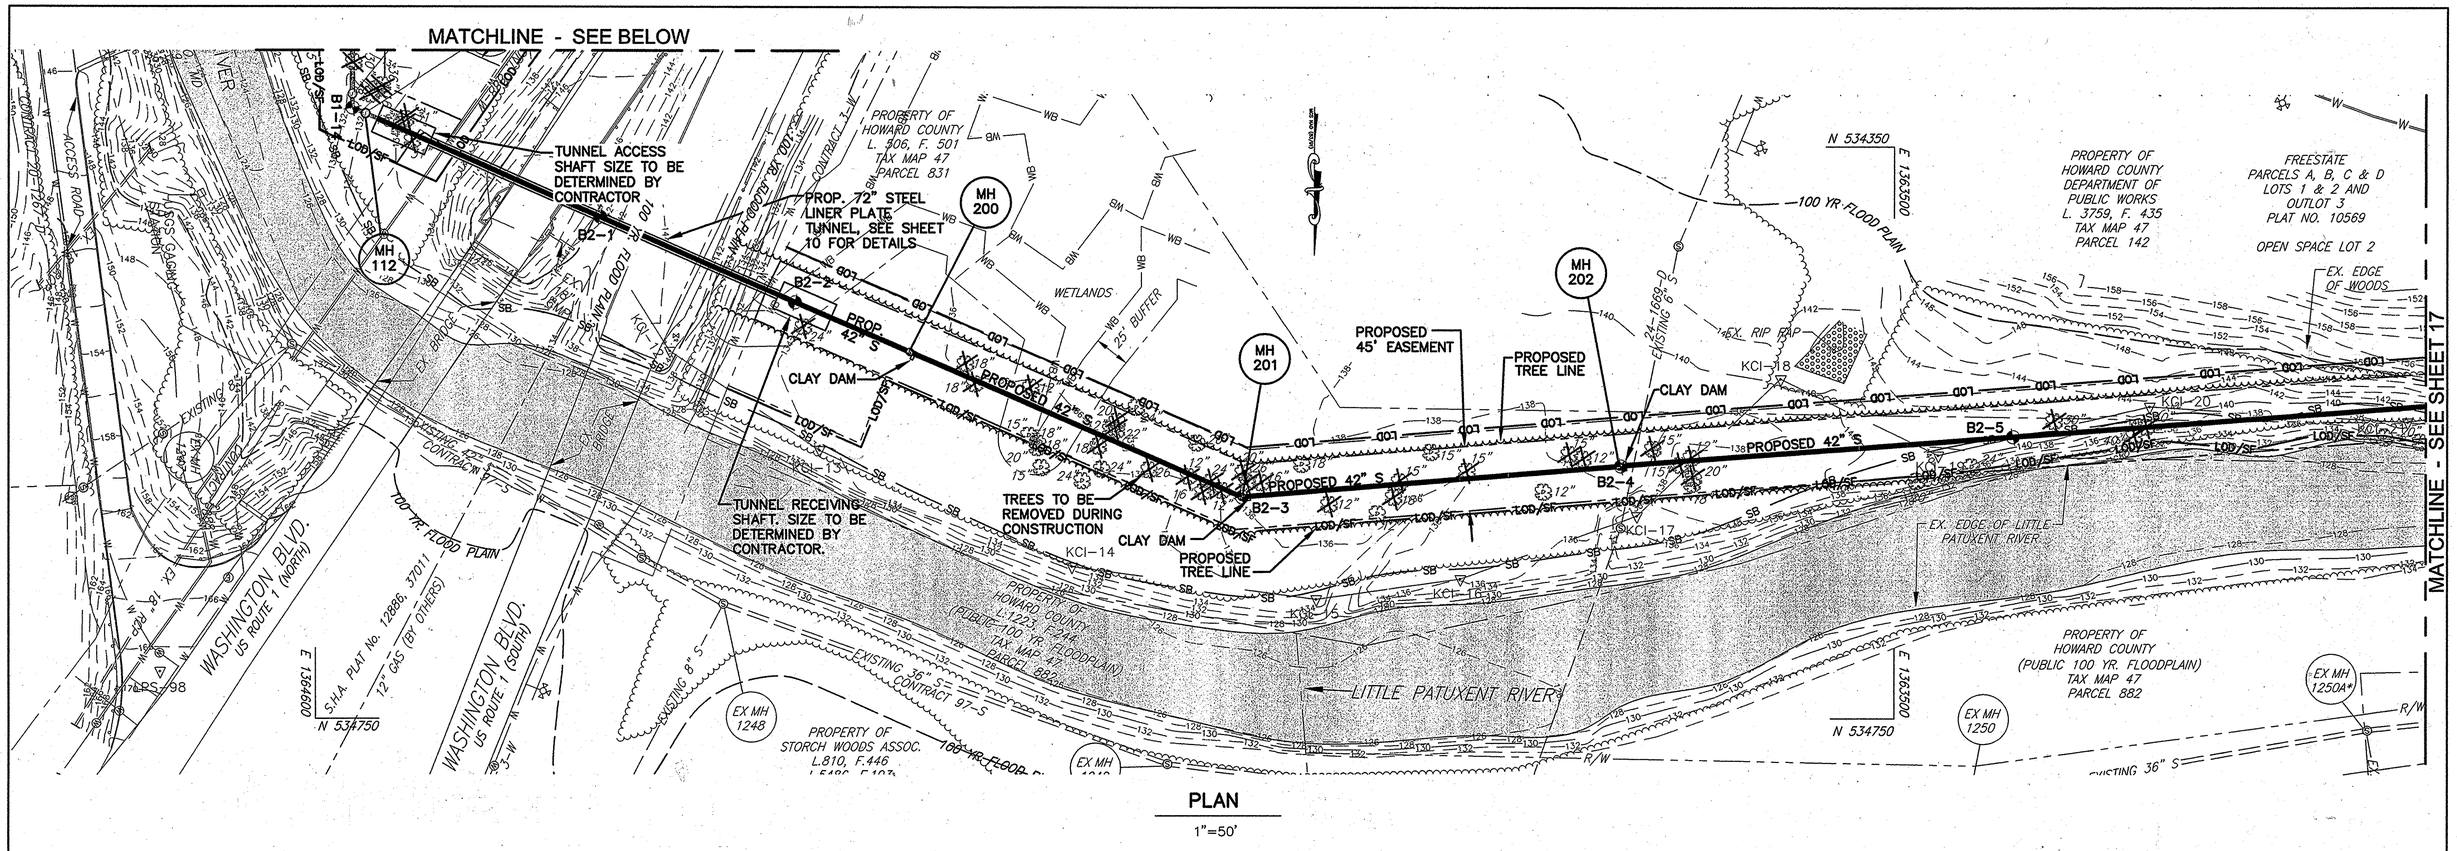

PLAN

1"=50'

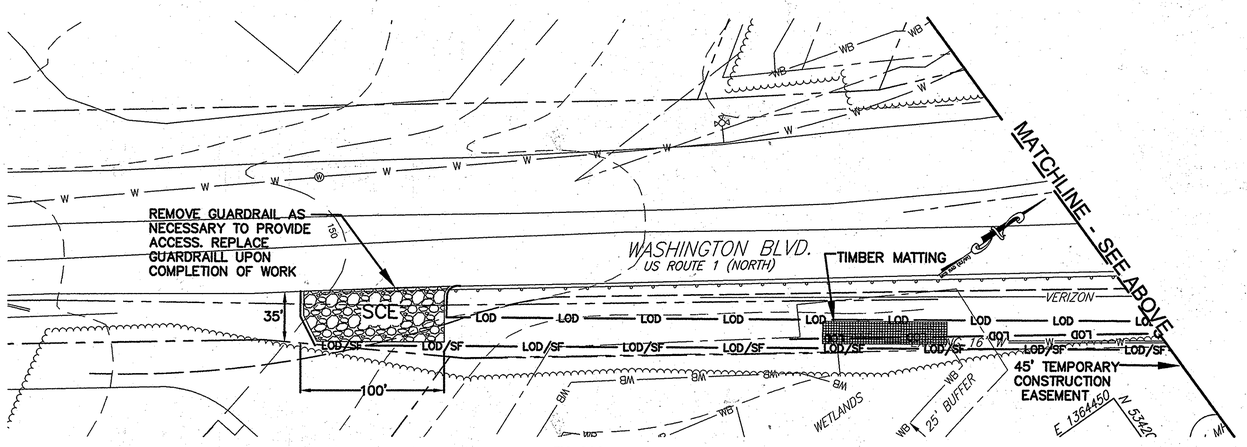

PLAN

1"=50'

NOTES:

1. CONTRACTOR TO COORDINATE INSTALLATION, USE AND REMOVAL OF THE ACCESS ROAD W/ THE CONTRACTOR CONSTRUCTING CONTRACT #20-4531. COMPENSATION WILL NOT BE GIVEN TO THE CONTRACTOR FOR DELAYS, INCONVIENCES OR DAMAGE SUSTAINED DUE TO LACK OF COORDINATION BETWEEN CONTRACTORS.
2. ALL EXCESS FILL MATERIAL WILL BE REMOVED FROM THE 100-YEAR FLOODPLAIN AND EXISTING CONTOURS WILL BE RESTORED ONCE THE UTILITY HAS BEEN INSTALLED. AS SUCH, THERE WILL BE NO "MOUNDING" OR "WASTING" OF MATERIALS WITHIN THE LOD.

AS-BUILT

PROFESSIONAL CERTIFICATION

I HEREBY CERTIFY THAT THESE DOCUMENTS WERE PREPARED OR APPROVED BY ME, AND THAT I AM A DULY LICENSED PROFESSIONAL ENGINEER UNDER THE LAWS OF THE STATE OF MARYLAND.

LICENSE NO. 31146 EXPIRATION DATE: 10/8/11

DEPARTMENT OF PUBLIC WORKS
HOWARD COUNTY, MARYLAND

DIRECTOR OF PUBLIC WORKS — DATE 12/12/08
CHIEF, BUREAU OF ENGINEERING — DATE 12/12/08
CHIEF, BUREAU OF UTILITIES — DATE 12/12/08
CHIEF, UTILITY DESIGN DIVISION — DATE 12/11/08

Patton Harris Rust & Associates, Inc.
Engineers. Surveyors. Planners. Landscape Architects.
8818 Centre Park Drive
Columbia, MD 21045
T 410.997.8900
F 410.997.9282

STATE OF MARYLAND — MARK A. DOSTER — NO. 31146 — REGISTERED PROFESSIONAL ENGINEER
9/8/11

DES: C.H.
DRN: K.L.B.
CHK: G.C.L.
DECEMBER, 2008

BY	NO.	REVISION	DATE
			12/10

SEDIMENT & EROSION CONTROL PLAN

600' SCALE MAP 47 | BLOCK 10, 16, 17, & 18

LITTLE PATUXENT
PARALLEL INTERCEPTOR SEWER
CAPITAL PROJECT S-6175
CONTRACT NO. 20-4532
1ST ELECTION DISTRICT
HOWARD COUNTY, MARYLAND

SCALE AS SHOWN

SHEET 16 OF 27

"J:\proj\ed\31-079-11-V\Elev\Plans\Contract 2\AS-BUILT\16-AS-BUILT-Sediment & Erosion Control Plan.dwg, 7/20/2011 3:29:00 PM, TDS500.pc3"