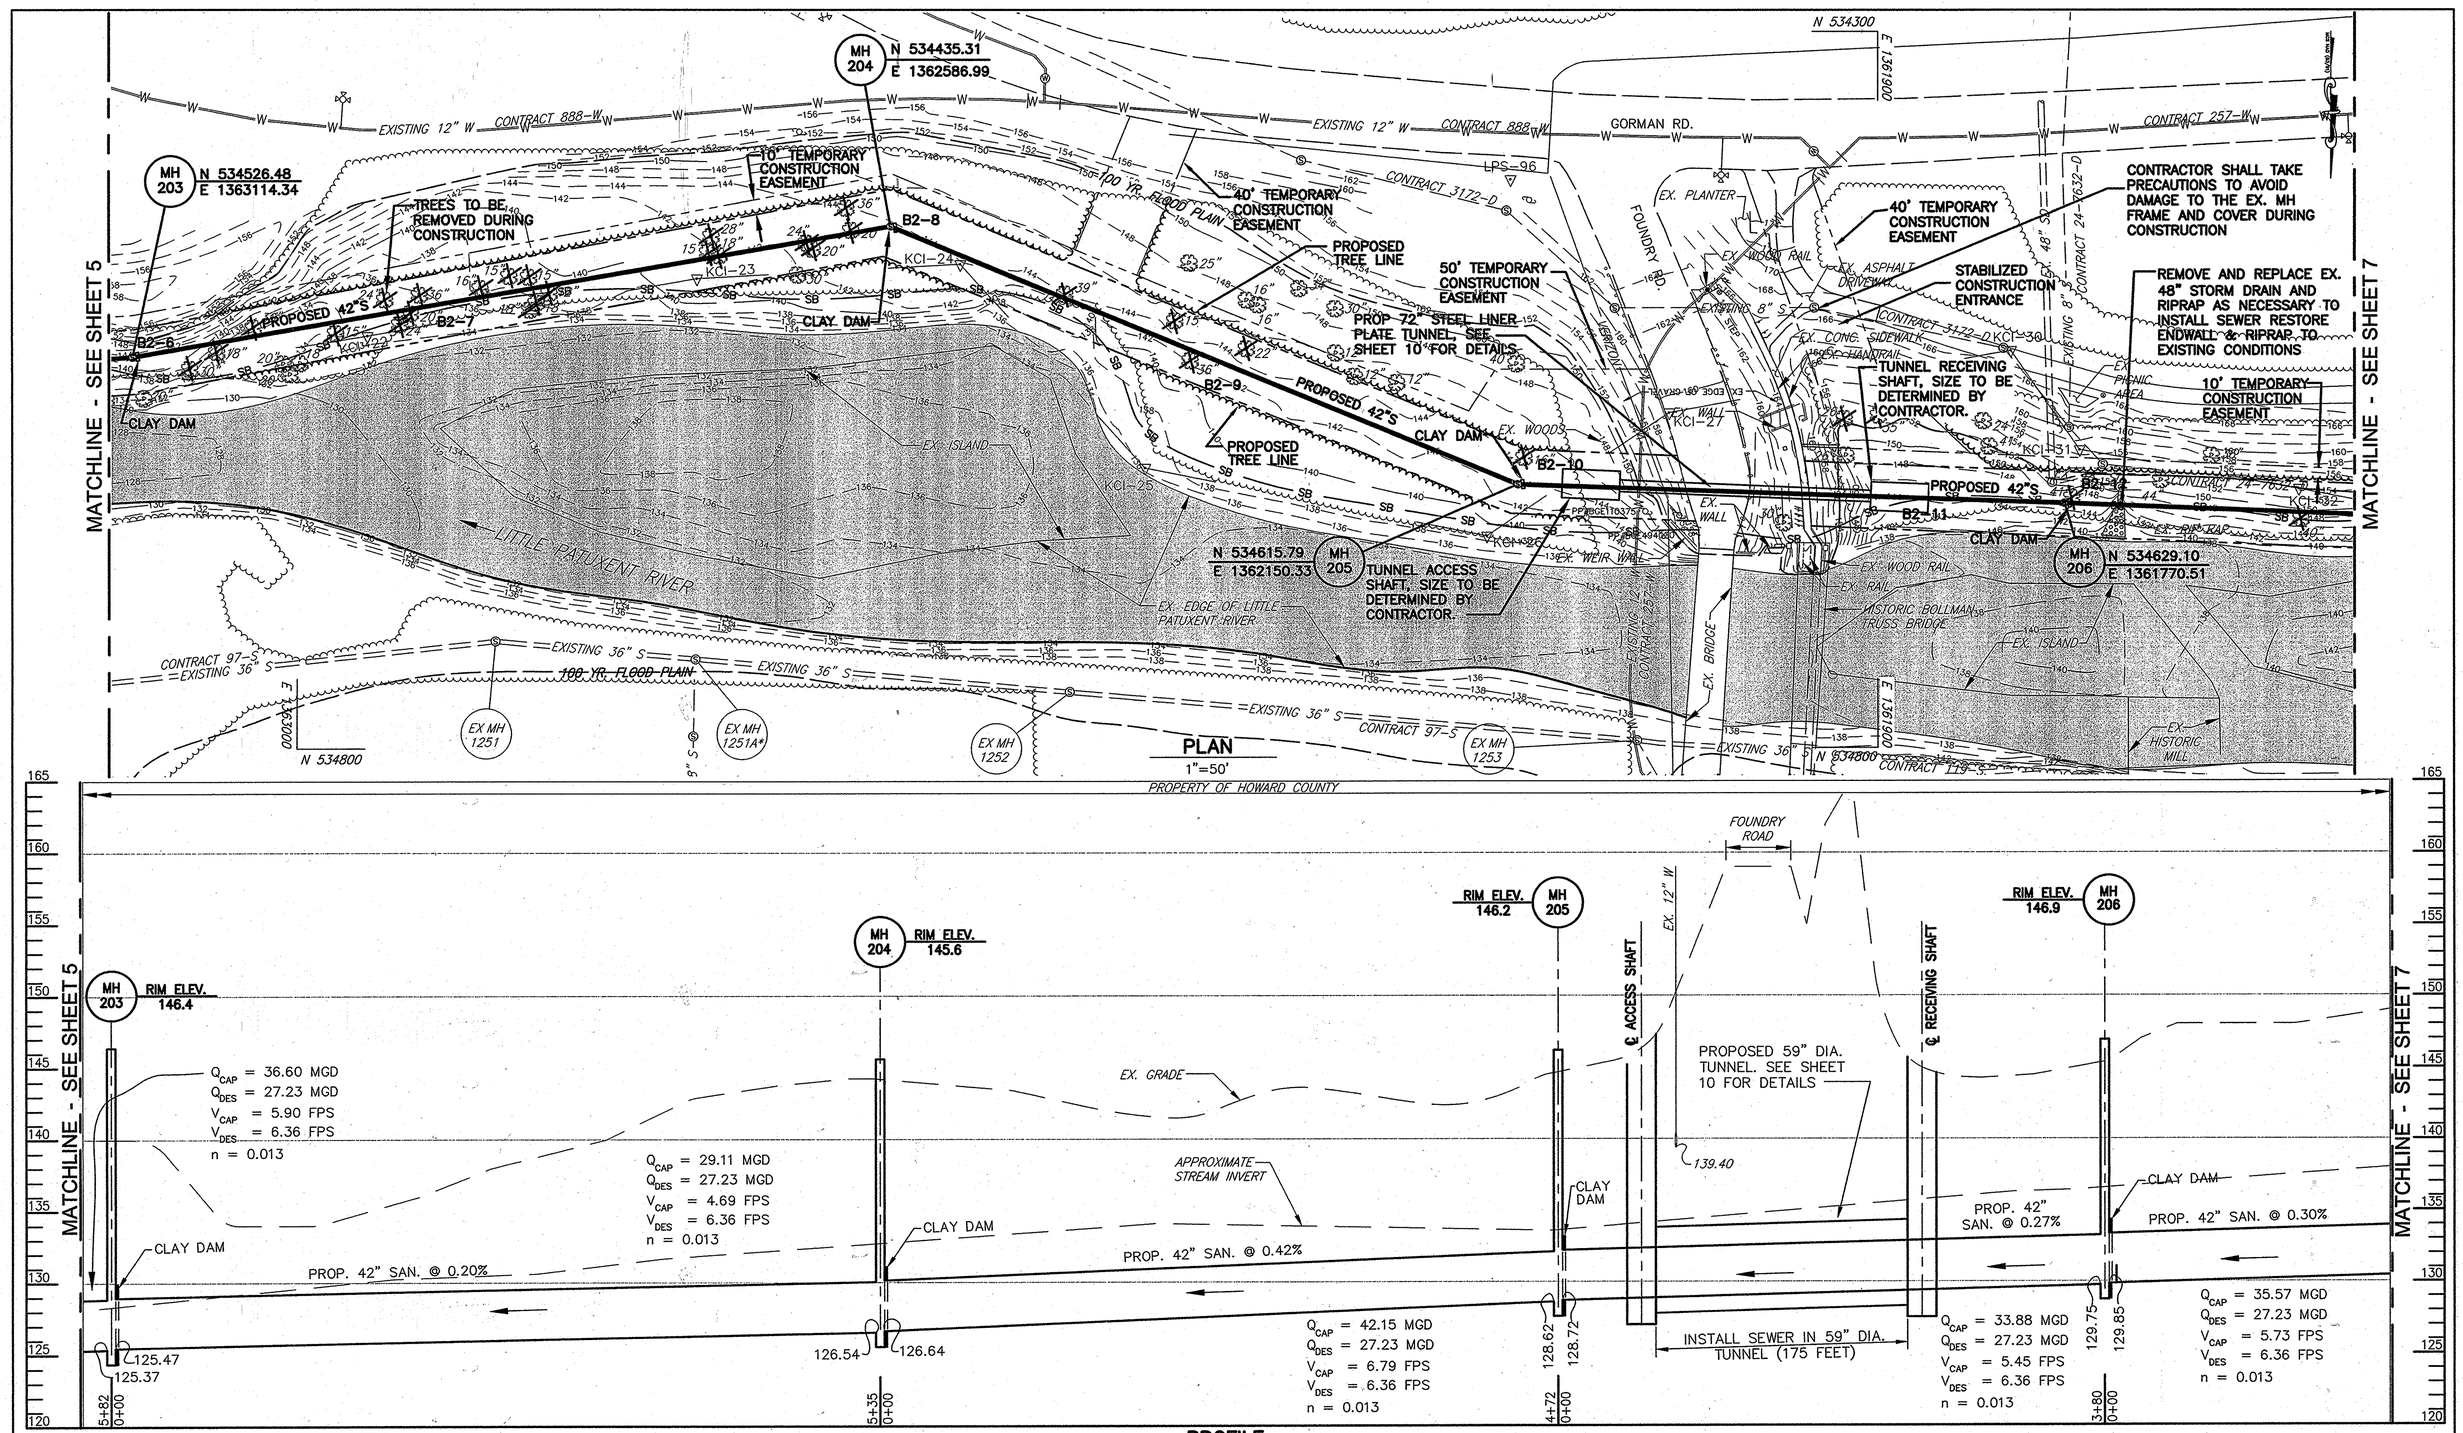

PROFESSIONAL CERTIFICATION

I HEREBY CERTIFY THAT THESE DOCUMENTS WERE PREPARED OR APPROVED BY ME, AND THAT I AM A DULY LICENSED PROFESSIONAL ENGINEER UNDER THE LAWS OF THE STATE OF MARYLAND.

LICENSE NO. 8146 EXPIRATION DATE: 10/8/11

DEPARTMENT OF PUBLIC WORKS
HOWARD COUNTY, MARYLAND

DIRECTOR OF PUBLIC WORKS — DATE 12/12/08
CHIEF, BUREAU OF ENGINEERING — DATE 12/12/08
CHIEF, BUREAU OF UTILITIES — DATE 12/12/08
CHIEF, UTILITY DESIGN DIVISION — DATE 12/11/08

Patton Harris Rust & Associates, Inc.
Engineers. Surveyors. Planners. Landscape Architects.
8818 Centre Park Drive
Columbia, MD 21045
T 410.997.8900
F 410.997.9282

STATE OF MARYLAND — JAMES R. GORALSKI — No. 14822 — PROFESSIONAL ENGINEER
12/11/08

DES: C.H.			
DRN: K.L.B.			
CHK: G.C.L.			
DECEMBER, 2008	R.J.C.	AS-BUILT	12/10
	BY NO.	REVISION	DATE

PLAN AND PROFILE

600' SCALE MAP 47 — BLOCK 10, 16, 17 ,& 18

LITTLE PATUXENT
PARALLEL INTERCEPTOR SEWER
CAPITAL PROJECT S-6175
CONTRACT NO. 20-4532
1ST ELECTION DISTRICT
HOWARD COUNTY, MARYLAND

SCALE AS SHOWN

SHEET 6 OF 27

P:\projects\14579\41-0\Eng\Plans\Contract 2\AS-BUILT\06-AS-BUILT-Plan & Profile.dwg, 7/15/2011 10:11:53 AM, \\cmb-svr-03\CMB HP DesignJet 1050 HPGL