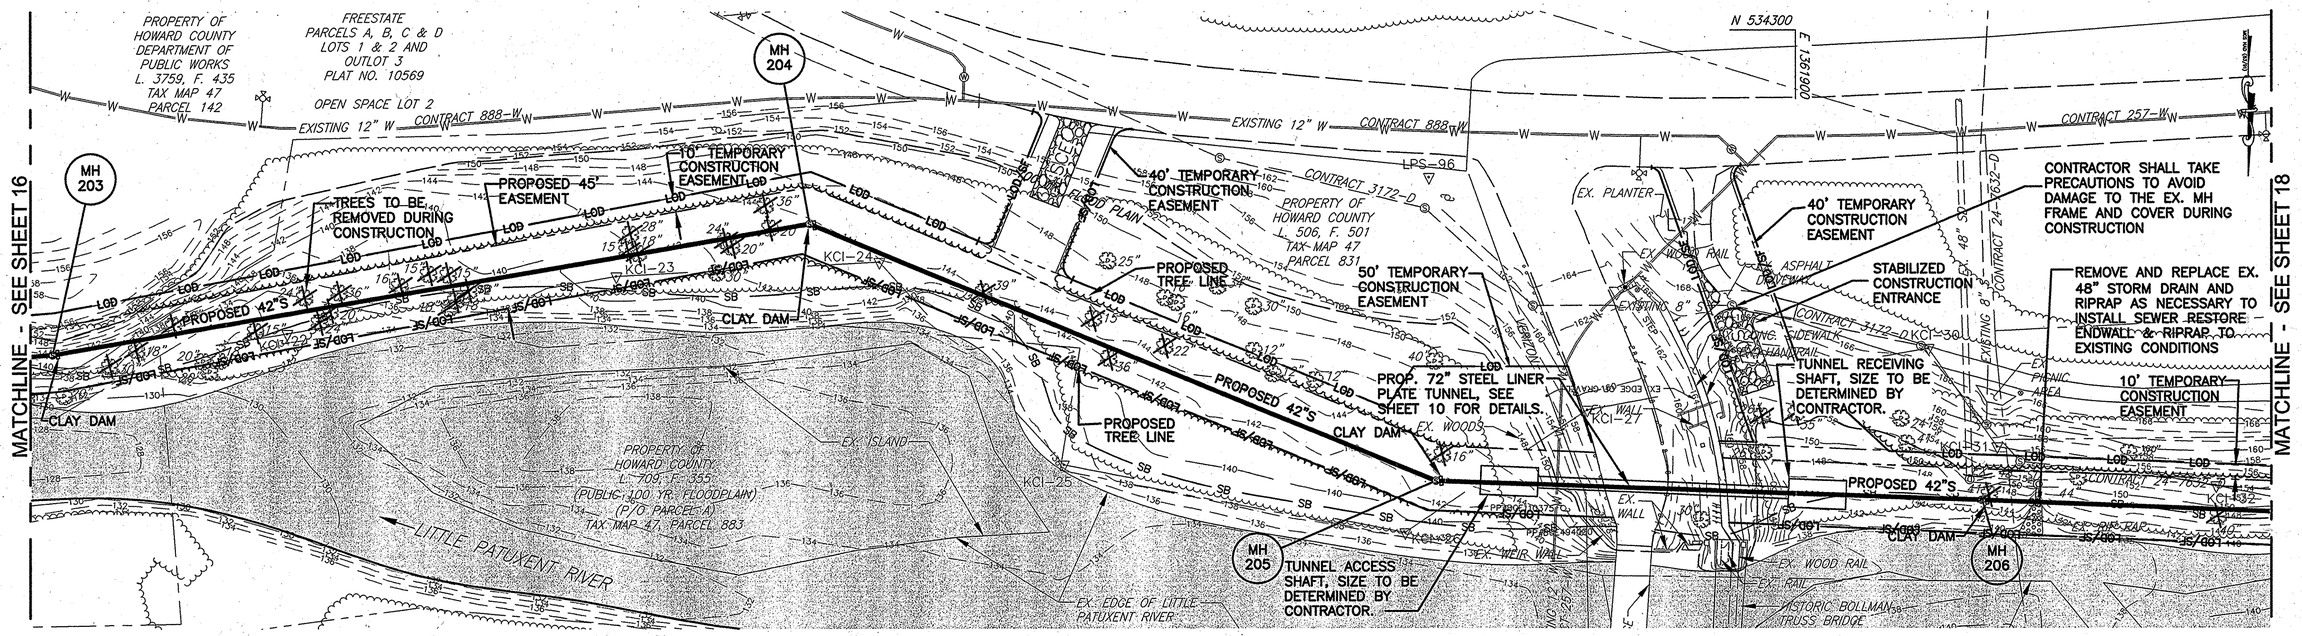

PLAN

1"=50'

NOTES:

1. ALL EXCESS FILL MATERIAL WILL BE REMOVED FROM THE 100-YEAR FLOODPLAIN AND EXISTING CONTOURS WILL BE RESTORED ONCE THE UTILITY HAS BEEN INSTALLED. AS SUCH, THERE WILL BE NO "MOUNDING" OR "WASTING" OF MATERIALS WITHIN THE LOD.

PROFESSIONAL CERTIFICATION

I HEREBY CERTIFY THAT THESE DOCUMENTS WERE PREPARED OR APPROVED BY ME, AND THAT I AM A DULY LICENSED PROFESSIONAL ENGINEER UNDER THE LAWS OF THE STATE OF MARYLAND.

LICENSE NO. 8146 EXPIRATION DATE: 10/8/11

AS-BUILT

DEPARTMENT OF PUBLIC WORKS
HOWARD COUNTY, MARYLAND

DIRECTOR OF PUBLIC WORKS — DATE 12/12/08
CHIEF, BUREAU OF ENGINEERING — DATE 12/12/08
CHIEF, BUREAU OF UTILITIES — DATE 12/12/08
CHIEF, UTILITY DESIGN DIVISION — DATE 12/11/08

Patton Harris Rust & Associates, Inc.
Engineers. Surveyors. Planners. Landscape Architects.
8818 Centre Park Drive
Columbia, MD 21045
T 410.997.8900
F 410.997.9282

STATE OF MARYLAND — ROBERT E. DONAHUE — NO. 8146 REGISTERED PROFESSIONAL ENGINEER — 8/8/11

DES: C.H.
DRN: K.L.B.
CHK: G.C.L.
DECEMBER, 2008

BY	NO.	REVISION	DATE
			12/10

SEDIMENT & EROSION CONTROL PLAN

600' SCALE MAP 47 | BLOCK 10, 16, 17, & 18

LITTLE PATUXENT
PARALLEL INTERCEPTOR SEWER
CAPITAL PROJECT S-6175
CONTRACT NO. 20-4532
1ST ELECTION DISTRICT
HOWARD COUNTY, MARYLAND

SCALE AS SHOWN

SHEET 17 OF 27

T:\projects\479411-01Env\Plans\Contract 2\VS-BUILT\17-ASBUILTSediment & Erosion Control Plan.dwg, 7/20/2011 3:31:01 PM, TD5600.pc3