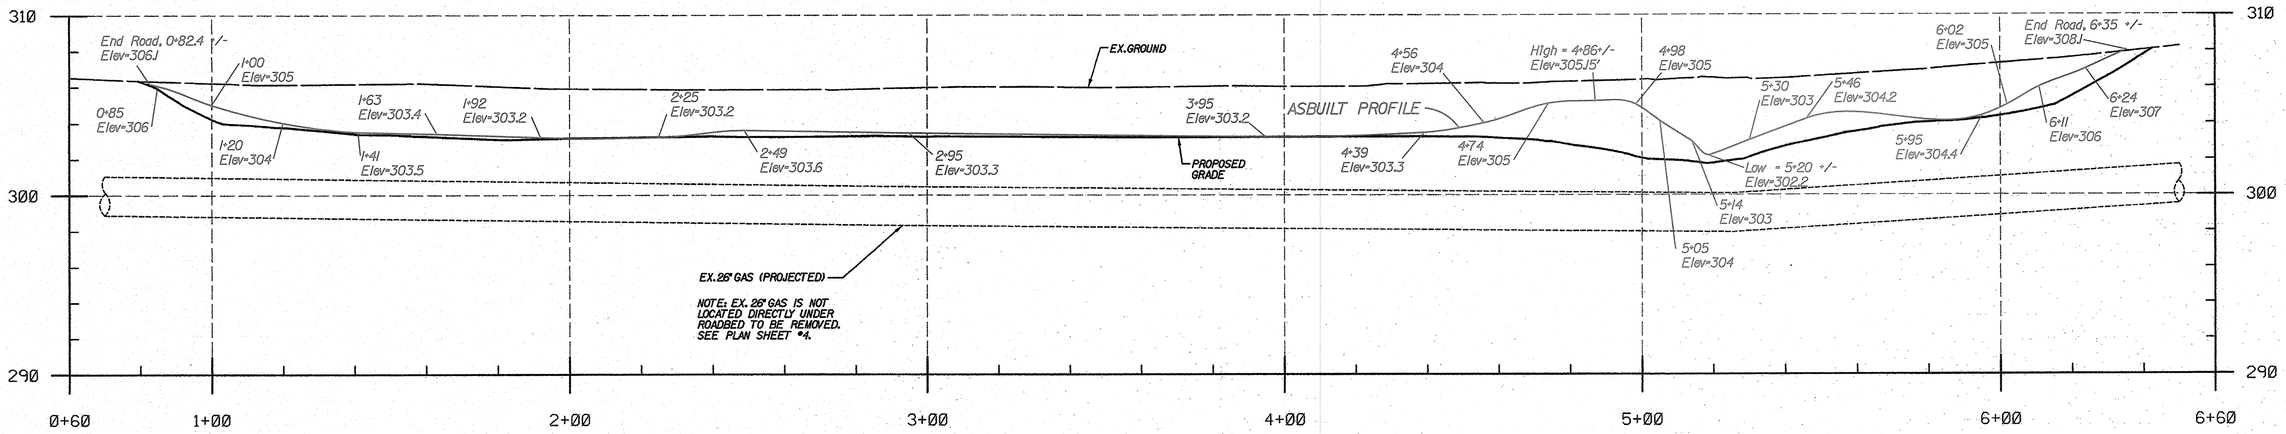

WETLAND CREATION /ROAD BED REMOVAL PROFILE

SCALE:HORIZONTAL: 1" = 20'
VERTICAL: 1" = 4'

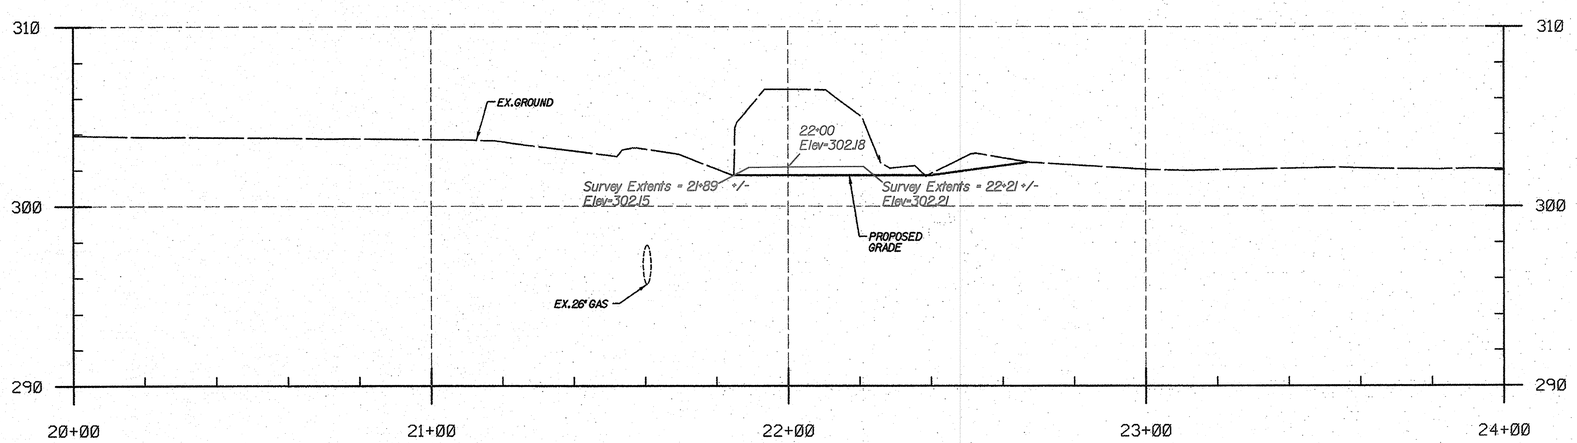

WETLAND ENHANCEMENT PROFILE AT EXISTING ROAD BED

SCALE:HORIZONTAL: 1" = 20'
VERTICAL: 1" = 4'

ASBUILT
Sheet 2 of 3

PROFESSIONAL CERTIFICATION. I HEREBY CERTIFY THAT THESE DOCUMENTS WERE PREPARED OR APPROVED BY ME , AND THAT I AM A DULY LICENSED PROFESSIONAL ENGINEER UNDER THE LAWS OF THE STATE OF MARYLAND, LICENSE NO. 20903 EXPIRATION DATE: 07-18-2013

PLOTTED: 08:36 AM on Friday, July 27, 2012
FILE: M:\2008\0706195.14\dwings\03-profile.dgn

DEPARTMENT OF PUBLIC WORKS
HOWARD COUNTY, MARYLAND

DIRECTOR OF PUBLIC WORKS	DATE	CHIEF, BUREAU OF ENGINEERING	DATE 8/16/12
CHIEF, BUREAU OF UTILITIES	DATE 8/17/12	CHIEF, UTILITY DESIGN DIVISION	DATE 8/16/12

KCI TECHNOLOGIES
ENGINEERS
PLANNERS
SCIENTISTS
CONSTRUCTION MANAGERS
936 RIDGEBROOK ROAD
SPARKS, MARYLAND 21152
TELEPHONE: (410) 316-7800
FAX: (410) 316-7818

DES: ES/JK/JB				
DRN: KP/CD/MP				
CHK: JK/JB/JK				
DATE: JULY 2012	BY	NO.	REVISION	DATE

PROFILE SHEET

600' SCALE MAP NO._____ BLOCK NO._____

LEAFTREADER WAY
WETLAND MITIGATION SITE
SECTION 7, AREA 10
CAPITAL PROJECT No. S-6175
ELECTION DISTRICT NO. 15 HOWARD COUNTY, MARYLAND

SCALE HORZ: 1"= 20' VERT: 1"= 4'

SHEET 3 OF 16