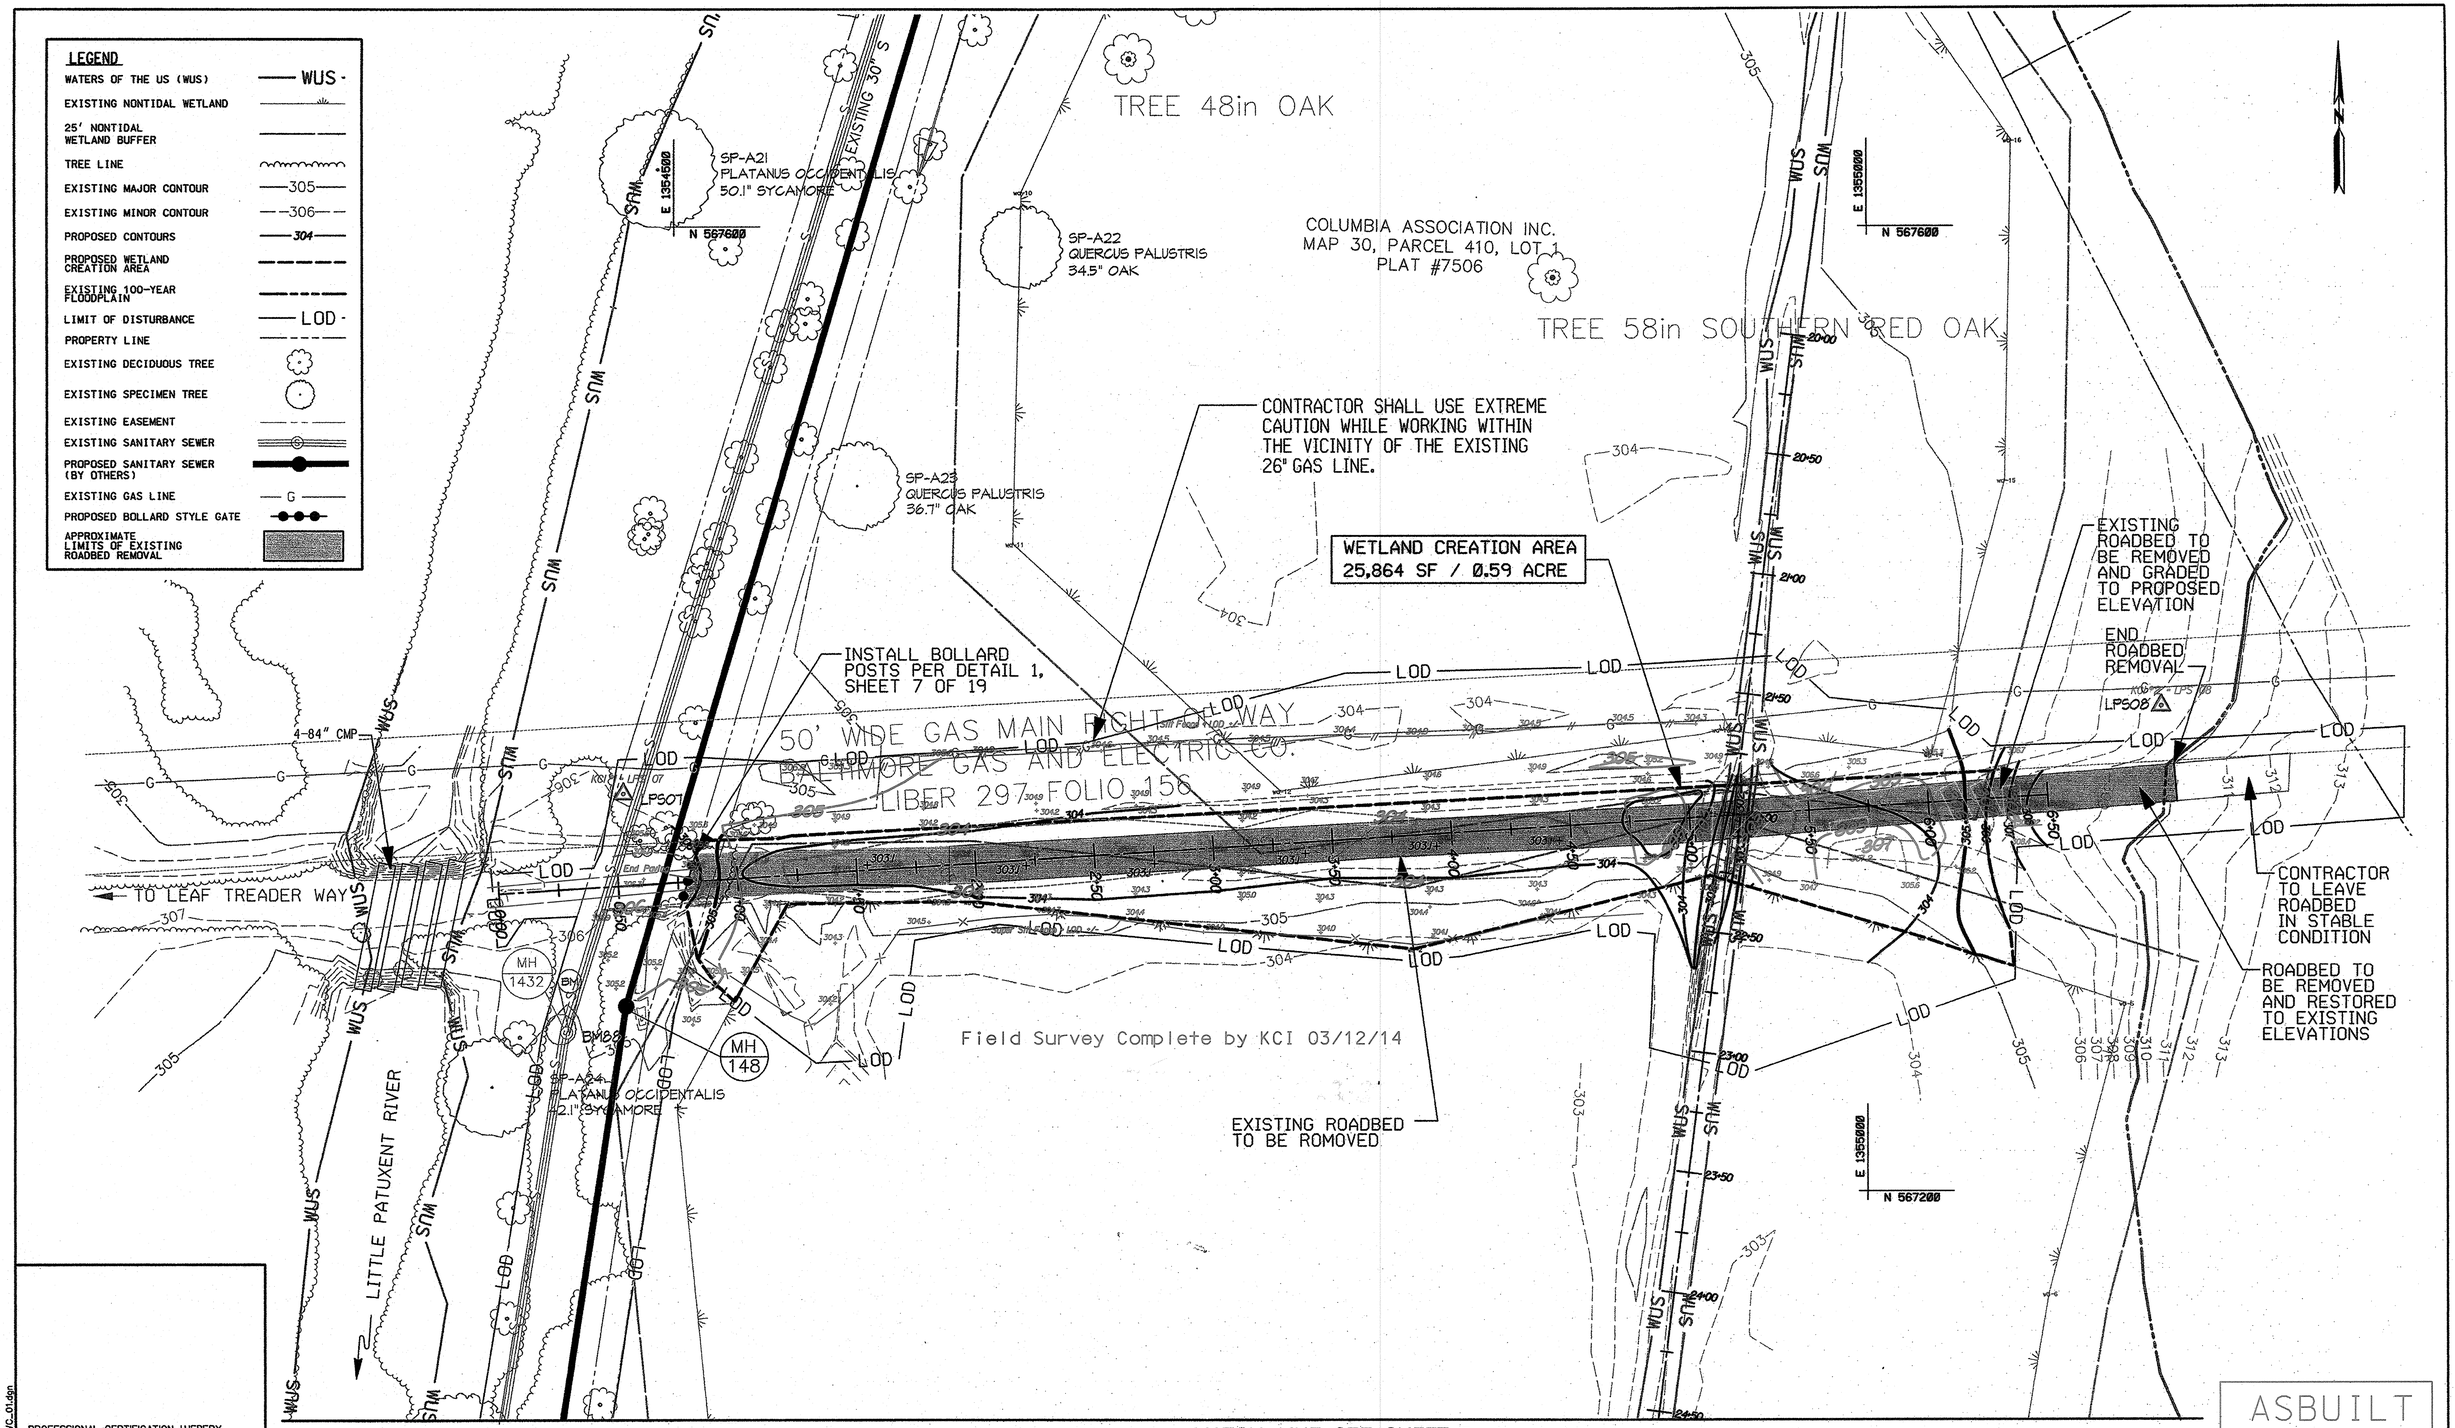

ASBUILT
Sheet 3 of 3

PROFESSIONAL CERTIFICATION. I HEREBY CERTIFY THAT THESE DOCUMENTS WERE PREPARED OR APPROVED BY ME, AND THAT I AM A DULY LICENSED PROFESSIONAL ENGINEER UNDER THE LAWS OF THE STATE OF MARYLAND, LICENSE NO. 20903 EXPIRATION DATE: 07-18-2013

PLOTTED:"08:27 AM, on Friday, July 27, 2012"
FILE: M:\2008\0068795.14\Drawings\04-SWT_WC_01.dgn

DEPARTMENT OF PUBLIC WORKS
HOWARD COUNTY, MARYLAND

DIRECTOR OF PUBLIC WORKS	DATE	CHIEF, BUREAU OF ENGINEERING	DATE 8/16/12
CHIEF, BUREAU OF UTILITIES	DATE 8/17/12	CHIEF/UTILITY DESIGN DIVISION	DATE 8/16/12

KCI TECHNOLOGIES
ENGINEERS PLANNERS SCIENTISTS CONSTRUCTION MANAGERS
936 RIDGEBROOK ROAD SPARKS, MARYLAND 21152
TELEPHONE: (410) 316-7800
FAX: (410) 316-7818

DES: ES/JK/JB				
DRN: KP/CD/MP				
CHK: JK/JB/JK				
DATE: JULY 2012	BY	NO.	REVISION	DATE

WETLAND CREATION AREA PLAN SHEET

600' SCALE MAP NO. _____ BLOCK NO. _____

LEAFTREADER WAY WETLAND MITIGATION SITE

SECTION 7, AREA 10
CAPITAL PROJECT No. S-6175

ELECTION DISTRICT NO. 15 HOWARD COUNTY, MARYLAND

SCALE 1" = 30'

SHEET 4 OF 16