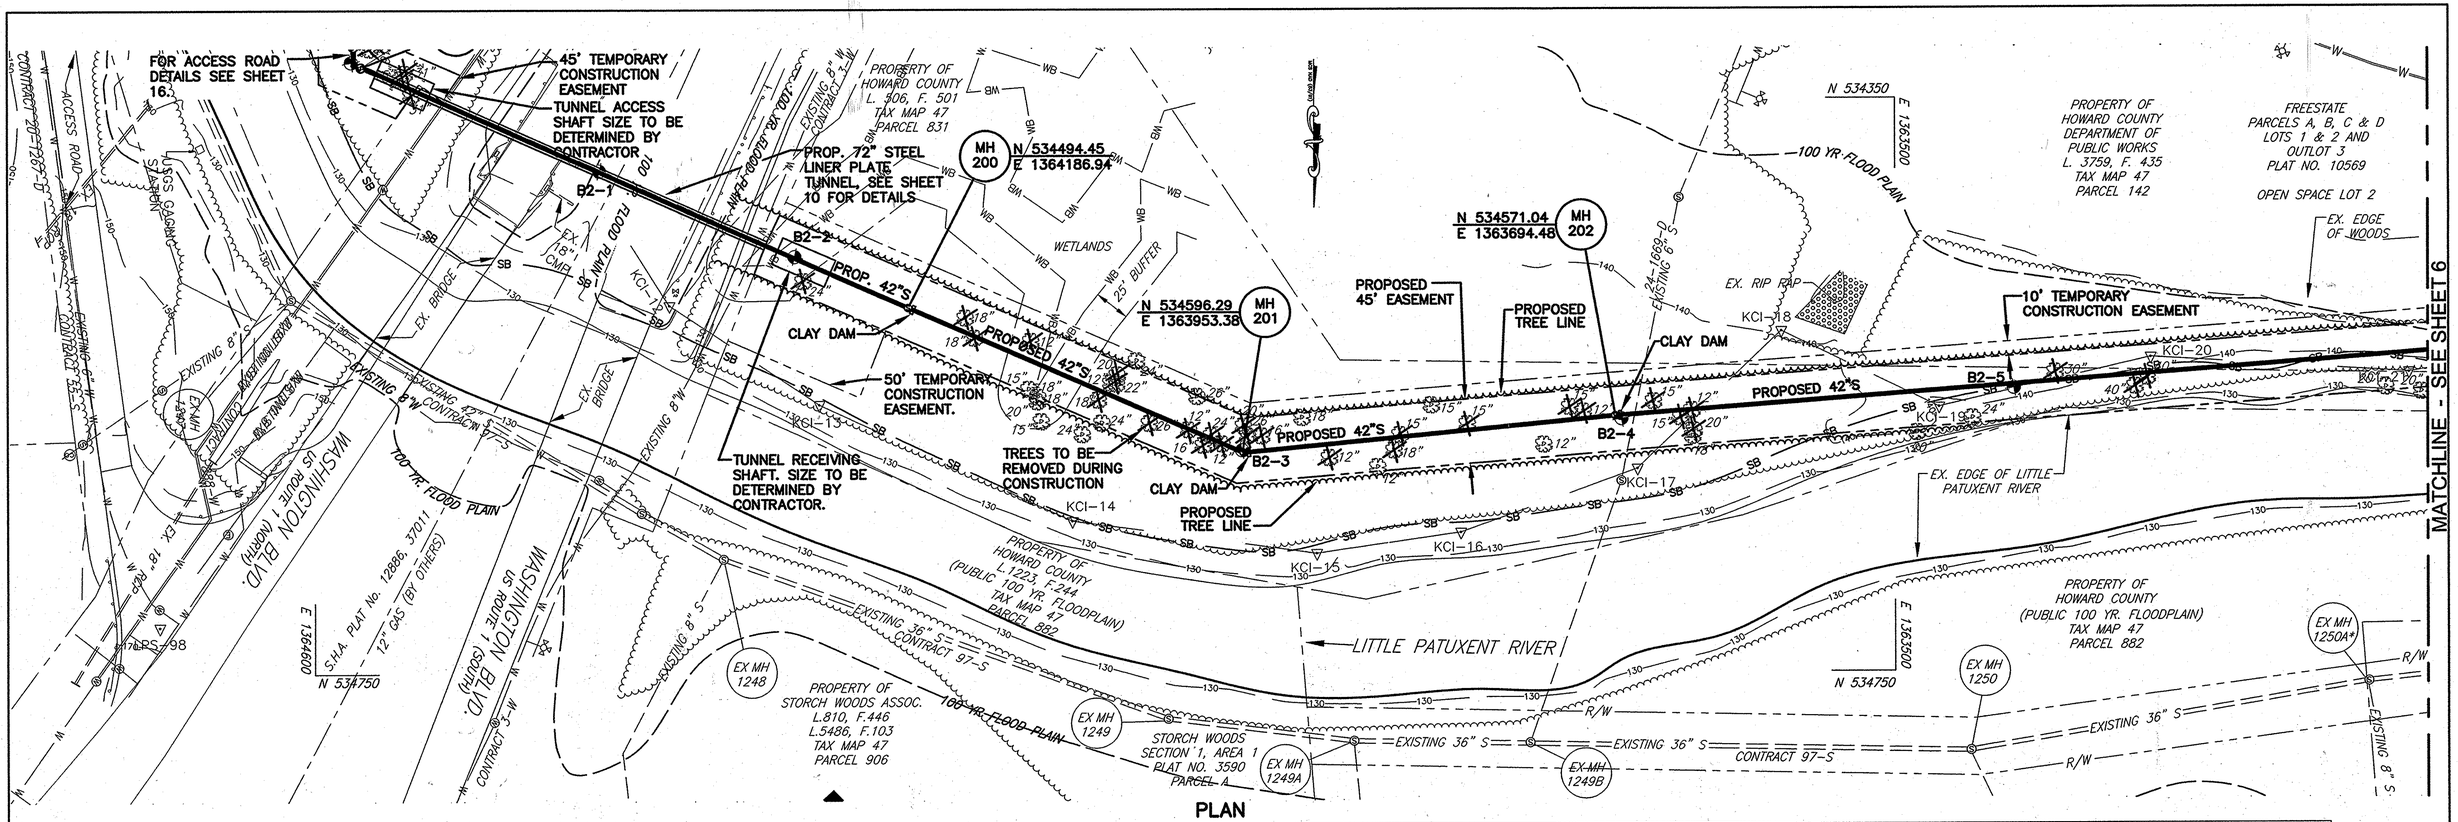

PLAN

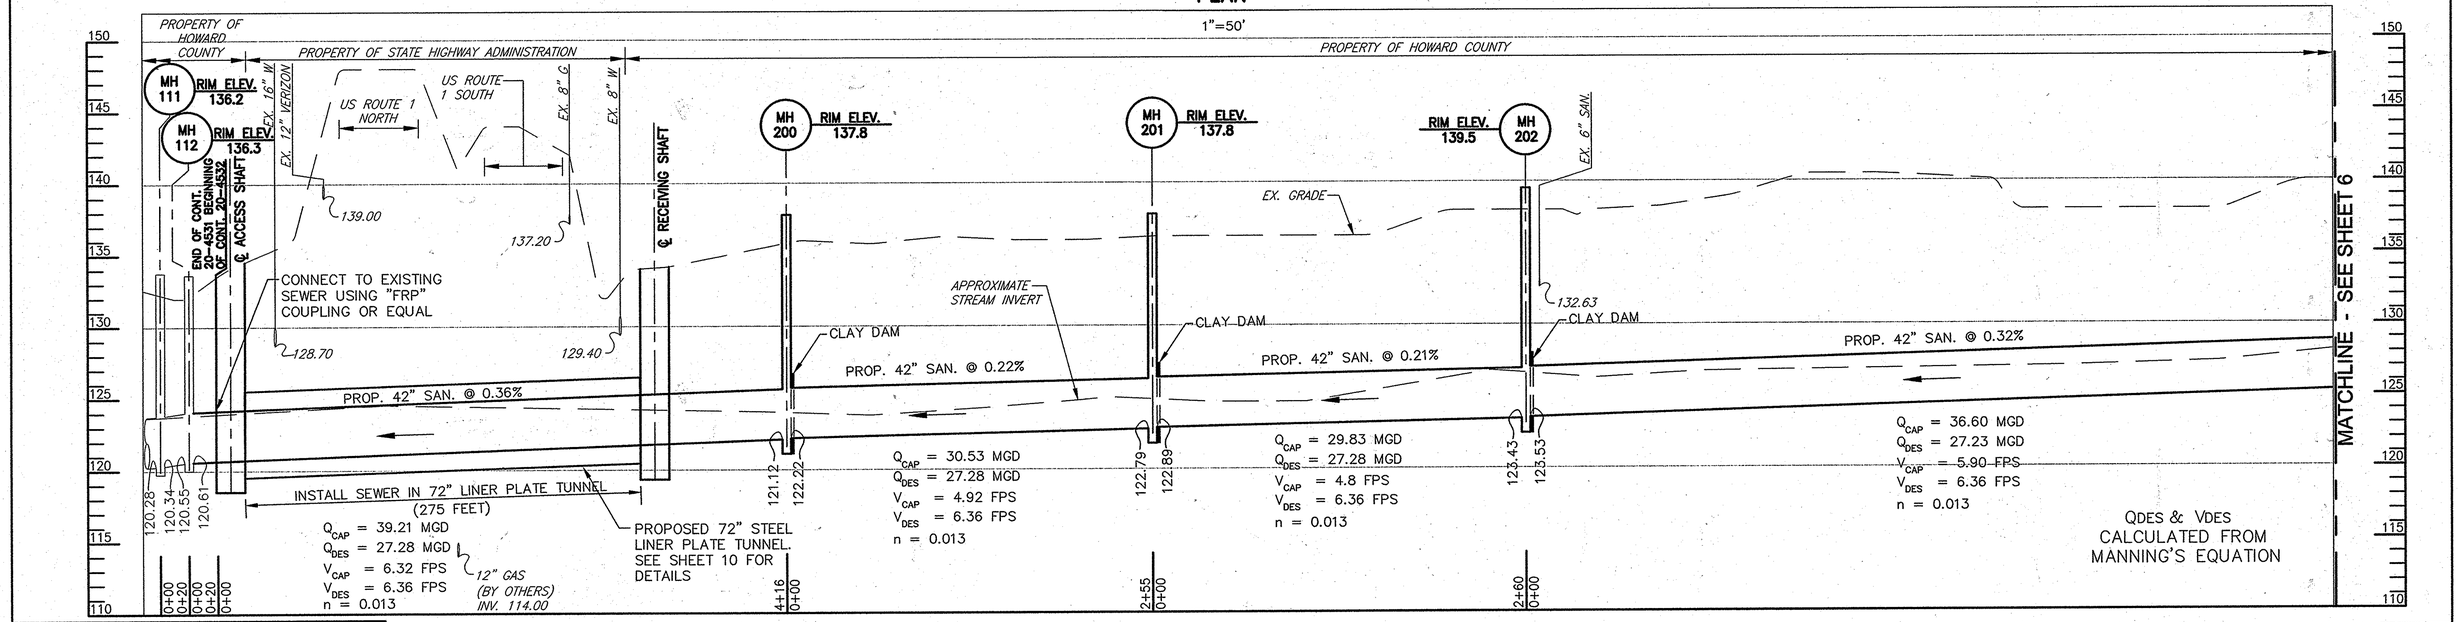

PROFILE

HORIZONTAL: 1"=50'
VERTICAL: 1"=5'

PROFESSIONAL CERTIFICATION

I HEREBY CERTIFY THAT THESE DOCUMENTS WERE PREPARED OR APPROVED BY ME, AND THAT I AM A DULY LICENSED PROFESSIONAL ENGINEER UNDER THE LAWS OF THE STATE OF MARYLAND.

LICENSE NO. 8146 EXPIRATION DATE: 10/8/11

AS-BUILT

DEPARTMENT OF PUBLIC WORKS
HOWARD COUNTY, MARYLAND

DIRECTOR OF PUBLIC WORKS — DATE 12/12/08
CHIEF, BUREAU OF ENGINEERING — DATE 12/12/08
CHIEF, BUREAU OF UTILITIES — DATE 12/12/08
CHIEF, UTILITY DESIGN DIVISION — DATE 12/11/08

Patton Harris Rust & Associates, Inc.
Engineers. Surveyors. Planners. Landscape Architects.
8818 Centre Park Drive
Columbia, MD 21045
T 410.997.8900
F 410.997.9282

PHR+A

STATE OF MARYLAND — MICHAEL G. GOLDBERG — NO. 8146 — REGISTERED PROFESSIONAL ENGINEER — 8/9/11

DES: C.H.
DRN: K.L.B.
CHK: G.C.L.
DECEMBER, 2008

BY	NO.	REVISION	DATE
R.J.C.		AS-BUILT	12/10

PLAN AND PROFILE

600' SCALE MAP 47 — BLOCK 10, 16, 17 ,& 18

LITTLE PATUXENT
PARALLEL INTERCEPTOR SEWER
CAPITAL PROJECT S-6175
CONTRACT NO. 20-4532
1ST ELECTION DISTRICT
HOWARD COUNTY, MARYLAND

SCALE AS SHOWN

SHEET 5 OF 27

P:\projects\14704\1-0\Env\Plans\Contract 2\AS-BUILT\05-AS-BUILT-Plan & Profile.dwg, 7/15/2011 10:00:41 AM, \\cmb-svr-01\CMB HP Designjet 1050 HPGL