




GENERAL NOTES

- THE PROJECT IS IN CONFORMANCE WITH THE LATEST HOWARD COUNTY STANDARDS UNLESS WAIVERS HAVE BEEN APPROVED.
- PROJECT BACKGROUND:  
LOCATION: GORMAN ROAD • STEPHENS ROAD  
TAX MAP: 36-18, 37-13  
ZONING: R-ED  
ELECTION DISTRICT: G  
GROSS AREA OF TRACT: 8.05 ACRES
- SEE DEPARTMENT OF PLANNING + ZONING FILE NUMBERS:  
S 00-13, WP 01-60, PB 345, F 01-117, P 01-15, F 01-204.5 02-21 + P 03-14.
- THE TOPOGRAPHY SHOWN HAS A 2' CONTOUR INTERVAL AND WAS DETERMINED BY AERIAL PHOTOGRAPHY BY DAFT, McCUNE + WALKER, SUMMER 1998.
- PUBLIC WATER AND SEWER TO BE UTILIZED.  
SITE IS IN METROPOLITAN DISTRICT.
- HORIZONTAL AND VERTICAL CONTROL BASED ON HOWARD COUNTY CONTROL STATIONS 47 EA + E4.
- INFORMATION CONCERNING UNDERGROUND UTILITIES WAS OBTAINED FROM BEST AVAILABLE RECORDS. THE CONTRACTOR MUST DETERMINE THIS EXACT LOCATION AND ELEVATION OF THE MAINS BY DIGGING TEST PITS BY HAND AT ALL CROSSINGS WELL IN ADVANCE OF CONSTRUCTION. ANY DISCREPANCIES MUST BE COMMUNICATED TO THE ENGINEER AT ONCE.
- ALL CONSTRUCTION SHALL BE IN ACCORDANCE WITH THE LATEST STANDARDS AND SPECIFICATIONS OF HOWARD COUNTY AND MSHA STANDARDS AND SPECIFICATIONS, IF APPLICABLE.
- THE CONTRACTOR SHALL NOTIFY THE DEPARTMENT OF PUBLIC WORKS /DIVISION OF CONSTRUCTION INSPECTION AT 1 (410) 313 - 1880 AT LEAST FIVE (5) DAYS PRIOR TO THE START OF WORK.
- THE CONTRACTOR SHALL NOTIFY THE FOLLOWING UTILITIES OR AGENCIES AT LEAST FIVE (5) WORKING DAYS BEFORE STARTING WORK SHOWN ON THE PLANS.  
MIS UTILITY 1-800-257-7777  
VERIZON 1-800-446-5266  
HOWARD COUNTY BUREAU OF UTILITIES 410-313-4900  
AT+T CABLE LOCATION DIVISION 393-3553  
BALTIMORE GAS + ELECTRIC CO. 410-850-4620 + 410-787-9068
- TRENCH COMPACTION FOR STORM DRAINS WITHIN ROADS AND STREET RIGHT - OF - WAYS LIMITS SHALL BE IN ACCORDANCE WITH 'HOWARD COUNTY DESIGN MANUAL', VOL. IV, STANDARD G-2.01.
- SEDIMENT CONTROL SHALL BE PROVIDED IN ACCORDANCE WITH '1994 MARYLAND STANDARDS AND SPECIFICATION FOR SOILS EROSION AND SEDIMENT CONTROL'.
- TRAFFIC CONTROL DEVICES, MARKINGS, AND SIGNING SHALL BE IN ACCORDANCE WITH THE LATEST EDITION OF THE MANUAL ON UNIFORM TRAFFIC CONTROL DEVICES (MUTCD).
- STREET TREES SHALL BE PLANTED A MINIMUM OF FIVE (5) FEET FROM STORM DRAIN, WATERLINE OR SEWER PIPE MANHOLES; ALSO A MINIMUM OF TWENTY (20) FEET FROM STREET LIGHTS.
- COMPACTION IN FILL AREAS SHALL BE IN ACCORDANCE WITH AASHTO T-180 OR AS APPROVED IN THE DESIGN MANUAL VOLUME IV.
- WETLAND, STREAM, STEEP SLOPE, AND FOREST COVER DELINEATION BY DAFT, McCUNE AND WALKER.
- TRAFFIC STUDY WAS APPROVED AS PART OF THE SKETCH PLAN ON OCTOBER 10, 2000.
- ALL ROADS IN THIS DEVELOPMENT ARE PRIVATE.
- STREET TREE LOCATIONS SHOWN ARE TENTATIVE AND ARE TO BE USED FOR BOND PURPOSES ONLY. THE FINAL LOCATION AND VARIETY OF TREES MAY VARY TO ACCOMMODATE FIELD CONDITIONS AND BUILDERS LANDSCAPE PROGRAM.
- LANDSCAPING FOR THIS PROJECT HAS BEEN PREPARED ACCORDING TO THE ALTERNATIVE COMPLIANCE PORTION OF THE LANDSCAPE MANUAL (CHAPTER VD).
- NOISE STUDY WAS APPROVED AS PART OF THE SKETCH PLAN OCTOBER 10, 2000.
- ON JANUARY 16, 2001, WP 01-60, WAIVER OF SECTION 16.120 c (2) WAS GRANTED WHICH REQUIRES ALL LOTS TO HAVE FRONTAGE ON A PUBLIC ROAD, AND SECTION 16.120 c (4) WHICH LIMITS THE LENGTH OF A PRIVATE ROAD FOR SFA UNITS TO 200, SUBJECT TO ONE CONDITION IN THE APPROVAL LETTER.
- LANDSCAPE SCHEDULE A, PERIMETER LANDSCAPE EDGE, FOR LOTS A-1, A-6, A-55, A-56, A-28, A-59, A-60, D-6, D-7 + D-11 AND THE SCHEDULE C, RESIDENTIAL DEVELOPMENT INTERNAL LANDSCAPING WILL BE SUBMITTED AND APPROVED UNDER THE SITE DEVELOPMENT PLANS.
- STORMWATER MANAGEMENT COMPUTATIONS AND PLANS SUBMITTED AND APPROVED UNDER F 01-177, FEBRUARY 27, 2002 AND F 01-204, JUNE 5, 2002. PARCELS A AND D DRAIN TO THE EXISTING QUARRY.
- THERE ARE NO 100-YEAR FLOOD PLAIN WITHIN THE BOUNDARY OF THIS PROJECT.

# CONSTRUCTION PLANS FOR STONE LAKE

## LOTS A-1 thru A-6, A-26 thru A-28, A-37 thru A-66, LOTS D-1 thru D-14 and Lot 122 A RESUBDIVISION OF PARCELS A&D AND OPEN SPACE LOT 38

LAKE EDGE DRIVE, MISTY WATER WAY, MIRROR LAKE WAY, & BOULDER HILL PLACE

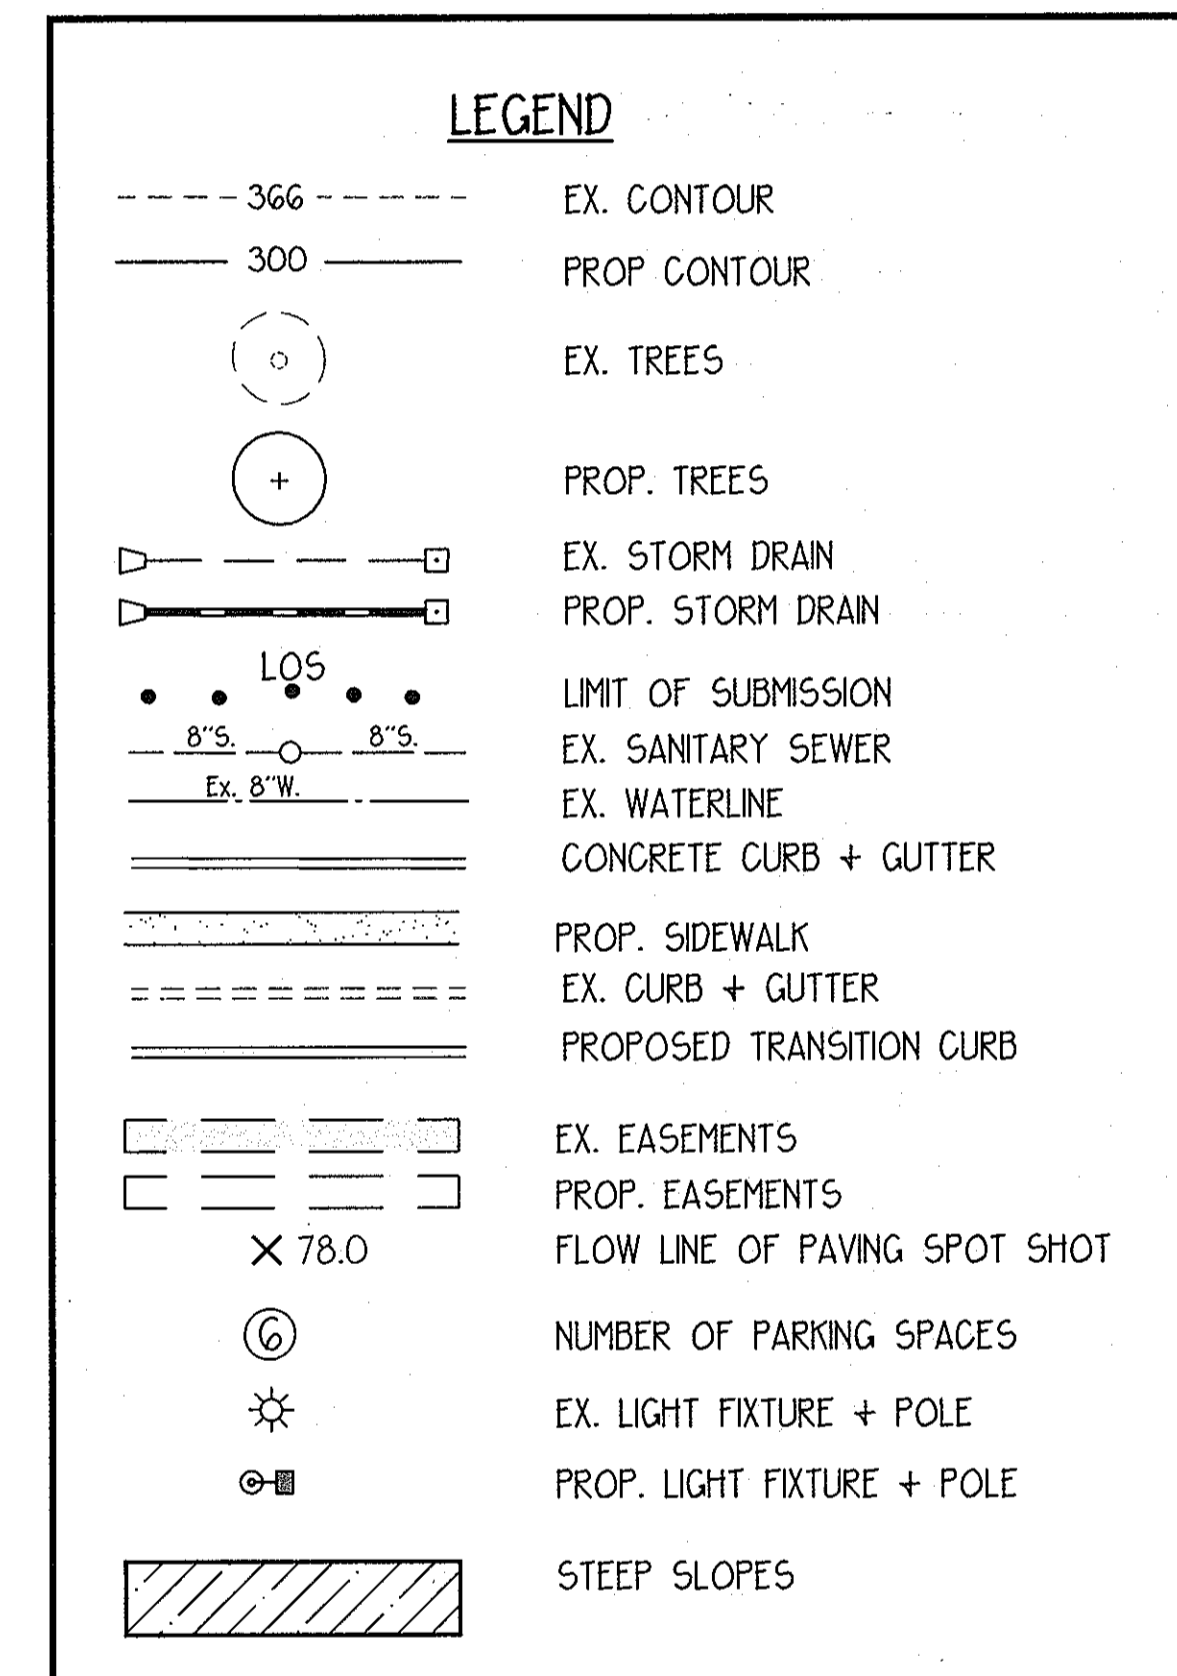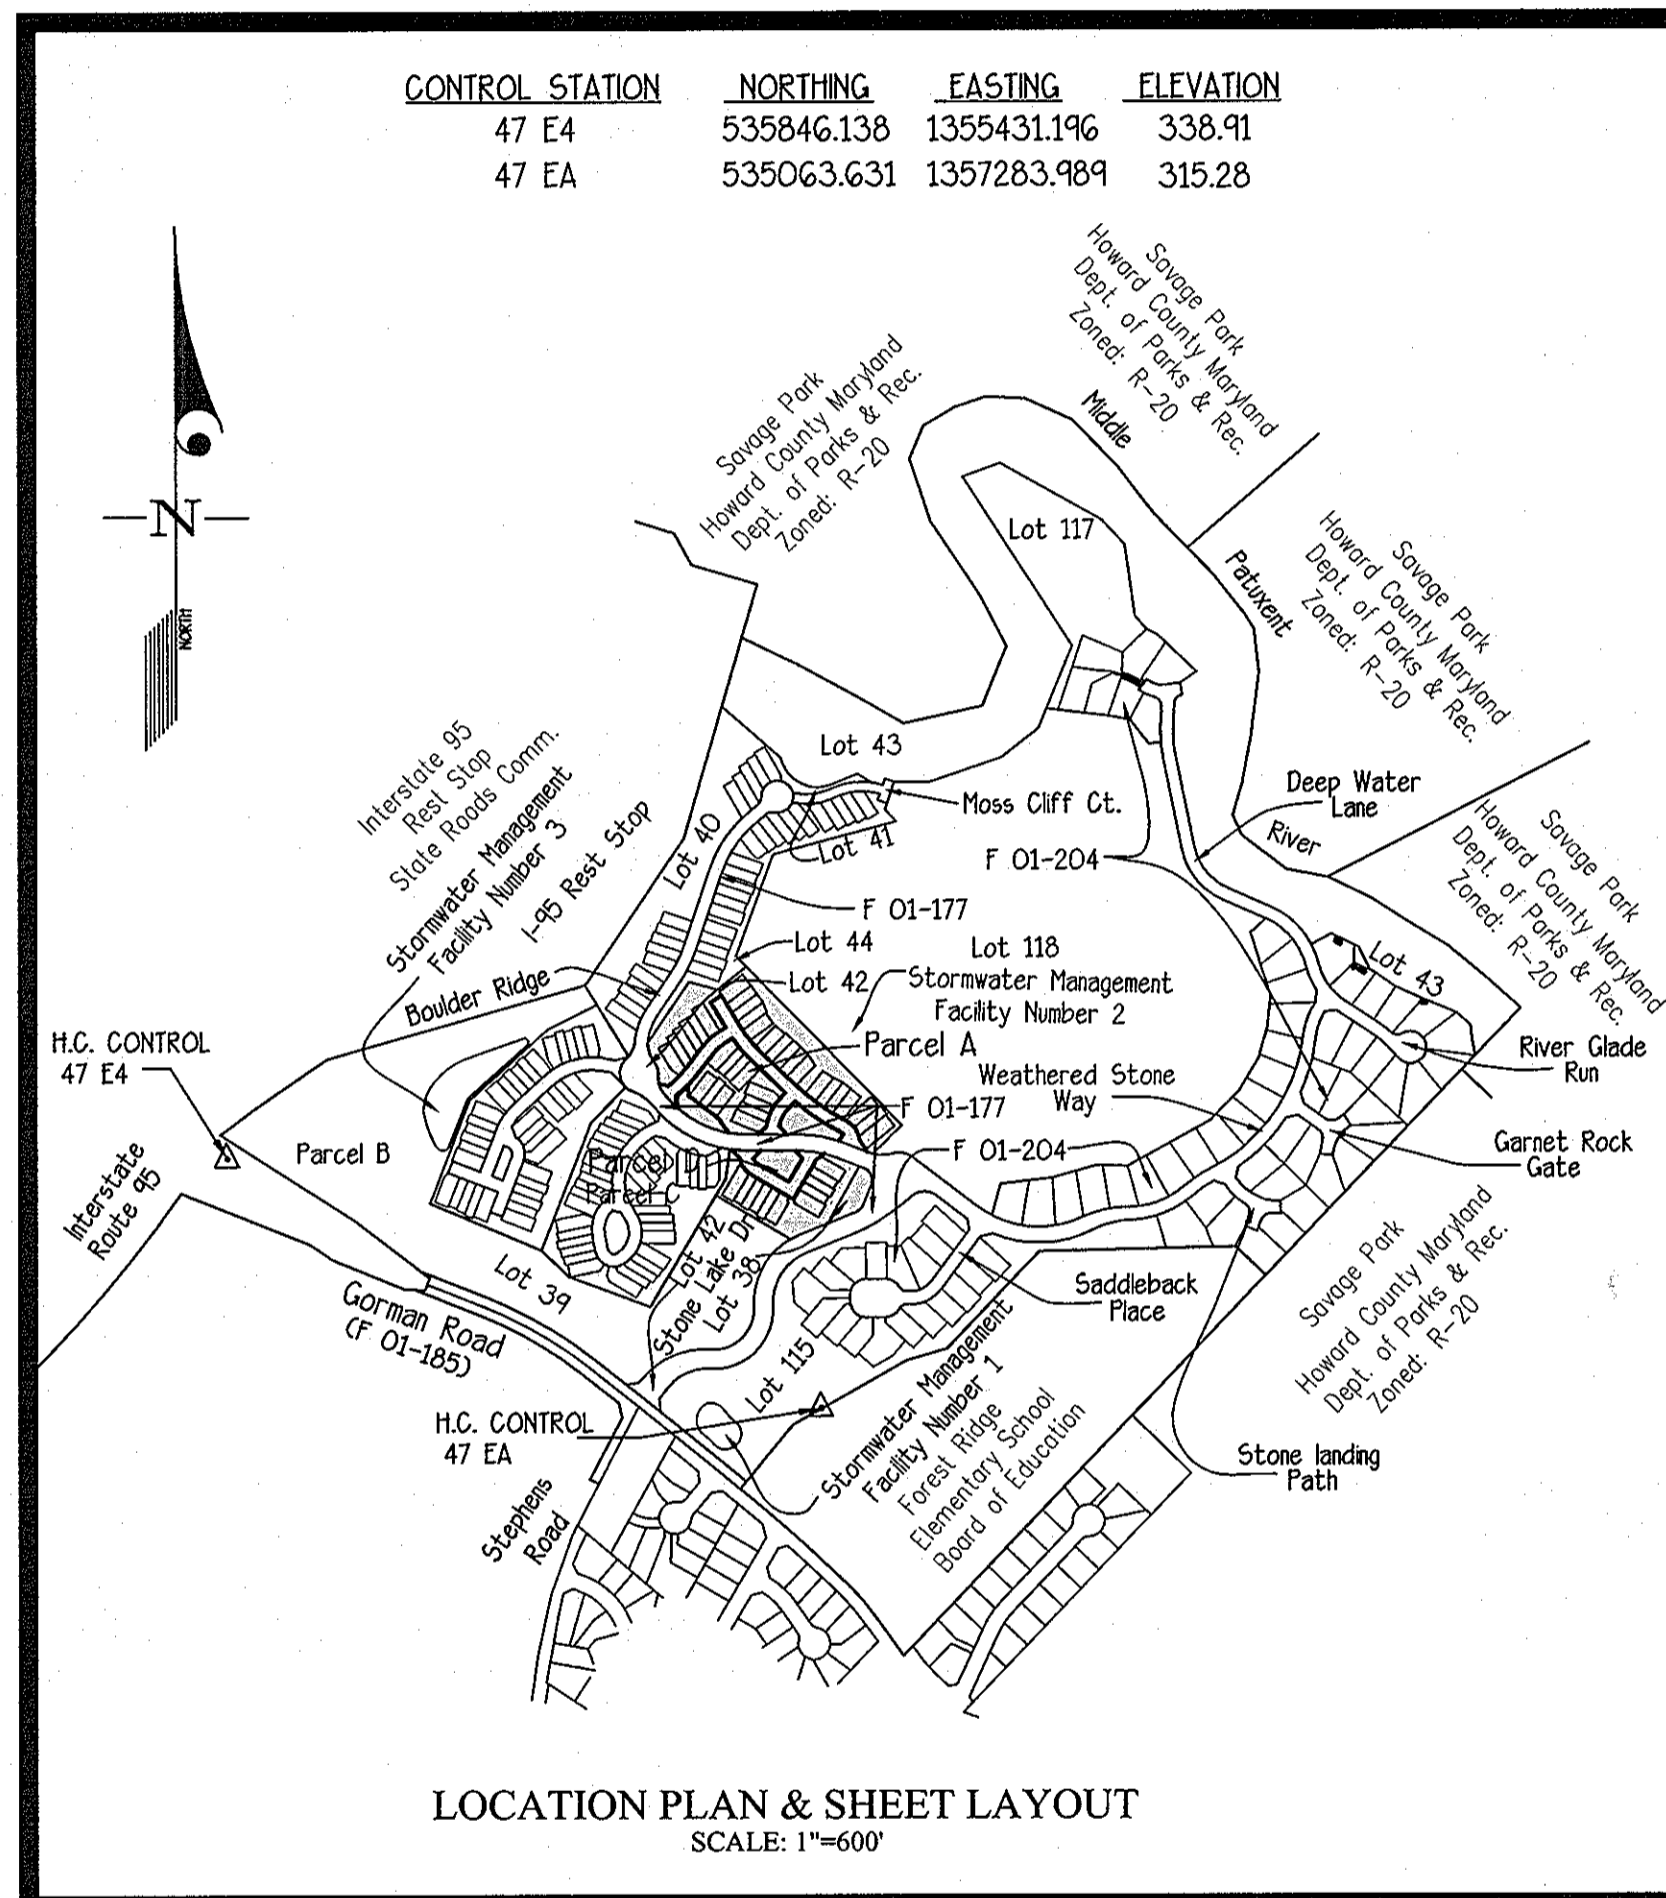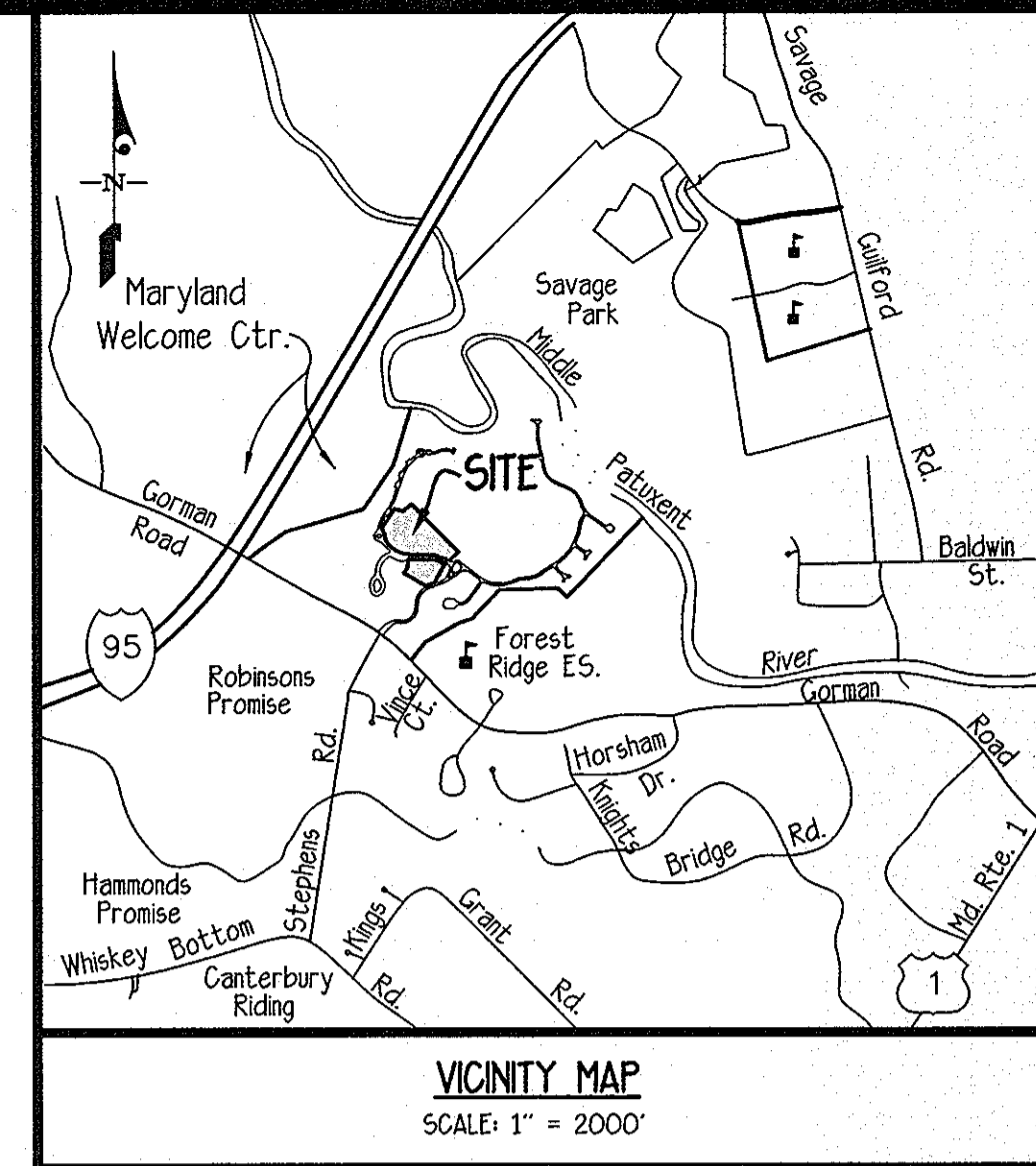

Parking Requirements:

Parcel A:  
Total Parking Required: 34 units x 2 spaces/unit = 68 Spaces  
Garages: 68 Spaces (2 ea. SFA)  
Driveways: 34 Spaces (1 ea. SFA)  
Surfaces: 36 Spaces  
Total: 138 Spaces

Overflow/Guest Parking Requirements (per Design Manual Volume II, 2.8.2)

Parking Required: 34 units x 0.5 spaces per unit = 17 spaces  
Overflow/Guest Parking provided: 77 spaces (138 - 68 = 70)

Parcel D:  
Total Parking Required: 11 units x 2 spaces/unit = 22 Spaces  
Garages: 22 Spaces (2 ea. SFA)  
Driveways: 11 (1 ea. SFA)  
Surfaces: 16 Spaces  
Total: 49 Spaces

Overflow/Guest Parking Requirements (per Design Manual Volume II, 2.8.2)

Parking Required: 11 units x 0.5 spaces per unit = 6 spaces  
Overflow/Guest Parking provided: 27 spaces (49 - 22 = 27)



OWNER & PREPARED FOR:  
LOTS A-1 THRU A-6, A-26 THRU A-28, A-37 THRU A-66, LOTS D-1 THRU D-14 AND LOT 122  
THRU A-63, and D-1 THRU D-11  
MILLER & SMITH  
8401 GREENSBORO DRIVE, SUITE 300  
McLEAN, VIRGINIA 22101  
ATTN: COLLEEN DWELLEY  
(703) 821-2500 ext. 236

Sheet Index

- COVER SHEET
- PLAN AND PROFILES: LAKE EDGE DRIVE, MISTY WATER WAY + MIRROR LAKE WAY.
- PLAN AND PROFILES: BOULDER HILL PLACE.
- SITE + LANDSCAPE DETAIL SHEET
- GRADING PLAN
- STORM DRAIN PROFILES
- STORM DRAIN DRAINAGE AREA MAP
- SEDIMENT CONTROL PLAN
- SEDIMENT CONTROL DETAILS

NOTE: THESE REPLACEMENT SHEETS SUPERCEDES THE PLAN SHEET DATED DEC., 2003

APPROVED: HOWARD COUNTY DEPARTMENT OF PUBLIC WORKS  
PRIVATE ROADS, DRAINS + SWM  
Chief, Bureau of Highways  
Date: \_\_\_\_\_

APPROVED: HOWARD COUNTY DEPARTMENT OF PLANNING + ZONING  
Chief, Division of Land Development  
Date: \_\_\_\_\_

APPROVED: HOWARD COUNTY DEPARTMENT OF PLANNING + ZONING  
Chief, Development Engineering Division  
Date: \_\_\_\_\_

GLWGUTSCHICK LITTLE & WEBER, P.A.  
CIVIL ENGINEERS, LAND SURVEYORS, LAND PLANNERS, LANDSCAPE ARCHITECTS  
3909 NATIONAL DRIVE - SUITE 250 - BURTONSVILLE OFFICE PARK  
BURTONSVILLE, MARYLAND 20866  
TEL: 301-421-4024 BAL: 410-880-1820 DC/VA: 301-989-2524 FAX: 301-421-4186

OWNER & PREPARED FOR:  
STONE LAKE COMMUNITY ASSOCIATION, INC.\*  
C/O THE HOWARD RESEARCH & DEVELOPMENT CORP.  
THE ROUSE BUILDING  
10275 LITTLE PATUXENT PARKWAY  
COLUMBIA, MARYLAND 21044  
ATTN: JOE NECKER  
TELE: (410) 992-6084

COVER SHEET  
STONE LAKE  
LOTS A-1 thru A-6, A-26 thru A-28, A-37 thru A-66, LOTS D-1 thru D-14 AND LOT 122  
A RESUBDIVISION OF PARCELS 'A' & 'D' AND OPEN SPACE LOT 38  
FLAT No's 15274 & 15275  
ELECTION DISTRICT No. 6  
HOWARD COUNTY, MARYLAND

SCALE	ZONING	G. L. W. FILE No.
AS SHOWN	NT	99140
DATE	TAX MAP - GRID	SHEET
Sept., 2005	47-9/10 P/O PARCEL 837	1 OF 9

DATE	DESCRIPTION	BY	APPR.
09-08	Changed Title Block Lot Numbers, General Notes 23 + 24 Location Plan, Owner Designation	BJM	mjl
	REVISION	BY	APPR.

04-78

PT. No.	STATION	OFFSET	ELEV.
1	0+12.00	29.99' Rt.	332.12
2	0+15.65	17.49' Rt.	331.43
3	0+25.44	12.00' Rt.	331.10
4	0+63.20	12.00' Rt.	329.88
5	1+00.95	12.00' Rt.	329.22
6	1+11.19	12.00' Rt.	329.04
7	2+05.35	12.00' Rt.	327.37
8	2+99.51	12.00' Rt.	325.70
9	4+64.56	12.00' Rt.	322.79
10	5+10.37	12.00' Rt.	321.98
11	5+56.19	12.00' Rt.	321.16
12	6+70.11	12.00' Rt.	319.63
13	6+70.11	12.00' Lt.	319.63
14	6+60.11	12.00' Lt.	319.69
15	6+55.11	17.00' Lt.	319.78
16	6+55.11	30.00' Lt.	320.17
17	5+92.11	30.00' Lt.	321.07
18	5+42.11	17.00' Lt.	320.68
19	5+87.11	12.00' Lt.	320.62
20	2+99.57	12.00' Lt.	320.34
21	2+88.03	12.00' Lt.	320.01
22	2+44.64	12.00' Lt.	318.94
23	2+11.24	12.00' Lt.	317.86
24	1+37.24	12.00' Lt.	315.79
25	1+19.46	12.00' Lt.	315.29
26	1+01.50	12.00' Lt.	314.79
27	0+46.25	17.00' Lt.	314.79
28	0+46.25	30.00' Lt.	315.18
29	0+57.49	30.00' Lt.	314.09
30	0+57.49	17.00' Lt.	313.07
31	0+52.49	12.00' Lt.	313.41
32	0+38.91	12.00' Lt.	313.03
33	0+22.15	21.09' Lt.	312.56
34	0+20.63	40.10' Lt.	312.00
35	0+32.62	33.38' Rt.	314.14
36	0+18.00	18.36' Rt.	312.46
37	0+29.54	14.74' Rt. Δ	312.76 Δ
38	101+99.67	12.24' Rt. Δ	313.02 Δ
39	1+00.77	12.00' Rt.	314.77
40	1+37.42	12.00' Rt.	315.79
41	2+11.42	12.00' Rt.	317.87
42	2+44.64	12.00' Rt.	318.94
43	2+88.03	12.00' Rt.	320.01
44	3+00.27	12.00' Rt.	320.36 Δ

PT. No.	STATION	OFFSET	ELEV.
45	5+34.75	12.00' Lt. Δ	321.54 Δ
46	Δ	Δ	Δ
47	Δ	Δ	Δ
48	Δ	Δ	Δ
49	4+68.55	12.00' Lt.	322.71
50	4+01.20	12.00' Lt.	323.91
51	3+96.20	17.00' Lt.	324.14
52	3+96.20	30.00' Lt.	324.53
53	3+24.20	17.00' Lt.	325.42
54	3+24.20	30.00' Lt.	325.81
55	3+19.20	12.00' Lt.	325.36
56	3+14.20	12.00' Lt.	325.44
57	1+57.11	12.00' Lt.	325.62
58	1+27.85	12.00' Lt.	325.22
59	0+81.34	12.00' Lt.	324.80
60	0+34.82	12.00' Lt.	325.63
61	0+17.86	17.86' Lt.	327.03
62	0+12.00	32.00' Lt.	326.80
63	0+12.00	32.00' Rt.	327.25
64	0+17.86	17.86' Rt.	327.02
65	0+32.00	12.00' Rt.	325.71
66	0+52.35	12.00' Rt.	325.16
67	0+58.14	17.12' Rt.	325.20
68	0+58.14	30.00' Rt.	325.59
69	0+93.00	30.00' Rt.	324.44
70	1+27.85	30.00' Rt.	325.76
71	1+46.87	30.00' Rt.	326.07
72	1+46.87	17.00' Rt.	325.68
73	1+51.87	12.00' Rt.	325.62
74	2+61.75	12.00' Lt.	326.37
75	2+52.38	12.00' Lt.	326.54
76	2+47.51	17.00' Lt.	326.77
77	2+47.51	30.00' Lt.	327.16
78	2+07.75	30.00' Lt.	327.87
79	1+67.98	30.00' Lt.	328.57
80	1+67.98	17.00' Lt.	328.18
81	1+63.11	12.00' Rt.	328.12
82	1+37.15	12.00' Rt.	328.58
83	1+37.15	12.00' Rt.	329.22
84	1+00.95	12.00' Rt.	329.76
85	0+70.18	12.00' Rt.	330.31
86	0+39.40	12.00' Rt.	330.64
87	0+21.42	17.06' Rt.	330.75
88	0+12.00	30.17' Lt.	330.75
89	101+92.80	12.00' Lt. Δ	313.28 Δ
90	100+57.19	12.00' Lt. Δ	320.93 Δ
91	100+28.43	15.38' Lt. Δ	322.10 Δ
92	100+19.04	18.30' Lt. Δ	323.27 Δ
93	5+82.02	13.70' Rt. Δ	324.24 Δ
94	5+90.65	12.00' Rt. Δ	323.81 Δ
95	5+20.23	12.00' Rt. Δ	325.47 Δ
96	100+18.30	19.00' Rt. Δ	325.30 Δ
97	100+31.32	12.00' Rt. Δ	324.20 Δ
98	100+40.00	12.00' Rt. Δ	323.12 Δ
99	100+48.85	12.00' Rt. Δ	322.03 Δ
100	101+77.83	12.00' Rt. Δ	314.46 Δ
101	101+89.26	17.28' Rt. Δ	314.08 Δ
102	0+80.83	12.00' Rt. Δ	314.21 Δ

APPROVED: HOWARD COUNTY DEPARTMENT OF PUBLIC WORKS  
 Chief, Bureau of Highways  
 Date: 5/12/08


APPROVED: HOWARD COUNTY DEPARTMENT OF PLANNING + ZONING  
 Chief, Division of Land Development  
 Date: 5/6/08

Chief, Development Engineering Division

STONE LAKE CORPORATION  
 STONE LAKE  
 PARCEL B  
 PLAT No. 15274  
 (F 01-177)  
 (F 04-22)  
 ZONED: R-ED

GOODER BUILDERS AT STONE LAKE  
 LAKE L.C. STONE LAKE  
 LOT C-1 THRU C-39  
 PLAT No. 15478  
 ZONED: R-ED

STONE LAKE  
 LOT 42  
 (COMMON OPEN AREA)  
 PLAT No. 15275 + 15276  
 (F 01-177)

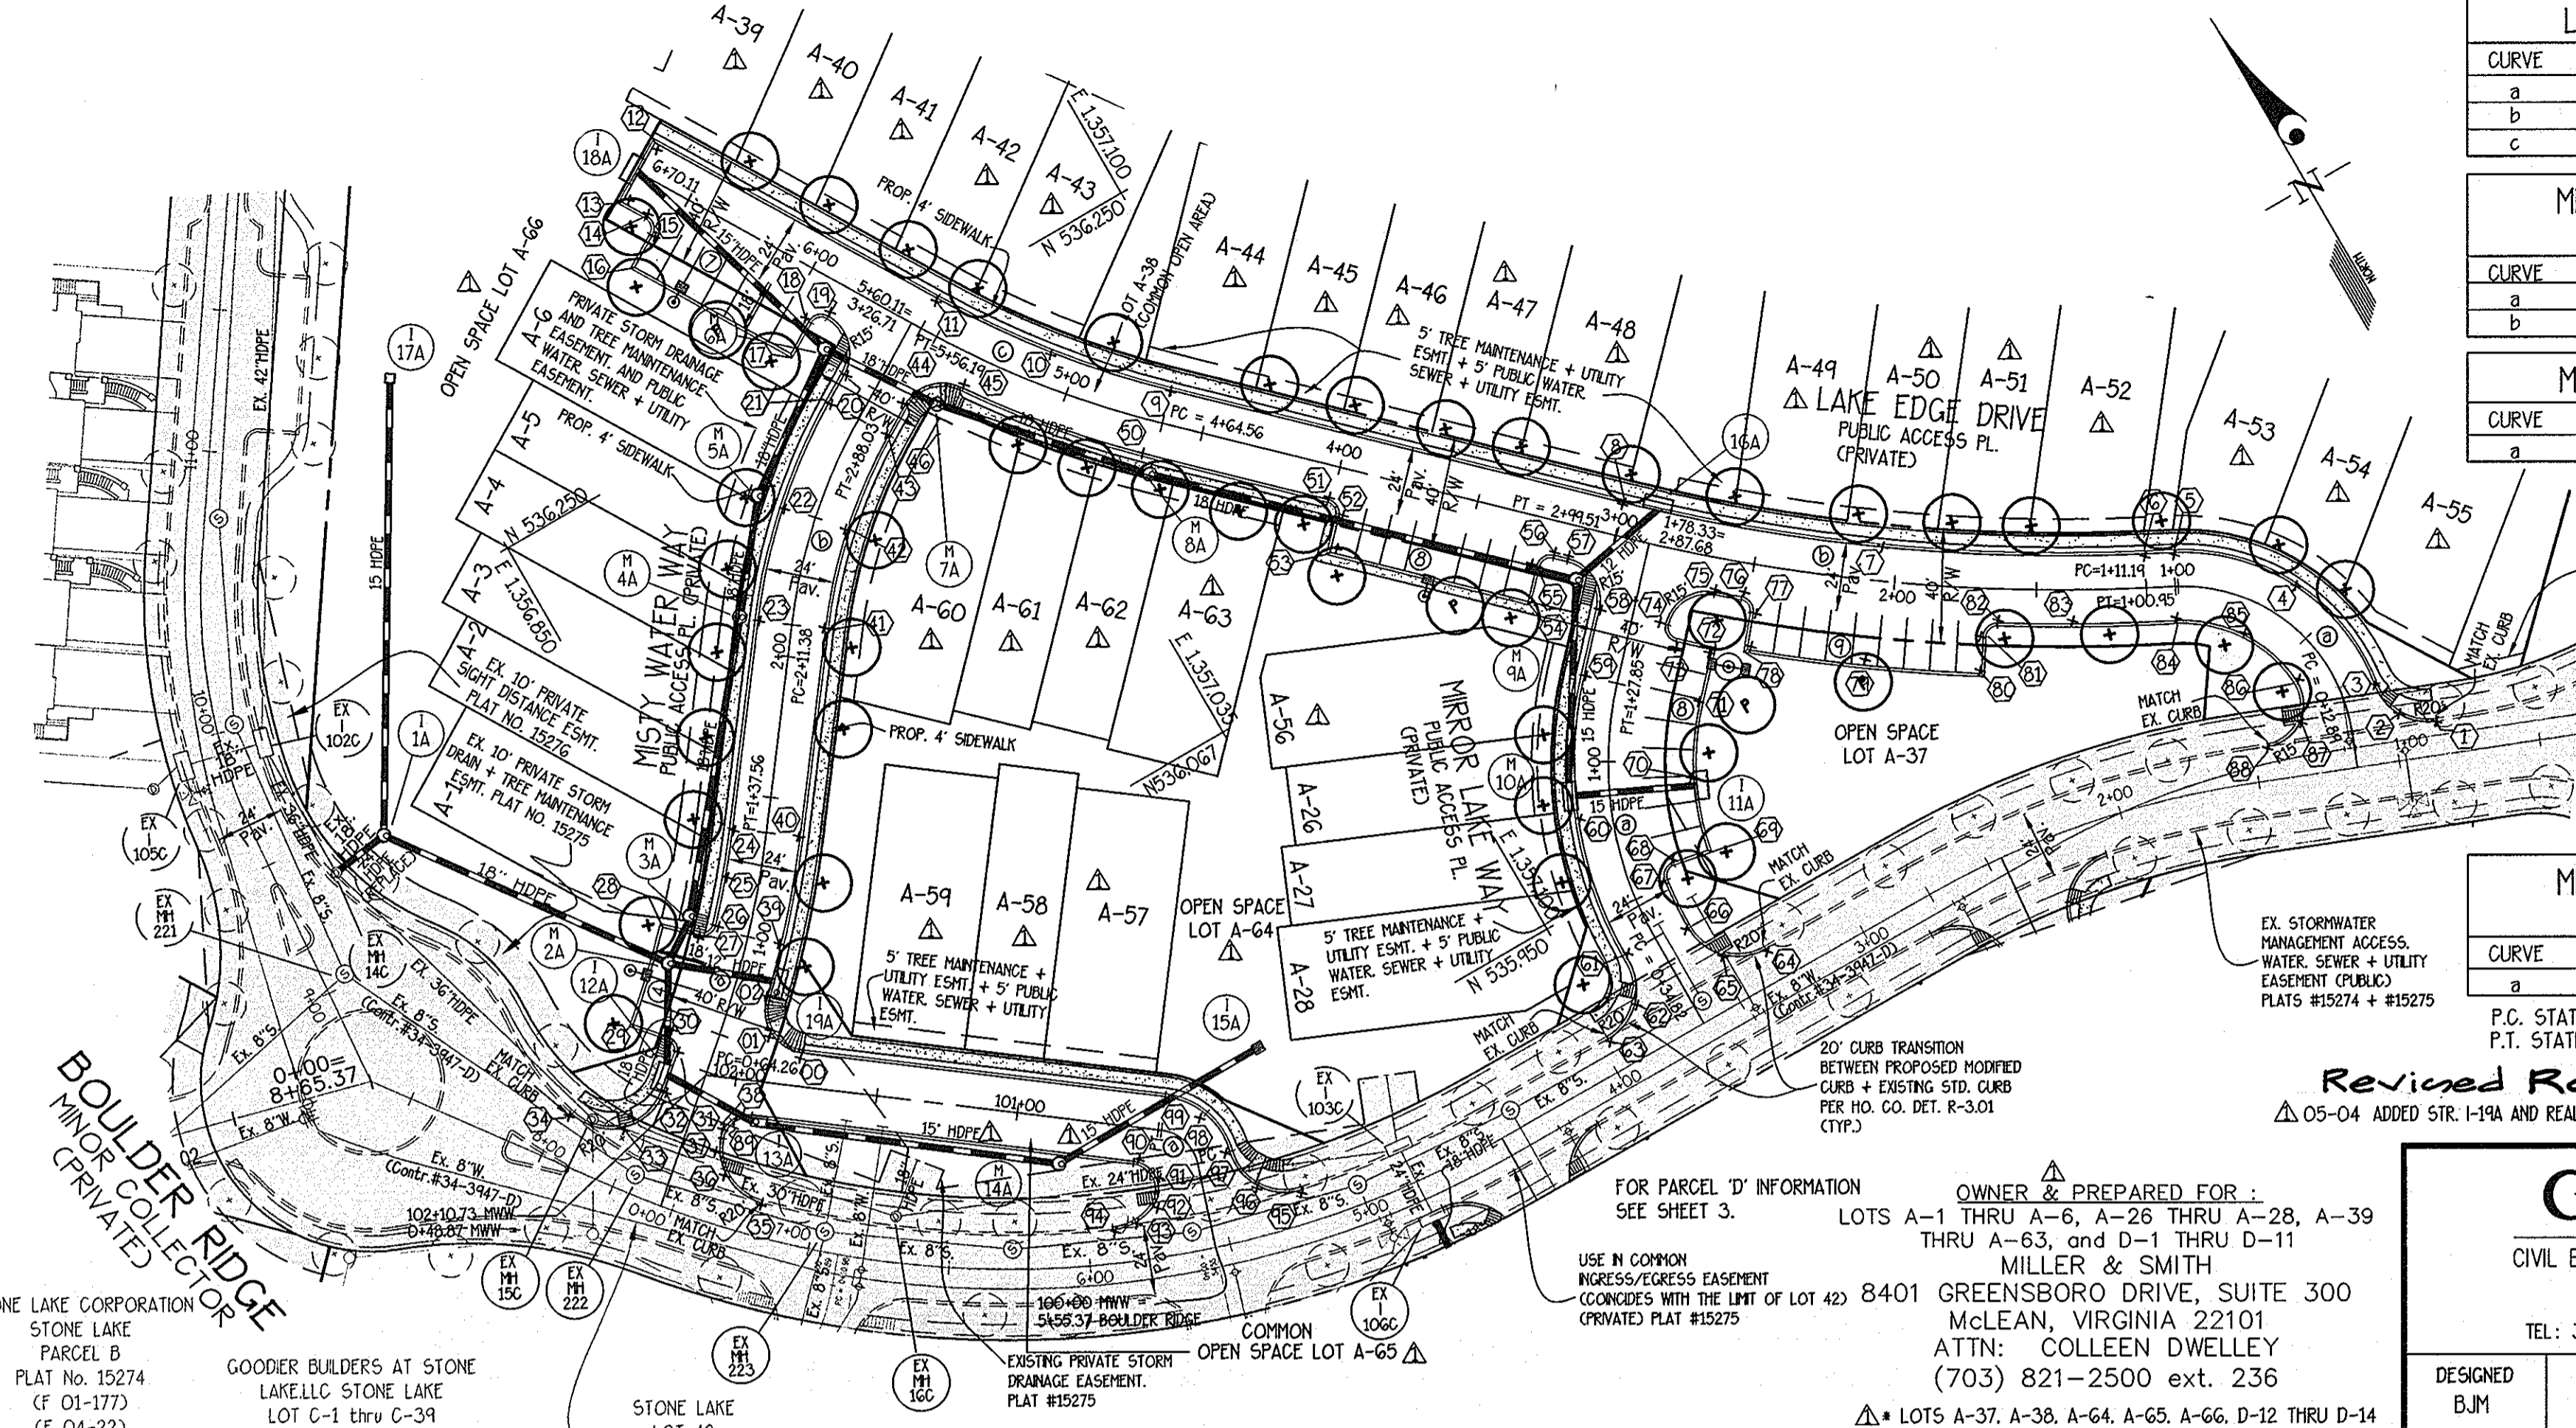

CURVE	LENGTH	RADIUS	TANGENT	CHORD	BEARING	DELTA
a	88.06'	60.00'	54.11'	80.37'	N 20° 43' 10" W	84° 29' 35"
b	188.32'	650.00'	94.82'	187.66'	N 54° 18' 00" W	16° 36' 00"
c	91.63'	350.00'	46.08'	91.37'	S 38° 30' 00" E	15° 00' 00"

CURVE	LENGTH	RADIUS	TANGENT	CHORD	BEARING	DELTA
a	73.30'	350.00'	36.79'	73.17'	N 43° 00' 00" E	12° 00' 00"
b	76.79'	200.00'	38.88'	76.32'	N 48° 00' 00" E	22° 00' 00"

CURVE	LENGTH	RADIUS	TANGENT	CHORD	BEARING	DELTA
a	93.03'	125.00'	48.79'	90.90'	N 72° 38' 10" E	42° 38' 35"

NOTES:  
 1. LOT A-38 IS ALSO A PUBLIC WATER, SEWER + UTILITY EASEMENT.

MISTY WATER WAY CENTERLINE CURVE TABLE  
 STA 100+00 THRU 102+10.73

CURVE	LENGTH	RADIUS	TANGENT	CHORD	BEARING	DELTA
a	18.61'	15.00'	10.71'	17.44'	S 17° 27' 46" E	71° 04' 29"

P.C. STATION = 100+30.25  
 P.T. STATION = 100+48.85

PARCEL A ROAD PLAN  
 PLAN VIEW  
 SCALE: 1" = 50'

STREET TREE SCHEDULE

SYMBOL	NAME (BOTANICAL/COMMON)	SIZE	QUANTITY	REMARKS
Qr	Quercus Rubra / Red Oak	2"-3" Cal. 12"-14" Ht.	51 Δ	B, S FULL HEAD

STREET LIGHT SCHEDULE

LOCATION	LAMP TYPE	MOUNTING	POLE TYPE
C.L. STA. 2+52.66 - 37' L. LAKE EDGE DRIVE	100-W HIGH PRESSURE SODIUM VAPOR	TRADITIONAIRE POST TOP	14' BLACK FIBERGLASS
C.L. STA. 3+60.20 - 37' L. LAKE EDGE DRIVE	100-W HIGH PRESSURE SODIUM VAPOR	TRADITIONAIRE POST TOP	14' BLACK FIBERGLASS
C.L. STA. 6+37.07 - 34' L. LAKE EDGE DRIVE	100-W HIGH PRESSURE SODIUM VAPOR	TRADITIONAIRE POST TOP	14' BLACK FIBERGLASS

Revised Road Construction Plan  
 Δ 05-04 ADDED STR. 1-194 AND REALIGNED STORM DRAIN FROM I-124 THRU I-154. GRADING MODIFIED TO ENABLE NEW LOT + ROAD ALIGNMENT.

OWNER & PREPARED FOR:  
 LOTS A-1 THRU A-6, A-26 THRU A-28, A-39  
 MILLER & SMITH  
 McLEAN, VIRGINIA 22101  
 ATTN: COLLEEN DWELLEY  
 (703) 821-2500 ext. 236  
 Δ LOTS A-37, A-38, A-64, A-65, A-66, D-12 THRU D-14


GLWGUTSCHICK LITTLE & WEBER, P.A.  
 CIVIL ENGINEERS, LAND SURVEYORS, LAND PLANNERS, LANDSCAPE ARCHITECTS  
 3909 NATIONAL DRIVE - SUITE 250 - BURTONSVILLE OFFICE PARK  
 BURTONSVILLE, MARYLAND 20886  
 TEL: 301-421-4024 BALT: 410-880-1820 DC/VA: 301-989-2524 FAX: 301-421-4186

CONSTRUCTION PLAN  
 STONE LAKE  
 MISTY WATER WAY - STATION 0+00 TO STATION 3+26.71  
 Δ MISTY WATER WAY - STATION 100+00 TO STATION 102+10.73  
 MIRROR LAKE WAY - STATION 0+00 TO STATION 6+70.11  
 LAKE EDGE DRIVE - STATION 0+00 TO STATION 6+70.11  
 ELECTION DISTRICT No. 6

DESIGNED BY: [Signature]  
 DRAWN BY: [Signature]  
 CHECKED BY: [Signature]  
 DATE: SEPT. 2005

SCALE: AS SHOWN  
 DRAWING: 2 OF 9  
 ZONING: RE-D  
 JOB No.: 99140


PREPARED FOR:  
 STONE LAKE COMMUNITY ASSOCIATION, INC.  
 C/O THE HOWARD RESEARCH & DEVELOPMENT CORPORATION  
 THE ROUSE BUILDING  
 10275 LITTLE PATENT PARKWAY  
 COLUMBIA, MARYLAND 21044  
 ATTN: JOE NEGER  
 PH: (410) 992-6084

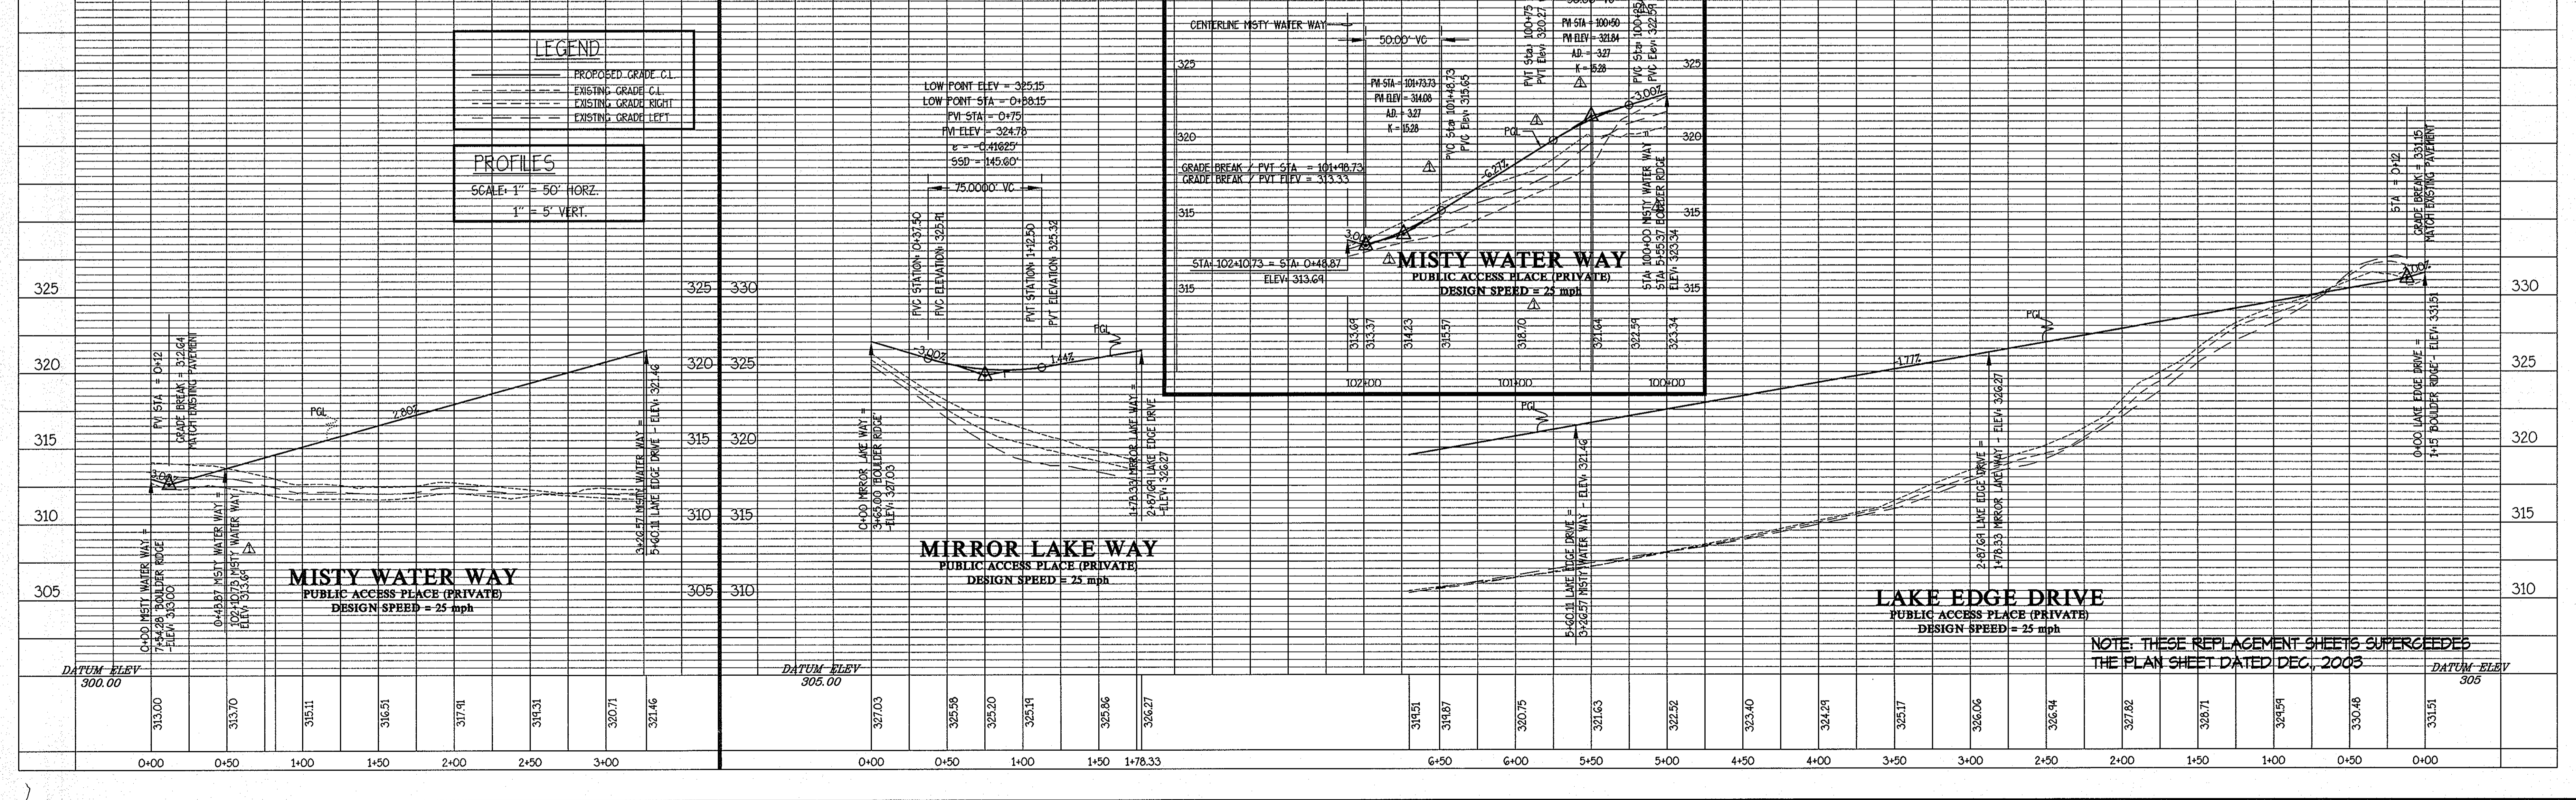

PT. No.	STATION	OFFSET	ELEV.
* 1	0+13.87	34.18' Lt.	329.51
2	0+18.86	18.65' Lt.	329.36
3	0+33.75	12.00' Lt.	328.91
4	0+37.56	12.00' Lt.	329.04
5	0+48.54	12.00' Lt.	329.38
6	0+59.53	12.00' Lt.	329.64
7	1+63.47	16.97' Lt.	330.79
8	2+96.47	12.00' Lt.	327.87
9	3+22.57	12.00' Lt.	327.02
10	3+48.68	12.00' Lt.	326.16
11	3+57.25	12.00' Lt.	325.89
12	3+70.79	17.28' Lt.	325.45
* 13	3+77.18	30.32' Lt.	324.99
* 14	3+75.91	32.00' Rt.	326.10
15	3+70.05	17.86' Rt.	325.83
16	3+55.91	12.00' Rt.	325.93
17	3+48.68	12.00' Rt.	326.17
18	3+22.57	12.00' Rt.	327.02
19	2+96.47	12.00' Rt.	327.87
20	2+91.47	12.00' Rt.	328.04
21	2+86.47	17.00' Rt.	328.35
22	2+86.47	30.00' Rt.	328.74
23	2+05.47	30.00' Rt.	330.95
24	2+05.47	17.00' Rt.	330.56
25	2+00.47	12.00' Rt.	330.47
26	1+90.47	12.00' Rt.	330.60
27	1+36.47	12.00' Rt.	330.78
28	1+31.47	17.00' Rt.	330.90
29	1+31.47	30.00' Rt.	331.29
30	0+68.47	30.00' Rt.	330.44
31	0+68.47	17.00' Rt.	330.05
32	0+63.47	12.00' Rt.	329.78
33	0+37.56	12.00' Rt.	329.05
34	0+33.68	12.00' Rt.	328.91
35	0+18.93	18.49' Rt.	328.29
* 36	0+13.76	33.74' Rt.	328.03

\* MATCH EXISTING CURB


GOODER BUILDERS AT STONE LAKE, LLC  
STONE LAKE  
LOTS C-1 thru C-39  
PLAT No. 15476  
ZONED: R-ED

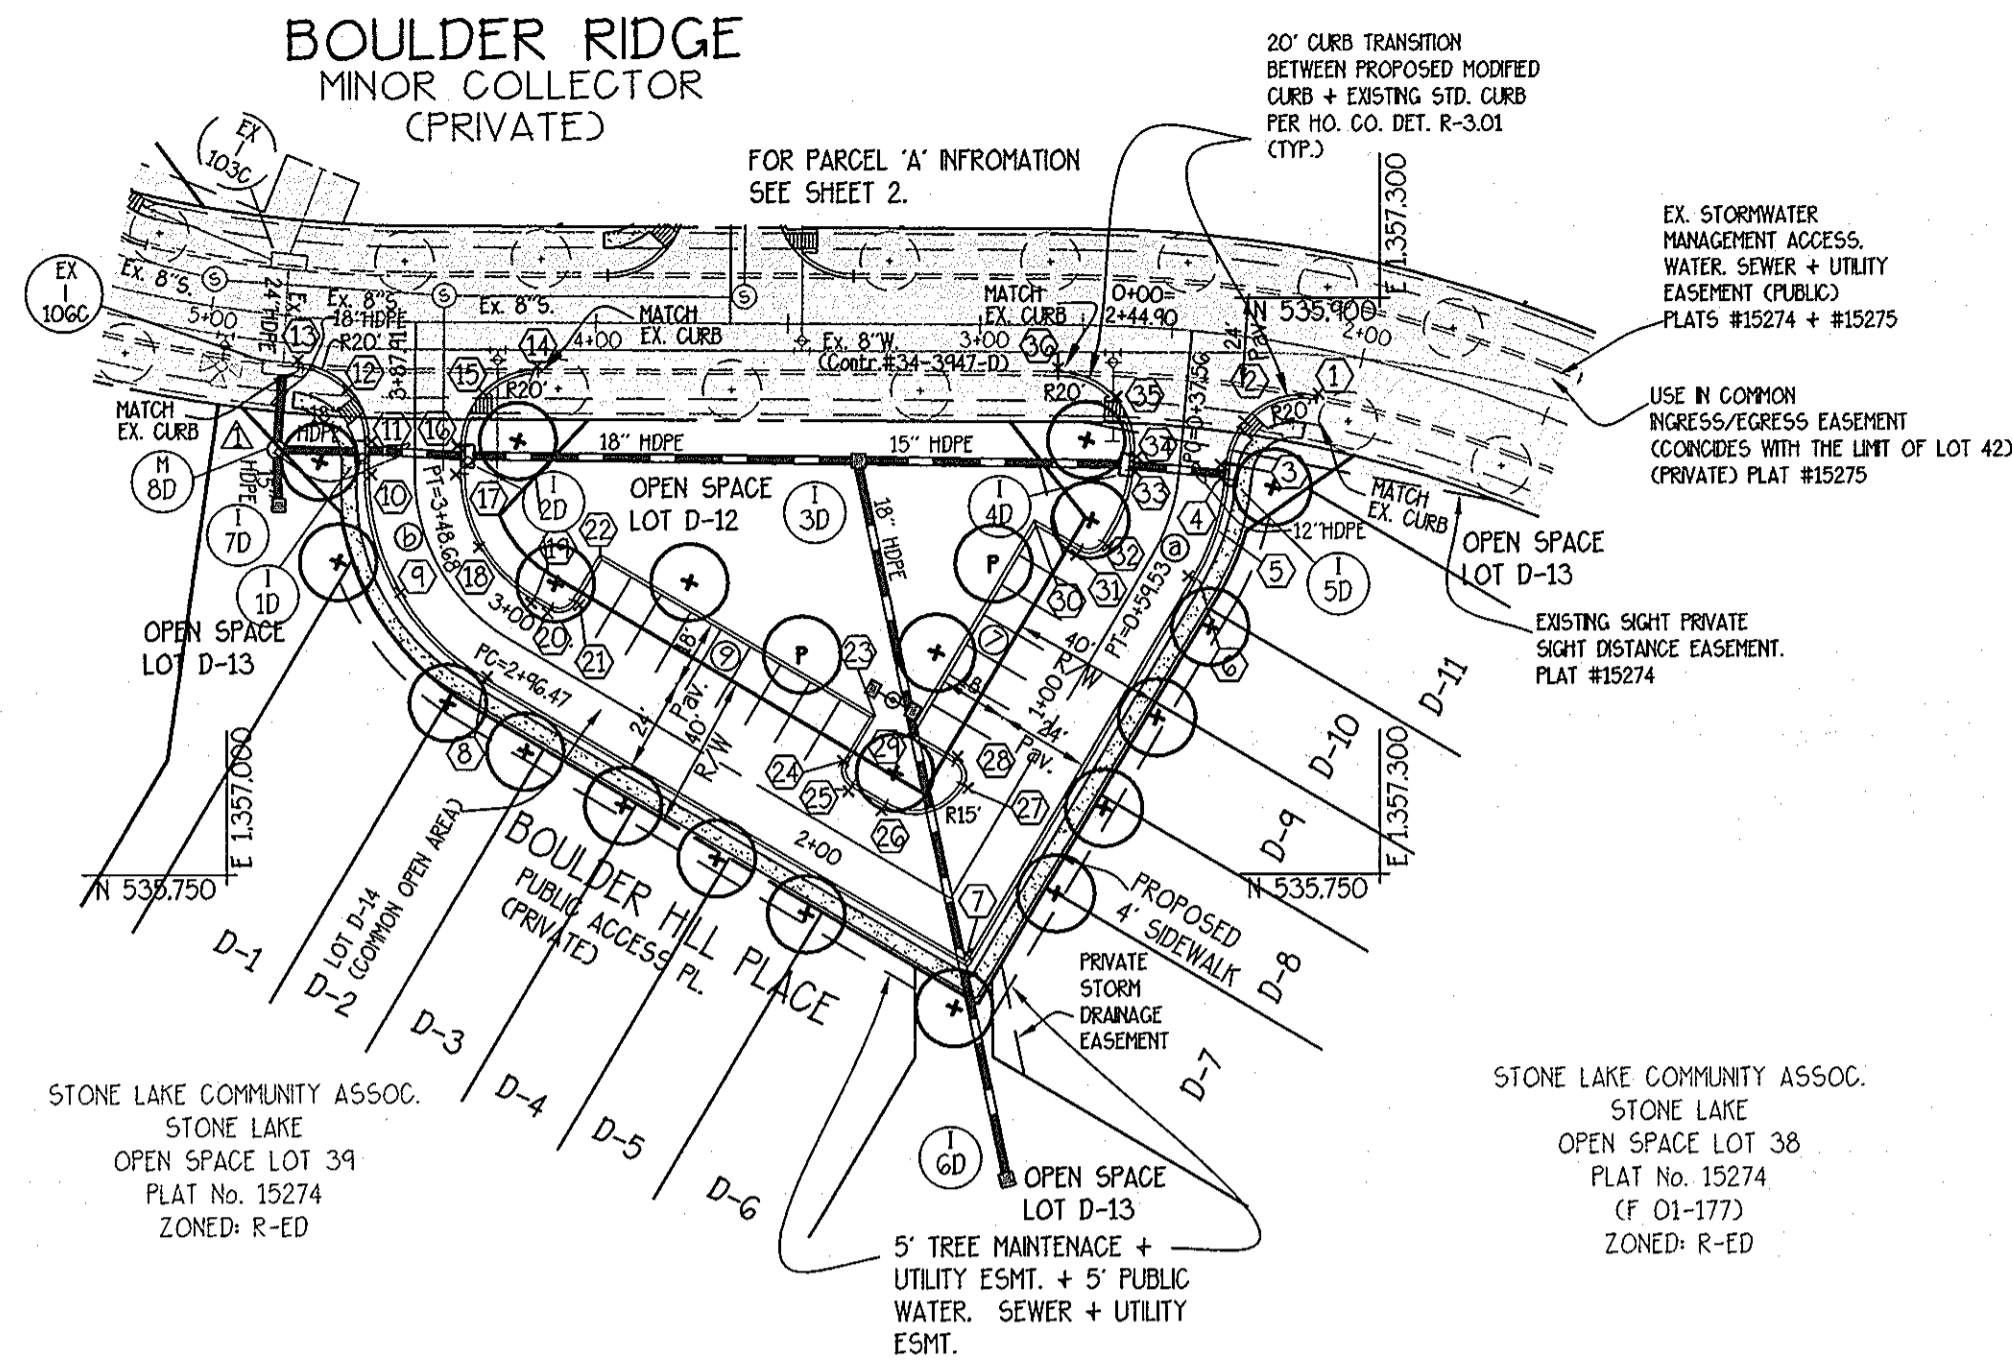

PARCEL D ROAD PLAN  
PLAN VIEW

SCALE: 1" = 50'

NOTES:  
1. LOT D-14 IS ALSO A PUBLIC WATER, SEWER + UTILITY EASEMENT.

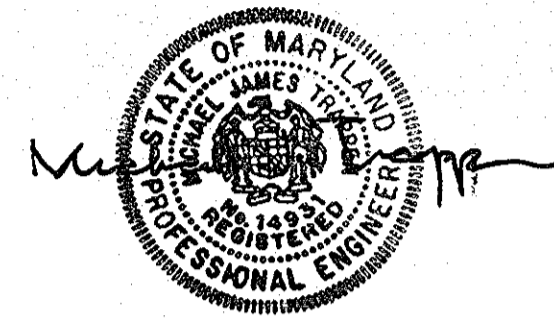

CURVE	LENGTH	RADIUS	TANGENT	CHORD	BEARING	DELTA
a	21.96'	50.00'	11.16'	21.79'	N 17° 53' 53" E	25° 10' 01"
b	52.21'	50.00'	28.77'	49.87'	S 29° 36' 07" E	59° 49' 59"

Revised Road Construction Plan  
05-04 OWNER INFORMATION, TITLE BLOCK AND ADDED STORM INLET 7D

OWNER & PREPARED FOR:  
LOTS A-1 THRU A-6, A-26 THRU A-28, A-39  
THRU A-63, and D-1 THRU D-11  
MILLER & SMITH  
8401 GREENSBORO DRIVE, SUITE 300  
MCLEAN, VIRGINIA 22101  
ATTN: COLLEEN DWELLEY  
(703) 821-2500 ext. 236

Δ\* LOTS A-37, A-38, A-64, A-65, A-66, D-12 THRU D-14

APPROVED: HOWARD COUNTY DEPARTMENT OF PUBLIC WORKS  
Chief, Bureau of Highways

APPROVED: HOWARD COUNTY DEPARTMENT OF PLANNING + ZONING  
Chief, Division of Land Development  
Date: 5/12/08  
Chief, Development Engineering Division  
Date: 5/6/08

SYMBOL	NAME (BOTANICAL/COMMON)	SIZE	QUANTITY	REMARKS
Qr	Quercus Rubra / Red Oak	2"-3" Cal. 12-14' Ht.	20	B + B FULL HEAD


LOCATION	LAMP TYPE	MOUNTING	POLE TYPE
C.I. STA. 2+02.57 - 37' RT. BOULDER HILL PLACE	100-W HIGH PRESSURE SODIUM VAPOR	TRADITIONAL POST TOP	14' BLACK FIBERGLASS

**GLWGUTSCHICK LITTLE & WEBER, P.A.**  
CIVIL ENGINEERS, LAND SURVEYORS, LAND PLANNERS, LANDSCAPE ARCHITECTS  
3909 NATIONAL DRIVE - SUITE 250 - BURTONSVILLE OFFICE PARK  
BURTONSVILLE, MARYLAND 20866  
TEL: 301-421-4024 BAL: 410-880-1820 DC/VA: 301-989-2524 FAX: 301-421-4186

**CONSTRUCTION PLAN**  
**STONE LAKE**  
BOULDER HILL PLACE - STATION 0+00 TO STATION 3+87.91

DESIGNED: BJM SCALE: AS SHOWN  
DRAWN: KIP DRAWING: 3 OF 9  
CHECKED: BJM ZONING: RE-D  
DATE: 2003 JOB No.: 99140  
DEC. 2003

PREPARED FOR:  
STONE LAKE COMMUNITY ASSOCIATION, INC. Δ  
C/O THE HOWARD RESEARCH + DEVELOPMENT CORPORATION  
THE ROUSE BUILDING  
10275 LITTLE PATRIENT PARKWAY  
COLUMBIA, MARYLAND 21044  
ATTN: JOE HECKER  
PL. #4103 410-368-4444

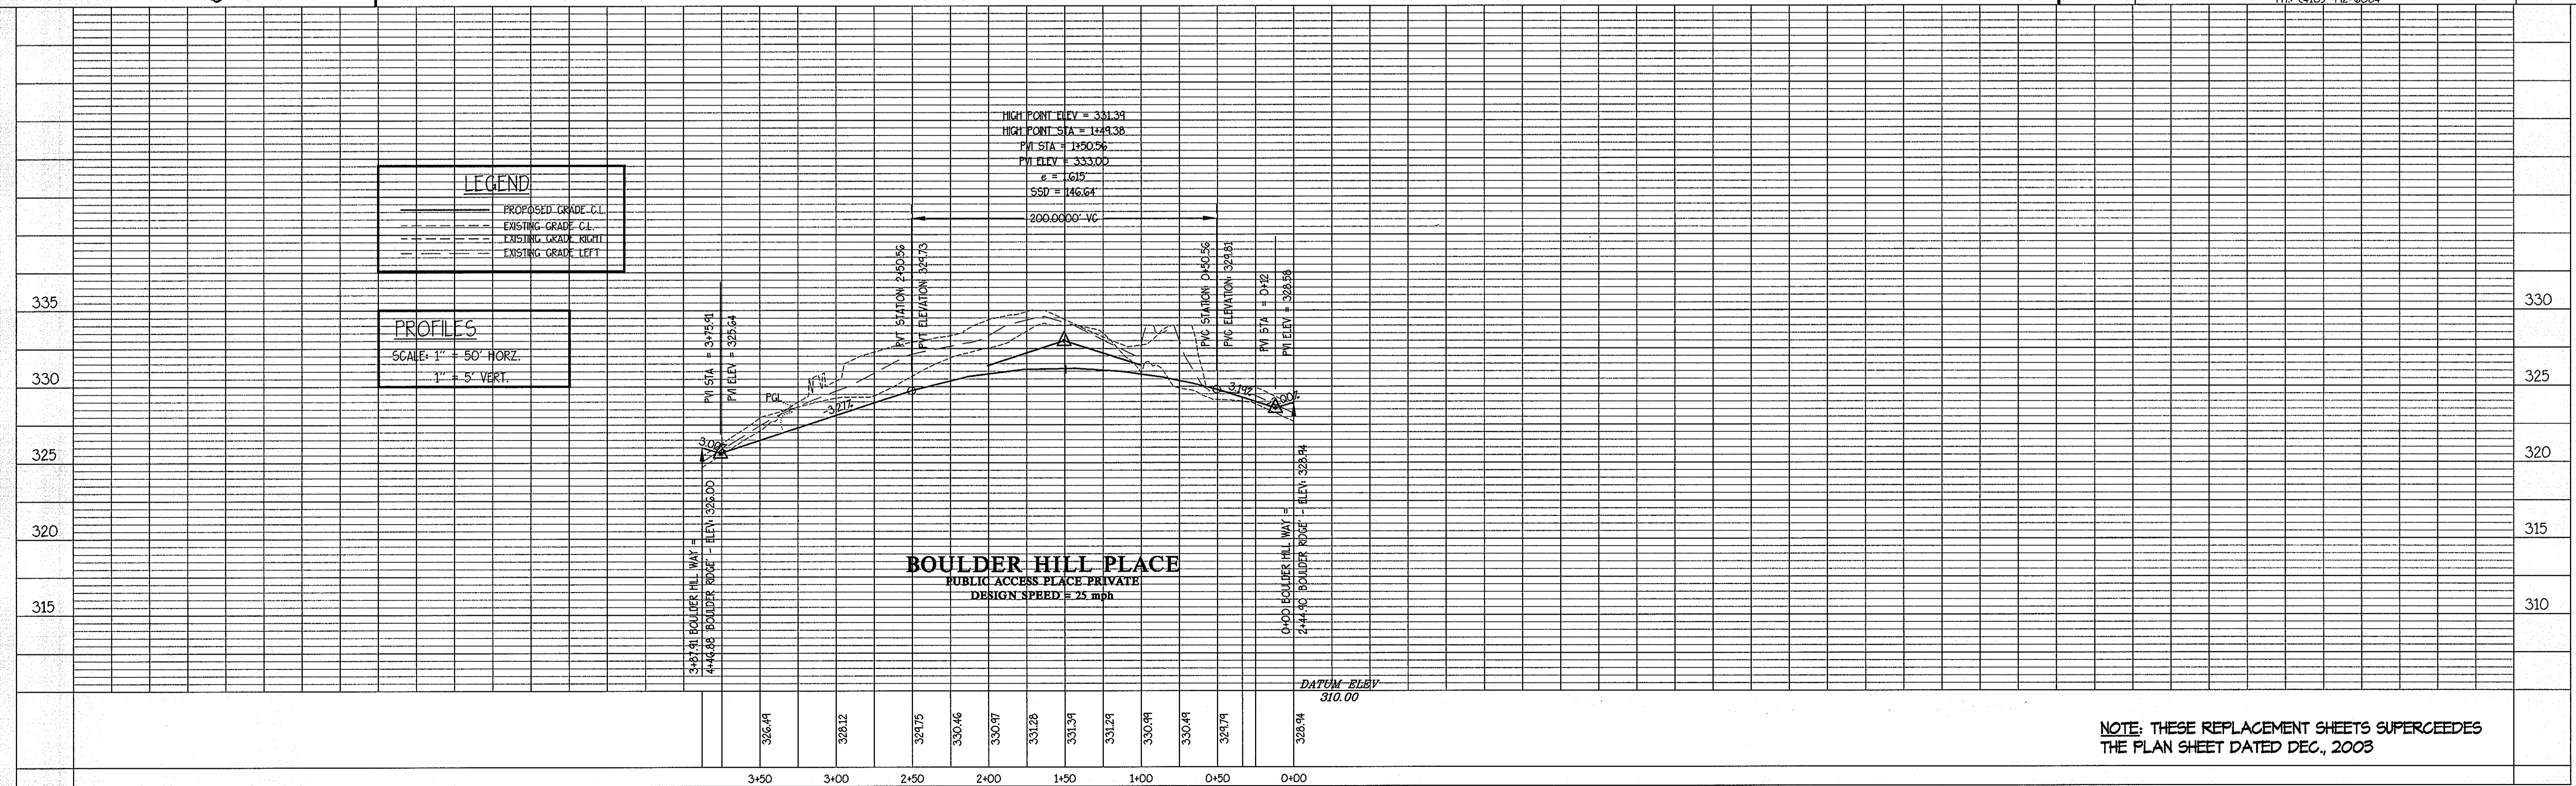

NOTE: THESE REPLACEMENT SHEETS SUPERCEDES THE PLAN SHEET DATED DEC., 2003









### D.A. Tabulation

Inlet NO.	Area AC.	IMP %	C
I-5D	0.25	85	0.80
I-4D	0.07	85	0.80
I-2D	0.12	85	0.80
I-1D	0.36	85	0.80
I-3D	0.15	85	0.80
I-6D	Δ1.39	85	0.54
I-11A	0.6	85	0.80
I-10A	0.25	85	0.80
I-16A	0.48	85	0.80
I-13A	Δ0.34	85	0.80
I-12A	0.38	85	0.80
I-17A	0.60	85	0.80
I-15A	Δ0.57	85	0.80
I-18A	0.58	85	0.80
ex I-102C	0.33	85	0.80
ex I-106C	0.38	85	0.80
Δ I-19A	Δ0.57	85Δ	0.80 Δ
Δ I-1A	Δ0.20	85Δ	0.80 Δ
Δ I-7D	Δ0.36	85Δ	0.80 Δ

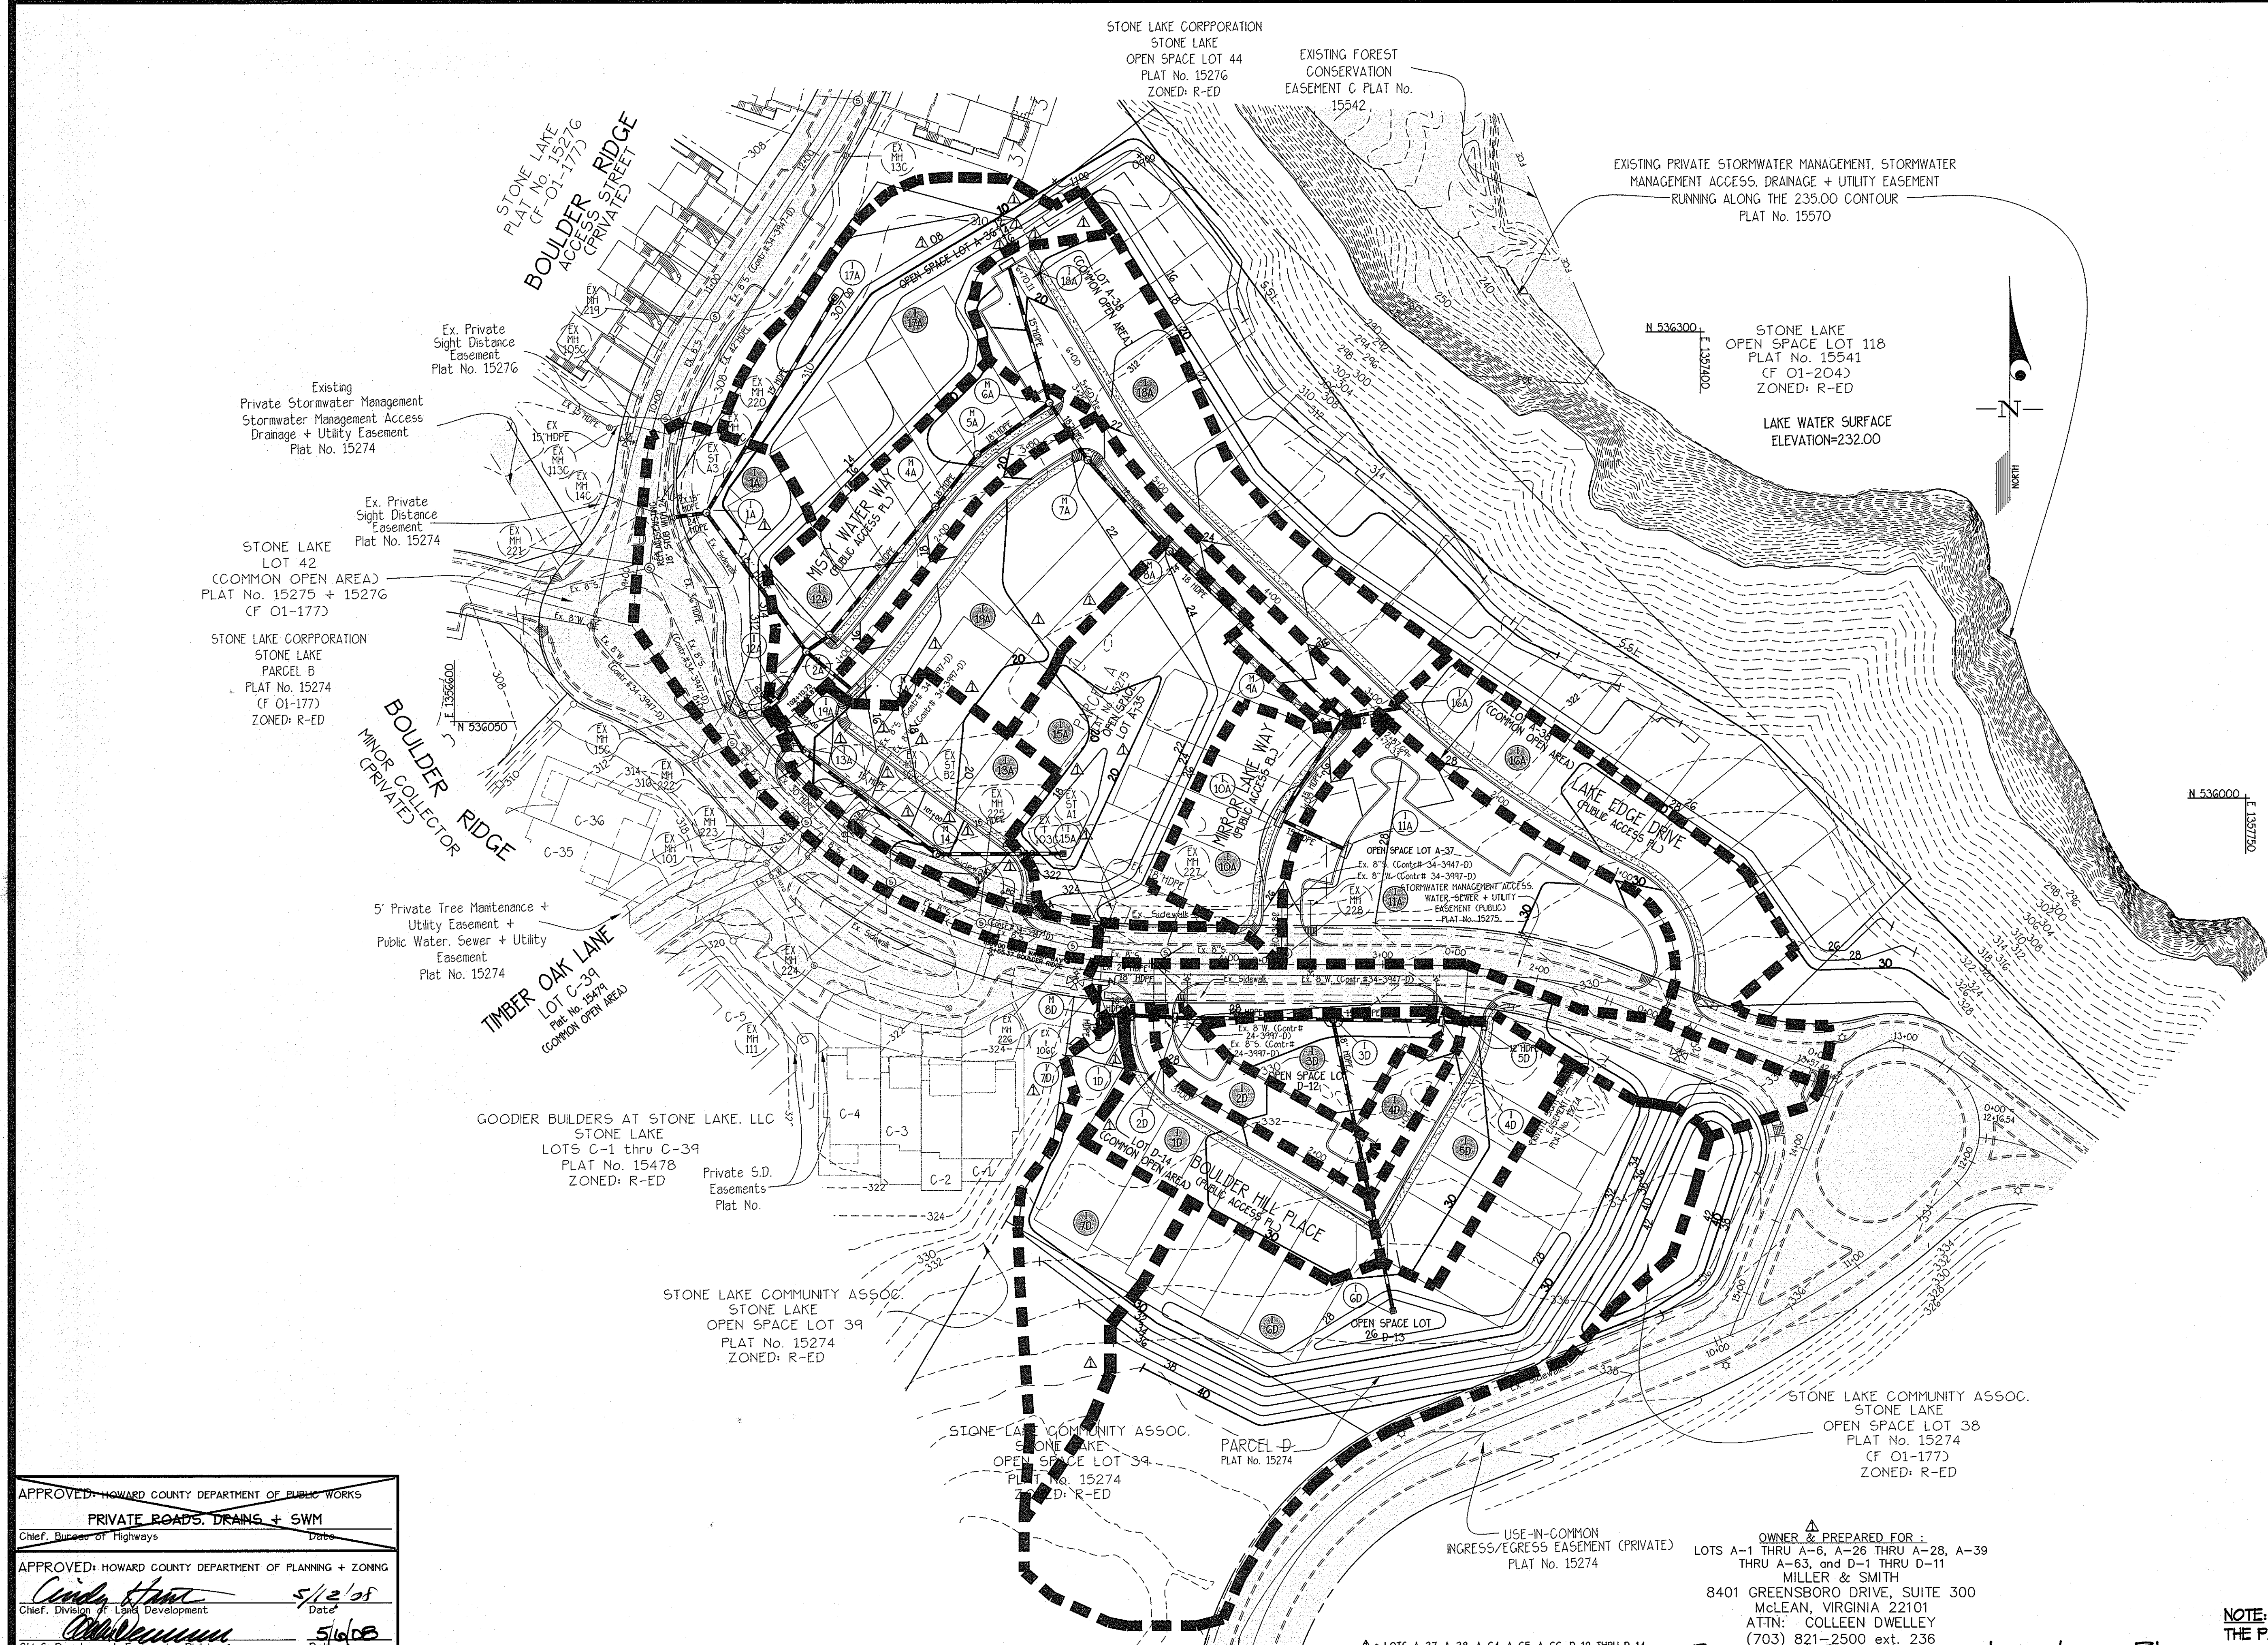

**LEGEND**  
 --- 600 --- EXISTING CONTOUR  
 ——— 600 ——— PROPOSED CONTOUR  
 [Thick Dashed Line] STORM DRAIN DRAINAGE AREA

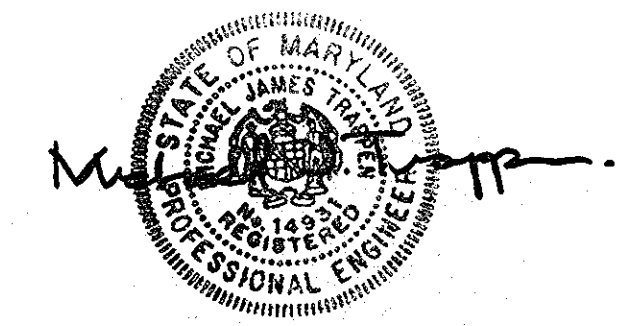

APPROVED: HOWARD COUNTY DEPARTMENT OF PUBLIC WORKS  
**PRIVATE ROADS, DRAINS + SWM**  
 Chief, Bureau of Highways  
 Date: \_\_\_\_\_

APPROVED: HOWARD COUNTY DEPARTMENT OF PLANNING + ZONING  
*Cinda Hunt* 5/12/05  
 Chief, Division of Land Development  
 Date: \_\_\_\_\_

*Chris DeWitt* 5/16/05  
 Chief, Development Engineering Division  
 Date: \_\_\_\_\_

OWNER & PREPARED FOR:  
 LOTS A-1 THRU A-6, A-26 THRU A-28, A-37 THRU A-63, AND D-1 THRU D-11  
 MILLER & SMITH  
 8401 GREENSBORO DRIVE, SUITE 300  
 McLEAN, VIRGINIA 22101  
 ATTN: COLLEEN DWELLEY  
 (703) 821-2500 ext. 236  
 Revised Road Construction Plan

NOTE: THESE REPLACEMENT SHEETS SUPERCEDES THE PLAN SHEET DATED DEC, 2003

**GLWGUTSCHICK LITTLE & WEBER, P.A.**  
 CIVIL ENGINEERS, LAND SURVEYORS, LAND PLANNERS, LANDSCAPE ARCHITECTS  
 3909 NATIONAL DRIVE - SUITE 250 - BURTONSVILLE OFFICE PARK  
 BURTONSVILLE, MARYLAND 20866  
 TEL: 301-421-4024 FAX: 301-421-4186


DATE	DESCRIPTION	BY	APPR.
09-08	ADDED STR I-19A + REALIGNED STORM DRAIN I-12A THRU I-15A. GRADING MODIFIED TO ENABLE NEW LOT + ROAD ALIGNMENT	BJM	JE

OWNER & PREPARED FOR:  
 STONE LAKE COMMUNITY ASSOCIATION, INC.\*  
 C/O THE HOWARD RESEARCH & DEVELOPMENT CORP.  
 THE ROUSE BUILDING  
 10275 LITTLE PATUXENT PARKWAY  
 COLUMBIA, MARYLAND 21044  
 ATTN: JOE NECKER  
 TELE: (410) 992-6084

**STORM DRAINAGE AREA MAP**  
**STONE LAKE**  
 LOTS A-1 thru A-6, A-26 thru A-28, A-37 thru A-66, LOTS D-1 thru D-14 AND LOT 122  
 A RESUBDIVISION OF PARCELS 'A' & 'D' AND OPEN SPACE LOT 38  
 PLAT No's 15274 & 15275  
 ELECTION DISTRICT No. 6  
 HOWARD COUNTY, MARYLAND

SCALE	ZONING	G. L. W. FILE No.
1" = 50'	NT	99140
DATE	TAX MAP - GRID	SHEET
Sept., 2005	47-9/10 P/O PARCEL 837	7 OF 9

04-48

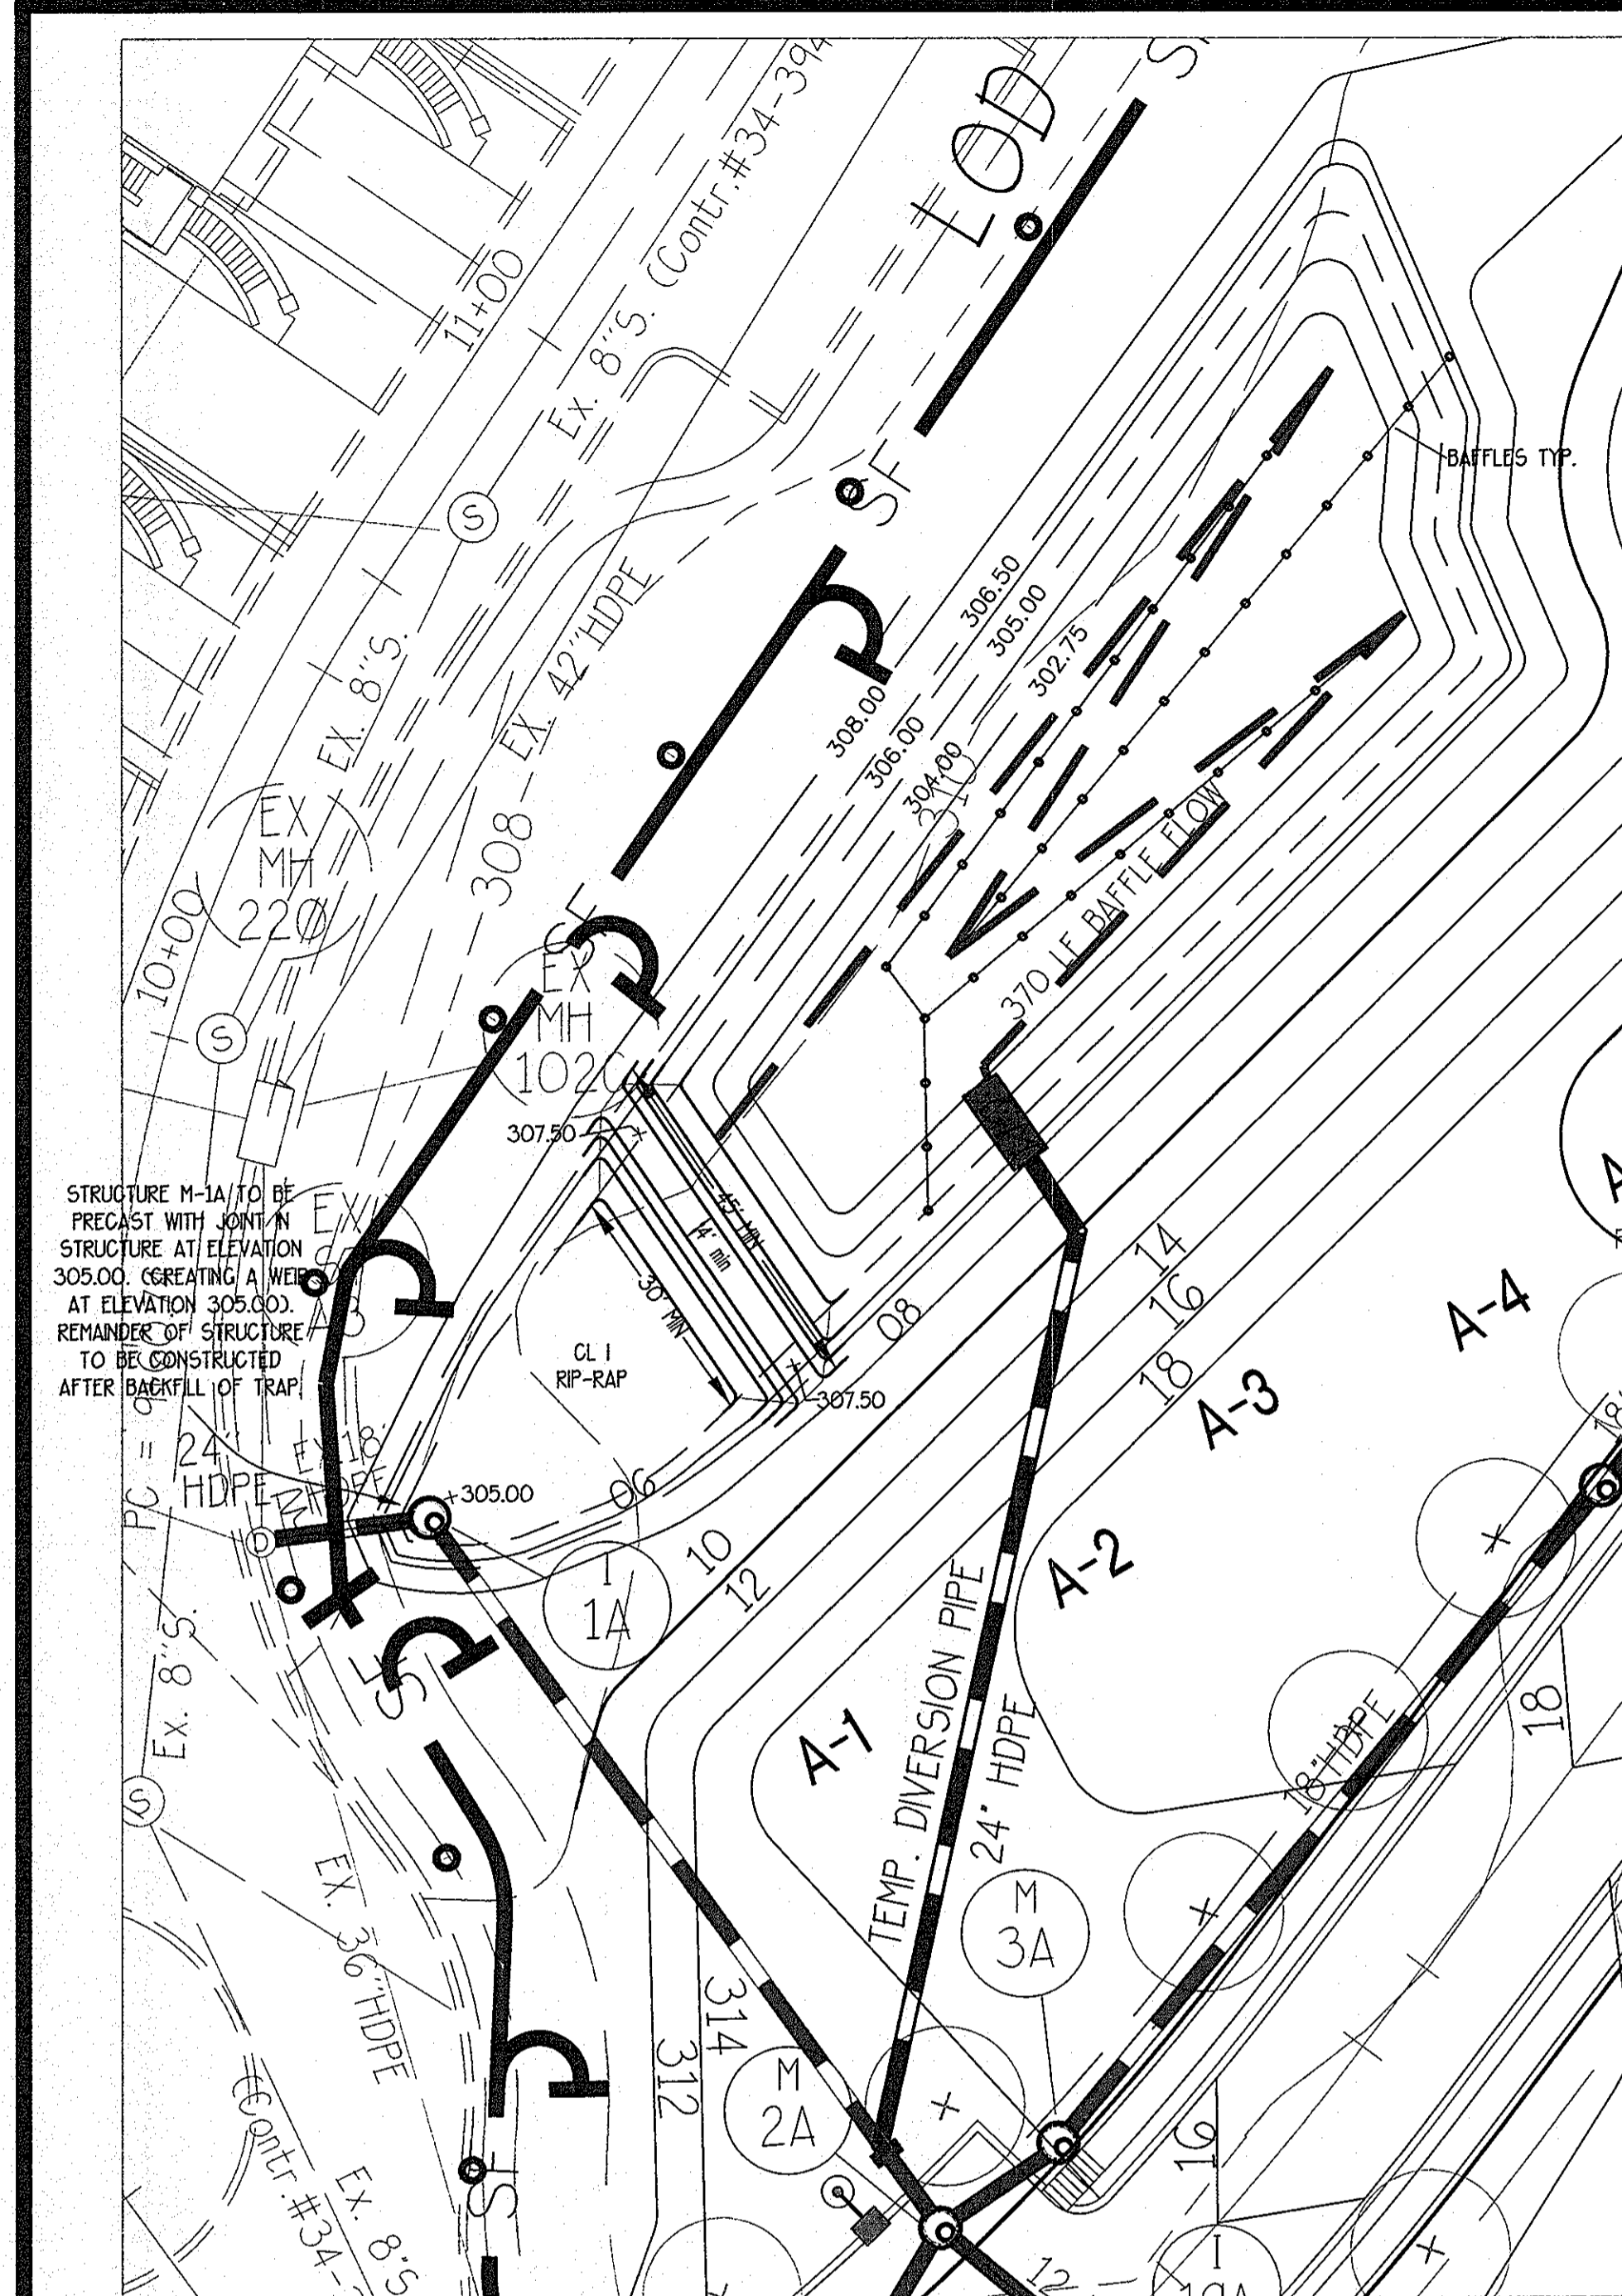

**ENLARGEMENT OF SEDIMENT TRAP**  
SCALE: 1"=20'

**SEDIMENT TRAP I - TYPE ST-IV**

WORST CASE DRAINAGE AREA 5.44 AC.  
 TOTAL STORAGE REQUIRED 19584 C.F.  
 WET STORAGE PROVIDED 10018 C.F.  
 DRY STORAGE PROVIDED 9792 C.F.  
 TOTAL STORAGE PROVIDED 19602 C.F.  
 LIMIT WET STORAGE 305.00 FT.  
 LIMIT OF DRY STORAGE 306.50 FT.  
 TOP OF WEIR 307.00 FT.  
 WEIR LENGTH 45 FT.  
 BOTTOM 302.75 FT.  
 TOP OF DAM 308.00 FT.  
 EXISTING GRADE 308-309 FT.  
 TEMPORARY SWM PROVIDED BY EXISTING FACILITY.

Existing Private Stormwater Management Access Drainage + Utility Easement Plat No. 15274

Ex. Private Sight Distance Easement Plat No. 15274

STONE LAKE LOT 42 (COMMON OPEN AREA) PLAT No. 15275 + 15276 (CF 01-177)

STONE LAKE CORPORATION STONE LAKE PARCEL B PLAT No. 15274 (CF 01-177) ZONED: R-ED

5' Private Tree Maintenance + Utility Easement + Public Water, Sewer + Utility Easement Plat No. 15274

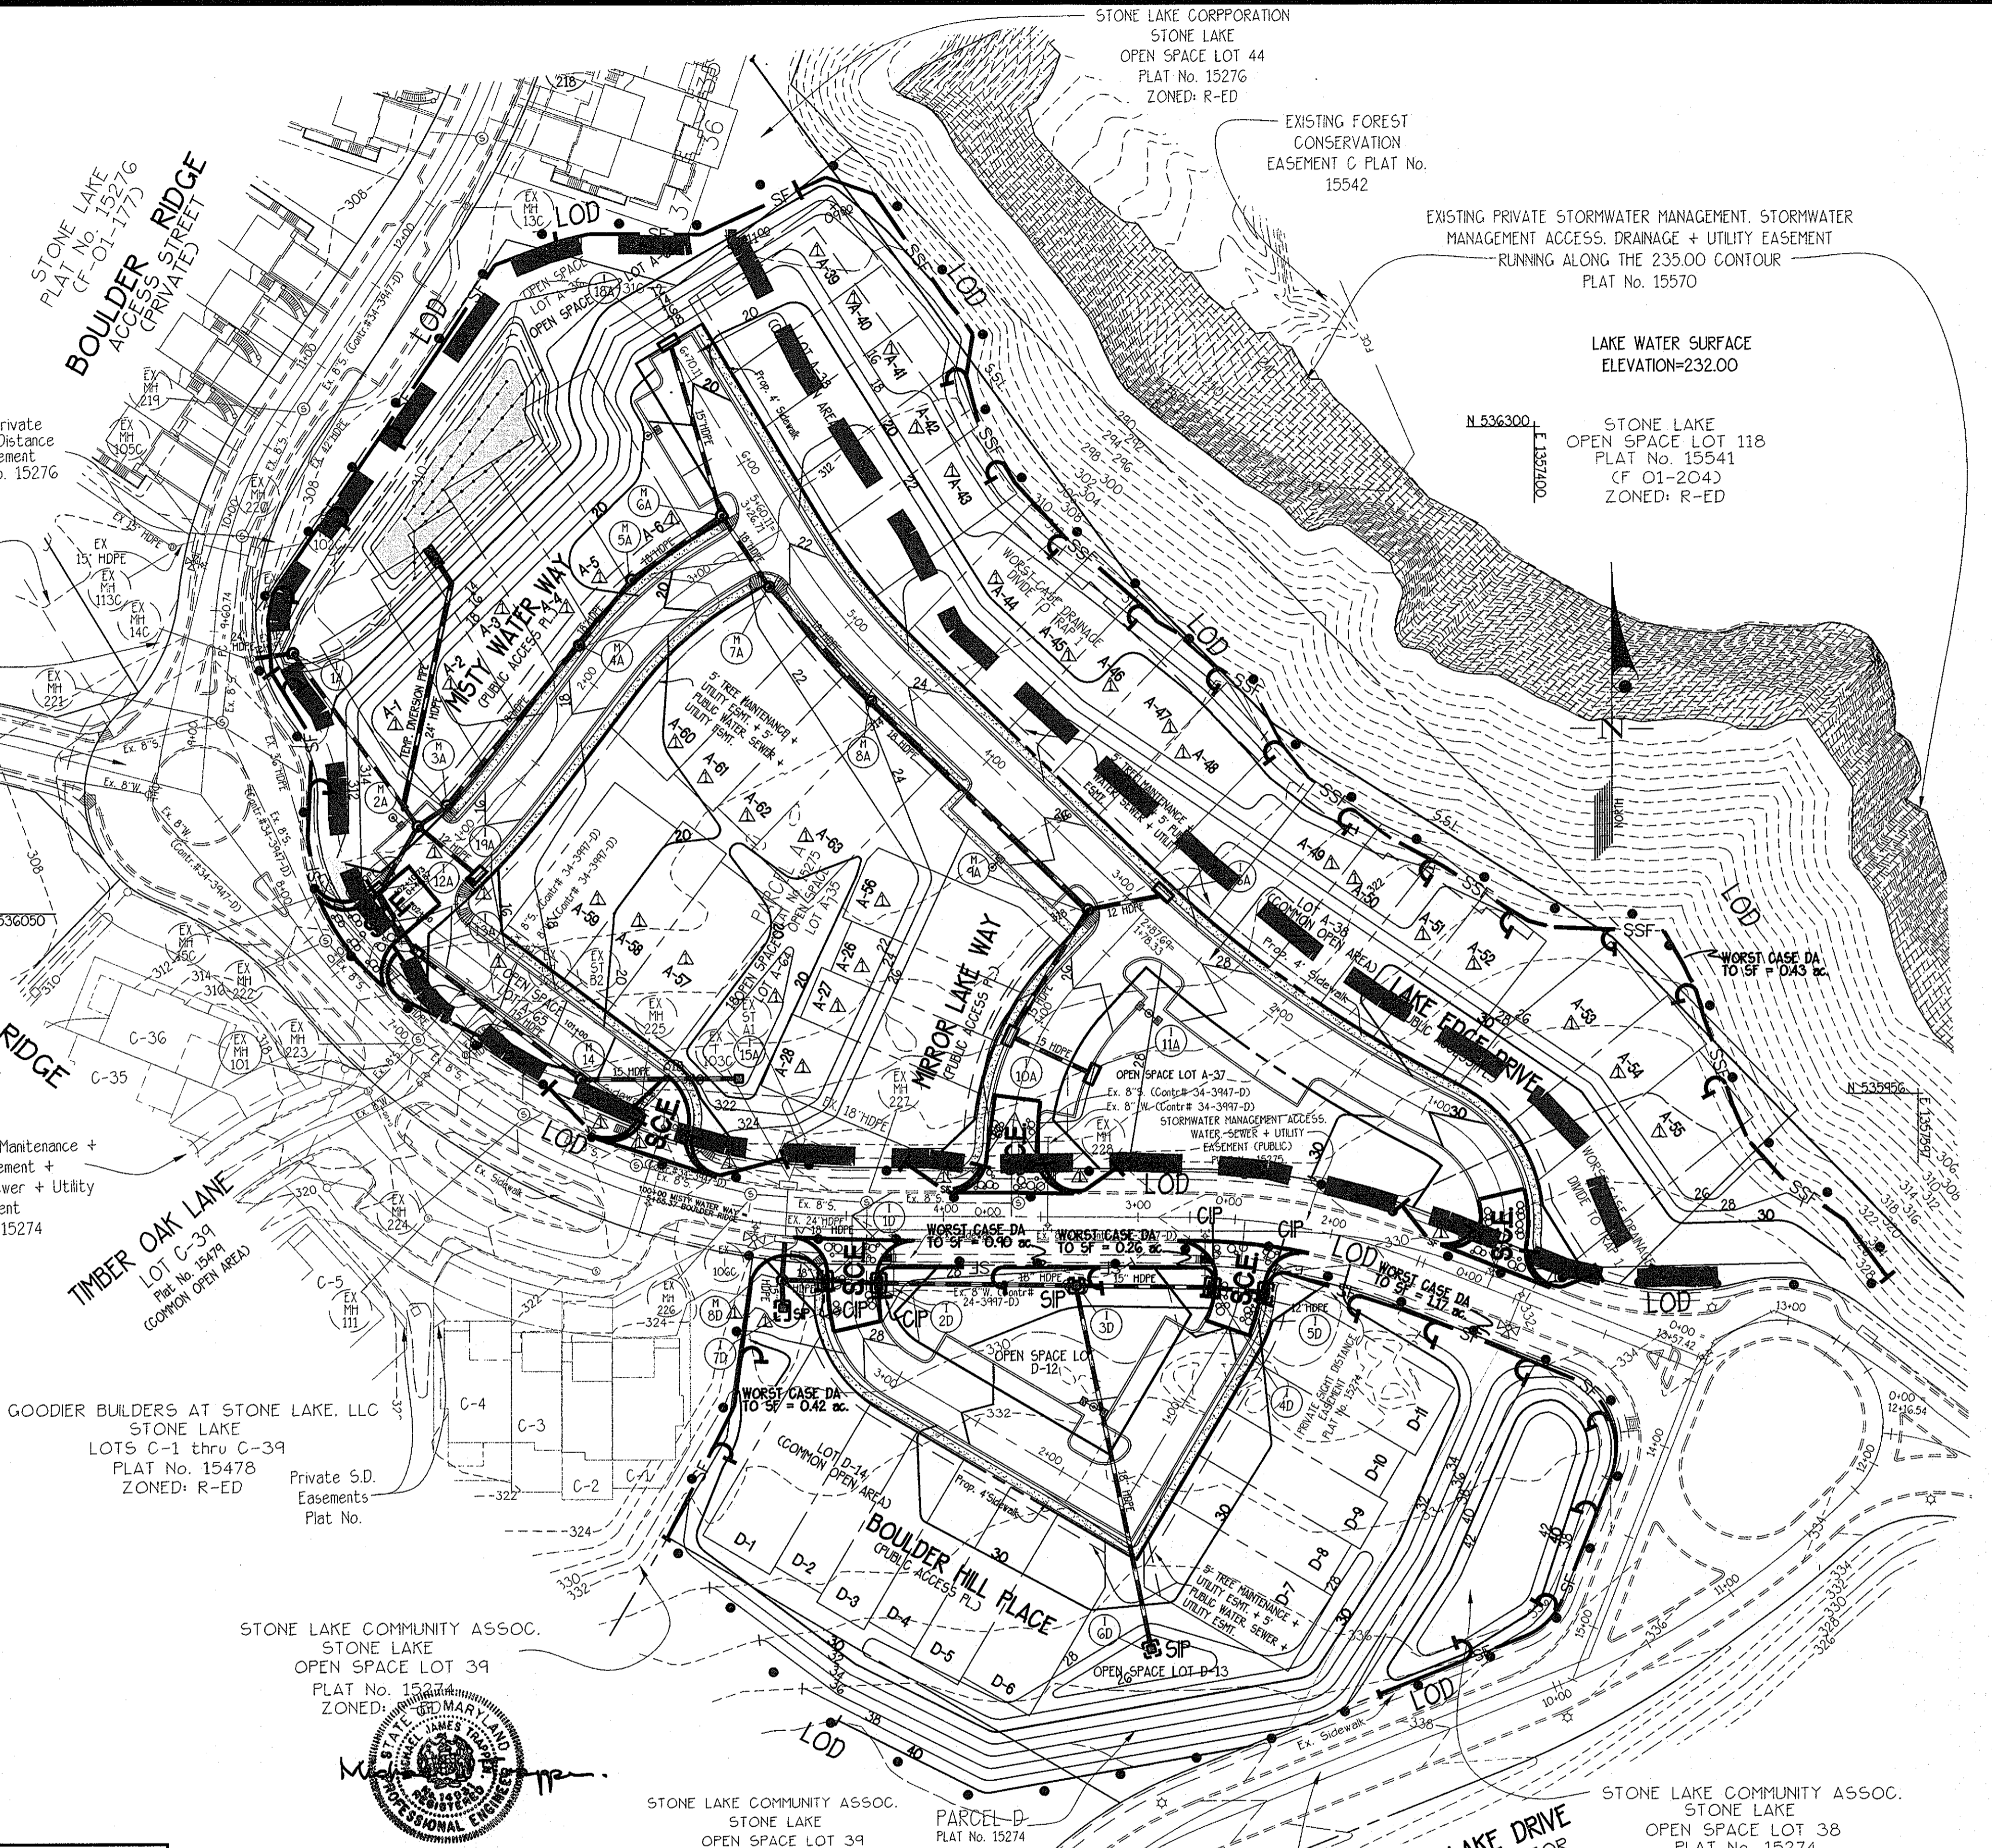

**SEDIMENT CONTROL LEGEND**

--- 600 --- EXISTING CONTOUR  
 --- 600 --- PROPOSED CONTOUR  
 + 368.00 PROPOSED SPOT ELEV.  
 • LOD • LIMIT OF GRADING DISTURBANCE  
 --- SF --- PROPOSED SILT FENCE  
 --- SSF --- PROPOSED SUPER SILT FENCE  
 [SCE] STABILIZED CONSTRUCTION ENTRANCE  
 [SIP] STANDARD INLET PROTECTION  
 [CIP] CURB INLET PROTECTION

**SEDIMENT TRAP I - TYPE ST-IV**

WORST CASE DRAINAGE AREA 5.44 AC.  
 TOTAL STORAGE REQUIRED 19584 C.F.  
 WET STORAGE PROVIDED 10018 C.F.  
 DRY STORAGE PROVIDED 9792 C.F.  
 TOTAL STORAGE PROVIDED 19602 C.F.  
 LIMIT WET STORAGE 305.00 FT.  
 LIMIT OF DRY STORAGE 306.50 FT.  
 TOP OF WEIR 307.00 FT.  
 WEIR LENGTH 45 FT.  
 BOTTOM 302.75 FT.  
 TOP OF DAM 308.00 FT.  
 EXISTING GRADE 308-309 FT.  
 TEMPORARY SWM PROVIDED BY EXISTING FACILITY.

Existing Private Stormwater Management Access Drainage + Utility Easement Plat No. 15274

Ex. Private Sight Distance Easement Plat No. 15274

STONE LAKE LOT 42 (COMMON OPEN AREA) PLAT No. 15275 + 15276 (CF 01-177)

STONE LAKE CORPORATION STONE LAKE PARCEL B PLAT No. 15274 (CF 01-177) ZONED: R-ED

5' Private Tree Maintenance + Utility Easement + Public Water, Sewer + Utility Easement Plat No. 15274

THIS DEVELOPMENT PLAN IS APPROVED FOR SOIL EROSION AND SEDIMENT CONTROL BY THE HOWARD SOIL CONSERVATION DISTRICT.

HOWARD S.C.D. DATE

THESE PLANS HAVE BEEN REVIEWED FOR THE HOWARD SOIL CONSERVATION DISTRICT AND MEET THE TECHNICAL REQUIREMENTS.

NATURAL RESOURCES CONSERVATION SERVICE DATE

APPROVED: HOWARD COUNTY DEPARTMENT OF PUBLIC WORKS  
**PRIVATE ROADS, DRAINS + SWM**  
 Chief, Bureau of Highways

APPROVED: HOWARD COUNTY DEPARTMENT OF PLANNING + ZONING  
 Chief, Division of Land Development  
 Chief, Development Engineering Division

**DEVELOPER'S/BUILDER'S CERTIFICATE**

"I/WE CERTIFY THAT ALL DEVELOPMENT AND/OR CONSTRUCTION WILL BE DONE ACCORDING TO THIS PLAN, AND THAT ANY RESPONSIBLE PERSONNEL INVOLVED IN THE CONSTRUCTION PROJECT WILL HAVE A CERTIFICATE OF ATTENDANCE AT A MARYLAND DEPARTMENT OF THE ENVIRONMENT APPROVED TRAINING PROGRAM FOR THE CONTROL OF SEDIMENT AND EROSION BEFORE BEGINNING THE PROJECT. I ALSO AUTHORIZE PERIODIC ON-SITE INSPECTION BY THE HSCD."

Signature: Paul G. Conlan  
 Date: 9/22/05

**ENGINEER'S CERTIFICATE**

"I CERTIFY THAT THIS PLAN FOR EROSION AND SEDIMENT CONTROL REPRESENTS A PRACTICAL AND WORKABLE PLAN BASED ON MY PERSONAL KNOWLEDGE OF THE SITE CONDITIONS AND THAT IT WAS PREPARED IN ACCORDANCE WITH THE REQUIREMENTS OF THE HOWARD SOIL CONSERVATION DISTRICT."

Signature: Michael J. Trapper  
 Date: 9/22/05

**OWNER & PREPARED FOR:**

STONE LAKE COMMUNITY ASSOCIATION, INC.  
 C/O THE HOWARD RESEARCH & DEVELOPMENT CORP.  
 THE ROUSE BUILDING  
 10275 LITTLE PATUXENT PARKWAY  
 COLUMBIA, MARYLAND 21044  
 ATTN: JOE NECKER  
 TELE: (410) 992-6084

**SEDIMENT & EROSION CONTROL PLAN**

**STONE LAKE**

LOTS A-1 thru A-6, A-26 thru A-28, A-37 thru A-66, LOTS D-1 thru D-14 AND LOT 122  
 A RESUBDIVISION OF PARCELS 'A' & 'D' AND OPEN SPACE LOT 38  
 PLAT No's 15274 & 15275

SCALE: 1" = 50'

ZONING: NT

G. L. W. FILE No.: 99140

DATE: Sept, 2005

TAX MAP - GRID: 47-9/10

P/O PARCEL 837

SHEET: 8 OF 9

NOTE: THESE REPLACEMENT SHEETS SUPERCEDES THE PLAN SHEET DATED DEC, 2003

Revised Road Construction Plan  
 THIS PLAN IS FOR SEDIMENT CONTROL PURPOSES ONLY!

**GLWGUTSCHICK LITTLE & WEBER, P.A.**

CIVIL ENGINEERS, LAND SURVEYORS, LAND PLANNERS, LANDSCAPE ARCHITECTS  
 3909 NATIONAL DRIVE - SUITE 250 - BURTONSVILLE OFFICE PARK  
 BURTONSVILLE, MARYLAND 20866  
 TEL: 301-421-4024 BAL: 410-880-1820 DC/VA: 301-989-2524 FAX: 301-421-4186

DATE: 09-08  
 GRADING MODIFIED, SCE ADDED, SILT FENCE RELOCATED.  
 DES. BJM DRN. BJM CHK. MJT

DATE: 09-08  
 GRADING MODIFIED, SCE ADDED, SILT FENCE RELOCATED.  
 DES. BJM DRN. BJM CHK. MJT

**OWNER & PREPARED FOR:**

STONE LAKE COMMUNITY ASSOCIATION, INC.  
 C/O THE HOWARD RESEARCH & DEVELOPMENT CORP.  
 THE ROUSE BUILDING  
 10275 LITTLE PATUXENT PARKWAY  
 COLUMBIA, MARYLAND 21044  
 ATTN: JOE NECKER  
 TELE: (410) 992-6084

**SEDIMENT & EROSION CONTROL PLAN**

**STONE LAKE**

LOTS A-1 thru A-6, A-26 thru A-28, A-37 thru A-66, LOTS D-1 thru D-14 AND LOT 122  
 A RESUBDIVISION OF PARCELS 'A' & 'D' AND OPEN SPACE LOT 38  
 PLAT No's 15274 & 15275

SCALE: 1" = 50'

ZONING: NT

G. L. W. FILE No.: 99140

DATE: Sept, 2005

TAX MAP - GRID: 47-9/10

P/O PARCEL 837

SHEET: 8 OF 9

NOTE: THESE REPLACEMENT SHEETS SUPERCEDES THE PLAN SHEET DATED DEC, 2003











Revised Road Construction Plan  
 THIS PLAN IS FOR SEDIMENT CONTROL PURPOSES ONLY!



**SEDIMENT CONTROL NOTES**

1. A MINIMUM OF 24 HOURS NOTICE MUST BE GIVEN TO THE HOWARD COUNTY OFFICE OF INSPECTION AND PERMITS PRIOR TO THE START OF ANY CONSTRUCTION. (410) 313-1855
2. ALL VEGETATIVE AND STRUCTURAL PRACTICES ARE TO BE INSTALLED ACCORDING TO THE PROVISIONS OF THIS PLAN AND ARE TO BE IN CONFORMANCE WITH THE 1994 MARYLAND STANDARDS AND SPECIFICATIONS FOR SOIL EROSION AND SEDIMENT CONTROL AND REVISIONS THERETO.
3. FOLLOWING INITIAL SOIL DISTURBANCE OR REDISTURBANCE, PERMANENT OR TEMPORARY STABILIZATION SHALL BE COMPLETED WITHIN A 7 CALENDAR DAYS FOR ALL PERIMETER SEDIMENT CONTROL STRUCTURES, DIKES AND PERIMETER SLOPES AND ALL SLOPES GREATER THAN 3:1. BY 14 DAYS AS TO ALL OTHER DISTURBED OR GRADED AREAS ON THE PROJECT SITE.
4. ALL SEDIMENT TRAPS/BASINS SHOWN MUST BE FENCED AND WARNING SIGNS POSTED AROUND THEIR PERIMETER IN ACCORDANCE WITH VOL. 1, CHAPTER 12, OF THE HOWARD COUNTY DESIGN MANUAL, STORM DRAINAGE.
5. ALL DISTURBED AREAS MUST BE STABILIZED WITHIN THE TIME PERIOD SPECIFIED ABOVE IN ACCORDANCE WITH THE 1994 MARYLAND STANDARDS AND SPECIFICATIONS FOR SOIL EROSION AND SEDIMENT CONTROL FOR PERMANENT SEEDINGS, SOD, TEMPORARY SEEDINGS AND MULCHING (S.E.C. C). TEMPORARY STABILIZATION WITH MULCH ALONE, CAN ONLY BE DONE WHEN RECOMMENDED SEEDING DATES DO NOT ALLOW FOR PROPER GERMINATION AND ESTABLISHMENT OF GRASSES.
6. ALL SEDIMENT CONTROL STRUCTURES ARE TO REMAIN IN PLACE AND ARE TO BE MAINTAINED IN OPERATIVE CONDITION UNTIL PERMSSION FOR THEIR REMOVAL HAS BEEN OBTAINED FROM THE HOWARD COUNTY SEDIMENT CONTROL INSPECTOR.
7. SITE ANALYSIS:
 

TOTAL AREA OF SITE	7.71 ACRES
AREA DISTURBED	7.13 ACRES
AREA TO BE ROOFED OR PAVED	1.06 ACRES
AREA TO BE VEGETATIVELY STABILIZED	6.07 ACRES
TOTAL CUT	12,000 CU. YDS.
TOTAL FILL	12,000 CU. YDS.
OFF-SITE WASTE/BORROW AREA LOCATION	n/a
8. ANY SEDIMENT CONTROL PRACTICE WHICH IS DISTURBED BY GRADING ACTIVITY FOR PLACEMENT OF UTILITIES MUST BE REPAIRED ON THE SAME DAY OF DISTURBANCE.
9. ADDITIONAL SEDIMENT CONTROL MUST BE PROVIDED, IF DEEMED NECESSARY BY THE HOWARD COUNTY DPW SEDIMENT CONTROL INSPECTOR.
10. ON ALL SITES WITH DISTURBED AREAS IN EXCESS OF 2 ACRES, APPROVAL OF THE INSPECTION AGENCY SHALL BE REQUESTED UPON COMPLETION OF INSTALLATION OF PERIMETER EROSION AND SEDIMENT CONTROLS, BUT BEFORE PROCEEDING WITH ANY OTHER EARTH DISTURBANCE OR GRADING, OTHER BUILDING OR GRADING INSPECTION APPROVALS MAY NOT BE AUTHORIZED UNTIL THIS INITIAL APPROVAL BY THE INSPECTION AGENCY IS MADE.
11. TRENCHES FOR THE CONSTRUCTION OF UTILITIES IS LIMITED TO 3 PIPE LENGTHS OR THAT WHICH SHALL BE BACKFILLED AND STABILIZED WITHIN 3 WORKING DAY, WHICHEVER IS SHORTER.

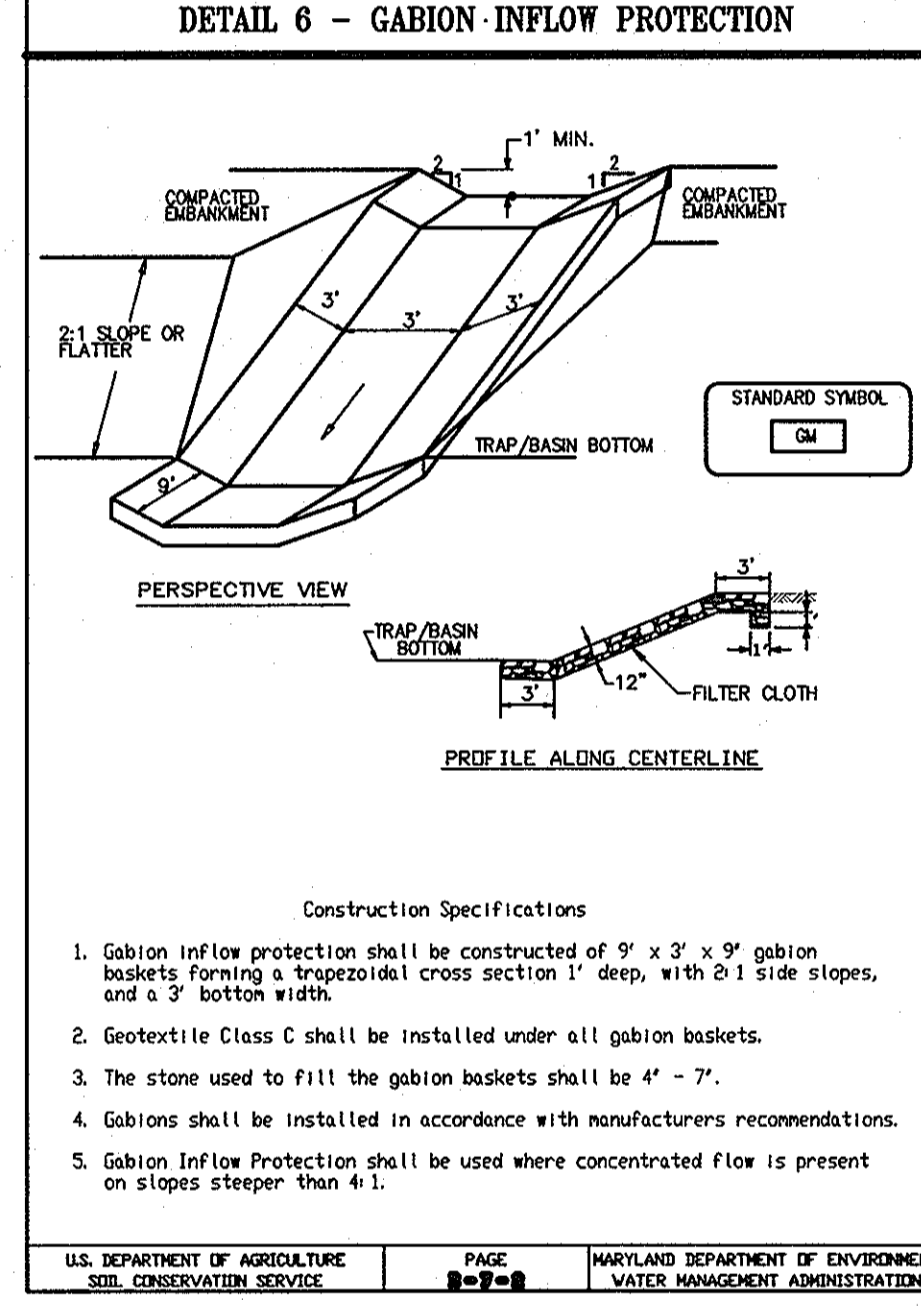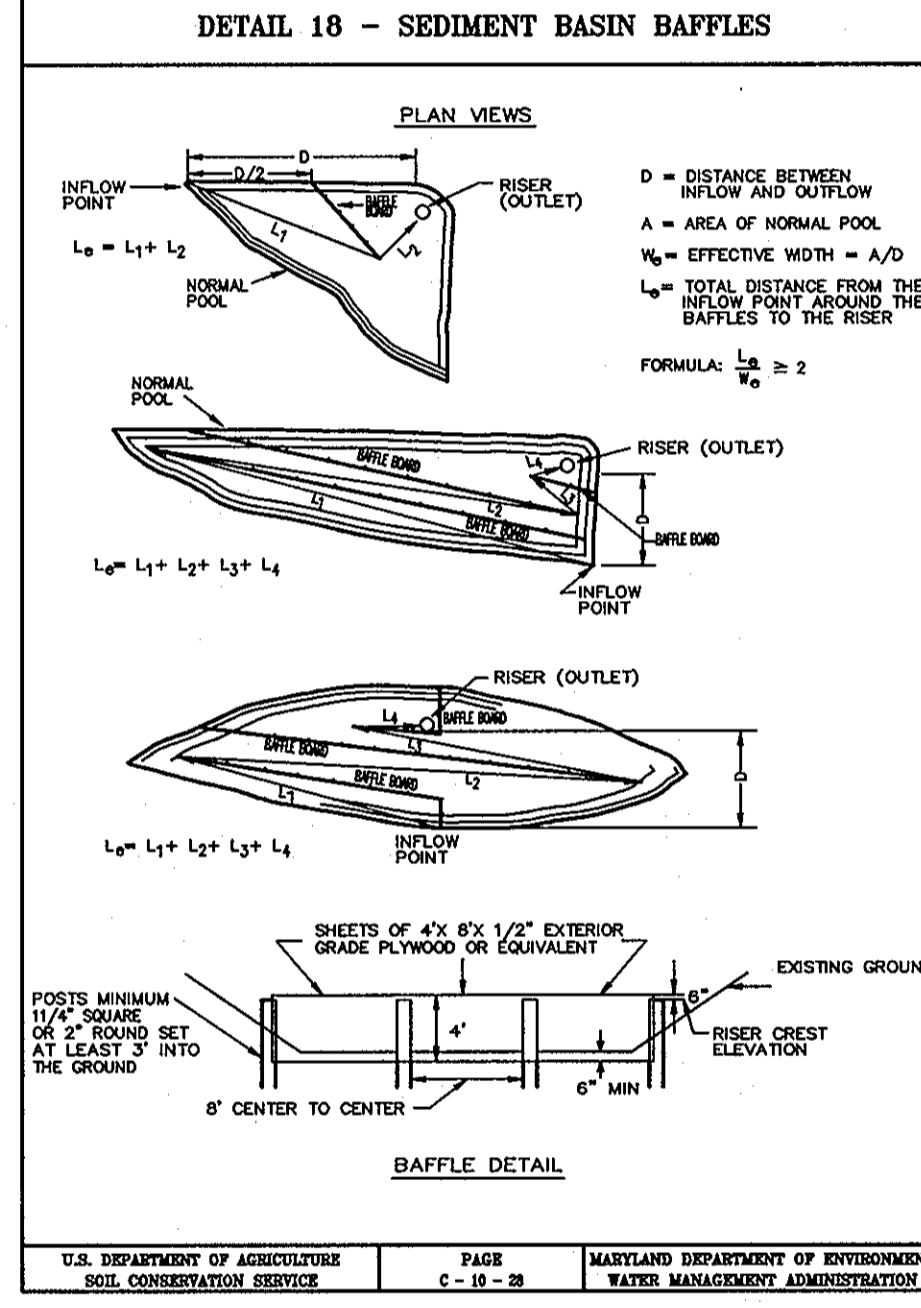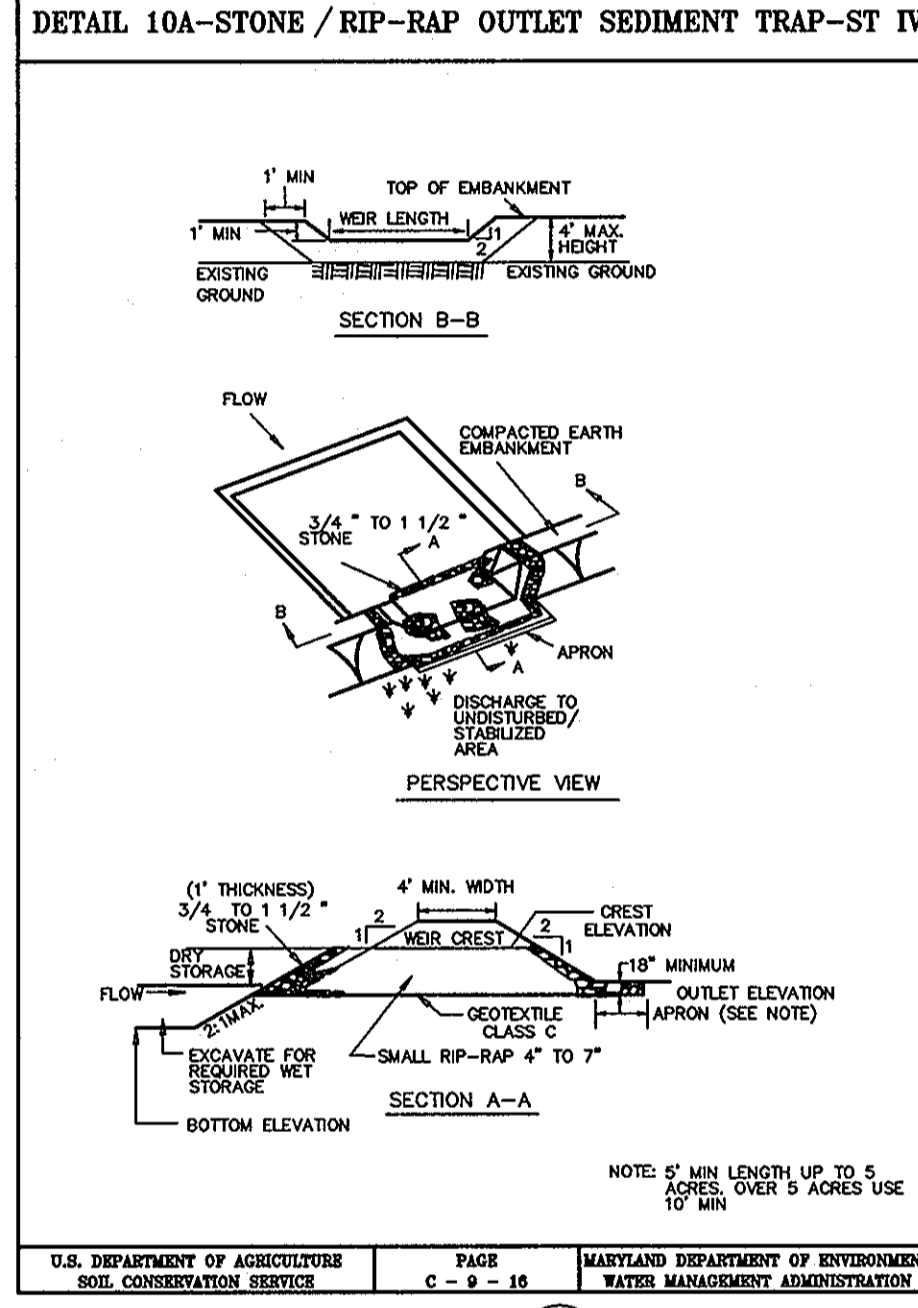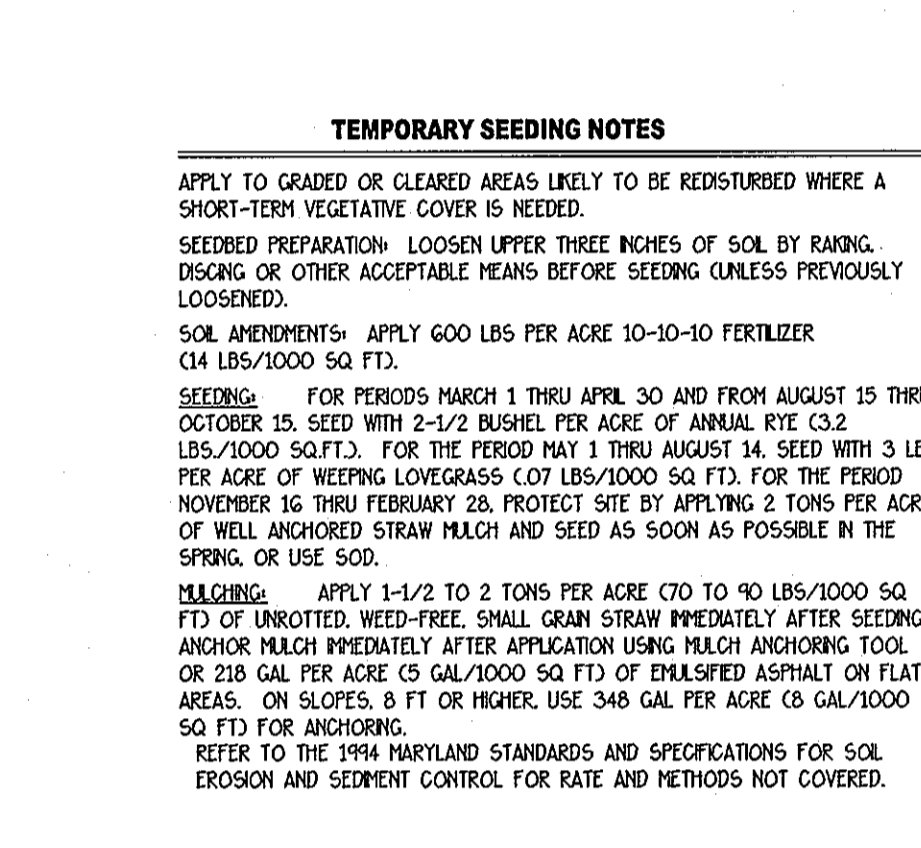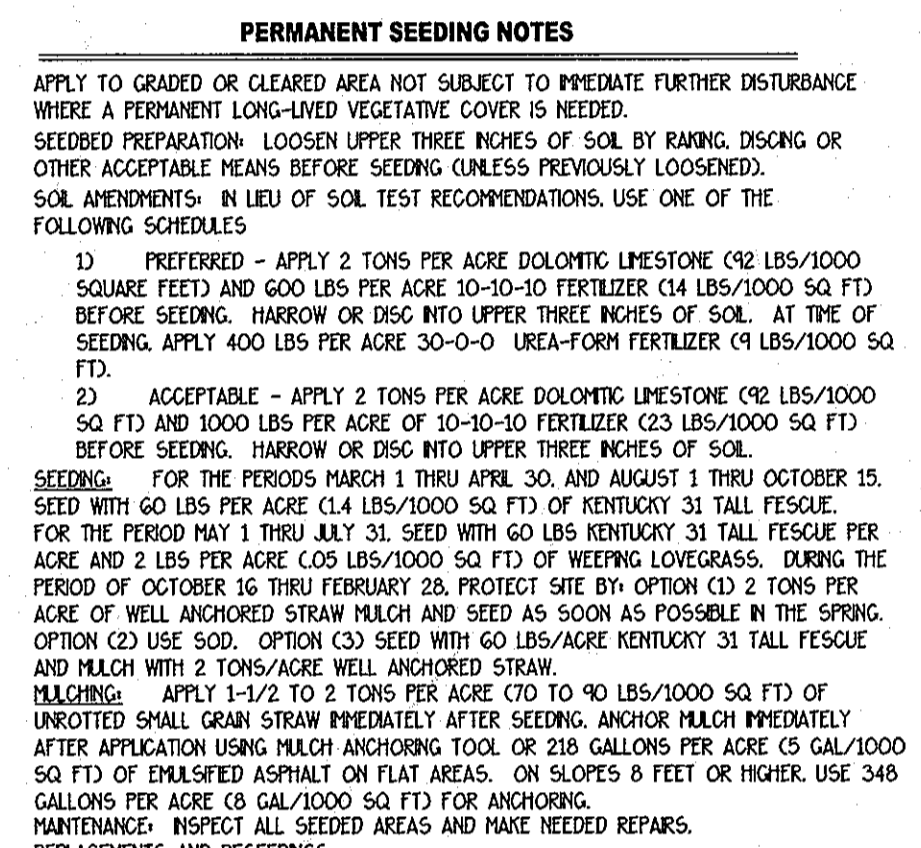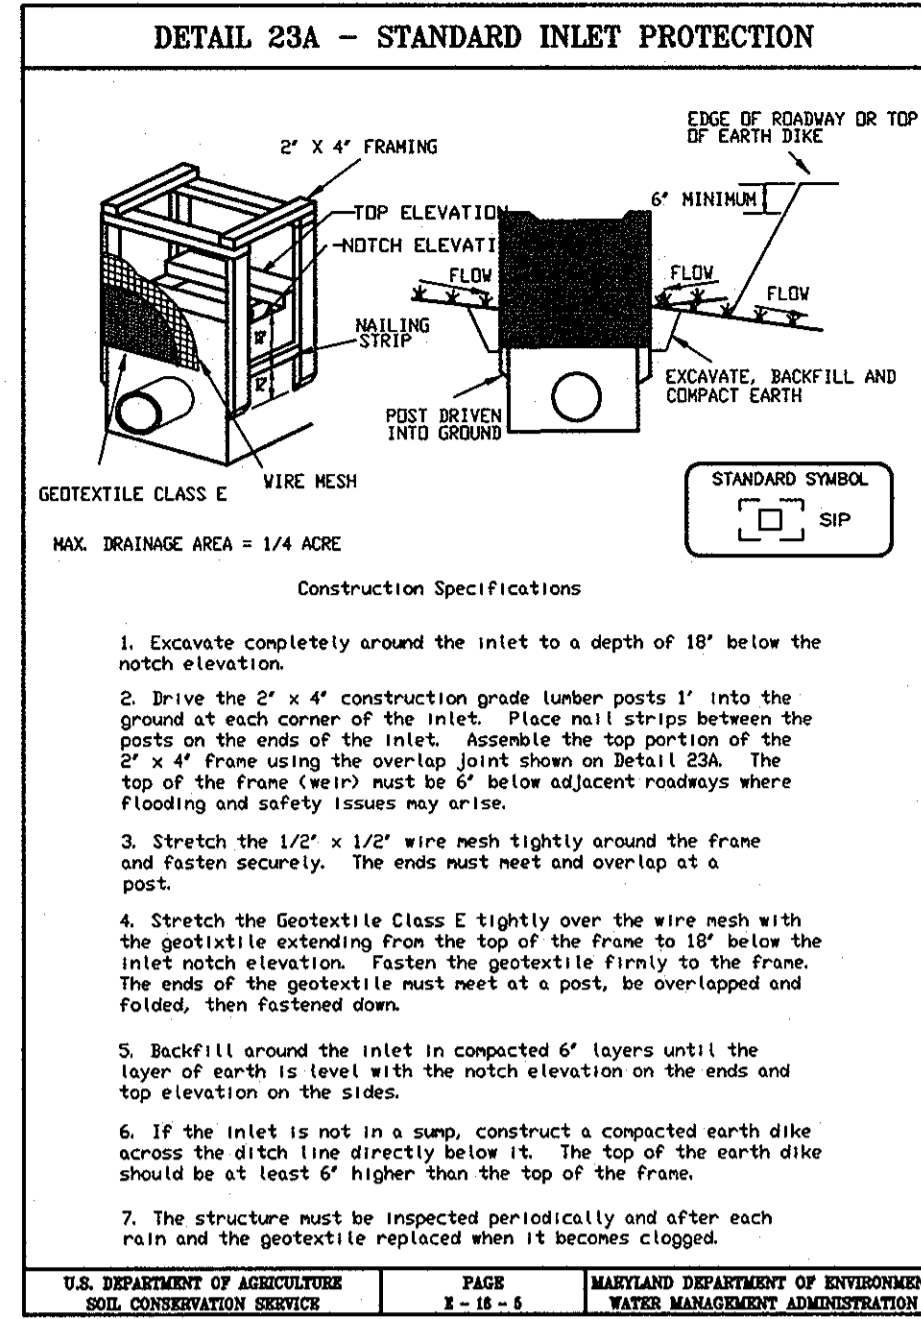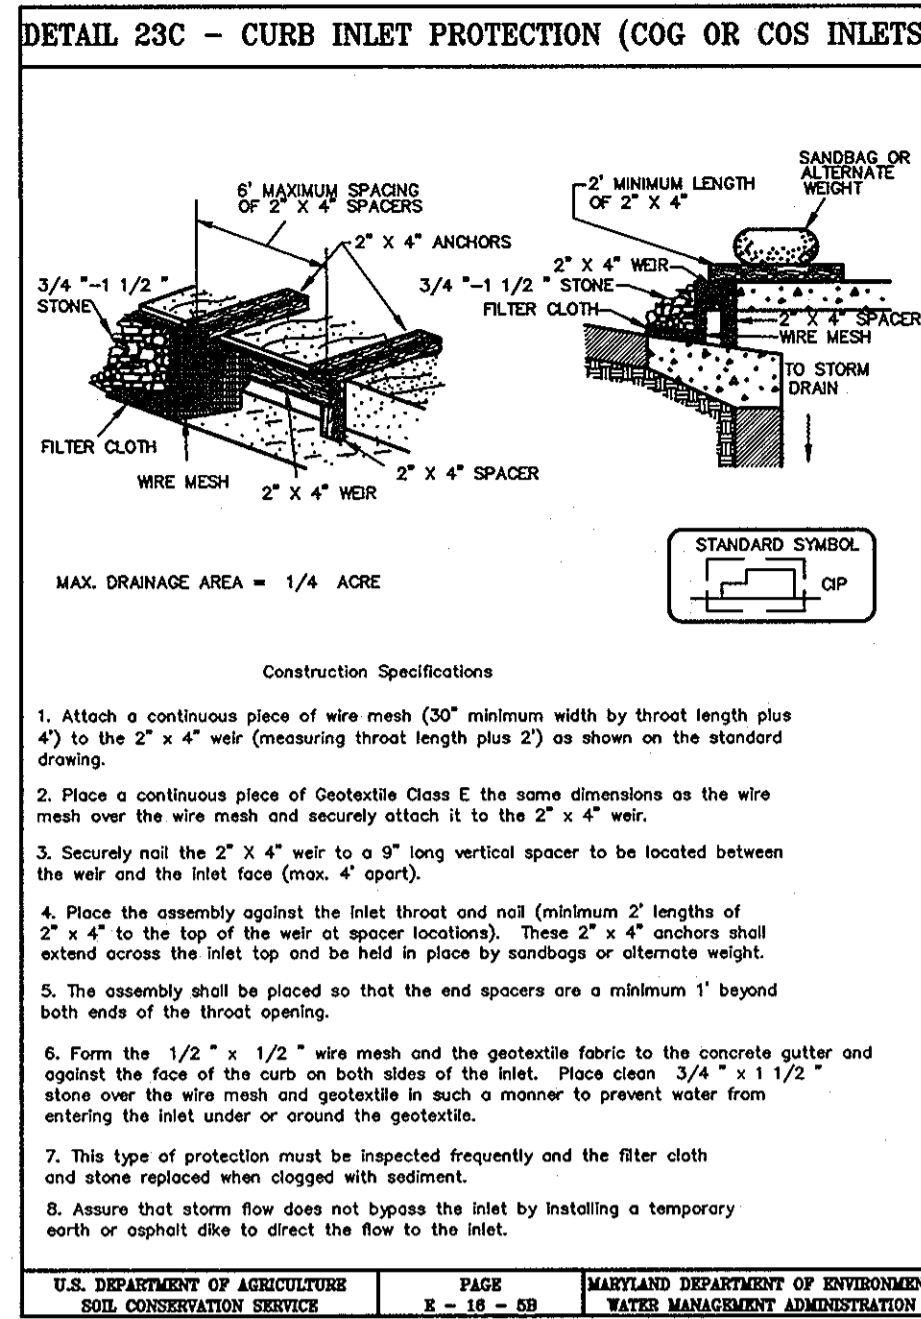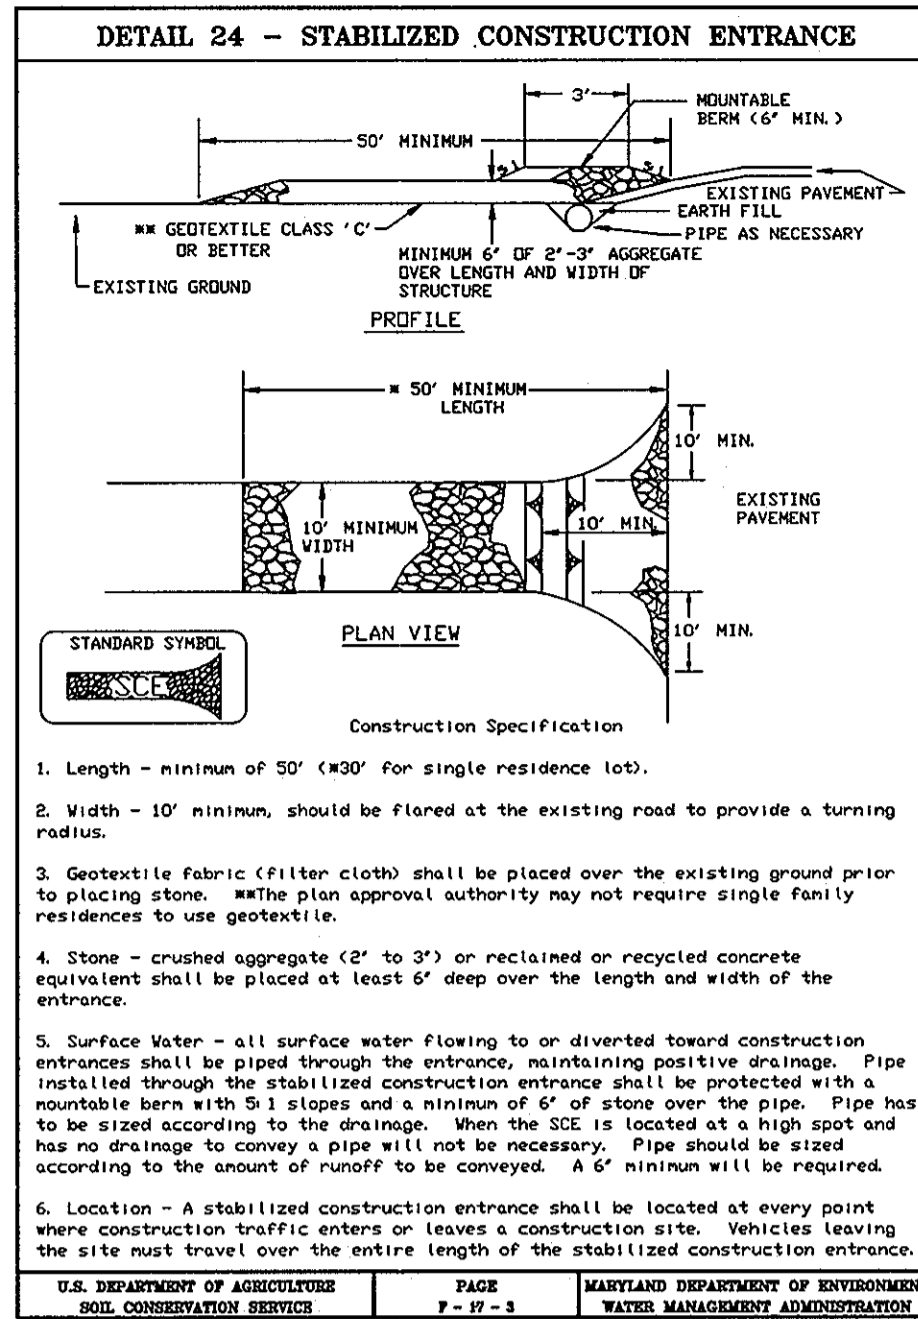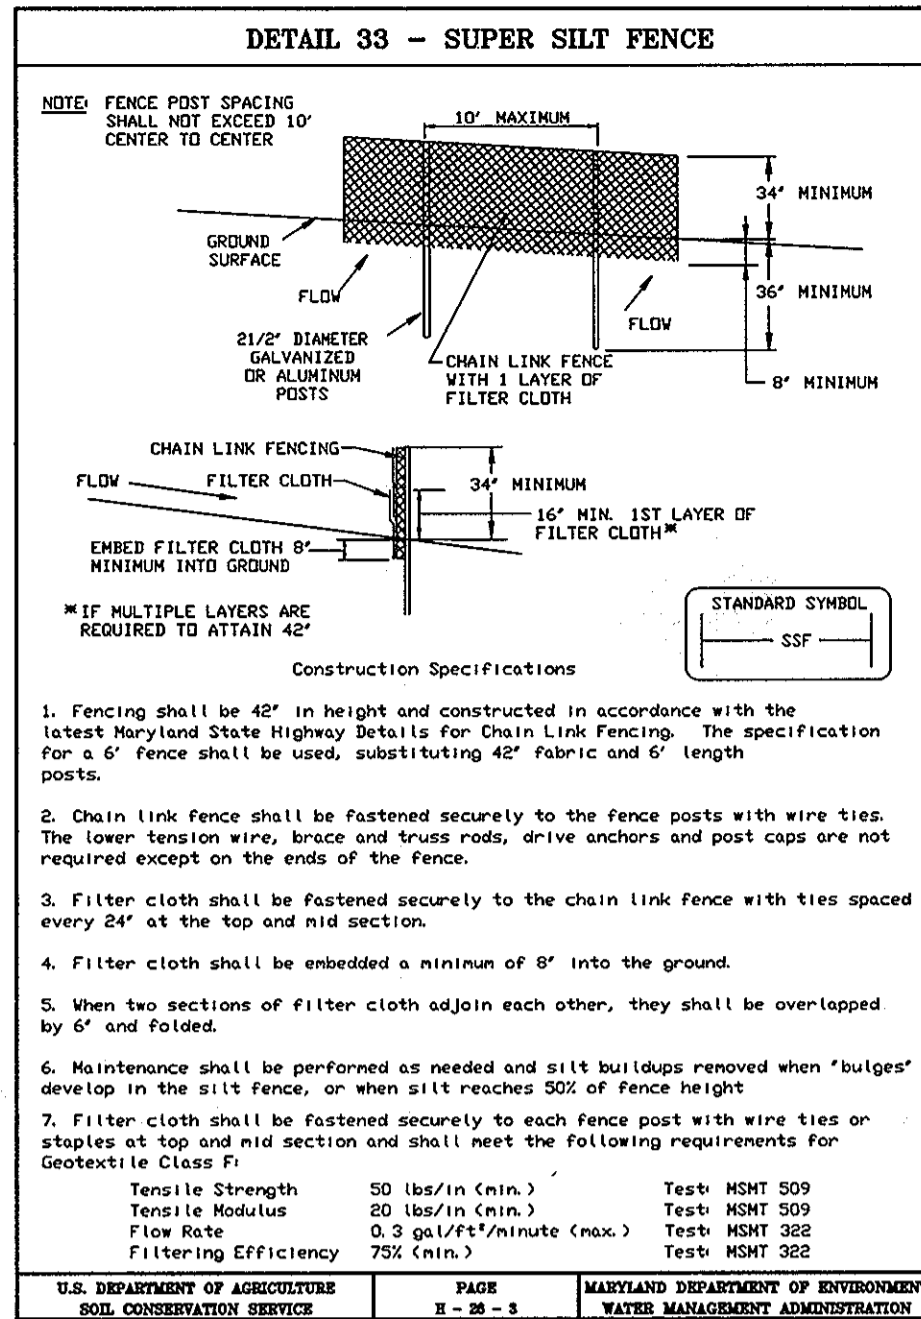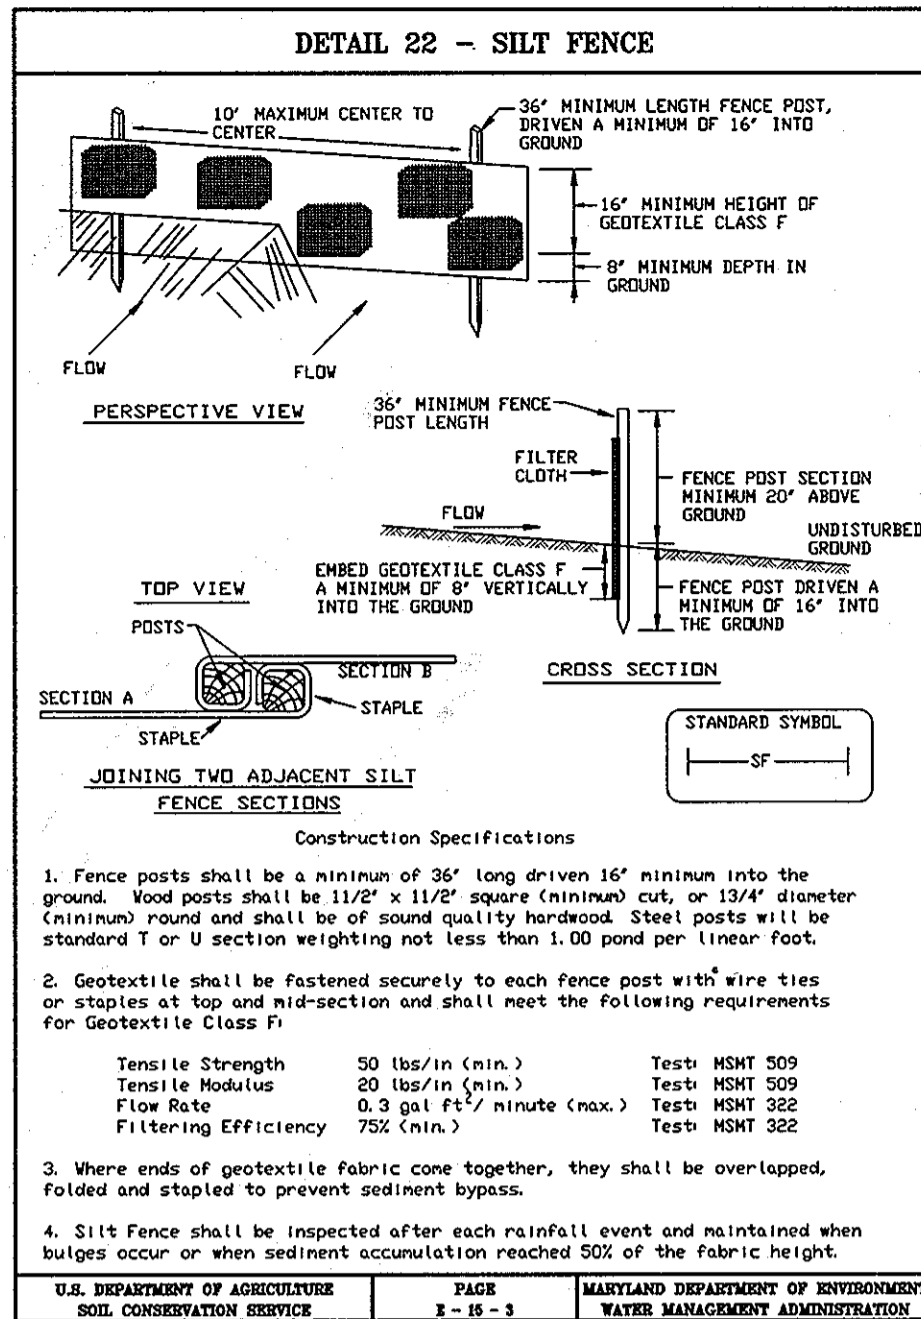

**STANDARD AND SPECIFICATIONS FOR TOPSOIL**

**DEFINITION:** PLACEMENT OF TOPSOIL OVER A PREPARED SUBSOIL PRIOR TO ESTABLISHMENT OF PERMANENT VEGETATION.

**PURPOSE:** TO PROVIDE A SUITABLE SOIL MEDIUM FOR VEGETATIVE GROWTH. SOILS OF CONCERN HAVE LOW MOISTURE CONTENT, LOW NUTRIENT LEVELS, LOW PH, MATERIALS TOXIC TO PLANTS, AND/OR UNACCEPTABLE SOIL GRADATION.

**CONDITIONS WHERE PRACTICE APPLIES:**

- A. THE TEXTURE OF THE EXPOSED SUBSOIL/PARENT MATERIAL IS NOT ADEQUATE TO PRODUCE VEGETATIVE GROWTH.
- B. THE SOIL MATERIAL IS SO SHALLOW THAT THE ROOTING ZONE IS NOT DEEP ENOUGH TO SUPPORT PLANTS OR FURNISH CONTINUING SUPPLY OF MOISTURE AND PLANT NUTRIENTS.
- C. THE ORIGINAL SOIL TO BE VEGETATED CONTAINS MATERIAL TOXIC TO PLANT GROWTH.
- D. THE SOIL IS SO ACIDIC THAT TREATMENT WITH LIMESTONE IS NOT FEASIBLE.

**CONSTRUCTION AND MATERIAL SPECIFICATIONS:**

- I. TOPSOIL SALVAGED FROM THE EXISTING SITE MAY BE USED PROVIDED THAT IT MEETS THE STANDARDS AS SET FORTH IN THESE SPECIFICATIONS. TYPICALLY, THE DEPTH OF TOPSOIL TO BE SALVAGED FOR A GIVEN SOIL TYPE CAN BE FOUND IN THE RESPECTIVE SOIL PROFILE SECTION IN THE SOIL SURVEY PUBLISHED BY USDA-SOCS IN COOPERATION WITH MARYLAND AGRICULTURAL EXPERIMENTAL STATION.
- I. TOPSOIL SPECIFICATIONS - SOIL TO BE USED AS TOPSOIL MUST MEET THE FOLLOWING:
  - A. TOPSOIL SHALL BE A LOAM, SANDY LOAM, CLAY LOAM, SILT LOAM, SANDY CLAY LOAM, LOAMY SAND, OTHER SOILS MAY BE USED IF RECOMMENDED BY A AGRONOMIST OR SOIL SCIENTIST AND APPROVED BY THE APPROPRIATE APPROVAL AUTHORITY. REGARDLESS OF SOIL TYPE, SOIL SHALL NOT BE A MIXTURE OF CONTRASTING TEXTURED SUBSOILS AND SHALL CONTAIN LESS THAN 5% BY VOLUME OF ONDERS, STONES, SLAG, COARSE FRAGMENTS, GRAVEL, STICKS, ROOTS, TRASH, OR OTHER MATERIALS LARGER THAN 1 1/2" IN DIAMETER.
  - B. TOPSOIL SHALL BE FREE OF PLANT PARTS SUCH AS BERBERIS GRASS, QUACKGRASS, JOHNSONGRASS, NUTSEDGE, POISON IVY, THISTLE, OR OTHERS AS SPECIFIED.
  - C. WHERE THE SUBSOIL IS EITHER HIGHLY ACIDIC OR COMPOSED OF HEAVY CLAYS, GROUND LIMESTONE SHALL BE SPREAD AT THE RATE OF 1-4 TONS/ACRE (200-400 POUNDS PER 1000 SQUARE FEET) PRIOR TO THE PLACEMENT OF TOPSOIL. LIME SHALL BE DISTRIBUTED UNIFORMLY OVER DESIGNATED AREAS AND WORKED INTO THE SOIL IN CONJUNCTION WITH TILLAGE OPERATIONS AS DESCRIBED IN THE FOLLOWING PROCEDURES.
- II. FOR SITES HAVING DISTURBED AREAS UNDER 5 ACRES:
  - A. PLACE TOPSOIL OF REQUIRED AND APPLY SOIL AMENDMENTS AS SPECIFIED IN 2.0 VEGETATIVE STABILIZATION - SECTION 1 - VEGETATIVE STABILIZATION METHODS AND MATERIALS (SEE SEE SEEDING NOTES).
  - B. FOR SITES HAVING DISTURBED AREAS OVER 5 ACRES:
    - A. ON SOIL MEETING TOPSOIL SPECIFICATIONS, OBTAIN TEST RESULTS INDICATING FERTILIZER AND LIME AMENDMENTS REQUIRED TO BRING THE SOIL INTO COMPLIANCE WITH THE FOLLOWING:
      1. PH FOR TOPSOIL SHALL BE BETWEEN 6.0 AND 7.5. IF THE TESTED SOIL DEMONSTRATES A PH OF LESS THAN 6.0, SUFFICIENT LIME SHALL BE RESCORDED TO RAISE THE PH TO 6.0, OR HIGHER.
      2. ORGANIC CONTENT OF TOPSOIL SHALL BE NOT LESS THAN 1.5 PERCENT BY WEIGHT.

**ALTERNATIVE FOR PERMANENT SEEDING -** INSTEAD OF APPLYING THE FULL AMOUNTS OF LIME AND COMPERAL FERTILIZER, COMPOSTED SLUDGE AND AMENDMENTS MAY BE APPLIED AS SPECIFIED BELOW:

- A. COMPOSTED SLUDGE MATERIAL FOR USE AS A SOIL CONDITIONER FOR SITES HAVING DISTURBED AREAS UNDER 5 ACRES SHALL BE TESTED TO PRESCRIBE AMENDMENTS AND FOR SITES HAVING DISTURBED AREAS UNDER 5 ACRES SHALL CONFORM TO THE FOLLOWING REQUIREMENTS:
  1. COMPOSTED SLUDGE SHALL BE SUPPLIED BY, OR ORIGINATE FROM A PERSON OR PERSONS THAT ARE PERMITTED CAT THE TIME OF ACQUISITION OF THE COMPOST BY THE MARYLAND DEPARTMENT OF THE ENVIRONMENT UNDER COPAR 26.24.06.
  2. COMPOSTED SLUDGE SHALL CONTAIN AT LEAST 1 PERCENT NITROGEN, 1.5 PERCENT PHOSPHORUS, AND 0.2 PERCENT POTASSIUM AND HAVE A PH OF 7.0 TO 8.0. IF COMPOST DOES NOT MEET THESE REQUIREMENTS, THE APPROPRIATE CONSTITUENTS MUST BE ADDED TO MEET THE REQUIREMENTS PRIOR TO USE.
  3. COMPOSTED SLUDGE SHALL BE APPLIED AT A RATE OF 1 TON/1000 SQUARE FEET.
- B. COMPOSTED SLUDGE SHALL BE AMENDED WITH A POTASSIUM FERTILIZER APPLIED AT A RATE OF 4 LB/1000 SQUARE FEET, AND 1/3 THE NORMAL LIME APPLICATION RATE.

REFERENCES: GUIDELINE SPECIFICATIONS, SOIL PREPARATION AND SOODING, MD-VA PUB. #1, COOPERATIVE EXTENSION SERVICE, UNIVERSITY OF MARYLAND AND VIRGINIA POLYTECHNIC INSTITUTES, REVISED 1973.

**SEQUENCE OF CONSTRUCTION**

1. APPLY FOR GRADING PERMIT AND SCHEDULE A PRE-CONSTRUCTION MEETING WITH THE INSPECTOR. OBTAIN GRADING PERMIT FROM THE INSPECTOR AT THE MEETING.
  2. INSTALL STABILIZED CONSTRUCTION ENTRANCES, SILT FENCE AND SUPER SILT FENCE (WHERE APPLICABLE). CONSTRUCT SEDIMENT TRAP.
  3. GRADE SITE. PROVIDE DUST CONTROL AS NECESSARY.
  4. CONSTRUCT UTILITIES, EXCEPT STORM DRAIN FROM MANHOLE M 2A TO M 1A. INSTALL TEMPORARY STORM DRAIN DIVERSION AND INSTALL INLET PROTECTION. CONSTRUCT CURB AND GUTTER AND BASE PAV. INSTALL LANDSCAPING.
  5. STABILIZE REMAINING BARE DIRT AREAS WITH PERMANENT SEEDING OR WITH SOD.
  6. ONCE AREA DRAINING TO SEDIMENT CONTROL MEASURES HAVE BEEN STABILIZED, OBTAIN PERMISSION FROM THE INSPECTOR TO REMOVE THE SEDIMENT CONTROL ITEMS. BACKFILL THE SEDIMENT TRAP AND REMOVE THE TEMPORARY STORM DRAIN DIVERSION. CONSTRUCT STORM DRAIN FROM MANHOLE M 2A TO M 1A.
  7. INSTALL SURFACE PAVING.
- NOTE: THESE REPLACEMENT SHEETS SUPERCEDES THE PLAN SHEET DATED DEC., 2003

**ENGINEER'S CERTIFICATE**

I CERTIFY THAT THIS PLAN FOR EROSION AND SEDIMENT CONTROL REPRESENTS A PRACTICAL AND WORKABLE PLAN BASED ON MY PERSONAL KNOWLEDGE OF THE SITE CONDITIONS AND THAT IT WAS PREPARED IN ACCORDANCE WITH THE REQUIREMENTS OF THE HOWARD SOIL CONSERVATION DISTRICT.

*Michael J. Trappan* 9/22/05  
ENGINEER'S SIGNATURE DATE

**BUILDER'S CERTIFICATE**

I/WE CERTIFY THAT ALL DEVELOPMENT AND/OR CONSTRUCTION WILL BE DONE ACCORDING TO THIS PLAN, AND THAT ANY RESPONSIBLE PERSONNEL INVOLVED IN THE CONSTRUCTION PROJECT WILL HAVE A CERTIFICATE OF ATTENDANCE AT A MARYLAND DEPARTMENT OF THE ENVIRONMENT APPROVED TRAINING PROGRAM FOR THE CONTROL OF SEDIMENT AND EROSION BEFORE BEGINNING THE PROJECT. I ALSO AUTHORIZE PERIODIC ON-SITE INSPECTION BY THE HSCD.

*Paul G. Comaroff* 9/22/05  
SIGNATURE OF DEVELOPER/BUILDER DATE

THIS DEVELOPMENT PLAN IS APPROVED FOR SOIL EROSION AND SEDIMENT CONTROL BY THE HOWARD SOIL CONSERVATION DISTRICT.

HOWARD S.C.D. DATE

THESE PLANS HAVE BEEN REVIEWED FOR THE HOWARD SOIL CONSERVATION DISTRICT AND MEET THE TECHNICAL REQUIREMENTS.

NATURAL RESOURCES CONSERVATION SERVICE DATE

APPROVED: HOWARD COUNTY DEPARTMENT OF PUBLIC WORKS


PRIVATE ROADS, DRAINS & SWM

Chief, Bureau of Highways DATE

APPROVED: HOWARD COUNTY DEPARTMENT OF PLANNING + ZONING

Chief, Division of Land Development DATE

Chief, Development Engineering Division DATE

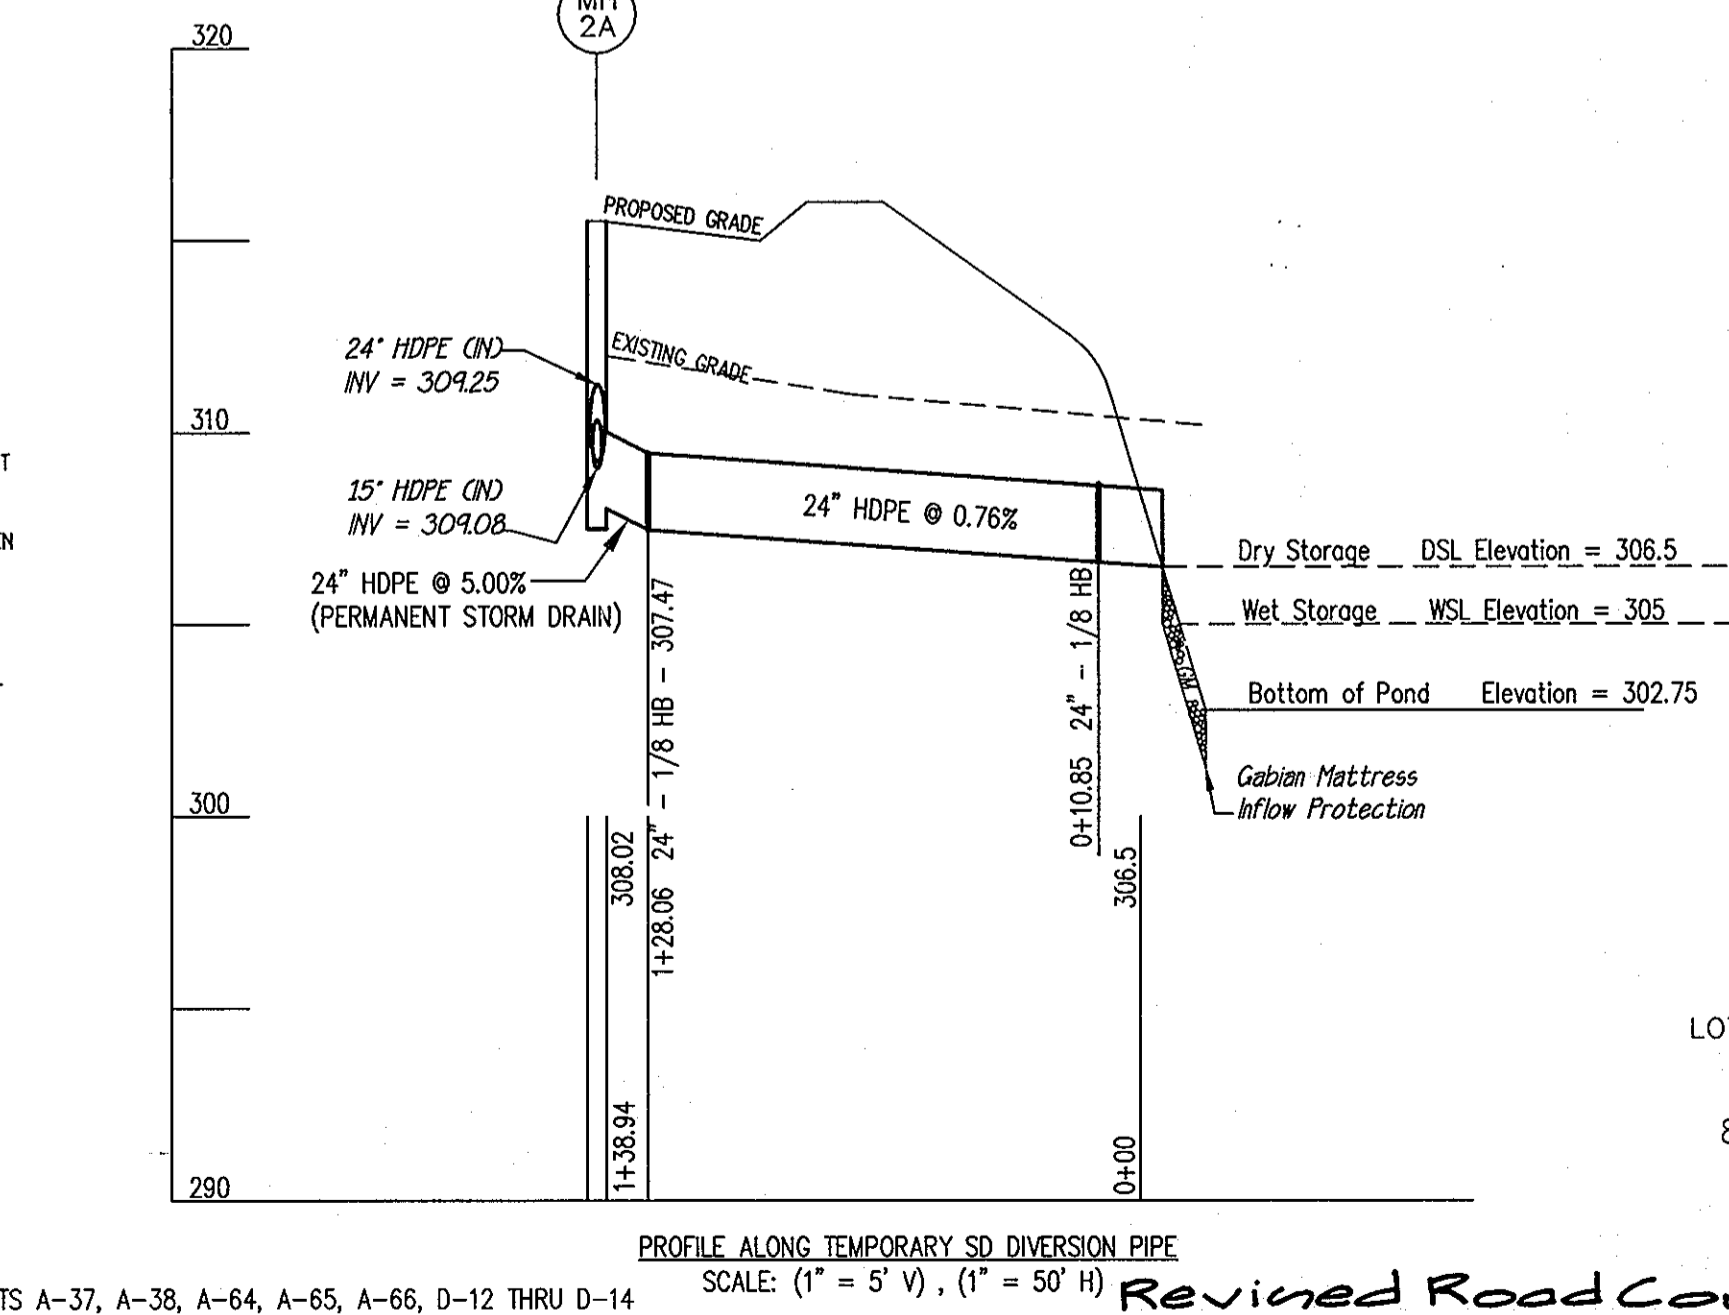

**GLWGUTSCHICK LITTLE & WEBER, P.A.**

CIVIL ENGINEERS, LAND SURVEYORS, LAND PLANNERS, LANDSCAPE ARCHITECTS

3909 NATIONAL DRIVE - SUITE 250 - BURTONSVILLE OFFICE PARK

BURTONSVILLE, MARYLAND 20866

TEL: 301-421-4024 FAX: 301-421-4186

DATE: 09-08

OWNER INFORMATION AND TITLE BLOCK CHANGED

DATE: \_\_\_\_\_

REVISION: \_\_\_\_\_

OWNER & PREPARED FOR: STONE LAKE COMMUNITY ASSOCIATION, INC. / C/O THE HOWARD RESEARCH & DEVELOPMENT CORP.

THE ROUSE BUILDING

10275 LITTLE PATUENCK PARKWAY

COLUMBIA, MARYLAND 21044

ATTN: JOE NECKER

TELE.: (410) 992-6084

SEDIMENT AND EROSION CONTROL DETAILS

STONE LAKE

LOTS A-1 thru A-6, A-26 thru A-28, A-37 thru A-66, LOTS D-1 thru D-14 AND LOT 122

A RESUBDIVISION OF PARCELS 'A' & 'D' AND OPEN SPACE LOT 38

PLAT No's 15274 & 15275

ELECTION DISTRICT No. 6

OWNER'S SIGNATURE: *Colleen Dwelley*

OWNER'S ADDRESS: 8401 GREENSBORO DRIVE, SUITE 300 McLEAN, VIRGINIA 22101

ATTN: COLLEEN DWELLEY (703) 821-2500 ext. 236

SCALE: (1" = 5' V), (1" = 50' H)

Revined Road Construction Plan

OWNER'S SIGNATURE: *Colleen Dwelley*

OWNER'S ADDRESS: 8401 GREENSBORO DRIVE, SUITE 300 McLEAN, VIRGINIA 22101

ATTN: COLLEEN DWELLEY (703) 821-2500 ext. 236

NOTE: THESE REPLACEMENT SHEETS SUPERCEDES THE PLAN SHEET DATED DEC., 2003

SCALE: NTS

ZONING: NT

G. L. W. FILE No.: 99140

DATE: Sept., 2005

TAX MAP - GRID: 47-9/10

P/O PARCEL: B37

SHEET: 9 OF 9

04-18