

1. Material Specifications

The allowable materials to be used in these practices are detailed in Table B.4.1.

Planting Soil

The soil shall be a uniform mix, free of stones, stumps, roots or other similar objects larger than two inches. No other materials or substances shall be mixed or dumped within the micro-bioretention practice that may be harmful to plant growth, or prove a hindrance to the planting or maintenance operations. The planting soil shall be free of Bermuda grass, Quackgrass, Johnson grass, or other noxious weeds as specified under COMAR

The planting soil shall be tested and shall meet the following criteria: Soil Component - Loamy Sand or Sandy Loam (USDA Soil Textural Classification) Organic Content - Minimum 10% by dry weight (ASTM D 2974). In general, this can be met with a mixture of loamy sand (60%-65%) and compost (35% to 40%) or sandy loam (30%), coarse sand (30%), and compost

Clay Content — Media shall have a clay content of less than 5%. pH Range — Should be between 5.5 — 7.0. Amendments (e.g., lime, iron sulfate plus sulfur) may be mixed into the soil to increase or decrease pH.

There shall be at least one soil test per project. Each test shall consist of both the standard soil test for pH, and additional tests of organic matter, and soluble salts. A textural analysis is required from the site stockpiled topsoil. If topsoil is imported, then a texture analysis shall be performed for each location where the topsoil was

It is very important to minimize compaction of both the base of bioretention practices and the required backfill. When possible, use excavation hoes to remove original soil. If practices are excavated using a loader, the contractor should use wide track or marsh track equipment, or light equipment with turf type tires. Use of equipment with narrow tracks or narrow tires, rubber tires with large lugs, or high-pressure tires will cause excessive compaction resulting in reduced infiltration rates and is not acceptable. Compaction will significantly

Compaction can be alleviated at the base of the bioretention facility by using a primary tilling operation such as a chisel plow, ripper, or subsoiler. These tilling operations are to refracture the soil profile through the 12 inch compaction zone. Substitute methods must be approved by the engineer. Rototillers typically do not till deep enough to reduce the effects of compaction from heavy equipment.

Rototill 2 to 3 inches of sand into the base of the bioretention facility before backfilling the optional sand layer. Pump any ponded water before preparing (rototilling) base. When backfilling the topsoil over the sand layer, first place 3 to 4 inches of topsoil over the sand. then rotatill the sand/topsoil to create a gradation zone. Backfill the remainder of the topsoil to final grade.

When backfilling the bioretention facility, place soil in lifts 12" to 18". Do not use heavy equipment within the bioretention basin. Heavy equipment can be used around the perimeter of the basin to supply soils and sand. Grade bioretention materials with light equipment such as a compact loader or a dozer/loader with marsh

Compost is a better organic material source, is less likely to float, and should be placed in the invert and other low areas. Mulch should be placed in surrounding to a uniform thickness of 2" to 3". Shredded or chipped hardwood mulch is the only accepted mulch. Pine mulch and wood chips will float and move to the perimeter of the bioretention area during a storm event and are not acceptable. Shredded mulch must be well aged (6 to 12 months) for acceptance.

Rootstock of the plant material shall be kept moist during transport and on-site storage. The plant root ball should be planted so 1/8th of the ball is above final grade surface. The diameter of the planting pit shall be at least six inches larger than the diameter of the planting ball. Set and maintain the plant straight during the entire planting process. Thoroughly water ground bed cover after installation

Trees shall be braced using 2" by 2" stakes only as necessary and for the first growing season only. Stakes are

Grasses and legume seed should be drilled into the soil to a depth of at least one inch. Grass and leaume plugs shall be planted following the non-grass ground cover planting specifications.

The topsoil specifications provide enough organic material to adequately supply nutrients from natural cycling. The primary function of the bioretention structure is to improve water quality. Adding fertilizers defeats, or at a minimum, impedes this goal. Only add fertilizer if wood chips or mulch are used to amend the soil. Rototill urea fertilizer at a rate of 2 pounds per 1000 square feet.

MAINTENANCE CRITERIA

established areas reveaetated

cleaned and/or replaced.

1. The following items should be addressed to ensure proper maintenance and long-term performance of

2. Privately owned practices shall have a maintenance plan and shall be protected by easement, deed restriction, ordinance, or other legal measures preventing its neglect, adverse alteration, and removal. 3. During the first year of operation, inspection frequency should be after every major storm and poorly

4. Sediment accumulation on the surface of the facility should be removed and the top two to three inches of

5. The top few inches of the planting soil should be removed and replaced when water ponds for more than 48 hours or there is algal growth on the surface of the facility.

6. If standing water persists after filter media has been maintained, the gravel, soil, and sand may need to be

7. Occasional pruning and replacement of dead vegetation is necessary. If specific plants are not surviving, more appropriate species should be used. Watering may be required during prolonged dry periods.

M-3 LAUDSCAPE INFILTRATION PLANT SIZING AND SPACING

PLANTSPACING

PERENNIALS-12" ON CENTER FOR QUART-SIZE 3 ONCENIER FOR GALLON SIZE 3'-MONCENTER FOR QUART GALLON STEE

2-10-14

PLANT SPECIES


HOWARD COUNTY DEPARTMENT OF PLANNING AND ZONING

CHIEF, DIVISION OF LAND DEVELOPMENTAL

APPROVED

PLANTSPECIES SHALLBE SELECTED FROM "PLANT SPECIES APPROPRIETE FOR USE IN BIORETENTION AROX; PRINCE GEORGE COUNTY, DEP, MD WWW. low impact development. Org

Table B.4.1 Materials Specifications for Micro-Bioretention. Rain Gardens & Landscape Infiltration-Specification see Appendix A, Table A.4 plantings are site-specific SWM Design Manual loamy sand (60 - 65%) & USDA soil types loamy sand or sandy loam; clay conter compost (35 – 40%) [2' to 4' deep] sandy loam (30%), coarse sand (30%) & compost (40%) Min. 10% by dry weigh (ASTM D 2974) shredded hardwood aged 6 months, minimum; no pin pea gravel: ASTM-D-448 NO. 8 OR NO. 9 Pea gravel diaphragm (1/8" TO 3/8") Curtain drain omamental stone: washed stone: 2" to 5' eotextile AASHTO M-43 NO. 57 OR NO. 6 A GGREGATE Gravel (underdrains and infiltration berms) (3/8" to 3/4") 4" to 6" rigid schedule 40 PVC or Slotted or perforated pipe; 3/8" perf. @ 6" on center, 4 Inderdrain piping F 758, Type PS 28 or AASHTO holes per row; minimum of 3" of gravel over pipes; not necessary underneath pipes. Perforated pipe shall be wrapped with ¼-inch galvanized hard ware cloth Poured in place concrete (if MSHA Mix No. 3: f'c = 3500 psi on-site testing of poured-in-place concrete required: @ 28 days, normal weight, air-28 day strength and slump test; all concrete design (castentrained; reinforcing to meet in-place or pre-cast) not using previously approved State ASTM-615-60 or local standards requires design drawings sealed and approved by a professional structural engineer licensed in the State of Maryland - design to include meeting ACI Code 350.R/89; vertical loading [H-10 or H-20]; allo wable horizontal loading (based on soil pressures): and analysis of potential cracking AASHTO-M-6 or ASTM-C-33 0.02" to 0.04" Sand substitutions such as Diabase and Graystone (AAS HTO) #10 are not acceptable. No calcium carbonated or dolomitic sand substitutions are acceptable

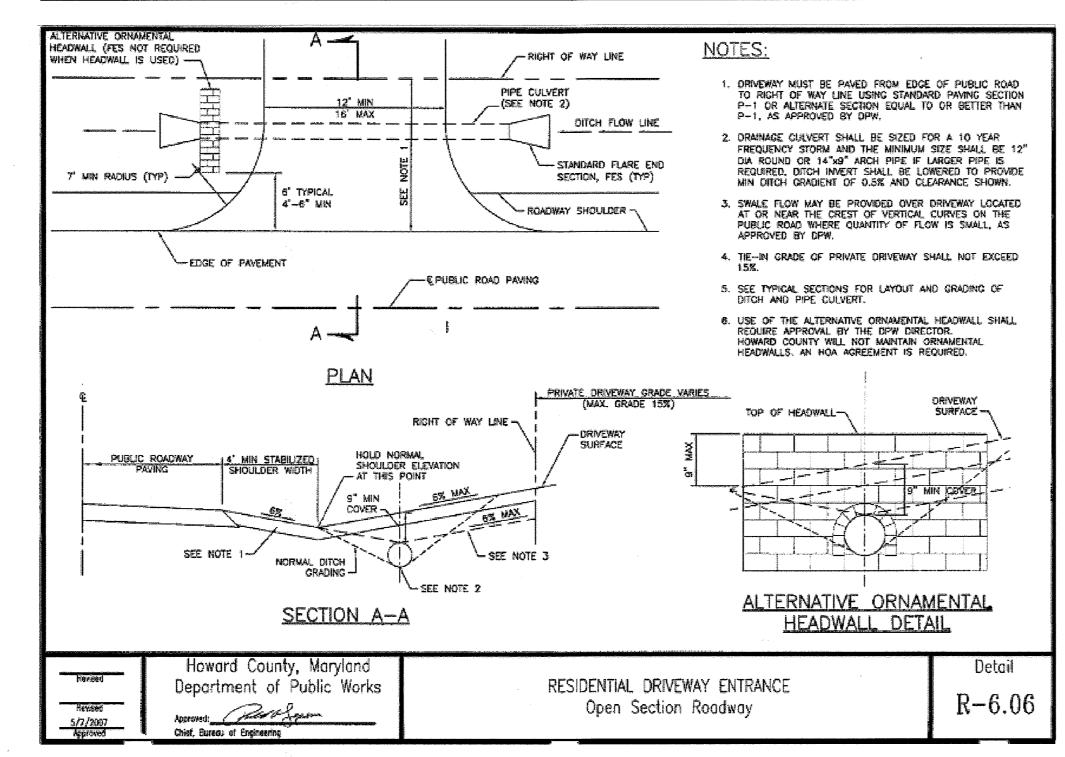

No "rock dust" can be used for sand

Non-Rooftop Disconnection Construction Criteria:

The following should be addressed during construction of projects with non-rooftop

Erosion and Sediment Control: *Erosion and sediment control practices (e.g.,* sediment traps) shall not be located in areas designated for non-rooftop disconnections.

Site Disturbance: To minimize disturbance and compaction, construction vehicles and equipment should avoid areas receiving disconnected runoff. Should areas receiving disconnected runoff become compacted, scarifying the surface or rototilling the soil to a depth of four to six inches shall be performed to ensure permeability. Additionally, amendments may be needed for tight, clayey soils.

Inspection:


A final inspection shall be conducted before use and occupancy approval to ensure that adequate treatment areas and permanent stabilization has been established. **Rooftop Disconnection Construction Criteria:**

The following items should be addressed during the construction of projects with planned rooftop disconnections:

Erosion and Sediment Control: *Erosion and sediment control practices* (e.g., sediment traps) shall not be located in vegetated areas receiving disconnected runoff.

Site Disturbance: Construction vehicles and equipment should avoid areas receiving disconnected runoff to minimize disturbance and compaction. Should areas receiving disconnected runoff become compacted, scarifying the surface or rototilling the soil to a depth of four to six inches shall be performed to ensure permeability. Additionally, amendments may be needed for tight, clayey soils.

A final inspection shall be conducted before use and occupancy approval to ensure that sizing for treatment areas have been met and permanent stabilization has been established.

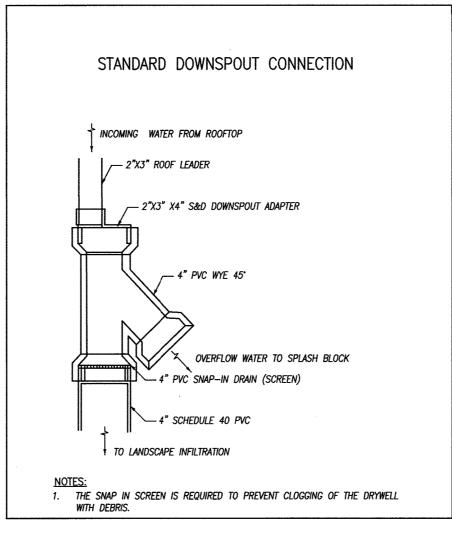


SWM TREATMENT SUMMARY LOTT YOLUME (SSI) YOLUME (ESIV) REGOIRED PROVIDED DRAINAGE IMPERMOUS PRACTICE METHOPOLOGY AREA AREA TREATED esou=PexRxAdizwhere Pe=1.0" Ru=0.95 N-2 NON ROOFEDP 10355F 82 CF 82 CF DISCONNECTION ESDr=Pe×RV*A/12where N-3 SHEET FLAW TO 26535F 26535F 210 CF ZIO CF CONSULY ATTOM AREA Pe=1.0' Rv=0.95 TOTAL SSOV PROVIDED 292 CF ESO, REQUIRED 292CF

OPERATION AND MAINTENANCE SCHEDULE FOR LANDSCAPE INFILTRATION (M-3)

- a. The Owner shall maintain the plant material, mulch layer and soil layer annually. Maintenance of mulch and soil is limited to correcting areas of erosion or wash out. Any mulch replacement shall be done in the spring. Plant material shall be checked for disease and insect infestation and maintenance will address dead material and pruning. Acceptable replacement plant material is limited to the following: 2000 Maryland Stormwater Design Manual Volume II. Table A.4.1 and 2.
- b. The Owner shall perform a plant in the spring and in the fall of each year. During the inspection, the Owner shall remove dead and diseased vegetation considered beyond treatment, replace dead plant material with acceptable replacement plant material, treat diseased trees and shrubs, and replace all deficient stakes
- c. The Owner shall inspect the mulch each spring. The mulch shall be replaced every two to three years. The previous mulch layer shall be removed before the new layer is applied.
- d. The Owner shall correct soil erosion on an as needed basis, with a minimum of once per month and after each heavy storm..

OPERATION AND MAINTENANCE SCHEDULE FOR PRIVATELY OWNED AND MAINTAINED DISCONNECTION OF ROOFTOP RUNOFF (N-1)

DISCONNECTION OF NON-ROOFTOP (N-2)MAINTENANCE OF AREAS RECEIVING DISCONNECTED RUNOFF IS GENERALLY NO DIFFERENT THAN THAT REQUIRED FOR OTHER LAWN OR LANDSCAPED AREAS. THE OWNER SHALL ENSURE THE AREAS RECEIVING RUNOFF ARE PROTECTED FROM FUTURE COMPACTION OR DEVELOPMENT OF IMPERVIOUS AREA. IN

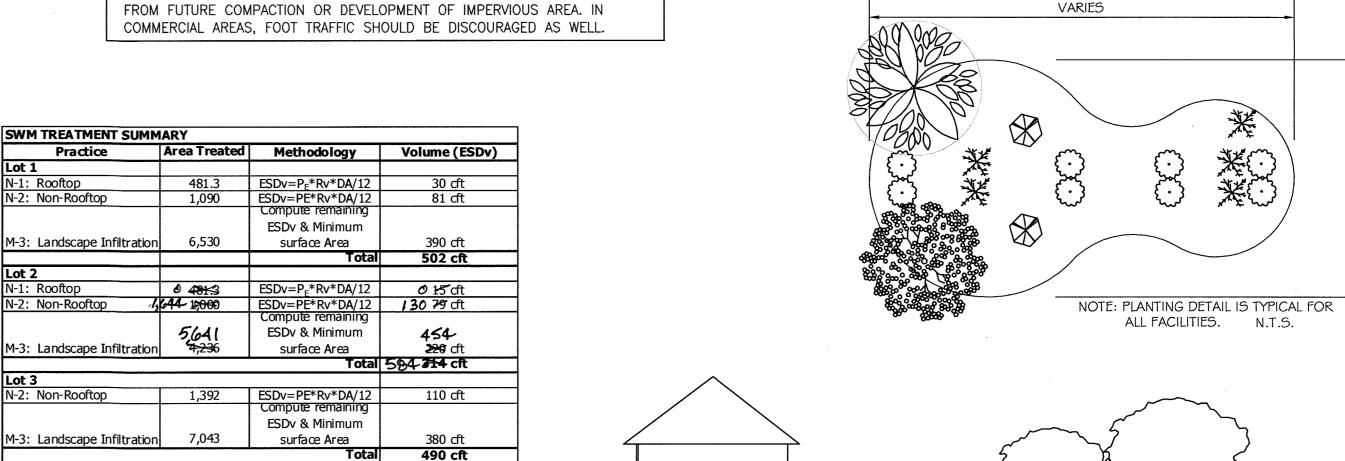

2 INFLOW SIDES

FILTER FABRIC

12" GRAVEL -

ONLY)

(SIDE OF TRENCH

3" MULCY

I OUTFLOW SIDE

-ELEV. (SEE TABLE)

— 12"-18" PLANTING SOII

FILTER FABRIC

ONLY)

(SIDE OF TRENCH

I OUTFLOW SIDE

-PLANTING SOIL

12"-18"

8' SWM GRASS

OWNER:

QUARTZ HILL III, LLC

410-489-4630

4003 JENNINGS CHAPEL

SCALE: AS SHOWN

BROOKEVILLE, MD 20833

-GRAVEL 12"

-SAND 6"-12"


(SEE TABLE)

TYPICAL SECTION FOR PROPOSED

N.T.S.


LANDSCAPE INFILTRATION PLANTING DETAIL

LANDSCAPE INFILTRATION FACLITIES

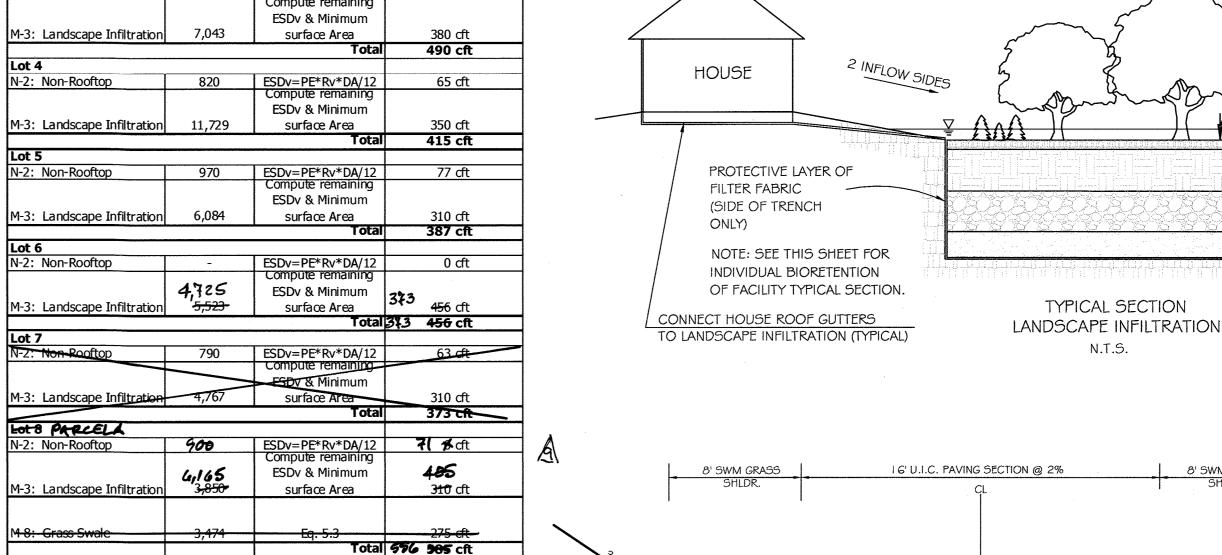

Total ESDv Provided = 4,109 cft ESDv Required = 4,104 cft SWM FACILITY TABLE SWM-1 M-3 LANDSCAPED INFILTRATION 26' x 15' -12" PONDING SWM-2 M-3 LANDSCAPED INFILTRATION 22' x 10' =12" PONDING | ZZ' x 17'-12" PONDING SWM-3 M-3 LANDSCAPED INFILTRATION 380 SF -12" PONDING SWM-4 M-3 LANDSCAPED INFILTRATION 350 SF -12" PONDING SWM-5 M-3 LANDSCAPED INFILTRATION 20' x 15.5' -12" PONDING ZIS' x8'-12" PONDING SWM-6 M-3 LANDSCAPED INFILTRATION 38' x 12' -12" PONDING WM-7 M-3 LANDSCAPED INFILTRATION 31' x 10' 12" PONDING SWM-8 M-3 LANDSCAPED INFILTRATION 31' x 10' -12" PONDING

S" COMPACTED CRUSHER RUN BASE WITH TAR \$ CHIP COATING (1-1/2" MIN.) PAVING SECTION USE-IN-COMMON DRIVEWAY SECTION NOT TO SCALE

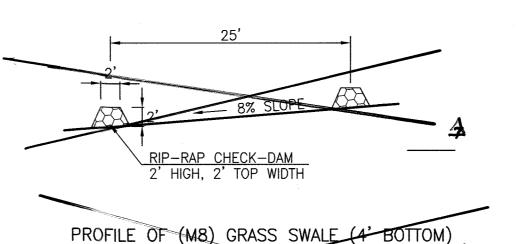

WITH CHECK-DAMS TO REMAINDER PARCEL 4
(SEE SHEET 3 FOR STONE CHECK DAM DETAIL)

SCALE: 1" = 10' VERT. & HORIZ

Use-In-Common Drives

7/16/2020 P. LOTG SUM 5/25/2020 LOTS SWAU DATE | REVISIONS 17/2017 LOT 7 SIUM M3 TON 3 RSJ

PROFESSIONAL CERTIFICATION

STATE OF MARYLAND, LICENSE NO. 18417, EXPIRATION DATE: 9-18-15

HEREBY CERTIFY THAT THESE DOCUMENTS WERE PREPARED OR APPROVED BY ME,

AND THAT I AM A DULY LICENCED PROFESSIONAL ENGINEER UNDER THE LAWS OF TH

5/20/2010 SWM 5 M-3 FACILITY &

SUPPLEMENTAL PLAN 3/6/2020 M3/6-1842 Infilher Fec. STORMWATER MANAGEMENT/CONSTRUCTION NOTES AND DETAILS LOTS 1-7, BUILDABLE PRESERVATION PARCEL A & QUARTZ HILL III FOREST MITIGATION BANK

QUARTZ HILL III

TAX MAP: 8 ELECTION DISTRICT: No. 4 GRID: 11 HOWARD COUNTY, MARYLAND PARCEL NO: 401

DATE: NOVEMBER, 2013 EX. ZONING: RC-DEO SHEET 2 OF 4 F-13-070

VANMAR
ASSOCIATES, INC.
Engineers Surveyors Planners
310 South Main Street P.O. box 328 Mount Airy, Maryland 21771
(301) 829 2890 (301)831 5015 (410) 549 2751

- 2. NOTIFY SEDIMENT CONTROL INSPECTOR AT LEAST THREE (3) WORKING DAYS PRIOR TO STARTING WORK.
- 3. INSTALL STABILIZED CONSTRUCTION ENTRANCES. INSTALL SILT FENCE
- AND OTHER SEDIMENT CONTROL DEVICES AS SHOWN IN THE SEDIMENT CONTROL PLAN. 4. STABILIZE ALL THE GRADED AREAS UP TO 20' OUTSIDE OF THE LIMIT
- 5. COMPLETE UIC DRIVEWAY GRADING AFTER INSTALLATION OF UIC

OF GRADING AS PER PERMANENT SEDDING NOTES.

DRIVEWAY ENTRANCE CULVERTS.

- 6. UPON APPROVAL OF SEDIMENT CONTROL INSPECTOR; REMOVE ALL TEMPORARY SEDIMENT CONTROL DEVICES FOR UIC DRIVEWAYS. FIL ALL DISTURBED AREAS AND STABILIZE AREAS IN ACCORDANCE WITH THE MARYLAND 2011 STANDARDS AND SPECIFICATIONS FOR SOIL EROSION AND SEDIMENT CONTROL.
- 7. NOTIFY INSPECTOR FOR FINAL INSPECTION OF COMPLETED UIC
- 8. INSTALL SEDIMENT CONTROL DEVICES INCLUDING STABILIZED CONSTRUCTION ENTRANCES AND SILT/SUPER SILT FENCES FOR EACH LOT/PRESERVATION PARCEL AS REQUIRED BEFORE HOUSE CONSTRUCTION BEGINS ON THE LOT
- 9. ONCE THE SEDIMENT CONTROL DEVICES ARE INSTALLED THE PERMITTEE MUST OBTAIN APPROVAL FROM THE INSPECTOR BEFORE PROCEEDING WITH ADDITIONAL CLEARING, GRUBBING OR GRADING.
- 10. GRADE LOT/PRESERVATION PARCEL PER APPROVED PLAN AND BEGIN CONSTRUCTION.— WWW.
- 11. ANY AREAS THAT CAN BE TEMPORARILY SEEDED DURING HOUSE. -CONSTRUCTION MUST BE TEMPORARILY STABILIZED PER SEEDING NOTES
- -12-COMPLETE-HOUSE-CONSTRUCTION.
- 13. UPON COMPLETION OF HOUSE CONSTRUCTION AND STABILIZATION OF> -DISTURBED -AREAS, CONSTRUCT-LANDSCAPE INFILTRATION FACILITY ON HOUSE
- 14. UPON APPROVAL OF SEDIMENT CONTROL INSPECTOR; REMOVE ALL TEMPORARY SEDIMENT CONTROL DEVICES FOR HOUSE CONSTRUCTION. FILL ALL DISTURBED AREAS AND STABILIZE AREAS IN ACCORDANCE WITH THE MARYLAND 2011 STANDARDS AND SPECIFICATIONS FOR SOIL EROSION AND SEDIMENT CONTROL.
- 15. NOTIFY INSPECTOR FOR FINAL INSPECTION OF COMPLETED HOUSE CONSTRUCTION.

DUST CONTROL

DUST CONTROL METHOD FOR THIS SITE TO PREVENT BLOWING AND MOVEMENT OF DUST FROM EXPOSED SOIL SURFACES: CALCIUM CHLORIDE SHALL BE APPLIED TO EXPOSED SURFACES AT A RATE THAT WILL KEEP SURFACE MOIST UNTIL SOIL IS STABILIZED ACCORDING TO VEGETATIVE SPECS. FOR THIS SITE AND AREAS TO BE PAVED ARE COMPLETED.

MATERIALS SPECIFICATIONS TABLE GEOTEXTILE FABRICS

CLASS	APPARENT OPENING SIZE MM. MAX.	GRAB TENSILE STRENGTH LB. MIN.	BURST STRENGTH PSI. MIN.
A	0.30	250	500
В	0.60	200	320
С	0.30	200	320
D	0.60	90	145
E.	0.30	90	145
F (SILT FENCE)	0.40-0.80*	90	190

*US STD SIEVE CW-02215

THE PROPERTIES SHALL BE DETERMINED IN ACCORDANCE WITH THE FOLLOWING PROCEDURES: -APPARENT OPENING SIZE MST323

-GRAB TENSILE STRENGTH ASTM D 1682:4X8" SPECIMEN, 1X2" CLAMPS, 12"/MIN. STRAIN RATE IN BOTH PRINCIPAL DIRECTIONS OF GEOTEXTILE FABRIC. -BURST STRENGTH ASTM D 3786

THE FABRIC SHALL BE INERT TO COMMONLY ENCOUNTERED CHEMICALS AND HYDROCARBONS, AND WILL BE ROT AND MILDEW RESISTANT. IT SHALL BE MANUFACTURED FROM FIBERS CONSISTING OF LONG CHAIN SYNTHETIC POLYMERS, AND COMPOSED OF A MINIMUM OF 85% BY WEIGHT OF POLYOLEPHINS, POLYOLESTERS, OR POLYAMIDES. THE GEOTEXTILE FABRIC SHALL RESIST DETERIORATION FROM ULTRAVIOLITE EXPOSURE.

IN ADDITION, CLASSES A THROUGH E SHALL HAVE A 0.01 CM/SEC. MINIMUM PERMEABILITY WHEN TESTED IN ACCORDANCE WITH MSMT 507, AND APPARENT MINIMUM ELONGATION OF 20 PERCENT (20%) WHEN TESTED IN ACCORDANCE WITH THE GRAB TENSILE STRENGTH REQUIREMENTS LISTED

NOTE: RECYCLED CONCRETE EQUIVALENT MAY BE SUBSTITUTED FOR ALL STONE CLASSIFICATIONS. RECYCLED CONCRETE EQUIVALENT SHALL BE BROKEN INTO SIZES MEETING THE PROOPRIATE CLASSIFICATION, SHALL CONTAIN NO STEEL REINFORCEMENT, AND SHALL HAVE A DENSITY OF 150 POUNDS PER CUBIC FOOT.

FOR UTILITY WORK ONLY OR FOR OFF-SITE UTILITY WORK

- CAN NOT EXCEED 5,000 SQUARE FEET PLACE ALL EXCAVATED MATERIAL ON HIGH SIDE OF TRENCH.
- ONLY DO AS MUCH WORK AS CAN BE DONE IN ONE DAY SO BACKFILLING, FINAL GRADING, SEEDEING AND MULCHING CAN OCCUR.
- ANY SEDIMENT CONTROL MEASURES DISTURBED BY CONSTRUCTION WILL BE
- STOCKPILE NOTES: NO STOCKPILING ALLOWED ON ASPHALT.

ALL STOCKPILES LEFT AT THE END OF THE NEXT DAY NEED TO BE STABILIZED UNTIL THE NEXT REDISTURBANCE.

PERMANENT SEEDING NOTES

Scope: Planting permanent, long lived vegetative cover on graded and/or cleared areas and areas that have been in temporary vegetation for more than 6 months.

Standards: The following notes shall conform to Section B-4 of the "2011 MARYLAND STANDARDS AND SPECIFICATIONS FOR SOIL EROSION AND SEDIMENT CONTROL" published jointly by the Maryland Department of Environment - Water Management Administration, the National Resource Conservation Service and the Maryland Association of Soil Conservation Districts.

The seed bed shall be prepared by loosening the soil to a depth of 3 to 5 inches and incorporating the lime and fertilizer into this loosened layer of soil. See section B-4-2.

For sites over 5 ac. soil tests will be performed. Soil tests will be conducted by the University of Maryland or a recognized commercial laboratory. Minimum soil conditions shall meet the requirements of section B-4-2-A-2-a, otherwise soil amendments or topsoil will need to be applied. Topsoiling may occur when soil conditions meet the minimum requirements as stated in section B-4-2-B. Soil amendments must meet the requirements as set forth in section B-4-2-C and must be applied as

For sites of 5 ac. or less of disturbance, the following fertilizer and lime rates shall apply. Fertilizer shall consist of a mixture of 10-20-20 and be applied at the following rates: N = 45 lb. per acre (1 lb. per 1000 sq.ft.) P205 = 90 lb. per acre (2 lb. per 1000 sq.ft.) K20 = 90 lb. per acre (2 lb. per 1000 sq.ft.) Lime shall be applied at a rate of 2 tons per acre (90 lb. per 1000 sq.ft.)

Seed type, turigrass or sod application shall meet the requirements in section B-4-5. Seed tags shall be made available to the inspector to verify the type and application rate of seed used. Mulch type and its application will meet the requirements in section B-4-3 a, b and c, and will be applied along with seed or immediately after seeding

Seeding mixtures shall be selected from or will be equal to those on Table B-3. The seeding chart below will need to be placed on and filled in on the sediment control plan

			ss Zone (from xture (from T	Figure B.3):		-	Fertilizer Rat (10-20-20)	æ	Lime Rate
No.	Species	Application	Rate (lb/ac)	Seeding Dates	Seeding Depths	N	P205	K20	
	·				1/4-1/2 in	45 pounds	90 lb/ac (2	90 lb/ac (90 lb/1000 sf)	2 tons/ac
					1/4-1/2 in		lb/1000 sf)	lb/1000 sf)	(90 lb/ 1000 sf)
					1/4-1/2 in	(1.0 lb/ 1000 sf)			1000 01)
		•					•	·	·

HOWARD COUNTY DEPARTMENT OF PLANNING AND ZONING

<u>2-10-14</u> CHIEF. DIVISION OF LAND DEVELOPMENT H Chd Edmen

CHIEF, DEVELOPMENT ENGINEERING DIVISION

THIS DEVELOPMENT PLAN IS APPROVED FOR SOIL EROSION AND SEDIMENT CONTROL BY THE HOWARD SOIL CONSERVATION DISTRICT.

HOWARD SOIL CONSERVATION DISTRICT

SOD SPECIFICATIONS / NOTES

To provide quick cover on disturbed areas (2:1 grade or flatter).

1. General Specifications a. Class of turferass sod must be Maryland State Certified. Sod labels must be made available to

the job foreman and inspector. b. Sod must be machine cut at a uniform soil thickness of ¾ inch, plus or minus ¼ inch, at the time of cutting. Measurement for thickness must exclude top growth and thatch. Broken pads

and torn or uneven ends will not be acceptable. c. Standard size sections of sod must be strong enough to support their own weight and retain their size and shape when suspended vertically with a firm grasp on the upper 10 percent of the

d. Sod must not be harvested or transplanted when moisture content (excessively dry or wet) may adversely affeits survival. c. Sod must be harvested, delivered, and installed within a period of 36 hours. Sod not transplanted within this period must be approved by an agronomist or soil scientist prior to its

a. During periods of excessively high temperature or in areas having dry subsoil, lightly irrigate

the subsoil immediately prior to laying the sod. b. Lay the first row of sod in a straight line with subsequent rows placed parallel to it and tightly wedged against each other. Stagger lateral joints to promote more uniform growth and strength. Ensure that sod is not stretched or overlapped and that all joints are butted tight in

order to prevent voids which would cause air drying of the roots.

c. Wherever possible, lay sod with the long edges parallel to the contour and with staggering joints. Roll and tamp, peg or otherwise secure the sod to prevent slippage on slopes. Ensure solid contact exists between sod roots and the underlying soil surface.

d. Water the sod immediately following rolling and tamping until the underside of the new sod pad and soil surface below the sod are thoroughly wet. Complete the operations of laying, tamping and irrigating for any piece of sod within eight hours.

3. Sod Maintenance

a. In the absence of adequate rainfall, water daily during the first week or as often and sufficiently as necessary to maintain moist soil to a depth of 4 inches. Water sod during the

heat of the day to prevent wilting. b. After the first week, sod watering is required as necessary to maintain adequate moisture

c. Do not mow until the sod is firmly rooted. No more than? of the grass leaf must be removed by the initial cutting or subsequent cuttings. Maintain a grass height of at least 3 inches unless otherwise specified

TEMPORARY SEEDING NOTES

Scope: Planting short term (no more than 6 Months) vegetation to temporarily stabilize any areas where soil disturbance has occurred, until the area can be permanently stabilized with vegetative or

Standards: The following notes shall conform to Section B-4 of the"2011 MARYLAND STANDARDS AND SPECIFICATIONS FOR SOIL EROSION AND SEDIMENT CONTROL" published jointly by the Maryland Department of Environment - Water Management Administration, the National Resource Conservation Service and the Maryland Association of Soil Conservation Districts

The seed bed shall be prepared by loosening the soil to a depth of 3 to 5 inches and incorporating the lime and fertilizer into this loosened layer of soil. See section B-4-2

For temporary stabilization, fertilizer shall consist of a mixture of 10-20-20 and be applied at a rate of 436 lb. per acre (10 lb. per 1000 sq. ft.) and will meet the requirements in section B-4-2. Lime shall be applied at a rate of 2 tons per acre (90 lb. per sq. ft.) and shall meet the requirements in section B-4-2 and B-4-4

Seed type and application shall meet the requirements in section B-4-3 Seed tags shall be made available to the inspector to verify the type and rate of seed used. Mulch type and its application will meet the requirements in section B-4-3 a, b and c and will be applied along with the seed or immediately after seeding

Seeding mixtures shall be selected from or will be equal to those on Table B.1 (page B.20).

Temporary Seeding Summary
The seeding chart below will need to be placed on and filled in on the sediment control plan

*	H: Se	ardiness Zone (from eed Mixture (from	m Figur Table E	e B.3): _ l.1):				Fertilizer Rate	Lime Rate
No.	Species	Application Rate	(lb/ac)	Seeding	Dates	Seeding	Depths	(10-20-20)	mile race
								436 lb/ac (10 lb/1000 sf)	2 tons/ac
								(,,,	(00 15) 1000 51)

VEGETATIVE SPECIFICATIONS AND NOTES

- 1. DISTURB AS SMALL AN AREA OF THE PRESENT COVER AS POSSIBLE WHILE PERFORMING GRADING.
- 2. LIMIT DURATION OF EXPOSURE OF BARE EARTH FROM GRADING OPERATION TO 7 DAYS BY THE ESTABLISHMENT OF TEMPORARY VEGETATION (OR MULCHING IF APPROPRIATE) OR BY
- 3. ESTABLISH PERMANENT VEGETATIVE COVER IMMEDIATELY AFTER FINAL GRADING IS COMPLETED. (THIS INCLUDES ALL GRADING ON OR OFF THIS SITE THAT IS AFFECTED BY THIS CONSTRUCTION.) IF FINAL GRADING IS COMPLETED AT A TIME OTHER THAN THE SEEDING SEASON, A TEMPORARY GROUND COVER SUCH AS MULCHING WILL BE USED TO STABILIZE THE
- 4. RECOMMENDED TEMPORARY SEED MIXTURE: BALBOA RYE AT 150 LBS. PER ACRE
 2 TONS GROUND LIMESTONE PER ACRE
 10-10-10 AT 1,000 LBS. PER ACRE
 STRAW AT 1.5 TONS PER ACRE FERTILIZER: MULCH: SS-1 OR EQUIVALENT AT 200 GAL. PER ACRE ASPHALT:
- KY-31 FESCUE AT 60 LBS. PER ACRE 2 TONS GROUND LIMESTONE PER ACRE 10-10-10 AT 1,000 LBS. PER ACRE STRAW AT 1.5 TONS PER ACRE FERTILIZER: ASPHALT: SS-1 OR EQUIVALENT AT 200 GAL. PER ACRE

ALL OTHER DISTURBED OR GRADED AREAS ON THE PROJECT SITE

- ALL POINTS OF CONSTRUCTION INGRESS AND EGRESS SHALL BE PROTECTED BY 50 FT. (LINEAR) OF CRUSHED STONE TO PREVENT TRACKING OF MUD ONTO PUBLIC ROADS.
- FOLLOWING INITIAL SOIL DISTURBANCE OR REDISTURBANCE, PERMANENT OR TEMPORARY STABILIZATION (SPECIFIED ON PLANS) SHALL BE COMPLETED WITHIN SEVEN CALENDAR DAYS AS TO THE SURFACE OF ALL PERIMETER CONTROL, DIKES, SWALES, DITCHES, PERIMETER SLOPES, AND ALL SLOPES GREATER THAN 3 HORIZONTAL TO 1 VERTICAL (3:1) AND FOURTEEN DAYS AS TO
- 8. ON ALL SITES WITH DISTURBED AREAS IN EXCESS OF 2 ACRES, APPROVAL OF THE INSPECTION AGENCY SHALL BE REQUESTED UPON COMPLETION OF INSTALLATION OF PERIMETER EROSION AND SEDIMENT CONTROLS, BUT BEFORE PROCEEDING WITH ANY OTHER EARTH DISTURBANCE OR GRADING. OTHER BUILDING OR GRADING INSPECTION APPROVALS MAY NOT BE AUTHORIZED UNTIL THIS INITIAL APPROVAL BY THE INSPECTION AGENCY IS MADE. APPROVAL SHALL BE REQUESTED UPON FINAL STABILIZATION OF ALL SITES WITH DISTURBED AREAS IN EXCESS OF 2 ACRES BEFORE REMOVAL OF SEDIMENT CONTROLS.

DETAIL D-2 STONE CHECK DAM

GEOTEXTILE 6 IN

CHANNEL PROFILE

CROSS_SECTION

PLACE NONWOVEN GEOTEXTILE, AS SPECIFIED IN SECTION H-1 MATERIALS, UNDER THE BOTTOM AND SIDES OF THE DAM PRIOR TO PLACEMENT OF STONE. CONSTRUCT THE CHECK DAM WITH WASHED 4 T 7 INCH STONE OR EQUIVALENT RECYCLED CONCRETE (WITHOUT REBAR) WITH SIDE SLOPES OF 2:1 OR FLATTER AND A MINIMUM TOP WOTH OF 12 INCHES. PLACE THE STONE SO THAT IT COMPLETELY COVERS THE WIDTH OF THE CHANNEL AND CHANNEL BANKS. FORM THE WER SO THAT TOP OF THE OUTLET CREST IS APPROXIMATELY 6 INCHES LOWER THAN THE OUTER EDGES. LINE THE UPSTREAM

SET THE HEIGHT FOR THE WEIR CREST EQUAL TO ONE-HALF THE DEPTH OF THE CHANNEL OR DITCH. TO AVOID SCOUR THE MAXIMUM HEIGHT OF THE WEIR CREST MUST NOT EXCEED 2.0 FEET.

. REMOVE ACCUMULATED SEDIMENT WHEN IT REACHES ONE—HALF OF THE HEIGHT OF THE WEIR CREST. MAINTAIN LINE, GRADE, AND CROSS SECTION.

MARYLAND STANDARDS AND SPECIFICATIONS FOR SOIL EROSION AND SEDIMENT CONTROL

FACE OF THE DAM WITH A 1 FOOT THICK LAYER OF WASHED AGGREGATE (1/4 TO 1/2 INCH).

►4 TO 7 IN STONE

GEOTEXTILE 6 I

CONSTRUCTION SPECIFICATIONS

U.S. DEPARTMENT OF AGRICULTURE

-4 TO 7 IN STONE (TYP.)

__12 IN MIN.

MARYLAND DEPARTMENT OF ENVIRONMENT WATER MANAGEMENT ADMINISTRATION

FLOW

EARTHWORK CUT AND FILL QUANTITIES AND AREA OF DISTURBANCE INDICATED ON THIS PLAN ARE SHOWN FOR PURPOSE OF OBTAINING SEDIMENT CONTROL PLAN APPROVAL AND ARE NOT TO BE USED FOR CONTRACTUAL OBLIGATION.

TARLE - STONE SIZE

ABLE - STONE	SIZE				
	SIZE RANGE	D ₅₀	D100	AASHTO	WEIGHT
NUMBER 57*	3/8"-1 1/2"	1/2"	1 1/2"	M-43	N/A
NUMBER 1	2" - 3"	2 1/2"	3"	M-43	N/A
RIP-RAP**	4" - 7"	2 1/2"	7"	N/A	N/A
CLASS I	N/A	9 1/2"	15"	N/A	150 LB MAX
CLASS II	N/A	16"	24"	N/A	700 LB MAX
CLASS III	N/A	23"	34"	N/A	2000 LB MAX

* THIS CLASSIFICATION IS TO BE USED ON THE INSIDE FACE OF STONE OUTLETS AND CHECK DAMS.

** THIS CLASSIFICATION IS TO BE USED WHENEVER SMALL RIP-RAP IS REQUIRED. THE STATE HIGHWAY ADMINISTRATION DDESIGNATION FOR THIS STONE IS STONE FOR GABIONS (905.01 .04)

SILT FENCE
CLASS F GEOTEXTILE FABRICS FOR SILT FENCE SHALL HAVE A 50 LB/IN. MINIMUM TENSILE STRENGTH AND A 20 LB/IN. MINIMUM TENSILE MODULES WHEN TESTED IN ACCORDANCE WITH MSMT 609. THE MATERIAL SHALL ALSO HAVE A 0.3 GAL/FT2/MIN. FLOW RATE AND SEVENTY-FIVE PERCENT (75%) MINIMUM FILTERING EFFICIENCY WHEN TESTED IN ACCORDANCE WITH MSMT 322.

GEOTEXTILE FABRICS USED IN THE CONSTRUCTION OF SILT FENCE SHALL RESIST DETERIORATION FROM ULTRAVIOLET EXPOSURE. THE FABRIC SHALL CONTAIN SUFFICENT AMOUNTS OF ULTRAVIOLET RAY INHIBTORS AND STABILIZATIONS TO PROVIDE A MINIMUM OF 12 MONTHS OF EXPECTED USABLE CONSTRUCTION LIFE AT A TEMPERATURE RANGE OF 0 TO 120 DEGREES F.

STANDARD SYMBOL

ESS SCE SS

EXISTING PAVEMENT

ROPII

NORTH SECTION OF THE SECTION

CLASS THICKNESS (T)

II 32 IN

-- d/2 |--

SECTION A-A

-EARTH FILL

-PIPE (SEE NOTE 6)

E FOR	GABION BASKE	TS .	
sket th	IICKNESS	SIZE OF IND	MIDUAL STONES
ICHES	ММ	INCHES	
6	150	3 - 5	75 - 125
9	225	4 - 7	100 - 175
12	300	4 - 7	100 - 175
18	460	4 - 7	100 - 175

4 - 12

DETAIL B-1 STABILIZED CONSTRUCTION

ENTRANCE

MIN. 6 IN OF 2 TO 3 IN
AGGREGATE OVER LENGTH
AND WIDTH OF ENTRANCE

50 FT MIN.

PROFILE

PLAN VIEW

PLACE STABILIZED CONSTRUCTION ENTRANCE IN ACCORDANCE WITH THE APPROVED PLAN. VEHICLES MUST TRAVEL OVER THE ENTRE LENGTH OF THE SCE. USE MINIMUM LENGTH OF 50 FEET (*30 FEET FOR SINGLE RESIDENCE LOT). USE MINIMUM WIDTH OF 10 FEET. FLARE SCE 10 FEET MINIMUM AT THE EXISTING ROAD TO PROVIDE A TURNING RADIUS.

PIPE ALL SURFACE WATER FLOWING TO OR DIVERTED TOWARD THE SCE UNDER THE ENTRANCE, MAINTAINING POSITIVE DRAINAGE. PROTECT PIPE INSTALLED THROUGH THE SCE WITH A MOUNTABLE BERM WITH 5:1 SLOPES AND A MINIMUM OF 12 INCHES OF STONE OVER THE PIPE. PROVIDE PIPE AS SPECIFIED ON APPROVED PLAN. WHEN THE SCE IS LOCATED AT A HIGH SPOT AND HAS NO DRAINAGE TO CONVEY, A PIPE IS NOT NECESSARY. A MOUNTABLE BERM IS REQUIRED WHEN SCE IS NOT LOCATED AT A HIGH SPOT.

PREPARE SUBGRADE AND PLACE NONWOVEN GEOTEXTILE, AS SPECIFIED IN SECTION H-1 MATERIALS.

REBAR) AT LEAST 6 INCHES DEEP OVER THE LENGTH AND WIDTH OF THE SCE.

DETAIL D-4-1-B ROCK OUTLET PROTECTION II

PLAN VIEW

O% SLOPE INVERT

PROFILE

RIPRAP AND STONE MUST CONFORM TO THE SPECIFIED CLASS.

NONWOVEN GEOTEXTILE

CONSTRUCTION SPECIFICATIONS

PLACE CRUSHED AGGREGATE (2 TO 3 INCHES IN SIZE) OR EQUIVALENT RECYCLED CONCRETE (WITHOUT

MAINTAIN ENTRANCE IN A CONDITION THAT MINIMIZES TRACKING OF SEDIMENT, ADD STONE OR MAKE OTHER REPAIRS AS CONDITIONS DEMAND TO MAINTAIN CLEAN SURFACE, MOUNTABLE BERM, AND SPECIFIED DIMENSIONS. IMMEDIATELY REMOVE STONE AND/OR SEDIMENT SPILLED, DROPPED, OR TRACKED ONTO ADJACENT ROADWAY BY VACUUMING, SCRAPING, AND/OR SWEEPING. WASHING ROADWAY TO REMOVE MUD TRACKED ONTO PAVEMENT IS NOT ACCEPTABLE UNLESS WASH WATER IS DIRECTED TO AN APPROVED SEDIMENT CONTROL PRACTICE.

MARYLAND STANDARDS AND SPECIFICATIONS FOR SOIL EROSION AND SEDIMENT CONTROL

USE NONWOVEN GEOTEXTILE AS SPECIFIED IN SECTION H-1 MATERIALS, AND PROTECT FROM PUNCTURING, CUTTING, OR TEARING, REPAIR ANY DAMAGE OTHER THAN AN OCCASIONAL SMALL HOLE BY PLACING ANOTHER PIECE OF GEOTEXTILE OVER THE DAMAGED PART OR BY COMPLETELY REPLACING THE GEOTEXTILE, PROVIDE A MINIMUM OF ONE FOOT OVERLAP FOR ALL REPAIRS AND FOR JOINING TWO PIECES OF GEOTEXTILE TOGETHER.

PREPARE THE SUBGRADE FOR GEOTEXTILE OR STONE FILTER (% TO 1½ INCH STONE FOR 6 INCH MINIMUM DEPTH) AND RIPRAP TO THE REQUIRED LINES AND GRADES. COMPACT ANY FILL REQUIRED IN THE SUBGRADE TO A DENSITY OF APPROXIMATELY THAT OF THE SURROUNDING UNDISTURBED MATERIAL

CONSTRUCT RIPRAP OUTLET TO FULL COURSE THICKNESS IN ONE OPERATION AND IN SUCH A MANNER AS TO AVOID DISPLACEMENT OF UNDERLYING MATERIALS. PLACE STONE FOR RIPRAP OUTLET IN A MANNER THAT MILL ENSURE THAT IT IS REASONABLY HOMOGENOUS WITH THE SMALLER STONES AND SPALLS FILLING THE VOIDS BETWEEN THE LARGER STONES. PLACE RIPPAY IN A MANNER TO PREVENT DAMAGE TO THE STONE FILTER BLANKET OR GEOTEXTILE. HAND PLACE TO THE EXTENT NECESSARY.


WHERE NO ENDWALL IS USED, CONSTRUCT THE UPSTREAM END OF THE APRON SO THAT THE WIDTH IS TWO TIMES THE DIAMETER OF THE OUTLET PIPE, AND EXTEND THE STONE UNDER THE OUTLET BY A MINIMUM OF 18 INCHES.

CONSTRUCT APRON WITH 0% SLOPE ALONG ITS LENGTH AND WITHOUT OBSTRUCTIONS. PLACE STONE S THAT IT BLENDS IN WITH EXISTING GROUND.

MARYLAND STANDARDS AND SPECIFICATIONS FOR SOIL EROSION AND SEDIMENT CONTROL

NONWOVEN GEOTEXTILE -

CONSTRUCTION SPECIFICATIONS

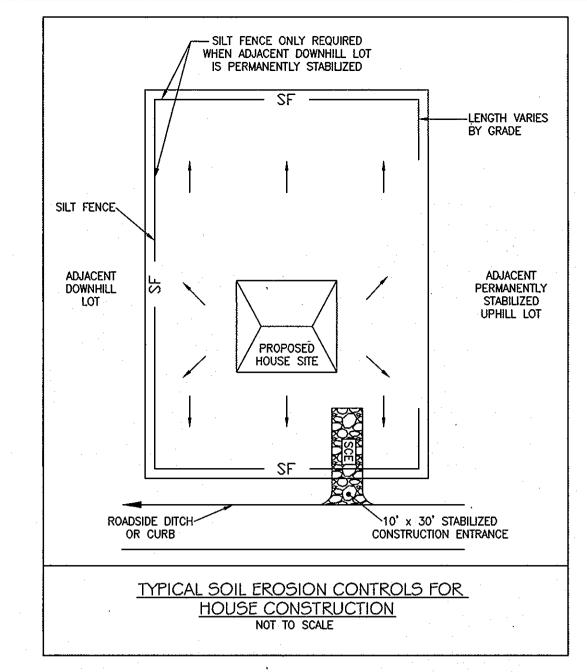

MAP SYMBOL	MAPPING UNIT	HYDROLOGIC SOIL GROUP	HYDRIC? COMPONENTS	Kw	SLOPE
BaA	BAILE silt loam	D,C	YES	.43/32	0-8%
Co	CODORUS & HATBORO silt loam	C,D	YES	.37	0-3%
GgB, GgC	GLENELG loam	В	NO ·	.28	3-15%
GmB	GLENVILLE silt loam	С	NO	.32	3-8%
GnB '	GLENVILLE—BAILE silt loam	C,D	YES	.32/.49	3-8%
MaB, MaC, MaD	MANOR loam	В	NO		3-25%
MkF	MANOR-BRINKLOW complex	B,C/D	NO	.28/.24	25-65%

TEMPORARY STOCKPILE NOTE SITE EARTHWORK HAS BEEN BALANCED SUCH THAT A TEMPORARY STOCKPILE SHOULD NOT BE NECESSARY. SHOULD CONTRACTOR DECIDE TO USE A STOCKPILE, CONTRACTOR SHALL PLACE STOCKPILE ON SUITABLE AREA OF THE SITE AND FOLLOW TEMPORARY STABILIZATION NOTES.

HOWARD SOIL CONSERVATION DISTRICT STANDARD SEDIMENT CONTROL NOTES

revisions thereto.

6)

STANDARD SYMBOL

⊢—SSF—

Site Analysis:

- 1) A minimum of 48 hours notice must be given to the Howard County Department of Inspections, Licenses and Permits, Sediment Control Division prior to the start of any
- construction, (313-1855) 2) All vegetative and structural practices are to be installed according to the provisions of this plan and are to be in conformance with the most current "MARYLAND STANDARDS AND SPECIFICATIONS FOR SOIL EROSION AND SEDIMENT CONTROL", and
- Following initial soil disturbance or redisturbance, permanent or temporary stabilization shall be completed within: a) 3 calendar days for all perimeter sediment control structures, dikes, perimeter slopes and all slopes greater than 3:1, b) 7 days as to all other disturbed or graded areas on the project site.
- All disturbed areas must be stabilized within the time period specified above in accordance with the 2011 MARYLAND STANDARDS AND SPECIFICATIONS FOR SOIL EROSION AND SEDIMENT CONTROL for permanent seeding (Sec. B-4-4), temporary seeding (Sec. B-4-4) and mulching (Sec. B-4-3). Temporary stabilization with mulch alone can only be done when recommended seeding dates do not allow for proper germination and establishment of grasses.
- 5) All sediment control structures are to remain in place and are to be maintained in operative condition until permission for their removal has been obtained from the Howard County Sediment Control Inspector.
 - Total Area of Site 35.20 Acres. 5.43 Acres. Area Disturbed Area to be roofed or paved 1.00 Acres. Area to be vegetatively stabilized 4.43 Acres.

Total Cut ___ Çu. Yds. Total Fill Offsite waste/borrow area location N/A. Location must have active grading permit and as approved

necessary by the Howard County Sediment Control Inspector.

by inspector. Any sediment control practice which is disturbed by grading activity for placement of utilities must be repaired on the

same day of disturbance. Additional sediment control must be provided, if deemed

9) On all sites with disturbed areas in excess of 2 acres, approval of the inspection agency shall be requested upon completion of installation of perimeter erosion and sediment controls, but before proceeding with any other earth disturbance or grading. Other building or grading inspection approvals may not be authorized until this initial approval by the inspection agency is made.

10) Trenches for the construction of utilities is limited to three pipe lengths or that which can be back filled and stabilized within one working day, whichever is shorter.

11) Any changes or revisions to the sequence of construction must be reviewed and approved by the plan approval authority prior to proceeding with construction.

12) A project is to be sequenced so that grading activities begin on one grading unit (maximum acreage of 20 ac. per grading unit) at a time. Work may proceed to a subsequent grading unit when at least 50 percent of the disturbed area in the preceeding grading unit has been stabilized and approved by the enforcement authority. Unless otherwise specified and approved by the approval authority, no more than 30 acres cumulatively may be disturbed at a given time.

13) Double row of "Super Silt Fence" is to be provided at the direction of the Seciment Control Inspector.

STANDARD SYMBOL DETAIL E-1 SILT FENCE DETAIL E-3 SUPER SILT FENCE 10 FT MAX ELEVATION GALVANIZED CHAIN LINK FENCE WITH WOVEN SLIT FILM GEOTEXTILE ELEVATION woven sut film geotextile— EMBED GEOTEXTILE MIN. OF 8 IN VERTICALLY INTO THE GROUND. BACKFILL AND COMPACT THE SOIL ON BOTH SIDES OF GEOTEXTILE. CROSS SECTION CROSS SECTION CONSTRUCTION_SPECIFICATIONS STEP 2 FASTEN 9 GAUGE OR HEAVIER GALVANIZED CHAIN LINK FENCE (2% INCH MAXIMUM OPENING) 42 INCHES IN HEIGHT SECURELY TO THE FENCE POSTS WITH WIRE TIES OR HUG RINGS.

STAPLE

MARYLAND DEPARTMENT OF ENMRONMENT WATER MANAGEMENT ADMINISTRATION

OWNER:

QUARTZ HILL III, LLC

4003 JENNINGS CHAPEL ROAD

BROOKEVILLE, MD 20833

STAPLE -----

STAPLE-

JOINING TWO ADJACENT SILT

FENCE SECTIONS (TOP VIEW)

S. DEPARTMENT OF AGRICULTURE
RESOURCES CONSERVATION SERVICE

MARYLAND STANDARDS AND SPECIFICATIONS FOR SOIL EROSION AND SEDIMENT CONTROL

2011

PROFESSIONAL CERTIFICATION HEREBY CERTIFY THAT THESE DOCUMENTS WERE PREPARED OR APPROVED BY ME,

STATE OF MARYLAND, LICENSE NO. 18417, EXPIRATION DATE: 9-18-15

AND THAT I AM A DULY LICENCED PROFESSIONAL ENGINEER UNDER THE LAWS OF THE

. INSTALL 2% INCH DIAMETER GALVANIZED STEEL POSTS OF 0.095 INCH WALL THICKNESS AND SIX FOOT LENGTH SPACED NO FURTHER THAN 10 FEET APART, DRIVE THE POSTS A MINIMUM OF 36 INCHES INTO THE GROUND.

I. FASTEN WOVEN SLIT FILM GEOTEXTILE AS SPECIFIED IN SECTION H-1 MATERIALS, SECURELY TO THE UPSLOPE SIDE OF CHAIN LINK FENCE WITH TIES SPACED EVERY 24 INCHES AT THE TOP AND MID SECTION. EMBED GEOTEXTILE AND CHAIN LINK FENCE A MINIMUM OF 8 INCHES INTO THE GROUND. WHERE ENDS OF THE GEOTEXTILE COME TOGETHER, THE ENDS SHALL BE OVERLAPPED BY 6 INCHES, FOLDED, AND STAPLED TO PREVENT SEDIMENT BY PASS.

EXTEND BOTH ENDS OF THE SUPER SILT FENCE A MINIMUM OF FIVE HORIZONTAL FEET UPSLOPE AT 45 DEGREES TO THE MAIN FENCE ALIGNMENT TO PREVENT RUNOFF FROM GOING AROUND THE ENDS OF THE SUPER SILT FENCE. PROVIDE MANUFACTURER CERTIFICATION TO THE INSPECTION/ENFORCEMENT AUTHORITY SHOWING THAT GEOTEXTILE USED MEETS THE REQUIREMENTS IN SECTION H-1 MATERIALS.

MARYLAND STANDARDS AND SPECIFICATIONS FOR SOIL EROSION AND SEDIMENT CONTROL 2011

PATE | REVISIONS

NAL'

STANDARD STABILIZATION NOTE FOLLOWING INITIAL SOIL DISTURBANCE OR RE-DISTURBANCE, PERMANENT OR TEMPORARY STABILIZATION MUST BE COMPLETED WITHIN: A. THREE (3) CALENDAR DAYS AS TO THE SURFACE OF ALL PERIMETER DIKES, SWALES, DITCHES, PERIMETER SLOPES, AND ALL SLOPES STEEPER THAN 3 HORIZONTAL TO 1 VERTICAL (3:1); AND B. SEVEN (7) CALENDAR DAYS AS TO ALL OTHER DISTURBED OR GRADED AREAS ON THE PROJECT SITE NOT UNDER ACTIVE GRADING.


DEVELOPER'S CERTIFICATE:

"IWE CERTIFY THAT ALL DEVELOPMENT AND CONSTRUCTION WILL BE DONE ACCORDING TO THIS PLAN OF DEVELOPMENT FOR SEDIMENT AND EROSION CONTROL. AND THAT ANY RESPONSIBLE PERSONNEL INVOLVED IN THE CONSTRUCTION PROJECT WILL HAVE A CERTIFICATE OF ATTENDANCE AT A DEPARTMENT OF THE ENVIRONMENT APPROVED TRAINING PROGRAM FOR THE CONTROL OF SEDIMENT AND EROSION BEFORE BEGINNING THE PROJECT. I ALSO AUTHORIZE PERIODIC ON-SITE INSPECTIONS BY THE HOWARD SOIL CONSERVATION DISTRICT."

ENGINEER'S CERTIFICATE:

"I HEREBY CERTIFY THAT THIS PLAN FOR EROSION AND SEDIMENT CONTROL REPRESENTS A PRACTICAL AND WORKABLE PLAN BASED ON MY PERSONAL KNOWLEDGE OF THE SITE CONDITIONS AND THAT IT WAS PREPARED IN ACCORDANCE WITH THE REQUIREMENTS OF THE HOWARD SOIL CONSERVATION DISTRICT AND THE 2011 MARYLAND STANDARDS & SPECIFICATIONS FOR SOIL EROSION AND SEDIMENT CONTROL.

RONALD/E. THOMPSON, P.E. SUPPLEMENTAL PLAN

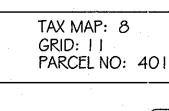

QUARTZ HILL III

ELECTION DISTRICT: No. 4 HOWARD COUNTY, MARYLAND EX. ZONING: RC-DEO

SEDIMENT AND EROSION CONTROL NOTES & DETAILS

LOTS 1-7, BUILDABLE PRESERVATION PARCEL A & QUARTZ HILL III FOREST MITIGATION BANK


SCALE: AS SHOWN DATE: NOVEMBER, 2013 SHEET 3 OF 4

Engineers Surveyors Planners 310 South Main Street P.O. box 328 Mount Airy, Maryland 21771 (301) 829 2890 (301)831 5015 (410) 549 2751

F-13-070

ASSOCIATES, INC.

JOB NO.AO-447

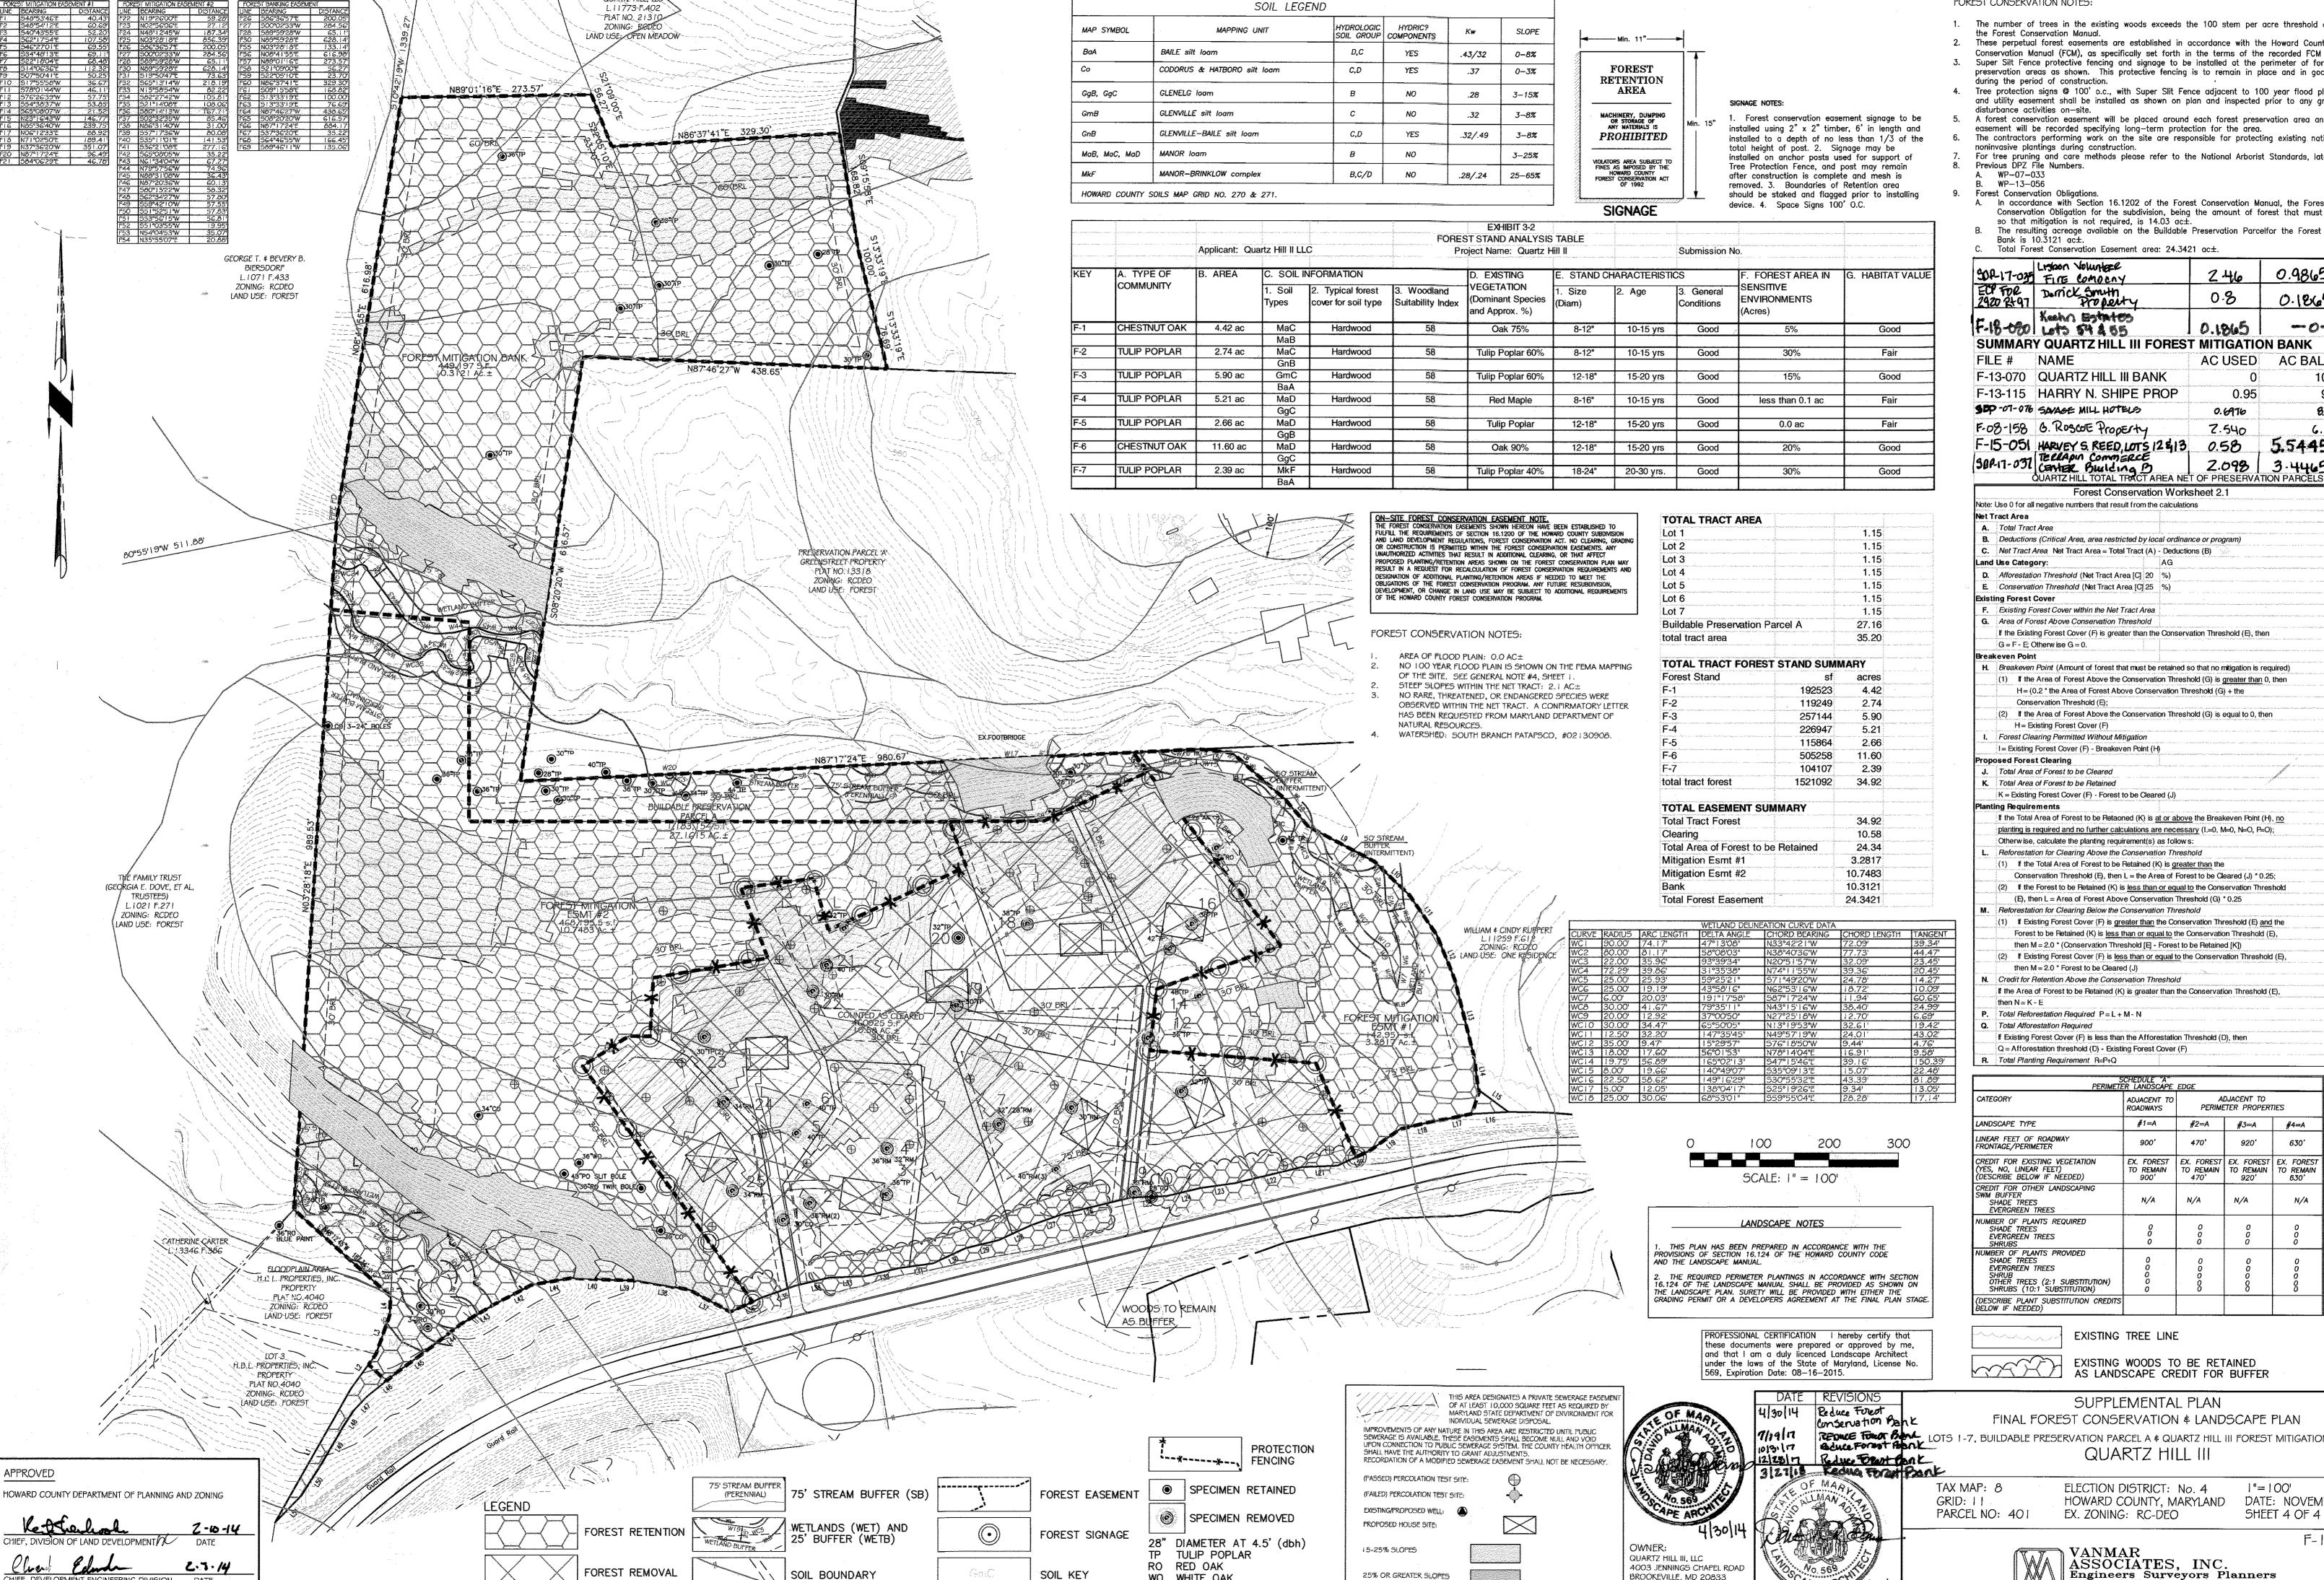

CHIEF, DEVELOPMENT ENGINEERING DIVISION DATE

WO WHITE OAK

RM RED MAPLE

FOREST CONSERVATION NOTES:

- The number of trees in the existing woods exceeds the 100 stem per acre threshold as defined in the Forest Conservation Manual. These perpetual forest easements are established in accordance with the Howard County Forest Conservation Manual (FCM), as specifically set forth in the terms of the recorded FCM easement. 3. Super Silt Fence protective fencing and signage to be installed at the perimeter of forest
- preservation areas as shown. This protective fencing is to remain in place and in good repair during the period of construction. 4. Tree protection signs @ 100' o.c., with Super Slit Fence adjacent to 100 year flood plain, drainage and utility easement shall be installed as shown on plan and inspected prior to any grading or
 - disturbance activities on-site. A forest conservation easement will be placed around each forest preservation area and a deed of
 - easement will be recorded specifying long—term protection for the area.
 - The contractors performing work on the site are responsible for protecting existing native & noninvasive plantings during construction.
 - For tree pruning and care methods please refer to the National Arborist Standards, latest edition. Previous DPZ File Numbers. A. WP-07-033
 - WP-13-056 Forest Conservation Obligations.
 - A. In accordance with Section 16.1202 of the Forest Conservation Manual, the Forest Conservation Obligation for the subdivision, being the amount of forest that must be retained so that mitigation is not required, is 14.03 ac±.
 - The resulting acreage available on the Buildable Preservation Parcelfor the Forest Mitigation Bank is 10.3121 ac±. Total Forest Conservation Easement area: 24.3421 ac±.

30P-17-035	Listoon Volunteer Fire Company	246	0.9865
ECP FOR 2920 Rt97	Derrick Smuth Property	0.8	0.1865
F-18-0%	Keaks Estates Lets 54 4 65	0.1865	 O
SUMMAR'	Y QUARTZ HILL III FOREST	MITIGATIO	N BANK
FILE #	NAME	AC USED	AC BALANCE
F-13-070	QUARTZ HILL III BANK	0	10.3121
F-13-115	HARRY N. SHIPE PROP	0.95	9.3621
95P-07-076	Smage Mill Hotels	0.6976	8.6645
F-08-158	6. ROSCOE Property	7.540 P	6.1245
F-15-051	HARVEY S. REED, LOTS 12413	0.58	5.5445

2.098 3.4465

continued

POOVE

Note:	Use 0 for all negative numbers that result from	1 the	calculations		
	ract Area			and the second of the second o	
A.	Total Tract Area		e femiliar transfer to the second transfer transfer to the second transfer transfer transfer to the second transfer trans	A=	3
В.	Deductions (Critical Area, area restricted by	y loc	cal ordinance or program)	В=	0
C.	Net Tract Area Net Tract Area = Total Tract	Me hours	delicent that the control of the transfer of the control of the co	C=	35
Land	Use Category:	. h.v	AG		1 11 1960
D.	Afforestation Threshold (Net Tract Area [C]	20	uden and the state of the second state of the second second and according according to the second and the second according to the second and the second according to the secon	D=	7
E	Conservation Threshold (Net Tract Area [C]	Same	(100) (100) (100) (100) (100) (100) (100) (100) (100) (100) (100) (100) (100) (100) (100) (100)	E	
**********	ing Forest Cover		tigation to the second of the	· · · · · · · · · · · · · · · · · · ·	
F.	Existing Forest Cover within the Net Tract A	rea	affirmental mercum extraorder at the control of the	F=	34
G.	Area of Forest Above Conservation Thresho		of season in the contract of the season to the contract to the contract of the		
	If the Existing Forest Cover (F) is greater than	n the	Conservation Threshold (日, then		ngerman har harb
	G = F - E Otherwise G = 0.		and the second s	G=	26
Breal	where the received and manifestation where the second manifestation and a second secon	S. Carrage	and the second section of the second		er i den
H.	Breakeven Point (Amount of forest that mus	t be	retained so that no mitigation is required)		- 14144 (1711-171)
w/2-1/-1/	t subjection of the destruction than the contract of the property of the contract of the contr		on Threshold (G) is greater than 0, then	*	
,,,,	H=(0.2 * the Area of Forest Above Co		om ye aya aya tayba ca a aban gayy Jamabyo yolaa bira ayya abayya abayba ahaya ahaa ahaa ahaa 		- 21 11 11
P. V. a. (Marca and present resource)	Conservation Threshold (E);	A	местенде иште переделия стоящей темпера при переделичения от стерения подавить подавить подавить передели подавить подави	H=	14
ghaghail i a ngadh ga tagan	(2) If the Area of Forest Above the Conse	rvati	on Threshold (G) is equal to 0, then	an and a supplier	segunt in
*****	H = Existing Forest Cover (F)		ade en rec'h en en en en en dered reader en		
1.	Forest Clearing Permitted Without Mitigation	7	te disentan tahun termini mengalah di namban seri seri, anam mengalah mengalah mengalah di mengalah pengalah p Pengalah tahun termini mengalah seri seri seri seri seri seri seri seri	ayet an a mara tenga temperatura ya a a a a a a	**** *** ***
. (***) (***) *******	I = Existing Forest Cover (F) - Breakeven Poir		n and a statute of a contract their state, and a state, and a state of a state of a contract of a state of a co A	1=	20
Prop	osed Forest Clearing	C*********	agrande and interest and the advantagements and the constraint of the constraint of the constraint and the constraint of		
J.	Total Area of Forest to be Cleared		Santana and the control of the santana of the control of the contr	J=	10
K.	Total Area of Forest to be Retained		anna anna ar sa a anna anna anna anna an		:
	K = Existing Forest Cover (F) - Forest to be C	lear	ed (J)	K=	24
Plant	ing Requirements	cultil/class	afrikant tirang mengan dang mengangkan pentangan pentangan pentangan pentangan pentangan pentangan pentangan bana sa sa pendangan		v
	If the Total Area of Forest to be Retaoned (K)	isa	at or above the Breakeven Point (H), no		
n open open och	planting is required and no further calculation	A	The control of the co		981 - 500
4 tam - 4444 -	Otherwise, calculate the planting requirement	**********	Control of the Contro	Andrei a casadonno (a cartosa de la	
L.	Reforestation for Clearing Above the Conse	a service and	g aff million of the complition of the complete grade million of the complete for the complete of the complete	anne a transmission de la Proposition de la company	
	(1) If the Total Area of Forest to be Retained	on the same	at a contract of the person than a contract of the contract of	L=	0
	Conservation Threshold (E), then L = the	11, 1,11,11,11,11	Complete the graduate and the following of the following		
i pi pament anaren et.	terformation with the arrange to the first of the contract of		or equal to the Conservation Threshold		% a 4mm *
***** =* *****	(E), then L = Area of Forest Above Cons		and comments also were to the State of the State of the contract contract of a state of the state of the contract of the contr	Contraction to the contract of	
М.	Reforestation for Clearing Below the Conser			The second section of the sect	*****
and the state of t	(1) If Existing Forest Cover (F) is greater th	*****	de des financias actività de la compania del la compania de la compania del la compania de la compania del la compania dela compania del la compania del la compania del la compania del la		
· */ **** * * •	Forest to be Retained (K) is less than or	equ	ial to the Conservation Threshold (E),	M=	0.
ment of the section o	then M = 2.0 * (Conservation Threshold	[E] -	Forest to be Retained (K))		
t arthurshine hage the	and figure the first as a section of the contract of the contr		equal to the Conservation Threshold (E),		
	then M = 2.0 * Forest to be Cleared (J)		erinaria de la composition della composition del		
N.	Credit for Retention Above the Conservation	Thi	reshold		***************************************
re alling all entracts	If the Area of Forest to be Retained (K) is gre	ate	than the Conservation Threshold (E),	and the same test process as a surface of	
torbratta oraș	then N=K-E		жылдардын жырында дамын жорон толоо олоо олоо олоо олоо олоо олоо о	N⊨	0
P.	Total Reforestation Required P=L+M-N		nakata inga, politolying i as is tudotamining, patatana politic i na italaminin in transcribin i construir i i	P=	0
Q.	Total Afforestation Required		ating a reference of the angles of a second control of the angles of the		
and the second of the second of	If Existing Forest Cover (F) is less than the A	ffor	estation Threshold (D), then	o na	
THE STATE OF THE S	Q = Afforestation threshold (D) - Existing For	April 1 A COLON	итиштена путте а тетиченият батышини тенетте и Такынбоги, тогот теленичения и колон и општучини интридистични и учини и учини.		0
	Appen and the second		agramma and a structure and a second		

CATEGORY	ADJACENT TO ROADWAYS		DJACENT TO TER PROPERT			
LANDSCAPE TYPE	#1=A	#2=A	#3=A	#4=A		
LINEAR FEET OF ROADWAY FRONTAGE/PERIMETER	900'	470*	920'	630*		
CREDIT FOR EXISTING VEGETATION (YES, NO, LINEAR FEET) (DESCRIBE BELOW IF NEEDED)	EX. FOREST TO REMAIN 900'	EX. FOREST TO REMAIN 470'	EX. FOREST TO REMAIN 920'	EX. FOREST TO REMAIN 630'		
CREDIT FOR OTHER LANDSCAPING SWM BUFFER SHADE TREES EVERGREEN TREES	N/A	N/A	N/A	N/A		
NUMBER OF PLANTS REQUIRED SHADE TREES EVERGREEN TREES SHRUBS	0 0 0	0 0 0	0 0	0 0		
NUMBER OF PLANTS PROVIDED SHADE TREES EVERGREEN TREES SHRUB OTHER TREES (2:1 SUBSTITUTION) SHRUBS (10:1 SUBSTITUTION)	0 0 0 0	00000	00000	0000		
(DESCRIBE PLANT SUBSTITUTION CREDITS BELOW IF NEEDED)						

SCHEDULE "A" PERIMETER LANDSCAPE EDGE

EXISTING TREE LINE

EXISTING WOODS TO BE RETAINED AS LANDSCAPE CREDIT FOR BUFFER

SUPPLEMENTAL PLAN FINAL FOREST CONSERVATION & LANDSCAPE PLAN LOTS 1-7, BUILDABLE PRESERVATION PARCEL A & QUARTZ HILL III FOREST MITIGATION BANK QUARTZ HILL III

BROOKEVILLE, MD 20833

410-489-4630

ELECTION DISTRICT: No. 4 | "= | 00'HOWARD COUNTY, MARYLAND DATE: NOVEMBER, 2013 EX. ZONING: RC-DEO

SHEET 4 OF 4 F-13-070

VANMAR ASSOCIATES, INC. Engineers Surveyors Planners 310 South Main Street P.O. box 328 Mount Airy, Maryland 21771 (301) 829 2890 (301)831 5015 (410) 549 2751