

B-4-8 STANDARDS AND SPECIFICATIONS FOR STOCKPILE AREA Definition A mound or pile of soil protected by appropriately designed erosion and sediment control measures. To provide a designated location for the temporary storage of soil that controls the potential for erosion, sedimentation, and changes to drainage patterns. Conditions Where Practice Applies Stockpile areas are utilized when it is necessary to salvage and store soil for later use

1. The stockpile location and all related sediment control practices must be clearly indicated on the

- 2. The footprint of the stockpile must be sized to accommodate the anticipated volume of material and based on a side slope ratio no steeper than 2:1. Benching must be provided in accordance
- with Section B-3 Land Grading. Runoff from the stockpile area must drain to a suitable sediment control practice.
- 4. Access the stockpile area from the upgrade side.
- 5. Clear water runoff into the stockpile area must be minimized by use of a diversion device such as an earth dike, temporary swale or diversion fence. Provisions must be made for discharging
- concentrated flow in a non-erosive manner 6. Where runoff concentrates along the toe of the stockpile fill, an appropriate erosion/sediment
- control practice must be used to intercept the discharge 7 Stockpiles must be stabilized in accordance with the 3/7 day stabilization requirement as well as
- Standard B-4-1 Incremental Stabilization and Standard B-4-4 Temporary Stabilization 8. If the stockpile is located on an impervious surface, a liner should be provided below the stockpile to facilitate cleanup. Stockpiles containing contaminated material must be covered with impermeable sheeting.

The stockpile area must continuously meet the requirements for Adequate Vegetative Establishment in accordance with Section B-4 Vegetative Stabilization. Side slopes must be maintained at no steeper than a 20 ratio. The stockpile area must be kept free of erosion. If the vertical height of a stockpile exceeds 20 feet for 2:1 slopes, 30 feet for 3:1 slopes, or 40 feet for 4:1 slopes, benching must be provided in accordance with Section B-3 Land Grading.

B.43

REVAL REVISE TOTAL SHTS TO 7 12/12/17

development plan is approved for soil erasion and sediment control by the

ENGINEER'S CERTIFICATE

Date 🌡

hereby certify that this plan for sediment and erosion control

accordance with the requirements of the Howard Soil Conservation

DEVELOPER'S CERTIFICATE

I/We certify that all development and construction will be done

according to this plan of development for sediment and erosion

control, and that all responsible personnel involeved in the

construction project will have a Certificate of Attendance at a

Department of Environment Approved Training Program for the

Control of Sediment and Erosion before beginning the project.

also authorize periodic on-site inspections by the Howard Soil

represents a practical and workable plan based on my personal

knowledge of the site conditions and that it was prepared in

Signature of Engineer (print name below signature)

Signature of Developer (print name below signature)

hief, Development Engineering Division PY

NPPROVED: DEPARTMENT OF Planning & Zoning

Chief, Division of Land Development Date

Conservation District."

District.

B-4-2 STANDARDS AND SPECIFICATIONS

SOIL PREPARATION, TOPSOILING, AND SOIL AMENDMENTS

The process of preparing the soils to sustain adequate vegetative stabilization.

To provide a suitable soil medium for vegetative growth.

Conditions Where Practice Applies

Where vegetative stabilization is to be established

Soil Preparation

- 1. Temporary Stabilization
- a. Seedbed preparation consists of loosening soil to a depth of 3 to 5 inches by means of suitable agricultural or construction equipment, such as disc harrows or chisel plows or rippers mounted on construction equipment. After the soil is loosened, it must not be rolled or dragged smooth but left in the roughened condition. Slopes 3:1 or flatter are to be tracked with ridges running parallel to the contour of the slope.
- b. Apply fertilizer and lime as prescribed on the plans.
- c. Incorporate lime and fertilizer into the top 3 to 5 inches of soil by disking or other suitable

2. Permanent Stabilization

- a. A soil test is required for any earth disturbance of 5 acres or more. The minimum soil
- conditions required for permanent vegetative establishment are: Soil of I between 6.0 and 7.0.

would be acceptable

- ii. Soluble salts less than 500 parts per million (ppm). iii. Soil contains less than 40 percent clay but enough fine grained material (greater than 30 percent silt plus clay) to provide the capacity to hold a moderate amount of moisture. An exception: if lovegrass will be planted, then a sandy soil (less than 30 percent silt plus clay)
- iv. Soil contains 1.5 percent minimum organic matter by weight,
- v. Soil contains sufficient pore space to permit adequate root penetration. b. Application of amendments or topsoil is required if on-site soils do not meet the above
- c. Graded areas must be maintained in a true and even grade as specified on the approved plan, then scarified or otherwise loosened to a depth of 3 to 5 inches.
- d. Apply soil amendments as specified on the approved plan or as indicated by the results of a soil
- e. Mix soil amendments into the top 3 to 5 inches of soil by disking or other suitable means, Rake lawn areas to smooth the surface, remove large objects like stones and branches, and ready the area for seed application. Loosen surface soil by dragging with a heavy chain or other equipment to roughen the surface where site conditions will not permit normal seedbed preparation. Track slopes 3:1 or flatter with tracked equipment leaving the soil in an irregular condition with ridges running parallel to the contour of the slope. Leave the top 1 to 3 inches of soil loose and friable. Seedbed loosening may be unnecessary on newly disturbed areas.

- 1. Topsoil is placed over prepared subsoil prior to establishment of permanent vegetation. The purpose is to provide a suitable soil medium for vegetative growth. Soils of concern have low moisture content, low nutrient levels, low pH, materials toxic to plants, and/or unacceptable soil gradation. 2. Topsoil salvaged from an existing site may be used provided it meets the standards as set forth in these specifications. Typically, the depth of topsoil to be salvaged for a given soil type can be found
- in the representative soil profile section in the Soil Survey published by USDA-NRCS. 3. Topsoiling is limited to areas having 2:1 or flatter slopes where:
- a. The texture of the exposed subsoil/parent material is not adequate to produce vegetative growth.
- b. The soil material is so shallow that the rooting zone is not deep enough to support plants or furnish continuing supplies of moisture and plant nutrients.
- c. The original soil to be vegetated contains material toxic to plant growth d. The soil is so acidic that treatment with limestone is not feasible.
- 4. Areas having slopes steeper than 2:1 require special consideration and design.
- 5. Topsoil Specifications: Soil to be used as topsoil must meet the following criteria:
- a. Topsoil must be a loam, sandy loam, clay loam, silt loam, sandy clay loam, or loamy sand Other soils may be used if recommended by an agronomist or soil scientist and approved by the appropriate approval authority. Topsoil must not be a mixture of contrasting textured subsoils and must contain less than 5 percent by volume of cinders, stones, slag, coarse fragments gravel, sticks, roots, trash, or other materials larger than 11/2 inches in diameter
- b. Topsoil must be free of noxious plants or plant parts such as Bermuda grass, quack grass, Johnson grass, nut sedge, poison ivy, thistle, or others as specified.
- c. Topsoil substitutes or amendments, as recommended by a qualified agronomist or soil scientist
- 6. Topsoil Application a. Erosion and sediment control practices must be maintained when applying topsoil.
- b. Uniformly distribute topsoil in a 5 to 8 inch layer and lightly compact to a minimum thickness of 4 inches. Spreading is to be performed in such a manner that sodding or seeding can proceed with a minimum of additional soil preparation and tillage. Any irregularities in the surface resulting from topsoiling or other operations must be corrected in order to prevent the formation of depressions or water pockets.
- c. Topsoil must not be placed if the topsoil or subsoil is in a frozen or muddy condition, when the subsoil is excessively wet or in a condition that may otherwise be detrimental to proper grading

and seedbed preparation. C. Soil Amendments (Fertilizer and Lime Specifications)

- 1. Soil tests must be performed to determine the exact ratios and application rates for both lime and fertilizer on sites having disturbed areas of 5 acres or more. Soil analysis may be performed by a ecognized private or commercial laboratory. Soil samples taken for engineering purposes may also be used for chemical analyses.
- 2. Fertilizers must be uniform in composition, free flowing and suitable for accurate application by appropriate equipment. Manure may be substituted for fertilizer with prior approval from the appropriate approval authority. Fertilizers must all be delivered to the site fully labeled according to he applicable laws and must bear the name, trade name or trademark and warranty of the producer. 3. Lime materials must be ground limestone (hydrated or burnt lime may be substituted except when hydroseeding) which contains at least 50 percent total oxides (calcium oxide plus magnesium oxide). Limestone must be ground to such finences that at least 50 percent will pass through a #100
- mesh sieve and 98 to 100 percent will pass through a #20 mesh sieve. 4. Lime and fertilizer are to be evenly distributed and incorporated into the top 3 to 5 inches of soil by disking or other suitable means.
- Where the subsoil is either highly acidic or composed of heavy clays, spread ground limestone at the rate of 4 to 8 tons/acre (200-400 pounds per 1,000 square feet) prior to the placement of topsoil.

B-4 STANDARDS AND SPECIFICATIONS

FOR **VEGETATIVE STABILIZATION**

Using vegetation as cover to protect exposed soil from erosion.

o promote the establishment of vegetation on exposed soil.

Conditions Where Practice Applies On all disturbed areas not stabilized by other methods. This specification is divided into sections on incremental stabilization; soil preparation, soil amendments and topsoiling; seeding and mulching; temporary stabilization;

Effects on Water Quality and Quantity

Stabilization practices are used to promote the establishment of vegetation on exposed soil. When soil is stabilized with vegetation, the soil is less likely to erode and more likely to allow infiltration of rainfall, thereby reducing sediment loads and runoff to downstream areas.

Planting vegetation in disturbed areas will have an effect on the water budget, especially on volumes and rates of runoff, infiltration, evaporation, transpiration, percolation, and groundwater recharge. Over time, vegetation will increase organic matter content and improve the water holding capacity of the soil and subsequent plant growth.

Vegetation will help reduce the movement of sediment, nutrients, and other chemicals carried by runoff to receiving waters. Plants will also help protect groundwater supplies by assimilating those substances present

Sediment control practices must remain in place during grading, seedbed preparation, seeding, mulching, and vegetative establishment

Inspect seeded areas for vegetative establishment and make necessary repairs, replacements, and reseedings within the

Adequate Vegetative Establishment

planting season.

- 1. Adequate vegetative stabilization requires 95 percent groundcover.
- 2. If an area has less than 40 percent groundcover, restabilize following the original recommendations for lime, fertilizer, seedbed preparation, and seeding.
- 3. If an area has between 40 and 94 percent groundcover, over-seed and fertilize using half of the rates
- 4. Maintenance fertilizer rates for permanent seeding are shown in Table B.6.

B-4-3 STANDARDS AND SPECIFICATIONS

SEEDING AND MULCHING

Purpose

Definition he application of seed and mulch to establish vegetative cover,

o protect disturbed soils from erosion during and at the end of construction.

Conditions Where Practice Applies

o the surface of all perimeter controls, slopes, and any disturbed area not under active grading. Criteria

- 1. Specification:
- a. All seed must meet the requirements of the Maryland State Seed Law. All seed must be subject to re-testing by a recognized seed laboratory. All seed used must have been tested within the 6 months immediately preceding the date of sowing such material on any project. Refer to Table B.4 regarding the quality of seed. Seed tags must be available upon request to the inspector to verify type of seed and seeding rate
- b. Mulch alone may be applied between the fall and spring seeding dates only if the ground is frozen. The appropriate seeding mixture must be applied when the ground thaws
- c. Inoculants: The inoculant for treating legume seed in the seed mixtures must be a pure culture of nitrogen fixing bacteria prepared specifically for the species. Inoculants must not be used later than the date indicated on the container. Add fresh inoculants as directed on the package Use four times the recommended rate when hydrosceding. Note: It is very important to keep inoculant as cool as possible until used. Temperatures above 75 to 80 degrees Pahrenheit can weaken bacteria and make the inoculant less effective
- d. Sod or seed must not be placed on soil which has been treated with soil sterilants or chemicals used for weed control until sufficient time has elapsed (14 days min.) to permit dissipation of phyto-toxic materials.

2. Application

- a. Dry Seeding: This includes use of conventional drop or broadcast spreaders i. Incorporate seed into the subsoil at the rates prescribed on Temporary Seeding Table B.1,
- Permanent Seeding Table B.3, or site-specific seeding summaries. ii. Apply seed in two directions, perpendicular to each other. Apply half the seeding rate in each direction. Roll the seeded area with a weighted roller to provide good seed to soil
- b. Drill or Cultipacker Seeding: Mechanized seeders that apply and cover seed with soil. i. Cultipacking seeders are required to bury the seed in such a fashion as to provide at least 1/4 inch of soil covering. Seedbed must be firm after planting. ii. Apply seed in two directions, perpendicular to each other. Apply half the seeding rate in
- c. Hydroseeding: Apply seed uniformly with hydroseeder (slurry includes seed and fertilizer). i. If fertilizer is being applied at the time of seeding, the application rates should not exceed the following: nitrogen, 100 pounds per acre total of soluble nitrogen; P2O3 (phosphorous),
- 200 pounds per acre; K2O (potassium), 200 pounds per acre. ii. Lime: Use only ground agricultural limestone (up to 3 tons per acre may be applied by hydroseeding). Normally, not more than 2 tons are applied by hydroseeding at any one time. Do not use burnt or hydrated lime when hydroseeding
- iii. Mix seed and fertilizer on site and seed immediately and without interruption. iv. When hydroseeding do not incorporate seed into the soil.

. Mulch Materials (in order of preference)

- a. Straw consisting of thoroughly threshed wheat, rve, oat, or barley and reasonably bright in color. Straw is to be free of noxious weed seeds as specified in the Maryland Seed Law and not musty, moldy, caked, decayed, or excessively dusty. Note: Use only sterile straw mulch in areas where one species of grass is desired.
- b. Wood Cellulose Fiber Mulch (WCFM) consisting of specially prepared wood cellulose processed into a uniform fibrous physical state.
- i. WCPM is to be dyed green or contain a green dye in the package that will provide an appropriate color to facilitate visual inspection of the uniformly spread slurry.
- ii. WCFM, including dye, must contain no germination or growth inhibiting factors. ili. WCFM materials are to be manufactured and processed in such a manner that the wood cellulose fiber mulch will remain in uniform suspension in water under agitation and will blend with seed, fertilizer and other additives to form a homogeneous slurry. The mulch
- material must form a blotter-like ground cover, on application, baving moisture absorption and percolation properties and must cover and hold grass seed in contact with the soil without inhibiting the growth of the grass seedlings. _iv. WCFM material must not contain elements or compounds at concentration levels that will
- v. WCFM must conform to the following physical requirements: fiber length of approximately 10 millimeters, diameter approximately 1 millimeter, pH range of 4.0 to 8.5, ash content of 1.6 percent maximum and water holding capacity of 90 percent minimum.

Application

- a. Apply mulch to all seeded areas immediately after seeding.
- b. When straw mulch is used, spread it over all seeded areas at the rate of 2 tons per acre to a uniform loose depth of I to 2 inches. Apply mulch to achieve a uniform distribution and depth so that the soil surface is not exposed. When using a mulch anchoring tool, increase the application rate to 2.5 tons per acre.
- c. Wood cellulose fiber used as mulch must be applied at a net dry weight of 1500 pounds per acre. Mix the wood cellulose fiber with water to attain a mixture with a maximum of 50 pounds of wood cellulose fiber per 100 gallons of water.

a. Perform mulch anchoring immediately following application of mulch to minimize loss by wind or water. This may be done by one of the following methods (listed by preference), depending upon the size of the area and erosion bazard

i. A mulch anchoring tool is a tractor drawn implement designed to punch and anchor mulch

- into the soil surface a minimum of 2 inches. This practice is most effective on large areas, but is limited to flatter slopes where equipment can operate safely. If used on sloping land, this practice should follow the contour.
- ii. Wood cellulose fiber may be used for anchoring straw. Apply the fiber binder at a net dry weight of 750 pounds per acre. Mix the wood cellulose fiber with water at a maximum of 50 pounds of wood cellulose fiber per 100 gallons of water. iii. Synthetic binders such as Acrylic DLR (Agro-Tack), DCA-70, Petroset, Terra Tax II, Terra
- Tack AR or other approved equal may be used. Follow application rates as specified by the manufacturer. Application of liquid binders needs to be heavier at the edges where wind catches mulch, such as in valleys and on crests of banks. Use of asphalt binders is strictly

iv. Lightweight plastic netting may be stapled over the mulch according to manufacturer recommendations. Netting is usually available in rolls 4 to 15 feet wide and 300 to 3,000

B-4-4 STANDARDS AND SPECIFICATIONS

<u>FOR</u>

TEMPORARY STABILIZATION

To stabilize disturbed soils with vegetation for up to 6 months.

To use fast growing vegetation that provides cover on disturbed soils.

Exposed soils where ground cover is needed for a period of 6 months or less. For longer duration of time permanent stabilization practices are required.

1. Select one or more of the species or seed mixtures listed in Table B.1 for the appropriate Plant Hardiness Zone (from Figure B.3), and enter them in the Temporary Seeding Summary below along with application rates, seeding dates and seeding depths. If this Summary is not put on the plan and

Conditions Where Practice Applies

- completed, then Table B. I plus fertilizer and lime rates must be put on the plan. 2. For sites having soil tests performed, use and show the recommended rates by the testing agency,
- Soil tests are not required for Temporary Seeding. 3. When stabilization is required outside of a seeding season, apply seed and mulch or straw mulch alone as prescribed in Section B-4-3.A.I.b and maintain until the next seeding season.

B-4-5 STANDARDS AND SPECIFICATIONS

FOR

PERMANENT STABILIZATION

Definition

To stabilize disturbed soils with permanent vegetation.

To use long-lived perennial grasses and legumes to establish permanent ground cover on disturbed soils.

Conditions Where Practice Applies

Exposed soils where ground cover is needed for 6 months or more.

A. Seed Mixtures

- 1. General Use
- a. Select one or more of the species or mixtures listed in Table B.3 for the appropriate Plant Hardiness Zone (from Figure B.3) and based on the site condition or purpose found on Table B.2. Enter selected mixture(s), application rates, and seeding dates in the Permanent Seeding Summary. The Summary is to be placed on the plan.
- b. Additional planting specifications for exceptional sites such as shorelines, stream banks, or dunes or for special purposes such as wildlife or aesthetic treatment may be found in USDA-NRCS Technical Field Office Guide, Section 342 - Critical Area Planting.
- c. For sites having disturbed area over 5 acres, use and show the rates recommended by the soil d. For areas receiving low maintenance, apply urea form fertilizer (46-0-0) at 3 ½ pounds per 1000 square feet (150 pounds per acre) at the time of seeding in addition to the soil amendments
- shown in the Permanent Seeding Summary.
- a. Areas where turfgrass may be desired include lawns, parks, playgrounds, and commercial sites which will receive a medium to high level of maintenance
- b. Select one or more of the species or mixtures listed below based on the site conditions or purpose. Enter selected mixture(s), application rates, and seeding dates in the Permanent Seeding Summary. The summary is to be placed on the plan. i. Kentucky Bluegrass: Full Sun Mixture: For use in areas that receive intensive
- management. Irrigation required in the areas of central Maryland and Eastern Shore. Recommended Certified Kentucky Bluegrass Cultivars Seeding Rate: 1.5 to 2.0 pounds per 1000 square feet. Choose a minimum of three Kentucky bluegrass cultivars with each ranging from 10 to 35 percent of the total mixture by weight. ii. Kentucky Bluegrass/Perennial Rye: Full Sun Mixture: For use in full sun areas where rapid establishment is necessary and when turf will receive medium to intensive
- management. Certified Perennial Ryegrass Cultivars/Certified Kentucky Bluegrass Seeding Rate: 2 pounds mixture per 1000 square feet. Choose a minimum of three Kentucky bluegrass cultivars with each ranging from 10 to 35 percent of the total mixture by weight. iii. Tall Fescue/Kentucky Bluegrass: Full Sun Mixture: For use in drought prone areas and/or for areas receiving low to medium management in full sun to medium shade. Recommended mixture includes; Certified Tall Fescue Cultivars 95 to 100 percent, Certified Kentucky Bluegrass Cultivars 0 to 5 percent. Seeding Rate: 5 to 8 pounds per
- 1000 square feet. One or more cultivars may be blended. iv. Kentucky Bluegrass/Fine Fescue: Shade Mixture: For use in areas with shade in Bluegrass lawns. For establishment in high quality, intensively managed turf area. Mixture includes; Certified Kentucky Bluegrass Cultivars 30 to 40 percent and Certified Pine Fescue and 60 to 70 percent. Seeding Rate: 11/2 to 3 pounds per 1000 square feet.
- Select turfgrass varieties from those listed in the most current University of Maryland Publication, Agronomy Memo #77, "Turfgrass Cultivar Recommendations for Maryland"
- Choose certified material. Certified material is the best guarantee of cultivar purity. The certification program of the Maryland Department of Agriculture, Turf and Seed Section, provides a reliable means of consumer protection and assures a pure genetic line
- Western MD: March 15 to June 1, August 1 to October 1 (Hardiness Zones: 5b, 6a) Central MD: March 1 to May 15, August 15 to October 15 (Hardiness Zone: 6b)
- Southern MD, Eastern Shore: March 1 to May 15, August 15 to October 15 (Hardiness Zones: 7a, 7b) d. Till areas to receive seed by disking or other approved methods to a depth of 2 to 4 inches, level and rake the areas to prepare a proper seedbed. Remove stones and debris over 11/2 inches in diameter. The resulting seedbed must be in such condition that future mowing of grasses will
- pose no difficulty, e. If soil moisture is deficient, supply new seedings with adequate water for plant growth (1/2 to 1 inch every 3 to 4 days depending on soil texture) until they are firmly established. This is especially true when seedings are made late in the planting season, in abnormally dry or hot

seasons, or on adverse sites, Sod: To provide quick cover on disturbed areas (2:1 grade or flatter).

c. Ideal Times of Seeding for Turf Grass Mixtures

a. Class of turfgrass sod must be Maryland State Certified. Sod labels must be made available to the job foreman and inspector.

b. Sod must be machine cut at a uniform soil thickness of % inch, plus or minus % inch, at the time

- of cutting. Measurement for thickness must exclude top growth and thatch. Broken pads and torn or uneven ends will not be acceptable c. Standard size sections of sod must be strong enough to support their own weight and retain their size and shape when suspended vertically with a firm grasp on the upper 10 percent of the
- d. Sod must not be harvested or transplanted when moisture content (excessively dry or wet) may adversely affect its survival.

transplanted within this period must be approved by an agronomist or soil scientist prior to its

Ensure that sod is not stretched or overlapped and that all joints are butted tight in order to

e. Sod must be harvested, delivered, and installed within a period of 36 hours. Sod not

- a. During periods of excessively high temperature or in areas having dry subsoil, lightly irrigate the subsoil immediately prior to laying the sod. b. Lay the first row of sod in a straight line with subsequent rows placed parallel to it and tightly wedged against each other. Stagger lateral joints to promote more uniform growth and strength,
- prevent voids which would cause air drying of the roots. c. Wherever possible, lay sod with the long edges parallel to the contour and with staggering joints. Roll and tamp, peg or otherwise secure the sod to prevent slippage on slopes. Ensure solid contact exists between sod roots and the underlying soil surface.

d. Water the sod immediately following rolling and tamping until the underside of the new sod pad-

and soil surface below the sod are thoroughly wet. Complete the operations of laying, tamping and irrigating for any piece of sod within eight hours.

otherwise specified

- a. In the absence of adequate rainfall, water daily during the first week or as often and sufficiently as necessary to maintain moist soil to a depth of 4 inches. Water sod during the heat of the day to prevent wilting.
- b. After the first week, sod watering is required as necessary to maintain adequate moisture e. Do not mow until the sod is firmly rooted. No more than 1/3 of the grass leaf must be removed by the initial cutting or subsequent cuttings. Maintain a grass height of at least 3 inches unless


BEST MANAGEMENT PRACTICES FOR WORKING IN NONTIDAL WETLANDS, WETLAND BUFFERS. WATERWAYS, AND 100-YEAR FLOODPLAINS

- No excess fill, construction material, or debris shall be stockpiled or stored in nomidal wetlands, nontidal wetland buffers, waterways, or the 100-year floodolain
- Place materials in a location and manner which does not adversely impact surface or subsurface water flow into or out of nontidal wetlands, nontidal wetland buffers, waterways, or the 100-year floodplain.
- Do not use the excavated material as backfill if it contains waste metal products, unsightly debris, toxic material, or any other deleterious substance. If additional backfill is required use clean material free of waste metal products, unsightly debris, toxic material, or any
- other deleterious substance. Place heavy equipment on mats or suitably operate the equipment to prevent damage to
- nontidal wetlands, nontidal wetland buffers, waterways, or the 100-year floodplain. Repair and maintain any serviceable structure or fill so there is no permanent loss of nontidal wetlands, nontidal wetland buffers, or waterways, or permanent modification of the 100-year floodplain in excess of that lost under the originally authorized structure or
- Rectify any nontidal wetlands, wetland buffers, waterways, or 100-year floodplain temporarily impacted by any construction. All stabilization in the nontidal wetland and nontidal wetland buffer shall consist of the following species: Annual Ryegrass (Lolium multiflorum), Millet (Setaria italica), Barley
- (Hordeum sp.), Oats (Uniola sp.), and/or Rye (Secale cereale). These species will allow for the stabilization of the site while also allowing for the voluntary revegetation of natural wetland species. Other non-persistent vegetation may be acceptable, but must be approved by the Nontidal Wetlands and Waterways Division. Kentucky 31 fescue shall not be utilized in wetland or buffer areas. The area should be seeded and mulched to reduce
- After installation has been completed, make post-construction grades and elevations the same as the original grades and elevations in temporarily impacted areas. To protect aquatic species, in-stream work is prohibited as determined by the classification

erosion after construction activities have been completed.

DETAIL B-4-6-C

- of the stream as follows: Use I Waters (public water supply). In-stream work may not be conducted during the period March I through June 15, inclusive, during any year. Use III Waters (natural trout waters). In-stream work may not be conducted
- during the period October 1 through April 30, inclusive, during any year. Use IV Waters (recreational trout waters). In-stream work may not be conducted during the period March I through May 31, inclusive, during any
- 10) Stormwater runoff from impervious surfaces shall be controlled to prevent the washing of debris into the waterway Culverts shall be constructed and any riprap placed so as not to obstruct the movement of aquatic species, unless the purpose of the activity is to impound water.

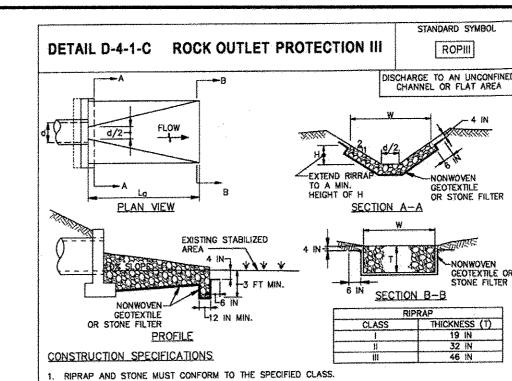


- 2. USE NONWOVEN GEOTEXTILE, AS SPECIFIED IN SECTION H-1 MATERIALS, AND PROTECT FROM PUNCTURING, CUTTING, OR TEARING. REPAIR ANY DAMAGE OTHER THAN AN OCCASIONAL SMALL HOLE BY PLACING ANOTHER PIECE OF GEOTEXTILE OVER THE DAMAGED PART OR BY COMPLETELY REPLACING THE GEOTEXTILE. PROVIDE A MINIMUM OF ONE FOOT OVERLAP FOR ALL REPAIRS AND FOR JOINING TWO.
- PREPARE THE SUBGRADE FOR GEOTEXTILE OR STONE FILTER (% TO 1% INCH MINIMUM STONE FOR REQUIRED IN THE SUBGRADE TO A DENSITY OF APPROXIMATELY THAT OF THE SURROUNDING UNDISTURBED MATERIAL.
- 1. EXTEND GEOTEXTILE AT LEAST 6 INCHES BEYOND EDGES OF RIPRAP AND EMBED AT LEAST 4 INCHES AT SIDES OF RIPRAP. CONSTRUCT RIPRAP OUTLET TO FULL COURSE THICKNESS IN ONE OPERATION AND IN SUCH A MANNER AS TO AVOID DISPLACEMENT OF UNDERLYING MATERIALS. PLACE STONE FOR RIPRAP OUTLET IN A MANNER THAT WILL ENSURE THAT IT IS REASONABLY HOMOGENOUS WITH THE SMALLER STONES AND SPALLS FILLING THE VOIDS BETWEEN THE LARGER STONES, PLACE RIPRAP IN A MANNER TO PREVENT DAMAGE TO THE FILTER BLANKET OR GEOTEXTILE, HAND PLACE TO THE EXTENT NECESSARY.
- WHERE NO ENDWALL IS USED, CONSTRUCT THE UPSTREAM END OF THE APRON SO THAT THE WIDTH IS TWO TIMES THE DIAMETER OF THE OUTLET PIPE, AND EXTEND THE STONE UNDER THE OUTLET BY A MINIMUM OF 18 INCHES.
- CONSTRUCT APRON WITH 0% SLOPE ALONG ITS LENGTH AND WITHOUT OBSTRUCTIONS. PLACE STONE SC THAT IT BLENDS IN WITH EXISTING GROUND. MAINTAIN LINE, GRADE, AND CROSS SECTION. KEEP OUTLET FREE OF EROSION. REMOVE ACCUMULATED SEDIMENT AND DEBRIS. AFTER HIGH FLOWS INSPECT FOR SCOUR AND RIPRAP DISLODGED RIPRAP. MAKE

MARYLAND STANDARDS AND SPECIFICATIONS FOR SOIL EROSION AND SEDIMENT CONTROL U.S. DEPARTMENT OF AGRICULTURE
NATURAL RESOURCES CONSERVATION SERVICE

D.22

STANDARD SYMBOL

-----ssr------

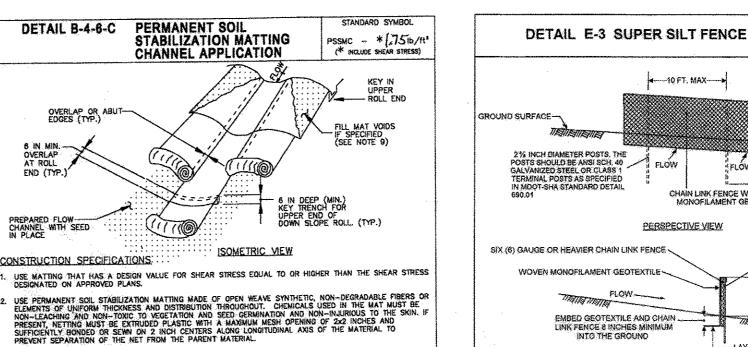

MB

TO 3 IN STONE

- PERFORM FINAL GRADING, TOPSOIL APPLICATION, SEEDBED PREPARATION, AND PERMANENT SEEDING IN ACCORDANCE WITH SPECIFICATIONS, PLACE MATTING WITHIN 48 HOURS OF COMPLETING SEEDING OPERATIONS, UNLESS END OF WORKDAY STABILIZATION IS SPECIFIED ON THE APPROVED EROSION AND SEDIMENT CONTROL PLAN.
- UNROLL MATTING IN DIRECTION OF WATER FLOW, CENTERING THE FIRST ROLL ON THE CHANNEL CENTER LINE. WORK FROM CENTER OF CHANNEL OUTWARD WHEN PLACING ROLLS. LAY MATTING SMOOTHLY AND FIRMLY UPON THE SEEDED SURFACE. AVOID STRETCHING THE MATTING.

SECURE MATTERS USING STEEL STAPLES OR WOOD STAKES. STAPLES MUST BE "U" OR "T" SHAPED STEEL

L STAPLE/STAKE MAT IN A STAGGERED PATTERN ON 4 FOOT (MAXIMUM) CENTERS THROUGHOUT AND 2 FOOT (MAXIMUM) CENTERS ALONG SEAMS, JOINTS, AND ROLL ENDS. IF SPECIFIED BY THE DESIGNER OR MANUFACTURER AND DEPENDING ON THE TYPE OF MAT BEING INSTALLED ONCE THE MATTING IS KEYED AND STAPLED IN PLACE, FILL THE MAT YOURS WITH TOP SOIL OR GRANULAR MATERIAL AND LIGHTLY COMPACT OR ROLL TO MAXIMIZE SOIL/MAT CONTACT WITHOUT CRUSHING MAT.

ISOMETRIC VIEW

5 FT (A DIKE) / 35 FT (B DIKE)

5 FT

6 IN MIN.

SECTION A-A

PLACE NONWOVEN GEOTEXTILE, AS SPECIFIED IN SECTION H-1 MATERIALS, OVER THE EARTH MOUND PRIOR TO PLACING STONE.

MAINTAIN LINE, GRADE, AND CROSS SECTION. ADD STONE OR MAKE OTHER REPAIRS AS CONDITIONS DEMAND TO MAINTAIN SPECIFIED DIMENSIONS. REMOVE ACCUMULATED SEDIMENT AND DEBRIS. MAINTAIN POSITIVE DRAINAGE.

MARYLAND STANDARDS AND SPECIFICATIONS FOR SOIL EROSION AND SEDIMENT CONTROL

. USE MINIMUM WIDTH OF 10 FEET TO ALLOW FOR VEHICULAR PASSAGE.


CONSTRUCTION SPECIFICATIONS


COMPACTED EAR'


18 IN MIN/A DIKE

DETAIL C-8 MOUNTABLE BERM

KEY IN THE TOP OF SLOPE END OF MAT 6 INCHES (MINIMUM) BY DIGGING A TRENCH, PLACING THE MATTING ROLL END IN THE TRENCH, STAPLING THE MAT IN PLACE, REPLACING THE EXCAVATED MATERIAL, AND TAMPING TO SECURE THE MAT END IN THE KEY.

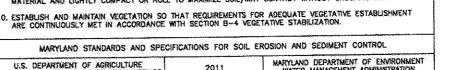

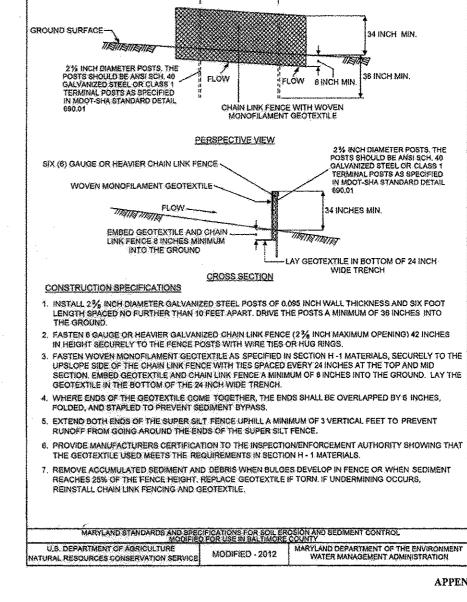

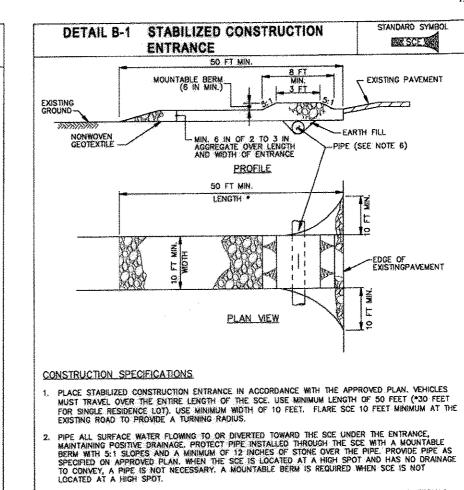

PREPARE SUBGRADE AND PLACE NONWOVEN GEOTEXTILE, AS SPECIFIED IN SECTION H-1 MATERIALS.

PLACE CRUSHED AGGREGATE (2 TO 3 INCHES IN SIZE) OR EQUIVALENT RECYCLED CONCRETE (WITHOUT

MAINTAIN ENTRANCE IN A CONDITION THAT MINIMIZES TRACKING OF SEDIMENT. ADD STONE OR MAKE OTHER REPAIRS AS CONDITIONS DEMAND TO MAINTAIN CLEAN SURFACE, MOUNTABLE BERM, AND SPECIFIED DIMENSIONS. IMMEDIATELY REMOVE STONE AND/OR SEDIMENT SPILLED, DROPPED, OR TRACKED ONTO ADJACENT ROADWAY BY VACUUMING, SCRAPING, AND/OR SWEEPING, WASHING ROADWAY TO REMOVE MUD TRACKED ONTO PAYEMENT IS NOT ACCEPTABLE UNLESS WASH WATER IS DIRECTED TO AN APPROVED SEDIMENT CONTROL PRACTICE.

MARYLAND STANDARDS AND SPECIFICATIONS FOR SOIL EROSION AND SEDIMENT CONTROL

CONTACT OWNER Jeffrey L. Schwab Michael Balakirsky 1 1755 Bragdon Wood 401 Washington Ave. Suite 303 Clarksville, MD 21029 Towson, MD 21029 Phone: 410-340-7823 Phone: 410-321-7600

401 Washington Ave. Suite 303

Sediment & Erosion Control Details Howard County. Maryland

rofessional Certification. I hereby certify that these documents were prepared or

approved by me, and that I am a duly licensed professional engineer under the laws f the State of Maryland, License No. 14230, Expiration Date: 12/09/14. 14885/154 TAX/ZONE HAP ELECT.DISTRICT RC-DEO 29 Date: 9/12/2014





Scale: N/A


²roj. #: 13012

14-119

DESIGN: JLS | DRAWN: MAS | CHKED: JLS

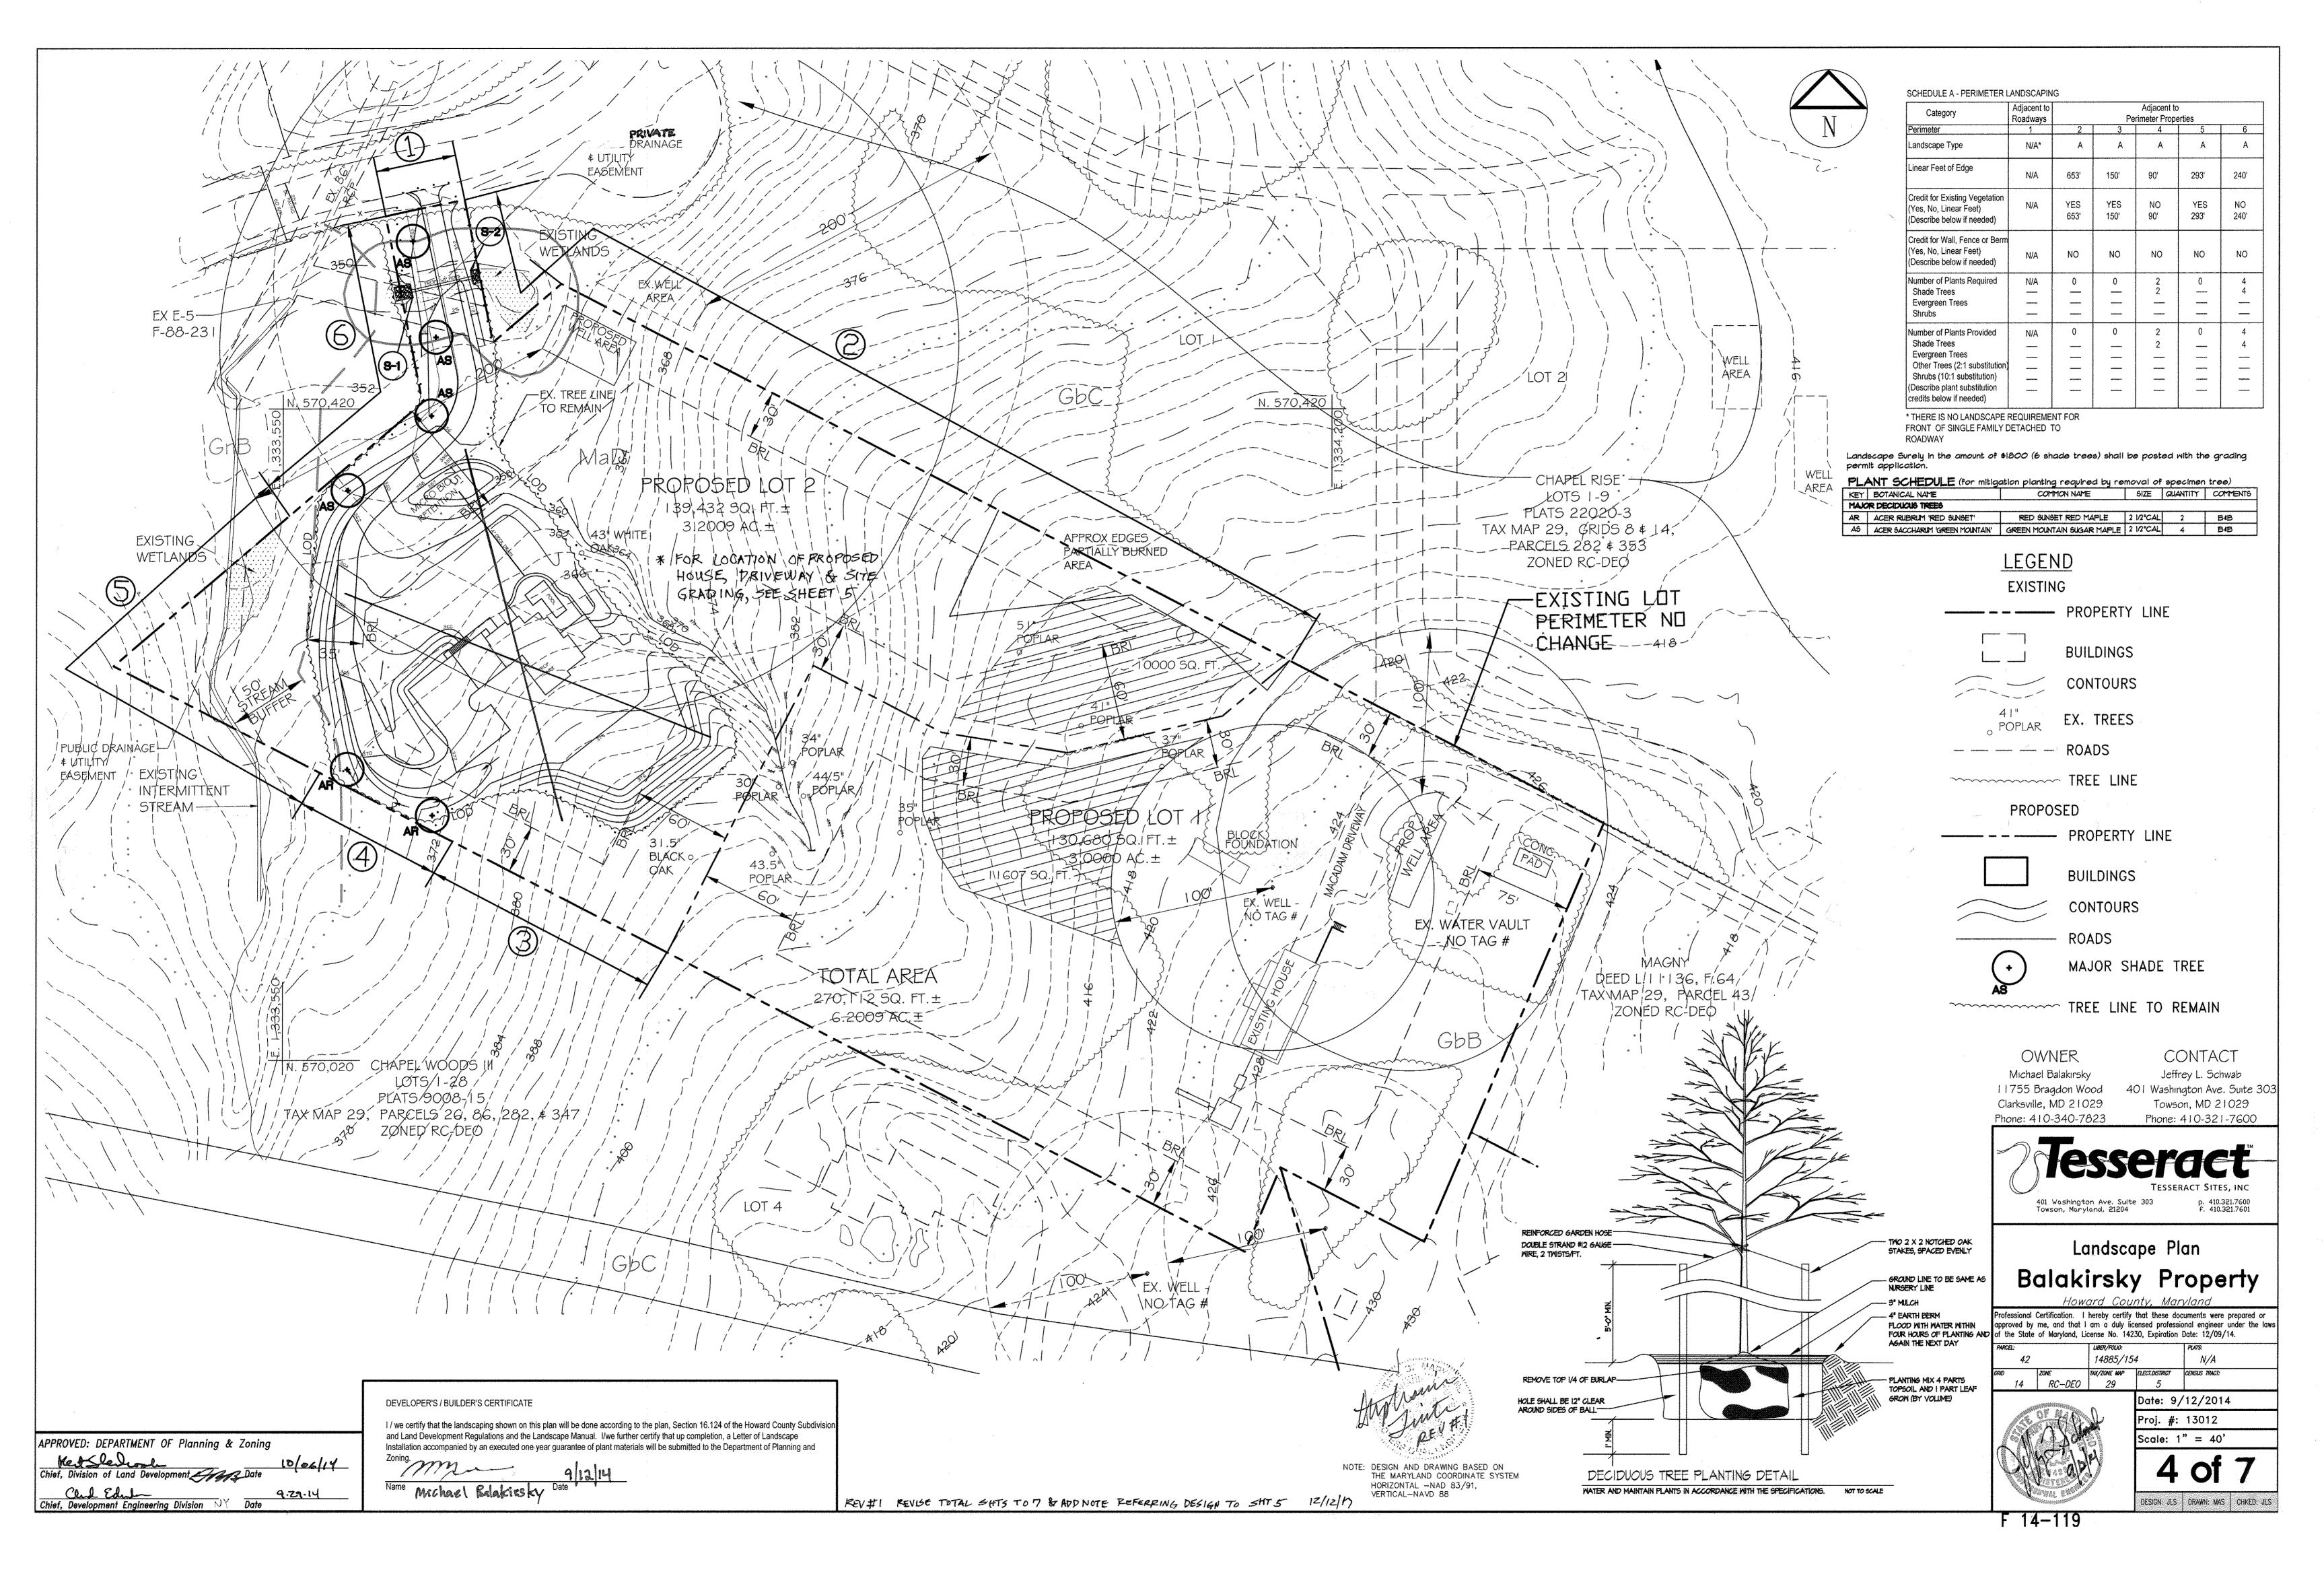

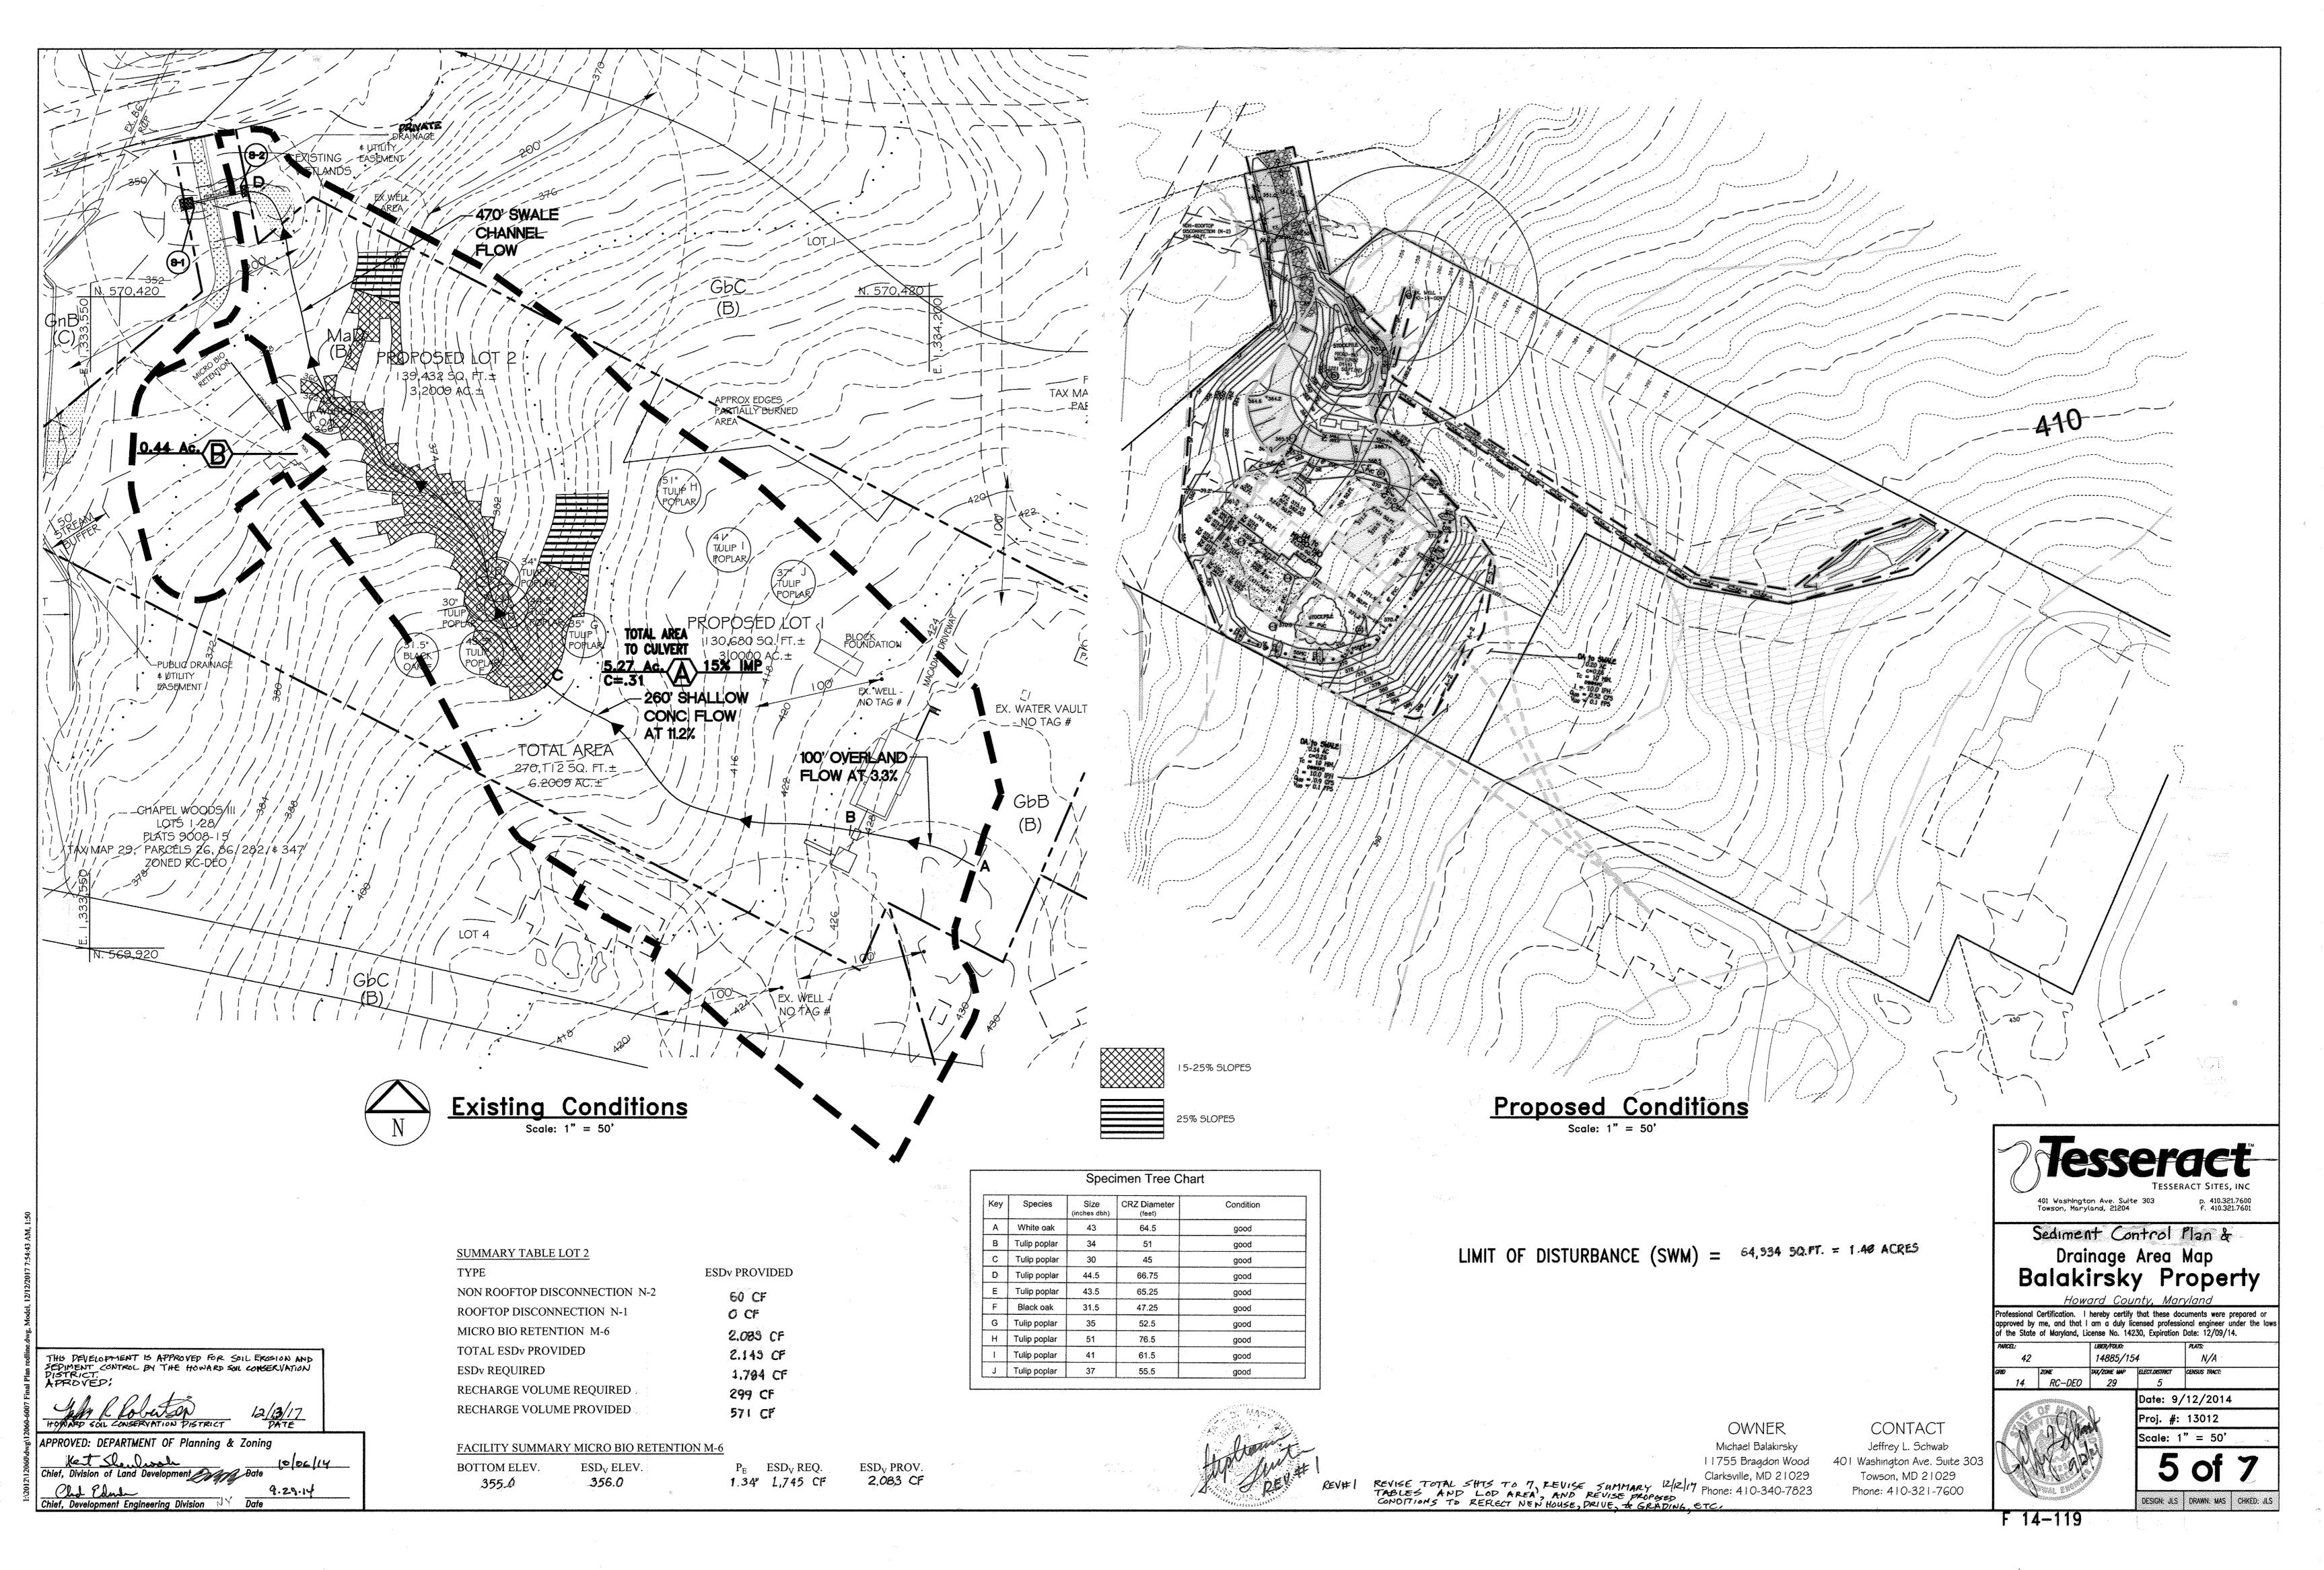

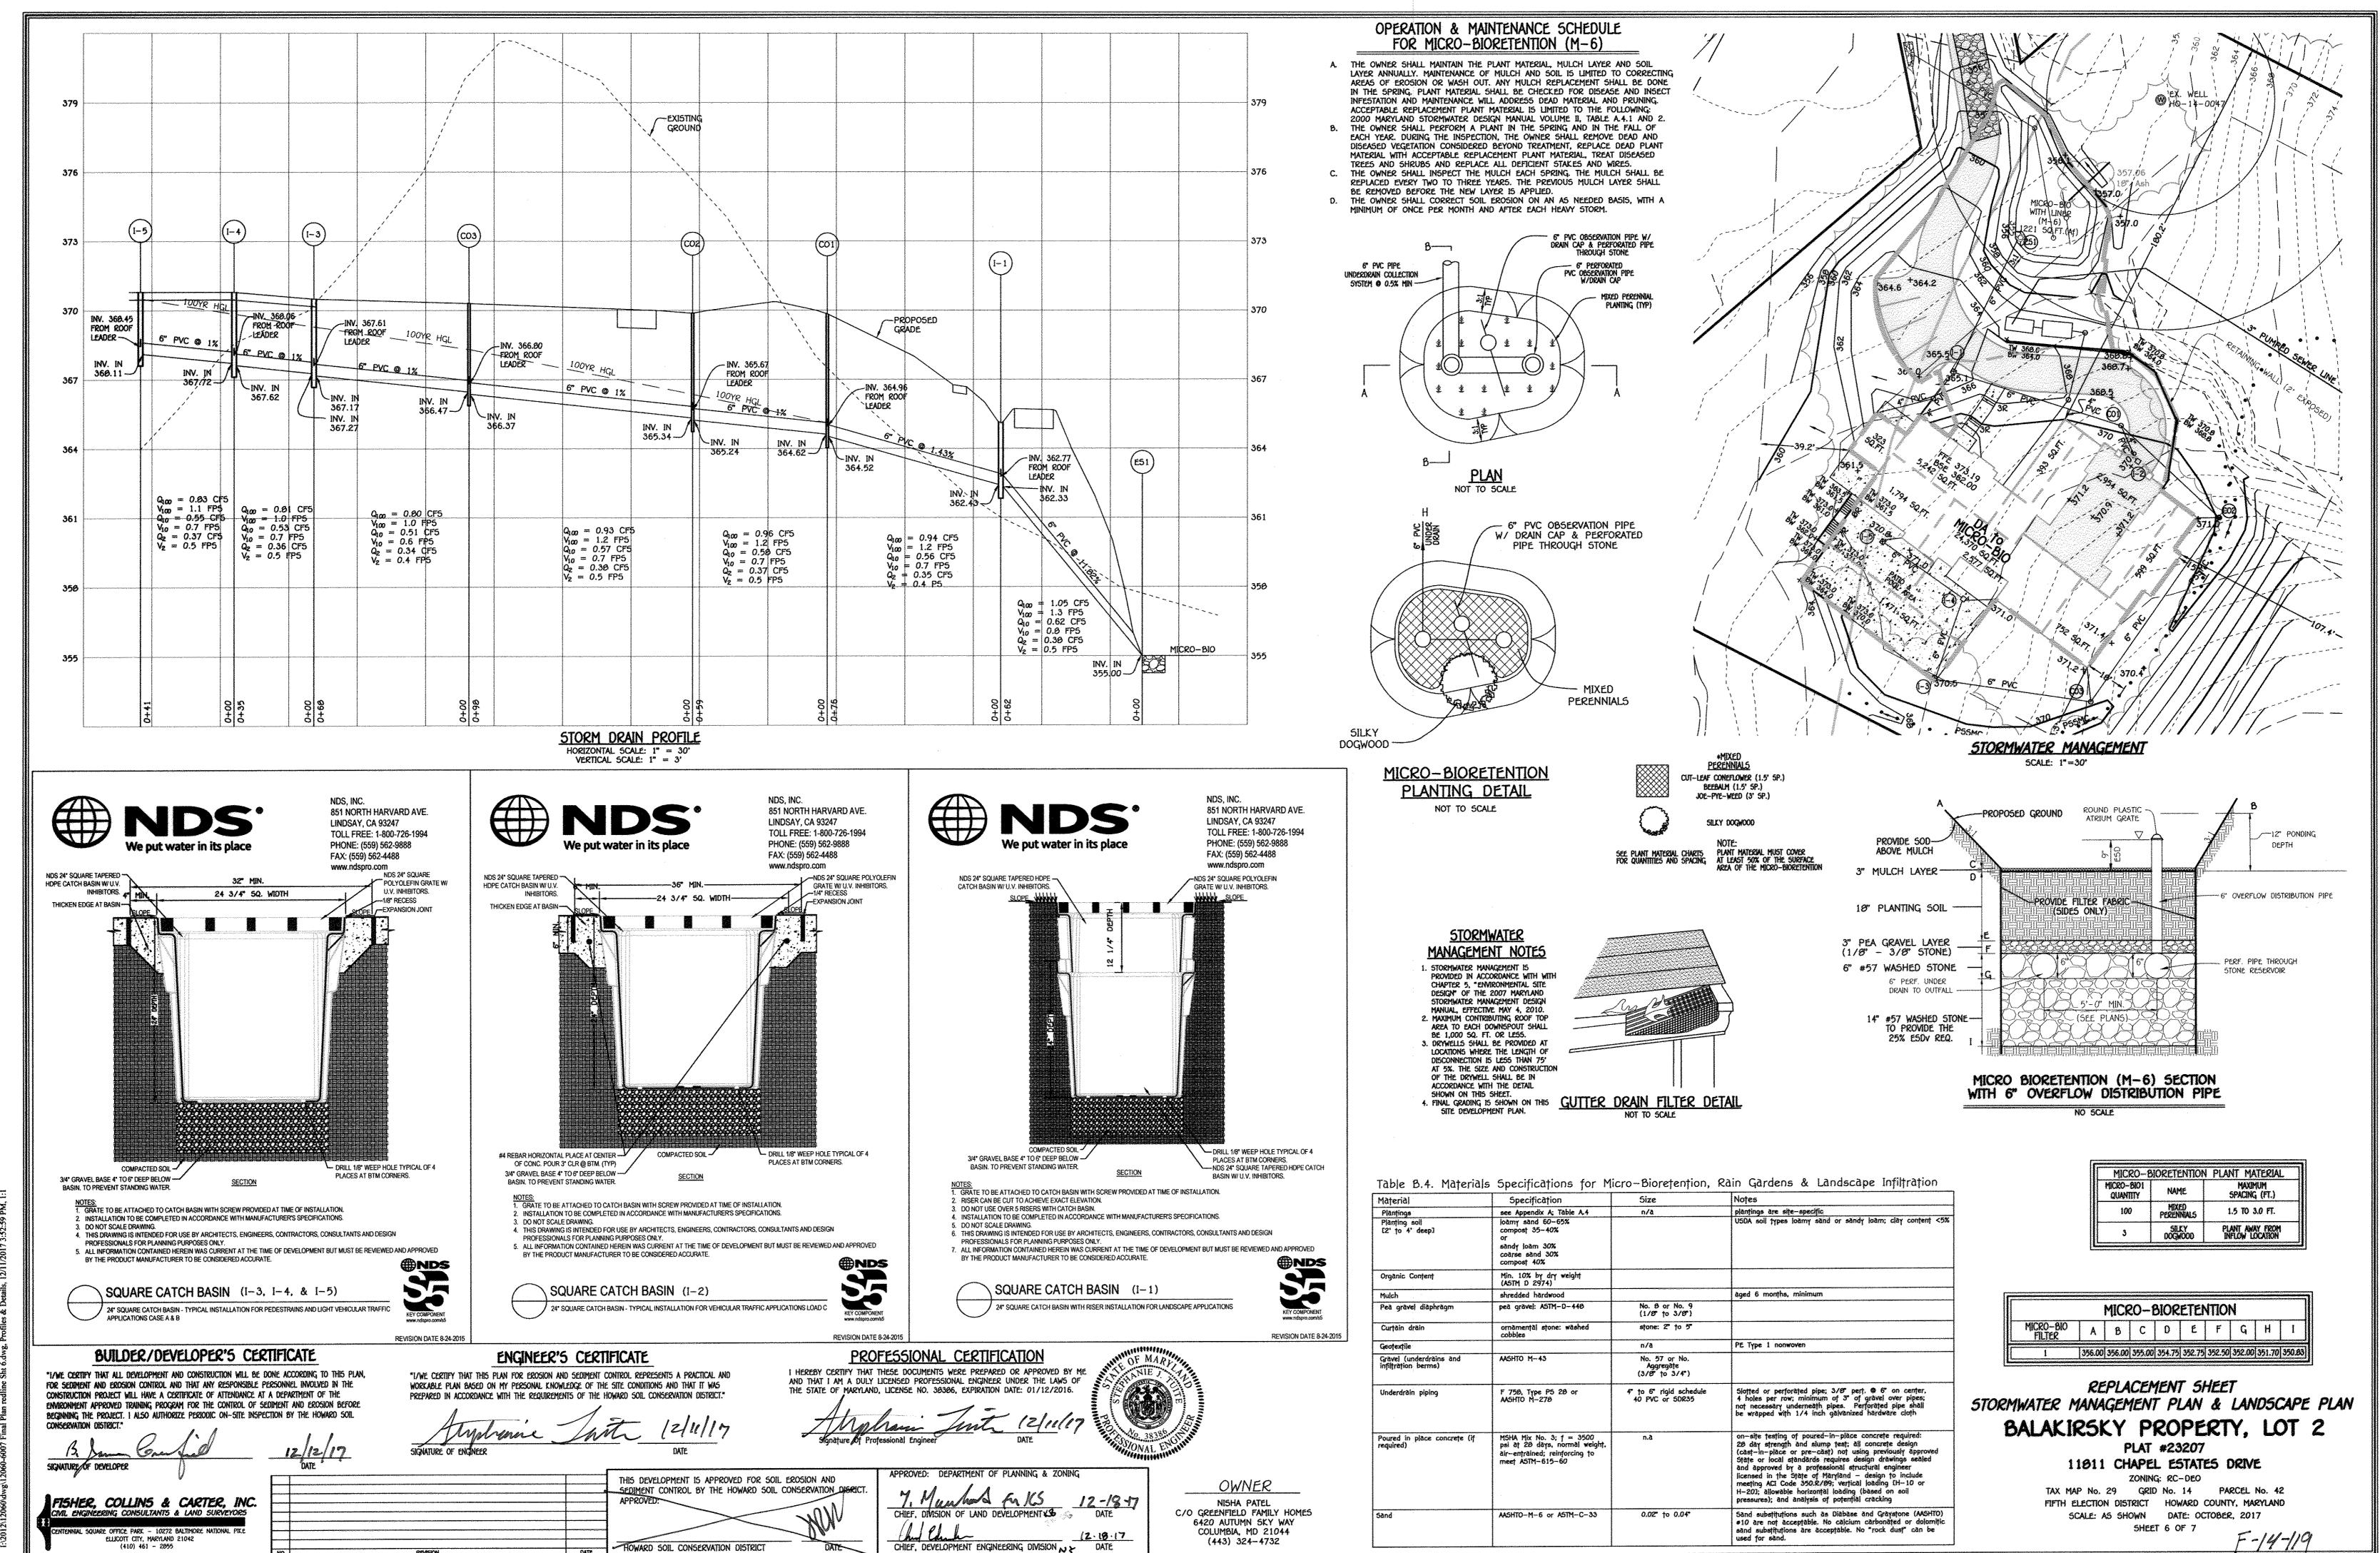

a. Seedbed preparation consists of loosening soil to a depth of 3 to 5 inches by means of suitable agricultural or construction equipment, such as disc harrows or chisel plows or rippers mounted on construction equipment. After the soil is loosened, it must not be rolled or dragged smooth but left in the roughened condition. Slopes 3:1 or flatter are to be tracked with ridges running parallel to the contour of the slope.

b. Apply fertilizer and lime as prescribed on the plans.

c. Incorporate lime and fertilizer into the top 3 to 5 inches of soil by disking or other suitable means. 2. Permanent Stabilizatio

a. A soil test is required for any earth disturbance of 5 acres or more. The minimum soil conditions required for permanent vegetative establishment are:

i. Soil oH between 6.0 and 7.0. ii. Soluble salts less than 500 parts per million (ppm). iii. Soil contains less than 40 percent clay but enough fine grained material (greater than 30 percent silt plus clay) to provide the capacity to hold a moderate amount of moisture. An exception: if lovegrass will be

iv. Soil contains 1.5 percent minimum organic matter by weight. v. Soil contains sufficient pore space to permit adequate root penetration

planted, then a sandy soil (less than 30 percent silt plus clay) would be acceptable.

Application of amendments or topsoil is required if on-site soils do not meet the above conditions

Graded areas must be maintained in a true and even grade as specified on the approved plan, ther scarified or otherwise loosened to a depth of 3 to 5 inches.

3 inches of soil loose and friable. Seedbed loosening may be unnecessary on newly disturbed areas.

d. Apply soil amendments as specified on the approved plan or as indicated by the results of a soil test. e. Mix soil amendments into the top 3 to 5 inches of soil by disking or other suitable means. Rake lawn areas to smooth the surface, remove large objects like stones and branches, and ready the area for seed application. Loosen surface soil by dragging with a heavy chain or other equipment to roughen the surface where site conditions will not permit normal seedbed preparation. Track slopes 3:1 or flatter with tracked equipment leaving

the soil in an irregular condition with ridges running parallel to the contour of the slope. Leave the top 1 to

B. Topsoiling

1. Topsoil is placed over prepared subsoil prior to establishment of permanent vegetation. The purpose is to provide a suitable soil medium for vegetative growth. Soils of concern have low moisture content, low nutrient levels, low pH, materials toxic to plants, and/or unacceptable soil gradation.

2. Topsoil salvaged from an existing site may be used provided it meets the standards as set forth in these specifications. Typically, the depth of topsoil to be salvaged for a given soil type can be found in the representative soil profile section in the Soil Survey published by USDA-NRCS.

3. Topsoiling is limited to areas having 2:1 or flatter slopes where:

d. The soil is so acidic that treatment with limestone is not feasible

a. The texture of the exposed subsoil/parent material is not adequate to produce vegetative growth.

b. The soil material is so shallow that the rooting zone is not deep enough to support plants or furnish continuing supplies of moisture and plant nutrients

c. The original soil to be vegetated contains material toxic to plant growth

4. Areas having slopes steeper than 2:1 require special consideration and design

5. Topsoil Specifications: Soil to be used as topsoil must meet the following criteria:

used if recommended by an agronomist or soil scientist and approved by the appropriate approval authority. Topsoil must not be a mixture of contrasting textured subsoils and must contain less than 5 percent by volume of cinders,

stones, slag, coarse fragments, gravel, sticks, roots, trash, or other materials larger than 1 1/2 inches in diameter. b. Topsoil must be free of noxious plants or plant parts such as Bermuda grass, quack grass, Johnson grass, nut sedge, poison ivy, thistle, or others as specified.

c. Topsoil substitutes or amendments, as recommended by a qualified agronomist or soil scientist and approved by the appropriate approval authority, may be used in lieu of natural topso 6. Topsoil Application

a. Erosion and sediment control practices must be maintained when applying topsoil.

b. Uniformly distribute topsoil in a 5 to 0 inch layer and lightly compact to a minimum thickness of 4 inches. Spreading is to be performed in such a manner that sodding or seeding can proceed with a minimum of additional soil preparation and tillage. Any irregularities in the surface resulting from topsoiling or other operations must be corrected in order to prevent the formation of depressions or water pockets.

c. Topsoil must not be placed if the topsoil or subsoil is in a frozen or muddy condition, when the subsoil is excessively wet or in a condition that may otherwise be detrimental to proper grading and seedbed preparation.

C. Soil Amendments (Fertilizer and Lime Specifications)

1. Soil tests must be performed to determine the exact ratios and application rates for both lime and fertilizer on sites having disturbed areas of 5 acres or more. Soil analysis may be performed by a recognized private or commercial laboratory. Soil samples taken for engineering purposes may also be used for chemical analyses. 2. Fertilizers must be uniform in composition, free flowing and suitable for accurate application by appropriate equipment. Manure may be substituted for fertilizer with prior approval from the appropriate approval authority. Fertilizers must all be delivered to the site fully labeled according to the applicable laws and must bear the name, trade name or trademark and warranty of the producer.

3. Lime materials must be ground limestone (hydrated or burnt lime may be substituted except when hydroseeding) which contains at least 50 percent total oxides (calcium oxide plus magnesium oxide). Limestone must be ground to such fineness that at least 50 percent will pass through a #100 mesh sieve and 98 to 100 percent will pass through

4. Lime and fertilizer are to be evenly distributed and incorporated into the top 3 to 5 inches of soil by disking or

5. Where the subsoil is either highly acidic or composed of heavy clays, spread ground limestone at the rate of 4 to 8 tons/acre (200-400 pounds per 1,000 square feet) prior to the placement of topsoil.

8-4-3 STANDARDS AND SPECIFICATIONS FOR SEEDING AND MULCHING

To protect disturbed soils from erosion during and at the end of construction

Conditions Where Practice Applies To the surface of all perimeter controls, slopes, and any disturbed area not under active grading.

Seeding

1. Specifications
a. All seed must meet the requirement of the Maryland State Seed Law. All seed must be subject to re-testing by a recognized seed

a. All seed must meet the requirement of the Maryland State Seed Law. All seed must be subject to re-testing by a recognized seed laboratory. All seed used must have been tested within the 6 months immediately preceding the date of sowing such material on any project. Refer to Table B.4 regarding the quality of seed. Seed tags must be available upon request to the inspector to verify type of seed and seeding rate.

must be applied when the ground thaws.

c. Inoculants: The inoculant for treating legume seed in the seed mixtures must be a pure culture of nitrogen fixing bacteria prepared specifically for the species. Inoculants must not be used later than the date indicated on the container. Add fresh inoculants as directed on the package. Use four times the recommended rate when hydroseeding. Note: It is very important to keep inoculant as cook as possible until used. Temperatures above 75 to 80 degrees Fahrenheit can weaken bacteria and make the inoculant less

d. Sod or seed must not be placed on soil which has been treated with soil sterilants or chemicals used for weed control until sufficient time has elapsed (14 days min.) to permit dissipation of phyto-toxic materials.

a. Dry Seeding: This includes use of conventional drop or broadcast spreaders.
i. Incorporate seed into the subsoil at the rates prescribed on Temporary Seeding Table B.1, Permanent Seeding Table B.3, or

site-specific seeding summaries.

ii. Apply seed in two directions, perpendicular to each other. Apply half the seeding rate in each direction. Roll the seeded area with

weighted roller to provide good seed to soil contact.

b. Drill or Cultipacker Seeding: Mechanized seeders that apply and cover seed with soil.

i. Cultipacking seeders are required to bury the seed in such a fashion as to provide at least 1/4 inch of soil covering. Seedbed must be firm after planting.
 ii. Apply seed in two directions, perpendicular to each other. Apply half the seeding rate in each direction.

c. Hydroseeding: Apply seed uniformly with hydroseeder (slurry includes seed and fertilizer).

i. If fertilizer is being applied at the time of seeding, the application rates should not exceed the following: nitrogen, 100 pounds per

acre total of soluble nitrogen; P O (phosphorus), 200 pounds per acre; K O (potassium), 200 pounds per acre.

ii. Lime: Use only ground agricultural limestone (up to 3 tons per acre may be applied by hydroseeding). Normally, not more than 2 tons are applied by hydroseeding at any one time. Do not use burnt or hydrated lime when hydroseeding.

iii. Mix seed and fertilizer on site and seed immediately and without interruption. iv. When hydroseeding do not incorporate seed into the soil. OWNER

NISHA PATEL C/O GREENFIELD FAMILY HOMES 6420 AUTUMN SKY WAY COLUMBIA, MD 21044 (443) 324-4732 FISHER, COLLINS & CARTER, INC. CIVIL ENGINEERING CONSULTANTS & LAND SURVEYORS

THIS DEVELOPMENT IS APPROVED FOR SOIL EROSION AND SEDIMENT CONTROL BY THE HOWARD SOIL CONSERVATION DISRICT. APPROVED

Mulch Materials (in order of preference)

gregs where one species of grass is desired.

land this practice should follow the contour,

TEMPORARY SEEDING NOTES (B-4-4)

Hardiness Zone (from Figure 8.3): ____6b__

Application Rate

(lb/ac)

96

72

Guide, Section 342 - Critical Area Planting.

receive a medium to high level of maintenance.

in the Permanent Seeding Summary

summary is to be placed on the plan.

2. Turfordss Mixtures

total mixture by weight.

(Hardiness Zones: 7a, 7b)

Hardiness Zone (from Figure B.3): <u>6b</u>

Application Rate

100

(lb/ac)

Seed Mixture (from Table B.3): ____

TALL

FESCUE

112

PERMANENT SEEDING NOTES (8-4-5)

Seed Mixture (from Table 8.1):

BARLEY

OATS

RYE

1. General Use

A. Seed Mixtures

To stabilize disturbed soils with vegetation for up to 6 months

duration of time, permanent stabilization practices are required.

testing agency. Soil tests are not required for Temporary Seeding.

To use fast growing vegetation that provides cover on disturbed soils

Conditions Where Practice Applies

Exposed soils where ground cover is needed for a period of 6 months or less. For longer

1. Select one or more of the species or seed mixtures listed in Table 8.1 for the appropriate

along with application rates, seeding dates and seeding depths. If this Summary is not put on

the plan and completed, then Table B.1 plus fertilizer and lime rates must be put on the plan.

3. When stabilization is required outside of a seeding season, apply seed and mulch or straw

mulch alone as prescribed in Section B-4-3.A.1.b and maintain until the next seeding season.

Seeding

Depths

1"

1"

a. Select one or more of the species or mixtures listed in Table B.3 for the appropriate Plant Hardiness Zone (from

Figure 8.3) and based on the site condition or purpose found on Table 8.2. Enter selected mixture(s). application

rates, and seeding dates in the Permanent Seeding Summary. The Summary is to be placed on the plan

b. Additional planting specifications for exceptional sites such as shorelines, stream banks, or dunes or for

special purposes such as wildlife or aesthetic treatment may be found in USDA-NRCS Technical Field Office

c. For sites having disturbed area over 5 acres, use and show the rates recommended by the soil testing

agency. d. For areas receiving low maintenance, apply urea form fertilizer (46-0-0) at 3 1/2 pounds per

1000 square feet (150 pounds per acre) at the time of seeding in addition to the soil amendments shown

a. Areas where turforass may be desired include lawns, parks, playgrounds, and commercial sites which will

b. Select one or more of the species or mixtures listed below based on the site conditions or purpose.

Enter selected mixture(s), application rates, and seeding dates in the Permanent Seeding Summary. The

required in the areas of central Maryland and Eastern Shore. Recommended Certified Kentucky Bluegrass

Cultivars Seeding Rate: 1.5 to 2.0 pounds per 1000 square feet. Choose a minimum of three Kentucky

establishment is necessary and when turf will receive medium to intensive management. Certified Perennial

Choose a minimum of three Kentucky bluegrass cultivars with each ranging from 10 to 35 percent of the

iii. Tall Fescue/Kentucky Bluegrass: Full Sun Mixture: For use in drought prone areas and/or for areas

Tall Fescue Cultivars 95 to 100 percent, Certified Kentucky Bluegrass Cultivars 0 to 5 percent. Seeding

iv. Kentucky Bluegrass/Fine Fescue: Shade Mixture: For use in areas with shade in Bluegrass lawns. For

establishment in high quality, intensively managed turf area. Mixture includes; Certified Kentucky Bluegrass

Cultivars 30 to 40 percent and Certified Fine Fescue and 60 to 70 percent. Seeding Rate: 1 1/2 to 3

Select turfgrass varieties from those listed in the most current University of Maryland

Choose certified material. Certified material is the best quarantee of cultivar purity. The

d. Till areas to receive seed by disking or other approved methods to a depth of 2 to 4 inches, level and

rake the areas to prepare a proper seedbed. Remove stones and debris over 1 1/2 inches in diameter

e. If soil moisture is deficient, supply new seedings with adequate water for plant growth (1/2 to 1 inch

every 3 to 4 days depending on soil texture) until they are firmly established. This is especially true when seedings are made late in the planting season, in abnormally dry or hot seasons, or on adverse sites.

Depths

(1.0 lb/ 1000 sf)

The resulting seedbed must be in such condition that future moving of grasses will pose no difficulty.

Permanent Seeding Summary

Mar. 1-May 15 1/4-1/2 45 lbs. Aug. 15-Oct. 15 in. per acre

Dates

certification program of the Maryland Department of Agriculture, Turf and Seed Section, provides

Publication, Agronomy Memo #77, "Turfgrass Cultivar Recommendations for Maryland"

Ideal Times of Seeding for Turf Grass Mixtures Western MD: March 15 to June 1, August 1 to

October 1 (Hardiness Zones: 5b, 6a) Central MD: March 1 to May 15, August 15 to October 15

(Hardiness Zone: 6b) Southern MD, Eastern Shore: March 1 to May 15, August 15 to October 15

à reliable means of consumer protection and assures à pure genetic line

receiving low to medium management in full sun to medium shade. Recommended mixture includes; Certified

Ryegrass Cultivars/Certified Kentucky Bluegrass Seeding Rate: 2 pounds mixture per 1000 square feet.

i, Kentucky Bluegrass: Full Sun Mixture: For use in areas that receive intensive management. Irrigation

bluegrass cultivars with each ranging from 10 to 35 percent of the total mixture by weight.

Rate: 5 to 8 pounds per 1000 square feet. One or more cultivars may be blended.

ii. Kentucky Bluegrass/Perennial Rye: Full Sun Mixture: For use in full sun areas where rapid

Fertilizer Rate

(10-20-20)

436 lb/ac

1000 sf)

(10 lb/

Lime Rate

2 tons/ac

(90 lb/

1000 sf)

2. For sites having soil tests performed, use and show the recommended rates by the

Seeding

Dates

3/1 - 5/15

8/15 - 10/15

Plant Hardiness Zone (from Figure 8.3), and enter them in the Temporary Seeding Summary below

the uniformly spread slurry.

i. WCFM, including dye, must contain no germination or growth inhibiting factors.

a. Straw consisting of thoroughly threshed wheat, rye, oat, or barley and reasonably bright in color. Straw is to be free of noxious weeds as specified in the Maryland Seed Law and not musty, moldy, caked, decayed, or excessively dusty. Note: Use only sterile straw mulch in

b. Wood Cellulose Fiber Mulch (WCFM) consisting of specially prepared wood cellulose processed into a uniform fibrous physical state.

i, WCFM is to be dyed green or contain a green dye in the package that will provide an appropriate color to facilitate visual inspection of

iii. WCFM materials are to be manufactured and processed in such a manner that the wood cellulose fiber mulch will remain in uniform suspension in water under agitation and will blend with seed, fertilizer and other additives to form a homogeneous slurry. The mulch

a. Apply mulch to all seeded areas immediately after seeding.
b. When straw mulch is used, spread it over all seeded areas at the rate of 2 tons per acre to a uniform loose depth of 1 to 2 inches

increase the application rate to 2.5 tons per acre.

c. Wood cellulose fiber used as mulch must be applied to a net dry weight of 1500 pounds per acre. Mix the wood cellulose fiber with water to attain a mixture with a maximum of 50 pounds of wood cellulose fiber per 100 gallons of water.

a. Perform mulch anchoring immediately following application of mulch to minimize loss by wind or water. This may be done by one of the

following methods (listed by preference), depending upon the size of the area and erosion hazard:

i. A mulch anchoring tool is a tractor drawn implement designed to punch and anchor mulch into the soil surface a minimum of 2 inches.

This practice is most effective on large areas, but is limited to flatter slopes where equipment can operate safely. If used on sloping

i. Wood cellulose fiber may be used for anchoring straw. Apply the fiber binder at a net dry weight of 750 pounds per acre. Mix the woo

iii. Synthetic binders such as Acrylic DLR (Agro-Tack), DCA-70, Petroset, Terra Tax II, Terra Tack AR or other approved equal may be used. Follow application rates as specified by the manufacturer. Application of liquid binders needs to be heavier at the edges where wind catches mulch, such as in valleys and on crests of banks. Use of asphalt binders is strictly prohibited.

iv. Lightweight plastic netting may be stapled over the mulch according to manufacturer recommendations. Netting is usually available in rolls 4-15 feet wide and 300 to 3,000 feet long.

cellulose fiber with water at a maximum of 50 pounds of wood cellulose fiber per 100 gallons of water.

material must form a blotter-like ground cover, on application, having moisture absorption and percolation properties and must cover and hold grass seed in contact with the soil without inhibiting the growth of the grass seedlings.

iv. WCFM material must not contain elements or compounds at concentration levels that will by phyto-toxic.

v. WCFM must conform to the following physical requirements: fiber length of approximately 10 millimeters, diameter approximately 1 millimeter, pH range of 4.0 to 8.5, ash content of 1.6 percent maximum and water holding capacity of 90 percent minimum.

APPROVED: DEPARTMENT OF PLANNING & ZONING T. Menhad fe KS 12-18-17

CHIEF, DIMSION OF LAND DEVELOPMENT US DATE

CONSERVATION DISTRICT.*

Fertilizer Rate (10-20-20) Lime Rate

90 lb/ac 2 tons/a

(2 lb/ (90 lb/

1000 sf) | 1000 sf) | 1000 sf)

P205

90 lb/ac

(2 lb/

General Specifications a. Class of turfgrass sod must be Maryland State Certified. Sod labels must be made available to the job foreman and inspector. b. Sod must be machine cut at a uniform soil thickness to 1/2 inch, plus or minus 1/2 inch, at the time of cutting. Measurement for thickness must exclude top growth and thatch. Broken pads and torn or uneven ends will not be acceptable. c. Standard size sections of sod must be strong enough to support their own weight and retain their size and shape when suspended vertically with a firm grasp on the upper 10 percent of the section.

B. Sod: To provide quick cover on disturbed areas (2:1 grade or flatter).

d. Sod must not be harvested or transplanted when moisture content (excessively dry of wet) may adversely affect its survival. e. Sod must be harvested, delivered, and installed within a period of 36 hours. Sod not transplanted within this period must be approved by an agronomist or soil scientist prior to its installation.

a. During periods of excessively high temperature or in areas having dry subsoil, lightly irrigate the subsoil immediately prior to laying b. Lay the first row of sod in a straight line with subsequent rows placed parallel to it and tightly wedged against each other.

Stagger lateral joints to promote more uniform growth and strength. Ensure that sod is not stretched or overlapped and that all joints are butted tight in order to prevent voids which would cause air drying of the roots. Wherever possible, lay sod with the long edges parallel to the contour and with staggering joints. Roll and tamp, peg or otherwise secure the sod to prevent slippage on slopes. Ensure solid contact exists between sod roots and the underlying soil surface.

a. In the absence of adequate rainfall, water daily during the first week or as often and sufficiently as necessary to maintain moist

d. Water the sod immediately following rolling and tamping until the underside of the new sod pad and soil surface below the sod are thoroughly wet. Complete the operations of laying, tamping, and irrigating for any piece of sod within eight hours.

soil to a depth of 4 inches. Water sod during the heat of the day to prevent wilting. b. After the first week, sod watering is required as necessary to maintain adequate moisture content. Do not mow until the sod is firmly rooted. No more than 1/3 of the grass leaf must be removed by the initial cutting or subsequent cuttings. Maintain a grass height of at least 3 inches unless otherwise specified.

> HOWARD SOIL CONSERVATION DISTRICT (HSCD) STANDARD SEDIMENT CONTROL NOTES

A pre-construction meeting must occur with the Howard County Department of Public Works, Construction Inspection Division (CID), 410-313-1055 after the future LOD and protected areas are marked clearly in the field. A minimum of 40 hour notice to CID must be given at the following stages:

proceeding with any other earth disturbance or grading.

c. Prior to the start of another phase of construction or opening of another grading unit. . Prior to the removal or modification of sediment control practices

Other building or grading inspection approvals may not be authorized until this initial approval by the inspection agency is made. Other related state and federa permits shall be referenced, to ensure coordination and to avoid conflicts with this plan. All vegetative and structural practices are to be installed according to the provisions of this plan and are to be in conformance with the 2011 MARYLAND STANDARDS AND SPECIFICATIONS FOR SOIL EROSION AND SEDIMENT CONTROL, and revisions thereto.

Following initial soil disturbance or re-disturbance, permanent or temporary stabilization is required within three (3) calendar days as to the surface of all

perimeter controls, dikes, swales, ditches, perimeter slopes, and all slopes steeper than 3 horizontal to 1 vertical (3:1); and seven (7) calendar days as to all other disturbed areas on the project site except for those areas under active grading.

All disturbed areas must be stabilized within the time period specified above in accordance with the 2011 MARYLAND STANDARDS AND SPECIFICATIONS FOR SOIL


EROSION AND SEDIMENT CONTROL for topsoil (Sec. B-4-2), permanent seeding (Sec. B-4-3), temporary stabilization with mulch alone can only be applied between the fall and spring seeding dates if the ground is frozen. Incremental stabilization (Sec. B-4-1) specifications shall be enforced in areas with >15 of cut and/or fill. Stockpiles (Sec. B-4-8) in excess of 20 ft. must be benched with stable outlet. All concentrated flow, steep slope, and highly erodible areas shall receive soil stabilization matting (Sec. B-4-6). Il sediment control structures are to remain in place, and are to be maintained in operative condition until permission for their removal has been obtained from

the CID. Site Analysis: Total Area of Site: _ Area Disturbed: Area to be roofed or paved: 0.41 Acres
Area to be vegetatively stabilized: 1.06 Acres

Offsite waste/borrow area location: N/A

Offsite waste/borrow area location: N/A

Any sediment control practice which is disturbed by grading activity for placement of utilities must be repaired on the same day of disturbance.

Additional sediment control must be provided, if deemed necessary by the CID. The site and all controls shall be inspected by the contractor weekly; and the next

day after each rain event. A written report by the contractor, made available upon request, is part of every inspection and should include:

inspection date

inspection type (routine, pre-storm event, during rain event)

Name and title of inspector

Weather information (current conditions as well as time and amount of last recorded precipitation) Brief description of project's status (e.g., percent complete) and/or current activities Evidence of sediment discharges identification of plan deficiencies identification of sediment controls that require maintenance identification of missing or improperly installed sediment controls

Compliance status regarding the sequence of construction and stabilization requirements Photographs
Monitoring/sampling
Maintenance and/or corrective action performed
Other inspection items as required by the General Permit for Stormwater Associated with Construction Activities (NPDES, MDE).
Other inspection items as required by the General Permit for Stormwater Associated with Construction Activities (NPDES, MDE).

Trenches for the construction of utilities is limited to three pipe lengths or that which can and shall be back-filled and stabilized by the end of each workday,

winchever is storger.

Any major changes or revisions to the plan or sequence of construction must be reviewed and approved by the HSCD prior to proceeding with construction. Minor revisions may allowed by the CID per the list of HSCD-approved field changes.

Disturbance shall not occur outside the LO.D. A project is to be sequenced so that grading activities begin on one grading unit (maximum acreage of 20 ac. per grading unit) at a time. Work may proceed to a subsequent grading unit when at least 50 percent of the disturbed area in the preceding grading unit has been stabilized and approved by the CID. Unless otherwise specified and approved by the HSCO, no more than 30 acres cumulatively may be disturbed at a given time.

12. Wash water from any equipment, vehicles, wheels, pavement, and other sources must be treated in a sediment basin or other approved washout structure.

13. Topsoil shall be stockpiled and preserved on-site for redistribution onto final grade.

14. All Sit Fence and Super Sit Fence shall be placed on-the-contour, and be imbricated at 25 minimum

intervals, with lower ends curied uphill by 2 in elevation.

Stream channels must not be disturbed during the following restricted time periods (inclusive): Use I and IP March 1 - June 15

Use IV March 1 - May 31

16. A copy of this pian, the 2011 MARYLAND STANDARDS AND SPECIFICATIONS FOR SOIL EROSION AND SEDIMENT CONTROL, and associated permits shall be on-site and available when the site

B-4-8 STANDARDS AND SPECIFICATIONS FOR STOCKPILE AREAS

<u>Definition</u>

A mound or pile of soil protected by appropriately designed erosion and sediment control measures

To provide a designated location for the temporary storage of soil that controls the potential for erosion, sedimentation, and changes to drainage patterns.

Conditions Where Practice Applies Stockpile areas are utilized when it is necessary to salvage and store soil for later use.

Criteria 1. The stockpile location and all related sediment control practices must be clearly indicated on the erosion and sediment control plan. 2. The footprint of the stockpile must be sized to accommodate the anticipated volume of material and based on a side slope ratio no steeper than 2:1. Benching must be provided in accordance with Section B-3 Land Grading. 3. Runoff from the stockpile area must drain to a suitable sediment control

4. Access the stockpile area from the upgrade side. 5. Clear water runoff into the stockpile area must be minimized by use of a diversion device such as an earth dike, temporary swale or diversion tence. Provisions must be made for discharging concentrated flow in a non-erosive

6. Where runoff concentrates along the toe of the stockpile fill, an appropriate erosion/sediment control practice must be used to intercept the discharge. 7. Stockpiles must be stabilized in accordance with the 3/7 day stabilization requirement as well as Standard 8-4-1 Incremental Stabilization and Standard 8. If the stockpile is located on an impervious surface, a liner should be

provided below the stockpile to facilitate cleanup. Stockpiles containing contaminated material must be covered with impermeable sheeting.

The stockpile area must continuously meet the requirements for Adequate Vegetative Establishment in accordance with Section B-4 Vegetative Stabilization Side slopes must be maintained at no steeper than a 2:1 ratio. The stockpile area must be kept free of erosion. If the vertical height of a stockpile exceeds 20 feet for 2:1 slopes, 30 feet for 3:1 slopes, or 40 feet for 4:1 slopes, benching must be provided in accordance with Section 8-3 Land Grading.

BUILDER/DEVELOPER'S CERTIFICATE

FOR SPOIMENT AND FROSION CONTROL AND THAT ANY RESPONSIBLE PERSONNEL INVOLVED IN THE

CONSTRUCTION PROJECT WILL HAVE A CERTIFICATE OF ATTENDANCE AT A DEPARTMENT OF THE

d - FLOW DEPTH 12 IN MIN. 24 IN MIN. PLAN VIEW FLOW CHANNEL STABILIZATION SEED WITH STRAW MULCH AND TACK, (NOT ALLOWED FOR CLEAR WATER DIVERSION.) A-2/B-2 SEED WITH SOIL STABILIZATION MATTING OR LINE WITH SOO. A-3/B-3 4 TO 7 INCH STONE OR EQUIVALENT RECYCLED CONCRETE PRESSED INTO SOIL A MINIMUM OF 7 INCHES AND FLUSH WITH GROUND. CONSTRUCTION SPECIFICATIONS REMOVE AND DISPOSE OF ALL TREES, BRUSH, STUMPS, OBSTRUCTIONS, AND OTHER OBJECTIONABLE MATERIAL SO AS NOT TO INTERFERE WITH PROPER FUNCTION OF EARTHDIKE. EXCAVATE OR SHAPE EARTH DIKE TO LINE, GRADE, AND CROSS SECTION AS SPECIFIED. BANK PROJECTIONS OR OTHER IRREGULARITIES ARE NOT ALLOWED. COMPACT FILL CONSTRUCT FLOW CHANNEL ON AN UNINTERRUPTED, CONTINUOUS GRADE, ADJUSTING THE LOCATION DUE TO FIELD CONDITIONS AS NECESSARY TO MAINTAIN POSITIVE DRAINAGE. PROVIDE OUTLET PROTECTION AS REQUIRED ON APPROVED PLAN. . Stabilize earth dike within three days of installation. Stabilize flow channel for clear water diversion within 24 hours of installation. 7. — MAINTAIN LINE, GRADE, AND CROSS SECTION. REMOVE ACCUMULATED SEDIMENT AND DEBRIS, AND MAINTAIN POSITIVE DRAINAGE. KEEP EARTH DIKE AND POINT OF DISCHARGE FREE OF EROSION, AND CONTINUOUSLY MEET REQUIREMENTS FOR ADEQUATE VEGETATIVE ESTABLISHMENT IN ACCORDANCE WITH SECTION B-4 VEGETATIVE STABILIZATION. "I/WE CERTIFY THAT ALL DEVELOPMENT AND CONSTRUCTION WILL BE DONE ACCORDING TO THIS PLAN

CROSS SECTION


EARTH DIKE

CONTINUOUS GRADE 0.5% MIN. TO 10% MAX. SLOPE

XXXXXXXXX

ENVIRONMENT APPROVED TRAINING PROCRAM FOR THE CONTROL OF SEDIMENT AND EROSION BEFORE BEGINNING THE PROJECT. I ALSO AUTHORIZE PERIODIC ON-SITE INSPECTION BY THE HOWARD SOIL

> ENGINEER'S CERTIFICATE "I/WE CERTIFY THAT THIS PLAN FOR EROSION AND SEDIMENT CONTROL REPRESENTS A PRACTICAL AND workable plan based on my personal knowledge of the site conditions and that it was PREPARED IN ACCORDANCE WITH THE REQUIREMENTS OF THE HOWARD SOIL CONSERVATION DISTRICT." Mylan

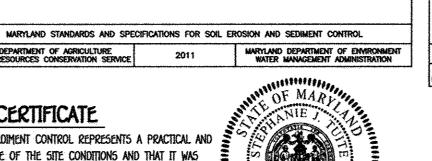

2. PLACE NONWOVEN GEOTEXTILE, AS SPECIFIED IN SECTION H-1 MATERIALS, UNDER THE BOTTOM AND SIDES OF THE DAM PRIOR TO PLACEMENT OF STONE. CONSTRUCT THE CHECK DAM WITH WASHED 4 TO INCH STONE OR EQUIVALENT RECYCLED CONCRETE (WITHOUT REBAR) WITH SIDE SLOPES OF 2:1 OR FLATTER AND A MINIMUM TOP WOTH OF 12 INCHES, PLACE THE STONE SO THAT IT COMPLETELY COVERS THE WOTH OF THE CHANNEL AND CHANNEL BANKS, FORM THE WERR SO THAT TOP OF THE OUTLET CREST IS APPROXIMATELY 6 INCHES LOWER THAN THE OUTER EDGES. UNE THE UPSTREAM FACE OF THE DAM WITH A 1 FOOT THICK LAYER OF WASHED AGGREGATE (%, TO 1½ INCH). REMOVE ACCUMULATED SEDIMENT WHEN IT REACHES ONE—HALF OF THE HEIGHT OF THE WEIR CREST. MAINTAIN LINE, GRADE, AND CROSS SECTION. MARYLAND STANDARDS AND SPECIFICATIONS FOR SOIL EROSION AND SEDIMENT CONTROL

ON FLOW CHANNEL SEE OF DROS

DIKE TYPE

APRON_ (TYP.)

NONWOVEN ...

o - DIKE HEIGHT 18 IN MIN. 30 IN MIN.

b - DIKE WIDTH 24 IN MIN. 36 IN MIN.

c - FLOW WIDTH 4 FT MIN. 8 FT MIN.

2:1 SLOPE OR FLATTER

NOTE: REAR OF HOUSE * SPACING = 0.6 FT / 0.022 FT/FT = 27 FT MIN. * CHECK DAMS SPACED 30 FT APART WITH WEIR HEIGHT OF 0.6 FT. WEIR 4 FT WIDE. FRONT OF HOUSE * SPACING = 0.6 FT / 0.02 FT/FT = 20 FT MIN. * CHECK DAMS SPACED 30 FT APART WITH WEIR HEIGHT OF 0.6 FT. WEIR 4 FT WIDE.

2011

STABILIZED CONSTRUCTION

PROFILE

PLAN VIEW

PLACE STABILIZED CONSTRUCTION ENTRANCE IN ACCORDANCE WITH THE APPROVED PLAN. VEHICLES MUST TRAVEL OVER THE ENTIRE LENGTH OF THE SCE. USE MINIMUM LENGTH OF 50 FEET (*30 FEET FOR SINGLE RESIDENCE LOT), USE MINIMUM WIDTH OF 10 FEET. FLARE SCE 10 FEET MINIMUM AT THE EXISTING ROAD TO PROVIDE A TURNING RADIUS.

PREPARE SUBGRADE AND PLACE NONWOVEN GEOTEXTILE, AS SPECIFIED IN SECTION H-1 MATERIALS

MARYLAND STANDARDS AND SPECIFICATIONS FOR SOIL EROSION AND SEDIMENT CONTROL

STABILIZATION MATTING

USE NATING THAT HAS A DESIGN VALUE FOR SHEAR STRESS EQUAL TO OR HIGHER THAN THE SHEAR STRESS DESIGNATED ON APPROVED PLANS.

. Unroll matting in direction of water flow, centering the first roll on the channel center line. Work from center of channel outward when placing rolls. Lay matting smoothly and firsely upon the seeded surface, avoid stretching the matting.

Overlap or abut edges of matting rolls per manufacturer recommendations, overlap roll ends by 6 inches (minimum), with the upstream mat overlapping on top of the next doministream mat.

7. KEY IN THE TOP OF SLOPE END OF MAT 8 INCHES (MINIMUM) BY DIGGING A TRENCH, PLACING THE MATTING ROLL END IN THE TRENCH, STAPLING THE MAT IN PLACE, REPLACING THE EXCAVATED MATERIAL, AND TAMPING TO SECURE THE MAT END IN THE KEY.

STAPLE/STAKE MAT IN A STAGGERED PATTERN ON 4 FOOT (MAXIMUM) CENTERS THROUGHOUT AND 2 FOOT (MAXIMUM) CENTERS ALONG SEAMS, JOINTS, AND ROLL DIEDS.

IF SPECIFIED BY THE DESIGNER OR MANUFACTURER AND DEPENDING ON THE TYPE OF MAT BEING INSTALLS
ONCE THE MATTING IS KEYED AND STAPLED IN PLACE, FILL THE MAT VOIDS WITH TOP SOIL OR GRANULAR
MATERIAL AND LIGHTLY COMPACT OR ROLL TO MAXIMIZE SOIL/MAT CONTACT WITHOUT CRUSHING MAT.

2011

12000

CROSS SECTION

DETAIL D-2 STONE CHECK DAM

CHANNEL APPLICATION

DETAIL B-4-6-C PERMANENT SOIL

CONSTRUCTION SPECIFICATIONS

50 FT MIN.

LENGTH .

ENTRANCI

NONWOVEN

CONSTRUCTION SPECIFICATIONS

SOF

STANDARD SYMBOL DETAIL E-1 SILT FENCE 6 FT MAX. CENTER TO CENTER _36 IN MIN. FENCE POST LENGTH DRIVEN MIN. 16 IN INTO GROUND B IN MIN. DEPTH ELEVATION V FENCE POST 18 IN MIN. —ABOVE GROUND WOVEN SUT FILM-CROSS SECTION PIPE ALL SURFACE WATER FLOWING TO OR DIVERTED TOWARD THE SCE UNDER THE ENTRANCE, MAINTAINING POSITIVE DRAINAGE. PROTECT PIPE INSTALLED THROUGH THE SCE WITH A MOUNTABLE BERN WITH 5.1 SLOPES AND A MINIMUM OF 12 INCHES OF STONE OVER THE PIPE. PROVIDE PIPE AS SPECIFIED ON APPROVED PLAN. WHEN THE SCE IS LOCATED AT A HIGH SPOT AND HAS NO DRAINAGE TO CONVEY, A PIPE IS NOT NECESSARY, A MOUNTABLE BERM IS REQUIRED WHEN SCE IS NOT LOCATED AT A HIGH SPOT. STAPLE-JOINING TWO ADJACENT SILT FENCE SECTIONS (TOP VIEW) MAINTAIN ENTRANCE IN A CONDITION THAT MINIMIZES TRACKING OF SEDIMENT, ADD STONE OR MAKE OTHER REPAIRS AS CONDITIONS DEMAND TO MAINTAIN CLEAN SURFACE, MOUNTABLE BERM, AND SPECIFIED DIMENSIONS. MAMEDIATELY REMOVE STONE AND/OR SEDIMENT SPILLED, DROPPED, OR TRACKED ONTO ADJACENT ROADWAY BY VACULUMING, SCRAPING, AND/OR SWEEPING. WASHING ROADWAY TO REMOVE MUD TRACKED ONTO PAVEMENT IS NOT ACCEPTABLE UNLESS WASH WATER IS DIRECTED TO AN APPROVED SEDIMENT CONTROL PRACTICE.

ONSTRUCTION SPECIFICATIONS

USE WOOD POSTS 1% X 1% \pm %, INCH (MINIMUM) SQUARE CUT OF SOURD QUALITY HARDWOOD. AS A ALTERNATIVE TO WOODEN POST USE STANDARD "T" OR "U" SECTION STEEL POSTS WEIGHING NOT LESS THAN 1 POUND PER LINEAR FOOT. USE 36 INCH MINIMUM POSTS DRIVEN 16 INCH MINIMUM INTO GROUND NO MORE THAN 6 FEET APAS

USE WOVEN SLIT FILM GEOTEXTILE AS SPECIFIED IN SECTION H-1 MATERIALS AND FASTEN GEOTEXTS. SECURELY TO UPSLOPE SIDE OF FENCE POSTS WITH WIRE TIES OR STAPLES AT TOP AND MID-SECTI

EMBED GEOTEXTILE A MINIMUM OF 8 INCHES VERTICALLY INTO THE GROUND. BACKFILL AND COMPACT THE SOIL ON BOTH SIDES OF FABRIC.

WHERE TWO SECTIONS OF GEOTEXTILE ADJOIN: OVERLAP, TWIST, AND STAPLE TO POST IN ACCORDAN

EXTEND BOTH ENDS OF THE SILT FENCE A MINIMUM OF FIVE HORIZONTAL FEET UPSLOPE AT 45 DEGREES TO THE MAIN FENCE ALIGNMENT TO PREVENT RUNOFF FROM GOING AROUND THE ENDS THE SILT FENCE.

MARYLAND STANDARDS AND SPECIFICATIONS FOR SOIL EROSION AND SEDIMENT CONTROL DETAIL E-3 SUPER SILT FENCE -SSF 10 FT MAX.

> GALVANIZED CHAIN LINK FENCE WITH WOVEN SLIT FILM GEOTEXTILE ELEVATION CHAIN LINK FENCING-HOVEN SLIT FILM GEOTEXTILE— FLOW ____

EMBED GEOTEXTILE AND — CHAIN LINK FENCE 8 IN LINL INTO GROUND CONSTRUCTION SPECIFICATIONS

D. ESTABLISH AND MAINTAIN VEGETATION SO THAT REQUIREMENTS FOR ADEQUATE VEGETATIVE ESTABLISHMENT ARE CONTINUOUSLY MET IN ACCORDANCE WITH SECTION 8—4 VEGETATIVE STABILIZATION. MARYLAND DEPARTMENT OF ENVIRONMEN WATER MANAGEMENT ADMINISTRATION SHEAR STRESS FOR PSSMC (REAR) = 62.4 ± 0.57 x 0.50 ft x 0.022 = 0.7 ± 0.57 ft SHEAR STRESS FOR PSSMC (FRONT) = $62.4 \text{ LBS/FT}^2 \times 0.39 \text{ FT } \times 0.02 = 0.5 \text{ LBS/FT}^2$

-4 TO 7 IN STONE (TYP.)

-12 IN MIN.

FASTEN WOVEN SLIT FILM GEOTEXTILE AS SPECIFIED IN SECTION H-1 MATERIALS, SECURELY TO THE UPSLOPE SIDE OF CHAIN LINK FENCE WITH TIES SPACED EVERY 24 INCHES AT THE TOP AND MID SECTION. EMBED GEOTEXTILE AND CHAIN LINK FENCE A MINIMUM OF 8 INCHES INTO THE GROUND.

REMOVE ACCUMULATED SEDIMENT AND DEBRIS WHEN BULGES DEVELOP IN FENCE OR WHEN SEDIMENT REACHES 25% OF FENCE HEIGHT. REPLACE GEOTEXTILE IF TORN, IF UNDERWINNING OCCURS, REINSTALL CHAIN LINK FENCING AND GEOTEXTILE. MARYLAND STANDARDS AND SPECIFICATIONS FOR SOIL EROSION AND SEDIMENT CONTROL

SEQUENCE OF CONSTRUCTION

OBTAIN A GRADING PERMIT AND HOLD PRE-CONSTRUCTION MEETING WITH COUNTY INSPECTOR. (2 WEEKS) NOTIFY "MISS UTILITY" AT LEAST 40 HOURS BEFORE BEGINNING ANY WORK AT

1-800-257-7777. NOTIFY THE HOWARD COUNTY DPW, CONSTRUCTION INSPECTION

DIVISION AT 410-313-1055 AT LEAST 40 HOURS BEFORE STARTING WORK. INSTALL STABILIZED CONSTRUCTION ENTRANCE, SILT FENCE, SUPER SILT FENCE, AND FARTH DIKES. (3 DAYS) ROUGH GRADE SITE AND UPON GRADING IN SWALES AS SHOWN ON THE PLANS INSTALL TEMPORARY CHECK DAMS (TCD) AND SOD WHERE SHOWN. (2 WEEKS)

INSTALL TEMPORARY SEEDING. (3 DAYS) CONSTRUCT BUILDING, ASSOCIATED DRIVEWAY, AND PORTION OF SEPTIC SYSTEM DOWNHILL OF EARTH DIKE. (18 MONTHS)

FINE GRADE SITE, REMOVE EARTH DIKES (UPON APPROVAL OF SEDIMENT CONTROL INSPECTOR), INSTALL REMAINING SEPTIC LINE, AND COMPLETE PERMANENT SEEDING UPON STABILIZATION AND ONCE ALL SITE WORK IS COMPLETED REMOVE TCD AND

INSTALL PERMANENT SOIL STABILIZATION MATTING IN SWALES WHERE SHOWN. NSTALL MICRO-BIORETENTION FACILITY. (1 WEEK) ALL FINAL GRADES AND STABILIZATION SHOULD BE COMPLETED BEFORE ANY

REMOVAL OF CONTROLS ASSOCIATED WITH THIS LOT. WHEN ALL CONTRIBUTING areas to the sediment control devices have been stabilized and with the PERMISSION OF THE SEDIMENT CONTROL INSPECTOR, THE SEDIMENT CONTROL DEVICES MAY BE REMOVED. (3 DAYS)

NOTE: THE CONTRACTOR SHALL INSPECT AND PROVIDE NECESSARY MAINTENANCE EACH

NOTES & DETAILS (HOUSE) BALAKIRSKY PROPERTY, LOT 2

PLAT #23207 11811 CHAPEL ESTATES DRIVE

SEDIMENT & EROSION CONTROL

ZONING: RC-DEO TAX MAP No. 29 GRID No. 14 PARCEL No. 42 FIFTH ELECTION DISTRICT HOWARD COUNTY, MARYLAND SCALE: AS SHOWN DATE: OCTOBER, 2017 SHEET 7 OF 7